

86 EAST

6 UNIT CONDOMINIUM
HORIZONTAL PROPERTY REGIME
OCEAN CITY
WORCESTER COUNTY
MARYLAND

I certify that the regulations of Article 21, Section 3-108 of the Annotated Code of Maryland, 1957 edition, (1973 Vol.) have been complied with, concerning the making of a plat, setting of markers and the existence of prior preliminary plats.

Raddy Conrad Co. Inc. Roland S. Raddy Pres.
Maryland Service Corporation Peter J. Lombardi, Pres. N

APPROVED FOR PUBLIC WATER AND SEWAGE SYSTEMS

 
Date 8/15/73 *James R. Tucker, R.S.*
County Health Officer

MASTER PLAN APPROVAL

Mayor and City Council of Ocean City
Worcester County, Maryland *ACB 9/18/73*

G.C.# 8-17-73 *Harry W. Kelly*
Mayor
Richard E. Powell
Council President

ELEMENTS:

COMMON ELEMENT 
UNIT AREA 

M.S. 8/12/73

I certify that these plans, comprised of sheets 1 through 7, inclusive, as built show graphically all particulars of the building including, but not limited to, the dimensions, area and location of each unit therein and the dimensions, area and location of common elements affording access to each unit. Other common elements, both limited and general, are shown graphically insofar as possible.


Date 8/11/73 *E. Jermore*



86 EAST

SHEET **1** OF **7**

MSA CS4 2157-926-1 2435

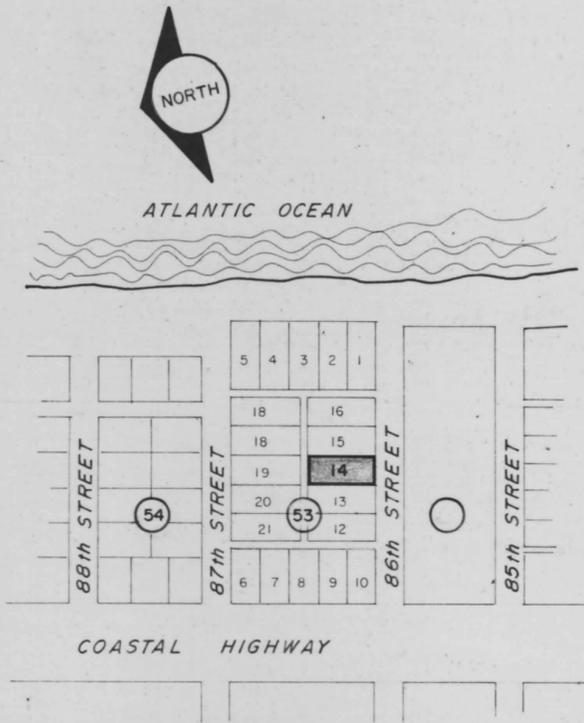

VICINITY MAP

SCALE: 1" = 200'

Lot 14
Block 53
Plat: OCEAN BAY CITY
OCEAN CITY
WORCESTER COUNTY
MARYLAND
Recorded among the land records of
Worcester County, Plat book O.D.C. No. 1
folios 23 and 76

G.K. INDUSTRIES, INC. 17 x 22 CONDOMINIUM FORM No. 7201

