


RHO 121/60

HIDDEN HARBOUR III, CONDOMINIUM  
PHASE-4 BLDG. N

NOTES OF CONDOMINIUM PLAT FOR HIDDEN HARBOUR

1. THIS CONDOMINIUM PLAT IS MADE SOLELY FOR THE PURPOSE OF COMPLIANCE WITH SECTION 11-105 OF THE MARYLAND CONDOMINIUM ACT. THUS, COMMON ELEMENTS ARE SHOWN DIAGRAMMATICALLY ONLY TO THE EXTENT FEASIBLE, AND MEASURED DIMENSIONS AND FLOOR AREAS ARE CORRECT ONLY TO A REASONABLE TOLERANCE, CAUTION IS URGED IN REGARD TO USING THIS PLAT FOR PURPOSES FOR WHICH IT IS NOT INTENDED, SUCH AS DETERMINING THE NATURE OR DESIGN OF THE STRUCTURAL OR OTHER COMPONENTS OF THE BUILDING OR THEIR EXACT DIMENSIONS OR LOCATION.
2. THIS PLAT INDICATES THE OUTLINES OF CERTAIN BUILDING COMPONENTS THAT ARE PART OF THE UNITS, IT IS NOT INTENDED TO SHOW THE EXACT LOCATION OR DIMENSION OF THESE COMPONENTS OR ALL OF THEM.
3. FLOOR AREAS OF UNITS ARE BASED ON THE PORTION OF THE FLOOR THAT IS PART OF THE UNIT, ACCORDINGLY, THE AREAS THAT ARE PART OF THE COMMON ELEMENTS AND THE LIMITED COMMON ELEMENTS SUCH AS BALCONYS, WALKWAYS, THE STRUCTURAL WALLS, COLUMNS, VOIDS, ETC., HAVE BEEN DELETED
4. THE ELEVATION OF THE UPPER AND LOWER BOUNDARIES OF EACH UNIT IS AN AVERAGE ELEVATION AND SUBJECT TO MINOR VARIANCES. IT IS STATED IN FEET ABOVE MEAN LOW WATER AND IS MEASURED TO THE UNFINISHED UPPER SURFACE OF THE STRUCTURAL FLOOR OF THE UNIT IN THE CASE OF ITS LOWER BOUNDARY, AND THE UNFINISHED LOWER SURFACE OF THE CEILING OR THE ROOF OF THE UNIT IN THE CASE OF ITS UPPER BOUNDARY. THE DATUM USED TO DETERMINE THE ELEVATION IS MEAN LOW WATER DATUM (1.57' FEET HIGHER THAN MEAN SEA LEVEL ESTABLISHED IN 1929, BY USGS).
5. SOLID SHADING OF AN AREA OR COMPONENT INDICATES THAT IT IS A GENERAL COMMON ELEMENT, CROSS-HATCHING INDICATES LIMITED COMMON ELEMENTS AND CLEAR AREAS ARE UNIT ELEMENTS
6. THESE NOTES ARE INTENDED TO AVOID MISUNDERSTANDING AND ARE NOT INTENDED TO CHANGE THE EFFECT OF THE CONDOMINIUM DECLARATION, WHICH CLASSIFIES VARIOUS COMPONENTS OF THE BUILDING AS SHOWN AS COMMON ELEMENTS OR PART OF A UNIT.

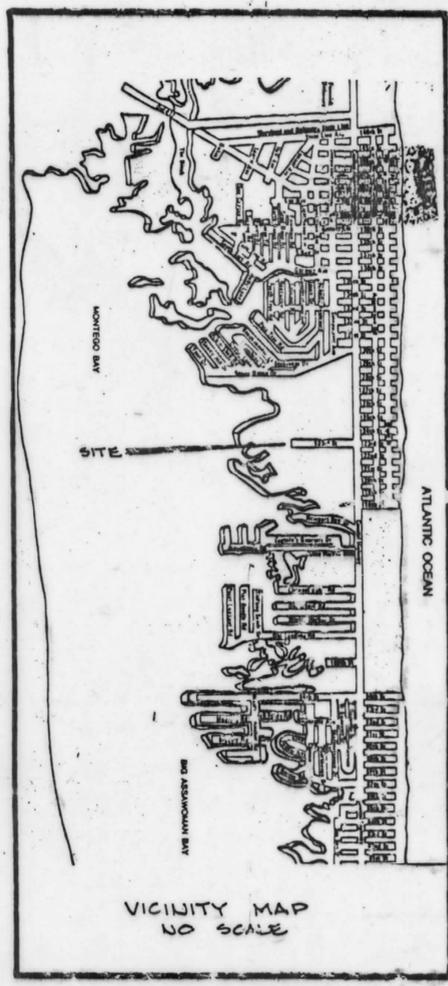


SURVEYOR'S CERTIFICATION

I HEREBY CERTIFY THAT I AM A LAND SURVEYOR LICENSED TO PRACTICE AS SUCH IN THE STATE OF MARYLAND AND THAT THIS CONDOMINIUM PLAT AND THE SURVEY SHOWN THEREON WERE MADE BY ME OR PERSONS UNDER MY DIRECTION AND SUPERVISION AND THAT THEY ACCURATELY DELINEATE THE LAND AND IMPROVEMENTS AS OF THIS DATE AND ALL EASEMENTS, RIGHT-OF-WAYS OR OTHER ENCROACHMENTS THAT COULD BE DETECTED BY AN INSPECTION OF THE PROPERTY ON THIS DATE OR OF WHICH I AM AWARE. ALL REQUIREMENTS OF LAW CONCERNING THE MAKING OF THE SURVEY SHOWN ON THIS CONDOMINIUM PLAT HAVE BEEN COMPLIED WITH, INCLUDING THE REQUIREMENTS OF THE SECTION 3-108 (C) OF THE REAL PROPERTY ARTICLE OF THE ANNOTATED CODE OF MARYLAND.

THIS WILL ALSO CERTIFY, FOR THE PURPOSE OF SECTION 11-105 (D) OF THE REAL PROPERTY ARTICLE OF THE ANNOTATED CODE OF MARYLAND, THAT THIS CONDOMINIUM PLAT, TOGETHER WITH THE APPLICABLE WORDING OF THE DECLARATION, IS A CORRECT REPRESENTATION OF THE CONDOMINIUM DESCRIBED AND THAT THE IDENTIFICATION AND LOCATION OF EACH UNIT AND THE COMMON ELEMENTS, AS CONSTRUCTED, CAN BE DETERMINED FROM THEM.

MY LICENSE NUMBER AS A LAND SURVEYOR IS NO. 10738

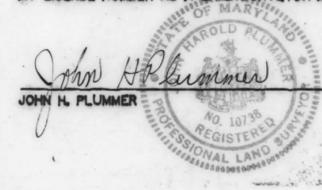

4/4/89  
DATE

OWNER'S CERTIFICATION

HIDDEN HARBOUR INC. ACTING AS DEVELOPER UNDER THE MARYLAND CONDOMINIUM ACT, HEREBY ADOPTS THIS CONDOMINIUM PLAT AND CERTIFIES THAT TO THE BEST OF ITS KNOWLEDGE, ALL REQUIREMENTS OF LAW CONCERNING ITS MAKING, INCLUDING THOSE OF SECTION 3-108 (C) OF THE REAL PROPERTY ARTICLE OF THE ANNOTATED CODE OF MARYLAND AS FAR AS IT CONCERNS THE MAKING OF THE SURVEY SHOWN HEREON AND THE SETTING OF MARKERS HAS BEEN COMPLIED WITH.

BY Thomas P. Monahan P 4-5-89  
HIDDEN HARBOUR INC. DATE

APPROVALS

THIS APPROVAL DOES NOT EXTEND TO ANY FUTURE USES AND IS LIMITED TO APPROVING THE USES AND AS BEING ENCOMPASSED WITHIN THE APPLICATION AND APPROVALS OF THE PLANNING AND ZONING COMMISSION AND THE BOARD OF APPEALS, THIS APPLICATION AND RECORDS ARE AVAILABLE FOR REVIEW AT THE OFFICE OF THE UNDERSIGNED

S. Slains Smith 4/5/89  
ZONING ADMINISTRATOR, TOWN OF OCEAN CITY, MARYLAND DATE

MASTER PLAN APPROVAL, MAYOR AND CITY COUNCIL OF OCEAN CITY, MARYLAND

Roland Powell 4-5-89  
MAYOR ROLAND POWELL DATE

George M. Hurley 4/5/89  
CITY COUNCIL PRESIDENT GEORGE M. HURLEY DATE

WORCESTER COUNTY ENVIRONMENTAL PROGRAMS  
Richard J. Welton 4/6/89  
WORCESTER COUNTY ENVIRONMENTAL PROGRAMS DATE

FILED  
APR 12 8 50 AM '89  
RICHARD H. CUTTEN  
CLK. CT. CT.  
WV. CO.

CLERK OF COURT  
RICHARD H. CUTTEN  
RISC FEE 15.00  
REC FEE 15.00  
TOTAL 30.00  
143BCKER 30.00  
01 01989 4-12 88-89

**HIDDEN HARBOUR III  
CONDOMINIUM**

**COVER SHEET**

**JOHN H. PLUMMER & ASSOC., INC.**  
CIVIL ENGINEERS AND LAND SURVEYORS  
BALISURY, MARYLAND

Contract	Surveyed	Deed Ref.
Scale: AS NOTED	Drc'n: LOKOWITZ	Plot Ref.
Date: 4/4/89	Checked	Sheet: 1 of 8

1-21KE-151E  
NSA  
NSA