

FILED
OCT 21 11 57 AM '82
WARNE C. LITTLETON
CLK. CT. CT.
WOR. CO.

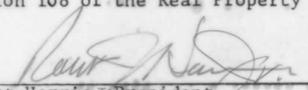
WCL 76/2

OUR PLACE AT THE BEACH CONDOMINIUM

OCT 21-82 A #27630 *** 15.00
OCT 21-82 A #27630 *** 15.00

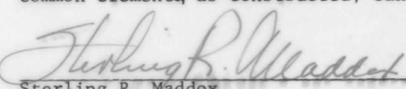
OWNER'S CERTIFICATE:

I certify that this Plan complies with the requirements of Title 3, Section 108 of the Real Property Article of the State of Maryland.


Robert Harris, President
Atlantic Pines, Inc.
P.O. Box 561
Ocean City, Maryland 21842

SURVEYOR'S CERTIFICATE:

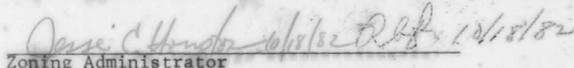
I certify that this Plat, together with the applicable wording of the Declaration, is a correct representation of the Condominium described and that the identification and location of each unit and the common elements, as constructed, can be determined from them.


Sterling R. Maddox
Professional Land Surveyor #529



PLAN APPROVAL - MAYOR AND COUNCIL TOWN OF OCEAN CITY, MARYLAND

This approval does not extend to any future uses and is limited to those uses encompassed within the application and approvals of the Planning and Zoning Commission and the Board of Appeals. Said records are available for review at the office of the Zoning Administrator.


Zoning Administrator


Engineering Department


Mayor


Council President

Approved for Public Water and Sewer:


Worcester County Health Department

- 1 COVER & APPROVALS
- 2 PHASING PLAN
- 3 SITE PLAN
- 4 FLOOR PLANS
- 5 ELEVATIONS
- 6 FOUNDATION PLAN

COVER SHEET
Our Place at the Beach Condominium
"ASBUILT" Sheet 1 of 6 Scale: NONE
date: SEPT., 1982 dwn. by: RLG
BUILDING I, PHASE 1

MSA CSU 2157-4386-1

R. LEE GILLISS, JR.
R.P.L.S. # 185 B
3409 COASTAL HIGHWAY
OCEAN CITY, MD 21842 301-289-3203
DELMARVA SURVEYS, INC.

