

WCL 84-30

APPROVED BY PLANNING AND ZONING
Ocean City, Worcester County, Maryland

This approval does not extend to any future uses and is limited to approving those uses and plans as being encompassed within the application and approvals of Planning and Zoning and the Board of Appeals. The application and records are available for review at the office of the undersigned. The subdivision of the land for condominium purposes, as shown, is approved.

Gay W Kelly
Mayor
Date
Shalb Trump
President, City Council
Date
Samuel B. Burton, III
Zoning Administrator
8/16/83
Date

APPROVED FOR PUBLIC WATER SUPPLY AND SEWERAGE SYSTEMS.

SP Wagoner for Donald Harting MD. MCH. 8/17/83
Worcester County Health Department
Date

OWNER'S CERTIFICATION



We certify that the requirements of Section 3-108 of the Real Property volume of the Annotated Code of Maryland (1981), concerning the making of this plat and the setting of markers have been complied with to the best of our knowledge and that it is in accordance with our desires.

Calvin E. Smalls Sr.
Date

SURVEYOR'S CERTIFICATION

I certify that the requirements of Section 3-108 of the Real Property volume of the Annotated Code of Maryland (1981) concerning the making of this plat and the setting of markers have been complied with and that this plat, together with the applicable wording of the declaration, is a correct and true representation of the condominium described, and the identification and location of each unit and the common elements, as constructed, can be determined from them.

Frank G. Lynch Jr.
Frank G. Lynch Jr.
8/16/83
Date

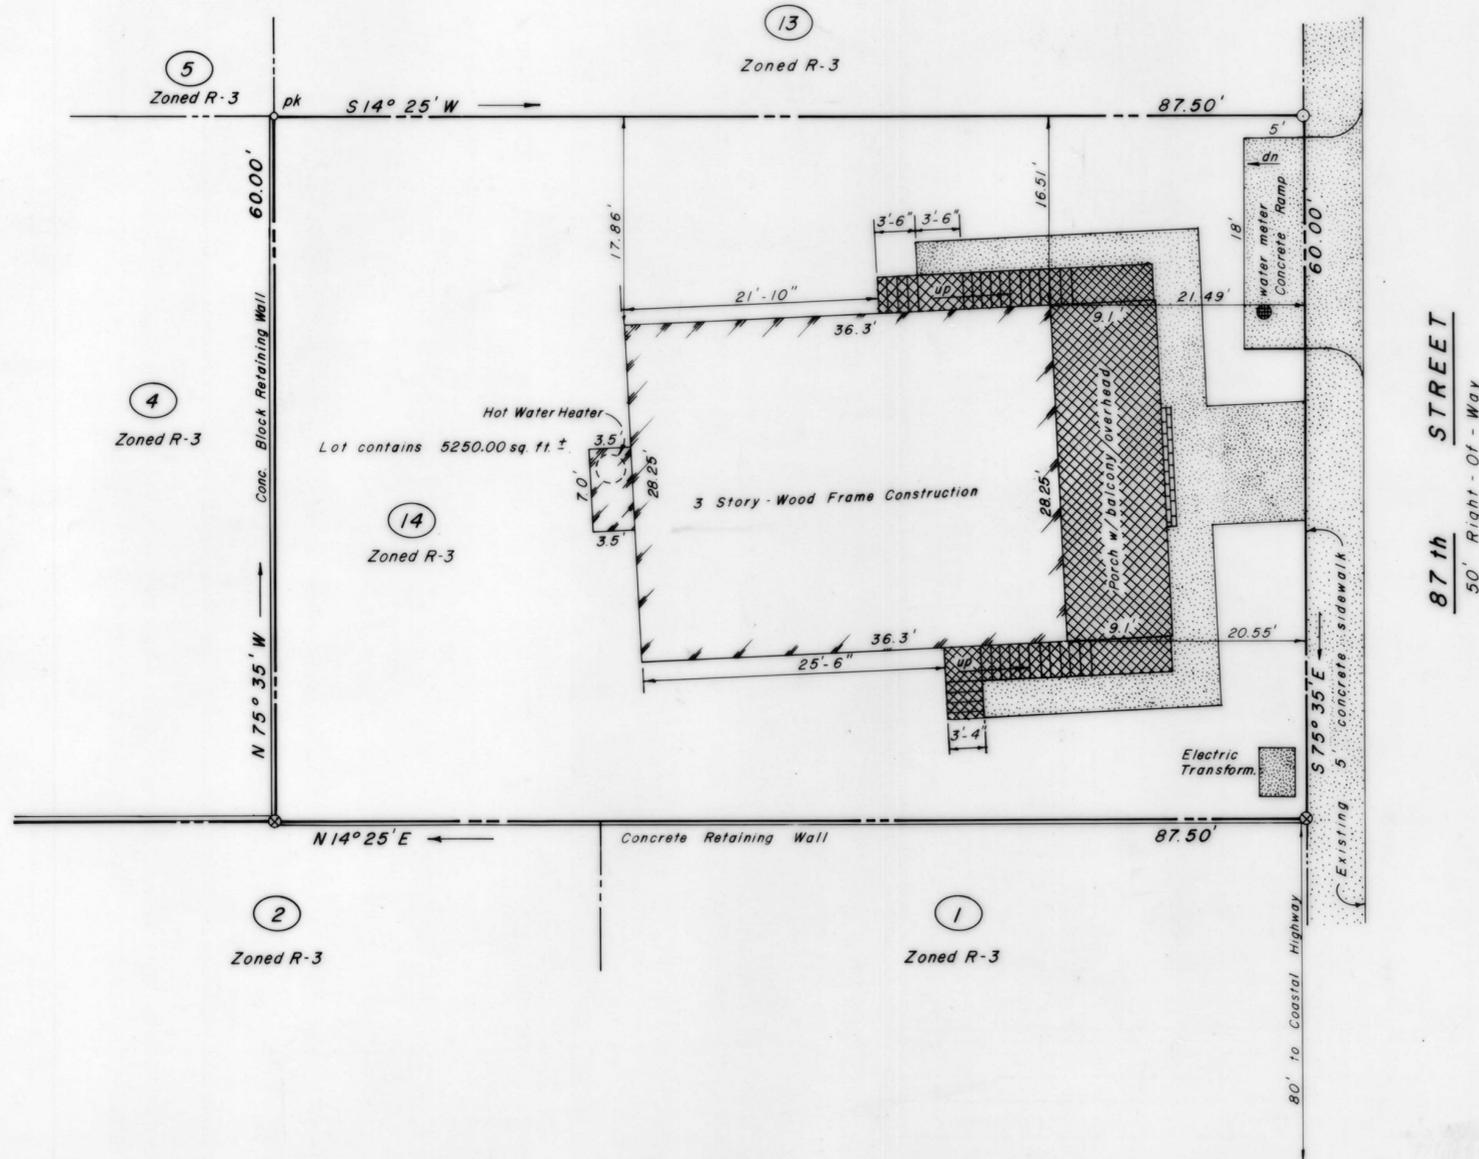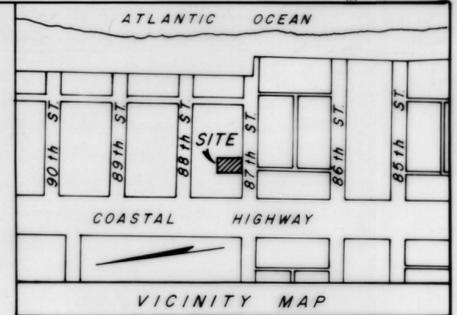

87th STREET
50' Right-Of-Way

- ⊙ Indicates Iron Rod
- ⊗ Indicates Chiseled 'X'
- ⊙ pk Indicates 'P-K' Nail
- ⑭ Indicate Original Lot Number as shown on Block 54, 'OCEAN BAY CITY' Plat.
- ▨ Indicates Limited Common Element

CORAL MIST CONDOMINIUM		
Scale: 1" = 10'	Approved:	Date:
File No.: 623/83	Revised:	Drawn: W O M
FRANK G. LYNCH Jr. and ASSOCIATES Surveying Land Planning Route 4, Box 299 B, Berlin, Maryland, 21811 ph: 641-3773		
SITE PLAN		Sheet 1 of 4

