

WCL 8/50 ✓

# BRADLEY ON THE BAY CONDOMINIUM

### OWNER'S CERTIFICATION:

We hereby certify that the requirements of Section 3-108 of the Real Property Volume of the Annotated Code of Maryland (1974), concerning the making of this plat and the setting of markers have been complied with, to the best of our knowledge, and that it is in accordance with our desires.

Owner Mary Lou Taylor, Pres Date 11/9/83

### APPROVED by MAYOR and CITY COUNCIL

Ocean City, Worcester County, Maryland


Mayor Alan W Kelly Date \_\_\_\_\_

President Bill Tapp Date \_\_\_\_\_

### APPROVED for PUBLIC WATER SUPPLY and SEWERAGE SYSTEM

Worcester County Health Department, Snow Hill, Maryland

By SP Wagoner Date 11/9/83  
For Donald Harding, M.D. MRH.

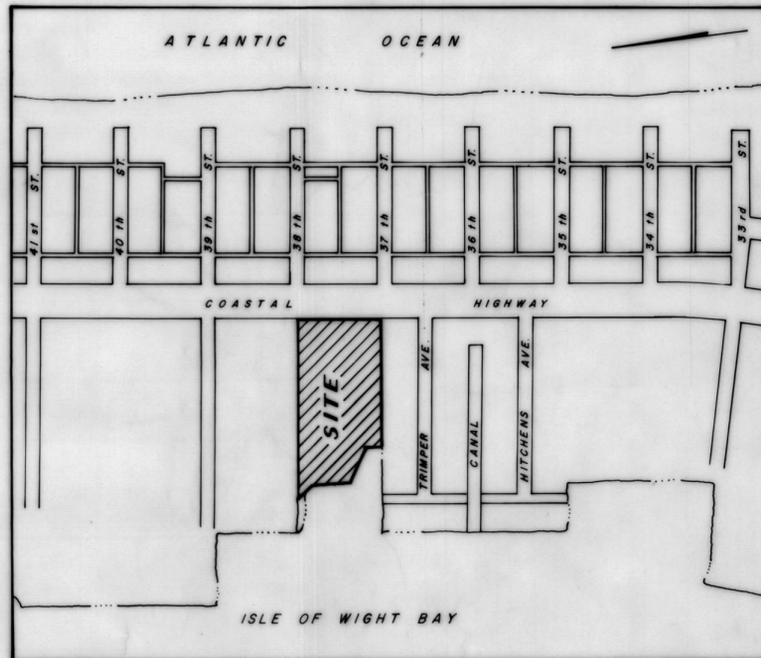

VICINITY MAP

Scale 1" = 400'

### TABLE OF CONTENTS :

Cover Sheet .....	1
Site Plan .....	2
Typical Unit Layouts .....	3
Elevations - Bldg. 'B' .....	4
Unit Designation Plan - Bldg. 'B', First Floor .....	5
Unit Designation Plan - Bldg. 'B', Second Floor .....	6
Unit Designation Plan - Bldg. 'B', Third Floor .....	7
Elevations - Bldg. 'G & H' .....	8
Unit Designation Plan - Bldg. 'G', First Floor .....	9
Unit Designation Plan - Bldg. 'G', Second Floor .....	10
Unit Designation Plan - Bldg. 'G', Third Floor .....	11
Unit Designation Plan - Bldg. 'H', First Floor .....	12
Unit Designation Plan - Bldg. 'H', Second Floor .....	13
Unit Designation Plan - Bldg. 'H', Third Floor .....	14

## PHASE

## III

### APPROVED by PLANNING and Zoning

Ocean City, Worcester County, Maryland

This approval does not extend to any future uses and is limited to approving those uses and plans as being encompassed within the application and approvals of the Planning and Zoning Commission and Board of Appeals. The application and records are available for review at the office of the undersigned. The subdivision of the land for condominium purposes, as shown, is approved.

Zoning Administrator James Byrne, II Date 11/15/83

### SURVEYOR'S CERTIFICATION:

I certify that the requirements of Section 3-108 of the Real Property Volume of the Annotated Code of Maryland (1974), concerning the making of this plat and the setting of markers have been complied with and that this plat, together with the applicable wording of the declaration, is a correct representation of the condominium described, and the identification, and location of each unit and the common elements, as constructed, can be determined from them.

By Frank G. Lynch, Jr. Date 11/8/1983  
Frank G. Lynch, Jr. P.L.S. No. 179-B



## COASTAL HIGHWAY BUILDERS, INC.

53rd STREET and COASTAL HIGHWAY  
OCEAN CITY, MARYLAND 21842

