FWH 28/60 Filed 10.16.72

NANTUCKET
CONDOMINIUM

HORIZONTAL PROPERTY REGIME
OCEAN CITY
WORCESTER COUNTY
MARYLAND

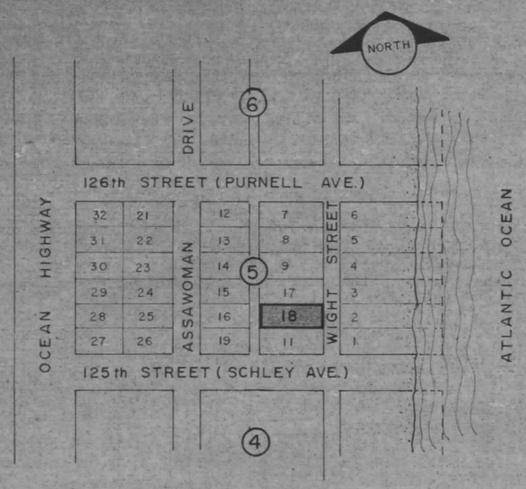

VICINITY MAP

SCALE: 1"=200'

NOTES:

Lot 18
Block 5
Plat of: FENWICK, MARYLAND
OCEAN CITY
WORCESTER COUNTY
MARYLAND

Recorded among the land records of Worcester County: following references:

Plat book O.D.C. No. 1 folio 12
" " O.D.C. No. 1 " 27
" " O.D.C. No. 1 " 22
" " E.W.R. No. 3 " 23

I certify that the regulations of Article 17, Section 59 and 59B of the Annoted Code of Maryland, 1957 edition, have been complied with, concerning the making of a plat, setting of markers and the existance of prior preliminary plats.

Barbara A. Baker Barbara Vosburgh
Candice M. Baker

APPROVED FOR PUBLIC WATER AND SEWAGE SYSTEMS

10/16/72 — Date
Joseph R. Insley, R.S. — (County Health Officer) AUTHORIZED SIGNATURE

MASTER PLAN APPROVAL

Mayor and City Council of Ocean City MCB
Worcester County, Maryland

Harry W Kelley — Mayor
William H Purnell Jr. Sec. — Council President

ELEMENTS:

COMMON ELEMENT
UNIT AREA

I certify that these drawings, Sheets 1 thru 5 are representative of the property and improvements thereon, as found by survey and or as indicated as built by contractor(s).

10/15/72 — Date
Emil J. Germano

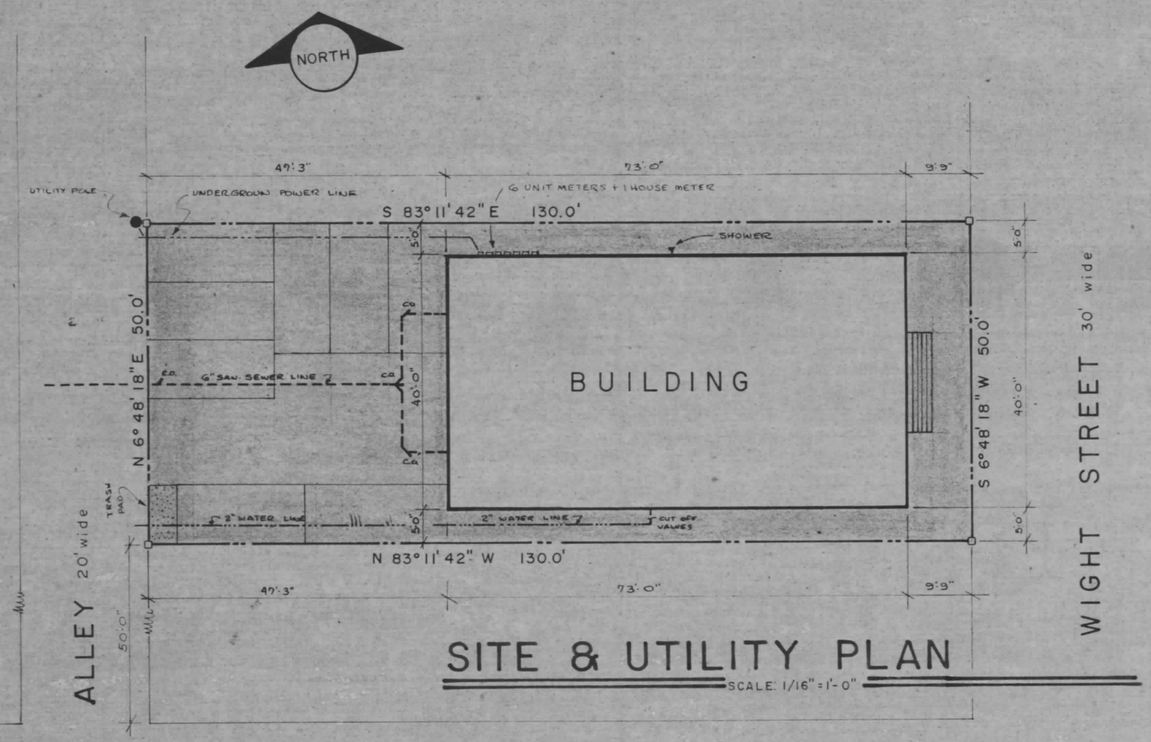

SITE & UTILITY PLAN

SCALE: 1/16"=1'-0"

125th STREET (PLATED AS SCHLEY AVENUE) 70' wide

G.K. INDUSTRIES, INC. 17 x 22 CONDOMINIUM FORM No. 7201

NANTUCKET CONDOMINIUM
6 UNITS

SHEET 1 OF 5

Drawings Prepared in the office of G.K. INDUSTRIES, INC., P.O. Box 532, Ocean City, Maryland. Dr. by: HGK Date: SEPT. 1972 Job No. 72-070

MSA CSU 2157-670-1

Maryland State Archives