FWH. 29/63 filed 12/11/98

128 EAST CONDOMINIUM

12 UNIT
HORIZONTAL PROPERTY REGIME
OCEAN CITY
WORCESTER COUNTY
MARYLAND

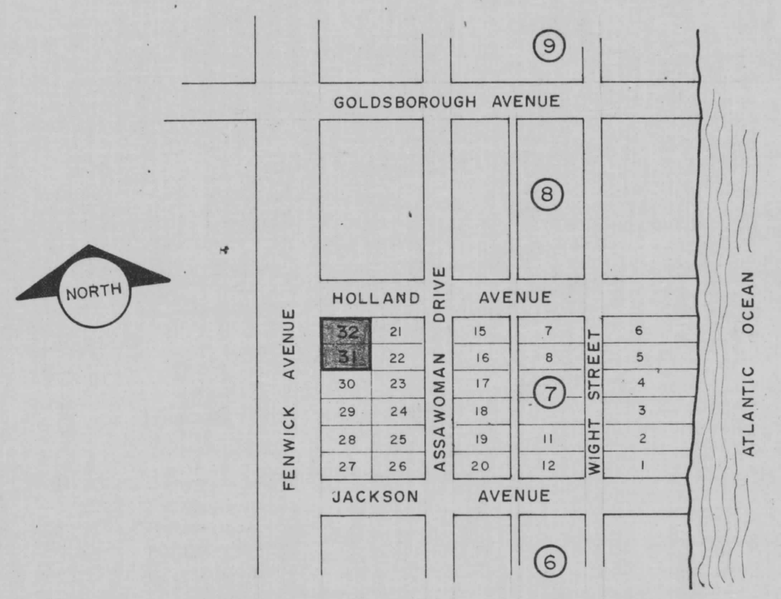

VICINITY MAP

SCALE: 1" = 200'

NOTES:

LOTS 31 & 32
BLOCK 7
Plat of: FENWICK, MARYLAND
OCEAN CITY
WORCESTER COUNTY
MARYLAND

Recorded among the land records of Worcester County:

Plat book	O.D.C. No. 1	folio	12
" "	O.D.C. No. 1	"	22
" "	O.D.C. No. 1	"	27
" "	E.W.R. No. 3	"	23

I certify that the regulations of Article 17, Section 59 and 59B of the Annoted Code of Maryland, 1957 edition, have been complied with, concerning the making of a plat, setting of markers and the existance of prior preliminary plats.

Ro. Elaine Paddy, Sec. — Paddy Const. Co. Inc. — J. Wilson Latchum, Pres.

APPROVED FOR PUBLIC WATER AND SEWAGE SYSTEMS

11/17/72 — James R. Fisher, R.S.
Date — County Health Officer, Authorized Signature

MASTER PLAN APPROVAL

Mayor and City Council of Ocean City
Worcester County, Maryland

Harry W Kelly
Mayor

Roland E. Powell
Council President

ELEMENTS:

COMMON ELEMENT

UNIT AREA

I certify that these drawings, Sheets 1 thru 7 are representative of the property and improvements thereon, as found by survey and or as indicated by contractor(s) as built.

11/14/72 — Emil J. Germano
Date

128 EAST CONDOMINIUM

SHEET 1 OF 7

G.K. INDUSTRIES, INC. 17 x 22 CONDOMINIUM FORM No. 7201

Drawings Prepa red in the office of G.K. INDUSTRIES, INC., P.O. Box 532, Ocean City, Maryland. Dr. by: HGK Date: OCT. 1972. Job No. 72-011

MSA CSU 2157-692-1

Maryland State Archives