FWH 31/53 filed 2-13-73

MARINERS WHARF CONDOMINIUM

OCEAN CITY, WORCESTER COUNTY, MARYLAND

AS BUILT

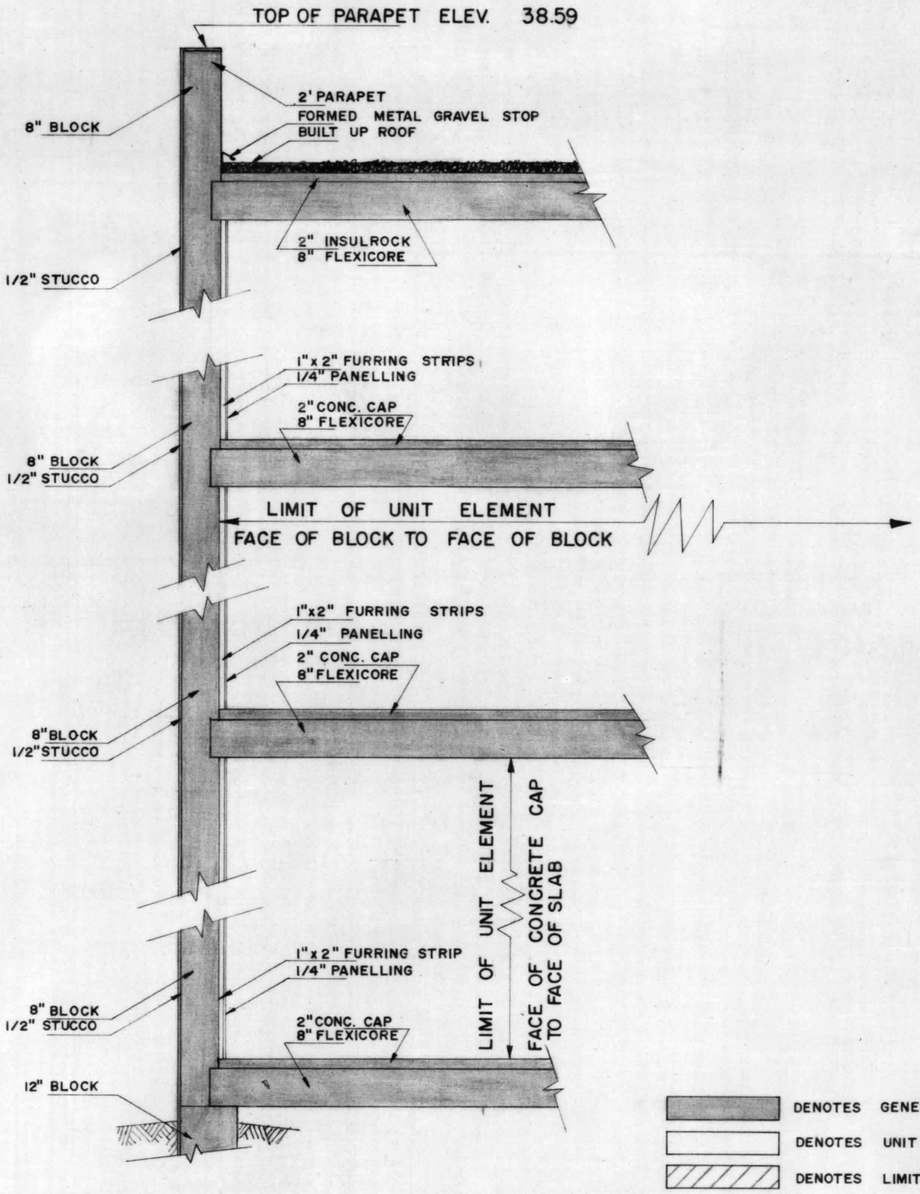

DENOTES GENERAL COMMON ELEMENT

DENOTES UNIT ELEMENT

DENOTES LIMITED COMMON ELEMENT

ELEVATIONS SHOWN ARE IN FEET ABOVE MEAN LOW WATER IN THE ATLANTIC OCEAN AT OCEAN CITY, MARYLAND, DATUM 1929.

TYPICAL EXTERIOR WALL SECTION

SCALE : 1/2" = 1'-0"

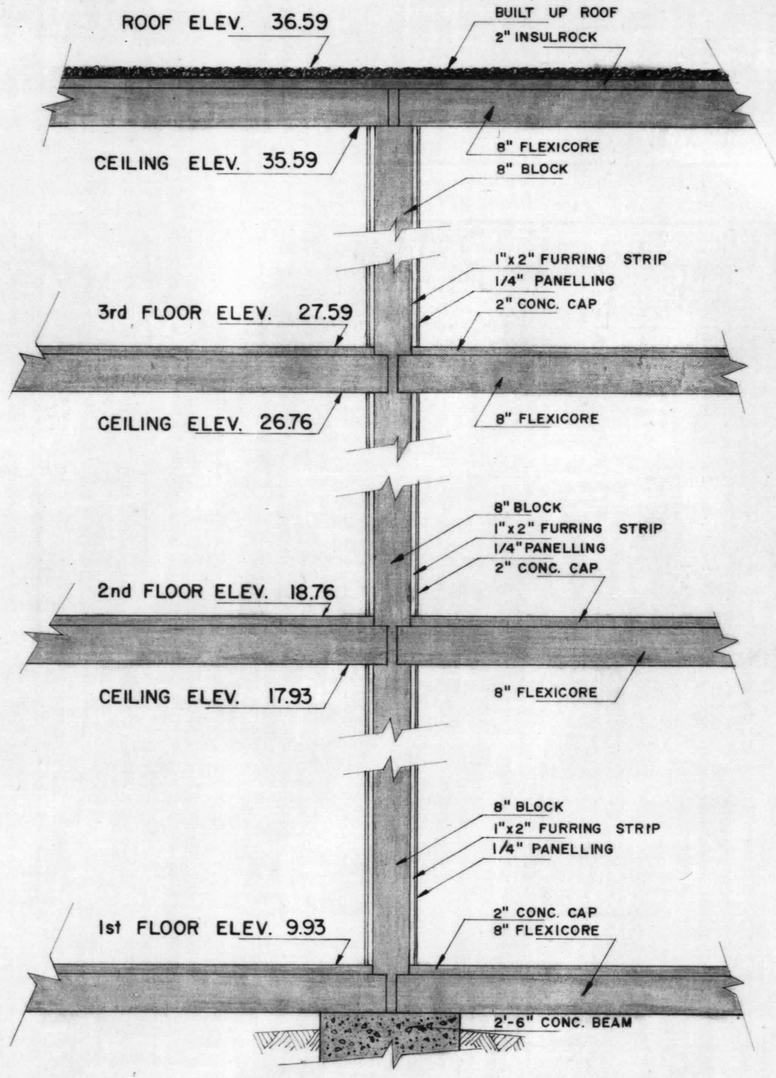

TYPICAL PARTY WALL SECTION

SCALE : 1/2"= 1'-0"

PREPARED IN THE OFFICE OF
G. B. C. SURVEYS, INC.
OCEAN CITY, MARYLAND
APPROVED BY
4/9/73 George B. Cropper
GEORGE B. CROPPER, P. E.
R. P. E. & L. S. No. 248

SURVEYED BY P. LOEWENSTEIN
DRAWN BY R. F. BOND
DATE NOV. 1972

MSA CSU 2157-769-12

SHEET 12 OF 12 SHEETS

Maryland State Archives