FWH 31/46 filed 2-13-73

MARINERS WHARF CONDOMINIUM

OCEAN CITY, WORCESTER COUNTY, MARYLAND

AS BUILT

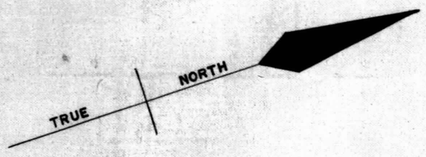

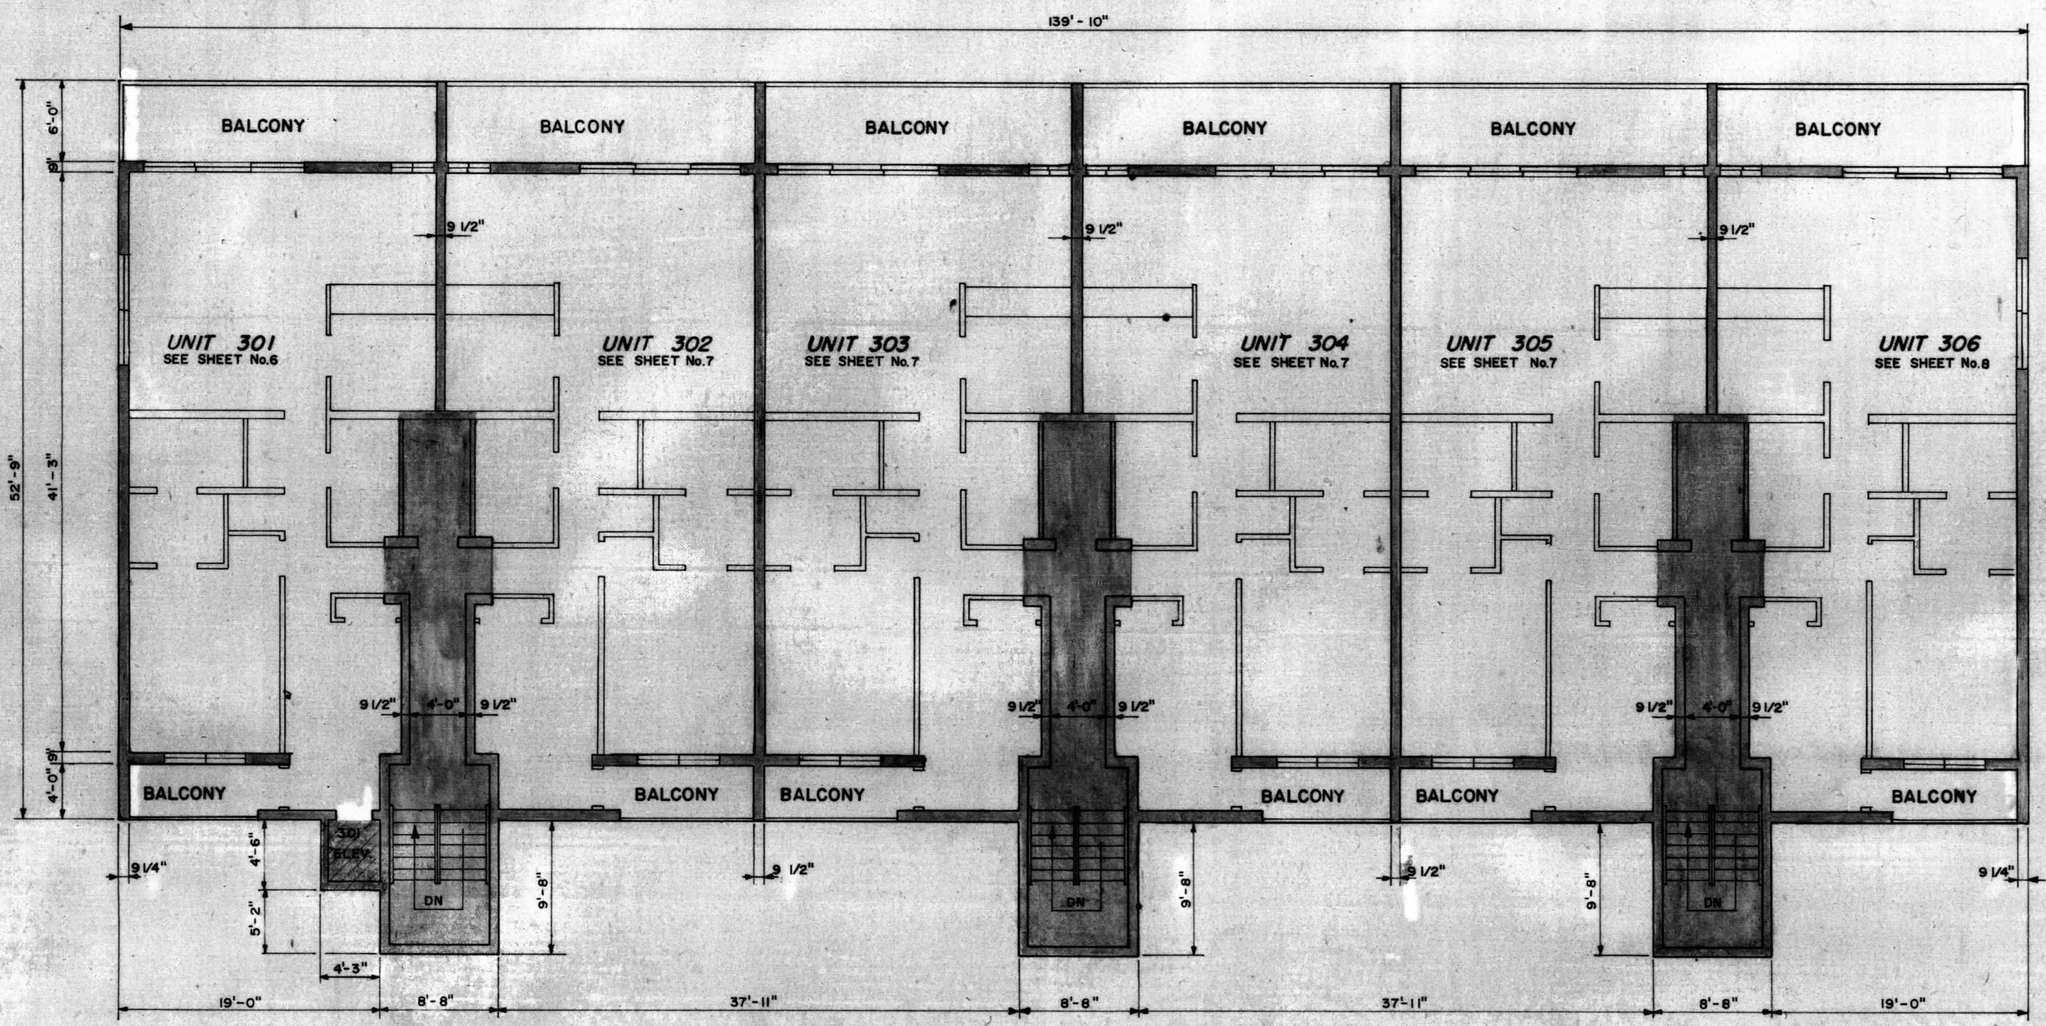

THIRD FLOOR PLAN

SCALE : 1/8" = 1'-0"

DENOTES GENERAL COMMON ELEMENT

DENOTES UNIT ELEMENT

DENOTES LIMITED COMMON ELEMENT

FOR DETAIL DIMENSIONS
SEE SHEET Nos. 6,7,8 8 9

PREPARED IN THE OFFICE OF
G. B. C. SURVEYS, INC.
OCEAN CITY, MARYLAND
APPROVED BY
4/9/73
George B. Cropper
GEORGE B. CROPPER, P. E.
R. P. E. & L. S. No. 248

SURVEYED BY P. LOEWENSTEIN
DRAWN BY R.F. BOND
DATE NOV. 1972

MSA CSU 2157-769-5

SHEET 5 OF 12 SHEETS

Maryland State Archives