CAMELOT CONDOMINIUM

OCEAN CITY, WORCESTER COUNTY, MARYLAND
AS BUILT

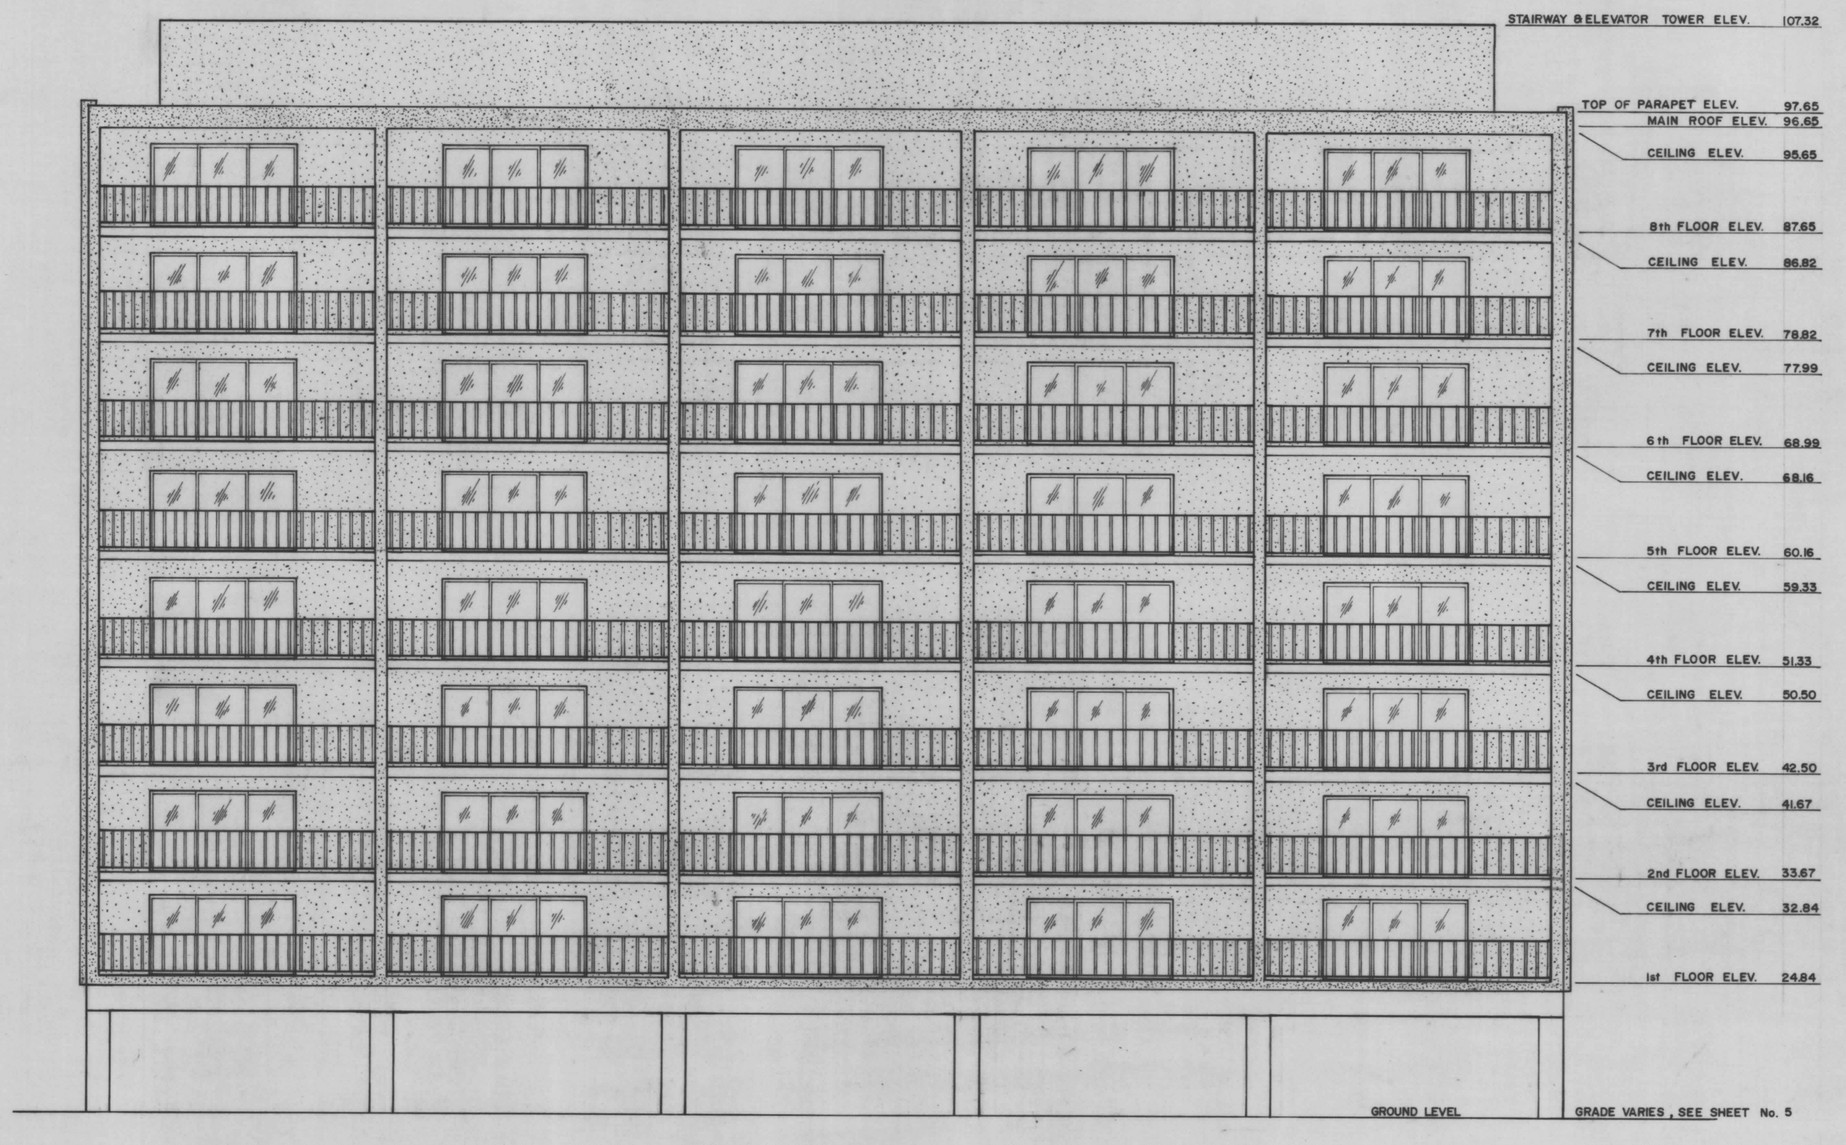

EAST ELEVATION
SCALE : 1/8" = 1'-0"

ALL ELEVATIONS SHOWN ARE IN FEET ABOVE MEAN LOW WATER IN THE ATLANTIC OCEAN AT OCEAN CITY, MARYLAND, DATUM 1929.

PREPARED IN THE OFFICE OF
G. B. C. SURVEYS, INC.
OCEAN CITY, MARYLAND
APPROVED BY
George B. Cropper
GEORGE B. CROPPER, P. E.
R. P. E. & L. S. No. 248

SURVEYED BY P. LOEWENSTEIN
DRAWN BY R. F. BOND
DATE MAR. 1973

SHEET 17 OF 19 SHEETS

MSA CS02157-800-17

Maryland State Archives