FWM 33/18 filed 5-1-73

CAMELOT CONDOMINIUM

OCEAN CITY, WORCESTER COUNTY, MARYLAND
AS BUILT

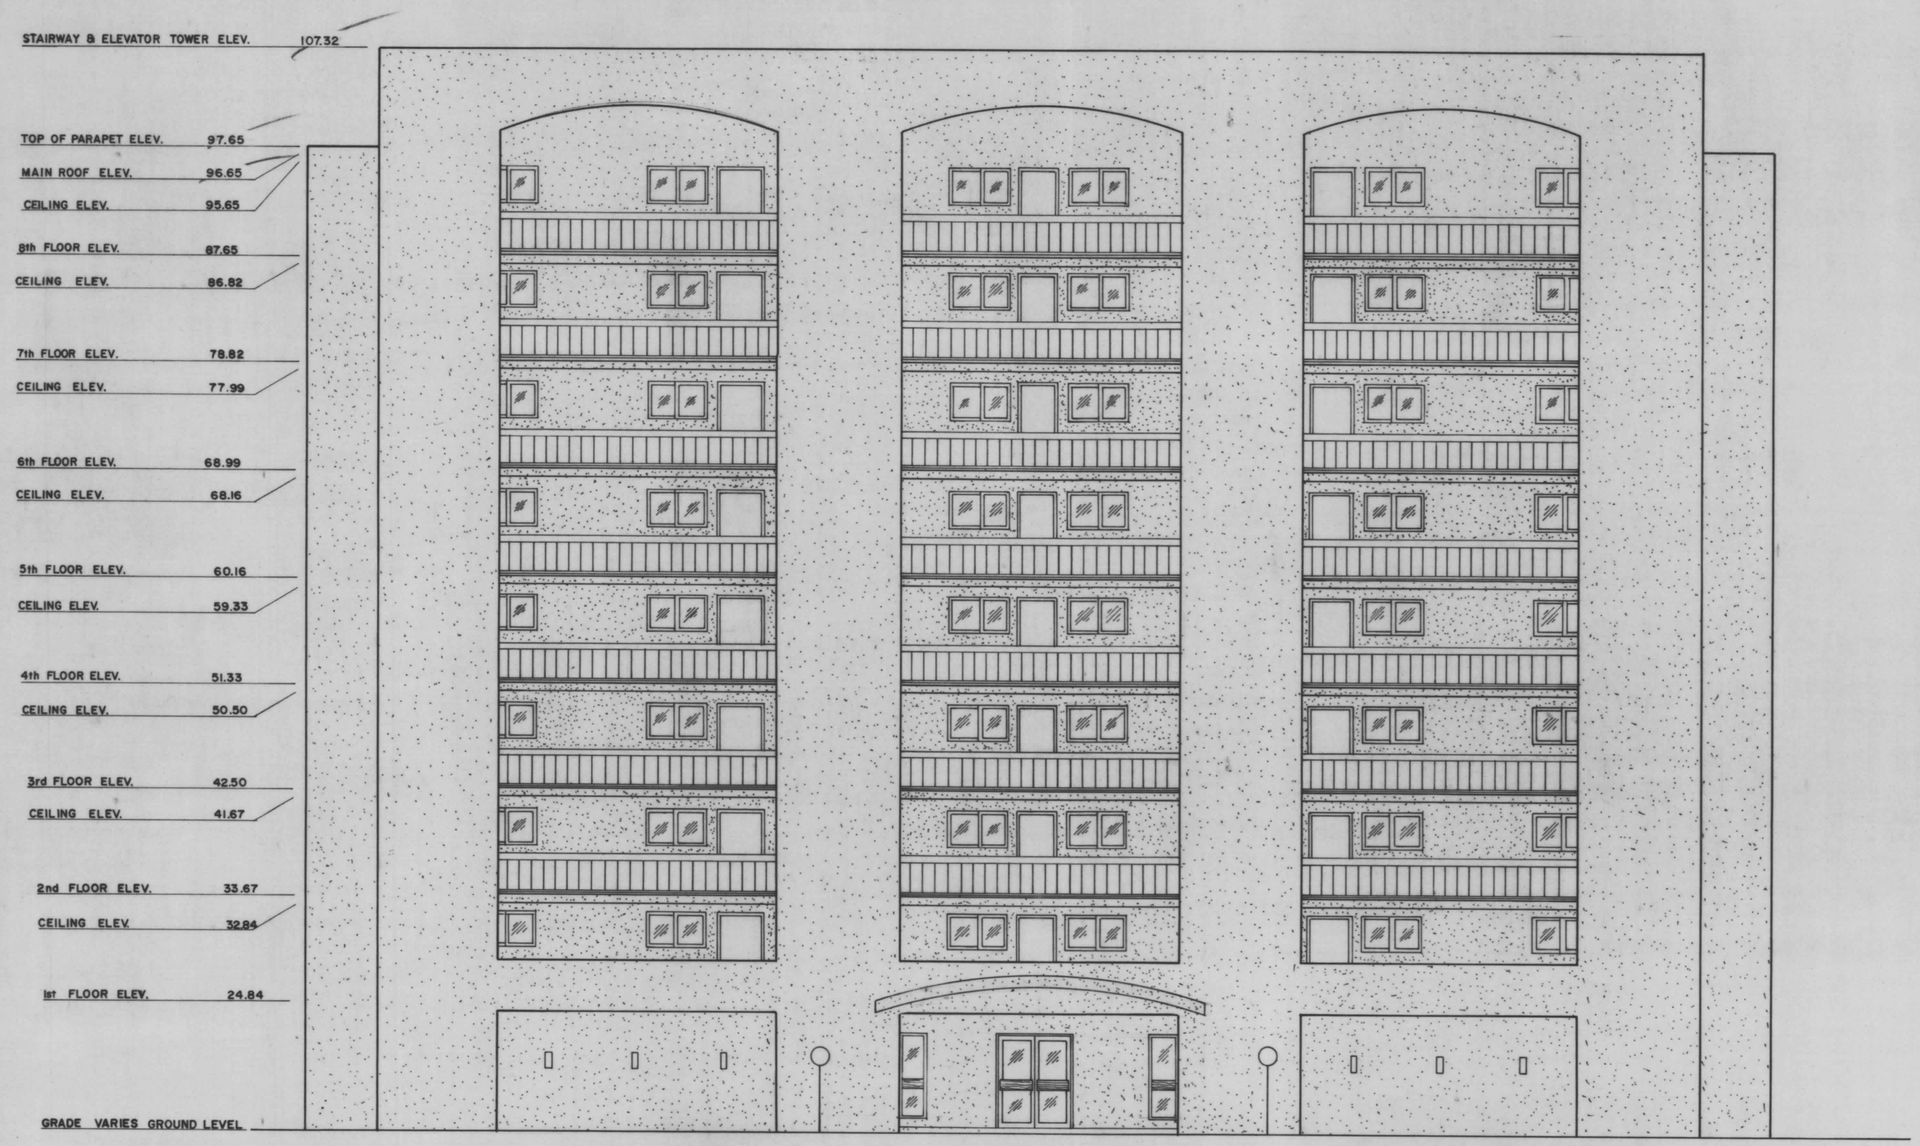

WEST ELEVATION

SCALE : 1/8" = 1'-0"

ALL ELEVATIONS SHOWN ARE IN FEET ABOVE MEAN LOW WATER IN THE ATLANTIC OCEAN AT OCEAN CITY, MARYLAND, DATUM 1929.

PREPARED IN THE OFFICE OF
G. B. C. SURVEYS, INC.
OCEAN CITY, MARYLAND
APPROVED BY
George B. Cropper
GEORGE B. CROPPER, P. E.
R. P. E. & L. S. No. 248

SURVEYED BY	P. LOEWENSTEIN
DRAWN BY	W. R. STULTZ
DATE	MAR. 1973

SHEET 18 OF 19 SHEETS

MSA CSU 2157-800-18

Maryland State Archives