FWH 33/29 filed 5-10-73

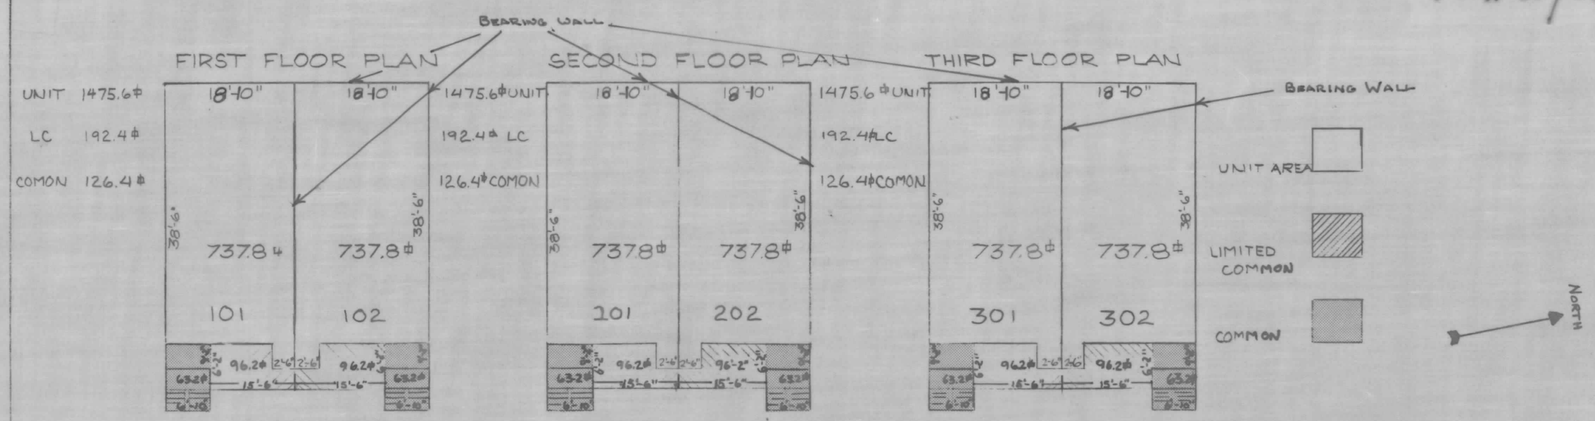

ELEVATIONS

NOTES

FIRST FLOOR ELEVATION	17.95	ABOVE MEAN LOW WATER
SECOND FLOOR ELEVATION	26.99	ABOVE MEAN LOW WATER
THIRD FLOOR ELEVATION	36.05	ABOVE MEAN LOW WATER
TOP PARAPET ELEVATION	45.32	ABOVE MEAN LOW WATER

SURVEYOR'S CERTIFICATE

I HEREBY CERTIFY THAT THESE PLATS OF THE CONDOMINIUM SHOWN ARE CORRECT; THAT IT IS A SUBDIVISION OF THE BUILDING LOCATED ON LOT NO. 24 AS SHOWN OF BLOCK; 3^ ON A PLAT ENTITLED FENWICK, MARYLAND IN OCEAN CITY, WOR. CO., MARYLAND AS RECORDED IN PLAT BOOK CWR-3, FOLIO-23 AMONG THE LAND RECORDS FOR WORCHESTER COUNTY, MARYLAND AND ALL LAND CONVEYED TO 123RD LIMITED PARTNERSHIP BY DEED DATED 3-9-72 AS RECORDED ON 3-10-72 IN LIBER FWH 342 AT FOLIO 355-357 AMONG THE OFFICIAL LAND RECORDS AND SAID BUILDING HAS BEEN ERECTED IN ACCORDANCE WITH THE SAID PLATS OF CONDOMINIUM.

THE TOTAL AREA INCLUDED ON THIS PLAT IS 0.1148 ACRES OF LAND.
THE TOTAL AREA OF THE UNITS INSIDE THE BUILDING IS 4426.80 SQUARE FEET.

S Ruffin Maddox Jr
REGISTERED SURVEYOR, MARYLAND

STATE OF MARYLAND S. RUFFIN MADDOX, JR. No. 8324 REGISTERED PROFESSIONAL LAND SURVEYOR

OWNERS DEDICATION

123 LTD PARTNERSHIP,
OWNER OF THE PROPERTY SHOWN AND DESCRIBED HEREON, HEREBY ADOPTS THIS PLAN OF HORIZONTAL PROPERTY REGIME AS SET FORTH IN ARTICLE 21, SECTION 117-A OF THE ANNOTATED CODE OF MARYLAND (1957), 1966 REPLACEMENT VOLUME.

Richard M Moore
John F Gudelunas Jr.
GENERAL PARTNERS 123 LTD PARTNERSHIP

ARCHITECT'S CERTIFICATE

I HEREBY CERTIFY THAT THE PLAN OF THE CONDOMINIUM SHOWN ON THESE PLATS IS CORRECT; THAT IT IS SUBDIVISION OF A SINGLE BUILDING IN OCEAN CITY, MD. AS SHOWN ON PLAT FILED AS PART OF THIS PLAN OF CONDOMINIUM.

W.C.A.
Harry W Kelly
MAYOR OCEAN CITY, WORCESTER CO, MD
Robert E Duell
PRESIDENT, CITY COUNCIL

REGISTERED ENGINEER ARCHITECT BOARD OF EXAMINERS AND REGISTRATION 1796-R STATE OF MARYLAND

W.C.A. Jr. 5/9/73

APPROVED FOR PUBLIC WATER SUPPLY & SEWERAGE SYSTEMS
WORCESTER CO. HEALTH DEPT.
DATE 5/10/73
SIGNATURE Jean K Tasker, R.S.

RECORDED: _____
CONDOMINIUM PLAT BOOK: _____
PLATE NO.: _____
("AS BUILT")

SHEET SI OF 1
PLAT OF CONDOMINIUM AND PLANS OF BUILDING
OCEAN CITY, WORCESTER CO MARYLAND
MACDONALD + ENGLEHART
ARCHITECT
OXON HILL, MD
SCALE: AS NOTED
DATE SEPT. 19, 1972

SEA POWER CONDOMINIUM

MSA CSU2157-803-1
#2310

Maryland State Archives