FWH 36/29 Filed 7/20/73

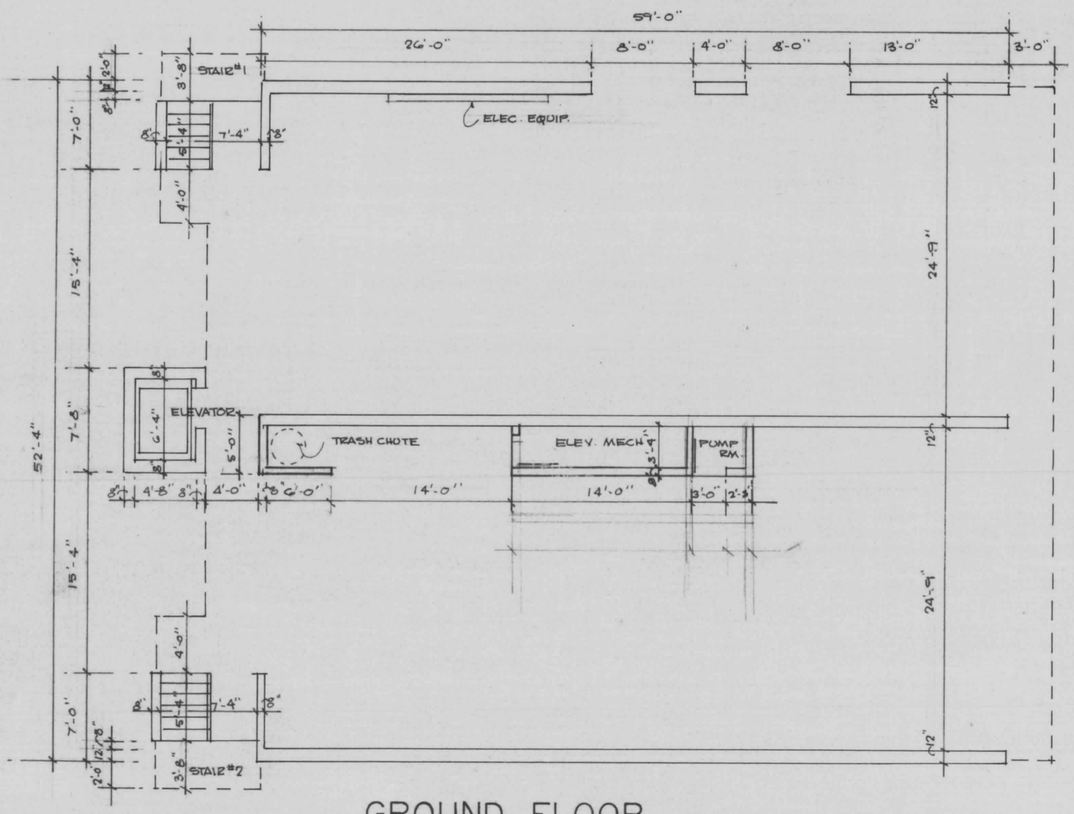

GROUND FLOOR

SCALE 1/8"=1'-0"

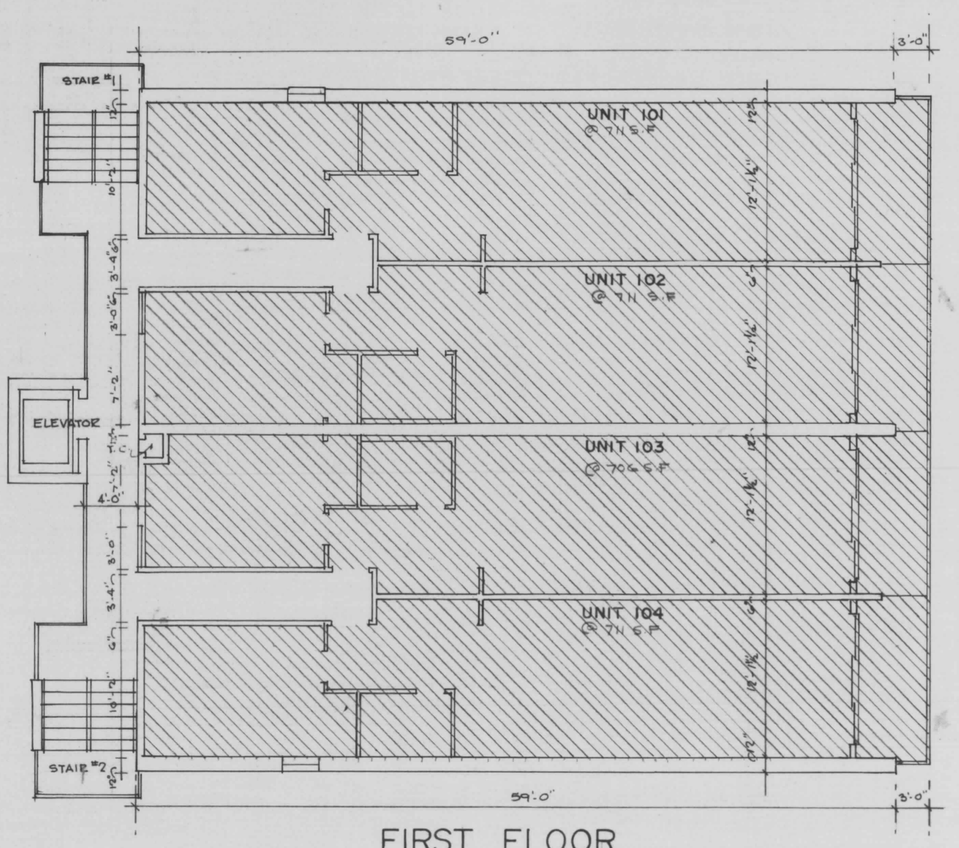

FIRST FLOOR

SCALE 1/8"=1'-0"

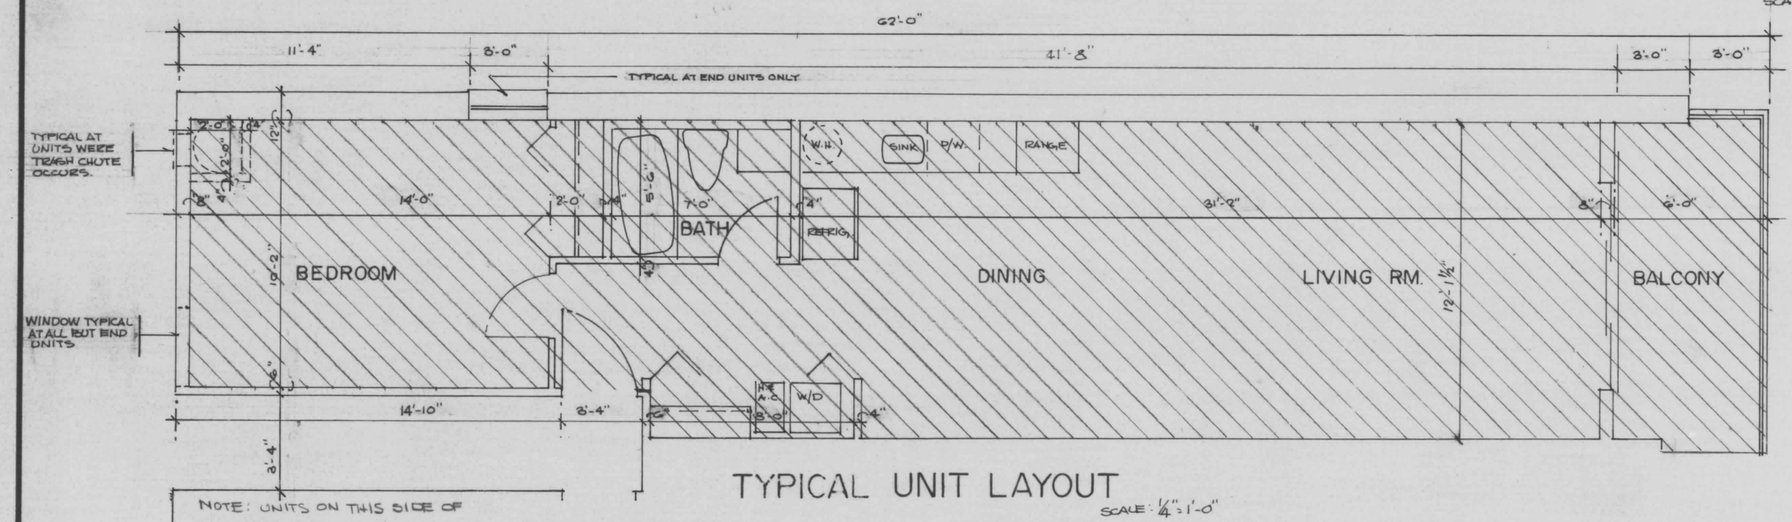

TYPICAL UNIT LAYOUT

SCALE 1/4"=1'-0"

COMMON ELEMENTS

UNIT AREA

SHEET NO. A-2 OF 4

nelson – tilghman · associates

architects · engineers

301 585-4644 815 thayer ave

silver spring maryland 20910

LOWELL E. NELSON REGISTERED ARCHITECTURAL REGISTRATION BOARD 1651-R STATE OF MARYLAND

REVISIONS

DATE

SHEET TITLE

FLOOR PLANS

SCALE AS NOTED.

AS-BUILT DRAWING.

OFFICE NO.

BREAKWATER I

CONDOMINIUM

OCEAN CITY, MARYLAND

MSA CSU 2157-834-2

1 2 3 4 5 6
Maryland State Archives