FWH 43/12 Filed 6-13-74

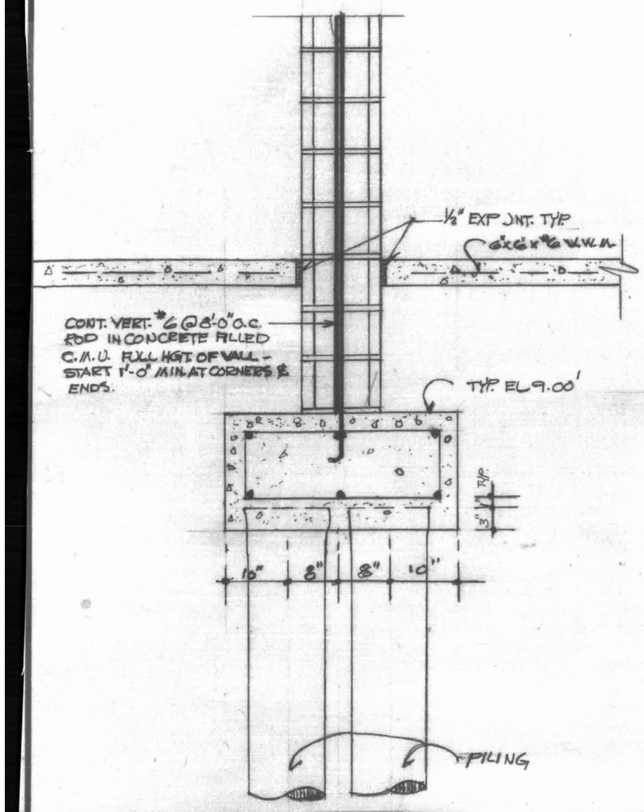

TYPICAL PILING DETAIL SCALE: 3/4"=1'-0"

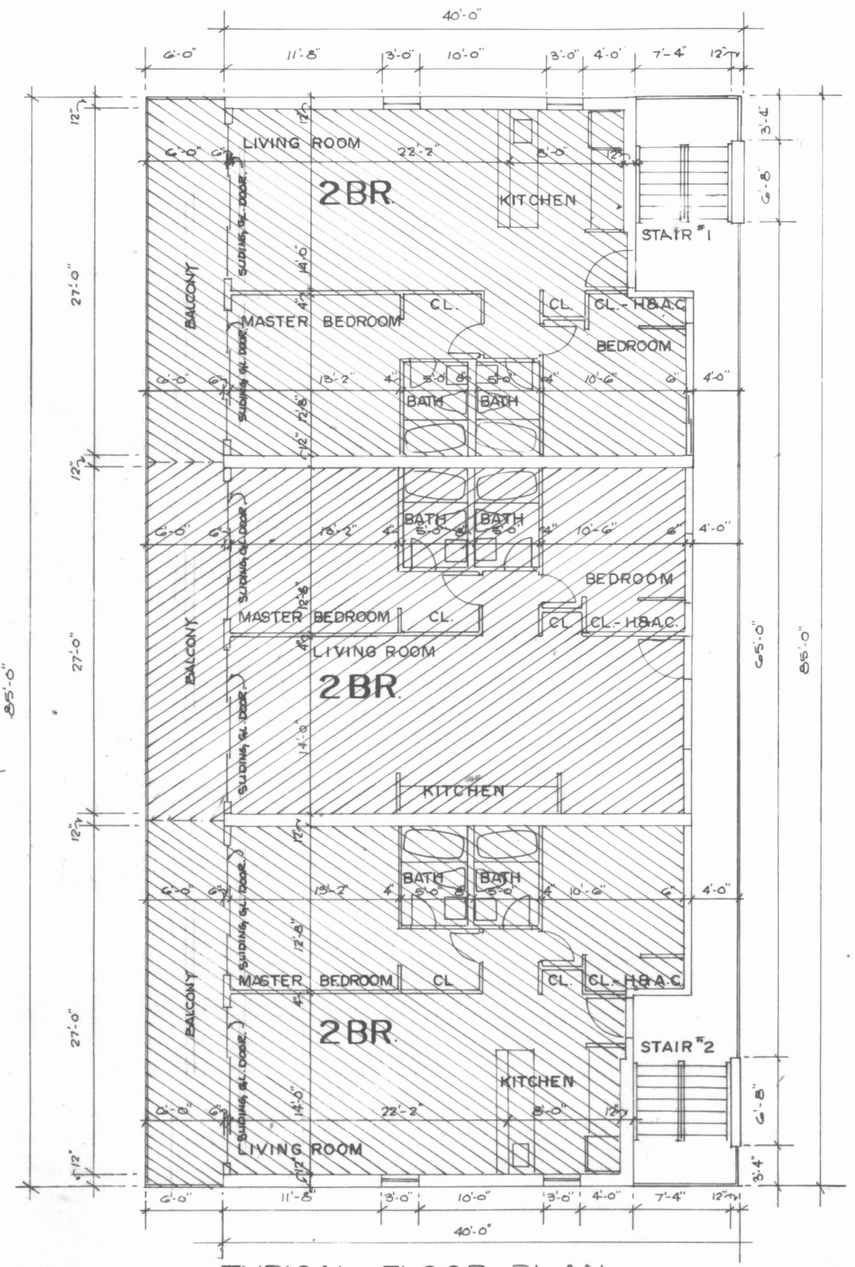

TYPICAL FLOOR PLAN SCALE: 1/8"= 1'-0"

COMMON ELEMENTS

UNIT AREA

NOTE: THE SYMBOLS USED TO DESIGNATE THE COMMON ELEMENTS & UNIT AREA ARE ONLY APPLICABLE TO SHEET A-2.

SHEET NO. A-2 OF

REVISIONS

DATE

SHEET TITLE

OFFICE NO.

nelson – tilghman · associates

TONS OF FUN CONDOMINIUM

OCEAN CITY, MARYLAND

AS BUILT DRAWING

architects · engineers

301 585-4644 815 thayer ave

silver spring maryland 20910

MSA CS4 2157-935-2

Maryland State Archives