FWH 68/68

BRASS EAGLE CONDOMINIUM

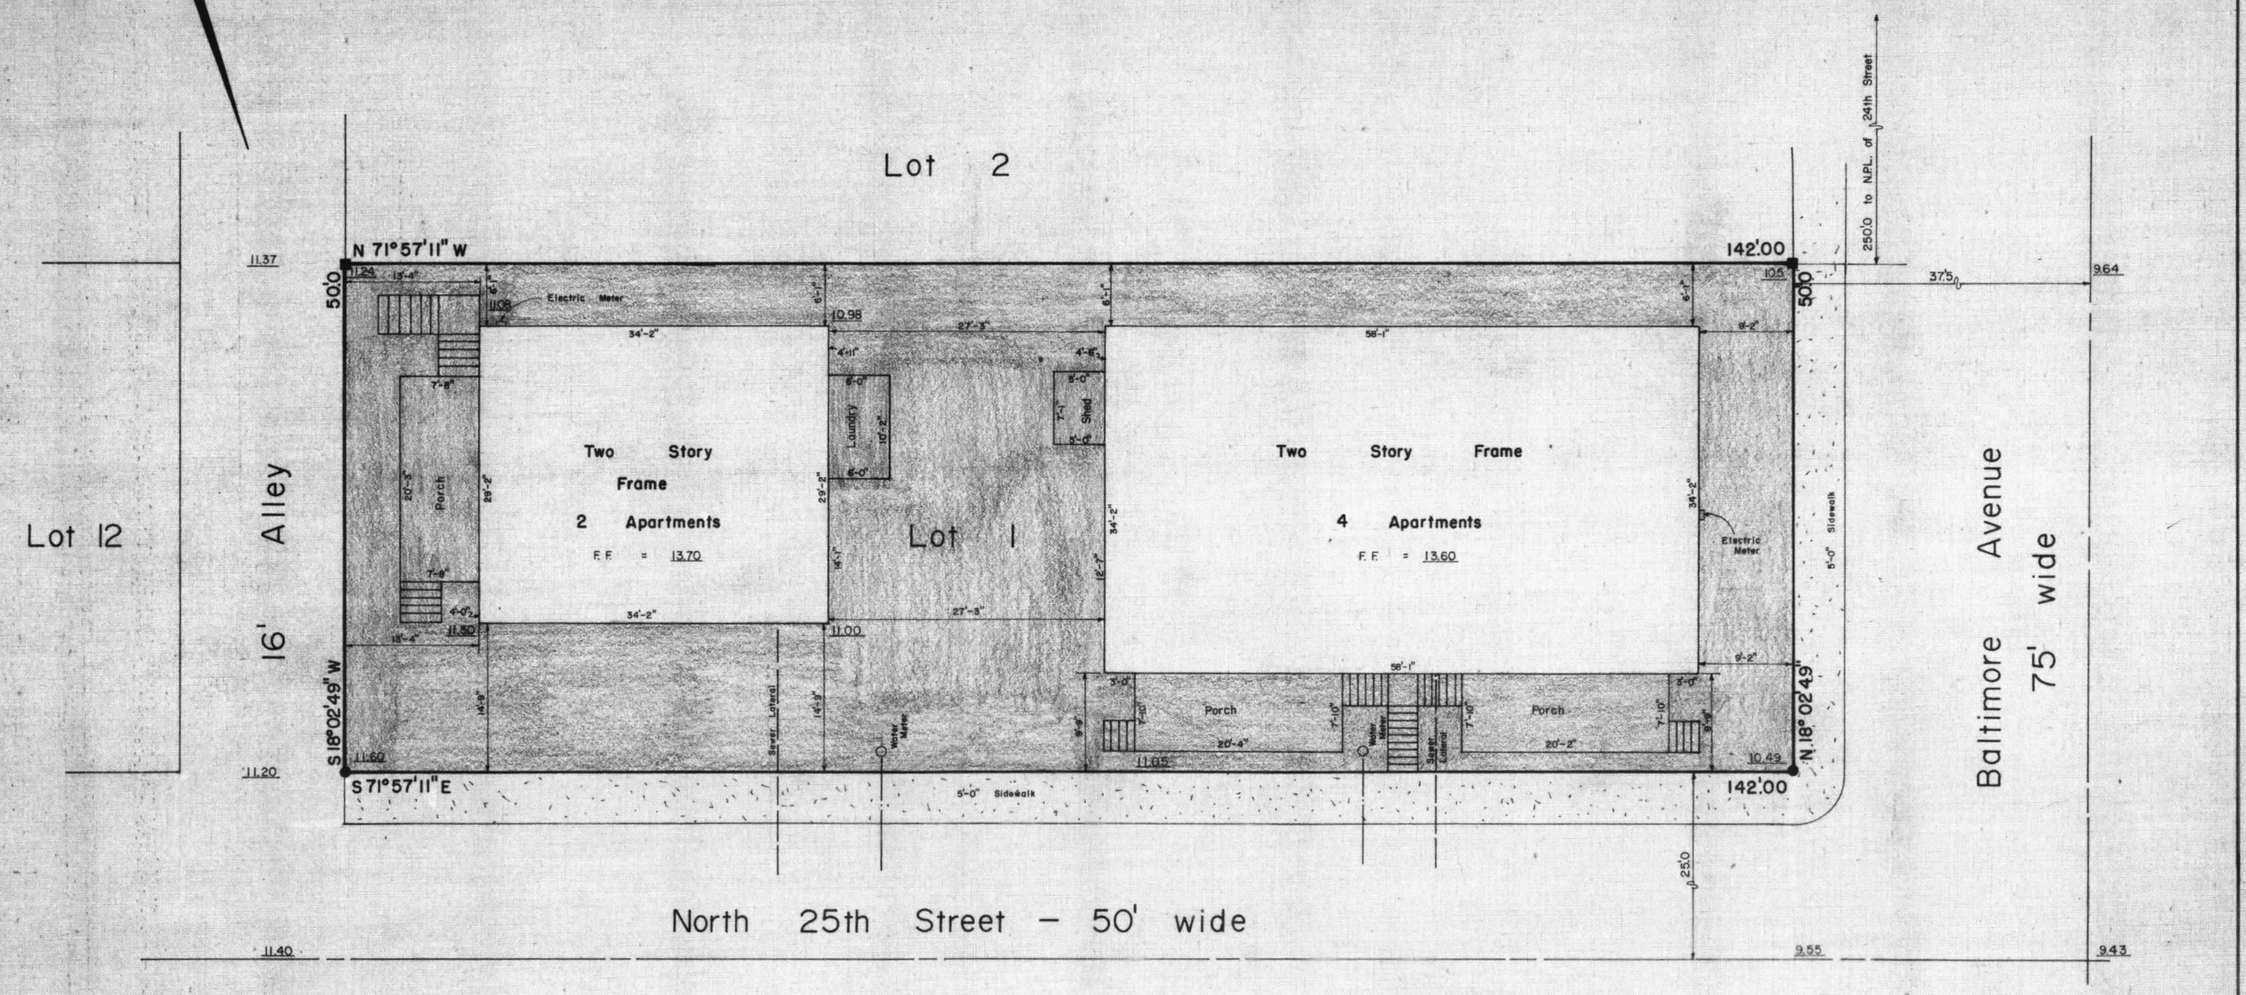

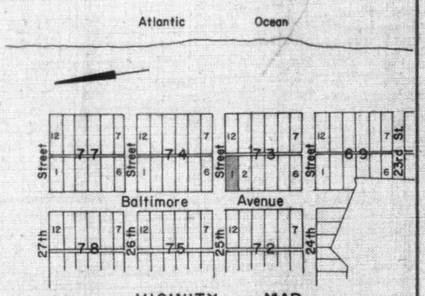

VICINITY MAP

Taken from "Sinepuxent Beach Co." Plat rec. O.D.C. 1, folio 2

Scale = 1" = 400'

APPROVED BY MAYOR AND CITY COUNCIL
OCEAN CITY, WORCESTER COUNTY, MARYLAND.

Mayor [signature] Date

President [signature] Date

APPROVED FOR PUBLIC WATER SUPPLY AND SEWERAGE SYSTEMS.
WORCESTER COUNTY HEALTH DEPARTMENT.

By [signature] Date 6-29-81

SURVEYOR'S CERTIFICATION

I certify that this plat represents an accurate survey that all monuments indicated hereon actually exist and their locations and description are correctly shown and that all requirements of the subdivision regulations have been complied with to the best of my knowledge.

[signature] Date 6/29/81

Peter E. Loewenstein P.E.S. #9439

ENGINEERS CERTIFICATION

I certify that this plat, together with the applicable wording of the declaration is a correct representation of the condominium described, and the identification and location of each unit and the common element as constructed, can be determined from them.

By David Sylvester Date 6/29/81

David Sylvester R.P.E. 3499

OWNERS CERTIFICATION

We certify the requirements of section 3-108 to the Real Property volume of the Annotated Code of Maryland (1974) concerning the making of this plat and the setting of makers have been complied with.

By [signature] Date 6/26/81

Norman R. and Marie E. Jones

NOTES

All elevations shown are in feet above mean low water in the Atlantic Ocean at Ocean City, Maryland using 1929 datum.

0.00 Denotes existing elevations.

■ Denotes concrete monument.

● Denotes property corner.

Denotes common element.

Denotes unit element.

10 0 5 10 20
Scale in Feet

"BRASS EAGLE CONDOMINIUM"
OCEAN CITY, WORCESTER COUNTY, MARYLAND

Scale shown	Approved By	Drawn By CRD
Date 6-24-81		Revised
Reference Lot 1, Block 73, Sinepuxent Beach Co. Plat recorded: O.D.C. 1, folio 2		
SITE PLAN		Drawing Number 1

MSA CSU 2157-1791-1

Maryland State Archives