FWH 71/52

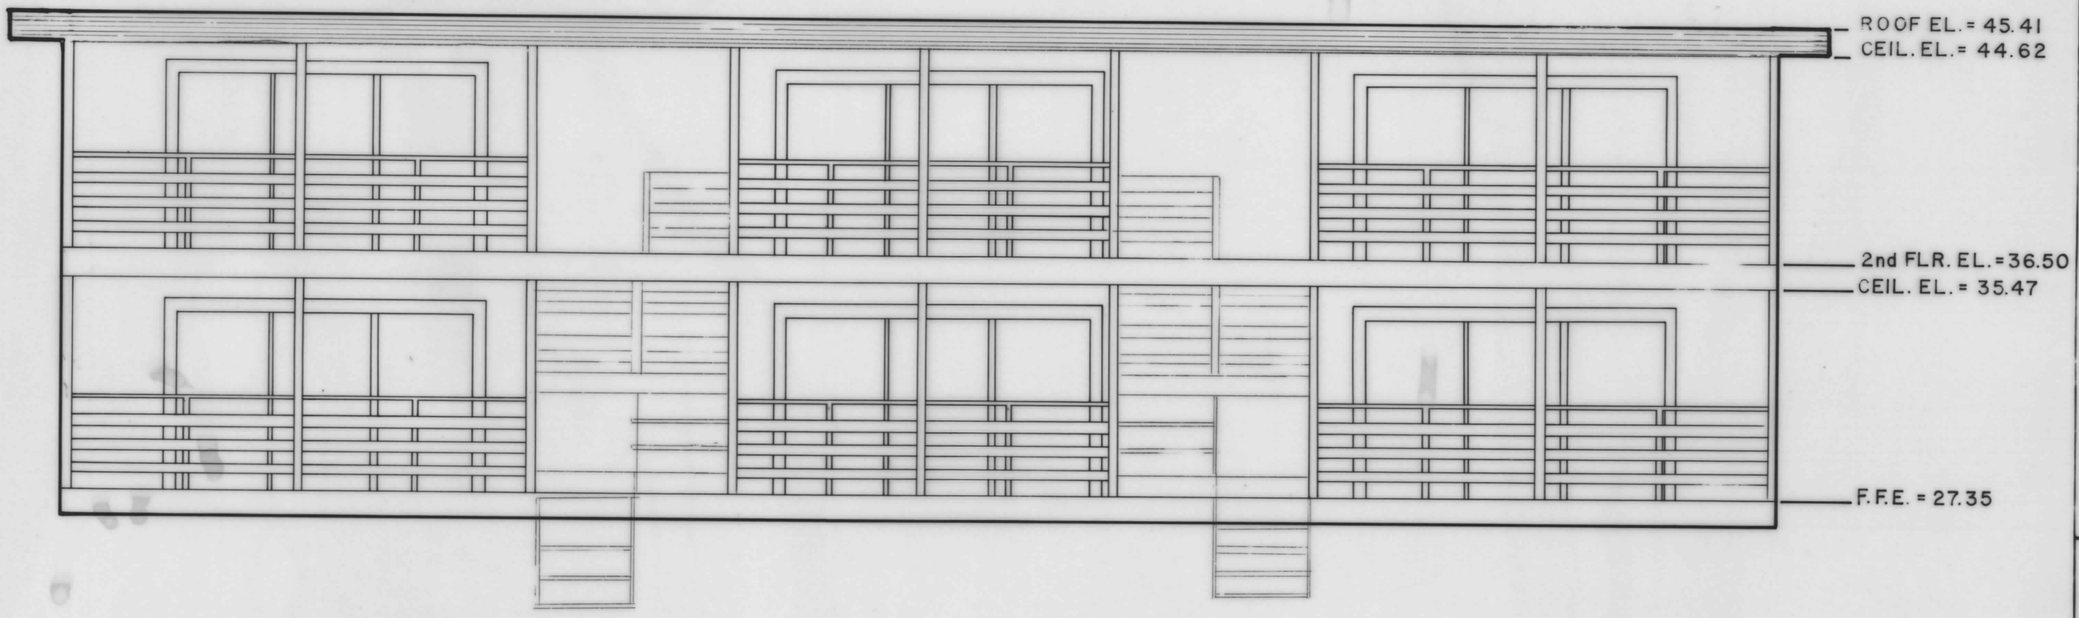

NORTH BUILDING - EAST ELEVATION

SCALE: 1/4" = 1'

THE NORTHERN CONDOMINIUM "AS BUILT" DRAWINGS
SHEET 5 OF 7

MSA CSU 2257-1992-5

DELMARVA SURVEYS, INC.
3409 COASTAL HIGHWAY
OCEAN CITY MD 21842 301-289-3203
R LEE GILLISS, JR
RPLS 185 B

Maryland State Archives