FW# 71/54

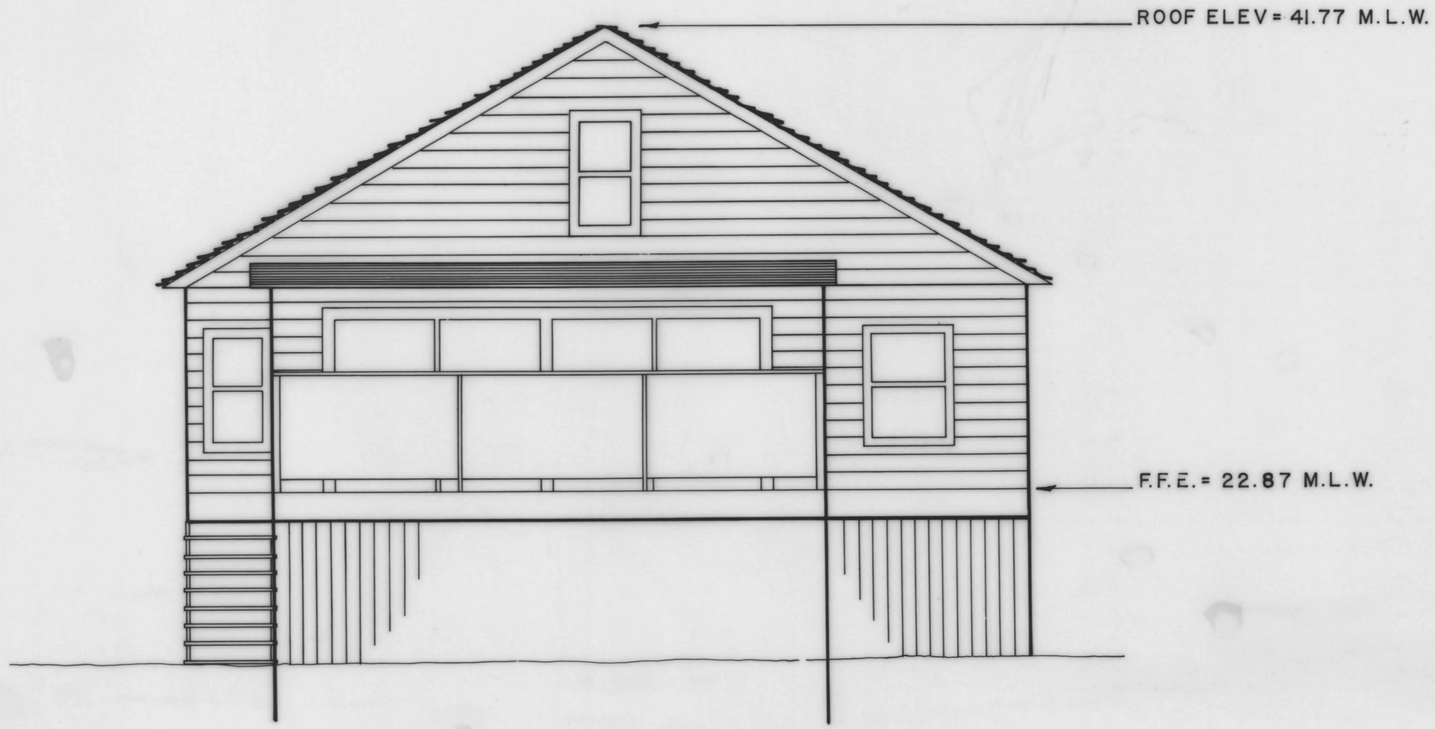

SOUTH BUILDING – EAST ELEVATION

SCALE: 1/4" = 1'

MSA CSU 2157-1992-7

THE NORTHERN CONDOMINIUM "AS BUILT" DRAWINGS
SHEET 7 OF 7

DELMARVA SURVEYS, INC.
3409 COASTAL HIGHWAY
OCEAN CITY, MD 21842 301-289-3203
R. LEE GILLISS, JR.
R.P.L.S. # 185 B

MSA CSU 2157-1992-7
Maryland State Archives