RTO 120/32

FILED
Dec 9 3 18 PM '83
RICHARD M. OUTTEN
CLK. CT. CT.
WOR. CO.

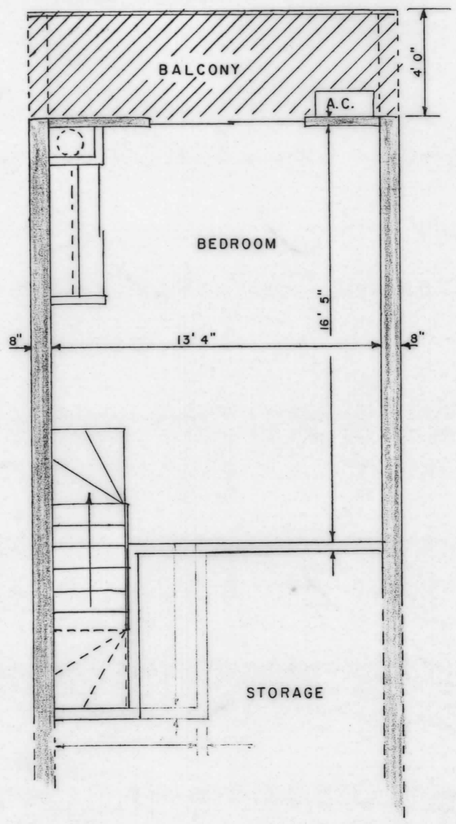

THIRD FLOOR

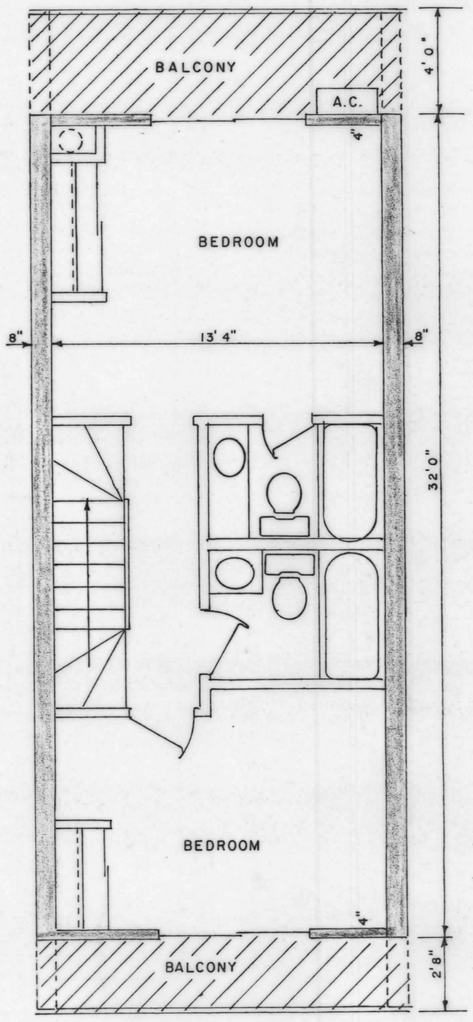

SECOND FLOOR

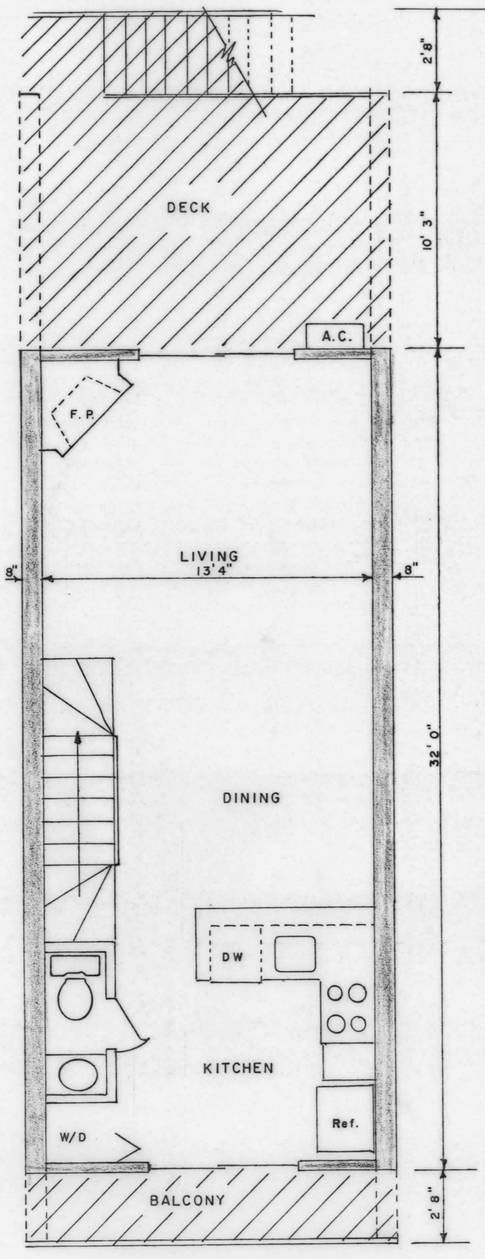

FIRST FLOOR

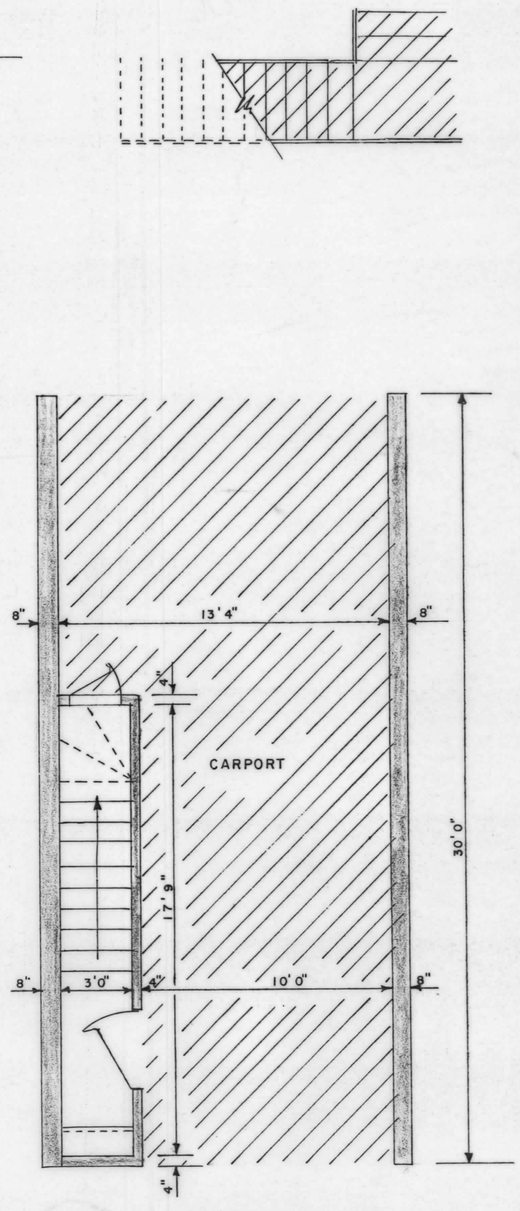

GROUND FLOOR

TYP. UNIT

1/4" = 1'0"

1,107. Sq. Ft.

TITLE HARBOR SAILS CONDOMINIUM
PHASE III
LOTS 35-37 & LOTS 153-164
CAINE HARBOR MILE
OCEAN CITY, WOR. CO., MARYLAND

REFERENCE AS-BUILTS

NORMAN R. JONES, INC.
OCEAN CITY, MARYLAND
APPROVED BY

Norman R. Jones, Pres.
Md. R.P.L.S. No. 202-B

SURVEYED
DRAWN R.B.J.
CHECKED
DATE April, 85
FILE
SHEET 2 OF 5

MSA CSU 2157-2320-2

DATAPRINT N2149

Maryland State Archives