RHO 122/28

RHO 122/28.

FILED
MAY 25 3 20 PM '89
RICHARD H. OUTTEN
CLK. CT. CT.
WOR. CO.

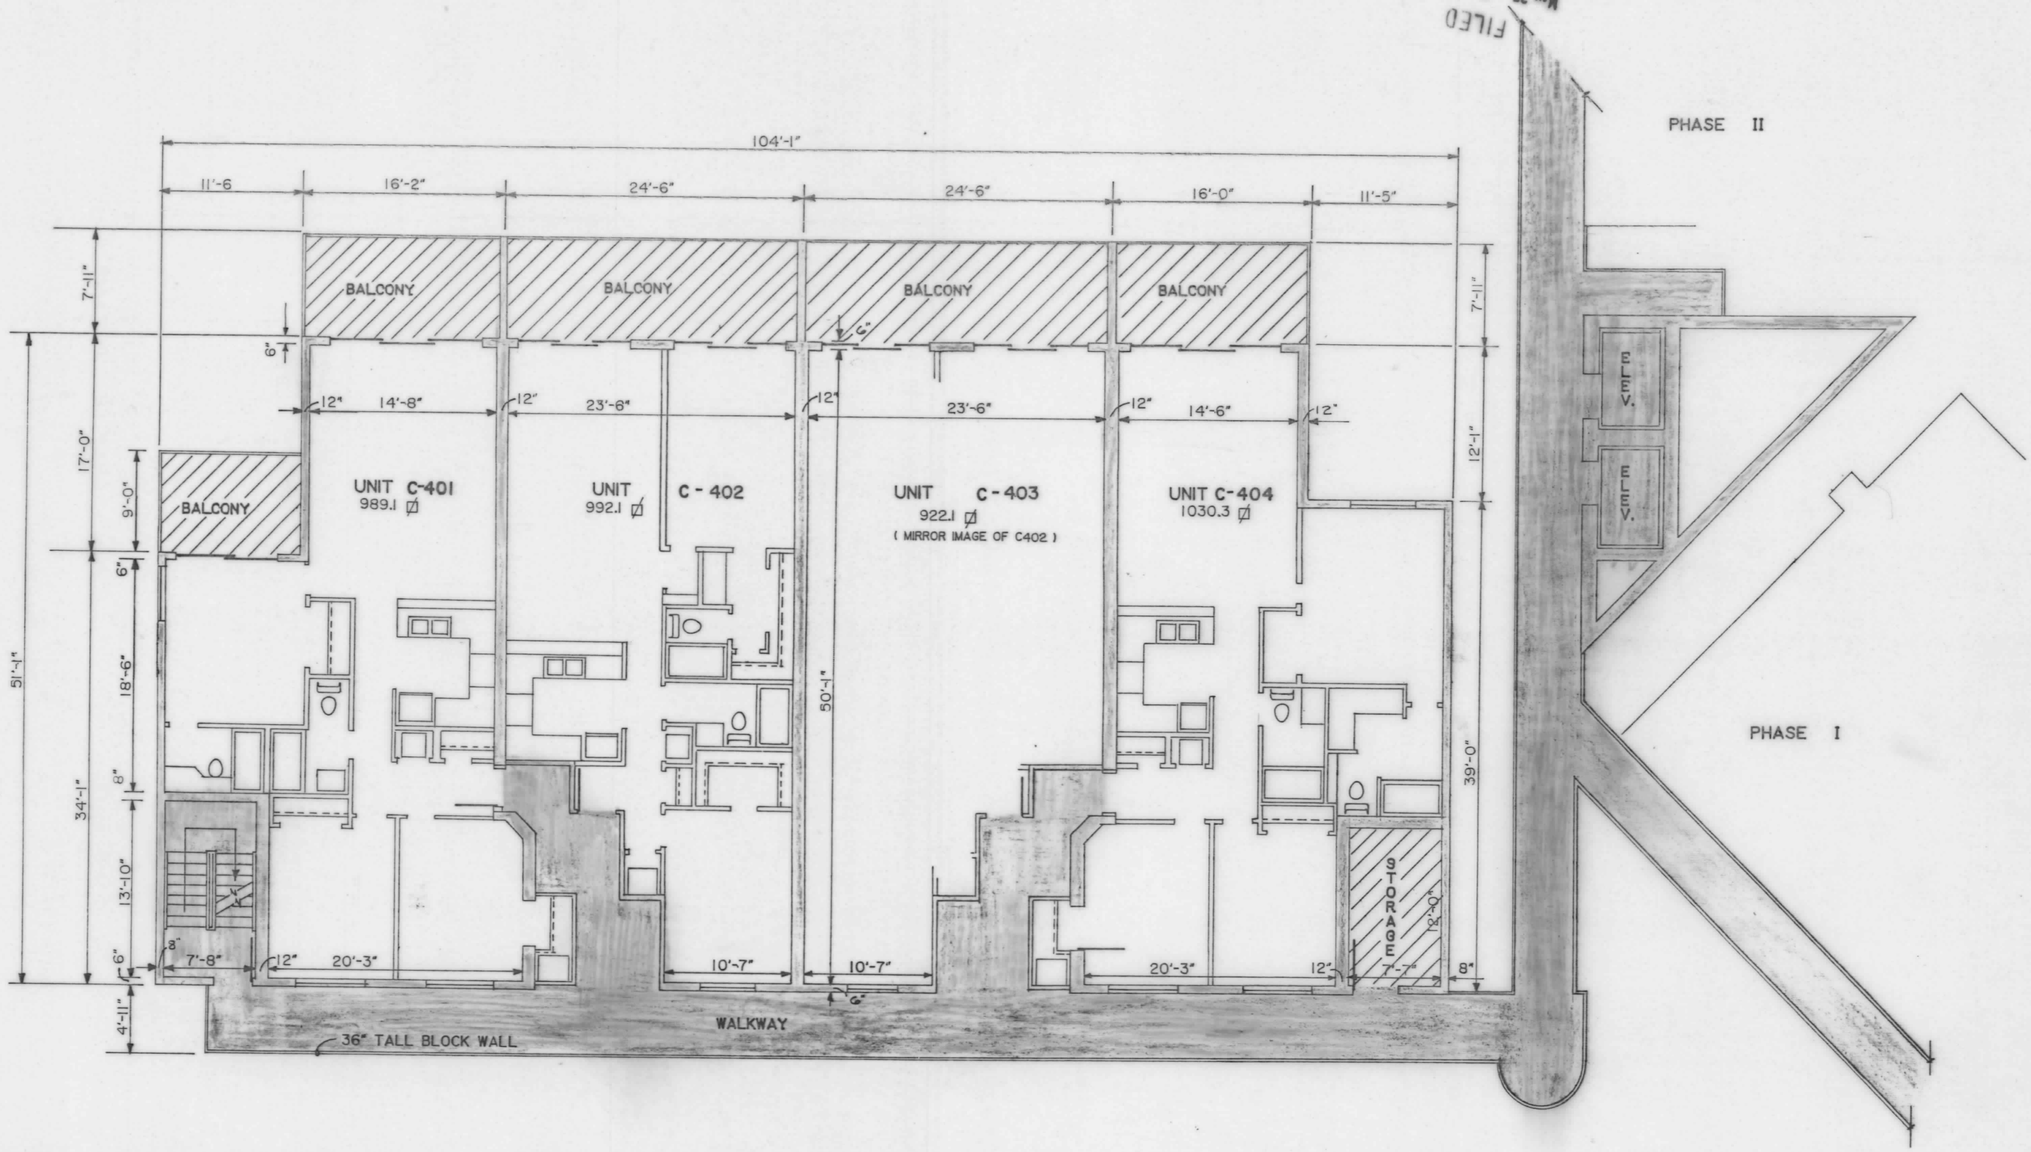

FOURTH FLOOR PLAN

1/8" = 1'-0"

TITLE	TRITONS TRUMPET CONDO BLOCK 104 OCEANBAY CITY PLAT OCEAN CITY, WOR.CO., MARYLAND
REFERENCE	AS-BUILTS
NORMAN R. JONES, INC. OCEAN CITY . MARYLAND APPROVED BY Norman R. Jones, Pres. Md. R.P.L.S. No. 202-B	SURVEYED DRAWN CHECKED DATE FILE SHEET 5 OF 7

DATAPRINT N04973

MSA CSU 2157-2454-5

Maryland State Archives