RH0122/29

FILED
May 25 3 20 PM '89
RICHARD H. OUTTEN
CLK. CT. CT.
WOR. CO.

RH0122/29

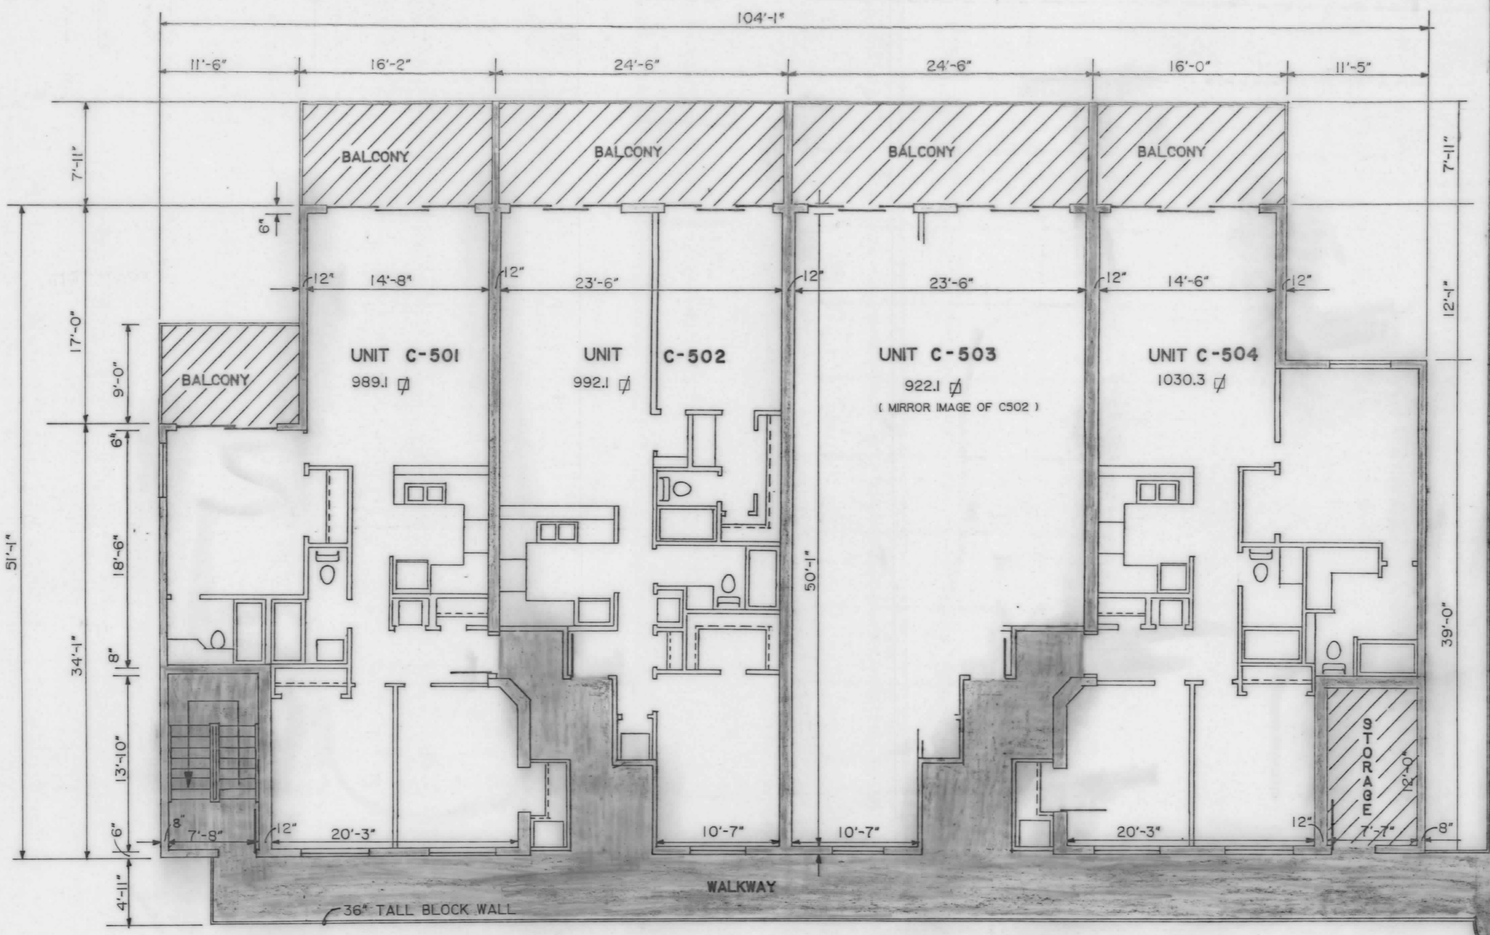

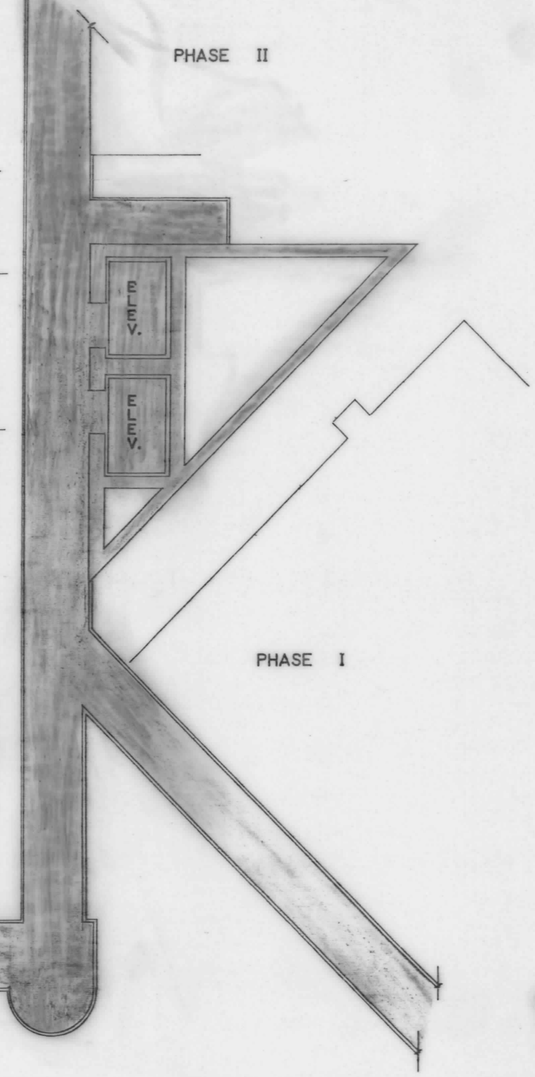

FIFTH FLOOR PLAN

1/8" = 1'-0"

TITLE	TRITONS TRUMPET CONDO BLOCK 104 OCEANBAY CITY PLAT OCEAN CITY, WOR.CO., MARYLAND
REFERENCE	AS-BUILTS
NORMAN R. JONES, INC. OCEAN CITY, MARYLAND APPROVED BY Norman R. Jones, Pres. Md. R.P.L.S. No. 202-B	SURVEYED DRAWN CHECKED DATE FILE SHEET 6 OF 7

DATAPRINT N0473

MSA CSU 2157-2457-6