RHO 122/9

10' ALLEY

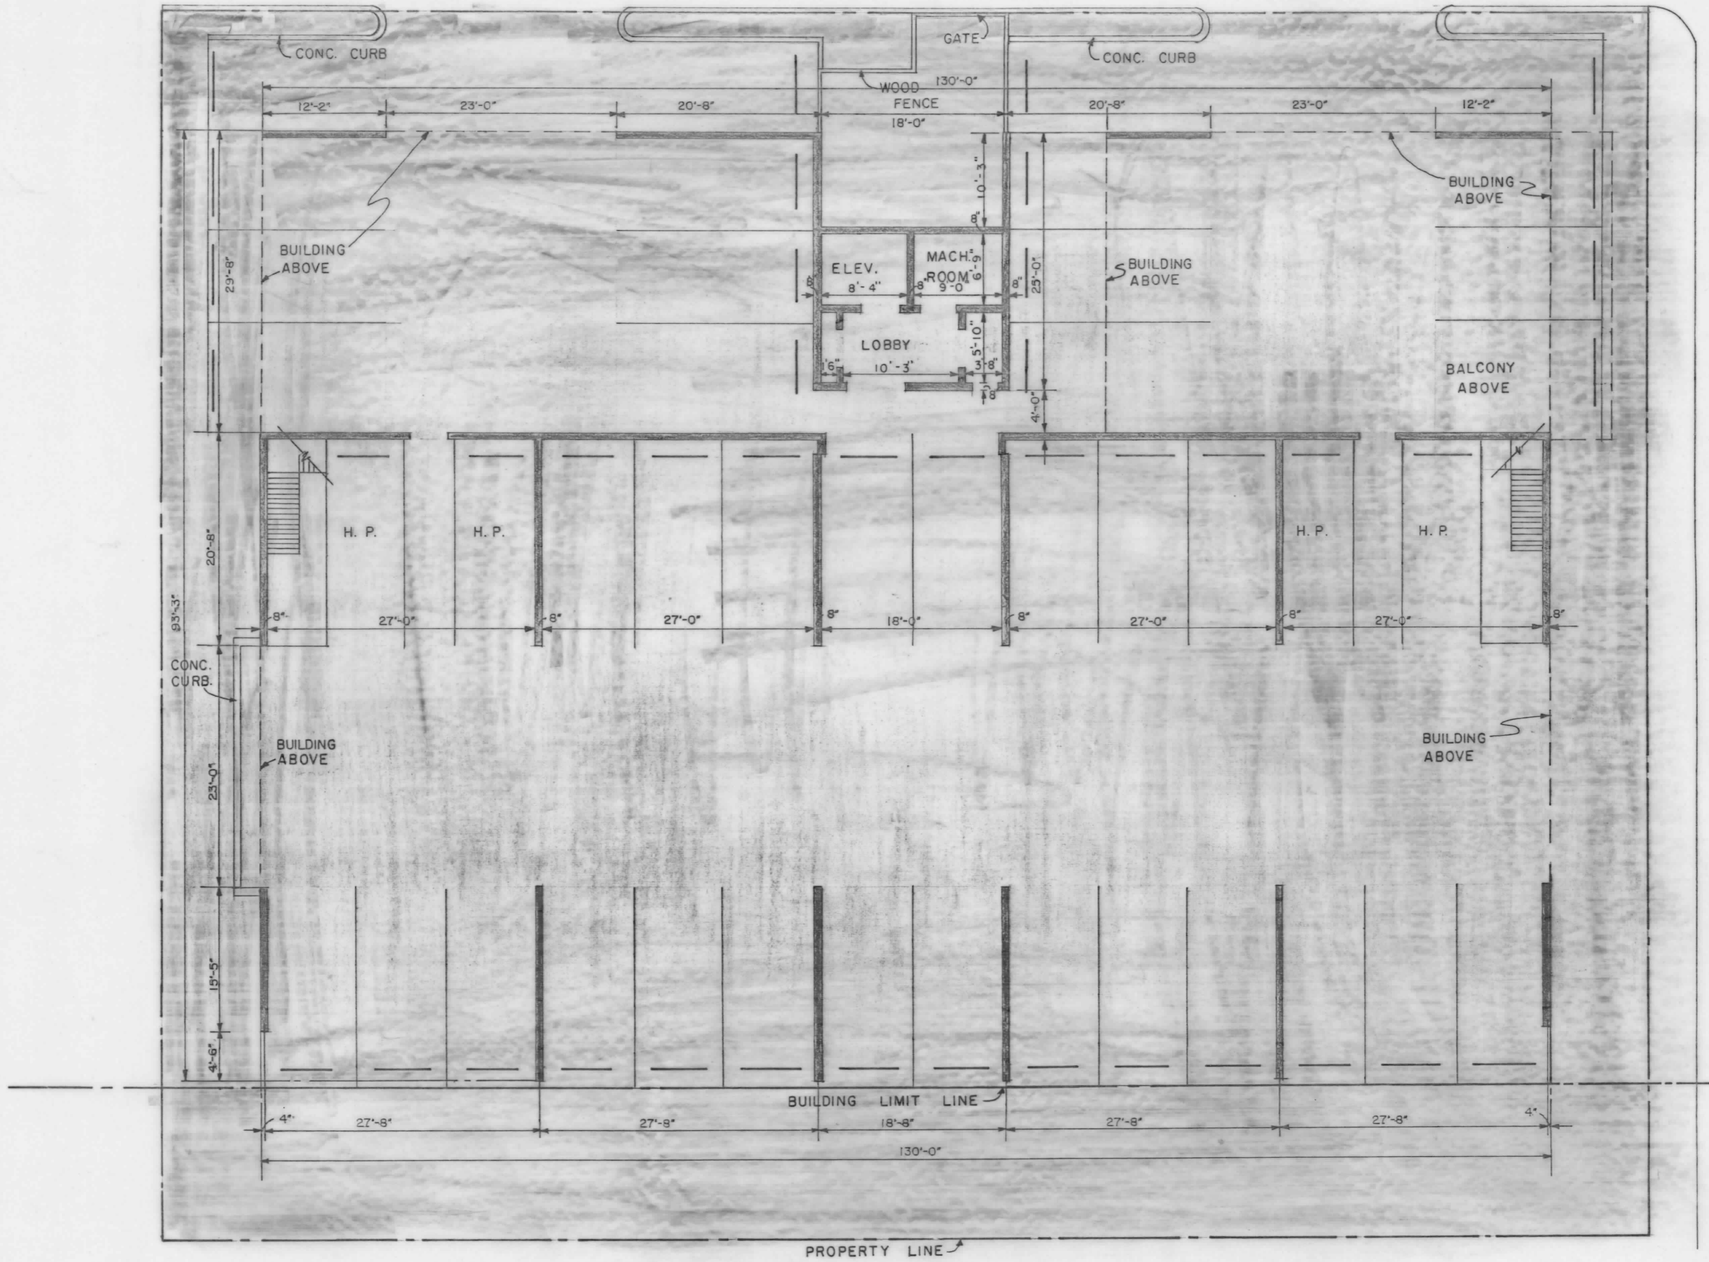

57th STREET

BEACH

GROUND FLOOR PLAN

1" = 10'-0"

OCEAN ONE CONDO

FILED
MAY 15 2 58 PM '89
RICHARD W. OUTTEN
CLK. CT. CT.
WOR. CO.

TITLE	OCEAN ONE CONDOMINIUM LOTS 3,4,5, BLOCK 24 ISLE OF WIGHT PLAT OCEAN CITY, WOR.CO., MARYLAND
REFERENCE	AS-BUILTS
NORMAN R. JONES, INC. OCEAN CITY, MARYLAND APPROVED BY Norman R. Jones, Pres. Md. R.P.L.S. No. 202-8	SURVEYED DRAWN CHECKED DATE FILE SHEET 2 OF 7

DATAPRINT N04973

MSA C84 2157-2511-2

Maryland State Archives