WCL 75/3

FILED
SEP 2 3 02 PM '82
WARNER L. LITTLETON
CLK. CT. CT.
WOR. CO.

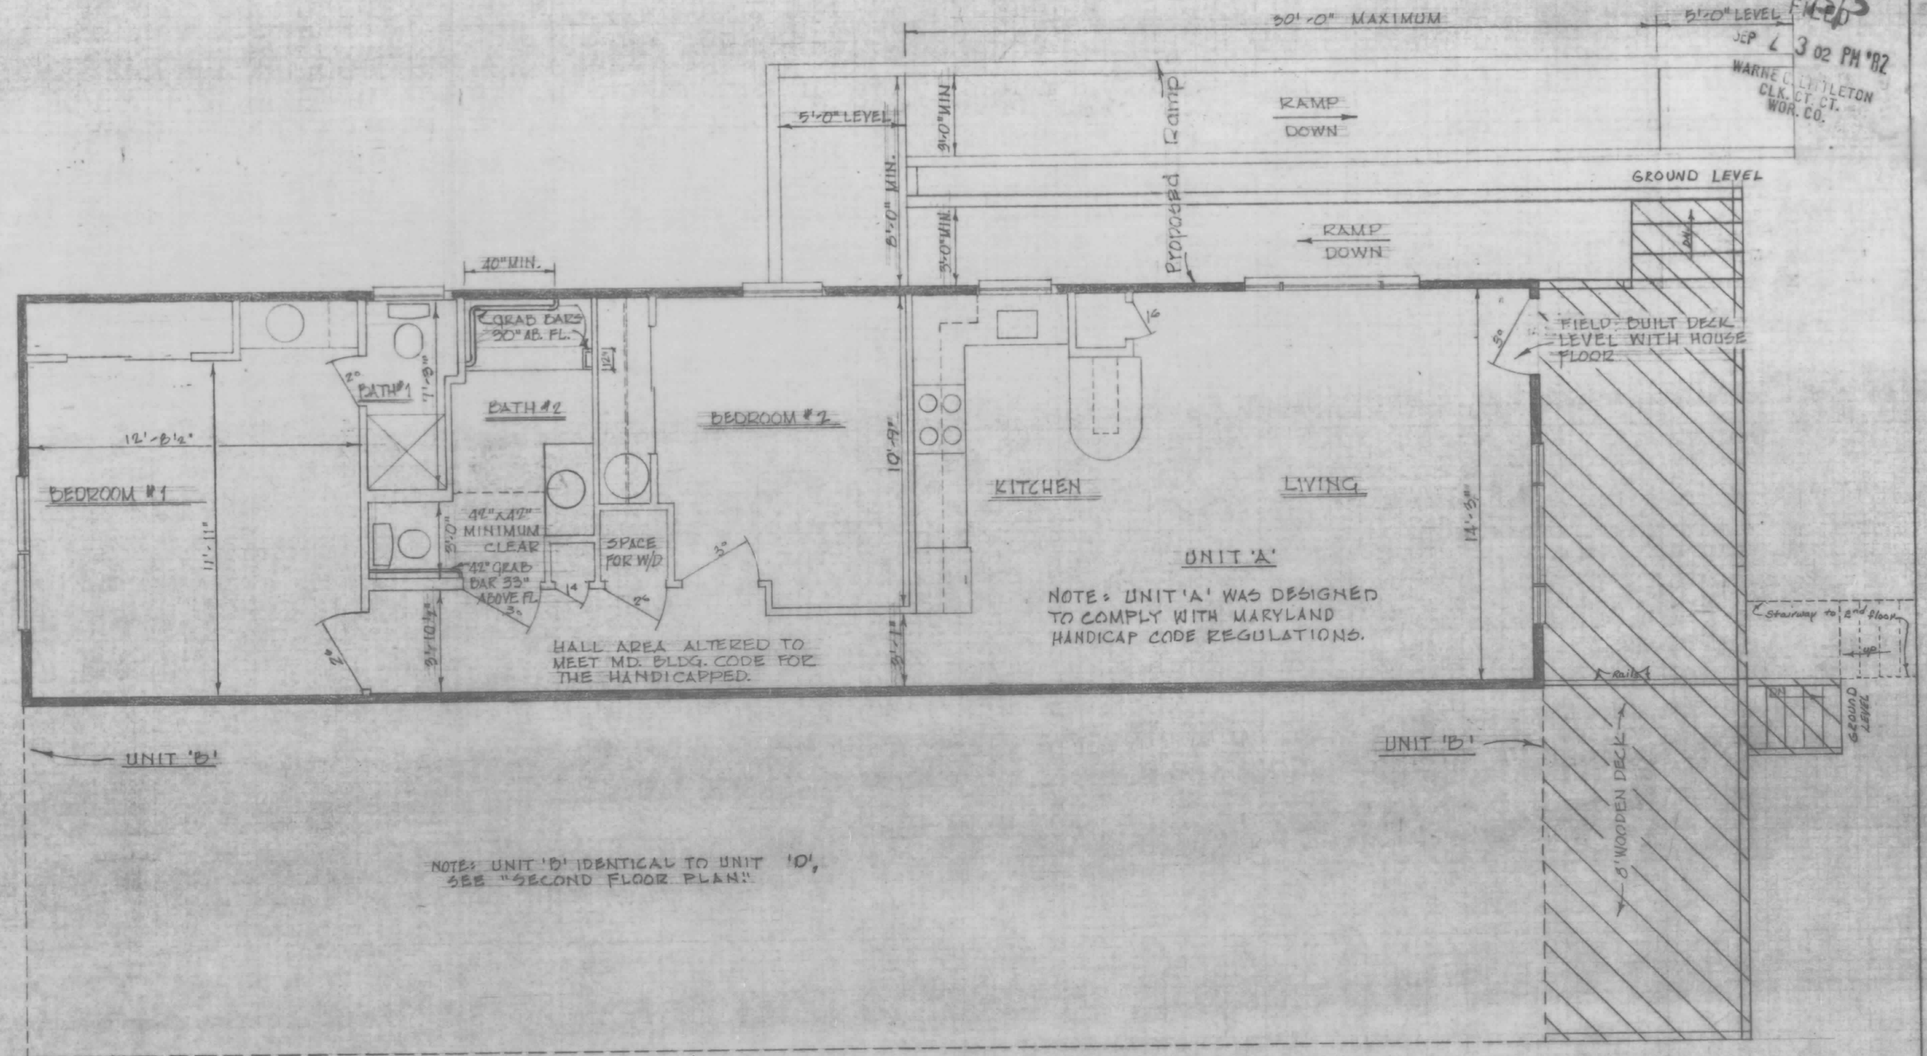

FIRST FLOOR PLAN

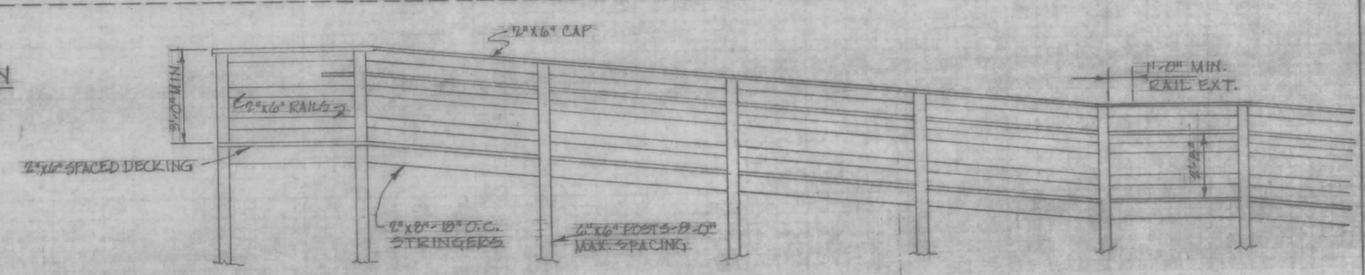

PROPOSED RAMP DETAILS

UNIT 'A' HAS 840.8 Sq. Ft. ±
UNIT 'B' HAS 840.8 Sq. Ft. ±

DENOTES UNIT ELEMENT
DENOTES LIMITED COMMON ELEMENT
DENOTES COMMON ELEMENT

SAND KEY CONDOMINIUM, (As Built), PHASE I Lots 277 and 278, Addition E, Bayshore Estates		
Scale: As Noted	Approved by:	Drawn by: W.M.
Date: 9/1/1982		Revised: 8/24/1982
FRANK G. LYNCH JR. and ASSOCIATES Rte. 4, Box 299 B, Berlin, Maryland 21811 ph.: 641-3773		
FIRST FLOOR PLAN		Drawing no.: 3 of 6

MSA CS02152-4335-3

Maryland State Archives