FILED
SEP 2 3 02 PM '82
WARNE C. LITTLETON
CLK. CT. CT.
WOR. CO.

WCL 75/5

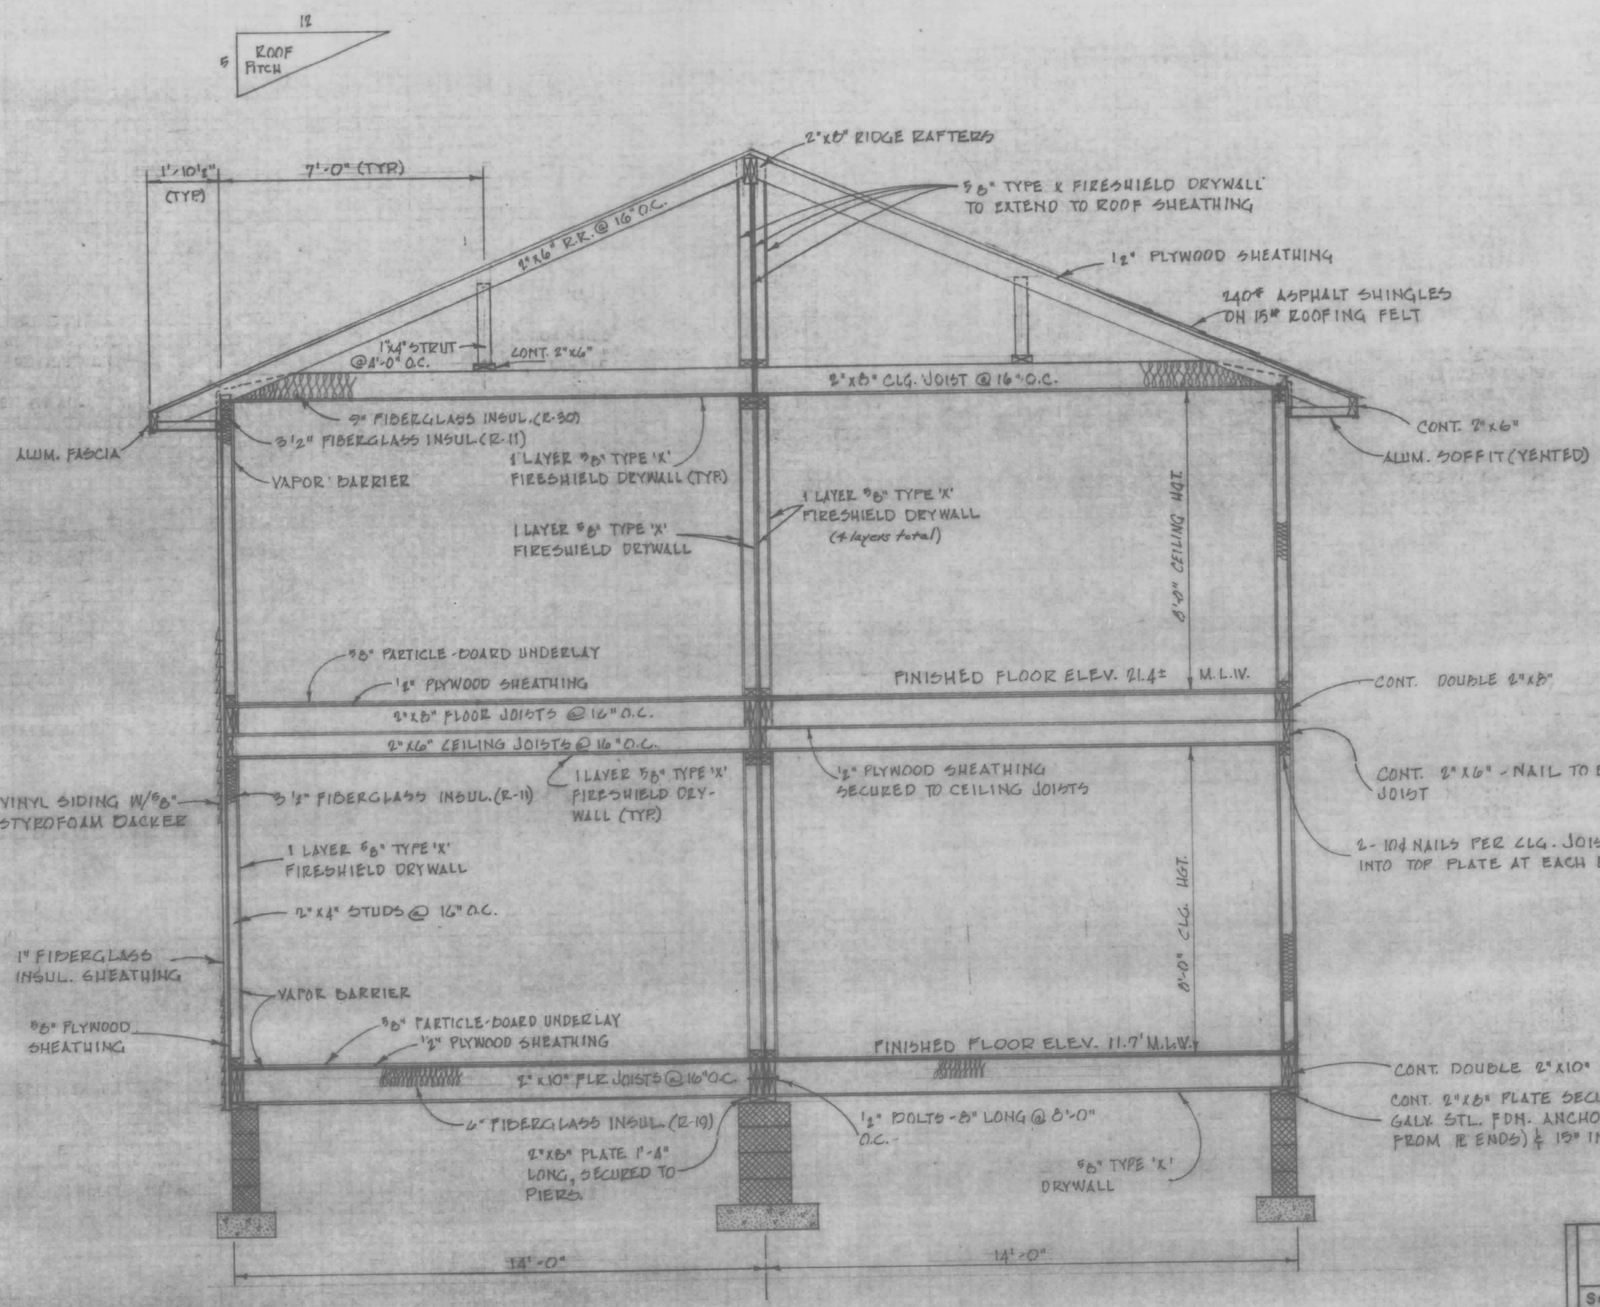

TYPICAL CROSS SECTION
SCALE: 3/8" = 1'-0"

SAND KEY CONDOMINIUM, (As Built), PHASE I Lot 277 and Lot 278, Addition E, Bayshore Estates		
Scale: As Noted	Approved by:	Drawn by: W.O.M.
Date: 7/11/1982		Revised: 8/21/1982
FRANK G. LYNCH JR. and ASSOCIATES Rte. 4, Box 299 B, Berlin, Maryland 21811 ph. 641-3773		
FRAMING SECTION		Drawing no. 5 of 6

MSA CSU 2157-4335-5

Maryland State Archives