WCL 75/6

FILED

SEP 4 3 02 PM '82

WARNER E. LITTLETON
CLK. CT. CT.
WOR. CO.

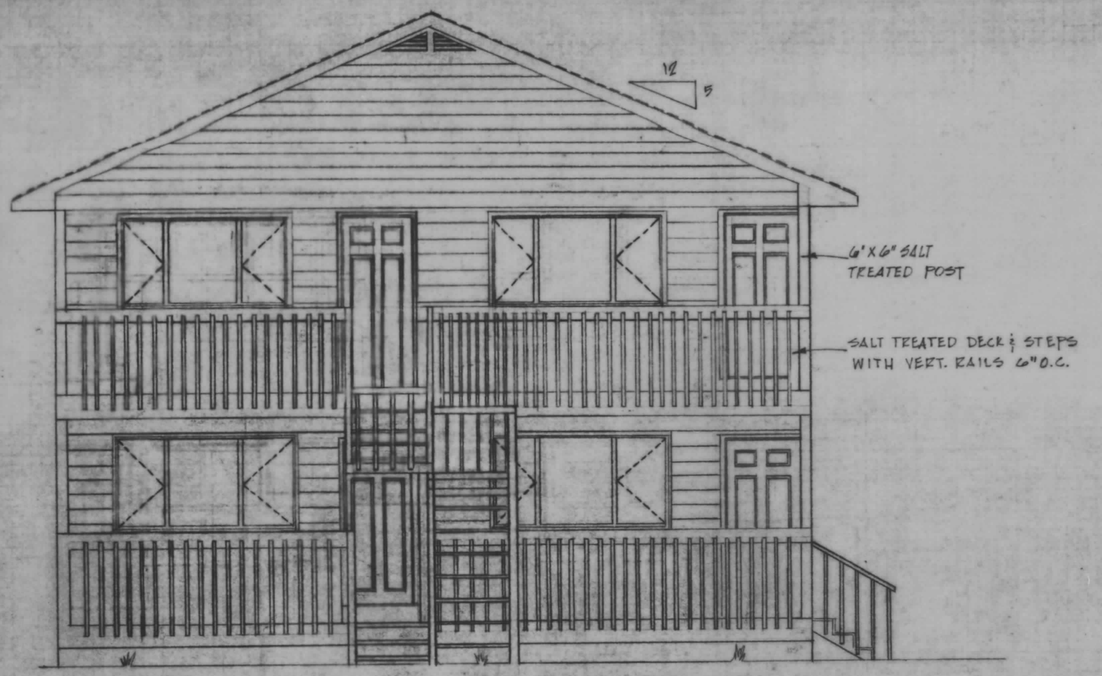

WEST ELEVATION 1/4" = 1'-0"

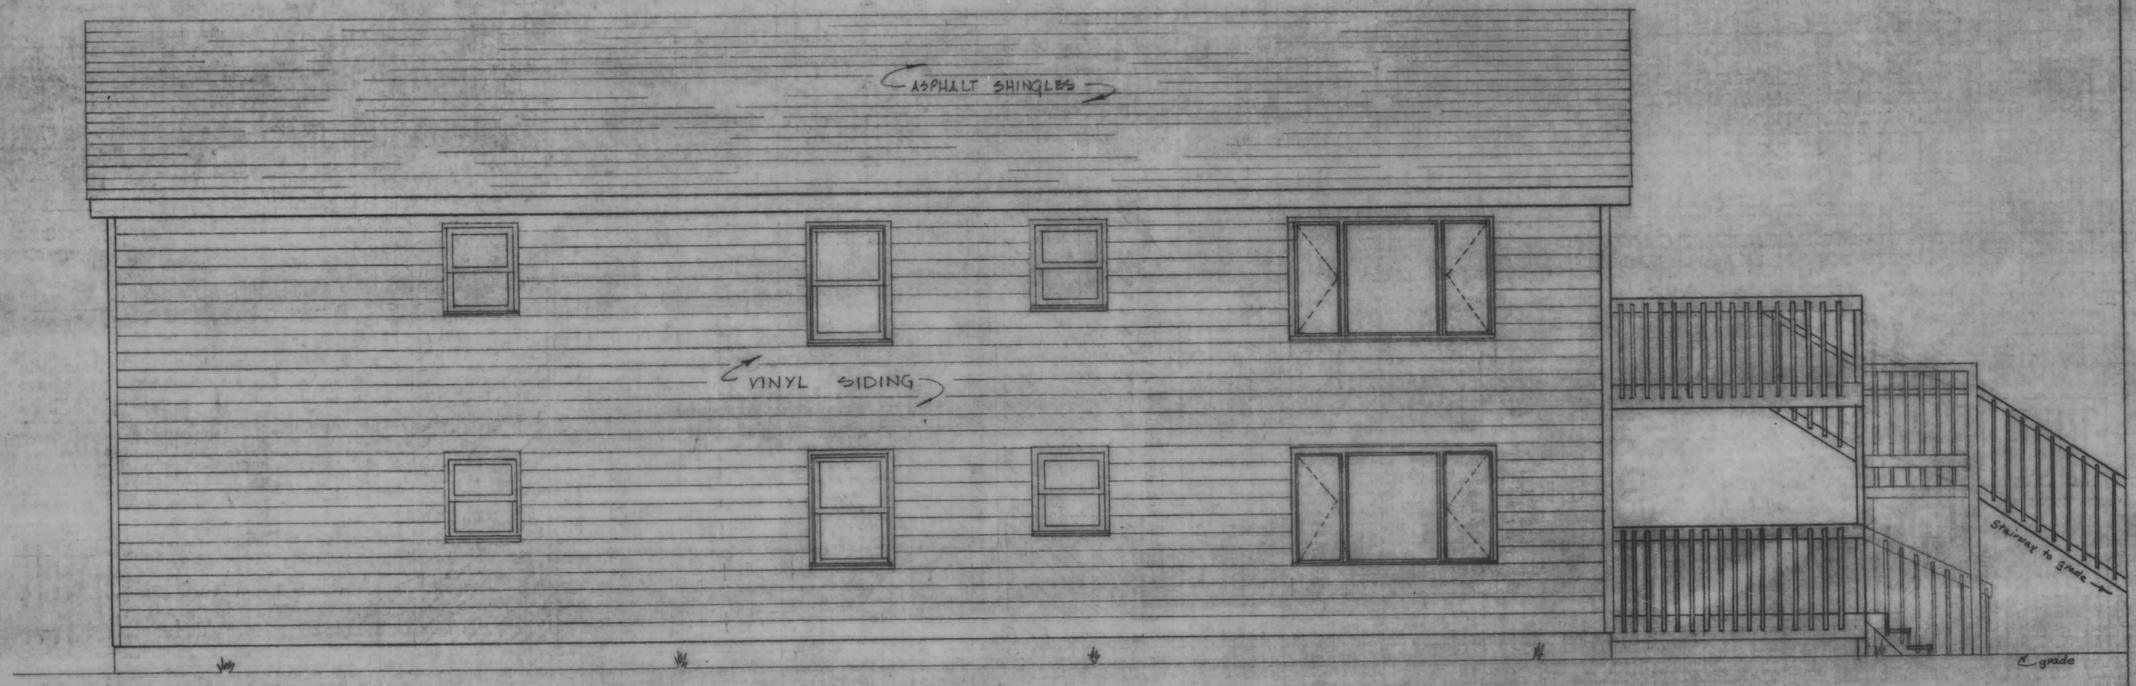

NORTH ELEVATION 1/4" = 1'-0"

SAND KEY CONDOMINIUM, (As Built), PHASE I Lot 277 and Lot 278, Addition E, Bayshore Estates		
Scale: As Noted	Approved by:	Drawn by: W.M.
Date: 7/1/1982		Revised: 8/21/1982
FRANK G. LYNCH JR. and ASSOCIATES Rte. 4, Box 299 B, Berlin, Maryland 21811 ph. 641-3773		
ELEVATIONS		Drawing no.: 6 of 6

MSA CSU 2152-4335-6

Maryland State Archives