FILED
JUN 15 1 52 PM '83
WARNE C. LITTLETON
CLK. CT. CT.
WOR. CO.

WCL 79/58

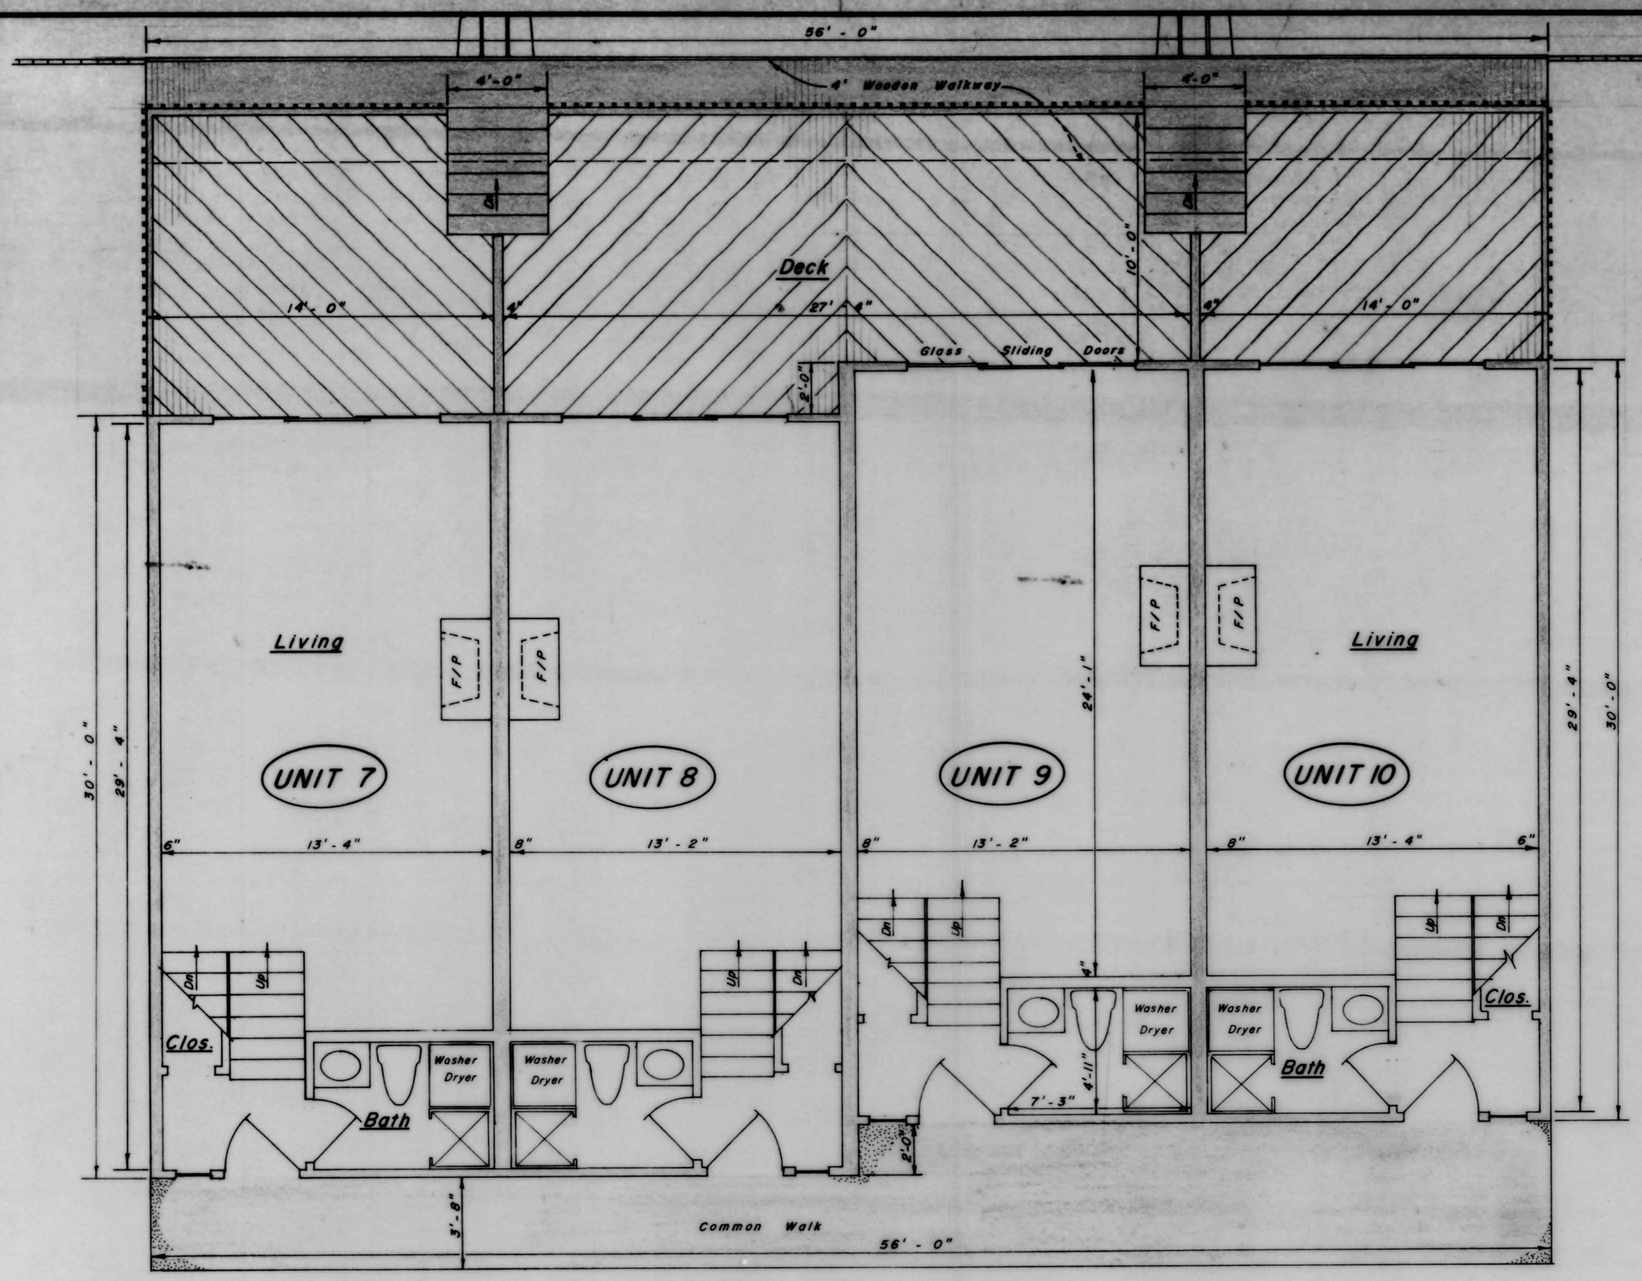

FLOOR PLANS

Denotes Common Element

Denotes Unit Element

Denotes Limited Common Element

Bayshore Points Condominium, Phase I

LOTS 622 & 623, BAYSHORE ESTATES, ADDITION "E"
Ocean City, Worcester County, Maryland

SCALE 1/4" = 1'-0"	AS BUILT	DRAWN BY W O M
DATE 6·15·82		REVISED

ROSCOE & ASSOCIATES
P.O. Box 562, Ocean City, Md.

GROUND & FIRST LEVEL LAYOUTS — DRAWING NUMBER 2 of 7

MSA CSA 2197-44712

Maryland State Archives