WGL 79/74

FILED

JUN 17 2 20 PM '83

WARNE C. LITTLETON
CLK. CT. CT.
WOR. CO.

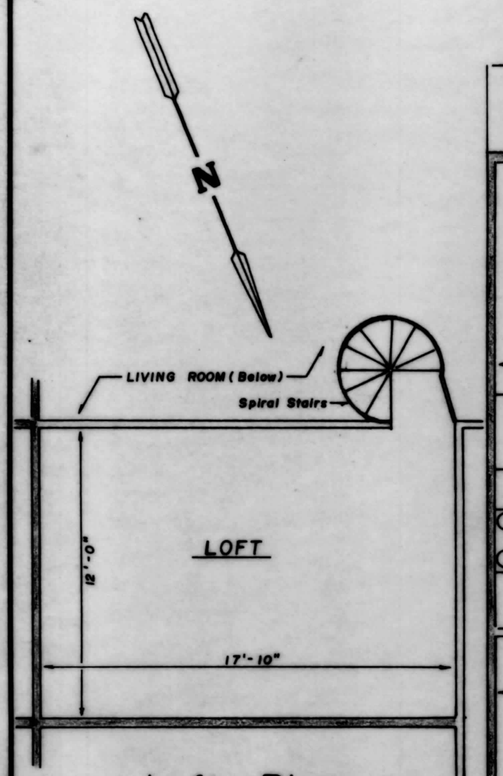

Loft Plan

UNITS 5 & 8 ONLY

LEGEND

=LIMITED COMMON ELEMENT
=COMMON ELEMENT
=UNIT ELEMENT

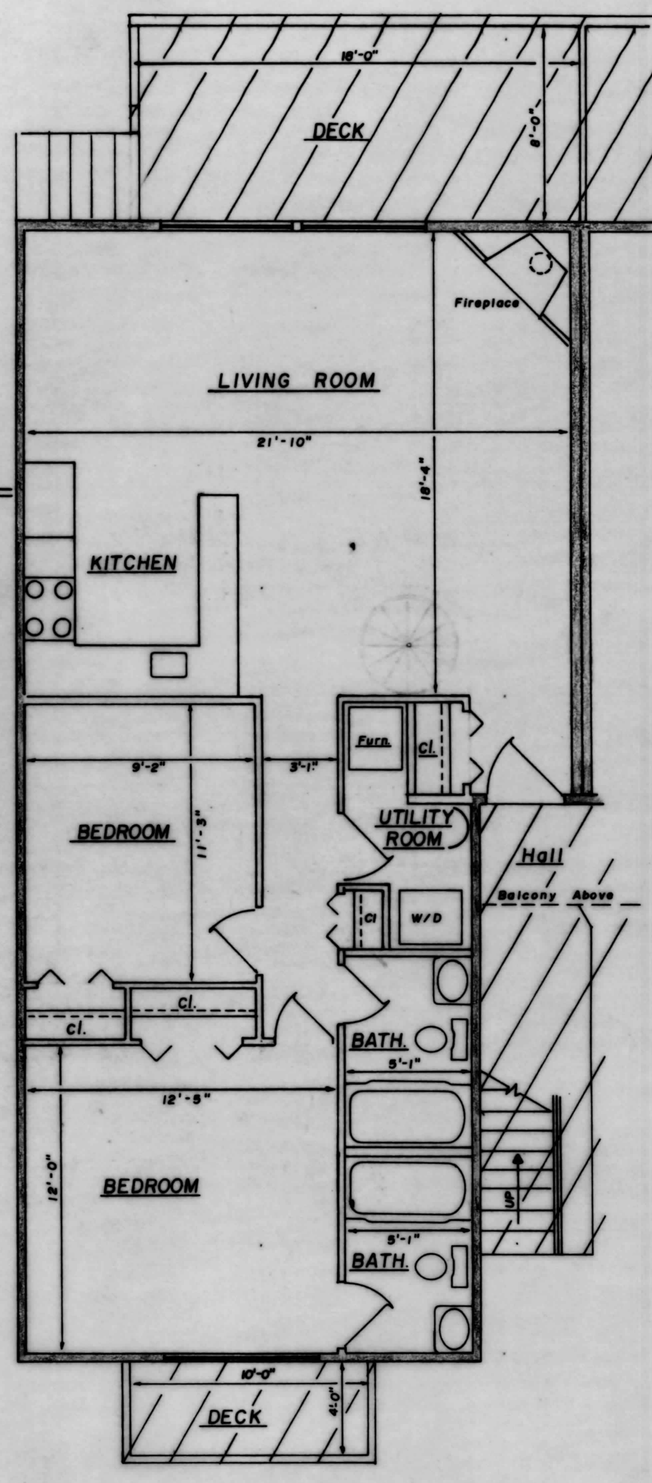

1st. Floor Units

UNITS 1 & 4 ONLY

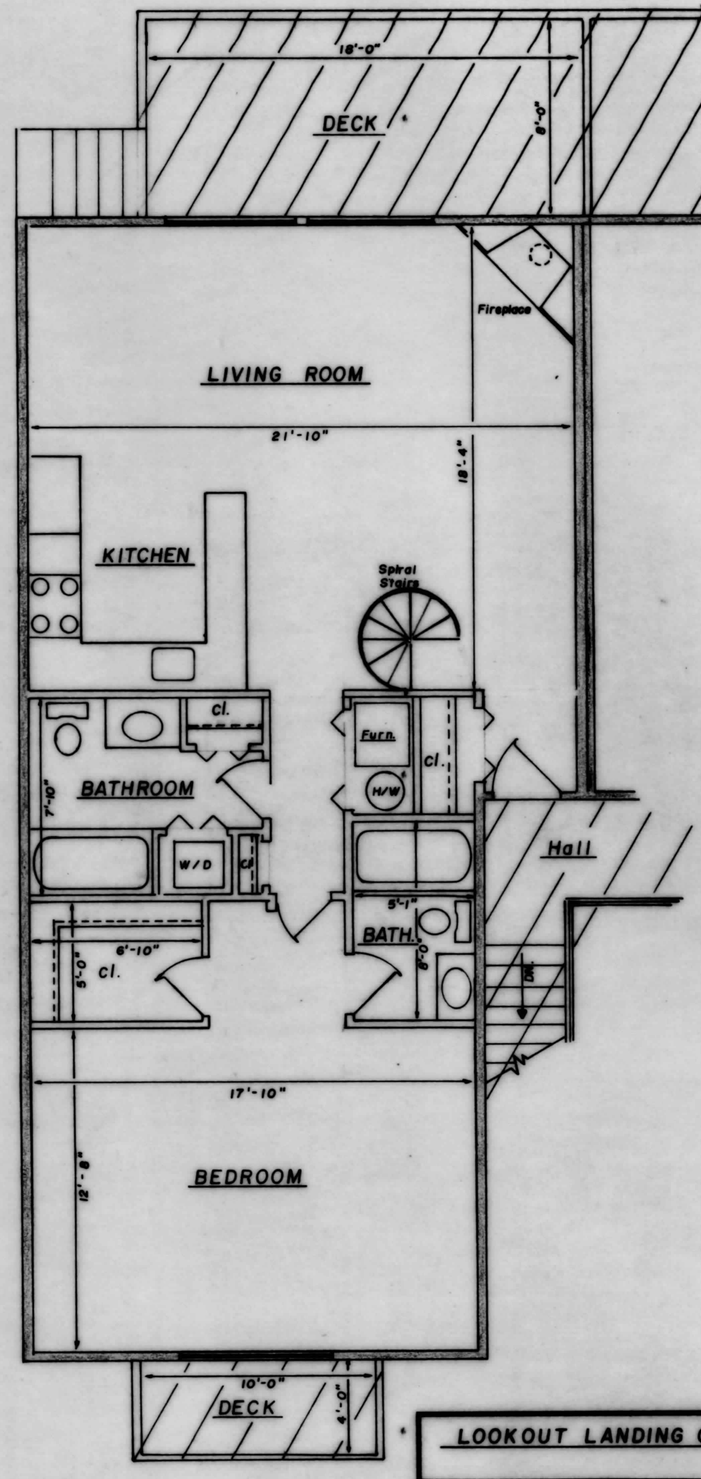

2nd. Floor Units

UNITS 5, 6, 7, 8

LOOKOUT LANDING CONDOMINIUM, As-Builts

SCALE: 1/4" = 1'-0"	APPROVED BY: R.H.N.	DRAWN BY M.T.P.
DATE: 5/20/83		REVISED —

ROSCOE AND ASSOCIATES
P.O. Box 562, Ocean City, Md.

FLOOR PLANS — DRAWING NUMBER 2

MSA CSU 2157-4474-2

Maryland State Archives