WCL 79/75

FILED
Jun 17 2 20 PM '83
WARNE C. LITTLETON
CLK. CT. CT.
WOR. CO.

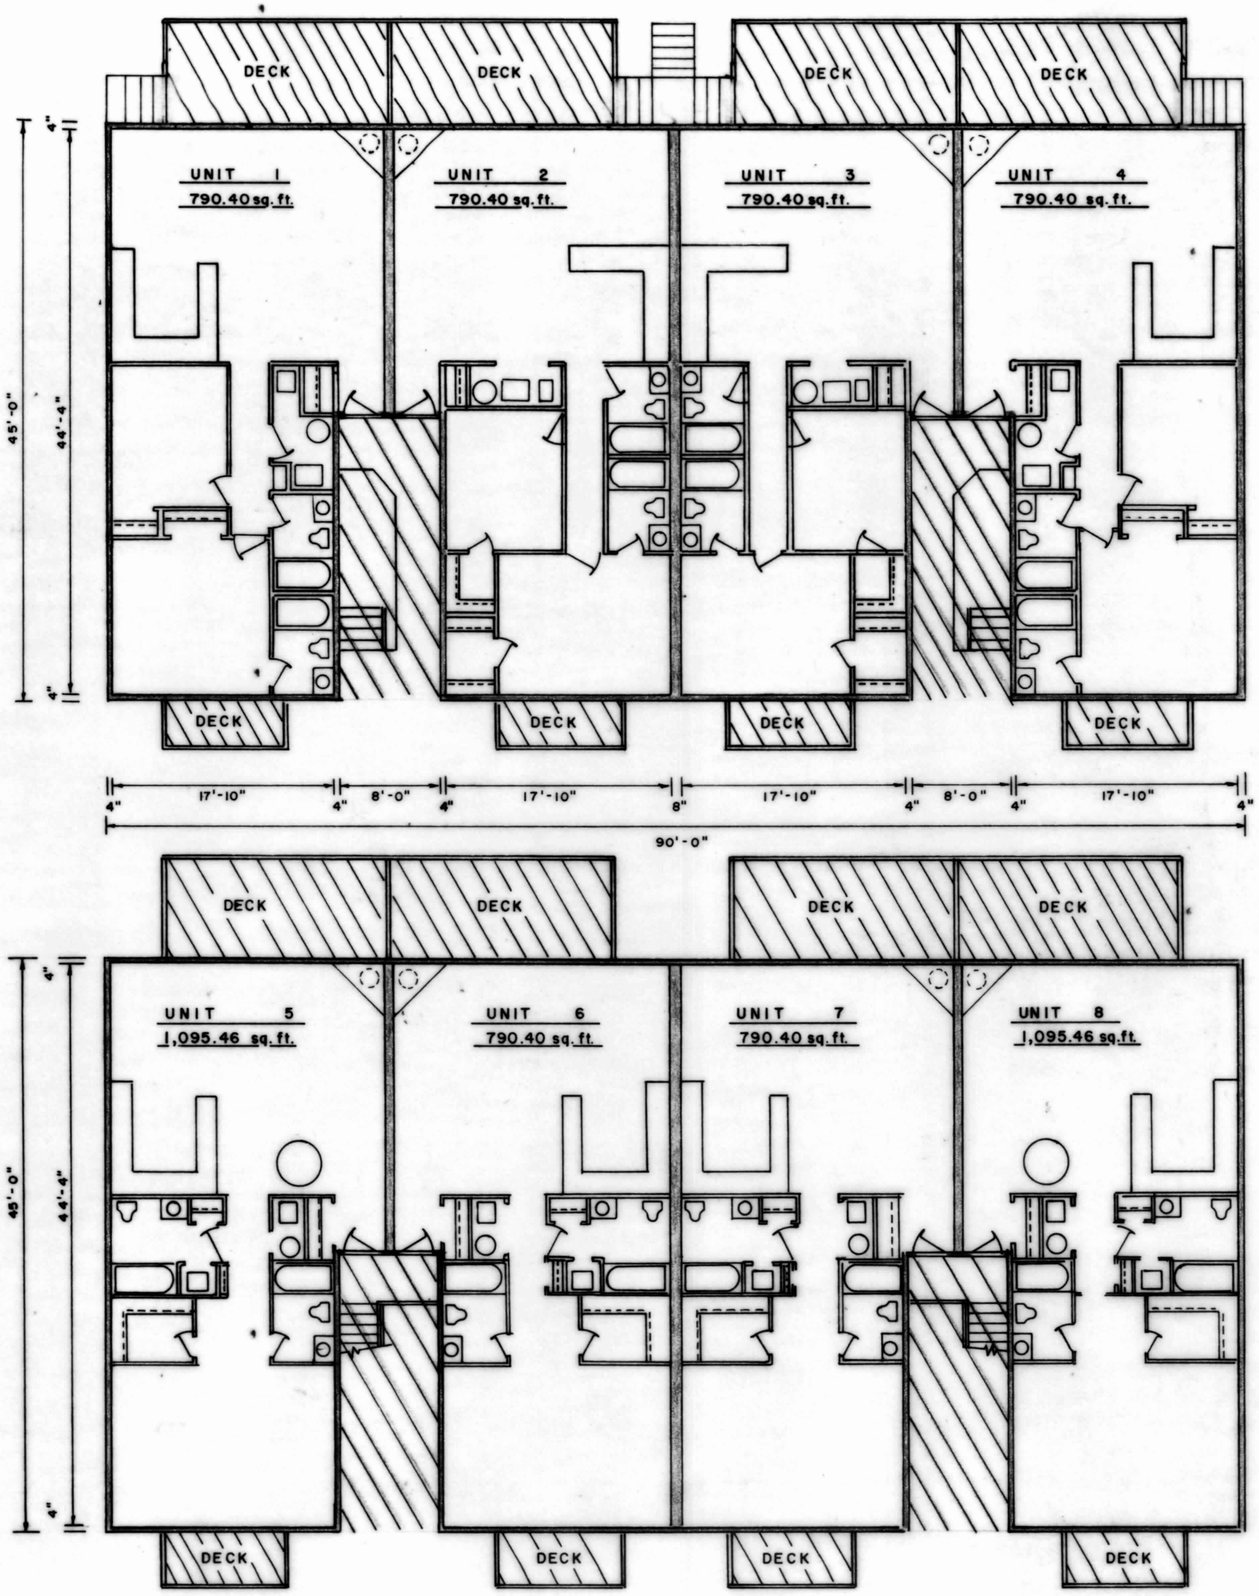

1ST. FLOOR PLAN

N

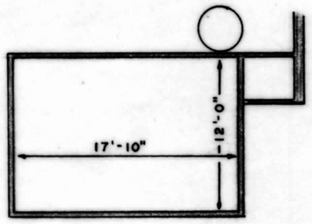

LOFT FLOOR PLAN
(Over Units 5

2ND. FLOOR PLAN

LEGEND

= LIMITED COMMON ELEMENT
= COMMON ELEMENT
= UNIT ELEMENT

LOOKOUT LANDING CONDOMINIUM, As Builts

SCALE: 1/8" = 1'	APPROVED BY:	DRAWN BY M.T.P.
DATE: 4/1/83		REVISED

ROSCOE AND ASSOCIATES
P.O. Box 562, Ocean City, Md.

FLOOR PLANS — DRAWING NUMBER 3

MSA CSU 2187-4474-3

Maryland State Archives