RHO 118/431

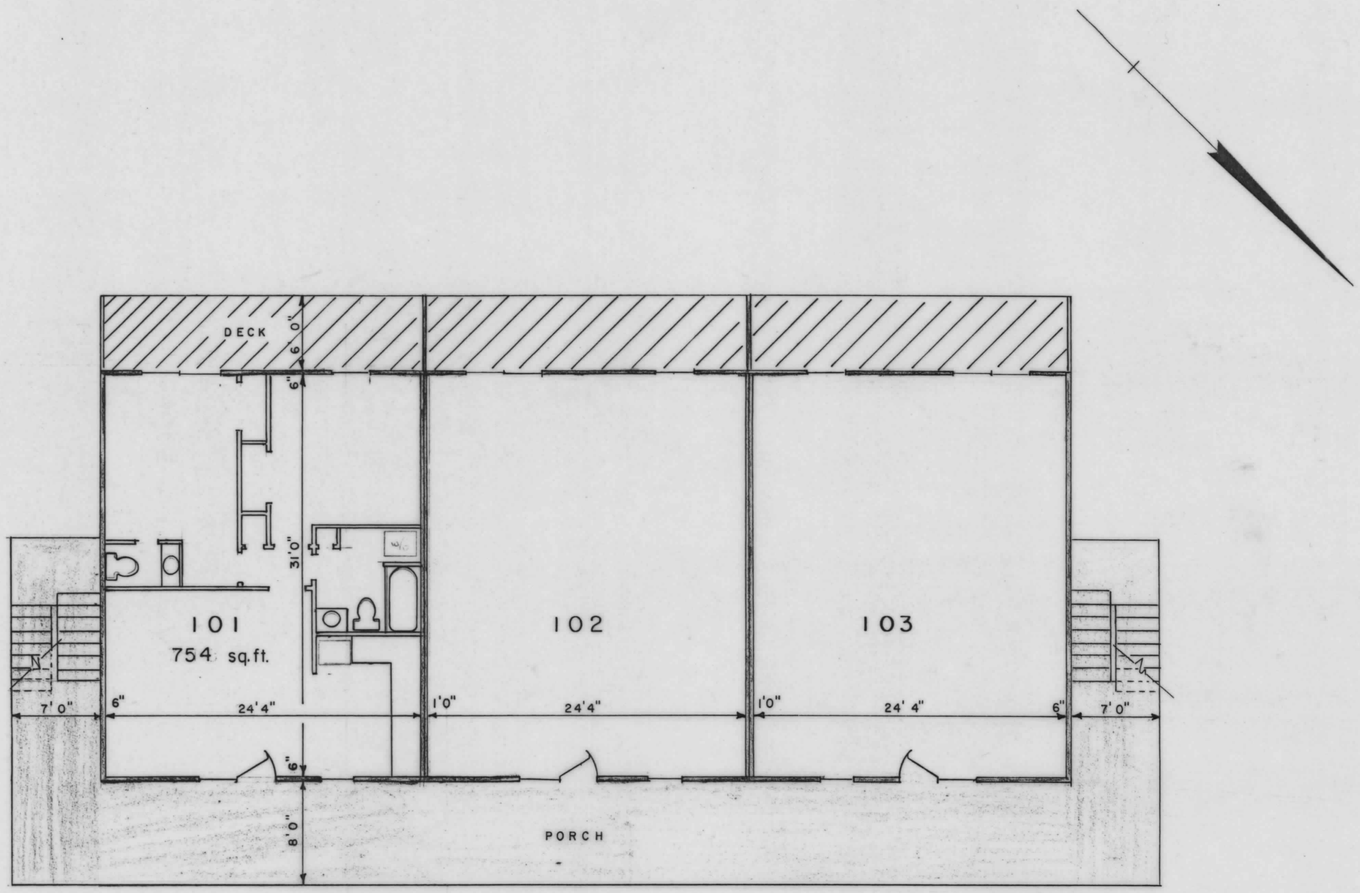

FIRST FLOOR PLAN

1/8" = 1'0"

FILED
JAN 16 11 05 AM '88
RICHARD H. CUTTEN
CLK. CT. CT.
WOR. CO.

TITLE MARATHON NORTH 3 CONDOMINIUM
LOTS 3 & 4, BLOCK 76
FENWICK
OCEAN CITY, WOR. COUNTY, MARYLAND

REFERENCE AS-BUILTS

NORMAN R. JONES, INC.
OCEAN CITY, MARYLAND
APPROVED BY
Norman R. Jones, Pres.
Md. R.P.L.S. No. 202-B

SURVEYED	
DRAWN	RBJ
CHECKED	
DATE	JAN., 88
FILE	
SHEET	2 OF 5

DATAPRINT N04973

Maryland State Archives