WCL 73/27

FILED
JUN 10 3 55 PM '82
WARNER S. SINGLETON
CLK. CT. CT.
WOR. CO.

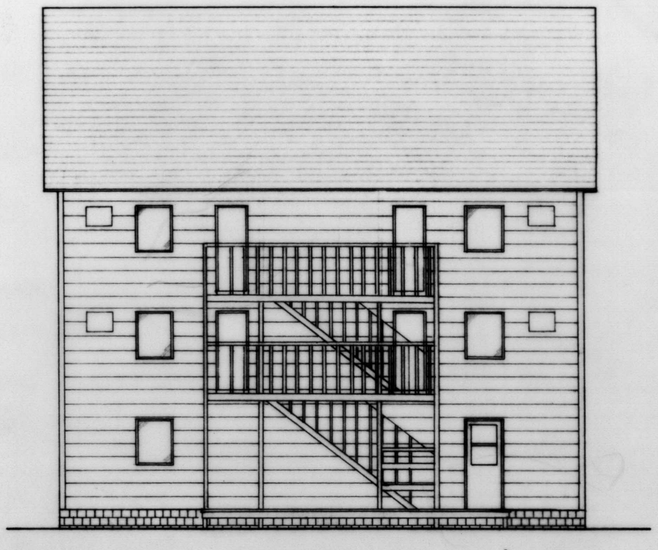

Rear View

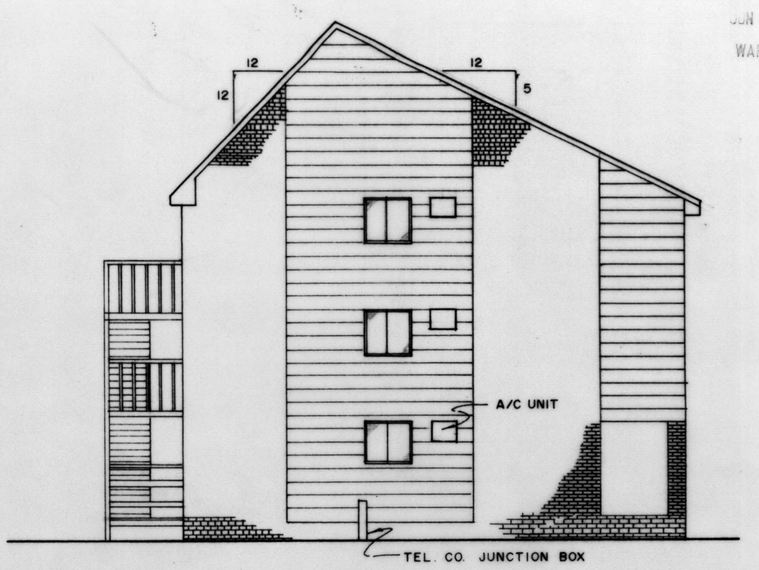

Side View

Front View

49.88	ROOF ELEVATION
38.88	3rd FLOOR CEILING ELEVATION
30.88	3rd FLOOR -FINISHED FLOOR ELEVATION
29.83	2nd FLOOR CEILING ELEVATION
21.83	2nd FLOOR - FINISHED FLOOR ELEVATION
20.78	1st FLOOR CEILING ELEVATION
12.78	1st FLOOR - FINISHED FLOOR ELEVATION

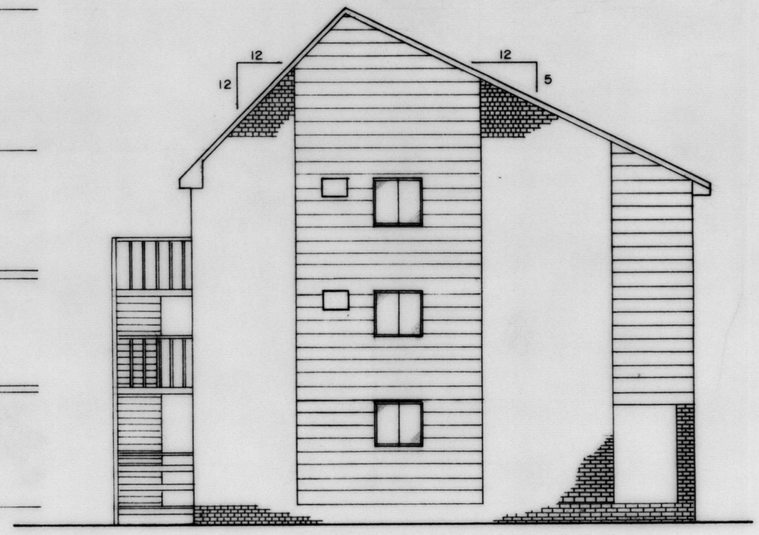

Side View

NOTE

ALL ELEVATIONS SHOWN ARE FEET ABOVE MEAN LOW WATER IN THE ATLANTIC OCEAN AT OCEAN CITY, MD., USING 1929 DATUM.

LAHAINA SHORES CONDOMINIUM (AS BUILT)

LOT 29, BLOCK 9, FENWICK PLAT No. 4
OCEAN CITY, WORCESTER CO., MARYLAND

SCALE: 1/8" = 1'-0"	APPROVED BY:	DRAWN BY: M.T.P.	
DATE: 5/15/82		REVISED: —	

Roscoe & Associates
P.O. Box 562, Ocean City, MD.

ELEVATIONS — DRAWING NUMBER 6 of 6

MSA CSU 2157-5438-6

Maryland State Archives