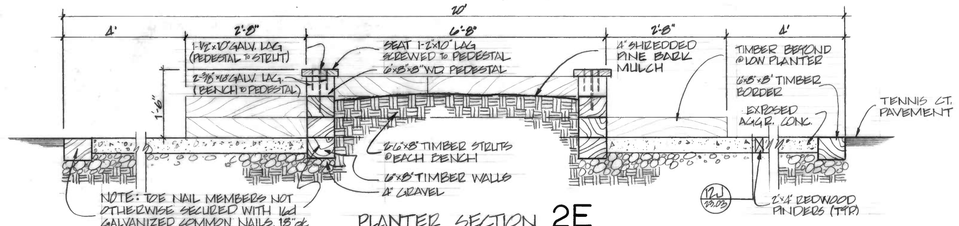

PLANTER SECTION 2E
SCALE: 3/4" = 1'-0"

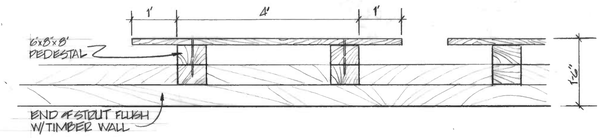

ELEVATION OF BENCH 2N
SCALE: 3/4" = 1'-0"

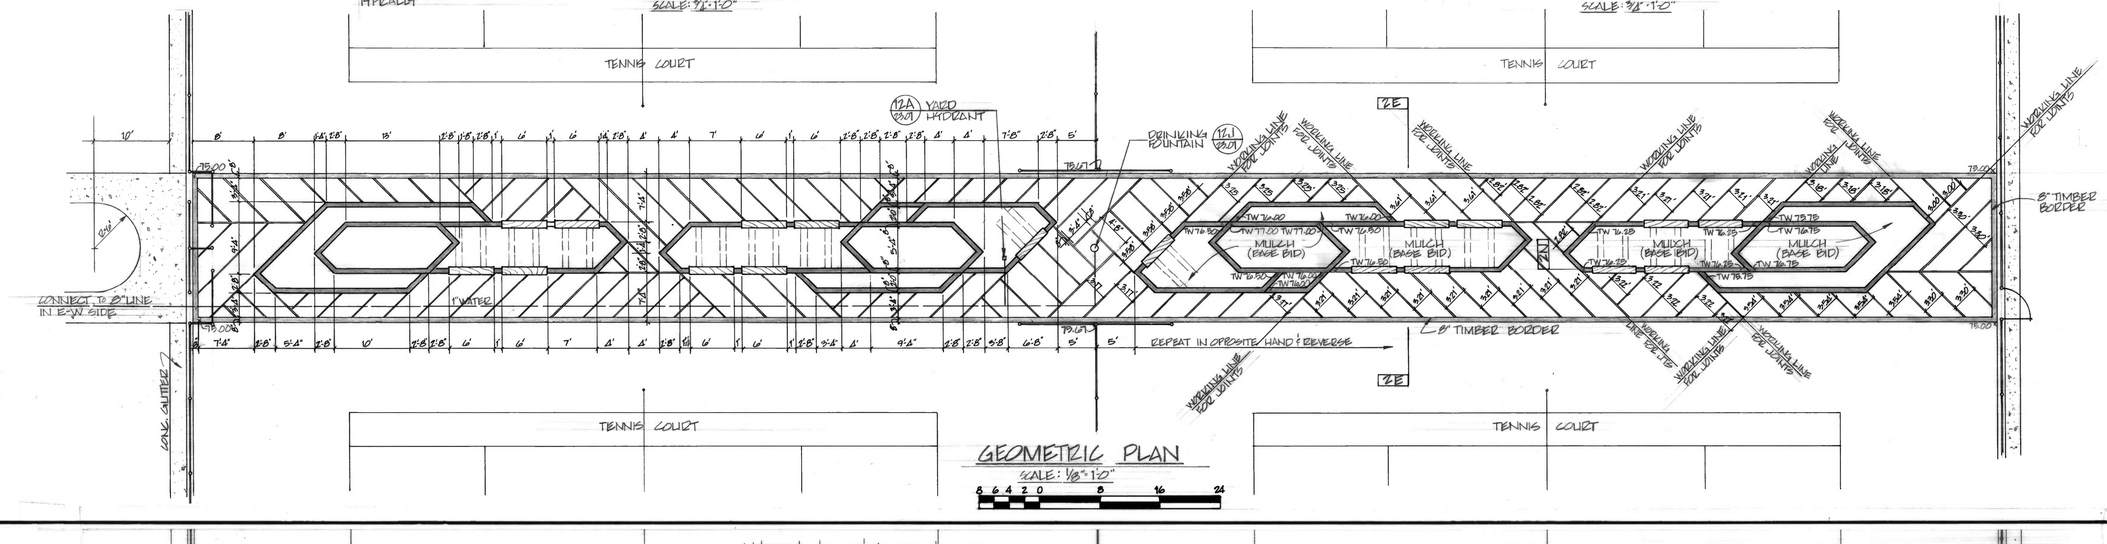

GEOMETRIC PLAN
SCALE: 1/8" = 1'-0"

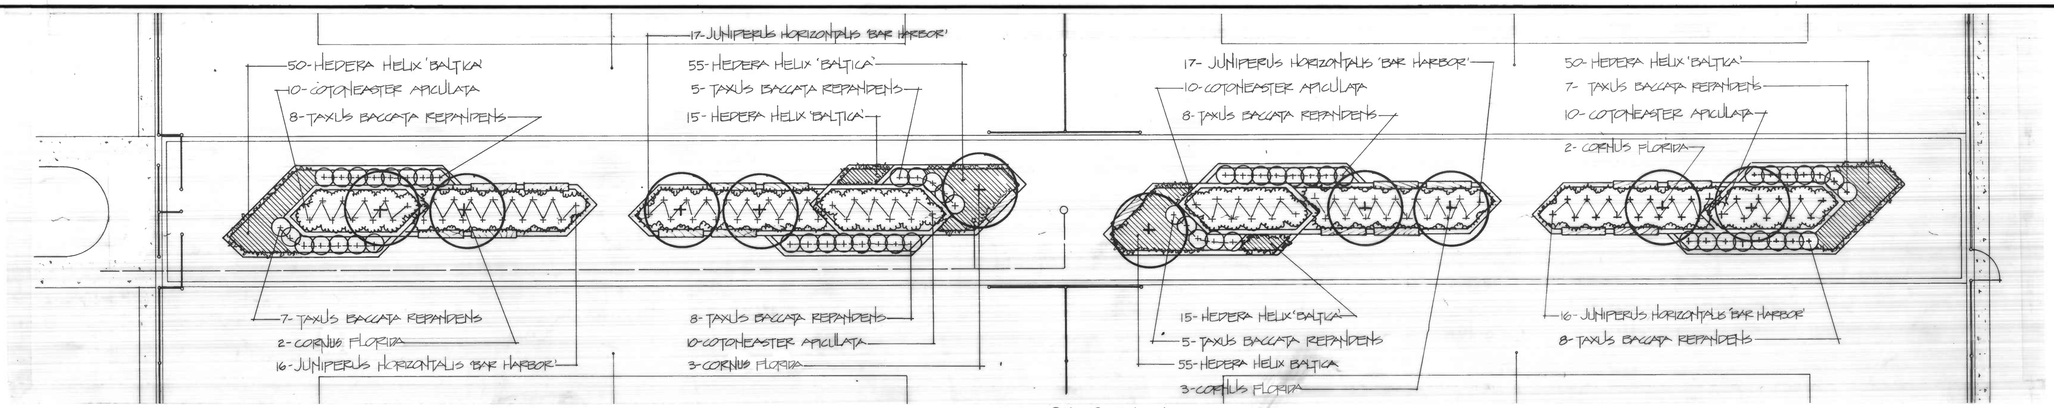

LANDSCAPE PLAN (ALTERNATE "C")
SCALE: 1/8" = 1'-0"

NOTES:
THIN BRANCHES AND FOLIAGE BY 1/3 VOLUME, RETAINING TREE SHAPE. NEVER CUT LEADER. PAINT ALL CUTS OVER 1/2" ϕ W/ APPROVED TREE PAINT.
SET TREE TO ORIGINAL GRADE AT TOPSOIL LEVEL.

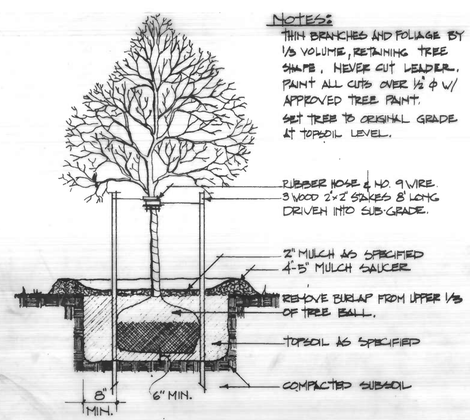

TYPICAL TREE PLANTING

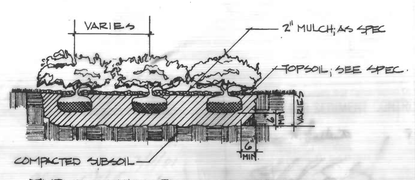

TYPICAL MASS PLANTING - SHRUBS

PLANT LIST (ALTERNATE "C")

QUAN.	BOTANICAL NAME	COMMON NAME	SIZE	CONDITION	REMARKS
	TREES				
10	CORNUS FLORIDA	FLOWERING DOGWOOD	10'-12' Ht.	B & B	HEAVY SPECIMEN
	SHRUBS				
40	COTONEASTER APICULATA	CRANBERRY COTONEASTER	18"-24" SPR.	CONTAINER	
66	JUNIPERUS H. 'BAR HARBOR'	BAR HARBOR JUNIPER	15"-18" SPR.	B & B	
56	TAXUS BACCATA REPANDENS	SPREADING ENGLISH YEW	18"-24" Ht. & SPR.	B & B	
	GROUND COVER				
240	HEDERA HELIX 'BALTICA'	BALTIC IVY	2¼" POTS		PLANT @ 8" O.C.

REVISIONS

NO.	DATE	ITEM	REV.

FIRM: RTKL
DESIGNED BY: RTKL
DRAWN BY: TC
CHECKED BY:
APPROVED BY:
SEAL: STATE OF MARYLAND — PROFESSIONAL ENGINEER

Dundalk Community College

Athletic Fields

RTKL Associates Inc.
Architects & Engineers
The Village Square
Village of Cross Keys
Baltimore, Md.

AS BUILT
APR. 12, 1979

PLANTING STRIP

JOB NO.	75012.00	25.
SCALE	AS SHOWN	
DATE	1 FEB '77	01
LAST REV.		

D-010070