CONSTRUCTION NOTES

Designation on Plans: 1 , etc.

1. Fire alarm annunciator panel location.
2. 1 1/2" o.d. metal pipe handrail. ℄ of handrail 2'-9" above tread nosing.
3. Furniture layout is for permit purposes only. Furniture is N.I.C.
4. Panel operable wall fixed jamb location.
5. Panel operable wall lead jamb location, verify dimension with final fixed jamb location.
6. Low wood capped wall. Top of wall 42" above raised floor.
7. A/V countertop, 42" above raised floor. See det. 12 of sht. A9.4 for construction information.
8. Panel operable wall section, single panel system.

GENERAL NOTES

1. A1 , etc. indicates building accessory item. See sht. A4.3 for construction information.
2. C1 , etc. indicates classroom/conference center accessory item. See sht. A4.4 for construction information.
3. S1 , etc. indicates building signage location. See sht. for construction information.
4. Interior dimensions are to finish face of wall or column centerline unless noted otherwise.
5. See sheets A1.2 thru A1.4 for construction types. Designation on plan: 1A 04 , etc.

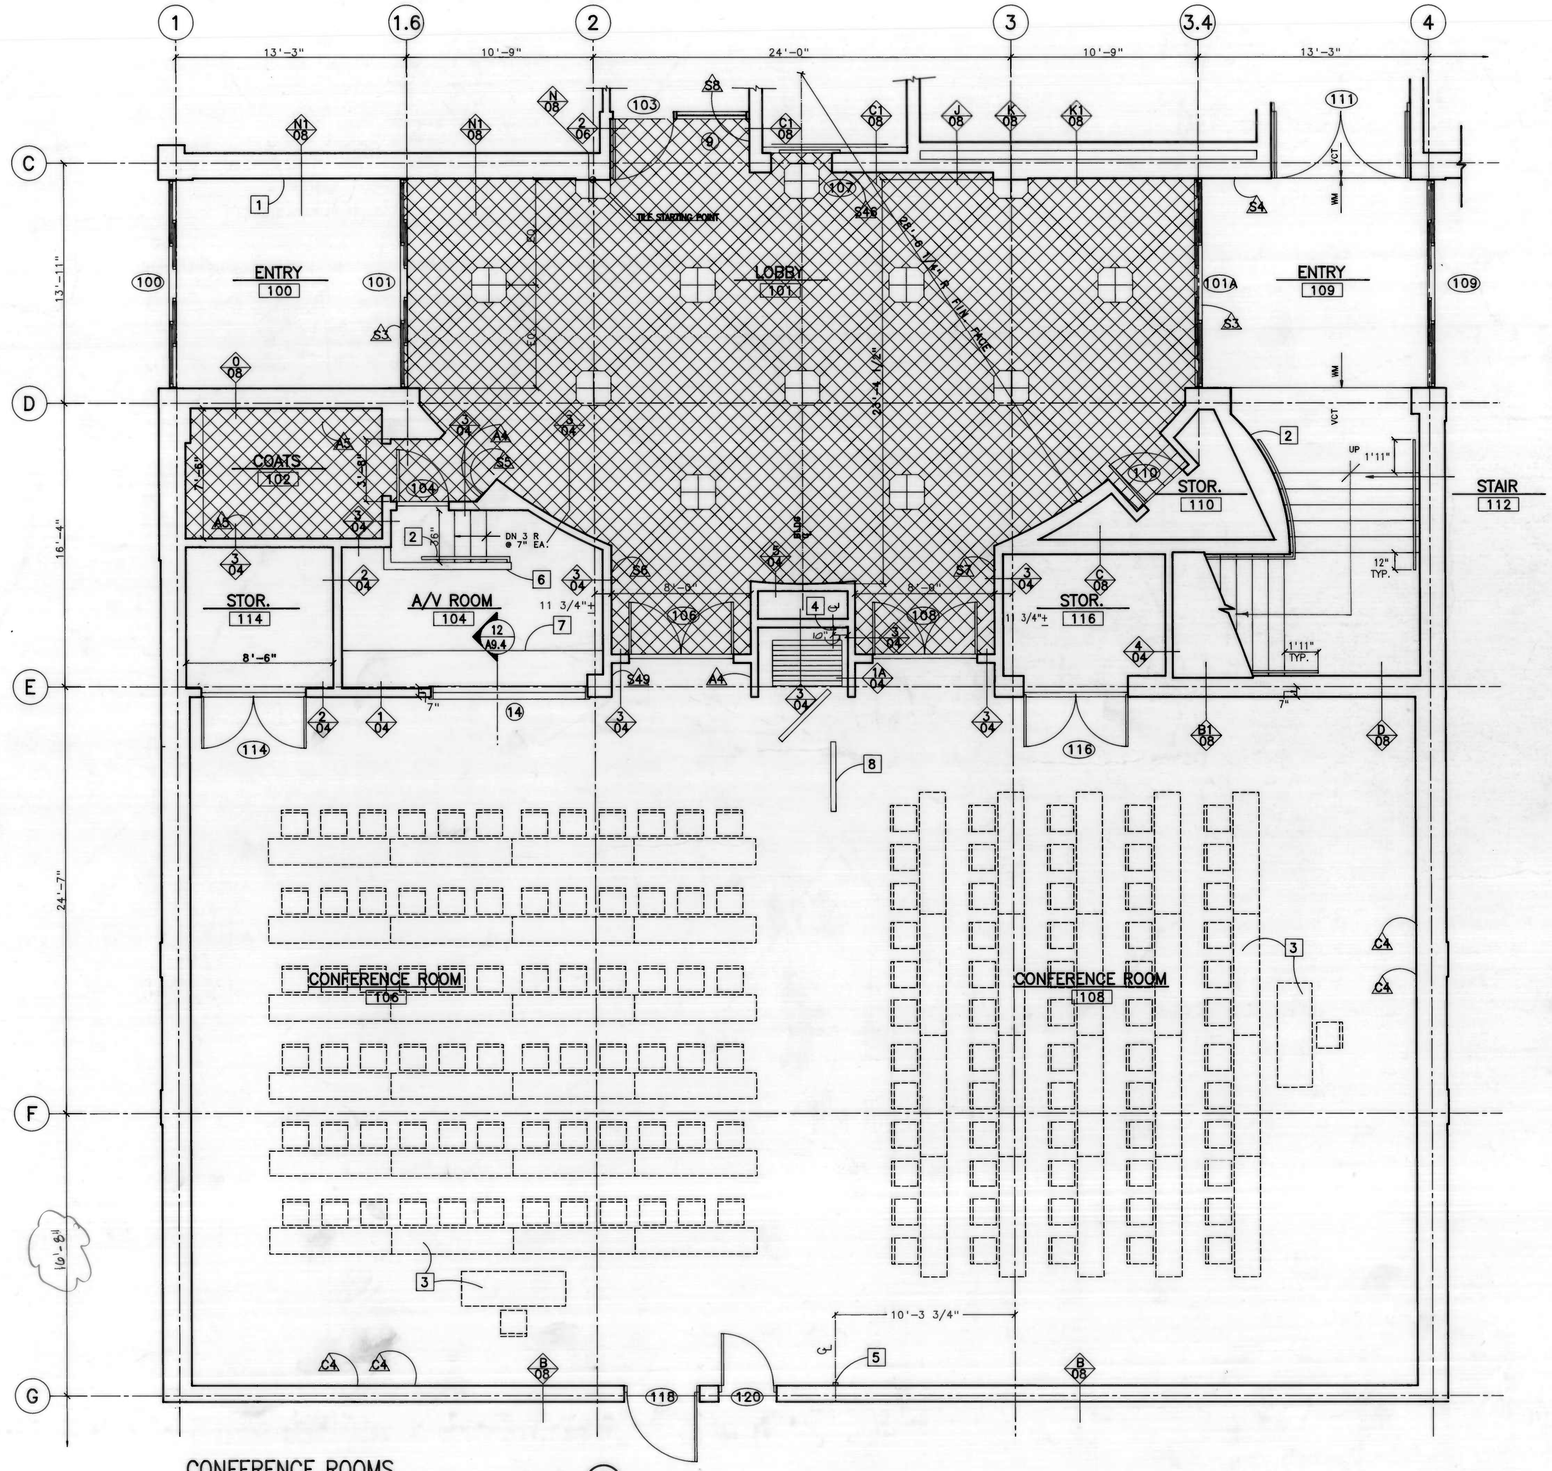

CONFERENCE ROOMS

SCALE: 1/4"=1'-0"

21 JUNE 90

BUSINESS INDUSTRIAL EDUCATION CENTER

DUNDALK COMMUNITY COLLEGE

7200 SOLLERS POINT RD.
DUNDALK, MD. 21222-4692

CONSULTANTS

CIVIL ENGINEER
WHITNEY BAILEY COX MAGNANI
1850 YORK RD.
TIMONIUM, MD. 21093

STRUCTURAL ENGINEER
WHITNEY BAILEY COX MAGNANI
1850 YORK RD.
TIMONIUM, MD. 21093

MECHANICAL/ELECTRICAL
SPEARS/VOTTA & ASSOC.
75 ANFORD RD.
BALTIMORE, MD. 21234

INTERIOR DESIGNER

LANDSCAPE ARCHITECT

Schamu Machowski Doo & Associates
Architects
107 East Preston Street
Baltimore Maryland 21202
(301)685-3582

THESE DRAWINGS ARE NOT FOR CONSTRUCTION UNTIL SIGNED.

ALL DRAWINGS SPECIFICATIONS AND RELATED DOCUMENTS ARE THE COPYRIGHT PROPERTY OF THE ARCHITECT AND MUST BE RETURNED UPON REQUEST. REPRODUCTION OF DRAWINGS, SPECIFICATIONS AND RELATED DOCUMENTS IN PART OR WHOLE IS FORBIDDEN WITHOUT THE ARCHITECT'S WRITTEN PERMISSION.

REVISIONS
1 BID SET 6/18/90

RECORD SET BASED ON INFORMATION RECEIVED FROM THE CONTRACTOR

SUBSTANTIAL COMPLETION DATE
6 December, 1992

SCALE
1/4" = 1'-0"

JOB NO.
89038

TITLE 1/4" SCALE PLAN
CONFERENCE ROOMS

SHEET NO.
A4.5

D-013225