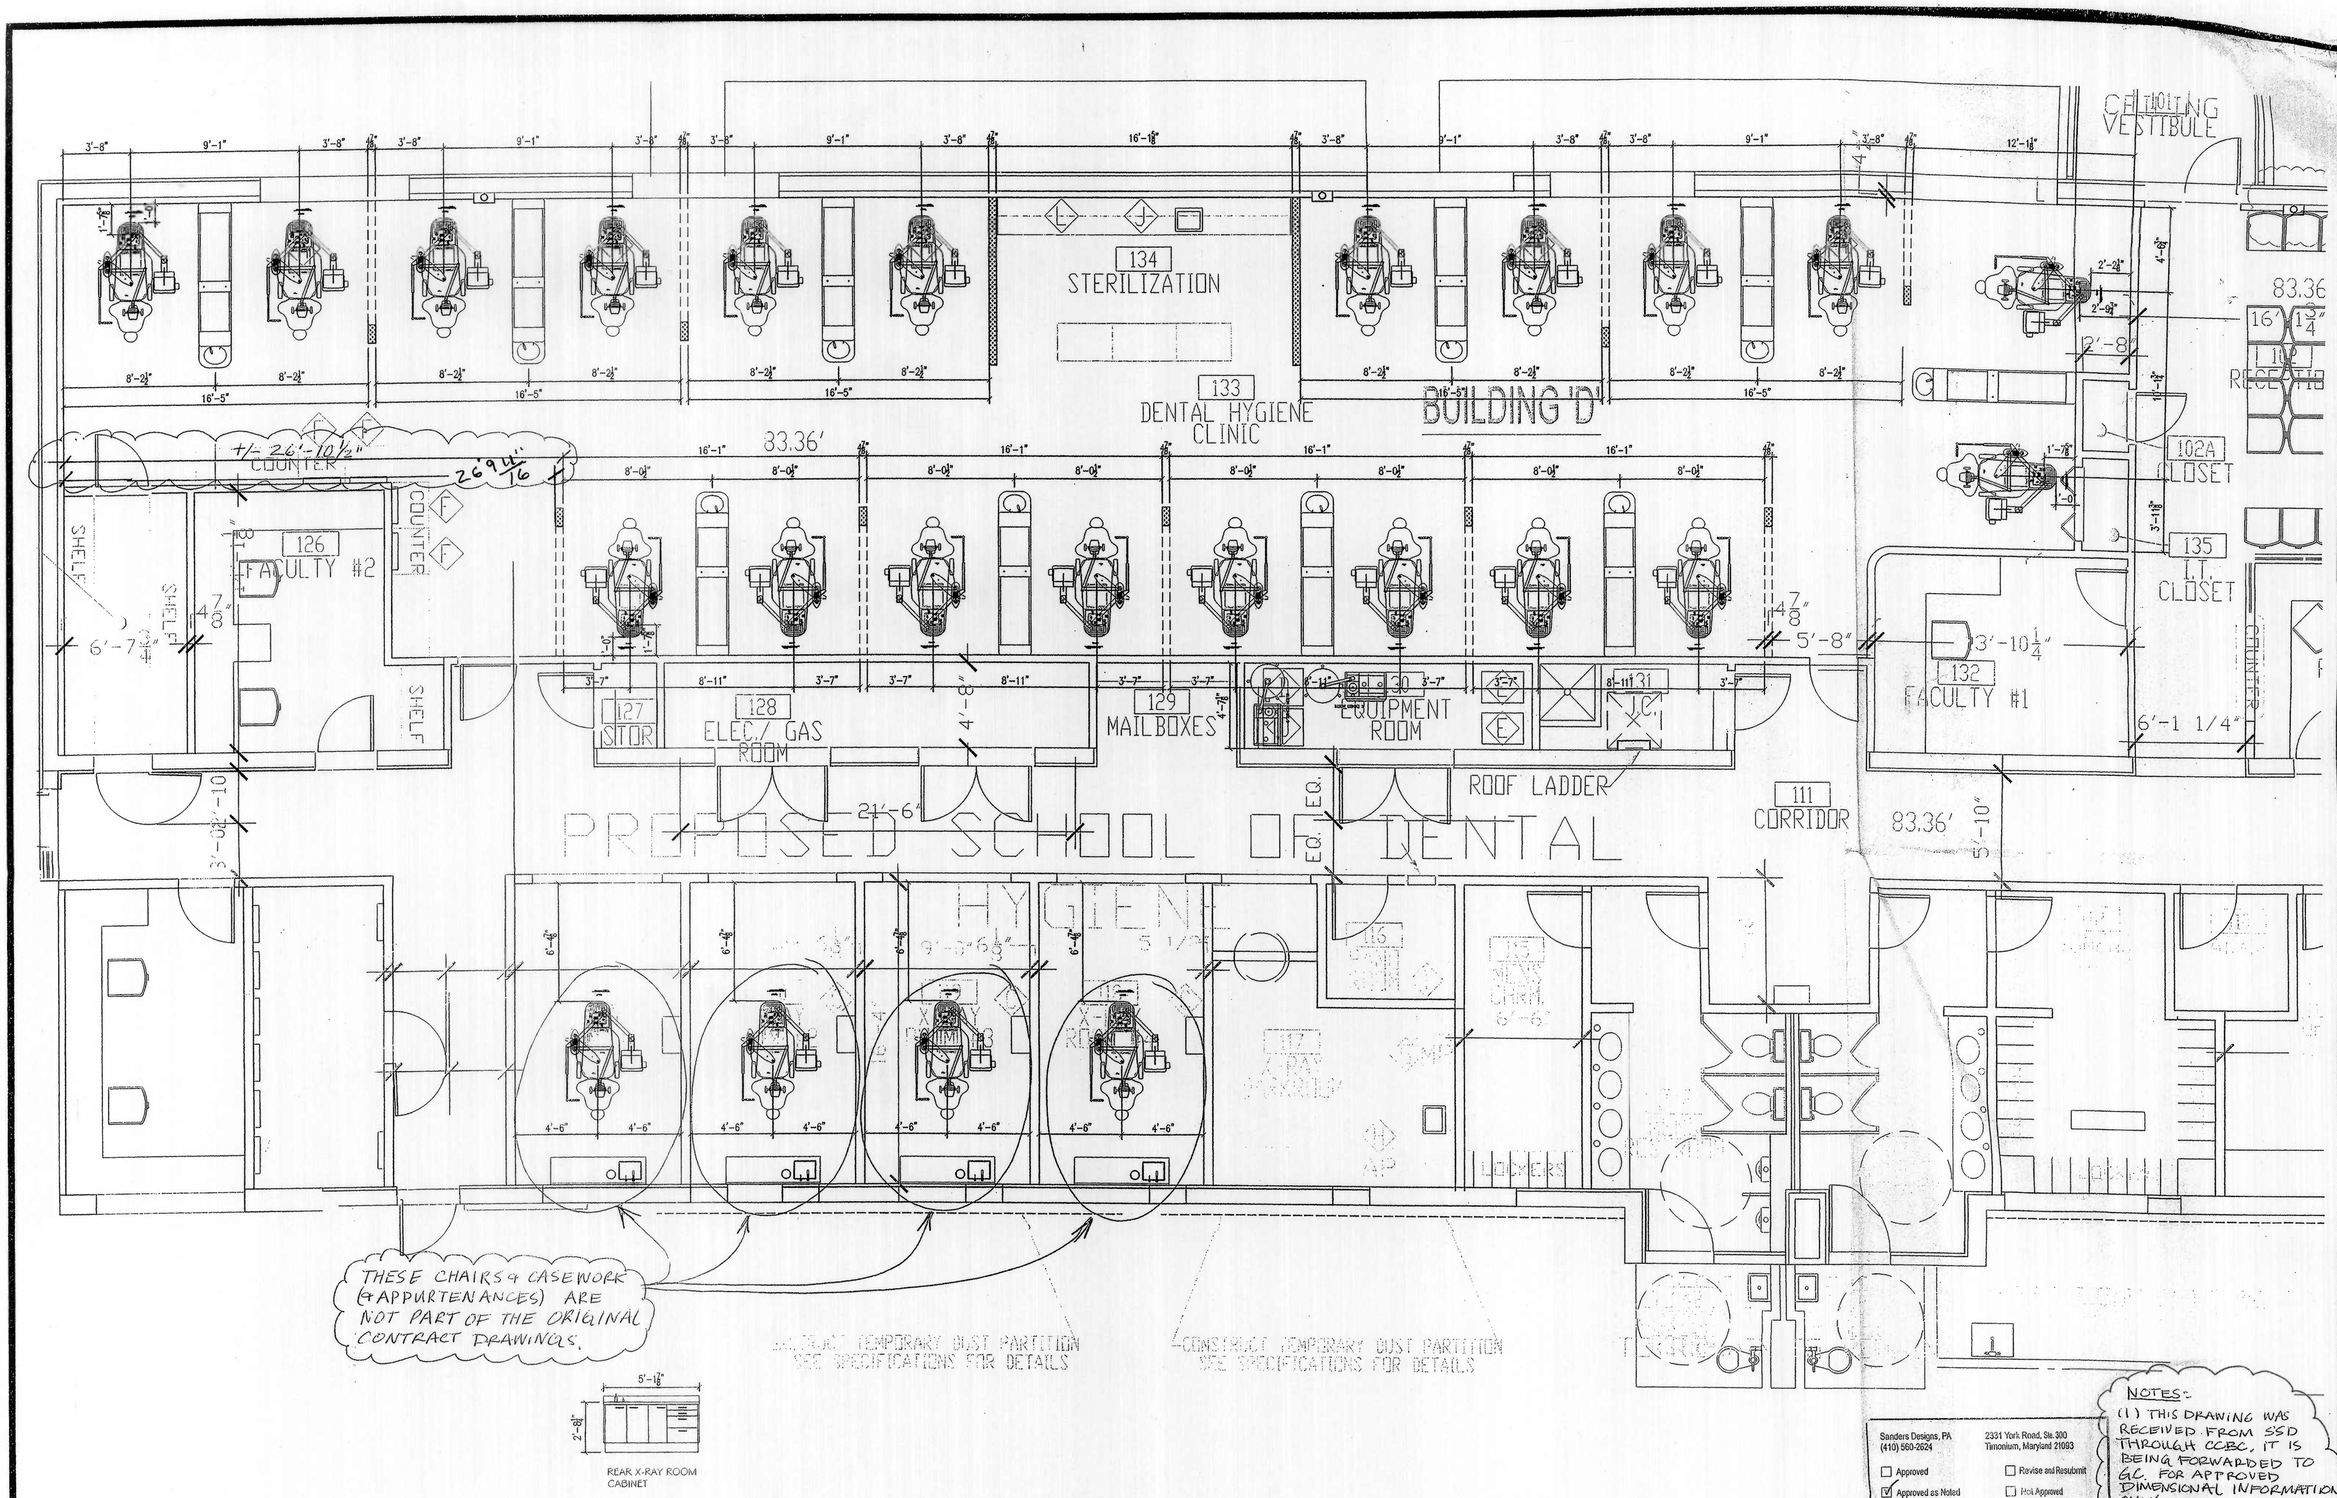

PROPOSED DENTAL LAYOUT

1/4"= 1'-0"

Sanders Designs, PA
(410) 560-2624
2331 York Road, Ste 300
Timonium, Maryland 21093

☐ Approved
☑ Approved as Noted
☐ Revise and Resubmit
☐ Not Approved

Reviewing is only for conformance with the design concept of the Project and compliance with the information given in the Contract Documents. The contractor is responsible for dimensions to be confirmed and correlated at the site; for information that pertains solely to the fabrication processes or to the means, methods, techniques, sequences and procedures of construction; and for coordination of the Work of all trades.

By [illegible] Date 9-18-07

NOTES:
(1) THIS DRAWING WAS RECEIVED FROM SSD THROUGH CCBC, IT IS BEING FORWARDED TO GC FOR APPROVED DIMENSIONAL INFORMATION ONLY.
(2) DENTAL CHAIRS AND DENTAL CASEWORK ARE TO BE PROVIDED BY OTHERS

RECEIVED
SEP 18 2007
SANDERS DESIGNS Architects

D-029340

© 2007 by SULLIVAN-SCHEIN

Sullivan-Schein
A HENRY SCHEIN COMPANY
Everything Dental

PROJECT: COMMUNITY COLLEGE OF BALTIMORE
LOCATION:

SULLIVAN-SCHEIN REP: MIKE DUVALL
CENTER: CITY, STATE
PHONE #: (800) 645-6594

-IMPORTANT NOTE-
THIS DOCUMENT HAS BEEN PREPARED AS AN INSTRUMENT OF PROFESSIONAL SERVICE, AND IS NOT AN ARCHITECTURAL PLAN. THE IDEAS/ DESIGNS INCLUDED HEREIN ARE THE SOLE PROPERTY OF SULLIVAN-SCHEIN, AND ARE PROTECTED UNDER COPYRIGHT. THEY MAY NOT BE USED OR REPRODUCED WITHOUT EXPRESSED WRITTEN CONSENT OF SULLIVAN-SCHEIN AND FULL PAYMENT OF ANY ASSOCIATED DESIGN FEES.
ALL DIMENSIONS ARE SUBJECT TO JOB-SITE VERIFICATION.

DRAWING NAME: DRAWING
PROJECT START DATE: 00/00/0000
DETAIL START DATE: 00/00/0000
DRAWN BY: TJK
DETAILED BY: ---
CHECKED BY: ---

REVISIONS:
--/--/-- ---
--/--/-- ---
--/--/-- ---
--/--/-- ---
--/--/-- ---
--/--/-- ---
INT.SQ.FT.= 0000.SF

SCALE: 1/4"=1'-0"
SHT. SIZE: D
FLOOR PLAN
SA.0