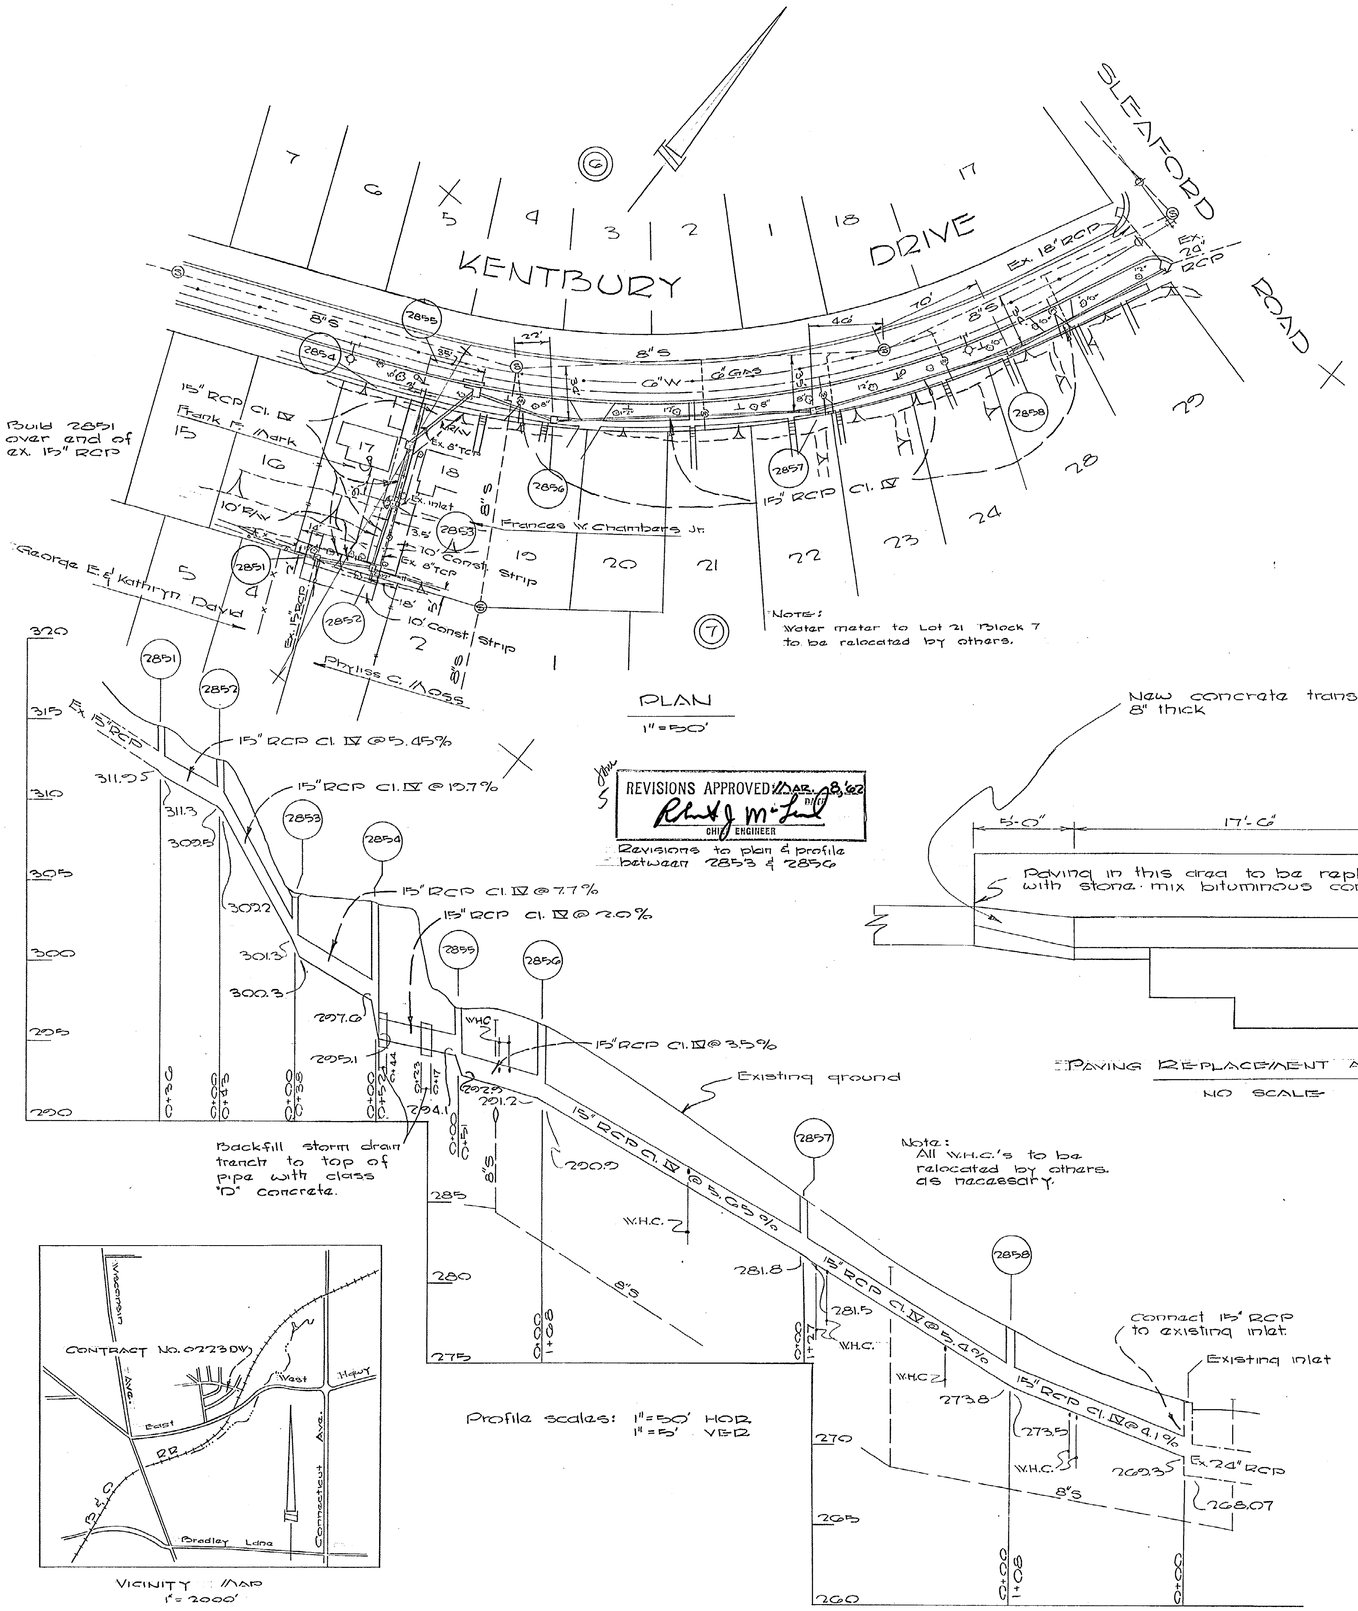

REVISIONS APPROVED MAR. 8, '62
CHIEF ENGINEER
Revisions to plan & profile between 2853 & 2856

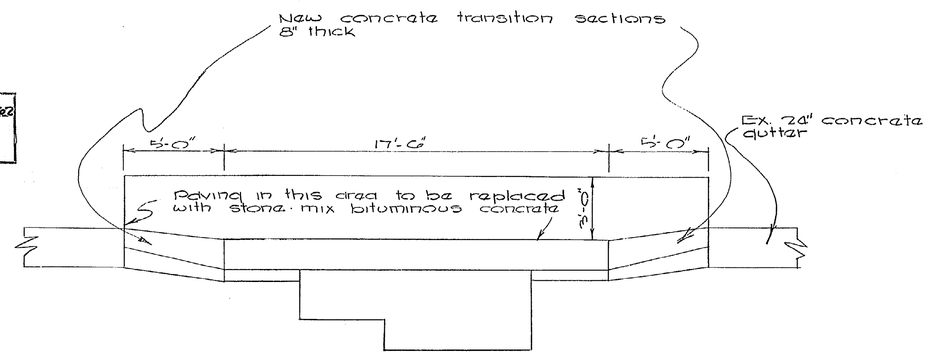

PAVING REPLACEMENT AT INLET
NO SCALE

VICINITY MAP
1"=2000'

GENERAL NOTES

1. Information concerning underground utilities was obtained from available records, but the contractor must determine the exact location and elevation of the mains by digging test pits by hand at all utility crossings well in advance of trenching.
2. Adjustments or repair to utilities damaged as a result of the contractors negligence or method of operation must be made at his expense.
3. All utilities to be moved by others as required to clear work under this contract.
4. All pipe elevations shown are invert elevations.
5. Top elevations of structures shall be adjusted in the field to meet existing conditions.
6. Completely remove existing inlet adjacent to 2853

BENCH MARKS

DTP #26624 Elev. 305.95
North P.C. of concrete doorstep @ back door of house #4318 on S. side of Kentbury Drive 700'± S.W. of Sleaford Road.

DTP #26625 Elev. 299.22
Nail & washer in N.E. side of Pepco pole #629808 on the S. side of Kentbury Drive 700'± S.W. of Sleaford Road.

DTP #26626 Elev. 281.37
Nail & washer in N.W. side of Pepco pole #629811 on S. side of Kentbury Drive 250'± S.W. of Sleaford Road.

STRUCTURE SCHEDULE			
No.	Type	Top	Remarks
2851	B-48	314.5	W.S.S.C. Manhole
2852	B-48	312.4	" "
2853	E	303.9	W.S.S.C. Inlet
2854	B-48	303.4	W.S.S.C. Manhole
2855	B-10	296.9 / 296.7	W.S.S.C. Inlet
2856	B-48	296.2	W.S.S.C. Manhole
2857	B-48	284.8	" "
2858	B-48	277.1	" "

EXAMINED FOR		
R/W Req'd	[illegible]	12/8/61
WATER & SEWER	[illegible]	12/8/61
OTHER UTILITIES	[illegible]	12/8/61

SUPERVISION
FOR MAIN LINES ONLY
REQ'D BY
DEPT. OF STATE FORESTS & PARKS-BALTO., MD.

REVISIONS	
DATE	DESCRIPTION
3/6/62	Plan & Profile revisions
4/3/62	Addition of conc. backfill

CONTRACT No. 0223DW

DRAWN	WASHINGTON SUBURBAN SANITARY COMMISSION	APPROVED DECEMBER 8, 1961 DATE		STORM	SEWER
TRACED			AUTHOR.	8-3-	61
CHECKED					
EXAMINED					
STARTED			JOB NO.	61DW	5354

CONTRACT No. 0223DW

CHEVY CHASE DISTRICT
STORM DRAIN
KENTBURY DRIVE, MEADOWBROOK VILLAGE

DRAWING NO. 1 OF 1

SCALE AS SHOWN

209NW4
611664
Y
18NW8-2

RELEASED 12-11-61

E-11 6-53 5C

CE 487-208 -1

SD FILE NO. 209