WCL 92/17

Maryland State Archives

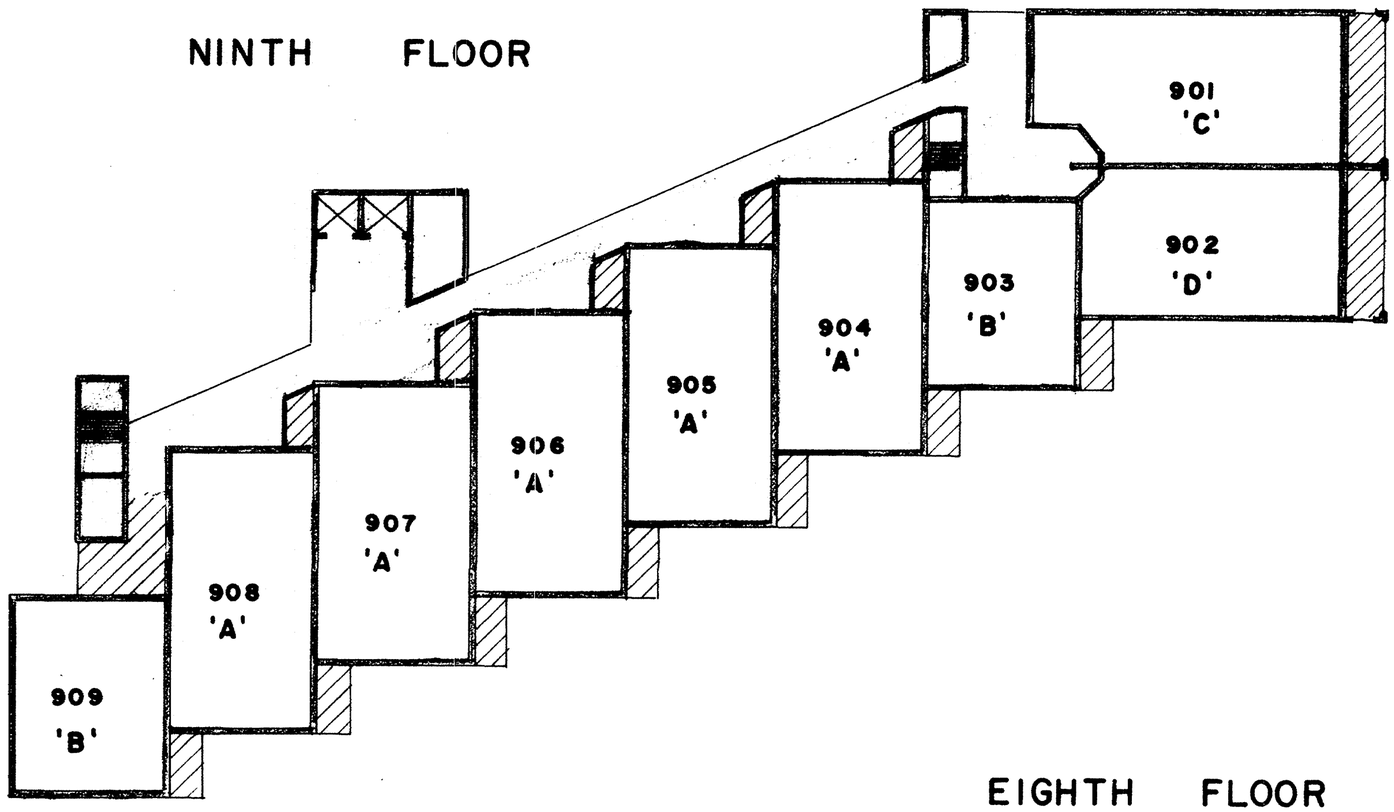

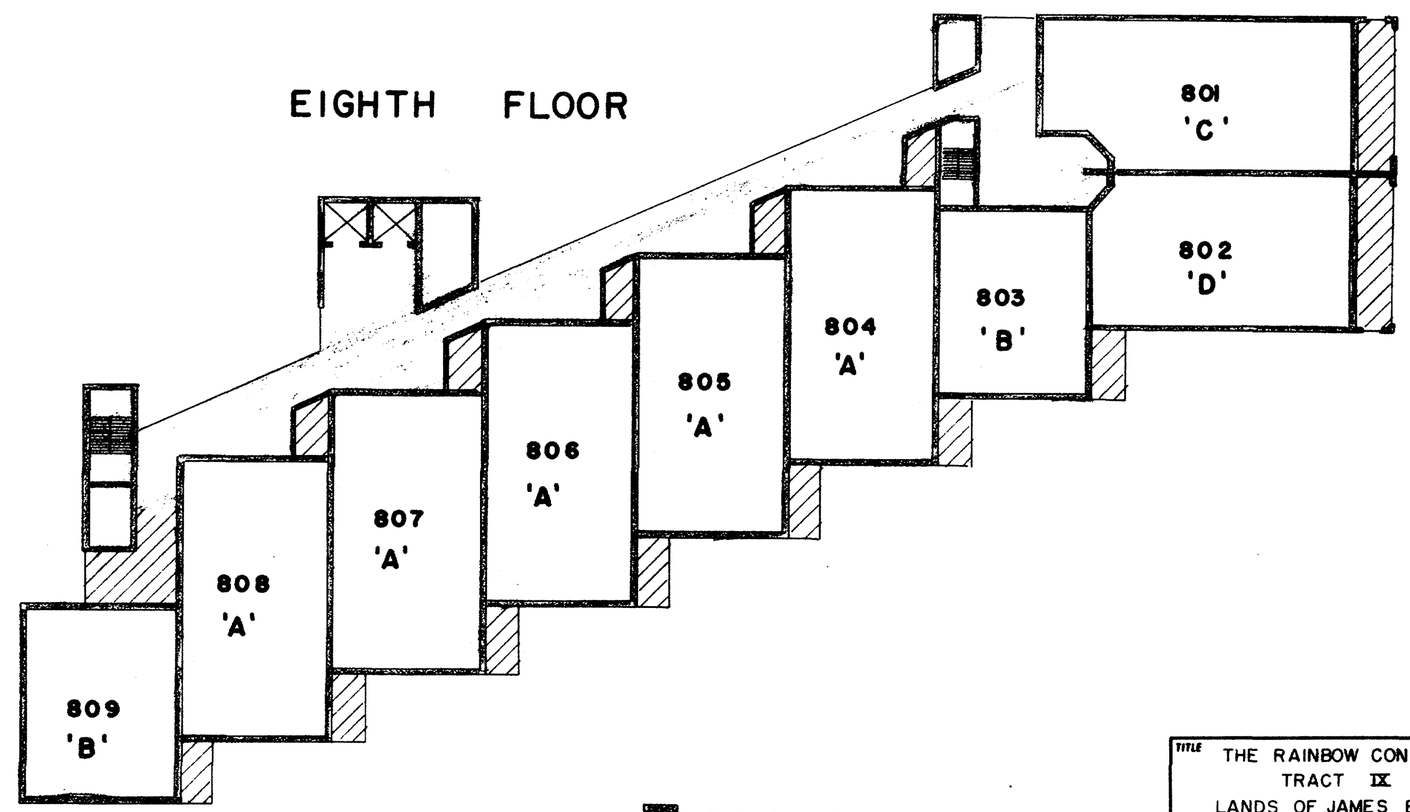

Denotes General Common Element
Denotes Limited Common Element
Denotes Unit Element

1" = 20'

TITLE THE RAINBOW CONDOMINIUM
TRACT IX
LANDS OF JAMES B. CAINE
OCEAN CITY, WOR. CO., MARYLAND

REFERENCE AS BUILTS

NORMAN R. JONES, INC.
OCEAN CITY MARYLAND
APPROVED BY
Norman R. Jones, Pres.
Md. R.P.L.S. No. 10E-9

SURVEYED	
DRAWN	RBJ
CHECKED	
DATE	June, 84
FILE	Patt
SHEET 8 OF	

Md MA 47625-8

MSA SSA 1257 8500-8

DATAPRINT N34149