FIFTH FLOOR PLAN

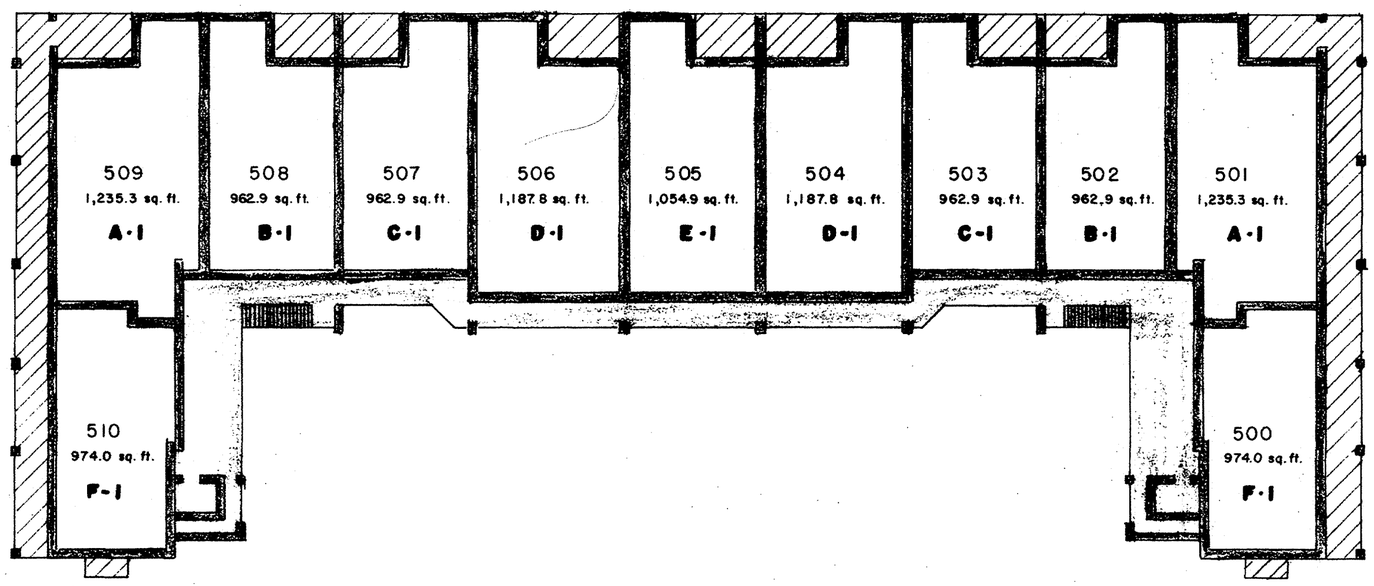

1" = 20'

Denotes General Common Element
Denotes Limited Common Element
Denotes Unit Element

TITLE SURFS EDGE CONDOMINIUM
LOTS 1-5, BLOCK 32
OCEAN BAY CITY
OCEAN CITY, WOR. CO., MARYLAND

REFERENCE AS-BUILTS

NORMAN R. JONES, INC.
OCEAN CITY, MARYLAND

SURVEYED	
DRAWN	RBJ
CHECKED	
DATE	June, 84
FILE	
SHEET	8 OF 9

Md HR 47631-8

MSA SSU 1257 8528-8

Maryland State Archives