Form 6 HPS (Rev. 1961)

ROAD INVENTORY SHEET

Party Chief F. SETTI
Recorder T. LANDON
Chainman

T. LANDON
F. [illegible]
VERIFIED
10/75

Road No. 0020
Name ACADEMY ST
Sheet No. 1 OF 1
Date 6-4-65
County DORCHESTER

CAMBRIDGE

CAT MUN 0 60 ST. 0510

MUN 0980 (MUSE ST) 0 55 MUN ST 0905 40'

0 53 WITHART ST

SPUR 0 52 SPUR 002/167 J C-C

SPUR 0 50 22'J C-C

MUN. PKG LOT 0970 0 45 MUN

MUIR 0 38 0470 MUN ST

Cambridge

20'G C-C

19.5'G C-C

N

0860 MUN LIGHT ST 0 13

17'G 22'CW

0 07 15'

MO WASHINGTON 0 00 16.393 ST

Form 6 HPS (Rev. 1961)

ROAD INVENTORY SHEET

Party Chief F. SETTI T. LANDON
Recorder T. LANDEN
Chainman

Road No. 0020
Name ACADEMY ST
Sheet No. 1 OF 1
Date 6-A-65
County DORCHESTER

10/27/65

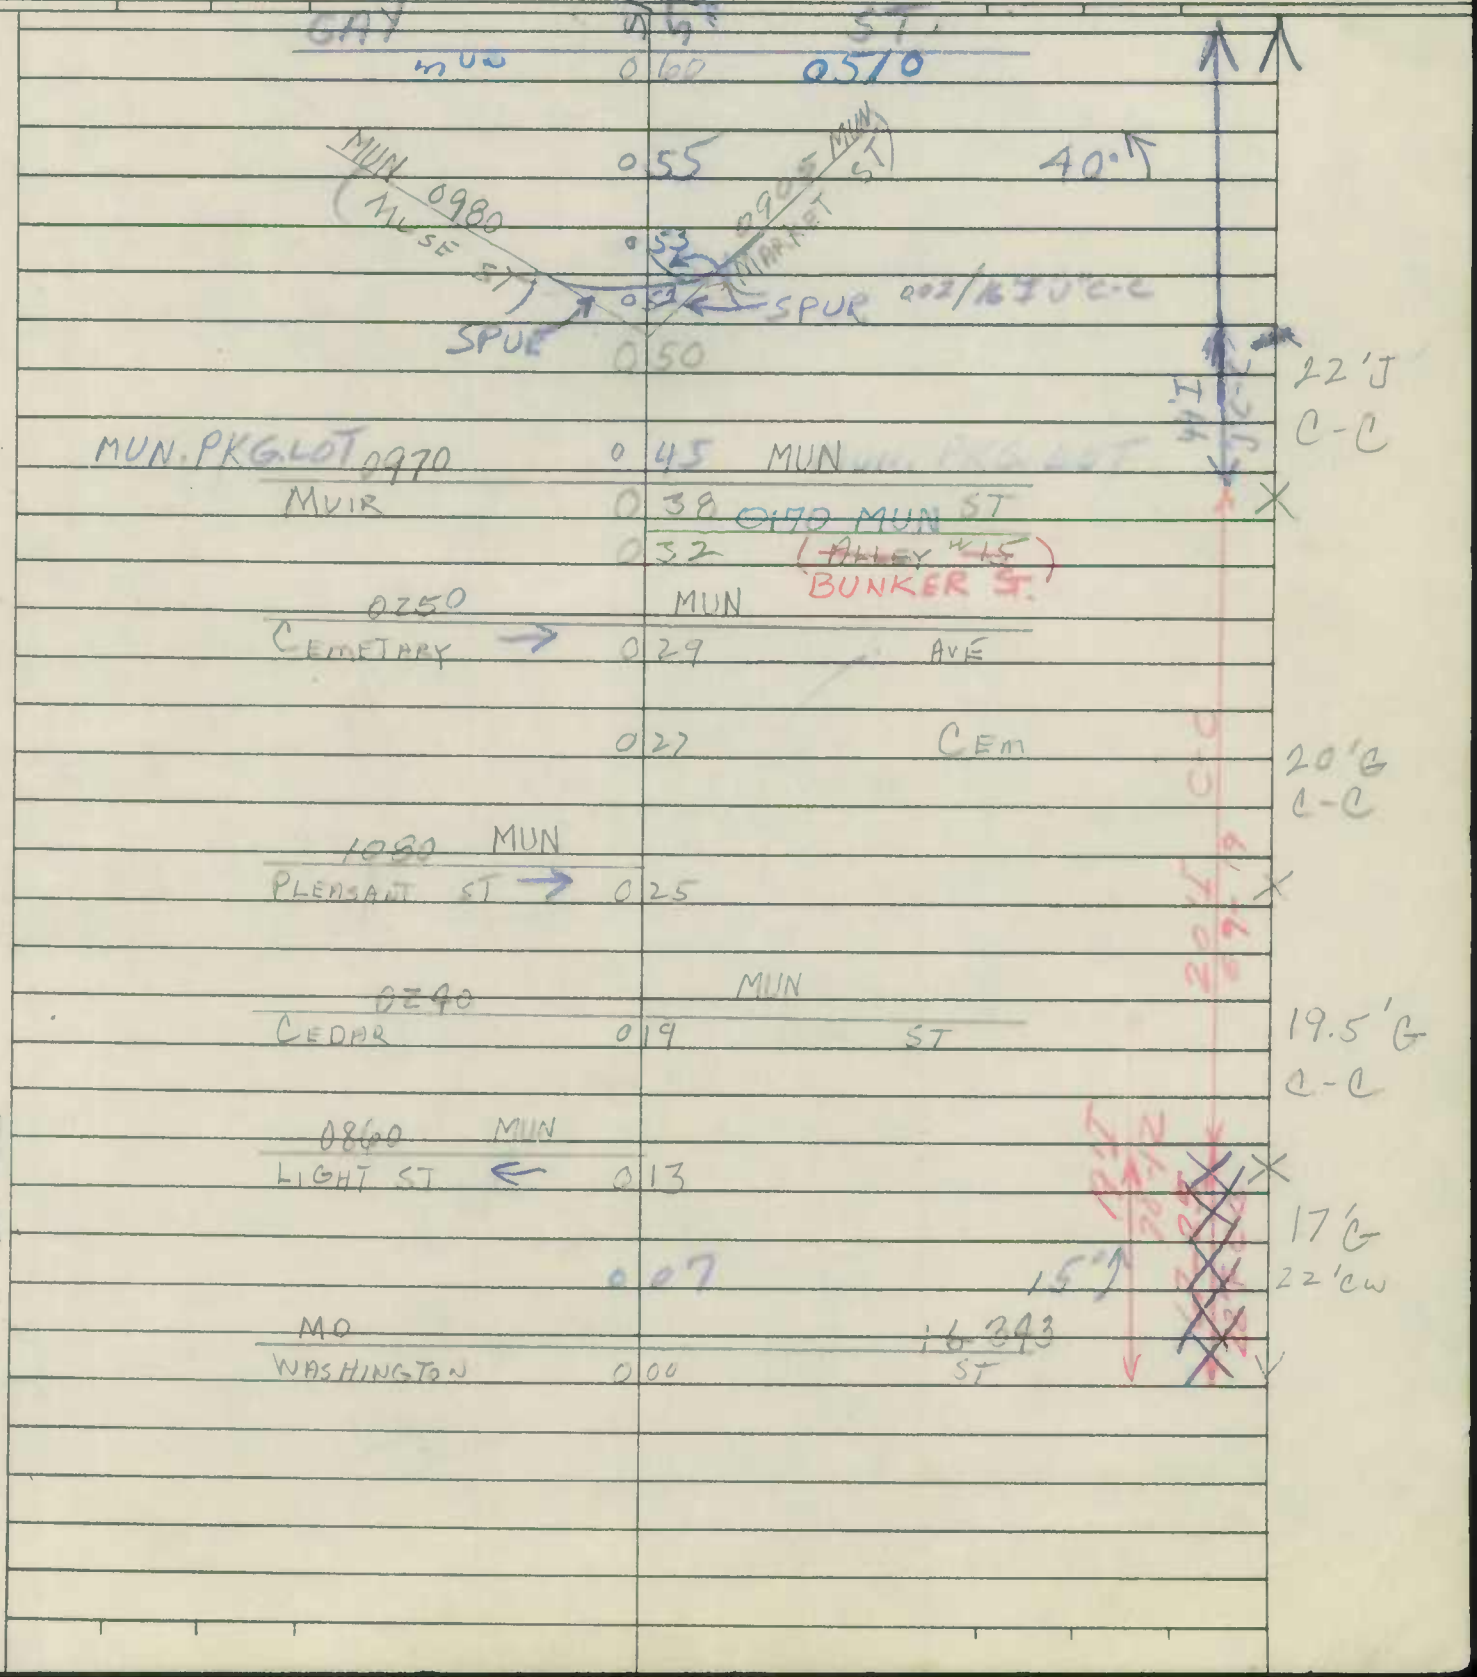

Form 6 HPS (Rev. 1961)

ROAD INVENTORY SHEET

Party Chief F. S.
Recorder C.F.
Chainman T.L.

T. LANDON
F. HOLMES
VERIFIED
10/17/75 BRIDGE

Road No. 0070
Name AURORA ST
Sheet No. 1 of 1
Date 5-28-65
County DOR

~~Road~~	~~END~~		
~~0 38~~			
	D	E	
CUL	0 35	SAG	NURSES Home
ENT. Hospital	0 33		
0190			
BYRNE	0 29	ST	
8100		8060	
AL # 10	0 25	AL # 6	
0910			
MARYLAND	0 21	AVE	
8080		8070	
ALLEY # 8	0 17	ALLEY # 7	
0660			
HENRY	0 14	ST	
	0 11	ALLEY # 22 8220	
0820			
LECOMPTE	0 07	ST	
~~CUL DE SAC~~	~~0 01~~		
~~Fletcher~~	0 00		
ROAD	END AVENUE		

33'G C-C
30'G CURB LT
37'G C-C
39.5'G C-C
30'F 40'CW

SHA 51.3-8
11-15-72

STATE HIGHWAY ADMINISTRATION OF MARYLAND 93-3 A/T

T. LANDON
RHOLES
F. VERIFIED
75

ROAD INVENTORY SHEET

Party Chief F. SETTAN
Recorder C. FORREST
Helper

Map No. I15

Road No. 0090
Road Name BAYLY AVE
Sheet No. 1 OF 1
Date 4-30-65 3-8-71
County DORCHESTER
State Coordinates

CAMBRIDGE 2035

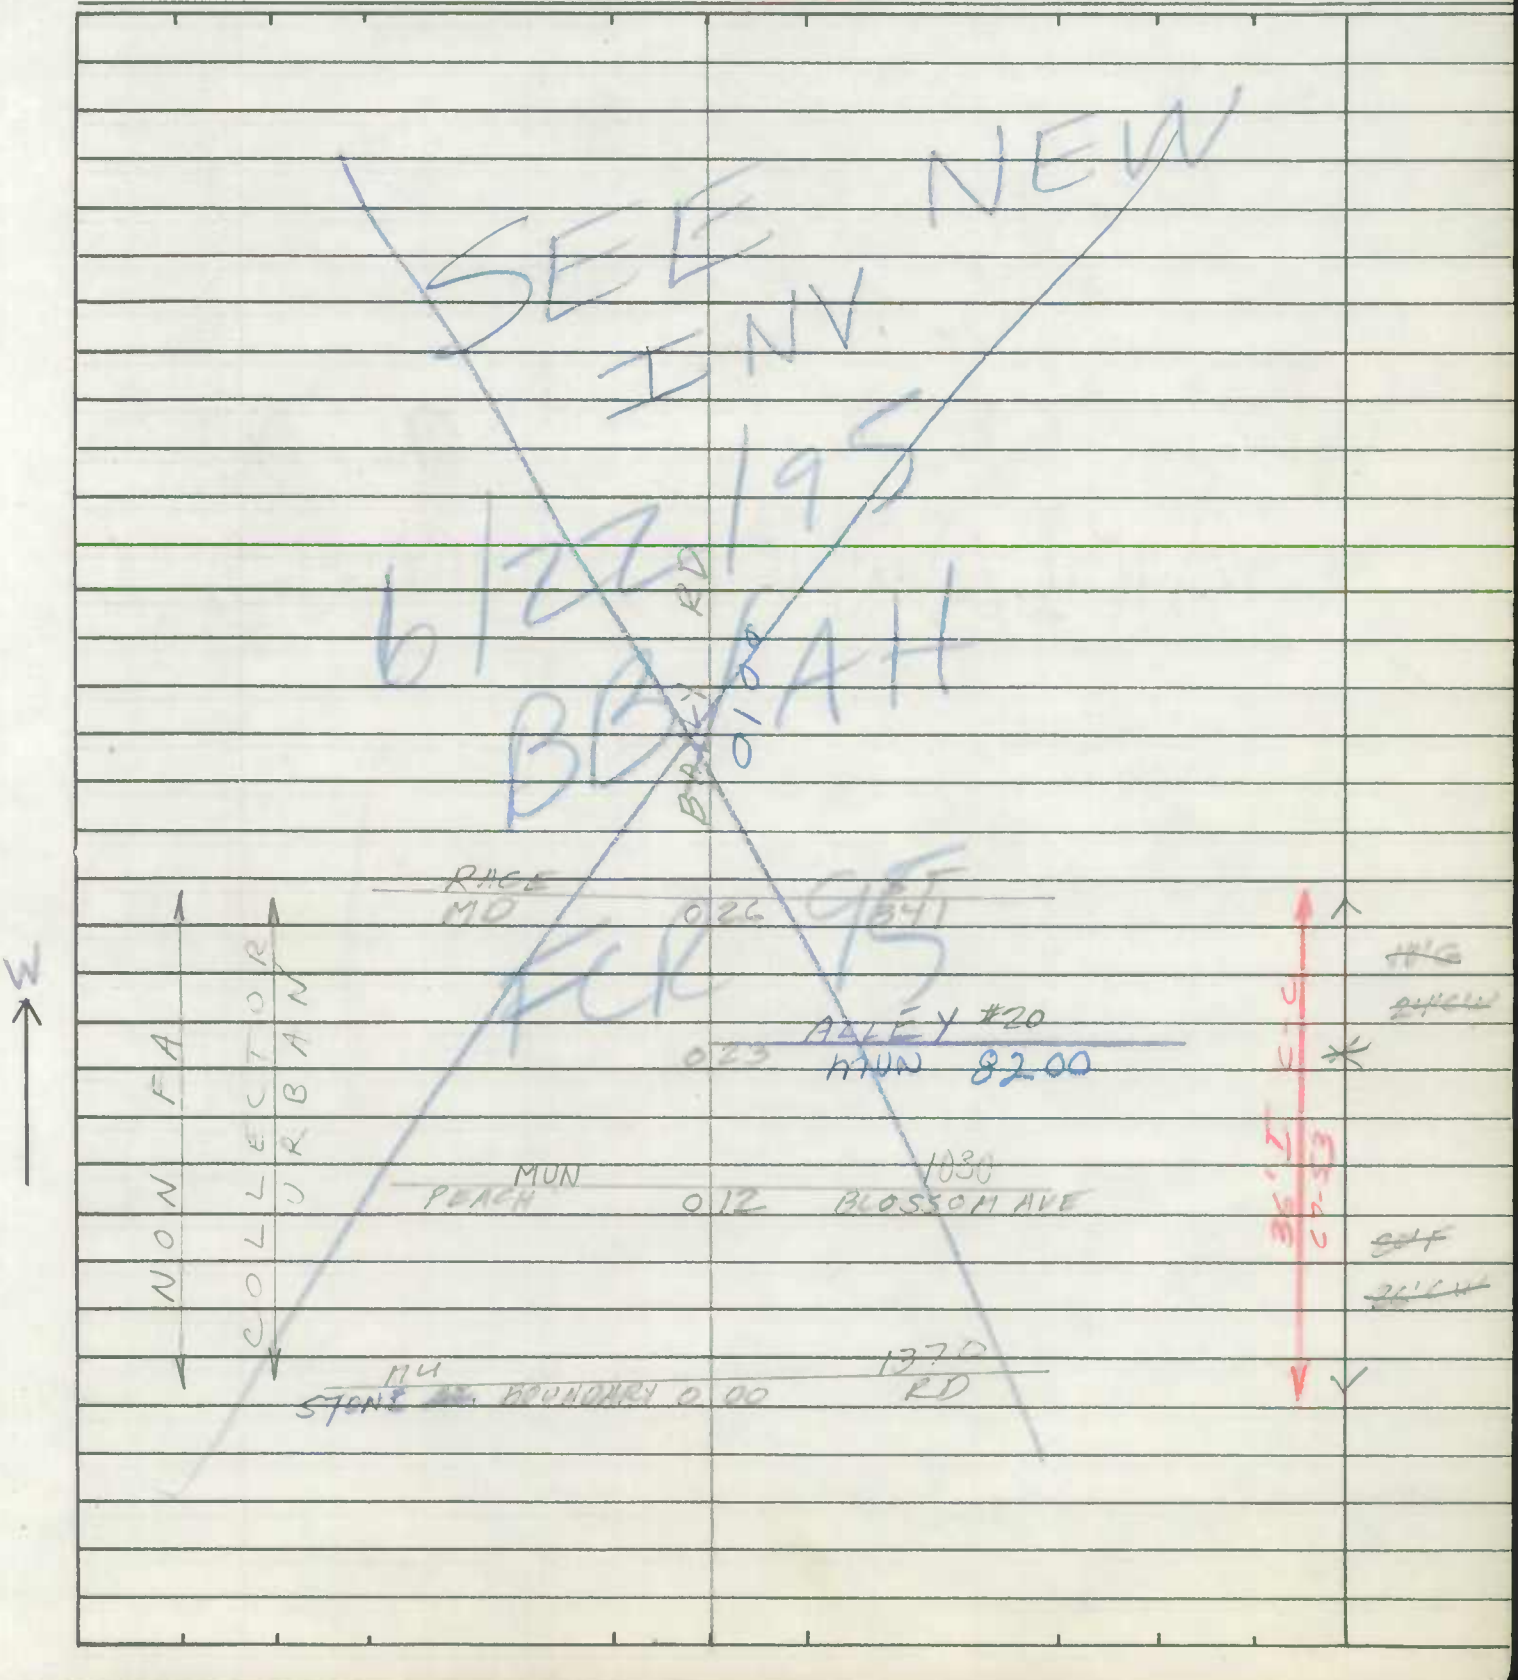

SHA 51.3-8
11-15-72

ROAD INVENTORY SHEET

Road No. _____
Road Name _____
Sheet No. _____
Date _____
County _____
State Coordinates _____

SHA 51.3-8
11-15-72

STATE HIGHWAY ADMINISTRATION OF MARYLAND

Cambridge

ROAD INVENTORY SHEET

T. LANDON
F. KHOLES
VERIFIED

Party Chief F. SUTTAN
Recorder C. FORREST
Helper

Map No. I15

Road No. 0100
Road Name BAYLY RD
Sheet No. 10F2
Date 4-30-65 4-21-65
County DORCHESTER Co
State Coordinates 242 10F4

81-13

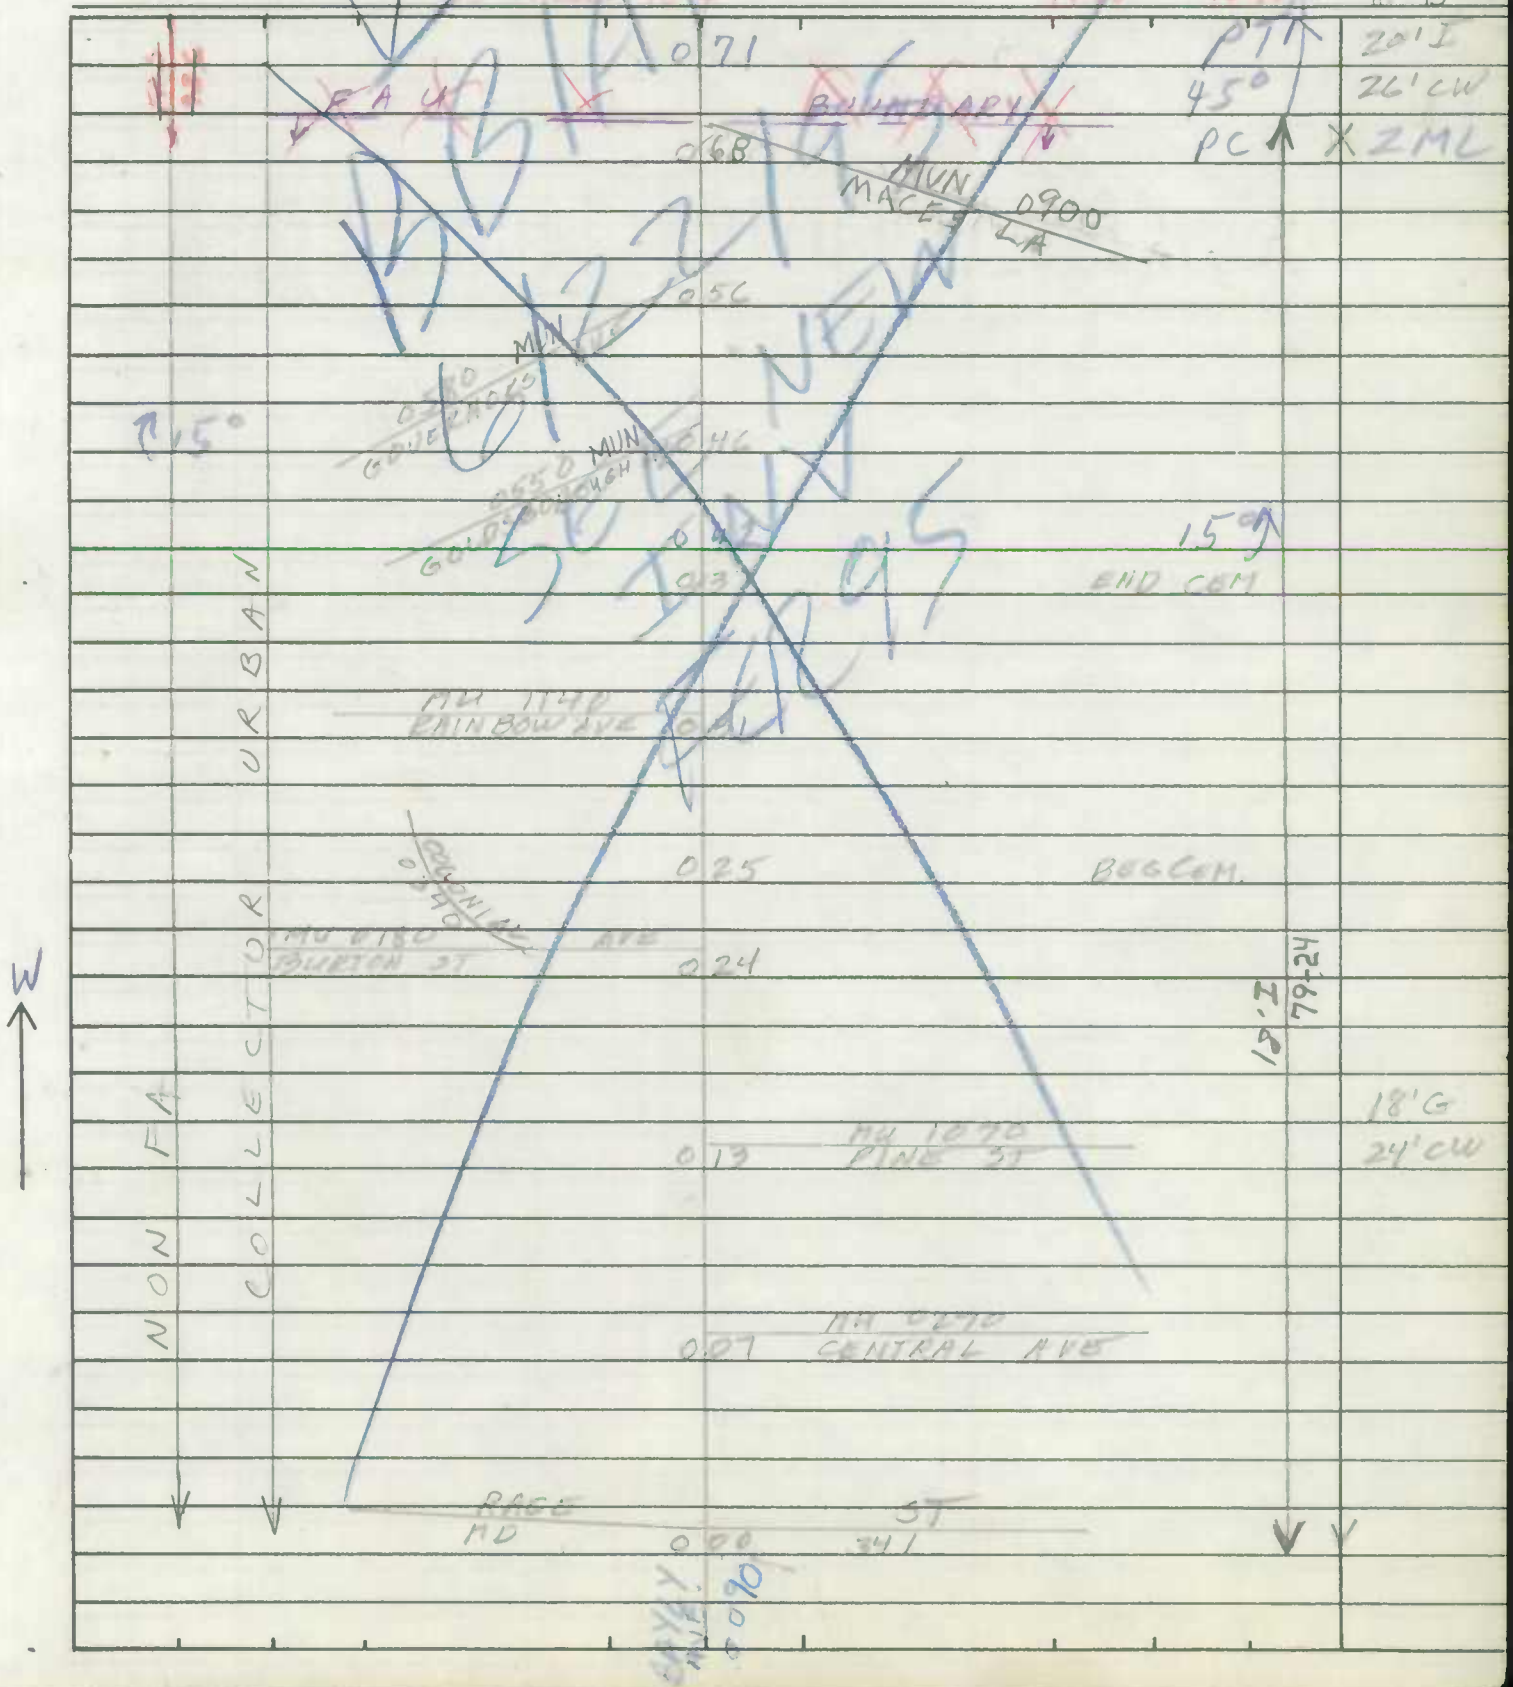

SHA 51.3-8
11-15-72

ROAD INVENTORY SHEET

Road No. _____
Road Name _____
Sheet No. _____
Date _____
County _____
State Coordinates _____

SHA 51.3-8
11-15-72

STATE HIGHWAY ADMINISTRATION OF MARYLAND

ROAD INVENTORY SHEET

Party Chief F. SETTAN
Recorder C. FORREST
Helper

Map No. I 15

Road No. 0100
Road Name BAYLY RD
Sheet No. 2 of 2
Date 4-21-65 REV 3-6-74 DAB
County DORCHESTER
State Coordinates

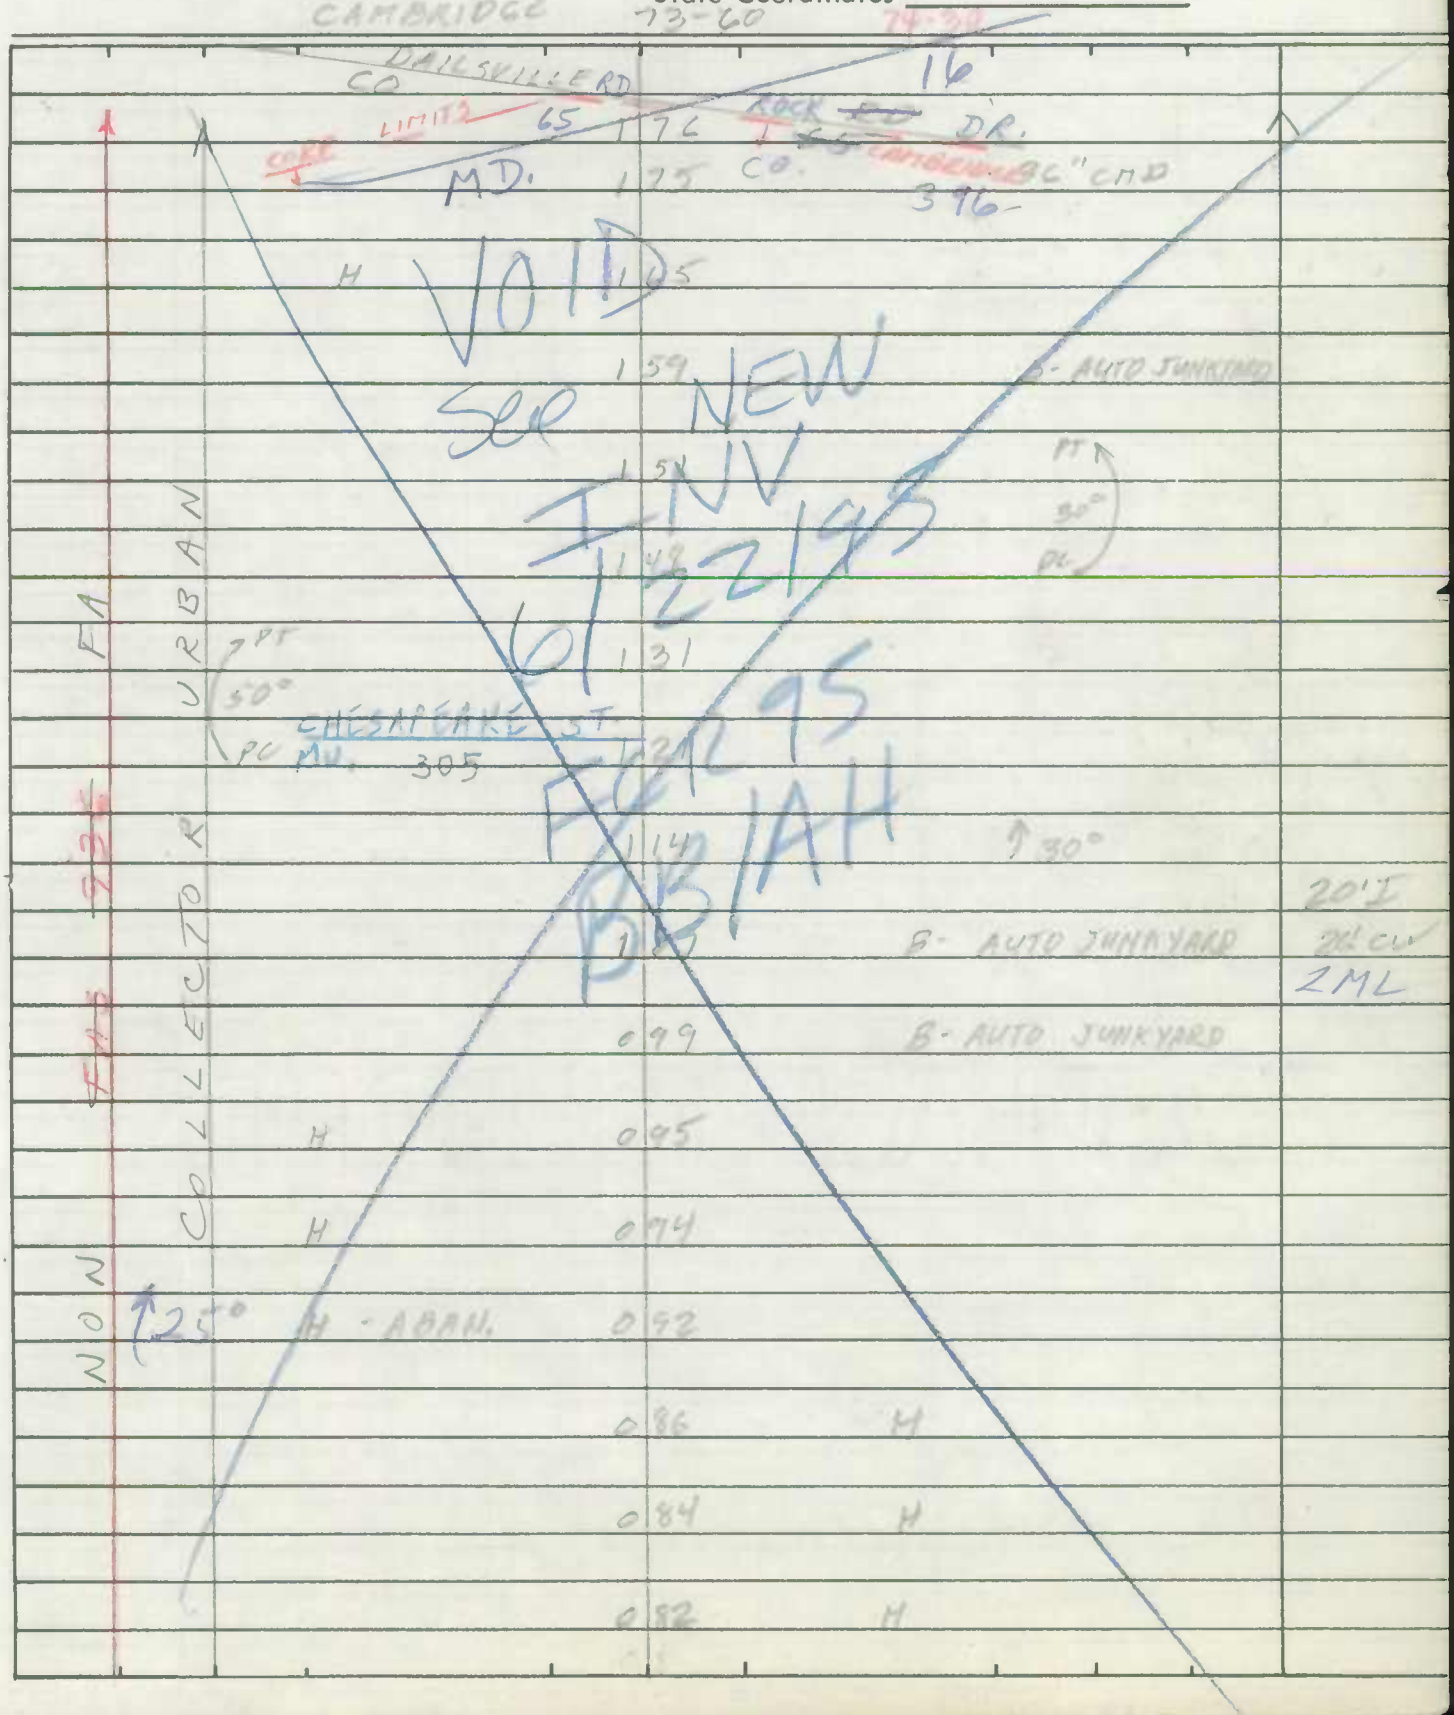

SHA 51.3-8
11-15-72

ROAD INVENTORY SHEET

Road No. _____
Road Name _____
Sheet No. _____
Date _____
County _____
State Coordinates _____

Form 6 HPS (Rev. 1961)

ROAD INVENTORY SHEET

MUN. No. 0110 93-4 A/T

Party Chief F SETTAN T. LANDON
Recorder G FOREST F. KNOLES
Chainman VERIFIED 10/24/75 CAMBRIDGE

Road No. BELVEDERE AVE
Name ~~BELVEDERE AVE~~
Sheet No. 1 OF 1
Date 4-23-65
County DORCHESTER

I 15

22-2

0890 LOCUST → 045 MUN → ST

1400 TRAVERS ← 042 MUN ← ST

1240 SCHOOL 023 MUN → ST

0620 HAMBROOKS AVE 011 MUN 0630

010 HAMBROOKS BLVD

000

(34) 33.5'G C-C

CHOPTANK RIVER

Form 6 HPS (Rev. 1961)

ROAD INVENTORY SHEET

Party Chief F SEITZ T. LINDON

Recorder C FORREST F. RHODES

Chainman

VERIFIED 10/20/75 CAMBRIDGE

Road No. 0130

Name BOUNDARY AVE

Sheet No. 10F 1

Date 4-30-65

County DORCHESTER

As Tabled 75-27 94-9 76-56

0560 GOODWILL 0 43 AVE

1370 0 35 S/W BOUNDARY RD

0 32 CAMBRIDGE POWER STA.

1350 SPRINGFIELD AVE 0 31

1030 PEACH 0 26 BLOSSOM AVE

ALLEY #20

0 T6 82.00 ST

RACE MD 0 12 T6 34

ALLEY 121 8210 0 08

0270 CENTRAL 0 05 AVE

~~03~~ ~~CIVIL DEFENSE HQ.~~

1070 PINE 0 00 ST

E

23'G CURB RT

24'G C-C

18'G 24'CW

H 18-79-22

Form 6 HPS (Rev. 1961)

ROAD INVENTORY SHEET

T. LANDON
F. RHODES
VERIFIED
10/21/75
CAMBRIDGE

Party Chief F. SETTEN
Recorder T. LANDON
Chainman

Road No. 0160
Name BROWN ST
Sheet No. 1 OF 1
Date 6-11-65
County DORCHESTER

ROAD END
0021 CITY WATER WORKS

0810
LAKE 0016 ST

0500
0008 FRONT ST

1040
PERIMORE ST 0006

0950
XXXXXXXXXXXX 0000

ROAD END

PEACH BLOSSOM
SCHOOL

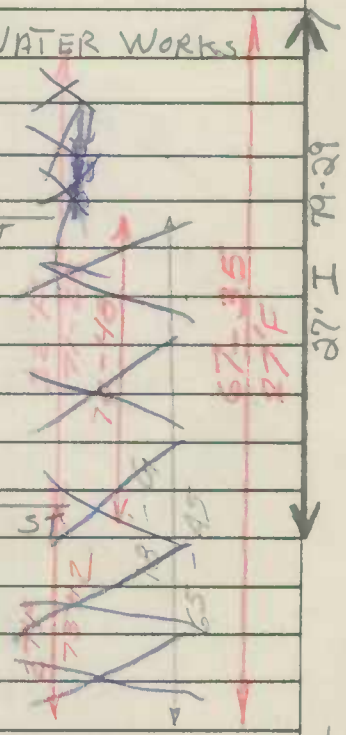

E

18'C
24'CW

Form 6 HPS (Rev. 1961)

ROAD INVENTORY SHEET

Party Chief F.S. T. LANDON
Recorder C.F. F. KHOLES
Chainman T.L.

VERIFIED 10/21/75 CAMBRIDGE

Road No. 0190
Name BYRNE ST.
Sheet No. 1 OF 1
Date 5.21-65
County DORCHESTER

0650
HAYWARD 035 ST

0490
FRANKLIN 027 ST

DORCHESTER GENERAL

0070
AURORA 019 ST


W

0410
DORCHESTER 010 AVE

1190
004 ROSEHILL ~~PL~~ ST

28'G 36'CW

SUNBURST HWY.
E.B 000
U.S. 50

SHA 51.3 - 8 Revised
4.83

Cambridge

MARYLAND STATE HIGHWAY ADMINISTRATION

ROAD INVENTORY SHEET

Party Chief E. Sattar
Recorder T. Landon
Assistant Rewritten 3-3-92 KJP
Map No./Dir. 1 W
State Coordinates

Road No. Mun 0240
Road Name Cedar ST.
County Dorchester
Date 6-18-65
Sheet No. 1 OF

TRAFFIC CODES
TRAFFIC CONTROLS: STOP SIGN=S.S., TRAFFIC LIGHT=T.L., FLASHING RED BALL=F.R.

TRAFFIC CODES
PARKING RESTRICTIONS: A.M. PEAK, P.M. PEAK, A.M./P.M. PEAK, NO PARKING ANYTIME=N.P., COMM/IND. ACCESS=E

SYSTEM				TRAFFIC		LINE DIAGRAM			TRAFFIC			PAVEMENT DATA
FED. AID.	FUNCT CLASS	HWY. SYS.	HPMS SAMPLE	PRKG. REST.	COM/IND. ACCESS				CONTROL	COM/IND. ACCESS	PRKG. REST.	
						Moorland Ave						
						Mun 0950 @.08	0	43				
						Perimore ST						
						Mu 1040 @.00	0	32				
					E	Dept of Fish & Wildlife	0	31				37'I
												Jcb. LT
												40'CW
												2 ML
								Trenton ST				
							0	25 Mu 1410 @.43			X	
							0	21				
						Dorchester Ave						
						Mu	0	10 C410 @.50				
												35'I
												40'CW
						(Sunburst Hwy)						2 ML
V	K					US	0	00 50 @1.37			V	
								925 @.17				
						Meteor Ave		Mun. 0				

NON F/A Collector Urban

LINE DIAGRAM

SYSTEM: FED. AID	SYSTEM: FUNCT. CLASS.	SYSTEM: HWY. SYS.	SYSTEM: HPMS SAMPLE	TRAFFIC: PRKG. REST.	TRAFFIC: COM/IND ACCESS			TRAFFIC: CONTROL	TRAFFIC: COM/IND ACCESS	TRAFFIC: PRKG. REST.	PAVEMENT DATA
						Pine	ST.				
						Mun 0.81	1070 @.25				
											30'I
											C-C
						Race	ST				
						Mu 0.68	1110 @.17				
						Academy	ST				
						Mu 0.58	0020 @.19				
						0.52	Cemetery		E		32'I
											J C-C
						Peach Blossom Ave	Ross ST				
						Mu 1030 @.00 0.48	Mu 1220 @.15				37'I
											J cb. LT.

NON F/A
Collector Urban
Urban Local

Form 6 HPS (Rev. 1961)

ROAD INVENTORY SHEET

Party Chief F. SETTER
Recorder T. L ANNON
Chainman

F. RHODES
VERIFIED
10/20/75

Road No. 0240
Name CEDAR ST
Sheet No. 1 OF 1
Date 6-18-65
County DORCHESTER

I 5
CAMBRIDGE
78-13 & 14
91-14 A/T

1070		MUN	
PINE	0 81	ST	
FAU 1110	0 74	PROPOSED NO BOAT	
RACE	0 68	MUN ST	
0020		MUN	
ACADEMY	0 58	ST	
1030	0 52	CEM 1220	
PEACH BLOSSOM AVE	0 48	ROSS ST	
MOORELAND AVE.			
~~BL ST~~	0 43		
1040			
PERIMORE ST MUN	0 32		
DEPT. OF FISH & WILDLIFE	0 31		
		MUN 1410 TRENTON ST	
	0 25		
	0 21		
		~~AFC~~ S32 083K MDDE	
0410		MUN	
DORCHESTER	0 10	AVE	
US	0 00	50	

URBAN
FA
COLLECTOR
NOW
W

30'H C-C
32'H C-C
37'I 40'CW 2ML
35'I 40'CW 2ML

SHA 51.3-8
11-15-72

STATE HIGHWAY ADMINISTRATION OF MARYLAND

(90-12 A/T)

ROAD INVENTORY SHEET

Party Chief I. LANDON
Recorder F. RHODES
Helper

Map No. I15

Road No. MUN. 0310
Road Name CHOPTANK AVE.
Sheet No. 1 OF 1
Date 10/23/75
County DORCHESTER
State Coordinates

CAMBRIDGE 91-07 A/T

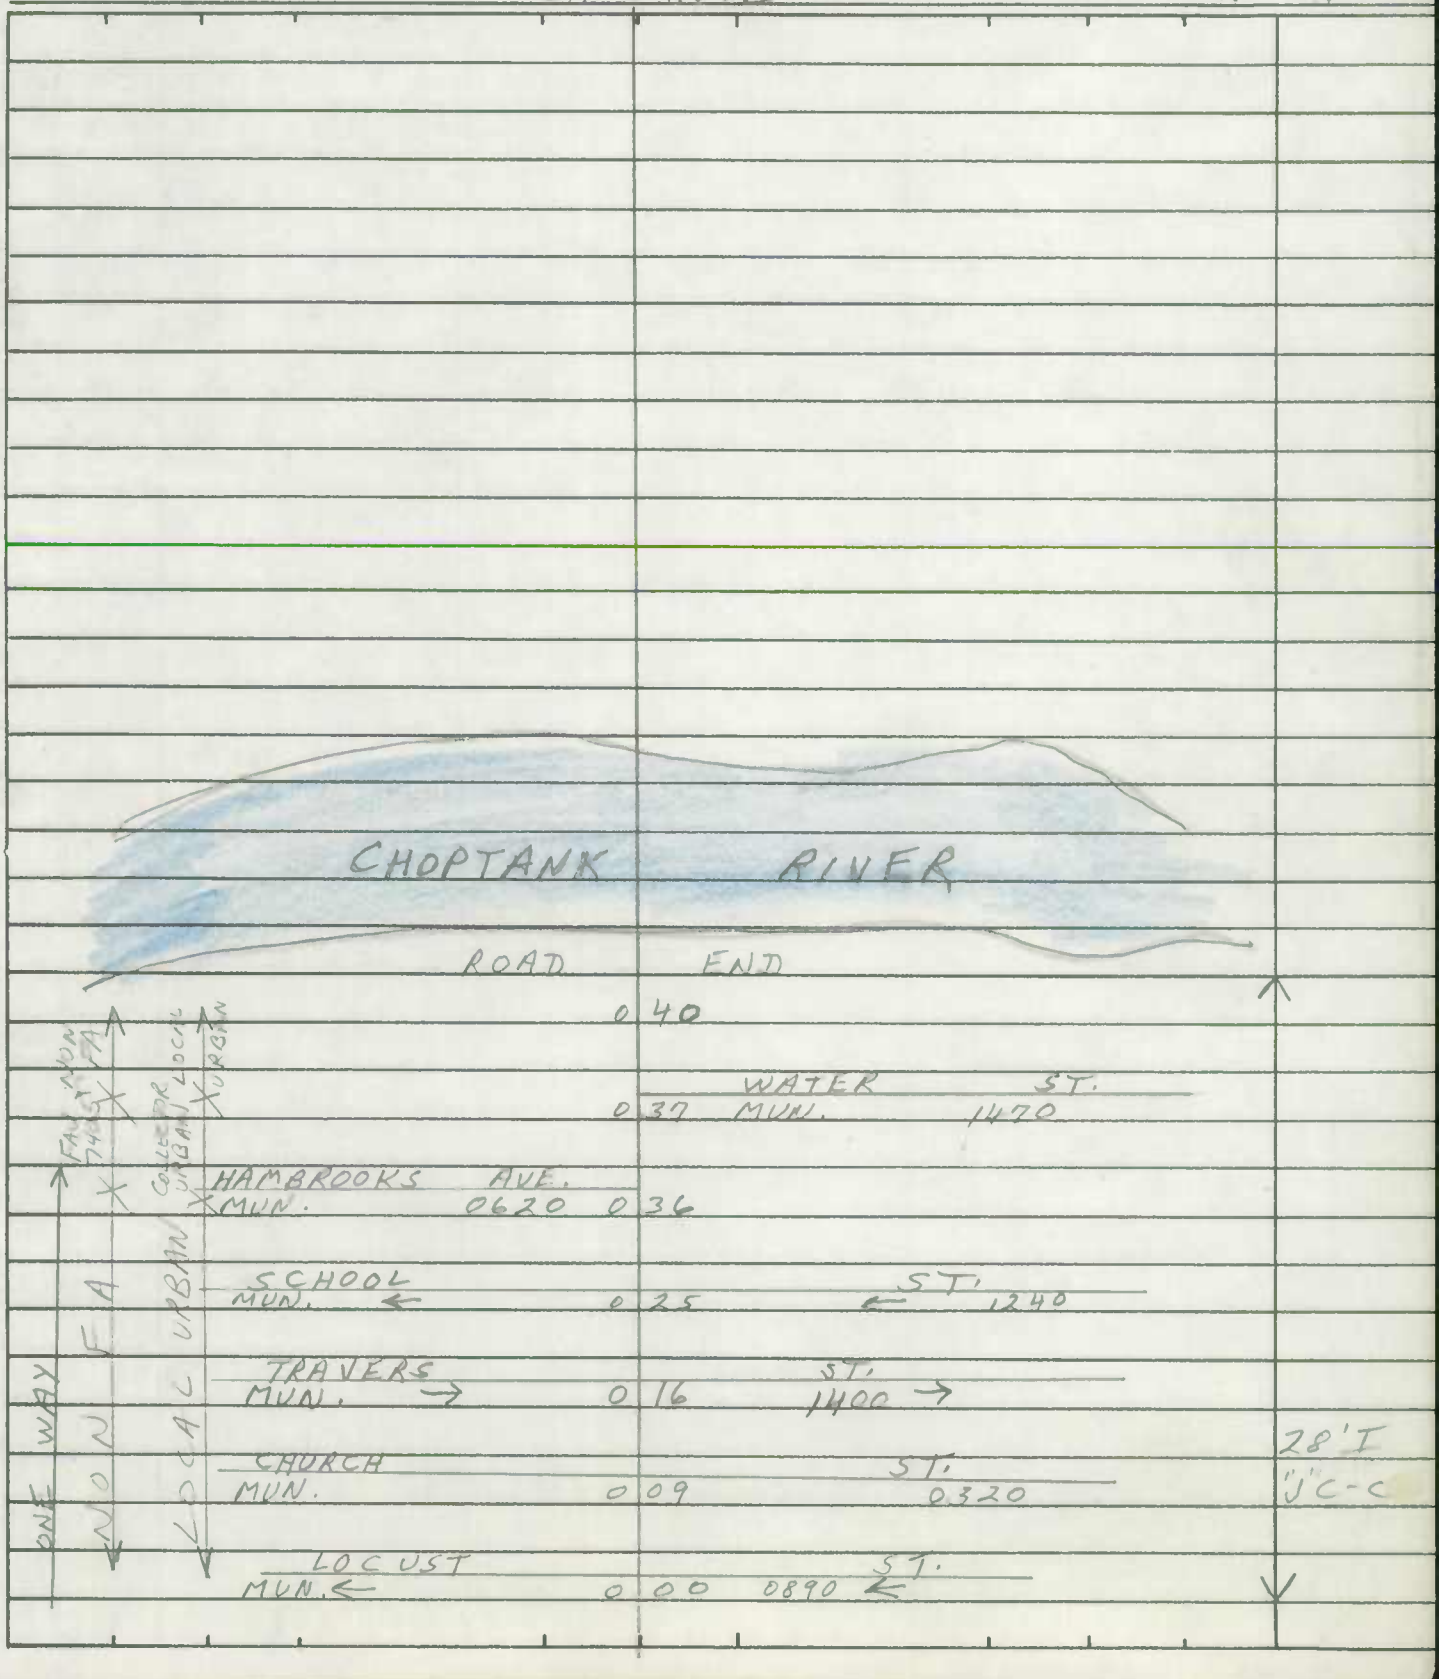

SHA 51.3-8
11-15-72

ROAD INVENTORY SHEET

Road No. _____
Road Name _____
Sheet No. _____
Date _____
County _____
State Coordinates _____

Form 6 HPS (Rev. 1961)

ROAD INVENTORY SHEET

Party Chief F. SETTAN
Recorder T. LANDON
Chainman

I 15

T. LANDON
F. RHODES
VERIFIED
10/22/75
CAMBRIDGE

Road No. 0370
Name COURT LANE
Sheet No. 1 OF 1
Date 6-15-67
County DORCHESTER

91-06 A/T

VOID SEE NEW BLANKS OF 2 PAGES

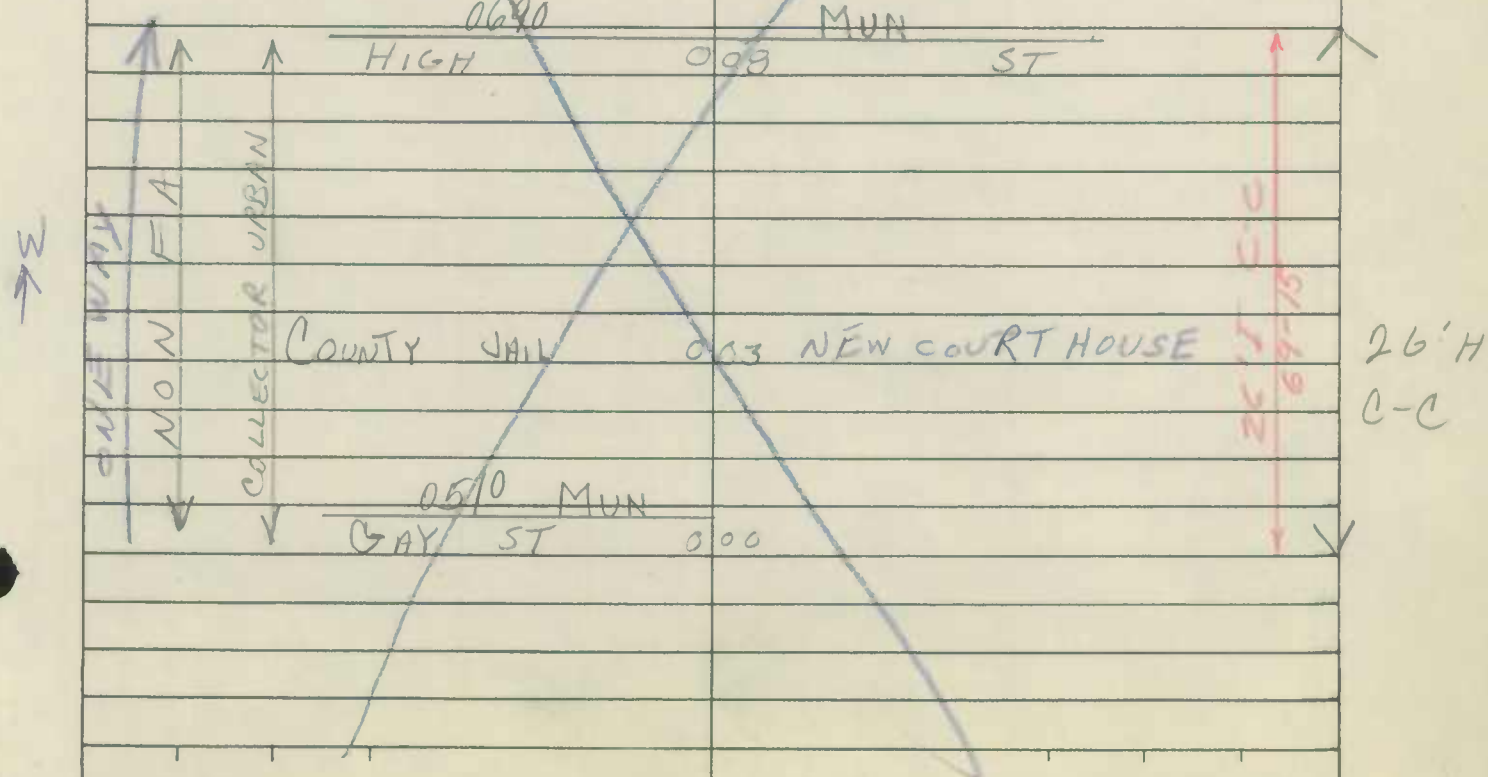

Form 6 HPS (Rev. 1961)

ROAD INVENTORY SHEET

Party Chief F.S.
Recorder C.E.
Chainman T.L

T. LANDRY
F. KING
VERIFIED
10/13/75

Road No. 0410
Name DORCHESTER AVE
Sheet No. 1 OF 1
Date 5-21-75
County DORCHESTER

WASH.		ST
MD	027	343+6
1500		
BRAMBLE ST	059	
0740	054	
CEDAR	050	ST
	049 HOWARD	ST PUMPING STA.
1200	042	0820
ROSCLIN AVE	031	LECOMPTE ST
	ALLEY #22 028	8220
0660		
HENRY	024	ST
ALLEY	021	8070
		#7
0910		
MD	017	AVE
		8060
	013	ALLEY #6
MUU		0190
BYRN	009	BYRN ST
1120		
RADANCE DR	000	

S

24'H
30'Cu

24'G
30'Cu
3%C.L.T.

30'G
36'Cu

Form 6 HPS (Rev. 1961)

ROAD INVENTORY SHEET

M404455

Party Chief F SETTAN
Recorder C FORREST
Chainman

T. LANDON
F. RHODES
VERIFIED
10/20/75

Road No. C073
Name EGYPT RD
Sheet No. 2 OF 2
Date 4-29-W
County DORCHESTER

	MD	7	20	16	
	OHIOS Rock Rd Co 65 396	7	18	EGYPT Rd 65	73-34 MUN.
		6	99		DR.
	1973 ANNEX LIMITS	6	85	CAMBRIDGE 17	
		6	73	SIGN	
		6	52	F	
		5	14	F	
		4	75	H	
	F	4	63		15-66 20'F 30'CV 2ML
		4	39	F	
	H	4	02		
	H	3	94		
	F-ABAN	3	76	F	
		3	46	H	
		3	43	H	
		3	18	H	SAME

Form 6 HPS (Rev. 1961)

ROAD INVENTORY SHEET

T. LANDON

F. RHODES

VERIFIED 10/23/75 CAMBRIDGE

Party Chief F SETTAN

Recorder C FORREST

Chainman

I15

Road No 0470

Name FAIRMOUNT AVE

Sheet No. 1 OF 1

Date 4-26-65

County DORCHESTER

0690 MUN
HIGH 025 ST

1330 MUN
SAUNDERS AVE 016

0300 MUN
CLINTON ST 011 ELE. School

460
RIGBY 009 MUN AVE

0730 MUN
HUBERT 002 ST

000
ROAD END

36'G
C-C

30'G
CURB RT.

18'F
24'CW

16'F
20'CW

E

Form 6 HPS (Rev. 1961)

ROAD INVENTORY SHEET

F. LANDON
F. RHODES
VERIFIED
10/17/75
CAMBRIDGE

Party Chief F.S.
Recorder C.F.
Chainman T.C.

Road No. 0490
Name FRANKLIN ST
Sheet No. 1 OF 1
Date 5-21-75
County DOR.

ROAD	END	
	041	
ENT CAM TERMINAL	035	25'I 30'CW
	032	
	028 ENT HOSPITAL	28'G 36'CW
0190 BYRNE	025 ST	
8100 ALLEY	021 # 10	
0910 MD	017 AVE	
8080 ALLEY	013 # 8	
0660 HENRY	009 ST	42'G C-C
8090 ALLEY # 9	006	
	003	
	002 GAS STORAGE TANKS	20'G 26'CW
~~1180~~ 0650 HAYWARD ~~R.R.~~	000 ST. ~~AVE~~	

E ↑

SHA 51.3-8
11-15-72

STATE HIGHWAY ADMINISTRATION OF MARYLAND

Cambridge

ROAD INVENTORY SHEET

Party Chief F SETHN
Recorder T LANDON
Helper

VER FRTL 10-22-75

Map No. I15

Road No. 0510
Road Name GAY ST
Sheet No. 1 of 1
Date 6-15-65
County DORCHESTER
State Coordinates

RECOPIT 8-30-81 JTSC

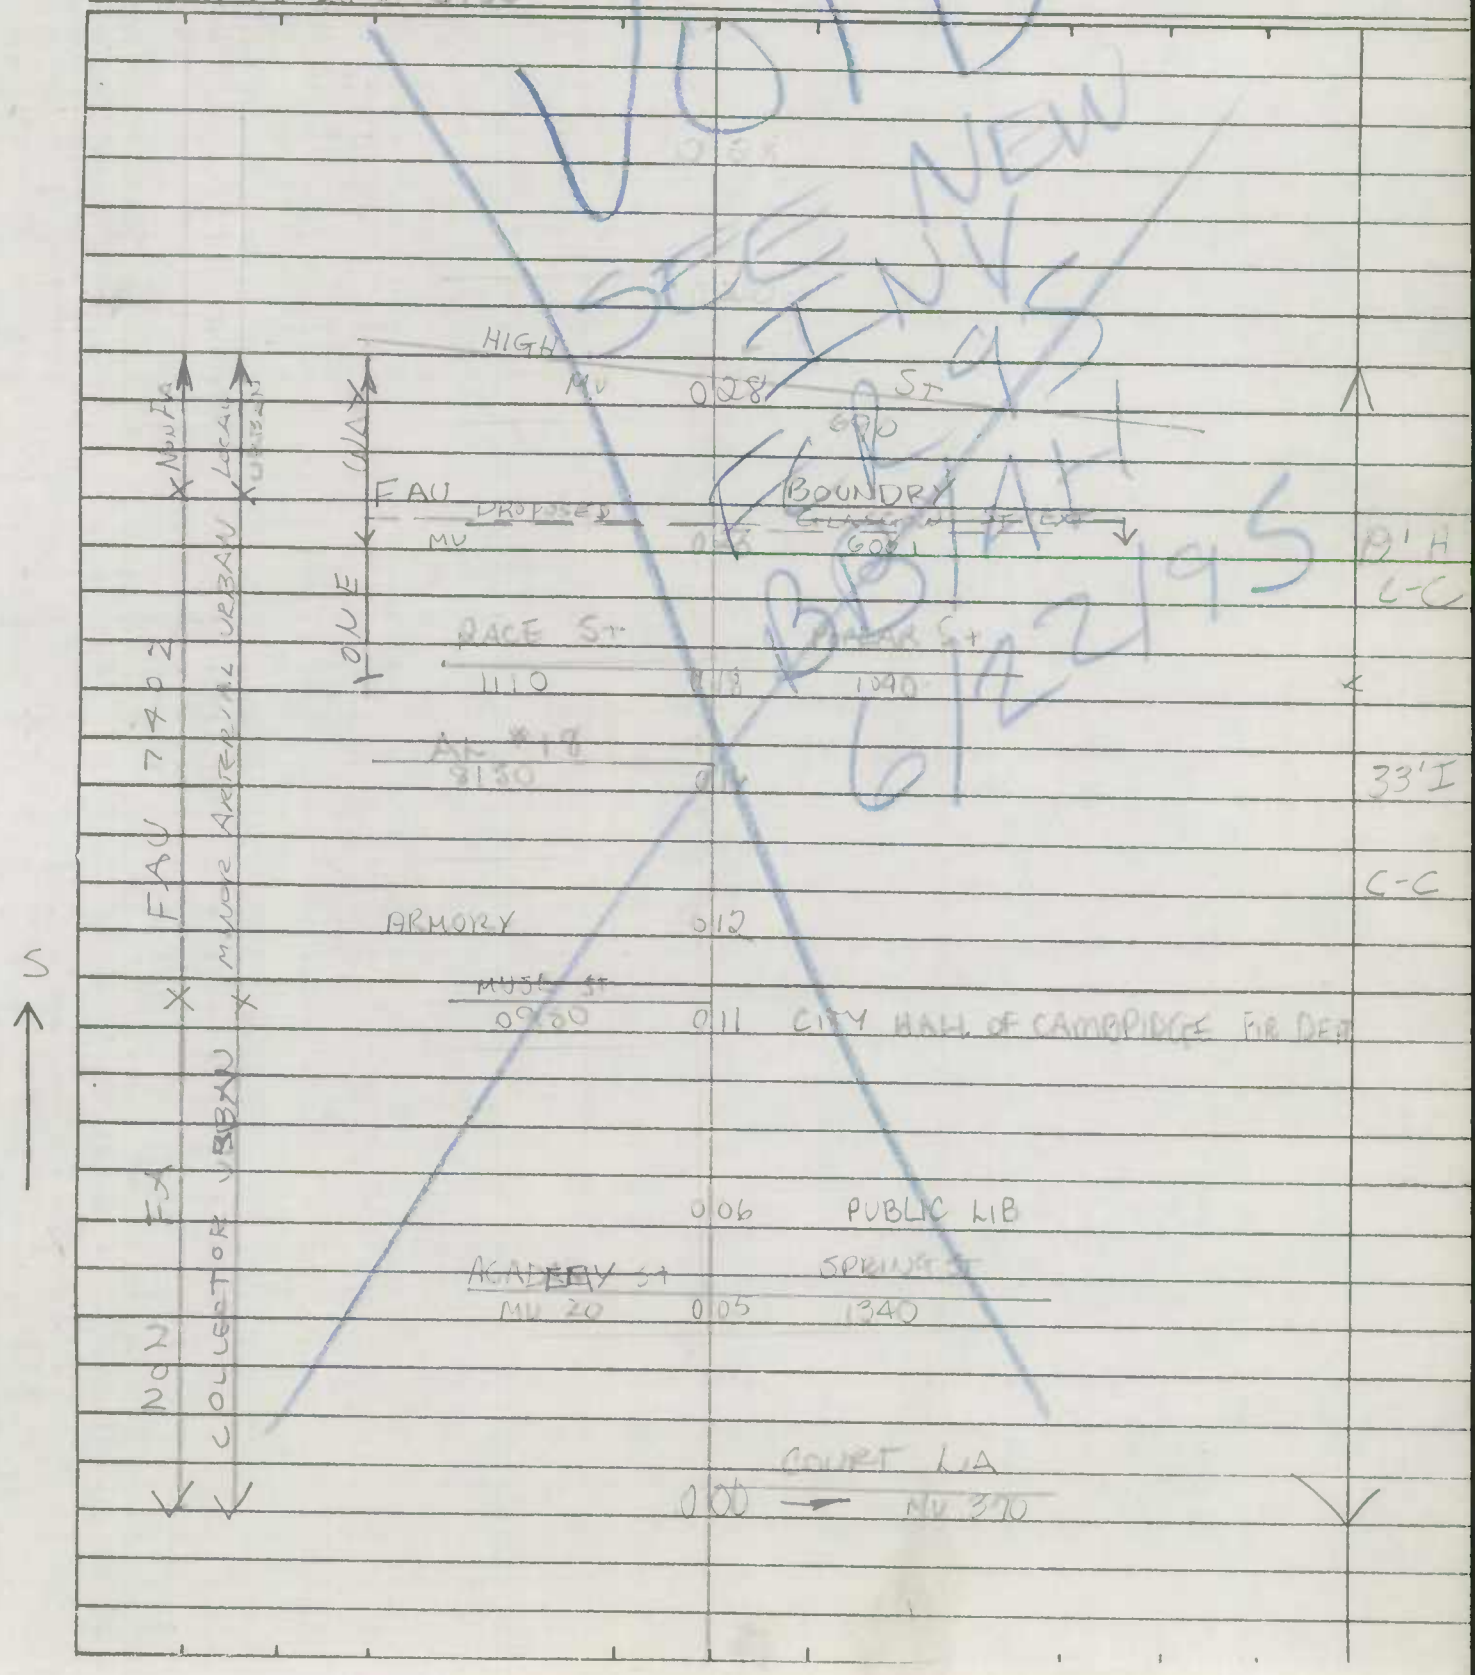

SHA 51.3-8
11-15-72

ROAD INVENTORY SHEET

Road No. _____
Road Name _____
Sheet No. _____
Date _____
County _____
State Coordinates _____

Form 6 HPS (Rev. 1961)

ROAD INVENTORY SHEET

Party Chief F. SETTER
Recorder T. LANDRY
Chainman

T. LANDRY
F. RHODES
VERIFIED
10/22/75
CAMBRIDGE

Road No. 0510
Name GRY ST
Sheet No. 1 OF 1
Date 6-15-65
County DORCHESTER

74-22

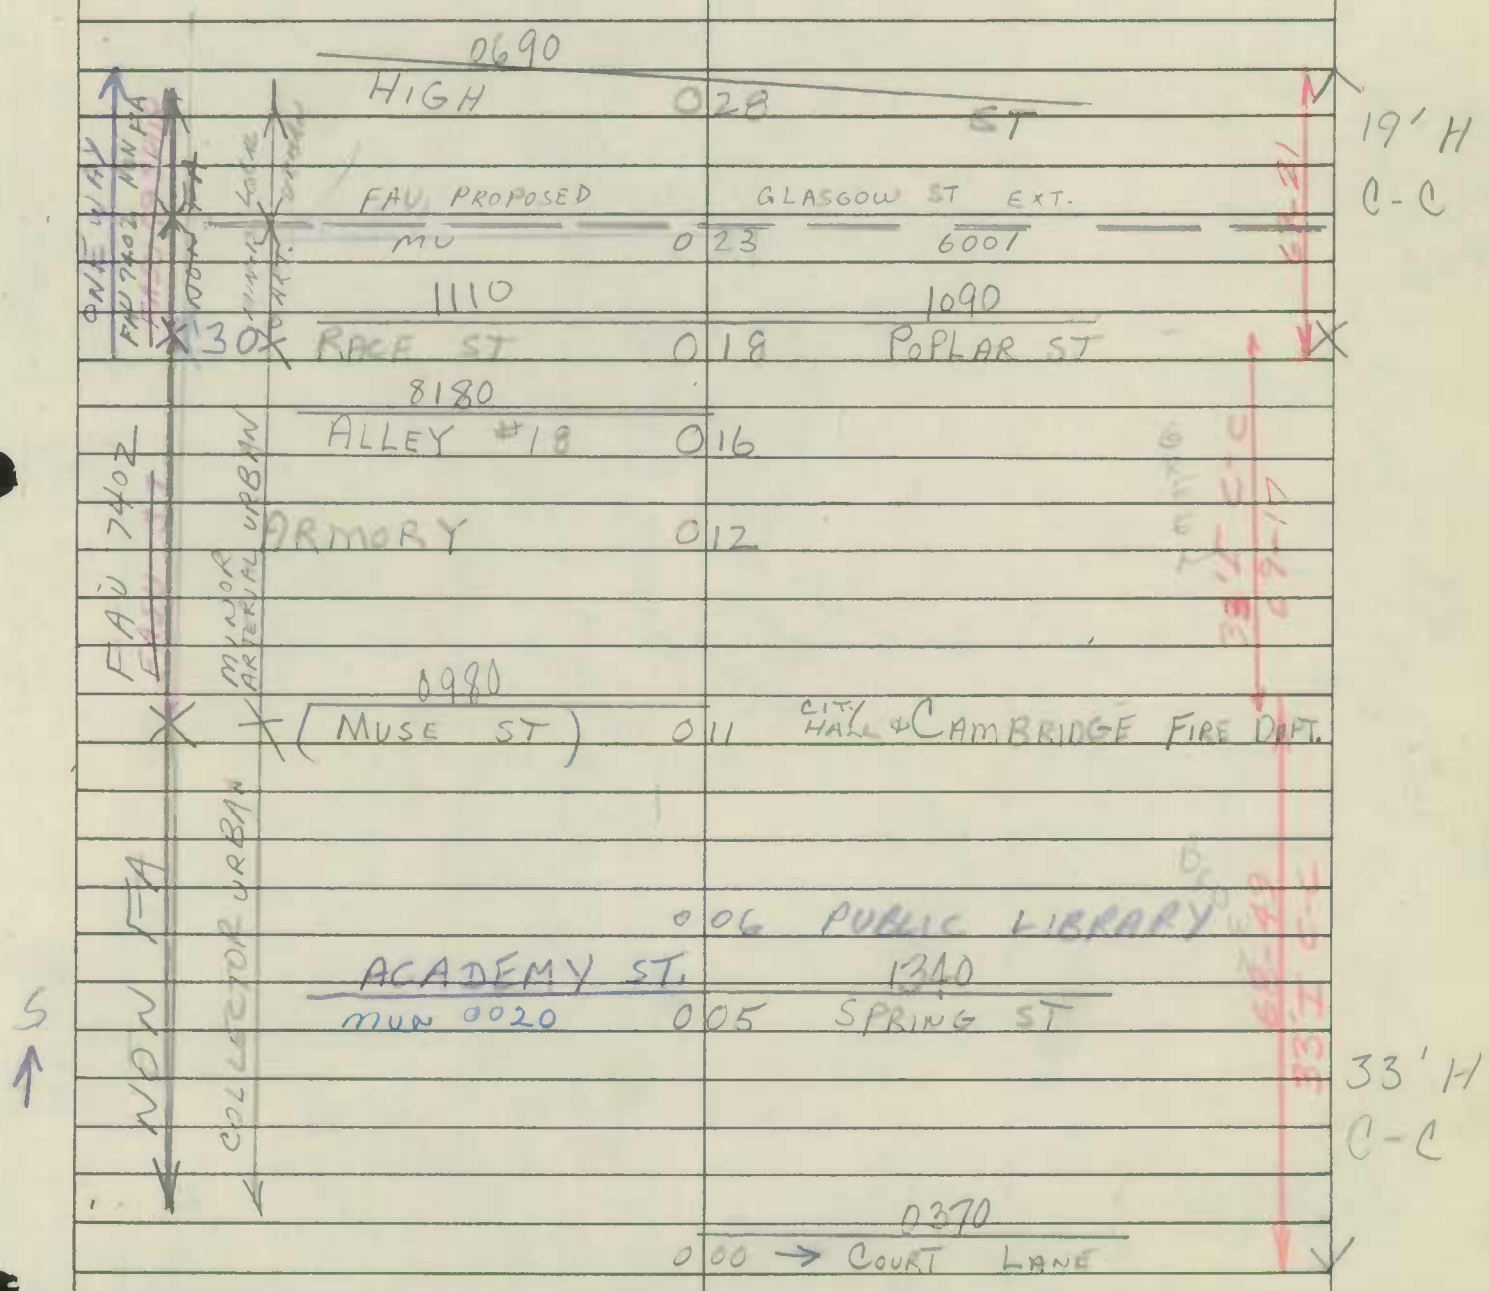

SHA 51.3-8
11-15-72

STATE HIGHWAY ADMINISTRATION OF MARYLAND

(90-08 A/T)

ROAD INVENTORY SHEET

Party Chief F SETTIAN
Recorder T LANDON
Helper

Map No. 15 VER NO 23 15 TL & FR

Road No. MD 520
Road Name GLOSGOW ST
Sheet No. 1 of 2
Date 6-4-65
County DORCHESTER
State Coordinates

Revisit 8-20-81 JTBC CAMBRIDGE

			LEONARDS LANE		
		0.36	840		30'I
URBAN	MILBOURNE ST				C-C
	930	0.29			2 MK
	GLENBURN AVE				
	MD	0.27	530	X	
MAJOR ARTERIAL	TALBOT AVE				
	MD	0.19	1380		40'I
					C-C
	ALT 13				2 MK
	8130	0.14			
FAU					
MINOR	SOMERSET AVE				
	1330	0.09			
			EDEN		
			EDDON PK DR		
	(A)	0.04	450		
		0.00			

E

5
30
40
50
60
70

SHA 51.3-8
11-15-72

ROAD INVENTORY SHEET

Road No. 520
Road Name GLASGOW ST
Sheet No. 2 of 2
Date 6-4-65
County DORCH
State Coordinates

HIGH ST.
MV 0 83 0690

24'I
J' C-C

0 77

MILL ST
MV 0940 0 71

30'I
J' C-LT

JR. HIGH School ST.
0 69 MV 0720

36' AU

SHOET ST.
MV 1280 0 66

23'I
26' AU

LINDEN AVE
0 54 MV-0880

30'I

WILLIS ST
MV 0 49 1520

C-C

2UML

OAKLY ST
MV 0 44 1010

7401 MINOR ARTERIAL URBAN
ONE WAY

Form 6 HPS (Rev. 1961)

ROAD INVENTORY SHEET

Party Chief F SETTIAN T. LANDON
Recorder T. LANDON F. RHC
Chainman VERIFIED 10/23/75 CAMBRIDGE

Road No. 0520
Name GLASGOW ST
Sheet No. 1 OF 2
Date 6-4-63
County DORCHESTER

	1520 WILLIS	049	ST	
	1010 OAKLEY	044	ST	
		040		
		036	LEONARDS LANE	
	0930 MILBOURNE ~~AVE~~ ST.	029		
	0530 GLENBURN	027	AVE	
	1380 TALBOT	019	AVE ~~ST~~	
	8130 ALLEY #13	014		
	1330 SOMERSET AVE	009		
		050		
	(A)	004	EDLEN - PARK DR.	
	CABLE LINES	000	CAMBRIDGE SIGN	

FAS 7410 (1) URBAN ARTERIAL MINOR

E

30'G C-C

40'G C-C

32 GLASGOW

Form 6 HPS (Rev. 1961)

ROAD INVENTORY SHEET

Party Chief F. SETTI
Recorder T. LANDON
Chainman

T. LANDON
F. RHODES
VERIFIED
CAMBRIDGE 75

Road No. MU 520
Name Glasgow ST
Sheet No. 2 OF 2
Date 6-4-65
County DORCHESTER

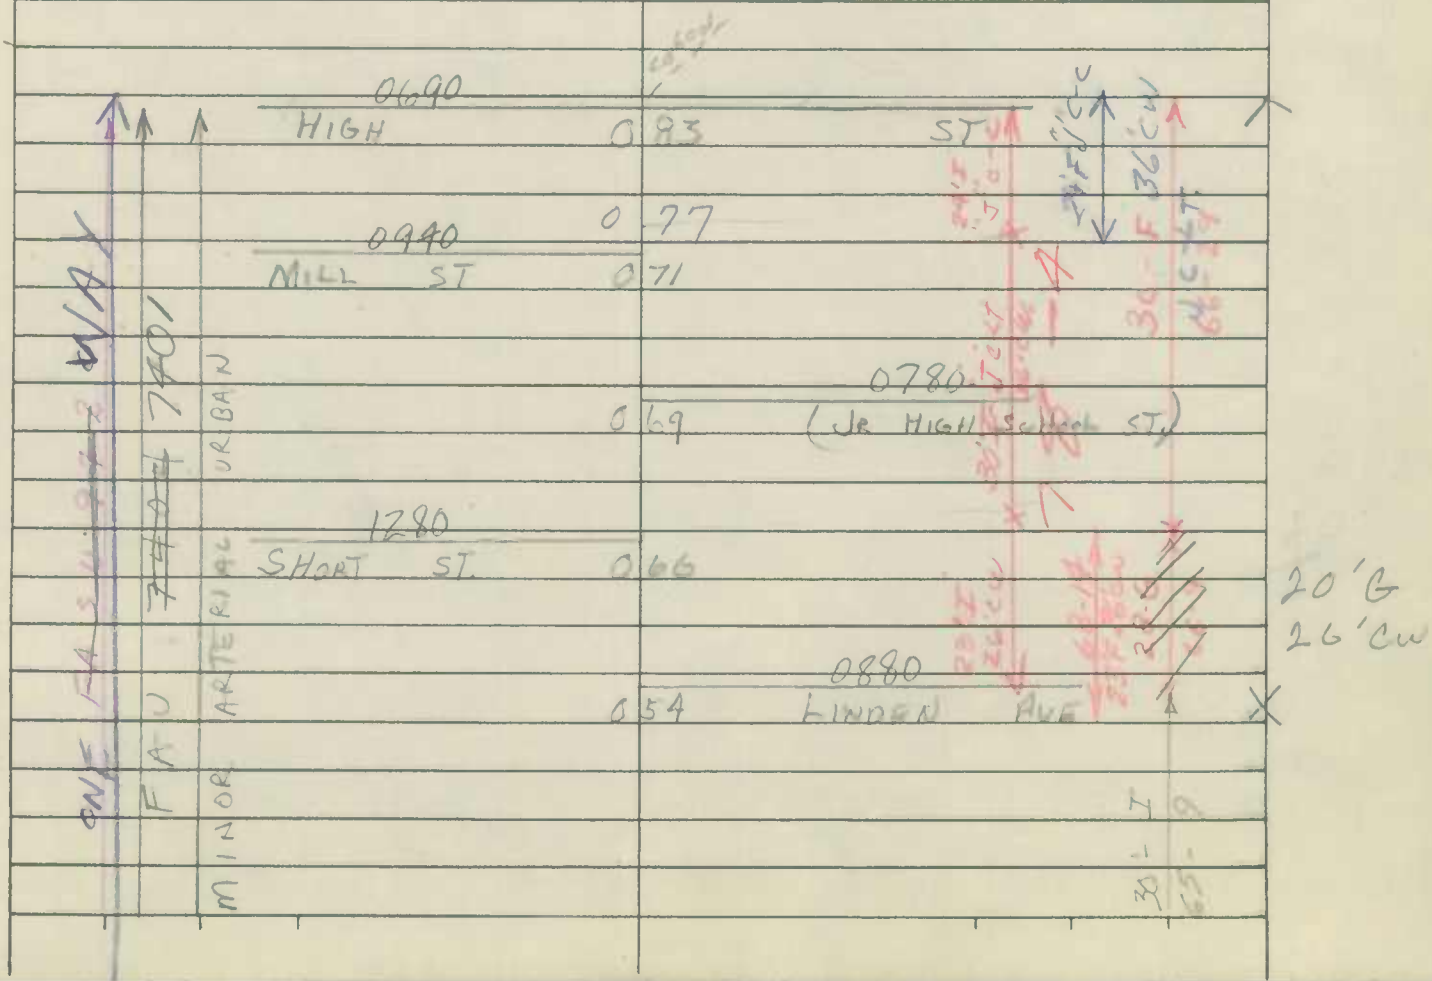

SHA 51.3-8
11-15-72

STATE HIGHWAY ADMINISTRATION OF MARYLAND

73-59 (90-04) ALT

T. LANDON RHODES
F. VERIFIED '75

79-18*

ROAD INVENTORY SHEET

Party Chief W. Dombroski
Recorder D. Taylor
Helper

Map No. I15

Road No. MUN 0530
Road Name Glenburn Ave
Sheet No. 1 of 1
Date 1-22-74
County Dorchester
State Coordinates

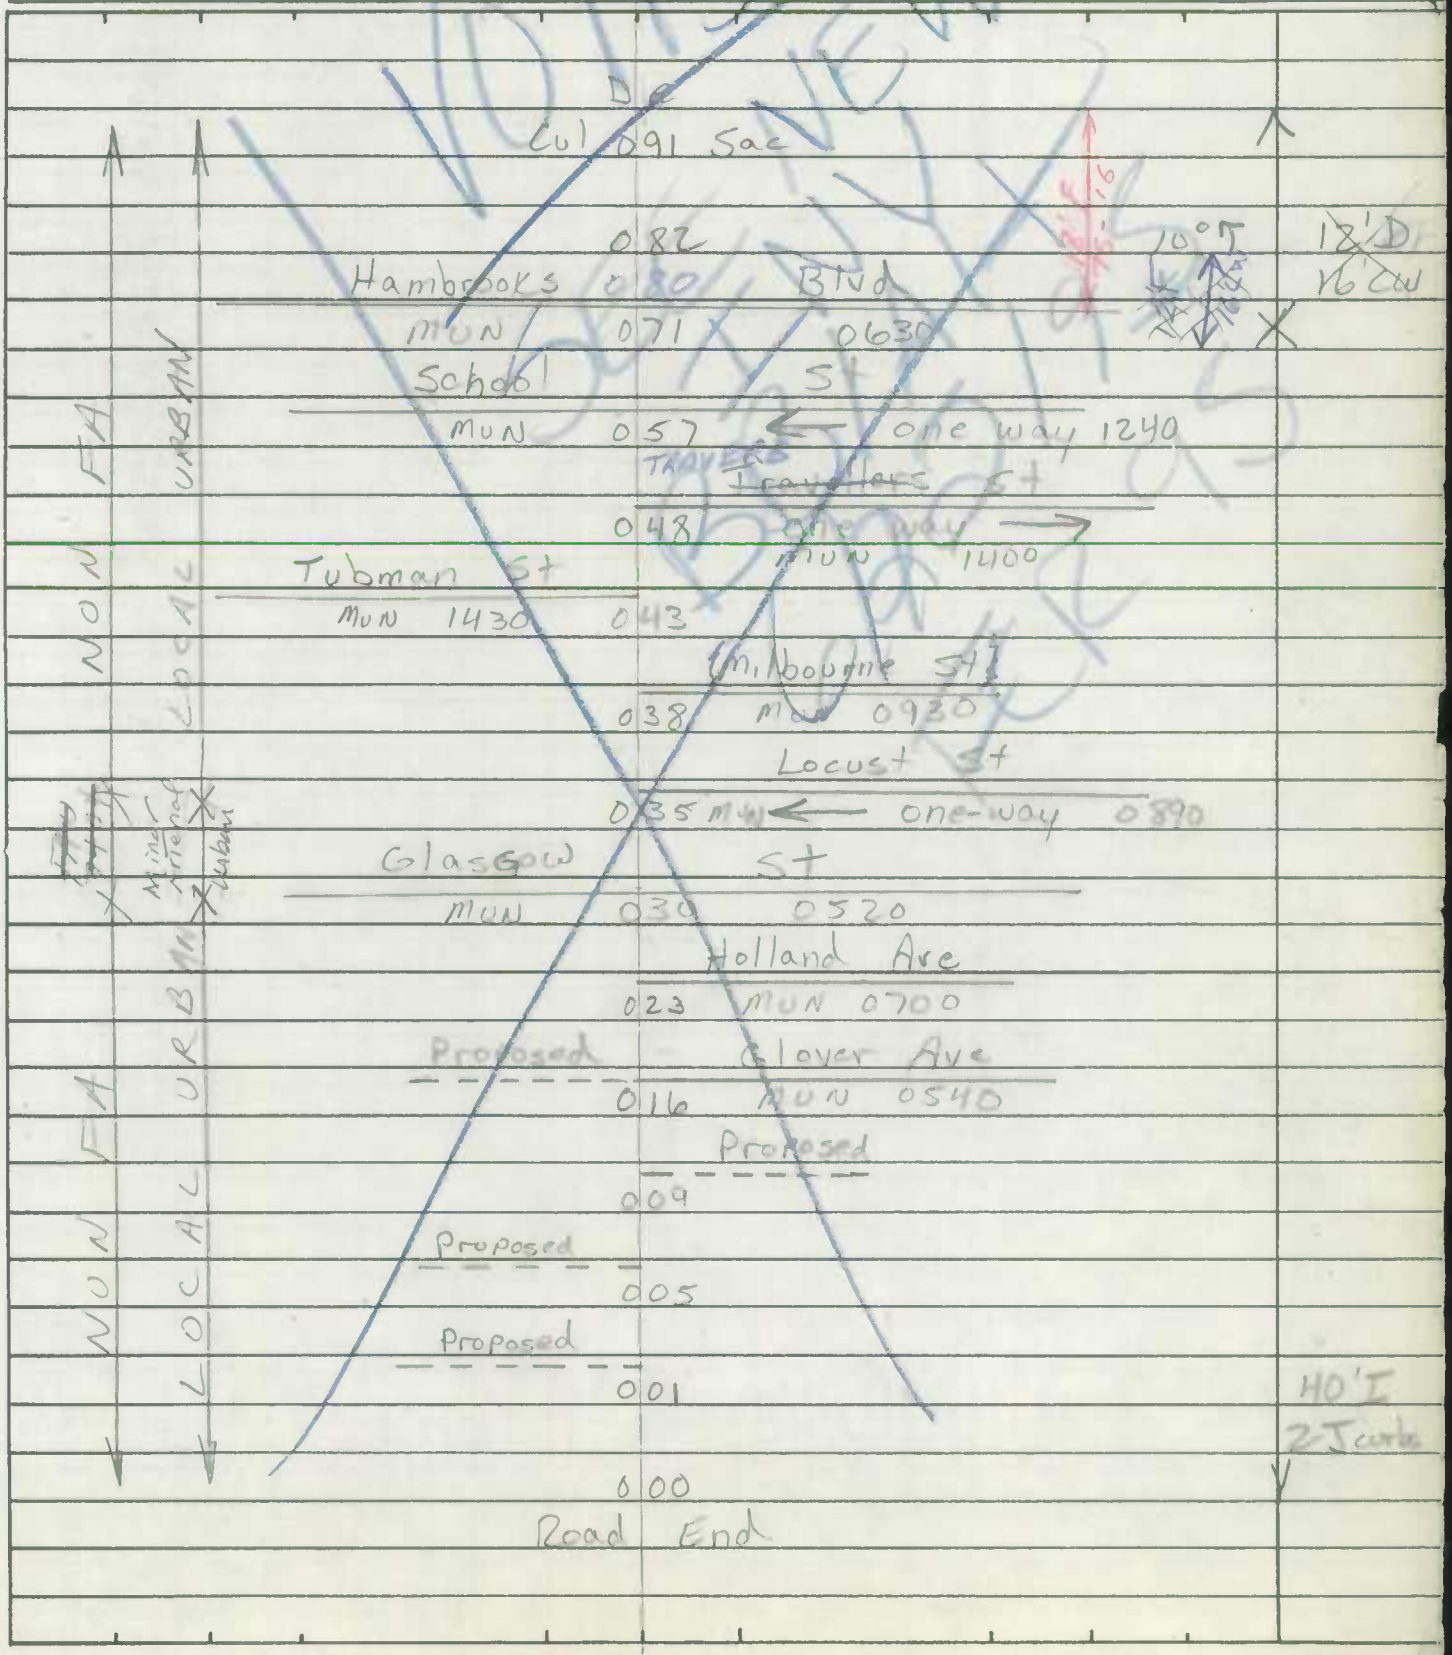

SHA 51.3-8
11-15-72

ROAD INVENTORY SHEET

Road No. _____
Road Name _____
Sheet No. _____
Date _____
County _____
State Coordinates _____

Form 6 HPS (Rev. 1961)

ROAD INVENTORY SHEET

MUN. No. 0590

Party Chief F.S.
Recorder C.F
Chainman T.L.

T. LANDCT
F. RHODES
VERIFIED
75

Road No. Green St
Name LCCompte ST
Sheet No. 1 OF 1
Date 5-21-63
County DOR.

CAMBRIDGE

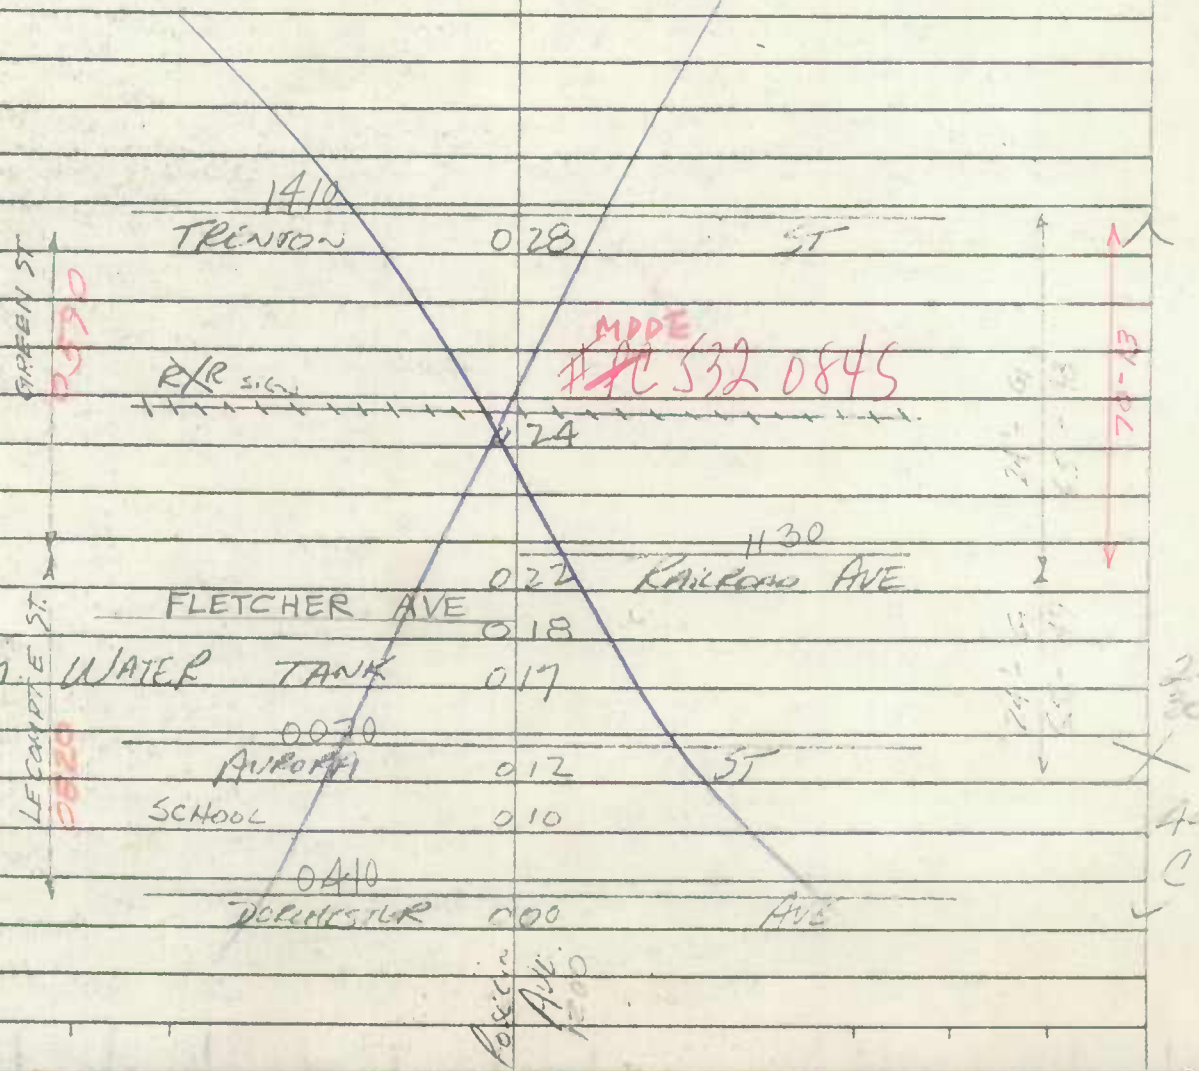

Form 6 HPS (Rev. 1961)

(90-05,06) MT

ROAD INVENTORY SHEET

T. LANDON
F. RHODES
VERIFIED
10/23/75

Party Chief F. SETTAN
Recorder T. LANDON
Chainman

I15

Road No. 0620
Name HAMBROOKS AVE
Sheet No. 1 OF 1
Date 6-4-65
County DORCHESTER

CAMBRIDGE 78-23

VOID SEE NEW BRIDGE ON NEW ALIGNMENT

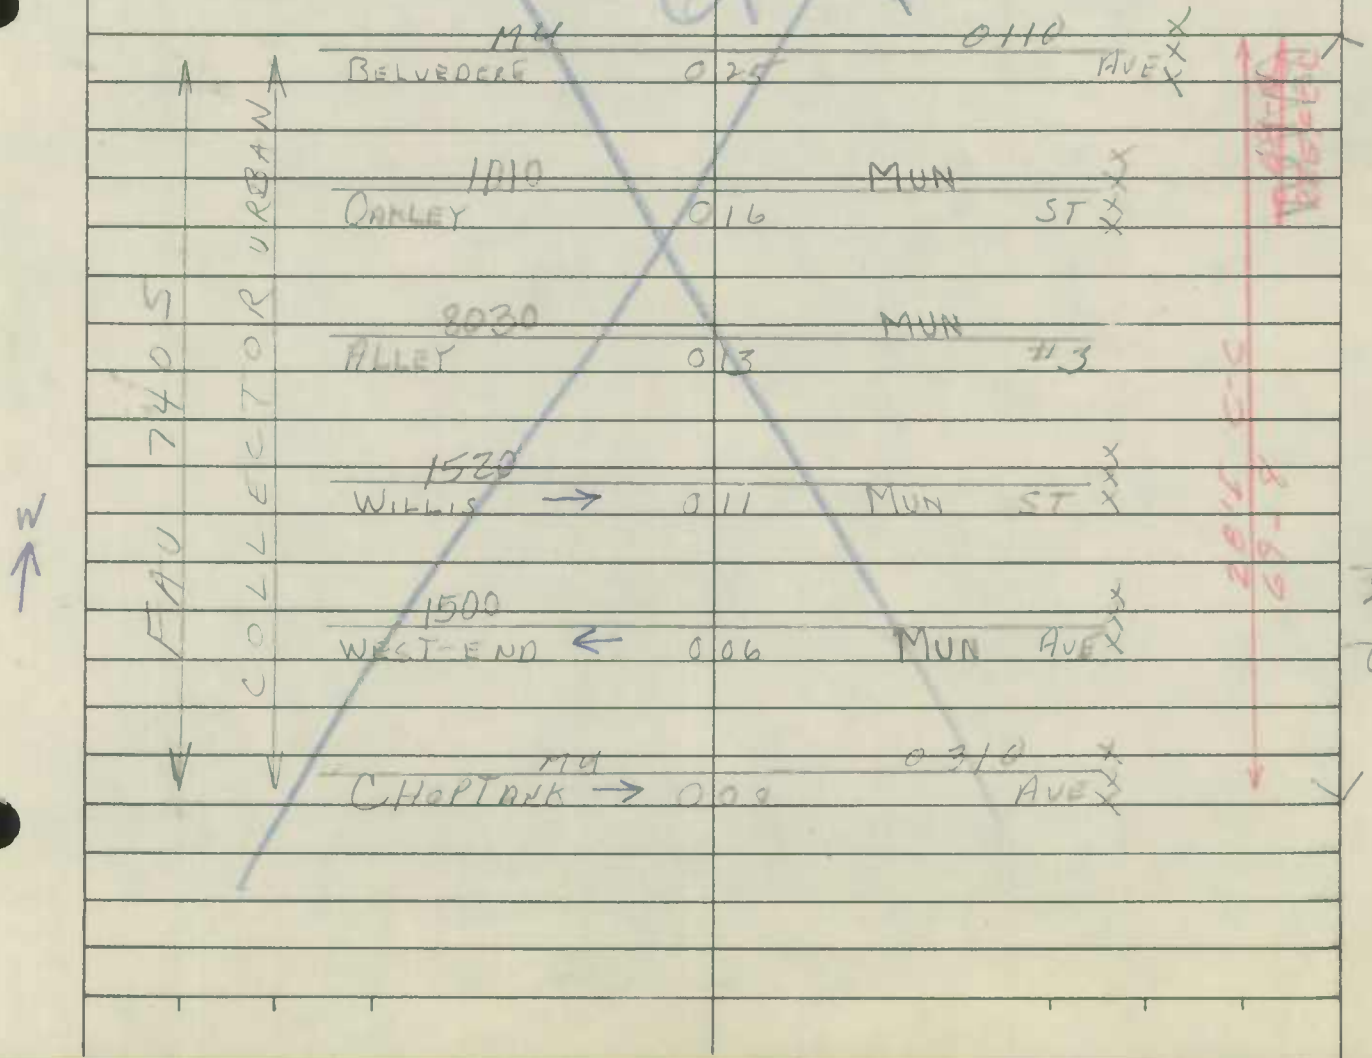

Form 6 HPS (Rev. 1961)

ROAD INVENTORY SHEET

Party Chief F. SETTANI
Recorder J. LANDER
Chainman

T. LANDER
F. RHU
VERIFIED
10/24/75
CAMBRIDGE

Road No. 0630
Name HAMBROOKS BLVD.
Sheet No. 1 OF 1
Date 6-4-65
County DORCHESTER

I15

A/T 83-D1

HAMBROOKS BLVD.

		036	QUEENSLAND AVE	1100
	1330		MUN	
	SOMERSET	026	AVE	
	1380		MUN	
	TALBOT	018	AVE	
	8010 MUN			
	ALLEY #1	013		
	0530		MUN	
	GLENBURN	010	AVE	
	0110		MUN	
	BELVEDERE	000	AVE	

FAU 7405 COLLECTOR URBAN

W

18'G
24'CW

30'G
C-C

36'G
C-C
ON TAPER
TO 58'G
C-C

Form 6 HPS (Rev. 1961)

ROAD INVENTORY SHEET

T. LANDON
F. RHOLES
VERIFIED 10/22/15

Party Chief F. SMITH
Recorder T. LANDON
Chainman

Road No. 0690
Name HIGH ST
Sheet No. 1 OF 4
Date 6-23-65

GB REN
FA 4-20-83 I15 CAMBRIDGE

| | | |

Form 6 HPS (Rev. 1961)

A/T (92-1) GO/ALIGNMENT 2/2/93

93-7 A/T

ROAD INVENTORY SHEET

Party Chief F. SETTAN
Recorder T. LANDI
Chainman

T. LANDI
F. RHO
VERIFIED
CAMBRIDGE 75

I15

Road No.
Name HIGH ST
Sheet No. 2 OF 4
Date 6-23-65
County DORCHESTER

FAU MINOR ARTERIAL URBAN 7403

0520 MUN
GLASGOW ST → 098

0510 GRAY ST
MUN
090 ALLEY #24
088 MUN 8240

0740 MUN
HUGHES CT. 085

086 MUN 1070 PINE ST

CHURCH 083

0970 MUN MUIR ST
077

MUN 1020
PARK LANE 072

MUN 0380
065 CROSS ST

0470 MUN
FAIRMONT AVE 063 CHESAPEAKE CT.
061 MUN 0300
056 CEM

1000 MUN
NOBLE ST 053

30' HI C-C
31' HI C-C
33' HI C-C

SAME

Form 6 HPS (Rev. 1961)

ROAD INVENTORY SHEET

Party Chief F SETTANI
Recorder T. LANDIN
Chainman

T. LANDON
F. KHOLES
VERIFIED
75
CAMBRIDGE

I15

Road No.
Name HIGH ST
Sheet No. 3 OF 4
Date 6-23-65
County DORCHESTER

				1610 MUN (WILLIAMS ST)	121
				MUN 0200	
				119 ("A" ST.)	
				MUN 0370	
				114 ← COURT LANE	
			CEM	112	COURT HOUSE
			CHURCH	111	
			0320 MUN	MUN 1340	
			CHURCH ST	110	SPRING ST
			CAMBRIDGE P.O.	108	
			0890 MUN		
			LOCUST ST ←	101	MUN 1090 POPLAR ST

FAU 7403 RURAL ARTERIAL MINOR

HPMS 6669 90101

30'K
C-C
(BRICK)

SAME

Form 6 HPS (Rev. 1961)

ROAD INVENTORY SHEET

Party Chief F. SETTAN
Recorder T. LANDIS
Chainman

LANDIS
F. RHODES
VERIFIED
75

Road No.
Name HIGH ST
Sheet No. 4 OF 4
Date 6-23-65
County DORCHESTER

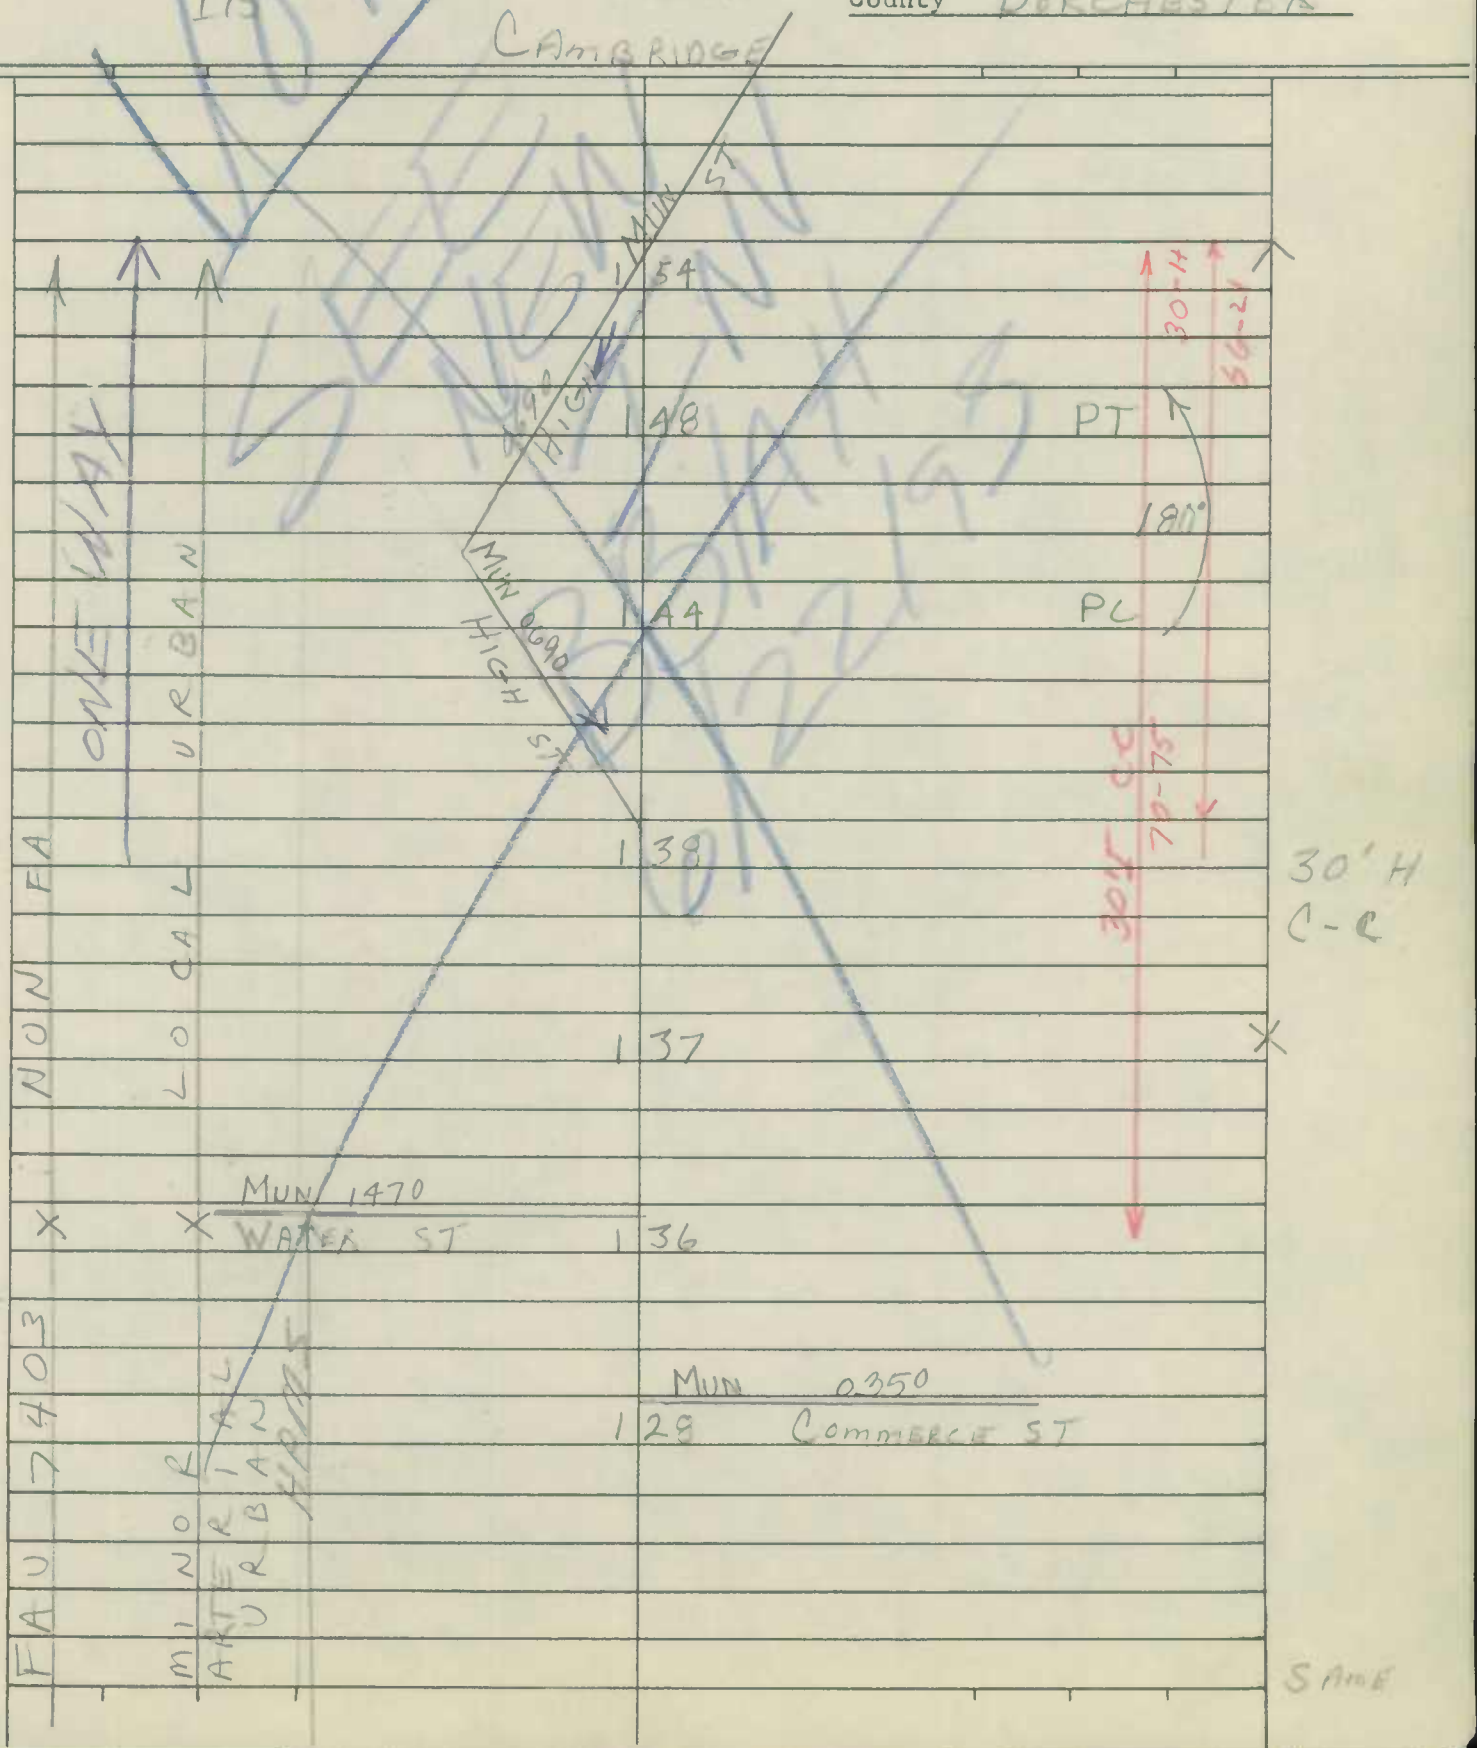

Form 6 HPS (Rev. 1961)

ROAD INVENTORY SHEET

Party Chief F SETTAN T. LANDCT

Recorder C FORREST F. RHODES

Chainman

VERIFIED 75

CAMBRIDGE

Road No. 0720

Name HUBBARDS ~~ST~~ ~~ST.~~ ST.

Sheet No. 1 OF 1

Date 4-30-65

County DORCHESTER

4 TOWNS 75-93

SEE NEW INV. 80-11

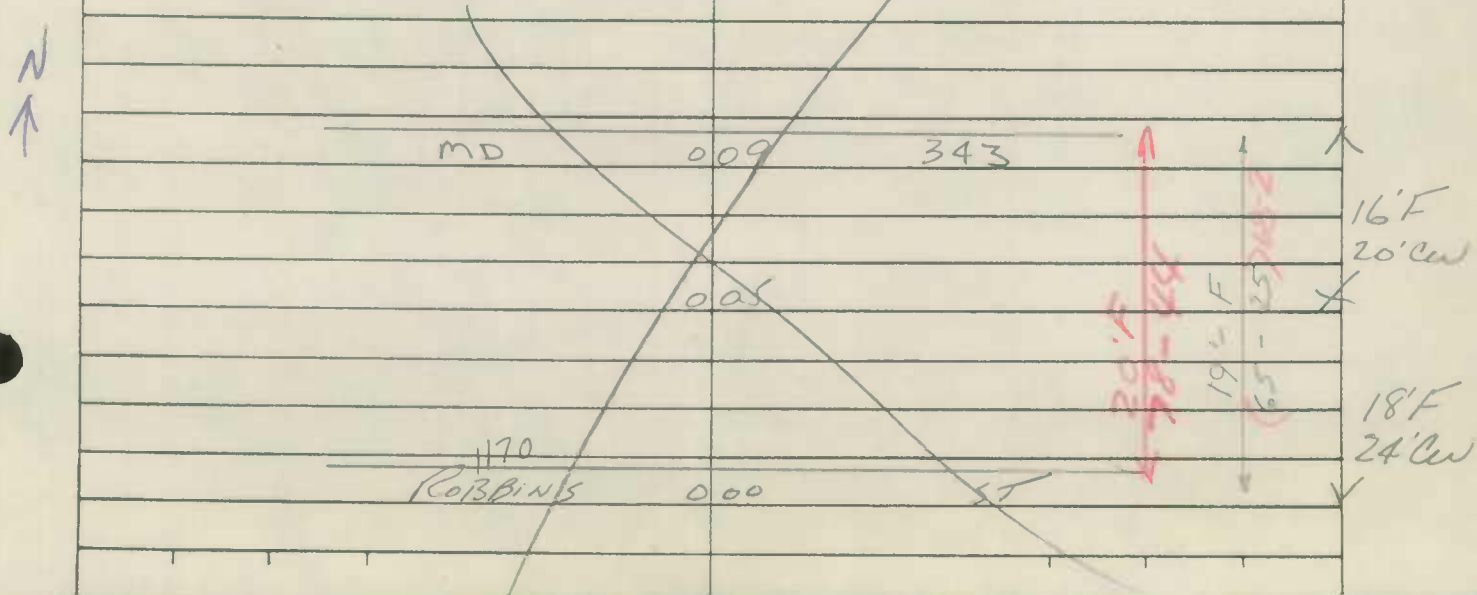

SHA 51.3-8
11-15-72

STATE HIGHWAY ADMINISTRATION OF MARYLAND

BB 84-4
RM 1-29-85

ROAD INVENTORY SHEET

Party Chief FS
Recorder CE
Helper TL

VER 10-17-25
TL & FR

Map No. I15

Road No. 520
Road Name LECOMPTE ST
Sheet No. 1 of 1
Date 5-21-65
County DORCH
State Coordinates

REWRIT! 8-19-81 JTS

CAMBRIDGE

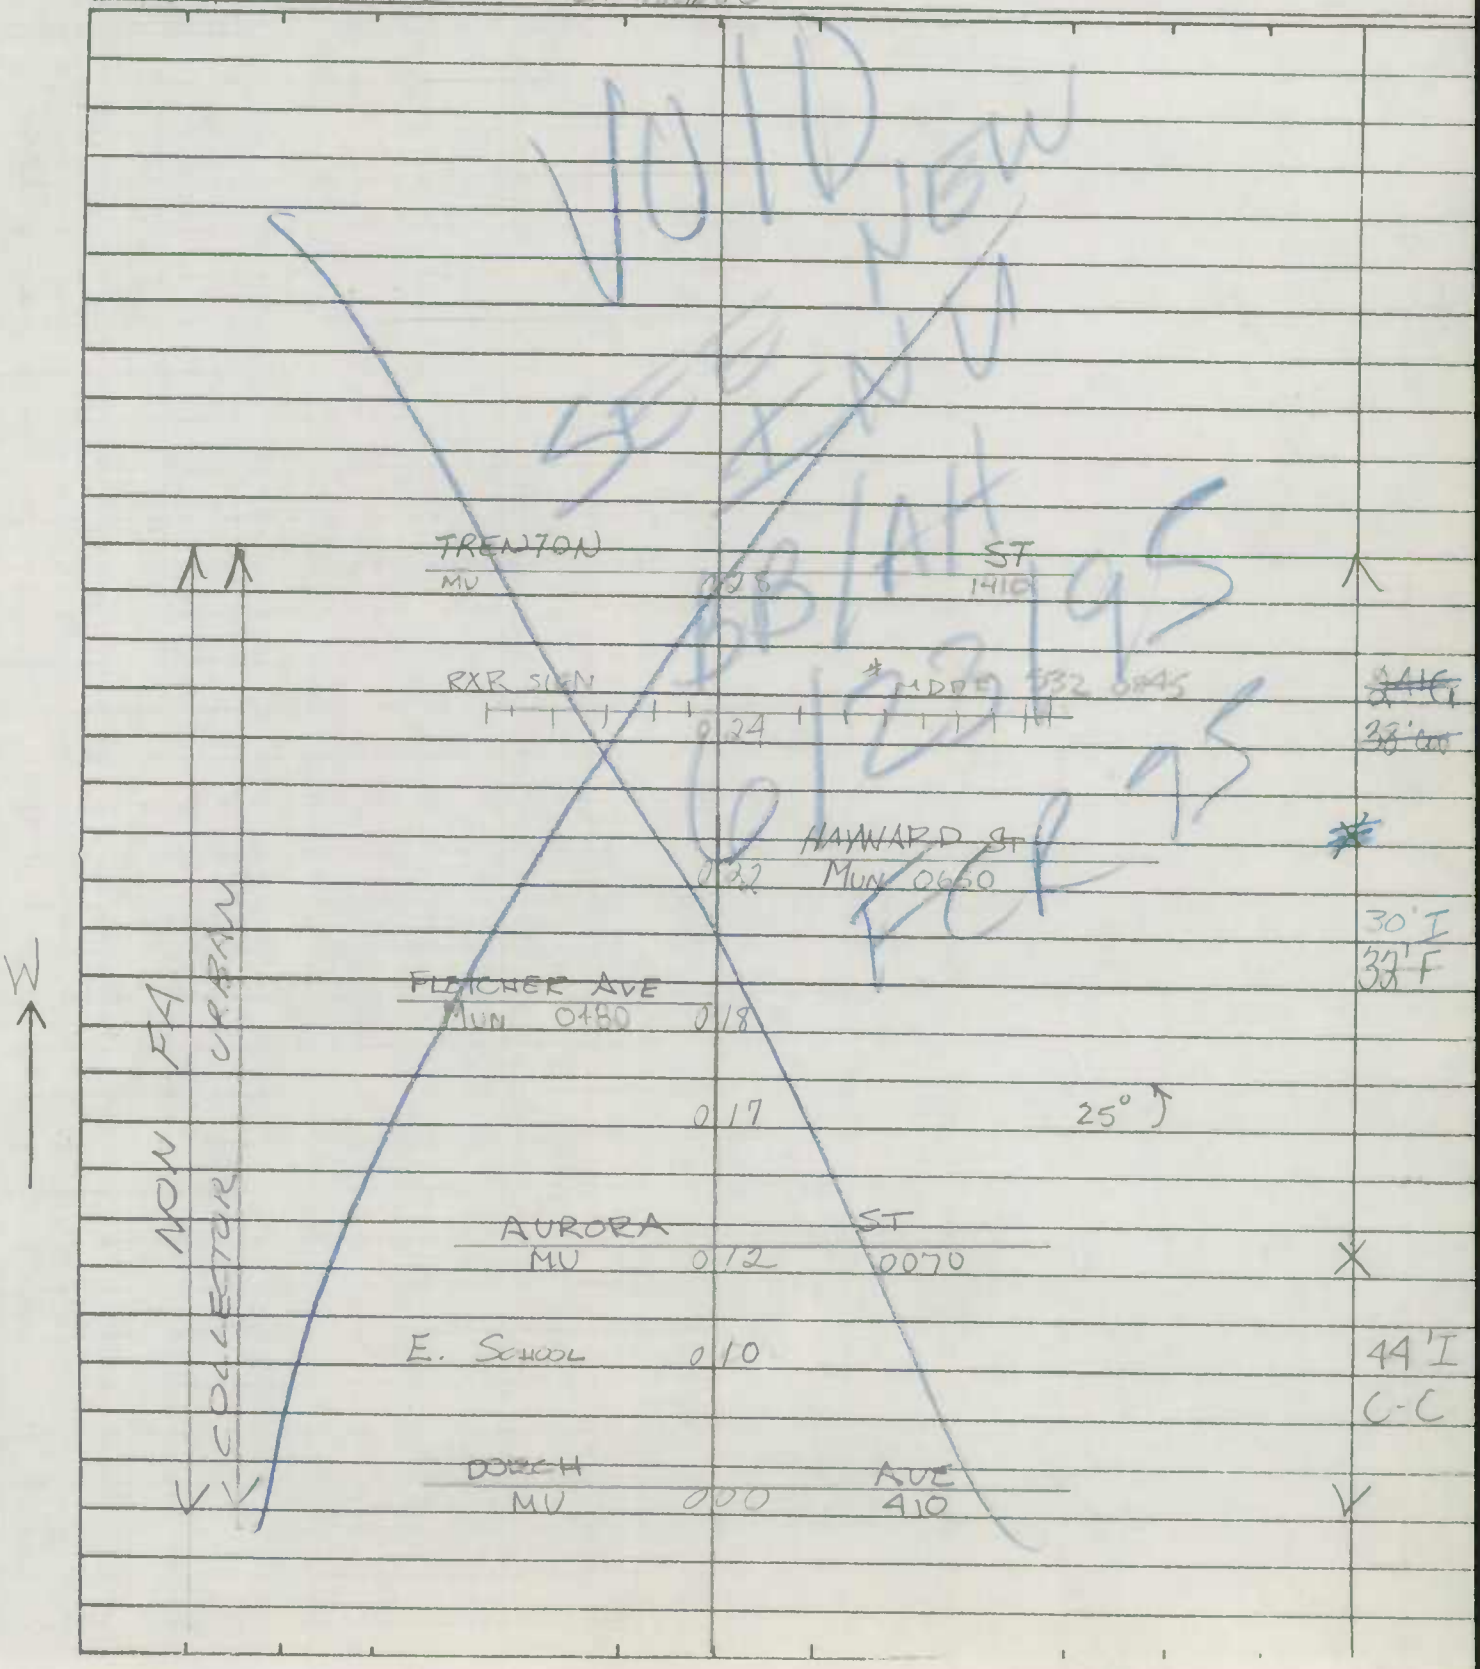

SHA 51.3-8
11-15-72

ROAD INVENTORY SHEET

Road No. _____
Road Name _____
Sheet No. _____
Date _____
County _____
State Coordinates _____

Form 6 HPS (Rev. 1961)

ROAD INVENTORY SHEET

Party Chief F.S.
Recorder C.F.
Chainman T.L.

LANDON — T. RHODES
VERIFIED 10/17 75 CAMBRIDGE

Road No. 0820
Name LEComPTE ST
Sheet No. 1 OF 1
Date 5-21-65
County DOR.
12-13

1410
TRENTON 028 ST

RXR SIG 024

MODE #12 532 0845

HOA
RICHARD AVE
HAYWARD ST. 022

(FLETCHER AVE) 018

CAM WAT. TANK 017

0870
AURORA 012 ST.

E. SCHOOL 010

0410
DORCHESTER 000 AVE

NORTH CAMBRIDGE URBAN

W

25'

24'G
30'CW

44'G
C-C

SHA 51.3-8
11-15-72

STATE HIGHWAY ADMINISTRATION OF MARYLAND

ROAD INVENTORY SHEET

LEONARDS LA

Party Chief F SETTAN
Recorder C FORREST
Helper

BB REV 10-73
FR-4 Map No. I15

Road No. 840
Road Name ~~LEANARDS LA~~
Sheet No. 1 of 1
Date 4-26-65
County DORCH
State Coordinates

RELOCT 18-P-81, JTSC

81-25

15-3,7

GLASGOW ST ←

MU → 0 81 → 520

0700 MUN

HOLLAND HOUSE 0 75

GLOVER AVE

540 MUN 0 68

PARK LA

0 57 MUN 1020

0 48

COSBY

~~CROSBY~~ AVE

0 39 MUN 365

GAS STORAGE TANKS (SHELL) 0 30

0 24

CAMBRIDGE DEPT OF PUB. WKS 0 20

WASHINGTON MD

0 00 ST 343

FUTURE MUNICIPAL AVENUE

N

30'I
C-C

X

~~P-C~~

~~24'~~
30'I
~~C-C~~

X 44'I

~~30'I~~

C-C

X

26'RI

30'CU

SHA 51.3-8
11-15-72

ROAD INVENTORY SHEET

Road No. _____
Road Name _____
Sheet No. _____
Date _____
County _____
State Coordinates _____

Form 6 HPS (Rev. 1961)

ROAD INVENTORY SHEET

Party Chief F SETTAN
Recorder
Chainman C FORREST

VERIFIED 10/23/75 CAMBRIDGE

Road No. 0840
Name LEONARDS Co LANE
Sheet No. 1 OF 1
Date 4-26-65
County DORCHESTER

0520
GLASGOW → 0 81 → ST

0700
HOLLAND AVE 0 75

0540
GLOUCK AVE 0 68

1020
PARK LA 0 57
COSBY AVE 0365 0 39

GAS STORAGE TANKS (SHELL) 0 30
0 24
CAMBRIDGE DEPT OF PUB. WORKS 0 20

WASHINGTON AVE 0 00 ST. 343

FA
COLLECTOR-URBAN
NON

N

30'C
C-C

18'C
24'CW

Form 6 HPS (Rev. 1961)

87-1 A/T

(90-03 A/T)

ROAD INVENTORY SHEET

Party Chief F. SETTANNI

Recorder J. LANDON

Chainman

LANDON

I. HUET

VERIFIED 10/23/75

CAMBRIDGE

Road No. 0890

Name LOCUST ST

Sheet No. 1 OF 2

Date 6-3-65

County DORCHESTER

I15

85-1

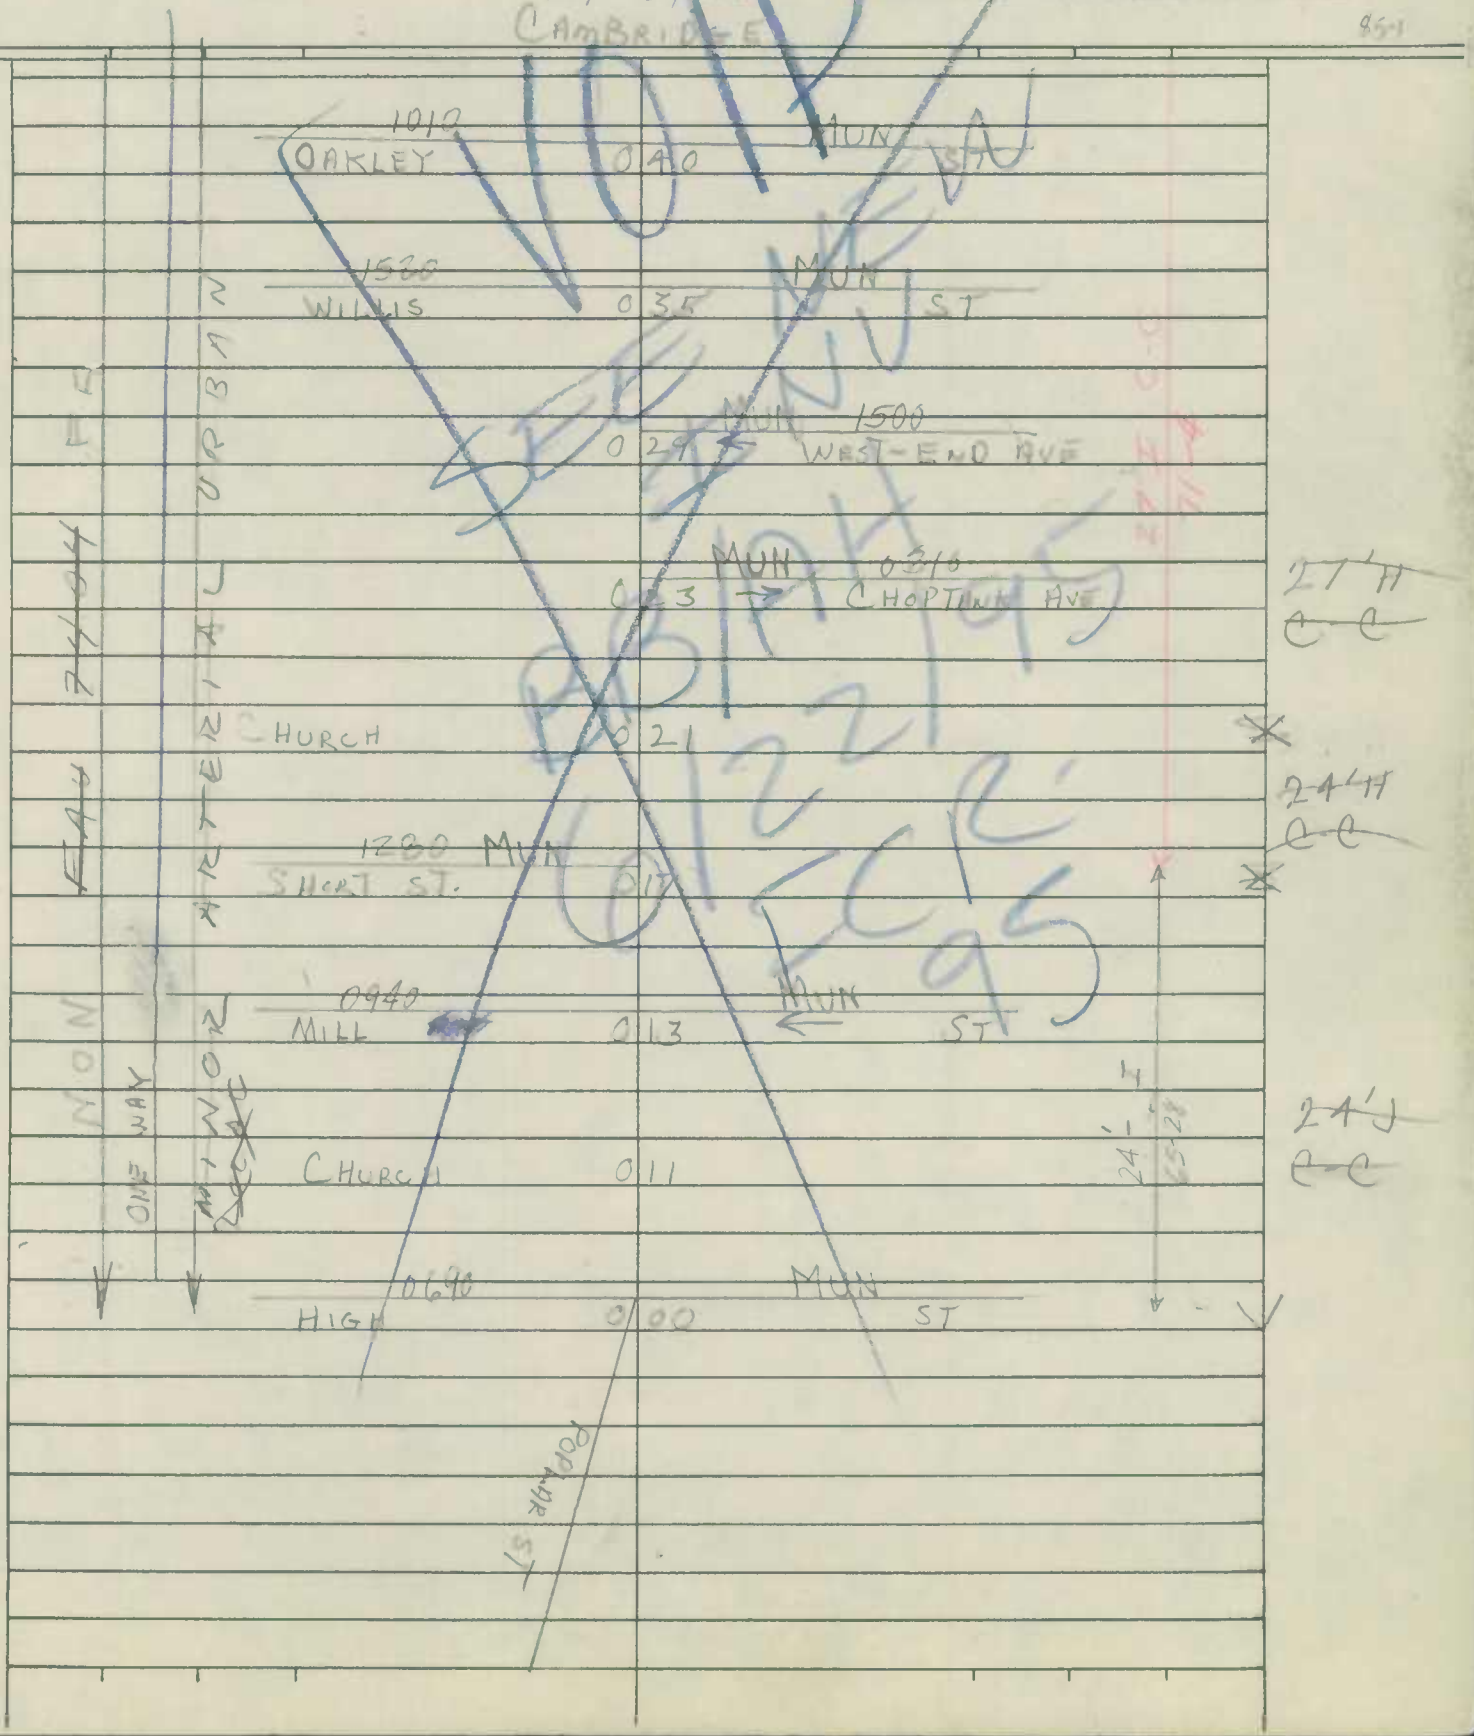

Form 6 HPS (Rev. 1961)

ROAD INVENTORY SHEET

Party Chief F. SETTANNI
Recorder T. LANDON
Chainman

LANDON
L. MILES
VERIFIED
75
CAMBRIDGE

Road No.
Name LOWELL ST
Sheet No. 2 OF 2
Date 6-3-65
County DORCHESTER

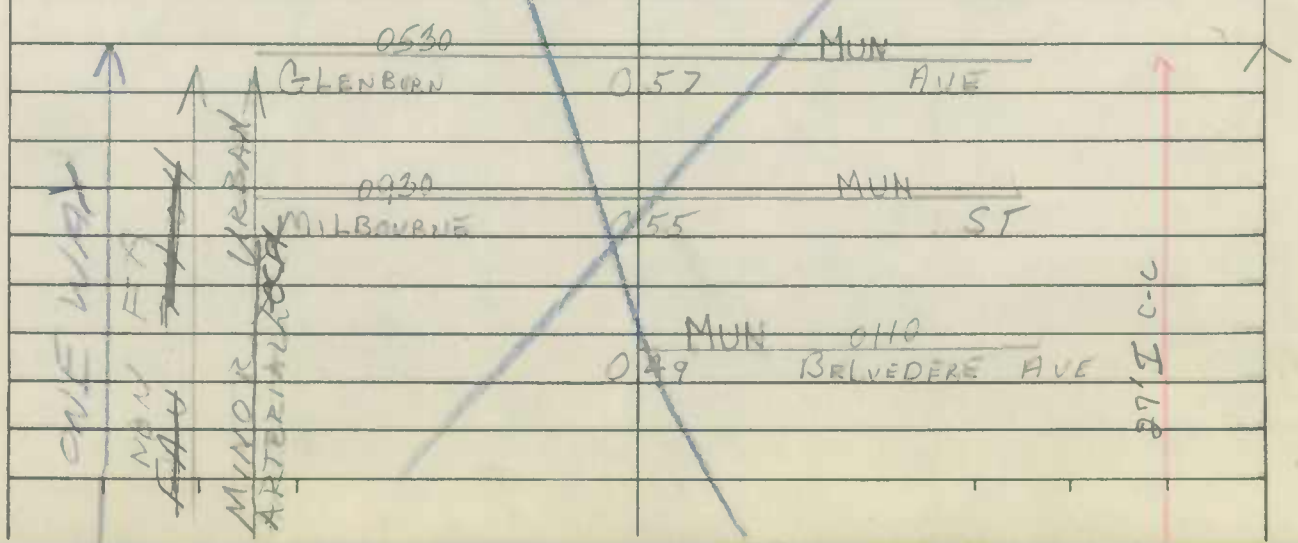

Form 6 HPS (Rev. 1961)

ROAD INVENTORY SHEET

Party Chief F SETTAN
Recorder C FORREST
Chairman

Road No. 0900
Name MACES LA
Sheet No. 1 OF 1
Date 4-27-65
County DORCHESTER

I15

BB 84-18 RM 1-28-85 VERIFIED 10/22/75 CAMBRIDGE

72-14

VOID SEE NEW

RD COTT

BAYLY (MUN) 0100

0 70

SCHOOL SHOP 14'F 0.09

0 61

0 49

ENT TO SCHOOL MACES LANE HIGH SCHOOL

0 45

ENT TO SCHOOL

0140 MUN BRADLEY AVE

0 36

0 14

MUN 1170 ROBBINS ST

0 11

0 08

MD

0 00

343

FA

RURAL

SOLECTED

MAIN

NON

18'C 22'CW

ROAD INVENTORY SHEET

MU 0903

Party Chief F SETTANT — LANDON
Recorder J. FORREST — I. RHODES
Chainman T.L. — VERIFIED
Cambridge 75

Road No. C0139
Name MAPLE DAM Rd.
Sheet No. 1 of 1
Date 5-5-65 9-13-74
County DORCHESTER
REV 12-10-73

	H	1	69	H
		1	67	DR
		1	40	F
		1	20	DR
	H	1	14	
	F	0	93	F
	F	0	80	
		0	61	H
	F	0	47	H
	H	0	38	
		0	35	SIGN-CORP LINE
	30°	0	29	
		0	26	
		0	25	
		0	23	
		0	18	35° F
	F	0	07	
	M.D.	000		16

FAS 1833 MAJOR COLLECTOR RURAL

ABANDONED 73-35 MU 0903 Rd.

20' I
26' Gr

SHA 51.3-8
11-15-72

STATE HIGHWAY ADMINISTRATION OF MARYLAND

ROAD INVENTORY SHEET

Party Chief FS
Recorder CF
Helper TL

Map No. L 15

Road No. 905
Road Name MARKET ST
Sheet No. 1 of 1
Date 5-28-65
County DORCH
State Coordinates

LEWIS : 8-19-81 JTSC

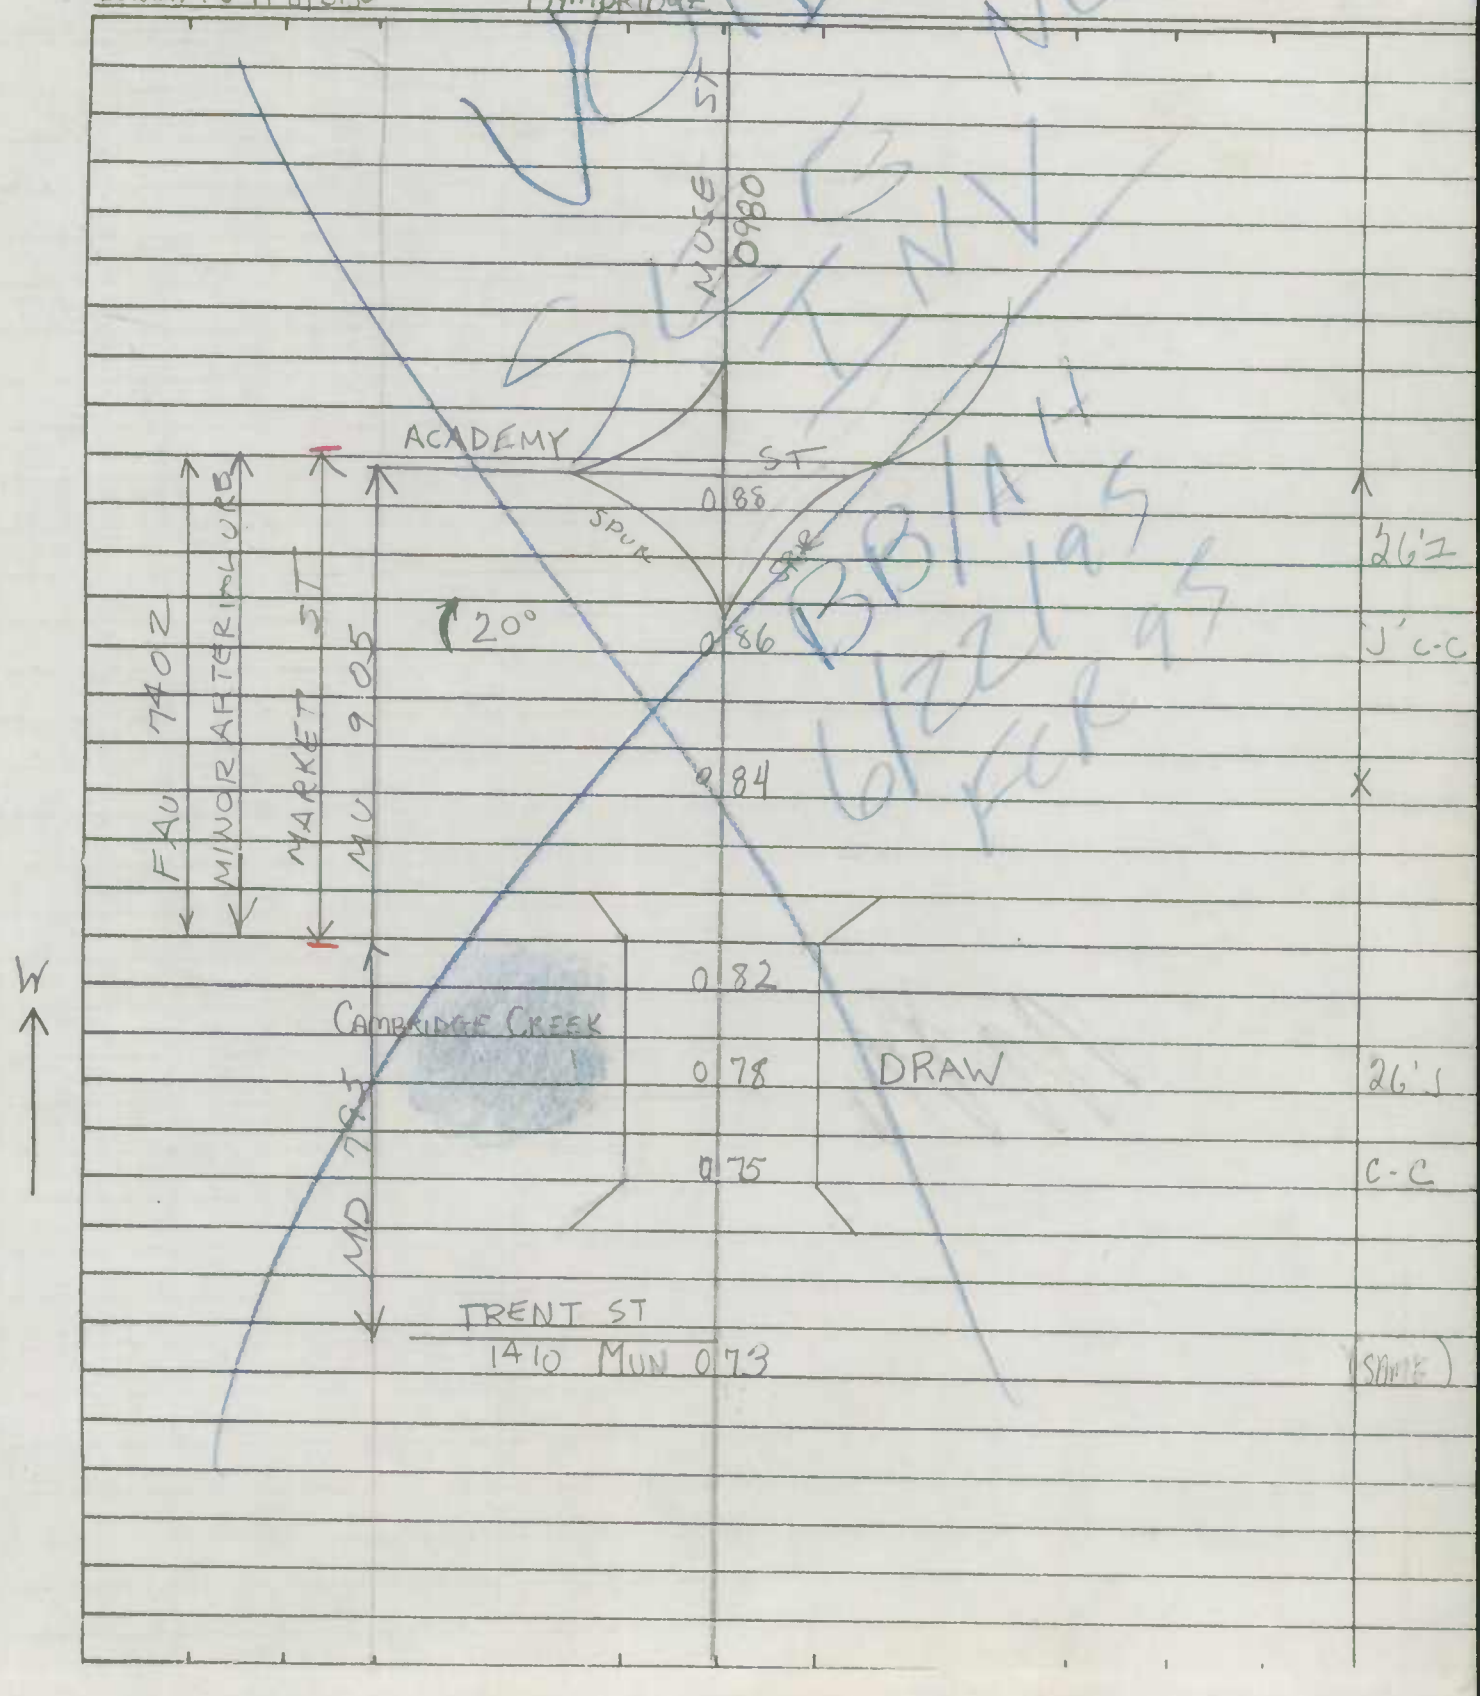

SHA 51.3-8
11-15-72

ROAD INVENTORY SHEET

Road No. _____
Road Name _____
Sheet No. _____
Date _____
County _____
State Coordinates _____

Form 6 HPS (Rev. 1961)

Mun. No. 0905

ROAD INVENTORY SHEET

Party Chief E.S
Recorder C.E
Chainman T.L

T. LINDOW
T. VARNADOS
VERIFIED
Cambridge 2/9/75

Road No. (Market St.)
Name MARYLAND RD
Sheet No. 20F 2
Date 5-28-75
County DOR

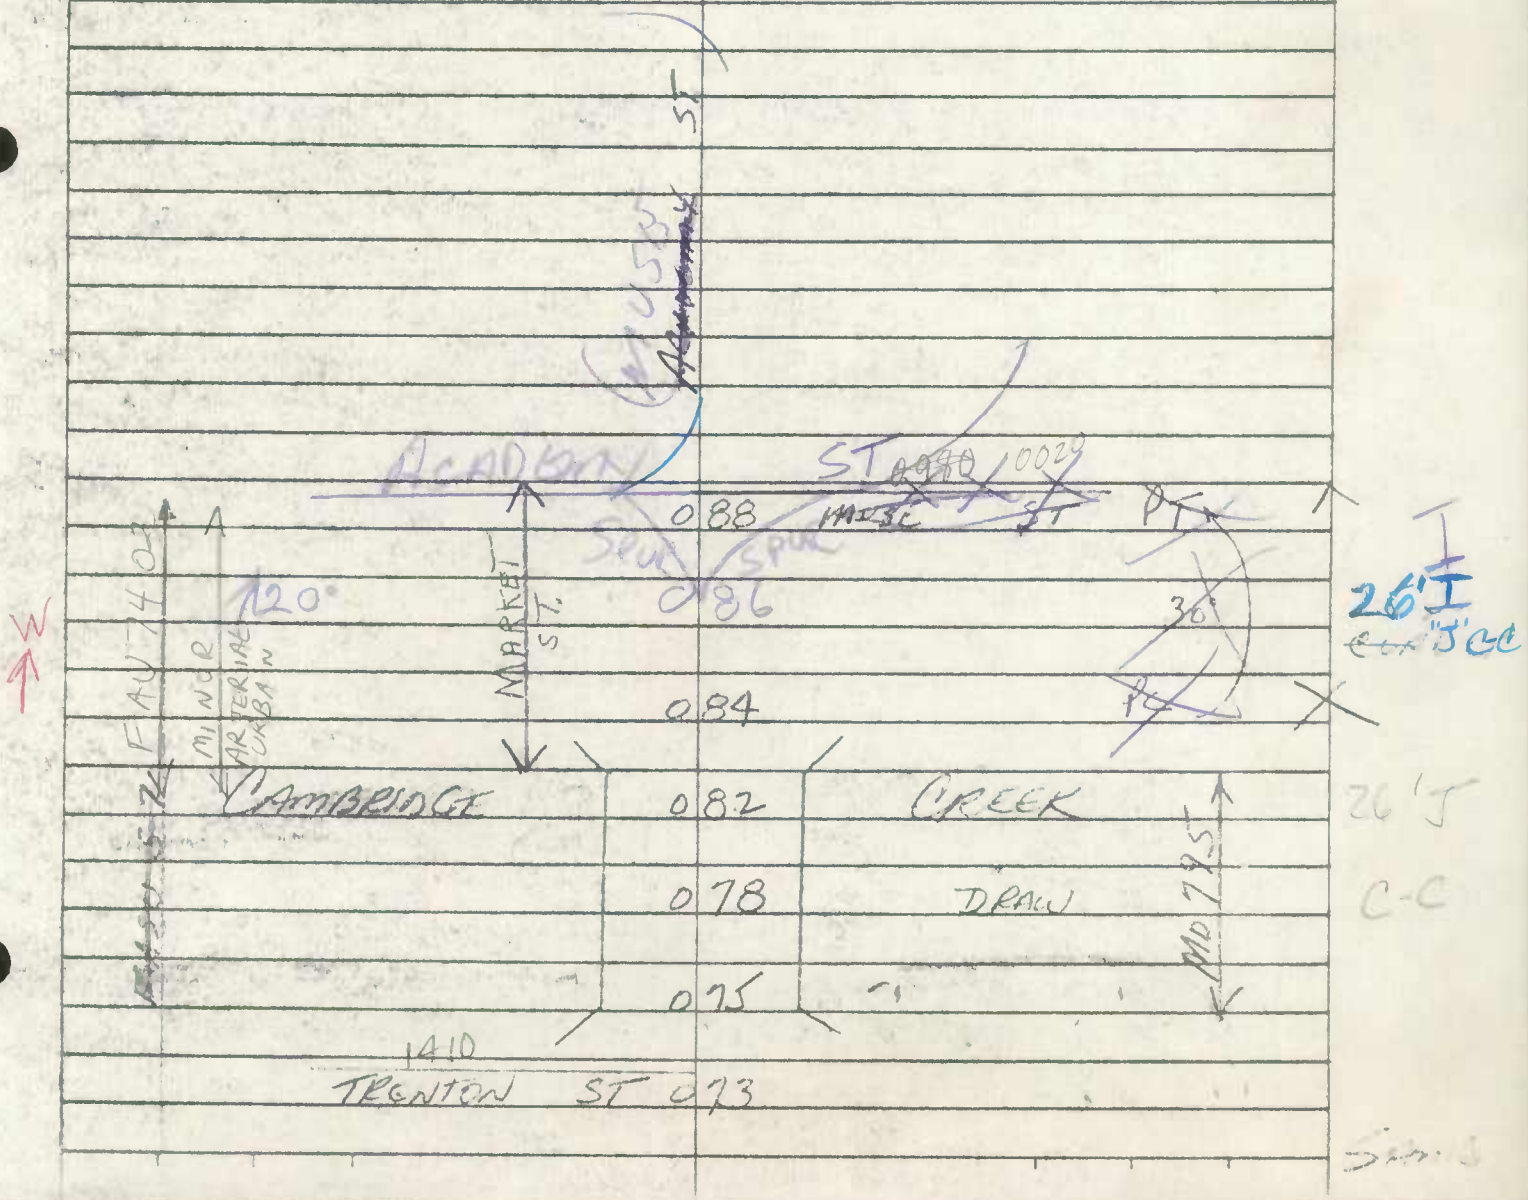

Form 6 HPS (Rev. 1961)

883
2-14-89
SB, DW

ROAD INVENTORY SHEET

Party Chief F.S.
Recorder C.F.
Chainman T.L.

1-15

LANDCT
T. CHOLES
VERIFIED
75
CAMBRIDGE

Road No. 0910
Name MARYLAND AVE.
Sheet No. 1 OF 2
Date 5-28-65
County DOR.

74-17 773 89-1

FAU 7402 FEDERAL AID URBAN SYSTEM LOCAL

		R/R TRACKS	0.72	ABAND.
			0.69	
			0.66	
0.50	HAYWARD		0.61	MUN ST
	CHURCH		0.38	
0.40	FRANKLIN		0.53	MUN ST
0.70	AURORA		0.41	MUN ST
0.40	DORCHESTER		0.34	MUN AVE.
			0.26	
	U.S.		0.23	50
	SUNBURST		0.19	HWY.
1.50	RAMBLER		0.16	MUN RD
0.80	KILLARNEY		0.09	MUN RD
0.70				MUN
	HIAWATHA		0.03	AV
0.80	CRUSADER RD		0.00	ABAND. LA

50'I J-CC 2ML
14'I 2ML J-CC
46'I J-CC
2ML
16'H
46'I
C-C
2ML
40'I J-CC
40'G J-CC
40'G
40'CW

Form 6 HPS (Rev. 1961)

ROAD INVENTORY SHEET

Party Chief F.S
Recorder C.F
Chainman T.L

1-15

LANDC
I. ...ES
VERIFIED 78

MUN. 910

Road No.
Name MARYLAND Ave
Sheet No. 2 of 2
Date 5-28-61
County DOR

VOID
SEE NEW
BB/AH
6/23/95
FCR 95

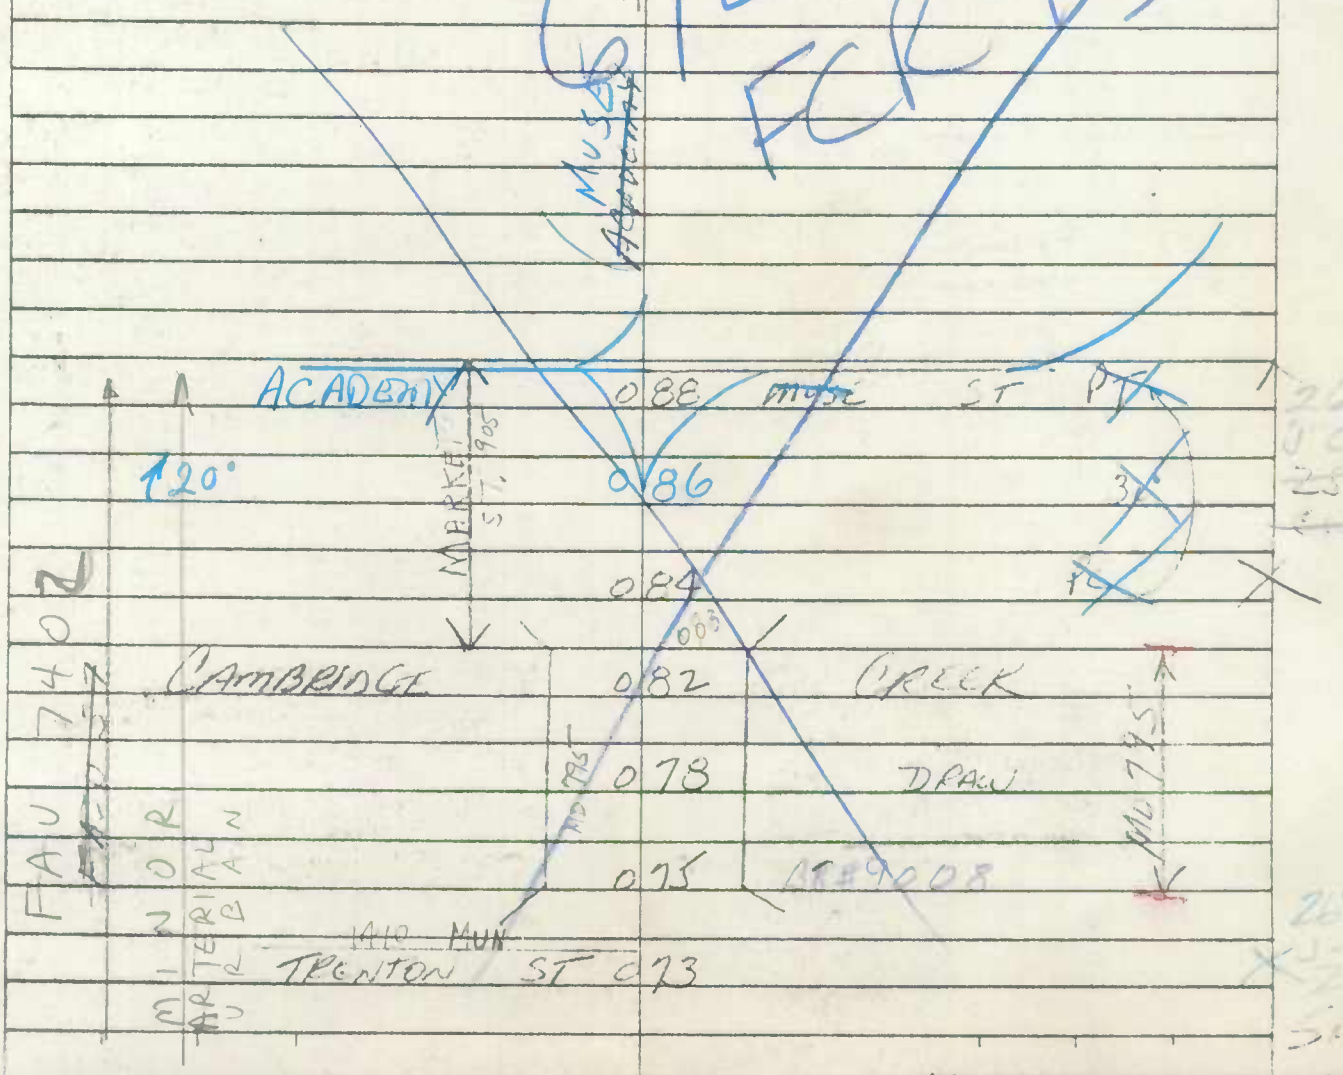

Form 6 HPS (Rev. 1961)

DT REV FA-3-6-79

ROAD INVENTORY SHEET

Party Chief T. LANDON
Recorder W. WARFIELD
Helper

Road No. 0925
Road Name METEOR AVE. 10/16/75
Sheet No. 1 of 1
Date 2-1-72
County DORCHESTER

70-57

CAMBRIDGE

LANCA ITIONS VERIFIED

W

CEDAR ST.

S.B. SUNHURST — HWY. LA.
US 017 50
LA.

N.B.

010 ~~017~~ PROPOSED
007 ~~390~~ CRUSADER RD.
CRUSADER RD. # 2 MOL 390

0391 0 06

0 02

ROAD 0 00 END

40'I
J'c-c

X

36'I
J'c-c

15°

V

Form 6 HPS (Rev. 1961)

ROAD INVENTORY SHEET

Road No. _____

Road Name _____

Sheet No. _____

Date _____

County _____

Form 6 HPS (Rev. 1961)

Mun. No. 0950

MOORELAND ST AVE.

ROAD INVENTORY SHEET

Party Chief F. SETTE

Recorder T. LANDON

Chainman

LANDC[illegible]

[illegible] CHUDLEIGH

VERIFIED

10/21/75

CAMBRIDGE

Road No.

Name ST. "B"

Sheet No. 1 of 1

Date 6-11-63

County DORCHESTER

74-15

0220

CEDAR 04500 ST

1450

VIRGINIA 07000 AVE

BRAN

BROWHAWN ST.

200 0450

31'G

C-RT.

36'CW

SHA 51.3-8
11-15-72

STATE HIGHWAY ADMINISTRATION OF MARYLAND

ROAD INVENTORY SHEET

Party Chief F SETTAN
Recorder T LANDON
Helper

VER 10-28-75 JLEFR

Map No. 1-15

Road No. 0980
Road Name MUSE ST
Sheet No. 1 OF 1
Date 6-15-65
County DORCH
State Coordinates

REVISED 61-B-61 JTSC CAMBRIDGE

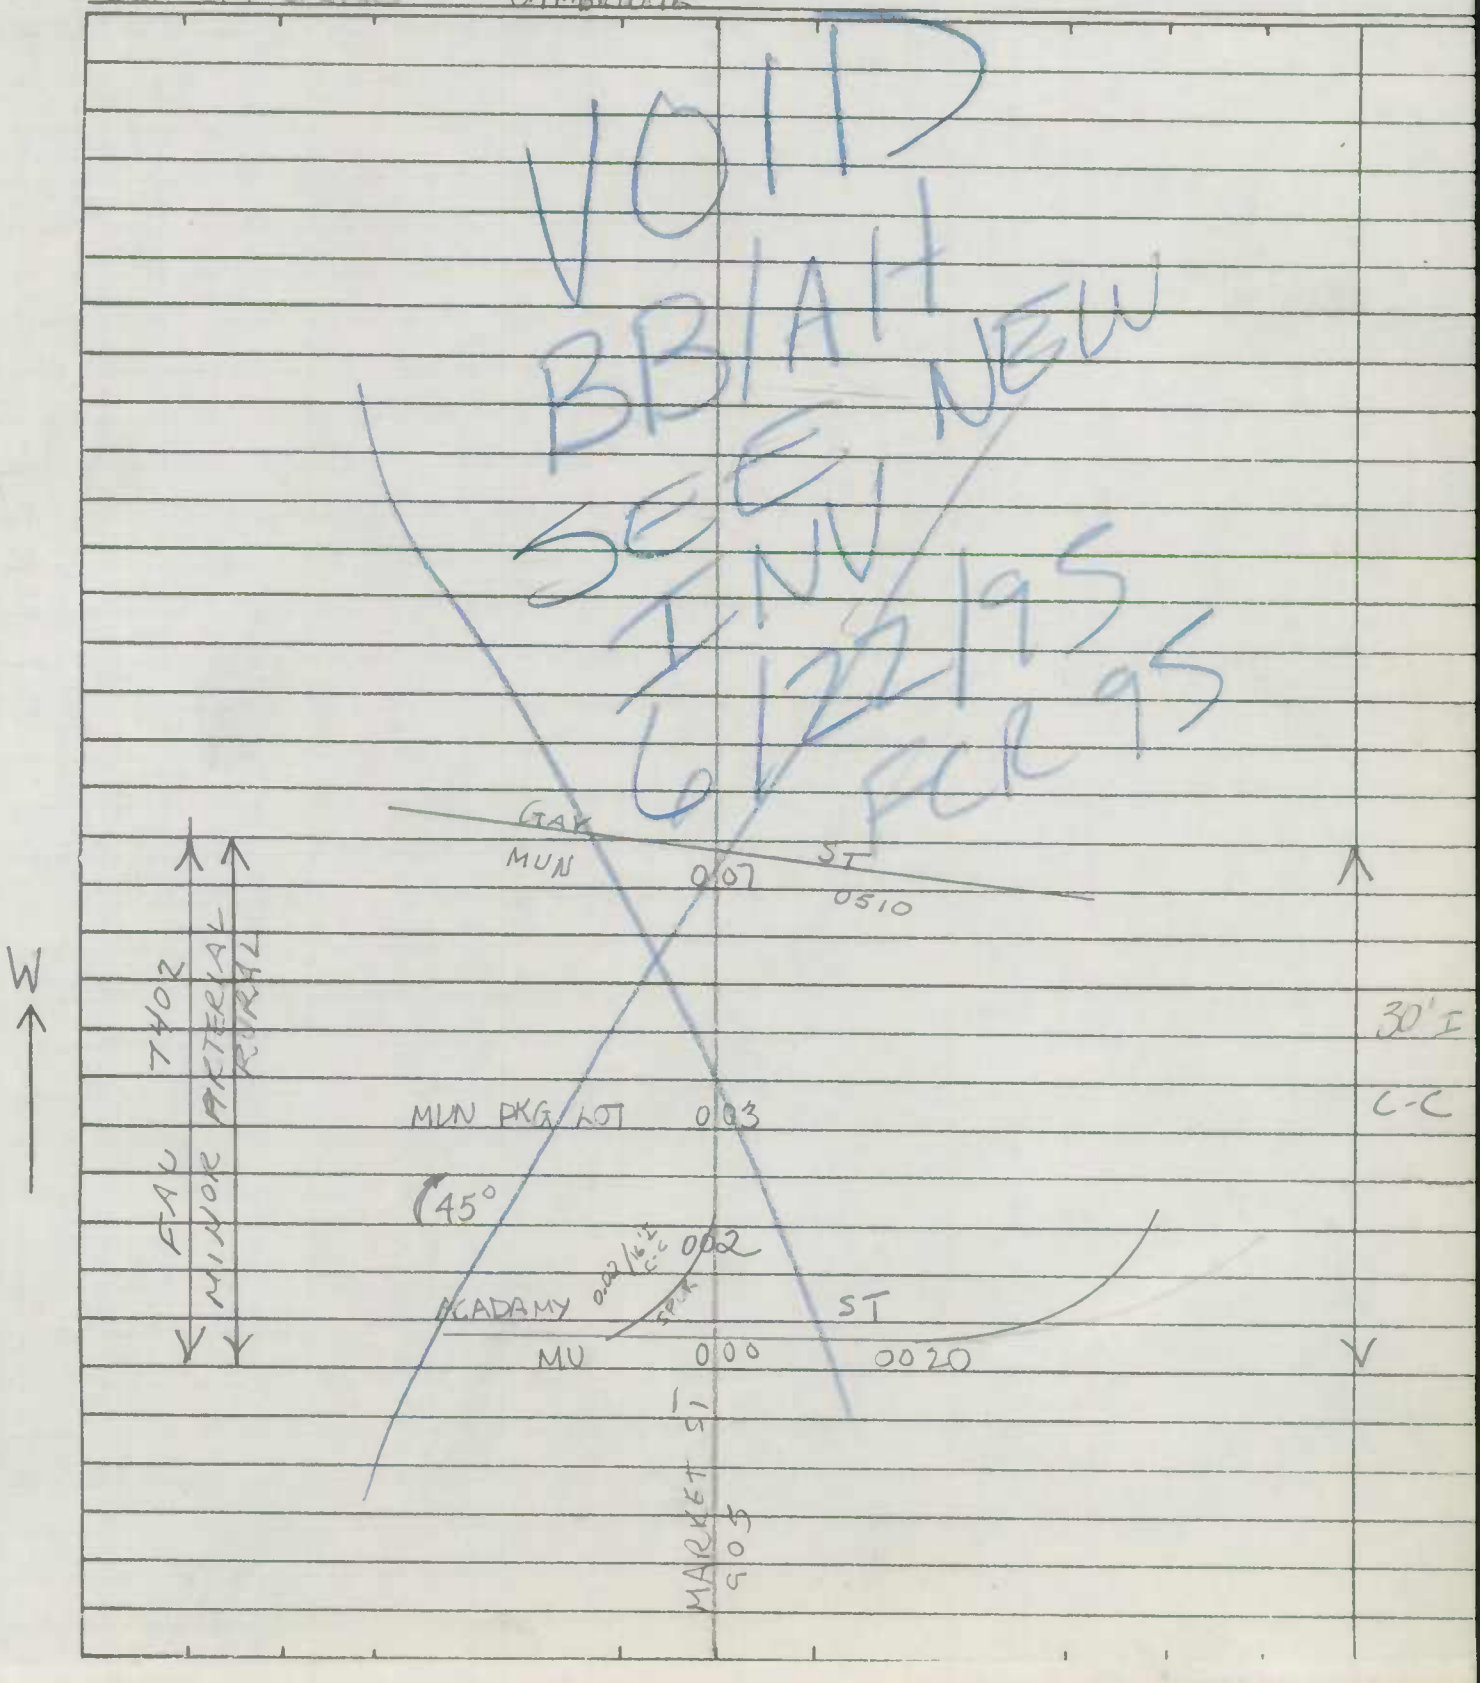

SHA 51.3-8
11-15-72

ROAD INVENTORY SHEET

Road No. _____
Road Name _____
Sheet No. _____
Date _____
County _____
State Coordinates _____

Form 6 HPS (Rev. 1961)

ROAD INVENTORY SHEET

Party Chief F. SETTA
Recorder T. LANDON
Chainman

VERIFIED
10/21/75
CAMBRIDGE

Road No. 0980
Name (MUSE ST.)
Sheet No. 1 of 1
Date 6-15-65
County DORCHESTER

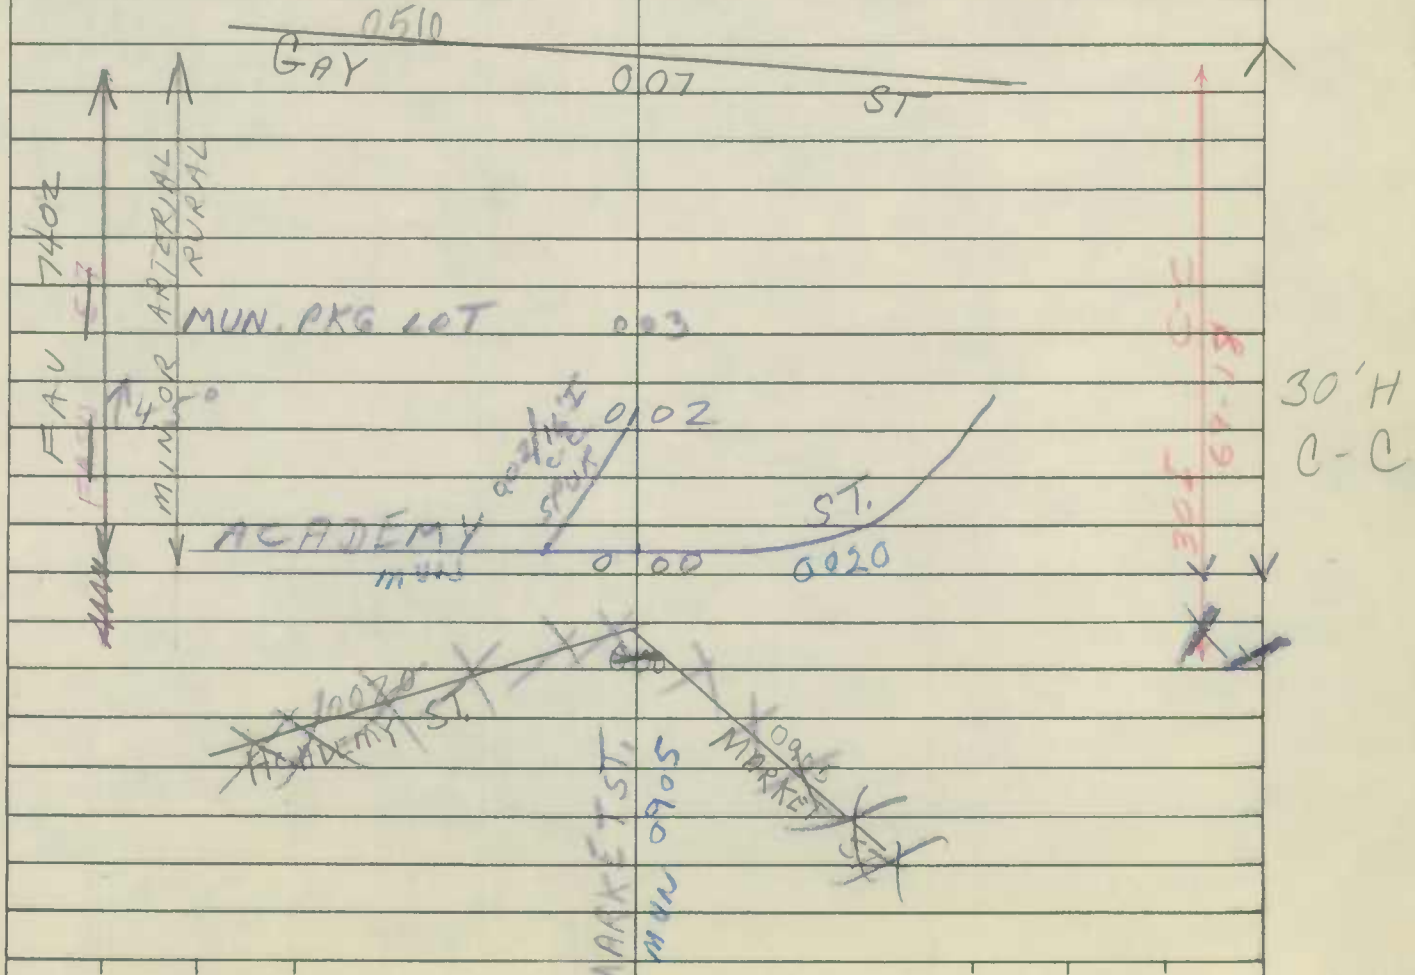

Form 6 HPS (Rev. 1961)

ROAD INVENTORY SHEET

Party Chief F SETTAN
Recorder C ~~FORRES~~
Chainman

T. LANDA
F. RHODES
VERIFIED
1/23/75
CAMBRIDGE

Road No. 1010
Name OAKLEY ST
Sheet No. 1 OF 1
Date 4-23-65
County DORCHESTER

CHOPTANK RIVER

XXXX
~~093~~ 070

0630
HAMBROOKS ~~066~~ 063 AVE

1240
SCHOOL ← ~~056~~ 052 ST ←

1400
TRAVERS ~~046~~ 043 ST

0990
LOCUST ← ~~037~~ 029 ← ST

0580
GLASGOW → ~~028~~ 025 → ST

1020
PARK ~~005~~ 000 LA

GREEN-WOOD AVE

ROAD ~~E.VO~~

30'G I
C-C
16'G
20'GW
33'G
C-C
18'E
24'W

Form 6 HPS (Rev. 1961)

ROAD INVENTORY SHEET

Party Chief F. SETTANI T. LANDON
Recorder T. LANDON F. [illegible]
Chainman

VERIFIED 10/22/75 CAMBRIDGE

Road No. 1070
Name PINE ST
Sheet No. 1 OF 2
Date 6-4-65
County DORCHESTER

0 31 → 1490 WELLS ST

0 28 0120 BETHEL ST

0 27 CHURCH

0 25 0240 CEDAR ST

0 22 ELKS LODGE

DUNNS CT.

0 20 0330 ~~ALLEY #14~~

0 18 → 0390 CROSS ST

0 16 0460 ELM ST

0 14 0400 DORSON ST

0 06 0970 MUIR ST

S

0 03 ALLEY #23 → 8230

500

0490 [illegible]

33/G C-C

Form 6 HPS (Rev. 1961)

ROAD INVENTORY SHEET

Party Chief F SETTAN
Recorder T. LANDON
Chainman

F. LANDON
F. KHOURI
VERIFIED
75
CAMBRIDGE

Road No.
Name PINE ST
Sheet No. 2 OF 2
Date 6-4-65
County DORCHESTER

		RD
0100 BAYLY	0 75	BRADLEY AVE.
	0 71	MUN. 0145
		NORTH DR.
	0 64	MUN. 1005
0130 BOUNDARY AVE	0 59	
		#2
		0960 962
CHURCH	0 52	MOORES AVE
1170 ROBBINS	0 49	ST
Mo. WASHINGTON	0 40	343 ST
		0870
	0 35 ←	~~LINCOLN ST~~ DOUGLAS ST.

20'C
26'CW

27'C
C-C

SAME

Form 6 HPS (Rev. 1961)

ROAD INVENTORY SHEET

Party Chief F SETTHW
Recorder T. LANDEN
Chainman

Road No. 1090
Name POPLAR ST
Sheet No. 1 OF 1
Date 6-18-65
County DORCHESTER

1-15

10/22

CAMBRIDGE

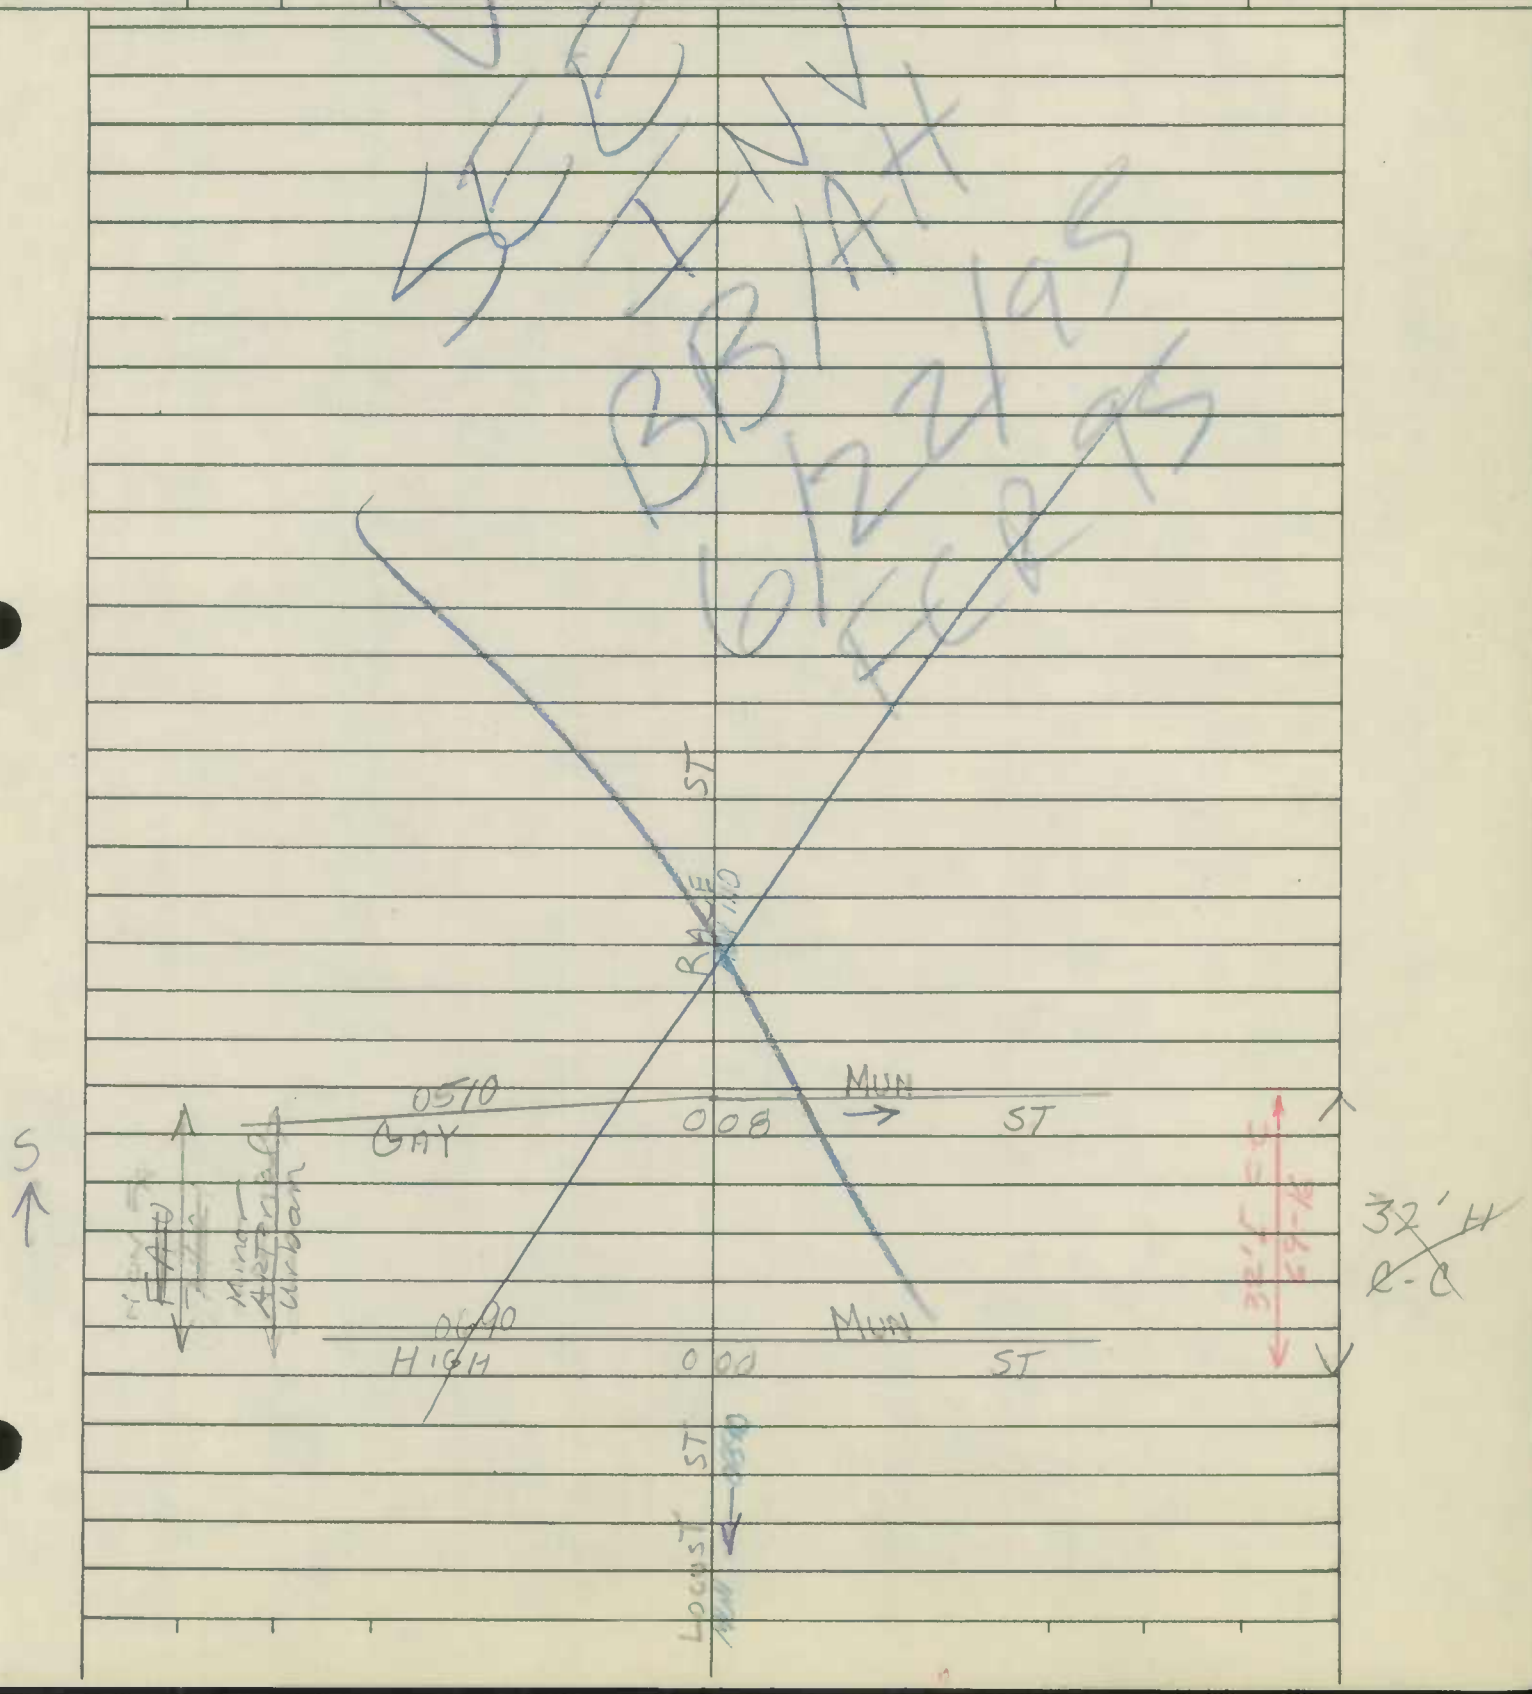

Form 6 HPS (Rev. 1961)

ROAD INVENTORY SHEET

Party Chief F SETTHA
Recorder T. L HAUDN
Chainman

T. LANDIS
F. MAULES
VERIFIED
10/22/75
CAMBRIDGE

Road No. 1110
Name RACE ST
Sheet No. 1 OF 1
Date 6-22-65
County DORCHESTER

1-15

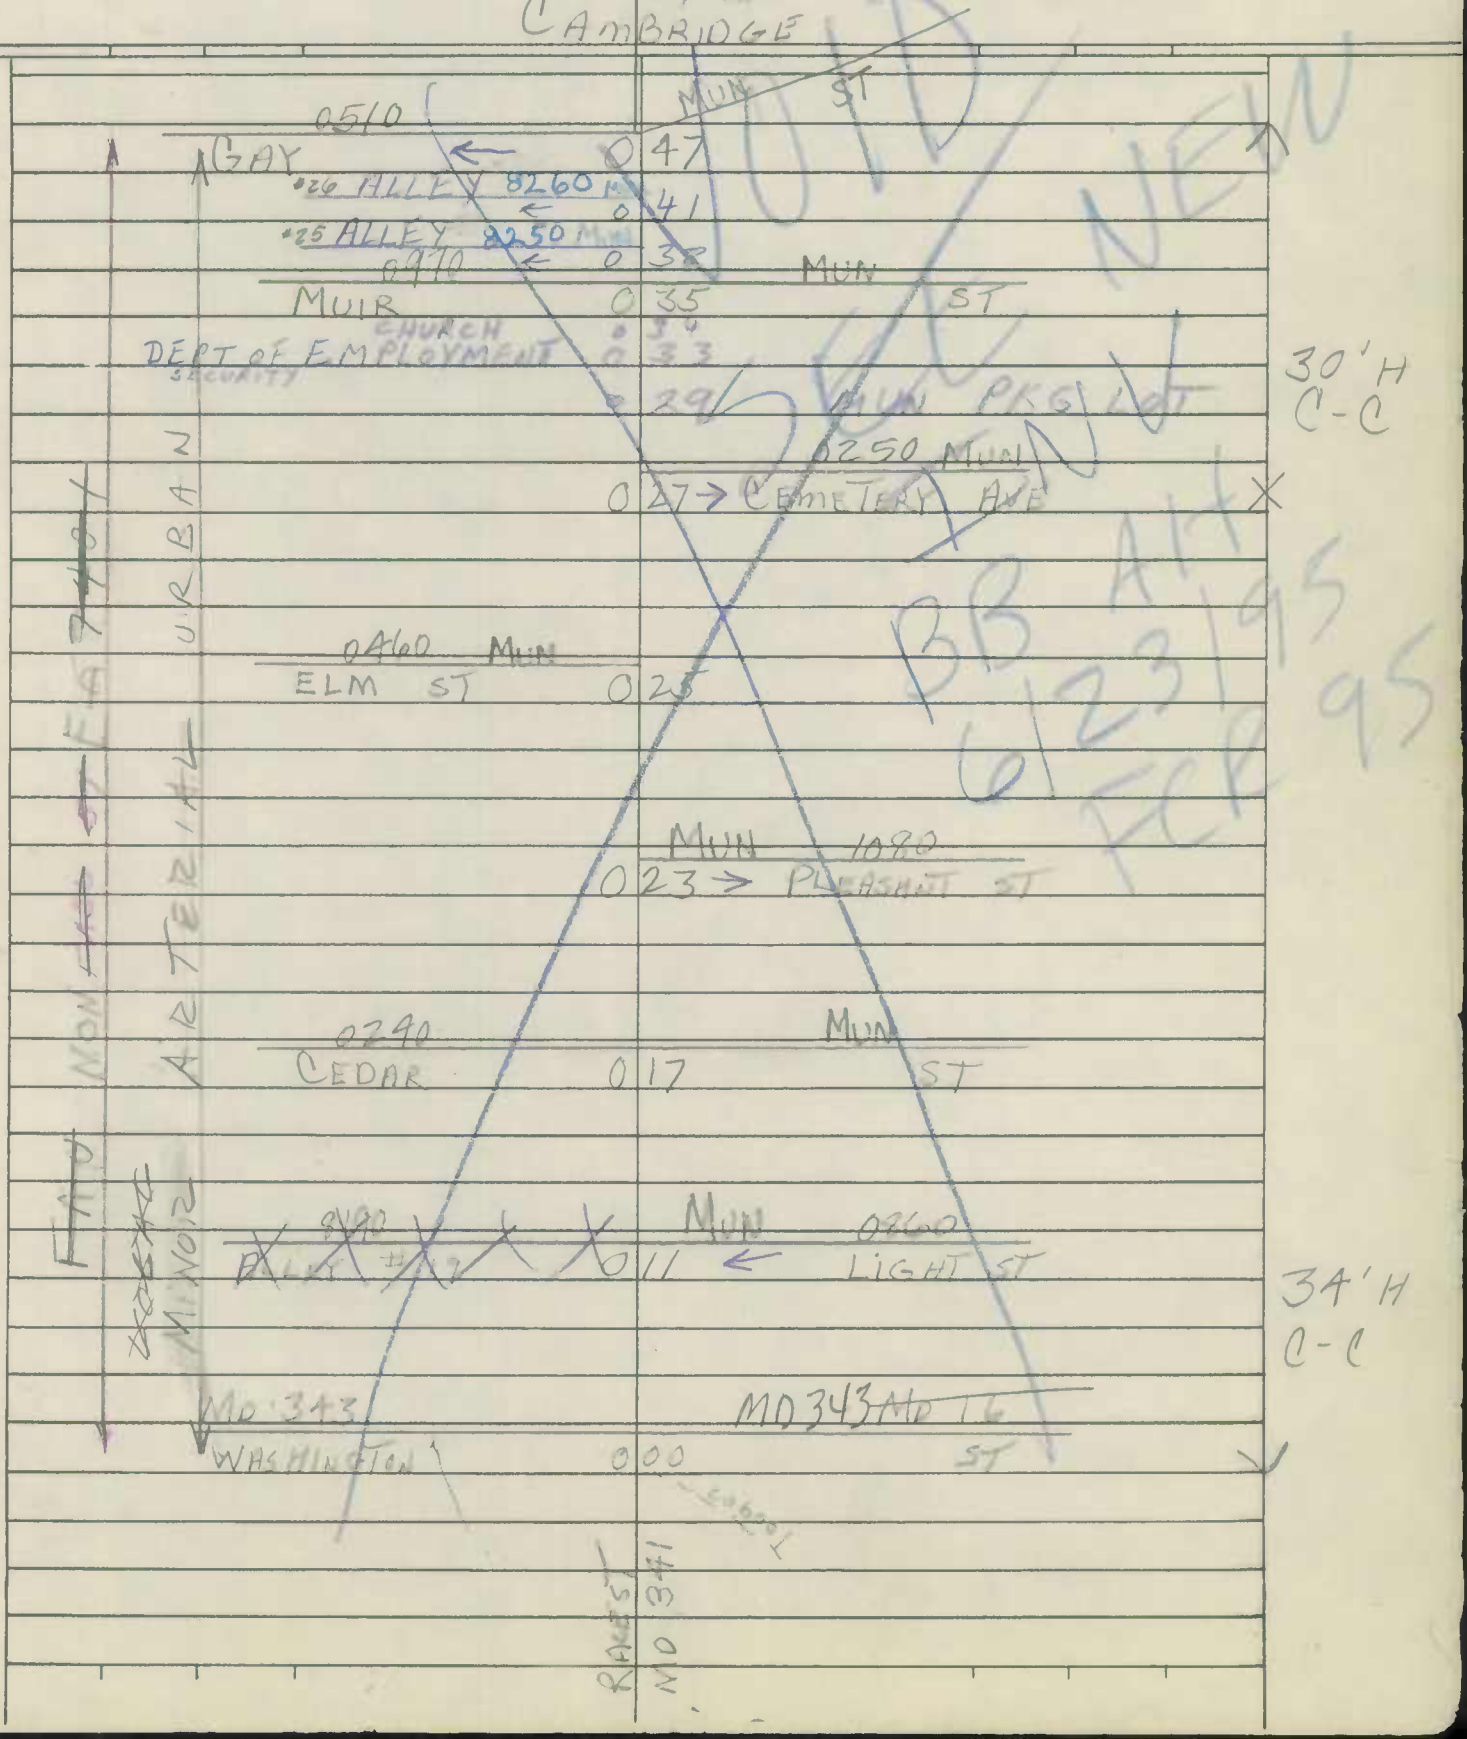

SHA 51.3-8
11-15-72

STATE HIGHWAY ADMINISTRATION OF MARYLAND

ROAD INVENTORY SHEET

Party Chief I. LANDON
Recorder F. RHODES
Helper

Map No.

Road No. MUN. 1120
Road Name RADIANCE DR.
Sheet No. 1 OF 1
Date 10/16/75
County DORCHESTER
State Coordinates

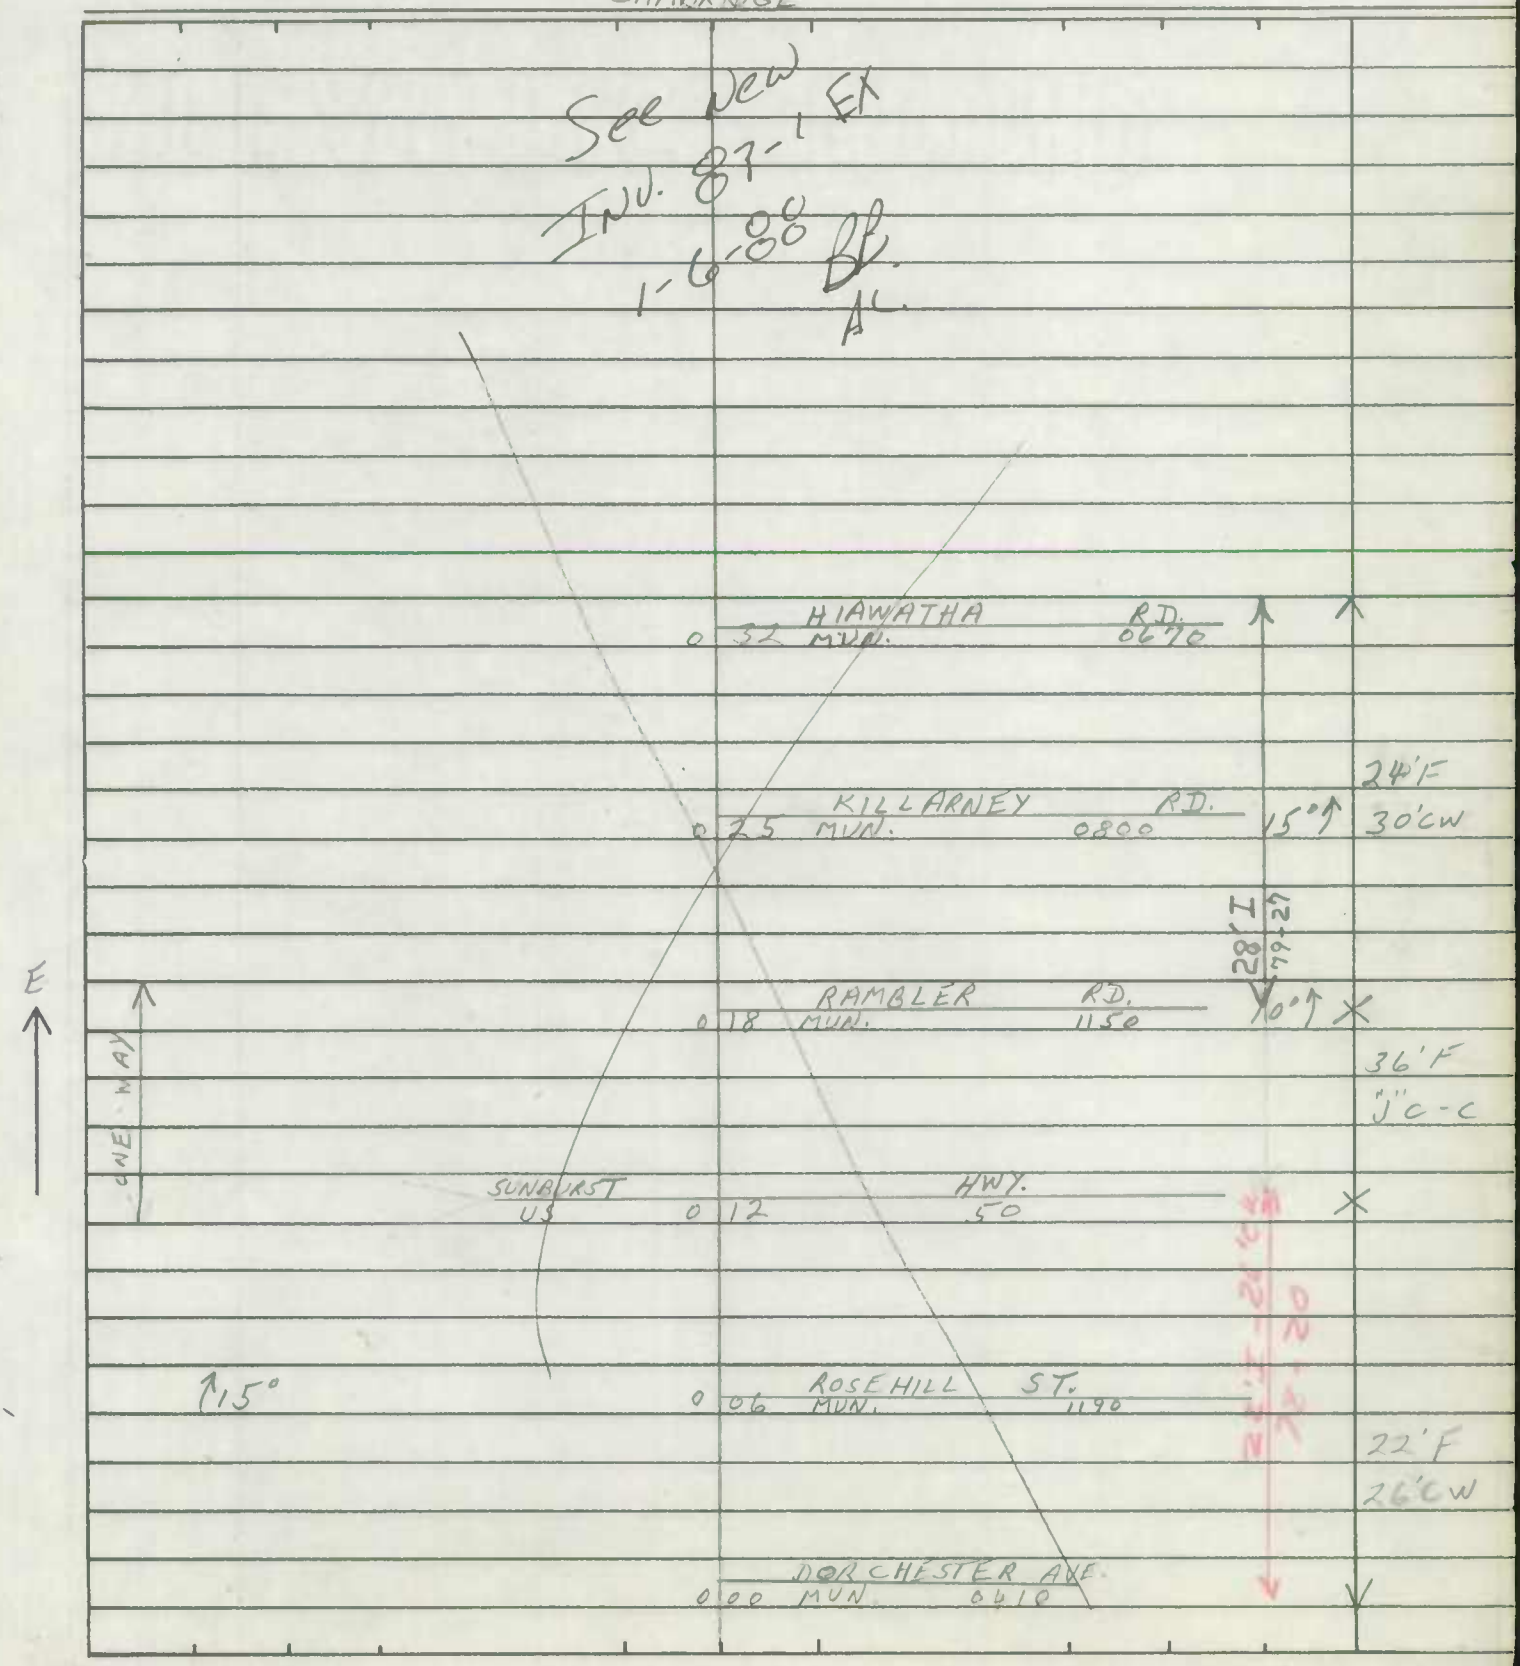

SHA 51.3-8
11-15-72

ROAD INVENTORY SHEET

Road No. _____
Road Name _____
Sheet No. _____
Date _____
County _____
State Coordinates _____

Form 6 HPS (Rev. 1961)

ROAD INVENTORY SHEET

Party Chief F.S. T. LANDON
Recorder C.F. F. [illegible] &
Chainman T.L.

VERIFIED
75
CAMBRIDGE

Road No. 1130
Name RAILROAD AVE
Sheet No. 1 OF 1
Date 5-21-65
County DOR

0820
LECOMPTE AV ST

0490
FRANKLIN ST 008

8090
ALLEY #9 00~

0650
HAYWARD ST 000

17'H
24'W

Form 6 HPS (Rev. 1961)

ROAD INVENTORY SHEET

Party Chief F SETTAN T. LANDI
Recorder C FORREST H. KMO
Chainman

VERIFIED 10/23/75 CAMBRIDGE 73-16 78-35

Road No. 1160
Name KIGBY AVE
Sheet No. 1 OF 1
Date 4-26-65
County DORCHESTER

CA.

MILES

MD 0 44

343

1210

0 39 ROSEMONT AVE

STILES CIRCLE 0 37 MU 365
11-14 0 26

0220

0 24 CAMBRIA ST

1540

0 20 WOOD ST

S

0470

FAIRMOUNT 0 10 AVE

1020

PARK → 0 00 LA

25'G
CURB RT

20'G
24'CW

Form 6 HPS (Rev. 1961)

ROAD INVENTORY SHEET

Party Chief F SETTAN . LANDIS
Recorder C FORREST T. RHODES
Chainman

VERIFIED 10/21/75 CAMBRIDGE

Road No. 1170
Name ROBBINS ST
Sheet No. 10F1
Date 4-30-65
County DORCHESTER

	ROAD END		
	0 82		
1350			
SPRINGFIELD	0 78	AVE	
1030			
PEACH	0 73	BLOSSOM AVE	
↑10°			
~~PIKE~~	0 66	ST	
MD	0 57	341	
	0770		
	0 51	CENTRAL AVE	
1070			
PINE	0 45	ST	
0960			
CENTER ST	0 39		
0730			
HUBBARD CT. ST	0 35		
1060			
PHILLIPS	0 30	ST	
0030			
ALLEN ST	0 24		
	ONE WAY	0960	
	0 19	MOORES AVE	
0960			
HIGH	0 16	ST	
0900			
MACES	0 00	LA	

28'F 34'CW C-LT.
25'G CURB RT
27'G C-C
22'G 30'CW
18'F 24'CW
22'F 30'CW

SHA 51.3-8
11-15-72

STATE HIGHWAY ADMINISTRATION OF MARYLAND

Cambridge

ROAD INVENTORY SHEET

FPP
91-03 MU
BB
SP
2-14-92

Party Chief FS
Recorder CF
Helper JL

Map No. 1-15

Road No. 1700
Road Name ROSELYN AVE.
Sheet No. 1 of 2
Date 5-21-65
County DORCH
State Coordinates N

Revised: 8-19-81 VTSC

		SUNBURST US 50	0 45	END HWY 50	55 X 30'F J' CP 40 I J CC
		MU #50 RAMBLER RD	0 38		X
		KILLARNEY RD MU 800	0 31		40'E 37'I J' C-C 2 UML
		CRUSADER MU	0 24	RD 390	
		NATHAN AVE MU 990	0 14		
			0 10	FIELD	
		ELM AVE MU 455	0 08		
			0 07		
		WOODS RD MU 1550	0 01	SEWAGE TREATMENT PLANT	
		CORP LIMITS Road	0 00	END CAMBRIDGE	

FUNCTIONAL CLASSIFICATION FOR URBAN
LOCAL URBAN

W

SHA 51.3-8
11-15-72

ROAD INVENTORY SHEET

Road No. 1200
Road Name ROSELYN AV
Sheet No. 2 of 2
Date 5-21-65
County DOR.
State Coordinates

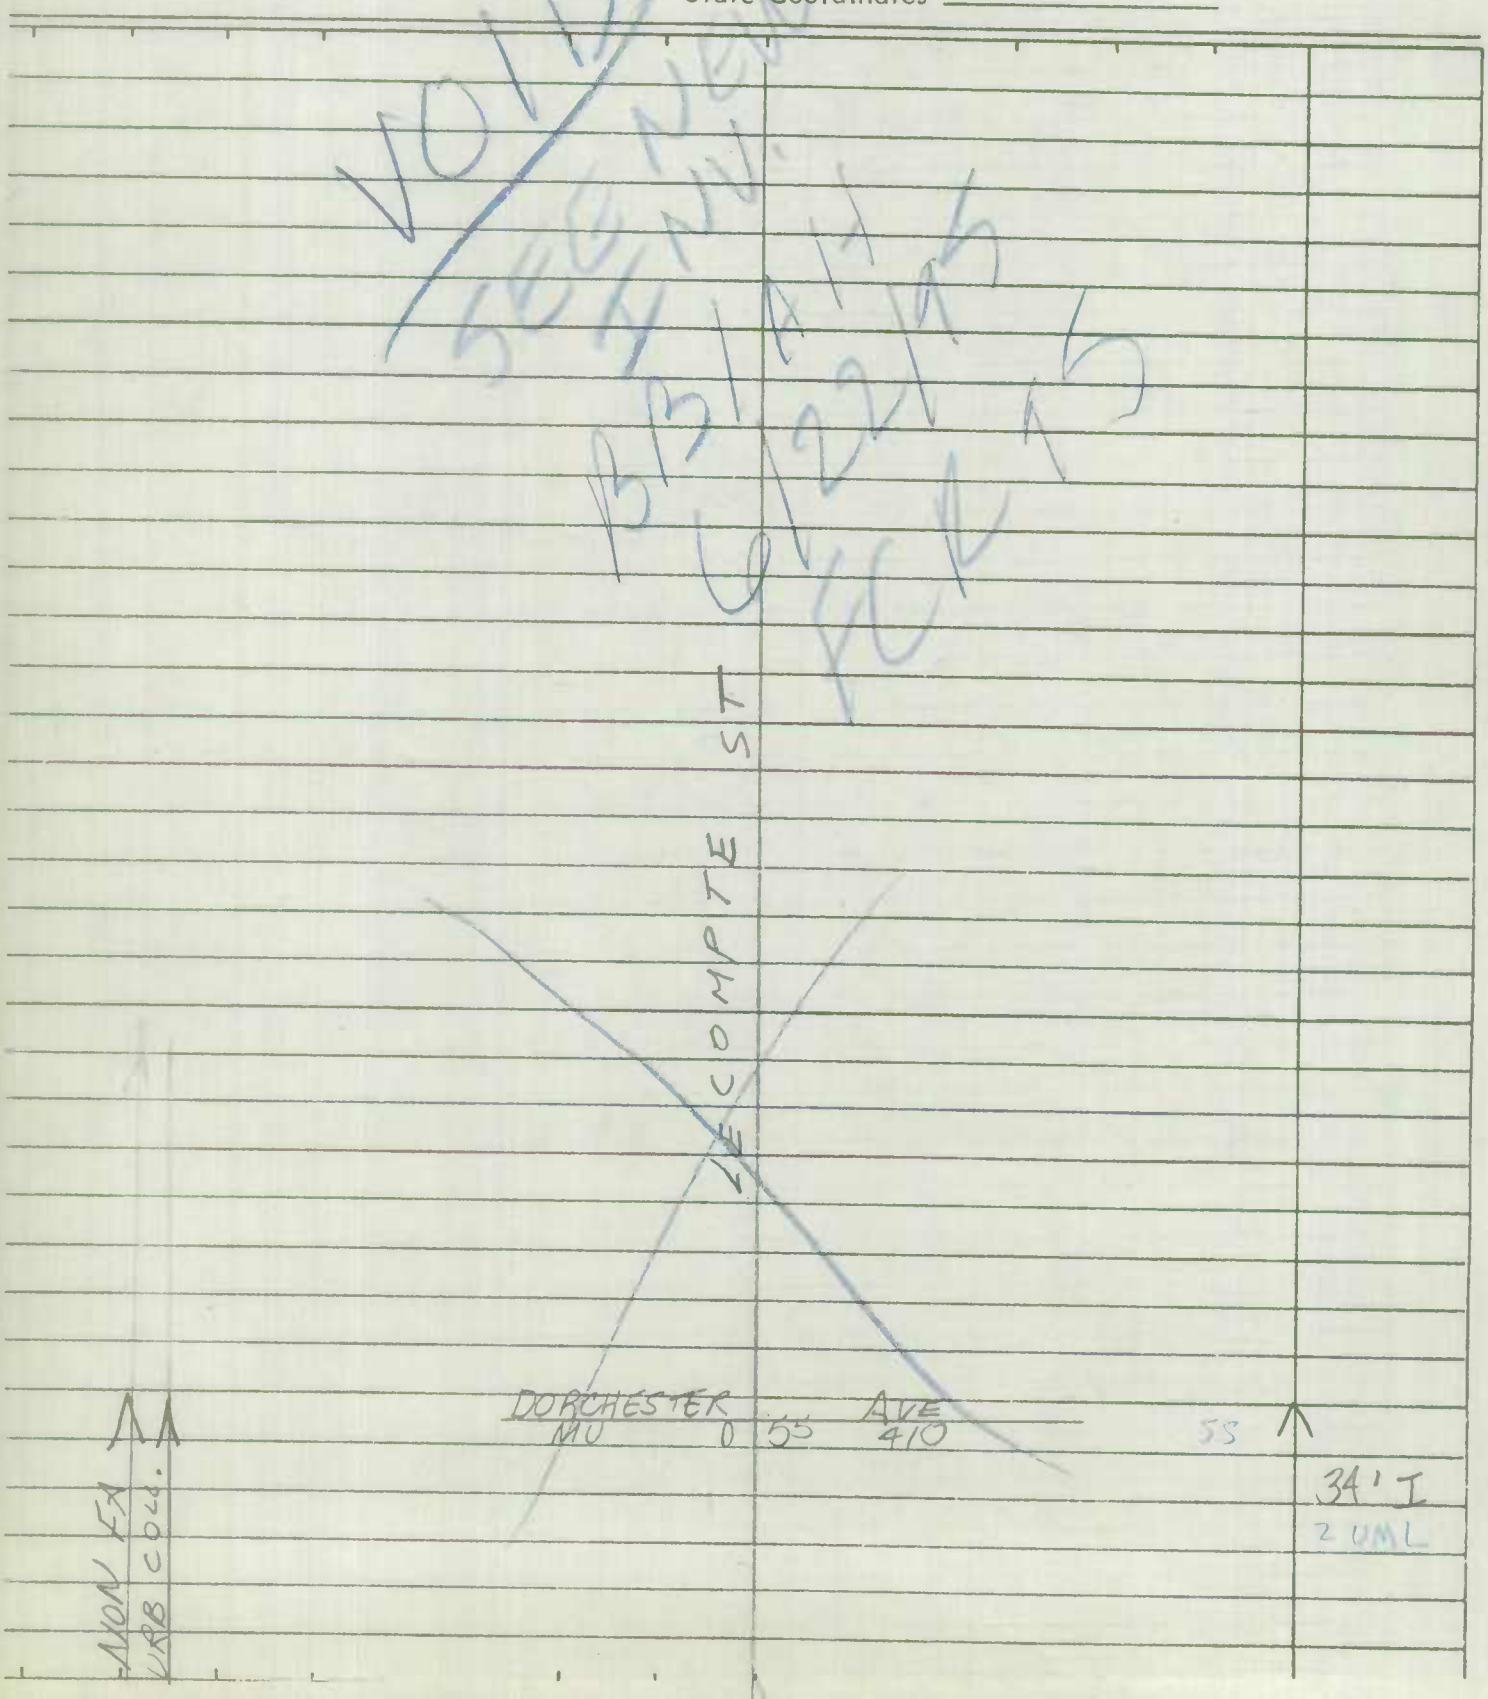

Form 6 HPS (Rev. 1961)

ROAD INVENTORY SHEET

T. LANDT
F. RH...
VERIFIED
10/17/75
AMBRIDGE

Party Chief E.S.
Recorder C.F.
Chainman T.C.

Road No. 1200
Name ROSCLYN AVE
Sheet No. 1 OF 1
Date 5-21-CJ
County DOR.

		0410 DORCHESTER	
	0	55	AVE
		U.S.	
	0	45	50
		SUNBURST	HWY
			1150
	0	38	RAMBLER RD
			0800
	0	31	KILLARNEY RD
		MUN.	0390
	0	27	CRUSADER RD
		CRUSADER	
		0990	
		NATHANS ~~ST~~ AVE	
	0	14	
	0	10	SHITFIELD
		ELM AVE.	
	0	07	1360
		MUN 0458	
		Cont. (1650 MUN.)	
	0	01	WOODS RD
			SEWAGE TREATMENT PLANT
	0	00	
		ROAD	END

24'G 30'CW

20'G 26'CW

18'G 24'CW

W

Form 6 HPS (Rev. 1961)

ROAD INVENTORY SHEET

Party Chief F. SETTAN
Recorder T. LANDON
Chainman

F. HOLES
VERIFIED
75

Road No. 1240
Name SCHOOL ST
Sheet No. 1 OF 2
Date 6-3-65
County DORCHESTER

CAMBRIDGE

0530				
GLENBURN	0	44	AVE	
8020				
ALLEY	0	40		+2
0110				
BELVEDERE	0	35	AVE	
1010				
OAKLEY	0	27	ST	
AGAN ~~ALLEY~~		8030		
	0	24	ALY	#3
1620				
WILLIS →	0	22	→ ST	
8120				
ALLEY	0	19		#12
1500				
WEST-END ←	0	16	← AVE	
0910				
CHOPTANK →	0	10	→ AVE	
0940				
MILL	0	00	ST	

ONE WAY

W

21'G
28'CW

17'G
24'CW

17'G
24'CW

17'G
24'CW

Form 6 HPS (Rev. 1961)

ROAD INVENTORY SHEET

Party Chief F. SETTA
Recorder T. LANDIN
Chainman

T. LANDIN
F. SETTA
VERIFIED
75
CAMBRIDGE

Road No.
Name SCHOOL ST
Sheet No. 2 OF 2
Date 6-3-65
County DORCHESTER

78-32

CORP LIMITS	0 70	CAMBRIDGE	
1330 SOMERSET	0 61	AVE	
CAMBRIDGE MID. HIGH SCHOOL	0 57		
1380 TALBOT	0 52	AVE	
4010 ALLEY	0 48	#1	

16'G
24'CW

26'G
C-LF

SAME

Form 6 HPS (Rev. 1961) OFFICE COPY

ROAD INVENTORY SHEET

Party Chief GRIFFIN T. LANDON

Recorder F. MUDGE

Chainman

Note: Road not built, to be reconstruction of Sewage Treatment plant 24-92

VERIFIED 75

Road No. 1260

Name SEWAGE TREATMENT RD

Sheet No. 1-1

Date 12-13-66

County DORCHESTER

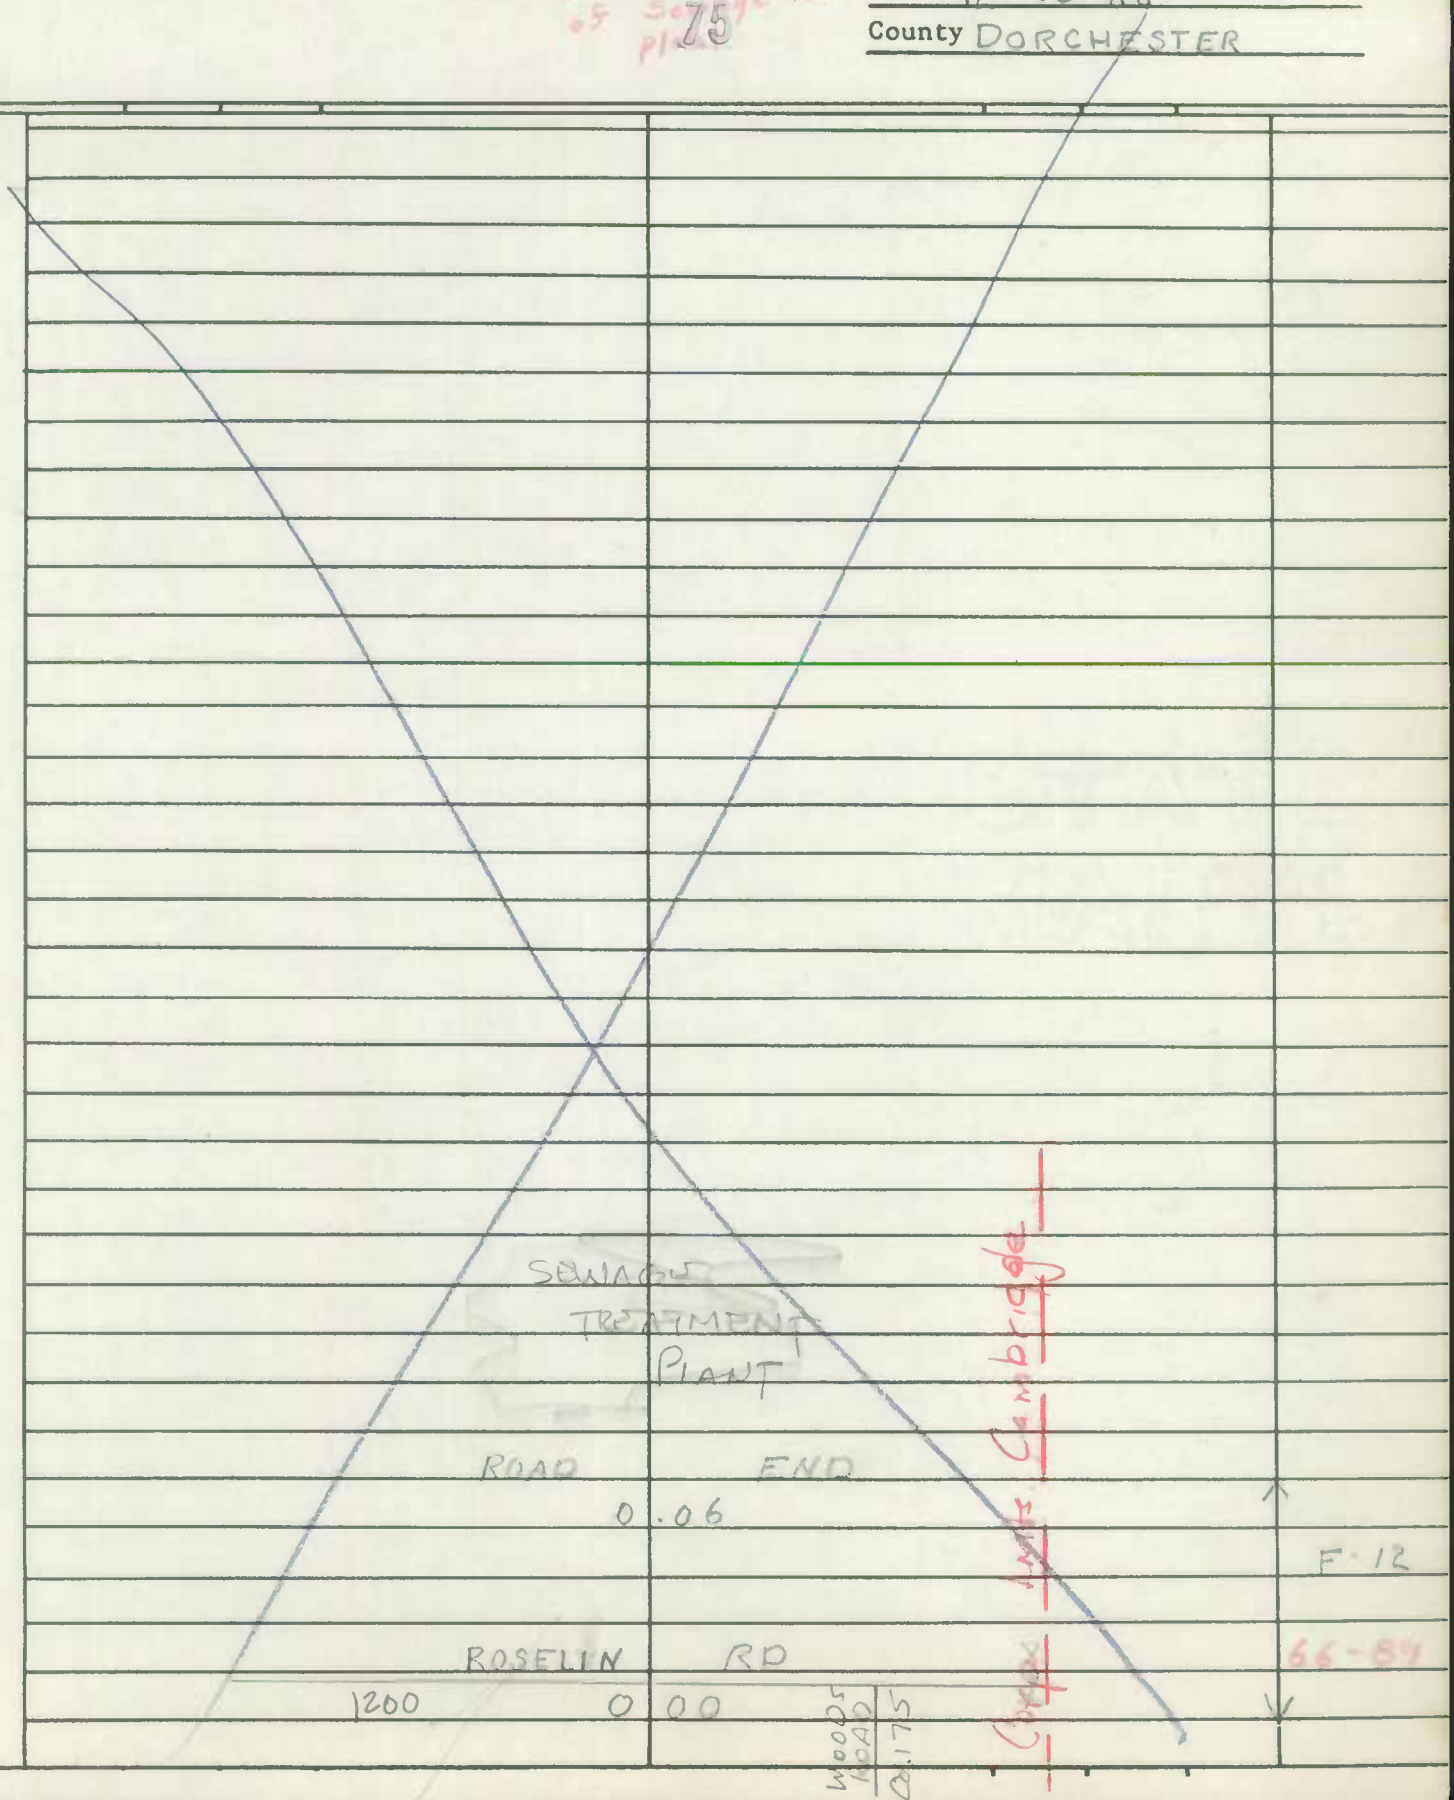

Form 6 HPS (Rev. 1961)

ROAD INVENTORY SHEET

Party Chief F SETTAN
Recorder C FORBES
Chainman

F. LANDON
F. RHODES
VERIFIED
10/24/75
CAMBRIDGE

Road No. 1330
Name SOMERSET AVE
Sheet No. 1 OF 1
Date 4-23-65
County DORCHESTER

26-17 28-31

CHARLES RIVER

CITY BOAT LAUNCH RAMP

0 74

20' BE
26' CW

↑ 20° 0080 BAY ST 0 62 0 51

18' G
24' CW

0630 HAMBROOKS 0 41

BLVD

20' G
26' CW

1240 SCHOOL 0 34 0 26

ST

36' G
CURB RT.

0 17

CAMBRIDGE H. SCH

1430 TUBMAN 0 13

ST

28' G
34' CW

0620 GLASGOW 0 00

ST

N

SHA 51.3-8
11-15-72

STATE HIGHWAY ADMINISTRATION OF MARYLAND

89-17
A/T 12/28/89
CG3B

ROAD INVENTORY SHEET

Party Chief F SETTAN
Recorder C FORREST
Helper

BB REV
AR 4-20-85

Map No. 1-15

VER 10-20-15

Road No. L370
Road Name STONE BOUNDARY RD
Sheet No. 1 of 1
Date 4-30-65
County DORCH
State Coordinates

Revised 8-15-81 JSC

BOUNDRY MU — AVE 130 — 30' I
1 31 — 30' T
U'i - RT
36' CU

BAYLY AVE MUN COND — 1.24 — 36' CU

ALLEY # 17 MUN 8170 — 19

SHEPPARD AVE MUN 1270 — 15 — 30' I

A — 09 — 36' CU

E APPLEBY MU — AVE 0340
0 96

FAU — BOUNDRY
091

0 67 48" C.M.P. 2' DEEP — 30' I
2 60' CU

CAMBRIDGE BYPASS
FAU 1120 — AVE — MD — 0.3716 — BOUNDARY 1980 SS

033 — 200

030 — WATER PUMPING STA. — 20'

CORP LIMITS OF CAMBRIDGE SIGN

004

000

8

SHA 51.3-8
11-15-72

ROAD INVENTORY SHEET

Road No. _____
Road Name _____
Sheet No. _____
Date _____
County _____
State Coordinates _____

SHA 51.3 - 8 Revised
4.83

MARYLAND STATE HIGHWAY ADMINISTRATION

ROAD INVENTORY SHEET

Party Chief F. Setton
Recorder C. Forrest
Assistant Rewritten 2/9/90 J.L.
Map No./Dir. 1-15 / N
State Coordinates

Road No. Mun 1370
Road Name Stone Boundary Rd
County Dorchester
Date 4-30-65
Sheet No. 1 OF 1

TRAFFIC CODES
TRAFFIC CONTROLS: STOP SIGN=S.S., TRAFFIC LIGHT=T.L., FLASHING RED BALL=F.R.

PARKING RESTRICTIONS: A.M. PEAK, P.M. PEAK, A.M./P.M. PEAK, NO PARKING ANYTIME=N.P., COMM/IND. ACCESS=E

SYSTEM				TRAFFIC		LINE DIAGRAM	TRAFFIC			PAVEMENT DATA
FED. AID.	FUNCT CLASS	HWY. SYS.	HPMS SAMPLE	PRKG. REST.	COM/IND. ACCESS		CONTROL	COM/IND. ACCESS	PRKG. REST.	
						Boundry Ave				
	U.L.					MU 1 31 0130				30' I
						Bayly Ave				J-C Rt.
						MU 9090 1 24				36' cw
						ADD # 17				
						MU 8170 19				
						Sheppard Ave				
						MU 1270 1 15				30' I
										36' cw
F/A	COLLECTOR					A 1 09				
						E APPLEBY AVE				
NON	URBAN					MU 0 76 0040				
						0 91				
						0 67 48" CMP 2' Deep				20' I
						Cambridge Bypass				26' cw
						MD 0 37 16		SS		
						0 30 Water Pumping Station		E		
						Southside Ave.				
						MU 0 04 1335				
F/A	LOCAL									
NON	URBAN									
						0 00				

SYSTEM				TRAFFIC		LINE DIAGRAM	TRAFFIC			PAVEMENT DATA
FED. AID.	FUNCT. CLASS.	HWY. SYS.	HPMS SAMPLE	PRKG. REST.	COM/IND ACCESS		CONTROL	COM/IND ACCESS	PRKG. REST.	

SHA 51.3-8
11-15-72

STATE HIGHWAY ADMINISTRATION OF MARYLAND

ROAD INVENTORY SHEET

Party Chief F. SETTAN
Recorder C. FORREST
Helper ~~T. LANDES~~ F. ANDES

Road No. 1370
Road Name STONE BOUNDARY RD
Sheet No. 1 OF 1
Date 4-30-65 REV 3-8-74 DNB
County DORCHESTER CO
State Coordinates

VERIFIED 10/2005

	MH BOUNDARY	3	85 122 0120 AVE	30'I 36'CW
	BAYLY AVE	3	77 115 221	X
	ALLEY #1	3 ~~TC~~	110 220	
	SHEPPERD AVE	~~3 69~~	106 213	
	(A)	~~3 77~~	100 213	30'I ~~C LT.~~ 36'CW
N	MH E. APPLEBY	~~3 47~~	087 2040 AVE	
	FAU		BOUNDARY 9	X 73-65
	MH	~~3 72~~	027 16	20'I 26'CW
		~~3 69~~	021	X
			019 WATER PUMPING STA. OF CAMBRIDGE	16'G 20'CW
	CORP. LIMITS		008 SIGN	

SHA 51.3-8
11-15-72

ROAD INVENTORY SHEET

Road No. _____
Road Name _____
Sheet No. _____
Date _____
County _____
State Coordinates _____

Form 6 HPS (Rev. 1961)

ROAD INVENTORY SHEET

Party Chief T. LANDON
Recorder F SETTAN
Chainman C FORREST F. MOSES

VERIFIED
10/29/75
CAMBRIDGE

Road No. 1380
Name TALBOT AVE
Sheet No. 1 OF 1
Date 4-23-75
County DORCHESTER

72-3 74-1 79-17

ROAD END				
	0	61		
0620 HAMBROOKS	0	54	BLVD.	22'G 28'CW
1640 SCHOOL	0	39	ST.	
CAMBRIDGE H. SCH.	0	30		30'G CURB CT
1430 TUBMAN	0	25	ST	
				40'G I C-C
0520 GLASGOW	0	17	ST.	30'G 40'CW
	0	00		
ROAD END				

N

Form 6 HPS (Rev. 1961)

ROAD INVENTORY SHEET

Party Chief F. SETTHAN
Recorder T. LANDON
Chainman

T. LANDON
I. JONES
VERIFIED
10/24/75
CAMBRIDGE

Road No. 1400
Name TRAVERS ST
Sheet No. 1 OF 1
Date 6-3-65
County DORCHESTER

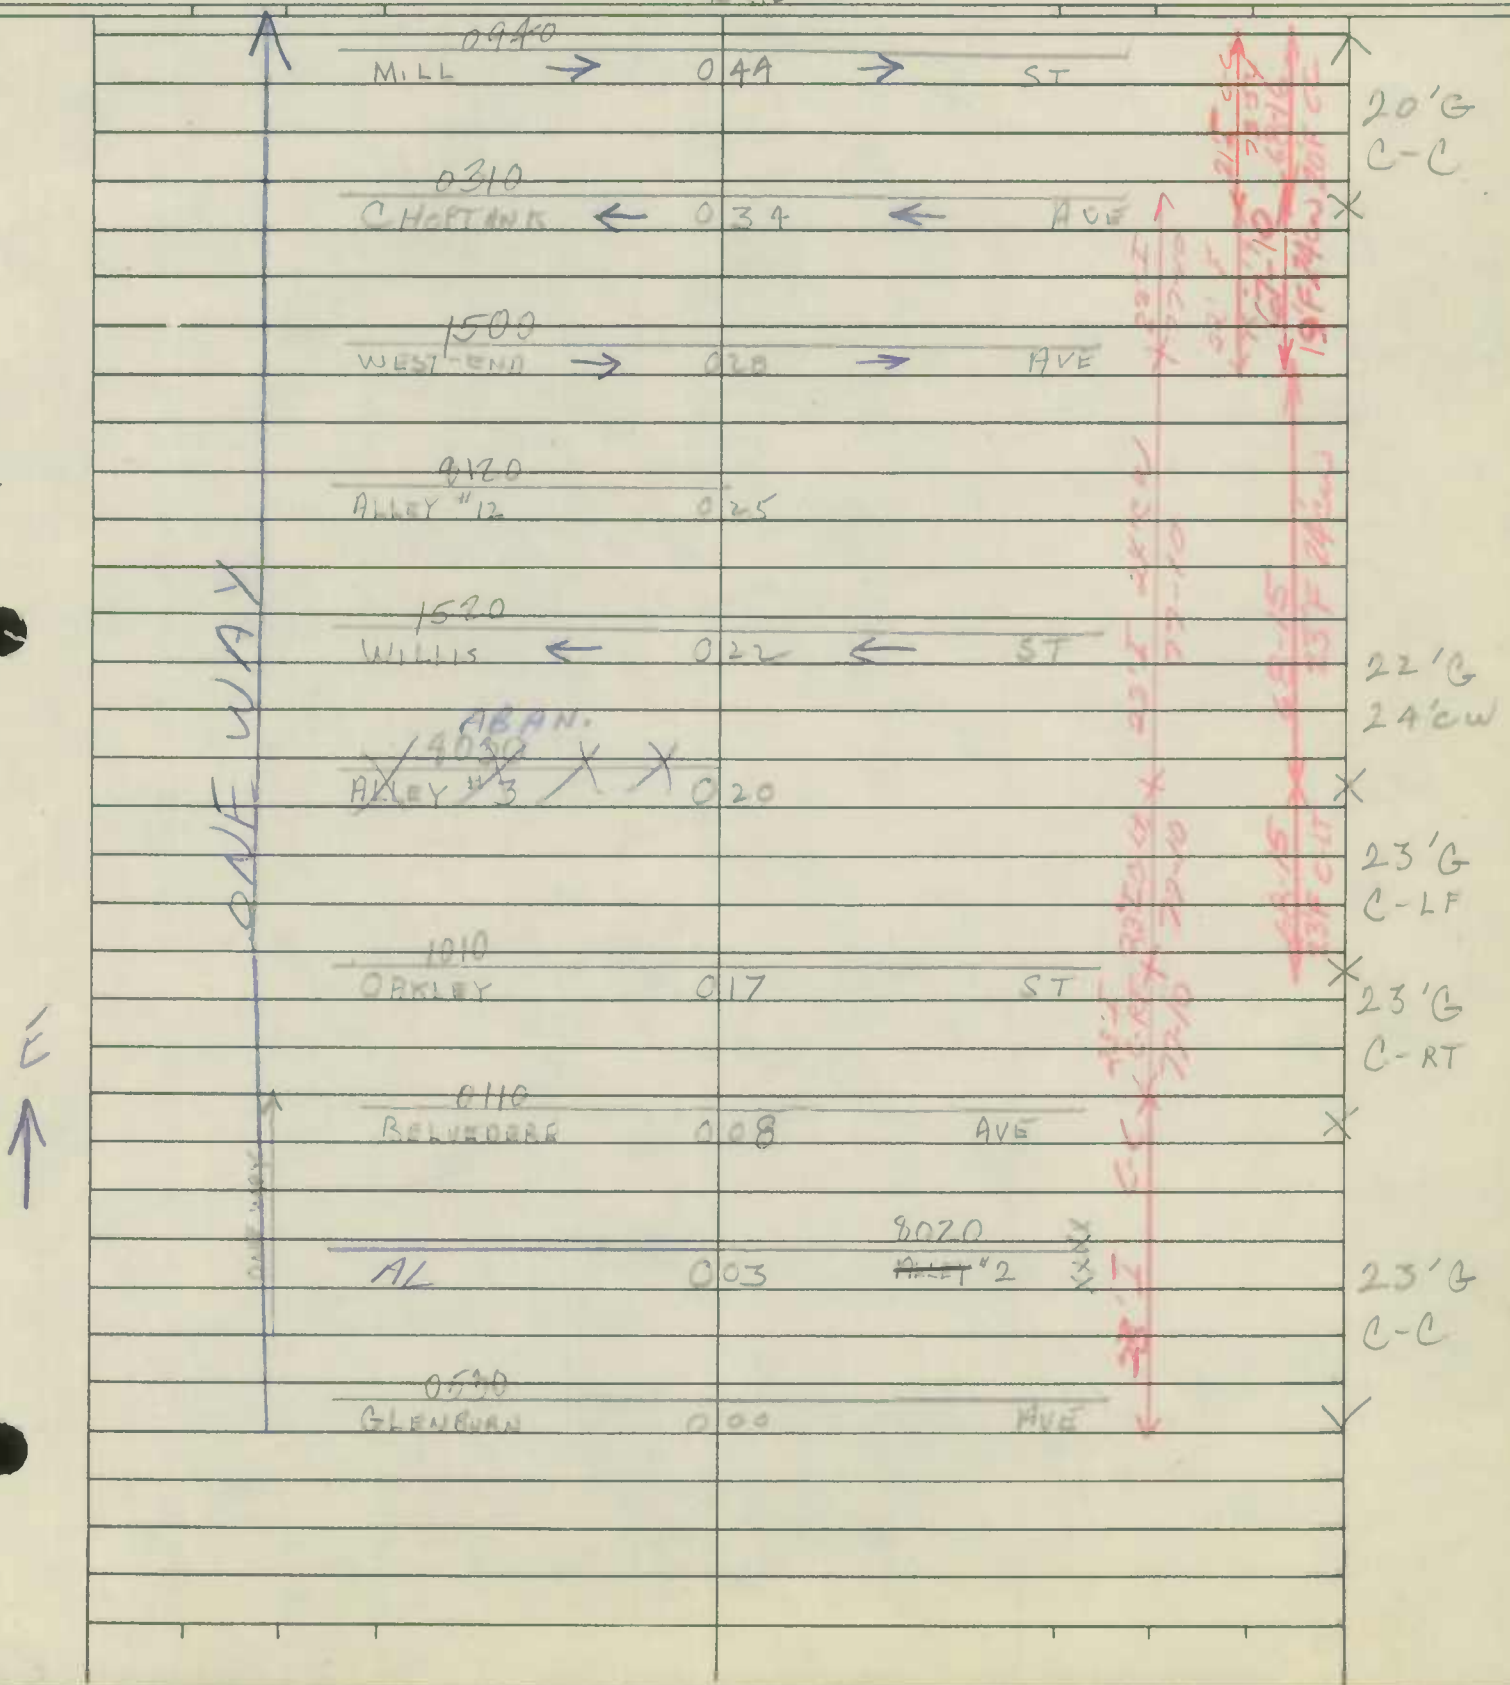

SHA 51.3-8
11-15-72

STATE HIGHWAY ADMINISTRATION OF MARYLAND

ROAD INVENTORY SHEET

Party Chief FS
Recorder CH
Helper TL

Map No. 1-15

VER 10/17/75 TLH R

Road No. 1410
Road Name TRENTON ST
Sheet No. 1 of 1
Date 5-28-65
County DORCH
State Coordinates

REVISIT: 8-13-81 JTSC

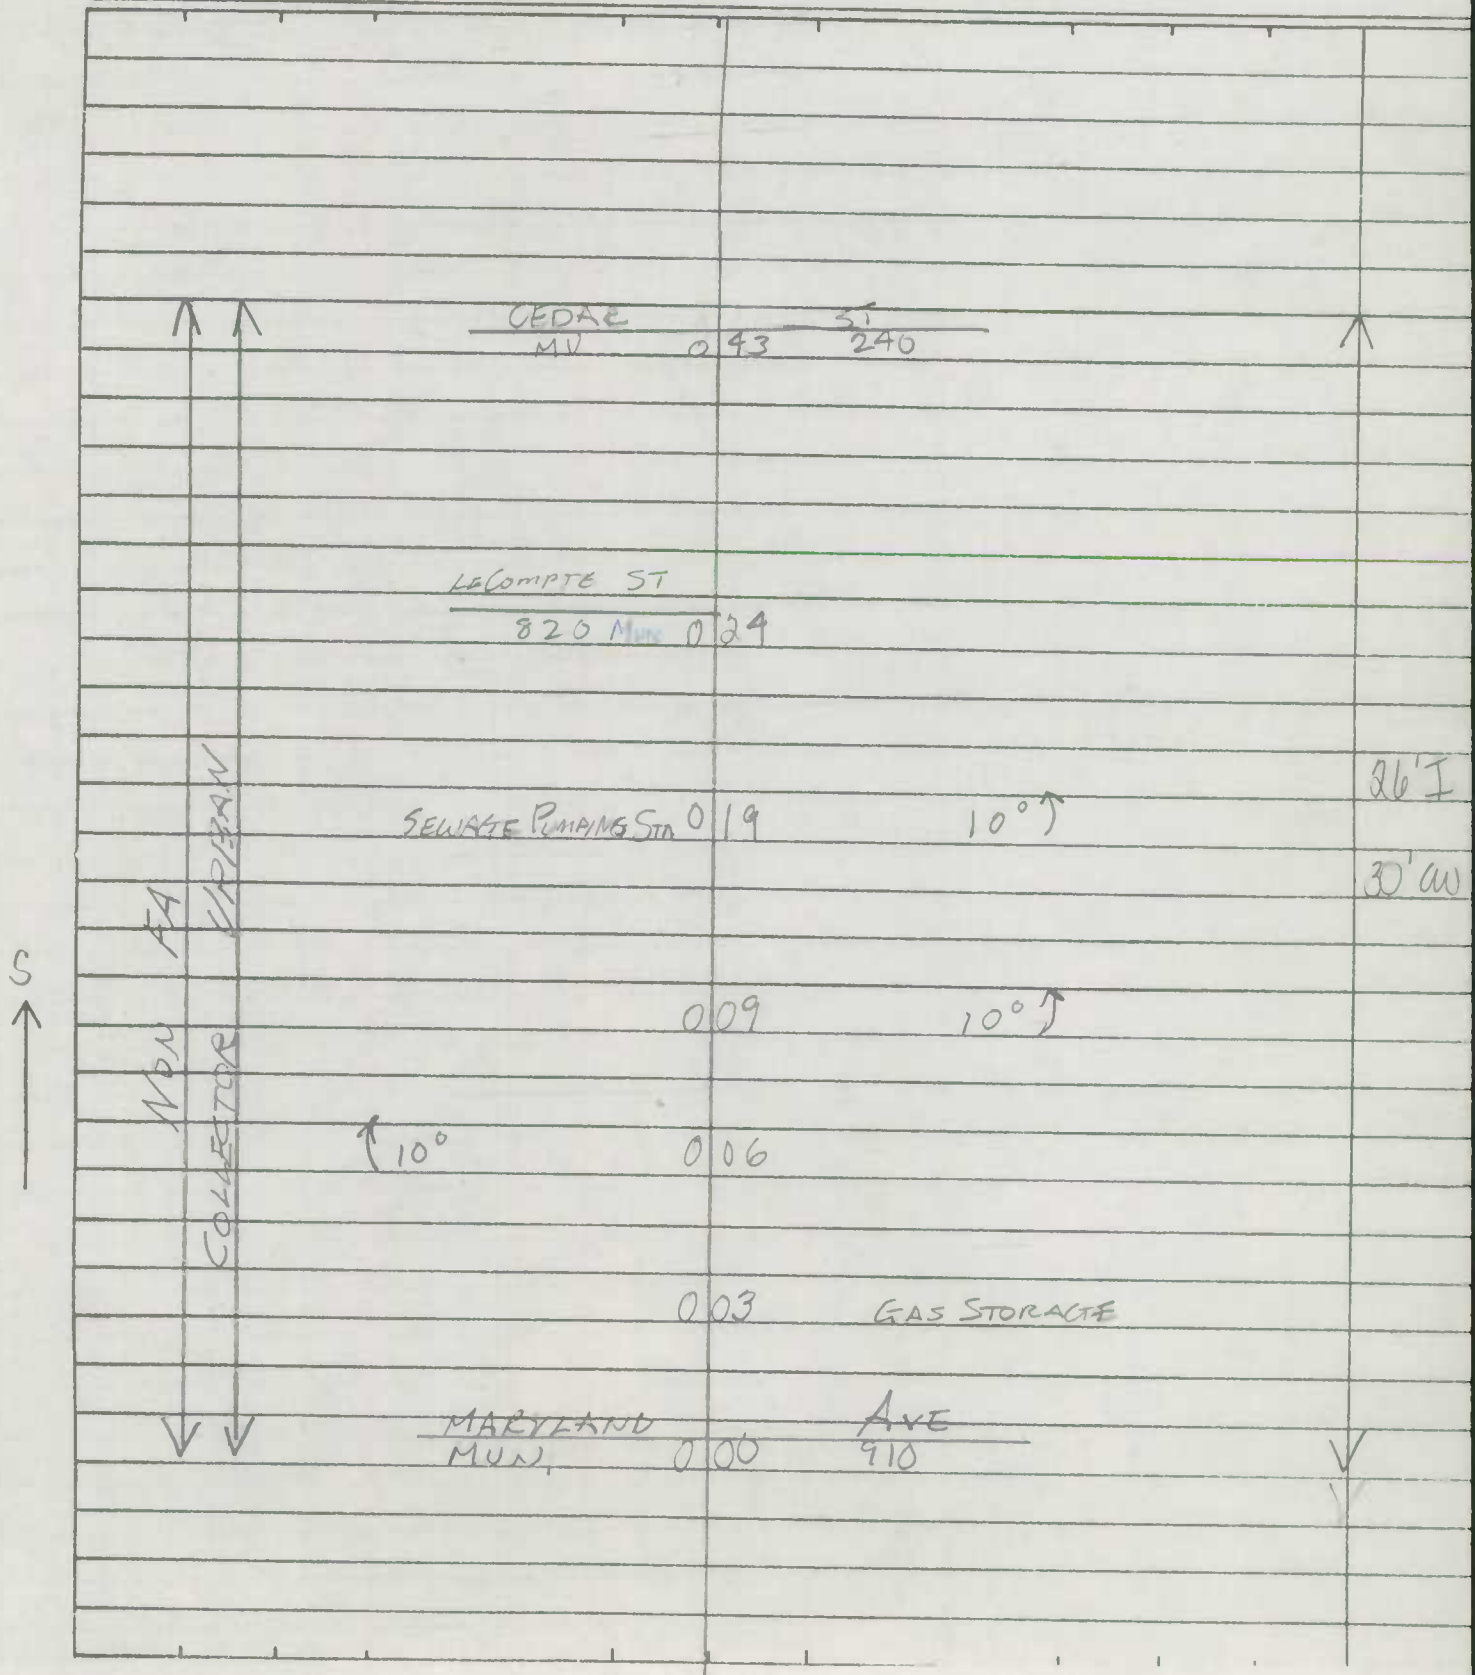

SHA 51.3-8
11-15-72

ROAD INVENTORY SHEET

Road No. _____
Road Name _____
Sheet No. _____
Date _____
County _____
State Coordinates _____

Form 6 HPS (Rev. 1961)

ROAD INVENTORY SHEET

Party Chief F.S.
Recorder C.F.
Chainman T.L.

T. LENTZ
F. NOLES
VERIFIED
10/17/75

Road No. 1410
Name TRENTON ST.
Sheet No. 1 OF 1
Date 5-28-65
County DOR

0240
CEDAR 043 ST

~~(GREEN ST)~~

(0820) LECOMPTE ST 024

SEWAGE PUMPING STA. 019
009
006

003 GAS STORAGE TANKS (AMERICAN)

~~RAILWAYS BUS STA.~~ ~~002~~

0410
MARYLAND 000 AVE

FA URBAN
COLLECTOR
NOW
10°
S

NOW
10°
10°
NOW

22'G
28'CW
38'G
50'CW

Form 6 HPS (Rev. 1961)

BB 84-9
RM 1-28-85

ROAD INVENTORY SHEET

Party Chief F SETTA T. LANDON
Recorder C FORREST F. NOLES
Chainman

VERIFIED
10/23/75
CAMBRIDGE

1-15

Road No. 1430
Name TUBMAN ST
Sheet No. 1 OF 1
Date 4-23-65
County DORCHESTER

ROAD END

	020		
1330 SOMERSET	016	MUN AVE	
MUN 8130 ALLEY # 13	011	CAMBRIDGE H.S.	
1380 TALBOT	008	MUN AVE	
0530 GLENBURN	000	MUN AVE	

W

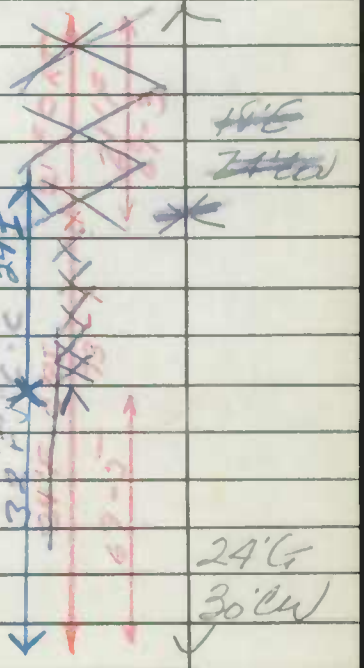

Form 6 HPS (Rev. 1961)

(10-09 MT)

ROAD INVENTORY SHEET

Party Chief F. SETTHN
Recorder T. LANDON
Chainman

Road No. 1470
Name WATER ST.
Sheet No. 1 OF 1
Date 6-3-65
County DORCHESTER

1-15

T. LANDON VERIFIED 10/23/75 CAMBRIDGE

VOID SEE NEW INV 6/22/95 BB/AH FCR 95

0310 CHORTOWN 026 MUN AVE

0940 MILL ST 020 MUN 1570 YACHT CLUB RD 016

025 WATER PUMPING STATION 2

1460 MUN VUEDELLEN ST 010

0690 HIGH 000 MUN ST.

7405 FAIR CLEAR URBAN

25'I J-C-C

31'I C-C

W

Form 6 HPS (Rev. 1961)

MUN. No. 1550

ROAD INVENTORY SHEET

Party Chief F. SETTAN
Recorder T. LANDON
Chainman C. FORREST

T. LANDON
F. RHODES
VERIFIED
75


74-21

	F		
	GA	TE	
	1 41		18' E 24' CW
	1 40	F	
	1 07		40' I 46' CW
B- BOXES	0 86		
	0 78	MDE B- FOOD FFE 532 0776	
R.R. SIGN SPUR COR LIMITS	0 77	CAMBRIDGE S.R. Fish	
B- BOATS	0 65		
	0 61	B- PRINTERS	38' I 60' CW
B- ELECTRONICS	0 54		
U S	0 38	50	28' G CURB RT. 50' CW
	0 32		
	0 13	WATER	
	0 27	36" CMP	18' G 40' CW
ROSELIN	0 00		

NOW COLLECT

Form 6 HPS (Rev. 1961)

ROAD INVENTORY SHEET

Party Chief F. SETTA
Recorder T. LANDON
Chainman

T. LANDON
F. [illegible]
VERIFIED
10/22/75
CAMBRIDGE

Road No. 8190
Name ALLEY # 19
Sheet No. 1 OF 1
Date 6-22-65
County DORCHESTER

(ABAN)

ROAD END
003
12'E
16'CW
1110
RACE 000 ST

SHA 51.3-8
11-15-72

STATE HIGHWAY ADMINISTRATION OF MARYLAND

DT REV
FA 3-8-79

ROAD INVENTORY SHEET (GLENOAK CIR. N) & S.

Party Chief T. LANDON
Recorder F. RHODES
Helper

PLUS 1.13

Map No. _____ 77-3
HURLOCK

Road No. MUN. ~~0312~~ 0101
Road Name ~~(WINFIELD CIR.)~~ N.
Sheet No. 1 OF 1
Date 1/31/78
County DORCHESTER
State Coordinates _____

North Main ST.

DR.

PT

180°

PC

E

~~MUN~~ 008 ~~END~~

WINFIELD DR.
~~(GLEN OAK CIR.)~~

0 06 ~~MU 103~~ 315

30'E
30'W

14'E
30'W

0 01

N. MAIN
MUN.

0 00 ST. 0140

Hurlock

SHA 51.3-8
11-15-72

ROAD INVENTORY SHEET

Road No. _____
Road Name _____
Sheet No. _____
Date _____
County _____
State Coordinates _____

SHA 51.3-8
11-15-72

STATE HIGHWAY ADMINISTRATION OF MARYLAND

DT REV.
FR 3-8-79

ROAD INVENTORY SHEET (GLEN OAK CIR. N) & S.

Party Chief T. LANDON
Recorder F. RHODES
Helper
PLUS 1.13

Map No. 77-3
HURLOCK

Road No. MUN. ~~0312~~ 0101
Road Name ~~(WINFIELD CIR.~~ N.
Sheet No. 1 OF 1
Date 1/31/78
County DORCHESTER
State Coordinates

8-18

North Main ST.
MU 0 33 0140
~~Glen Oak Cir.~~ WINFIELD DR.
0 27 MU ~~113~~ 315
PT
0 22
Penn St
MU 0235 0 20
180°
Holland Cr.
MU 0102 0 13
30'E
PC
0 10
E
~~ROAD~~ 0 08 ~~END~~
WINFIELD DR.
~~(GLEN OAK CIR.)~~
0 06 MU ~~103~~ 315
24'E
30'W
0 01
N. MAIN ST.
MUN. 000 0140

SHA 51.3-8
11-15-72

ROAD INVENTORY SHEET

Road No. _____
Road Name _____
Sheet No. _____
Date _____
County _____
State Coordinates _____

SHA 51.3-8
11-15-72

STATE HIGHWAY ADMINISTRATION OF MARYLAND

DT REV.
FR 3-8-79

ROAD INVENTORY SHEET (GLEN OAK CIR. S)

Party Chief T. LANDON
Recorder E. RHODES
Helper

Map No. 77-378-1
HURLOCK

Road No. MUN. ~~0313~~ 0102
Road Name ~~(WINFIELD CIR.)~~ S.
Sheet No. 1 OF 1
Date 1/31/78
County DORCHESTER.
State Coordinates

SEC MU

101

E

ROAD 0008 END

(GLEN OAK CIR.) (NO NAME)
MU0103 ~~0001~~ 78-1+2 EXTRA 0006

24'F
~~30'CW~~

0001

24'F
30'CW

N. MAIN ST.
MUN. 0000 0140

SHA 51.3-8
11-15-72

ROAD INVENTORY SHEET

Road No. _____
Road Name _____
Sheet No. _____
Date _____
County _____
State Coordinates _____

SHA 51.3-8
11-15-72

STATE HIGHWAY ADMINISTRATION OF MARYLAND

DB 84-30
RM 2.485 AT
86-XTR
DD/AL 23-86 A.T.

ROAD INVENTORY SHEET

1. L. RHODES
F. VERIFIED
10/15/75

Party Chief I. LANDON
Recorder E. RHODES
Helper _____

Map No. _____

PROSPECT HILLS HURLOCK

Road No. MUN. ~~0403~~ 104
Road Name (GOLD RUSH LA)
Sheet No. 1 OF 1
Date 10/1/74
County DORCHESTER
State Coordinates _____

77-4 B(-3)

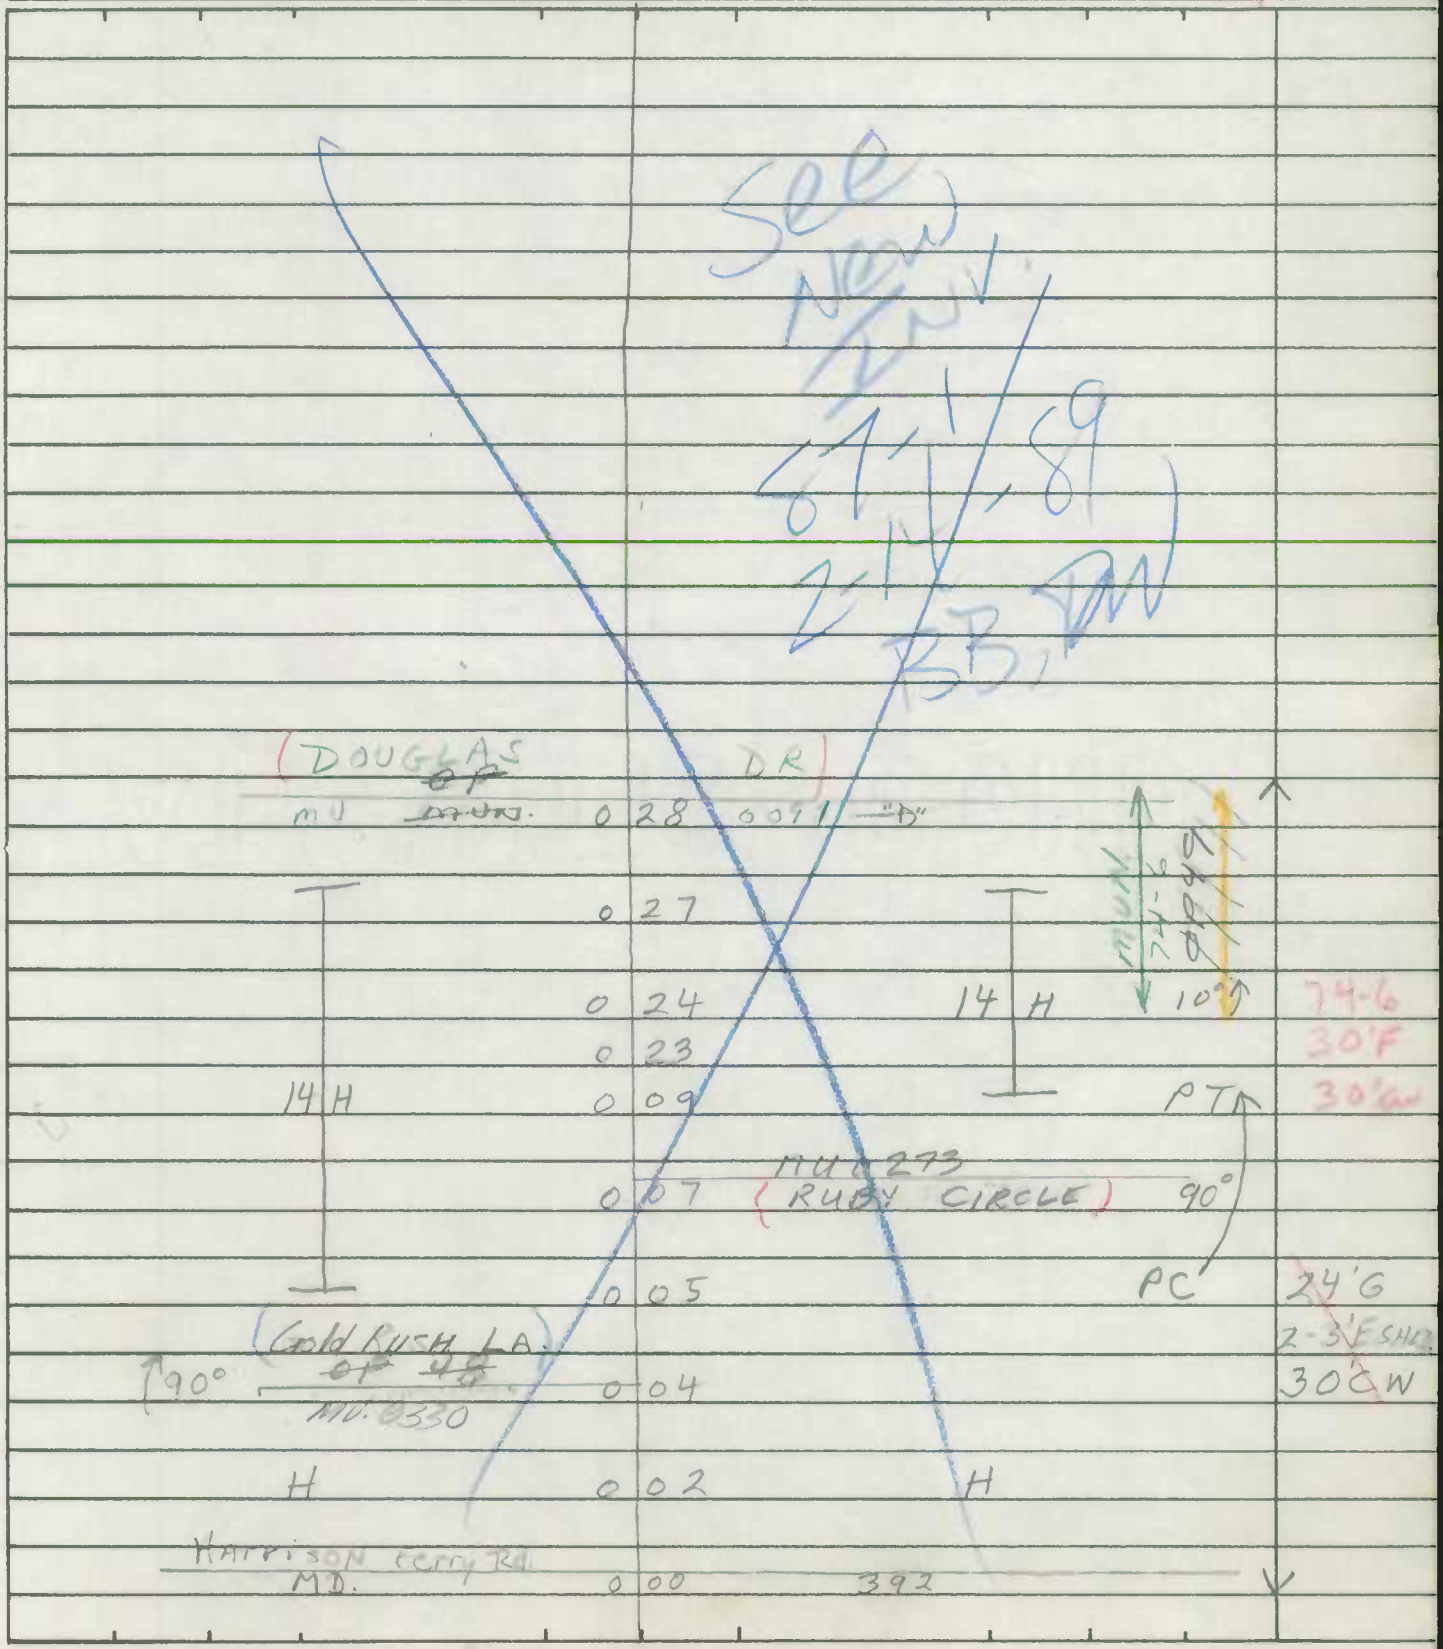

SHA 51.3-8
11-15-72

ROAD INVENTORY SHEET

Road No. _____
Road Name _____
Sheet No. _____
Date _____
County _____
State Coordinates _____

Form 6 HPS (Rev. 1961)

292-1126

PINE ST. X
MUN 110
~~HURLOCK AVE~~

ROAD INVENTORY SHEET

Party Chief F. SETTAN
Recorder T. LANDON
Chainman C. FOREST
T. LANDON
F. RHODES
10/1/74 VERIFIED HURLOCK

Road No. Co 320
Name HURLOCK AVE. PINE ST.
Sheet No. 1 OF 1
Date 5-27-75
County DORCHESTER
1127-292

MUN. 200			MUN. 200	
NEALSON	C	18	ST	
H	O	16	H	10°
H	C	14	H	
~~CHURCH~~ H	C	11	CHURCH	
H	O	09		
H	O	07		
H	O	06		
			T H	
HALL	O	05		
H	O	04	PT.	
T — T —	O	03	— T —	
			75° ~~35'~~	
	O	02		
N				
	O	01	PC.	
MD	O	00	392	

MUN 010
MOUNT MUNSON 176
SMITH 176
20'H
16'ow

PUT - IN MUNICIPAL BOOK

SHA 51.3 - 8 Revised
4.83

MARYLAND STATE HIGHWAY ADMINISTRATION

HURLOCK

ROAD INVENTORY SHEET

88-7 2/14/M BB/DW

(State) 89-3 ex # 1 CG/BB 12-28-89

Party Chief F. Sutton
Recorder T. London - C. Forrest
Assistant Rewritten 2/8/90 J.L.
Map No./Dir. H-15 / N
State Coordinates

Road No. MUN. 0125
Road Name Legion DR
County Dorchester
Date 5-27-65
Sheet No. 1 OF 1

92-4

TRAFFIC CODES
TRAFFIC CONTROLS: STOP SIGN=SS, TRAFFIC LIGHT=T.L., FLASHING RED BALL=F.R.

TRAFFIC CODES
PARKING RESTRICTIONS: A.M. PEAK, P.M. PEAK, A.M./P.M. PEAK, NO PARKING ANYTIME=N.P., COMM/IND. ACCESS=E

SYSTEM				TRAFFIC		LINE DIAGRAM	TRAFFIC			PAVEMENT DATA
FED. AID.	FUNCT CLASS	HWY SYS.	HPMS SAMPLE	PRKG. REST.	COM/IND ACCESS		CONTROL	COM/IND ACCESS	PRKG. REST.	
						VOID				
						SEE NEW				
						INV. FCR 95				
						RAILROAD AVE				
						MU 0 16 0260 70° J	SS			23'G
										J-C L+
						Stevens Alley				
						MU 8010 0 12			X	
										28'I
										~~30'G~~
										50'cw
										J-C-LT
										2 m l
NON	RURAL	MU	1 F/A			N. MAIN ST S. MAIN ST				
						MD 0 00 331				
						POPLAR ST MU 0240				
Y	Y	Y								

MINOR COLLECTOR

SYSTEM				TRAFFIC		LINE DIAGRAM	TRAFFIC			PAVEMENT DATA
FED. AID.	FUNCT. CLASS.	HWY. SYS.	HPMS SAMPLE	PRKG. REST.	COM/IND ACCESS		CONTROL	COM/IND ACCESS	PRKG. REST.	

Form 6 HPS (Rev. 1961)

Mun. No. 0140 X

ROAD INVENTORY SHEET

N. Main St

Party Chief F. SETTAN
Recorder T. LANDON
Chainman

T. LANDON
F. RHODES
VERIFIED
10/15/75
HURLOCK

Road No. Co 317
Name
Sheet No. 2 OF 2
Date 6-1-63
County DORCHESTER

TL REV.
FR 11/31/78

MD 331

MD 307
BROAD ST. 1 53 0220 OAK ST.

0190
MULBERRY ST. 1 46

1 40 MD 331 HURLOCK MUNICIPAL

0210
JAMES ST. 1 36

N. MAIN ST.

0230
1 35 ORCHARD ST.

0150
MAPLETON 1 29 STREET

GLEN OAK CIR. X SCAN FIELD ROAD
MUN. 0313 1 27 3 1 23
GLEN OAK CIR. X MUN. 0312 1 13
1 05

4 H

1 MILE 1 02 HURLOCK
0 99

20%

22'G
0'C-LT.
28'CW

22'G
0'C-RT.
28'CW

22'G
28'CW

11/31/78
24'F
30'CW

15'F
28'CW

SAME

SHA 51.3-8
11-15-72

STATE HIGHWAY ADMINISTRATION OF MARYLAND

(92 MU EXH 1)
60 A. MAPLETON
1/24/93

ROAD INVENTORY SHEET

OP 64

Party Chief T. LANDON
Recorder E. HUGHES
Helper

Map No.

Road No. MUN. 0150
Road Name MAPLETON ST.
Sheet No. 1
Date 10/15/75
County DORCHESTER
State Coordinates 1125 - 295

75-1 HURLOCK

E

H ROAD 036 END

MDDE
PK 629 967D

0 ABANDONED

E

0 28 CONN MUN. ST. 0235

0 25 COMMERCE MUN. ST. 0060

0 18 NOBLE MUN. ST. 0210

N MUN. MAIN 0 12 ST. 0140

ACADEMY MD. 000 ST. 231

10'C
15'CW

30'G
32'CW

18'G
26'CW

SHA 51.3-8
11-15-72

STATE HIGHWAY ADMINISTRATION OF MARYLAND

(92-12) CO/AMENDED 1-29-93

85-1 BB/AL 2-3-86

88-10 2-14-89 BB.Dw

ROAD INVENTORY SHEET

Party Chief F SETTAN
Recorder J LANDON
Helper C FORREST

Rev BB FR 1-30-81
BB 84-12
Rev 2-4-85 AT

Map No. H15

REVRIT 8-18-81 JTSC

Road No. 220
Road Name OAK ST
Sheet No. 1 of
Date 5-27-65
County Dorch
State Coordinates

92-7 AT

Transfer 88-24 (CO) 89-1 (mm)

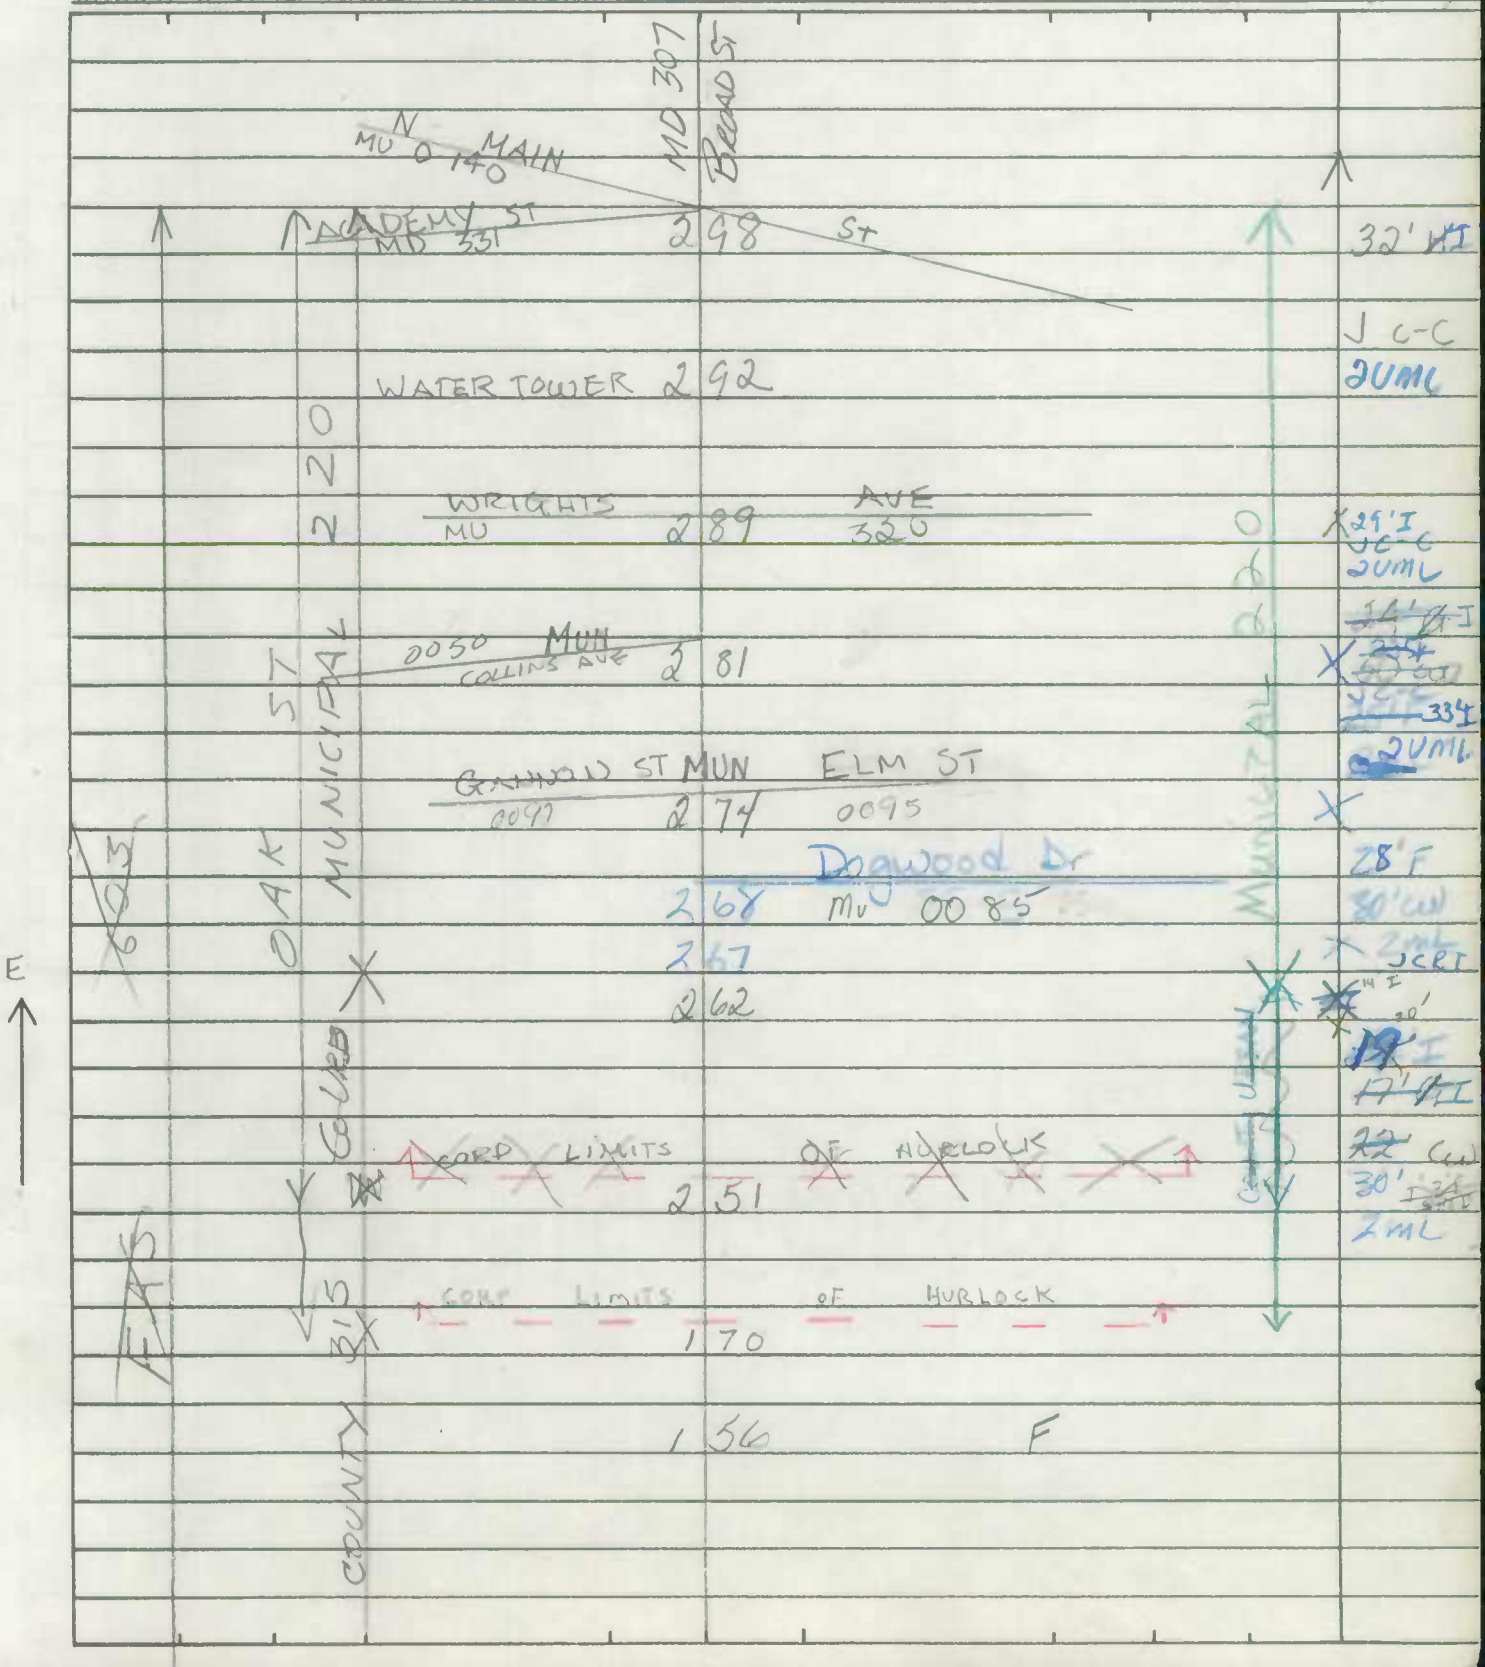

SHA 51.3-8
11-15-72

ROAD INVENTORY SHEET

Road No. _____
Road Name _____
Sheet No. _____
Date _____
County _____
State Coordinates _____

Form 6 HPS (Rev. 1961)

MUN. No. 0220

ROAD INVENTORY SHEET

OAK STREET

Party Chief F. SETTEN
Recorder T. LANNON
Chainman CHESTNUT

BB REV
FR 1-30-81

F. RHODES VERIFIED 10/15/75
Hurlock

Road No. C0315
Name
Sheet No. 1 OF 2
Date
County DORCHESTER




WATER TOWER 2 92

WRIGHTS 0320 2 89 AVE

COLLINS AVE 0250 ST 2 81
GANNON 2 74
2 62
Corp Limits 2 51

ELM ELM ST 0046 0095
OF Hurlock

MAIN

32'H
J'C-C
31'H
CURB LT
24'G
30'CW
80-10
17'G
22'CW

E
1
4
3
6
0
N

1 56 F
F-900' 1 32
1 28 1-1
1 22
6 H

SAME

SHA 51.3-8
11-15-72

STATE HIGHWAY ADMINISTRATION OF MARYLAND

73-T. LA... RHODES ... VEHICLE ... LINES

OP 65

ROAD INVENTORY SHEET

Party Chief W Dombroski
Recorder D Taylor
Helper

Map No. _____

Hurlock

Road No. MU 0235
Road Name Penn St
Sheet No. 1 of 1
Date 1-2-74
County Dorchester
State Coordinates 1125-295

E

Mapleton St
MUN 0100 0150

28' F
36' CW

James St
MUN 0000 0120

16' E
20' CW

90°

COMMERCE ST.
MUN. 0060

0.02
0.00

Main St.

SHA 51.3-8
11-15-72

STATE HIGHWAY ADMINISTRATION OF MARYLAND

73-T. X

T. LAWRENCE RHODES VERIFIED 6/15/73

ROAD INVENTORY SHEET

Party Chief W. Dombroski
Recorder D Taylor
Helper

Road No. 0235
Road Name Penn St
Sheet No. 1 of 1
Date 1-22-74
County Dorchester
State Coordinates

Map No. 77-2 (76-12,13)
77-11 Extra FR JE 2-7-80
Hurlock
77-14
80-17

Glen Oak
MU
0 23 0101

E

021

25°

Mapleton St
MUN 0150

30'F
36'CW

James St
MUN 0170

28'F
36'CW

90°

COMMERCE ST.
MUN 0060

SHA 51.3-8
11-15-72

ROAD INVENTORY SHEET

Road No. _____
Road Name _____
Sheet No. _____
Date _____
County _____
State Coordinates _____

MP. 08-.27
Transferred to To mun.
89-5 (mun), 88-23 (co.)
89-3 ex # 1 (ST.)
CG/BD
12/28/89

SHA 51.3 - 8 Revised
4.83

MARYLAND STATE HIGHWAY ADMINISTRATION

HURLOCK

ROAD INVENTORY SHEET MD 392-A

Party Chief F. SETTON
Recorder T. LANDON
Assistant C. FORREST
Map No./Dir. H-15 / N
State Coordinates

Road No. MU 240
Road Name Poplar St
County Dorchester
Date 5/27/65
Sheet No. 1 OF 2

Rewritten 2/8/90 T.L.

TRAFFIC CODES
TRAFFIC CONTROLS: STOP SIGN=SS, TRAFFIC LIGHT=T.L., FLASHING RED BALL=F.R.

TRAFFIC CODES
PARKING RESTRICTIONS: A.M. PEAK, P.M. PEAK, A.M./P.M. PEAK, NO PARKING ANYTIME=N.P., COMM/IND. ACCESS=E

SYSTEM: FED. AID. | FUNCT CLASS. | HWY. SYS. | HPMS SAMPLE
TRAFFIC: PRK.G. REST. | COM/IND. ACCESS

LINE DIAGRAM

NON F/A
RURAL
MINOR COLLECTOR
MU 0240
MD 392-A

E
Telephone office 0 51
ELM ST
MU 0095 0 41
Dogwood Dr
MU 0085 0 33
0 27
0 10
0 08
PT
90°
PC
0 05
0 01
MD 0 00 392

MUN 0240
MD 392-A

TRAFFIC: CONTROL | COM/IND. ACCESS | PRK.G. REST.

PAVEMENT DATA
30'I
J-C Lt.
2 ml
22'I
32'cw
2 ml
23'I
2'I Lt.
5'I Rt.
24'I
5'I Rt.
3'I Lt.
2 ML

LINE DIAGRAM

SYSTEM				TRAFFIC		TRAFFIC			PAVEMENT DATA
FED. AID.	FUNCT. CLASS.	HWY. SYS.	HPMS SAMPLE	PRKG. REST.	COM/IND ACCESS	CONTROL	COM/IND ACCESS	PRKG. REST.	
NON F/A	RURAL MINOR COLLECTOR	MU	0240						

LEGION DR
MU 0425

N. MAIN ST. — S. MAIN ST

MD 0 61 331 — SS

0 59

30'G
50'cw
J-C Lt.
2 m l

WAIGHTS AVE — CHARLES ST

MU 0320 0 52 MU 0040

SHA 51.3-8
11-15-72

STATE HIGHWAY ADMINISTRATION OF MARYLAND

MPO W - 0.05 = MD 392
C NE - 0.17 = CO 316
0.29 - 0.56 = MD 392

88-7
2-14-89
BB, BW

ROAD INVENTORY SHEET

Party Chief E SETTON
Recorder T LANDON
Helper C FORREST

Map No. 415 BB 84-8 REV 1-30-51 BB FR
2-4-85

Road No. 240
Road Name POPLAR ST
Sheet No. 1 of 2
Date 5-27-65
County DORCH
State Coordinates

89 3 Ex #1
CG/BB
12/28/89

REVISIT 8-13-81 JTSC HURLOCK

240
POPLAR ST
MUNICIPAL
ELM ST
MD 95
TELEPHONE OFFICE
Dogwood Dr
MD 85
CORP LIMITS OF HURLOCK
TO MD 845
MD 392-A
PT
90°
PC
EAST NEW MARKET HURLOCK RD
COUNTY
RURAL
NON MINOR
I-A
COLLECTOR
MD 392

0 51
0 41
0 38
0 33
0 27
0 22
0 10
0 08
0 25
0 01
0 00

30'I
J-CLT
2mL
22'I
32'W
2mL
23'E
2mL
MD 0 00 392

SHA 51.3-8
11-15-72

ROAD INVENTORY SHEET

Road No. 240
Road Name POPLAR ST
Sheet No. 2 of 2
Date 5-27-65
County DORCHESTER
State Coordinates

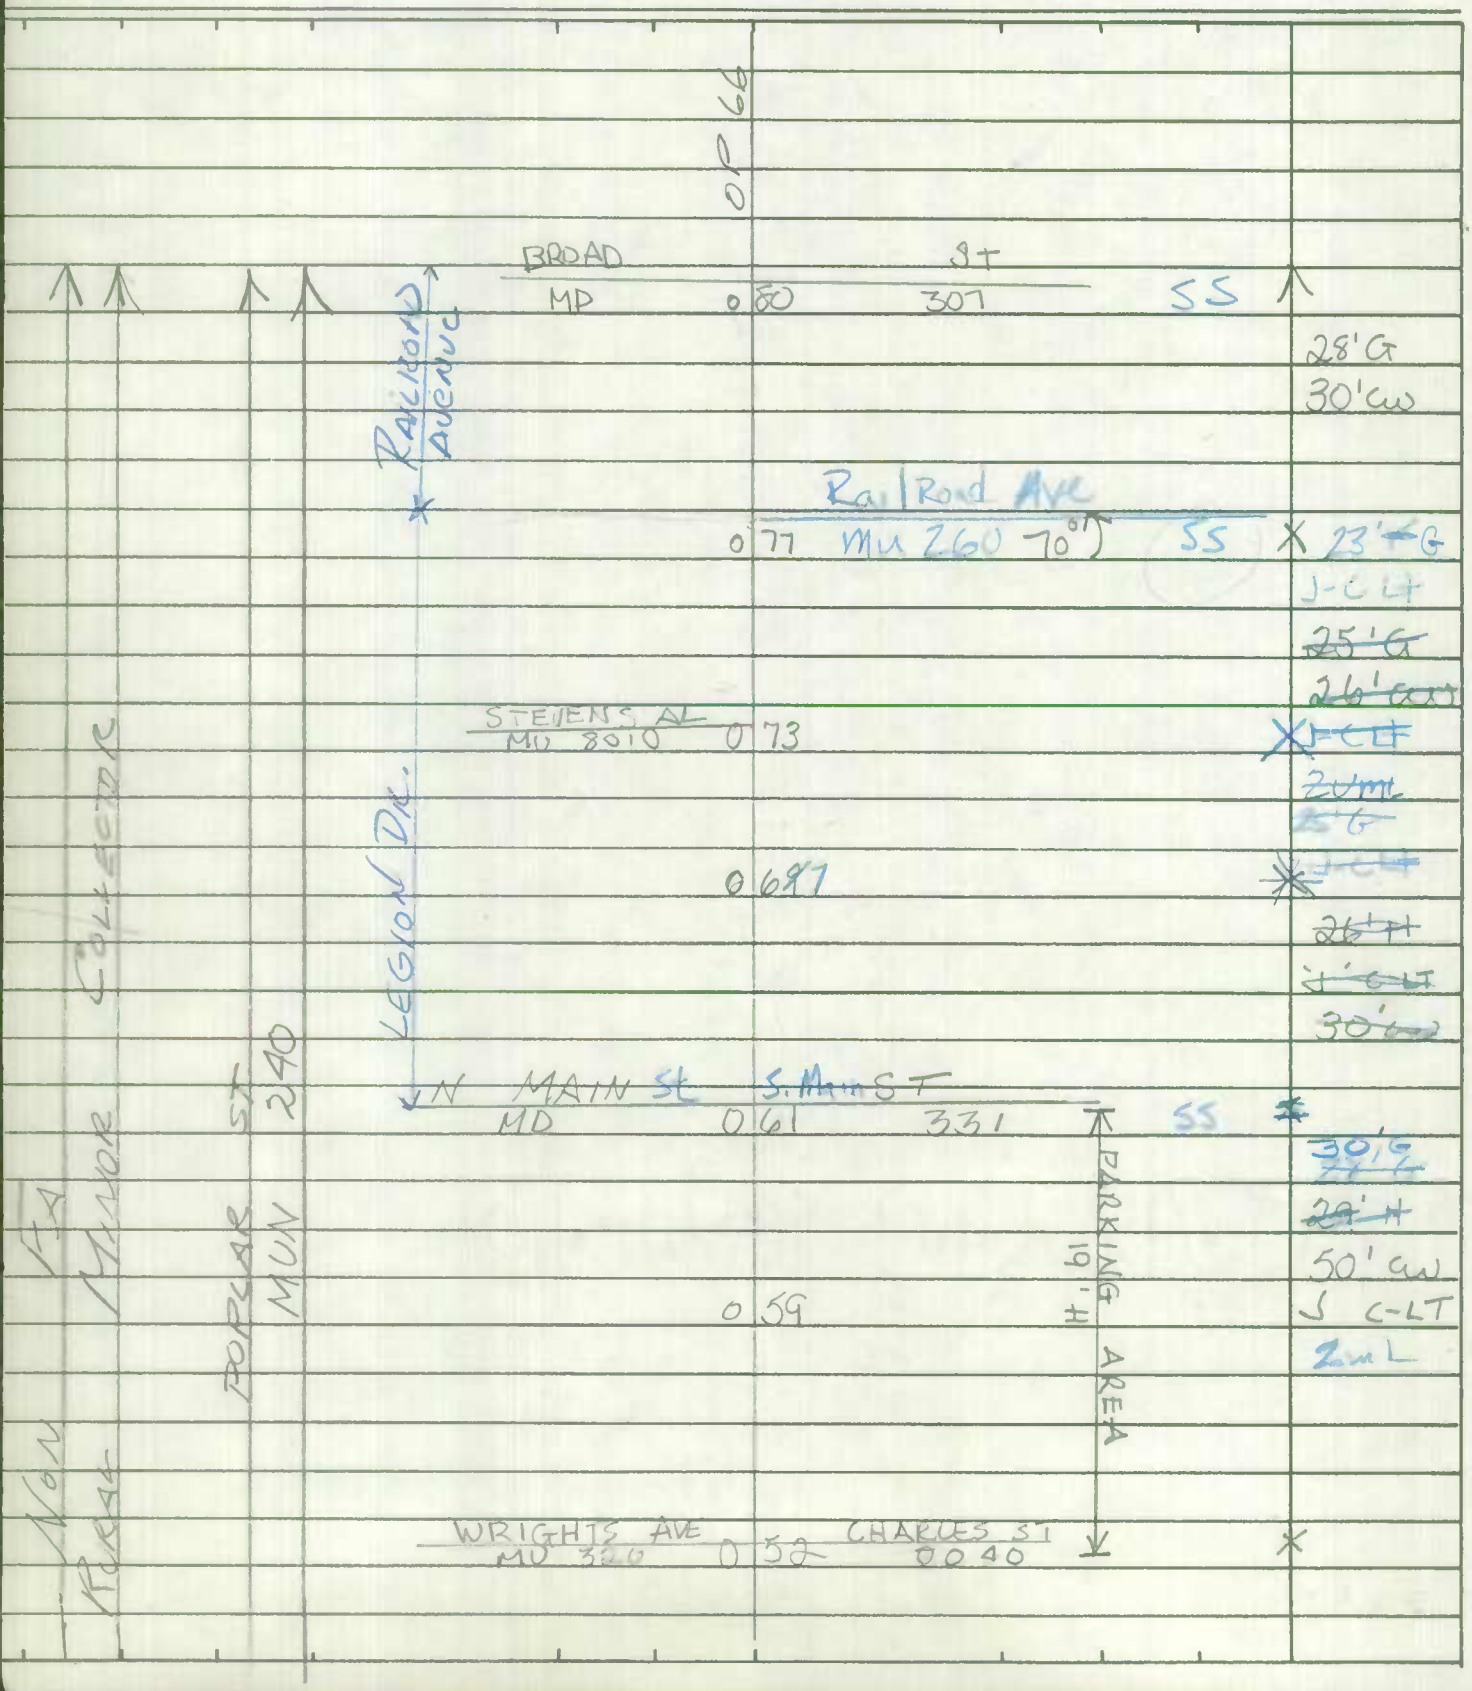

Form 6 HPS (Rev. 1961)

MUN. No. 0290

ROAD INVENTORY SHEET

P. FLAR ST.

Party Chief F. SETTINO
Recorder T. LANDON
Chainman A. FARMER

T. LANDON
F. RHOLES
Ck. VERIFIED MAIN.
10/14/75

BB REV FR 1-30-81

Road No. Co 316
Name EAST NEW MARKET HURLOCK RD.
Sheet No. 1 of 2
Date 5-27-65
County DORCHESTER

HURLOCK 78-15

	MD			331	
	N. MAIN ST.	061		S. MAIN ST	
	HURLOCK P.O.	059			
	0320 WRIGHTS AVE	052		0040 CHARLES ST.	
	TELEPHONE OFFICE	051			
	ELM ST 0095	041			
		038		B-FEED	
		027			
		020		HURLOCK	
	F	010			
	PT	005			
	90°				
	PC	001			
	MD	000		392	

26'H
3'C-LT.
30'CW

29'H
50'CW
3'C-LT.

22'I
32'CW
2ML

20'H
2-6'F SHDS
32'CW
2ML

Form 6 HPS (Rev. 1961)

X V

ROAD INVENTORY SHEET

MV 240

Party Chief	F. SETTAN	Road No.	Co 316
Recorder	T. LANDON	Name	
Chainman	C. FORREST	Sheet No.	2 OF 7
		Date	5-27-75
		County	DORCHESTER

T. LANDON
F. RHODES
VERIFIED
75

77-7

BROAD ST.
MD 0.30 307

28'G
30'CW

RAILROAD 0.60

70°

80-7

0.77 RAILROAD AVE 0.74

25'G

~~20'G~~

26'CW

3010
(STEVENS ALLEY) 0.73

AMERICAN LEGION 0.69

MAIN ST
RUSSIA
CHURCH

.86-.89 was part of Poplar ST, Mun. 0240 - 89 + 3 ex. #1 (5 sht.)

SHA 51.3 - 8 Revised
4.83

MARYLAND STATE HIGHWAY ADMINISTRATION

HURLOCK

ROAD INVENTORY SHEET

Party Chief: T. LANDON
Recorder: F. RHODES
Assistant: Rewritten 2/8/90 J.L.
Map No./Dir.: H-15 / N
State Coordinates:

Road No.: MUN 0260
Road Name: RAILROAD AVE
County: Dorchester
Date: 10/14/75
Sheet No.: 1 OF 2

92-5

TRAFFIC CODES
TRAFFIC CONTROLS: STOP SIGN=SS, TRAFFIC LIGHT=T.L., FLASHING RED BALL=F.R.

TRAFFIC CODES
PARKING RESTRICTIONS: A.M. PEAK, P.M. PEAK, A.M./P.M. PEAK, NO PARKING ANYTIME=N.P., COMM/IND. ACCESS=E

SYSTEM				TRAFFIC		LINE DIAGRAM	TRAFFIC			PAVEMENT DATA
FED. AID.	FUNCT CLASS	HWY. SYS.	HPMS SAMPLE	PK.KG. REST.	COM/IND. ACCESS		CONTROL	COM/IND ACCESS	PK.KG. REST.	
						0.50 NEW				28'G
						(A Pine St.) Pine Ave				30'CW
						~~MU 0010~~ 0.43 NW				28'G
						Delaware Ave				10'E Shld Lt.
						MD 0240 0.92				
						Prospect St.				
						MU 0250 0.35				
						TAYLOR AVE				28'G
						MU 0.28 0290				30'CW
						THOMPSON ST				
						MU 0300 0.20				
						Dorchester Ave				
						MU 0090 0.09				
						JACKSON RD				
						MU ~~0.16~~ 0.15 0.00 Co 318				
						0.22				
F/A	LOCAL	0260								
NON	RURAL	MU								
Y	Y	Y								Y

LINE DIAGRAM

SYSTEM: FED. AID. | FUNCT. CLASS. | HWY. SYS. | HPMS SAMPLE
TRAFFIC: PRKG. REST. | COM/IND ACCESS
TRAFFIC: CONTROL | COM/IND ACCESS | PRKG. REST.
PAVEMENT DATA

NON F/A
RURAL — R. Min. Col. — LOCAL
MU — 0260

SEE NEW LINE DIAGRAM

Broad St
MD 0089 1307

Legion Dr
Mu 0125 0 86
Grille

RXR Sign — #MDDE 532 058 C
2 Tracks 0 84 RXR Sign

(MILL ST)
Mu 0180 0 80

(MIDDLE ST)
MU 0170 0 77

MARYLAND AVE
MU 0 70 0160

Webster St
Mu 0310 0 63

Andrews St
Mu 0020 0 56

PAVEMENT DATA: 28'G | ~~28'G~~ | ~~30'~~ | 30'I | 28'G

SHA 51.3-8
11-15-72

STATE HIGHWAY ADMINISTRATION OF MARYLAND

85-5 RB/AL 2-3-86 X

ROAD INVENTORY SHEET

Party Chief I. LANDON
Recorder E. RHODES
Helper

Map No. BB AIT FR 1-30-81 HISEMETRIC A/T 1-29-83 BB84-2-3 AM 2-4-85 A/T

Road No. MUN. 0260
Road Name RAILROAD AVE.
Sheet No. 1 OF 1
Date 10/14/75
County DORCHESTER
State Coordinates

81-3/4/5 79-1 80-1 77-5 79-6 79-7 HURLOCK TAYLOR ICT

JACKSON RD.
CORP CO. LIMITS
0 B6 OF 318 HURLOCK

DORCHESTER AVE.
0 77 MUN. 0090

THOMPSON ST.
0 66 MUN. 0300

TAYLOR AVE.
MUN. 0 58 0310

PROSPECT ST.
0 51 MUN. 0250

DELAWARE AVE. 28'G
MD. 0 46 392 30'CW
("A" ST.)
0 43 MUN. 0010 X 28'G
0 36 X 10' ESHD LT
0 30 ANDREWS ST.
MUN. 0020

S
WEBSTER ST.
0 23 MUN. 0310

MARYLAND AVE.
MUN. 0 16 0160

(MIDDLE ST.)
0 09 MUN. 0170

28'G
30'CW
(MILL ST.)
0 06 MUN. 0180

MDDE
RXR SIGN
2 TRACKS 0 02 RXR SIGN 5.32 058C
5
02AQ
0 00

Form 6 HPS (Rev. 1961)

ROAD INVENTORY SHEET

Party Chief F. SETTAN
Recorder T. LANDON
Chainman

T. LANDON
F. RHODES
VERIFIED
10/14/75
HURLOCK

Road No. 0270
Name RUARK ST
Sheet No. 1 OF 1
Date 6-14-65
County DORCHESTER

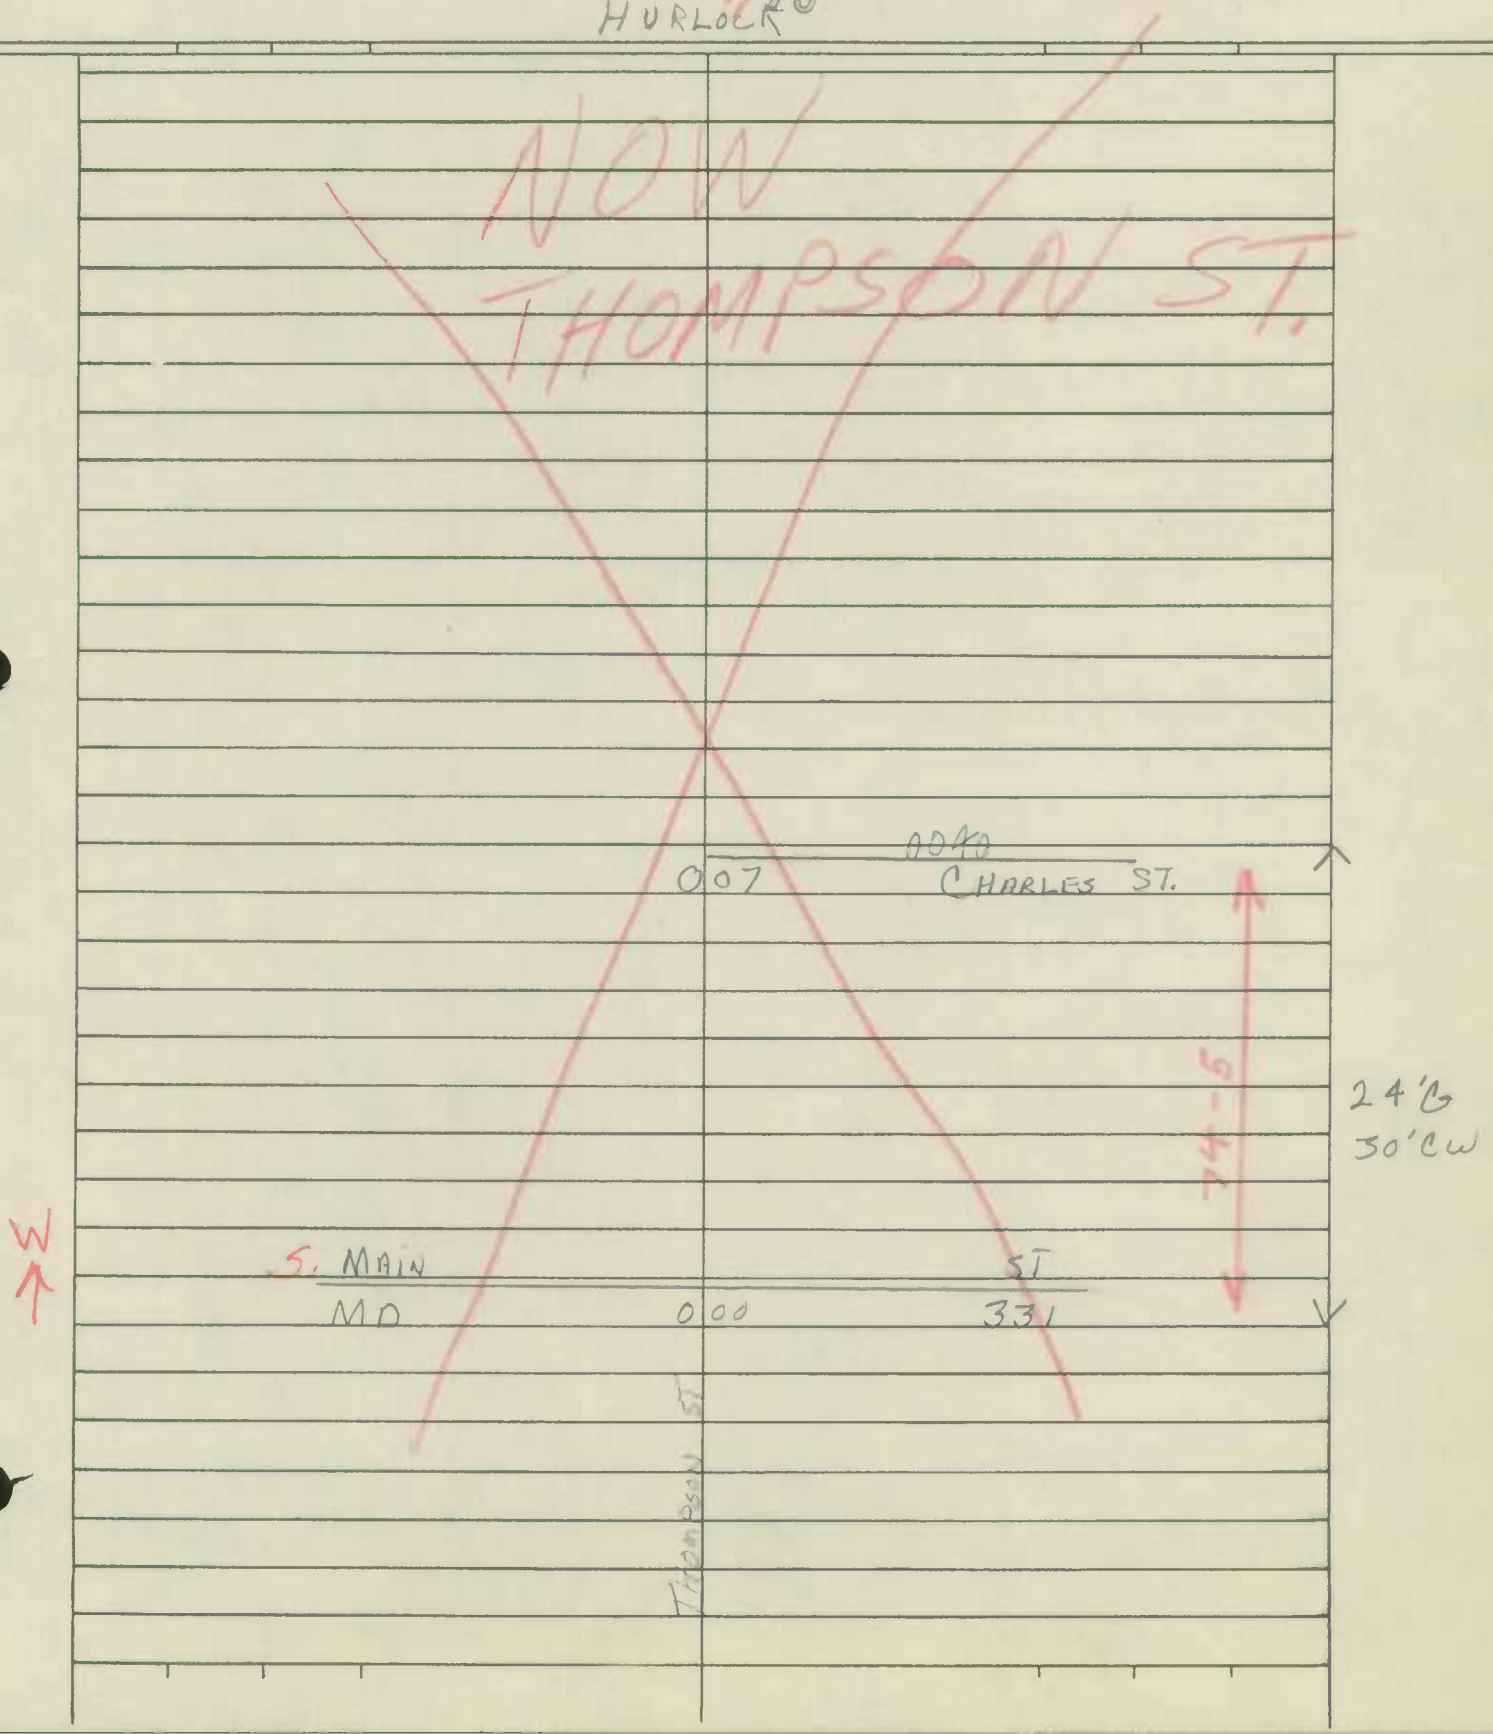

Form 6 HPS (Rev. 1961)

Mun. No. 0290

ROAD INVENTORY SHEET

Party Chief F.S.
Recorder C.E.
Chainman T.L.

T. LANDON
F. RHODES
VERIFIED
10/14/75

Road No. Co 310
Name TAYLOR AVE.
Sheet No. 10F1
Date 5-24-76
County DOR

MD

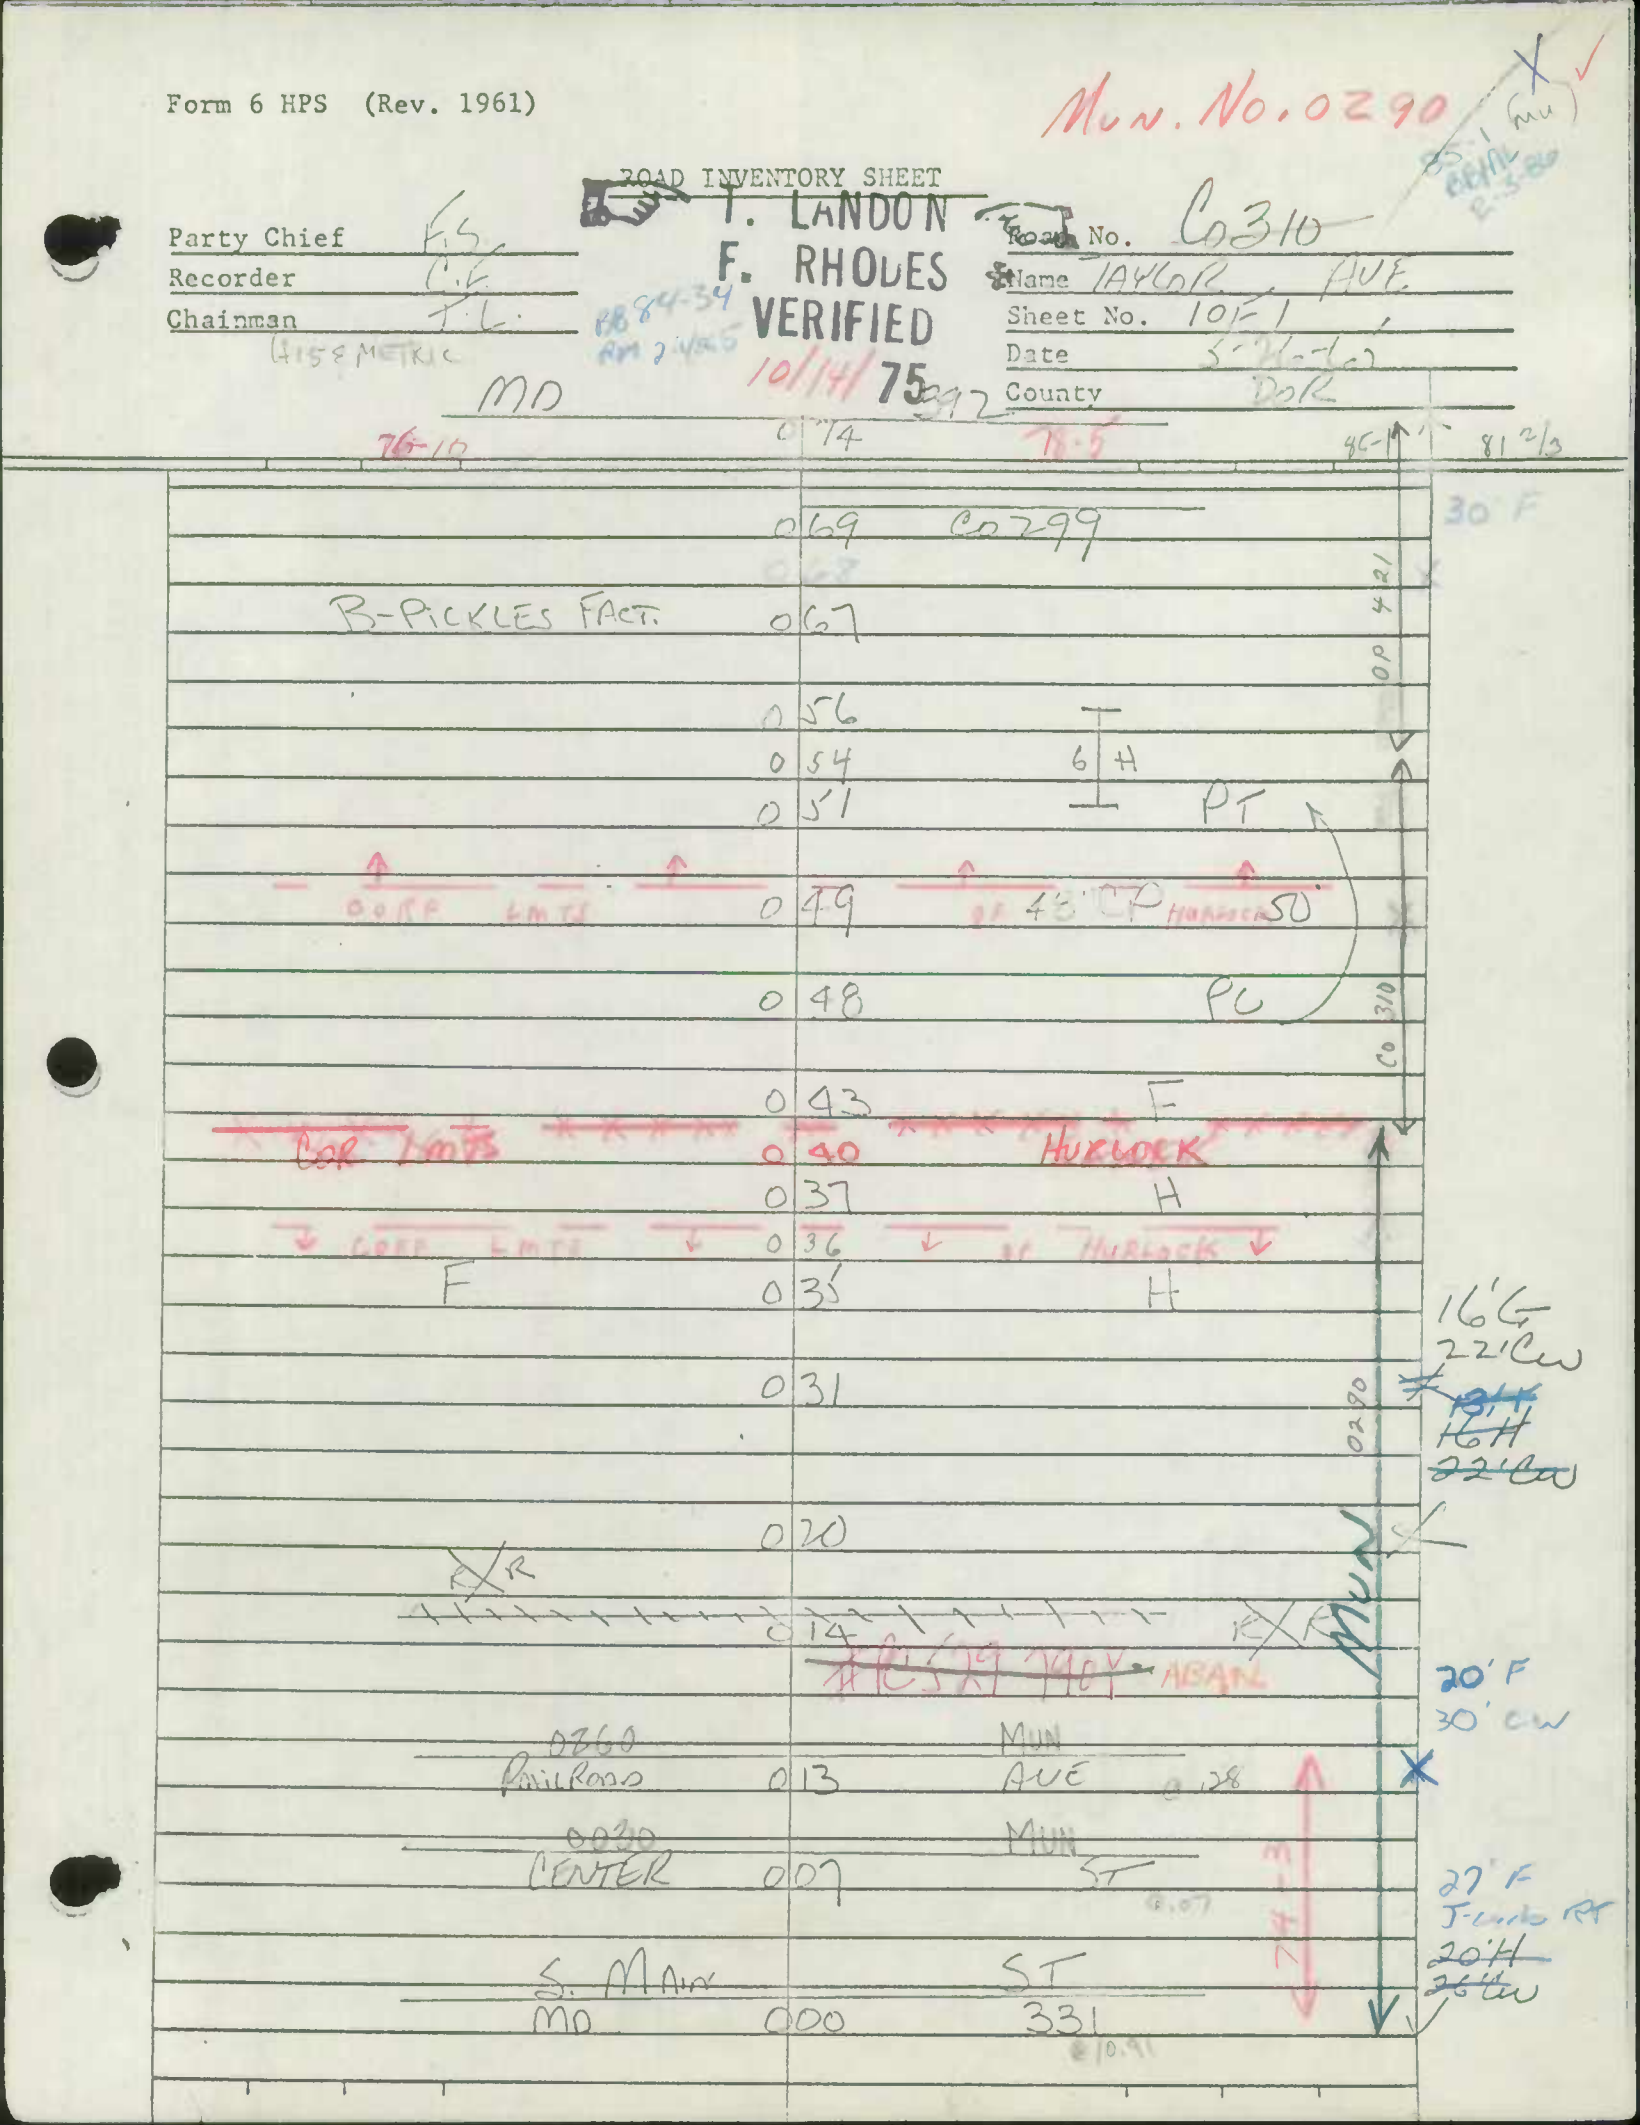

T. LANDON
F. RHODES
VERIFIED
75

SHA 51.3-8
11-15-72

STATE HIGHWAY ADMINISTRATION OF MARYLAND

ROAD INVENTORY SHEET

MUN 330 84-30. BB 2-4-85 RM AT

Party Chief T. LANDON
Recorder F. RHODES
Helper

Road No. ~~OP 48~~
Road Name (GOLD RUSH LA-) 79-1
Sheet No. 1 OF 1
Date 10/1/74
County DORCHESTER
State Coordinates 1128 - 292

Map No. G 10 PROSPECT HILLS

BB REV FR 4-21-83

82-15 HURLOCK

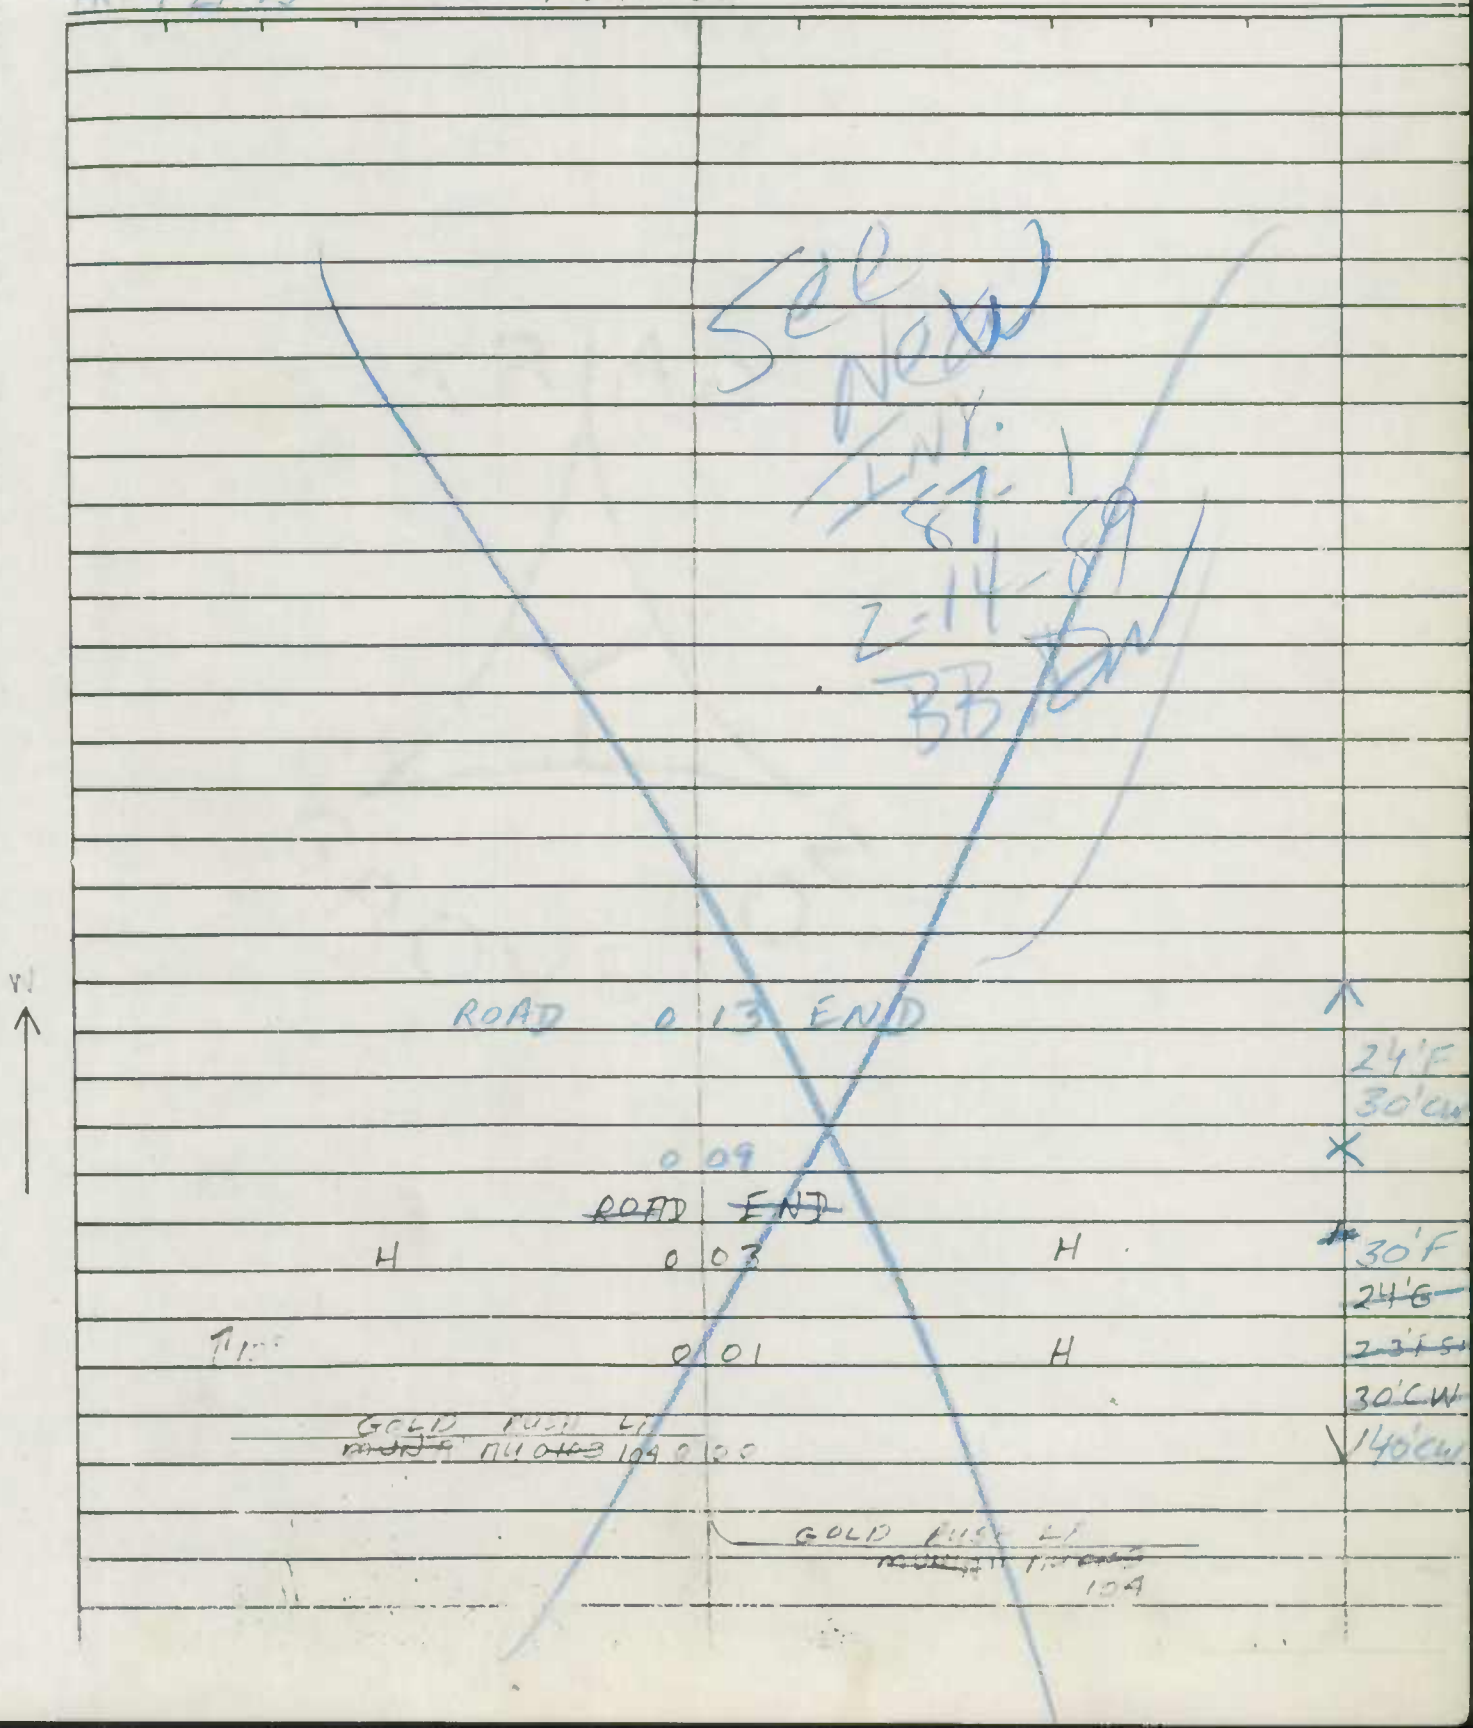

SHA 51.3-8
11-15-72

STATE HIGHWAY ADMINISTRATION OF MARYLAND

CO 77-19
CO 77-1

ROAD INVENTORY SHEET

MU 0070
~~CO 453~~

926-WK#3 extra 88-17
97-3mu

T. LANDON F. RHODES VERIFIED 10/14/75

Party Chief T. LANDON
Recorder F. RHODES
Helper

Map No. _____

Road No. ~~MUN~~ 0025 ST
Road Name (GOOD WILL ~~RTE~~)
Sheet No. 1 OF 1
Date 2/10/75
County DORCHESTER
State Coordinates 1101-282

SECRETARY

See new shw
written 09-28-01 SS/AQ
Imp # 2000-2mu

Secretary

S

ROAD END
0.08

BRANCH RD.
0.00
N
0020
MU
0.00
SOUTH
~~CO~~ MU
~~SOUTH~~
MUN.
~~463~~ 0240
ST.
~~2100~~
0.00
0.06
WEST RD.
MUDDY

88-17
20'I
~~20'G~~
26'CW

SHA 5F.3-8
11-15-72

ROAD INVENTORY SHEET

Road No. _____
Road Name _____
Sheet No. _____
Date _____
County _____
State Coordinates _____

SHA 51.3-8
11-15-72

STATE HIGHWAY ADMINISTRATION OF MARYLAND

CO 77-19
CO 77-1

ROAD INVENTORY SHEET

MU 0070
~~CO 453~~

920 LINK #3 EXTN 88-17
97-3mu

T. LANDON
F. RHODES
VERIFIED 10/14/75

Party Chief T. LANDON
Recorder F. RHODES
Helper _____

Map No. _____

Road No. ~~MUN 0025~~ ST
Road Name (GOOD WILL ~~AVE~~)
Sheet No. 1 OF 1
Date 2/10/75
County DORCHESTER
State Coordinates _____

SECRETARY 1101-282

See new Inv
Written 00-28-01 SS/AQ
Imp # 2000-2mu

S

ROAD END
0.08

88-17
20'I
~~20'G~~
26'CW

BRANCH RD.
0.00
0.20
N
E
W

SOUTH ~~CO~~ MU
~~SOUTH~~
MUN.
0.00

~~463~~ 0240
ST.
~~0100~~

0.06

WES RD.
0.00
0.20
N
E
W
MU 0220

SHA 5F.3-8
11-15-72

ROAD INVENTORY SHEET

Road No. _____
Road Name _____
Sheet No. _____
Date _____
County _____
State Coordinates _____

SHA 51.3-8
11-15-72

STATE HIGHWAY ADMINISTRATION OF MARYLAND

CO-77-19 MU 77-1

MU 0280

ROAD INVENTORY SHEET

~~CO~~ ~~466~~

Party Chief T. LANDON
Recorder E. RHODES
Helper _____

Map No. _____

Road No. ~~MUN.~~ ~~0125~~
Road Name WATER ST.
Sheet No. 1 OF 1
Date 10/14/75
County DORCHESTER
State Coordinates 1094 - 284

97-17 mu

SECRETARY

LOADING DOCK
2001 MUBX # 2
2/18/02
ss/ws

N

0 03 MAIN ST.
~~MUN.~~ ~~CO~~ MU 0120
~~0053~~ ~~457~~

18'I
2.6'E SHLD
34'CW

0 00
BARRICADE ST.
10'
14 I

MAIN
MD.

SHA 51.3-8
11-15-72

ROAD INVENTORY SHEET

Road No. _____
Road Name _____
Sheet No. _____
Date _____
County _____
State Coordinates _____

Form 6 HPS (Rev. 1961)

89-4
CG/BB
12-28-89
MP 0.13

ROAD INVENTORY SHEET

Party Chief F.S.
Recorder C.F
Chainman T.L.

T. LANDON
F. RHODES
VERIFIED
10/15/75

Road No. 0020
Name GAY ST
Sheet No. 1 OF 1
Date 5-17-65
County DOR

I 16

79-7

83-5

SEE ROUTE 16

Vienna

U.S. ~~MD~~ MN | 013 | 0075 ~~SO~~ ~~ST~~

MUN | 0090
RAE | 009 | ST

MUN | 0050
LINDEN | 007 | LA. ~~AVE~~

000
ROAD END

15'F
24'W

18'G
24'W

~~24'F~~
30'W

Form 6 HPS (Rev. 1961)

89-4
CG/BB
12-28-89
MP 0.13

ROAD INVENTORY SHEET

Party Chief F.S.
Recorder C.F.
Chainman T.L.

T. LANDON
F. RHODES
VERIFIED
10/17/75

Road No. 0020
Name GAY ST
Sheet No. 1 OF 1
Date 5-17-65
County DOR

I 16

SEE VIENNA

BB/AH
6/21/95
FOR 95

Rhodes Market Vienna Rd

OLD U S
~~U.S.~~ ~~MD~~ MU 0.13 0075 ~~50~~ ~~234~~ F.R.

MUN
RACE 009 0090 ST

MUN
LINDEN 007 0050 LA. ~~AVE~~

0.00
ROAD END

15'F
24'CW

18'G
24'CW

~~24'F~~
30'CW

SHA 51.3 - 8 Revised 4.83

Reported by mun. - 1972
Not reported by Co.

MARYLAND STATE HIGHWAY ADMINISTRATION

Vienna

ROAD INVENTORY SHEET

* 0.00-0.06 was Tabbed as Co 438 Revised per Dewey Blades, Pres. - Town of Vienna - phone conv. 1-30-90

Party Chief T. Landon
Recorder F. Rhodes
Assistant Revised 1-30-90 KWP
Map No./Dir. 1 S
State Coordinates 1135 - 240

Road No. MUN. 0050
Road Name ~~(LINDEN LA.)~~
County Dorch ST + C
Date 10-15-75
Sheet No. 1 OF 1

2-3-86

TRAFFIC CODES
TRAFFIC CONTROLS: STOP SIGN=SS, TRAFFIC LIGHT=T.L., FLASHING RED BALL=F.R.

TRAFFIC CODES
PARKING RESTRICTIONS: A.M. PEAK, P.M. PEAK, A.M./P.M. PEAK, NO PARKING ANYTIME=N.P., COMM/IND. ACCESS=E

SYSTEM				TRAFFIC		LINE DIAGRAM	TRAFFIC			PAVEMENT DATA
FED. AID.	FUNCT CLASS.	HWY. SYS.	HPMS SAMPLE	PRKG. REST.	COM/IND. ACCESS		CONTROL	COM/IND. ACCESS	PRKG. REST.	
						MARKET ST				
						MUN C 33 0060				
						See Log Inv. for 0.0-0.2				18' F
						Imp # 20 on MUN * 1 1A & 1B				24' CW
						SSInP Horseman ST				
						0 26 MUN 0040				
						GAY ST				
						MUN 0 22 0020				26' F
										30' CW
						Higgins ST				
						MUN C030 C 14				
										24' FI
										30' CW
						(Linden La.)				
						06 Co 438 90°				25' C
										4' E SW LT
										30' CW
						004				
						RADF Mun. ST 0040 .02 .01				30' I
										2-4' E SW LT
						COLO CLEAN US 50				40' CW
						~~MT~~ MU 000 ~~73~~ 75				

NON F/A Access Local

SYSTEM				TRAFFIC		LINE DIAGRAM	TRAFFIC			PAVEMENT DATA
FED. AID.	FUNCT. CLASS.	HWY. SYS.	HPMS SAMPLE	PRKG. REST.	COM/IND ACCESS		CONTROL	COM/IND ACCESS	PRKG. REST.	

SHA 51.3-8
11-15-72

STATE HIGHWAY ADMINISTRATION OF MARYLAND

85-2
RB/AL
2-3-86
A.T.

ROAD INVENTORY SHEET

Party Chief F SETTAN
Recorder C FORREST
Helper I L

Map No. I16 VER YLA FR 10-15-75

Road No. 0060
Road Name MARKET ST
Sheet No. 1 of 1
Date 5-13-67
County DORCH
State Coordinates

REWRIT-8-18-81 VTSC

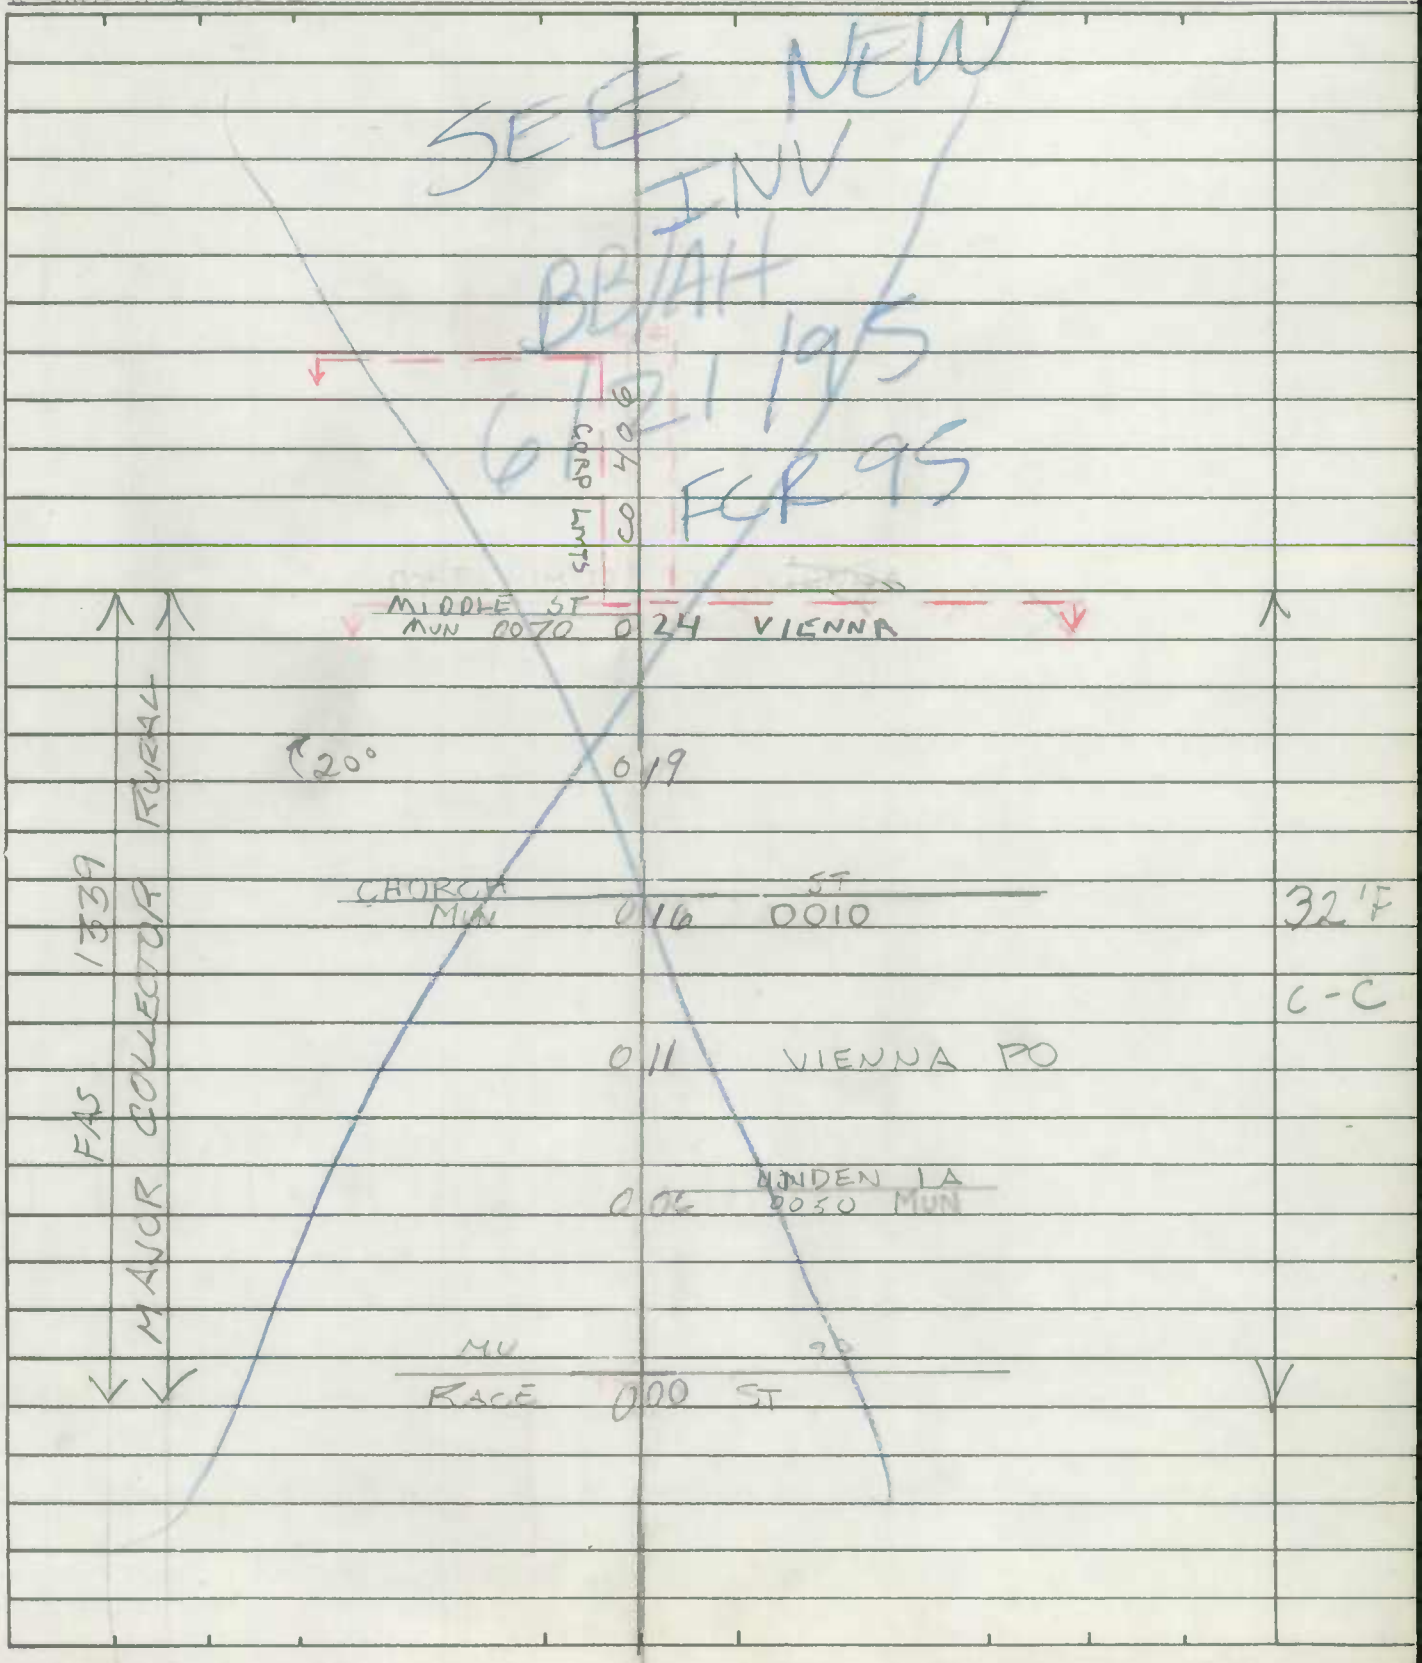

SHA 51.3-8
11-15-72

ROAD INVENTORY SHEET

Road No. _____
Road Name _____
Sheet No. _____
Date _____
County _____
State Coordinates _____

Form 6 HPS (Rev. 1961)

Vienna

ELLIOTT IS. RD. ✓

VIENNA HENRYS CROSSROADS

ROAD INVENTORY SHEET

Party Chief F SETTAN — T. LANDON

Recorder C FORREST — F. RHODES

Chainman T.L.

VERIFIED 10/5/75

Road No. C0192 C0406 CO

Name MARKET ST

Sheet No. 1 OF 4

Date 5-13-6J

County DORCHESTER

75-4 (A. Tapped) 73-3 78-2 77-3

F-1200'	1	36		
H-ABAN.	1	24	STEELES MILL Rd C0177	16'G 20'CW
F	1	14		X
	1	03	H	
	0	96	H	
	0	91	H	18'G 24'CW
	0	44	DR	X
F-500'	0	34		
	0	30	F	
VIENNA SCHOOL	0	27		
	0	26	H	20'G 26'CW
~~ABAN. L.S.~~	~~0~~ 0	~~24~~ 24	VIENNA	X
MIDDLE ST	0124	0.24 VIENNA		
CHURCH	0	16	ST.	
	0	11	VIENNA P.O.	
	0	06	LINDEN ~~AVE~~ LA.	32'G C-C
RACE	0	00	ST	✓

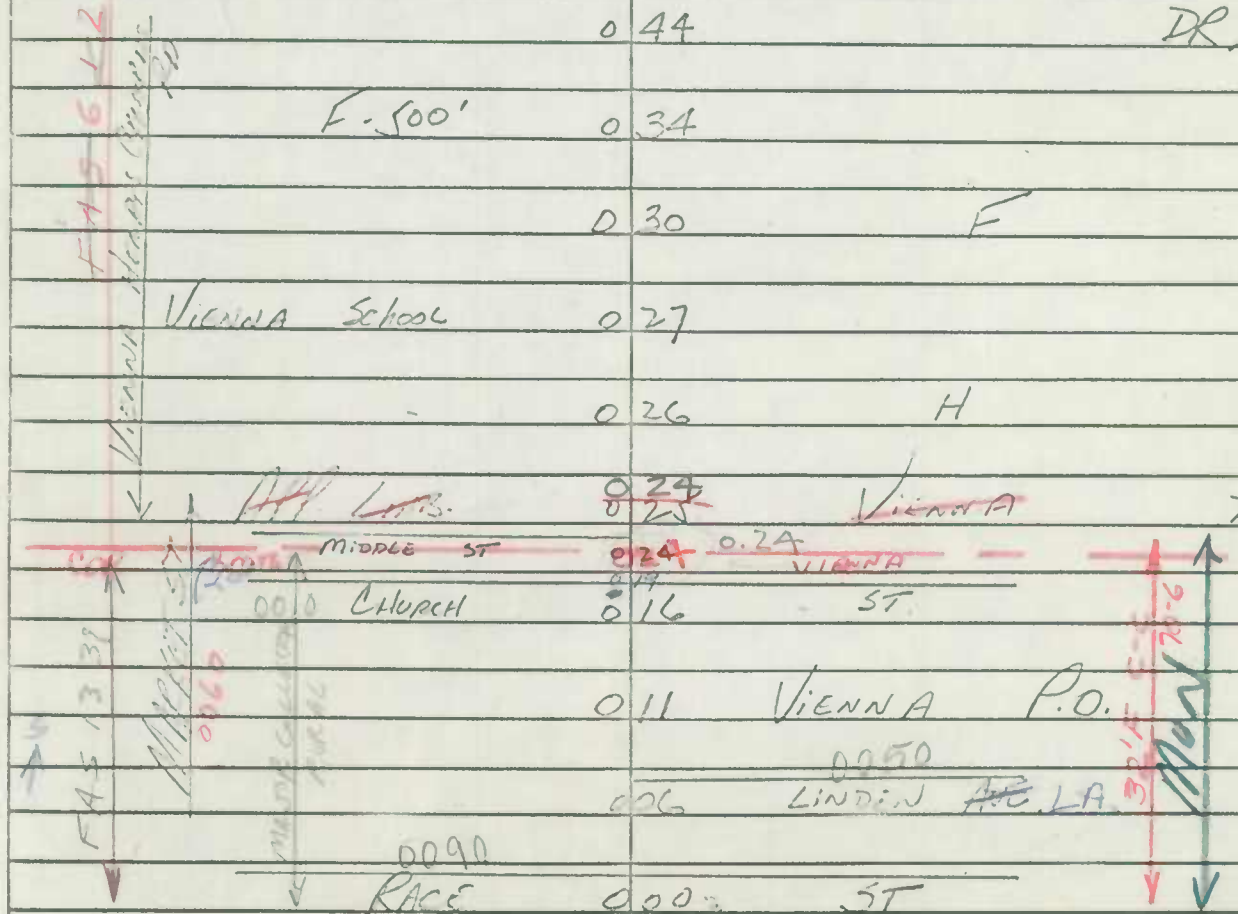

Form 6 HPS (Rev. 1961)

ROAD INVENTORY SHEET

T. LANDON
F. RHODES
VERIFIED
10/15/75

Party Chief	F.S.
Recorder	C.E.
Chainman	T.L.

Road No.	0070
Name	MIDDLE ST
Sheet No.	1 OF 1
Date	5-17-6J
County	DOR

75-5 A. Tarbell 77-4 78-3

VIENNA

VIENNA POWER PLANT

XXXXX

0043

18'G 24'CW

U.S. 0040 50

16'J 2-5'G stkd 26'CW

0090 PACE 0033 ST

30'G 40'CW

0010 CHURCH 0019 ST

18'G 24'CW

0012

~~School Acad~~ 0011 PT

Corp. Line Vienna 85°

PVT. Cem. 0007 PC

180°

0006

0002 PARKING NEW ELEM SCH.

E

0060 MARKET ST. 0000 VIENNA HENRYS CROSSROADS CO.

CO 406

~~Co 192~~

17'E 24'CW

Corp.

* Transfer Letter (12-10-90 - 1-4-91)

SHA 51.3 - 8 Revised 4.83

MARYLAND STATE HIGHWAY ADMINISTRATION

ROAD INVENTORY SHEET mu 0075 - Vienna COSTO (89-4)

Party Chief C.G
Recorder B.B.
Assistant
Map No./Dir. I-16 / E
State Coordinates 1130 - 243

Road No. ~~MD 331~~
Road Name OLD U.S. 50
County DORCHESTER
Date 12/27/89
Sheet No. 1 OF 2

91-1-A/T

TRAFFIC CODES
TRAFFIC CONTROLS: STOP SIGN=SS, TRAFFIC LIGHT=T.L., FLASHING RED BALL=F.R.

TRAFFIC CODES
PARKING RESTRICTIONS: A.M. PEAK, P.M. PEAK, A.M./P.M. PEAK, NO PARKING ANYTIME=N.P., COMM/IND. ACCESS=E

SYSTEM: FED. AID. | FUNCT. CLASS. | HWY. SYS. | HPMS SAMPLE
TRAFFIC: PKG. REST. | COM/IND. ACCESS

LINE DIAGRAM

NON FA
RURAL MINOR COLLECTOR
(1 # 1300500001521)

1 19
1 08
1 06
1 03
1 02
0 95
0 71
0 22
0 18
0 04
0 00

50 OLD RT
SPUR
.4 .1 .0
MM 95 (OLD US 50)
50 OLD RT
.4 .1 .0
VIENNA E.S.
SPUR US 50 TO MD 331
0.18 MI 12'I
GATEWAY
OCEAN
E.B.L
W.BL. U.S. 50

C10
C0
S10
C0
S10
C10

TRAFFIC: CONTROL | COM/IND. ACCESS | PKG. REST.
E
E
85° SS
SS

PAVEMENT DATA
24'I
240'I SHLD
2 ML
X
34'I
2 ML

LINE DIAGRAM

SYSTEM: FED. AID | FUNCT. CLASS | HWY SYS. | HPMS SAMPLE
TRAFFIC: PKG. REST. | COM/IND ACCESS
TRAFFIC: CONTROL | COM/IND ACCESS | PKG. REST.
PAVEMENT DATA

NANTICOKE RIVER
BRIDGE UNDER DEMOLITION
APPROX. 550' OPEN DRAW
CORP — LMT
VIENNA
#9001
ROAD CLOSED
VIENNA POWER PLNT
MIDDLE STREET
MU 0070
WEBSTER ALLEY
MU 8010
MU 0075
GAY ST
MU 0020
Vienna Rd
MU 0075
HIGGINS ST
MU 0030
MU 0075
RACE ST
MU 0040
LINDEN DR.
CORP LIMITS
OF VIENNA
MU 0050

24'I
2-10'ISHLD
2ML

E
FY

SHA 51.3-8
11-15-72

STATE HIGHWAY ADMINISTRATION OF MARYLAND

89-4 (state)
CG/BB
12-28-89
MP. 0.00

ROAD INVENTORY SHEET

Party Chief FS
Recorder CT
Helper TL

VER 10-15-15
TL & FR

Map No. I16

Road No. 0090
Road Name RACE ST
Sheet No. 1 OF 1
Date 5-17-65
County DOR
State Coordinates

REVIT: 8-18-81 JTSC

VIENNA

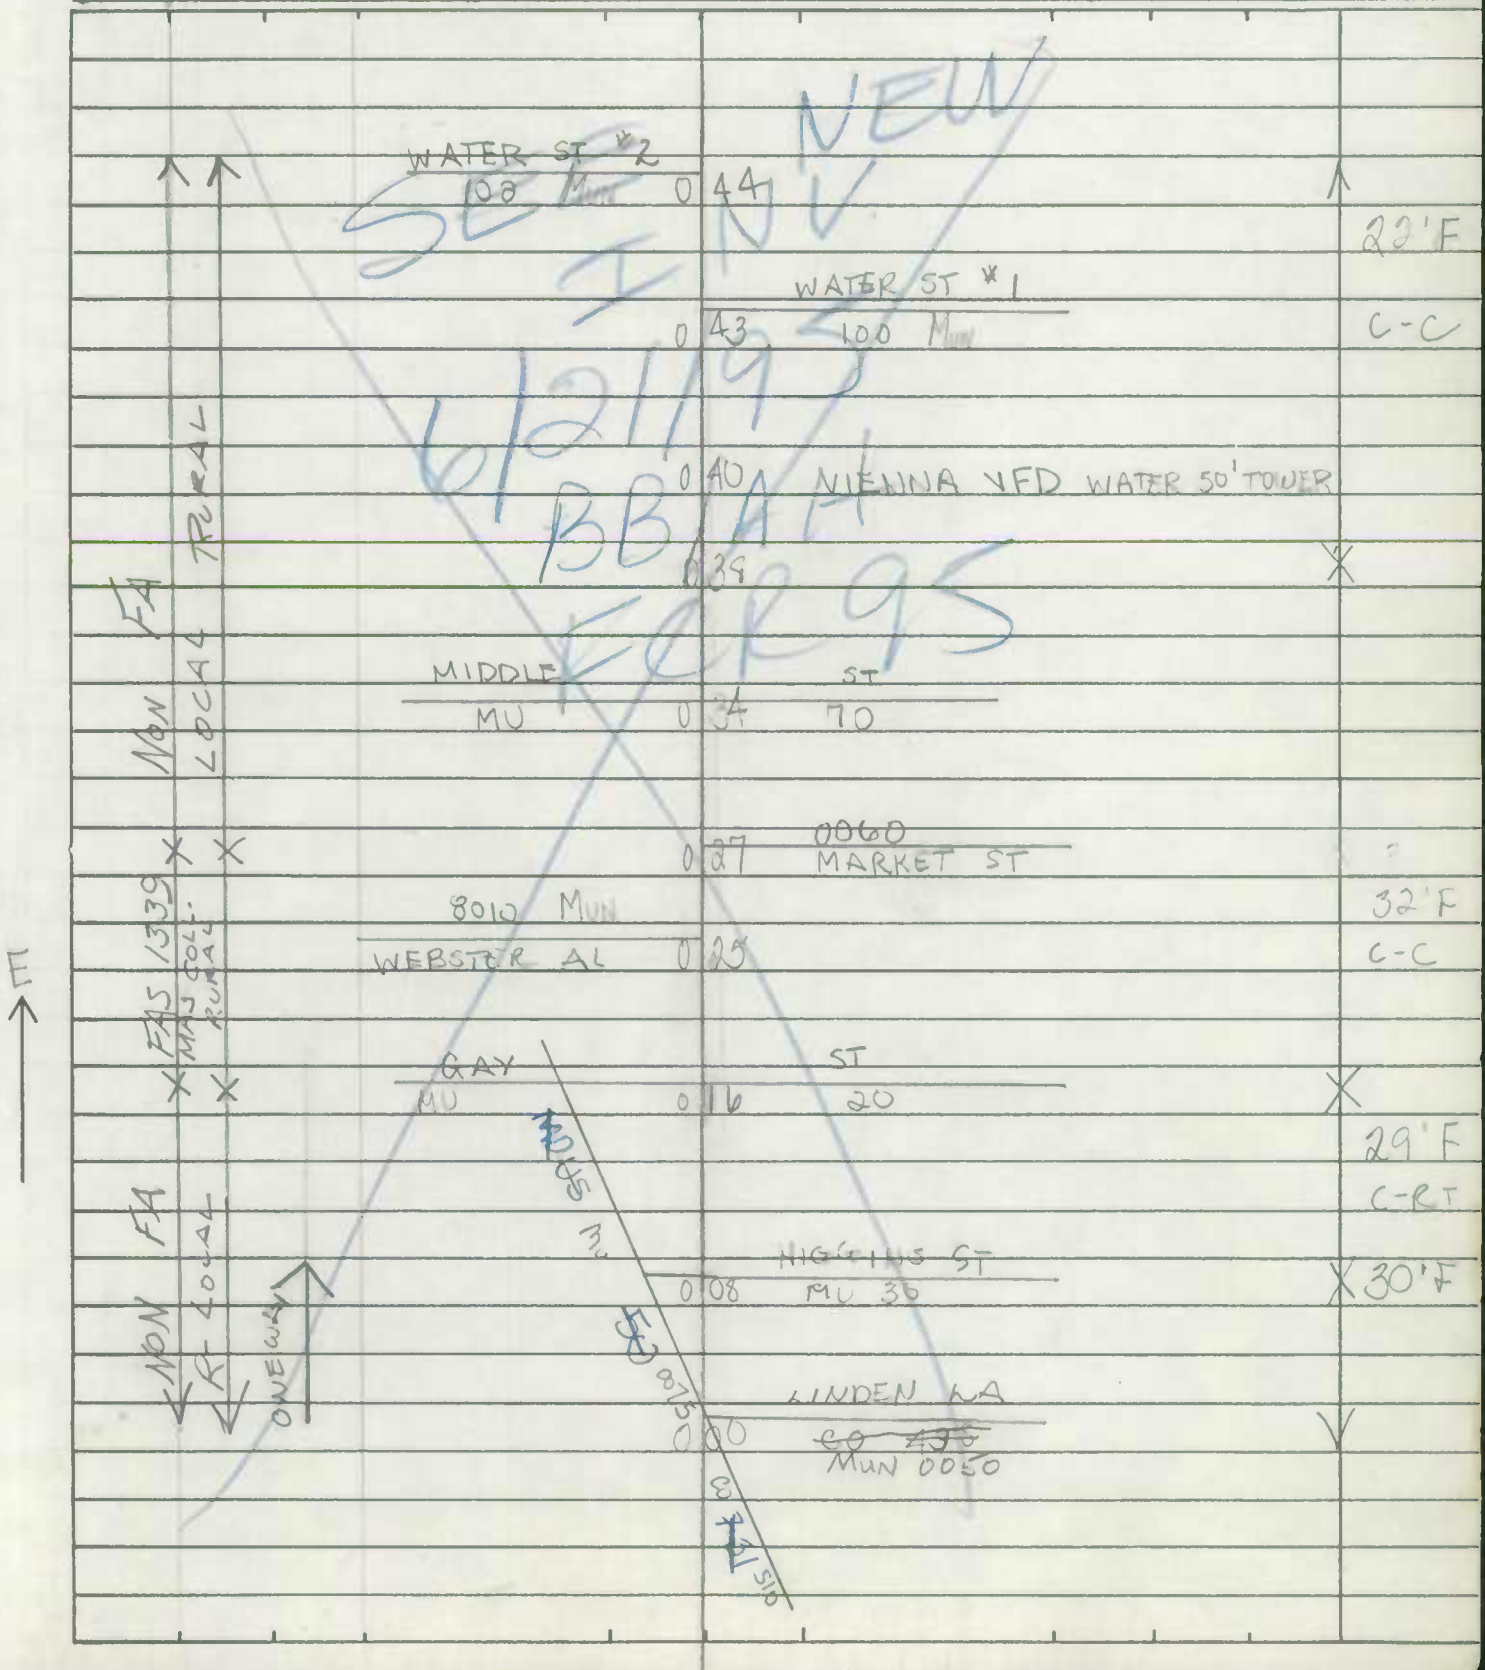

SHA 51.3-8
11-15-72

ROAD INVENTORY SHEET

Road No. _____
Road Name _____
Sheet No. _____
Date _____
County _____
State Coordinates _____

Form 6 HPS (Rev. 1961)

ROAD INVENTORY SHEET

Party Chief F.S.
Recorder C.F.
Chainman T.L.

T. LANDON
F. ARMOLES
VERIFIED
10/15/75

Road No. 0090
Name RACE ST
Sheet No. 1 OF 1
Date 5-17-65
County DOR

VIENNA

0102 (WATER ST #2) 044
0100 (WATER ST #1) 043
040 VIENNA V.F.D. WATER-50 TOWER
038
0090 MIDDLE 034 ST.
0060 027 MARKET ST
0010 (WEBSTER ALLEY) 025
0020 MD 331 GAY ST 016
0040 GAY ST
0030 008 HIGGINS ST
LINDEN LA
000 CO. 0050 927

22'G C-C
32'G C-C
29'G CURB RT.
18'G 30'CW

50

*Tranfer Letter (12-10-90) 89-4

SHA 51.3 - 8 Revised 4.83

MARYLAND STATE HIGHWAY ADMINISTRATION

Vienna

ROAD INVENTORY SHEET

Party Chief C. GALE
Recorder B. Balzanna
Assistant Rewr. Hen (1-21-91) JEL
Map No./Dir. I16/ N
State Coordinates 1135 - 240

Road No. MU 0095
Road Name (Rhodesdale-Vienna Rd)
County Dorchester
Date 12-27-89
Sheet No. 1 OF 1

TRAFFIC CODES
TRAFFIC CONTROLS: STOP SIGN=S.S., TRAFFIC LIGHT=T.L., FLASHING RED BALL=F.R.

TRAFFIC CODES
PARKING RESTRICTIONS: A.M. PEAK, P.M. PEAK, A.M./P.M. PEAK, NO PARKING ANYTIME=N.P., COMM/IND. ACCESS=E

SYSTEM				TRAFFIC		LINE DIAGRAM	TRAFFIC			PAVEMENT DATA
FED. AID.	FUNCT CLASS	HWY. SYS.	HPMS SAMPLE	PKG. REST.	COM/IND. ACCESS		CONTROL	COM/IND. ACCESS	PKG. REST.	
	FAS 1339					(Rhodesdale Rd)				24' I
	Rural Major Collector					SCENIC BYWAY				4' I Shld-RT
										2' I Shld-LT
										2 ML
						.01				
						CORP LMTS OF VIENNA				
						3.4 mi				
						0.01 SPUR				
						(Phillips St)				
						MU 0080 0.06				
										24' I
										10' I Shld-RT
										6' I Shld-LT
						Old US 50				2 ML
						MU 0.00 0075				
						GAY ST (MU 0080)				

SYSTEM				TRAFFIC		LINE DIAGRAM	TRAFFIC			PAVEMENT DATA
FED. AID.	FUNCT. CLASS.	HWY. SYS.	HPMS SAMPLE	PRKG. REST.	COM/IND ACCESS		CONTROL	COM/IND ACCESS	PRKG. REST.	

SKETCH OF EASTERN SHORE STATE HOSPITAL

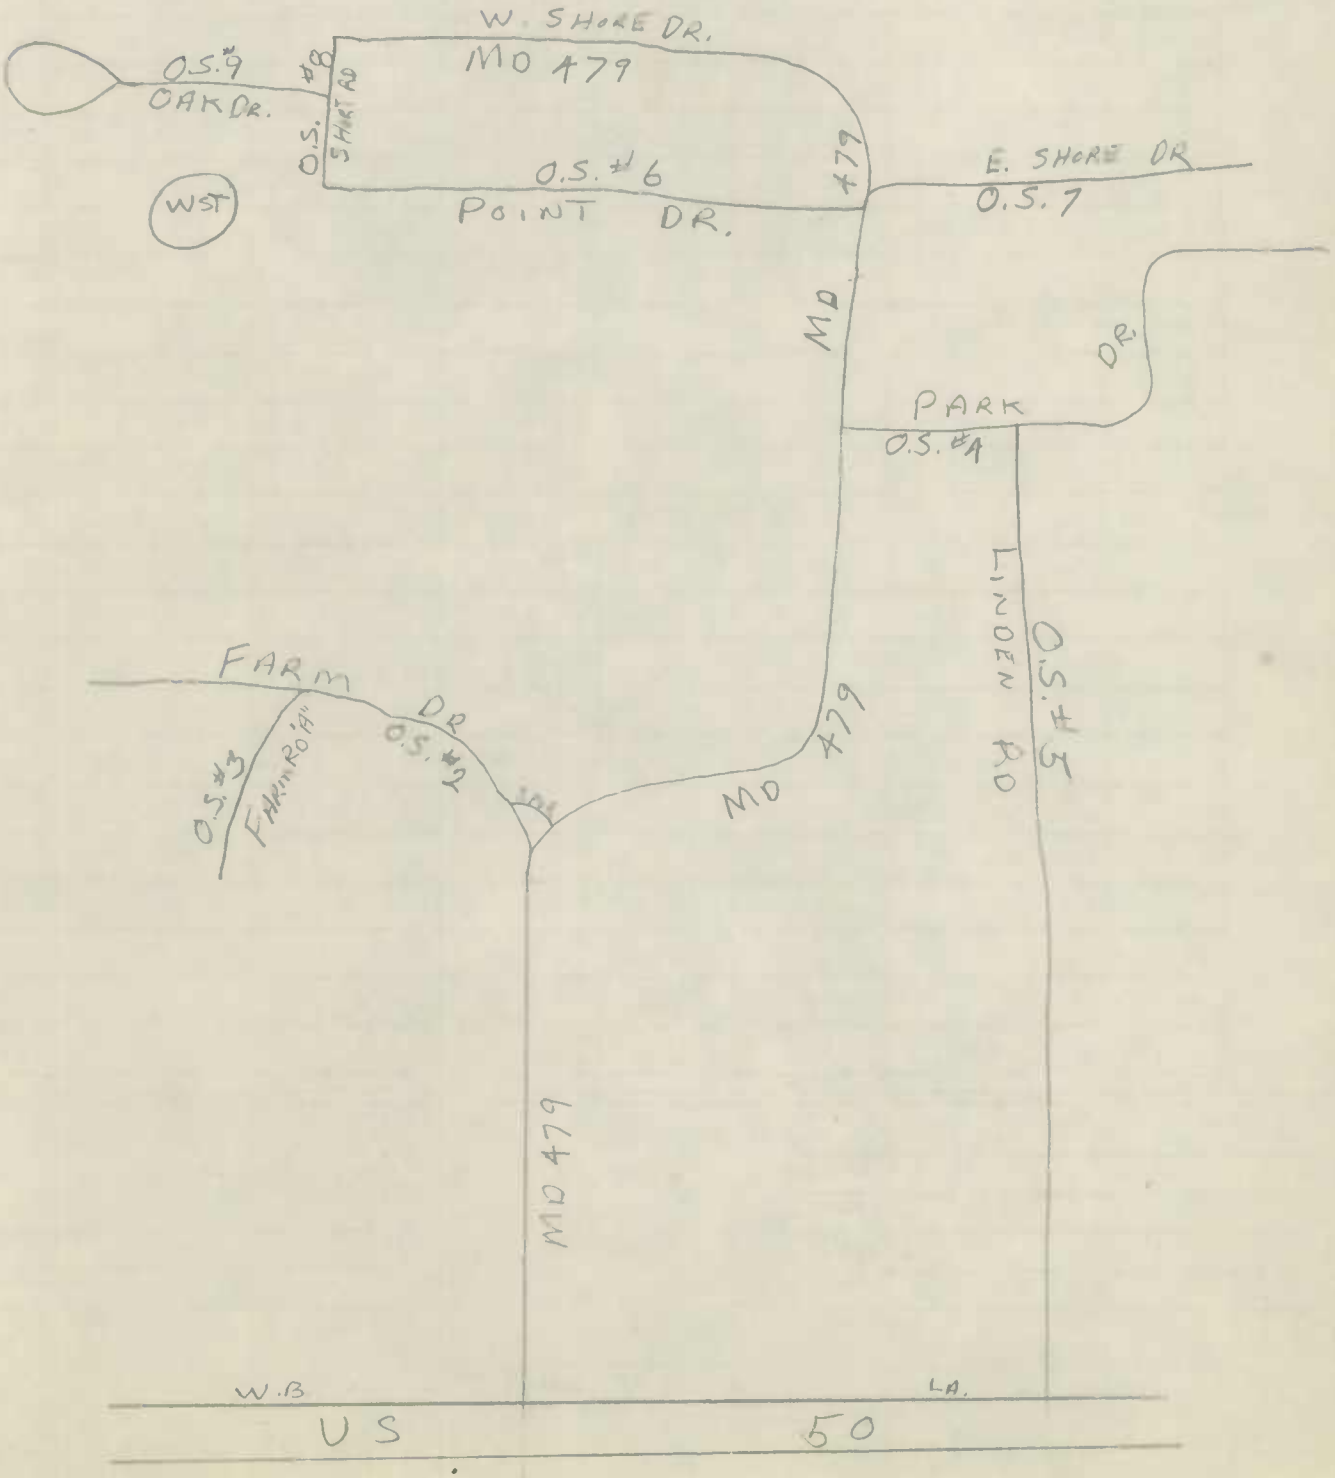

Form 6 HPS (Rev. 1961)

ROAD INVENTORY SHEET

Party Chief _____ Road No. _____

Recorder _____ Name _____

Chainman _____ Sheet No. _____

Date _____

County _____

Form 6 HPS (Rev. 1961)

0003

ROAD INVENTORY SHEET

~~4X-3~~ SR-3

Party Chief F. SEITZ

Recorder T. LANNON

Chainman

1071-266

G10

Road No. ~~05.#2~~

Name FARM DR

Sheet No. 1 OF 1

Date 6-25-65

County DORCHESTER

EASTERN SHORE STATE HOSPITAL

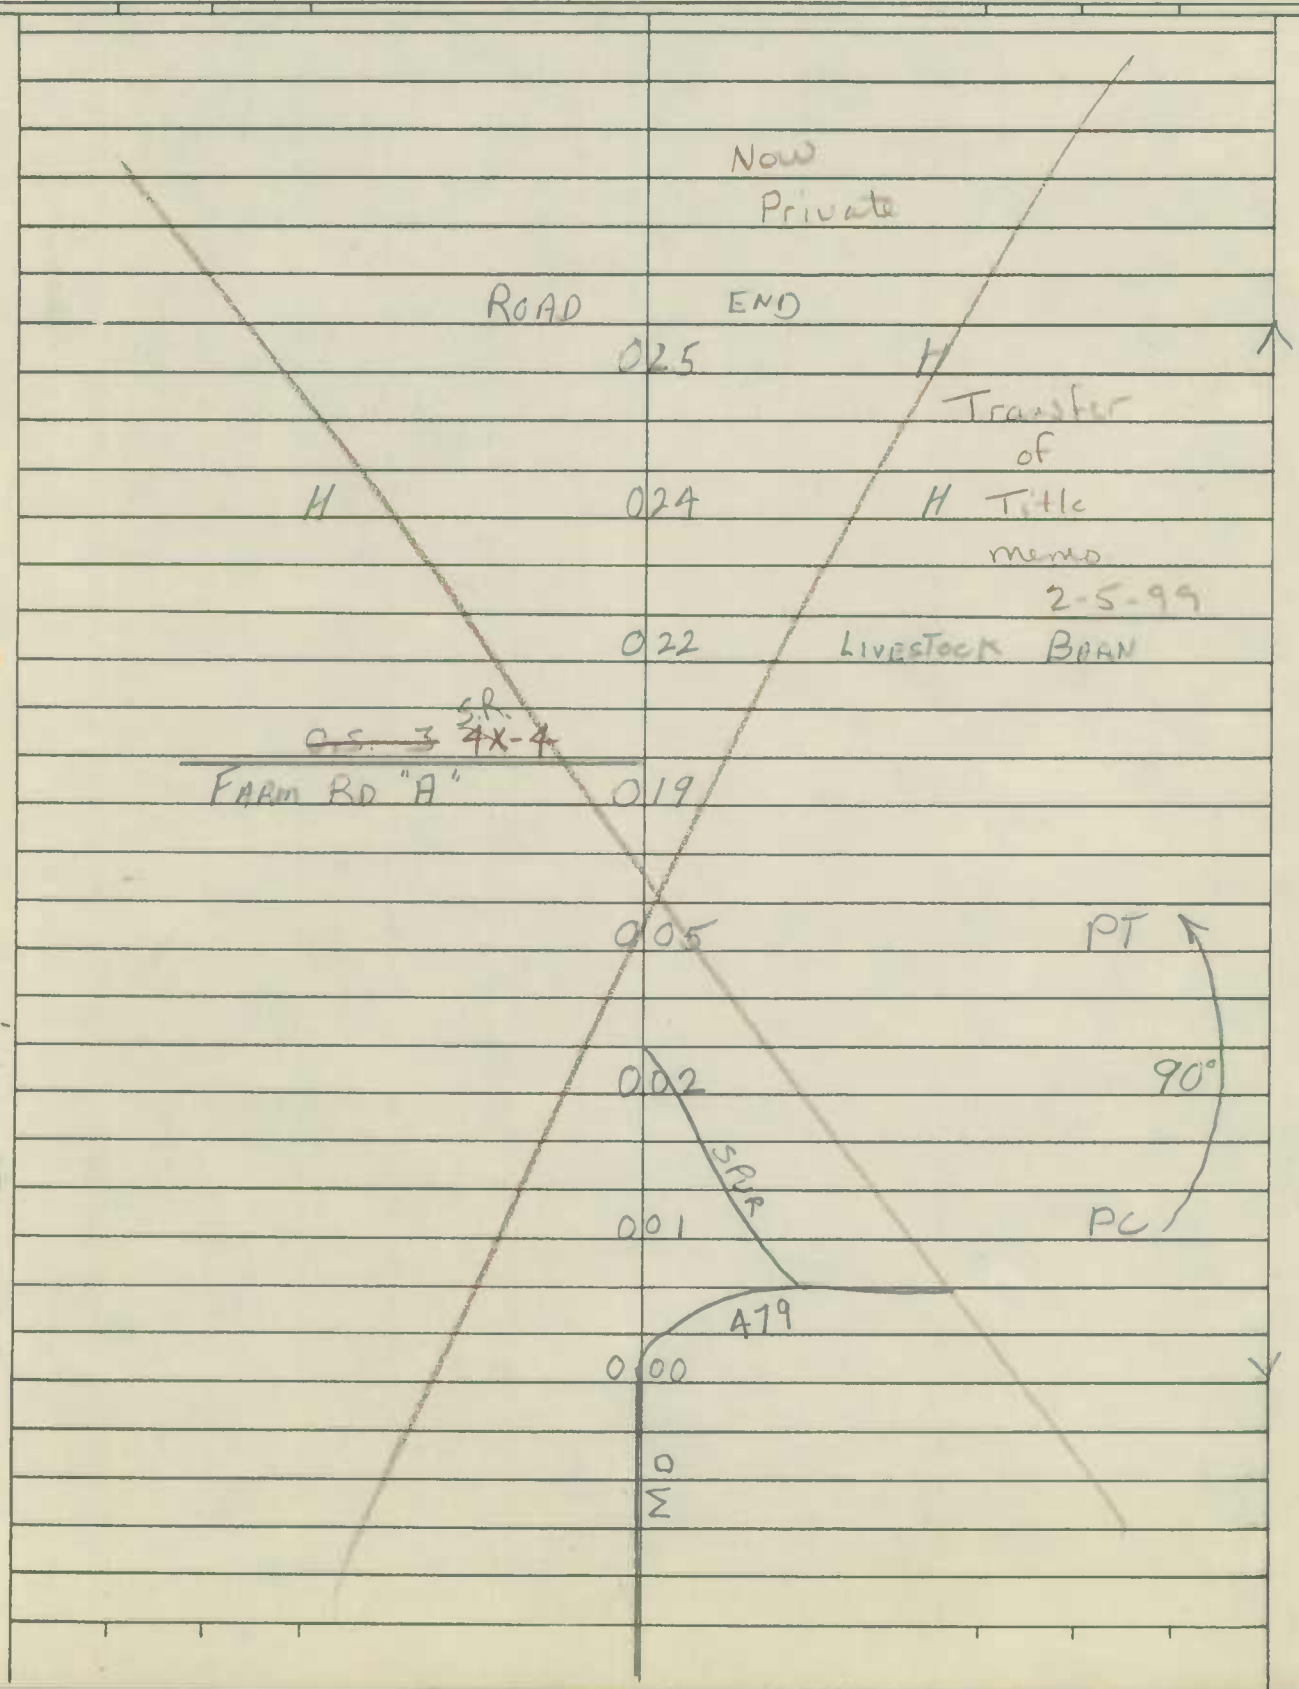

Form 6 HPS (Rev. 1961)

0004

ROAD INVENTORY SHEET

~~4X-4~~ SR-4

Party Chief F. SETTAN
Recorder J. LANDON
Chainman

1070-267
G10

Road No. ~~Q.S. #3~~
Name FARM RD "A"
Sheet No. 1 OF 1
Date 6-25-65
County DORCHESTER

EASTERN SHORE STATE HOSPITAL

NOW

Private

Transfer
of
Title

Memo. 2-5-99

ROAD

END

024

10'E
14'CW





Form 6 HPS (Rev. 1961)

0005

ROAD INVENTORY SHEET

~~4X-5~~ SR-5

Party Chief F SETTHN
Recorder T. L HANDON
Chainman

1076-266
G10

Road No. ~~0.5.44~~
Name PARK DR
Sheet No. 1 OF 2
Date 6-25-65
County DORCHESTER

EASTERN SHORE STATE HOSPITAL

PT 90° PC	0 41	Now
	0 39	Private
	0 32	Transfer of Title Memo 2-5-99
PT 90° PC	0 29	
H-200'	0 25	
		~~S.R. 5~~ S.R. ~~4X-6~~
H	0 21	LINDEN RD
	0 15	
	0 00	A-79

19'I
24'CW

X

22'H
C-C

E

9

MD

CAMBRIDGE

0005

Form 6 HPS (Rev. 1961)

ROAD INVENTORY SHEET

~~4X-5~~ SR·5

Party Chief F. SETTAN

Recorder T. LANDON

Chainman

Road No. ~~U.S. 4~~

Name PARK DR

Sheet No. 2 OF 2

Date 6-25-65

County DORCHESTER

EASTERN SHORE STATE HOSPITAL

	ROAD END
APARTMENT PARKING	0 46
APARTMENT-6-UNITS	0 42

SAME

CAMBRIDGE

0006

Form 6 HPS (Rev. 1961)

ROAD INVENTORY SHEET

~~4X-6~~ SR-6

Party Chief F. SETTAR
Recorder T. LANDER
Chainman

1073-265
G10

Road No. ~~U.S. #50~~
Name LINDEN RD
Sheet No. 1 OF 1
Date 6-25-65
County DORCHESTER

EASTERN SHORE STATE HOSPITAL

Now

Private

Transfer
of
Title
Memo 2-5-99

US
W.B

0 46

50
FM

0 35

DR

0 07

DR

12' E
16' W

~~U.S.~~ SR ~~4X~~ - 5

4

PART

0 00

DR

Form 6 HPS (Rev. 1961) Cambridge 0007

ROAD INVENTORY SHEET

~~4X-7~~ SR-7

Party Chief F. SETTAN
Recorder T. LANDON
Chainman

1072-267
G10

Road No. ~~U.S. #6~~
Name POINT DR.
Sheet No. 1 OF 1
Date 6-25-65
County DORCHESTER

EASTERN SHORE STATE HOSPITAL

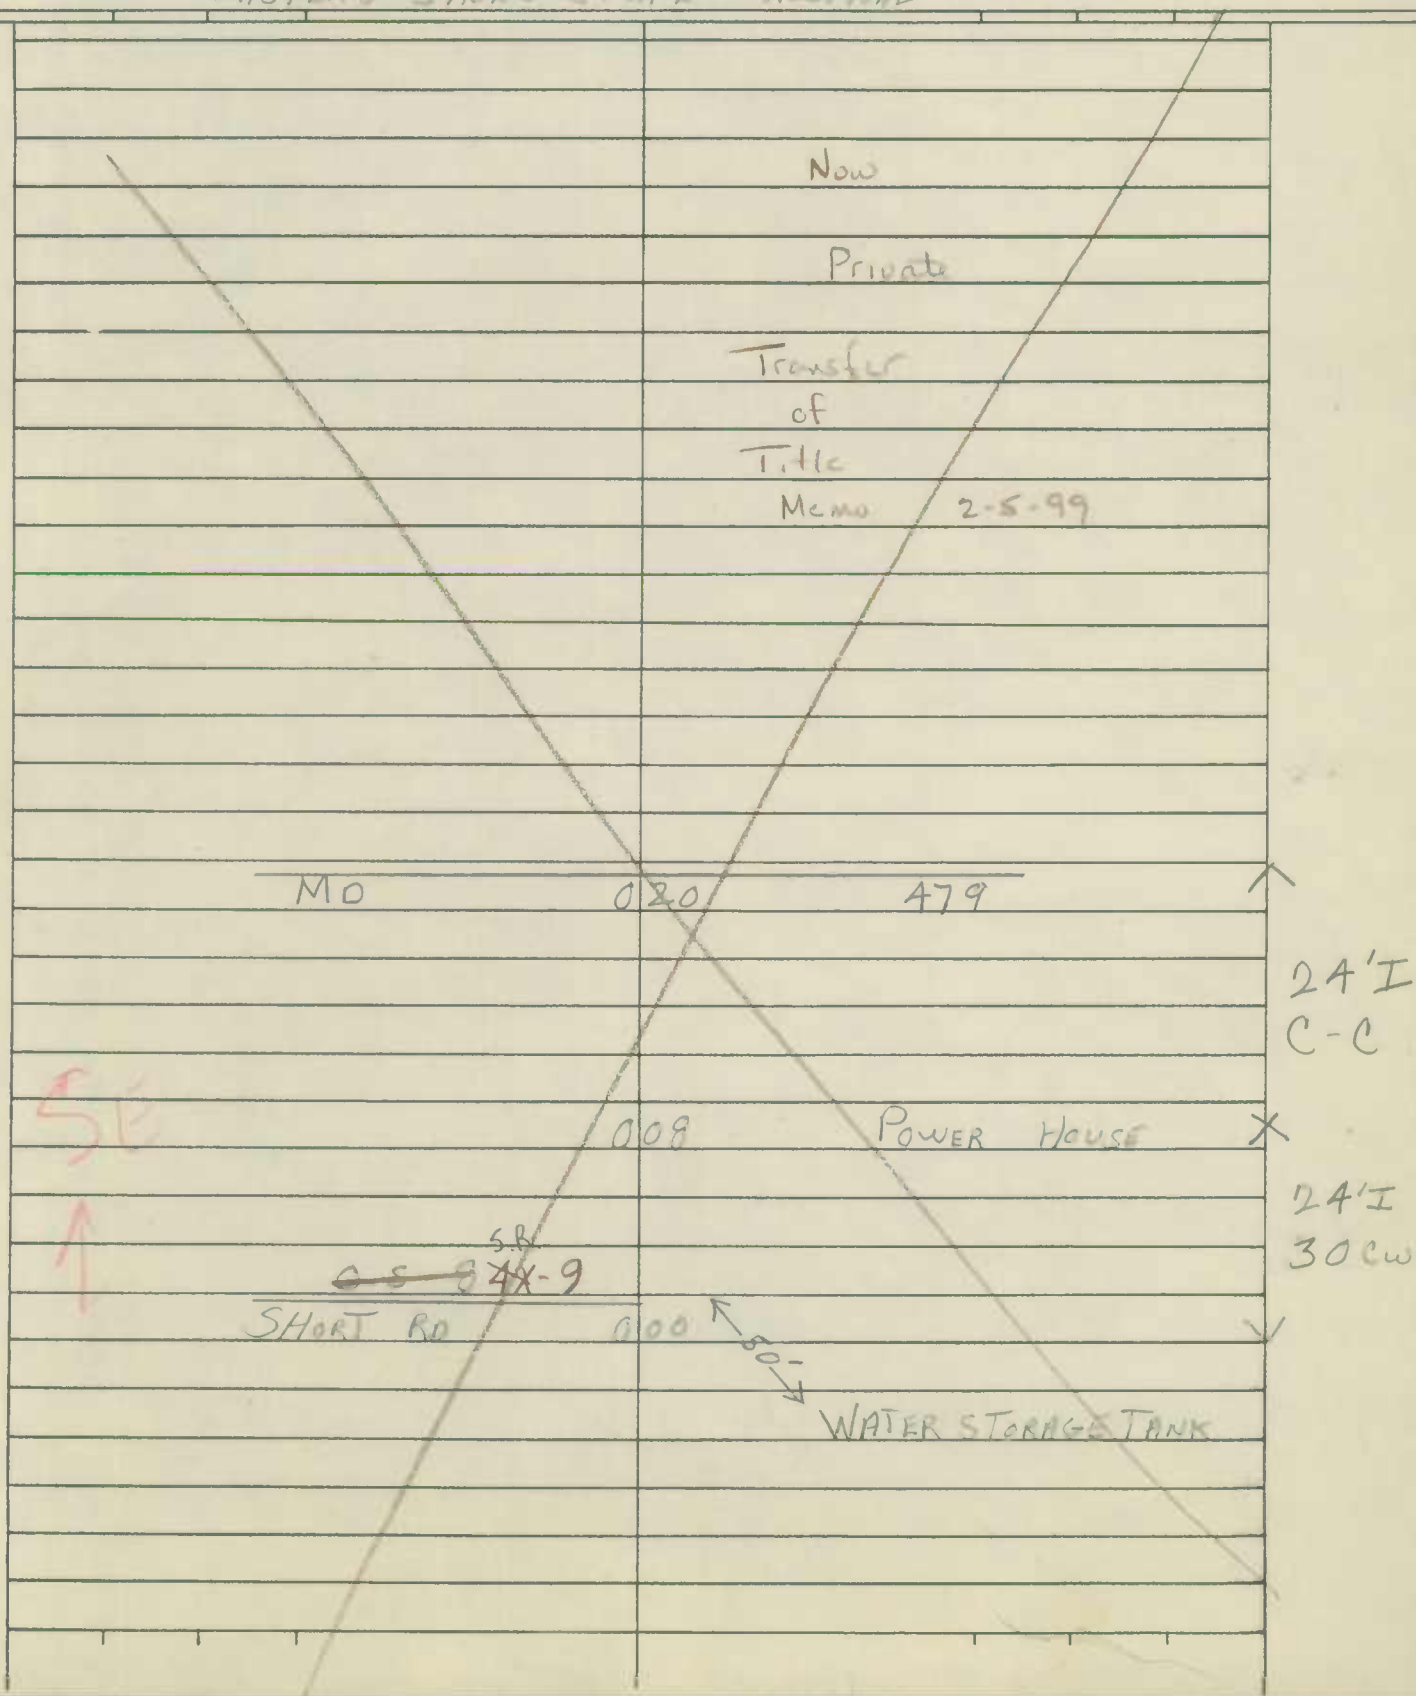

Form 6 HPS (Rev. 1961)

Cambridge

0008

ROAD INVENTORY SHEET

~~4X-8~~ SR-Z

Party Chief F. SETTAN
Recorder T. LANDON
Chainman

1072-267
G10

Road No. ~~U.S. 4~~ 7
Name E. SHORE DR
Sheet No. 1 OF 1
Date 6-25-65
County DORCHESTER

EASTERN SHORE STATE HOSPITAL

Now

Private

Transfer
of
Title
Memo 2-5-99

ROAD END

013

010 INFIRMARY

18'H
24'CW

PT
90°
PC

005

001

MO 000 479

0009

Form 6 HPS (Rev. 1961)

Cambridge

ROAD INVENTORY SHEET

~~4X-9~~ SR-9

Party Chief F. SETTLE

Recorder T. LANDON

Chainman

1071-268

G10

Road No. ~~O.S. #8~~

Name SHORT RD

Sheet No. 1 OF 1

Date 6-25-65

County DORCHESTER

EASTERN SHORE STATE HOSPITAL

Now

Private

Transfer of Title Memo 2-5-99

~~O.S.~~ Sh. ~~4X-7~~

POINT DR

006

003

001

000

MD 479

Sh. ~~O.S. 9~~ 4X-10

OAK DR

25'I C-C

14'B 24'CW

Form 6 HPS (Rev. 1961)

0010

Cambridge
ROAD INVENTORY SHEET

~~4X-10~~ SR-10

Party Chief F. SETTEN
Recorder T. LANDON
Chainman

1071-268

G10

Road No. ~~0 S 19~~
Name OAK DR
Sheet No. 1 OF 1
Date 6-25-65
County DORCHESTER
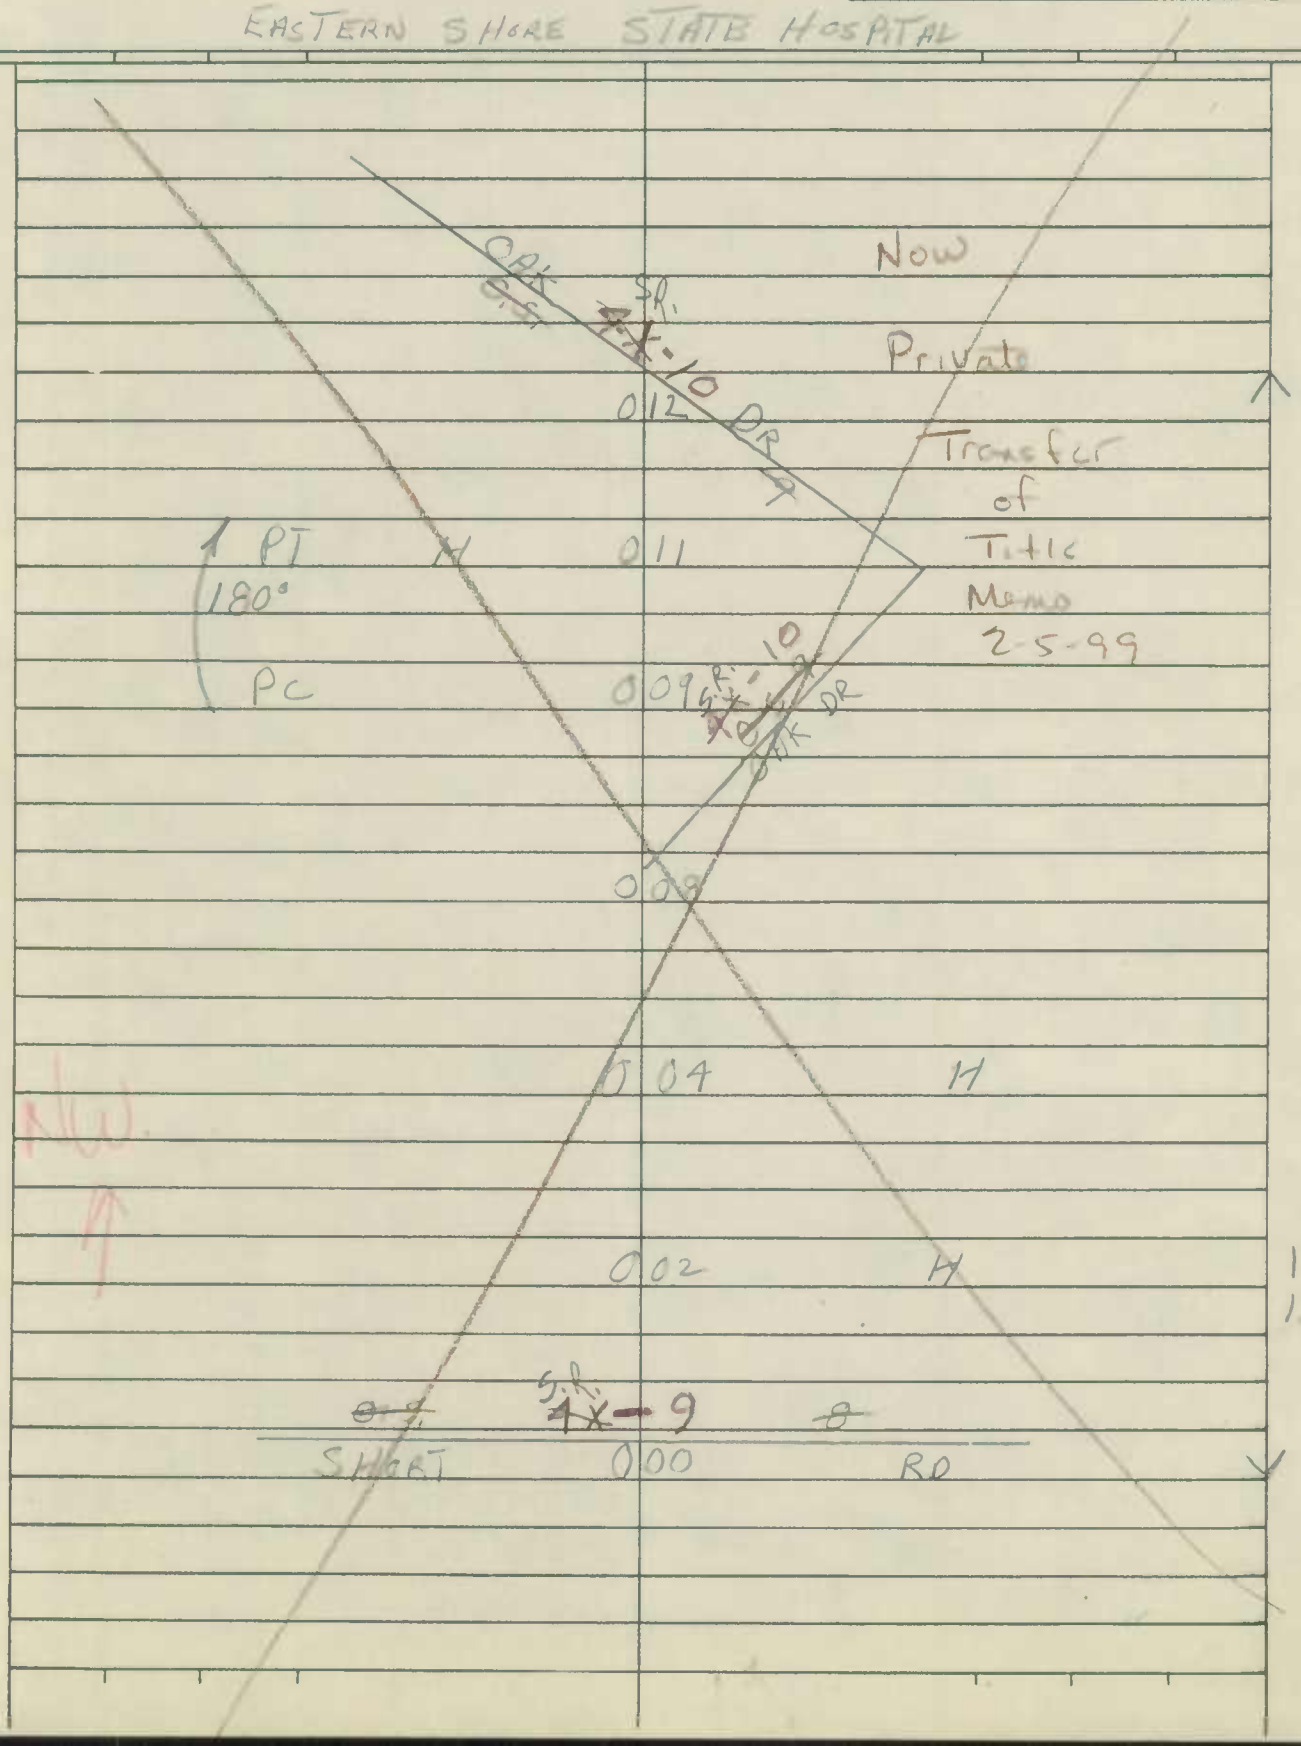
EASTERN SHORE STATE HOSPITAL