Form 6 HPS (Rev. 1961)

ROAD ~~INVENTORY~~ SHEET

T. LANDON
F. RHODES
VERIFIED
10/20/77

0010

PARTY CHIEF Frederick Settan
RECORDER Thomas Landon
CHAINMAN

ROAD NO.
NAME BAY VIEW RD
SHEET NO. 1 OF 1
DATE 6-15-67
COUNTY KENT

BETTERTON

Betterton

SASSAFRAS RIVER

~~ROAD OUT END~~ A

~~TTF~~
21'CW

~~(MUN)~~ BAYSIDE BLVD
007 MUN 0005 A

(MUN) 8010
003 (BAYSIDE ALLEY)

N

14'C
30'CW

FIRST AVENUE
MD 000 293 A

Form 6 HPS (Rev. 1961)

ROAD ~~INVENTORY~~ SHEET

T. LANDON
F. RHODES
VERIFIED
10/20/77

0010

PARTY CHIEF Frederick Settan
RECORDER Thomas Landon
CHAINMAN

ROAD NO.
NAME BAY VIEW RD
SHEET NO. 1 OF 1
DATE 6-15-67
COUNTY KENT

BETTERTON

SASSAFRAS RIVER

~~ROAD 01A END~~ A

~~TTF~~
~~24'CW~~

~~BAYSIDE BLVD~~
~~007 MUN 0005~~ A

(MUN) 8010
003 (BAYSIDE ALLEY)

N

14'C
30'CW

FIRST AVENUE
MD 000 293A

Form 6 HPS (Rev. 1961)

ROAD INVENTORY SHEET

T. LANDON
F. RHODES
VERIFIED
10/20/67

PARTY CHIEF Frederick Settan
RECORDER Thomas Landon
CHAINMAN

ROAD NO. 0080
NAME GLEN STREET #1
SHEET NO. 1 OF 1
DATE 6-15-67
COUNTY HUNT

BETTERTON

(MUN) 120
MUN: THIRD ~~017~~ 015 ~~THIRD~~ AVENUE

~~014~~ ~~90°~~

~~90°~~ ~~012~~ 8'17
12'CW

→ (MUN) 0110
007 SECOND AVENUE

S
↑
14'F
20'CW

FIRST AVENUE
MD 000 293A

SHA 51.3-8
11-15-72

STATE HIGHWAY ADMINISTRATION OF MARYLAND

1.51-1.63 WAS MD 293 B

PART TRANS to MU 7-1-89

ROAD INVENTORY SHEET

MU 0085

Party Chief I. LANDON
Recorder E. RHODES
Helper

Map No. TRANSFER LETTER 12-1-87 87-66

Road No. CO. 51
Road Name HOWELL POINT RD.
Sheet No. 1 OF 1
Date 10/28/77
County KENT
State Coordinates 1057-560

85.2 AH

		SIXTH ST CO 148		
MAIN MD	1	65 ST 292		22' I
BETTERTON V.F.D.	1	57	MU 0.85	5 CURB 26' CW 2 ML
ERICSSON ERICKSON AVE. MU 0030 MD. ~~293~~ 6319	1	51		
	1	47 Corp. Limits F		
	1	44		
H	1	34		17' F
		Betterton		30' CW
H	1	32	20°	X 2 ML
F (ABAN.)	0	95		
	0	78	25°	
	0	71 Corp. Limits Betterton		
CORP. LIMITS	0	70 CO. OF BETTERTON	CLARK RD. ST	
H	0	67		
APT	0	66		
PC	0	59		
F	0	42 F		
				18' F
				30' CW
H VAR 900'	0	00 CAL END	B-FERTILIZER-3500'	
ROAD		30'		

E

SHA 51.3-8
11-15-72

ROAD INVENTORY SHEET

Road No. _____
Road Name _____
Sheet No. _____
Date _____
County _____
State Coordinates _____

Form 6 HPS (Rev. 1961)

ROAD INVENTORY SHEET

T. LANDON
F. RHODE
VERIFIED
10/29/77

IDLEWHILE AVE

PARTY CHIEF Frederick Settan
RECORDER Thomas Landon
CHAINMAN

ROAD NO. 0090
NAME ~~IDLEWILDE AVE.~~
SHEET NO. 1 OF 1
DATE 6-15-67
COUNTY KENT

BETTERTON

99-2

SASSAFRAS RIVER

CORP LIMIT PVT RD RD END OF BETTERTON

8'D

30
28
27
24
22
19
00

PT 90° PC

PT 160° PC

W

MD - MOD. Corp. Limits

MAINT. Betterton

ERICSON AVENUE

MD 291

GO. 20'

11'F
16'CW
13'G
18'CW

Form 6 HPS (Rev. 1961)

T. LANDON
F. RHC
VERIFIED
10/20/72

ROAD INVENTORY SHEET

Party Chief T. LANDON
Recorder W. WARFIE
Helper

Road No. 0120
Road Name ~~3 RD~~ AVE. THIRD AVE.
Sheet No. 1 OF 1
Date 2-14-72
County KENT

71-1

BETTERTON

71-3

Form 6 HPS (Rev. 1961)

ROAD INVENTORY SHEET

Road No. _____

Road Name _____

Sheet No. _____

Date _____

County _____

Form 6 HPS (Rev. 1961)

ROAD INVENTORY SHEET

T. LANDON
F. RHODES
VERIFIED
10/21/77

PARTY CHIEF Frederick Settan
RECORDER Thomas Landon
CHAINMAN

ROAD NO. 0030
NAME CALVERT STREET
SHEET NO. 1 OF 1
DATE 6-22-67
COUNTY KENT

65-ICH
11-25-87
91-6 A/T

C HESTERTOWN

SD '14

REINSTATE

Chester town

SPRING
MUN ~~MD~~ 0.45 039 ~~2C~~

(MUN)
MILL ~~0.37~~ 031 STRUC

(MUN) C

(MUN) ~~0.60~~ (MUN)
KENT 0.24 020 CIRCLE
GARNETT ~~CHESTERTOWN~~ ELE SCHOOL 0.18 017

(MUN) (MUN) 0.10
COLLEGE ~~0.13~~ 008 AVE

ONE WAY (MUN) 0170 (MUN)
LYNCHBURG 0.05 STREET

~~OP~~ RAILROAD 0.20 ~~(MUN) 280 AVE #2~~

40'@I
C-C
33'@I
C-LT
24'@
30'@N

Form 6 HPS (Rev. 1961)

ROAD INVENTORY SHEET

T. LANDON
F. RHODES
VERIFIED
10/21/77

PARTY CHIEF Frederick Settan
RECORDER Thomas Landon
CHAINMAN

ROAD NO. 0030
NAME CALVERT STREET
SHEET NO. 1 OF 1
DATE 6-22-67
COUNTY KENT

65-1CH
CO-25-87
91-6 A/T

C HESTERTOWN

SD '14

REINSTATED 77-1C

SPRING MUN ~~MD~~ 0.45 039 ST ~~AVE~~ ~~20~~ 0340

(MUN) MILL ~~0.37~~ 0300 (MUN) 0180 STREET

(MUN) KENT 0.24 020 (MUN) CIRCLE

~~GARNETT~~ ~~CHESTERTOWN~~ HS SCHOOL ~~0.19~~ 017

(MUN) COLLEGE ~~0.13~~ 008 (MUN) 0060 AVE

ONE WAY (MUN) LYNCHBURG ~~0.05~~ 000 0170 (MUN) STREET

~~OP SECTION~~ (RAILROAD 0.10) ~~(MUN) 280 AVE 2~~

40'G C-C
40'CI C-C
33'CI C-LT
24'G
30'CN

Form 6 HPS (Rev. 1961)

92-Coex-39
3-9-93
BB/JS

ROAD INVENTORY SHEET

OP 182

PARTY CHIEF Frederick Settan
RECORDER Thomas Landon
CHAINMAN

ROAD NO. 0040
NAME (1 AMPUS AVE.
SHEET NO. 1 OF 1
DATE 7-7-67
COUNTY KENT

10/21/77

(HESTERTOWN

91-1 A/T

90-1 78-10 80-D

	0066 ~~END~~		40'I
	(ROAD CHG)		CONTINUED 30'I
	0065 ~~MUN~~ T 0267		2 LANE
(MUN) 310			
ROLLING RD	0064 (MORRIS DR)		
	0062 ~~MUN~~ MU 0004		
(A)	0051 BARROLL DR		
(HESTERTOWN MIDDLE ~~HIGH~~ SCHOOL	0046		
	(MUN) 0110		
	0045 DAVID DR		
(MUN) 0330			
(SCHOOL STREET)	0043		
	(MUN) 0370		
	0038 WALDO DR		
(MUN) 0290			
(RIVERSIDE RD)	0037		
	(MUN) 0020		
	0032 BYFORD DR.		40'I
	(MUN) 0220		C-C
	0027 PHILOSOPHERS TERR 20'		
	0022 (A)		34'I
WASHINGTON	AVE		C-C
~~HS~~ MD	0017 213 @.74		
	(MUN) 0190		
	0008 MT. VERNON AVE.		35'I
			C-C
AB MD. ~~ANNAPOLIS~~	(MUN) 80		
~~CATONSVILLE~~ AVE	0000 College Ave.		

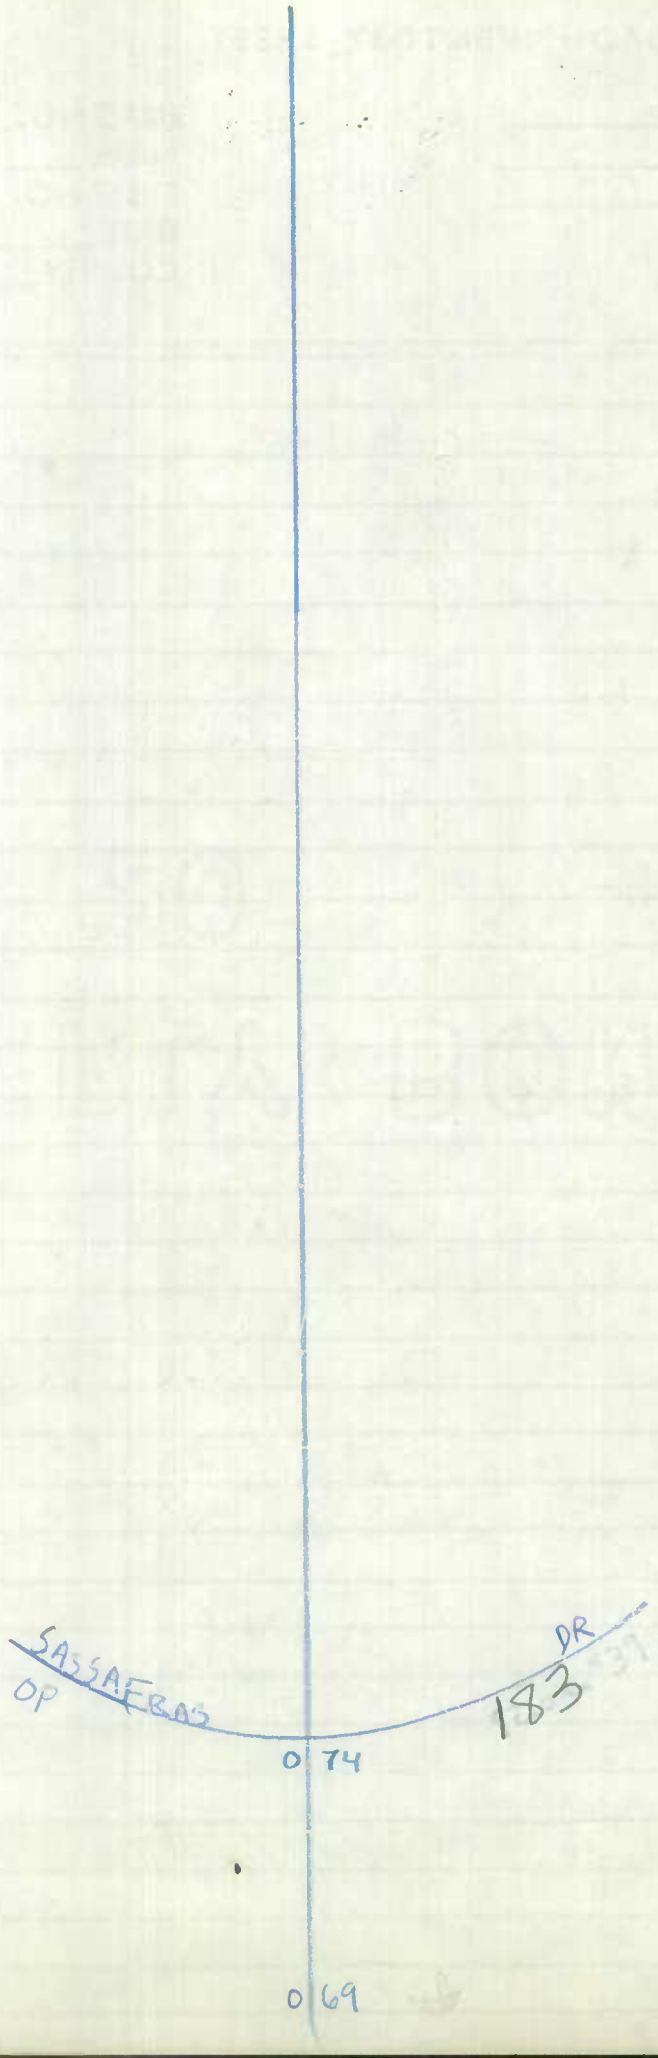
SASSAFRAS
OP
DR
183
0 74
0 69
55
30'I
2mL
X

SHA 51.3 - 8 Revised
4.83

MARYLAND STATE HIGHWAY ADMINISTRATION

Verified 10/21/77

ROAD INVENTORY SHEET ~~OP 182~~

Party Chief E. Sellan
Recorder T. Landon
Assistant Rewritten 10/25/93 KJP
Map No./Dir. 1 E
State Coordinates

Road No. Mu 0040
Road Name Campus Ave
County Kent
Date 7/7/67
Sheet No. 1 OF

92 Coex #39
91-1 A/T
90-1
80-19
78-10

SYSTEM: FED. AID. | FUNCT CLASS. | HWY. SYS. | HPMS SAMPLE
TRAFFIC: PRKG. REST. | COMM/IND. ACCESS

LINE DIAGRAM

CHESTERTOWN

SEE MAP I-V

FO RI-95

6-1E

BB/TM

(Riverside Rd)

Mu 0290 0 37

Waldo Dr.
0 38 Mu 0370

Byford Dr
0 32 Mu 0020

Philosophers Terr
0 27 Mu 0220 20'

0 22 A

Washington Ave.
MD 0 17 213 e.74

MT. Vernon Ave.
0 08 Mu 0190

College Ave
0 00 Mu 0080

Rural Minor Collector

TRAFFIC: CONTROL | COMM/IND. ACCESS | PRKG. REST.

PAVEMENT DATA

40' I
J C-C

34' I
C-C

35' I
C-C

TRAFFIC CODES

TRAFFIC CONTROLS: STOP SIGN=SS, TRAFFIC LIGHT=T.L., FLASHING RED BALL=F.R.

TRAFFIC CODES

PARKING RESTRICTIONS: A.M. PEAK, P.M. PEAK, A.M./P.M. PEAK, NO PARKING ANYTIME=N.P., COMM/IND. ACCESS=E

LINE DIAGRAM

SYSTEM				TRAFFIC		TRAFFIC			PAVEMENT DATA
FED. AID.	FUNCT. CLASS.	HWY. SYS.	HPMS SAMPLE	PRK.G. REST.	COM/IND ACCESS	CONTROL	COM/IND ACCESS	PRK.G. REST.	
	Rural Local								
									DR
									Sassafras
	↑								Mu 0 74 0317 — 30'I
									JC-C
									2 ML
									0 69
									40' on Taper To
									0 66 — 30'I
									JC-C
									2 ML
									Reed CT
									0 65 Mu 0267
									Rolling Rd
	*								Mu 0310 0 64
									(Morris DR)
									0 62 Mu 0185
									Barrell DR
									0 51 Mu 0004
	Rural Minor Collector			E					Chesterfield Middle School 0 46
									David DR
									0 45 Mu 0110
									(School ST)
									Mu 0330 0 43
									40'I
									JC-C

Form 6 HPS (Rev. 1961)

ROAD INVENTORY SHEET

T. LANDON
F. RHOADES
VERIFIED
10/21/77
CHESTERTOWN

PARTY CHIEF Frederick Settan
RECORDER Thomas Landon
CHAINMAN

ROAD NO. 0060
NAME CEDAR STREET
SHEET NO. 1 of 1
DATE 7-7-67
COUNTY KENT

XXXX
ROAD 040 END
(MUN) 0310
SCHOOL RD 037
(MUN)
031 VALLEY RD 90°
PT
45°
(MUN)
(VALLEY RD) 028
PC 025
CREENWOOD AVE
DELL MUN. AVE 020 0140
MUN HOLLY 0005 AVE 014
MUN. 0155 007
SE
NEC
MORGAN
MUN. 000 ROAD 0183
37'C
C-C

Form 6 HPS (Rev. 1961)

(GIBSON AVE)

ROAD INVENTORY SHEET

PARTY CHIEF Frederick Settan
RECORDER Thomas Landon
CHAINMAN

T. LANDON
F. RHODES
VERIFIED
10/21/77

ROAD NO. 0080
NAME College Ave.
SHEET NO. 1 OF 1
DATE 6-23-67
COUNTY KENT

CHESTERTOWN

SEE NEW

82-3

JE

NS

(MUN) 50
CANNON 068 STREET
(MUN)
064 POPLAR STREET
30'H
C-C
HIGH
(MUN) STREET
061 MD 20
(MUN) 0020
CALVERT ST. 054 (MUN) STREET
I
26'H
C-C
CHURCH 050
ONE WAY
(MUN)
047 PROSPECT STREET
(MUN) 0040
CAMPUS AVE. 038
WATER STORAGE TANK 014
I
30'H
C-C
CO. HEALTH CENTER
Corp. Limits Chestertown
MD
NW
SW
MINOR COLLECTOR RURAL
FA

SHA 51.3-8
11-15-72

STATE HIGHWAY ADMINISTRATION OF MARYLAND

ROAD INVENTORY SHEET

Party Chief J. E.
Recorder N. S.
Helper

Road No. MU. 0080
Road Name COLLEGE AVE
Sheet No. 1 OF 1
Date 2 \ 1 \ 83
County KENT
State Coordinates

Map No.

82-3 CHESTERTOWN

SEE NEW INV
FC/RI - 95
6-1- 95
BG/TM

SW

		CANNON ST. (MUN) 0050	0	30	ST. (MUN) 0050
				POPLAR ST. 0240	30'H
			0	26 ← (MUN)	J-CC
		HIGH ST. (MUN)	0	23 TL ~~MD 20~~ 0150	X
		CALVERT ST. MU. 0030	0	16 ST.	26'I J-CC
		CHURCH	0	12	X
				PROSPECT ST.	30'I
			0	09 ONE WAY → (MUN.) 0250	J-CC
		CAMPUS AVE. MU 0040	0	00	

MINOR COLLECTOR RURAL NON FA

ABAND GIBSON CIR

SHA 51.3-8
11-15-72

ROAD INVENTORY SHEET

Road No. _____
Road Name _____
Sheet No. _____
Date _____
County _____
State Coordinates _____

Form 6 HPS (Rev. 1961)

ROAD INVENTORY SHEET

T. LANDON
F. RHODES
VERIFIED
10/21/77

PARTY CHIEF Frederick Settan
RECORDER Thomas Landon
CHAINMAN

ROAD NO. 0090
NAME COURT STREET
SHEET NO. 10 F 1
DATE 6-22-67
COUNTY KENT

CHESTERTOWN

76-1

Abandoned 9-10-01
Kent Co GPS
GDEF

SNI
GDEF
GPS-01
9/10/01

PARKING LOT ROAD 018 END

12'GJ
16'CW

MD 900 (MUN) TO ONE WAY
005 (CHURCH STREET) ×

WAY

ONE WAY (MUN) 0210
~~Park Row Pl~~ 001 4.0'C
MEMORIAL PLAZA C-C

ONE

NE

(MUN) 150
HIGH 000 (MUN) STREET

Form 6 HPS (Rev. 1961)

ROAD INVENTORY SHEET

PARTY CHIEF Frederick Settan
RECORDER Thomas Landon
CHAINMAN

T. RHODES
VERIFIED
10/20/17

ROAD NO. 0100
NAME CROSS STREET
SHEET NO. 1 OF 1
DATE 6-23-67
COUNTY KENT

CHESTERTOWN

PHILOSOPHERS (MUN) 220
TER. 033

34' I
C-C

MAPLE AVENUE
MD 027 213

CHESTERTOWN V.F.D. 022
(MUN) 0200
35' I
C-C

PARK ROW 016

ONE WAY (MUN) 0210
014 (PARK ROW #2)

(MUN) (MUN) 0150
HIGH 012 STREET
41' I
"J" C-C

(MUN) (MUN) 0050
CANNON 005 STREET
35' I
"J" C-C

(MUN) (MUN) 39
000 (RAILROAD AVE)

FEATURE NOT SHOWN ON PLAT
FEATURE NOT SHOWN ON PLAT
1290
NE

Form 6 HPS (Rev. 1961)

GIBSON AVE. MUN.0125

ROAD INVENTORY SHEET

PARTY CHIEF Frederick Settan — T. LANDON
RECORDER Thomas Landon — F. RAWLES
CHAINMAN

VERIFIED 10/21/77

ROAD NO. ~~0080~~
NAME ~~College Ave.~~
SHEET NO. 1 OF 1
DATE 6-23-67
COUNTY KENT

CHESTERTOWN

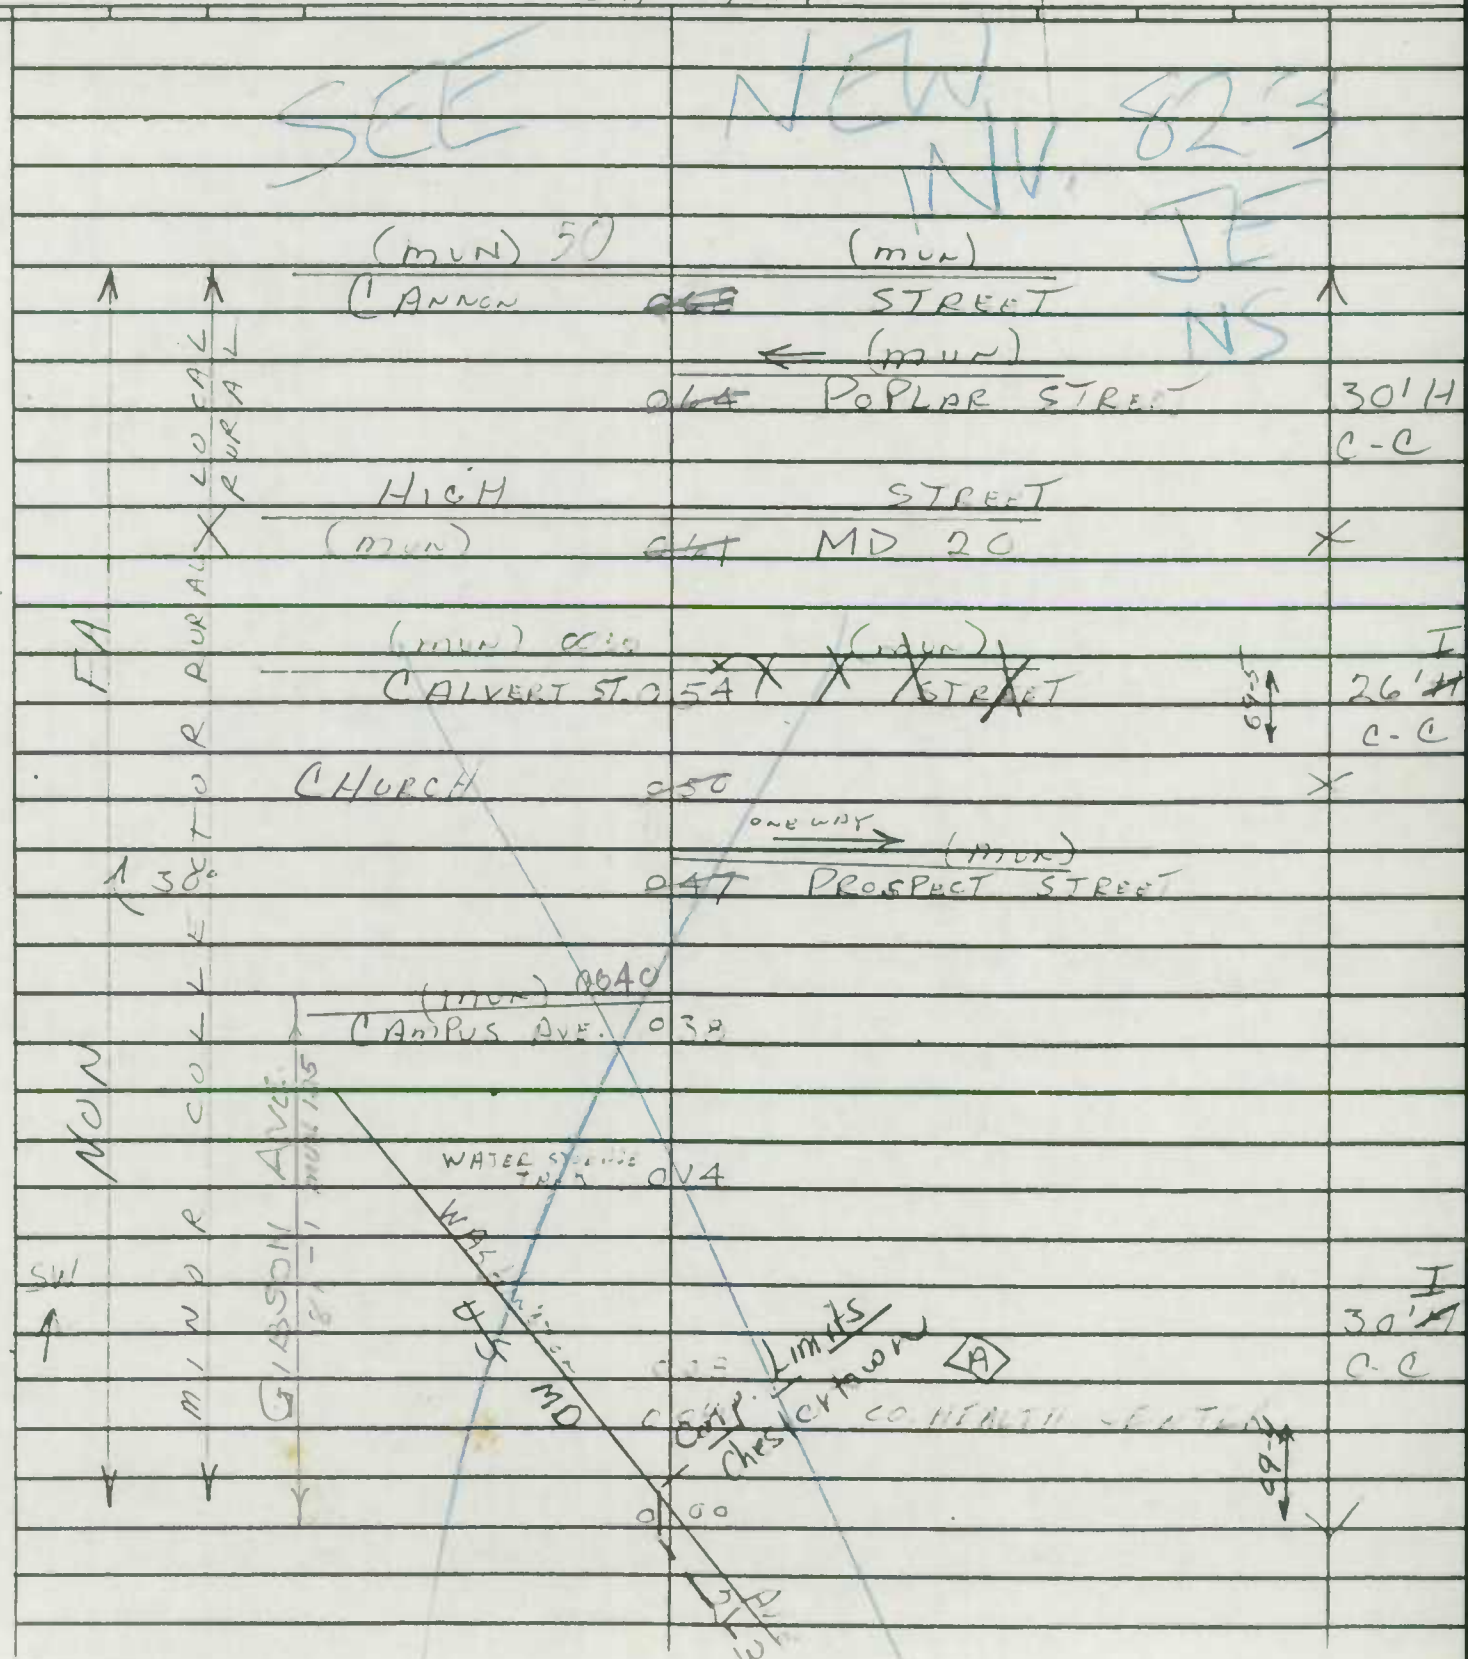

SHA 51.3 - 8 Revised
4.83

MARYLAND STATE HIGHWAY ADMINISTRATION

Chestertown

ROAD INVENTORY SHEET

Party Chief DE. JW. KJP
Recorder
Assistant
Map No./Dir. 1 NW
State Coordinates

Road No. Mu. 0150
Road Name High Street
County Kent
Date 6-23-67 Revision 3-4-87
Sheet No. 1 OF 3

TRAFFIC CODES
TRAFFIC CONTROLS: STOP SIGN=S.S., TRAFFIC LIGHT=T.L., FLASHING RED BALL=F.R.

TRAFFIC CODES
PARKING RESTRICTIONS: A.M. PEAK, P.M. PEAK, A.M./P.M. PEAK, NO PARKING ANYTIME=N.P., COMM/IND. ACCESS=E

SYSTEM				TRAFFIC		LINE DIAGRAM	TRAFFIC			PAVEMENT DATA
FED. AID.	FUNCT CLASS.	HWY. SYS.	HPMS SAMPLE	PRKG. REST.	COM/IND. ACCESS		CONTROL	COM/IND. ACCESS	PRKG. REST.	
	FAS 1291 Rural Major Collector	Was Tabbed Not on Nat Mun.	X			0 4 8 I R Intersection Blocks				36' I
						Mill Street ~~St.~~				J C-C
						Mun. 0387 0180				2 ML
									X	
										50' I
										J C-C
						Spring ← one way Avenue ~~St~~				entire TO
						Mun. 0324 0340	TL		X	
						025				
						Cross Street ~~St.~~				
X	X					MD 024 289	TL			
						VOID New 95 See Inv Fcls Inv Fcls Rdwy 6-1-95				
						Court Street ~~St.~~				
						018 Mun one way → 0090				50' I
										J C-C
						Queen ← one way Street ~~St.~~				2 ML
						Mun. 013 0260			X	
										45' I
						Water ← one way Street				J C-C, 2 ML
						Mun. 005 0380	SS		X	
										34' I
										50' (W)
										24 ML
						000				
						Chester River				
	NON FA Rural Local									

Mun 0150

LINE DIAGRAM

SYSTEM: FED. AID. | FUNCT. CLASS. | HWY. SYS. | HPMS SAMPLE
TRAFFIC: PRKG. REST. | COM/IND ACCESS

TRAFFIC: CONTROL | COM/IND ACCESS | PRKG. REST.

PAVEMENT DATA

FAS 1291
RURAL MAJOR COLLECTOR
MS 20 NB Mun. - Township Line Rd.

~~RR~~ ~~0.54~~

0.86 ~~Bridge~~ (~~Township~~) E

~~KTL~~ ~~Hwy~~ ~~0.95~~

DIXON DRive
MUN. 0115 0.8X0

~~Hwy~~ ~~Spur~~

VOID
FCKT 95
6195
BB/TM 0.754 Parking Lot E X

45' I
JC-C
2 ML

LYNCHBURG ST.
MUN. ~~0.70~~ 0.69 0170

39' I
JC-C
2 ML

College Ave.
MUN. 0.61 0080 TL X

~~39'~~ I
JC-C
2 ML

X KENT ~~One Way~~ ~~ST~~ ST ~~Kent~~ ~~Co.~~
MUN. ~~0.45~~ 0.48 ~~Akron~~ 0146 X

0.44 Kent Co. Library

~~Comm~~

To SR 59 MS 20 NB Mun.

Form 6 HPS (Rev. 1961)

ROAD INVENTORY SHEET

T. LANDON
F. RHODES
VERIFIED
10/21/77
CHESTERTOWN

PARTY CHIEF Frederick Settan
RECORDER Thomas Landon
CHAINMAN

ROAD NO. 0150
NAME HIGH STREET
SHEET NO. 1 OF 1
DATE 6-23-67
COUNTY KENT

70-1 80-4/5/6/7/8/9

				(MUN)			
		(MUN)		COLLEGE	061	AVENUE	14.31
					054	CHURCH	35'
		(MUN)			051	CHURCH (MUN)	C-C
		S. KENT ST.			049	KENT CIRCLE	
					044	LIBRARY	34.5'
		CHURCH			040	COUNTY OFFICE BLDG.	C-C
		MILL				STREET	
		MUN. ~~MD 698~~			038	~~(MUN)~~ 0180	14.54 50'
							C-C ON TAPE
					037	CHURCH	T. 35.5'
		SPRING	ONEWAY			AVENUE	C-C
		(MUN) 340			030	MD 20	14.62
		(MUN) 0100				(MUN)	
		CROSS			024	STREET	
						0090 (MUN) ONEWAY	
					018	COURT STREET	50'
							C-C
		QUEEN				STREET ONEWAY	2 ML
		~~MUN MD 289~~			013	~~(MUN)~~ 0260	
							45'
							C-C
		(MUN)				ONEWAY (MUN) 0390	2 ML
		WATER			005	STREET	
							34'
							50' C.L.
		ROAD			000	END	

CHESTER RIVER

SHA 51.3 - 8 Revised
4.83

MARYLAND STATE HIGHWAY ADMINISTRATION

ROAD INVENTORY SHEET

Party Chief _____
Recorder _____
Assistant _____
Map No./Dir. 1
State Coordinates _____

Road No. MUN. 0150
Road Name HIGH ST.
County KENT
Date 8-1-74 Revision 3-4-87
Sheet No. 3 OF 3

TRAFFIC CODES
TRAFFIC CONTROLS: STOP SIGN=SS, TRAFFIC LIGHT=T.L., FLASHING RED BALL=F.R.

TRAFFIC CODES
PARKING RESTRICTIONS: A.M. PEAK, P.M. PEAK, A.M./P.M. PEAK, NO PARKING ANYTIME=N.P., COMM/IND. ACCESS=E

SYSTEM				TRAFFIC		LINE DIAGRAM	TRAFFIC			PAVEMENT DATA
FED. AID.	FUNCT CLASS.	HWY. SYS.	HPMS SAMPLE	PRKG. REST.	COM/IND. ACCESS		CONTROL	COM/IND. ACCESS	PRKG. REST.	

SYSTEM				TRAFFIC		LINE DIAGRAM	TRAFFIC				PAVEMENT DATA
FED. AID.	FUNCT. CLASS.	HWY. SYS.	HPMS SAMPLE	PRKG. REST.	COM/IND ACCESS		CONTROL	COM/IND ACCESS	PRKG. REST.		

SHA 51.3-8
11-15-72

STATE HIGHWAY ADMINISTRATION OF MARYLAND

ROAD INVENTORY SHEET

Party Chief I. LANDON
Recorder E. RHODES
Helper

Map No. CHESTERTOWN

Road No. MUN. 0166
Road Name KENT ST.
Sheet No. 1 OF 1
Date 10/21/77
County
State Coordinates

76-1

See New Inv.
FCRT 95 Ext 3
BBITM 6/1/95

RICHARD DR. MUN. 0285

40°

30°

BARROLL DR. MUN. 0004

DAVID DR. MUN. 0170

WALDO DR MUN. 0220

GIFFORD DR. MUN. 20

RICHARD DR. MUN. 0285

RESERVOIR

20°

PHILOSOPHERS TER. MUN. 0220

CHURCH AVE

WASHINGTON MD. 213

KENT CIR MUN.

E

0	51			
0	49			
0	44			
0	41			
0	35			
0	29			
0	22			
0	20	RICHARD DR. MUN. 0285		36' I C-C
0	18	RESERVOIR	20°	X 27' I C-LT.
0	10	PHILOSOPHERS TER. 0220		X
0	06	CHURCH AVE		31' I C-C
0	00	WASHINGTON MD. 213		

SHA 51.3-8
11-15-72

ROAD INVENTORY SHEET

Road No. _____
Road Name _____
Sheet No. _____
Date _____
County _____
State Coordinates _____

Form 6 HPS (Rev. 1961)

ROAD INVENTORY SHEET

T. LANDON
F. RHODES
VERIFIED
10/21/77

PARTY CHIEF Frederick Settan
RECORDER Thomas Landon
CHAINMAN

ROAD NO. 0180
NAME MILL STREET
SHEET NO. 1 OF 1
DATE 6-22-67
COUNTY KENT

CHESTERTOWN

MILL STREET
MD 698

(MD) 20 (MAIN)
HIGH 011 STREET

30' RT
C-C

(MUD)
CALVERT 004
(MAIN) 30
STREET

27' RT
C-RT

SW

ROAD 000 END
XX XX

SHA 51.3-8
11-15-72

STATE HIGHWAY ADMINISTRATION OF MARYLAND

ROAD INVENTORY SHEET

Party Chief T. LANDON
Recorder
Helper

Map No. 76-4
CHESTERTOWN

Road No. (MUN 0185)
Road Name (MORRIS DR)
Sheet No. 1 OF 1
Date 2-4-77
County KENT
State Coordinates

Removed from Inventory 10-19-01 AMD
This is a driveway per conversation w/ Joan Merriment & Lucille Roberts town from Chestertown on 10-19-01

ROAD 002 END

SE

20'I
26'CW

CAMPUS AVE
MUN 000 0040

SHA 51.3-8
11-15-72

ROAD INVENTORY SHEET

Road No. _____
Road Name _____
Sheet No. _____
Date _____
County _____
State Coordinates _____

Form 6 HPS (Rev. 1961)

ROAD INVENTORY SHEET

T. LANDON
F. RHODES
VERIFIED
10/21/77

Memorial Plaza

PARTY CHIEF Frederick Settan
RECORDER Thomas Landon
CHAINMAN

ROAD NO. 0210
NAME ~~Pratt Row~~
SHEET NO. 1 OF 1
DATE 6-22-67
COUNTY KENT

CHESTERTOWN

SEE NEW INV
G.D. EF
9/10/01

MD ~~(MUN)~~)
CROSS 005 (~~MUN~~) 289
TREET

004 CHURCH

003 COURT HOUSE

32' R.I
C-C

NW
(MUN) 90
COURT 000 ONE WAY (MUN)
STREET

Form 6 HPS (Rev. 1961)

ROAD INVENTORY SHEET

PARTY CHIEF Frederick Settan
RECORDER Thomas Landon
CHAINMAN

T. LANDON
T.L. HOLMES
REVISED 2-4-77
VERIFIED
10/20/77
CHESTERTOWN

ROAD NO. 0260
NAME QUEEN STREET
SHEET NO. 1 OF 1
DATE 6-23-67
COUNTY KENT

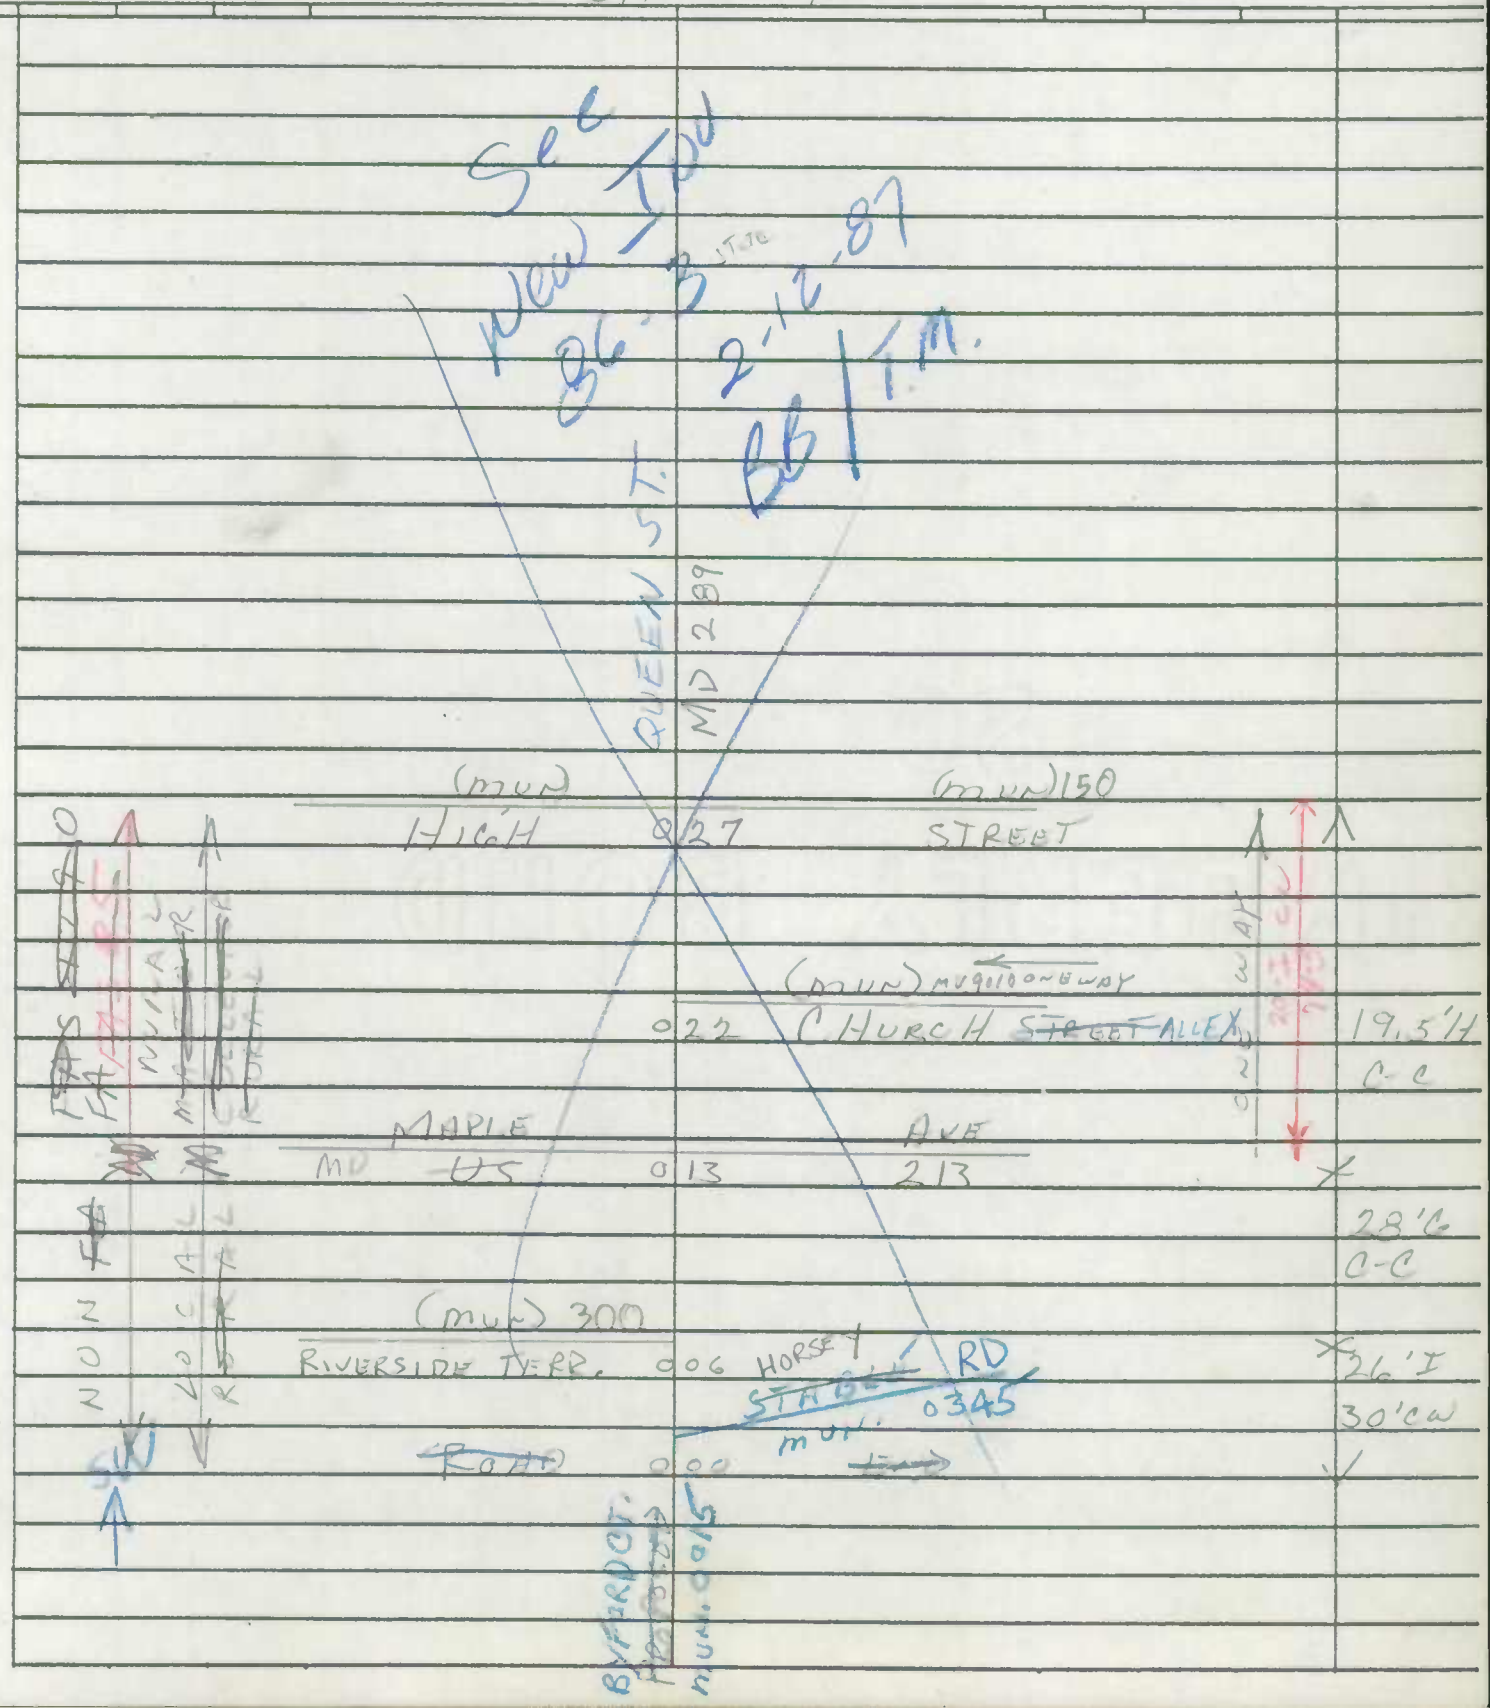

. 1961)

ROAD INVENTORY SHEET

PARTY CHIEF Frederick Settan
RECORDER Thomas Landon
CHAINMAN

T. LANDON
T. KNUSS
VERIFIED
10/21/77

ROAD NO. 0280
NAME (RAILROAD Ave #1)
SHEET NO. 1 OF 1
DATE 6-22-67
COUNTY KENT

CHESTERTOWN

NOW PIC

LOT

10 S 82

65 - K 11

(MUN) 250
013 PROSPECT STREET

14'C
20'cw

(MUN) 30
005 ALVERT STREET

16'C
22'cw

HIGH ST.
MD 000 30

SHA 51.3-8
11-15-72

STATE HIGHWAY ADMINISTRATION OF MARYLAND

ROAD INVENTORY SHEET

T. LANDON
F. RHODES
VERIFIED 12/77

Party Chief T. LANDON
Recorder
Helper

Map No. 76-5
0.20 CHESTERTOWN

Road No. MUN 0285
Road Name RICHARD DR.
Sheet No. 1 OF 1
Date 2-4-77
County KENT
State Coordinates

SE

KENT ST. Ahead
MUN 0166

BARROLL DR.
0 45 MUN. 0004
0 42 30°
0 37
0 35 90° PT
0 33 PC
0 06 RESERVE 40°
36' I "J" C-C
KENT ST.
MUN 0 00 0+60 0166

SHA 51.3-8
11-15-72

ROAD INVENTORY SHEET

Road No. _____
Road Name _____
Sheet No. _____
Date _____
County _____
State Coordinates _____

Form 6 HPS (Rev. 1961)

FC/KI-95 Ex.1
6-1-95
BB/TM

ROAD INVENTORY SHEET

T. LANDON
F. RHODES
VERIFIL
10/21/77

Roberts Dr

PARTY CHIEF Frederick Settan
RECORDER Thomas Landon
CHAINMAN

ROAD NO. 0290
NAME ~~RIVERSIDE RD~~
SHEET NO. 1 OF 1
DATE 7-7-67
COUNTY KENT

CHESTERTOWN

VOID
See New INV
6-1-95 FC/KI
BB/TM

KENT AND QUEEN ANNE'S BROWN MEMORIAL HOSPITAL

~~Road~~

ENT. TO HOSPITAL

MUN
BROWN STREET

(MUN)
CAMPUS AVE

NW

0000 0003 0004 0007 0009 0010 0013 0015 0017 0023 0028

SS
30°
PT
150°
PC
Ent to Pkg

20'I 2 um L
~~18'H~~
~~30'CW~~
~~20'I 2 cul it~~
2 um L
~~22'H~~
~~20 CW~~
8 28'I
~~26 CW~~
JCC 2 um L
34'I
C-C
2 um L

Form 6 HPS (Rev. 1961)

ROAD INVENTORY SHEET

PARTY CHIEF Frederick Settan
RECORDER Thomas Landon
CHAINMAN

T. LANDON
F. RHODES
VERIFIED
10/2[illegible]/67
CHESTERTOWN

ROAD NO. 0340
NAME (SPRING AVE)
SHEET NO. 1 OF 1
DATE 6-22-67
COUNTY KENT

(MUN) 50
CANNON 006 (MUN) STREET

004 PARKING LOT

MUN. 0150
HIGH 000 MD 20 ~~(MUN) 150~~ STREET

SPRING AVE.
MD 20

SW

CLEAR WAY

10'E
12'CW

SHA 51.3 - 8 Revised
4.83

MARYLAND STATE HIGHWAY ADMINISTRATION

Chestertown

ROAD INVENTORY SHEET

Party Chief Off. Inv. KJP
Recorder
Assistant
Map No./Dir. 1 SW
State Coordinates

Road No. MUN. 0340
Road Name SPRING ST.
County KENT
Date Rewritten 3-4-87
Sheet No. 1 OF 1

TRAFFIC CODES
TRAFFIC CONTROLS: STOP SIGN=SS, TRAFFIC LIGHT=T.L., FLASHING RED BALL=F.R.

TRAFFIC CODES
PARKING RESTRICTIONS: A.M. PEAK, P.M. PEAK, A.M./P.M. PEAK, NO PARKING ANYTIME=N.P., COMM/IND. ACCESS=E

SYSTEM				TRAFFIC		LINE DIAGRAM	TRAFFIC			PAVEMENT DATA
FED. AID.	FUNCT. CLASS.	HWY. SYS.	HPMS SAMPLE	PRKG. REST.	COM/IND. ACCESS		CONTROL	COM/IND. ACCESS	PRKG. REST.	
NON F/A	RURAL LOCAL					SEE NEW INV FC/RI-95 6-1-95 1313/TM				
						CANNON ST.				
						MUN. 0 20 0050				
						018 PARKING LOT		E		10' F
						one way				12' CW
						HIGH ST.				
						MUN. 014 0150				
						(PARK ROW)				
						MUN. 0200 010				34' I
						009 Post office				C-LT.
										2 ML
						CALVERT ST.				
						008 MUN. 0030				31' I
										3'E shd. LT. C-RT.
										2 ML
						005				
										24' I
										2-3'E shd.
						Maple Ave.				34' CW
						MD 000 Washington Ave. 213				2 ML
EAS 1292	RURAL MAJOR COLLECTOR									

Was Tabbed MD 20, Now MUN. - Transition Letter 8-28-85

SYSTEM				TRAFFIC		LINE DIAGRAM	TRAFFIC			PAVEMENT DATA
FED. AID.	FUNCT. CLASS.	HWY. SYS.	HPMS SAMPLE	PRK.G. REST.	COM/IND ACCESS		CONTROL	COM/IND ACCESS	PRK.G. REST.	

Form 6 HPS (Rev. 1961)

ROAD INVENTORY SHEET

PARTY CHIEF Frederick Settan
RECORDER Thomas Landon
CHAINMAN

T. LANDON
F. RHODES
VERIFIED
10/21/77

9010
ROAD NO. ~~0070~~ ALLEY
NAME CHURCH ~~STREET~~
SHEET NO. 1 OF 1
DATE 6-22-67
COUNTY KENT

CHESTERTOWN

SNI
GD.EF
GPS-01
9/10/01

ONE WAY
(MUN) 260
QUEEN 004 STREET
(MUN)

(MUN) 90
COURT 000
(MUN) ONE WAY
STREET

18' C
C-C

Form 6 HPS (Rev. 1961)

ROAD INVENTORY SHEET

CO 289

PARTY CHIEF Frederick Settan
RECORDER Thomas Landon
CHAINMAN

T. LANDON
F. RHODES
VERIFIED 10/19/77
MILLINGTON

ROAD NO. 0020
ROADNAME CRANE STREET
SHEET NO. 1 OF 1
DATE 6-8-67
COUNTY KENT

	ROAD	END	
H	033		
H	032	H	
H	031		
	030	H (ABOVE)	
H (WEST	026	ST.)	
~~OF 6~~	024 276	~~+2~~	
H	023		
H	022	H	
H	020	H	
H Corp. limits	018	Millington	
I	016		
CYPRESS		ST	
MD	007	291	
	000	(MUNI) ~~50~~ 0005 ~~RAILROAD~~ BACK ST.	

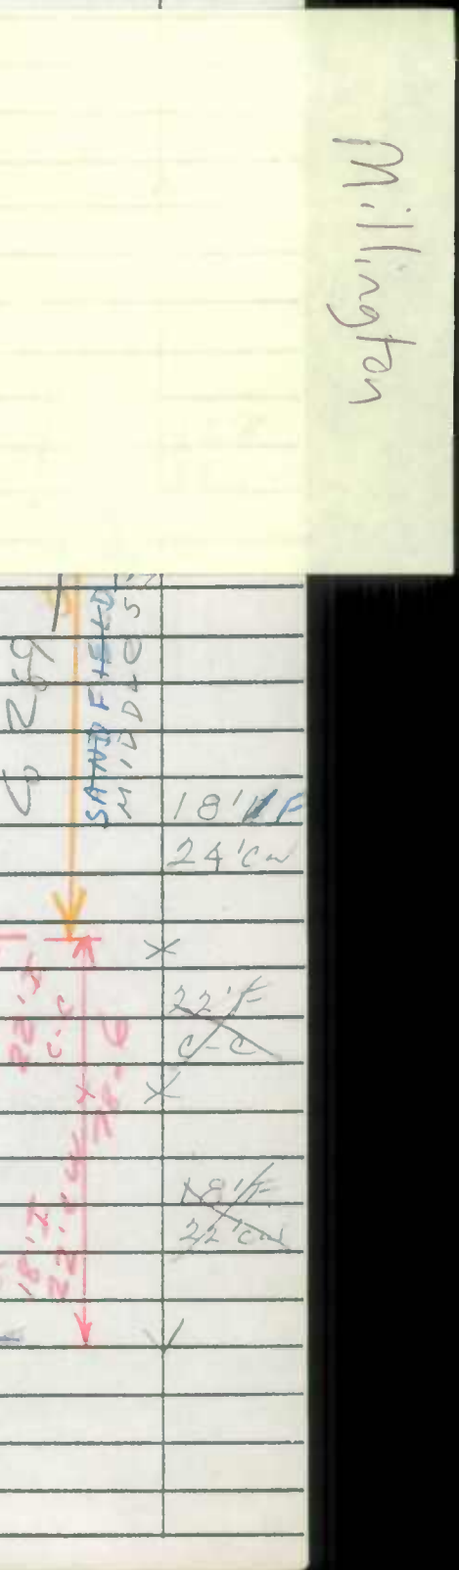

S

Form 6 HPS (Rev. 1961)

ROAD INVENTORY SHEET

CO 289

PARTY CHIEF Frederick Settan — T. LANDON
RECORDER Thomas Landon — F. RHODES
CHAINMAN — VERIFIED 10/19/77 MILLINGTON

ROAD NO. 0020
NAME CRANE STREET
SHEET NO. 1 OF 1
DATE 6-8-67
COUNTY KENT

	ROAD	END	
H	0 33		12'E 16'CW
H	0 32	H	
H	0 31		
	0 30	H (ABAN)	
H (WEST	0 26	ST.)	
~~OFF~~	0 24 276	~~12~~	
H	0 23		
H	0 22	H	18'E 24'CW
H	0 20	H	
H Corp. Limits	0 18	Millington	
	0 16		22'E C-C
CYPRESS		ST.	
MD	0 07	291	18'E 22'CW
	0 00	(MUL) ~~50~~ 0005 ~~RAILROAD~~ BACK ST.	

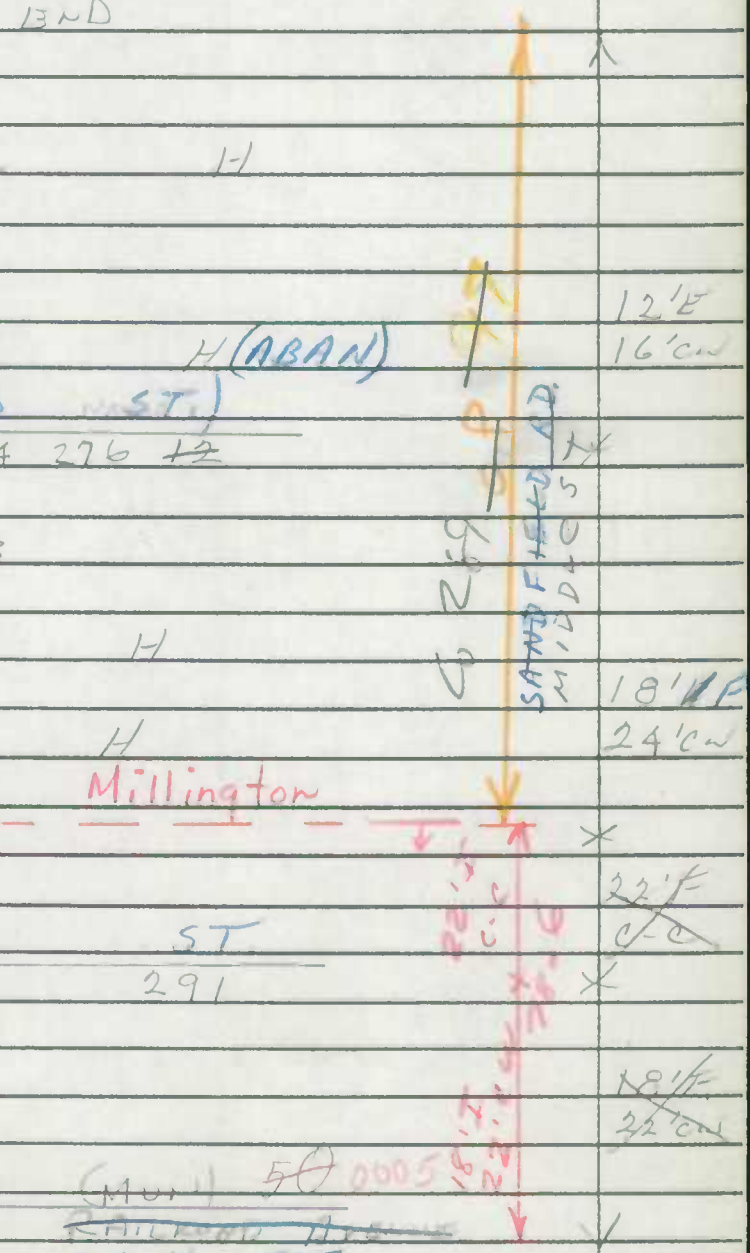

Form 6 HPS (Rev. 1961)

TL VER. FR. 10/20/77 ✓

ROAD INVENTORY SHEET

1014.5-475

PARTY CHIEF Frederick Settan
RECORDER Thomas Landon
CHAINMAN

ROAD NO. Co 123
NAME BAYSIDE AVENUE
SHEET NO. 1 OF 1
DATE 6-22-67
COUNTY KENT

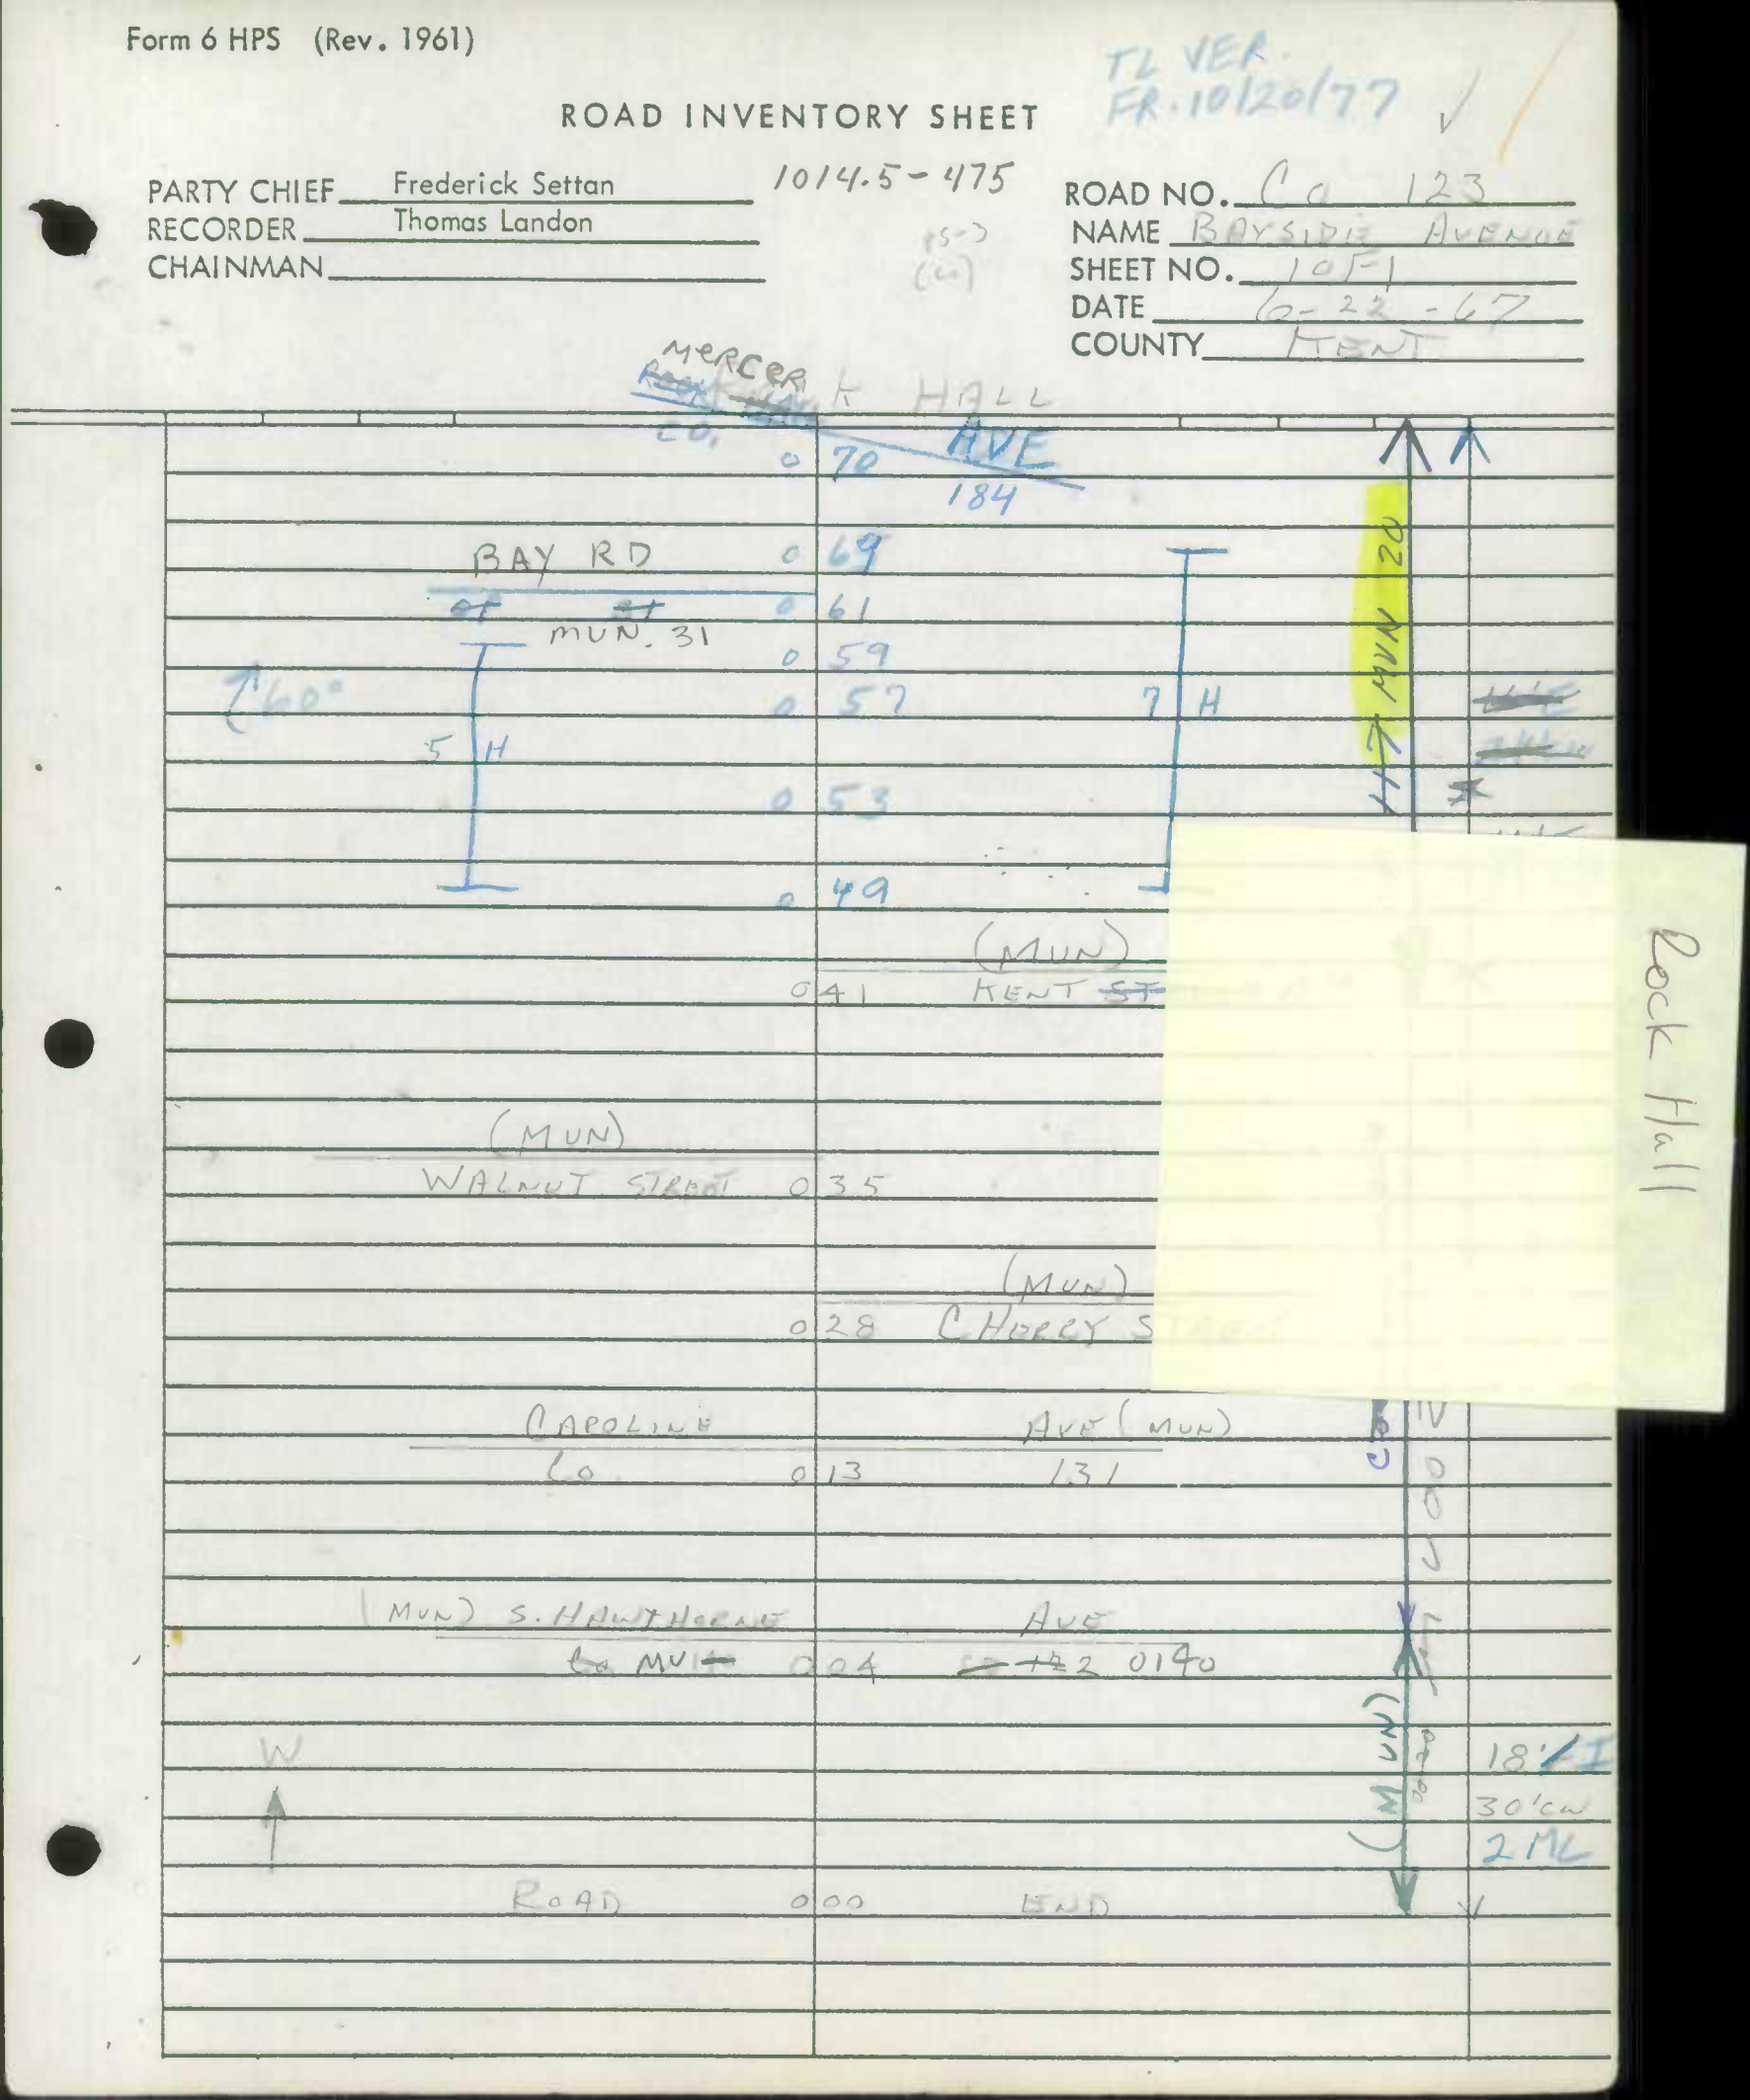

Form 6 HPS (Rev. 1961)

TL VER. FR. 10/20/77 ✓

ROAD INVENTORY SHEET

1014.5 - 475

PARTY CHIEF Frederick Settan
RECORDER Thomas Landon
CHAINMAN

ROAD NO. Co 123
NAME BAYSIDE AVENUE
SHEET NO. 1 OF 1
DATE 6-22-67
COUNTY KENT

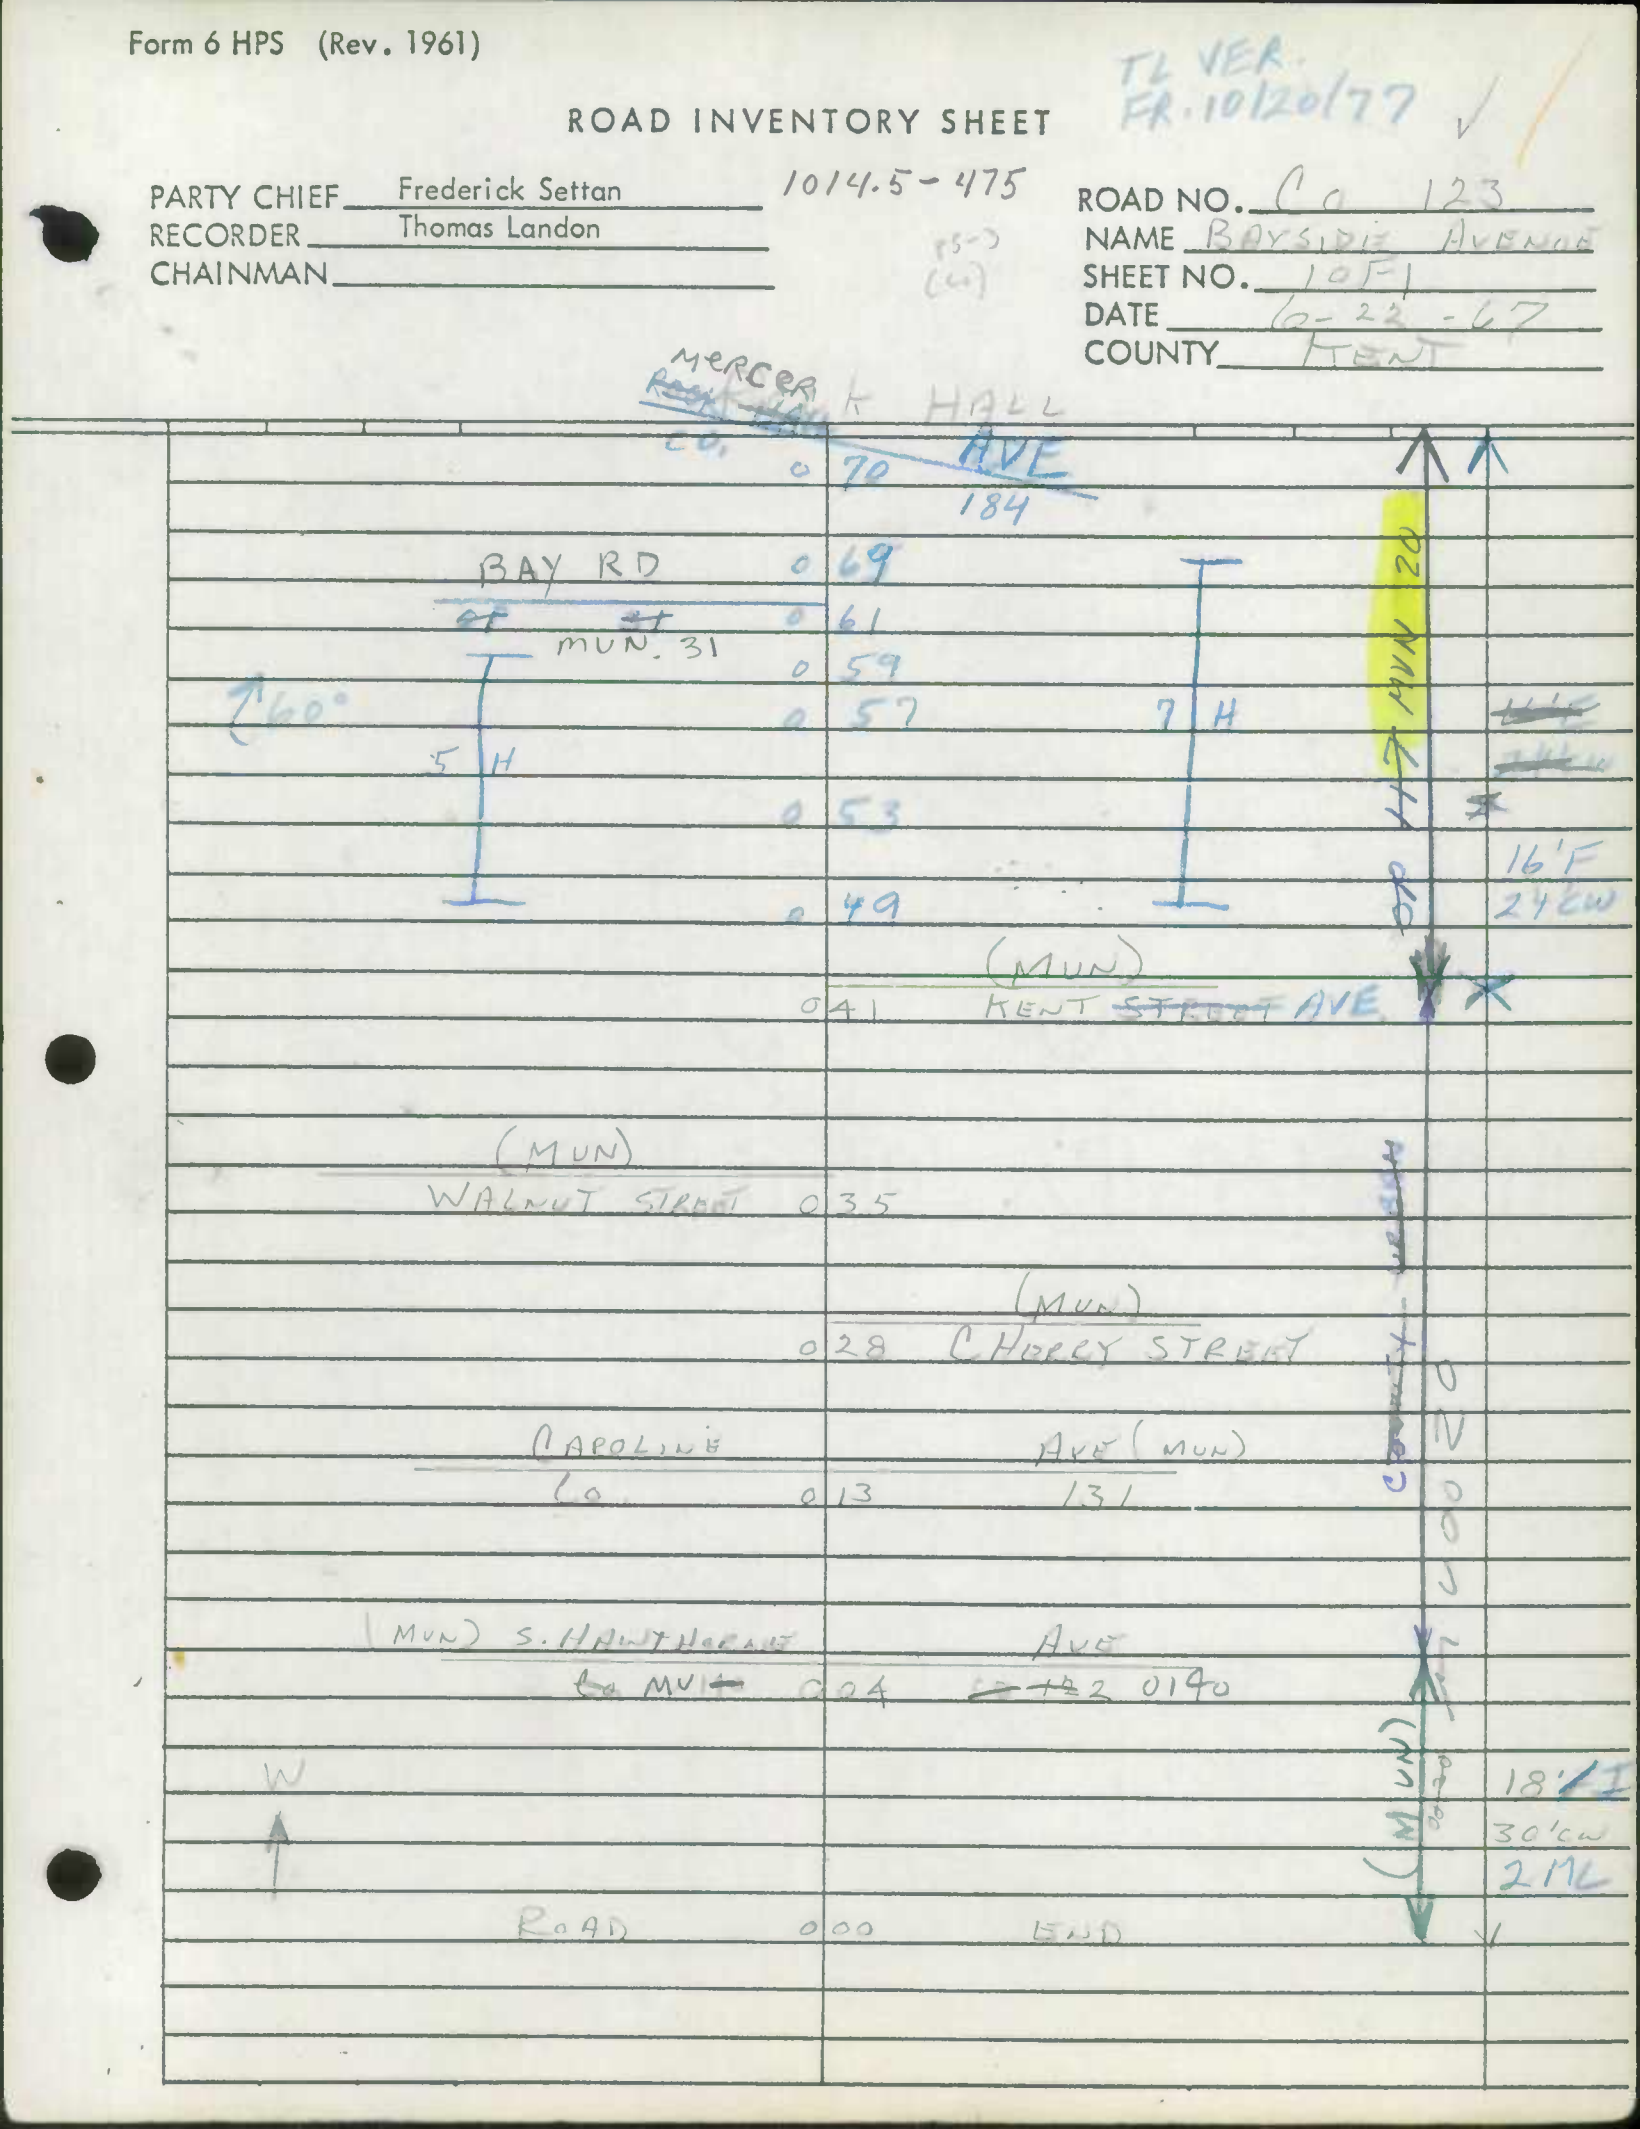

	0	70
	0	69
	0	61
	0	59
	0	57
	0	53
	0	49
	0	41
	0	35
	0	28
	0	13
	0	04
	0	00

Form 6 HPS (Rev. 1961)

MUN.0020

ROAD INVENTORY SHEET

PARTY CHIEF Frederick Settan
RECORDER Thomas Landon
CHAINMAN

1014.5 - 475
83-1
1/26/84
FR. → NS

ROAD NO. LC 123
NAME BAYSIDE AVENUE
SHEET NO. 1 OF 1
DATE 6-2-67
COUNTY KENT

MERCER CO. | 0 | 70 | BAYSIDE AVE | 184

0 69
0 61
0 59
0 57
0 53
0 49

~~OP~~ ~~3T~~ MUN 0015
60°
5 H
7 H

(MUN) 0170
0 41 KENT ~~STREET~~ AVE

(MUN)
WALNUT STREET 0 35

(MUN)
0 28 CHERRY STREET

CAROLINE CO
0 13 AVE (MUN) 131

MUN ~~CO~~ 0 04 ~~123~~ 0140

W
ROAD 0 00 END

COUNTY URBAN 0020 0123 (MUN) 0020

~~16'F~~
~~24CW~~
~~2~~
16'F
24CW
18'I
30'CW
2 ML

SHA 51.3 - 8 Revised
4.83

MARYLAND STATE HIGHWAY ADMINISTRATION

ROAD INVENTORY SHEET

Party Chief _____
Recorder _____
Assistant _____
Map No./Dir. 1
State Coordinates Rock Hall

Road No. MU 0025
Road Name _____
County _____
Date _____
Sheet No. _____ OF _____

SYSTEM				TRAFFIC		LINE DIAGRAM	TRAFFIC			PAVEMENT DATA
FED. AID.	FUNCT CLASS.	HWY. SYS.	HPMS SAMPLE	PRKG. REST.	COM/IND. ACCESS		CONTROL	COM/IND. ACCESS	PRKG. REST.	
						NOW MU 0072 87 - EXTRA				

TRAFFIC CODES

TRAFFIC CONTROLS: STOP SIGN=SS,
TRAFFIC LIGHT=T.L.,
FLASHING RED BALL=F.R.

TRAFFIC CODES

PARKING RESTRICTIONS: A.M. PEAK,
P.M. PEAK, A.M./P.M. PEAK, NO PARKING
ANYTIME=N.P., COMM/IND. ACCESS=E

SYSTEM				TRAFFIC		LINE DIAGRAM	TRAFFIC			PAVEMENT DATA
FED. AID.	FUNCT. CLASS.	HWY. SYS.	HPMS SAMPLE	PRKG. REST.	COM/IND ACCESS		CONTROL	COM/IND ACCESS	PRKG. REST.	

Form 6 HPS (Rev. 1961)

TL VER. MUN 0086
FR. 10/20/77
86-2

ROAD INVENTORY SHEET

PARTY CHIEF Frederick Settan 1009-477
RECORDER Thomas Landon
CHAINMAN

ROAD NO. ~~C029~~
NAME COLEMAN ROAD
SHEET NO. 1 OF 1
DATE 6-22-67
COUNTY KENT

ROCK HALL

ROCKHALL AVE
MD 0 1A 20

N

H 0 10

WILKINS AVE
0 07 ~~97~~ 29
MUN 0210

S.C. BEACH
MU 0 05

MERCER AVE
0 03 ~~ROCKHALL AVE~~
MUN 184

0 00

ROAD
00 17 ~~25~~ 35

(86-2)
18'C
2-4" SHLD
30'CM
2 ML

Form 6 HPS (Rev. 1961)

TL VER
FR. 10/20/77
MU0120

ROAD INVENTORY SHEET

1117 - 4775

PARTY CHIEF Frederick Settan
RECORDER Thomas Landon
CHAINMAN

ROAD NO. ~~C 8 109~~
NAME HAVEN RD
SHEET NO. 1 of 2
DATE 6-23-67
COUNTY KENT

ROCK HALL

		JAMAR RD		
H	0 50	~~CP 32~~ MU0158		
	0 47	H		
4 H	0 46			
	0 42	H		
3 H	0 40			16'F 2-3'ESHLD 30'CW
	0 35			
	0 34	H		
(MUN) MU0158	0 28			
HENRY AVE.	0 23			16'F 2-3'ESHLD 30'CW
N. MAIN		STREET	445	
MD	0 13			
	0 10			
H	0 08			
H	0 06			
WILLIAMS STREET				
MUN ~~C 0 95~~ 0200	0 05			18'F 2-4'ESHLD 32'CW
H	0 01			
ROAD	0 00	END		

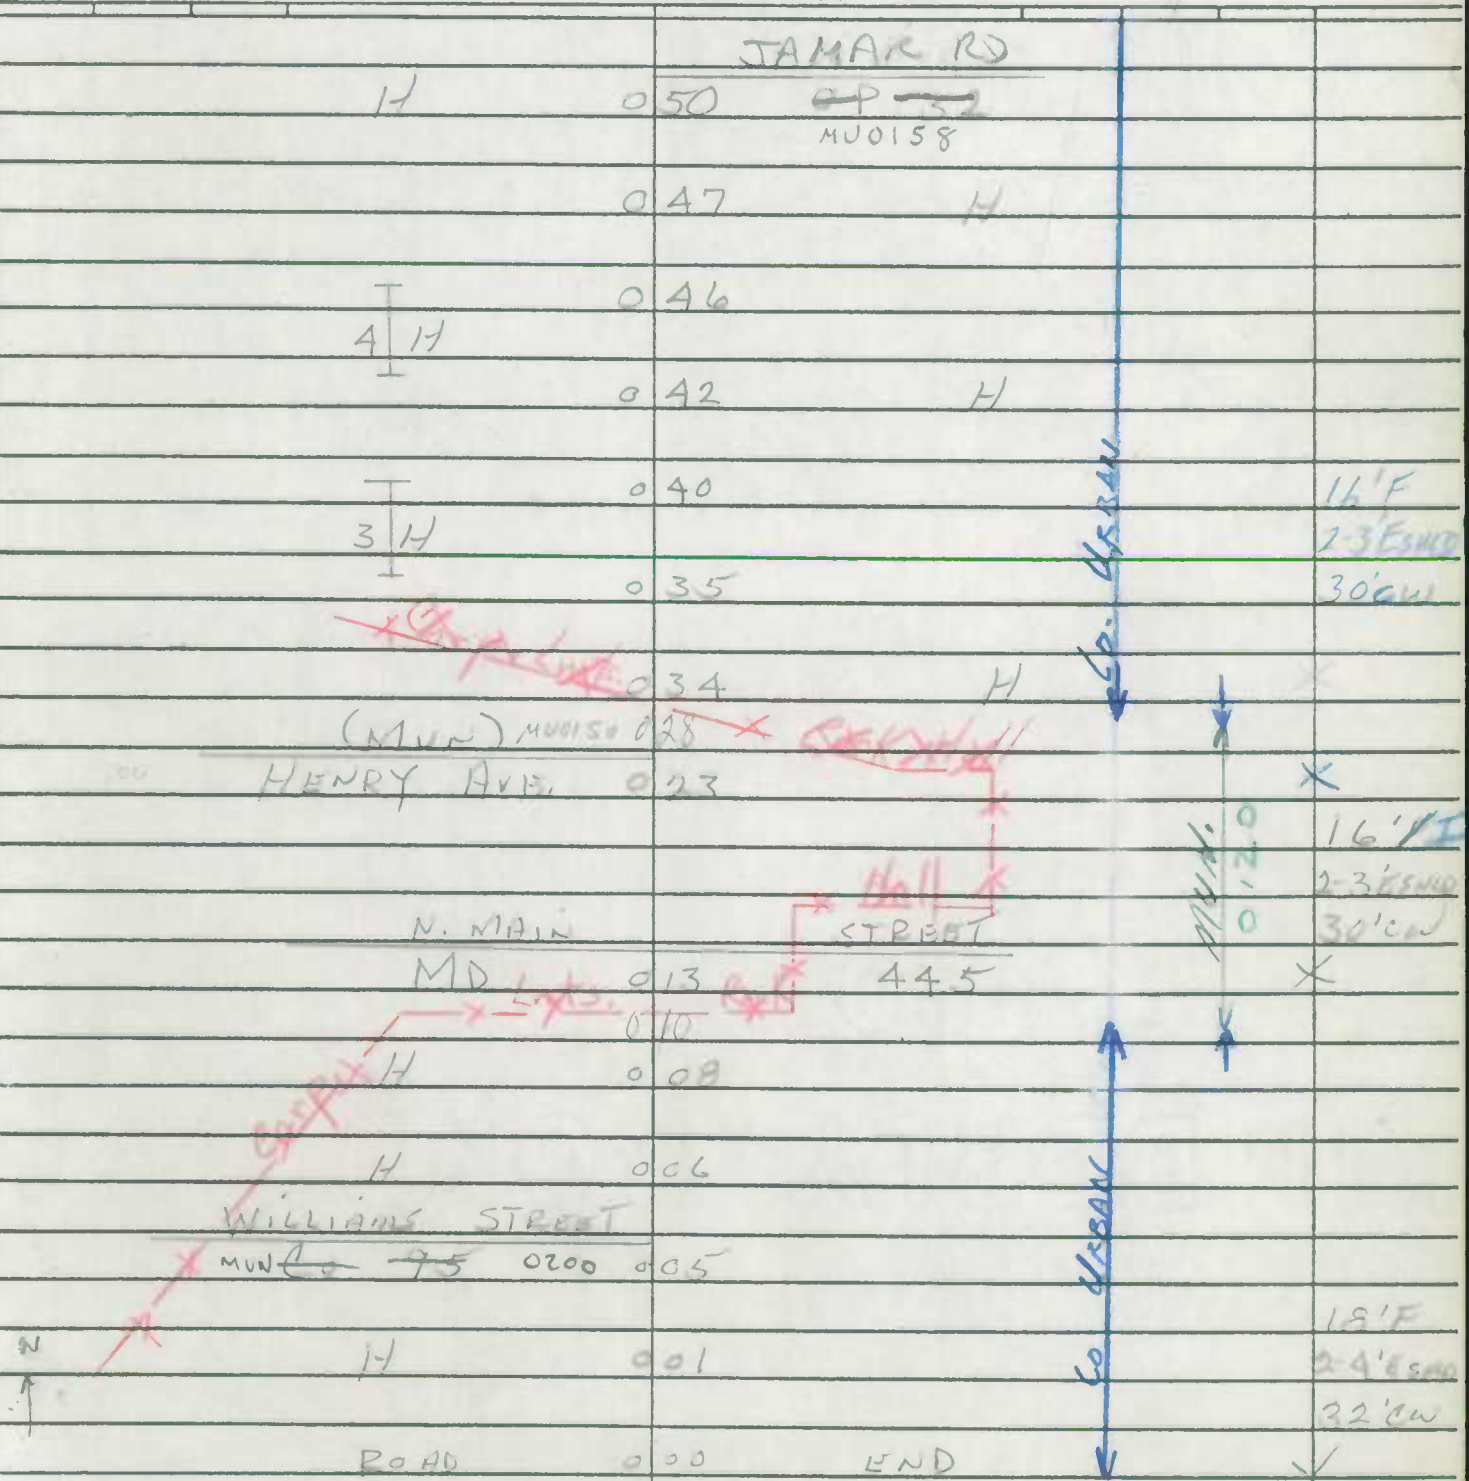

Form 6 HPS (Rev. 1961)

ROAD INVENTORY SHEET

MU0120

PARTY CHIEF Frederick Settan
RECORDER Thomas Landon
CHAINMAN

ROAD NO. to 109
NAME
SHEET NO. 2 OF 2
DATE 6-22-67
COUNTY KENT

THE HAVEN

ROAD END

0+69 H

0+66 H I

0+65 OBS. 0 PVT RD 0 9'E H

5 H

0+64

4 H

0+57

0+55 H

N. HAWTHORNE AVE.

MU ~~to~~ ~~116~~ 0130 0+53 H

H

0+52

0+51 H

SAVE

Form 6 HPS (Rev. 1961)

ROAD INVENTORY SHEET

T. LANDON
F. RHODES
VERIFIED
10/20/77

0120

PARTY CHIEF Frederick Settan
RECORDER Thomas Landon
CHAINMAN

ROAD NO. Co 109
NAME HAVEN RD
SHEET NO. 1 of 2
DATE 6-22-67
COUNTY KENT

ROCK HALL

		JAMAR RD	
H.	0 50	MUN BP 3.2 0158 18-3	
	0 47	H	
4 H	0 46		
	0 42	H	
3 H	0 40		
	0 35		16'F
			23'E SHED
	0 34	H	30'CW
(MUN)	0 28	Rock Wall	
HENRY AVE.	0 23		16'F
		Wall	3-3'ES
N. MAIN		STREET	30'CW
MD Limits	0 13	445	
	0 10		
H	0 09		
H	0 06		
WILLIAMS STREET			
Co 95	0 05		
			12'F
H	0 01		24'ES
			32'CW
ROAD	0 00	END	

Form 6 HPS (Rev. 1961)

ROAD INVENTORY SHEET

PARTY CHIEF Frederick Settan
RECORDER Thomas Landon
CHAINMAN

T. LANDON
T. HODES
VERIFIED

ROAD NO. Co 109
NAME
SHEET NO. 2 OF 2
DATE 6-22-67
COUNTY HUNT

ROCK HALL

THE HAVEN

ROAD END

0.69 H

0.6 H

HYNSON RD

0.5

5 H

0.64

4 H

0.57

0.55 H

N. HUNTINGTOWN AVE.

Co 110

0.53 H

H

0.52

0.51 H

SHOP

Form 6 HPS (Rev. 1961)

TL VER.
FR. 10/20/77
MD 0130

ROAD INVENTORY SHEET

PARTY CHIEF Frederick Settan 1011.5 - 1176.5
RECORDER Thomas Landon
CHAINMAN

ROAD NO. ~~Bo~~ ~~HO~~
NAME N. HAWTHORNE AVE.
SHEET NO. 1 OF 1
DATE 6-22-67
COUNTY KENT

ROCK HALL

HAVEN RD
CO MD 021 0120 ~~109~~
014 H
010 H
007
004
ROCKHALL AVE
MD 000 20

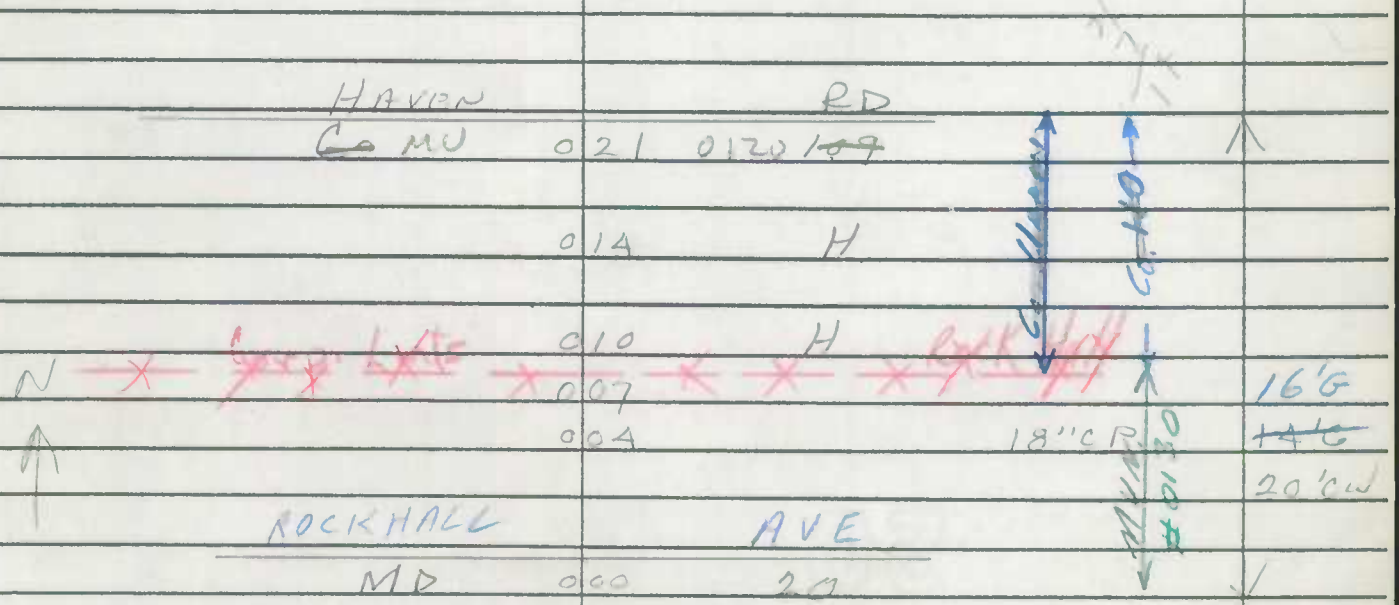

Form 6 HPS (Rev. 1961)

ROAD INVENTORY SHEET

0130

PARTY CHIEF Frederick Settan
RECORDER Thomas Landon
CHAINMAN

ROAD NO. Co 110
NAME N. HOWTHORNE AVE.
SHEET NO. 1 OF 1
DATE 6-22-67
COUNTY KENT

ROCK HALL

HAVEN			2D	
Co	021		109	
	014		H	
~~C/L~~	~~Limits~~	010	~~H~~	~~Rock Hall~~
	005T			16'C
	004		18'CP	~~14'C~~
				20'CW
ROCKHALL			AVE.	
MD	000		2A	

Form 6 HPS (Rev. 1961)

TL VER. FR. 10/20/77

91-1 MUN 1-3-92 6D/BB MU0140

ROAD INVENTORY SHEET

1014.5 - 476.5

PARTY CHIEF Frederick Settan
RECORDER Thomas Landon
CHAINMAN

ROAD NO. C-0 122
NAME S. HAWTHORNE AVE.
SHEET NO. 1 OF 1
DATE 6-22-67
COUNTY KENT

ROCK HALL

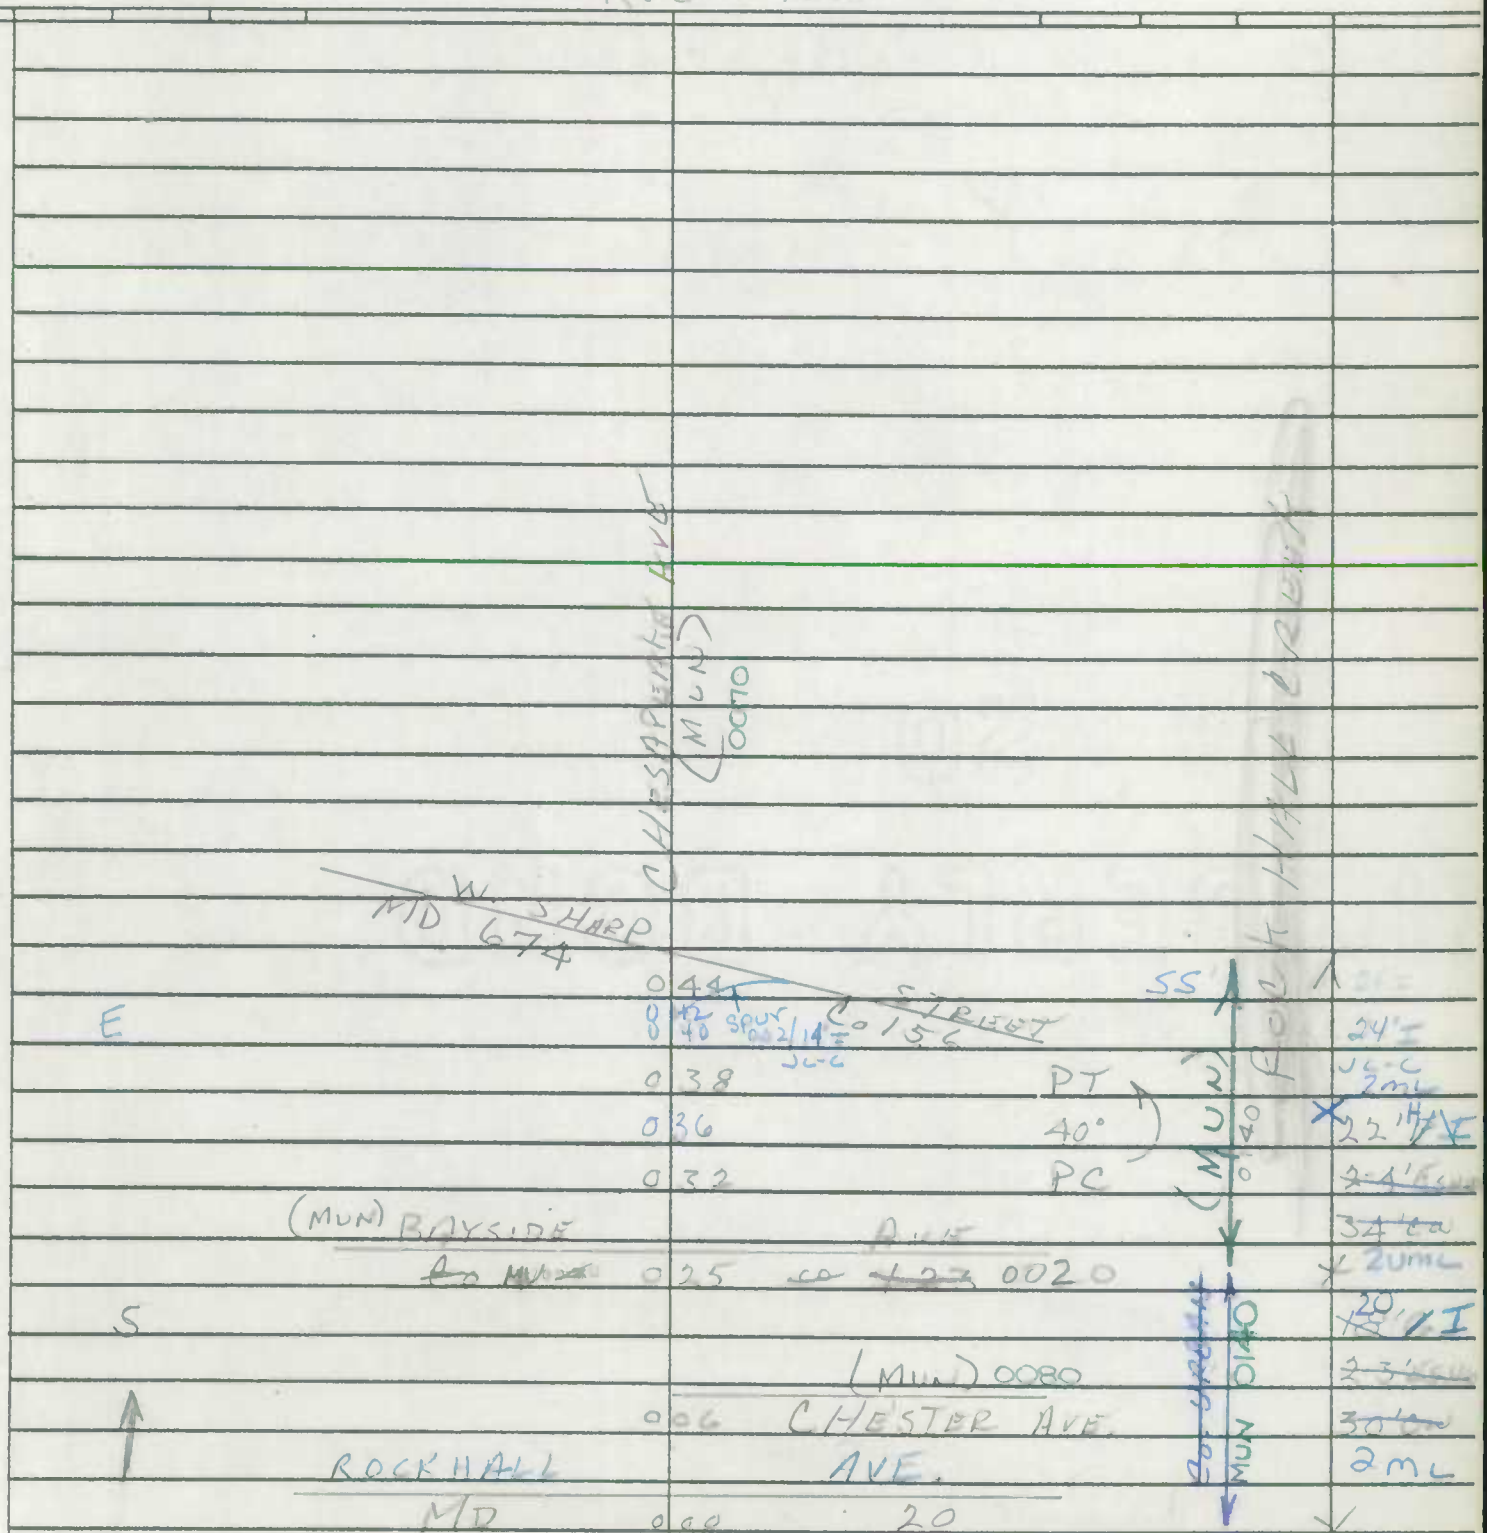

Form 6 HPS (Rev. 1961)

ROAD INVENTORY SHEET

T. LANDON

T. RHODES

VERIFIED 10/20/77

0140

PARTY CHIEF Frederick Settan
RECORDER Thomas Landon
CHAINMAN

ROAD NO. C 122
NAME S. HAWTHORNE AVE.
SHEET NO. 1 OF 1
DATE 6-22-67
COUNTY KENT

ROCK HALL

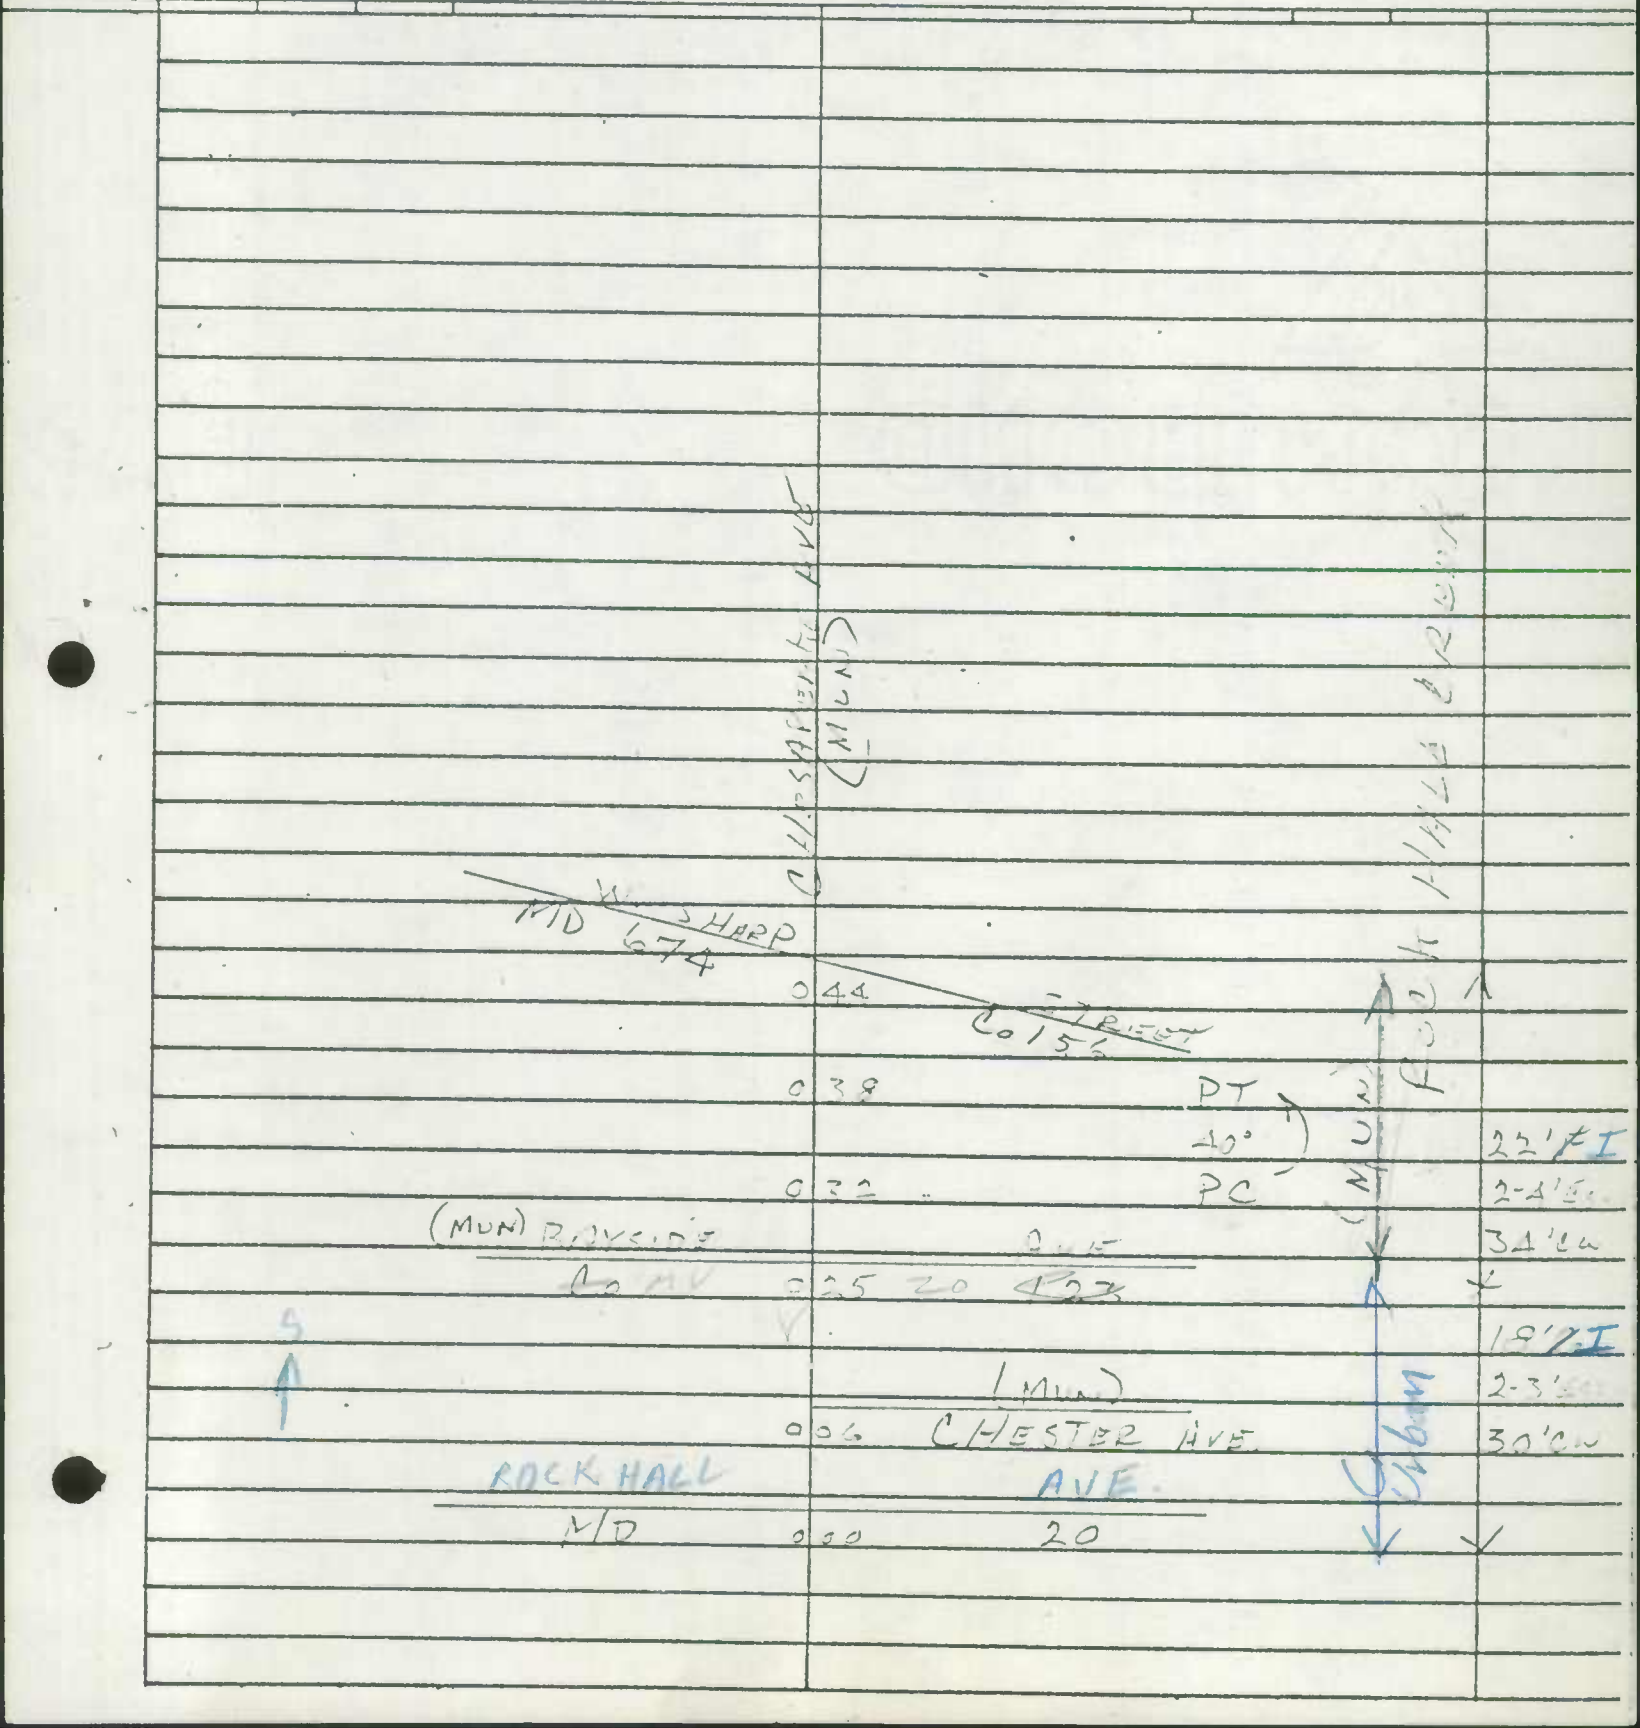

Form 6 HPS (Rev. 1961)

TC VER. FR 10/20/77 MV 0200

ROAD INVENTORY SHEET

1017-476

PARTY CHIEF Frederick Settan
RECORDER Thomas Landon
CHAINMAN

ROAD NO. C 0 95
NAME WILLIAMS STREET
SHEET NO. 1 OF 1
DATE 6-22-67
COUNTY HUNT

ROCK HALL

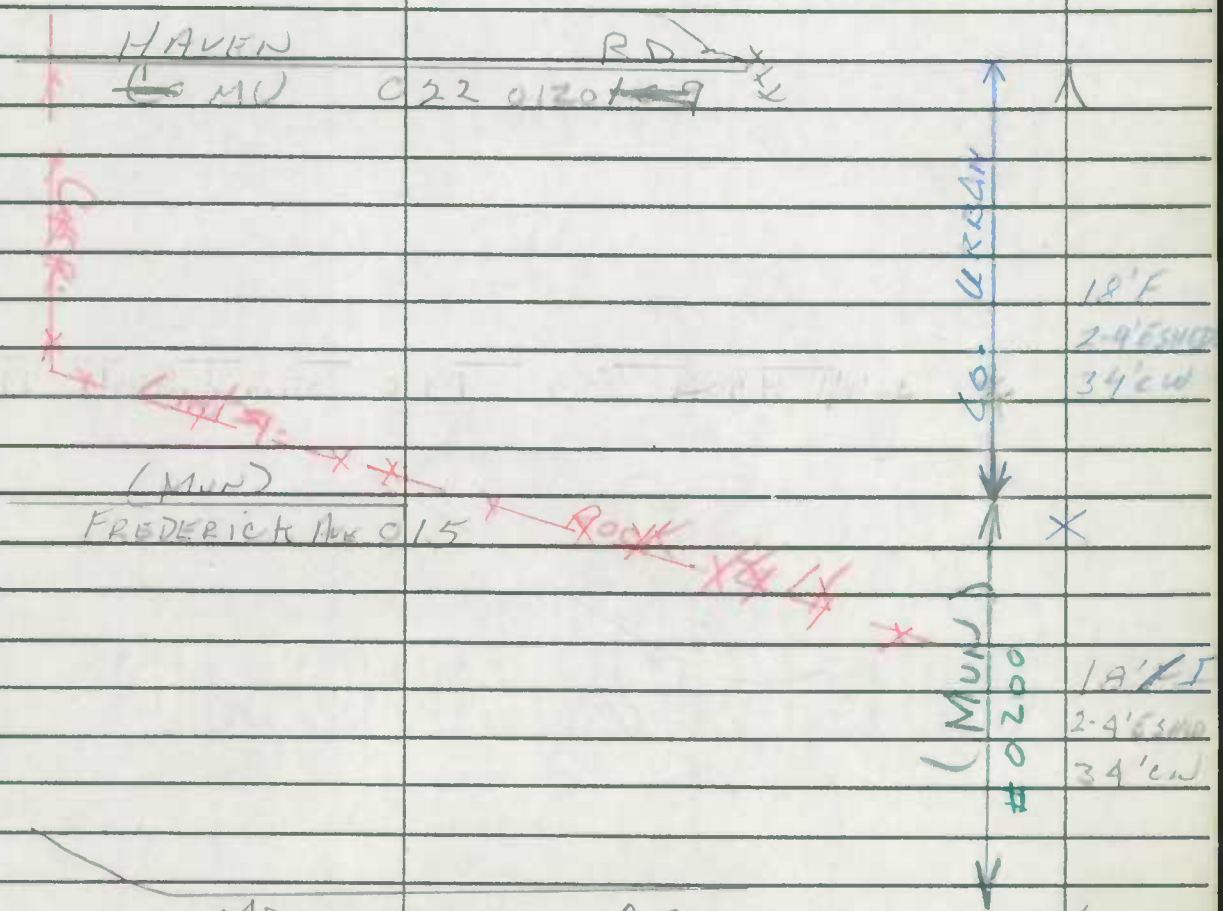

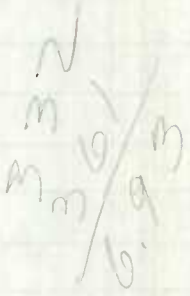

Form 5 HPS (Rev. 1961)

ROAD INVENTORY SHEET

0200

PARTY CHIEF Frederick Settan
RECORDER Thomas Landon
CHAINMAN

T. LANDON
VERIFIED
10/20/67

ROAD NO. C 095
NAME WILLIAMS STREET
SHEET NO. 1 OF 1
DATE 6-22-67
COUNTY KENT

ROCK HALL

HAVEN
C 0 C 22 RD 109

18'F
2-4'ESHD
34'CW

(MD) 10
FREDERICK 15

ROCK HALL

18'PI
2-4'ESHD
34'CW

N

ROCK HALL AVE.
MD 000 20