SHA 51.3 - 8 Revised
4.83

MARYLAND STATE HIGHWAY ADMINISTRATION

ROAD INVENTORY SHEET

BARNESVILLE

Party Chief W. DOMBROSKI
Recorder D. TAYLOR
Assistant
Map No./Dir. /
State Coordinates

Road No. MUN 0010
Road Name (A ST)
County MONT
Date 7-18-83
Sheet No. 1 OF 1

SYSTEM				TRAFFIC		LINE DIAGRAM	TRAFFIC			PAVEMENT DATA
FED. AID.	FUNCT CLASS.	HWY. SYS.	HPMS SAMPLE	PKG. REST.	COM/IND. ACCESS		CONTROL	COM/IND. ACCESS	PKG. REST.	
						Private Rd - 93-1 (mm)				
						008 25°A				
						130° 004				14'E
						(BARNESVILLE RD)				18'C-W
						CO 000 237				

Barnesville

TRAFFIC CODES
TRAFFIC CONTROLS: STOP SIGN=SS, TRAFFIC LIGHT=T.L., FLASHING RED BALL=F.R.

TRAFFIC CODES
PARKING RESTRICTIONS: A.M. PEAK, P.M. PEAK, A.M./P.M. PEAK, NO PARKING ANYTIME=N.P., COMM/IND. ACCESS=E

SYSTEM				TRAFFIC		LINE DIAGRAM	TRAFFIC				PAVEMENT DATA
FED. AID.	FUNCT. CLASS.	HWY. SYS.	HPMS SAMPLE	PRKG. REST.	COM/IND ACCESS		CONTROL	COM/IND ACCESS	PRKG. REST.		

SHA 51.3 - 8 Revised
4.83

MARYLAND STATE HIGHWAY ADMINISTRATION

ROAD INVENTORY SHEET

BARNESVILLE

Party Chief W. DOMBROSKI
Recorder D. TAYLOR
Assistant
Map No./Dir. /
State Coordinates

Road No. MUN 0010
Road Name (A ST)
County MONT
Date 7-18-83
Sheet No. 1 OF 1

SYSTEM				TRAFFIC		LINE DIAGRAM	TRAFFIC			PAVEMENT DATA
FED. AID.	FUNCT CLASS.	HWY. SYS.	HPMS SAMPLE	PRKG. REST.	COM/IND. ACCESS		CONTROL	COM/IND. ACCESS	PRKG. REST.	
						Private Rd – 93-1 (mun)				
						ROAD 009 END				
						008 25°N				
						130' 004				14'E
						(BARNESVILLE RD)				18'C-W
						CO 000 237				

TRAFFIC CODES
TRAFFIC CONTROLS: STOP SIGN=SS, TRAFFIC LIGHT=T.L., FLASHING RED BALL=F.R.

TRAFFIC CODES
PARKING RESTRICTIONS: A.M. PEAK, P.M. PEAK, A.M./P.M. PEAK, NO PARKING ANYTIME=N.P., COMM/IND. ACCESS=E

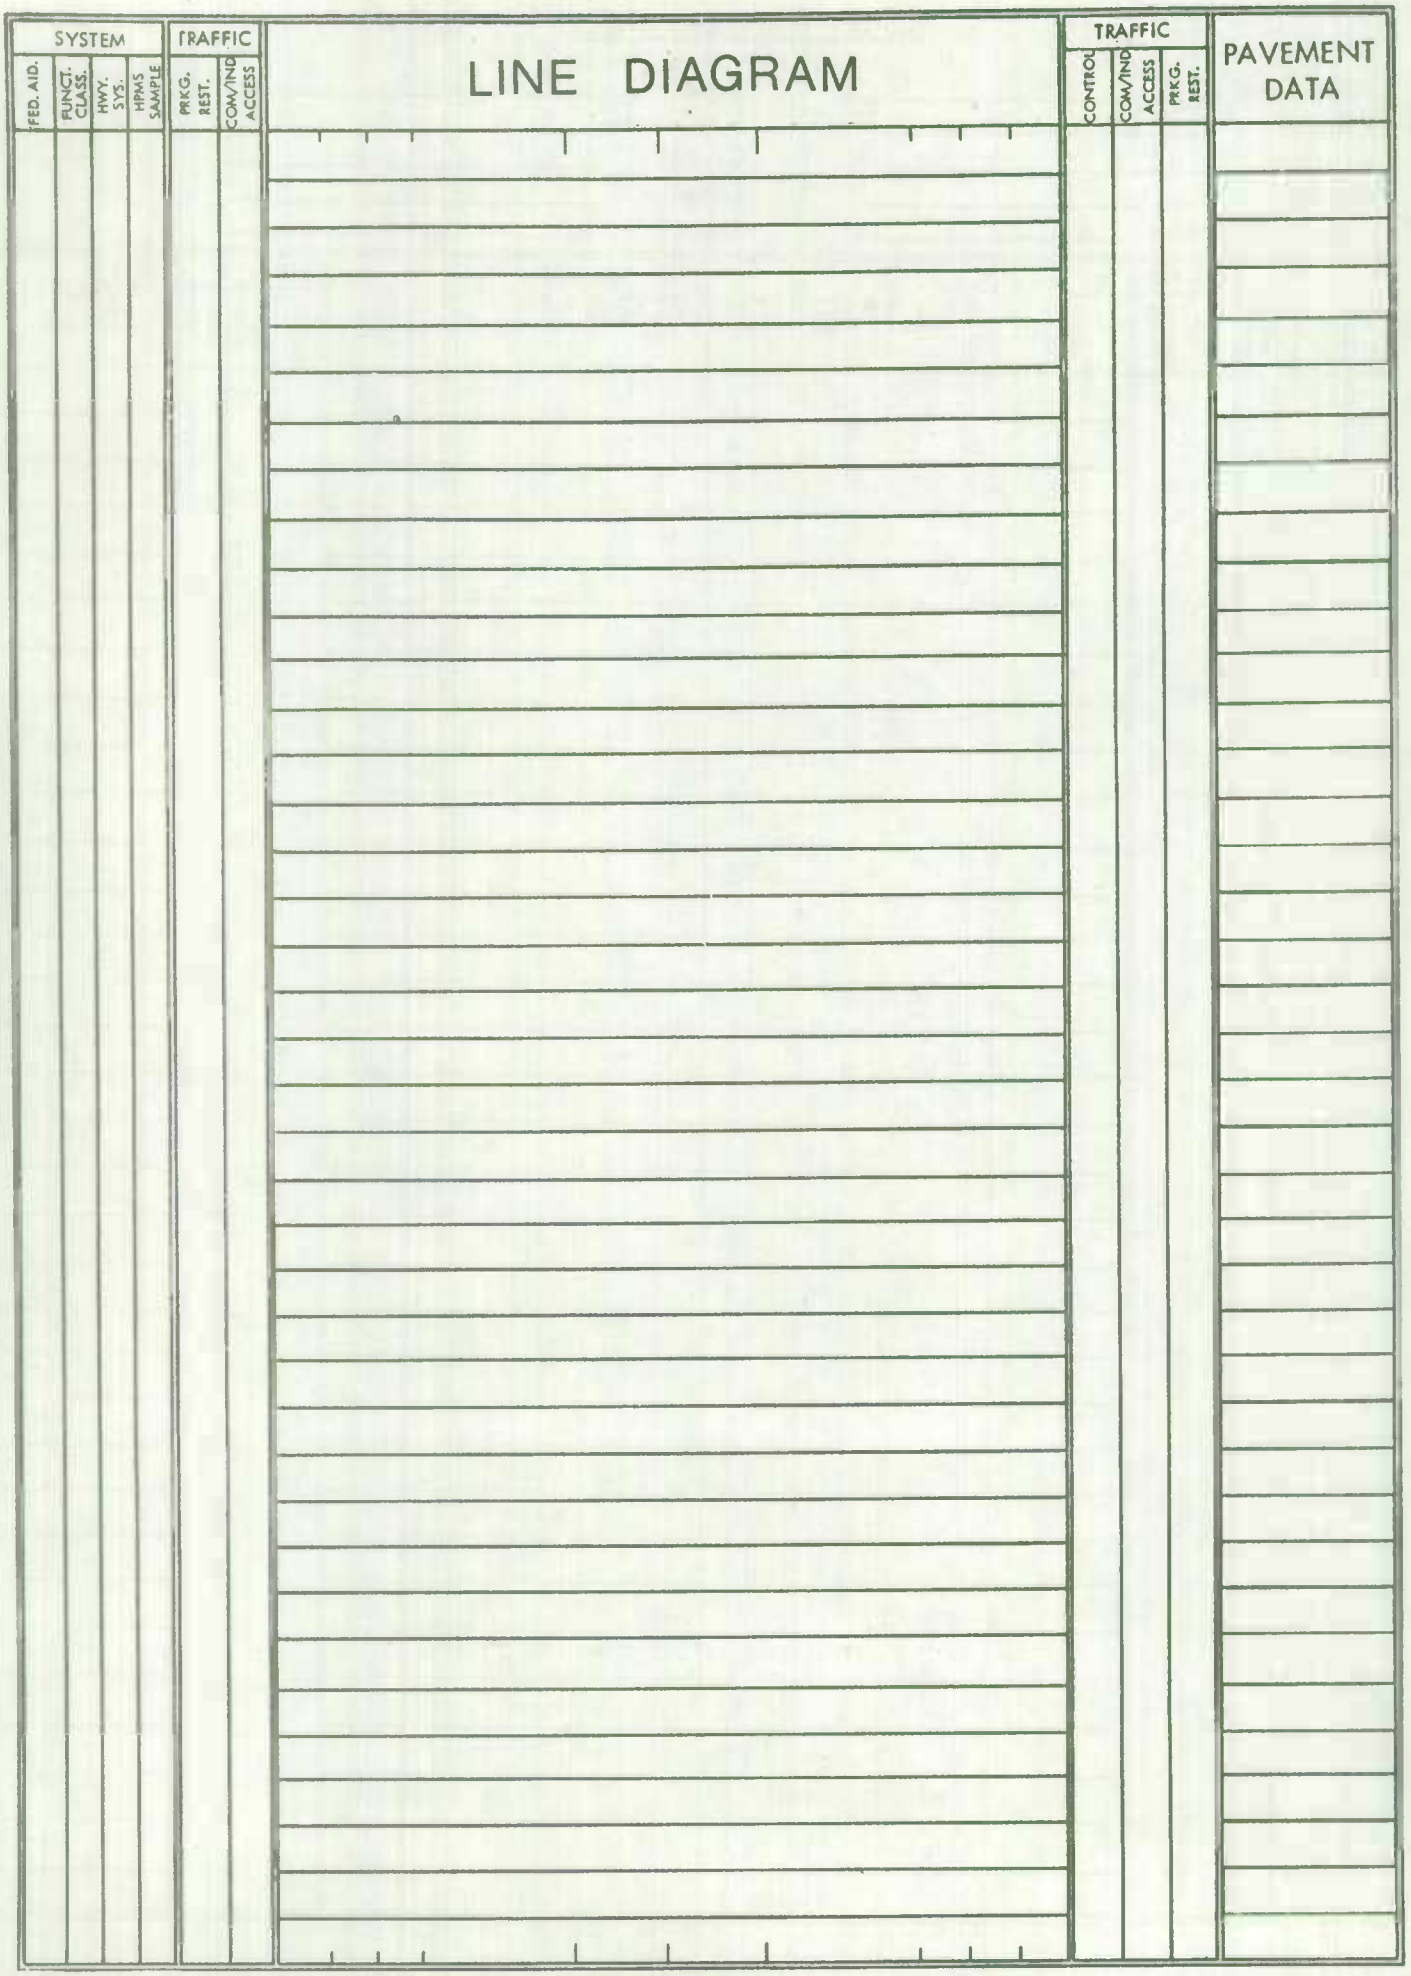
SYSTEM
FED. AID.
FUNCT. CLASS.
HWY. SYS.
HPMS SAMPLE
TRAFFIC
PRKG. REST.
COM/IND ACCESS
LINE DIAGRAM
TRAFFIC
CONTROL
COM/IND ACCESS
PRKG. REST.
PAVEMENT DATA

SHA 51.3-8
11-15-72

ROAD INVENTORY SHEET

Party Chief W. Dombroski
Recorder D. Taylor
Helper

Map No. 19
Barnesville

Road No. MUN 0010
Road Name (A St.)
Sheet No. 1 of 1
Date 7-18-73
County Montgomery
State Coordinates 692-506

S

Road End
009 Hall
Cem.
008 25°
130° 004
14' E
18' CW
(Barnesville Rd)
CO 000 237

SHA 51.3-8
11-15-72

ROAD INVENTORY SHEET

Road No. _____
Road Name _____
Sheet No. _____
Date _____
County _____
State Coordinates _____

Form 6 HPS (Rev. 1961)

Brookeville

ROAD INVENTORY SHEET

MUN 0035

Party Chief W. Dombroski
Recorder D Taylor
Helper

Map 27 & 21

Road No. ~~CO. 59~~
Road Name Brighton Dam Rd
Sheet No. 1 of 5
Date 8-10-73
County Montgomery
784-490

0047 30°↑

DT
35°
DC

0043
0039 DR
0037

Brookeville

↑10°

E ↑

0011 15°↑ 14'H 18'CW

Corp limits 0005 ←DR 21"CMP of Brookeville

"A" St.
MUN 0010 0004

Brookeville
Market St.

0002 H

22'I
2-I curbs

000 (Market Mun St. 0040)

Form 6 HPS (Rev. 1961)

Brookeville

ROAD INVENTORY SHEET

MUN 0035

Party Chief W. Dombroski
Recorder D Taylor
Helper

Map 27 & 21

Road No. ~~CO. 59~~
Road Name Brighton Dam Rd
Sheet No. 1 of 5
Date 8-10-73
County Montgomery
784-490

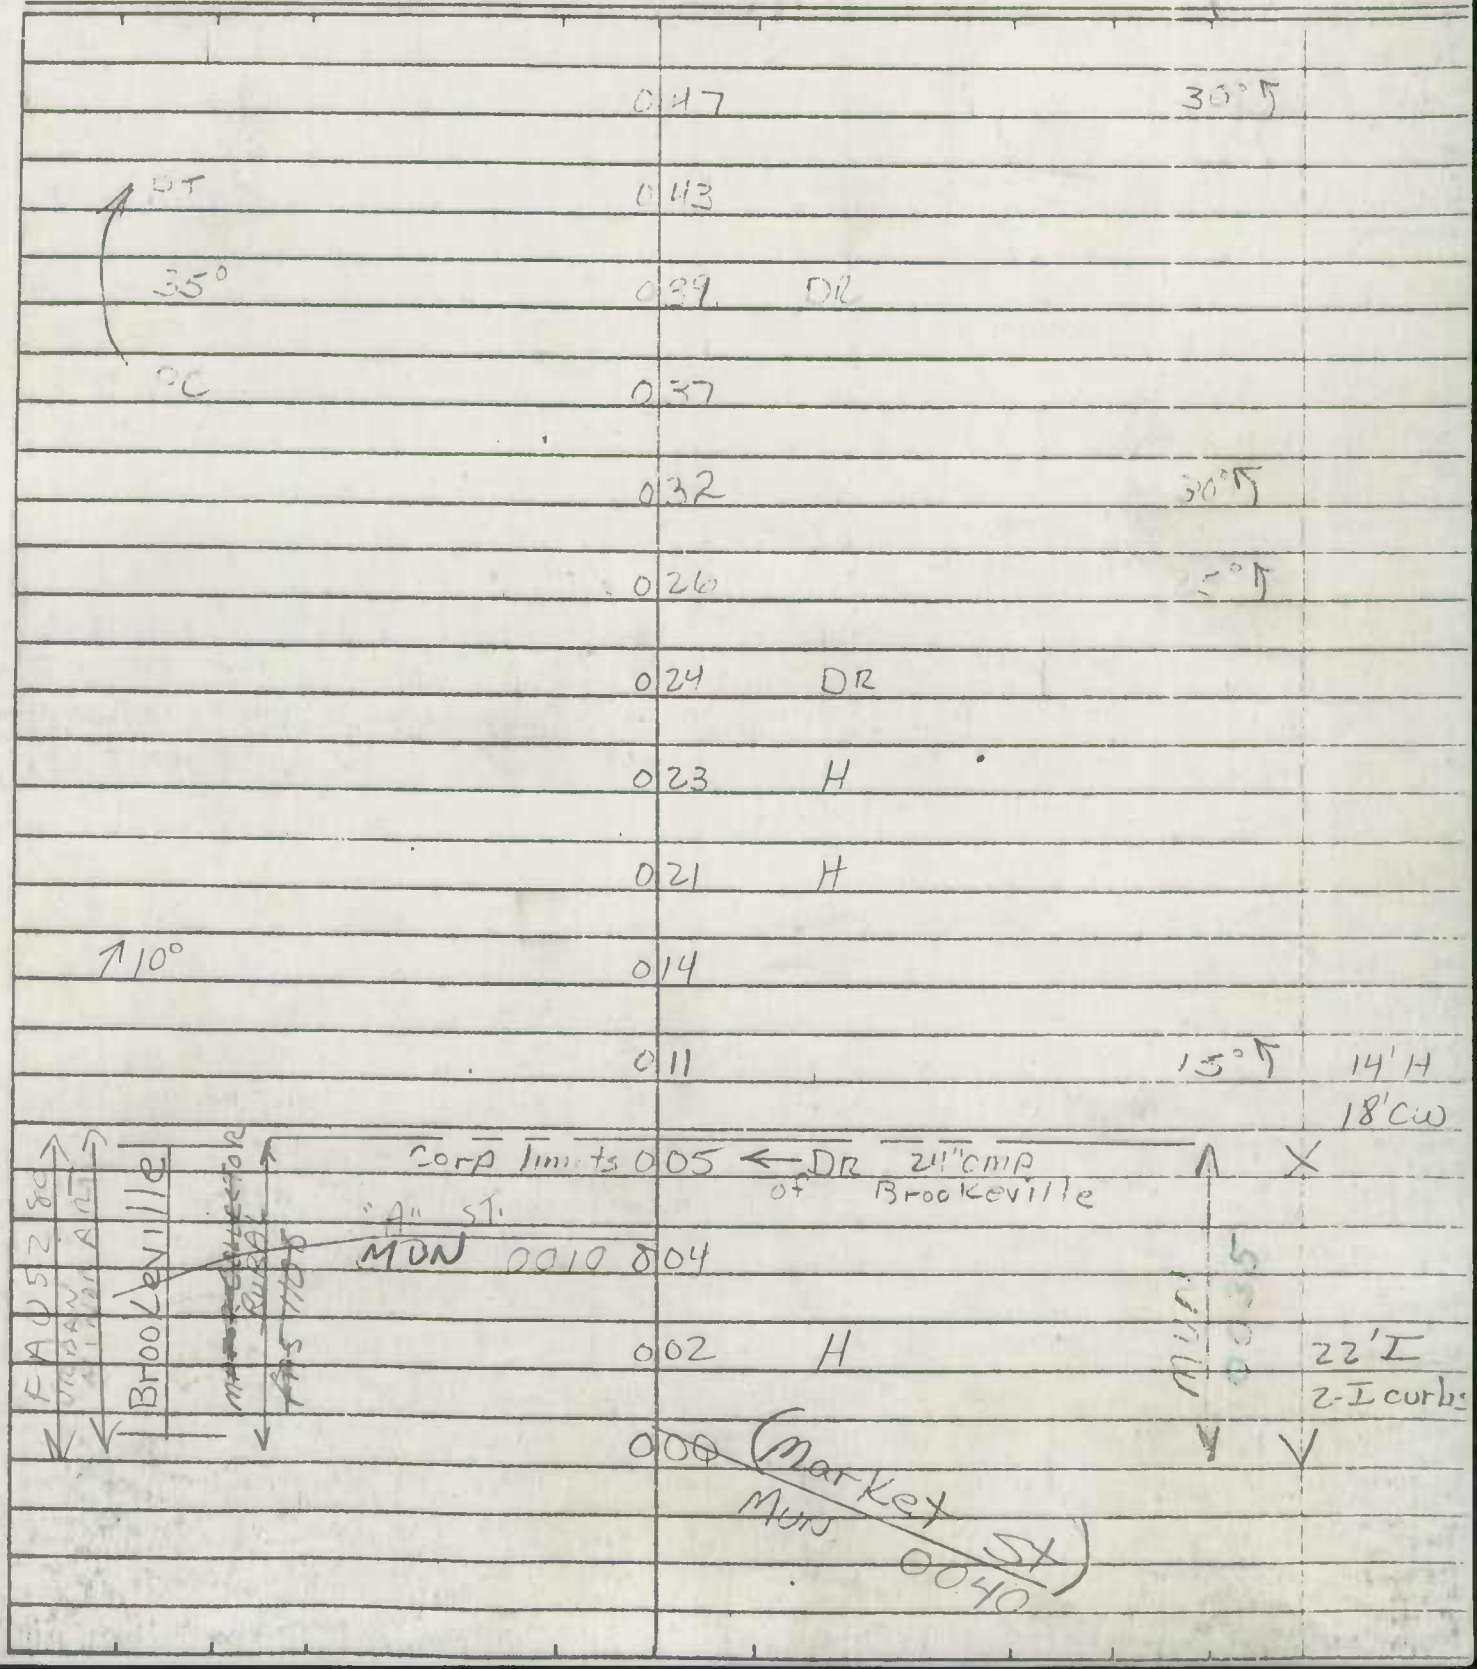

SHA 51.3-8
11-15-72

STATE HIGHWAY ADMINISTRATION OF MARYLAND LELAND ST

ROAD INVENTORY SHEET Co 408 Chevy Chase 5

Party Chief T. FALDEN
Recorder H. ZAKENSKI
Helper

Road No. MUN 0050
Road Name W. LELAND ST.
Sheet No. 1 of 2
Date 4-16-74
County MONT
State Coordinates

Map No. 31

CHEVY CHASE IV & V

PC
0.87
408
26' H
J'c-c
2 UML
15°
BROOKVILLE MD RD
0.76
15°
0.76
18G
PT
25°
PC
26' I 3s
J'c-c
2 UML
26' J
J'c-c
2 UML
20°
CHEVY CHASE IV
20°
MUN
N
30°
0.24
45°
MAPLE AVE
0.06
OAK LA
0.03
MUN 0.00
26' I
J'c-c
2 UML
0.00
LELAND ST

Chevy Chase #5

SHA 51.3-8
11-15-72

STATE HIGHWAY ADMINISTRATION OF MARYLAND LELAND ST

ROAD INVENTORY SHEET Co 408 Chevy Chase S

Party Chief T. FALDON
Recorder H. ZALENSKI
Helper

Road No. MUN 0050
Road Name W. LELAND ST.
Sheet No. 1 of 2
Date 4-16-74
County MONT
State Coordinates

Map No. 31

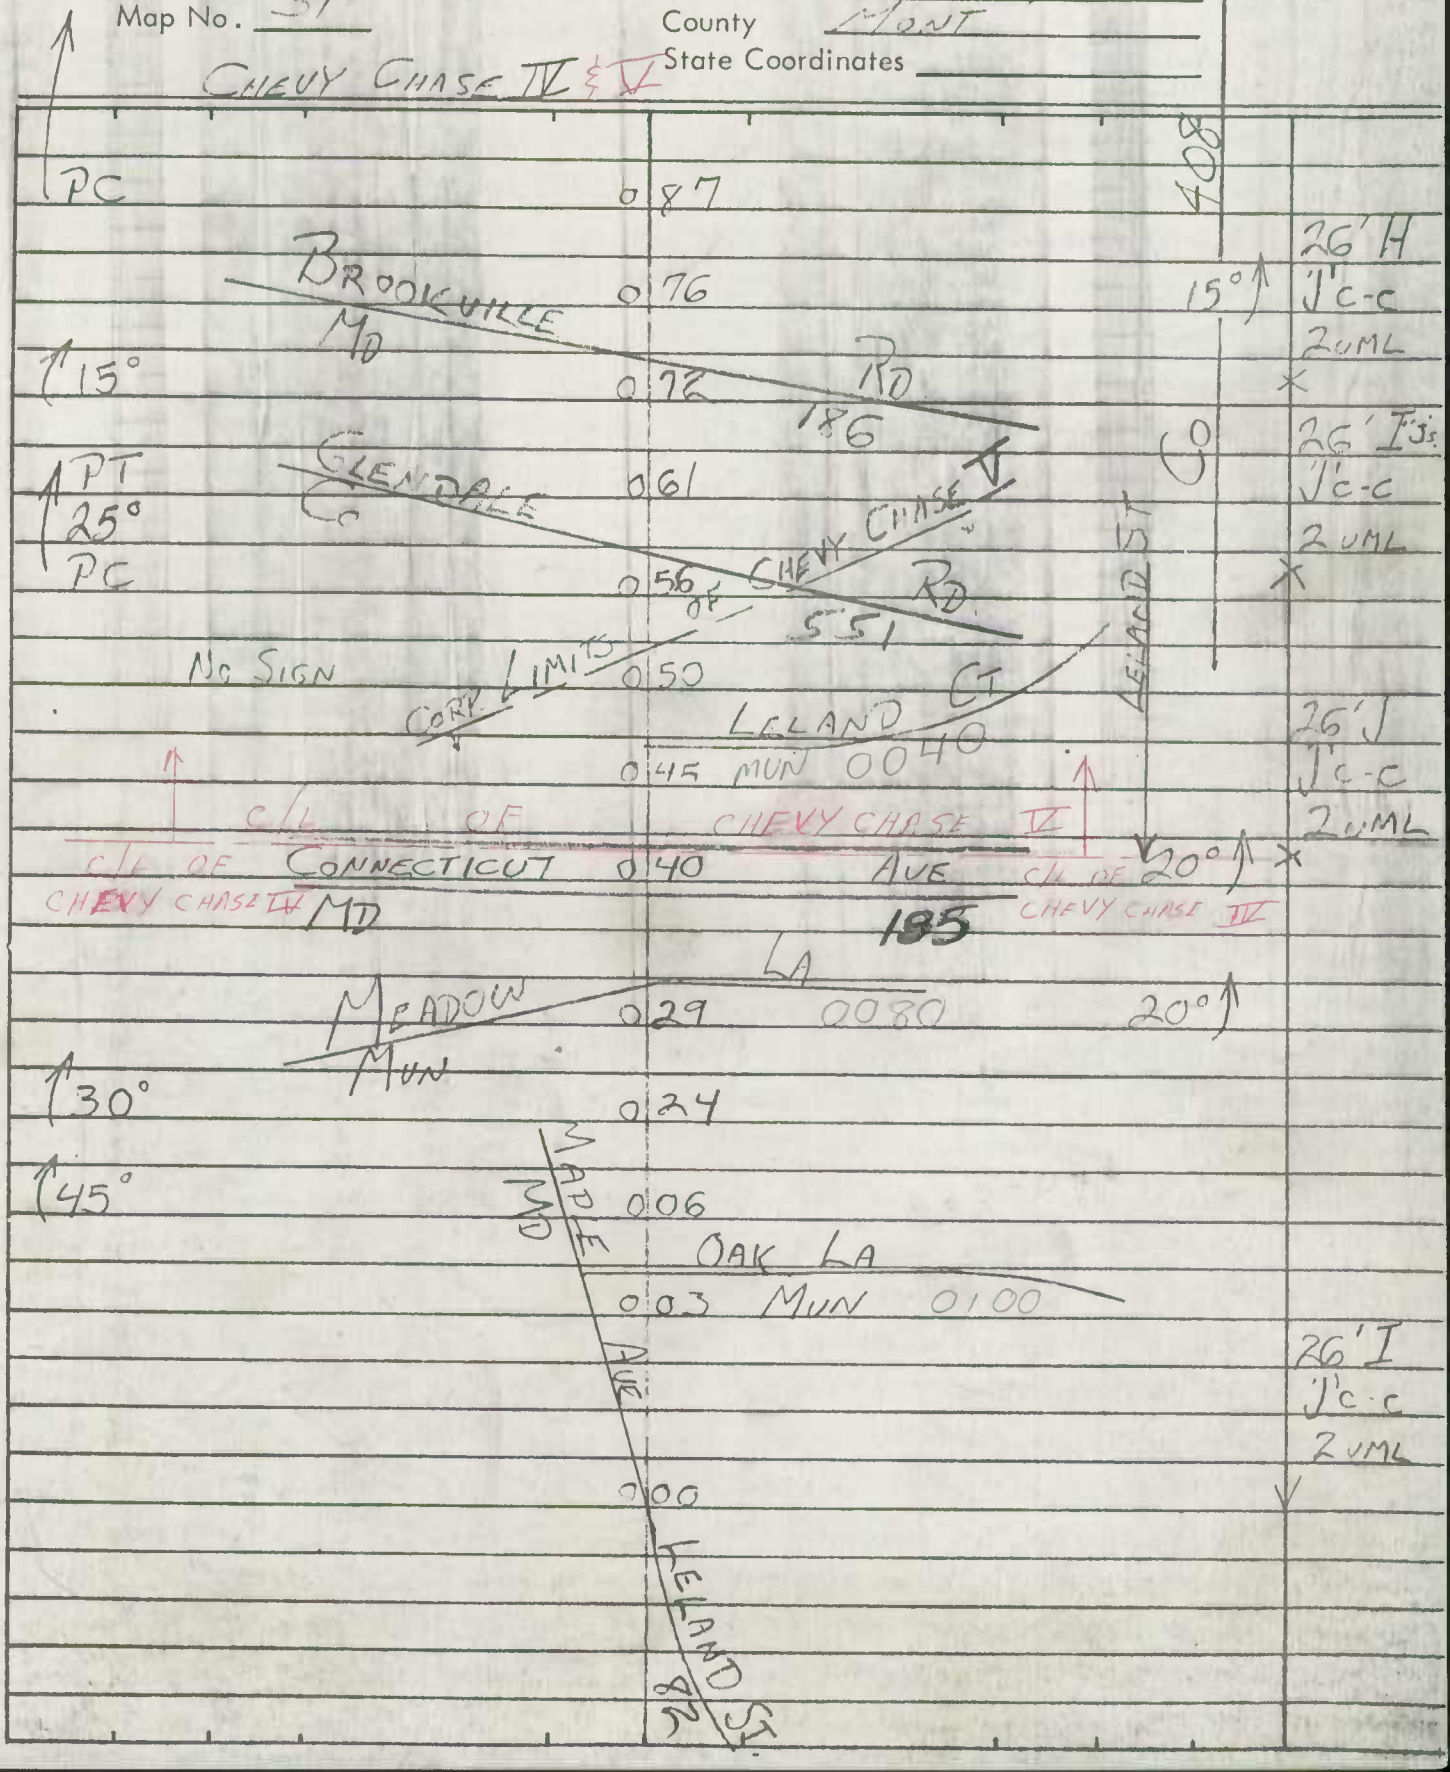

SHA 51.3-8
11-15-72

STATE HIGHWAY ADMINISTRATION OF MARYLAND

MUN. 0020

ROAD INVENTORY SHEET

Party Chief I. LANDON
Recorder M. ZALENSKI
Helper

Map No. 30 & 31

83-6
3/6/84
BB+NS

Road No. ~~Co 2852~~
Road Name DRESDEN ST
Sheet No. 1 of 1
Date 4-26-74
County MONT.
State Coordinates

CHEVY CHASE VIEW

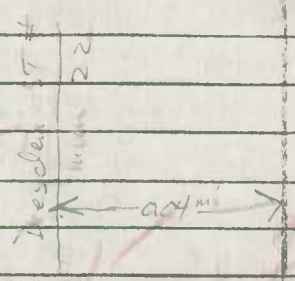

CONNECTICUT 079 AVE
MD 193 185

26'H
I c-c
2UML

X 26'I
X 20'H
X 26'
X 2UML

26'I
I c-c 2UML
15° X 16'H
22'CW
X 2UML

E

WILDWOOD 1479
014 CO.

10° 009

005 10°

26'H
I c-c
2UML

GREENFIELD CO. 000 ST. 1711

Chevy Chase View

SHA 51.3-8
11-15-72

STATE HIGHWAY ADMINISTRATION OF MARYLAND

MUN. 0020

ROAD INVENTORY SHEET

Party Chief I. LANDON
Recorder M. ZALENSKI
Helper

Map No. 30 & 31

83-6
3/6/84
BB-NS

Road No. ~~CO 2852~~
Road Name DRESDEN ST
Sheet No. 1 of 1
Date 4-26-74
County MONT
State Coordinates

CHEVY CHASE VIEW

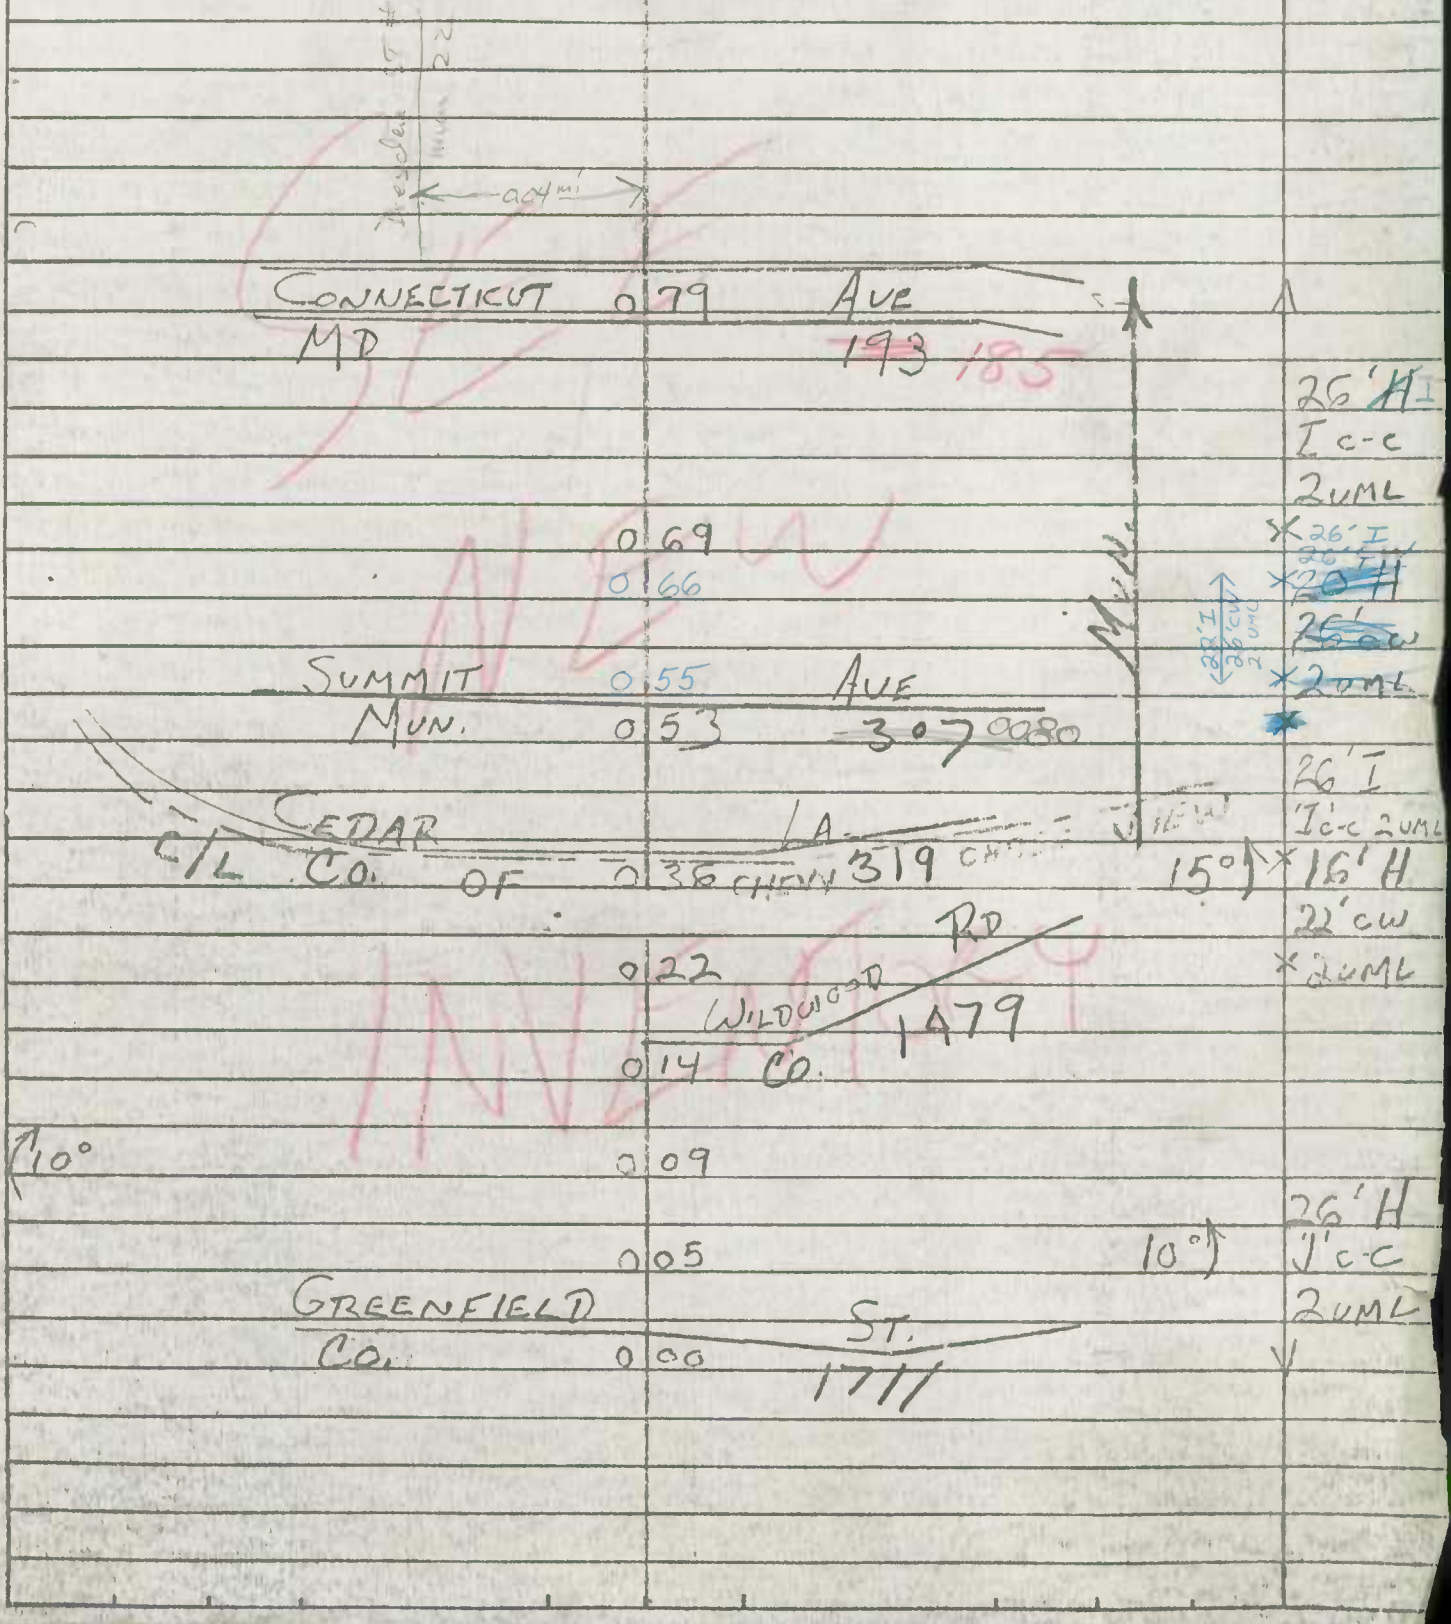

SHA 51.3-8
11-15-72

STATE HIGHWAY ADMINISTRATION OF MARYLAND

ROAD INVENTORY SHEET

MUN 0030

Party Chief J. LANDON
Recorder M. ZALENSKI
Helper

Map No. 31+30

Road No. ~~Co.~~ 1480
Road Name EVERETT ST.
Sheet No. 1 OF 1
Date 4-26-74
County MONT.
State Coordinates 778-432

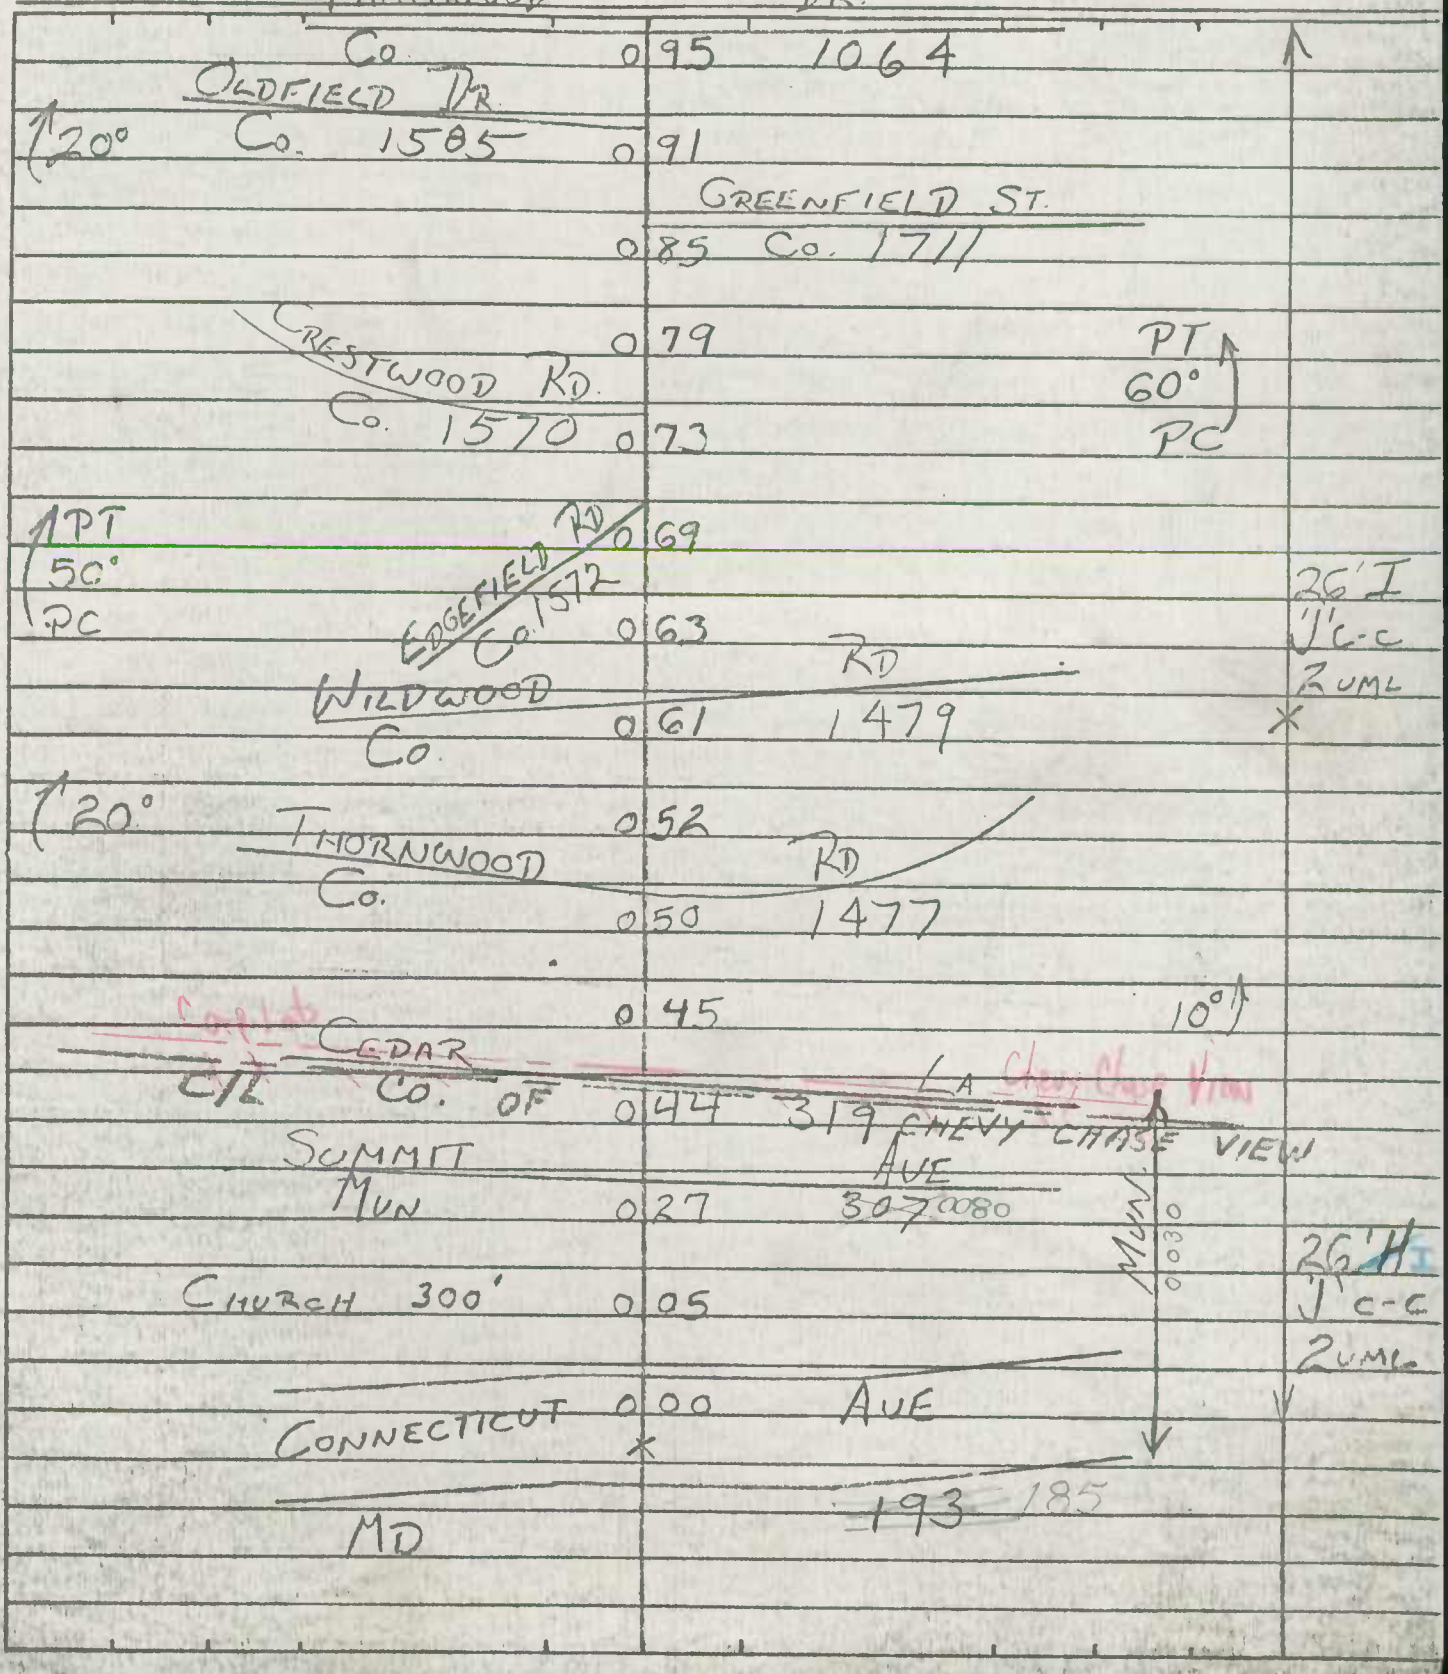

SHA 51.3-8
11-15-72

STATE HIGHWAY ADMINISTRATION OF MARYLAND

Chevy Chase View

ROAD INVENTORY SHEET

MUN 0040

Party Chief I. LANDON
Recorder M ZAKENSKI
Helper

Map No. 30 & 31

Raad No. ~~Co~~ 313
Road Name FRANKLIN ST
Sheet No. 1 OF 2
Date 4-26-74
County MONT.
State Coordinates 772-432

C.M. A.T. 83-4

SUMMIT AVE

MUN CEDAR Co.	0 84	0080	MUN	
c/l of	0 66	LA 319	~~SHEEY CHEC VIEW~~	
	0 65			
THORNWOOD Co.	0 61	RD 1479		
WILDWOOD Co.	0 54	RD 1479		
EDGEFIELD Co.	0 47	RD 1572		10°
WOODFIELD Co	0 41	RD 1571		
PT 40° ASHWOOD DR Co	0 34		C/L 0313	26' H 1
CRESTWOOD Co	0 32	RD 1568 1570		1 c-c
PC SAUL Co. ONE WAY	0 27	RD		2 UML
	0 20	318 RD. WOODFIELD 1571		10°
	0 16	Co		
EDGEFIELD Co	0 11	RD 1572		
15° PARKWOOD Co	0 05	DR 1064		26' I 1 c-c 2 UML
BEACH O.S.	0 00	DR 8		

E

SHA 51.3-8
11-15-72

ROAD INVENTORY SHEET

MUN 0040

Raad Na. ~~Co.~~ 313
Raad Name FRANKLIN ST
Sheet Na. 2 OF 2
Date 4-26-74
County MONT
State Caardinates

KENSINGTON
CORP LIMITS OF
CONNECTICUT
MD

PICNIC
121 538 VIEW
CHEVY CHASE
116
112 AVE
185 ~~193~~

MUN

same

SHA 51.3-8
11-15-72

STATE HIGHWAY ADMINISTRATION OF MARYLAND

ROAD INVENTORY SHEET

MUN 0060

Party Chief T. LANDON
Recorder M. ZALENSKI
Helper

Map No. 31 F 30

83-1
3/6/84
BB NS

Road No. ~~Co.~~ 1481
Road Name GLENRIDGE ST.
Sheet No. 1 OF 1
Date 4-26-74
County MONT.
State Coordinates 777-431

WILDWOOD Co
THORNWOOD Co
RD. 1479
RD. 1477
15°
PT
30°
PC
CEDAR
~~Co~~ units
C/L Co. OF
Chevy Chase View
SUMMIT MUN
Ave
~~3077~~ 0080
15°
GARTRELL MUN.
PL
0050
MUN
10°
15°
CONNECTICUT
MD
Ave
~~193~~ 185
N

0.66
0.57
0.54
0.50
0.49
0.28
0.23
0.17
0.14
0.12
0.08
0.00

26' H
VC-C
2 UNL
26' I
I-CC
16' H
20' CONC
2 UNL
24' I
I C-C
2 UNL

SHA 51.3-8
11-15-72

STATE HIGHWAY ADMINISTRATION OF MARYLAND

Chevy Chase Views

MUN 0080

ROAD INVENTORY SHEET

Party Chief L. LANDOLL
Recorder M. ZALENSKI
Helper

Map No. 30 & 31

Road No. ~~Co~~ 307
Road Name SUMMIT AVE
Sheet No. 1 OF 2
Date 4-26-74
County MONT.
State Coordinates 776-430

91-1 A/T

	068	80°) X
	CLEVELAND ST	
	065 MUN. 0010	
DRESDEN	ST.	
MUN	056 0020	
EVERETT	ST.	
MUN.	047 0030	
FRANKLIN	ST.	
MUN	039 0040	
GLENROSE	ST.	
MUN.	030 0070	MUN
GLENRIDGE	ST	26' I
MUN	023 0060	T C-C
SAUL	RD.	2 CM L
CO. OF	016 318 CHEVY CHASE VIEW	X
	015	
	014 EXIT SCHOOL 15°)	
	012 HOLY REDEEMER ELE. SCHOOL	
15°	010 ENT TO SCHOOL	
		26' H
	002 35°)	J C-C
CABLE	DR.	2 LN
Co	000 2315	

N

SHA 51.3-8
11-15-72

ROAD INVENTORY SHEET

MUN 0080

Road No. ~~Co~~ 307
Road Name SUMMIT AVE
Sheet No. 2 of 2
Date 4-26-74
County MONT.
State Coordinates

BRIDGE UNDER CONST.

BARRICADE
1.18

HOWARD AVE
Co 2081 1.17 MUN

20'H
2-4'E shld
2 ML
30° CUT

BRAINARD AVE
Co 306 1.10

42'I
J CURB LT

KNOWLES AVE 547
MD 1.03

46'
2 ML

WARNER ST
Co 1080 0.98

20° 0.96

BROOKFIELD DR
Co 1084 0.92

ANTHONY ST
Co 1350 0.87

MATTHEWS LA
Co 1348 0.82

PROSPECT ST.
0.79 MUN. 0310

AMBLER DR
Co 308 0.76

40'I
J C-C
2 ML

CEDAR LA
Co 319 0.71 OF CHEVY CHASE VIEW 40°

80° CORP. LIMITS 0.69

2-24'I
J C-C
5' J MED
2 UNL

MUN

HA 51.3-8
1-15-72

MUN 0015

Co 519

ROAD INVENTORY SHEET

BRADLEY LA.

Road No. MD. 191
Road Name BRADLEY BLVD.
Sheet No. 10 of 10
Date 7-24-73
County MONT.
State Coordinates 778 - 416

BB REV.
FR 3-22-83

M-25
82-TR

CHEVY CHASE VILLAGE

 

HA 51.3-8
1-15-72

MUN 0015

Co 519

ROAD INVENTORY SHEET

BRADLEY LA.

Road No. MD. 191
Road Name BRADLEY BLVD.
Sheet No. 10 OF 10
Date 7-24-73
County MONT.
State Coordinates 778 - 416

BB REV.
FR 3-22-83

M-25
82-TR

CHEV CHASE DIST. BDRY

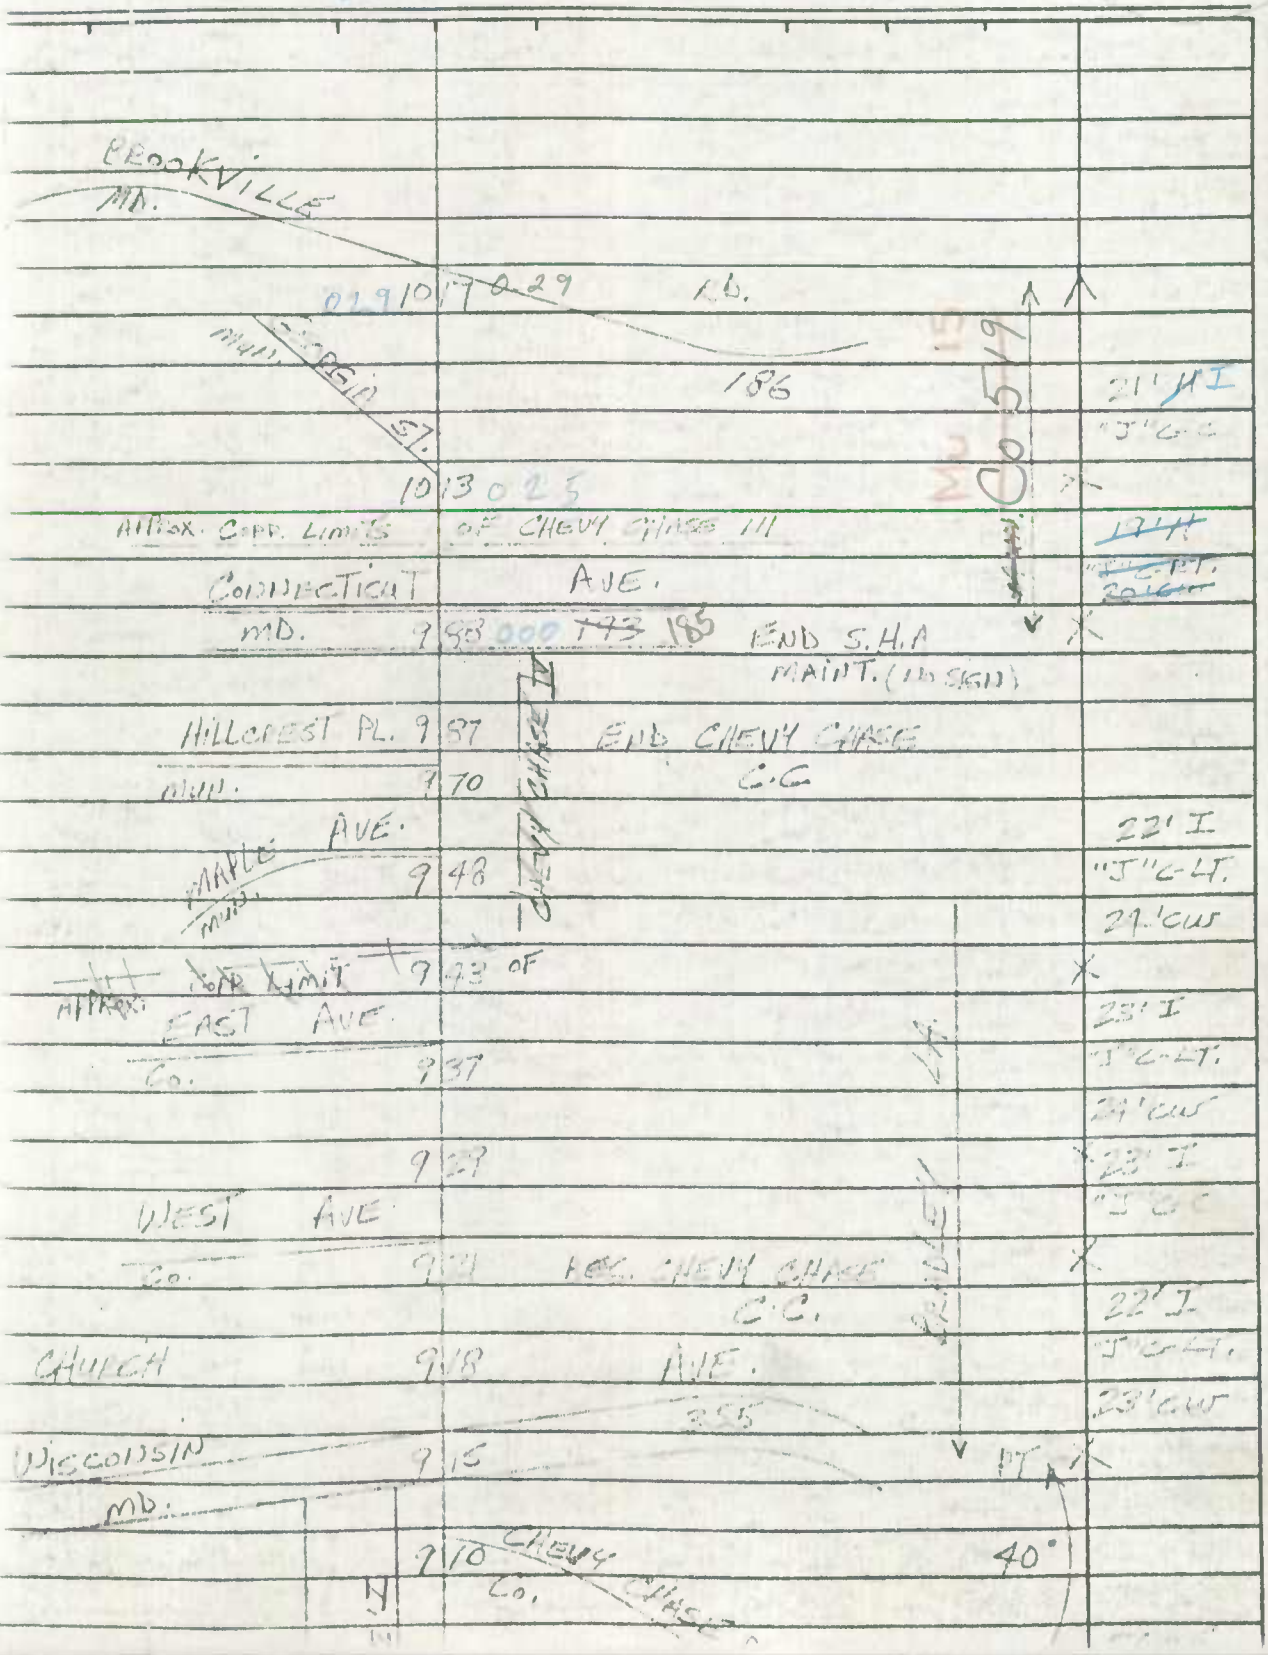
BROOKVILLE MD.
MAIN
WISCONSIN ST.
10 13025
APPROX. CORP. LIMITS
CONNECTICUT
MD.
9 93 000 T93 185
HILLCREST PL. 9 87
MUN.
9 70
MAPLE AVE.
MUN.
9 48
APPROX. CORP. LIMIT
EAST AVE.
CO.
9 37
9 27
WEST AVE
CO.
9 21
CHURCH
9 18
WISCONSIN
MD.
9 15
9 10
CHEVY CHASE
CO.
CHEVY CHASE
CHEVY CHASE
CHEVY CHASE

SHA 51.3-8
11-15-72

STATE HIGHWAY ADMINISTRATION OF MARYLAND

94-12
B3/AH
2/24/75

ROAD INVENTORY SHEET

Party Chief J. LANDON
Recorder M. ZALENSKI
Helper

Map No. 31 & 30

Road No. MUN. 0040
Road Name GRAFTON ST.
Sheet No. 1 OF 1
Date 4-15-74
County MONT.
State Coordinates

CHEVY CHASE VILLAGE

VOID SEE INV NO 94-12 MAP 12

CORP LIMITS OF CHEVY CHASE VILLAGE

WISCONSIN AVE
MD 355
0059

0058

(ALLEY 20' R/W)
MUN 8010 0054

KIRKSIDE DR
MUN 0046 0090

CEDAR PKWY
MUN. 0026 0020

0013

CHASE CIR
ONE WAY
CHEVY CHASE MD 185

NON-COLLECTOR FA URBAN

W

27'H
J'c-c
2UML
X
30'H
J'c-c
2UML
X
38'H
J'c-c
2UML

SHA 51.3-8
11-15-72

ROAD INVENTORY SHEET

Road No. _____
Road Name _____
Sheet No. _____
Date _____
County _____
State Coordinates _____

SHA 51.3-8
11-15-72

STATE HIGHWAY ADMINISTRATION OF MARYLAND

MUN. 0010

ROAD INVENTORY SHEET

Party Chief T. LANDON
Recorder M ZALENSKI
Helper

Map No. 30

DRUMMOND

Road No. Co 2387
Road Name DRUMMOND AVE
Sheet No. OF
Date 4- -74
County MONT.
State Coordinates

89-1(MUN)

120'

Co 2387

26'I
J'c-c
2 UML

26'H
J'c-c
2 UML

22'I
J'c-c
2 UML

W

CORP LIMITS OF DRUMMOND
END CO. MAINT SIGN 0+35

WARWICK LA
MUN. 0020 0+21

CORPS LIMIT OF WISCONSIN 0+00 DRUMMOND AVE
MD 355

SHA 51.3-8
11-15-72

STATE HIGHWAY ADMINISTRATION OF MARYLAND

MUN. 0010

ROAD INVENTORY SHEET

Party Chief T. LANDON
Recorder M ZALENSKI
Helper

Map No. 30

DRUMMOND

Road No. Co 2387
Road Name DRUMMOND AVE
Sheet No. 1 OF 1
Date 4- -74
County MONT.
State Coordinates

89-1 (MUN)

BARRICADE

0 52

120°

0 50

26' I
J'c-c
2 UML

0 48

26' H
J'c-c
2 UML

W

CORP LIMITS OF DRUMMOND

END CO. MAINT SIGN 0 35

WARWICK LA

MUN. 0020 0 21

22' I
J'c-c
2 UML

CORPS LIMITS OF WISCONSIN MD 0 00 DRUMMOND AVE 355

Co 2387

SHA 51.3-8
11-15-72

ROAD INVENTORY SHEET

Party Chief T. LANDON
Recorder T. ABBOTT
Helper

Map No. 26

UNDER CONST.

GAITHERSBURG

Road No. Mun. 0021
Road Name (BROOKS AVE.)
Sheet No. 1 of 1
Date 12-6-73
County Mont.
State Coordinates

NEW LEG

NEW INV.

Gaithersburg

W

ST 136

FAU

COLLECTOR

(GIRARD

Mun.

20°

45°

012 ENT TO APTS

006

004

8.

H

ST.)

000

0+36

0135

24' E Rt.

24' I Ct.

5' 2-C

SHA 51.3-8
11-15-72

ROAD INVENTORY SHEET

Road No. _____
Road Name _____
Sheet No. _____
Date _____
County _____
State Coordinates _____

SHA 51.3-8
11-15-72

ROAD INVENTORY SHEET

Party Chief J. LANDON
Recorder T. ABBOTT
Helper

Map No. 26 UNDER CONST.
GAITHERSBURG

Road No. MUN. 0021
Road Name (BROOKS AVE.)
Sheet No. 1 of 1
Date 11-6-73
County MONT.
State Coordinates

SEE NEW INV. 81-9 10-1-82 JL CP

ROAD END

0.24
0.22
0.16
0.12 ENT TO MITS
0.06
0.04
0.00 0.136
0.135

STA 36 URBAN
FAU COLLECTOR
(GIRARD ST.)
MUD.

20°
15°

N

24' E RT.
24' I CT.
5" C-C
10' GRASS MED

SHA 51.3-8
11-15-72

ROAD INVENTORY SHEET

Road No. _____
Road Name _____
Sheet No. _____
Date _____
County _____
State Coordinates _____

SHA 51.3-8
11-15-72

STATE HIGHWAY ADMINISTRATION OF MARYLAND

ROAD INVENTORY SHEET

Party Chief BB
Recorder FA
Helper

Map No. 82-19
GAITHERSBURG

Road No. MU 0022
Road Name BOSTWICK LA.
Sheet No. 1 OF 1
Date 3-23-83
County MONT.
State Coordinates

83-5
3/14/84
BB-NS

UNASSIGNED

MU 0033

N

ROAD 0 21 END

~~ROAD~~ 0 14 ~~END~~

SIOUX LA
MU 0 11 0361

15° 0 02

36'I
"J"C-C

ROAD 0 00 END

SHA 51.3-8
11-15-72

ROAD INVENTORY SHEET

Road No. _____
Road Name _____
Sheet No. _____
Date _____
County _____
State Coordinates _____

SHA 51.3-8
11-15-72

STATE HIGHWAY ADMINISTRATION OF MARYLAND

ROAD INVENTORY SHEET

Party Chief: BB
Recorder: NS
Helper:

Map No.: 83-10
GAITHERSBURG

Road No.: MUN 0029
Road Name: BAYRIDGE DR.
Sheet No.: 1 OF 1
Date: 3/14/84
County: MONTGOMERY
State Coordinates:

SCL NEW INV

S4-S
S
83-10

JL
BM

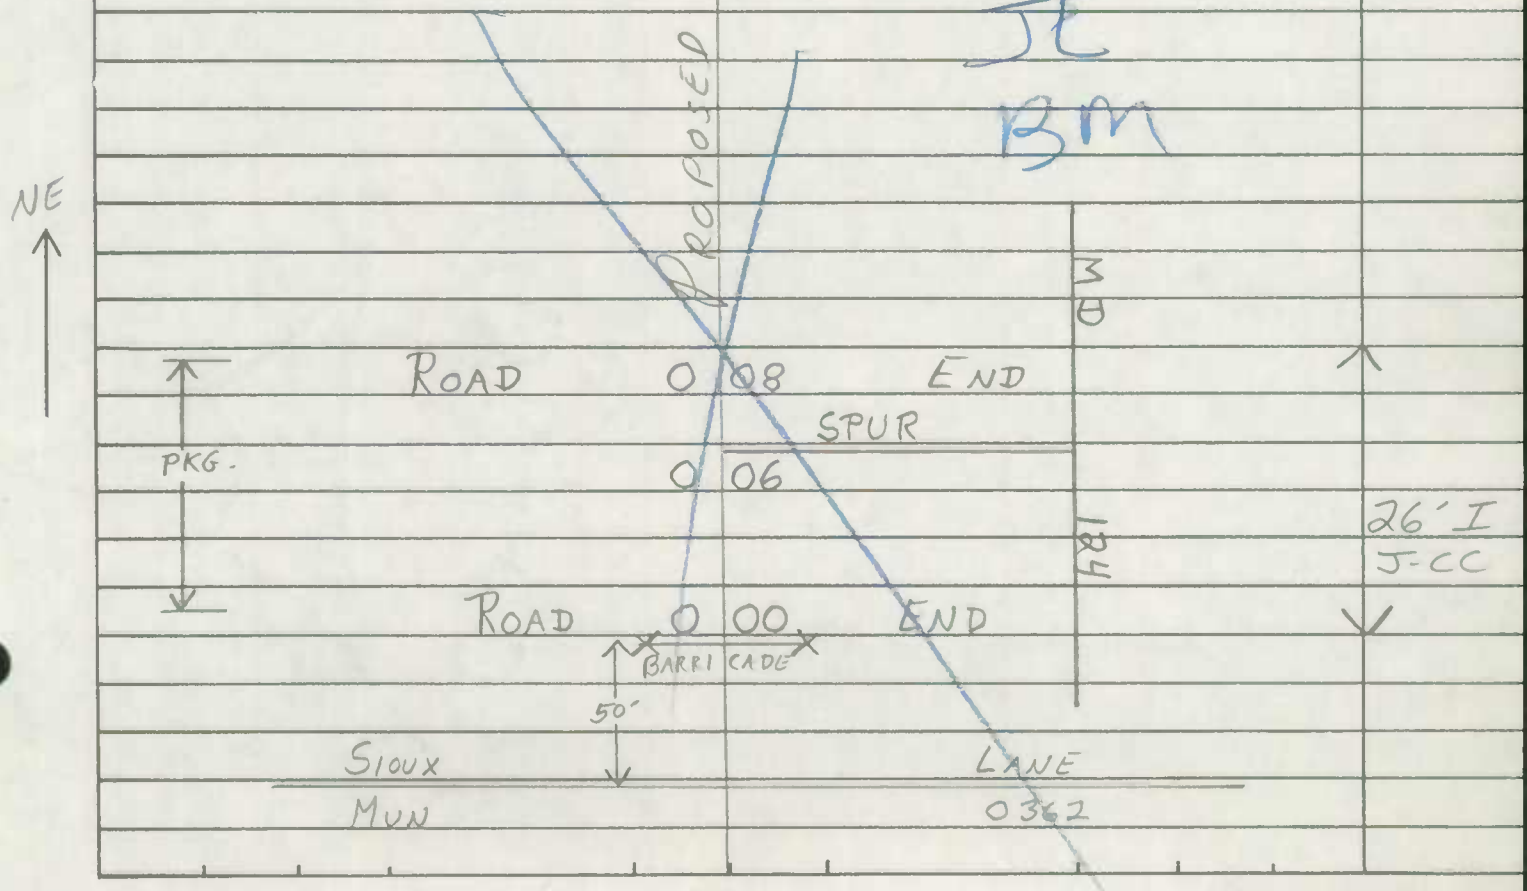

SHA 51.3-8
11-15-72

ROAD INVENTORY SHEET

Road No. _____
Road Name _____
Sheet No. _____
Date _____
County _____
State Coordinates _____

SHA 51.3-8
11-15-72

ROAD INVENTORY SHEET

Party Chief I. LANDON
Recorder M. ZALENSKI
Helper I. ABBOTT

Map No. 26
REV 2-16-77 WD=MZ
MZ-12 4-16-79
78-5 GAITHERSBURG 76-1

Road No. MUN. 0030
Road Name CEDAR AVE.
Sheet No. 1 OF
Date 10-25-73
County MONT.
State Coordinates

W. DEER
MUN
0.76
0.59
PARK RD
0061
0.68
0.51
CHURCH
WINNIE PL
MUN 0435
0.67
0.50
SUMMIT
MUN
0.60
HALL RD
0370
0.54
CHURCH
0.44
0.27
MILLS ST
MUN 0220
JAMES
MUN
0.28
0.21
ST
0180
GEORGE
MUN
0.32
0.15
ST
0130
S. FREDERICK
MD
0.17
0.00
AVE
355
0.07
40°
S. SUMMIT
MUN
0.00
AVE
0360
FAU 5140 COLLECTOR
S
3½'I
√c-c
20'I
23'I
32'I
"J" c-c
36'I
J c-c

SHA 51.3-8
11-15-72

ROAD INVENTORY SHEET

Road No. _____
Road Name _____
Sheet No. _____
Date _____
County _____
State Coordinates _____

urban

SHA 51.3 - 8 Revised
4.83

MARYLAND STATE HIGHWAY ADMINISTRATION

ROAD INVENTORY SHEET ~~OR 5463~~ Mu0038

Party Chief: BB
Recorder: DT
Assistant:
Map No./Dir.: E 10B/W
State Coordinates: 751-479

Road No.: Co 6071
Road Name: Cottage Hill Ct
County: MONT
Date: 10-2-90
Sheet No.: 1 OF 1

Gaithersburg
90-220 (mun)
90-236 (co)

TRAFFIC CODES

TRAFFIC CONTROLS: STOP SIGN=S.S., TRAFFIC LIGHT=T.L., FLASHING RED BALL=F.R.

PARKING RESTRICTIONS: A.M. PEAK, P.M. PEAK, A.M./P.M. PEAK, NO PARKING ANYTIME=N.P., COMM/IND. ACCESS=E

SYSTEM				TRAFFIC		LINE DIAGRAM	TRAFFIC			PAVEMENT DATA
FED. AID.	FUNCT CLASS	HWY. SYS.	HPMS SAMPLE	PK.G. REST.	COM/IND. ACCESS		CONTROL	COM/IND. ACCESS	PK.G. REST.	

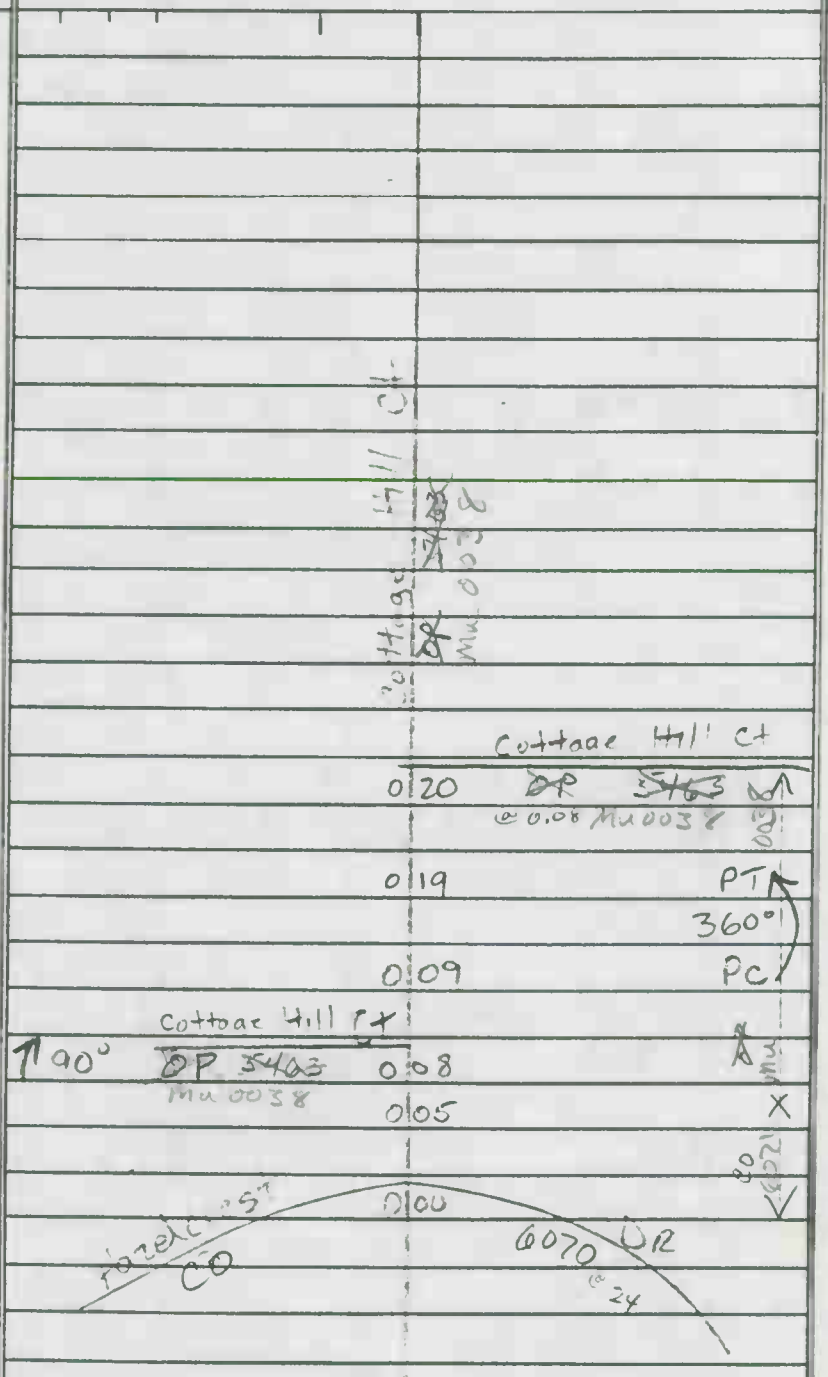

24 'I
J-CC

SHA 51.3 - 8 Revised
4.83

MARYLAND STATE HIGHWAY ADMINISTRATION

Gaithersburg

ROAD INVENTORY SHEET

Party Chief WB
Recorder CG
Assistant
Map No./Dir. 15
State Coordinates GAITHERSBURG

Road No. MU 0040
Road Name CHESTNUT ST.
County MONT.
Date 4-7-88
Sheet No. 1 OF 1

87-5
EXTRA

TRAFFIC CODES
TRAFFIC CONTROLS: STOP SIGN=SS, TRAFFIC LIGHT=T.L., FLASHING RED BALL=F.R.

TRAFFIC CODES
PARKING RESTRICTIONS: A.M. PEAK, P.M. PEAK, A.M./P.M. PEAK, NO PARKING ANYTIME=N.P., COMM/IND. ACCESS=E

SYSTEM				TRAFFIC		LINE DIAGRAM	TRAFFIC			PAVEMENT DATA
FED. AID.	FUNCT CLASS.	HWY. SYS.	HPMS SAMPLE	PKG. REST.	COM/IND. ACCESS		CONTROL	COM/IND. ACCESS	PKG. REST.	
						RD				
						MUDDY BRANCH				
						W. DIAMOND AVE				
A	A					022				
						MD 117	T.L.			
					E	013				
						MEEM AVE				31' I
						MU 0210				5 C-C
						027			X	2 ML
						006 140509W				44' I
										ON TAPER TO 31' I
										5 C-C
									X	2 ML
						025 ENT TO FAIRFIELD				
										44' I
										5 C-C
										2 ML
V	V					E. DIAMOND AVE. MD 124				
						000 MCGAIN AVE OP 5331				
						ST. 144				
						CHESTNUT MD				

NON F/A
URBAN collector

SYSTEM				TRAFFIC		LINE DIAGRAM	TRAFFIC				PAVEMENT DATA
FED. AID.	FUNCT. CLASS.	HWY. SYS.	HPMS SAMPLE	PRKG. REST.	COM/IND ACCESS		CONTROL	COM/IND ACCESS	PRKG. REST.		

SHA 51.3-8
11-15-72

ROAD INVENTORY SHEET

Party Chief T. Landon
Recorder M. Zaleski
Helper T. Hoot

Map No. 26B

Road No. MUN 0040
Road Name CHESTNUT ST
Sheet No. 1 of 1
Date 10-25-23
County Mont.
State Coordinates 745 - 477

Gaithersburg

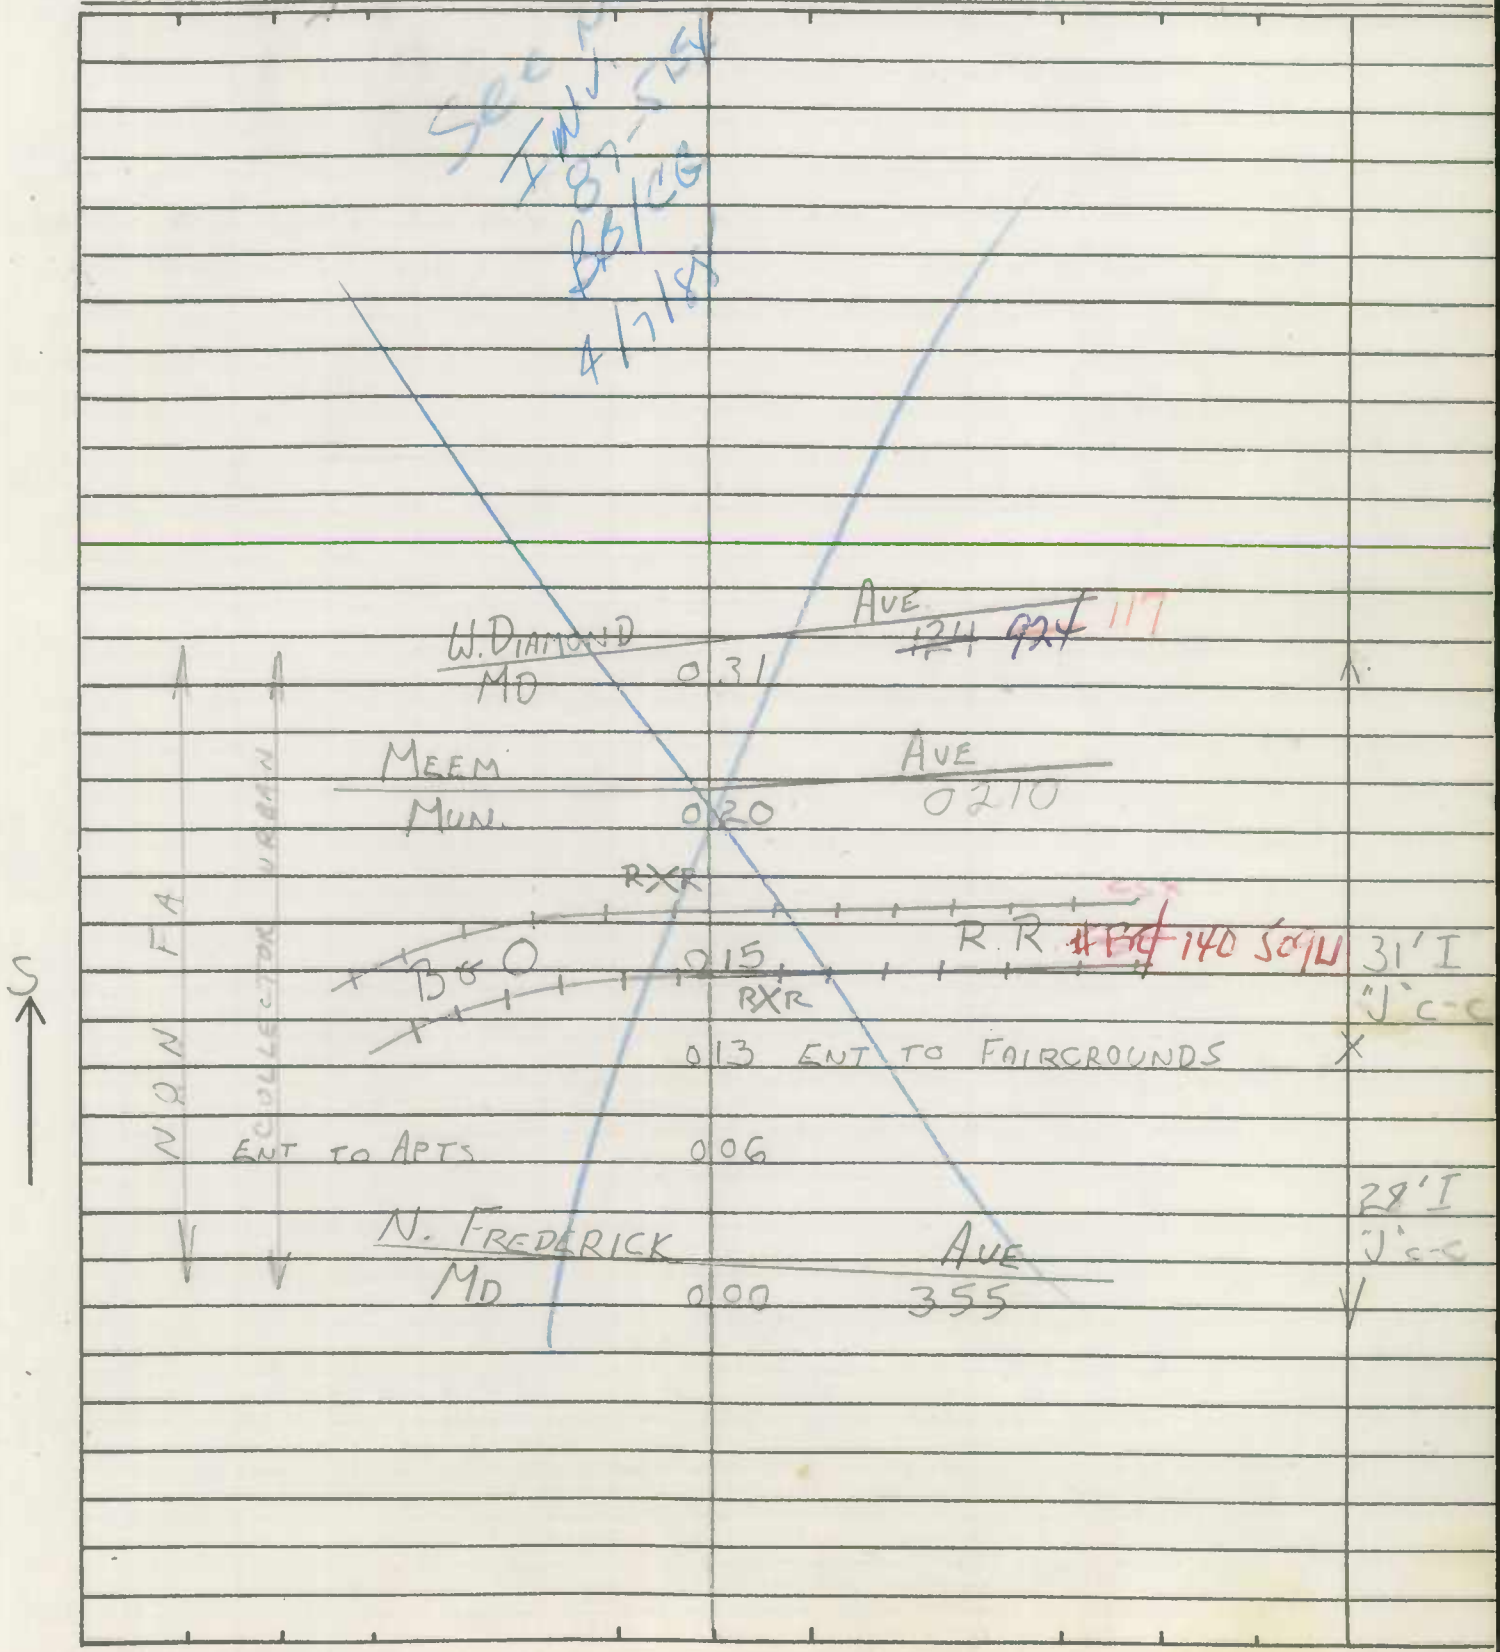

SHA 51.3-8
11-15-72

ROAD INVENTORY SHEET

Road No. _____
Road Name _____
Sheet No. _____
Date _____
County _____
State Coordinates _____

MUN IMP
85-16
JE
MB
4/8/85

1-15-72

ROAD INVENTORY SHEET CO 4863

Party Chief T. LANDON
Recorder M. ZALENSKI
Helper T. ABBOTT

Map No. 26A+B

Road No. MUN. 0043
Road Name CHRISTOPHER AVE
Sheet No. 1 of 1
Date 10-24-73
County MONT.
State Coordinates 744-482

N. Hagerstown N. Jct. RTE-1 4/19

LOT CO

MONTGOMERY CO 3727

0 76 VILLAGE AVE → 3727

72

69

PT 30° PC

HELLINGLY PL
ENT TO APTS

0 64

Corp Limits — Gaithersburg

52

0 49

0 47 ~~END~~ ENT APTS

2 43

ENT APTS

0 40 ENT APTS

0 38

PT 30° PC

0 29

RUSSELL AVE 0 19
MD 0339

16

PKG LOT 0 12

SPUP 0.02 16'I "J" c-c

N. FREDERICK MD.

0 01

AVE. 355

0 00

CO 4863 80-92

2 26'I
J c-c
71' CL MED

2-24'I
J c-c
20' CONC MED

55

24'I
"J" c-c

SHA 51.3-8
11-15-72

ROAD INVENTORY SHEET MUN 0060

Party Chief T LANDON
Recorder W ZALESKI
Helper T [illegible]

Road No. Co 3138
Road Name E DEER PARK DR
Sheet No. 1 of 1
Date 10-25-73
County MONT.
State Coordinates

Map No. 26 REV. 3-8-76

91-30 A/T

GAITHERSBURG

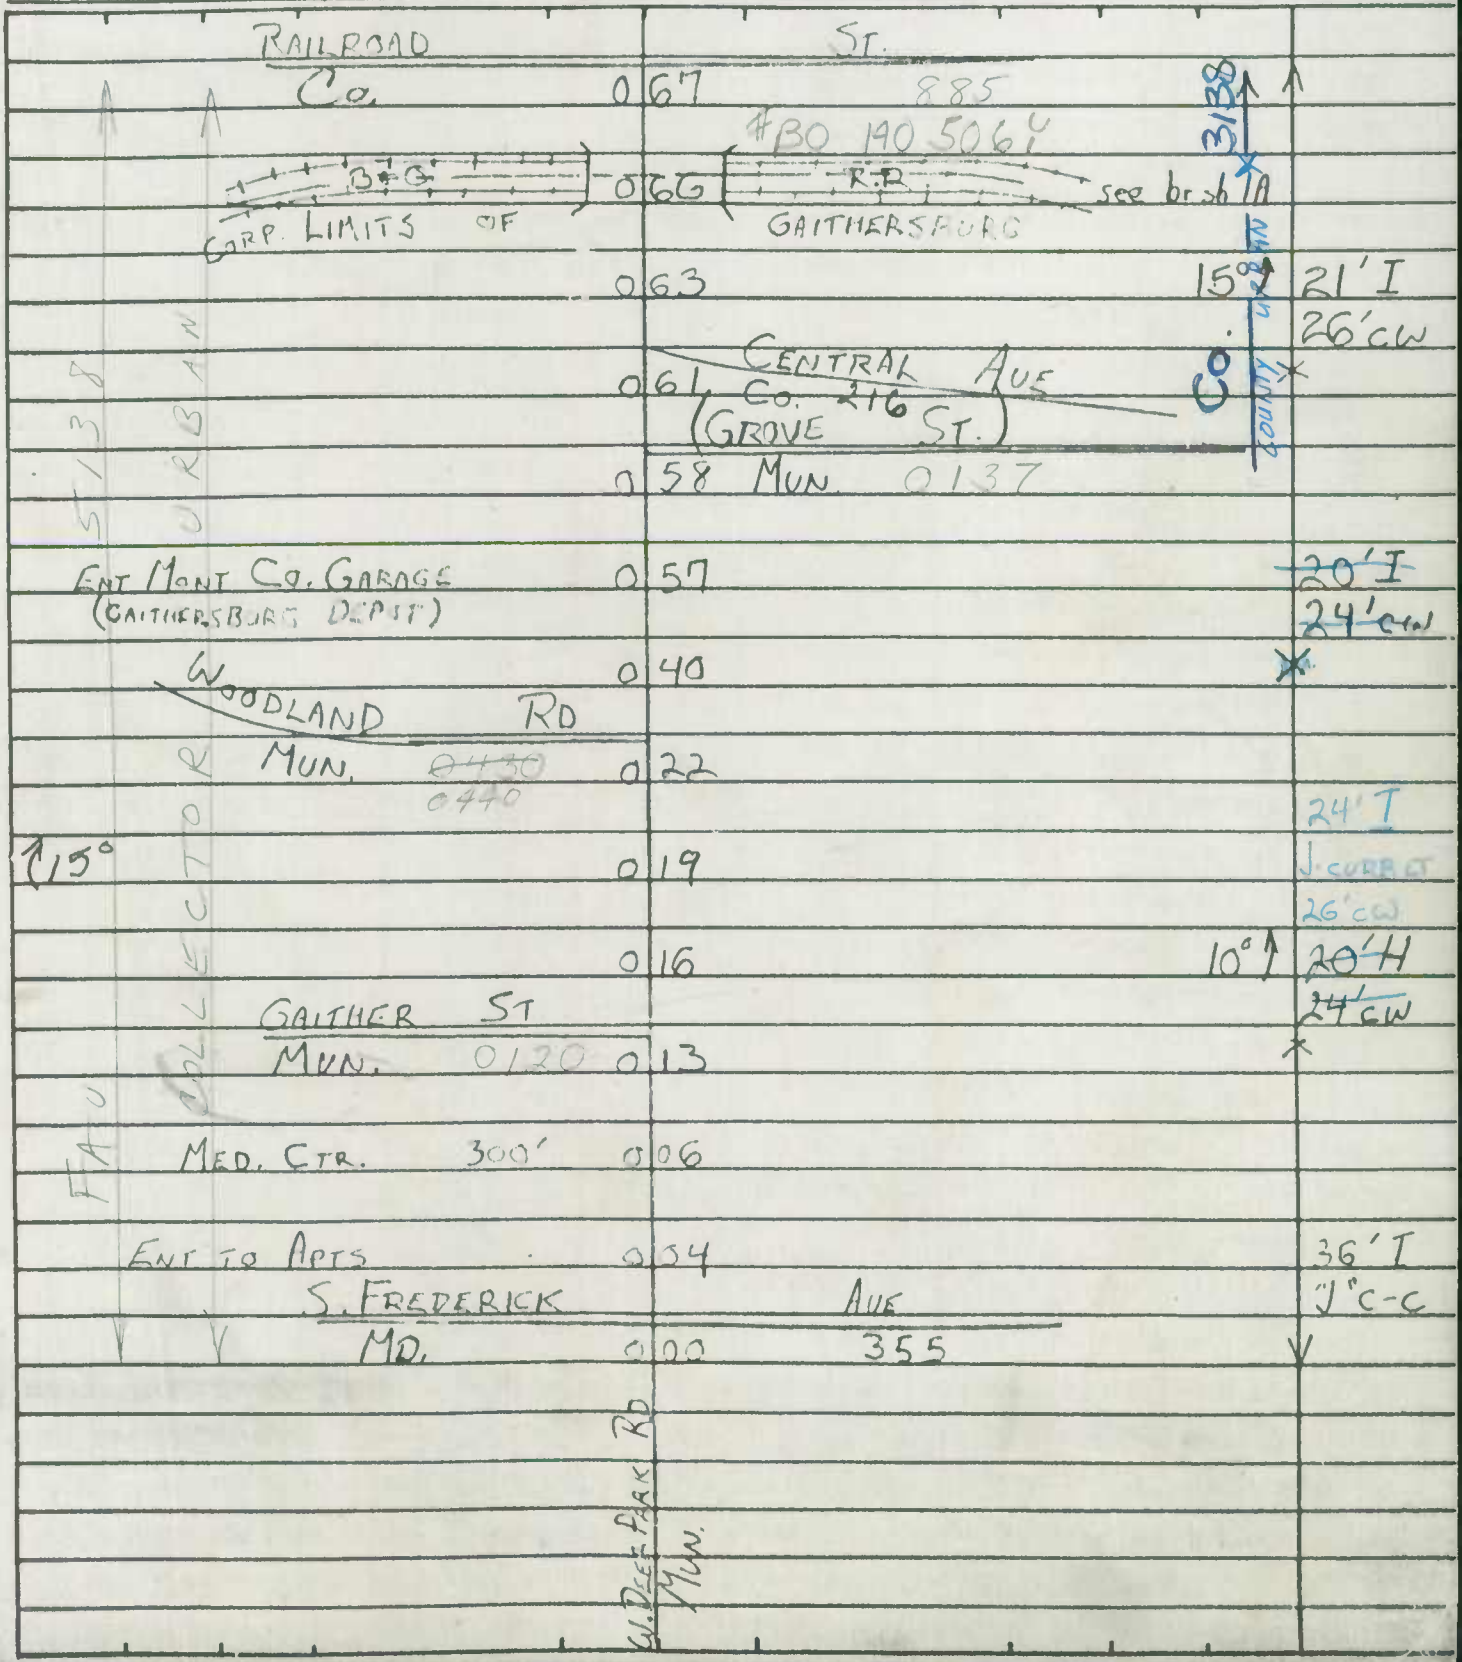

Form 6 HPS (Rev. 1961)

2000 mu Ex 9
SS/AO
2-13-01

ROAD INVENTORY SHEET

Party Chief FR
Recorder JE
Helper

Road No. MU 0064
Road Name DEER PARK LA
Sheet No. 1 of 1
Date 3-5-8
County MONT

Gaithersburg
79-15 79-17 EXTRA

SEE written NEW INVENTORY 2/23/01 SS/AO 2000 mu Ex 9

SWIMING POOL

ROAD END

0 X620

BRALAN LN

15° MUN 0019 0176

(BRAXU CT) MU 0013 0172

46' I JC-C

T20° 009

DEER PARK WAY 0067 MU 0067

76' I JC-C

S

DEER PARK RD MU 0061

0006 SS

T30° 002

32' I JC-C

CUL 000 SAC

D E

Form 6 HPS (Rev. 1961)

ROAD INVENTORY SHEET

Road No. _____
Road Name _____
Sheet No. _____
Date _____
County _____

SHA 51.3-8
11-15-72

ROAD INVENTORY SHEET

Party Chief J. LANDON
Recorder M. ZALENSKI
Helper J. ABBOTT

Map No. 26

GAITHERSBURG

Road No. MUNI 0064
Road Name DEER PARK LA.
Sheet No. 1 OF 1
Date 10-25-23
County MONT.
State Coordinates

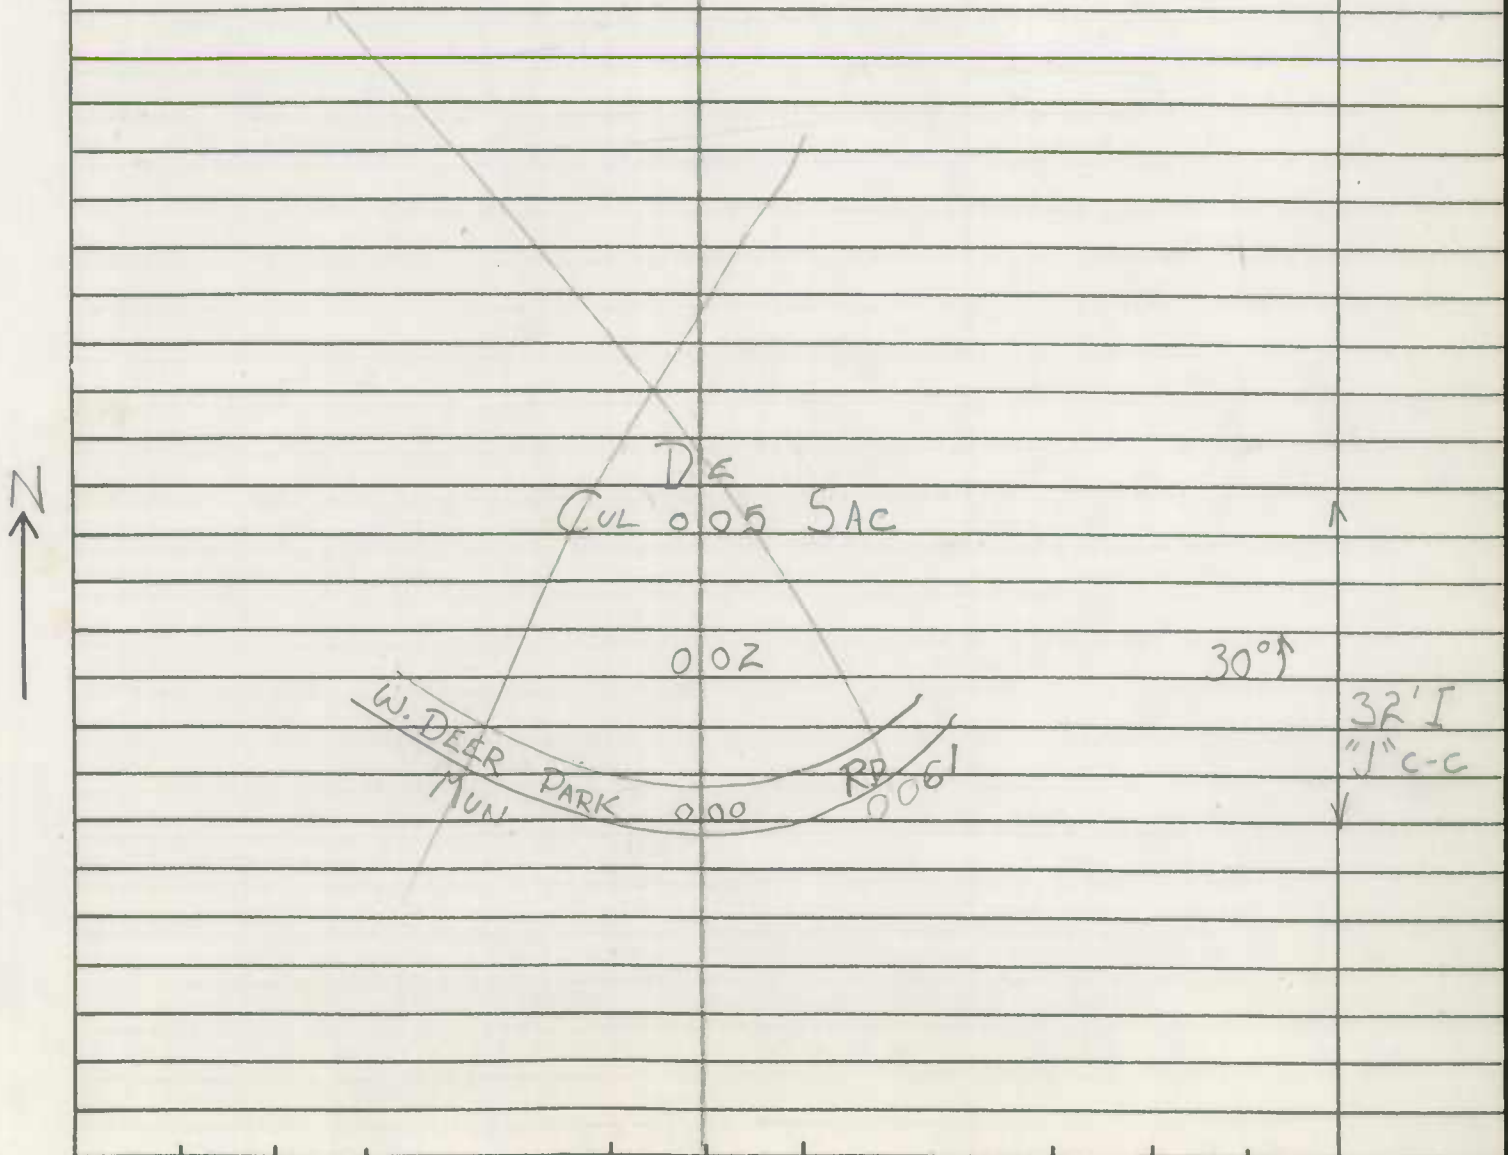

SHA 51.3-8
11-15-72

ROAD INVENTORY SHEET

Road No. _____
Road Name _____
Sheet No. _____
Date _____
County _____
State Coordinates _____

SHA 51.3-8
- 11-15-72

ROAD INVENTORY SHEET

mon 0087

Party Chief T. [illegible]
Recorder M. [illegible]
Helper

Map No. 56

79-3 FE 3-6-80

Road No. Co 2302
Road Name EDGEWOOD DR
Sheet No. 1 - 1
Date 1-17-
County Mont
State Coordinates 748-470

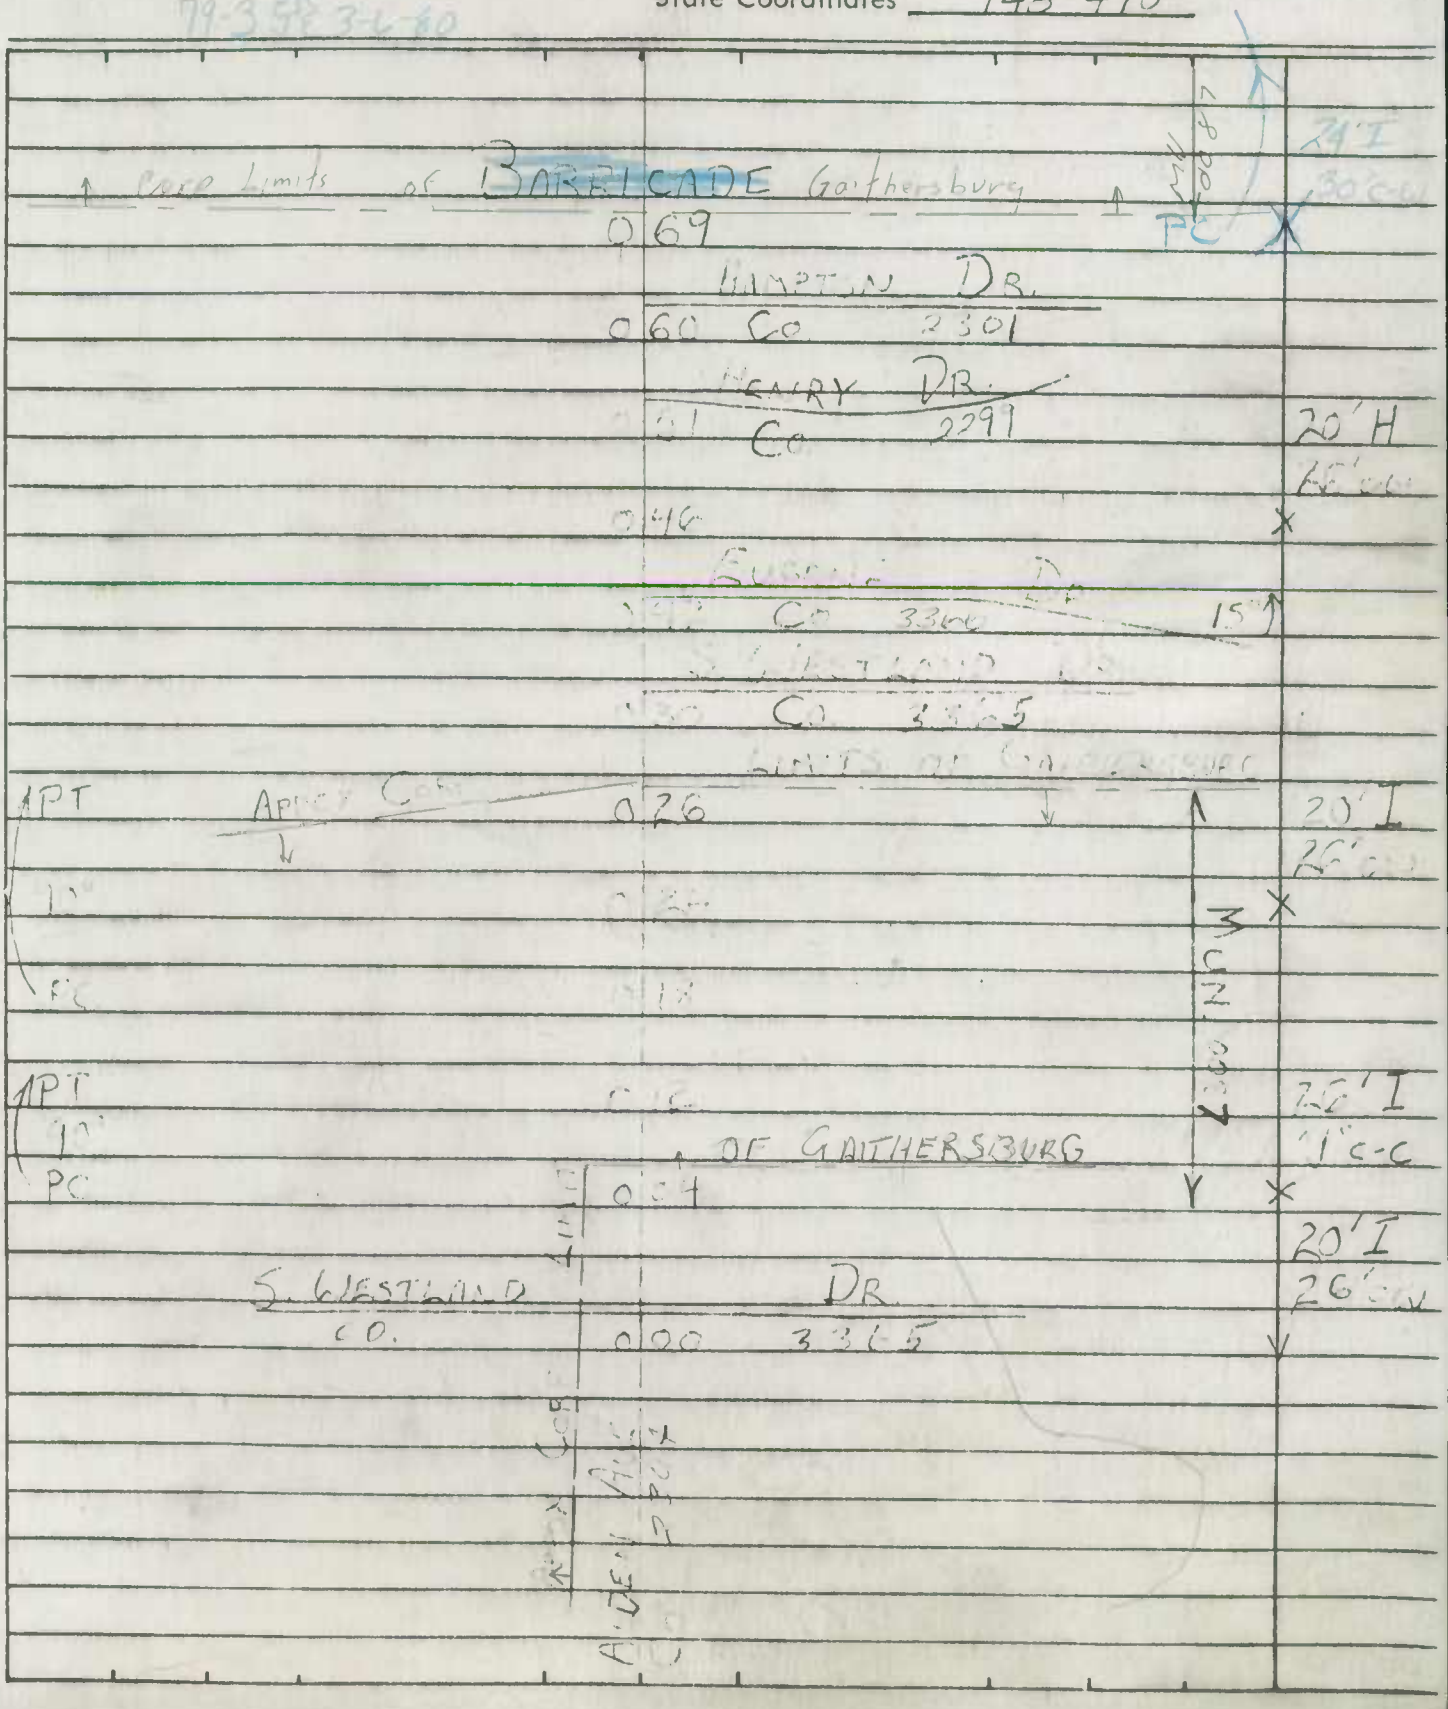

SHA 51.3-8
11-15-72

STATE HIGHWAY ADMINISTRATION OF MARYLAND

ROAD INVENTORY SHEET

Party Chief FR
Recorder JE
Helper

Road No. MU 0087
Road Name EDGEWOOD DR
Sheet No. 2 of 2 3
Date 3-6-80
County MONT
State Coordinates

Map No. 79-3 Gaithersburg

W

D E
CUL 0.96 SAC

0.82 90°

0.75 PT 90° SAME

SHA 51.3-8
11-15-72

ROAD INVENTORY SHEET

Road No. _____
Road Name _____
Sheet No. _____
Date _____
County _____
State Coordinates _____

SHA 51.3-8
11-15-72

STATE HIGHWAY ADMINISTRATION OF MARYLAND

ROAD INVENTORY SHEET

Party Chief T. LANDON
Recorder F. RHODES
Helper

Map No. GAITHERSBURG 77-12

79-2 FR TE 3-7-80

Road No. MUN. 0095
Road Name FIRSTFIELD RD.
Sheet No. 1 OF 1
Date 2/24/78
County MONT.
State Coordinates

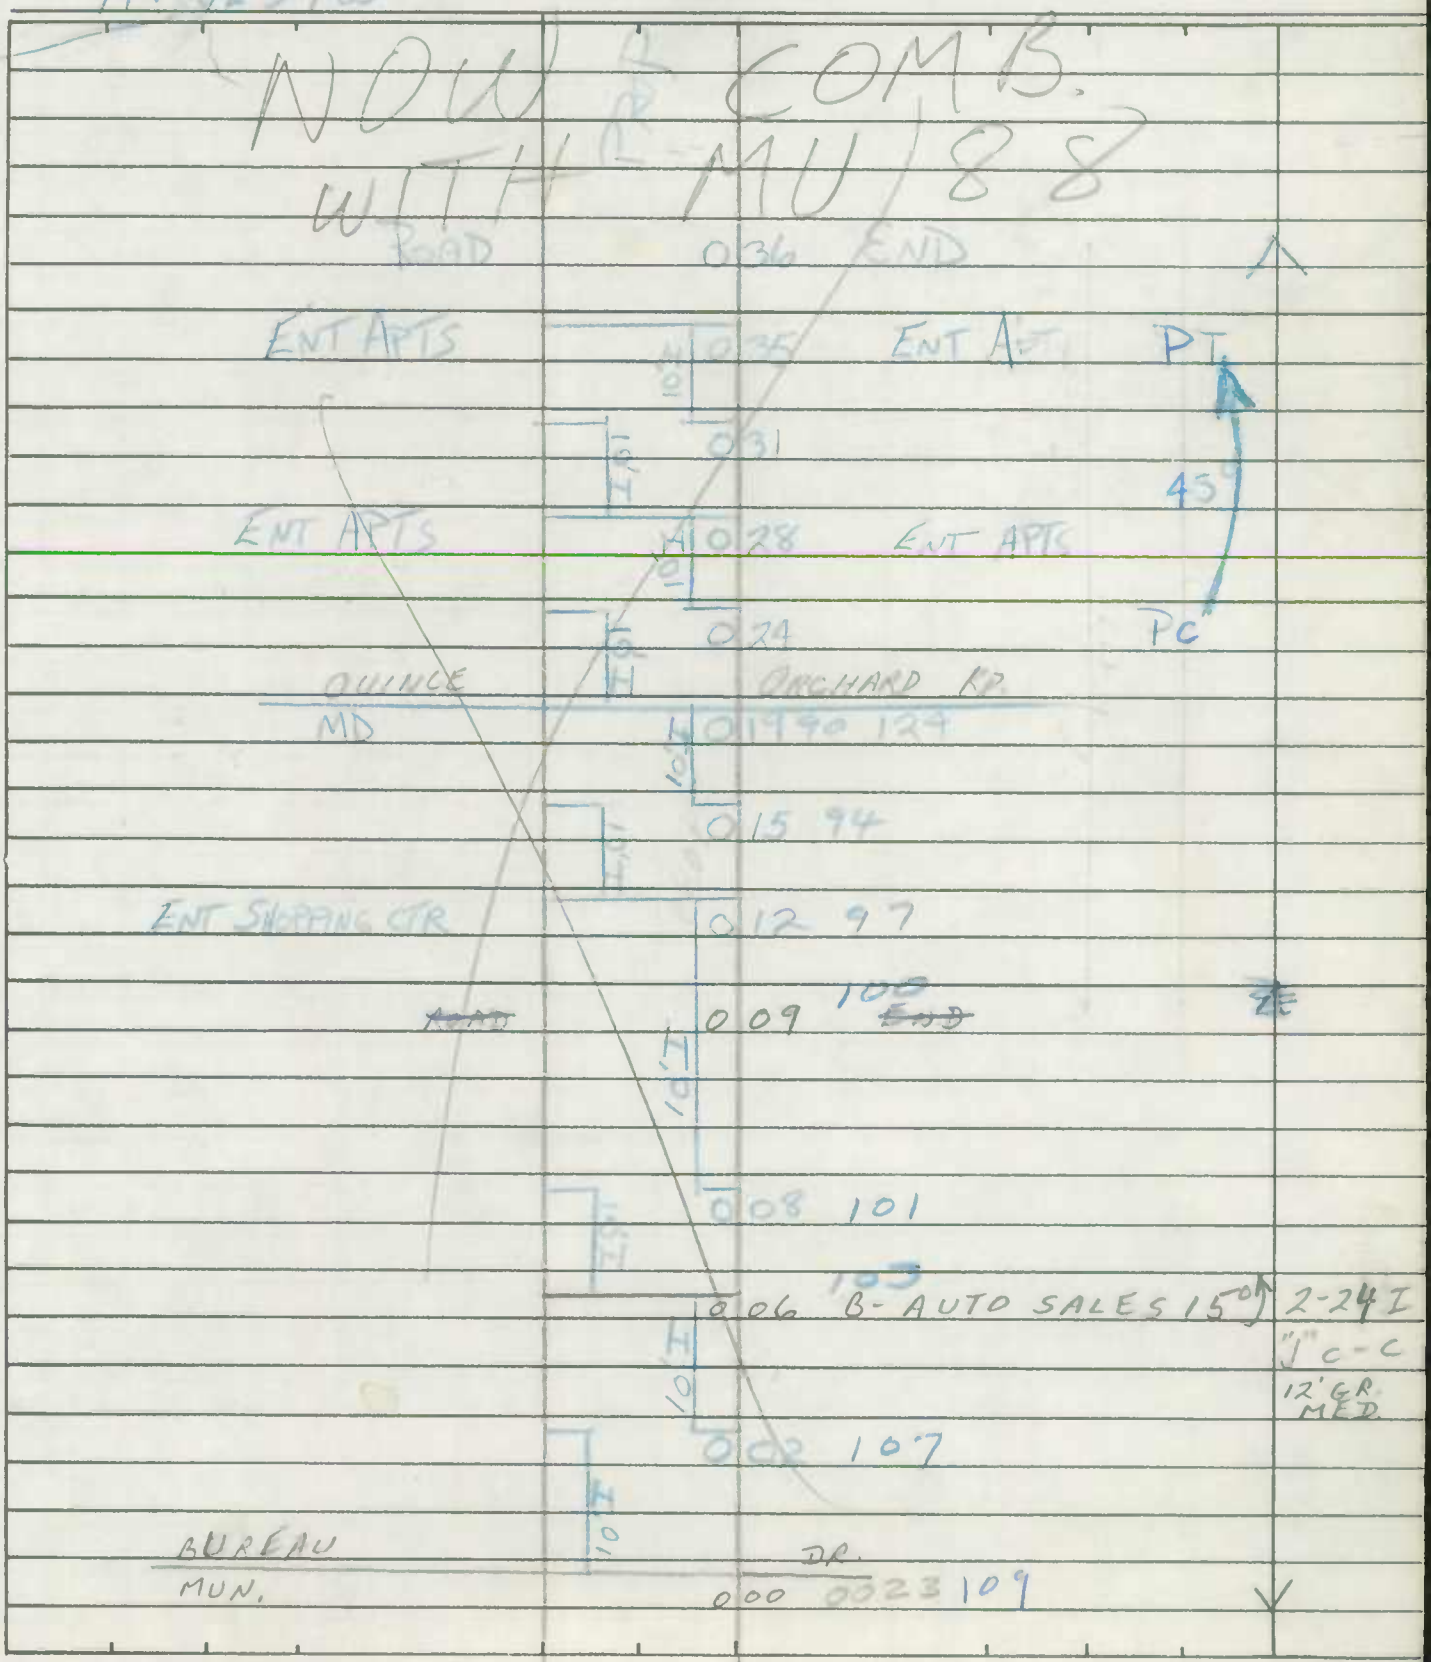

SHA 51.3-8
11-15-72

ROAD INVENTORY SHEET

Road No. _____
Road Name _____
Sheet No. _____
Date _____
County _____
State Coordinates _____

SHA 51.3 - 8 Revised
4.83

Gaithersburg
90-21

MARYLAND STATE HIGHWAY ADMINISTRATION

ROAD INVENTORY SHEET

Party Chief A Lijewski
Recorder J Klausing
Assistant
Map No./Dir. / E
State Coordinates

Road No. mu 0119
Road Name Gaither Rd
County Montgomery
Date 02-19-91
Sheet No. 1 OF 1

TRAFFIC CODES

TRAFFIC CONTROLS: STOP SIGN=S.S., TRAFFIC LIGHT=T.L., FLASHING RED BALL=F.R.

PARKING RESTRICTIONS: A.M. PEAK, P.M. PEAK, A.M./P.M. PEAK, NO PARKING ANYTIME=N.P., COMM/IND. ACCESS=E

SYSTEM				TRAFFIC		LINE DIAGRAM	TRAFFIC			PAVEMENT DATA
FED. AID.	FUNCT CLASS	HWY. SYS.	HPMS SAMPLE	PRKG. REST.	COM/IND. ACCESS		CONTROL	COM/IND. ACCESS	PRKG. REST.	
						Gaither Rd 213				
						003				52' I J c-c
						002				116' I J c-c
						CUL SAC				
K	K			E		U.P.S. 000 D E ENT. TO U.P.S.				

College Creek FAU 5139

SYSTEM				TRAFFIC		LINE DIAGRAM	TRAFFIC			PAVEMENT DATA
FED. AID.	FUNCT. CLASS.	HWY. SYS.	HPMS SAMPLE	PRK.G. REST.	COM/IND ACCESS		CONTROL	COM/IND ACCESS	PRK.G. REST.	

SHA 51.3-8
11-15-72

STATE HIGHWAY ADMINISTRATION OF MARYLAND

ROAD INVENTORY SHEET MU 0125

Party Chief BB
Recorder IR
Helper

Road No. ~~CO 5074~~
Road Name GAME PRESERVE RD.
Sheet No. 1 OF 1
Date 3-10-83
County MONT.
State Coordinates 738- 485

Map No. 26A

NOTE: OLD SECT. CO. 221 GAITHERSBURG

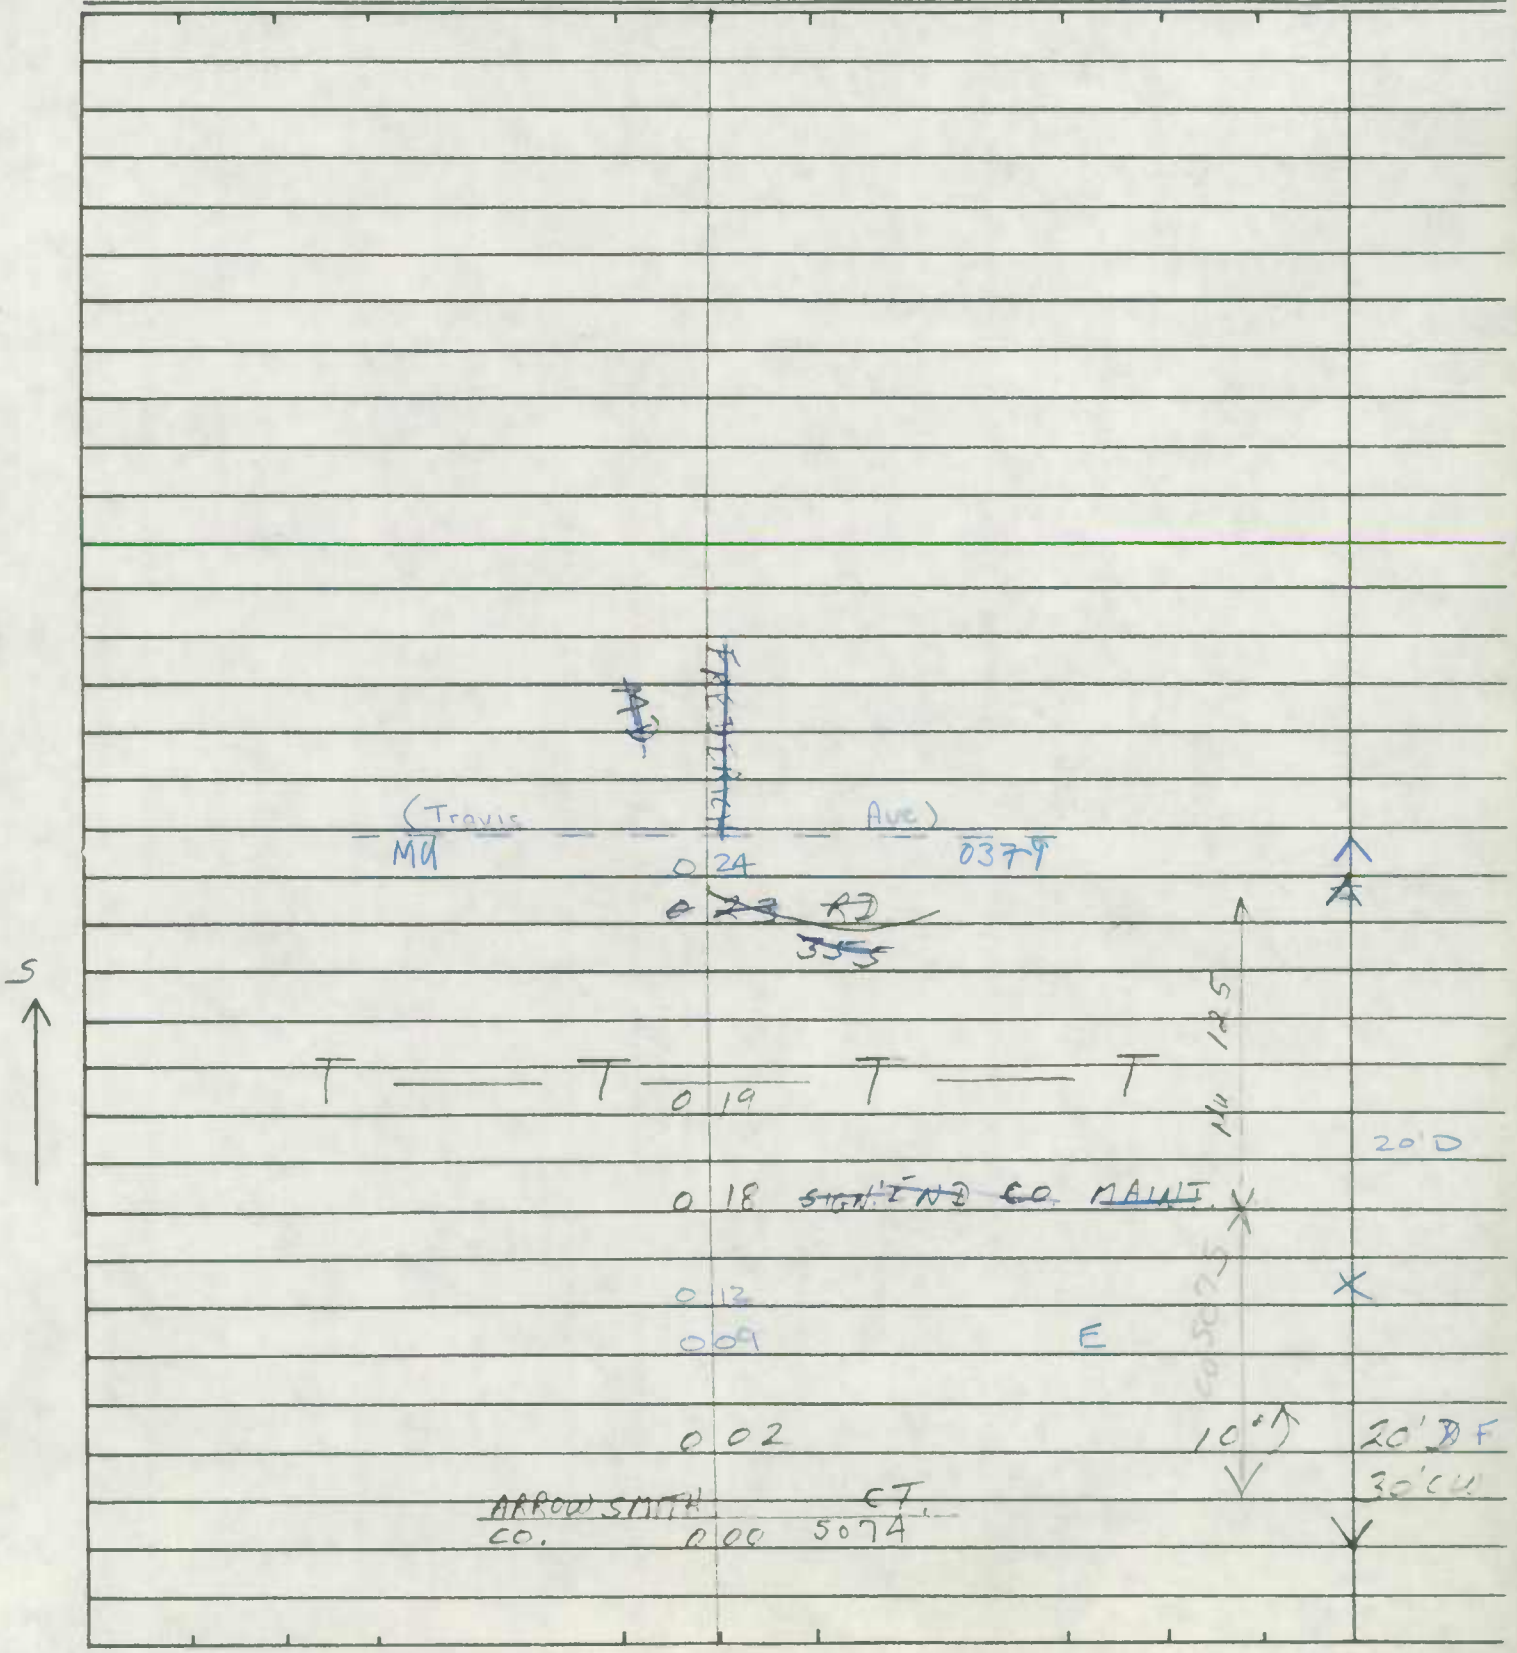

SHA 51.3-8
11-15-72

ROAD INVENTORY SHEET

MUN 0125

Party Chief I. LANDON
Recorder H ZALENSKI
Helper

Map No. 26

Road No. C 221
Road Name GAME PRESERVE RD
Sheet No. 3 OF 3
Date 9-28-73
County MONT
State Coordinates

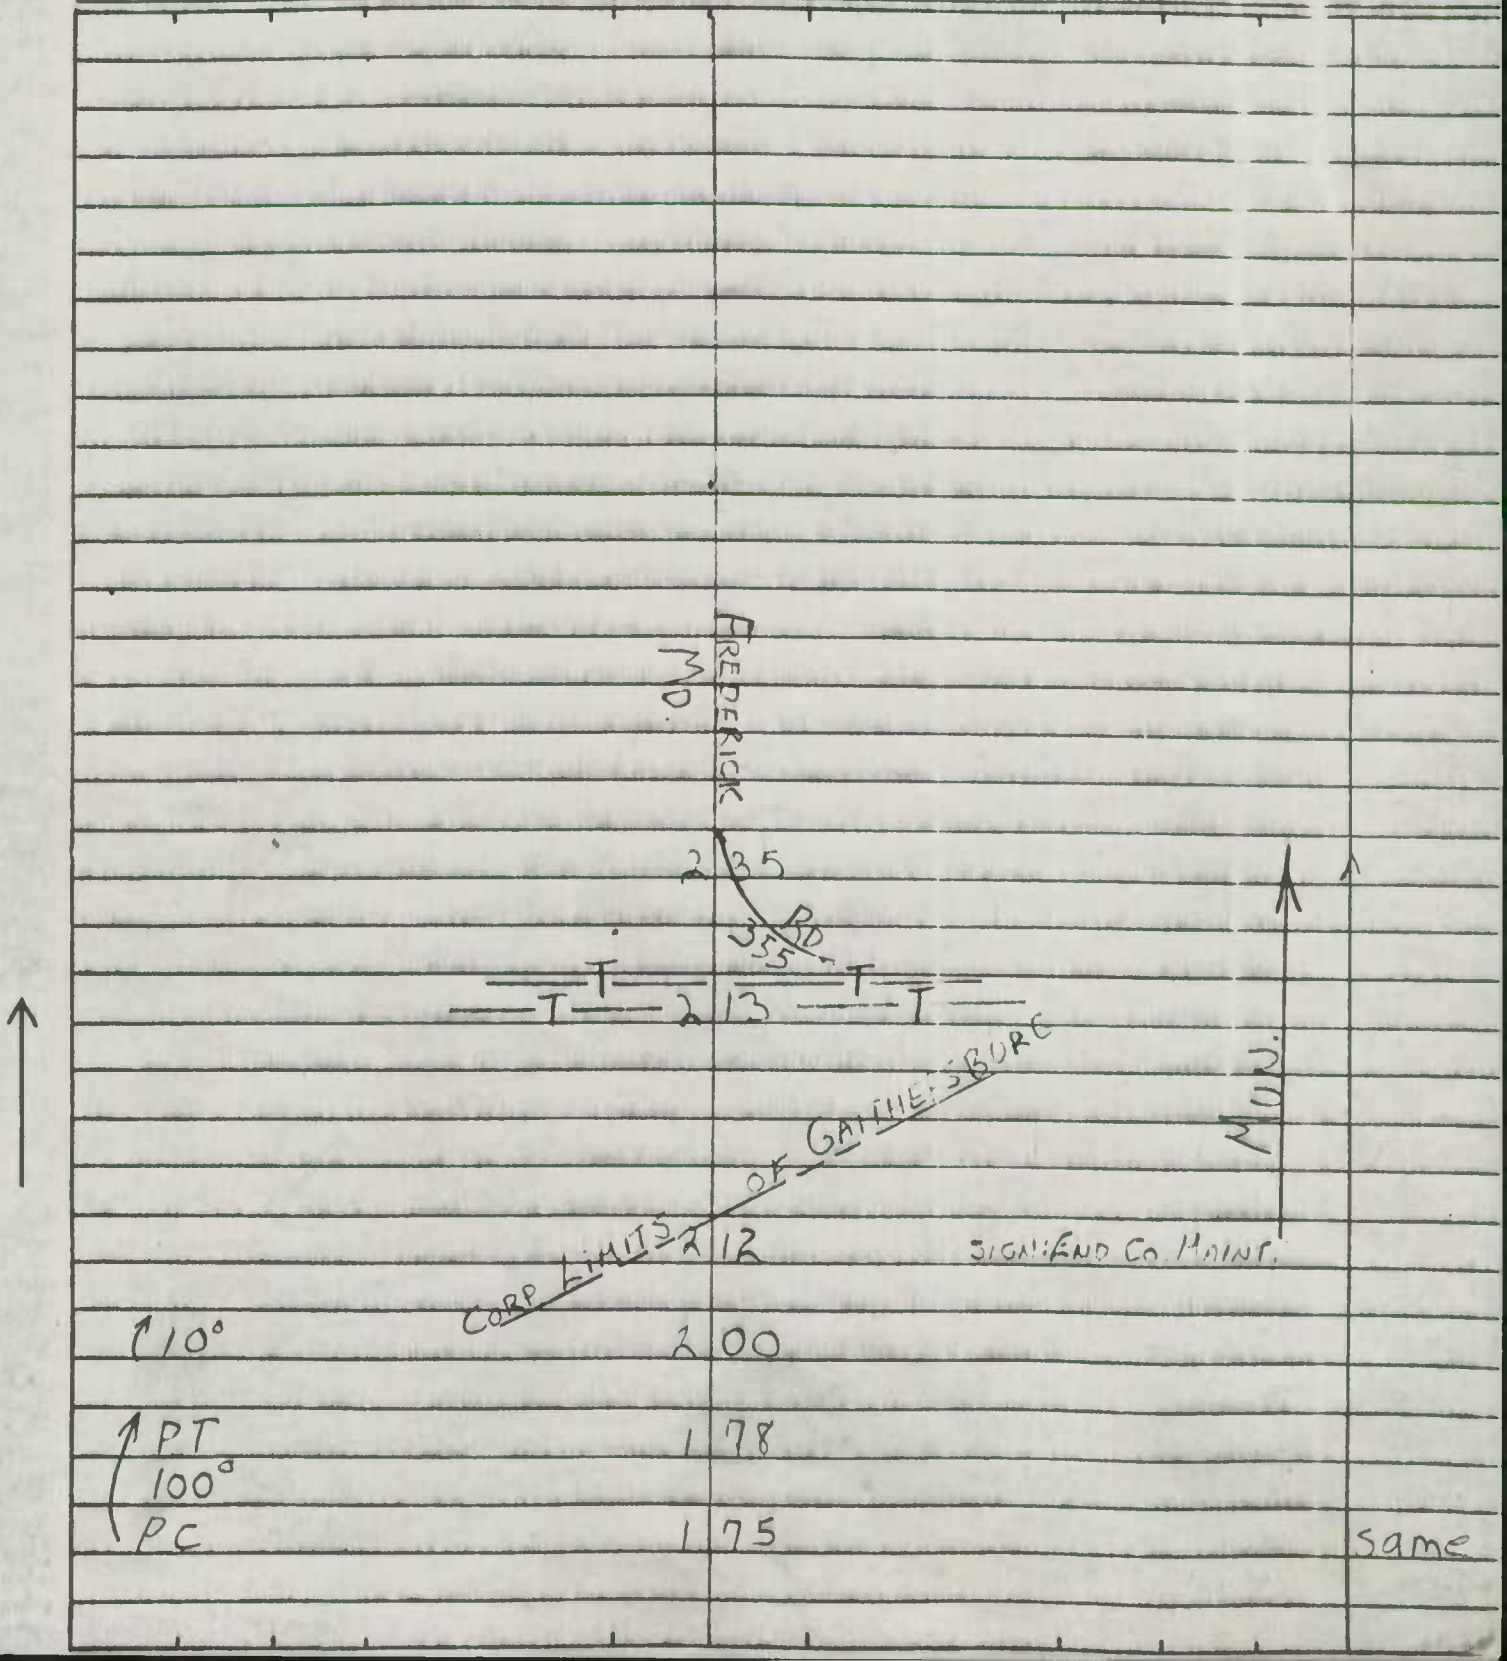

SHA 51.3-8
11-15-72

ROAD INVENTORY SHEET

Party Chief T. LAWLON
Recorder T. ABBOTT
Helper

Map No. 26

GAITHERSBURG 79-1 FT JC 3-5-80

Road No. MUN. 0135
Road Name GIRARD ST.
Sheet No. 1 of 2
Date 11-16-73
County MONT.
State Coordinates

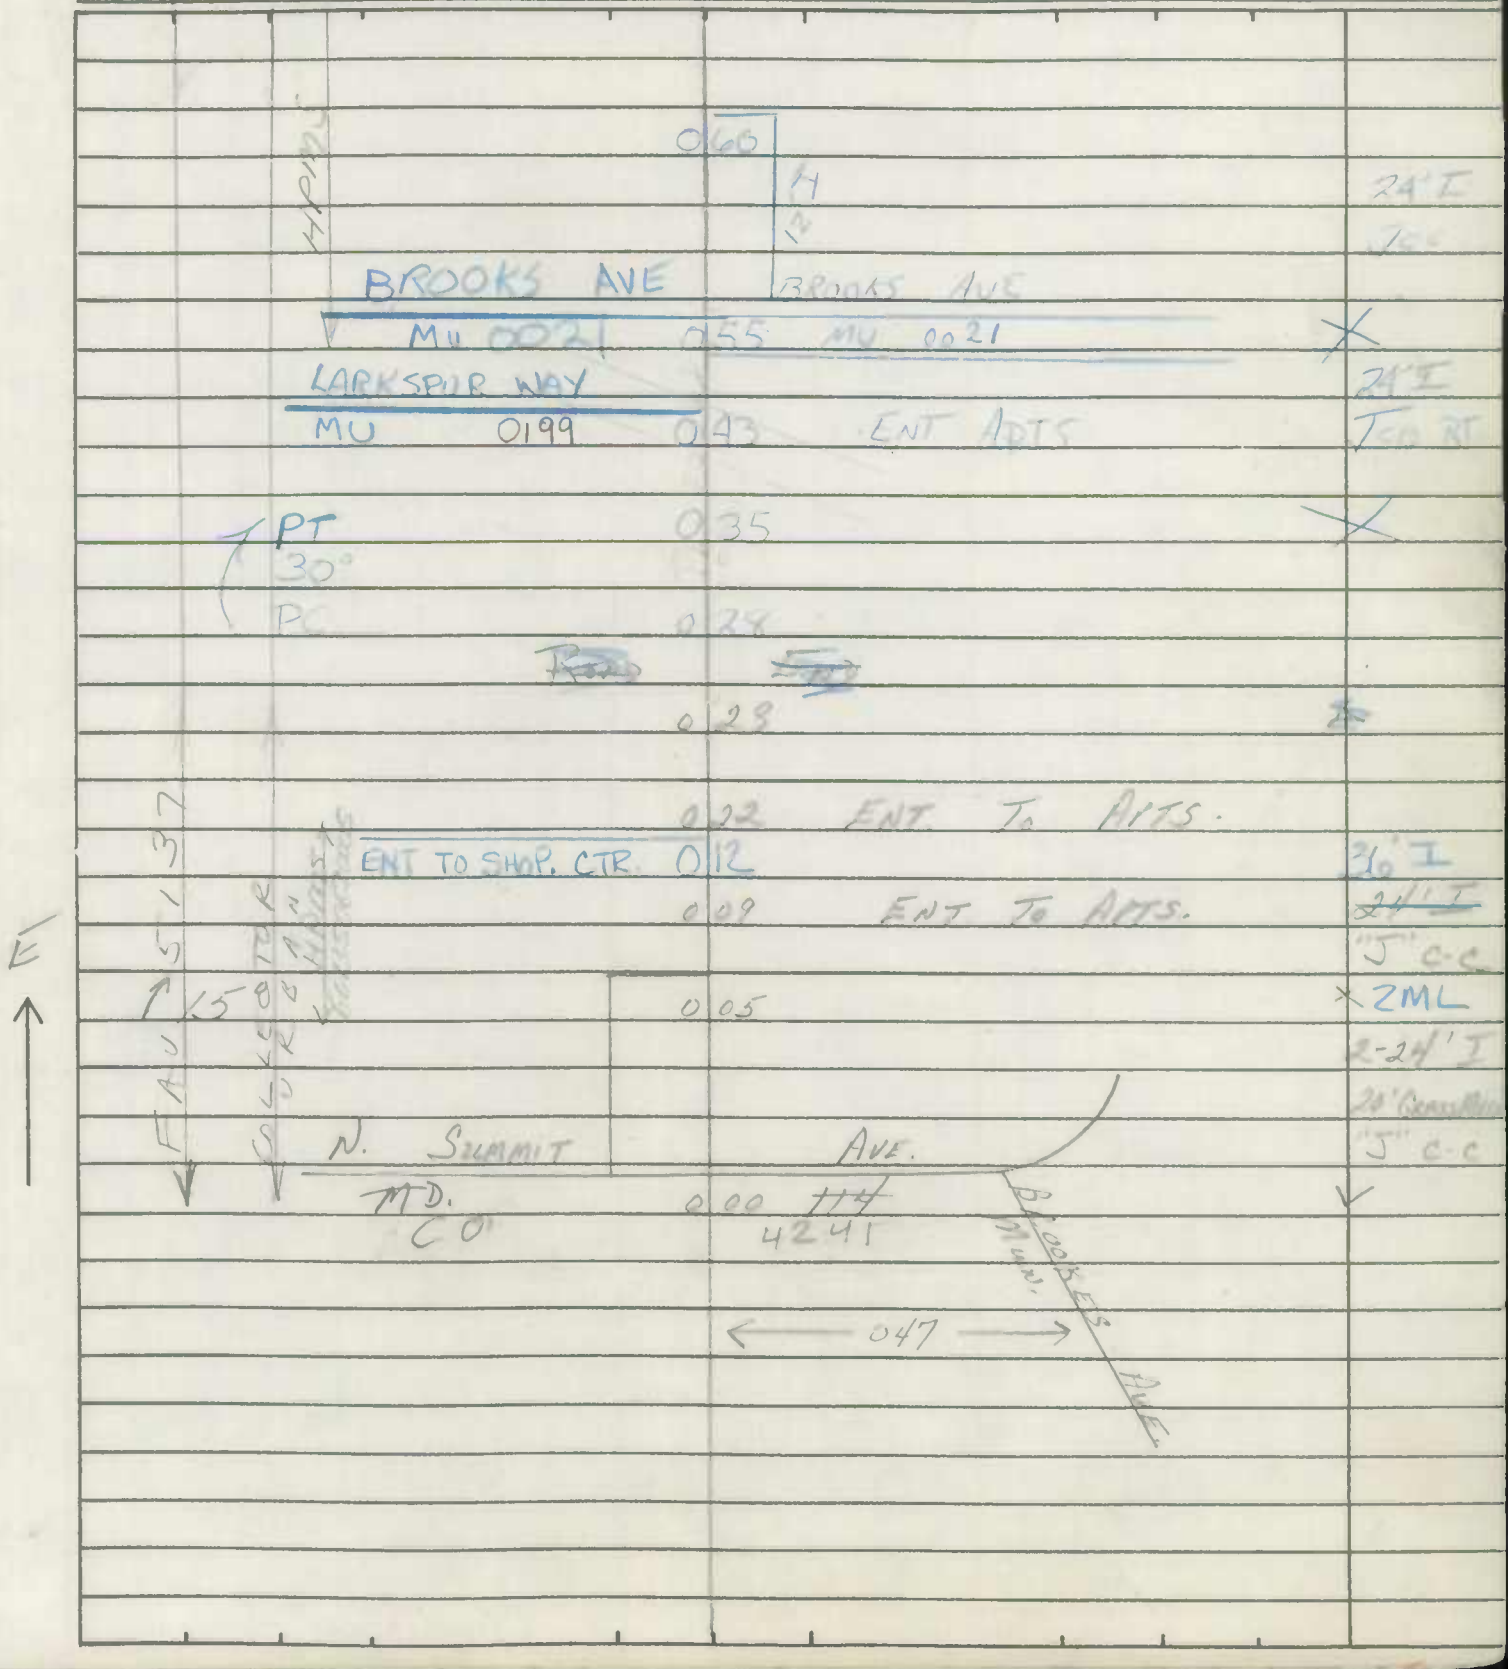

SHA 51.3-8
11-15-72

ROAD INVENTORY SHEET

Road No. _____
Road Name GIRRARD ST
Sheet No. 2 of 2
Date 3-5-80
County MONT
State Coordinates _____

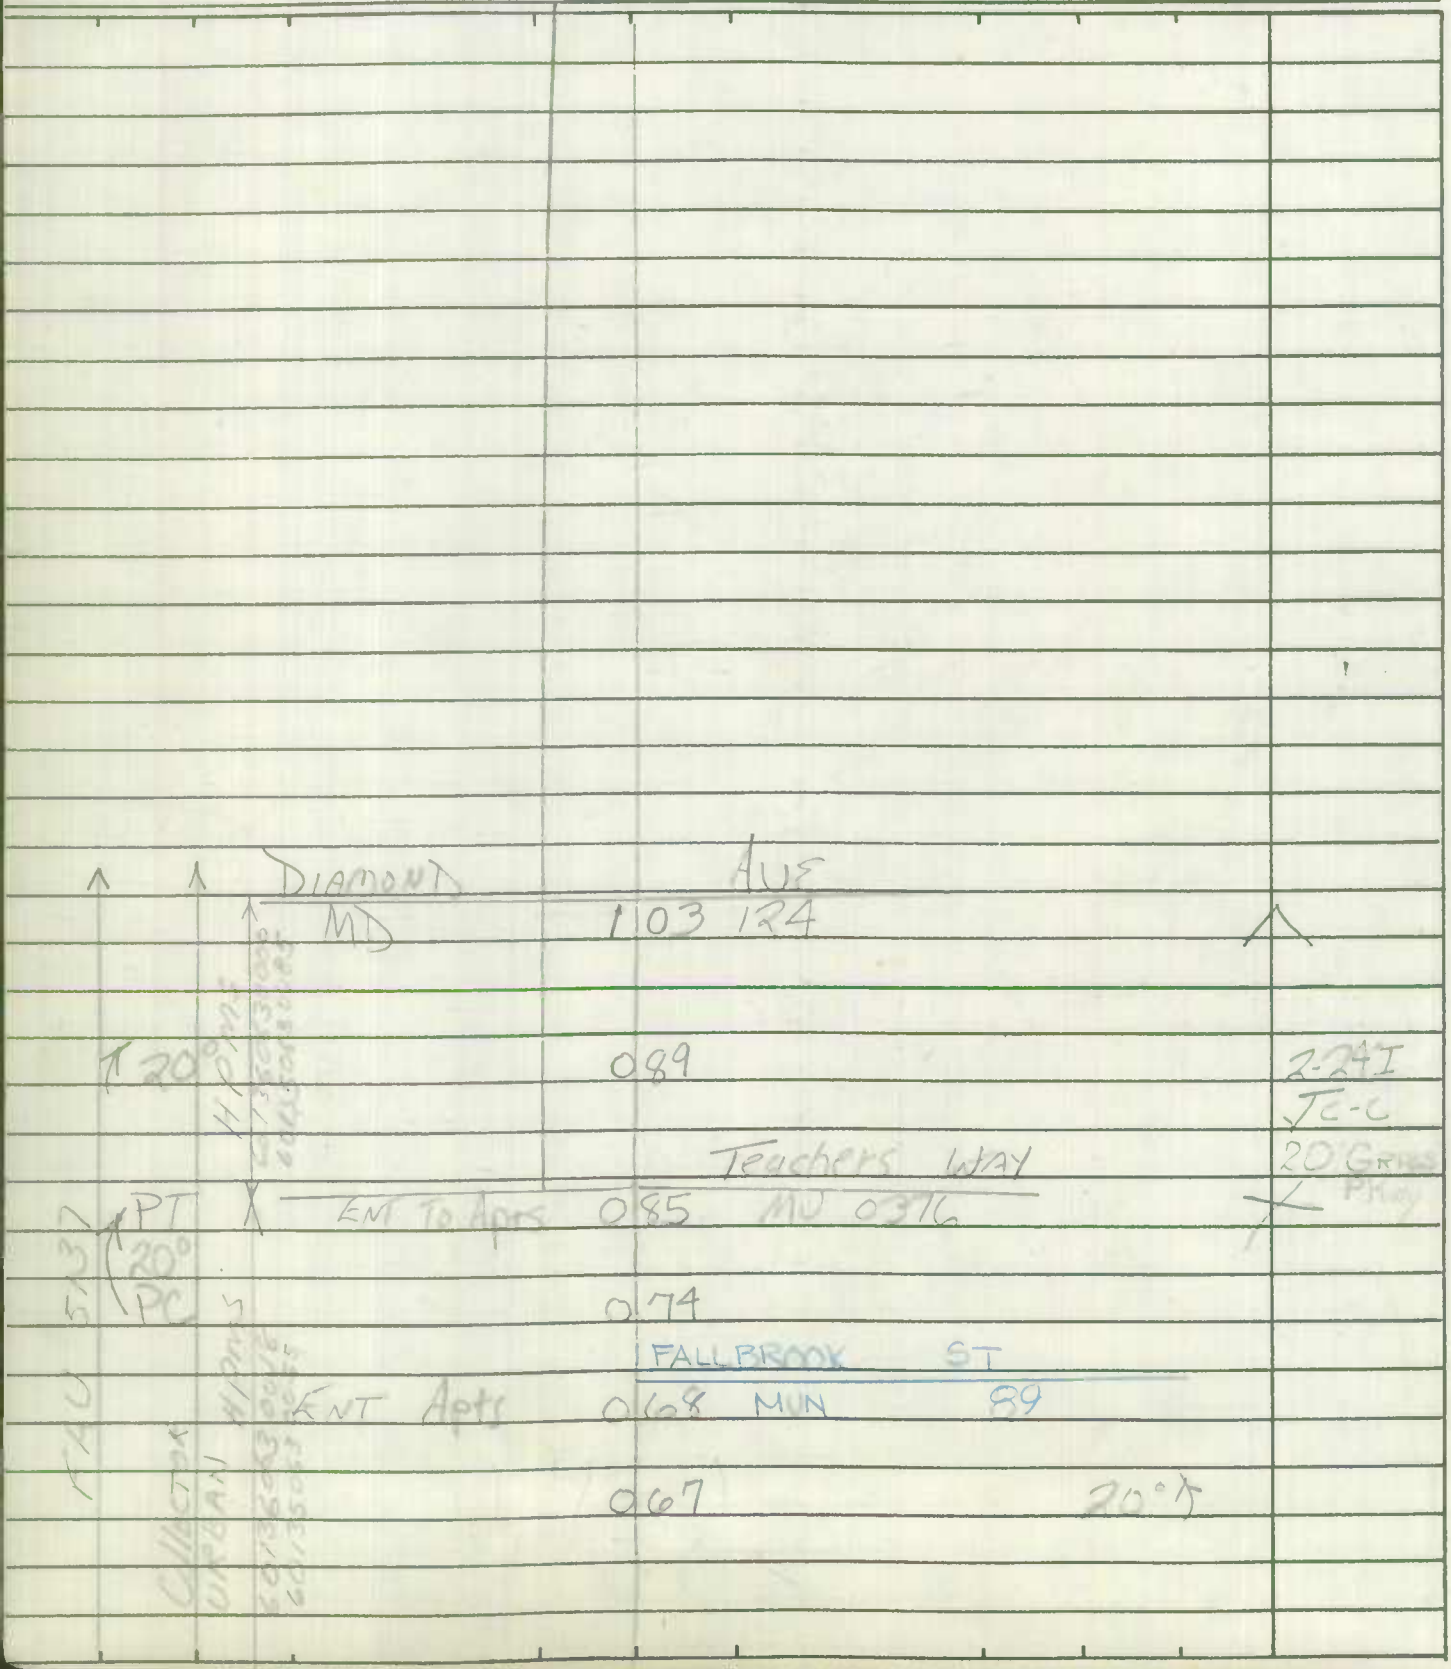

SHA 51.3 - 8 Revised
4.83

MARYLAND STATE HIGHWAY ADMINISTRATION

98-BX2
12/15/98
SS/RB

ROAD INVENTORY SHEET

Party Chief BB
Recorder JS
Assistant
Map No./Dir. / W
State Coordinates GAITHERSBURG

Road No. mu 0136
Road Name (GOLDEN ASH WAY)
County MONTGOMERY
Date 2-11-93
Sheet No. 1 OF 1

92-6

TRAFFIC CODES
TRAFFIC CONTROLS: STOP SIGN=SS, TRAFFIC LIGHT=T.L., FLASHING RED BALL=F.R.

TRAFFIC CODES
PARKING RESTRICTIONS: A.M. PEAK, P.M. PEAK, A.M./P.M. PEAK, NO PARKING ANYTIME=N.P., COMM/IND. ACCESS=E

SYSTEM				TRAFFIC		LINE DIAGRAM	TRAFFIC			PAVEMENT DATA
FED. AID.	FUNCT CLASS	HWY. SYS.	HPMS SAMPLE	PRKG. REST.	COM/IND. ACCESS		CONTROL	COM/IND. ACCESS	PRKG. REST.	
						SEE ROAD INVENTORY 98-BX2 12/15/98 SS/RB				
						HART ~~Rd~~ Rd mu 2141 0.09 0141				
						(INSPIRATION LA) mu 0173 0.00				28'I JC-C

SYSTEM				TRAFFIC		LINE DIAGRAM	TRAFFIC			PAVEMENT DATA
FED. AID.	FUNCT. CLASS.	HWY. SYS.	HPMS SAMPLE	PRKG. REST.	COM/IND ACCESS		CONTROL	COM/IND ACCESS	PRKG. REST.	

SHA 51.3-8
11-15-72

ROAD INVENTORY SHEET

Party Chief I. LANDON
Recorder M. ZALENSKI
Helper I. Abbott

Map No. 26 UNDER CONST.
REVISED
GAITHERSBURG 2-12-75

Road No. MUN 0136
Road Name (GIRARD ST)
Sheet No. 1 of 1
Date 10-29-73
County MONT.
State Coordinates

MUN 0135

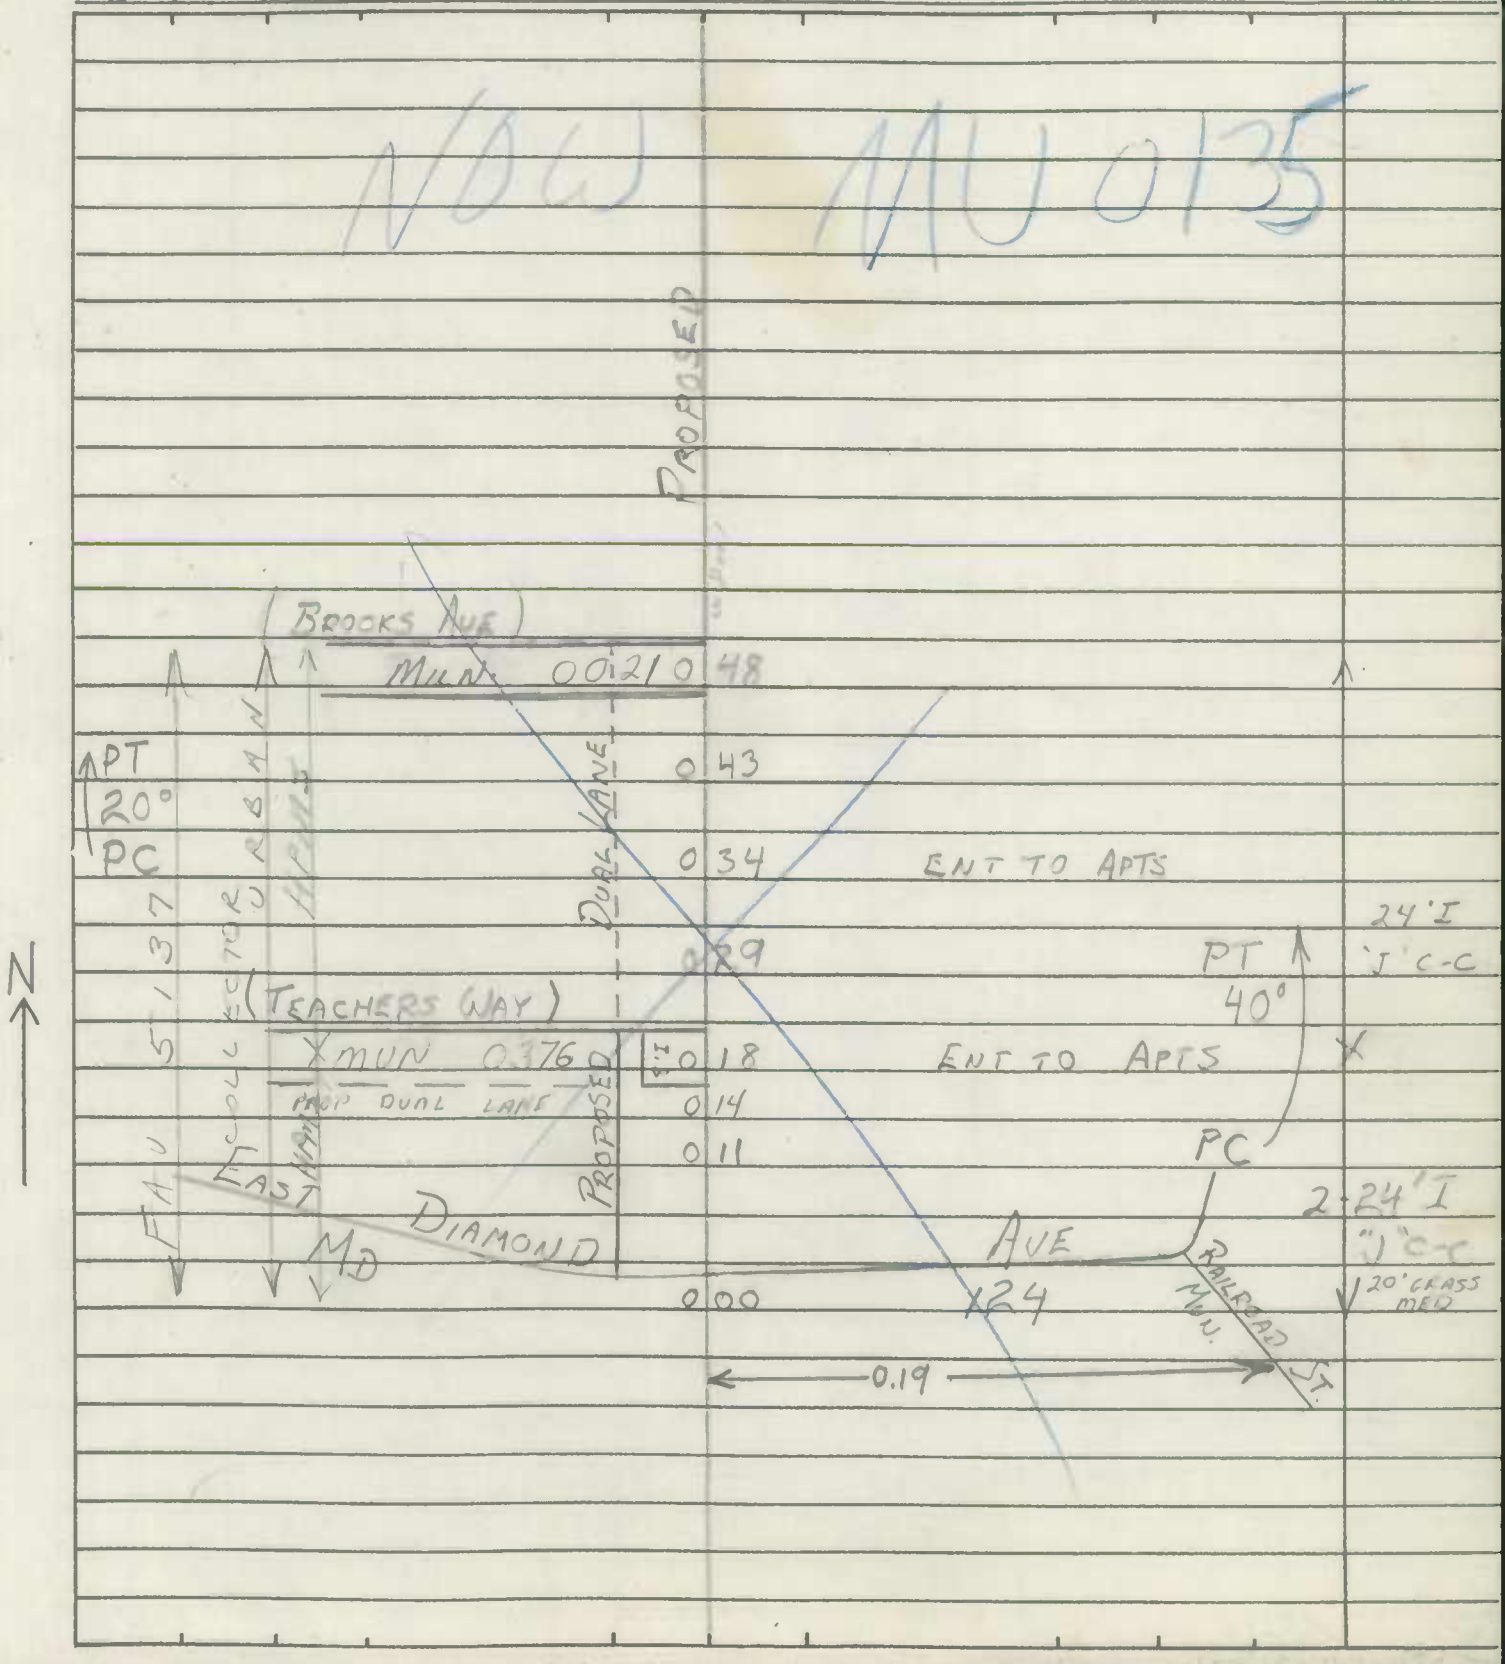

SHA 51.3-8
11-15-72

ROAD INVENTORY SHEET

Road No. _____
Road Name _____
Sheet No. _____
Date _____
County _____
State Coordinates _____

SHA 51.3-8
11-15-72

OP5403

ROAD INVENTORY SHEET

Party Chief I. LANDON
Recorder M. ZALENSKI
Helper I. ABBOTT

Map No. 26

GAITHERSBURG

Road No. MUN ~~0370~~ 0139
Road Name ~~SUMMIT HALL RD~~ HARMONY HALL RD
Sheet No. 1 OF
Date 10-25-73
County MONT.
State Coordinates

ROAD	END		
	0 ~~32~~ 38		31' I
	0 ~~37~~ 31	36" CP	34' CW
	0 ~~30~~		
CEDAR AVE			
MUN	0 ~~1524~~	0030	
120°	0 ~~14~~ 20		
RAWLINGS RD			
MUN 0320	0 ~~11~~ 17		
	~~14~~ BUTTRY RD		
	0 ~~08~~ MUN	0025	
SPRING ST			
MUN 0350	0 ~~05~~		36' I
			"J" C-C
~~WATER~~	~~ST~~	~~ST~~	
	~~044~~	~~214~~ ST	
WATER CO	006	ST 214	
E RKG.	004		
MUDDY BRANCH RD.			
~~OP~~	0 00	5402	

OP 5403

KING FARM FARM RD

SHA 51.3-8
11-15-72

ROAD INVENTORY SHEET

Road No. _____
Road Name _____
Sheet No. _____
Date _____
County _____
State Coordinates _____

SHA 51.3 - 8 Revised
4.83

MARYLAND STATE HIGHWAY ADMINISTRATION

ROAD INVENTORY SHEET

MU 0139

CB/AL
1-31-90
88-ey #1

89-344

Party Chief T LANDON
Recorder M. Zalenski
Assistant T. ABBOTT
Map No./Dir. E10 B / E
State Coordinates Gaithersburg

Road No. CO 5881
Road Name Harmony Hall RD
County Montgomery
Date 10-25-73
Sheet No. 1 OF 2

Rewritten
5-16-90
JB

TRAFFIC CODES
TRAFFIC CONTROLS: STOP SIGN=SS, TRAFFIC LIGHT=T.L., FLASHING RED BALL=F.R.

TRAFFIC CODES
PARKING RESTRICTIONS: A.M. PEAK, P.M. PEAK, A.M./P.M. PEAK, NO PARKING ANYTIME=N.P., COMM/IND. ACCESS=E

SYSTEM				TRAFFIC		LINE DIAGRAM	TRAFFIC			PAVEMENT DATA
FED. AID.	FUNCT CLASS.	HWY. SYS.	HPMS SAMPLE	PKG. REST.	COM/IND. ACCESS		CONTROL	COM/IND. ACCESS	PKG. REST.	
NON FA	URBAN LOCAL					CEDAR Ave mun 0124 0030 20° 0120 Rawlings RD mun 0320 017 BUTTRY RD 014 mun 0025 Spring ST mun 0350 011 Water ST CO 0106 214 Corp Lmts Gaithersburg 004 Muddy Branch RD OP 000 5407				36' I J C-C

CO 5881 01 39

LINE DIAGRAM

SYSTEM				TRAFFIC		TRAFFIC				PAVEMENT DATA
FED. AID.	FUNCT. CLASS.	HWY. SYS.	HPMS SAMPLE	PRKG. REST.	COM/IND ACCESS	CONTROL	COM/IND ACCESS	PRKG. REST.		
NON FA									Road 035 End	
URBAN	LOCAL									31'I
									037 36"CP	34'CW
									036	X

SHA 51.3-8
11-15-72

STATE HIGHWAY ADMINISTRATION OF MARYLAND

84-15,16
GD/CG
3-21-90

ROAD INVENTORY SHEET

Party Chief MZ
Recorder JE
Helper

Map No.

Road No. MU 0295 182
Road Name ~~PERRY PKWY~~ LAKEFOREST BLVD 81-16
Sheet No. 1 of 2
Date 4-17-79
County MONT
State Coordinates

GAITHERSBURG

A/T 84-27

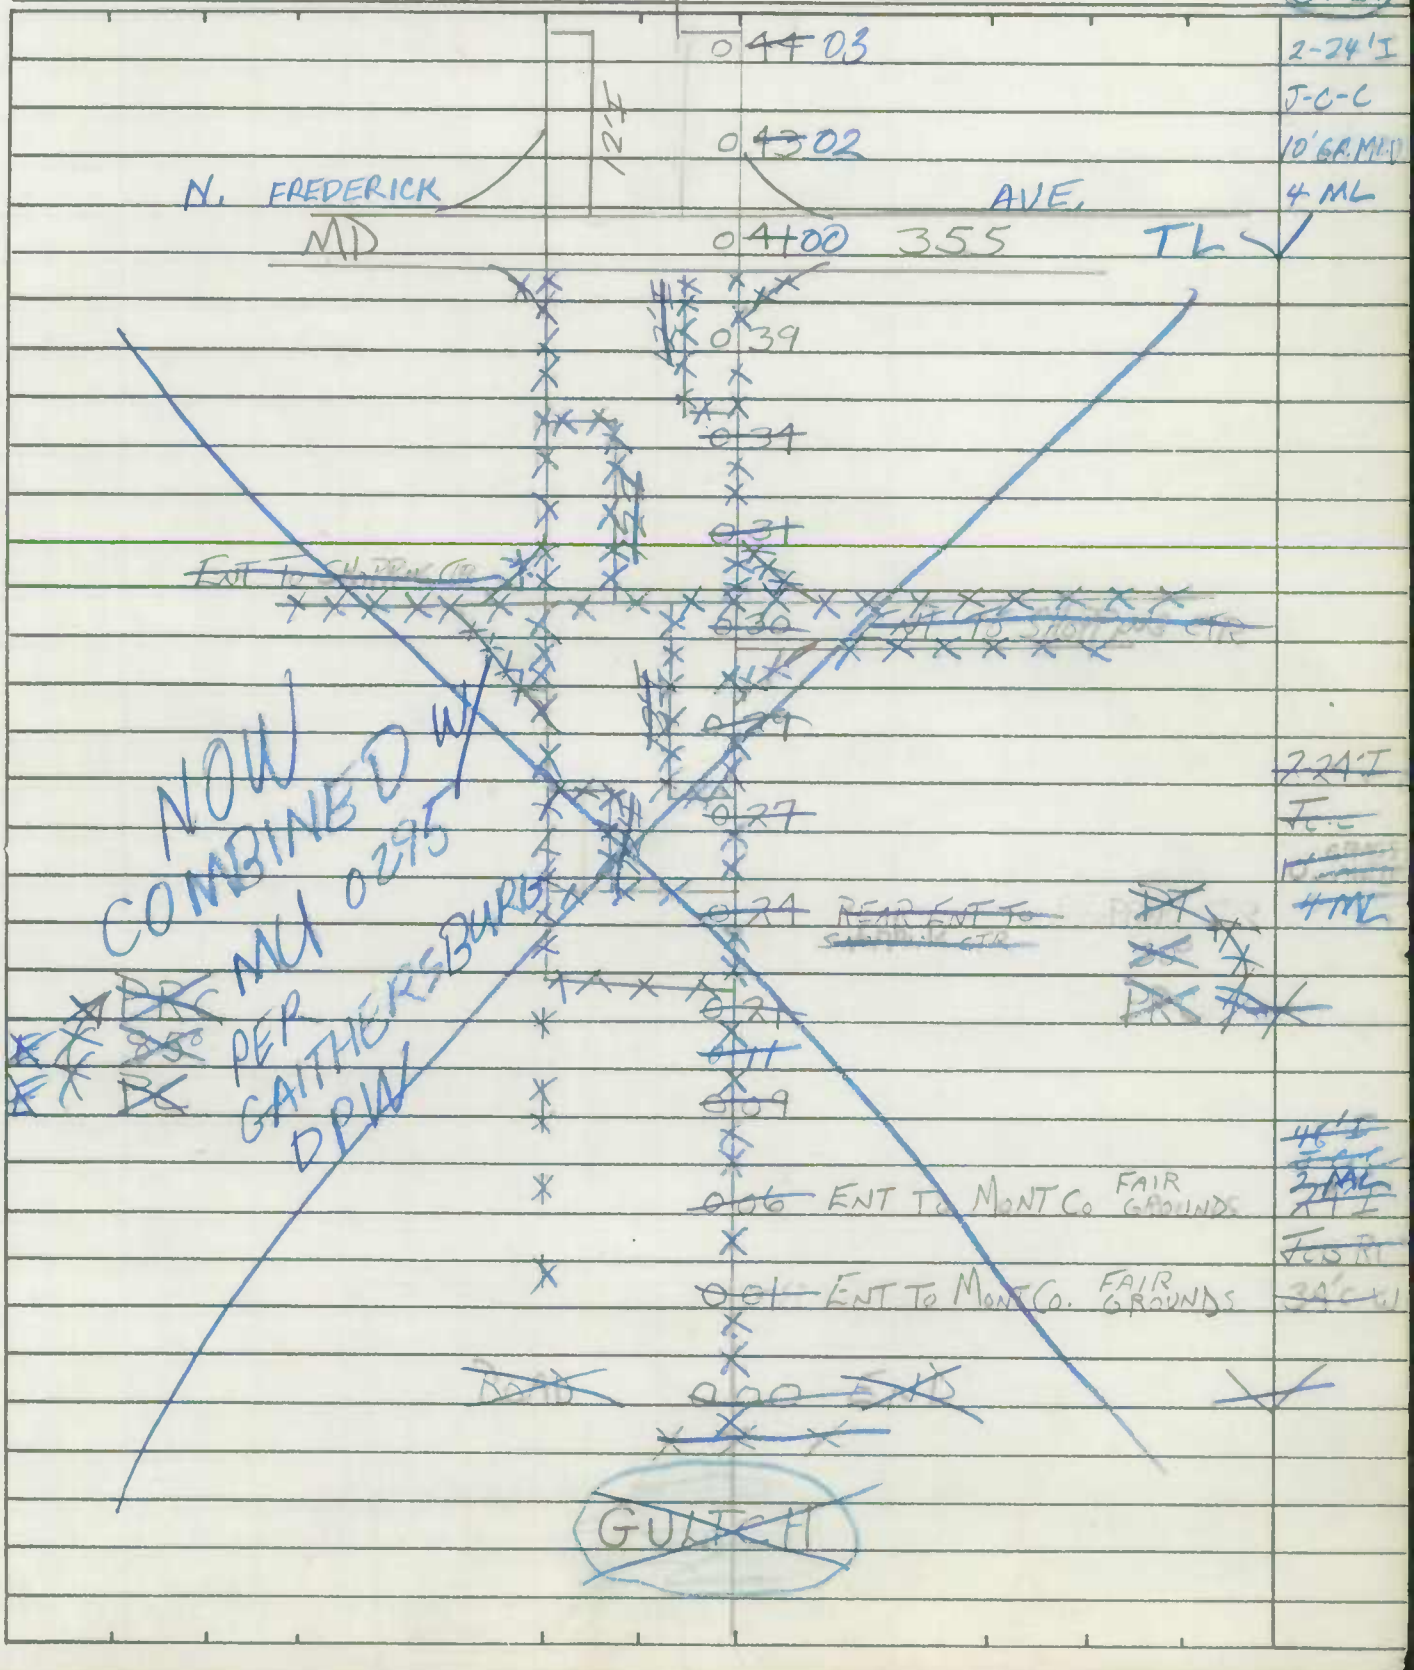

SHA 51.3-8
11-15-72

ROAD INVENTORY SHEET

0182

Road No. MU ~~0295~~
Road Name ~~PERRY PKWY~~
Sheet No. 2 of 2
Date 4-17-79
County MONT
State Coordinates

ENT. TO SHOPPING CTR

RUSSELL AVE

0 ~~54~~13

MU 340

2-21'I
Jc-c
20' GRASS MED.
4 ML

12'

12'

0 ~~49~~08

0 ~~47~~06 ENT TO BANK

12'

2-24'I
J-C-C
10' GR. MED.
4 ML

SHA 51.3-8
11-15-72

ROAD INVENTORY SHEET MU 0196

Party Chief I. LANDON
Recorder I. ABBOTT
Helper M. ZALENSKI

Map No. 26 4-16-79 MZ-JE
GAITHERSBURG 78-21

Road No. O.P. 321
Road Name LONGMEADOW DR.
Sheet No. 1 of 1
Date 10-30-79
County MONT.
State Coordinates 435-443

LONGMEADOW DR
~~OP~~ MU 0025 ~~321~~ 0196

↑ 170° 0022
ROAD ~~END~~
↑ 100° 0019

40' I
"J" C-C
PKG LT

LONGMEADOW DR
0017 ~~OP 321~~ MU 0196

~~R 100°~~ ~~0015~~
↑ 25° 0015 ~~0011~~

N
E

MIDLINE RD.
MU ~~OP~~ ~~0013~~ 0009 318 0019

LONGMEADOW DR 0010 30° ↑
MU ~~OP 321~~ 0196 0006
0004 90° ↑
~~0001~~ ~~90°~~ ↑
0003 90° ↑
0001 90° ↑ 20' I
"J" C-C

LONGMEADOW DR
~~OP~~ MU 0000 ~~321~~ 0196
ROAD ~~END~~

SHA 51.3-8
11-15-72

ROAD INVENTORY SHEET

Road No. _____
Road Name _____
Sheet No. _____
Date _____
County _____
State Coordinates _____

SHA 51.3 - 8 Revised 4.83

GAITHERSBURG (97-5)

98-8
12/15/98

00-6MU
SS/AC
2-13-01

MARYLAND STATE HIGHWAY ADMINISTRATION

ROAD INVENTORY SHEET

Party Chief GD
Recorder MP
Assistant
Map No./Dir. 1 S
State Coordinates

Road No. MU 0212
Road Name Main St
County Montgomery
Date 2/27/98
Sheet No. 1 OF ~~12~~ 13

SYSTEM: FUNCT CLASS | HWY SYS | HPMS SAMPLE
TRAFFIC: PEAK. REST. | COMM/IND ACCESS

LINE DIAGRAM

(PROP
0 22
INSPIRATION LA
0 20 MU ~~OP~~ 5947 - 0173
0 18
SEE NEW INVENT
WRITTEN 01/30/02
IMP # 01-1MU
S=1WP
ALFANDRE ST
0 15 MU 0559 ~~TRUNC~~
Midtown Rd
0 08 MU 0211
0 00
Kentlands Blvd
MU 0532

TRAFFIC: CONTROL | COMM/IND ACCESS | PEAK. REST.

PAVEMENT DATA
34'H
JC-C
2UML
32'I
JC-C
2UML

TRAFFIC CODES
TRAFFIC CONTROLS: STOP SIGN-SS, TRAFFIC LIGHT=T.L., FLASHING RED BALL=F.R.

TRAFFIC CODES
PARKING RESTRICTIONS: A.M. PEAK, P.M. PEAK, A.M./P.M. PEAK, NO PARKING ANYTIME=N.P., COMM/IND. ACCESS=E

COUNTY ROAD NO. MU0212 PAGE 2 OF 3

SYSTEM: FUNCT. CLASS | HWY SYS | HPMS SAMPLE
TRAFFIC: PREG. REST. | COM/IND ACCESS

LINE DIAGRAM

TRAFFIC: CONTROL | COM/IND ACCESS | PREG. REST.

PAVEMENT DATA

SEE NEW INVENT
WRITTEN 01/30/2
IMP#01-1MU
SS/WP

GOLDEN ASH WAY
0 57 MU 0186 (illegible)

GATESTONE ST
MU 0553 0 57

LAKE VARUNA MEWS
0 51
0 50

LAKE VARUNA DR
MU 0552 0 49
PT 0 48
100'
HEATHWALK ST
MU 0551 0 45
PC

CROSS GREEN ST
0 43 MU ~~OP 5949~~ 0545

E. MARKET ST
MU ~~0581~~ ← 0 33 0581 ~~OP 5944~~ SS
0.10

W. MARKET ST.
MU ~~0582~~ → 0 28 0582 ~~OP 5945~~ SS
0.07

(PROJ) 0 26

PAVEMENT DATA:
32'U
JC-C
1-4ML
X
34'I
JC-C
2UML
X
30'G
JC-C
2UML
X
34'H
JC-C
2UML
X
34'H
JC RT
2UML
X

SHA 51.3-8
11-15-72

STATE HIGHWAY ADMINISTRATION OF MARYLAND

OP 4711

ROAD INVENTORY SHEET

Party Chief MZ
Recorder VE
Helper

Map No.

Road No. MU 0273
Road Name ~~ALEM RD~~ ODENDHALL AVE
Sheet No. 1 of 2
Date 4-17-73
County Mont
State Coordinates

91-CU EX 26

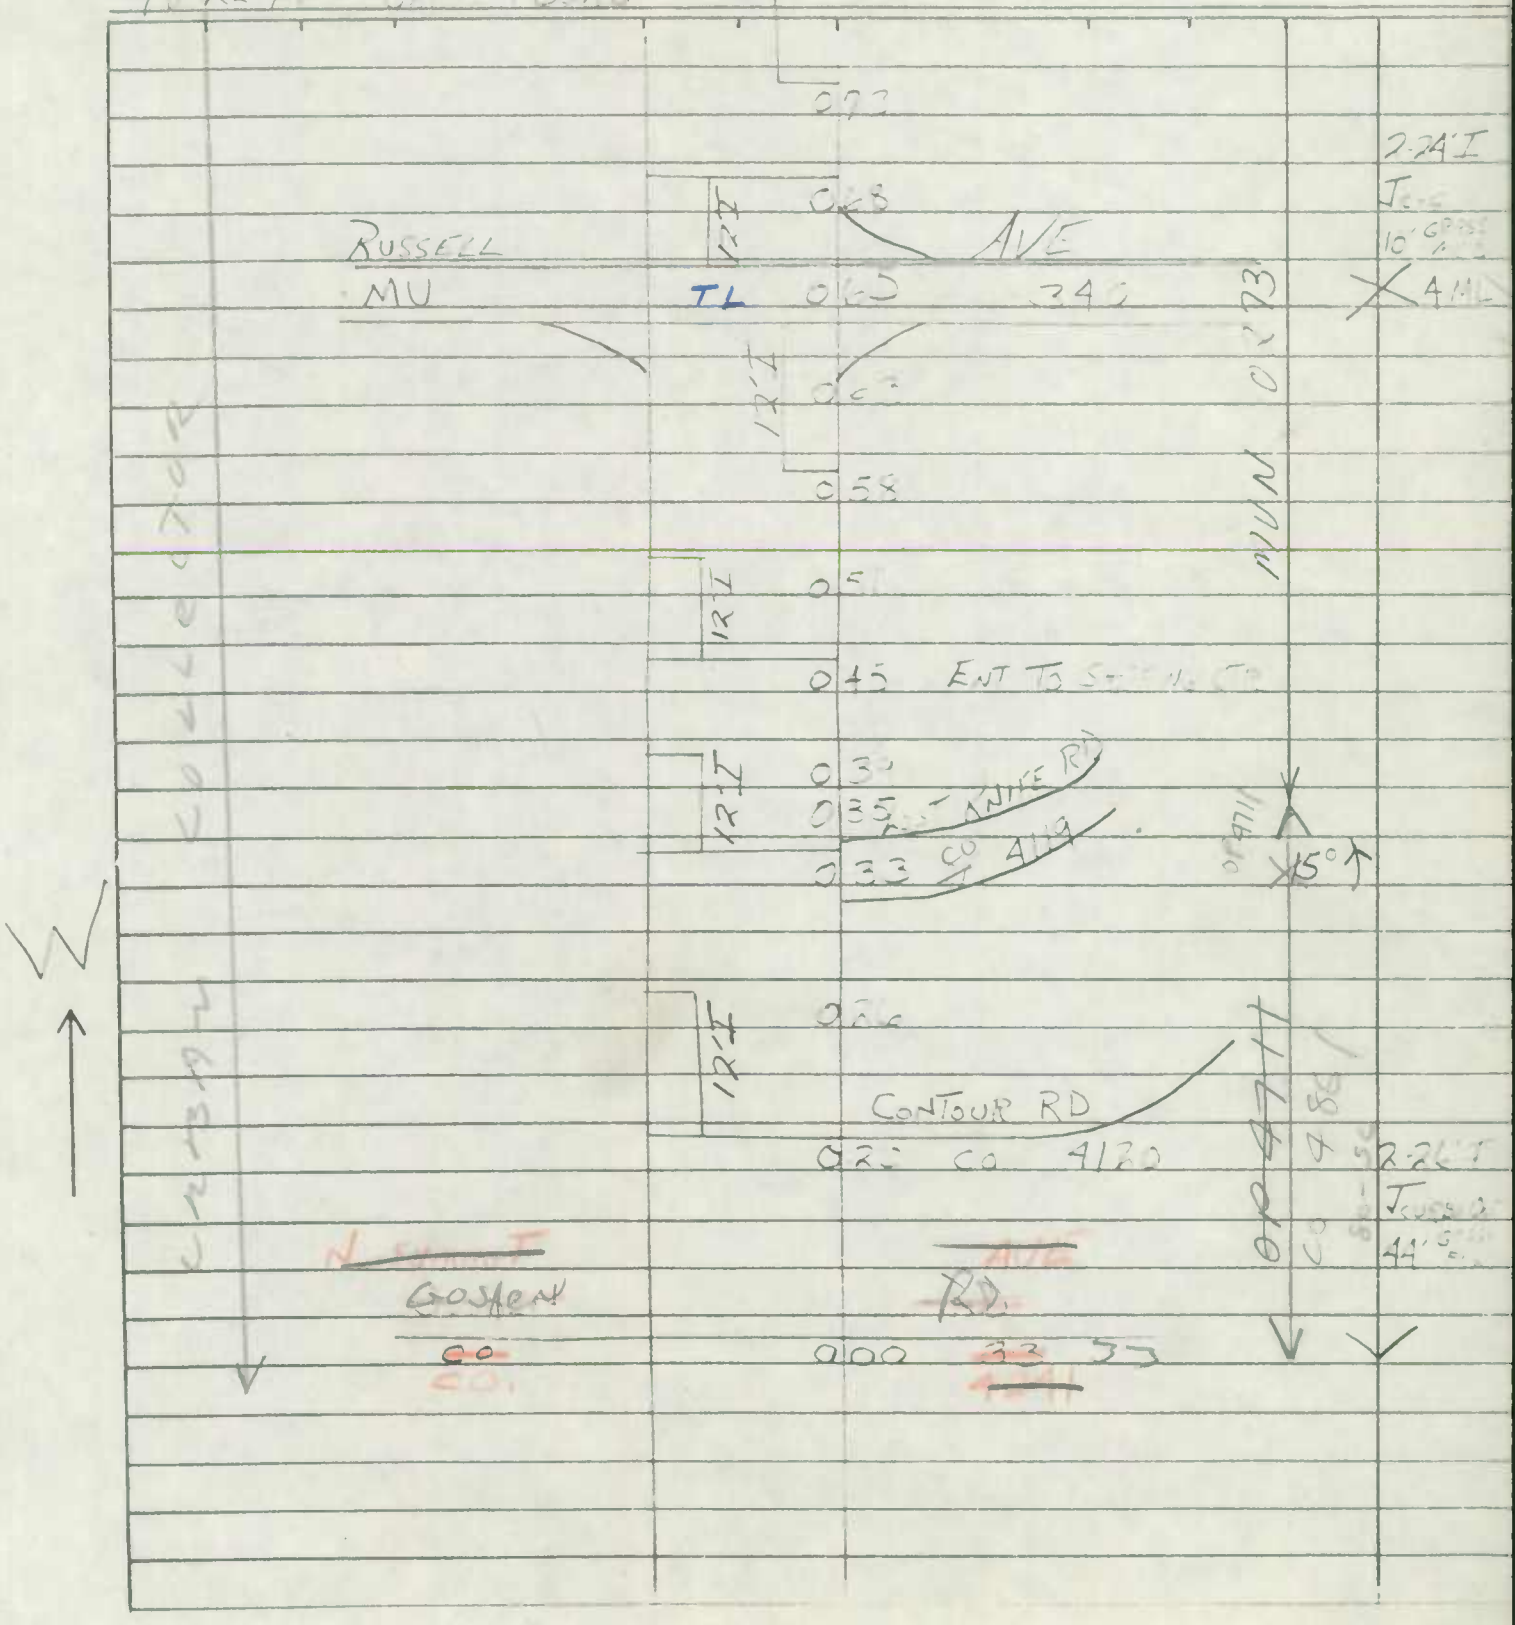

SHA 51.3-8
11-15-72

ROAD INVENTORY SHEET

Road No. MD
Road Name OLDEN' Mt. AVE
Sheet No. 2 of 2
Date 4-17-74
County MONT
State Coordinates

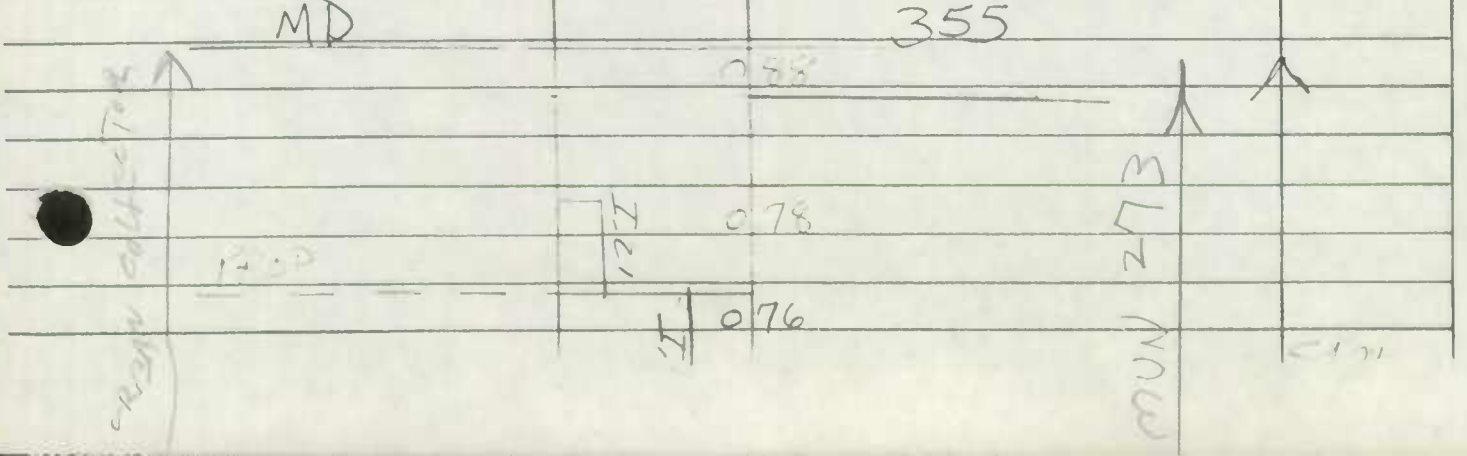

SHA 51.3-8
11-15-72

STATE HIGHWAY ADMINISTRATION OF MARYLAND

Co 4861

ROAD INVENTORY SHEET

OP 47.11

Party Chief MZ
Recorder JE
Helper

Map No. M26B
78-2 EXTRA GAITHERSBURG

Road No. MU 0273
Road Name ODEND' HAL AVE
Sheet No. 1 of 2
Date 4-17-79
County MONT
State Coordinates 741 - 478

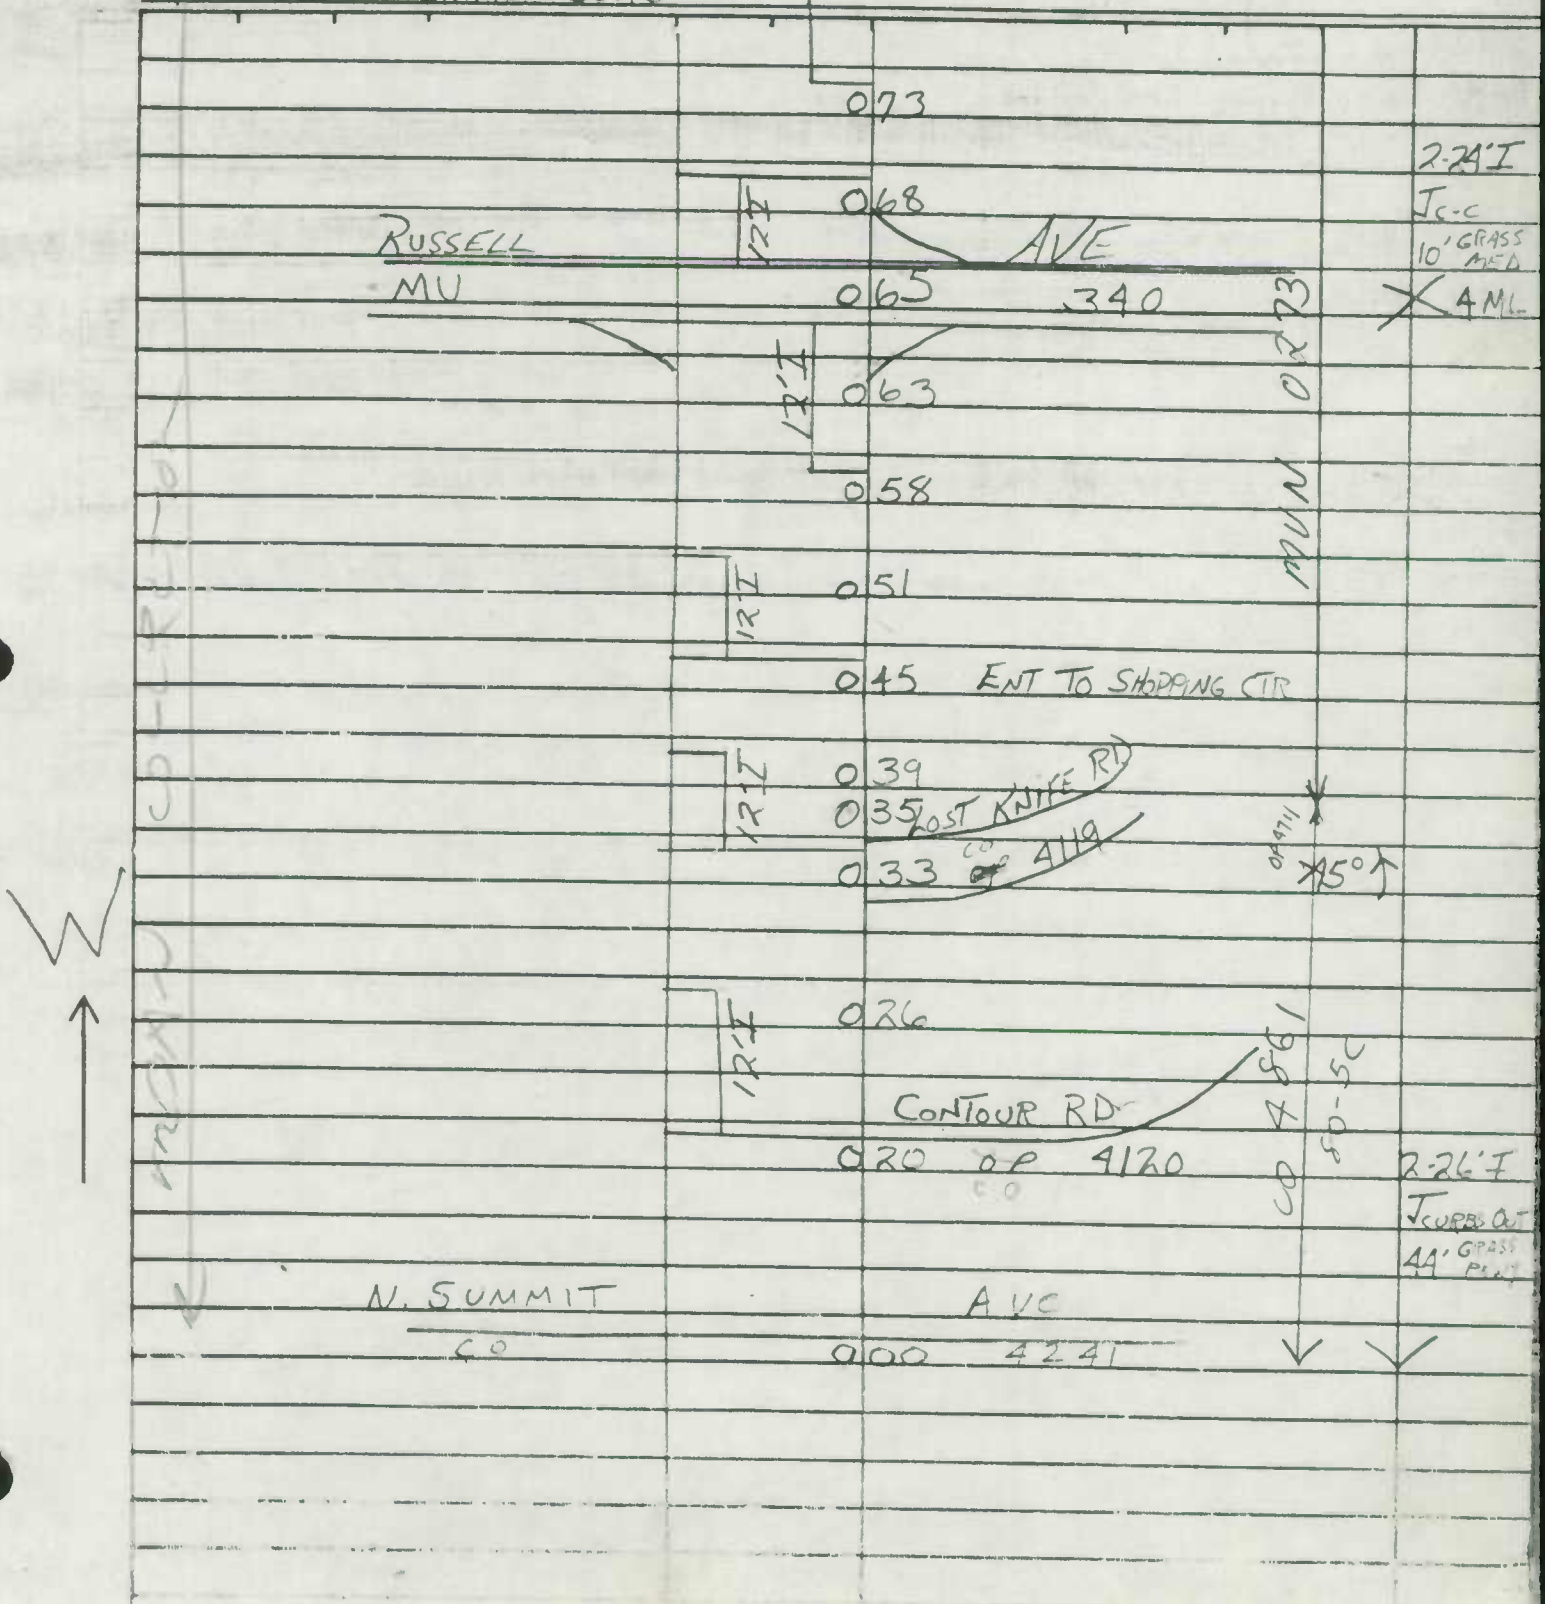

SHA 51.3-8
11-15-72

STATE HIGHWAY ADMINISTRATION OF MARYLAND

ROAD INVENTORY SHEET

Party Chief BB
Recorder NS
Helper

Map No. 83-15
GAITHERSBURG

Road No. MUN 0302
Road Name POINTER RIDGE DR #2
Sheet No. 1 OF 1
Date 3 / 14 / 84
County MONTGOMERY
State Coordinates

NOW COMBINED WITH MU 297

84-28

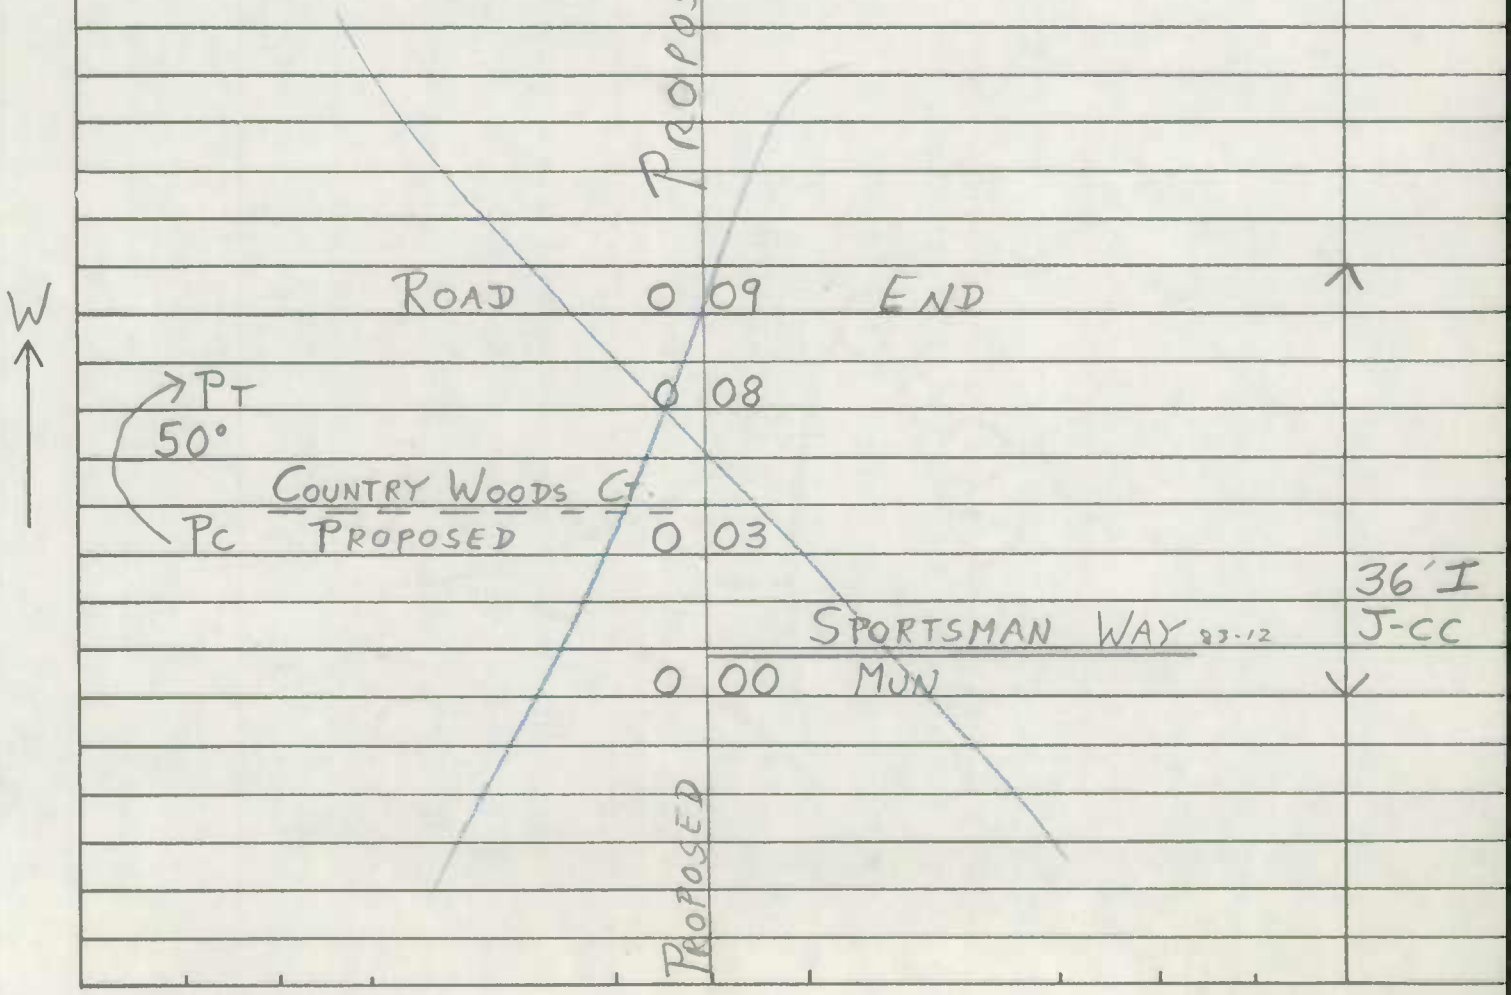

SHA 51.3-8
11-15-72

ROAD INVENTORY SHEET

Road No. _____
Road Name _____
Sheet No. _____
Date _____
County _____
State Coordinates _____

SHA 51.3-8
11-15-72

ROAD INVENTORY SHEET

MUN 0335

Party Chief T LAUDON
Recorder T ZAKENICKI
Helper

Map No. 26

Road No. ~~Co.~~ 2300
Road Name ROSEMONT DR
Sheet No. 1 of 1
Date 4-11-72
County
State Coordinates 147-472

ROAD END
0.34

VIRGINIA DR
0.30 MUN. 0390

HAMPTON DR
Co 2301 0.23

PT
75°
PC

0.18

HENRY DR.
Co 2299 0.15

0.11

ALDEN AVE
Co 0.09 2304

APPOX CORP

0.07

LIMITS OF CUMBERSTONE

0.04

S. FREDERICK AVE
MP 0.00 0.55

S

20' T
20' Cu

24' H
30' Cu

SHA 51.3-8
11-15-72

STATE HIGHWAY ADMINISTRATION OF MARYLAND

ROAD INVENTORY SHEET

Party Chief BB
Recorder FR
Helper

Map No.

Road No. MU. 0339
Road Name RUSSELL AVE.
Sheet No. 1 of 1
Date 3-23-83
County MONT.
State Coordinates

GAITHERSBURG

NOW
COMBINED
W MU 340

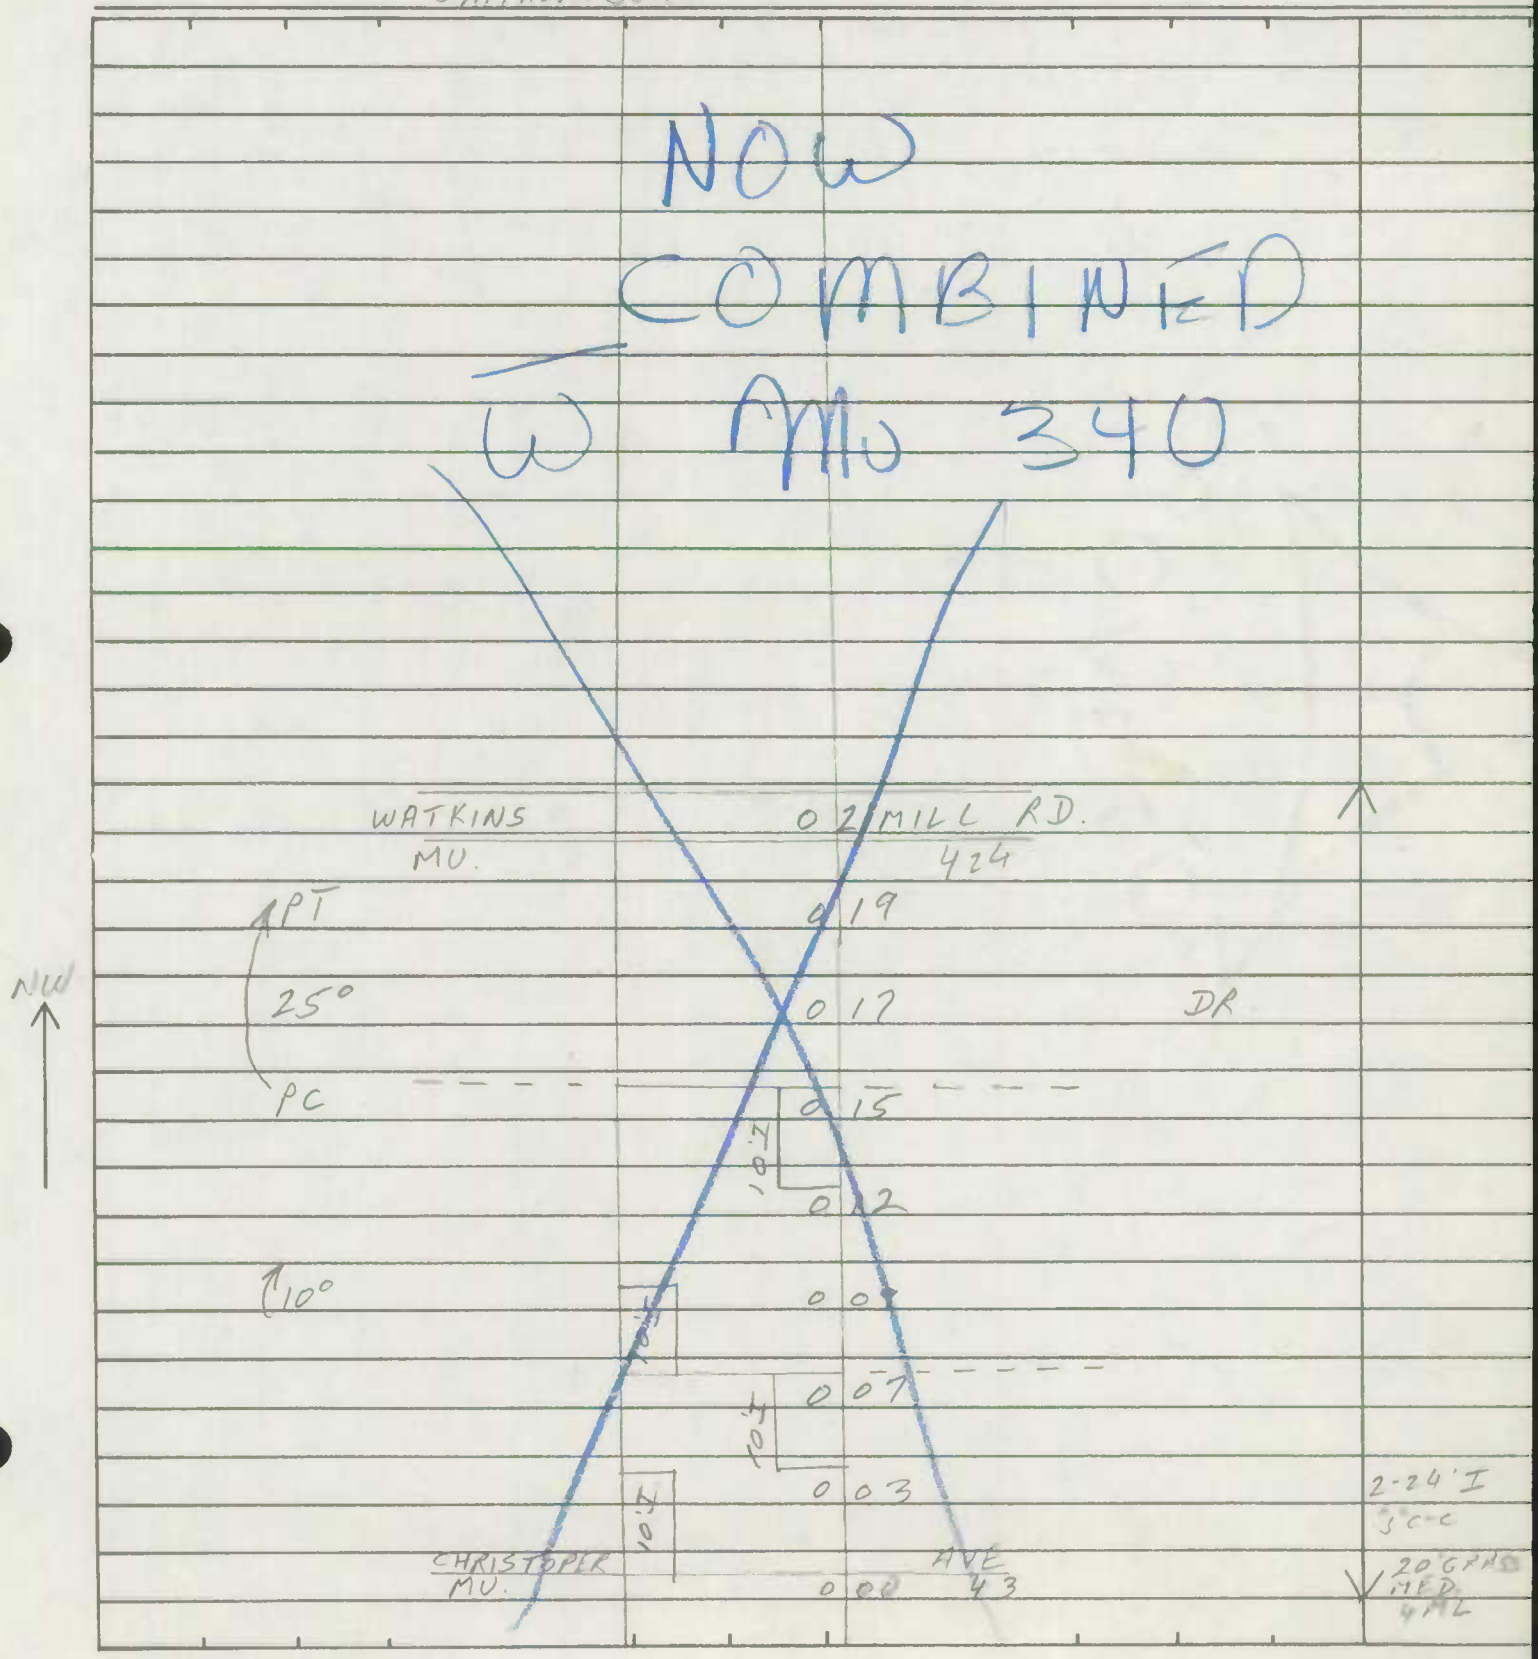

SHA 51.3-8
11-15-72

ROAD INVENTORY SHEET

Road No. _____
Road Name _____
Sheet No. _____
Date _____
County _____
State Coordinates _____

SHA 51.3-8
11-15-72

ROAD INVENTORY SHEET CO 4862

Road No. MU0340
Road Name RUSSELL AVE
Sheet No. 2 of 2
Date
County MONT
State Coordinates 140-482

M26A
80-17C

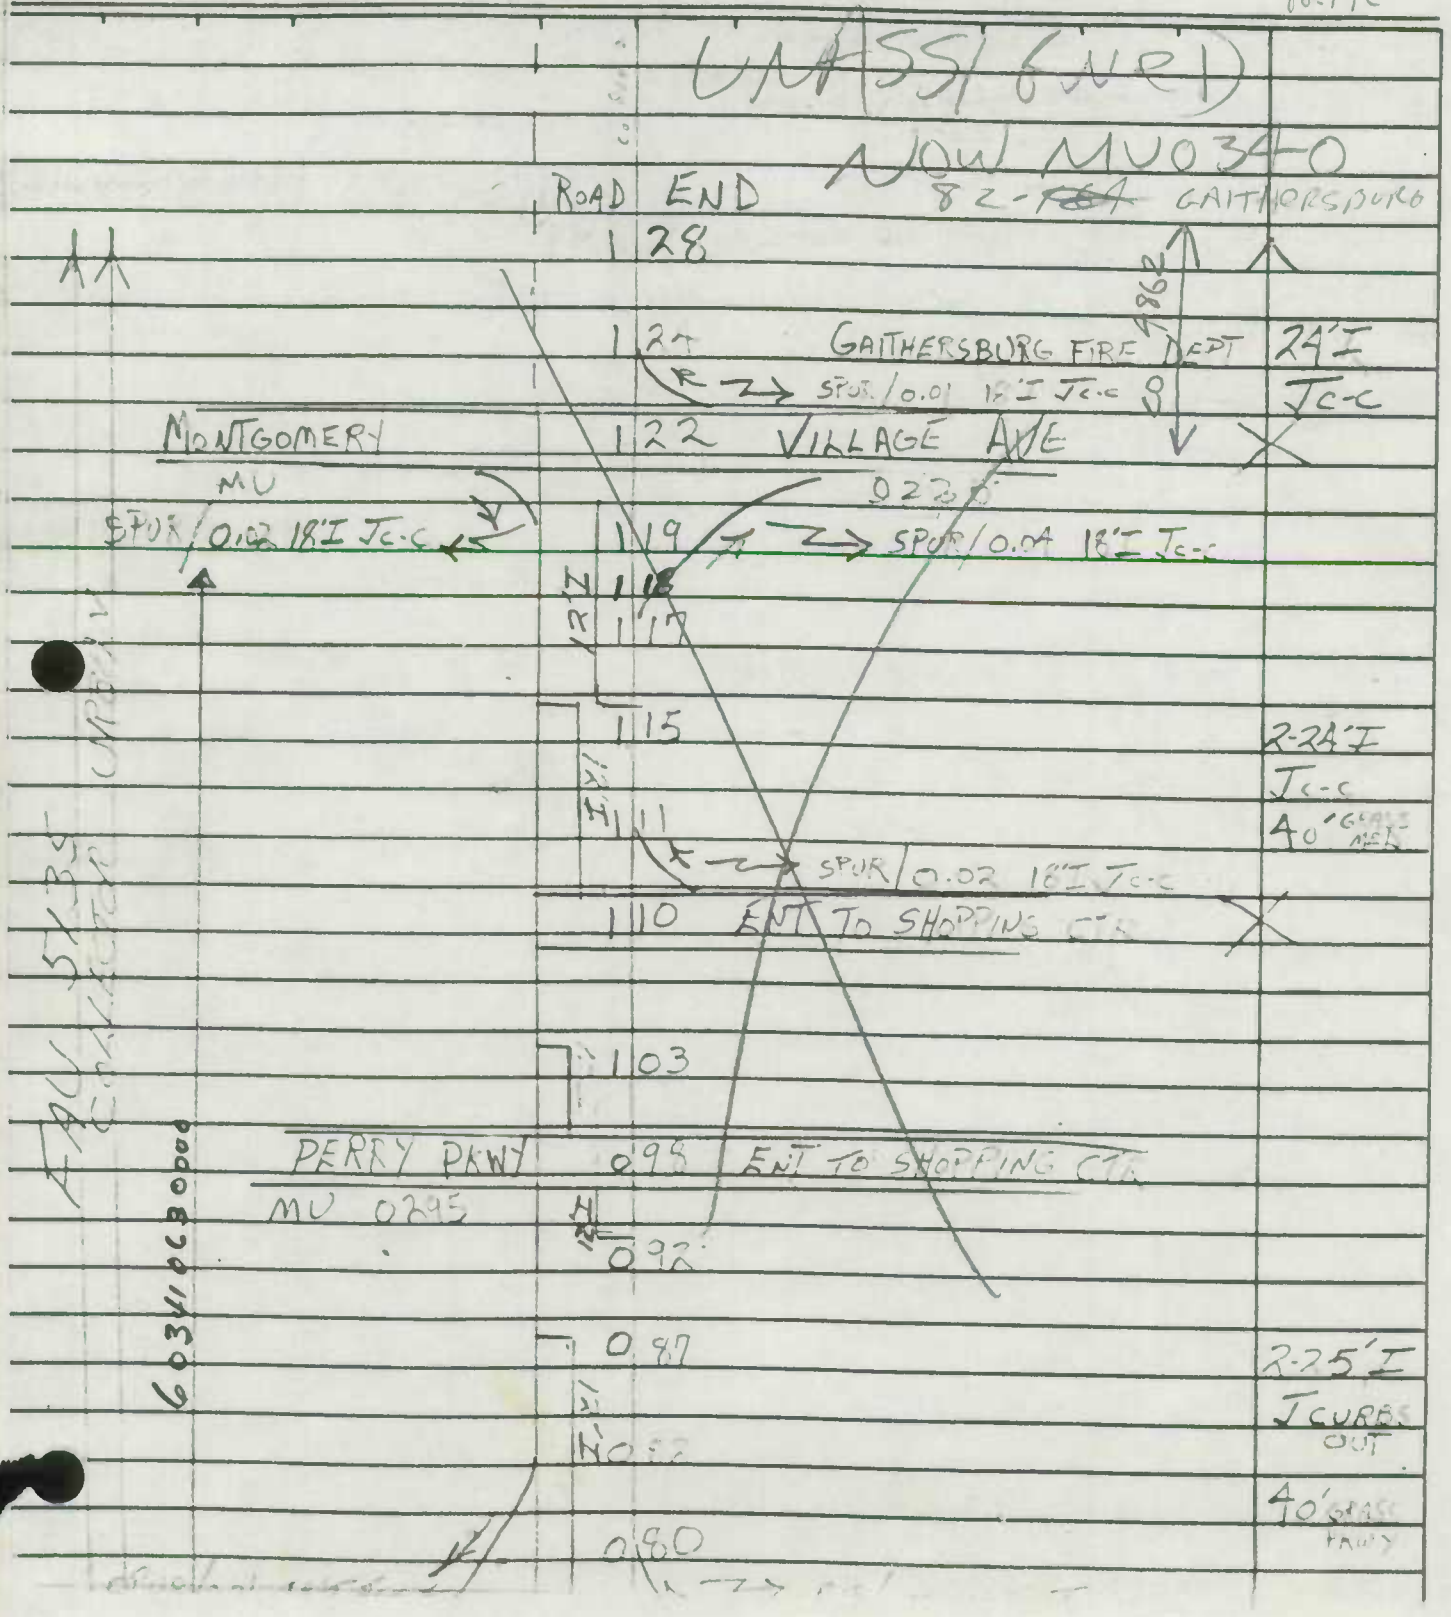

SHA 51.3-8
11-15-72

STATE HIGHWAY ADMINISTRATION OF MARYLAND

ROAD INVENTORY SHEET

Party Chief BB
Recorder FR.
Helper

Map No. E10A 82-21

84-ZEX 3-8-85 JE CM GAITHERS BURG

Road No. MU. 0361
Road Name SIOUX ~~RD.~~ LANE
Sheet No. 1 OF 1
Date 3-23-83
County MONT.
State Coordinates

E

ROAD 021 END
BOSTWICK LA
0 19 MU 0033

~~ROAD~~ 0 18 ~~END~~ 15°

BRADENTON CT. AGAWE CT.
MU. 0004 0 14 ~~AGAW~~ MUN 0001

~~BOSTWICK~~ LA
MU. ~~0002~~ 0 03 ~~0022~~ ~~0019~~ 0033

36' I
V I C T

CORD ~~LONGMET~~ CO. LMT 000 ~~2 2 3~~ OF GAITHERS

SHA 51.3-8
11-15-72

ROAD INVENTORY SHEET

Road No. _____
Road Name _____
Sheet No. _____
Date _____
County _____
State Coordinates _____

SHA 51.3-8
11-15-72

STATE HIGHWAY ADMINISTRATION OF MARYLAND

ROAD INVENTORY SHEET

Party Chief JE
Recorder BM
Helper

Map No. E-10A

Road No. MUN 0367
Road Name SIOUX LA
Sheet No. 1 OF 1
Date 8 MAR 1985
County MONTGOMERY
State Coordinates

84-6 EX GAITHERSBURG

8610

SLT
NBW
ENV

JE
CA

ROAD 027 END PT X
FLAGLER LA
076 MUN 0091
40°

BAY RIDGE TER
MUN 0028 018 MUN 0029 PC
(POLK CT)
MUN 0302 BAY RIDGE DR
014 MUN 0029
POSH DRIVE
OLD SECTION MD 124 X X 013 MUN 0083 PT X
30°

N

000 PC X

MD 003 124 RELOCATED X

001

ROAD 000 END

36'I
JC-C

48'I
JC-C
2 ML

2-24'I
JC-C
4'J MED
4 ML

17'I 2@ I LT
JC-C
21' GR MED

SHA 51.3-8
11-15-72

ROAD INVENTORY SHEET

Road No. _____
Road Name _____
Sheet No. _____
Date _____
County _____
State Coordinates _____

SHA 51.3-8
11-15-72

STATE HIGHWAY ADMINISTRATION OF MARYLAND

ROAD INVENTORY SHEET

Party Chief BB
Recorder FR.
Helper

Map No. _____ 82-22
GAITHERSBURG

Road No. MU 0362
Road Name SIOUX LA.
Sheet No. 1 OF 1
Date 3-23-83
County MONT.
State Coordinates

83-6
3/14/84
BO-NS

SEE NEW INV. 84-6 EXTRA

ROAD EXTENDED DUE TO RELOCATION OF MD 124 (QUINCE ORCH. RD)

NW

ROAD 0 14 END

(FLAGER LANE) 83-7
0 13 MUN

0 11

PT 40° PC

~~END~~ 0 06 ~~END~~

83-9 BAYRIDGE TER. ~~ENT~~ MUN. 0028 0 05 — — PROP. 36'I "J" C-C

POLK CT. ENT. JH 0 02 X36'I "I" C-C

QUINCE ORCHARD RD
MD 0 00 124

SHA 51.3-8
11-15-72

ROAD INVENTORY SHEET

Road No. _____
Road Name _____
Sheet No. _____
Date _____
County _____
State Coordinates _____

SHA 51.3-8
11-15-72

ROAD INVENTORY SHEET

Party Chief T. LANDON
Recorder M. ZALENSKI
Helper T. ABBOTT

Map No. 26 82-6
GAITHERSBURG

Road No. MUN 0371
Road Name SUMMIT HALL RD #2
Sheet No. 1 of 1
Date 10-25-23 83-1
County MONT 3/14/84
State Coordinates BC-NS

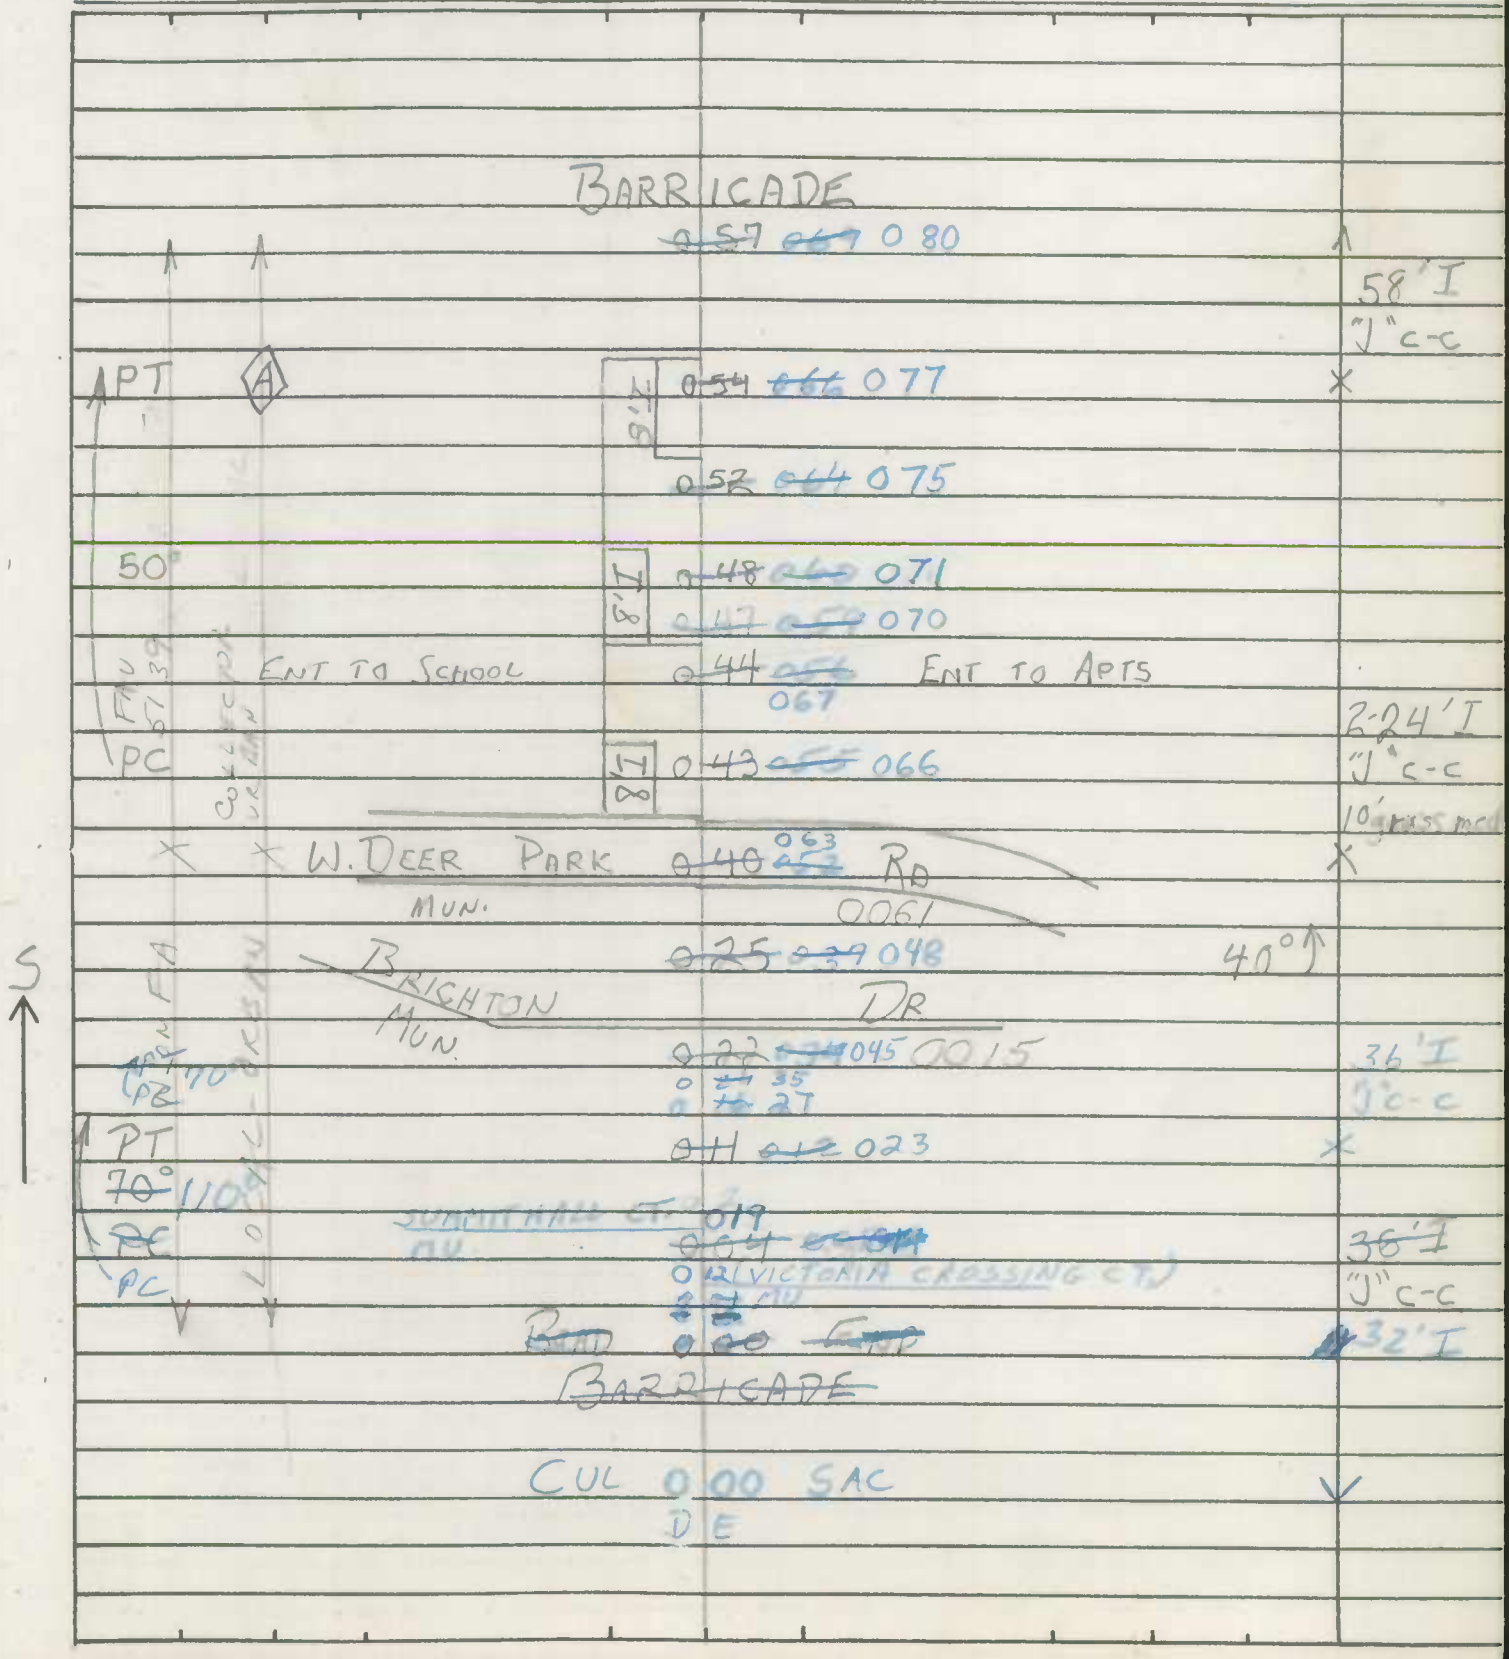

SHA 51.3-8
11-15-72

ROAD INVENTORY SHEET

Road No. _____
Road Name _____
Sheet No. _____
Date _____
County _____
State Coordinates _____

SHA 51.3-8
11-15-72

STATE HIGHWAY ADMINISTRATION OF MARYLAND

2000 MU Exh 11-10-72
SS/AO
2-15-01

TL REV. 77-4
FR. 2/24/78

ROAD INVENTORY SHEET

Party Chief W. DOMBROSKI
Recorder M. ZALENSKI
Helper

Map No. 26 74-7
GAITHERSBURG

Road No. (MUN 0376)
Road Name (TEACHER'S WAY)
Sheet No. 1 OF 1
Date 2-12-75
County MONT
State Coordinates

91-19
GD-JK
3-9-92

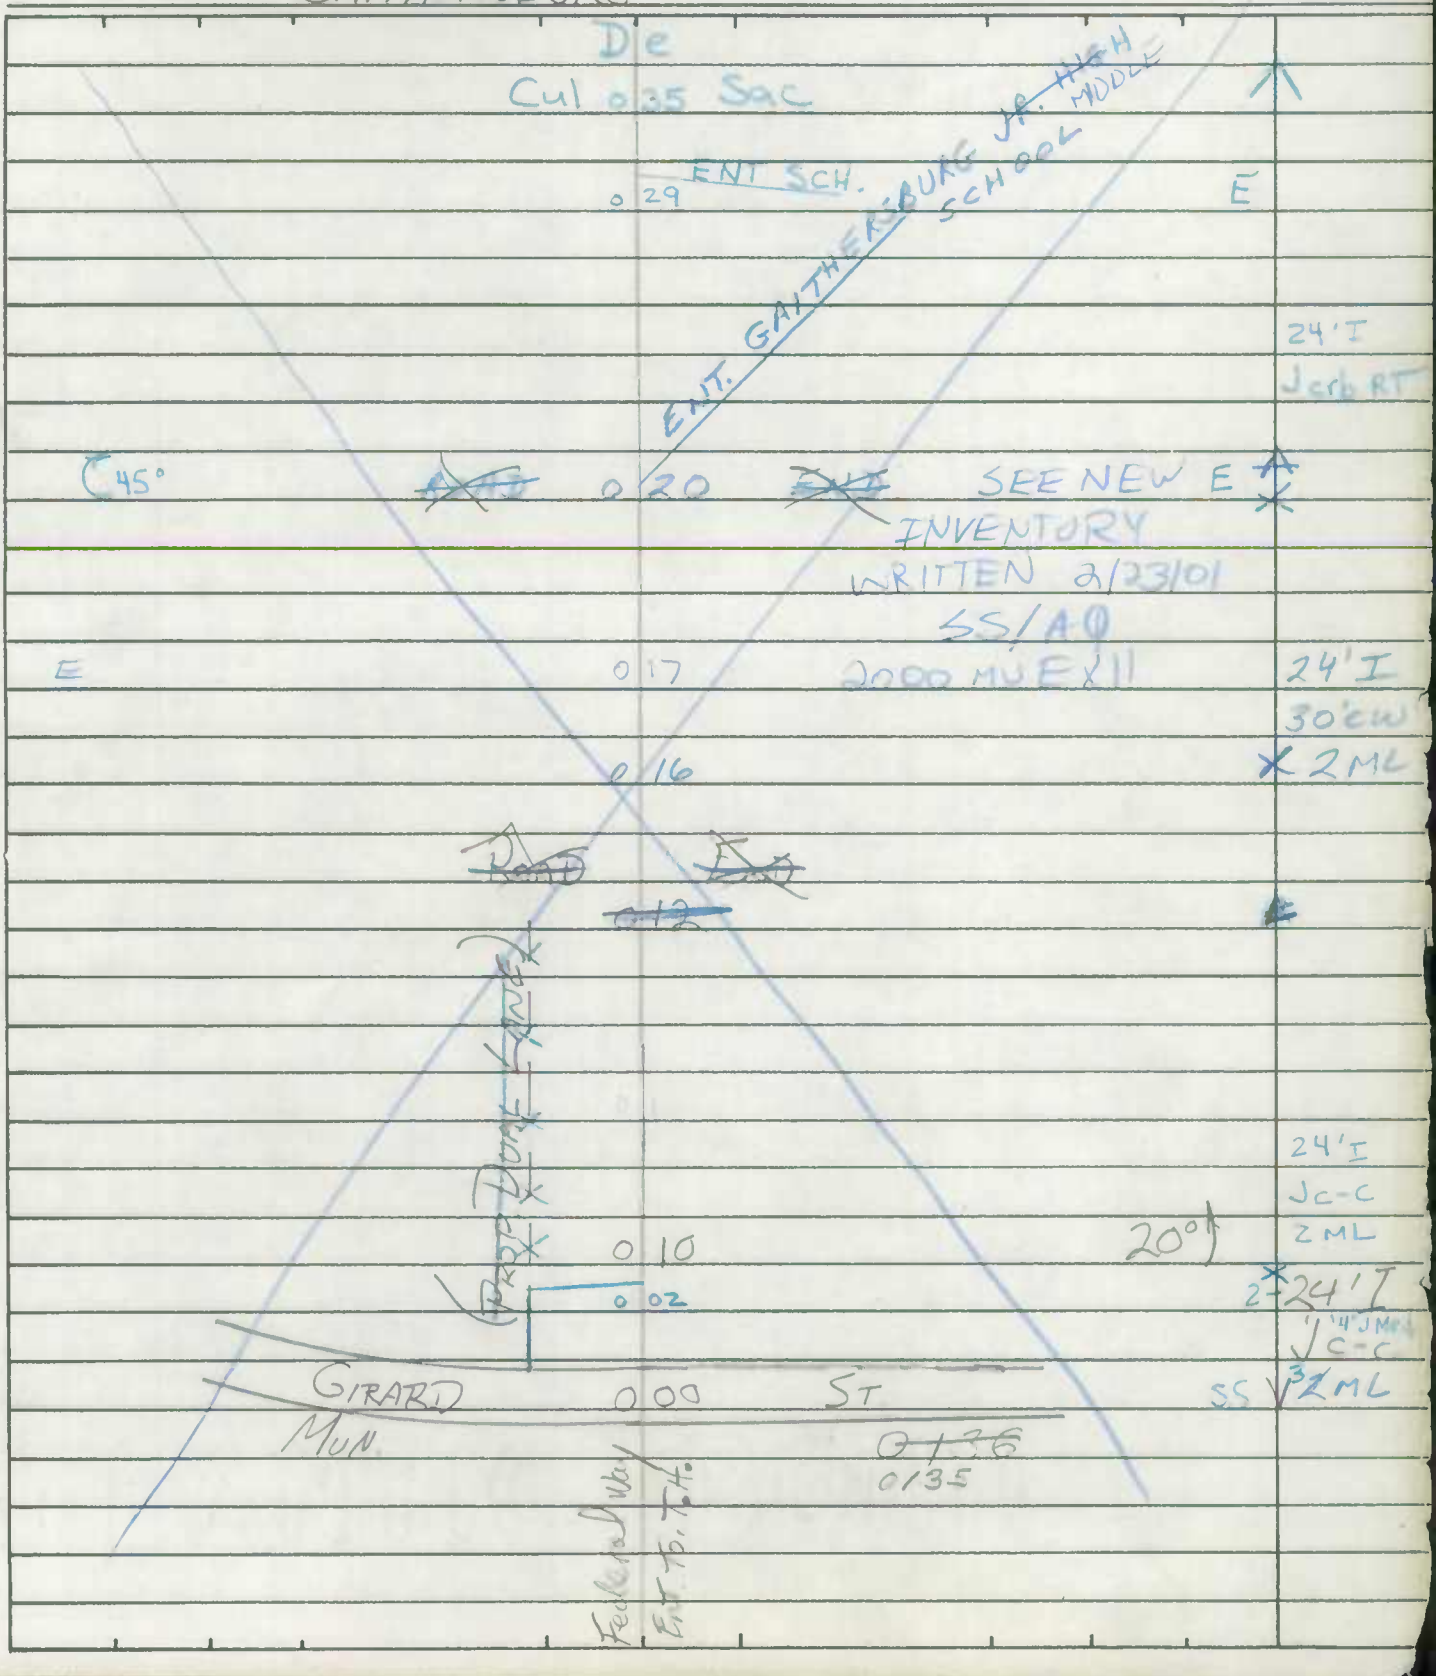

SHA 51.3-8
11-15-72

ROAD INVENTORY SHEET

Road No. _____
Road Name _____
Sheet No. _____
Date _____
County _____
State Coordinates _____

SHA 51.3-8
11-15-72

STATE HIGHWAY ADMINISTRATION OF MARYLAND

ROAD INVENTORY SHEET

Party Chief JE
Recorder BM
Helper

Map No. 84-16

Road No. MUN 0379
Road Name TRAVIS AV
Sheet No. 1 OF 1
Date 8 MAR 1985
County MONTGOMERY
State Coordinates

GAITHERSBURG

SEE MAP

TANYARD HILL RD
MUN 377
0138
0131
26'I
JC-C
0128
WILD FOREST DR
PT
0124 MUN 432
48'I
JC-C
25°
0122
PC
0120
0118
150°
WATKINS MILL RD
MUN
0114 424
(KNOLL MIST LA)
MUN 0176
0110
PT
2-24'I
JCC
0108
25°
19' GR MED
0103
PC
51'I
JC-C
TRAVIS LA
0100 MUN 392

SHA 51.3-8
11-15-72

ROAD INVENTORY SHEET

Road No. _____
Road Name _____
Sheet No. _____
Date _____
County _____
State Coordinates _____

Form 6 HPS (Rev. 1961)

ROAD INVENTORY SHEET

Party Chief FR
Recorder JE
Helper

Road No. MU 0379
Road Name TRAVIS AVE
Sheet No. 1 of 1
Date 5-7-80
County MONT

Gaithersburg
79-19

SEE NEW INV.
84-16
JE/BM

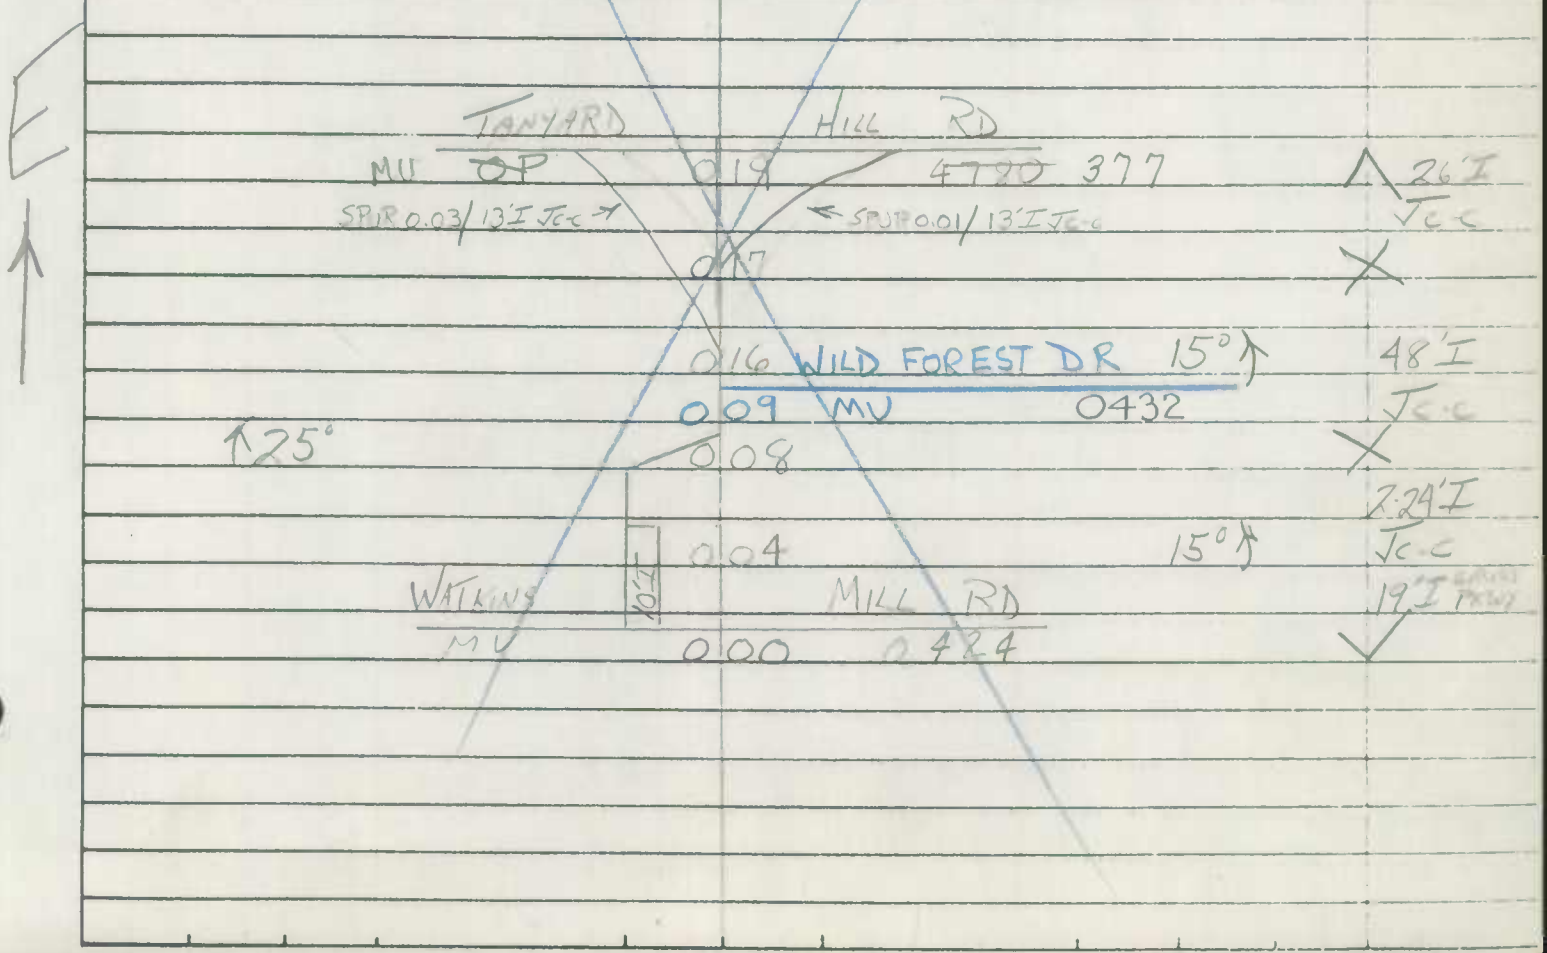

Form 6 HPS (Rev. 1961)

ROAD INVENTORY SHEET

Road No. _____
Road Name _____
Sheet No. _____
Date _____
County _____

SHA 51.3-8
11-15-72

STATE HIGHWAY ADMINISTRATION OF MARYLAND

Gaithersburg

ROAD INVENTORY SHEET

OP 5276
MUN 0386

85-7,8
4-9-86 JE
MB

86-10 ex
JE
CA

Party Chief JE
Recorder BM
Helper

Map No. E-10-A

Road No. ~~OP 5033~~
Road Name (TWIN LAKES DR)
Sheet No. 1 OF 1
Date 12 MAR 1985
County MONTGOMERY
State Coordinates 735-473

84-16 EX

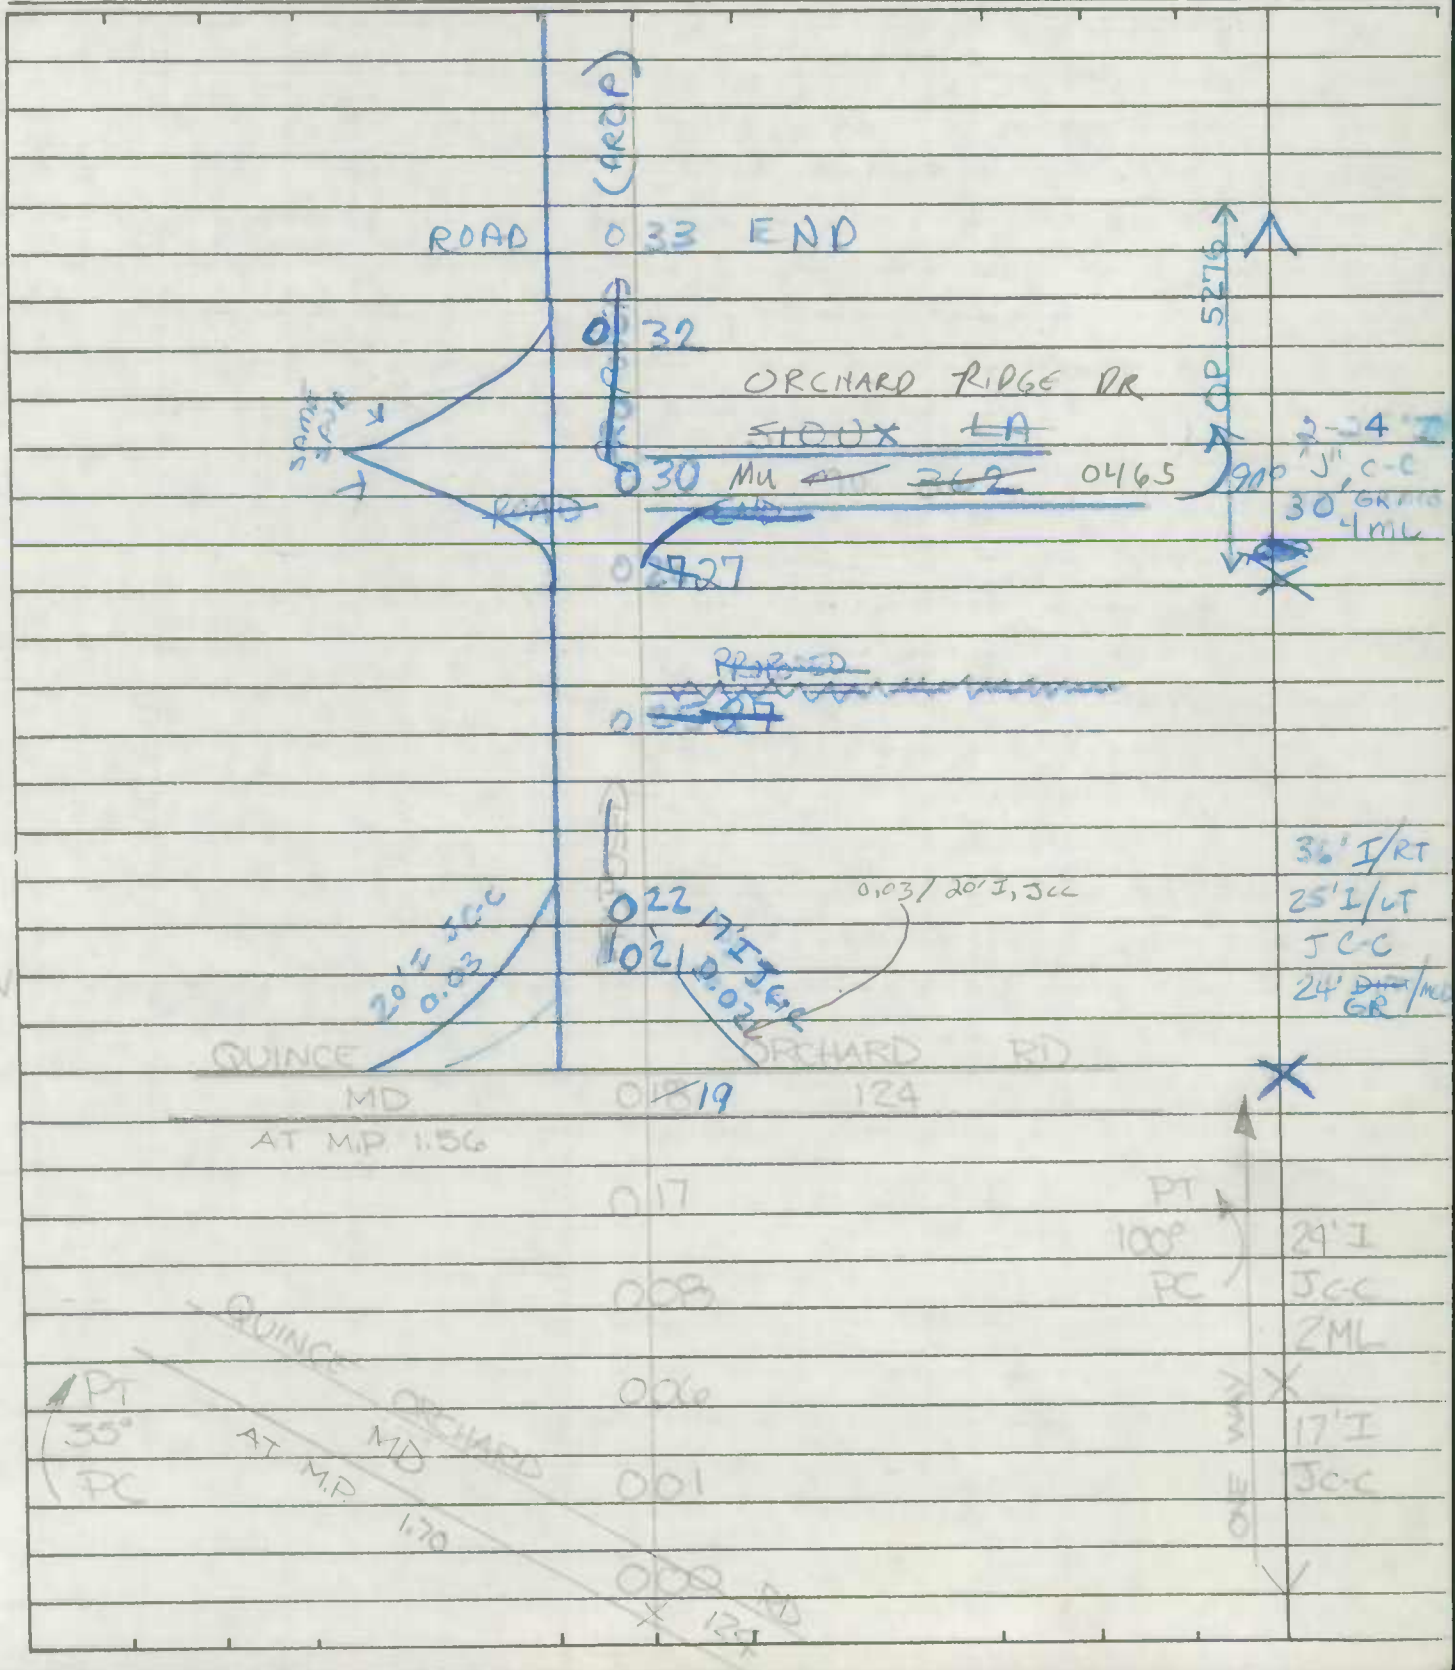

SHA 51.3-8
11-15-72

ROAD INVENTORY SHEET

Road No. _____
Road Name _____
Sheet No. _____
Date _____
County _____
State Coordinates _____

SHA 51.3-8
11-15-72

ROAD INVENTORY SHEET

MUN 0410

Party Chief T. HUDSON
Recorder M. ZALENSKI
Helper

Map No. 36

Road No. ~~Co~~ 216
Road Name CENTRAL AVE
Sheet No. 1 OF 1
Date 10 16 72
County 1
State Coordinate 747-472

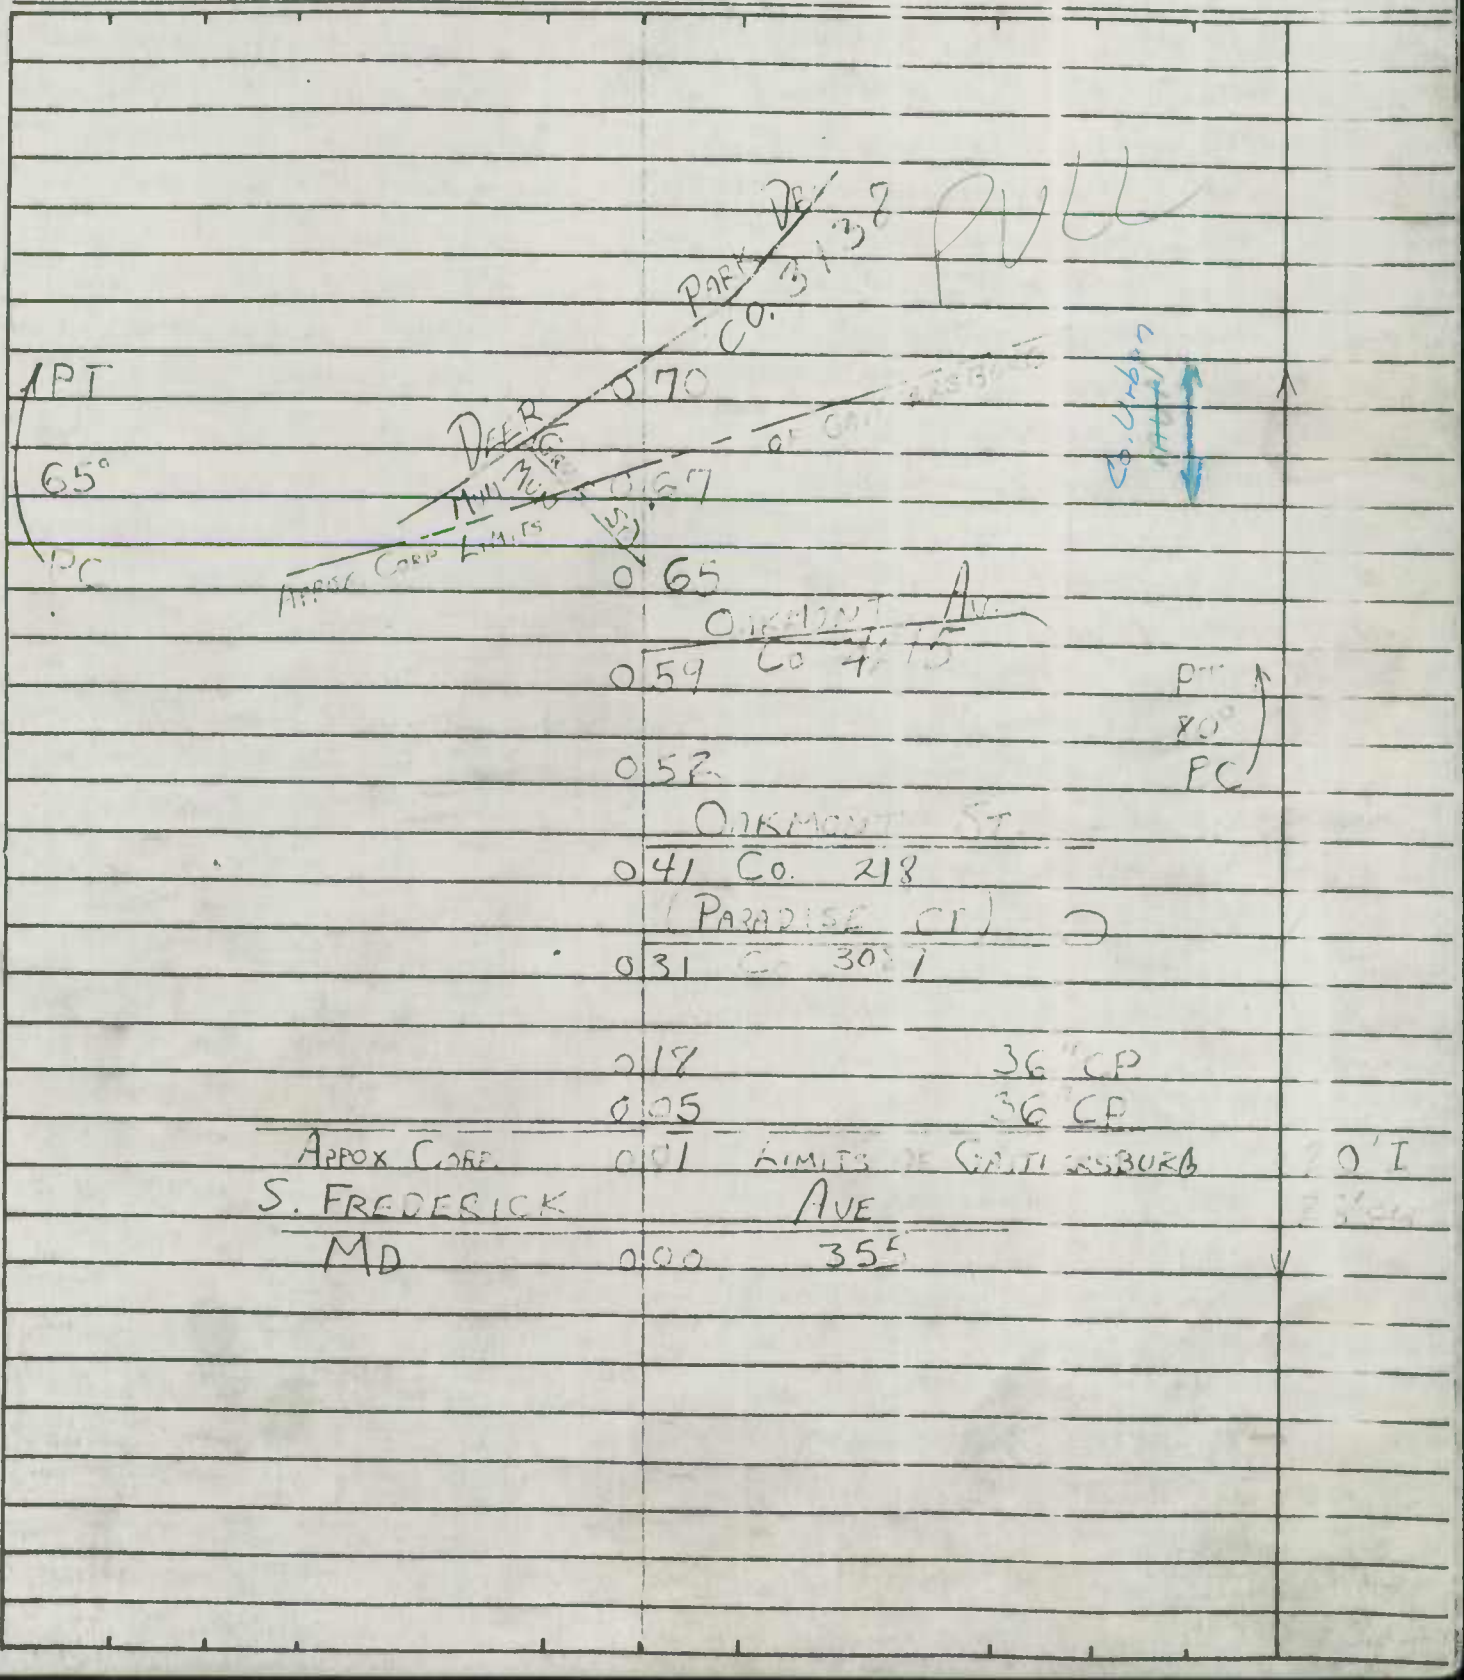

GAITHERSBURG

SHA 51.3 - 8 Revised
4.83

MARYLAND STATE HIGHWAY ADMINISTRATION

ROAD INVENTORY SHEET

MU 0420 88-ex#1

Party Chief CG
Recorder AL
Assistant
Map No./Dir. E-10 C / N
State Coordinates 741 - 474

Road No. Co. 214
Road Name Water St
County Mont.
Date 1-31-89
Sheet No. 1 OF 1

TRAFFIC CODES
TRAFFIC CONTROL: STOP SIGN=S, TRAFFIC LIGHT=T.L., FLASHING RED BALL=F.R.

TRAFFIC CODES
PARKING RESTRICTIONS: A.M. PEAK, P.M. PEAK, A.M./P.M. PEAK, NO PARKING ANYTIME=N.P., COMM/IND. ACCESS=E

SYSTEM				TRAFFIC		LINE DIAGRAM	TRAFFIC			PAVEMENT DATA
FED. AID.	FUNCT CLASS.	HWY. SYS.	HPMS SAMPLE	PKG. REST.	COM/IND ACCESS		CONTROL	COM/IND ACCESS	PKG. REST.	
						Mun. 0210 Ave				
						W. Diamond MD 0 44 117 Ave	SS			26'I on
						12' H 0 43				Taper to 29'I
						0 42				J c-c
										2mL
						0 38				26' I
										J c-rt
										I-c LT
										2mL
						48"CP & 2-30"CMP 0 32 Mills Rd. Mun. 0220				23'I
										I crb LT
										2mL
						0 25 30°				24' I
										J crb LT
						0 11				
						Harmony Hall Rd ~~Mun~~ Of 54030 10 mv 139	SS			23' I
										I crb rt
										2mL
						Muddy Br. CUL 50' 0 00 Sac D c				
						Park Rd 64 W Deer Mun. 01 El				

NON FED AID LOCAL

SYSTEM				TRAFFIC		LINE DIAGRAM	TRAFFIC				PAVEMENT DATA
FED. AID.	FUNCT. CLASS.	HWY. SYS.	HPMS SAMPLE	PKG. REST.	COM/IND ACCESS		CONTROL	COM/IND ACCESS	PKG. REST.		

SHA 51.3-8
11-15-72

ROAD INVENTORY SHEET

MUN 0420

Party Chief T. Cordell
Recorder R. Zehewski
Helper T. Post

Map No. 21

Road No. Co. 214
Road Name WATER ST
Sheet No. 1 of 1
Date 10-24-75
County Mun
State Coordinates 741½ - 474

Gaithersburg

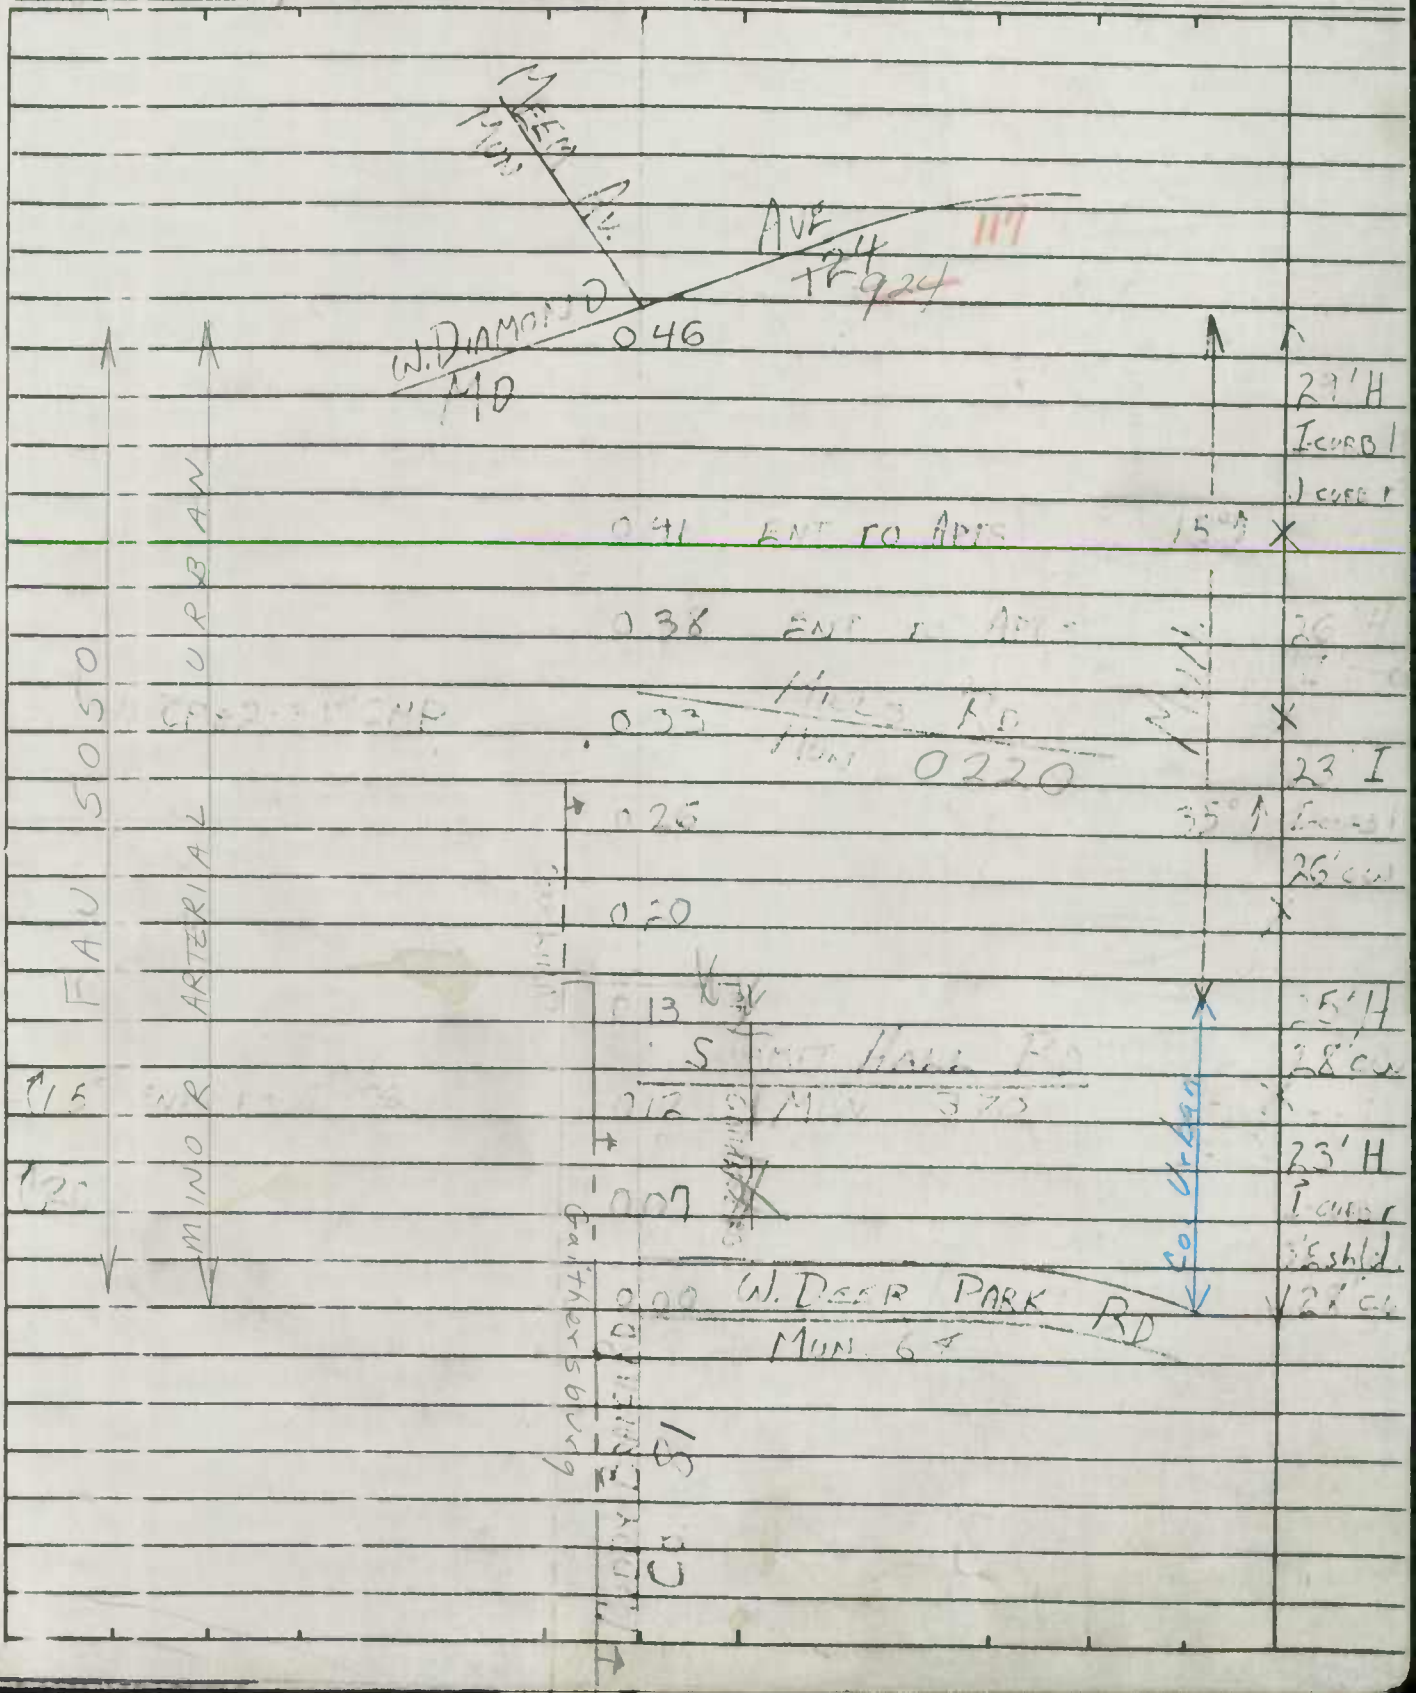

SHA 51..3-8
11-15-72

STATE HIGHWAY ADMINISTRATION OF MARYLAND

603720

ROAD INVENTORY SHEET

MUN

Party Chief W. DOMBROSKI
Recorder M. ZALENSKI
Helper

Map No. 26 & 20
GAITHERSBURG

Road No. ~~Go~~ 0424
Road Name WATKINS MILL RD.
Sheet No. 1 OF 4
Date 2-12-75
County MONT
State Coordinates A/T 82-46

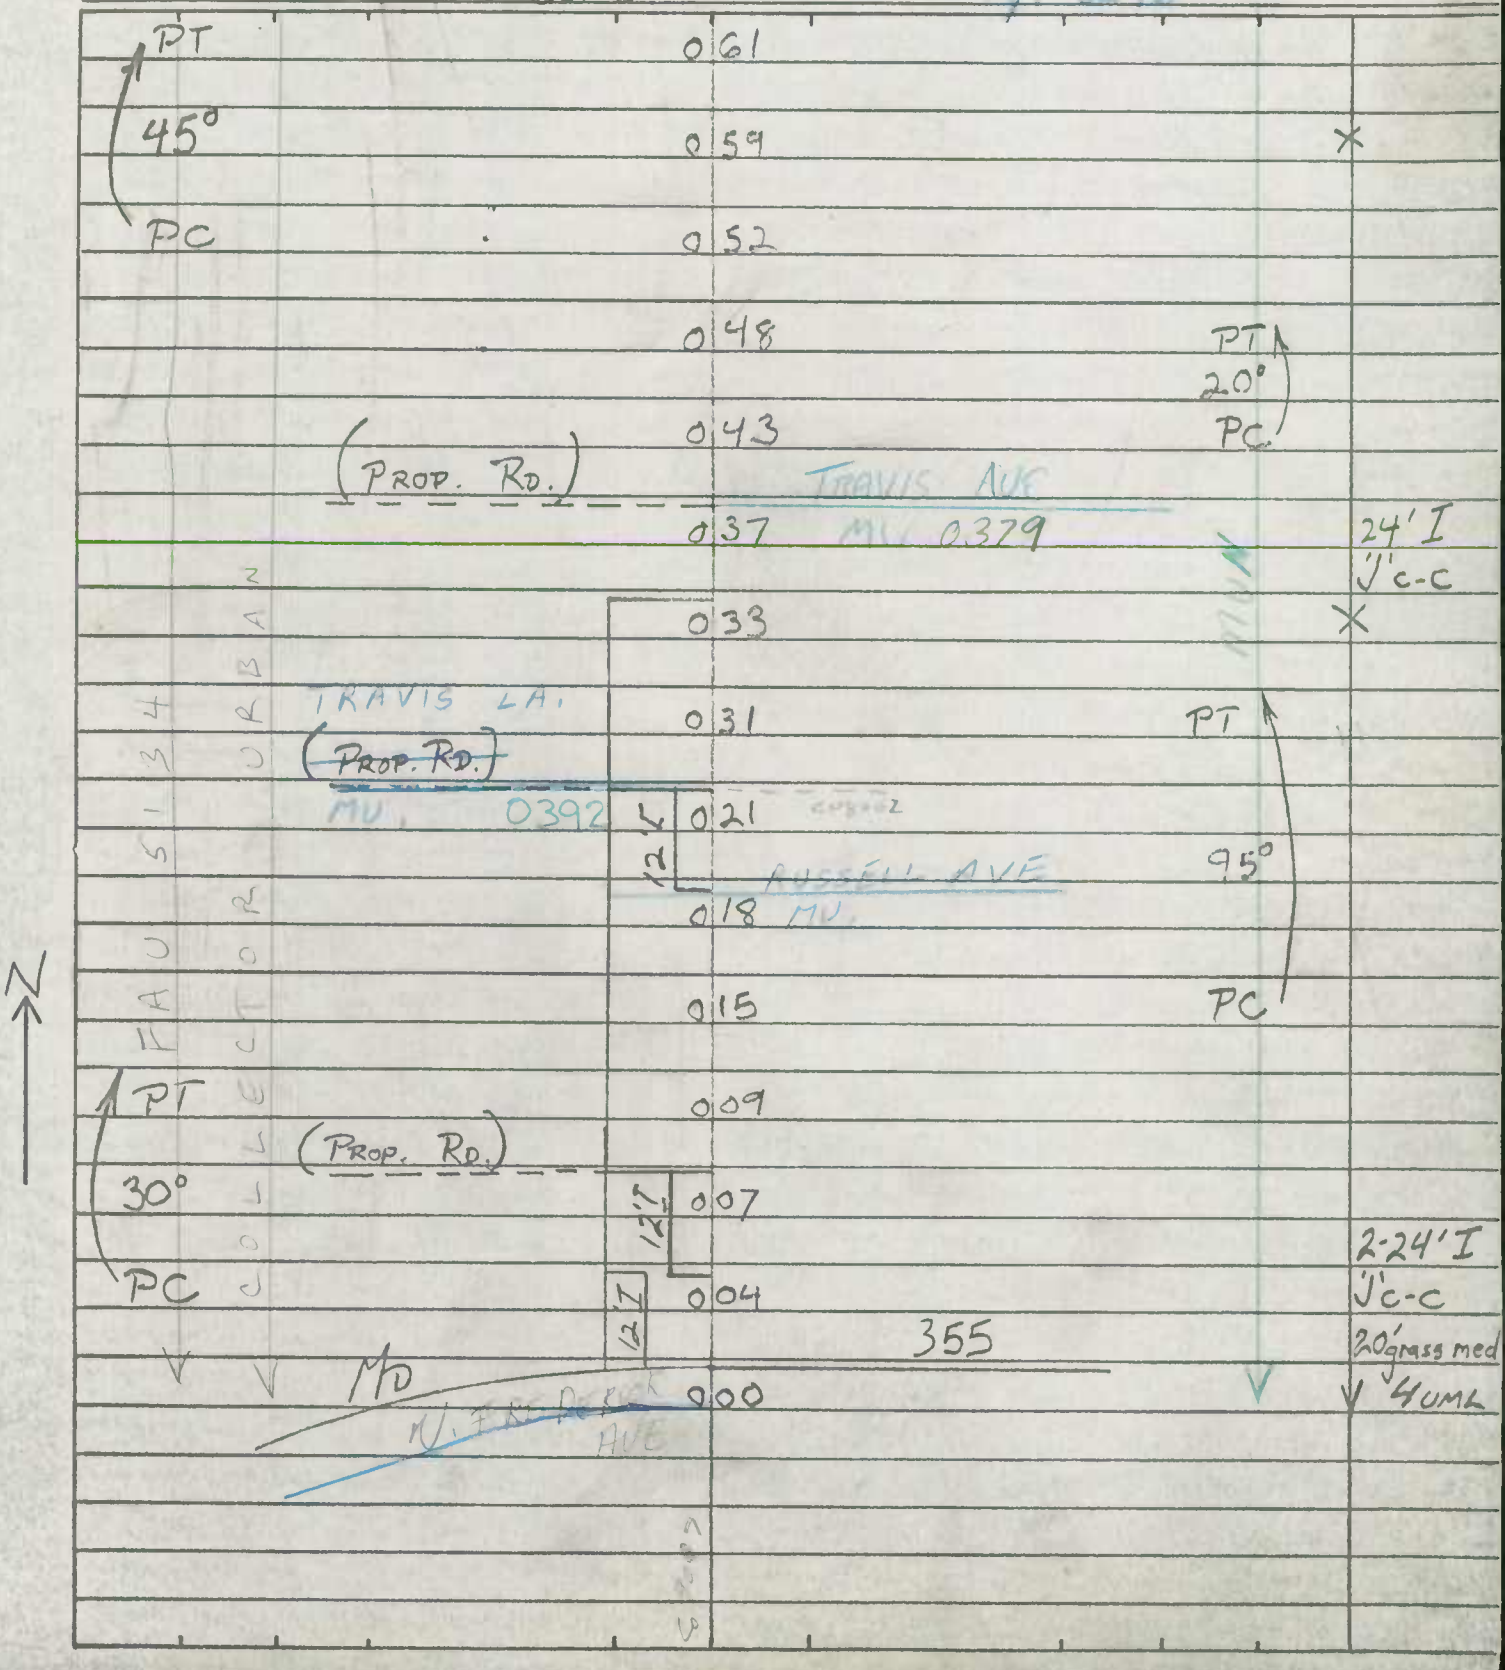

SHA 51.3-8
11-15-72

STATE HIGHWAY ADMINISTRATION OF MARYLAND

ROAD INVENTORY SHEET

Party Chief W. DOMBROSKI
Recorder M. ZALENSKI
Helper

Map No. 26

Road No. MUN 0424
Road Name WATKINS MILL RD
Sheet No. 2 OF 4
Date 2-12-75
County MONT.
State Coordinates

GAITHERSBURG

(PROP. RD.)

1 35

1 28 PC

MONT. VILLAGE
STEDWICK NB. HIGH

1 24 ENT. TO SHOP. CTR.

RD

1 10

KINDLY CT

OP. 182

1 02 PT

PEDESTRIAN 0.98 TUNNEL

40°

SMOOTHSTONE WAY

0 94

COLTFIELD CT

0 89 PC

0 85 WATKINS MILL SCHOOL

WATKINS MILL DR

0 83

44'I
J'c-c

0 82

15°

0 77

← WHEATSTONE

0 70 RUN see br sh. 7A

16'F
22'cw

0 64

ON PAPER
24'I TO
16'I'I c-c

0 63

A U 3 4
A 1
F 5

COLLECTOR
OR
LOCAL

SHA 51.3-8
11-15-72

STATE HIGHWAY ADMINISTRATION OF MARYLAND

ROAD INVENTORY SHEET

Party Chief W. DOMBROSKI
Recorder M. ZALENSKI
Helper

Map No. 26 74-13
GAITHERSBURG

Road No. MUN 0425
Road Name OLD WATKINS MILL RD
Sheet No. 1 OF 1
Date 2-12-75
County MONT
State Coordinates

ABAN.
NOW A CAR DEALER
86-EX 28

N

ROAD END
022
017
MD
355
000
N. FREDERICK AVE
20°
14'E
20'CW

SHA 51.3-8
11-15-72

ROAD INVENTORY SHEET

Road No. _____
Road Name _____
Sheet No. _____
Date _____
County _____
State Coordinates _____

SHA 51.3-8
11-15-72

STATE HIGHWAY ADMINISTRATION OF MARYLAND

ROAD INVENTORY SHEET

Party Chief: T LAWSON
Recorder: M ZALINSKI
Helper:

Map No. 26

Road No. MU 0427
Road Name S WESTLAND DR.
Sheet No. Lot 1
Date 10-16-73
County MONT
State Coordinates 750-472

Revised 8-26-81 ITE

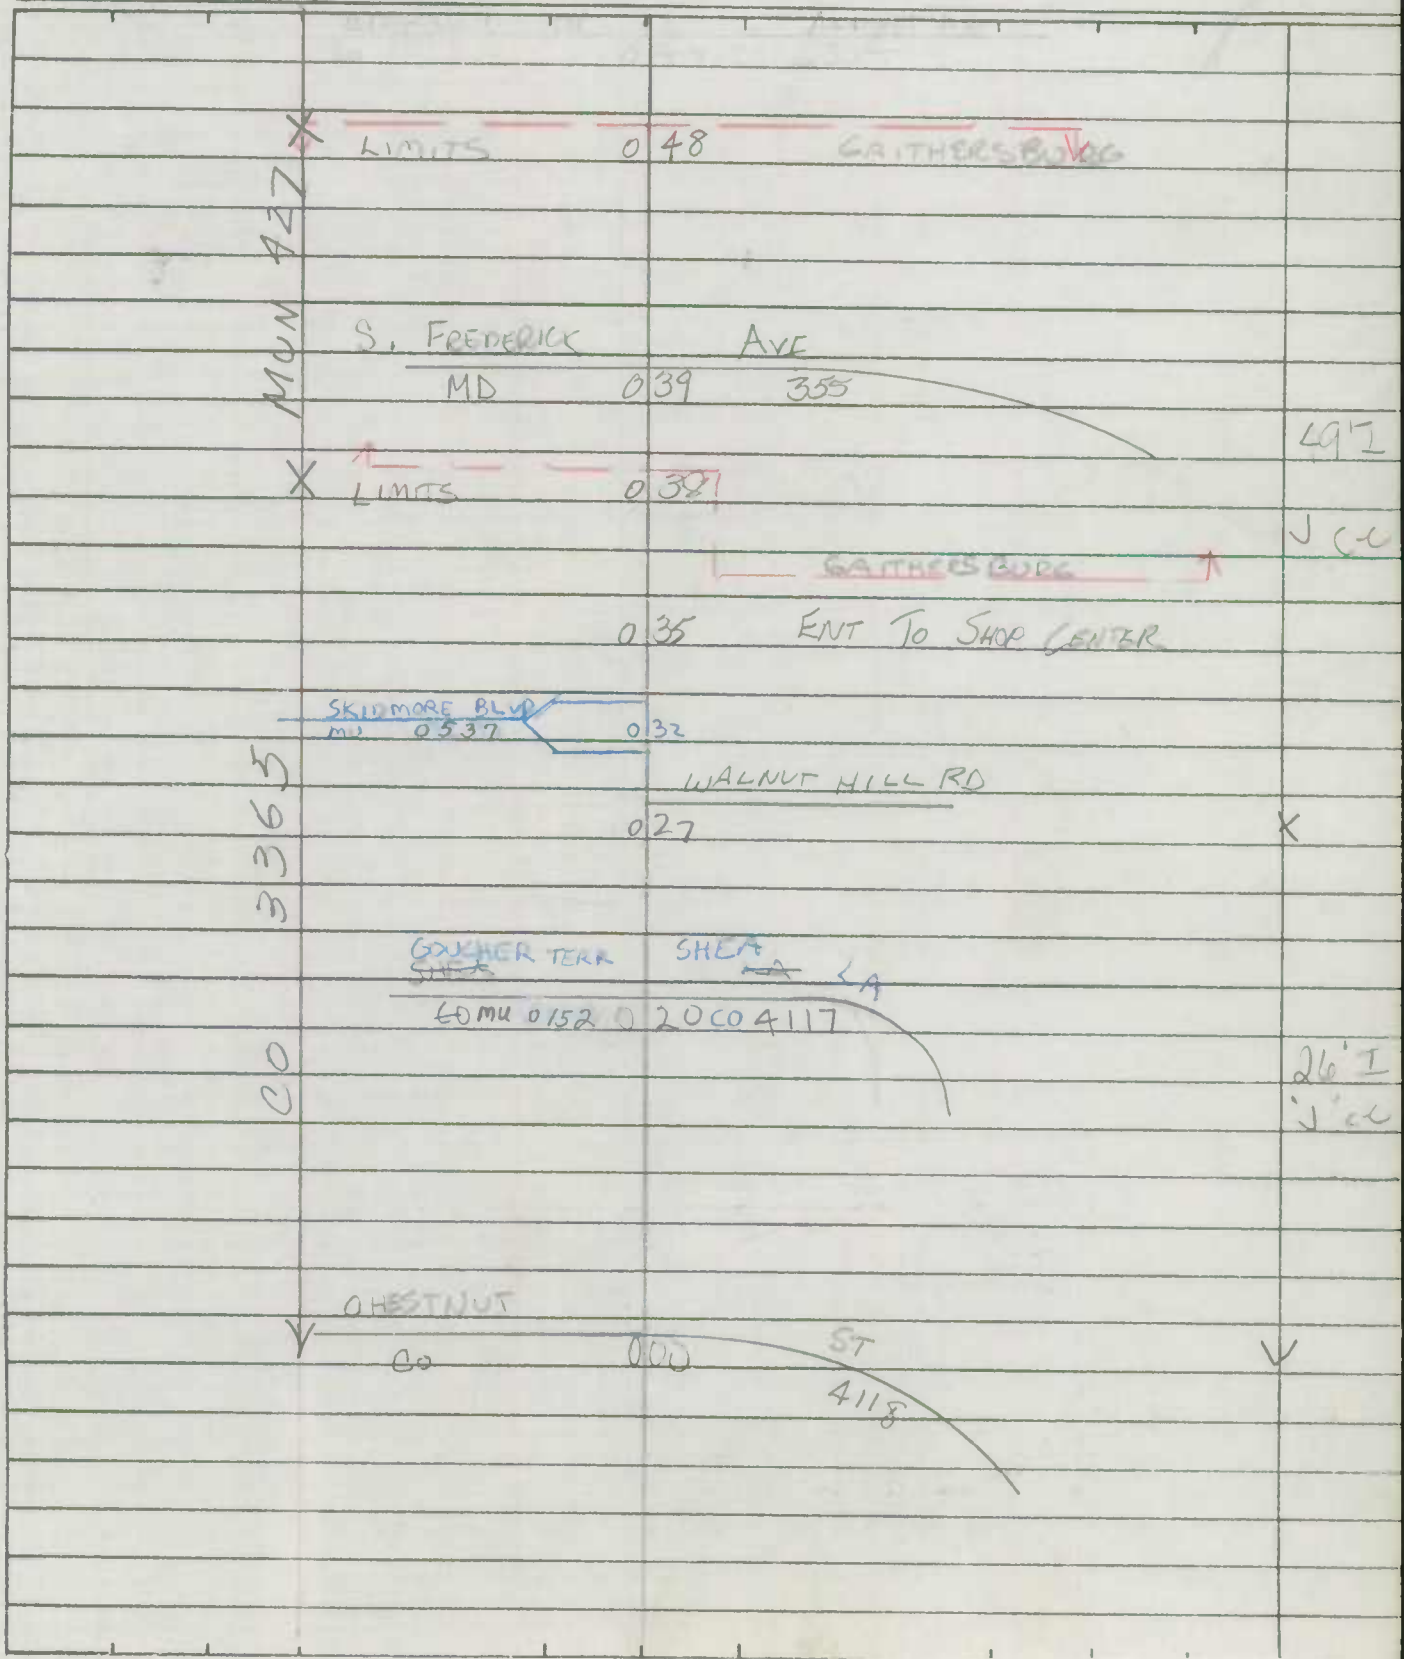

SHA 51.3-8
11-15-72

ROAD INVENTORY SHEET

Road No. _____
Road Name _____
Sheet No. _____
Date _____
County _____
State Coordinates _____

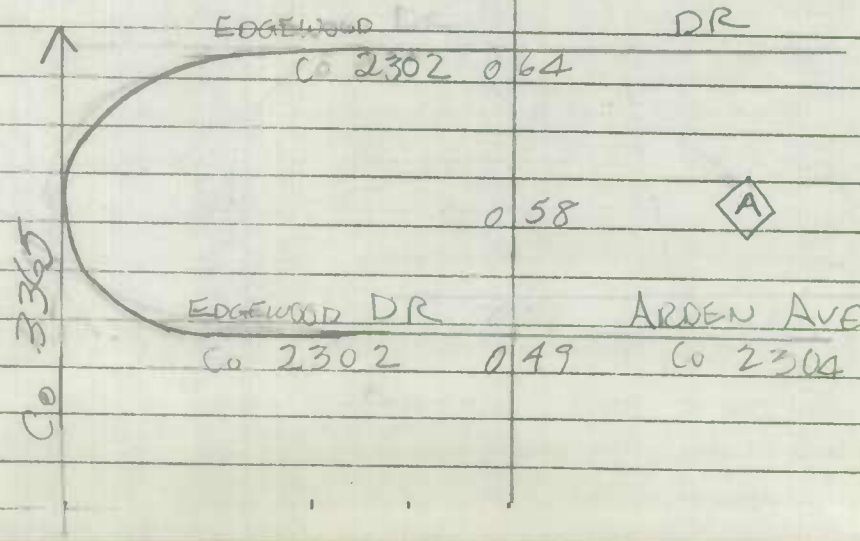

SHA 51.3-8
11-15-72

MUN 0427

ROAD INVENTORY SHEET

Party Chief T. L.
Recorder
Helper

Map No. 26

Road No. ~~Co~~ 3365
Road Name S. WOODLAND DR
Sheet No. 1 of 1
Date 7-16-73
County
State Coordinates 750-472

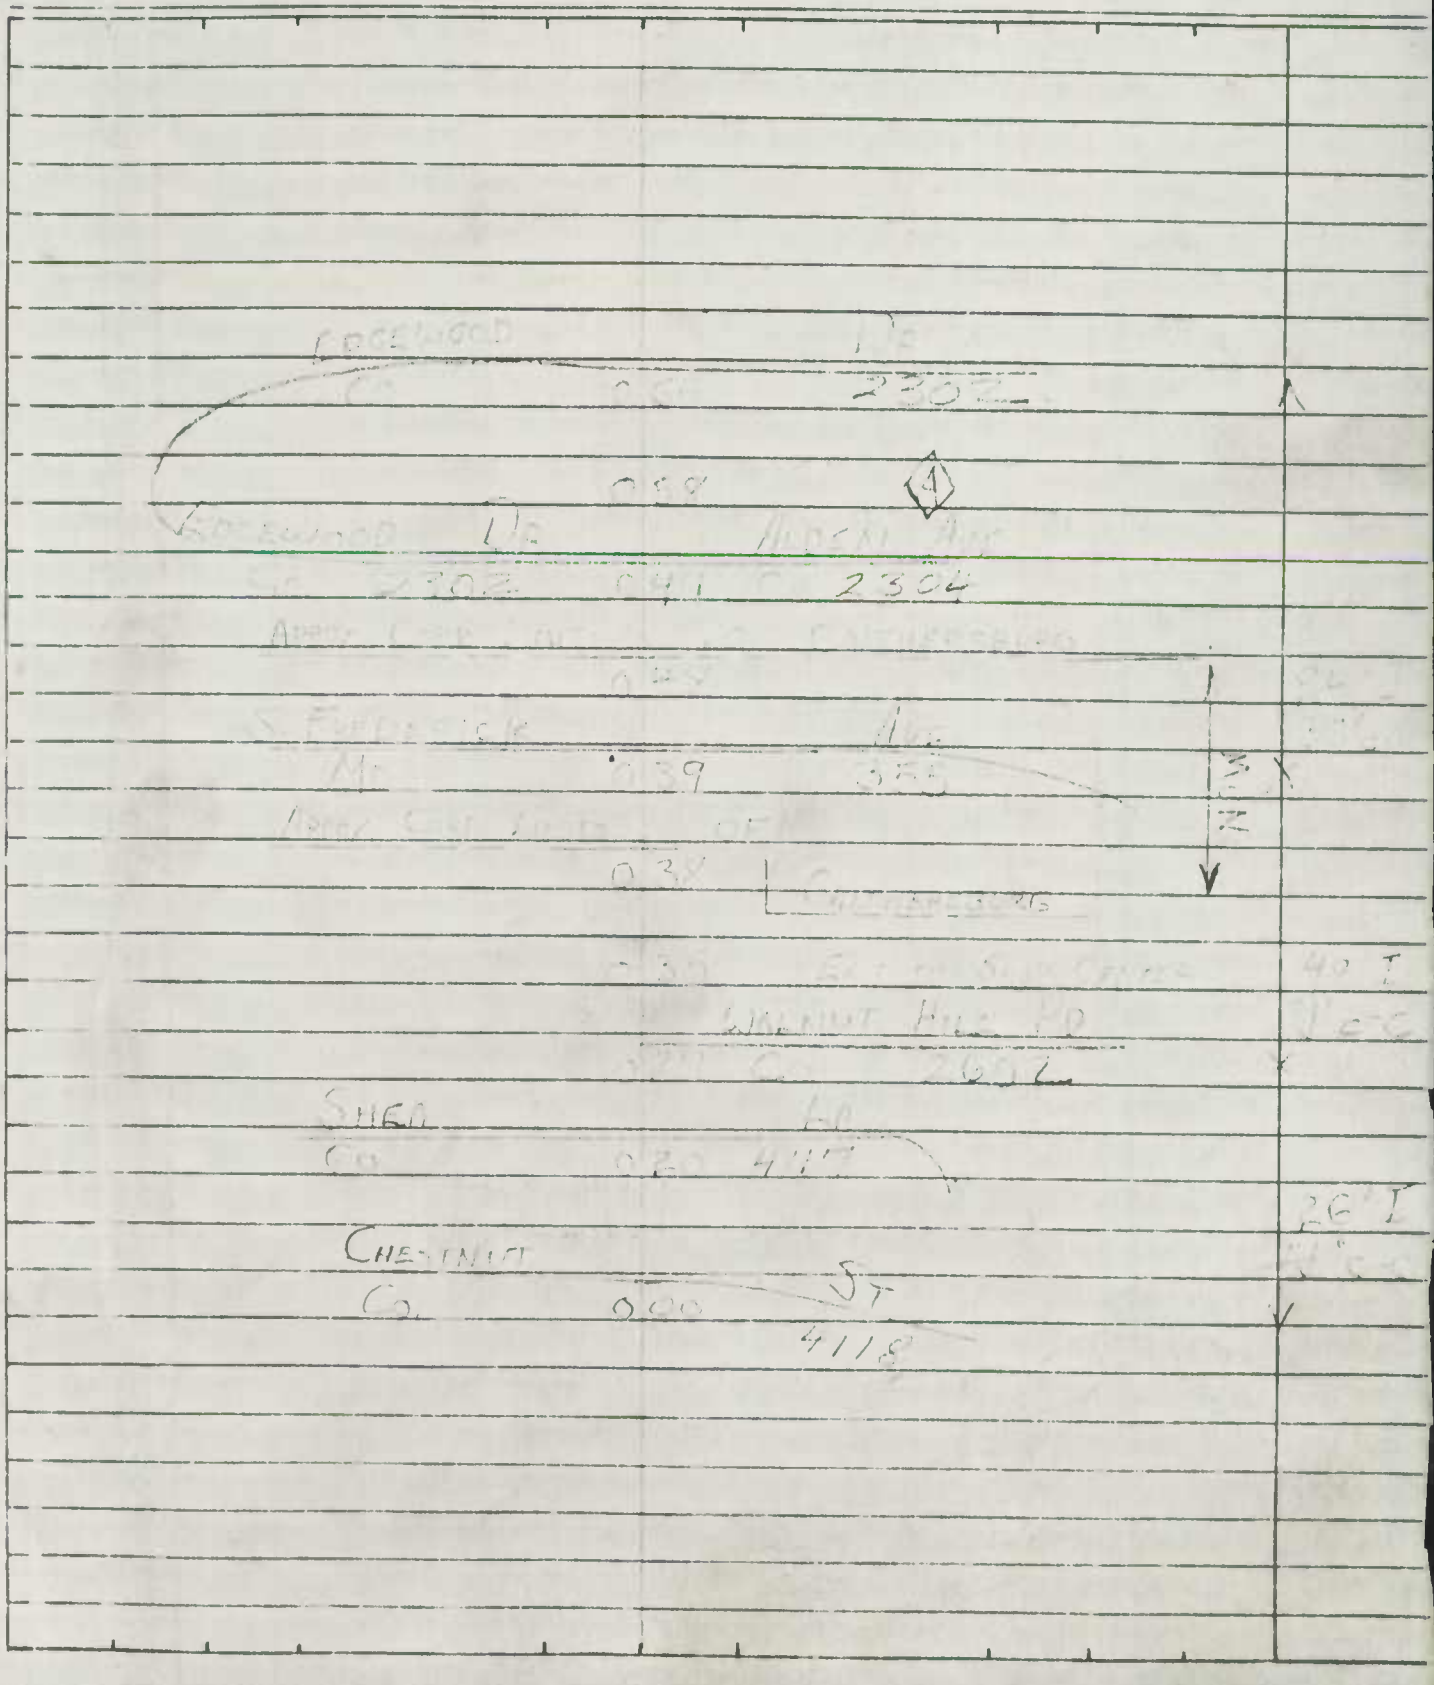

SHA 51.3-8
11-15-72

STATE HIGHWAY ADMINISTRATION OF MARYLAND

ROAD INVENTORY SHEET

Party Chief BB
Recorder NS
Helper

Map No. 83-4
GAITHERSBURG

Road No. MUN 0434
Road Name WINDJAMMER WAY
Sheet No. 1 OF 1
Date 3/14/84
County MONTGOMERY
State Coordinates

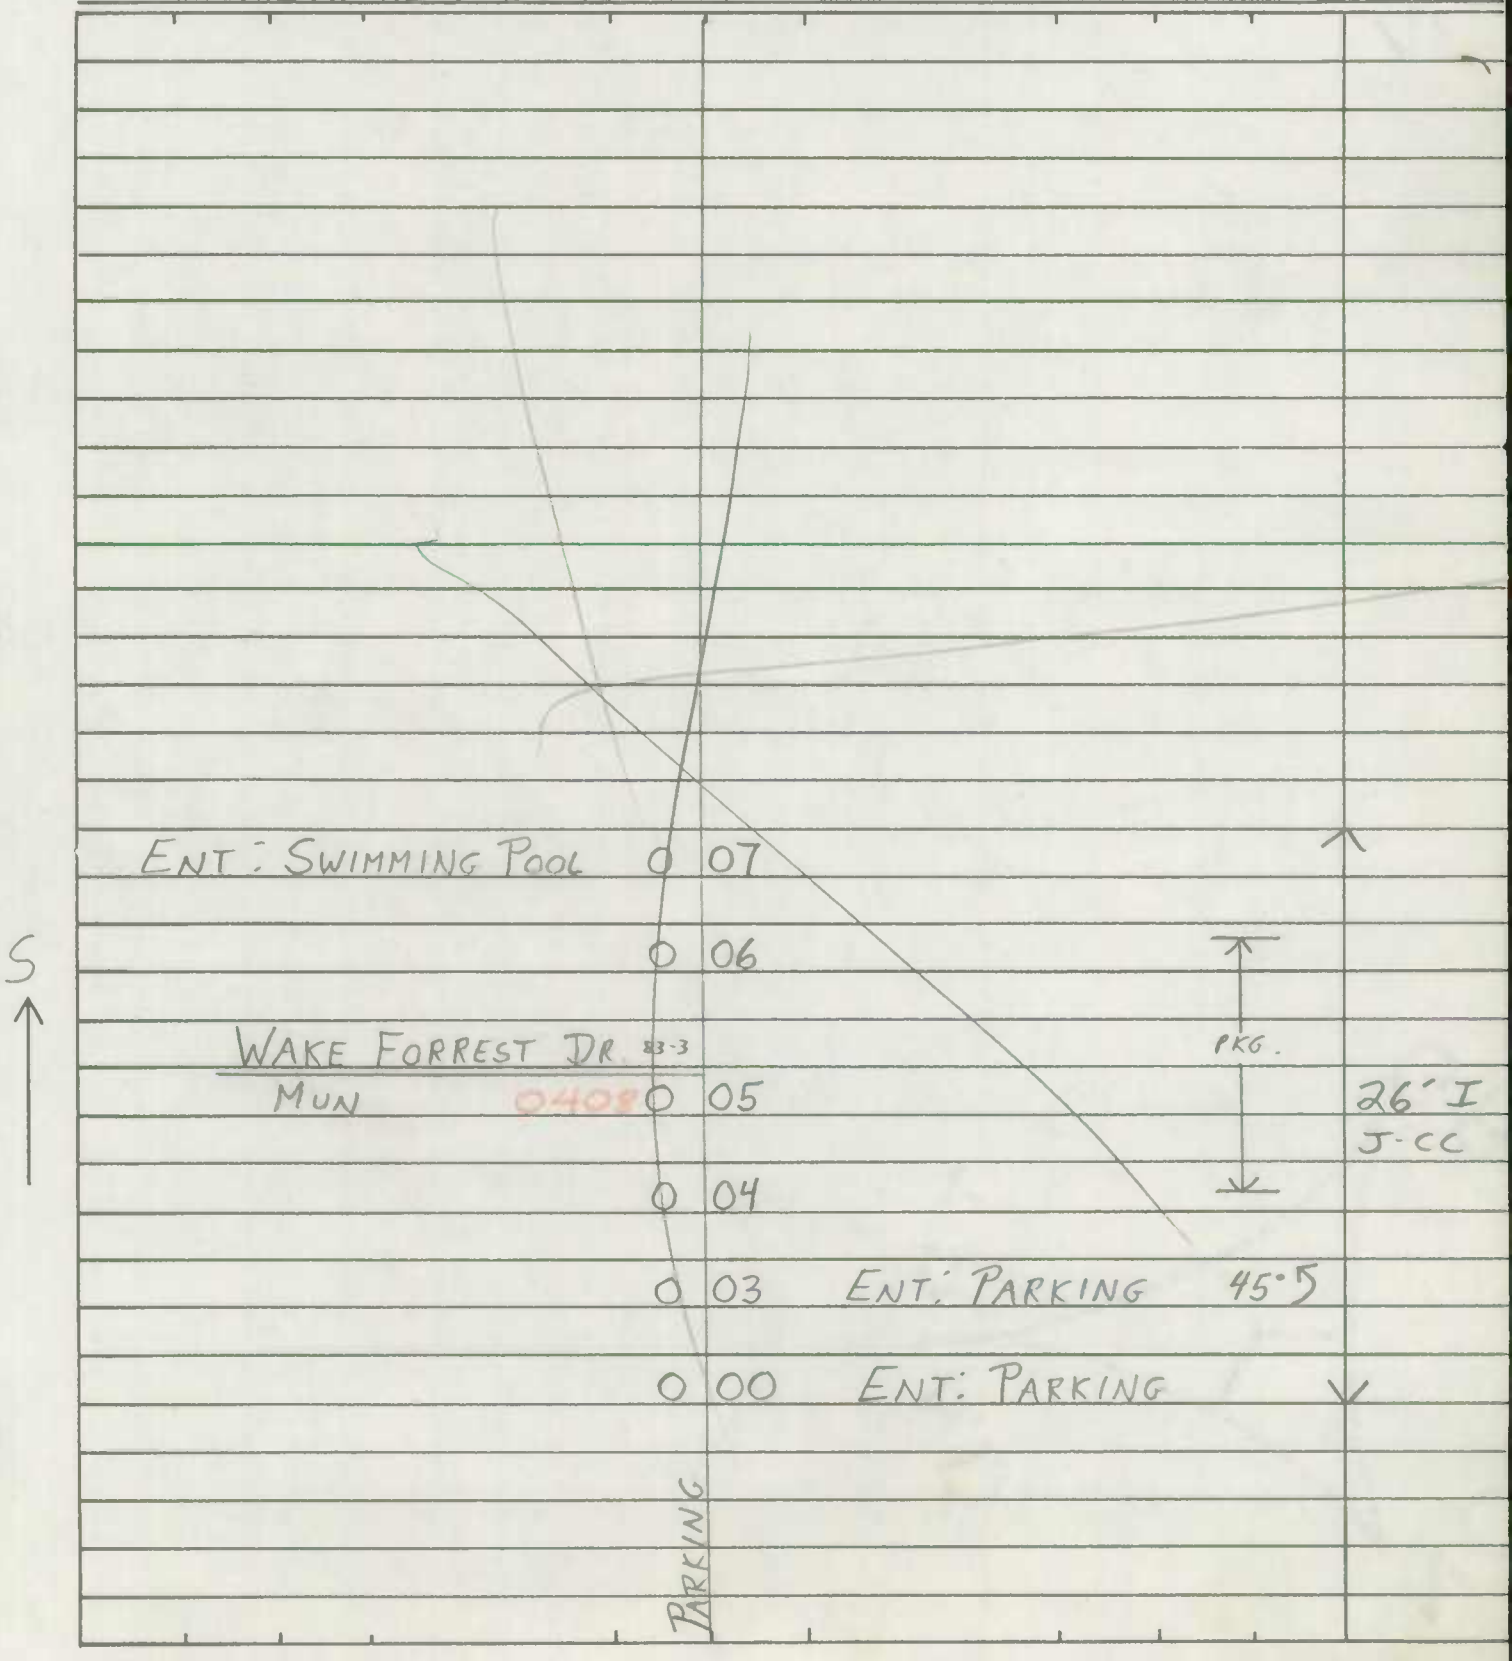

SHA 51.3-8
11-15-72

ROAD INVENTORY SHEET

Road No. _____
Road Name _____
Sheet No. _____
Date _____
County _____
State Coordinates _____

SHA 51.3-8
11-15-72

STATE HIGHWAY ADMINISTRATION OF MARYLAND

Was part of MD 124
Transfer Agreement 1/16/86

ROAD INVENTORY SHEET

85 - EXTRA
JE
MB
4-10-86

Party Chief JE
Recorder BM
Helper

Road No. MUN 0450
Road Name OLD SECTION MD 124 ZZZ
Sheet No. 1 OF 1
Date 12 MAR 1985
County MONTGOMERY
State Coordinates 730-472

92 MU. EX #8 A/T

Map No. E-10-A

84-17

~~QUINCE~~ ~~MD~~

~~ORCHARD~~ ~~RD~~

~~BARRICADE~~

~~BARRICADE~~

NE

ROAD END

0 10

24'I
30'CW

9'I
10'ESHLDR
40'CW
2ML

LONSDRAFT RD
130° CO 009 223

QUINCE ORCHARD SWIM AND TENNIS CLUB 000

36'I
SC-LT
4'GSHLDR

ROAD 000 END

SHA 51.3-8
11-15-72

ROAD INVENTORY SHEET

Road No. _____
Road Name _____
Sheet No. _____
Date _____
County _____
State Coordinates _____

SHA 51.3 - 8 Revised
4.83

MARYLAND STATE HIGHWAY ADMINISTRATION

ORCHARD RIDGE DR
(87-5)
WB/CG
4-6-88

MU
0465
86-10

ROAD INVENTORY SHEET

Party Chief JE
Recorder CA
Assistant
Map No./Dir. 1 N
State Coordinates

Road No. ~~MUN 362~~
Road Name ~~SOLUX LA~~
County MONT
Date 4-9-87
Sheet No. 1 OF

GAITHERSBURG

LINE DIAGRAM

SYSTEM: FED. AID. | FUNCT CLASS. | HWY. SYS. | HPMS SAMPLE
TRAFFIC: PRKG. REST. | COM/IND. ACCESS
TRAFFIC: CONTROL | COM/IND. ACCESS | PRKG. REST.
PAVEMENT DATA

TRAFFIC CODES
TRAFFIC CONTROLS: STOP SIGN=SS, TRAFFIC LIGHT=T.L., FLASHING RED BALL=F.R.

TRAFFIC CODES
PARKING RESTRICTIONS: A.M. PEAK, P.M. PEAK, A.M./P.M. PEAK, NO PARKING ANYTIME=N.P., COMM/IND. ACCESS=E

POLK CT
BAY RIDGE DR
0362 0 B8 E MUN 29
43'I
"J" C-C
2mL
DOSH DR
MUN 83
OLD SR MD 24
SOLUX LA
MU 362
MU 0362
0 32
30°
87-5
2-24'I
"J" C-C
41' I-mod
4mL
0 26 124
17'I-mod
"J" C-C
24'I-mod
0 23
0 21
PT
45°
PC
ORCHARD RIDGE DR (87-5)
10'I
0 11
10'I
0 08
E
0 05
I, 01
0 02
2-24'I
"J" C-C
30'I-mod
0 01
TWIN LAKES DR
0 00 MU 386
4mL
TWIN LAKES DR

SYSTEM				TRAFFIC		LINE DIAGRAM	TRAFFIC			PAVEMENT DATA
FED. AID.	FUNCT. CLASS.	HWY. SYS.	HPMS SAMPLE	PRKG. REST.	COM/IND ACCESS		CONTROL	COM/IND ACCESS	PRKG. REST.	

SHA 51.3 - 8 Revised
4.83

MARYLAND STATE HIGHWAY ADMINISTRATION

GAITHERSBURG

ROAD INVENTORY SHEET

Party Chief WB
Recorder CG
Assistant
Map No./Dir. (E-10B) / IV
State Coordinates 750-480

Road No. MU 0469
Road Name ~~COLONIAL~~ AVE.
County MONT
Date 4-6-88
Sheet No. 1 OF 1

SYSTEM				TRAFFIC		LINE DIAGRAM	TRAFFIC			PAVEMENT DATA
FED. AID.	FUNCT CLASS.	HWY. SYS.	HPMS SAMPLE	PKG. REST.	COM/IND. ACCESS		CONTROL	COM/IND. ACCESS	PKG. REST.	
	7									

ROAD 0.54 END

0.49

0.41

PKG.

MU 0477

VICTORY FARM DR.

Bristol Dr

MU 0493

MU 0470

PC

Cross Limits of Gaithersburg

0.02

0.00

2-36' HI

2-24' J
3 C-C OUT
20' GR MW

24' I RT
36' I LT
15' C

TRAFFIC CODES

TRAFFIC CONTROLS: STOP SIGN=S.S., TRAFFIC LIGHT=T.L., FLASHING RED BALL=F.R.

TRAFFIC CODES

PARKING RESTRICTIONS: A.M. PEAK, P.M. PEAK, A.M./P.M. PEAK, NO PARKING ANYTIME=N.P., COMM/IND. ACCESS=E

SYSTEM				TRAFFIC		LINE DIAGRAM	TRAFFIC			PAVEMENT DATA
FED. AID.	FUNCT. CLASS.	HWY. SYS.	HPMS SAMPLE	PRKG. REST.	COM/IND ACCESS		CONTROL	COM/IND ACCESS	PRKG. REST.	

SHA 51.3 - 8 Revised 4.83

99 MU EX #1 Gaithersburg 91-8

MARYLAND STATE HIGHWAY ADMINISTRATION

CG/TA 4-17-00 23-2, MU EX #2

ROAD INVENTORY SHEET

KENTLANDS BLVD

92-1 2-11-93 BB/JS

Party Chief GD
Recorder JK
Assistant
Map No./Dir. 1 S
State Coordinates

Road No. Mu 0532
Road Name ~~Longdraft Rd~~
County Montgomery
Date 3-6-92
Sheet No. 1 OF X 23

TRAFFIC CODES
TRAFFIC CONTROLS: STOP SIGN=SS, TRAFFIC LIGHT=T.L., FLASHING RED BALL=F.R.

TRAFFIC CODES
PARKING RESTRICTIONS: A.M. PEAK, P.M. PEAK, A.M./P.M. PEAK, NO PARKING ANYTIME=N.P., COMM/IND. ACCESS=E

SYSTEM				TRAFFIC		LINE DIAGRAM	TRAFFIC			PAVEMENT DATA
FED. AID.	FUNCT CLASS.	HWY. SYS.	HPMS SAMPLE	PRKG. REST.	COM/IND. ACCESS		CONTROL	COM/IND. ACCESS	PRKG. REST.	
						014 PC				
						10' LTL 013				
						Square CT PT Tshiffely Sq. Rd				
						Beacon Oil #7449 ENT. 010				
						Apts. Mu 0398				
						10' LTL				
						008 SNI 99-MU-EX #1 CG/TA 4-19-00				
						007 PT				
						40°				2-30'I
						003 PC				22'Grsmed
						10' LTL				4 Jcrbs
						Quince Orchard Rd				2 UML
						MD 000 124 @ J. 81	TL			
						Co 223 Longdraft Rd				

SYSTEM: FED. AID. | FUNCT. CLASS. | HWY. SYS. | HPMS SAMPLE

TRAFFIC: PRKG. REST. | COM/IND ACCESS

LINE DIAGRAM

TRAFFIC: CONTROL | COM/IND ACCESS | PRKG. REST.

PAVEMENT DATA

0.59
Market ST
0.58 Mu 0580
0.57
0.54
0.50
10' 2LT
SN1
99-MUA-EX#1
CG/TA
4-19-00
0.46
0.44
0.40
MAIN ST
SC. ROUND ABOUT
ROUND ABOUT
0.38 Mu 0212
0.36
0.36
0.32
ST
0.29 0053
10' LT
0.27
PT
30'
PRC
0.22
0.19
PRC
30'

2-36'I
JC-C IN/OUT
9'GRS MED
4 ML
2-36'I
9'GRS MED
2-24'I IN
JC-C IN/OUT
6'GRS MED
4 ML
5 ML
2-36'I
JC-C IN/OUT
9'GRS MED
4 ML
26'I RT
24'I LT
26 GRS MED
JCC
2 UML
2-24'I
50'GRS MED
JC-C
1 UML
2-24'I
22 GRS MED
JCC
2 UML
2-30'I
22'GRS MED
4 Jcrbs
2 UML

GAITHERSBURG

Wash. Urban

98-11
12/15/98
SS/RB

SHA 51.3 - 8 Revised
4.83

MARYLAND STATE HIGHWAY ADMINISTRATION

ROAD INVENTORY SHEET ~~OP~~ 5944

Party Chief SNYDER
Recorder BOOTH
Assistant
Map No./Dir. (E10) / N
State Coordinates 733-468

Road No. MU 0581
Road Name E. MARKET ST
County MONTGOMERY
Date 12/15/98
Sheet No. 1 OF 1

00-5

TRAFFIC CODES
TRAFFIC CONTROLS: STOP SIGN-SS, TRAFFIC LIGHT=T.L., FLASHING RED BALL=F.R.

TRAFFIC CODES
PARKING RESTRICTIONS: A.M. PEAK, P.M. PEAK, A.M./P.M. PEAK, NO PARKING ANYTIME=N.P., COMM/IND. ACCESS=E

SYSTEM				TRAFFIC		LINE DIAGRAM	TRAFFIC			PAVEMENT DATA
	FUNCT CLASS	HWY SYS	HPMS SAMPLE	PKG. REST.	COMM/IND ACCESS		CONTROL	COMM/IND ACCESS	PKG. REST.	
						See new Inv written 01/30/02				
						Line # 01-3 MU				
						SS/WP				
						CENTER POINT WAY				
						OP 0 18 5948	SS			
						0.16				
						PIKE				
						ONE WAY 10'-11" HERD-IN				
				E		LAKELANDS VISITOR CNTR 0 12				24'G
										JC-C
						MAIN 0 11				1 UML
						MU ST				
						0 10				
						0212				
						0.33				
						(PROP) 0 08				
						0 05 (PROP)				
										34'I
										JC-C
						GOLDEN ASH WAY				2UML
						~~OP~~ MU 0 00 ~~5946~~ 0136	SS			
						0.26				
						(PROP)				

COUNTY _____ ROAD NO. _____ PAGE ___ OF ___

SYSTEM				TRAFFIC		LINE DIAGRAM	TRAFFIC				PAVEMENT DATA
FUNCT. CLASS	HWY SYS	HPMS SAMPLE		PKG. REST.	COM/IND ACCESS		ON-STREET	COM/IND ACCESS	PKG. REST.		

SHA 51.3-8
11-15-72

ROAD INVENTORY SHEET

"B" ST

Road No. Md. 924 ILT
Road Name CLOPPER RD
Sheet No. 2 OF 2
Date 12-10-74
County MONTGOMERY
State Coordinates

25T

Gaithersburg

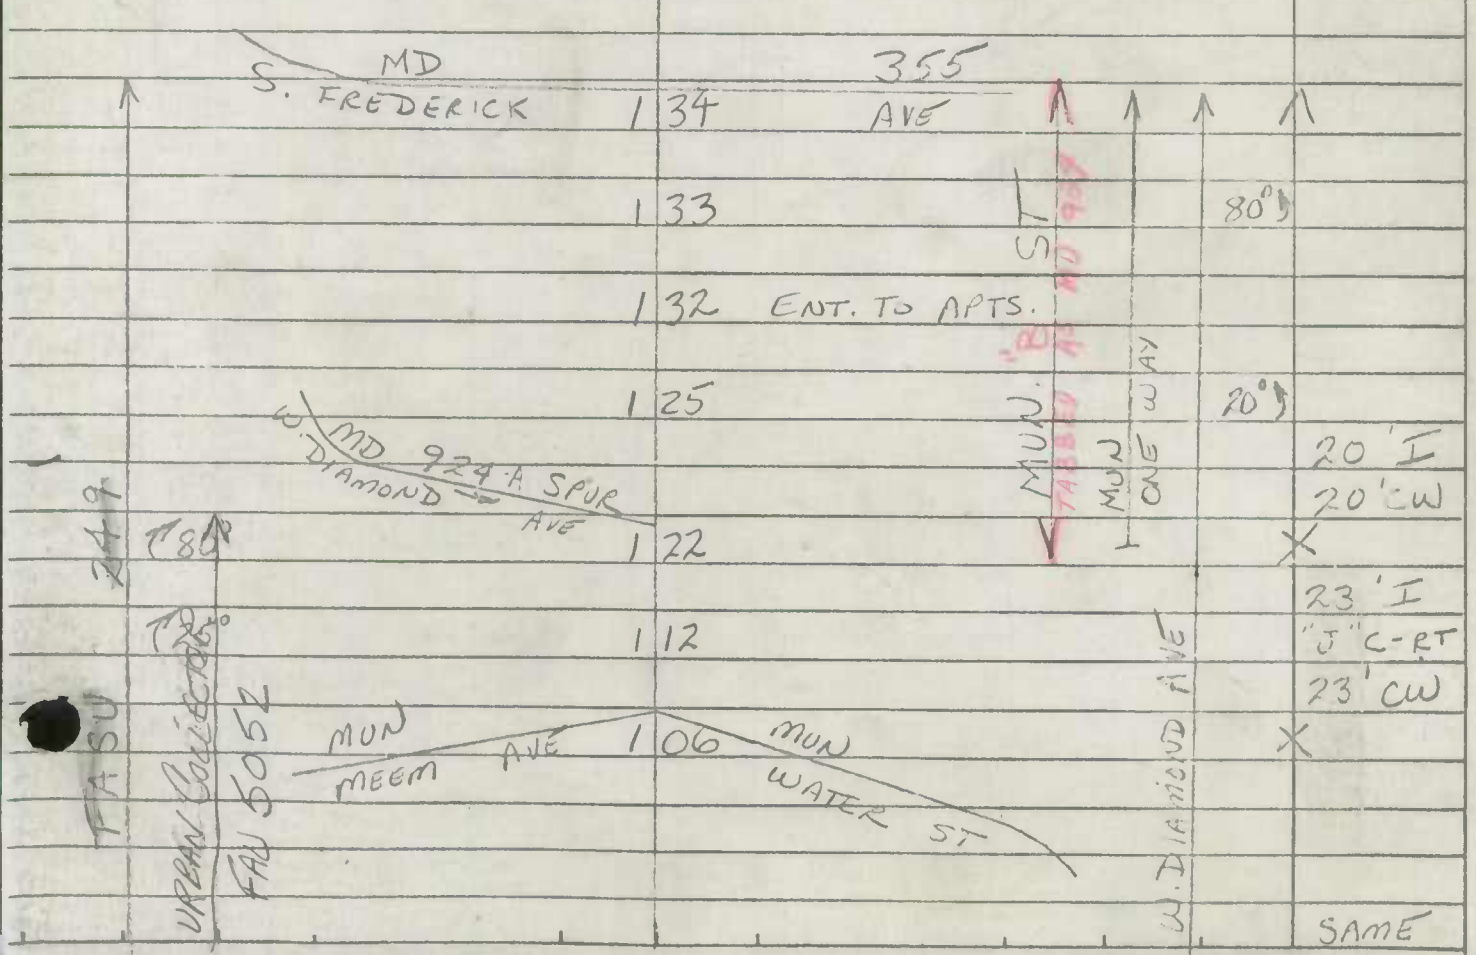

SHA 51.3 - 8 Revised
4.83

Gaithersburg
MARYLAND STATE HIGHWAY ADMINISTRATION

ROAD INVENTORY SHEET

Party Chief _____
Recorder _____
Assistant _____
Map No./Dir. 1
State Coordinates _____

Road No. Op 5837
Road Name (Chestertown St)
County Montgomery
Date _____
Sheet No. _____ OF _____

SYSTEM				TRAFFIC		LINE DIAGRAM	TRAFFIC			PAVEMENT DATA
FED. AID.	FUNCT CLASS.	HWY. SYS.	HPMS SAMPLE	PRKG. REST.	COM/IND. ACCESS		CONTROL	COM/IND. ACCESS	PRKG. REST.	

SEE INV.
OF
MU 0530

Gaithersburg (94-7)

2002 IMPS

TRAFFIC CODES
TRAFFIC CONTROLS: STOP SIGN=SS, TRAFFIC LIGHT=T.L., FLASHING RED BALL=F.R.

TRAFFIC CODES
PARKING RESTRICTIONS: A.M. PEAK, P.M. PEAK, A.M./P.M. PEAK, NO PARKING ANYTIME=N.P., COMM/IND. ACCESS=E

SYSTEM				TRAFFIC		LINE DIAGRAM	TRAFFIC				PAVEMENT DATA
FED. AID.	FUNCT. CLASS.	HWY. SYS.	HPMS SAMPLE	PRK.G. REST.	COM/IND ACCESS		CONTROL	COM/IND ACCESS	PRK.G. REST.		

SHA 51.3 - 8 Revised
4.83

Gaithersburg
MARYLAND STATE HIGHWAY ADMINISTRATION

ROAD INVENTORY SHEET

Party Chief _____
Recorder _____
Assistant _____
Map No./Dir. 1
State Coordinates _____

Road No. Op 5837
Road Name (Chestertown St)
County Montgomery
Date _____
Sheet No. _____ OF _____

SYSTEM				TRAFFIC		LINE DIAGRAM	TRAFFIC			PAVEMENT DATA
FED. AID.	FUNCT CLASS.	HWY. SYS.	HPMS SAMPLE	PKG. REST.	COM/IND. ACCESS		CONTROL	COM/IND. ACCESS	PKG. REST.	
						SEE INV. OF MU 0530 Gaithersburg (94-7)				

TRAFFIC CODES

TRAFFIC CONTROLS: STOP SIGN=S.S., TRAFFIC LIGHT=T.L., FLASHING RED BALL=F.R.

TRAFFIC CODES

PARKING RESTRICTIONS: A.M. PEAK, P.M. PEAK, A.M./P.M. PEAK, NO PARKING ANYTIME=N.P., COMM/IND. ACCESS=E

SYSTEM				TRAFFIC		LINE DIAGRAM	TRAFFIC				PAVEMENT DATA
FED. AID.	FUNCT. CLASS.	HWY. SYS.	HPMS SAMPLE	PRK.G. REST.	COM/IND ACCESS		CONTROL	COM/IND ACCESS	PRK.G. REST.		

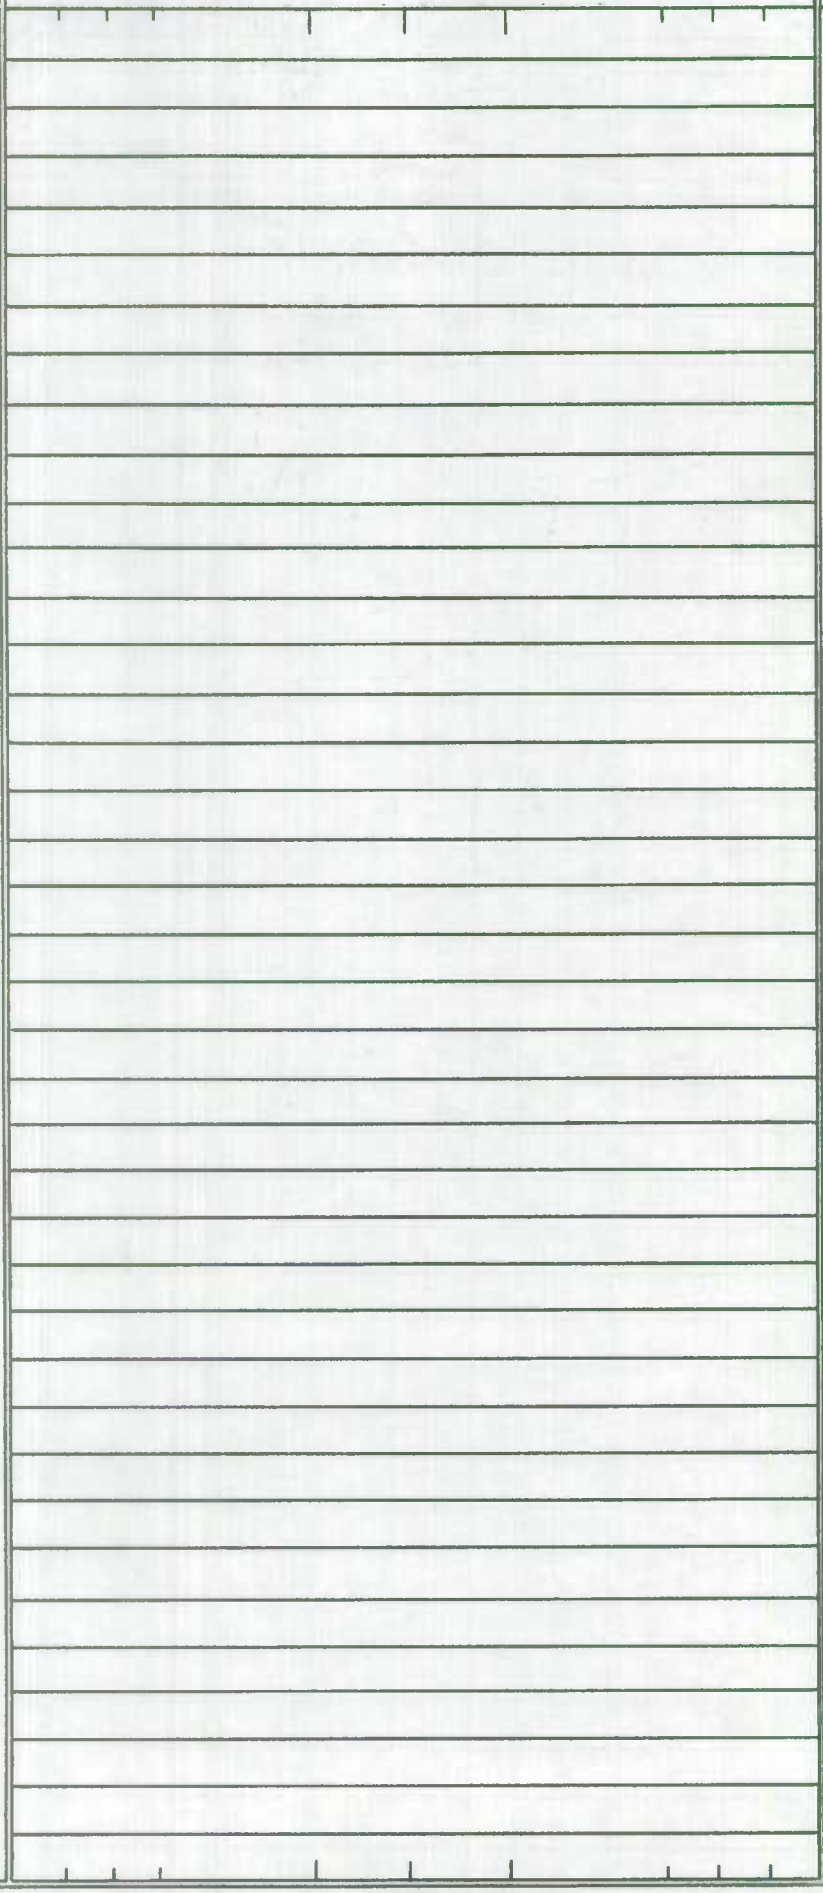

Gaithersburg

SHA 51.3 - 8 Revised
4.83

MARYLAND STATE HIGHWAY ADMINISTRATION

ROAD INVENTORY SHEET

Party Chief _____
Recorder _____
Assistant _____
Map No./Dir. 1
State Coordinates _____

Road No. Op 5897
Road Name Orchard Ridge Dr
County Montgomery
Date _____
Sheet No. _____ OF _____

SYSTEM				TRAFFIC		LINE DIAGRAM	TRAFFIC			PAVEMENT DATA
	FUNCT CLASS	HWY SYS	HPMS SAMPLE	REG. REST.	COM/IND ACCESS		CONTROL	COM/IND ACCESS	REG. REST.	

SEE INV.

OF

MU 0465

"Orchard Ridge Dr"
Gaithersburg
(97-13)

TRAFFIC CODES

TRAFFIC CONTROLS: STOP SIGN-SS,
TRAFFIC LIGHT=T.L.,
FLASHING RED BALL=F.R.

TRAFFIC CODES

PARKING RESTRICTIONS: A.M. PEAK, P.M. PEAK, A.M./P.M. PEAK, NO PARKING ANYTIME=N.P., COM/IND. ACCESS=E

COUNTY _____ ROAD NO. _____ PAGE ___ OF ___

SYSTEM				TRAFFIC		LINE DIAGRAM	TRAFFIC				PAVEMENT DATA
FUNCT CLASS	HWY SYS	NHAS	SAMPLE	PRES	COM/IND ACCESS		CHRG	COM/IND ACCESS	PRES. RES.		

SHA 51.3 - 8 Revised
4.83

MARYLAND STATE HIGHWAY ADMINISTRATION

ROAD INVENTORY SHEET

Gaithersburg

Party Chief _____
Recorder _____
Assistant _____
Map No./Dir. 1
State Coordinates _____

Road No. OP 5793
Road Name Travis View CT
County Montgomery
Date _____
Sheet No. 1 OF 1

SYSTEM				TRAFFIC		LINE DIAGRAM	TRAFFIC			PAVEMENT DATA
FED. AID.	FUNCT CLASS.	HWY. SYS.	HPMS SAMPLE	PRKG. REST.	COM/IND. ACCESS		CONTROL	COM/IND. ACCESS	PRKG. REST.	

See inventory of Mu 0394

93 Mu Ex #38

TRAFFIC CODES

TRAFFIC CONTROLS: STOP SIGN=S, TRAFFIC LIGHT=T.L., FLASHING RED BALL=F.R.

TRAFFIC CODES

PARKING RESTRICTIONS: A.M. PEAK, P.M. PEAK, A.M./P.M. PEAK, NO PARKING ANYTIME=N.P., COMM/IND. ACCESS=E

SYSTEM				TRAFFIC		LINE DIAGRAM	TRAFFIC			PAVEMENT DATA
FED. AID.	FUNCT. CLASS.	HWY. SYS.	HPMS SAMPLE	PRKG. REST.	COM/IND ACCESS		CONTROL	COM/IND ACCESS	PRKG. REST.	

SHA 51.3 - 8 Revised
4.83

MARYLAND STATE HIGHWAY ADMINISTRATION

Gaithersburg

ROAD INVENTORY SHEET

Party Chief _____
Recorder _____
Assistant _____
Map No./Dir. 1
State Coordinates _____

Road No. OP 5792
Road Name Sanders La
County Montgomery
Date 3-14-84
Sheet No. 1 OF 1

SYSTEM				TRAFFIC		LINE DIAGRAM	TRAFFIC			PAVEMENT DATA
FED. AID.	FUNCT CLASS.	HWY. SYS.	HPMS SAMPLE	PRKG. REST.	COM/IND. ACCESS		CONTROL	COM/IND. ACCESS	PRKG. REST.	

See inventory of MU 0344

93 Mu Ex #35

TRAFFIC CODES

TRAFFIC CONTROLS: STOP SIGN=SS, TRAFFIC LIGHT=T.L., FLASHING RED BALL=F.R.

TRAFFIC CODES

PARKING RESTRICTIONS: A.M. PEAK, P.M. PEAK, A.M./P.M. PEAK, NO PARKING ANYTIME=N.P., COMM/IND. ACCESS=E

SYSTEM				TRAFFIC		LINE DIAGRAM	TRAFFIC			PAVEMENT DATA
FED. AID.	FUNCT. CLASS.	HWY. SYS.	HPMS SAMPLE	PRK.G. REST.	COM/IND ACCESS		CONTROL	COM/IND ACCESS	PRK.G. REST.	

SHA 51.3 - 8 Revised
4.83

MARYLAND STATE HIGHWAY ADMINISTRATION

Gaithersburg

ROAD INVENTORY SHEET

Party Chief _____
Recorder _____
Assistant _____
Map No./Dir. 1
State Coordinates _____

Road No. MD 5790
Road Name Crystal CT
County Montgomery
Date _____
Sheet No. 1 OF 1

SYSTEM				TRAFFIC		LINE DIAGRAM	TRAFFIC			PAVEMENT DATA
FED. AID.	FUNCT CLASS.	HWY. SYS.	HPMS SAMPLE	PRKG. REST.	COM/IND. ACCESS		CONTROL	COM/IND. ACCESS	PRKG. REST.	
						See Inventory of MU 0045 93 MU EX# 31				

TRAFFIC CODES

TRAFFIC CONTROLS: STOP SIGN=SS, TRAFFIC LIGHT=T.L., FLASHING RED BALL=F.R.

TRAFFIC CODES

PARKING RESTRICTIONS: A.M. PEAK, P.M. PEAK, A.M./P.M. PEAK, NO PARKING ANYTIME=N.P., COMM/IND. ACCESS=E

SYSTEM				TRAFFIC		LINE DIAGRAM	TRAFFIC			PAVEMENT DATA
FED. AID.	FUNCT. CLASS.	HWY. SYS.	HPMS SAMPLE	PRK.G. REST.	COM/IND ACCESS		CONTROL	COM/IND ACCESS	PRK.G. REST.	

SHA 51.3 - 8 Revised
4.83

MARYLAND STATE HIGHWAY ADMINISTRATION

ROAD INVENTORY SHEET

Gaithersburg.

Party Chief _____
Recorder _____
Assistant _____
Map No./Dir. 1
State Coordinates _____

Road No. OP 5786
Road Name Buttry Rd
County Montgomery
Date 3-3994
Sheet No. 1 OF 1

SYSTEM				TRAFFIC		LINE DIAGRAM	TRAFFIC			PAVEMENT DATA
FED. AID.	FUNCT CLASS.	HWY. SYS.	HPMS SAMPLE	PRKG. REST.	COM/IND. ACCESS		CONTROL	COM/IND. ACCESS	PRKG. REST.	

See inventory of M0024

93 mu Ex# 18

TRAFFIC CODES

TRAFFIC CONTROLS: STOP SIGN=SS, TRAFFIC LIGHT=T.L., FLASHING RED BALL=F.R.

TRAFFIC CODES

PARKING RESTRICTIONS: A.M. PEAK, P.M. PEAK, A.M./P.M. PEAK, NO PARKING ANYTIME=N.P., COMM/IND. ACCESS=E

SYSTEM				TRAFFIC		LINE DIAGRAM	TRAFFIC			PAVEMENT DATA
FED. AID.	FUNCT. CLASS.	HWY. SYS.	HPMS SAMPLE	PRKG. REST.	COM/IND ACCESS		CONTROL	COM/IND ACCESS	PRKG. REST.	

SHA 51.3 - 8 Revised
4.83

MARYLAND STATE HIGHWAY ADMINISTRATION

ROAD INVENTORY SHEET Gaithersburg

Party Chief _____
Recorder _____
Assistant _____
Map No./Dir. 1
State Coordinates _____

Road No. OP5785
Road Name Norwich CT
County Montgomery
Date _____
Sheet No. 1 OF 1

SYSTEM				TRAFFIC		LINE DIAGRAM	TRAFFIC			PAVEMENT DATA
FED. AID.	FUNCT CLASS.	HWY. SYS.	HPMS SAMPLE	PRKG. REST.	COM/IND. ACCESS		CONTROL	COM/IND. ACCESS	PRKG. REST.	
						See Inventory of MU0248 93-MU-Ex-7				

TRAFFIC CODES

TRAFFIC CONTROLS: STOP SIGN=S.S., TRAFFIC LIGHT=T.L., FLASHING RED BALL=F.R.

TRAFFIC CODES

PARKING RESTRICTIONS: A.M. PEAK, P.M. PEAK, A.M./P.M. PEAK, NO PARKING ANYTIME=N.P., COMM/IND. ACCESS=E

SYSTEM				TRAFFIC		LINE DIAGRAM	TRAFFIC				PAVEMENT DATA
FED. AID.	FUNCT. CLASS.	HWY. SYS.	HPMS SAMPLE	PRKG. REST.	COM/IND ACCESS		CONTROL	COM/IND ACCESS	PRKG. REST.		

SHA 51.3 - 8 Revised
4.83

MARYLAND STATE HIGHWAY ADMINISTRATION

ROAD INVENTORY SHEET

Party Chief _____
Recorder _____
Assistant _____
Map No./Dir. 1
State Coordinates _____

Road No. OP 5450
Road Name TRAVIS AVE
County MONT
Date _____
Sheet No. _____ OF _____

SYSTEM				TRAFFIC		LINE DIAGRAM	TRAFFIC			PAVEMENT DATA
FED. AID.	FUNCT CLASS	HWY. SYS.	HPMS SAMPLE	PRKG. REST.	COM/IND. ACCESS		CONTROL	COM/IND. ACCESS	PRKG. REST.	
						SEE INVENTORY				
						MU 0379				
						GAITHERSBURG (0603)				
						8 9 1-esota				

TRAFFIC CODES

TRAFFIC CONTROLS: STOP SIGN=S.S., TRAFFIC LIGHT=T.L., FLASHING RED BALL=F.R.

TRAFFIC CODES

PARKING RESTRICTIONS: A.M. PEAK, P.M. PEAK, A.M./P.M. PEAK, NO PARKING ANYTIME=N.P., COMM/IND. ACCESS=E

SYSTEM				TRAFFIC		LINE DIAGRAM	TRAFFIC			PAVEMENT DATA
FED. AID.	FUNCT. CLASS.	HWY. SYS.	HPMS SAMPLE	PRK.G. REST.	COM/IND ACCESS		CONTROL	COM/IND ACCESS	PRK.G. REST.	

SHA 51.3 - 8 Revised 4.83

MARYLAND STATE HIGHWAY ADMINISTRATION

ROAD INVENTORY SHEET

Party Chief _____
Recorder _____
Assistant _____
Map No./Dir. 1
State Coordinates _____

Road No. OP 5276
Road Name TWIN LAKES DR
County MONT
Date _____
Sheet No. _____ OF _____

SYSTEM				TRAFFIC		LINE DIAGRAM	TRAFFIC			PAVEMENT DATA
FED. AID.	FUNCT CLASS.	HWY. SYS.	HPMS SAMPLE	PRKG. REST.	COM/IND. ACCESS		CONTROL	COM/IND. ACCESS	PRKG. REST.	
						SEE MON 0386				
						GAITHERSBURG				

TRAFFIC CODES

TRAFFIC CONTROLS: STOP SIGN=S.S., TRAFFIC LIGHT=T.L., FLASHING RED BALL=F.R.

TRAFFIC CODES

PARKING RESTRICTIONS: A.M. PEAK, P.M. PEAK, A.M./P.M. PEAK, NO PARKING ANYTIME=N.P., COMM/IND. ACCESS=E

SYSTEM				TRAFFIC		LINE DIAGRAM	TRAFFIC			PAVEMENT DATA
FED. AID.	FUNCT. CLASS.	HWY. SYS.	HPMS SAMPLE	PRKG. REST.	COM/IND ACCESS		CONTROL	COM/IND ACCESS	PRKG. REST.	

SHA 51.3-8
11-15-72

STATE HIGHWAY ADMINISTRATION OF MARYLAND

URBAN

ROAD INVENTORY SHEET

MUN.

Party Chief FR
Recorder JE
Helper

Road No. ~~OP 4781~~
Road Name WYE MILL CT
Sheet No. 1 of
Date 3-7-80
County MONT
State Coordinates 739-484

Map No. 26A Gaithersburg
79-19 Extra

SEE NEW INV.

80-10

S

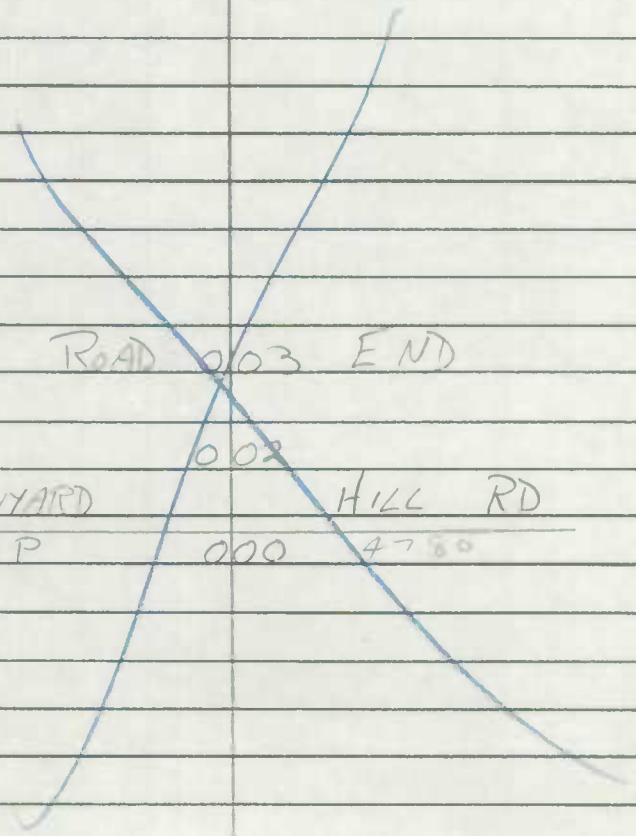

SHA 51.3-8
11-15-72

ROAD INVENTORY SHEET

Road No. _____
Road Name _____
Sheet No. _____
Date _____
County _____
State Coordinates _____

SHA 51.3-8
11-15-72

STATE HIGHWAY ADMINISTRATION OF MARYLAND

ROAD INVENTORY SHEET

0080

Party Chief I. LANDON
Recorder M. ZALENSKI
Helper

Road No. MUN
Road Name EVERETT ST
Sheet No. 1 OF 1
Date 4-26-74
County MONT.
State Coordinates

Map No. 31

KENSINGTON
CHEVY CHASE VIEW

Kensington

E

KENSINGTON
MUN.

0.12

CHEVY
0180

CORP. LIMITS OF
CORP. LIMITS OF 0.10 CHEVY CHASE VIEW

18'H
24'cw
2 UMB

CONNECTICOT 0.00 AVE

MD

193
185

SHA 51.3-8
11-15-72

STATE HIGHWAY ADMINISTRATION OF MARYLAND

ROAD INVENTORY SHEET

0080

Party Chief T. LANDON
Recorder M. ZALENSKI
Helper

Road No. MUN
Road Name EVERETT ST
Sheet No. 1 OF 1
Date 4-26-74
County MONT
State Coordinates

Map No. 31

KENSINGTON
CHEVY CHASE VIEW

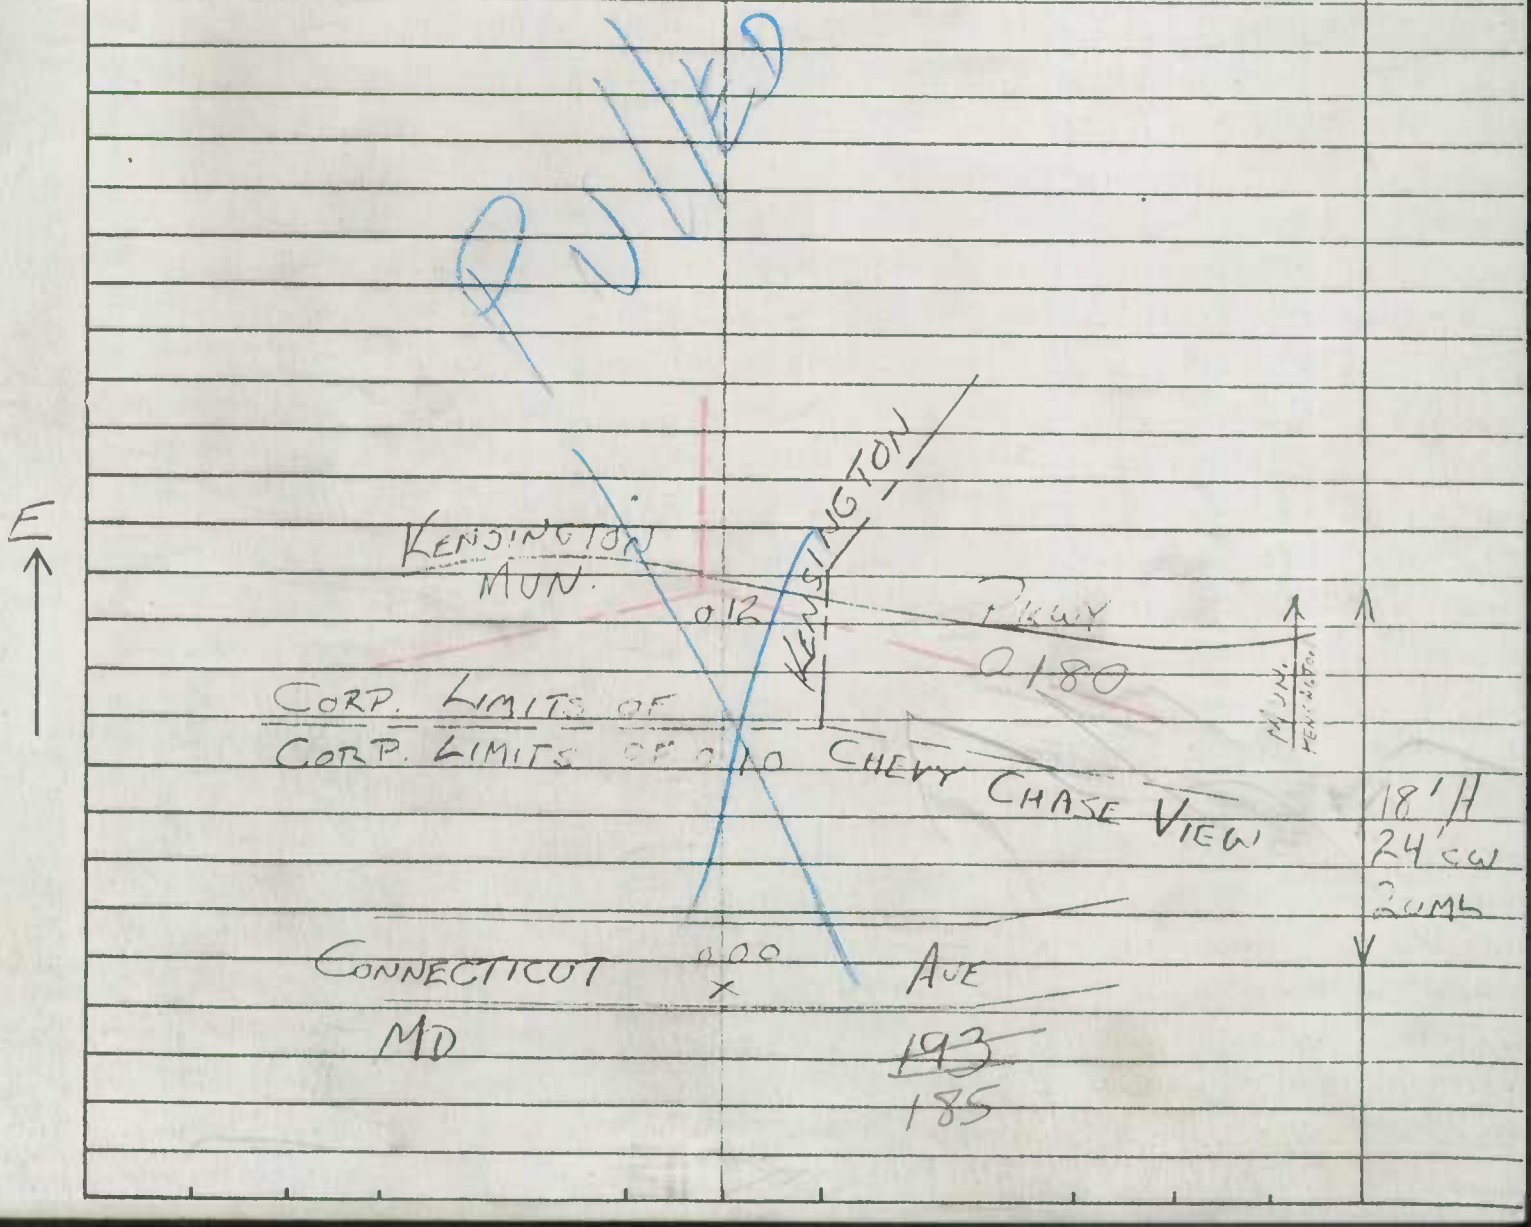

SHA 51.3-8
11-15-72

STATE HIGHWAY ADMINISTRATION OF MARYLAND

ROAD INVENTORY SHEET MUN 0090

Party Chief T. LANDON
Recorder M. ZALENSKI
Helper

Map No. 31

Road No. CO. 770
Road Name FARRAGUT AVE.
Sheet No. 1 OF 1
Date 4-29-74
County MONT.
State Coordinates

KENSINGTON

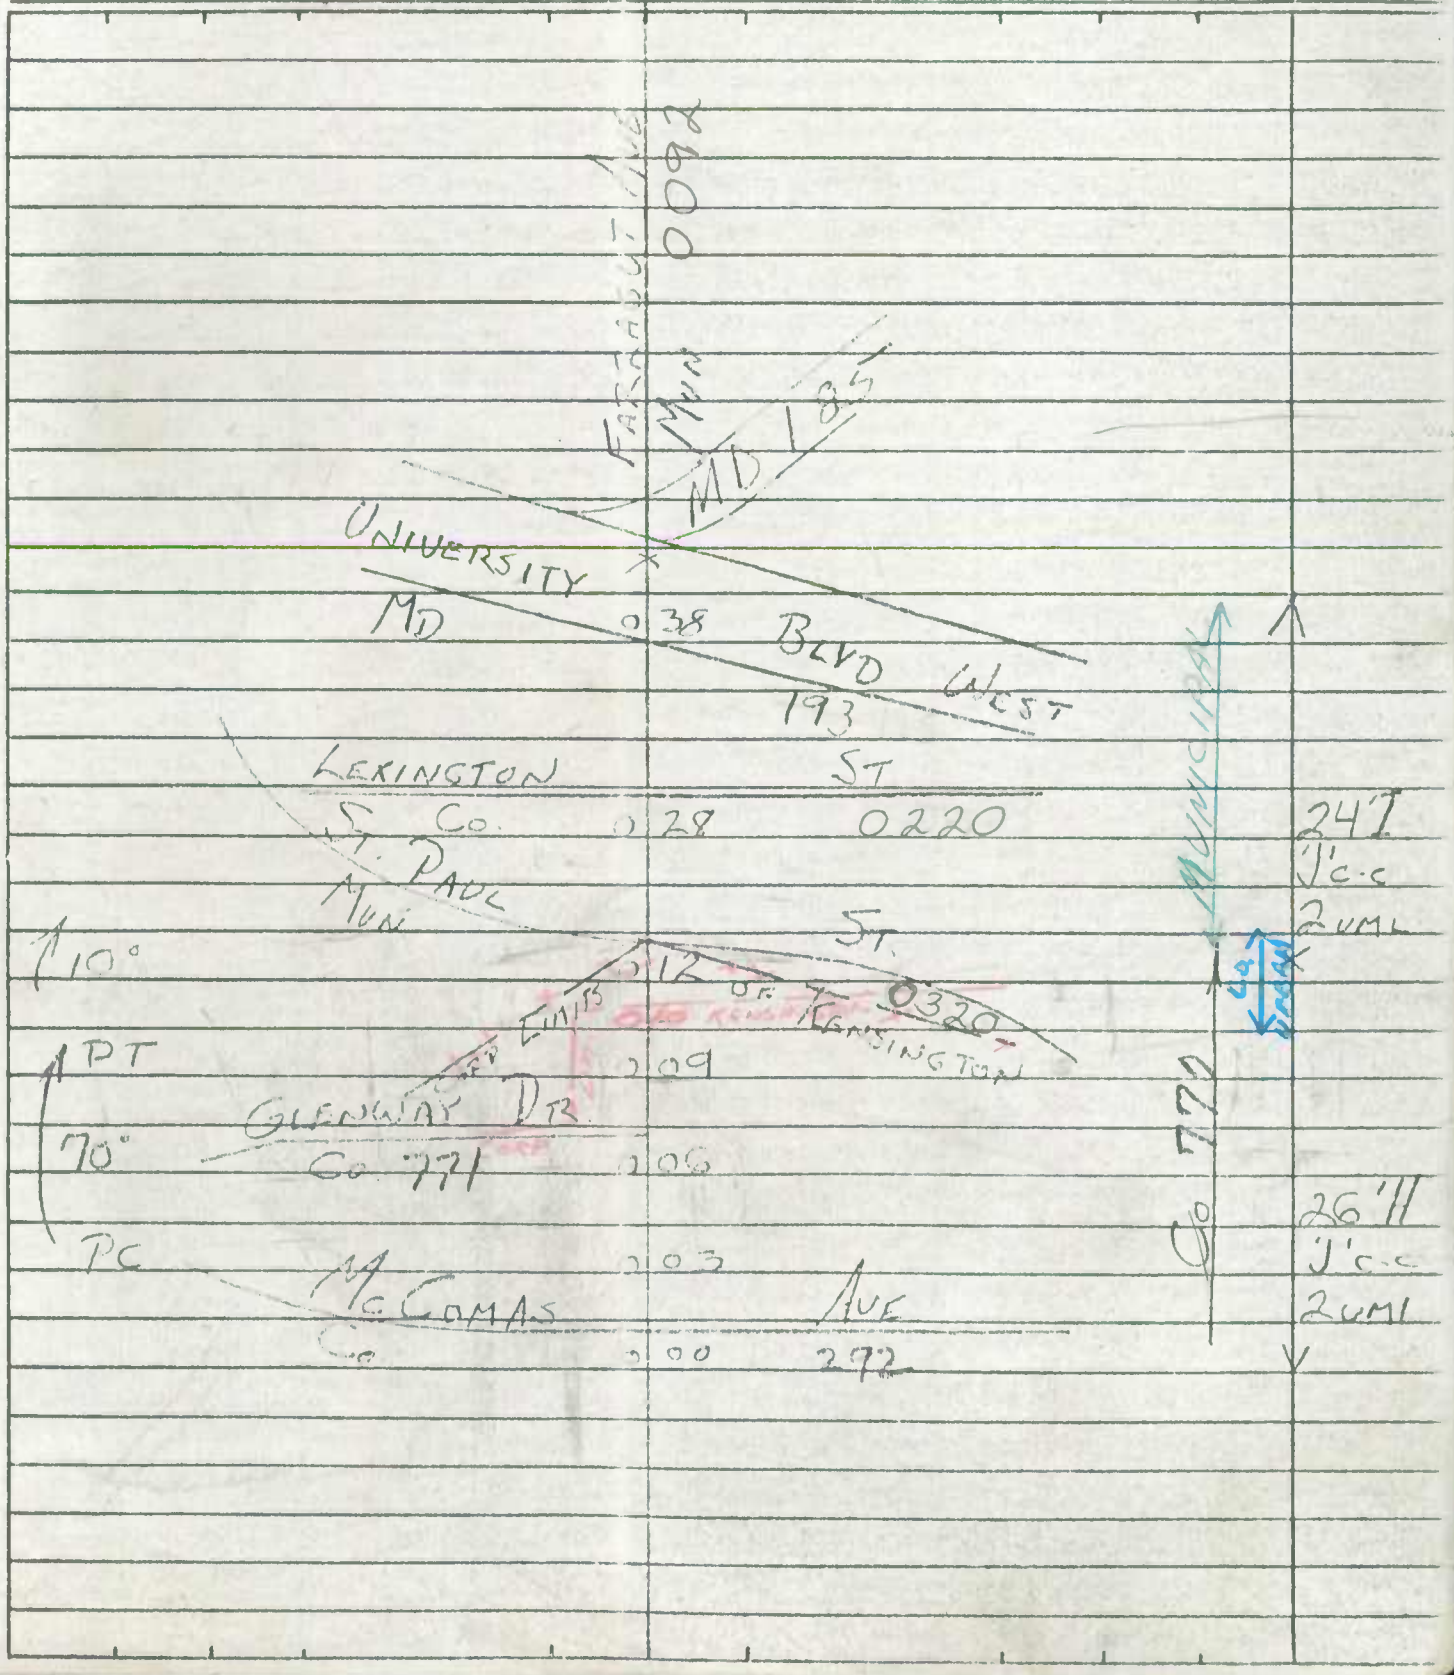

SHA 51.3-8
11-15-72

STATE HIGHWAY ADMINISTRATION OF MARYLAND

ROAD INVENTORY SHEET MU0090

Party Chief T. LANDON
Recorder M. ZALENSKI
Helper

Map No. 31

Road No. CO. 770
Road Name FARRAGUT AVE
Sheet No. 1 OF 1
Date 4-29-74
County MONT
State Coordinates 781-437

KENSINGTON

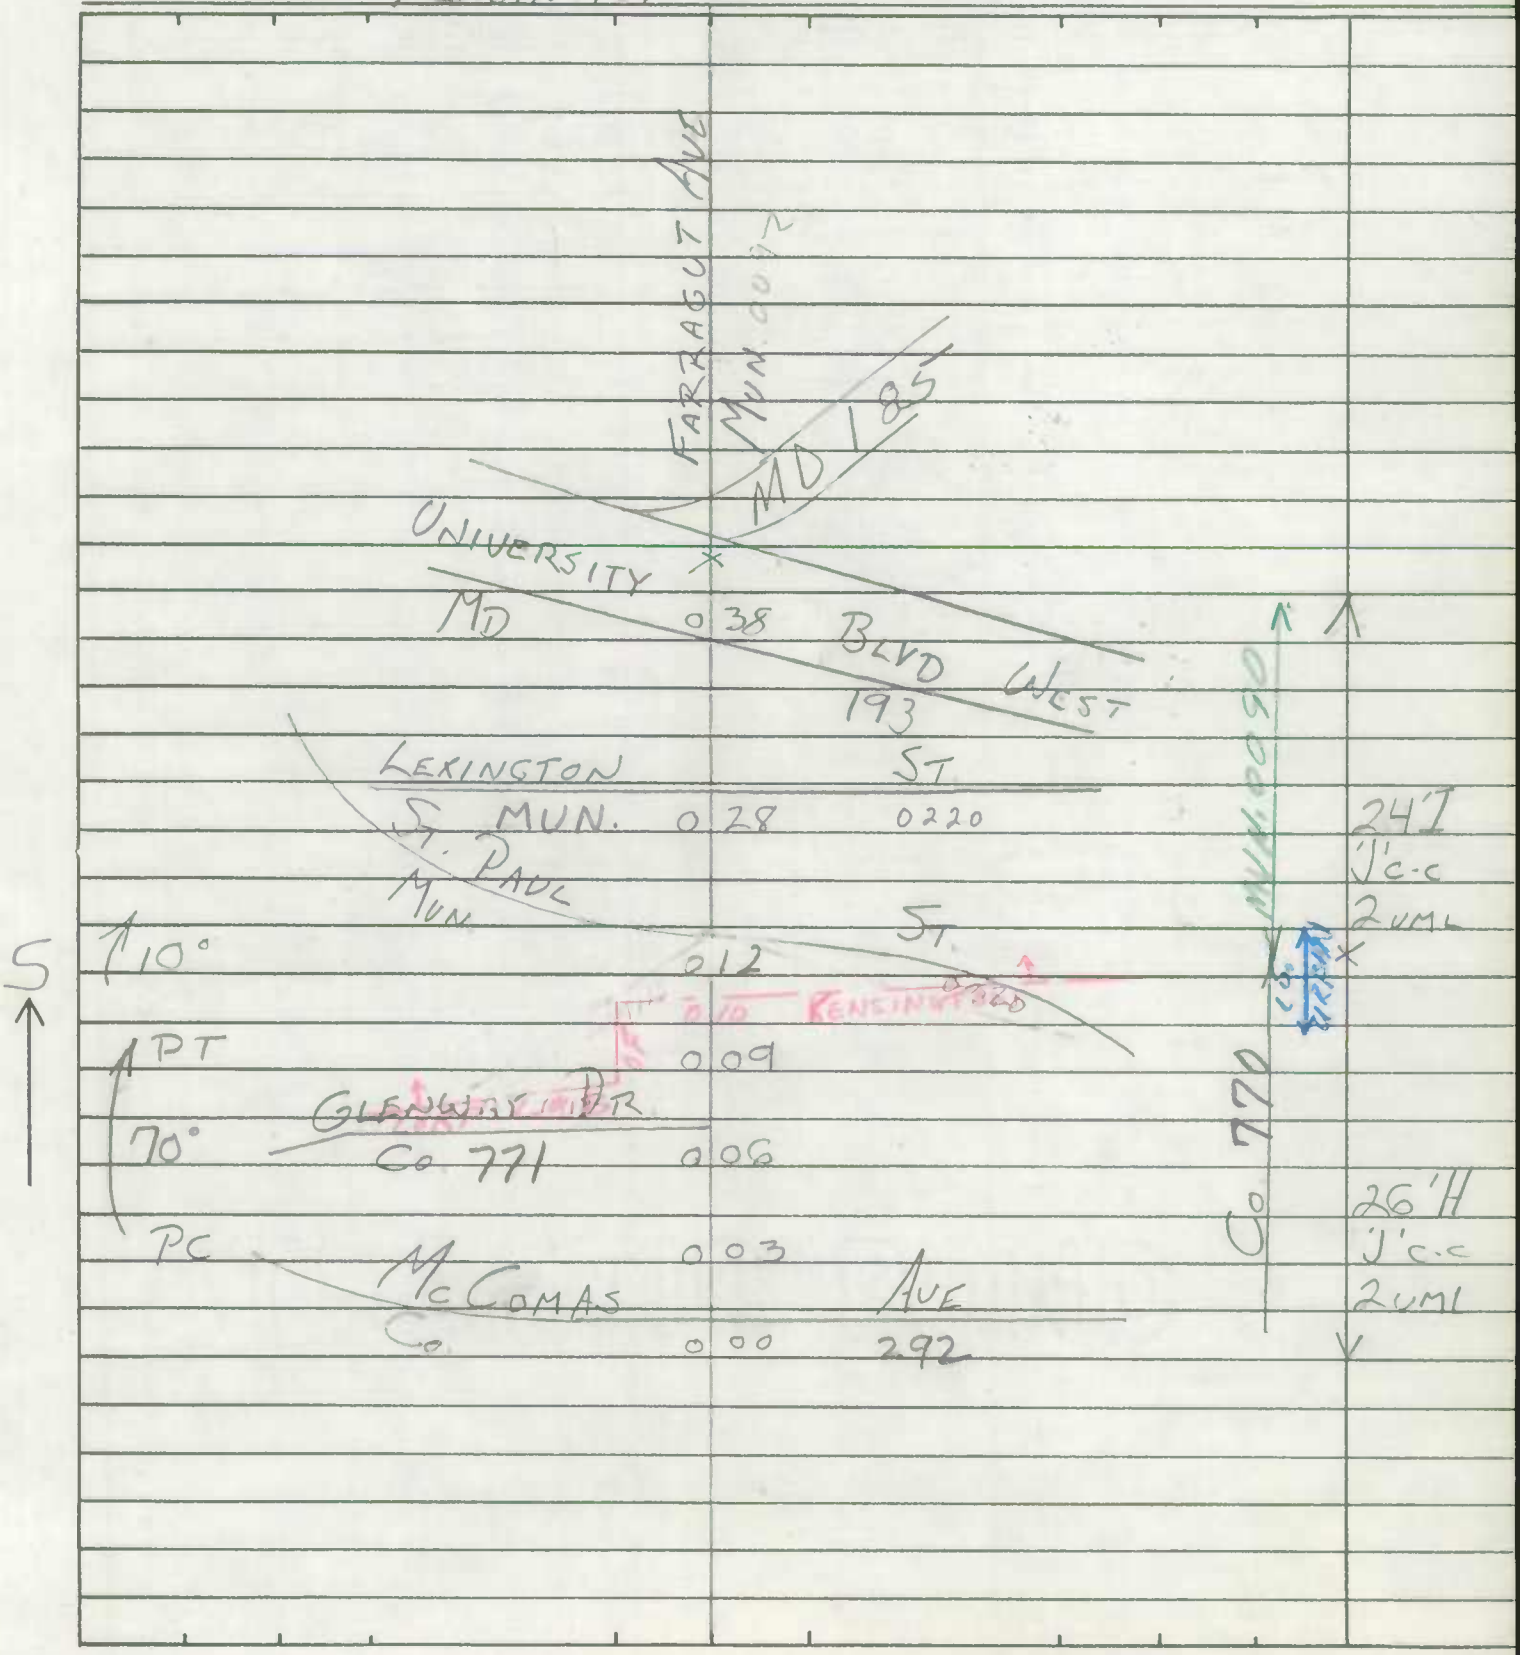

SHA 51.3-8
11-15-72

ROAD INVENTORY SHEET

Road No. _____
Road Name _____
Sheet No. _____
Date _____
County _____
State Coordinates _____

SHA 51.3-8
11-15-72

ROAD INVENTORY SHEET MUN. 0110

Party Chief _____
Recorder _____
Helper _____

Map No. 31
Kensington

Road No. CO. 1284
Road Name Ferndale St
Sheet No. 1 of 1
Date _____
County _____
State Coordinates 783-435

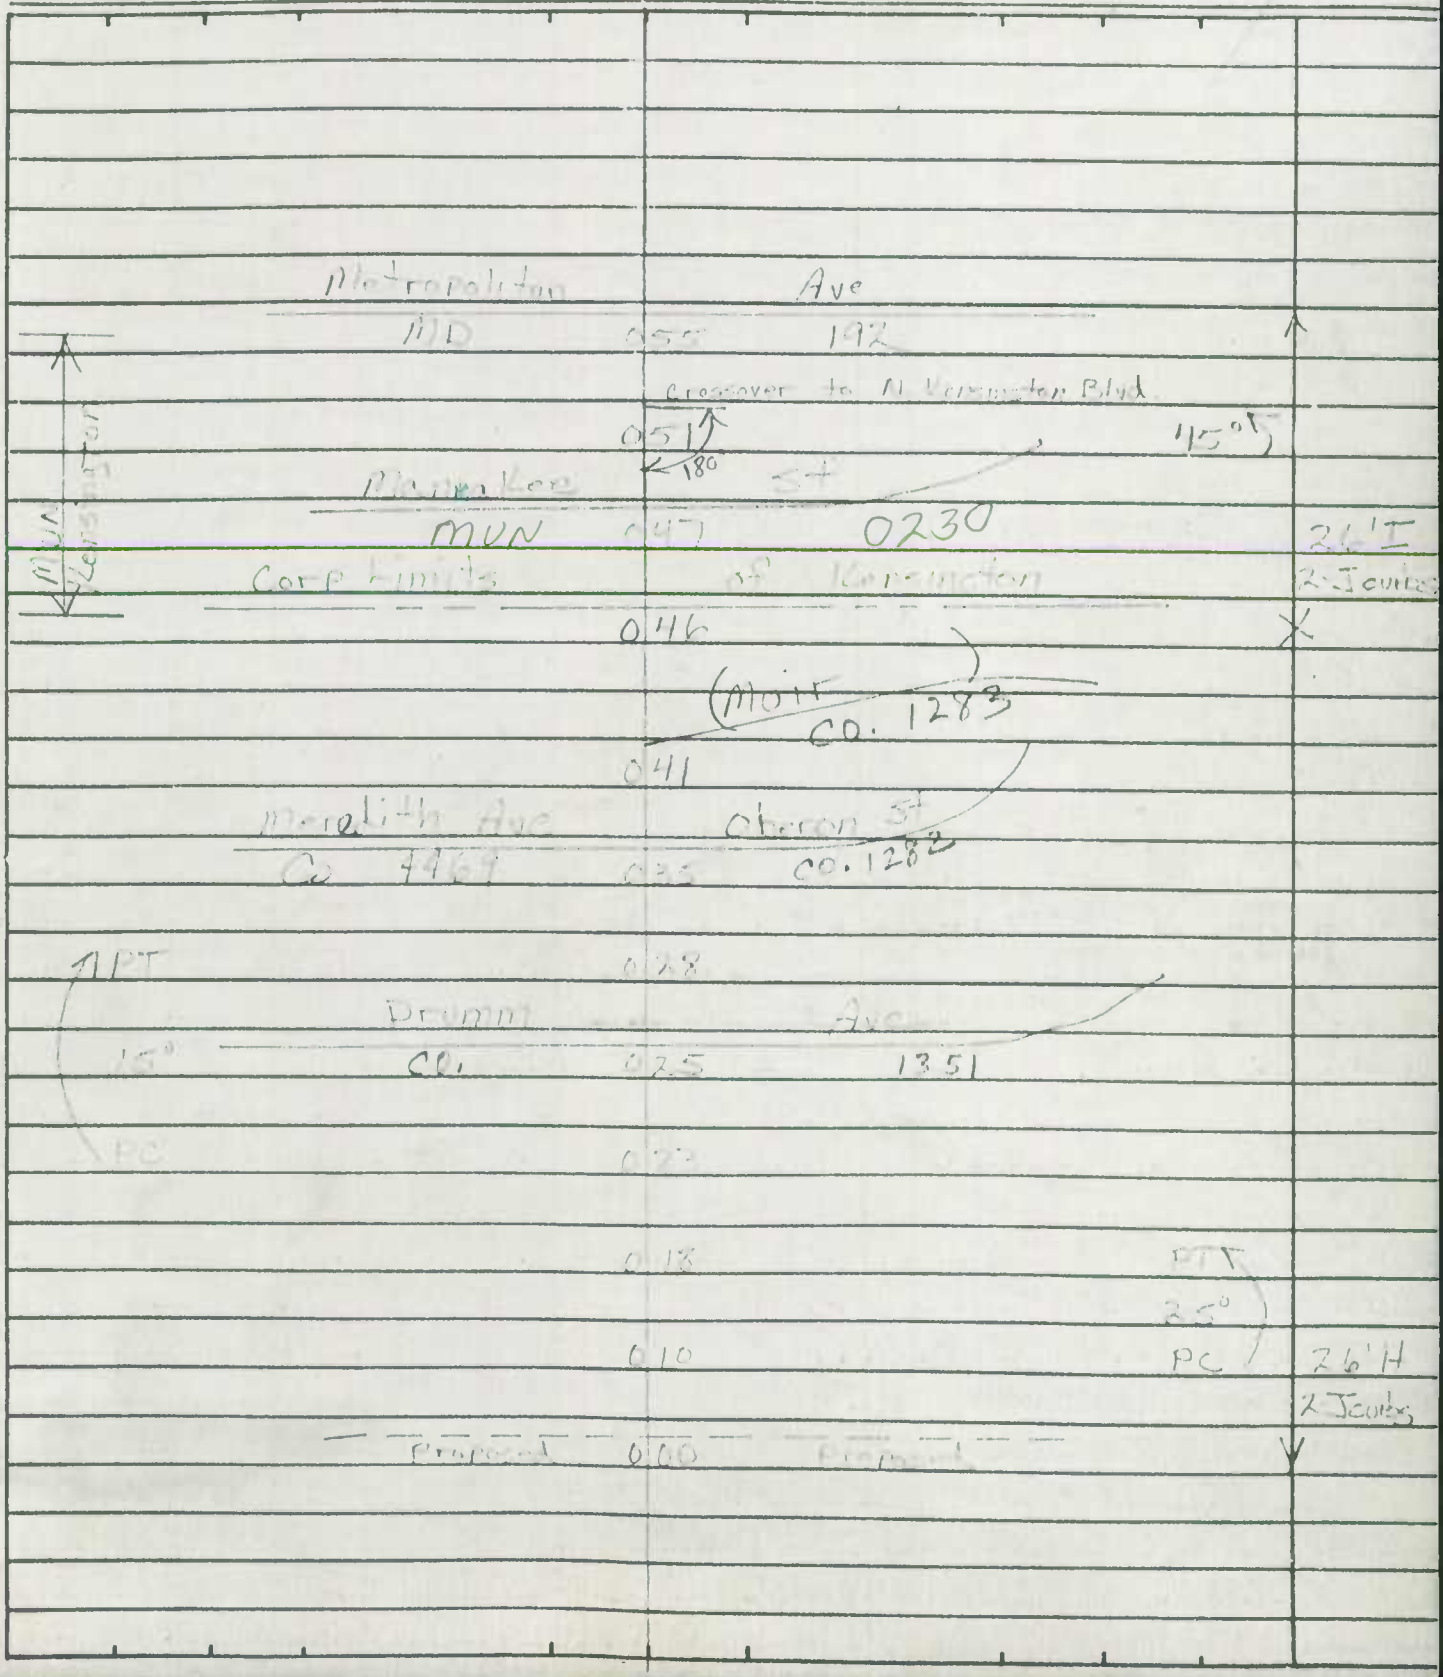

SHA 51.3-8
11-15-72

ROAD INVENTORY SHEET

MUN 0160

Road No. Co 2091
Road Name HOWARD AVE
Sheet No. 2 OF 2
Date 4-25-74
County MONT
State Coordinates

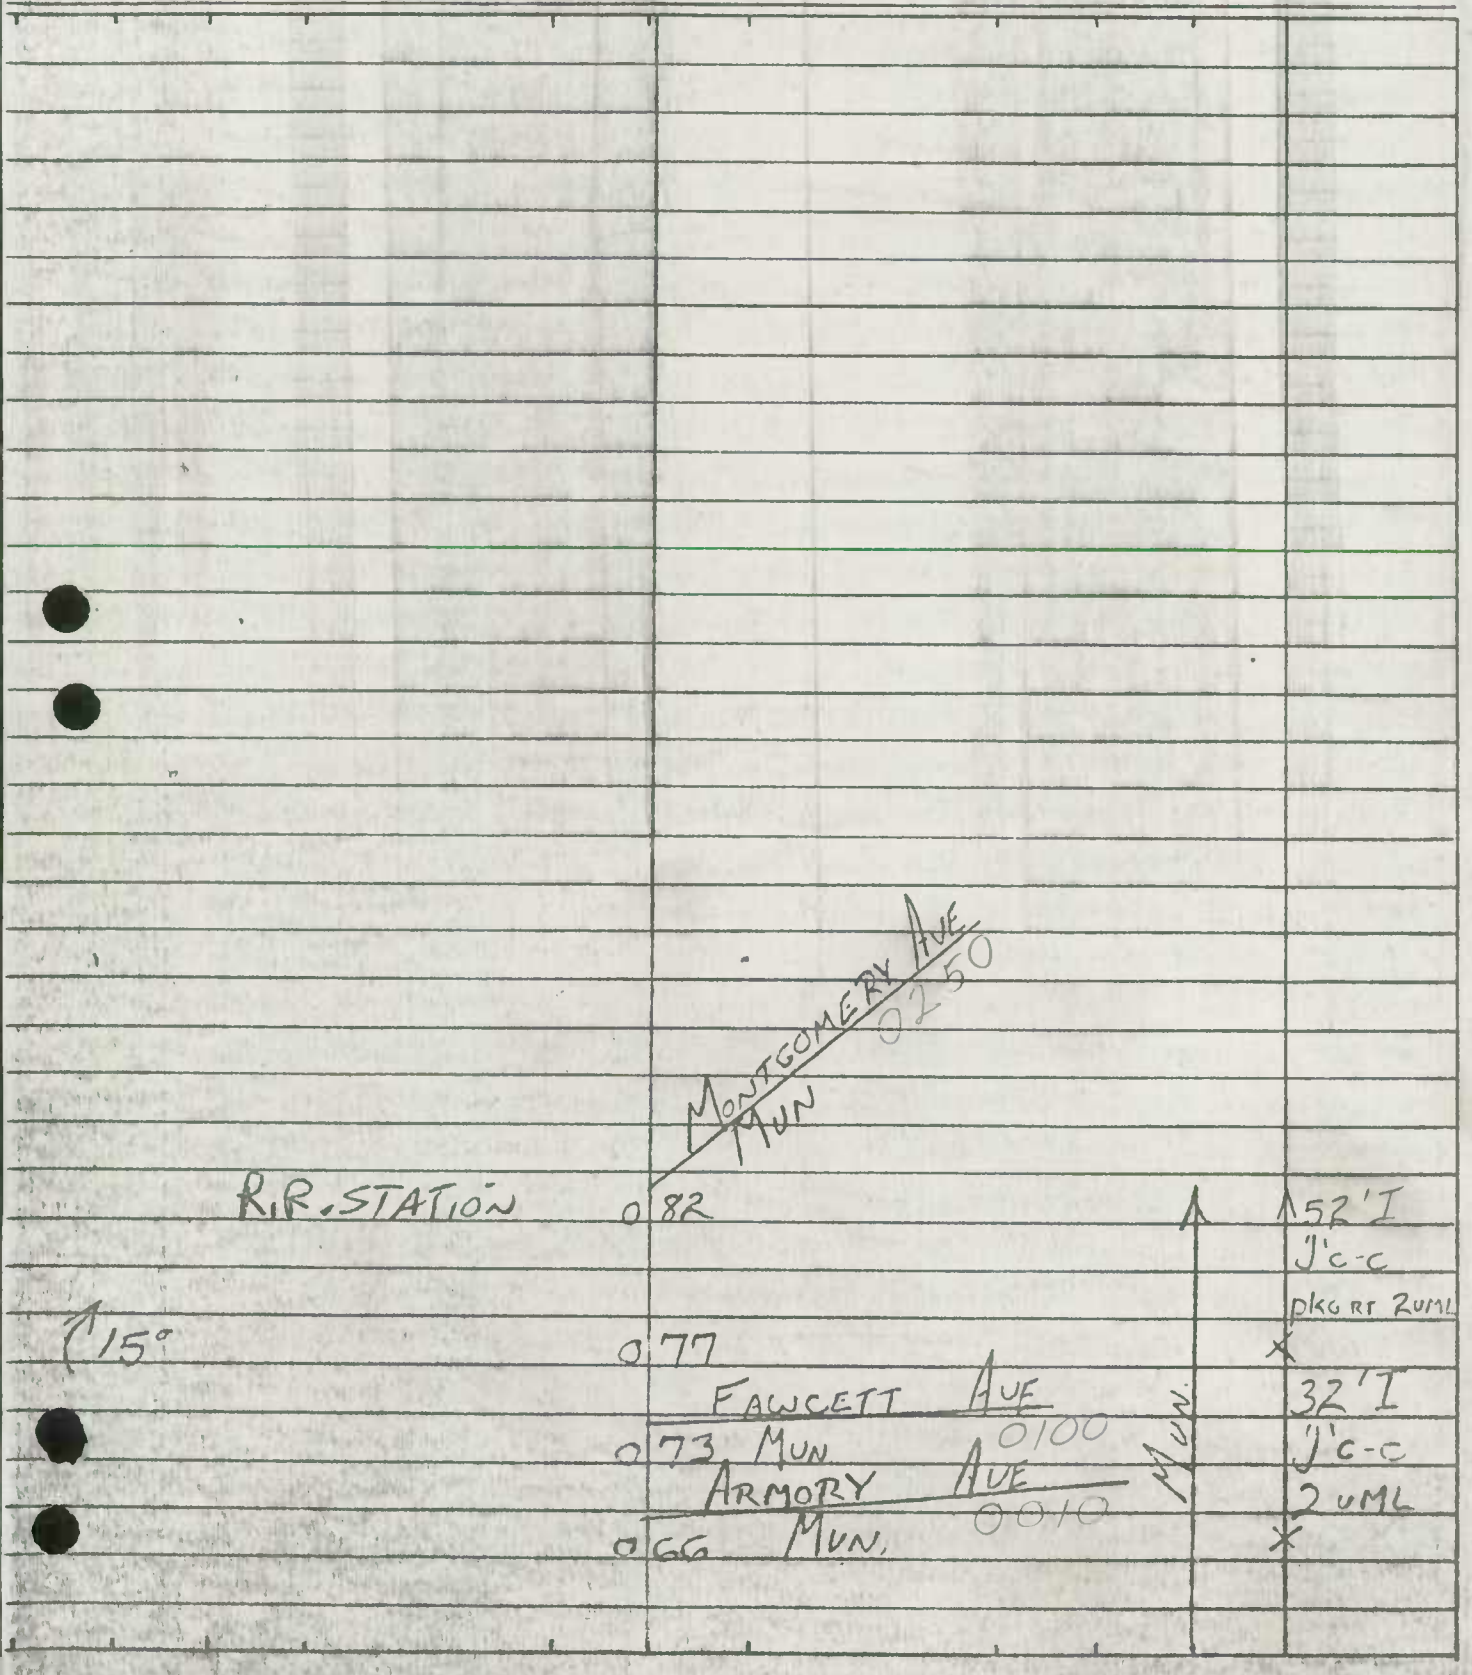

SHA 51.3-8
11-15-72

STATE HIGHWAY ADMINISTRATION OF MARYLAND

ROAD INVENTORY SHEET MUN 0160

Party Chief I. LANDON
Recorder M. ZALENSKI
Helper

Map No. 30&31

Road No. Co. 2081
Road Name HOWARD AVE
Sheet No. 1 OF 2
Date 4-25-74
County MONT.
State Coordinates 776-436

80-14

CONNECTICUT MD	0	55	AVE 193 ~~185~~ MUN	22'J J'c-c 2UML
			DETRICK AVE	
	0	49	MUN. 0060	X 26'I J'c-c
c/l SUMMIT OF Co.	0	43	AVE KENSINGTON 307	2UML X
	0	38	← SPUR: 0.01 N'G WARFIELD ST	22'H
	0	37	Co 303	Ic-c 2UML
125°	0	33		X 34'H
S.H.A GARAGE	0	22	15°	36CW 2UML
	0	16		X
85°	0	07		
MASONIC LODGE	0	01		26'H 29'CW
KNOWLES MD	0	00	AVE 547	2UML

N

SHA 51.3-8
11-15-72

STATE HIGHWAY ADMINISTRATION OF MARYLAND

ROAD INVENTORY SHEET MUN 0180

Party Chief I. LANDON
Recorder M. ZALENSKI
Helper

Map No. 31

Road No. Co. 538
Road Name KENSINGTON PKWY
Sheet No. 1 of 3
Date 4-30-74
County MONT.
State Coordinates 779-434

KENSINGTON

8-2 81-7

#M 0161P 052 72" CMP (SQUASH) 24'11 30'CW 2ML

LITTLEDALE RD MUN 0225 051 X

CO 198

APT 049

25°

PC FREDERICK AVE MUN 0120 044

#MK 038 043 72" CMP (SQUASH)

039 REC. CTR. ST. WASHINGTON ST. 0360

031 MUN PL. CALVERT MUN 0032

025

S

15° KENT ST. MUN 0190 023 38'I J'c-c 2UML

FREDERICK AVE MUN 0120 KENT ST MUN 0192 020 X 31'I J'c-c

45° 008 X 2ML

KENSINGTON P.O. 003

SPUR: 0.01/27'I J'c-c 39'I J'c-c

001 AVE 0250

MONTGOMERY MUN 000 2 ML

SHA 51.3-8
11-15-72

ROAD INVENTORY SHEET

MUN. 0180

Road No. Co 538
Road Name KENSINGTON PKWY
Sheet No. 2 of 3
Date 4-30-74
County M.-G.
State Coordinates

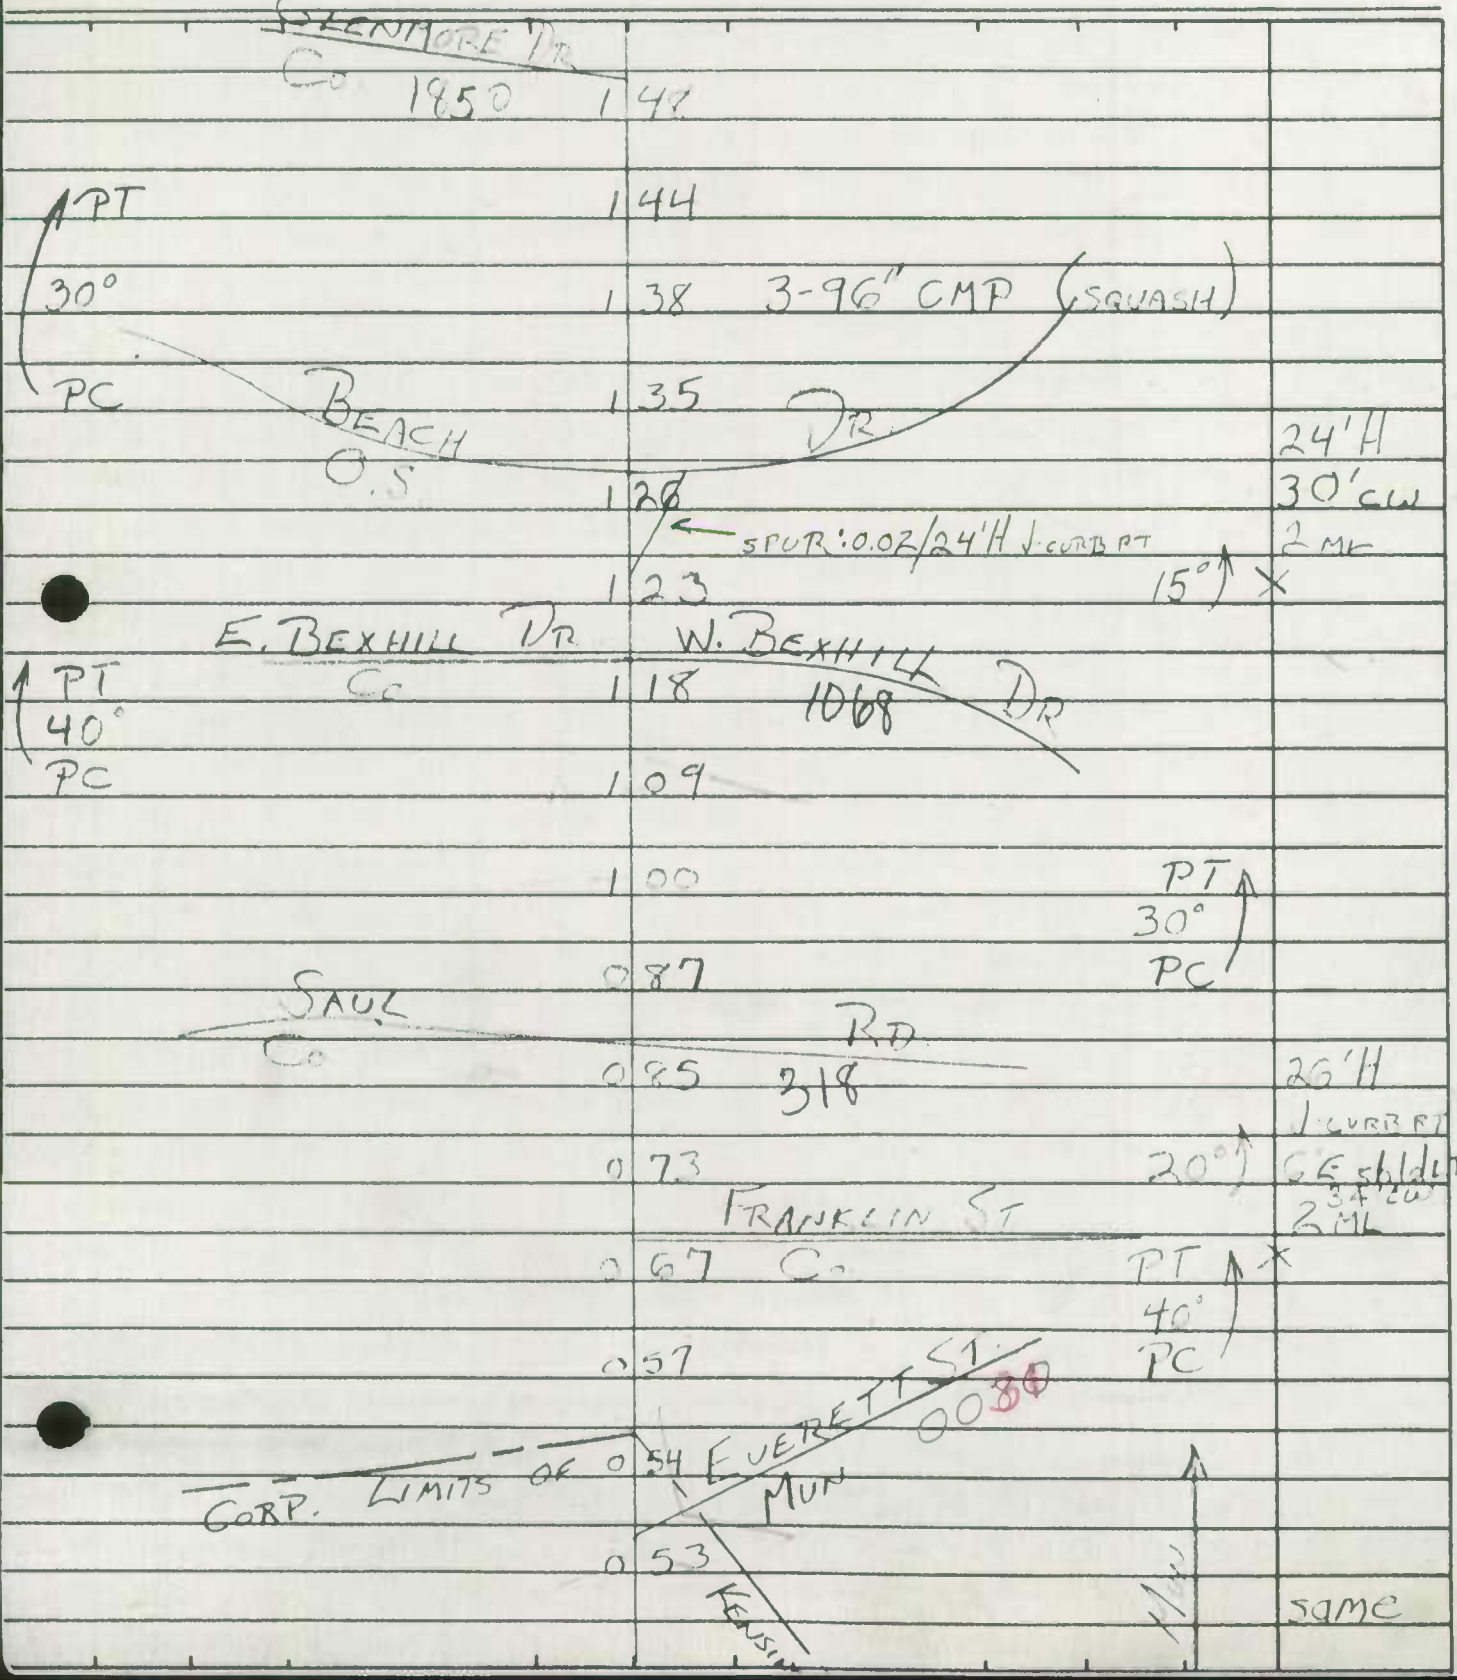

SHA 51.3-8
11-15-72

STATE HIGHWAY ADMINISTRATION OF MARYLAND

ROAD INVENTORY SHEET

Party Chief T. HANTON
Recorder M. ZAGENSKI
Helper

Map No. 31

Road No. MUN. 0192
Road Name KENT ST
Sheet No. 1 OF 1
Date 4-30-74
County MONT.
State Coordinates

KENSINGTON

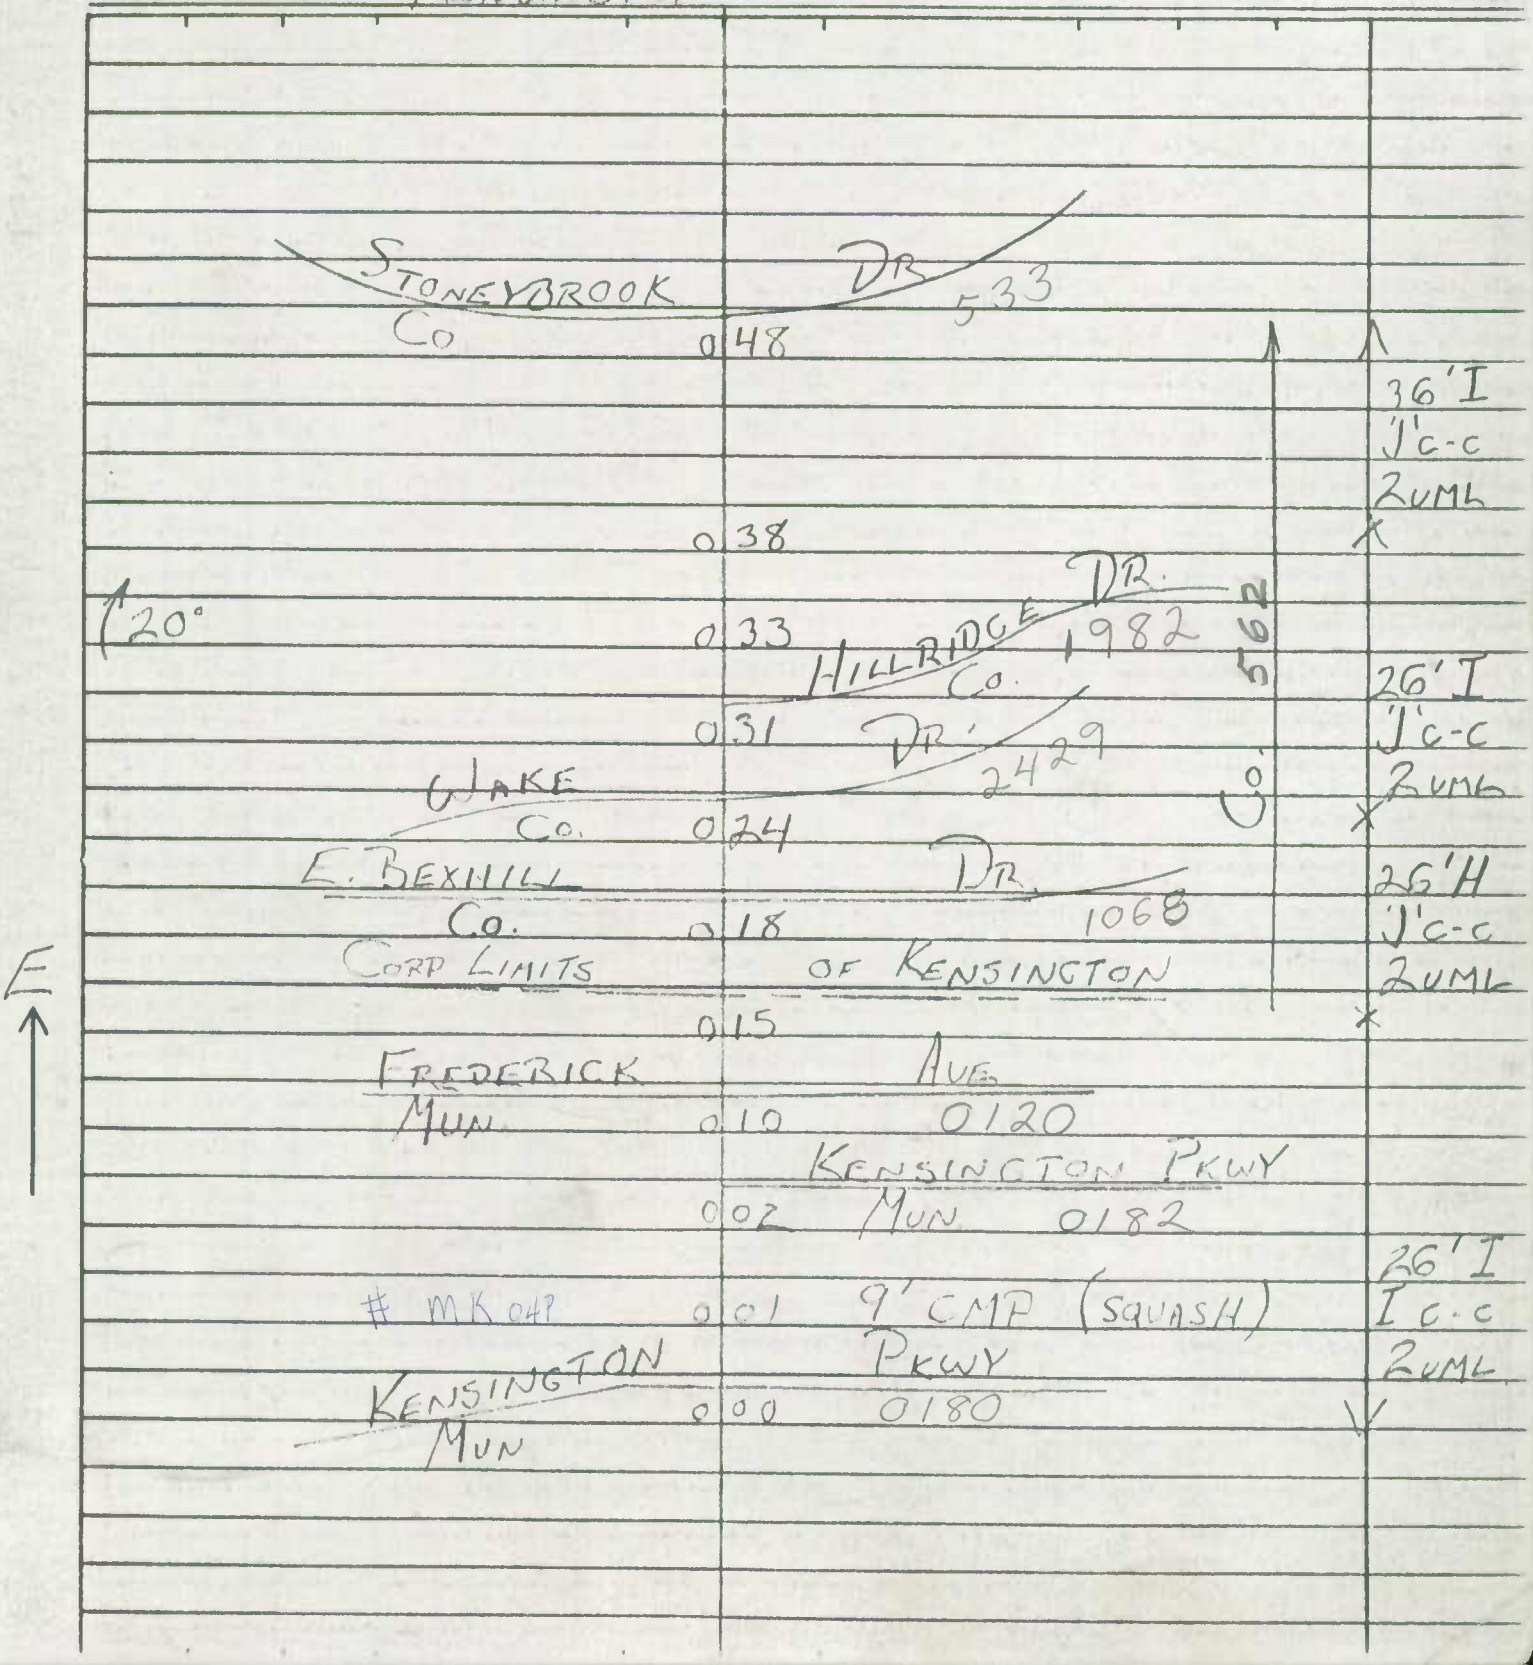

SHA 51.3-8
11-15-72

MUN 0200

ROAD INVENTORY SHEET

KNOWLES AVE.

Road No. ~~MD. 547~~
Road Name SYCAMORE AVE.
Sheet No. 2 OF 3
Date 7-26-73
County MONT.
State Coordinates

CONNECTICUT AVE. 81-5 T1-5

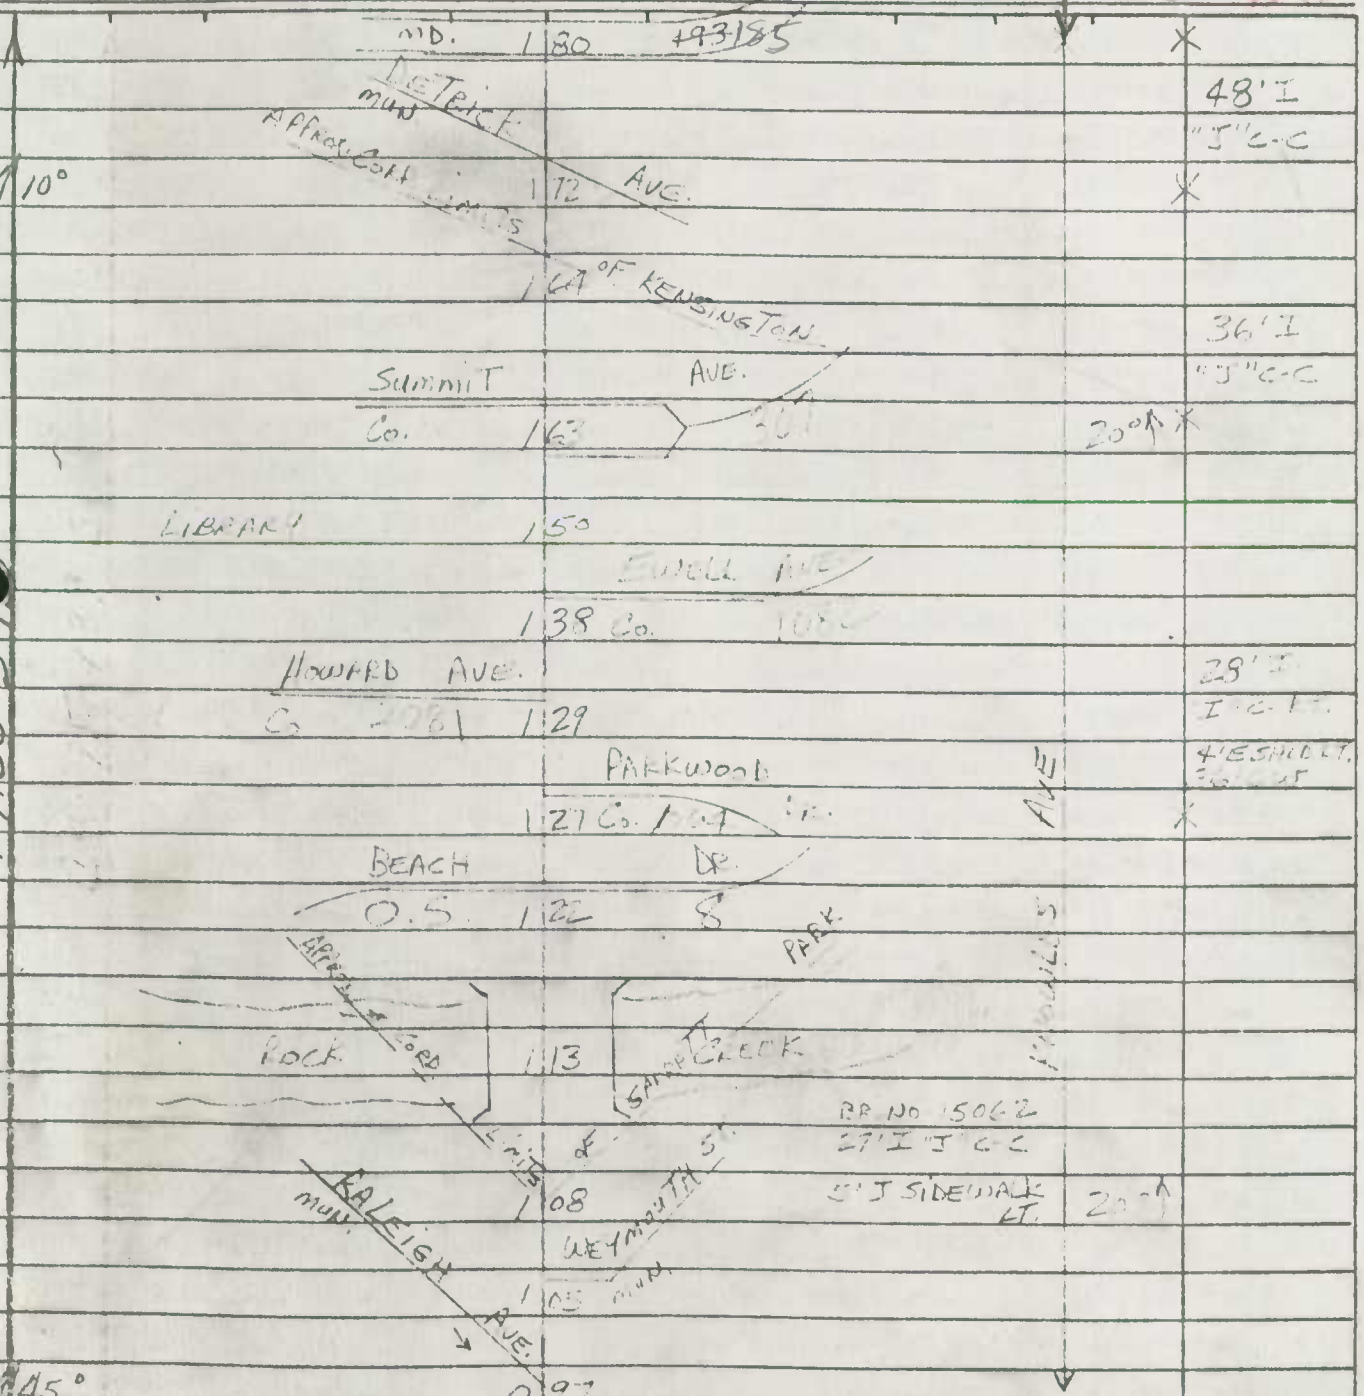

SHA 51.3-8
11-15-72

ROAD INVENTORY SHEET

MUN 0200

Party Chief T. LANDON
Recorder AL. WARFIELD
Helper _____

Map No. _____

Road No. ~~MD 594~~
Road Name KNOWLES AVE.
Sheet No. 3 OF 3
Date 7-26-73
County MONT.
State Coordinates _____

ARMORY AVE.
MUN. 137 0010

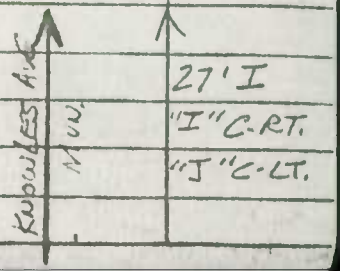

SHA 51.3-8
11-15-72

STATE HIGHWAY ADMINISTRATION OF MARYLAND

ROAD INVENTORY SHEET Co 4462

Party Chief T. LANDON
Recorder M. ZALENSKI
Helper

Map No. 31

Road No. MUN 0220
Road Name LEXINGTON ST
Sheet No. 1 OF 1
Date 4-30-74
County MONT.
State Coordinates

KENSINGTON

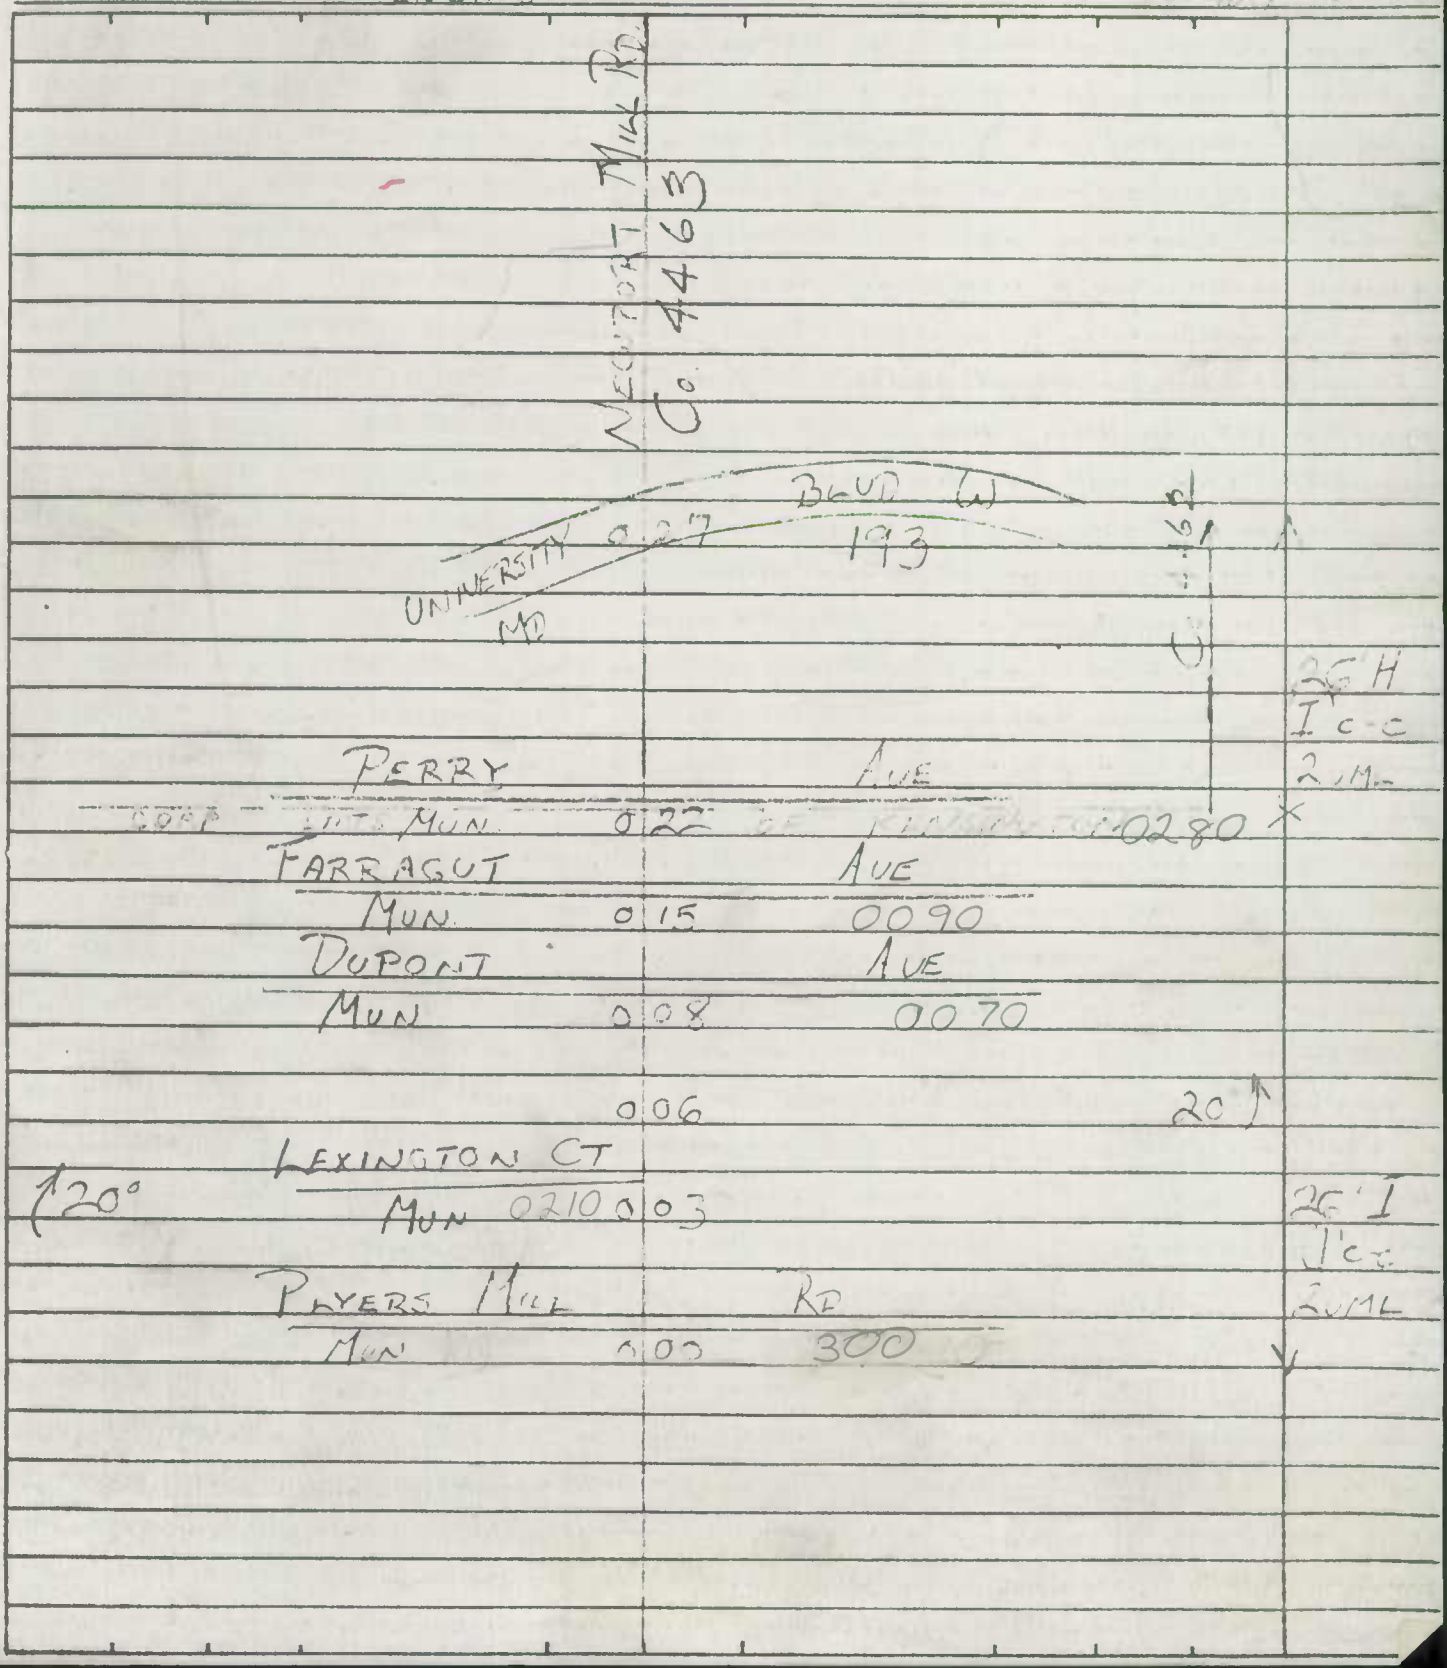

SHA 51.3-8
11-15-72

STATE HIGHWAY ADMINISTRATION OF MARYLAND

ROAD INVENTORY SHEET

CO 1282

Party Chief T. LANDON
Recorder M. ZALENSKI
Helper

Map No. 31

Road No. MUN 0270
Road Name OBERON ST
Sheet No. 1 OF 1
Date 4-30-71
County PGC
State Coordinates

KENSINGTON

MARBLITH AVE
4469

FERNDALE
Co

ST
1284

FT
60'
PC

CO 1282

MUIR PL
1283

CORP LIMITS

OF KENSINGTON PKWY

N. KENSINGTON
0183

MUN

24'H
1-CURB RT
1-CURB L
X 2 UML

E

CBC 1-16'xW-60'xD-5'

WHEATLEY
MUN

ST
0370

ST. PAUL
MUN

ST
0320

26'I
1 C-C
X 2 UML

SHA 51.3-8
11-15-72

STATE HIGHWAY ADMINISTRATION OF MARYLAND

ROAD INVENTORY SHEET MUN. 0280

Party Chief T. LAMON
Recorder
Helper

Map No. 31

Road No. ~~Co~~ 160
Road Name PERRY AVE
Sheet No.
Date 1-27-84
County
State Coordinates A/T 1-28-83

KENSINGTON

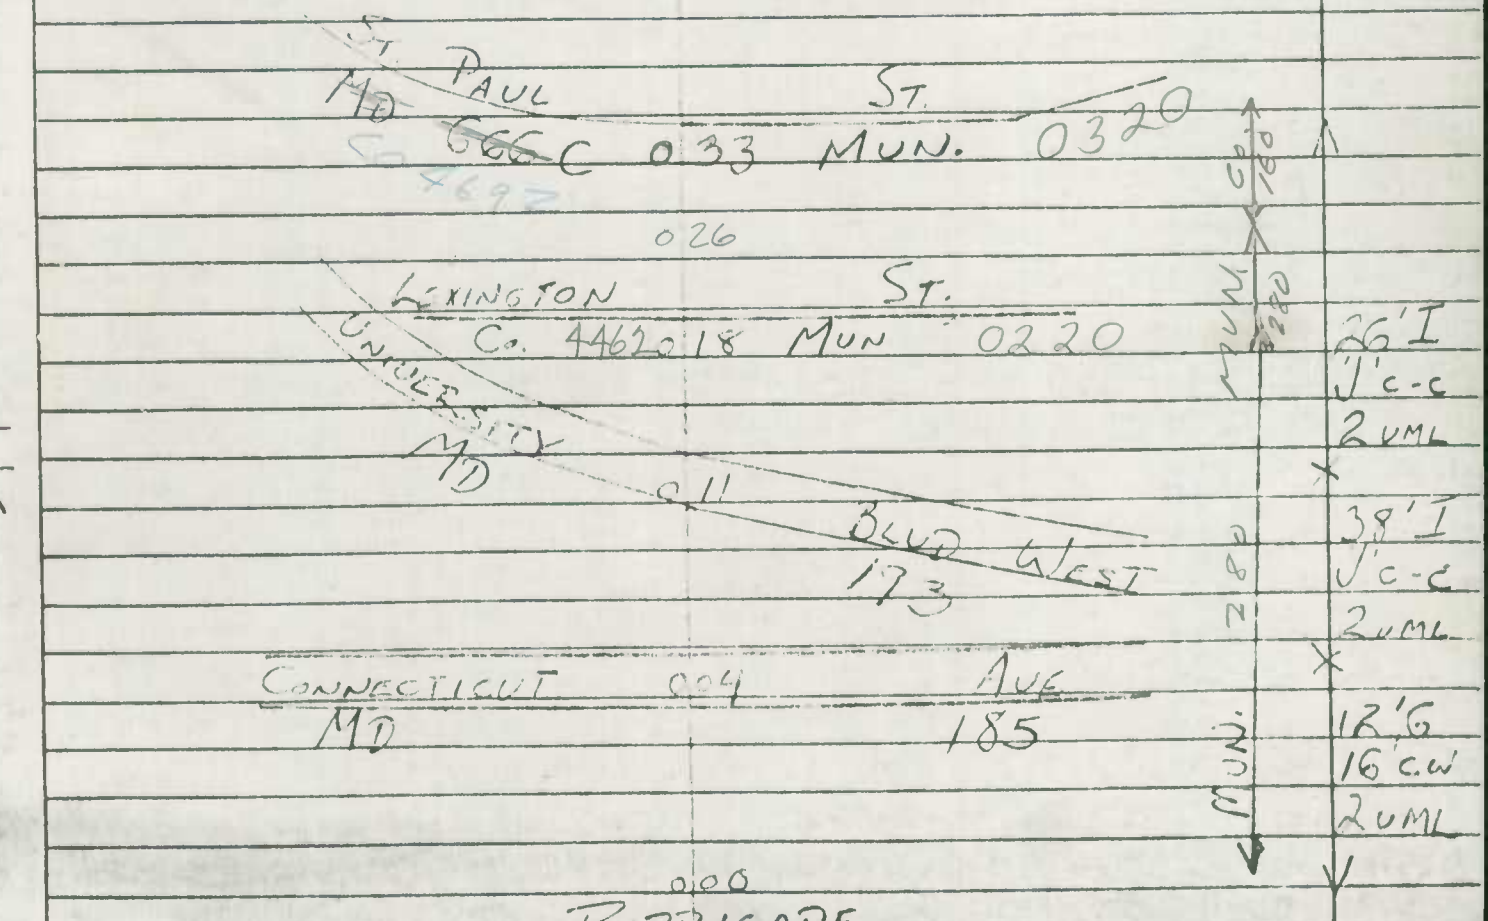

SHA 51.3-8
11-15-72

ROAD INVENTORY SHEET

MUN 0300

Road No. ~~C~~ 293
Road Name PLAYERS MILL RD
Sheet No. 2 of 2
Date 1-29-74
County Howard
State Coordinates

51-8

PLAYERS MILL RD

CONCORD ST.

METROPOLITAN AVE.

MD.

1 84 MUN 0050

NASH PL

1 78 MUN 0260

KENSINGTON TOWN OFFICE 1 73

LEXINGTON ST

MUN 0300

1 72 MUN 0220 0 34'I

PLAYERS MILL CT 0 I-CURB RT

1 65 MUN 0290 36'c-c

2 UNL

ST. PAUL ST

MUN 1 61 0320 20° ↑ *

WHEATLEY CT

MUN 1 55 0370

KENSINGTON

1 50 TRIB AVE

(25° ROCK CREEK

LIMITS OF DRUMM CO

1 39 1351

JENNINGS RD

1 34 Co 296

MAXBROOK PL

1 10 Co 294

98

MAXBROOK AVE

2 13 Co 1715

ENT TO OAKLAND THE KEEN SCHOOL 0 89

EXIT SCHOOL 0 87

BRUNSWICK CO 2.79 AVE 1583 15' ↑ same

SHA 51.3-8
11-15-72

STATE HIGHWAY ADMINISTRATION OF MARYLAND

ROAD INVENTORY SHEET CO 4692

Party Chief T LANDON
Recorder W. WINFIELD
Helper

Map No. 31

Rewrite, 8-24-81 UTSC

Road No. MU 0320
Road Name ST PAUL ST
Sheet No. 1 of 2
Date 8-23-93
County Mont
State Coordinates 179-435

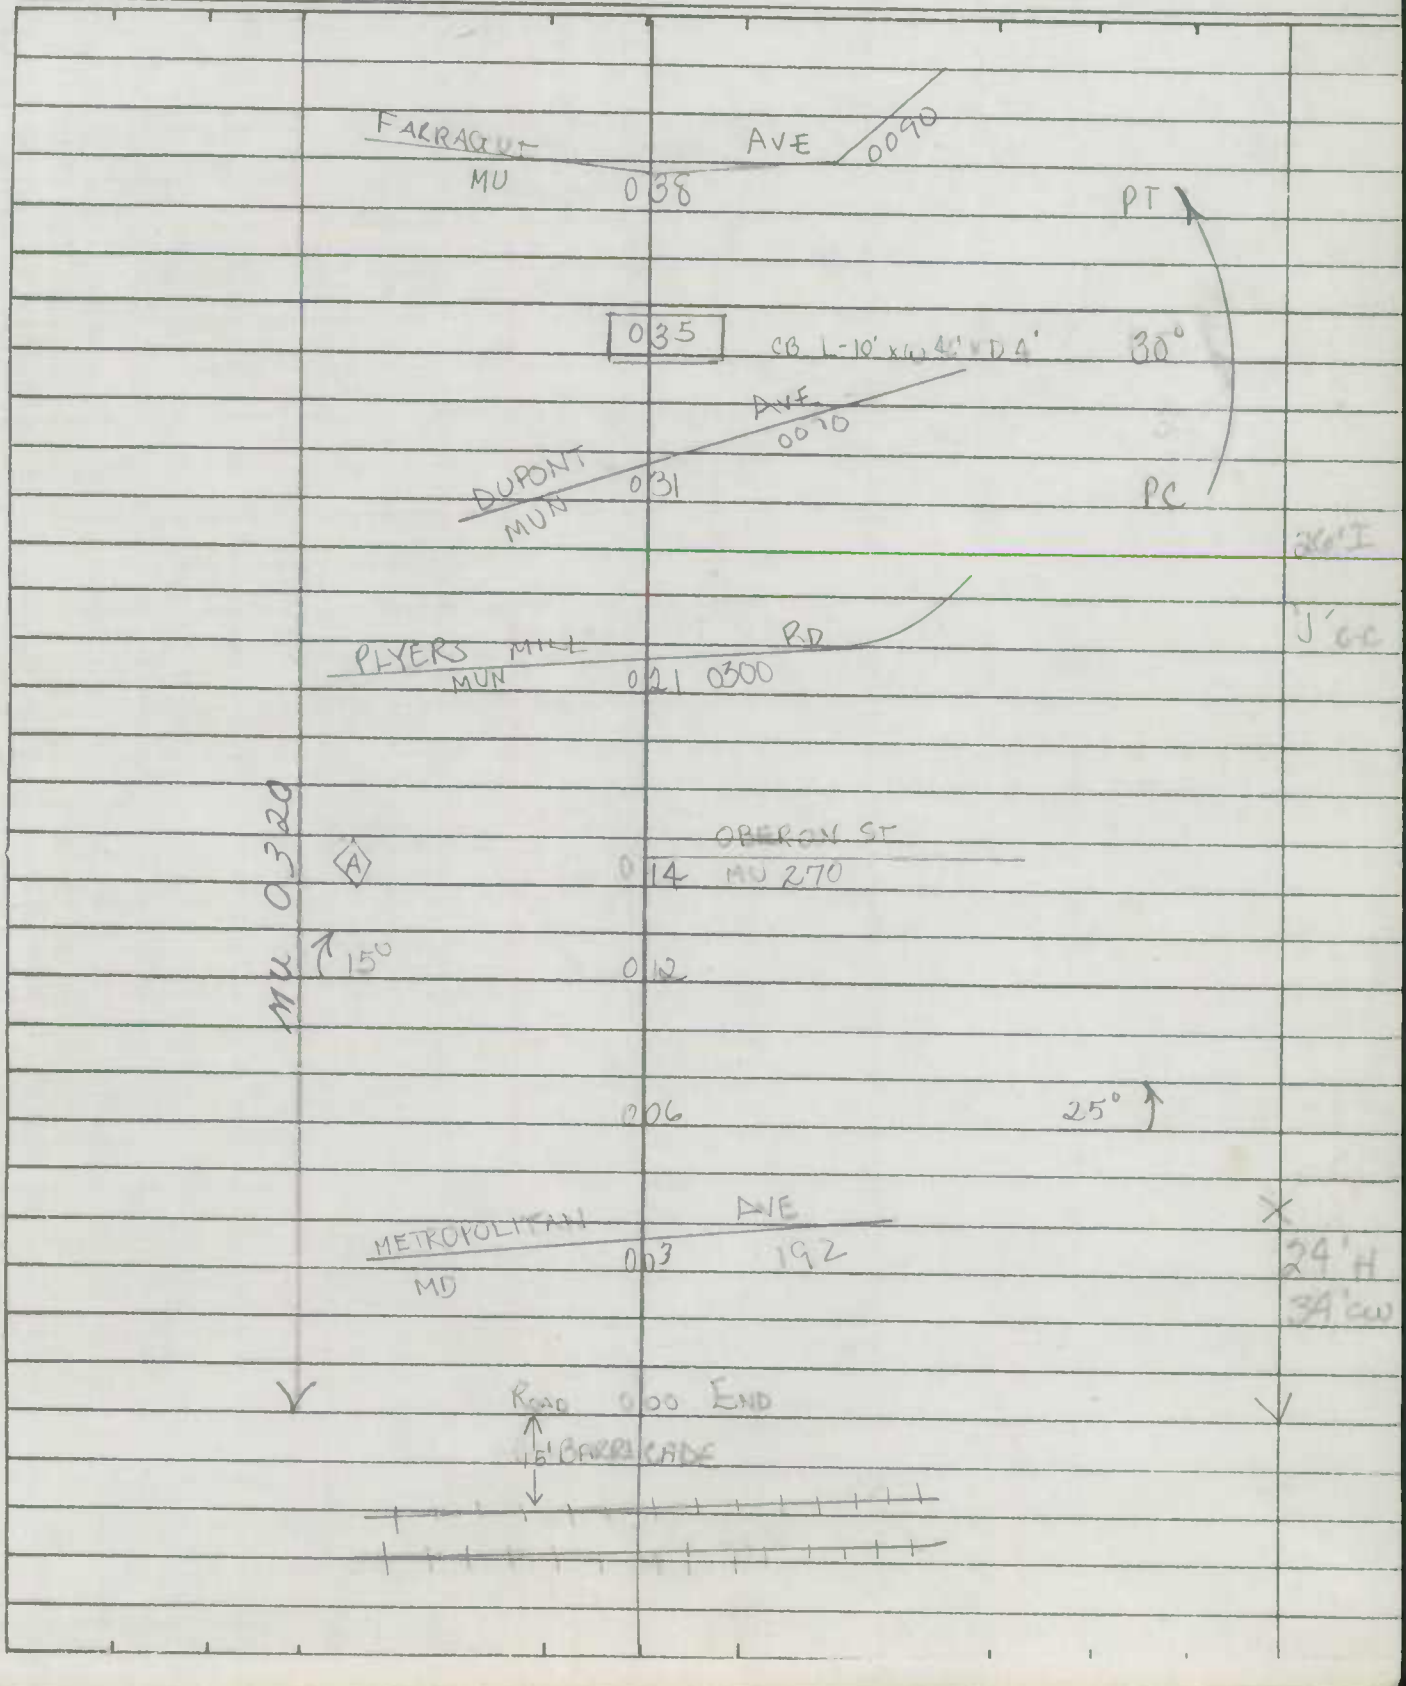

SHA 51.3-8
11-15-72

ROAD INVENTORY SHEET

Road No. 320
Road Name ST PAUL ST
Sheet No. 2 of 2
Date 8-23-73
County MONT
State Coordinates 779-435

CO 1692

CO 46 92

0 59

0 58

DECATUR AVE
CO 104

0 52

MCCOMAS AVE
292
CO

0 48

PERRY AVE
CO 160

0 45 — CORP LIMITS — OF KENSINGTON

0 44

MUNI 320

43' J

J' C-C

18' I

24' (W)

26' I

J' C-C

SHA 51.3-8
11-15-72

MUN. 0320
~~MUN. 0320~~

ROAD INVENTORY SHEET

~~MD. 666 C~~

Party Chief T. LANDON
Recorder W. WARFIELD
Helper

Road No. MD. 666 C
Road Name ST. PAUL ST.
Sheet No. 1 OF 2
Date 8-23-73
County MONT.
State Coordinates 779-435

Map No. 31

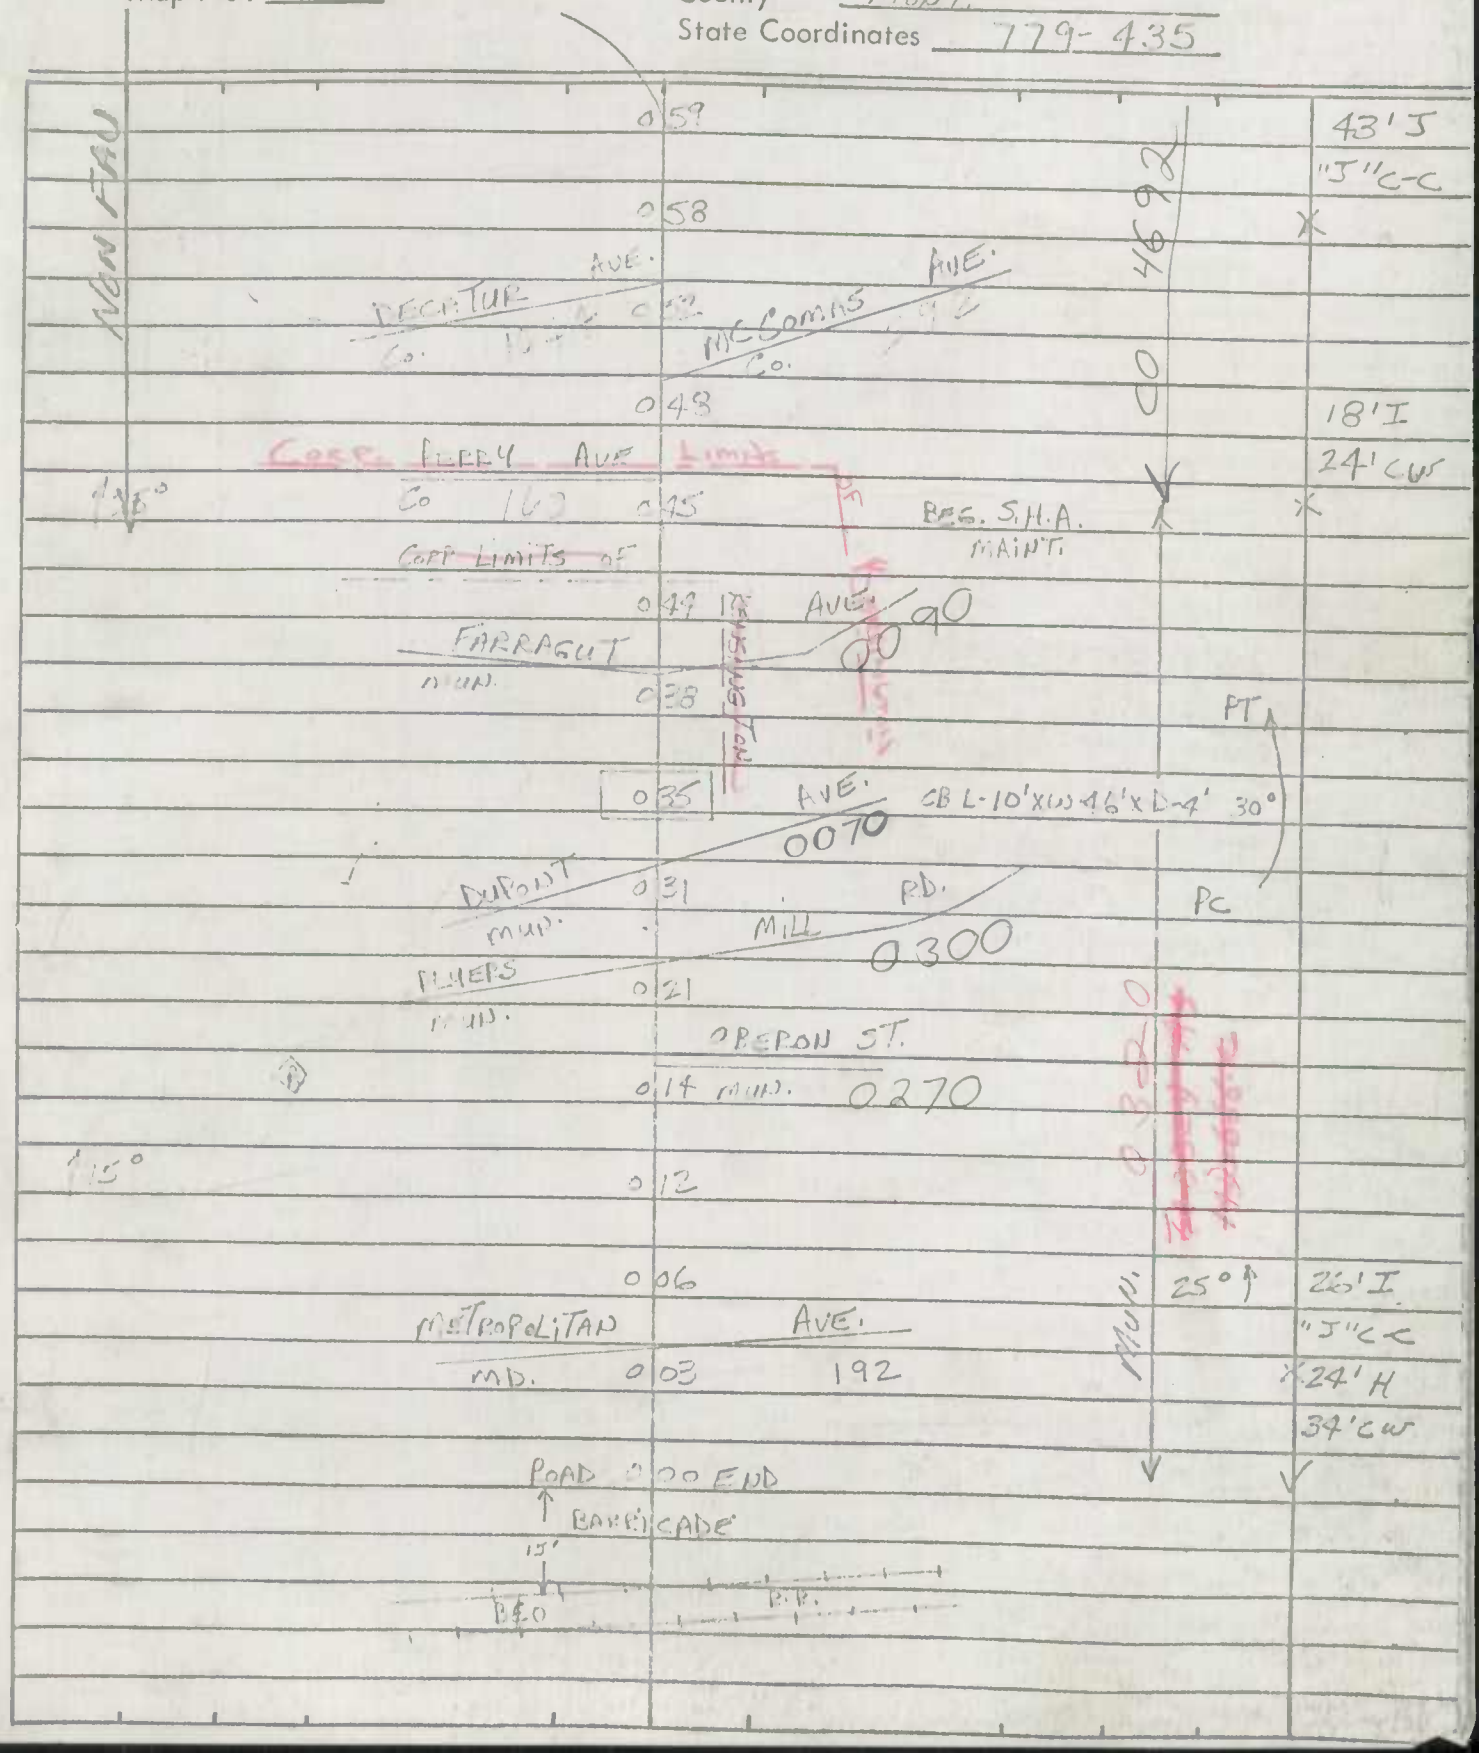

SHA 51.3-8
11-15-72

STATE HIGHWAY ADMINISTRATION OF MARYLAND

ROAD INVENTORY SHEET MUN 0340

Party Chief T. LANDON
Recorder M. ZABENSKI
Helper

Map No. 31

Road No. ~~Co. 1429~~
Road Name WAKE DR
Sheet No. 1 OF 1
Date 4-30-74
County MONT.
State Coordinates 781-432

KENSINGTON

FREDERICK AVE
MUN. 0.34
0.20

CORP LIMITS OF KENSINGTON
0.29

E. BEXHILL DR
CO 1069
0.26

0.17

KENT ST
CO 0.13 566'

0.07

HILLRIDGE DR
CO 0.00 1982'

N

PT 45° PC

MUN

PT 90° PC

36' I
1'c-c
2 UML

36' H
1'c-c
2 UML

26' I
1'c-c
2 UML

SHA 51.3-8
11-15-72

STATE HIGHWAY ADMINISTRATION OF MARYLAND

Kensington

ROAD INVENTORY SHEET TABBED AS

Party Chief I LANDON
Recorder W WARFIELD
Helper

Map No. _____

Road No. MD 192
Road Name PLYERS MILL RD
Sheet No. 1 OF 1
Date 7-26-73
County MONT
State Coordinates 776-437

Revised 8-26-81 JTC

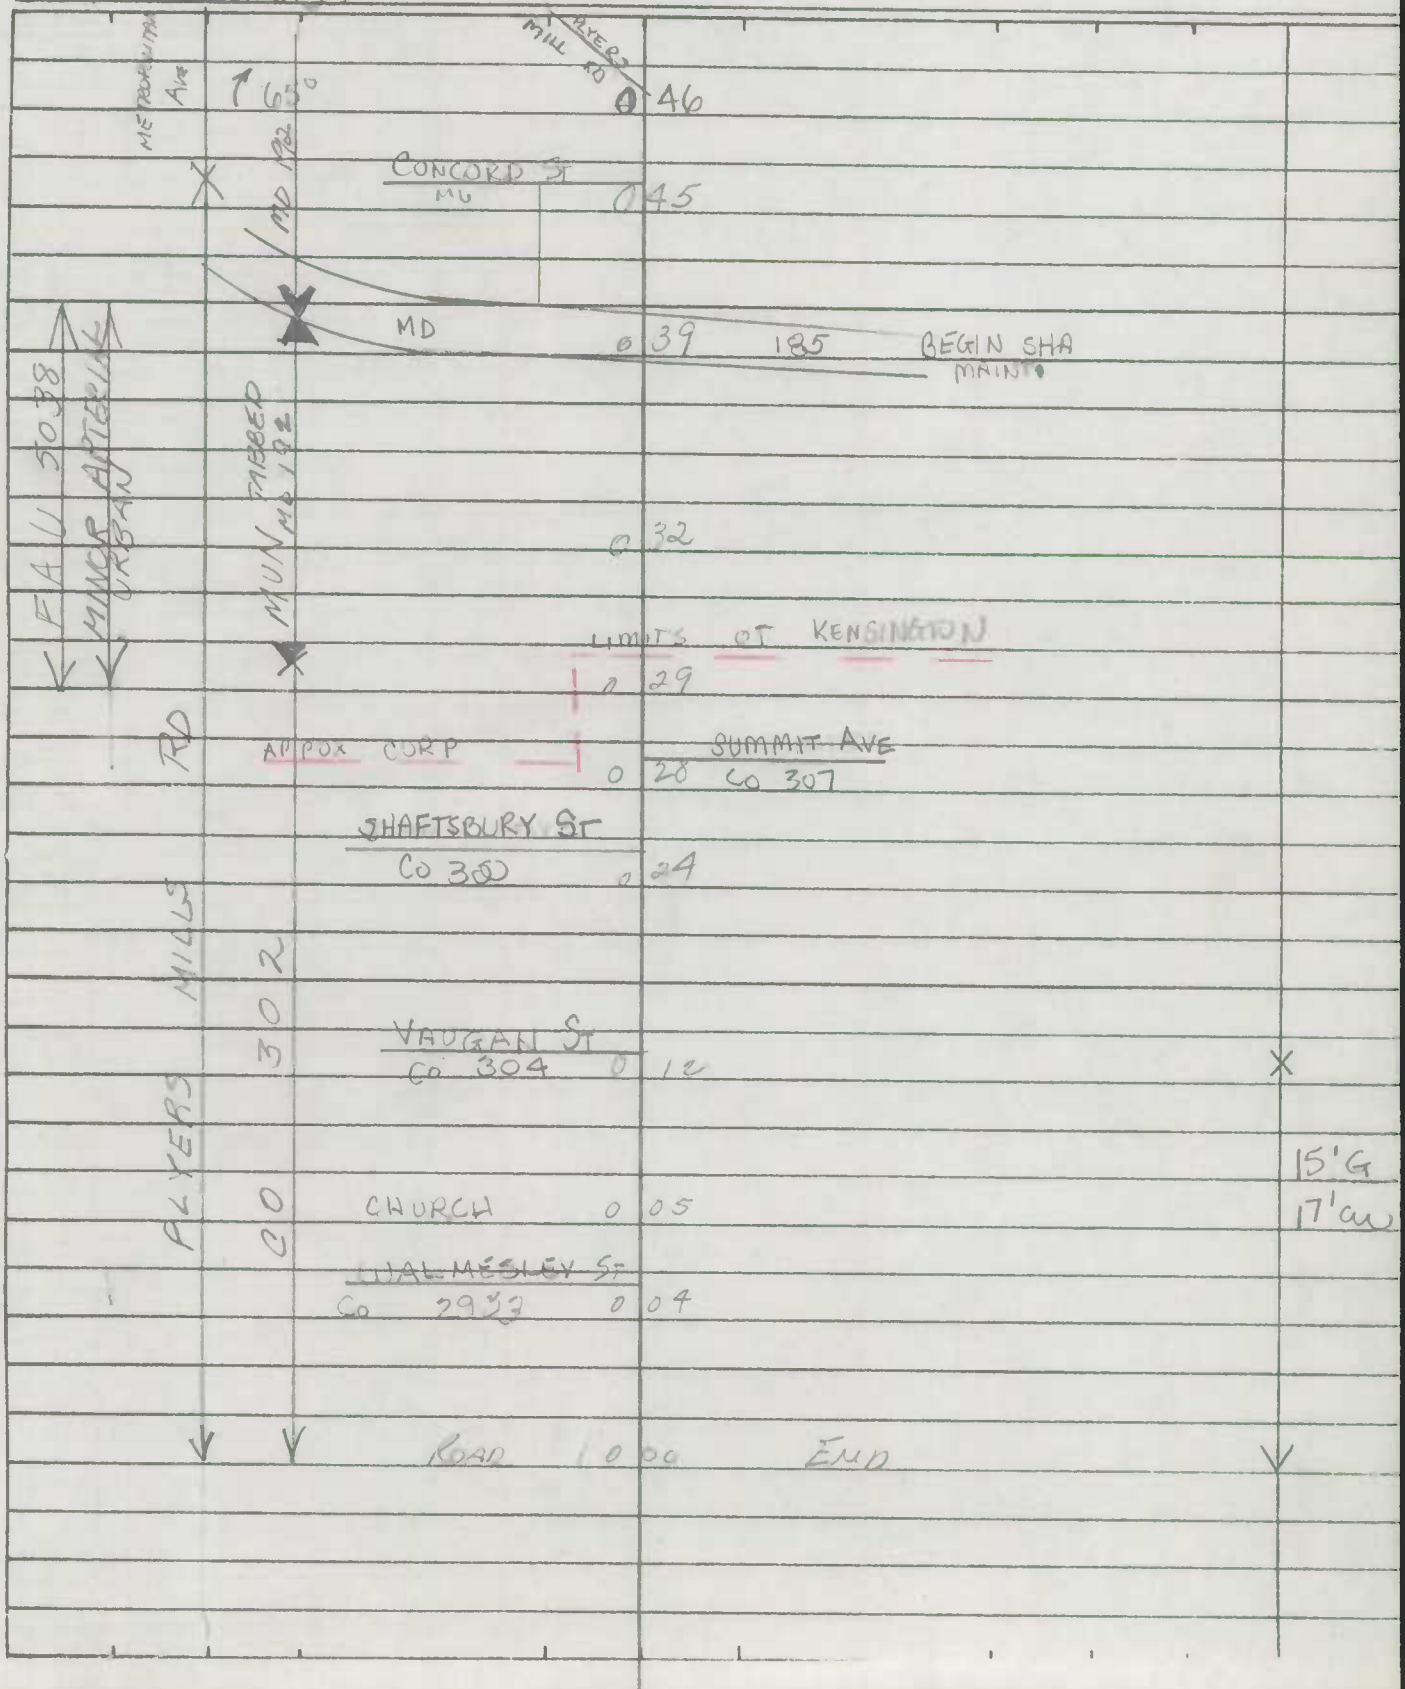

SHA 51.3-8
11-15-72

ROAD INVENTORY SHEET

Road No. _____
Road Name _____
Sheet No. _____
Date _____
County _____
State Coordinates _____

SHA 51.3-8
11-15-72

ROAD INVENTORY SHEET METROPOLITAN AVE.

Party Chief T. HANLON
Recorder W. WARFIELD
Helper

Map No. 31

Road No. ~~MD 192~~ MUN 0302
Road Name PLYERS MILL RD
Sheet No. 1 of 6
Date 7-26-72
County MONT.
State Coordinates 776-437

WHEATLEY ST
MUN.
0.72
ST. PAUL
MUN.
0.66
PLYERS MILL RD.
MUN.
165°
0.46
CONCORD ST.
MUN
0.45
CONNECTICUT
MD.
0.39
AVE.
BRS. S.H.A.
MAINT.
0.32
of KENSINGTON
0.01
APPROX. CORP. LIMITS
SUMMIT AVE.
0.28 Co. 307
SHAFFERMAN ST.
Co. 300 0.24
VALERIN ST.
Co. 304 0.12
CHURCH
0.05
WHEATLEY ST.
Co. 2933 0.04
END 0.00 END

METROPOLITAN AVE
MD 192
MUN 0302
PLYERS MILL RD
MUN

20' I
24' Cur
X
22' I
"J" C-C
X 2.24 I
"J" C-C
4' J Med.
X
31' H
"I" C-C
37' Cur
X
22' H
24' Cur
X
15' G
17' Cur

SHA 51.3-8
11-15-72

STATE HIGHWAY ADMINISTRATION OF MARYLAND

ROAD INVENTORY SHEET

MUN 0030

Party Chief T. LANDON
Recorder M. ZACENSKI
Helper

Map No. 31

Road No. Co. 2789
Road Name CUMMINGS LA
Sheet No. 1 OF 1
Date 5-3-74
County MONT
State Coordinates 782-417

 

Martins Additions

SHA 51.3-8
11-15-72

STATE HIGHWAY ADMINISTRATION OF MARYLAND

ROAD INVENTORY SHEET

MUN 0030

Party Chief T. LANDON
Recorder M. ZACENSKI
Helper

Map No. 31

Road No. Co. 2789
Road Name CUMMINGS LA
Sheet No. 1 OF 1
Date 5-3-74
County MONT
State Coordinates 782-417

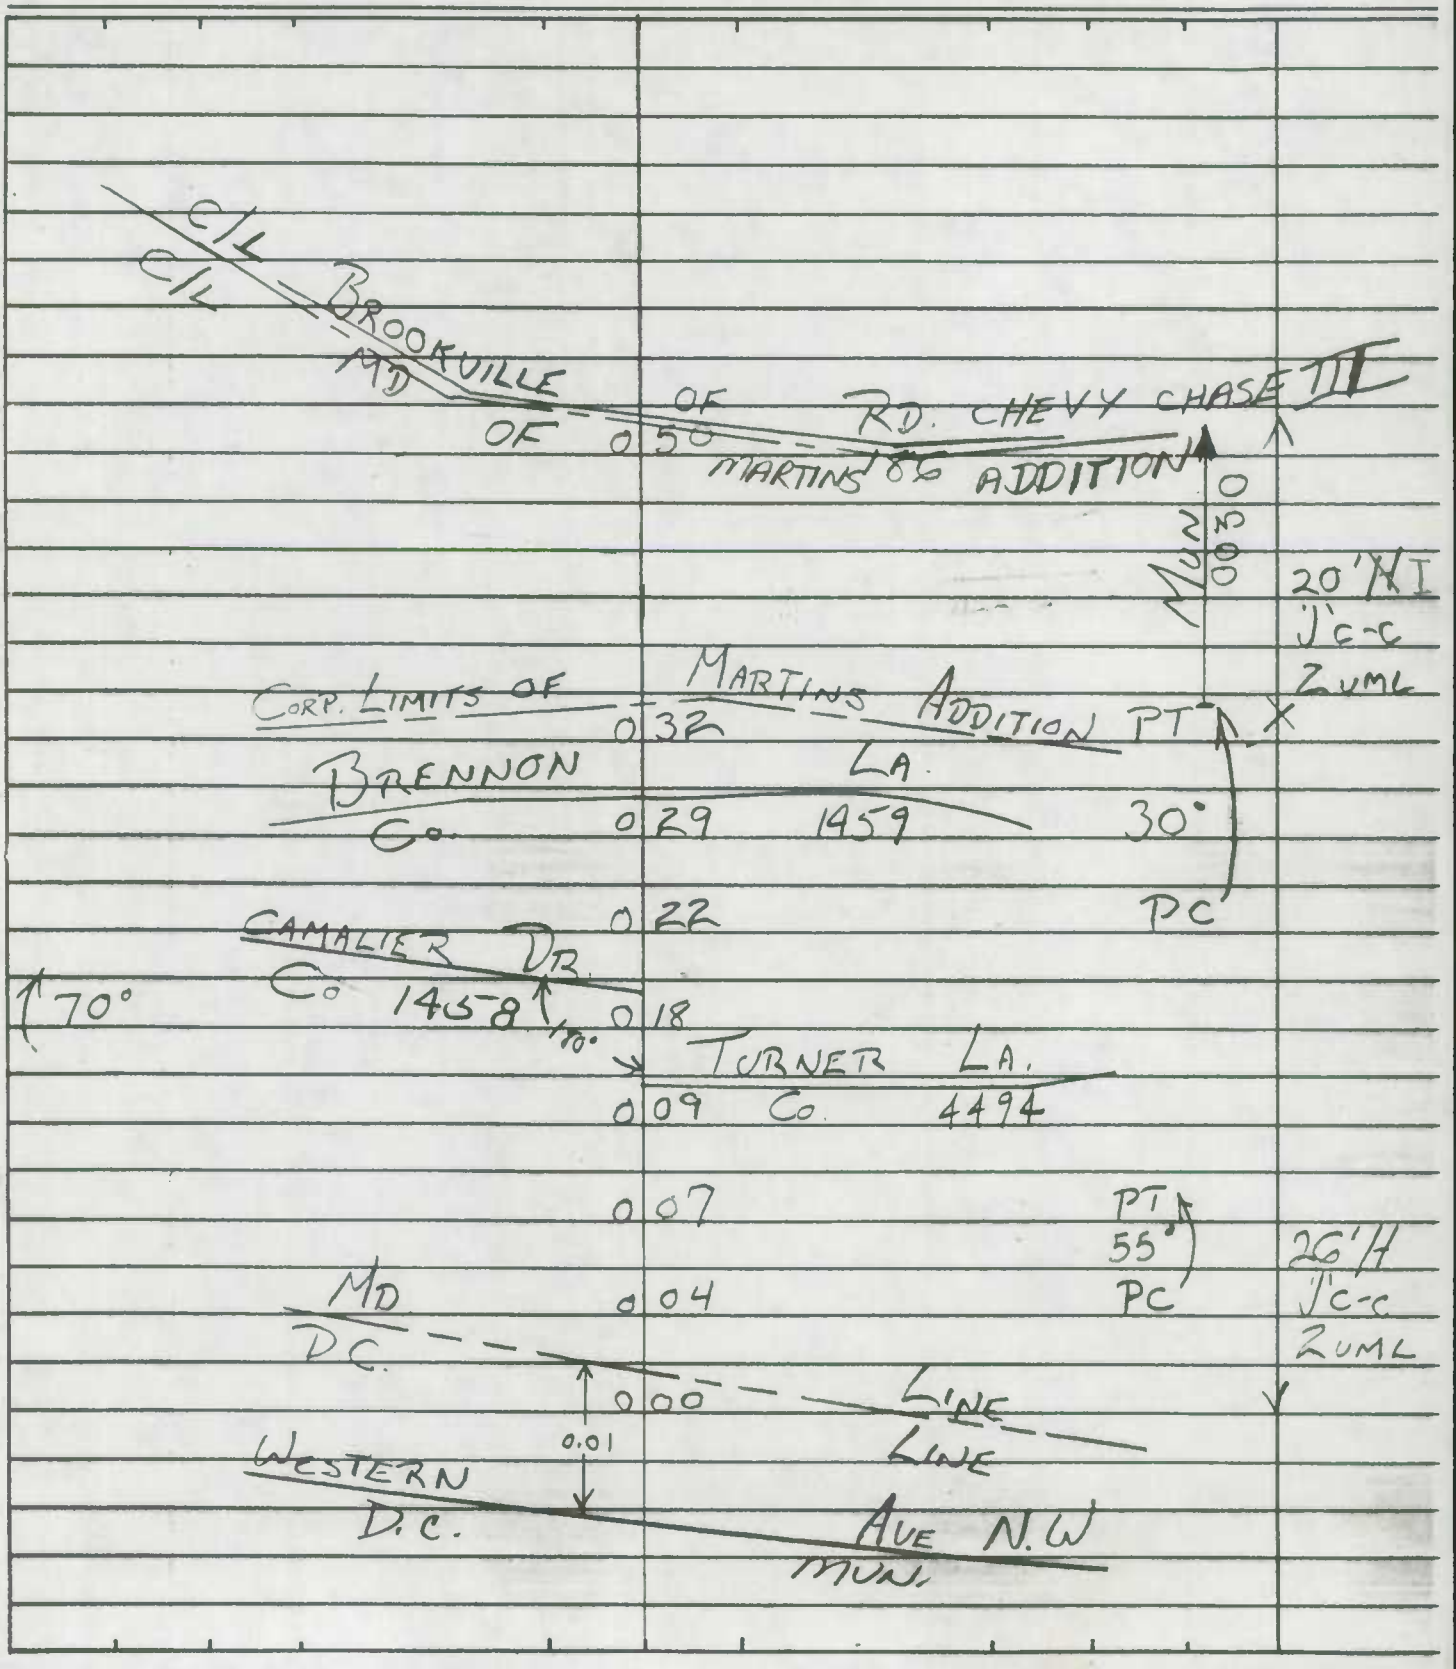

SHA 51.3-8
11-15-72

STATE HIGHWAY ADMINISTRATION OF MARYLAND

ROAD INVENTORY SHEET

MUN 0090

Party Chief T. LANDON
Recorder M. GALENSKI
Helper

Map No. 31

Road No. Co. 4495
Road Name SHEPHERD ST
Sheet No. 1 OF 1
Date 5-3-74
County MONT.
State Coordinates 781-417

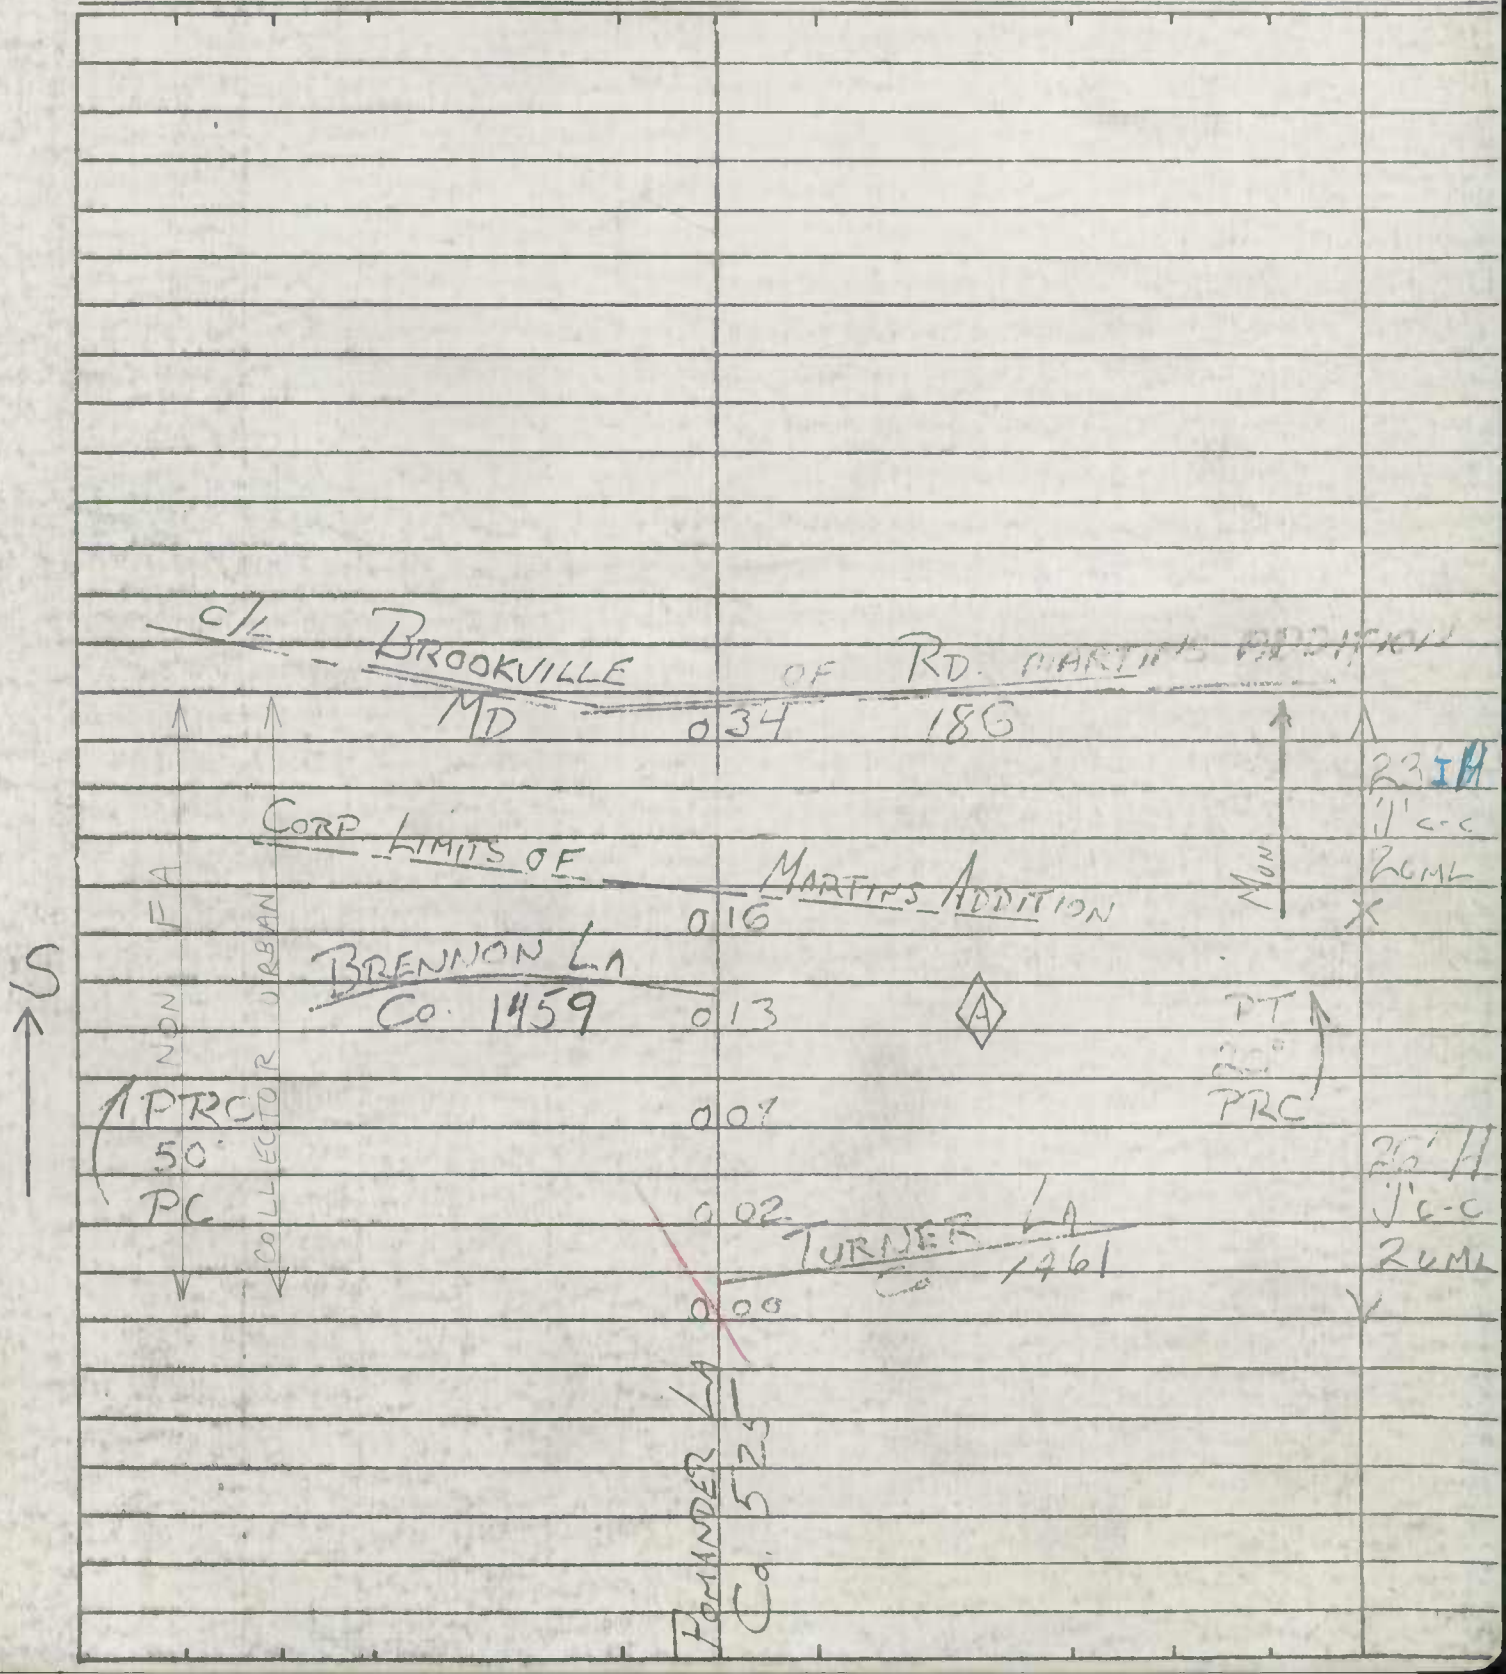

SHA 51.3-8
11-15-72

STATE HIGHWAY ADMINISTRATION OF MARYLAND

ROAD INVENTORY SHEET MU 0100 ✓

Party Chief I. LANDON
Recorder M. ZALENSKI
Helper

Map No. 31

75-1 AS TABBED

Road No. ~~Co. 532~~
Road Name SUMMIT AVE.
Sheet No. 1 OF
Date 5-3-74
County MONT.
State Coordinates 781-420

AI 84-2

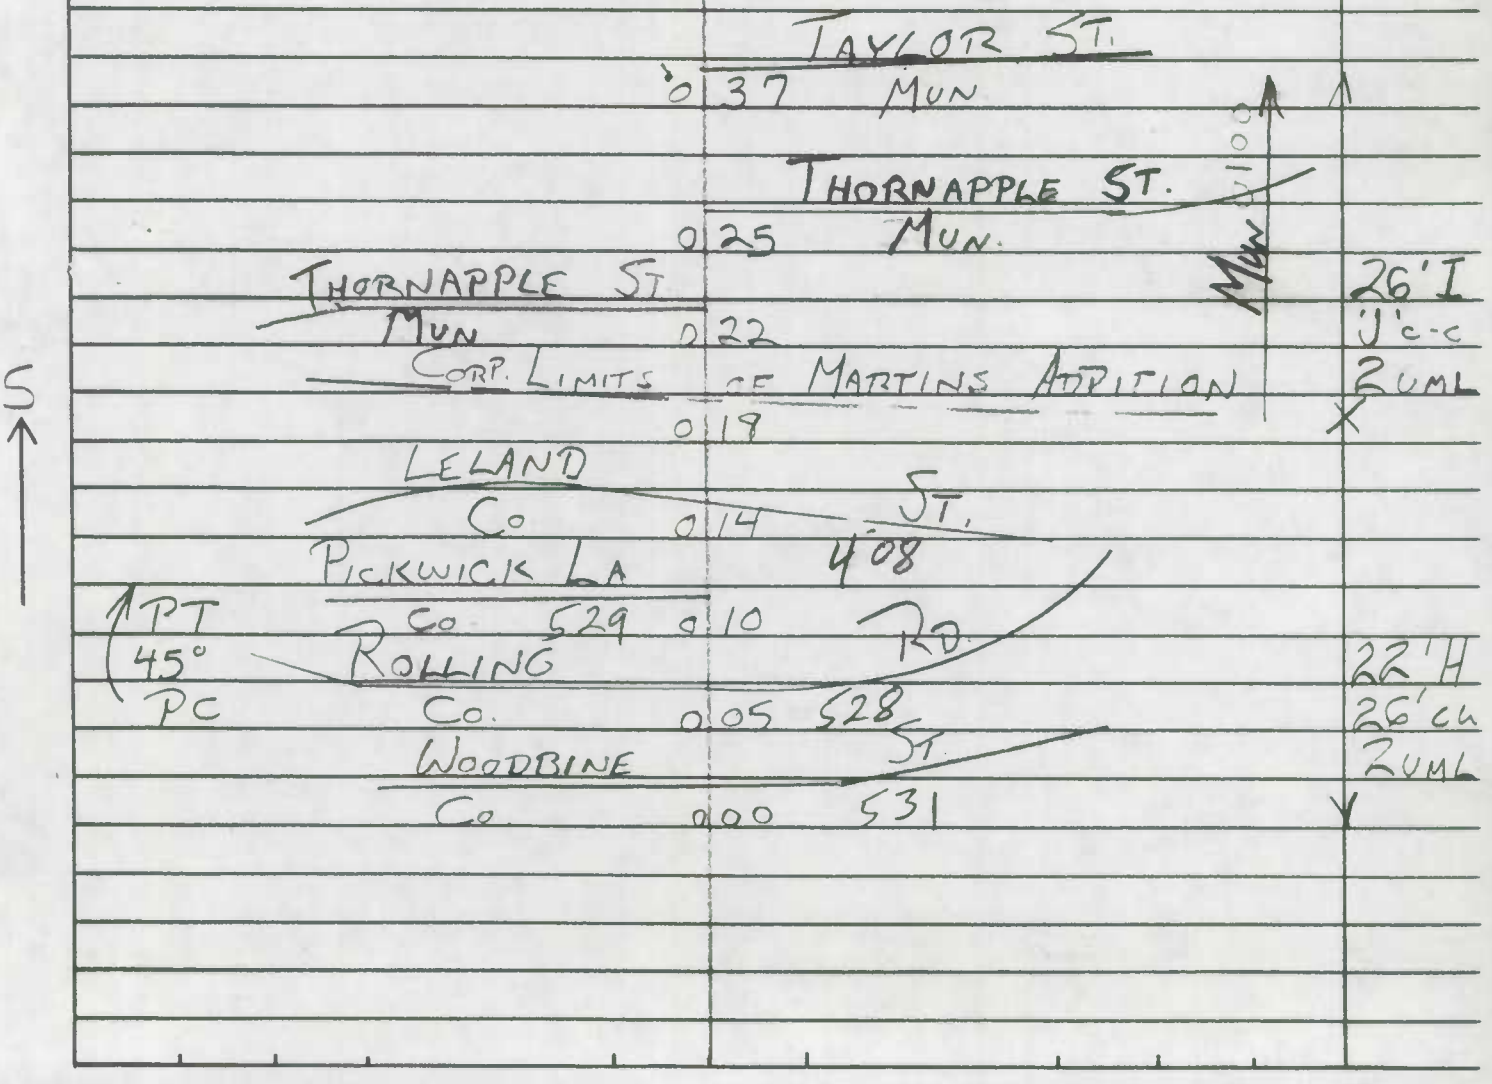

SHA 51.3-8
11-15-72

STATE HIGHWAY ADMINISTRATION OF MARYLAND

ROAD INVENTORY SHEET

MUN 0120

Party Chief T. LANDON
Recorder M. ZAGANSKI
Helper

Map No. 31

Road No. (M) CO 4493
Road Name TOMAHAWK ST.
Sheet No. 1 OF 1
Date 5-2-74
State Coordinates 782-419

81-6

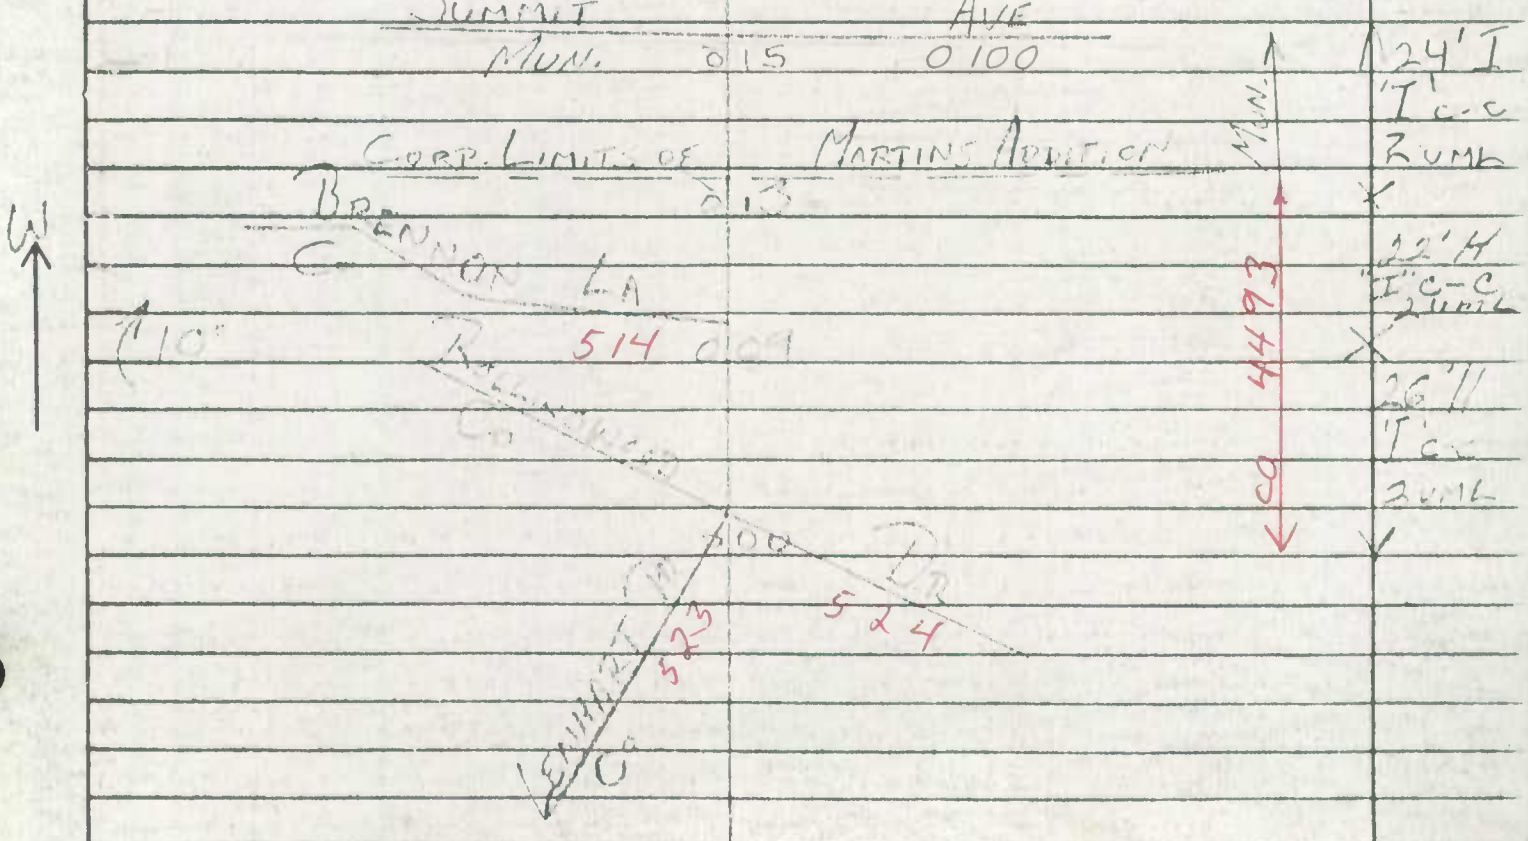

SHA 51.3-8
11-15-72

STATE HIGHWAY ADMINISTRATION OF MARYLAND

NORTH CHEVY CHASE

ROAD INVENTORY SHEET

MUN 0005

Party Chief T. LANDON
Recorder M. BAKER
Helper

Map No. 31

Road No. C 2283
Road Name CLIFFORD AVE
Sheet No. 1 of 1
Date 5-2-74
County MONT
State Coordinates 280-424

91-2
GD-JK
3-24-92

North Chevy Chase

N

MUN (91-2) = N13

0.05

0.01

JONES BRIDGE RD
537

PT
PC

2@11
1@6
2 @ ML

SHA 51.3-8
11-15-72

STATE HIGHWAY ADMINISTRATION OF MARYLAND

NORTH CHEVY CHASE

ROAD INVENTORY SHEET MUN 0005

Party Chief I. LANDON
Recorder M. BALES
Helper

Map No. 31

Road No. Co 2283
Road Name CLIFFORD AVE
Sheet No. 1 of 1
Date 5-2-74
County MONT
State Coordinates 280-424

91-2
SD-JK
3-24-92

MONTGOMERY AVE
MUN 0060 0.19 MUN 0062

CORP. LIMITS of NORTH CHEVY CHASE
0.15

Stewart Drwy
MUN (91-2) 0.13

0.05

0.01

JONES BRIDGE RD
CO 0.00 537

N

MON

25' I
1 LANE
2 UNL

PT
PC

25' H
1 LANE
2 UNL

SHA 51.3-8
11-15-72

STATE HIGHWAY ADMINISTRATION OF MARYLAND

North Chevy Chase

ROAD INVENTORY SHEET

MUN 0010

Party Chief T. LANDON
Recorder M. ZAHENSKI
Helper

Map No. 31 F11A

Road No. ~~Co. 2117~~
Road Name DUNDEE DRIVE
Sheet No. 1 of 1
Date 5-6-74
County MONT
State Coordinates 179-425

BRIERLEY RD
Co 0117 540

E

0.10 25° 26'H 1'C-C 2 UML

MCGREGOR DR
Co 2371 0.08

COUNTY LIMITS OF NORTH CHEVY CHASE
25° 0.06 26'I 1'C.T. 2 UML

MONTGOMERY AVE
MUN 0.00 0062

SHA 51.3-8
11-15-72

STATE HIGHWAY ADMINISTRATION OF MARYLAND

ROAD INVENTORY SHEET

MUN 0020

Party Chief T. LANDON
Recorder M. ZALESKI
Helper

Map No. 31

Road No. ~~C~~ 553
Road Name HUNTER, HWY
Sheet No. 1 OF 1
Date 5-2-74
County MONT.
State Coordinates 78-42.6

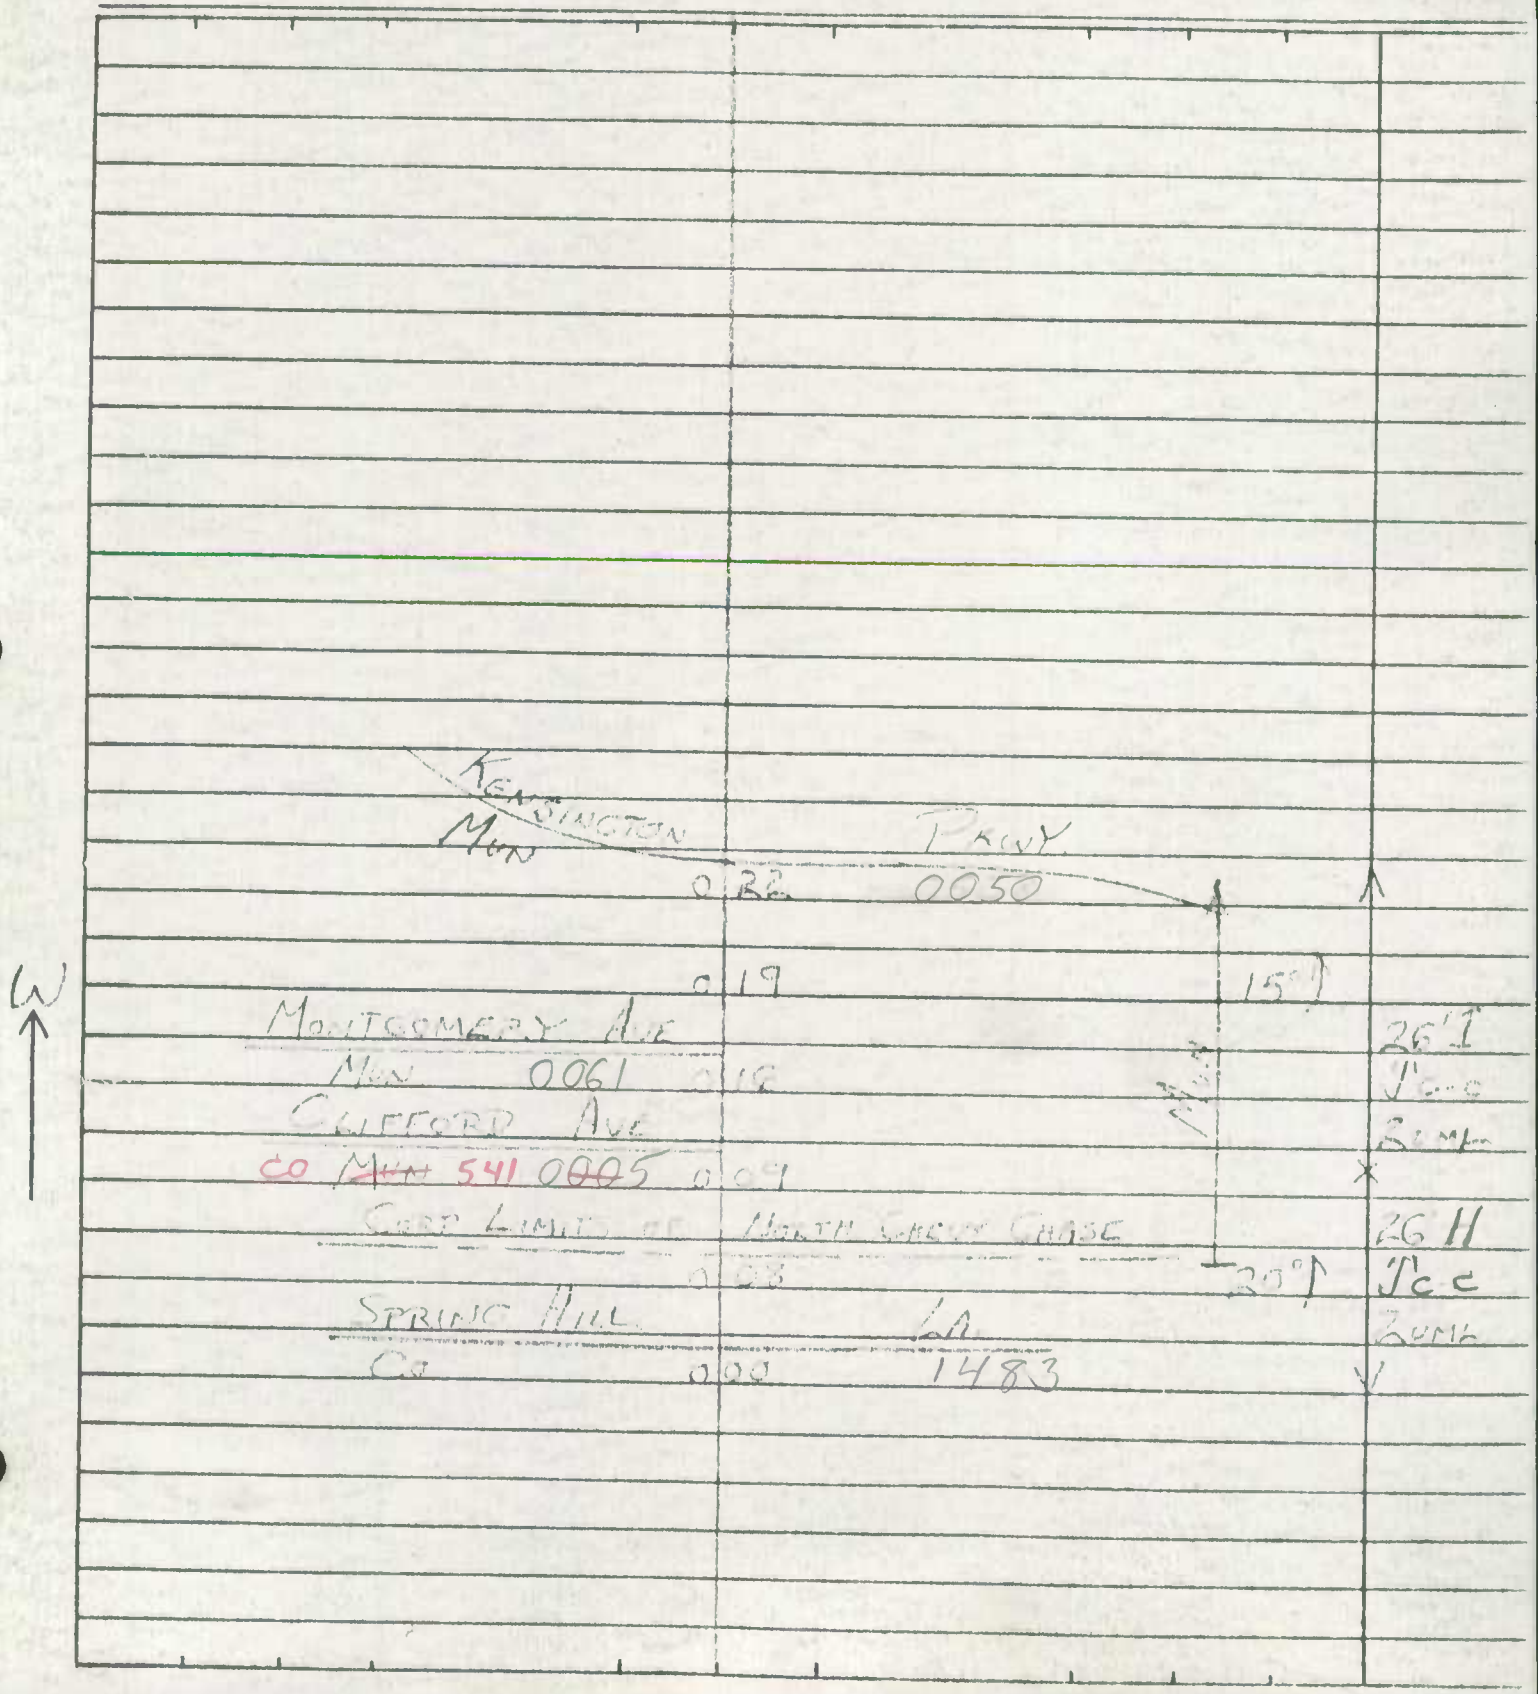

SHA 51.3-8
11-15-72

STATE HIGHWAY ADMINISTRATION OF MARYLAND

North Chevy Chase

ROAD INVENTORY SHEET

MUN 0030

Party Chief T. LANTON
Recorder M. ZAGENSKI
Helper

Map No. 31

Road No. ~~Co.~~ 539
Road Name INVERNESS DR
Sheet No. 1 OF 1
Date 5-2-74
County MONT
State Coordinates

80-2
79-3

BRIERLEY		RD	
Co.	0.22	540	26'H
			1 c-c
			2 UML
	0.19		X
SPRING HILL LA			
Co 1483	0.13		
CORP. LIMITS		OF NORTH CHEVY CHASE	20'H
	0.07		1 c-c
CHILTERN AVE			2 UML
15° CO/MUN 539 0005 11	0.06		X
			20'NI
			1-CURB LT
			1-CURB RT
			2 UML
	0.03		X
			20'I
MONTGOMERY		AVE	1 c-c
MUN	0.00	0061	2 UML

SHA 51.3-8
11-15-72

STATE HIGHWAY ADMINISTRATION OF MARYLAND

ROAD INVENTORY SHEET

MUN 0042

Party Chief I. LAWSON
Recorder M. KACENSKI
Helper

Map No. 31

Road No. ~~MD Co~~ 118
Road Name KENILWORTH DRWY
Sheet No. 1 OF 1
Date 5-2-74
County MONT.
State Coordinates

91-2
GD-JK
3-24-92

NORTH CHEVY CHASE

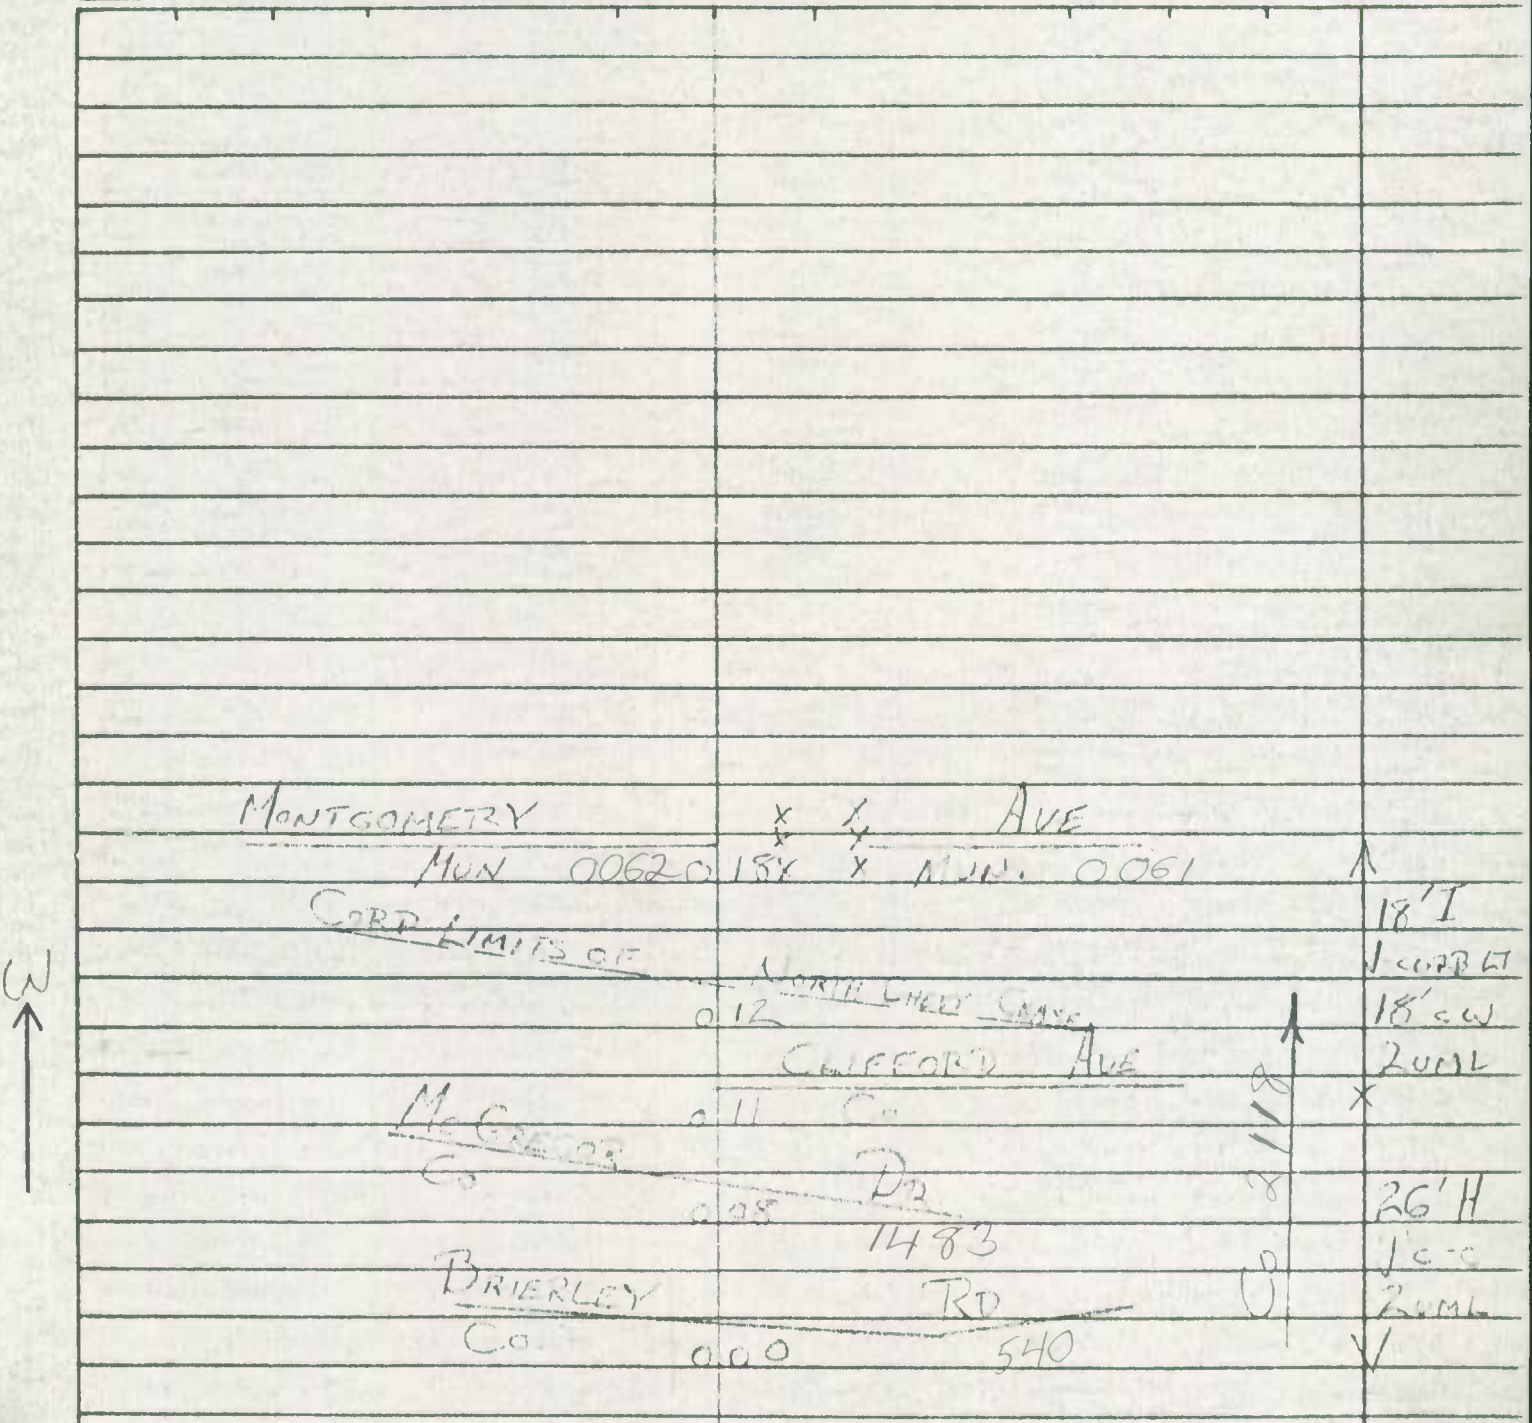

SHA 51.3-8
11-15-72

STATE HIGHWAY ADMINISTRATION OF MARYLAND

North Chevy Chase

ROAD INVENTORY SHEET MUN. 0050

Party Chief T. LANDON
Recorder M. ZALENSKI
Helper

Map No. 31

Road No. Co. 538
Road Name KENSINGTON PKWY
Sheet No. 3 OF 3
Date 4-30-74
County MONT.
State Coordinates

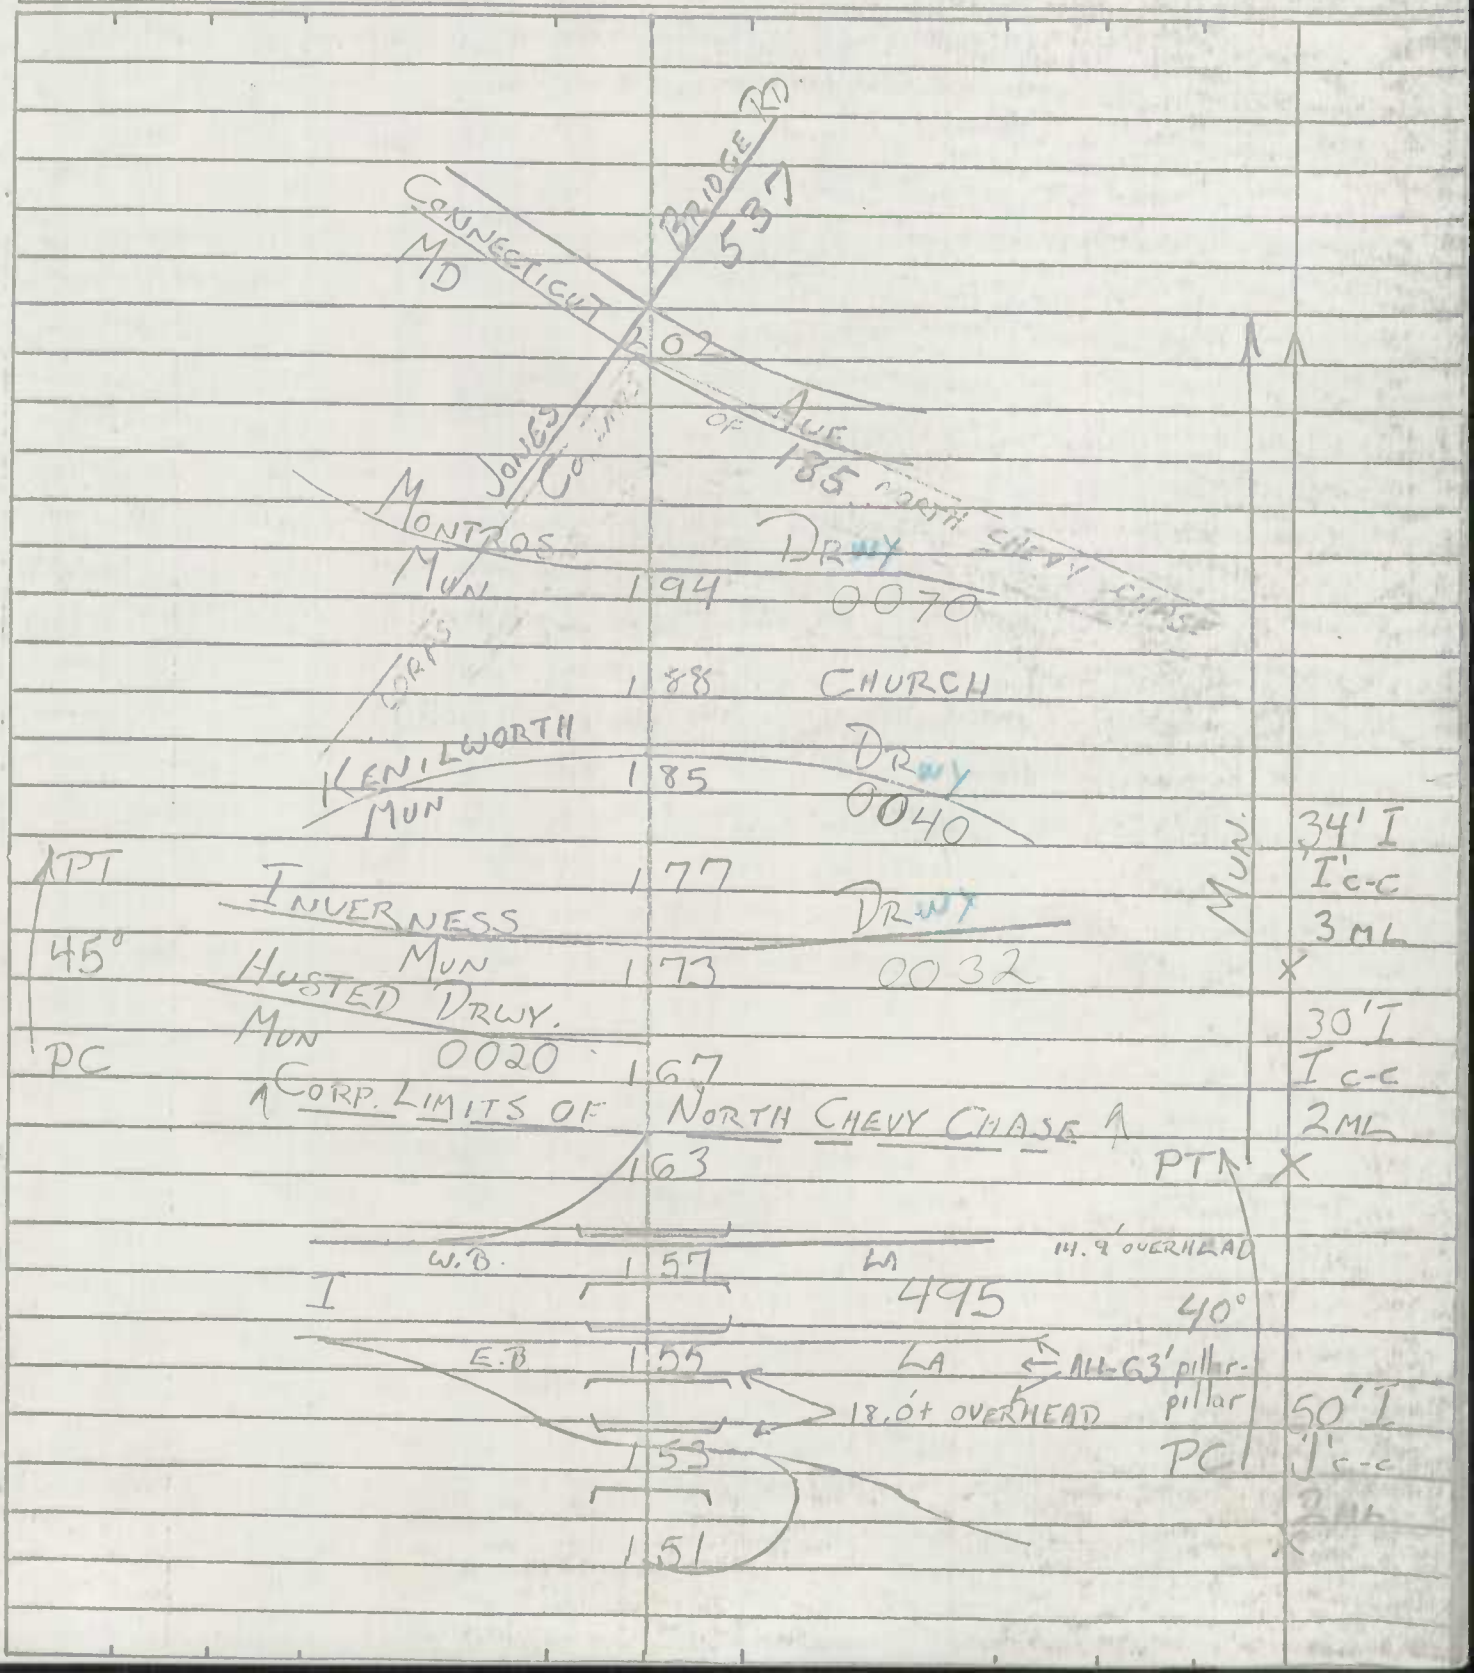

SHA 51.3-8
11-15-72

STATE HIGHWAY ADMINISTRATION OF MARYLAND

Co 4396

ROAD INVENTORY SHEET

Party Chief I. LANDEN
Recorder M. ZALOGOSKI
Helper

Map No. 30

OAKMONT

Road No. MUN 0020
Road Name OAK PL
Sheet No. 1 of 1
Date 2-19-74
County MONT
State Coordinates

Oakmont

CORP. LIMITS OF OAKMONT

END CO. MAINT. SIGN

0.27 (DALEY LA)

0.14 O.P 539

0.00 RD 169

OLD GEORGETOWN

MD

W

C&P TEL

28'H
J. CURB RT
30'C.W

20'H
J'C.C

SHA 51.3-8
11-15-72

STATE HIGHWAY ADMINISTRATION OF MARYLAND

Co 4396

ROAD INVENTORY SHEET

Party Chief T. LANDEN
Recorder M. ZALESKI
Helper

Map No. 30

OAKMONT

Road No. MUN 0020
Road Name OAK Pl
Sheet No. 1 of 1
Date 7-19-74
County MONT
State Coordinates

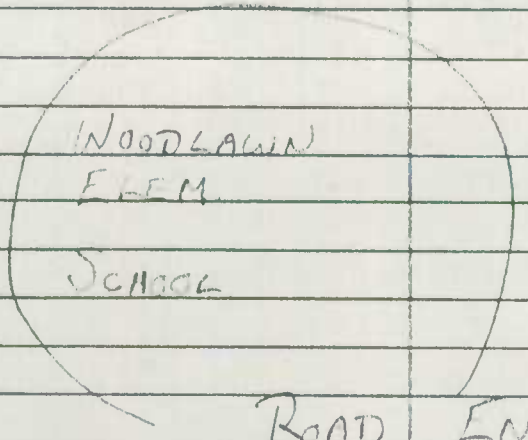

ROAD END
0.30
HEMPSTEAD AVE
0.29 CO 2650
CORP. LIMITS OF OAKMONT
END CO. MAINT. SIGN
0.27
(DALEY LA)
0.14 O.P 539
0.00 RD
OLD GEORGETOWN
MD
187

C 4.3%

28'H
J. CURB RT
30'C.W
20'H
J'C.C

W

SHA 51.3-8
11-15-72

OP 4590

ROAD INVENTORY SHEET

Party Chief W. Dombroski
Recorder D Taylor
Helper

Map No. 25

REV 3-1-76
75-Extra
Poolesville

Road No. MUN 0037
Road Name (Hoskinson Rd)
Sheet No. 1 of 1
Date 7-27-73
County Montgomery
State Coordinates 681-475

	ROAD END		
	0 55		

SHA 51.3-8
11-15-72

OP 4590

ROAD INVENTORY SHEET

Party Chief W. Dombroski
Recorder D Taylor
Helper

Map No. 25
Rev 3-7-76
75-5 [illegible]
Poolesville

Road No. MUN 0037
Road Name (Hoskinson Rd)
Sheet No. 1 of 1
Date 7-27-73
County Montgomery
State Coordinates 681-475

ROAD	END	
0	55	
BETMER	Ave	
MUN 0	53	0015
(Westerly	Ave)	
MUN 0	36	0059
0	28	10°R
(Spurrier	Rd)	
0	27	MUN 0056
(Chiswell	Rd)	
MUN 0	17	0017
Ent to Townhouses	0	10 Ent to Townhouses
Ent to Townhouses	0	07 Ent to Townhouses
Ent to Townhouses	0	03
	0	01 Ent to Townhouses
(Wootton		Ave)
MUN 0	00	0060

24'I
30'CW

S

SHA 51.3-8
11-15-72

Poolesville

ROAD INVENTORY SHEET

MUN. 0039

Party Chief [illegible]
Recorder D Taylor
Helper

Map No. 2.5

Road No. CO 270
Road Name Hughes Rd
Sheet No. 2 of 4
Date 7-24-73
County Montgomery
State Coordinates

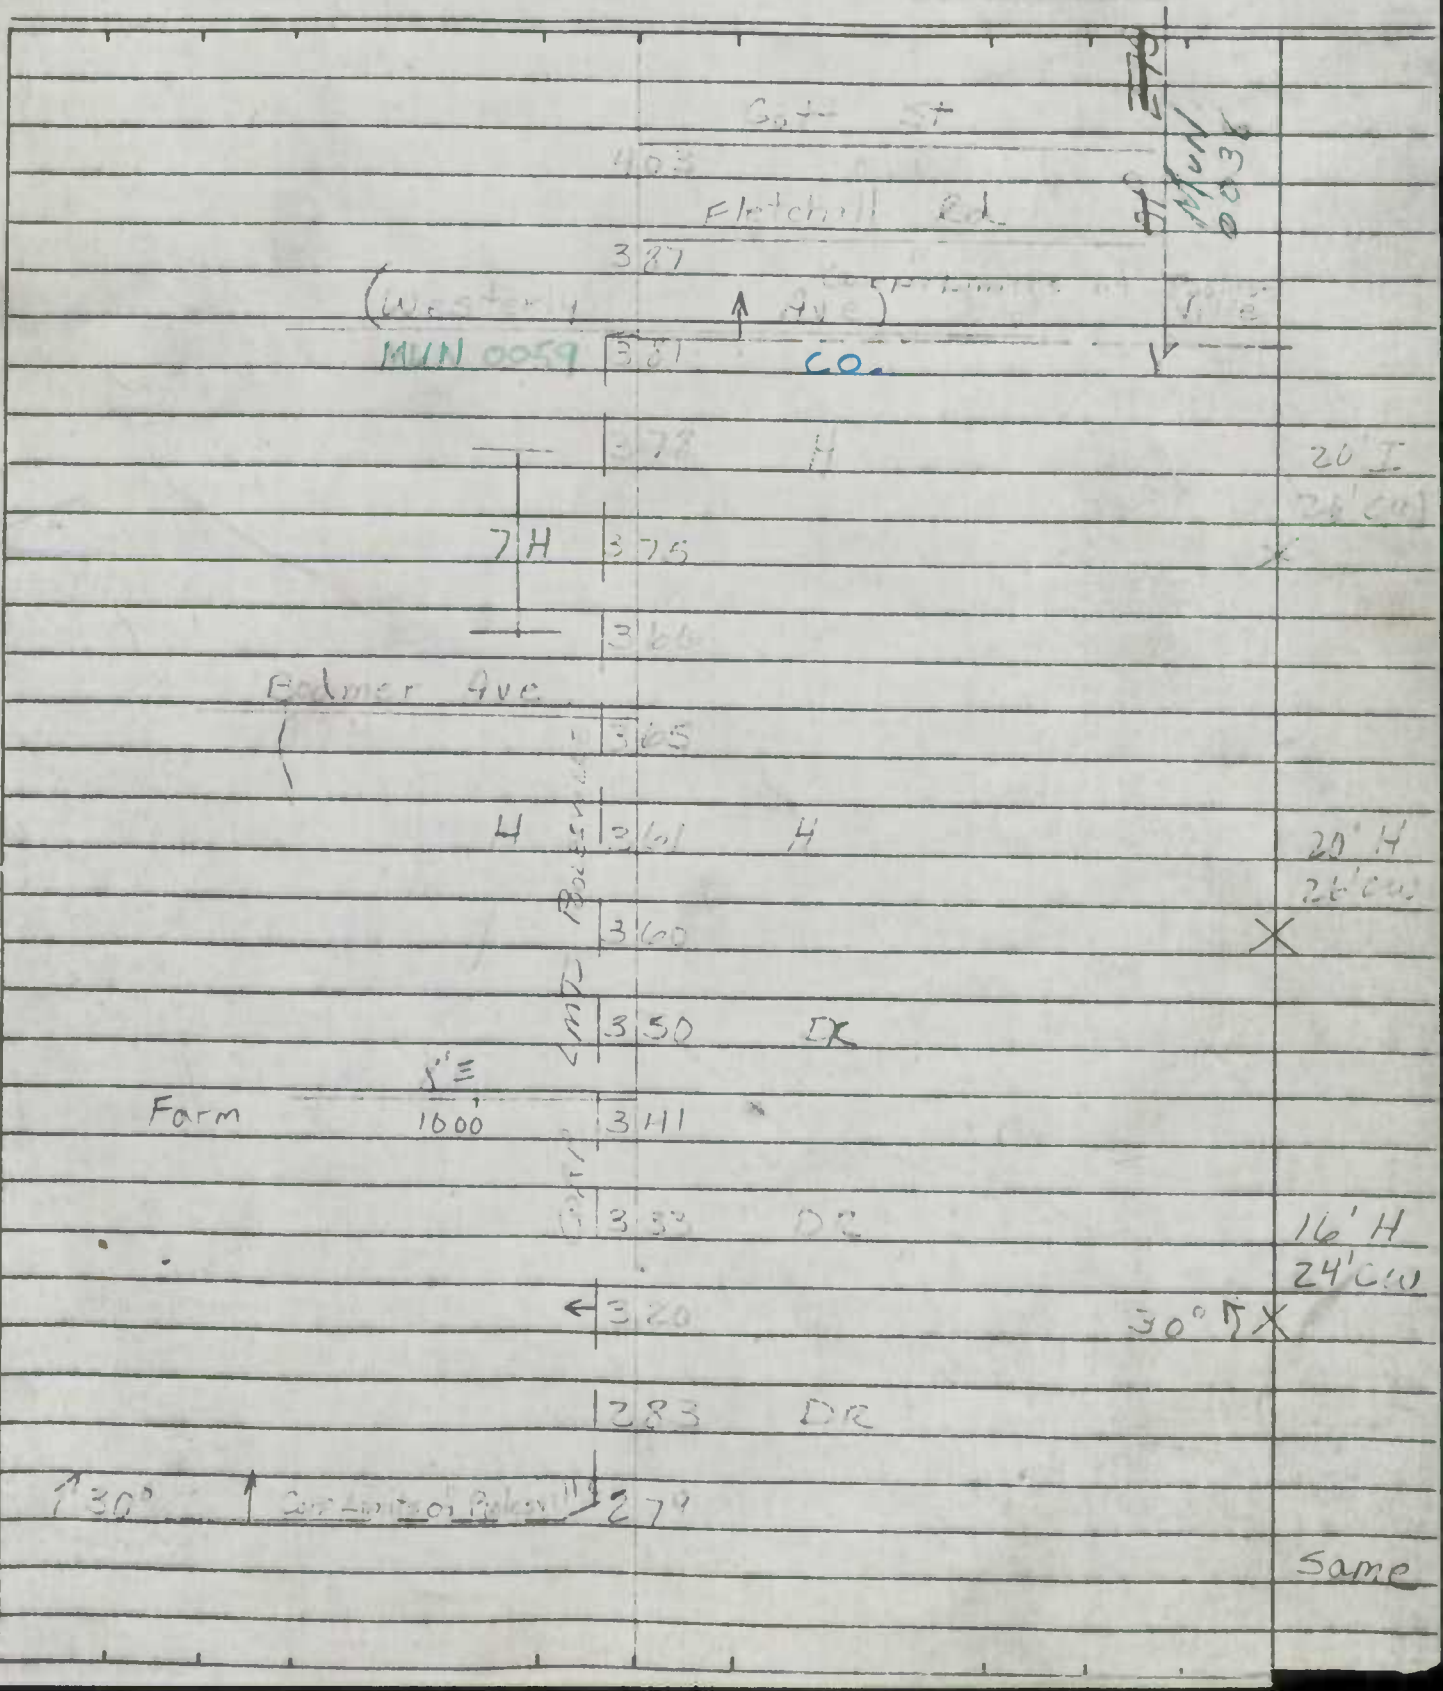

11-15-72

ROAD INVENTORY SHEET

Road No. CR. 27C
Road Name Hughes Rd
Sheet No. 4 of 11
Date 7-24-73
County Montgomery
State Coordinates

(Western Ave)
MIN. 415 0060

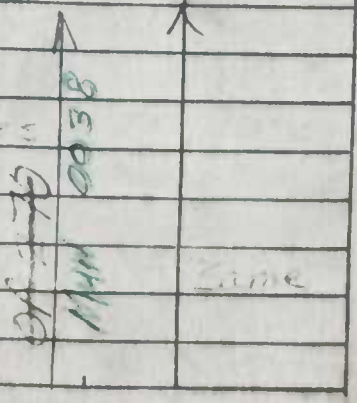

SHA 51.3-8
11-15-72

TL REV.
FR. 2/22/78

ROAD INVENTORY SHEET

CO 4738

Party Chief W. Dombraski
Recorder D Taylor
Helper

Map No. 25 Rev. 3-9-76 25-7 Poolesville

Road No. MUN. 0059
Road Name Westerly Ave
Sheet No. 1 of ~~X~~ 2
Date 7-27-73
County Montgomery
State Coordinates

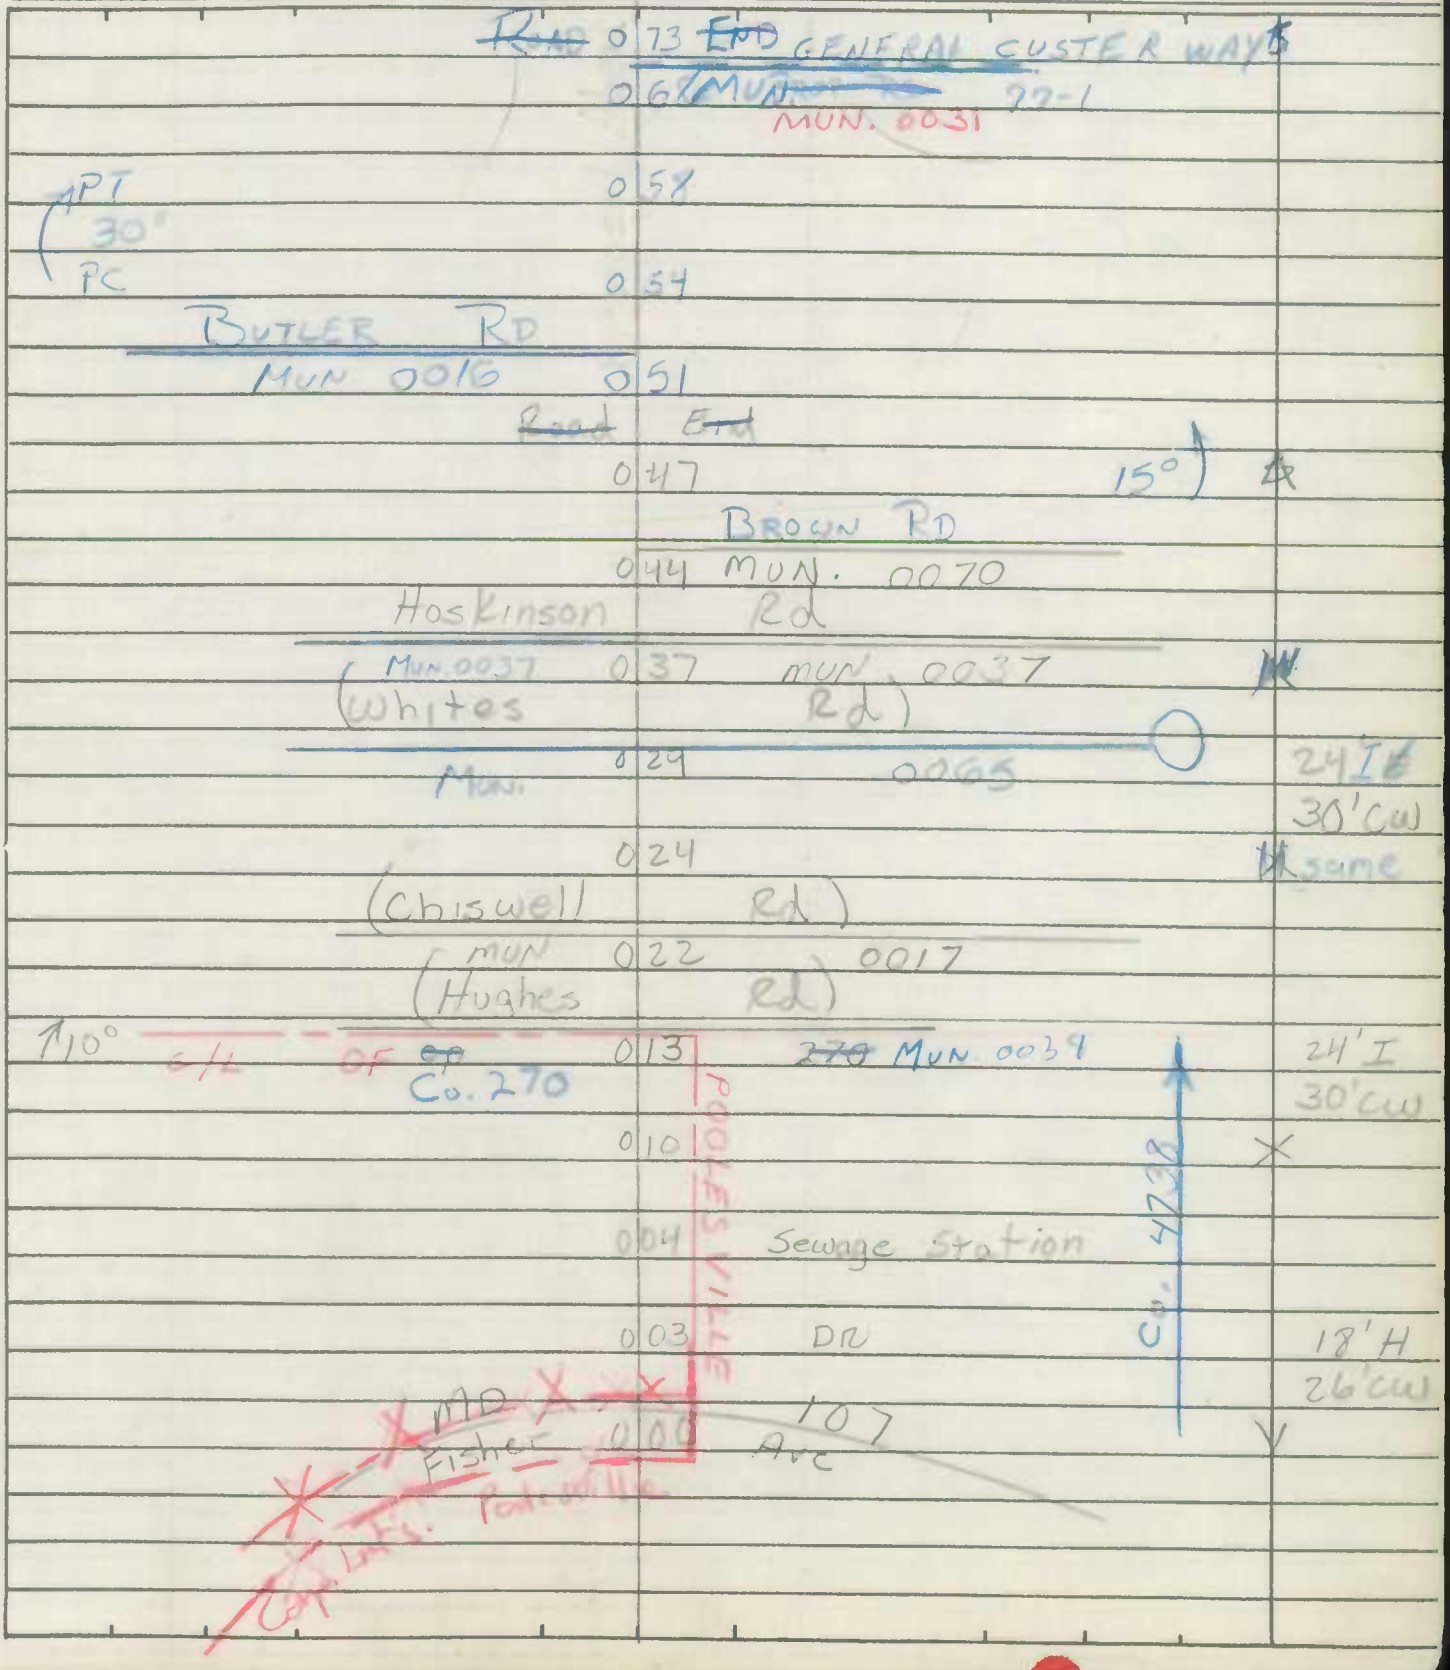

SHA 51.3-8
11-15-72

ROAD INVENTORY SHEET

Road No. MUN 0059
Road Name
Sheet No. 2 of 2
Date
County
State Coordinates

W. WILLARD	RT.	
CO. 0	84 0273	Λ
~~ROAD~~	~~END~~	
(Oxley Farm RD) 0	81	
~~OXLEY RD~~		
MU 0051 0	76	same

SHA 51.3-8
11-15-72

STATE HIGHWAY ADMINISTRATION OF MARYLAND

ROAD INVENTORY SHEET

Party Chief W. DOMBROSKI
Recorder M. ZALENISKI
Helper

Map No. 26 74-69
ROCKVILLE

Road No. MUN 0005
Road Name ("A" ST.)
Sheet No. 1 OF 1
Date 2-12-75
County MONT.
State Coordinates

81-1

PKG.

Rockville

E

2-22'T
3'c-c
4'J MED

MD 000 355

MUN. 2150
N. WASHINGTON ST

5-72

ROAD INVENTORY SHEET

Road No. _____
Road Name _____
Sheet No. _____
Date _____
County _____
State Coordinates _____

SHA 51.3-8
11-15-72

STATE HIGHWAY ADMINISTRATION OF MARYLAND

ROAD INVENTORY SHEET

Party Chief W. DOMBROSKI
Recorder M. ZALENSKI
Helper

Map No. 26 74.69
ROCKVILLE

Road No. MUN 0005
Road Name ("A" ST.)
Sheet No. 1 of 1
Date 2-12-75
County MONT.
State Coordinates

81-1

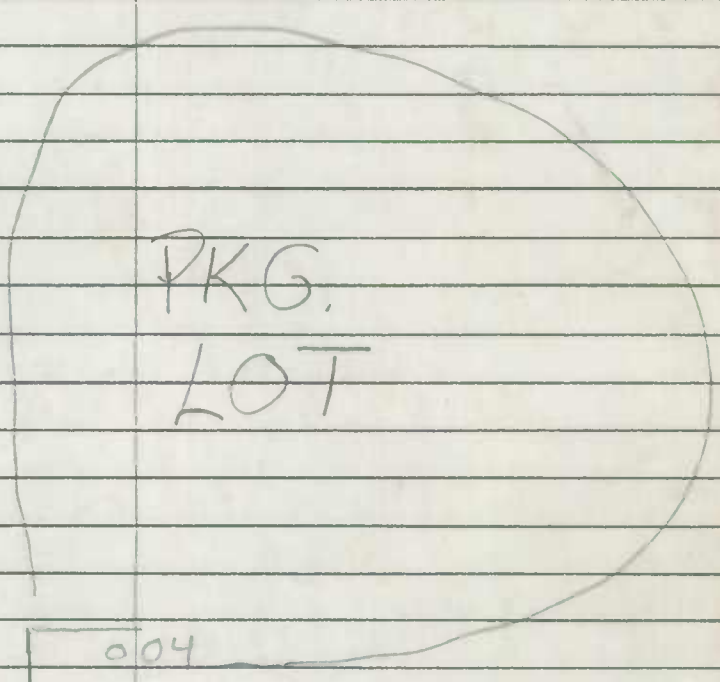

004

E

2-22' I
J'c-c
4'J MED

MD 000 355

N. WASHINGTON ST MUN. 2150

5-72

ROAD INVENTORY SHEET

Road No. _____
Road Name _____
Sheet No. _____
Date _____
County _____
State Coordinates _____

SHA 51.3-8
11-15-72

STATE HIGHWAY ADMINISTRATION OF MARYLAND

LV

ROAD INVENTORY SHEET N. ADAMS ST.

Party Chief I. LANDON
Recorder I. ABBOTT
Helper

Map No. 26

Road No. MUN. 0030
Road Name S. ADAMS ST.
Sheet No. 1 OF 1
Date 1-2-74
County MONT.
State Coordinates 756-454

ROCKVILLE 76-14

WOOD LA.
0 43 MUN. 3270

W. MIDDLE LA.
MUN. 0 37 2110

0 35

W. MONTGOMERY AV.
MUN. 0 32 3268

0 27

JEFFERSON ST
MD. 0 24 28

0 18

MARYLAND AV.
MUN. 0 00 2012

S. ADAMS ST.
N.

26' I
"J" C-C

25' I
30' CW

28' I
"J" C-C

36' I
"J" C-C

27' I
"J" C-C

26' I
"J" C-C

N

SHA 51.3-8
11-15-72

ROAD INVENTORY SHEET

Road No. _____
Road Name _____
Sheet No. _____
Date _____
County _____
State Coordinates _____

SHA 51.3-8
11-15-72

MUN 0140

ROAD INVENTORY SHEET

Party Chief T. LANDON
Recorder M. ZALENSKI
Helper

Map No. 26

Road No. ~~Co. 3162~~
Road Name ARDENNES AVE
Sheet No. 1 OF 2
Date 2-22-74
County MONT
State Coordinates

A/T ROCKVILLE

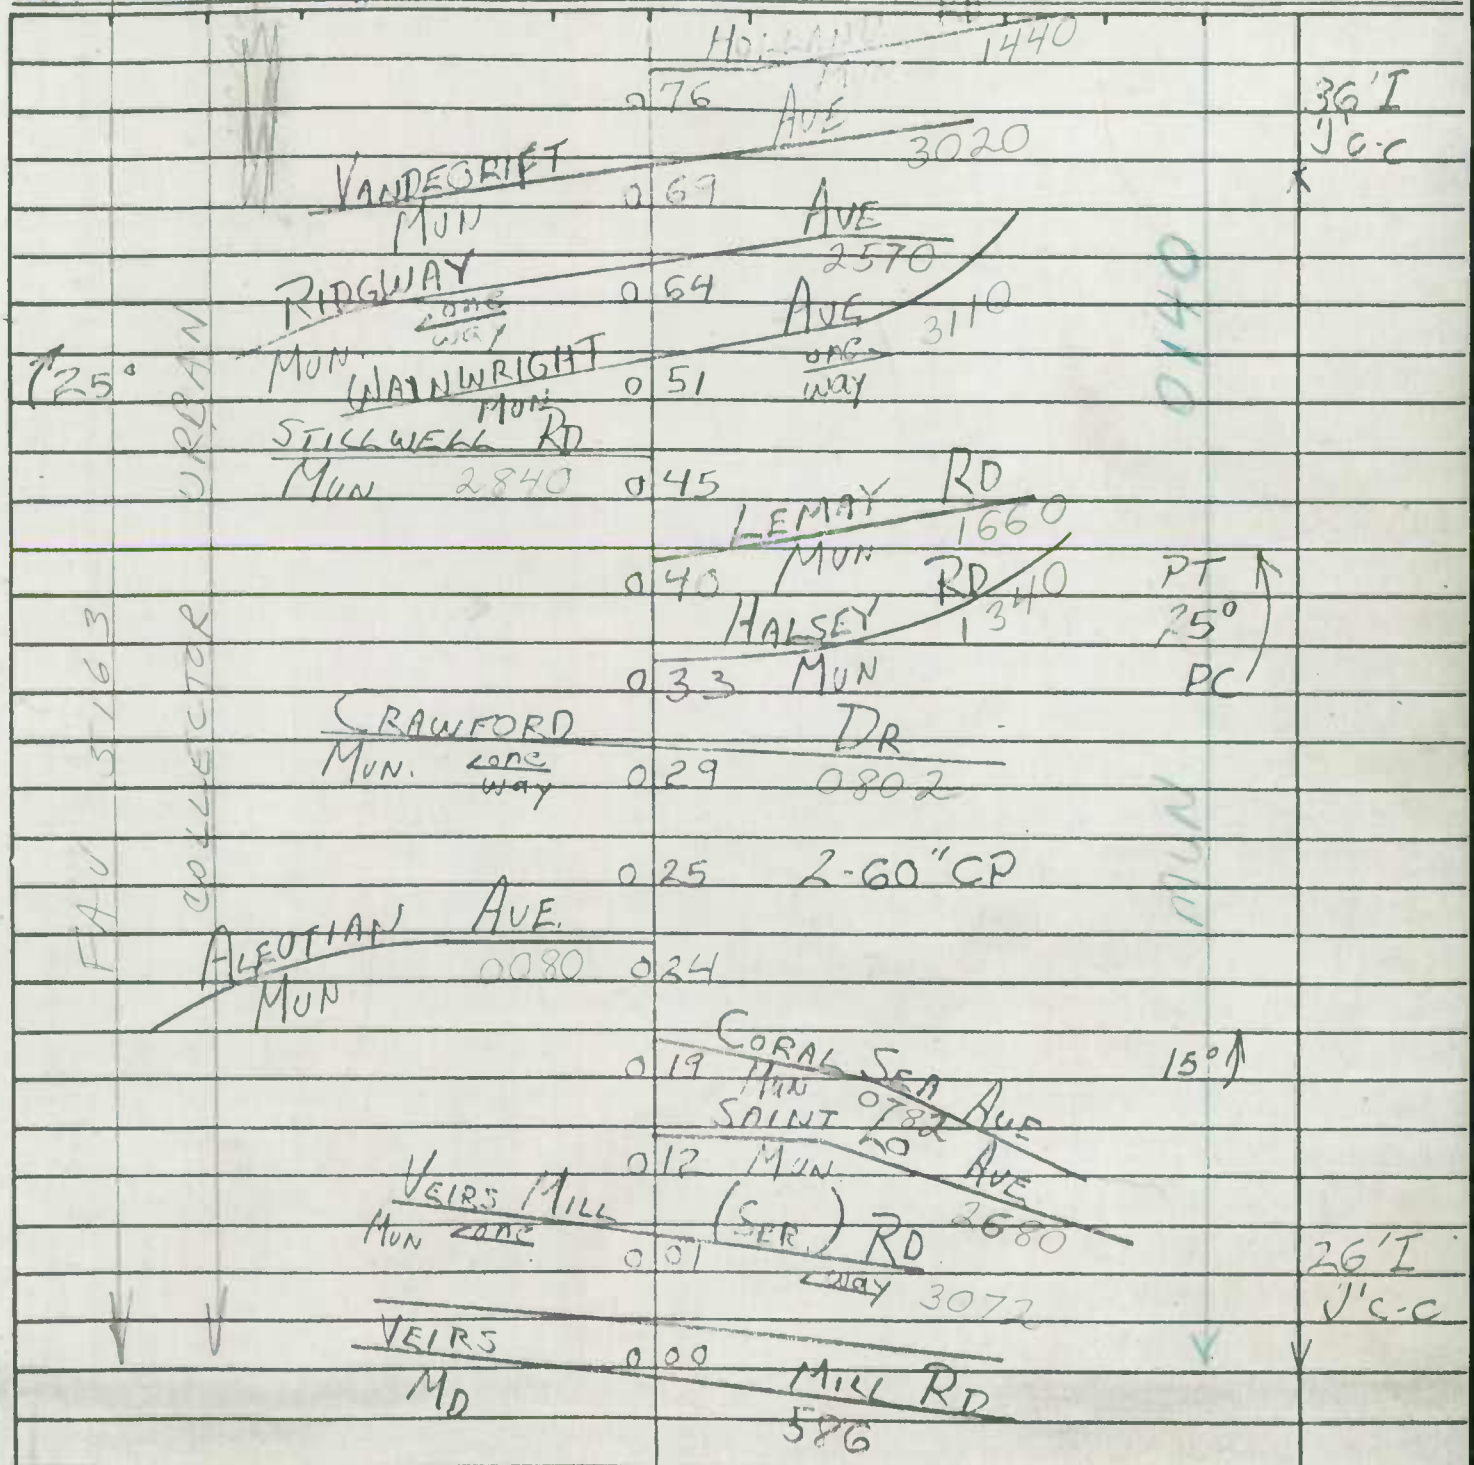

HA 51.3-8
1-15-72

MUN. 0140

ROAD INVENTORY SHEET

Road No. Co. 3162
Road Name ARDENNES AVE
Sheet No. 2 OF 2
Date 3-22-74
County MUN
State Coordinates

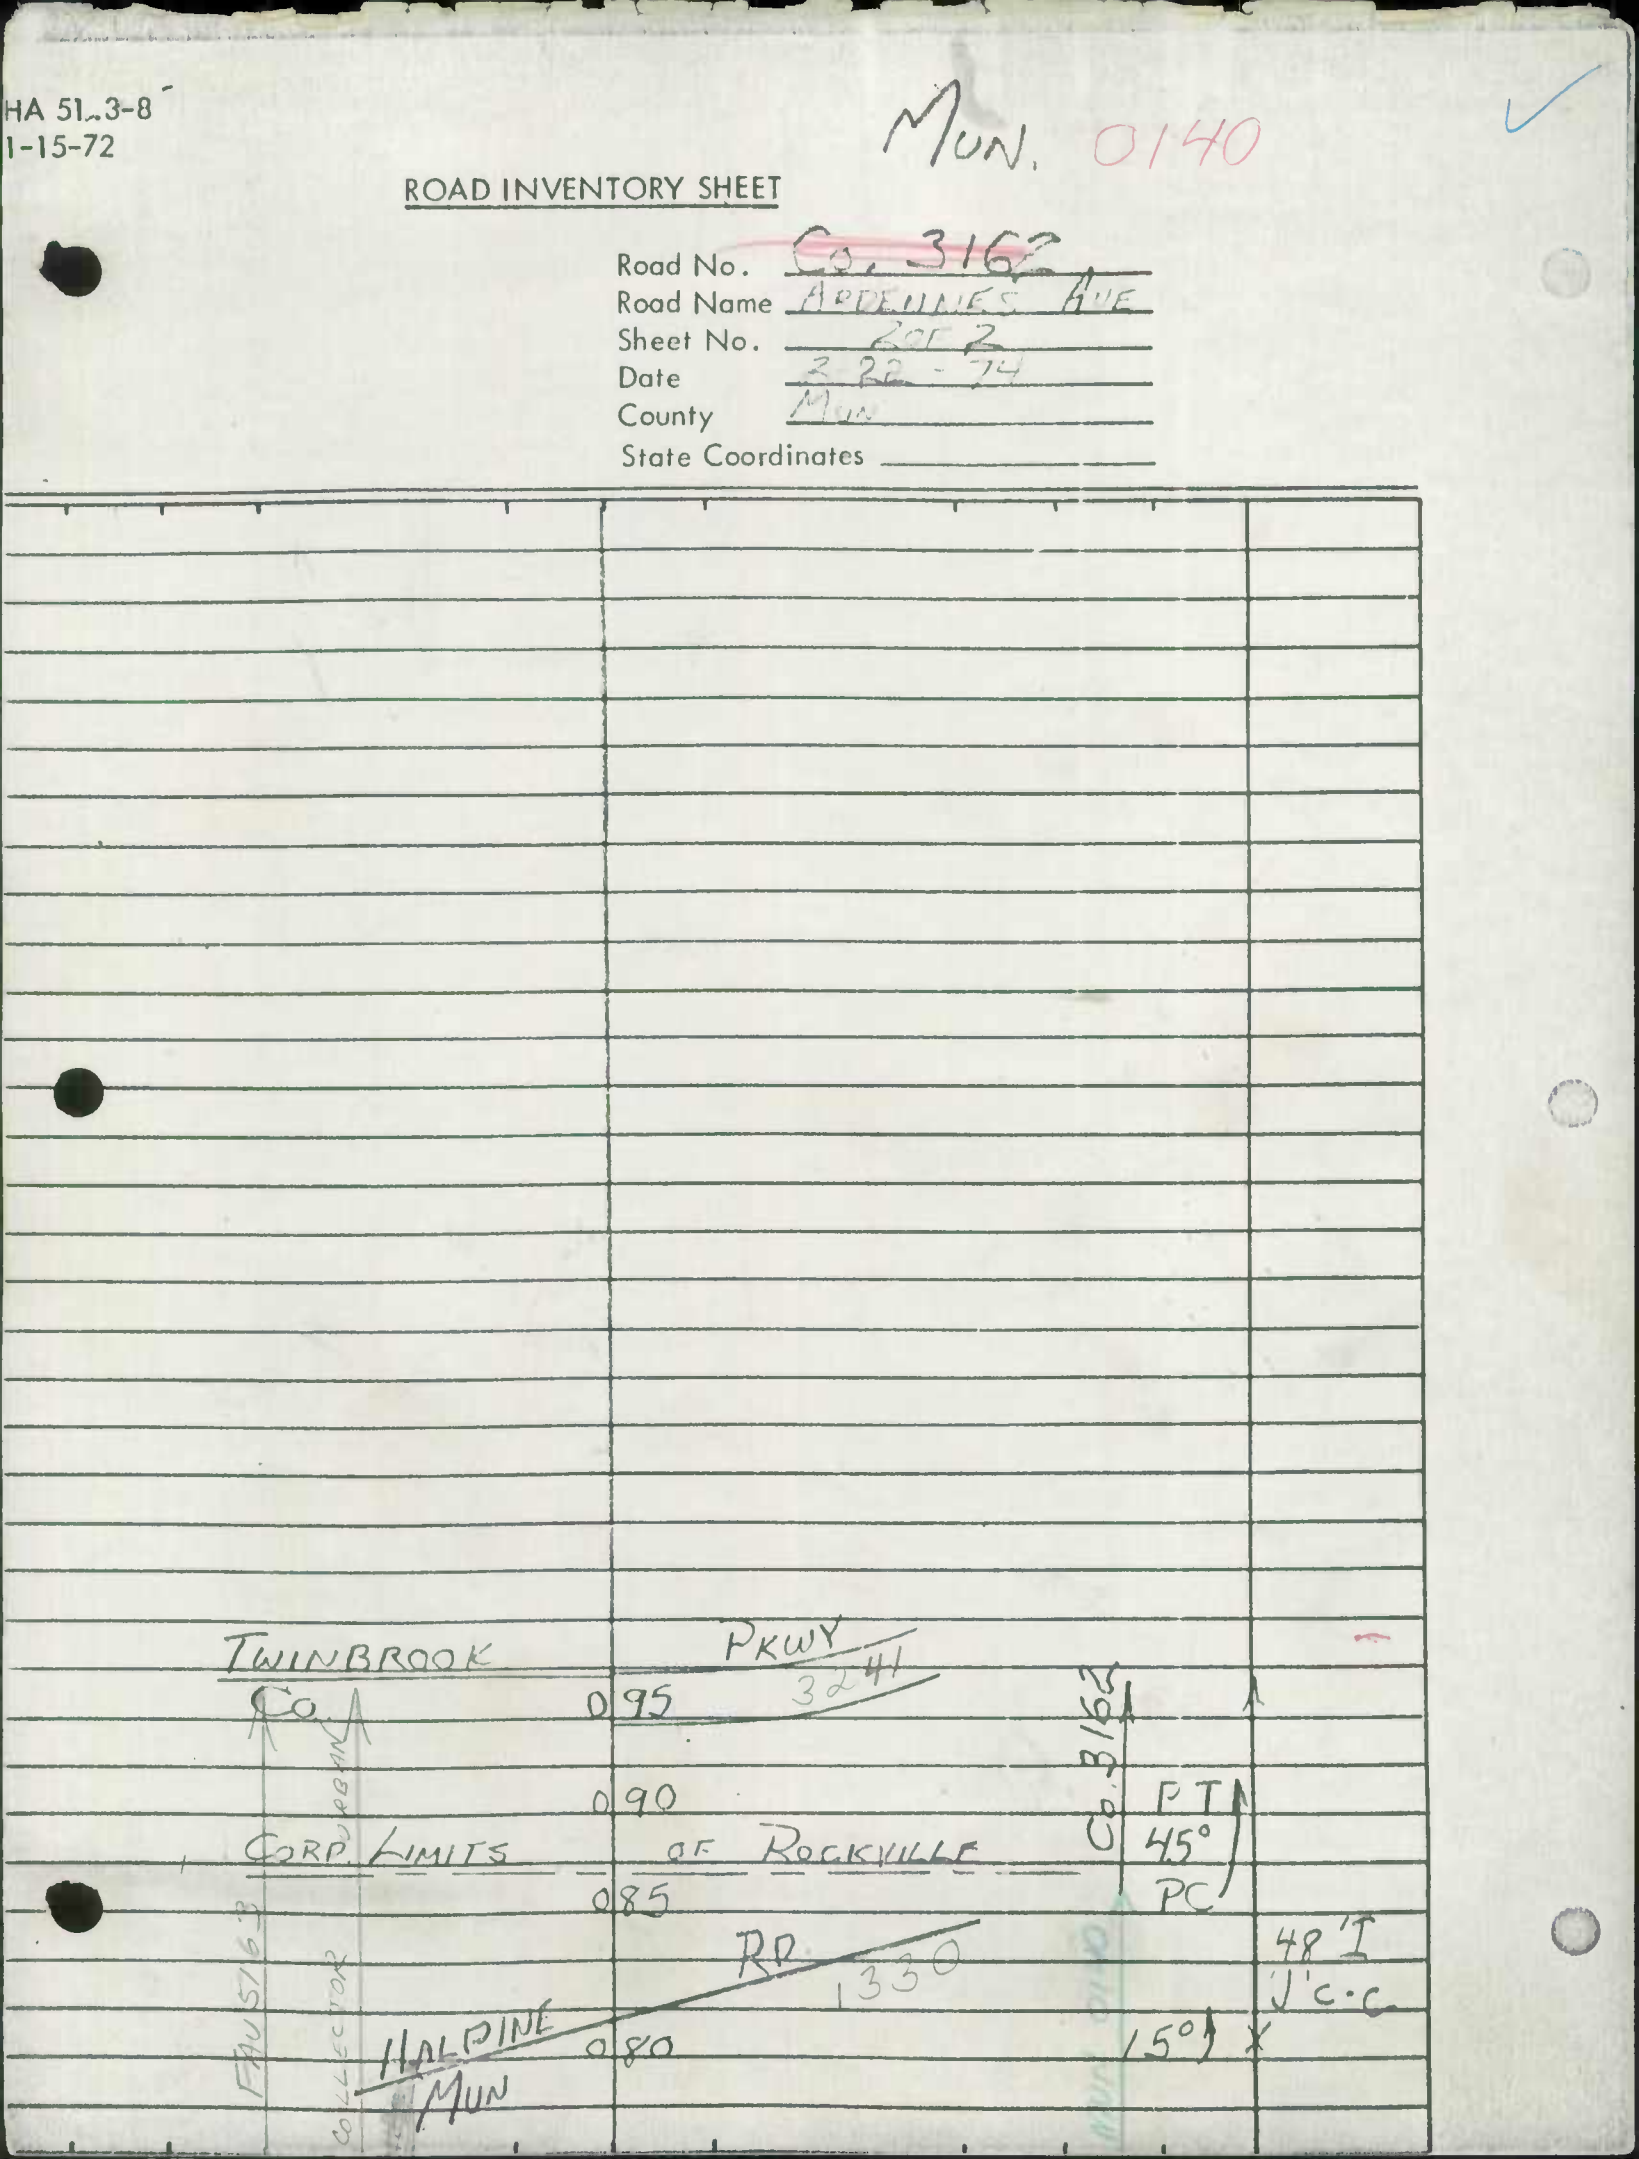

SHA 51.3-8
11-15-72

STATE HIGHWAY ADMINISTRATION OF MARYLAND

00-13ST
SS/WP
2-26-01

ROAD INVENTORY SHEET

MU 0205

Porty Chief T. LANDON
Recorder M. ZALENSKI
Helper

Mop No. 26 D + M
ROCKVILLE

Road No. CO 139
Rood Nome AVERY RD.
Sheet No. 1 OF 2
Date 2-15-74
County MONT.
Stote Coordinates 766-459

83-97
3/7/84
BG-NS

N

30°
10°
CORP. LIMITS
SIGN: END Co. MAINT.
SEE NEW INV WRITTEN 01-31-02
IMP # 01-4MU SS/WP
75°
10°
30°
20°
0 51
0 45
0 43
0 41
0 38
0 34
0 29
0 25
0 22
0 20
0 17 EXIT SCHOOL
0 12 MARK TWAIN SR HIGH SCH
0 08 ENT TO SCHOOL
0 06
0 00
ABAN OLD SECTION
MD 28
OF ROCKVILLE
15°
15°
45°
MUN. 02
20'E F
X 24'CW
18'F
16'B I
22'CW
2 ML
24'I
40'CW
TL

SHA 51.3-8
11-15-72

See new Inv written 01-31-02 SS/WP

ROAD INVENTORY SHEET

Road No. Co 139
Road Name AVERY RD
Sheet No. 2 OF 2
Date 2-15-74
County MONT
State Coordinates

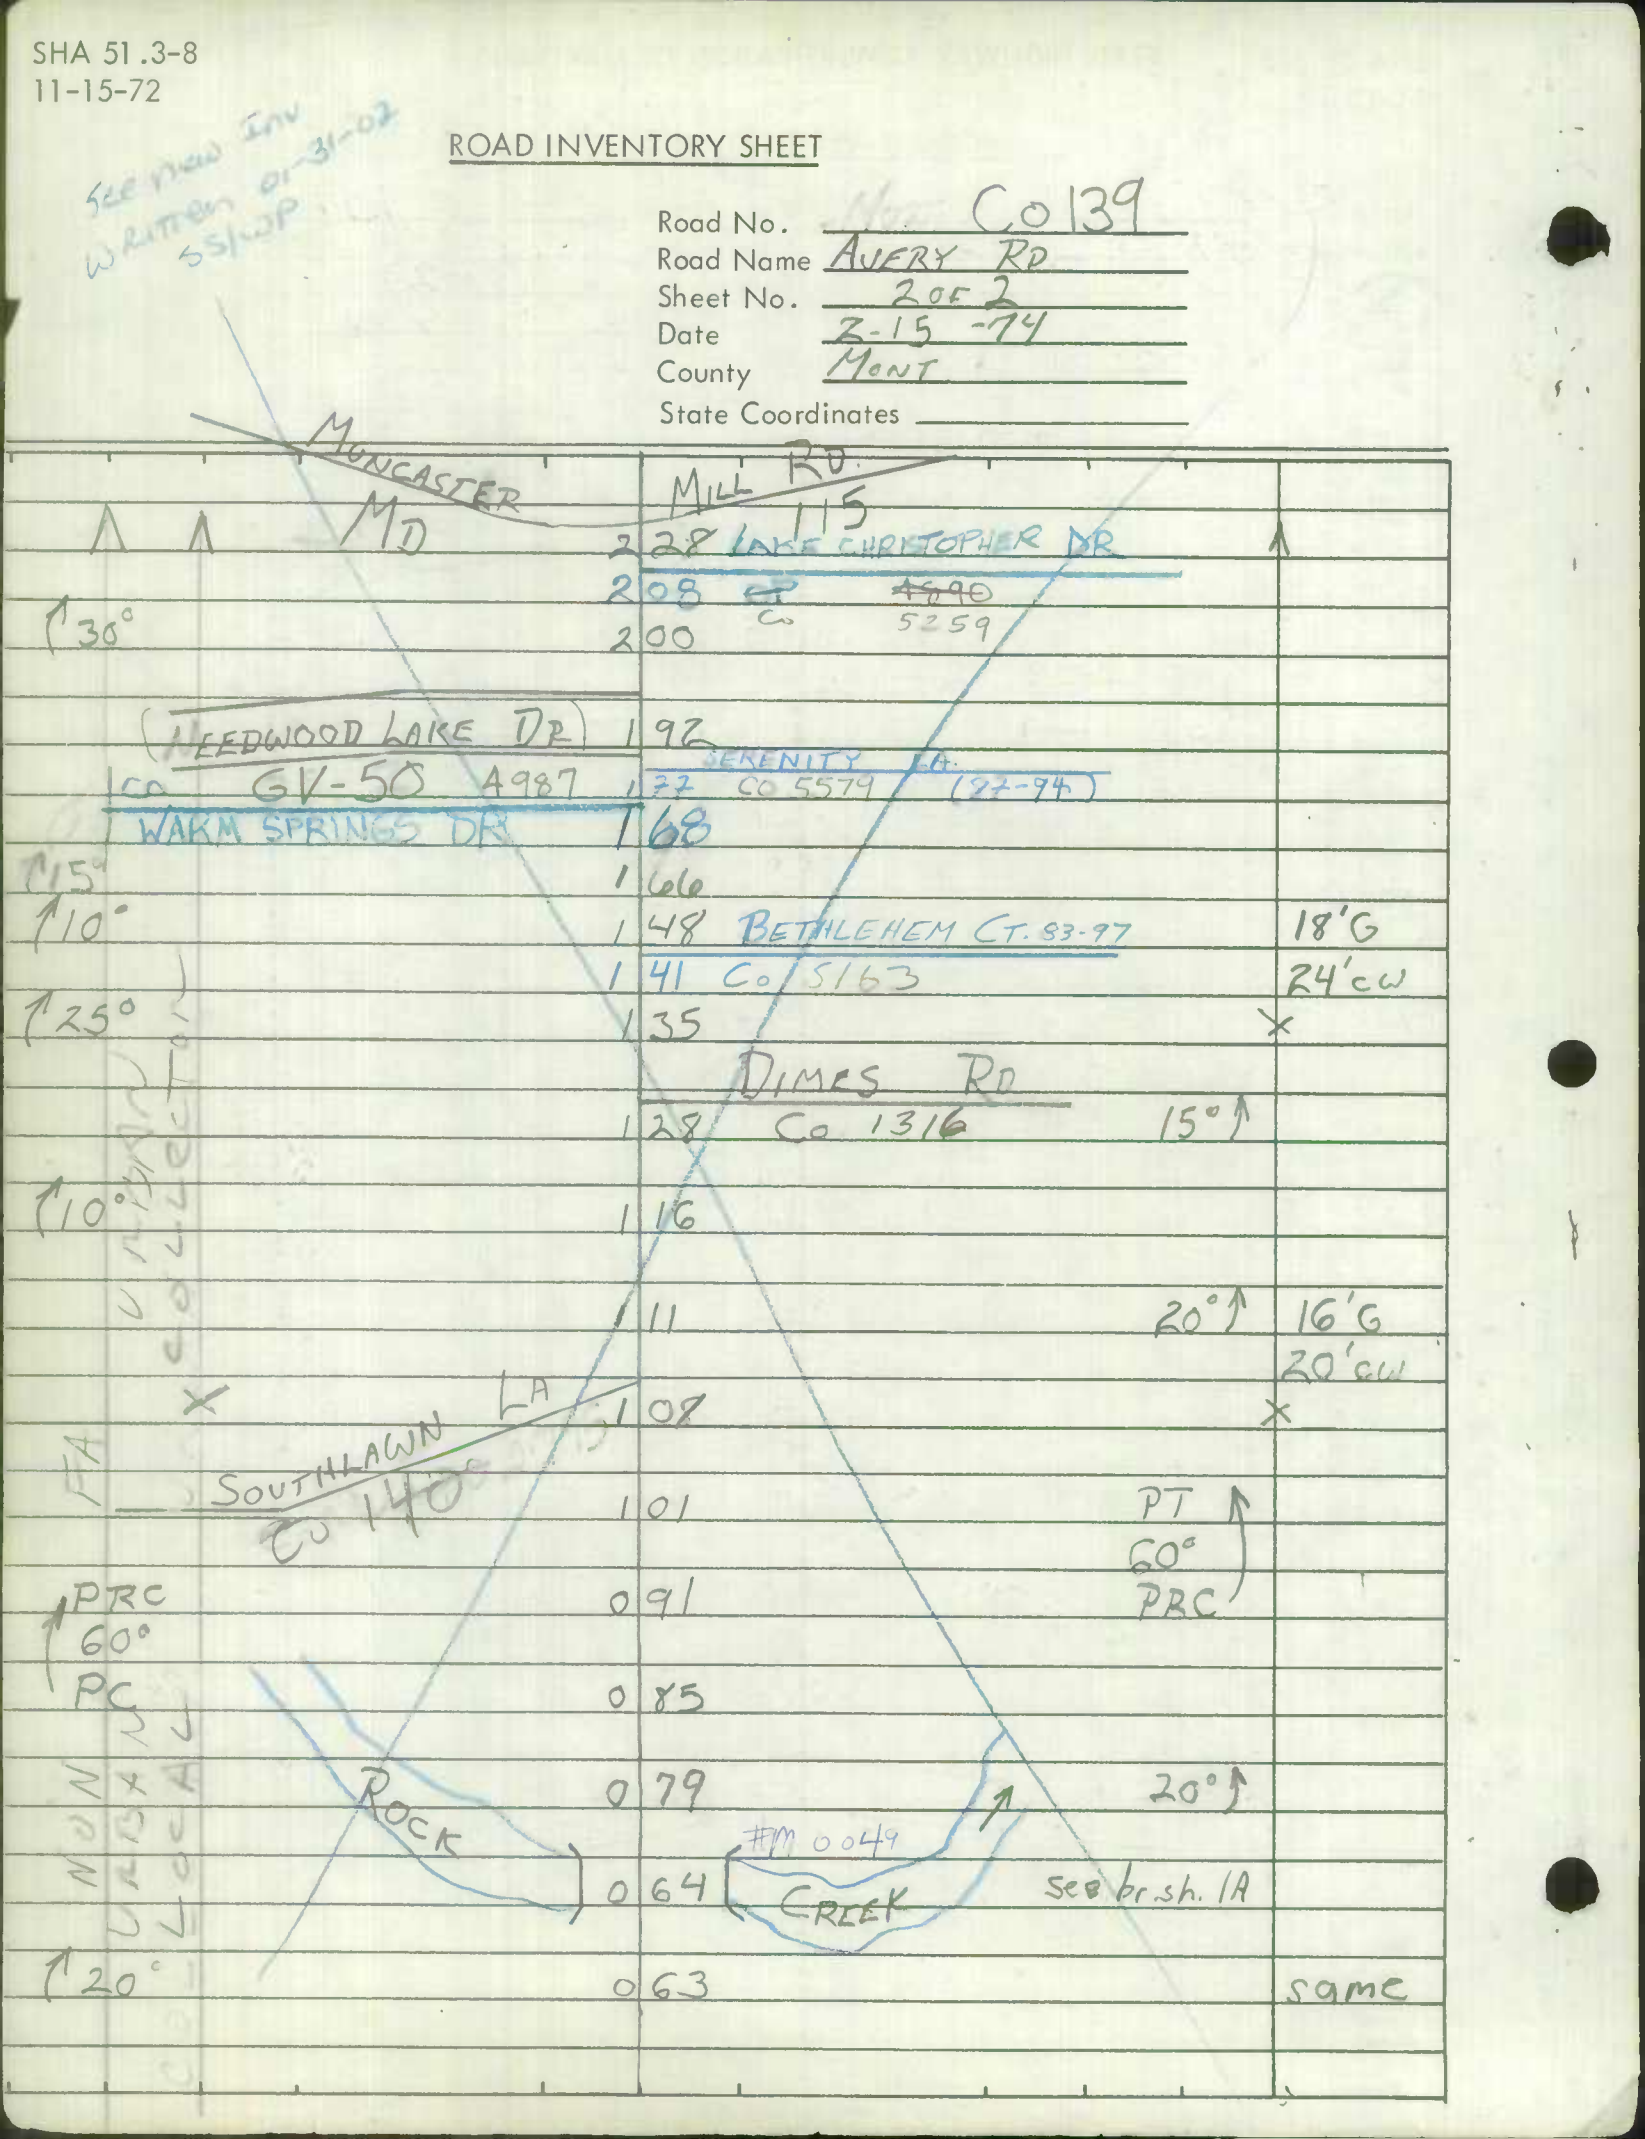

SHA 51.3-8
11-15-72

STATE HIGHWAY ADMINISTRATION OF MARYLAND

ROAD INVENTORY SHEET

~~00 139~~


Date 2-15-74
County Mont
State Coordinates

Map No. 26

Rockville

↑30°	0	51	20'E 24'CW
↑10°	0	45	
Corp Limits of Rockville			
Sign End Co. Maint	0	43	
	0	41	15°↑
↑15°	0	38	
↑10°	0	34	
	0	29	15°↑
↑30°	0	25	
	0	22	45°↑ 16'EI 22'CW
	0	20	
↑20°	0	17	Exit School
	0	12	Mark Twain Sr High Sch
	0	08	Ent to School 24'I RC'Eshld 40'CW
MD	0	00	28

N ↑

IA 51.3-8
1-15-72

ROAD INVENTORY SHEET

MUN 0205

Road No. ~~MUN~~ CO 139

	110	101	PT	
	Co		60°	
PRC		091	PRC	
60°				
PC		075	CO	
		079	20° ↑	
	ROCK			
		064	CREEK	See Brush IA
20°		063		same

Form 5-HPS
(Revised 1961)

MARYLAND STATE ROADS COMMISSION
PLANNING AND PROGRAMMING DIVISION

S26130

IN COOPERATION WITH
U.S. BUREAU OF PUBLIC ROADS

AVERY RD

ROAD NO. C 139

BRIDGE SHEET

SHEET NO. 1A

PARTY NO. _____

DATE 2-15-74

COUNTY MONT

RATED CAPACITY _____

FOR ALL STRUCTURES HAVING A TOTAL OPENING OF MORE THAN 20 FEET AS DEFINED IN NOTE 1.

ODOMETER READING 0.64 NAME OF (STREAM) RAILROAD OR HIGHWAY CROSSED Rock Creek

NUMBER OF RAILROAD TRACKS _____
KIND OF CROSSING (NOTE 2) _____

UNDERPASS-SIMPLE UNDERPASS-COMBINED (NOTE 3) OVERPASS BRIDGE OVER SYSTEM

DESCRIPTION

NUMBER OF SPANS	LENGTH EACH SPAN (NOTE 4)	TYPE (NOTE 5)
1	27'	I-BEAM

TOTAL LENGTH-ON LINE OF ROAD OVER-ALL (NOTE 6) 30'

MATERIAL
SUBSTRUCTURE I BEAM T CONC SUPERSTRUCTURE STEEL RAILS
FLOOR CONC

CLEARANCES
ROADWAY (NOTE 7) 18' 3" SIDEWALK WIDTHS: RIGHT NONE LEFT
SURFACE OF ROAD TO STREAM BED _____ FOR OVERPASSES, SHOW DISTANCES TO TOP OF RAIL OR SURFACE OF LOWER ROAD. (NOTE 8)
SURFACE OF ROAD TO BOTTOM PORTAL _____ (MINIMUM OVERHEAD CLEARANCE
CLEAR DISTANCE OF OPENING ABOVE STREAM BED _____ (WATERWAYS ONLY)
POSTED LOAD LIMITS _____ BRIDGE NO. _____ CONSTRUCTION DATE 1911

GENERAL CONDITION OF BRIDGE: CHECK IF GOOD, FAIR, OR POOR, DESCRIBE DEFECTS IF SERIOUS.

	GOOD	FAIR	POOR
SUPERSTRUCTURE			
FLOOR			
SUBSTRUCTURE			

PAINT ✓ BADLY CORRODED OR RUSTED

TYPE OF PROTECTION FOR DRAWBRIDGES (NOTE9) _____

(NOTES ON REVERSE SIDE)

SHA 51.3-8
11-15-72

Rockville

ROAD INVENTORY SHEET

MUN. 0242

Party Chief T. LANDON
Recorder W. WARFIELD
Helper

Map No. 26

Road No. ~~MD. 598 A~~
Road Name BALTO. RD.
Sheet No. 1 OF 4
Date 7-17-73
County MONT.
State Coordinates

DENHAM — P.D.
MUN 0 54 0920
10° ENT. SHOPPING CENTER 0 51
(8-B's)
ENT. SHOPPING CENTER 0 48
~~MD.~~ FIRST ST.
0 44 28
FIRST ST.
0 43 MUN. 1111
TAYLOR AVE.
MUN. 2900 0 35
~~CHARLES~~ MUN. 0660 ST.
45° PT
0 30
PC
S. HARPERS LA.
MUN. 1455 0 27
MAPLE AVE.
0 20 MUN. 1910
GRANDIN AVE.
MUN. 0 12 1255
0.01/16' I "J" C-C 0 03 0.01/15' I "J" C-C
AVE. 2850
STOVES STREET
MUN. 0 02
ROAD 0 00 END
BARRICADE 20' R.R.
R.R.
3 TRACKS

28' I
"J" C-L.T.
5' E SHLD. TO 32' CW
X
X
36' I
"J" C-C
X 16' I
18' CW
MUN.
CURVE TO CHANGE R/W
E
N
FAU COLLECTOR URBAN
NON FA LOCAL URBAN

SHA 51.3-8
11-15-72

ROAD INVENTORY SHEET

MUN 0242.

Road No. MD. 845-A
Road Name BALTO. RD.
Sheet No. 2 of 4
Date 7-17-73
County MONT.
State Coordinates

		COVE LA. Co. of 345	1 44			
	U.S. ARMY RESERVE		1 40			
				BROADWOOD		
			1 36	MUN. DR. 0420		
	END CEM.		1 33		PT	
					30°	
			1 23		PC	
20°			1 19			
		ST. MUNION CEMETERY				
			1 10	36" CMP		
	REG. CEM.		1 07		PT	
			1 02	END CEM.	30°	
				ST. MARYS CEM.		20'I
PRC	60		0 96	REG. CEM.	PRC	26'CW
60°		AVERY MUN. 0280 DR.				
			0 94			
PC						
			0 93	GLADSTONE DR. MUN. 1220		25'I
			0 87		20°	"I" C-RT.
				DR.		4'E SHLD 21'CW
		EDMONDSTON MUN.	0 77	1000		
						34'I
			0 67		15°	"I" C-C
		WOODBURN MUN.		RD.		
			0 60	3280		29'I
						"I" C-LT.
						4'E SHLD.
						33'CW

SHA 51.3-8
11-15-72

ROAD INVENTORY SHEET

Party Chief T. LANHAM
Recorder W. WARFIELD
Helper

Map No.

Road No. MUN. 0242
Road Name BALTO. RD.
Sheet No. 3 OF 4
Date 7-17-73
County MONT.
State Coordinates

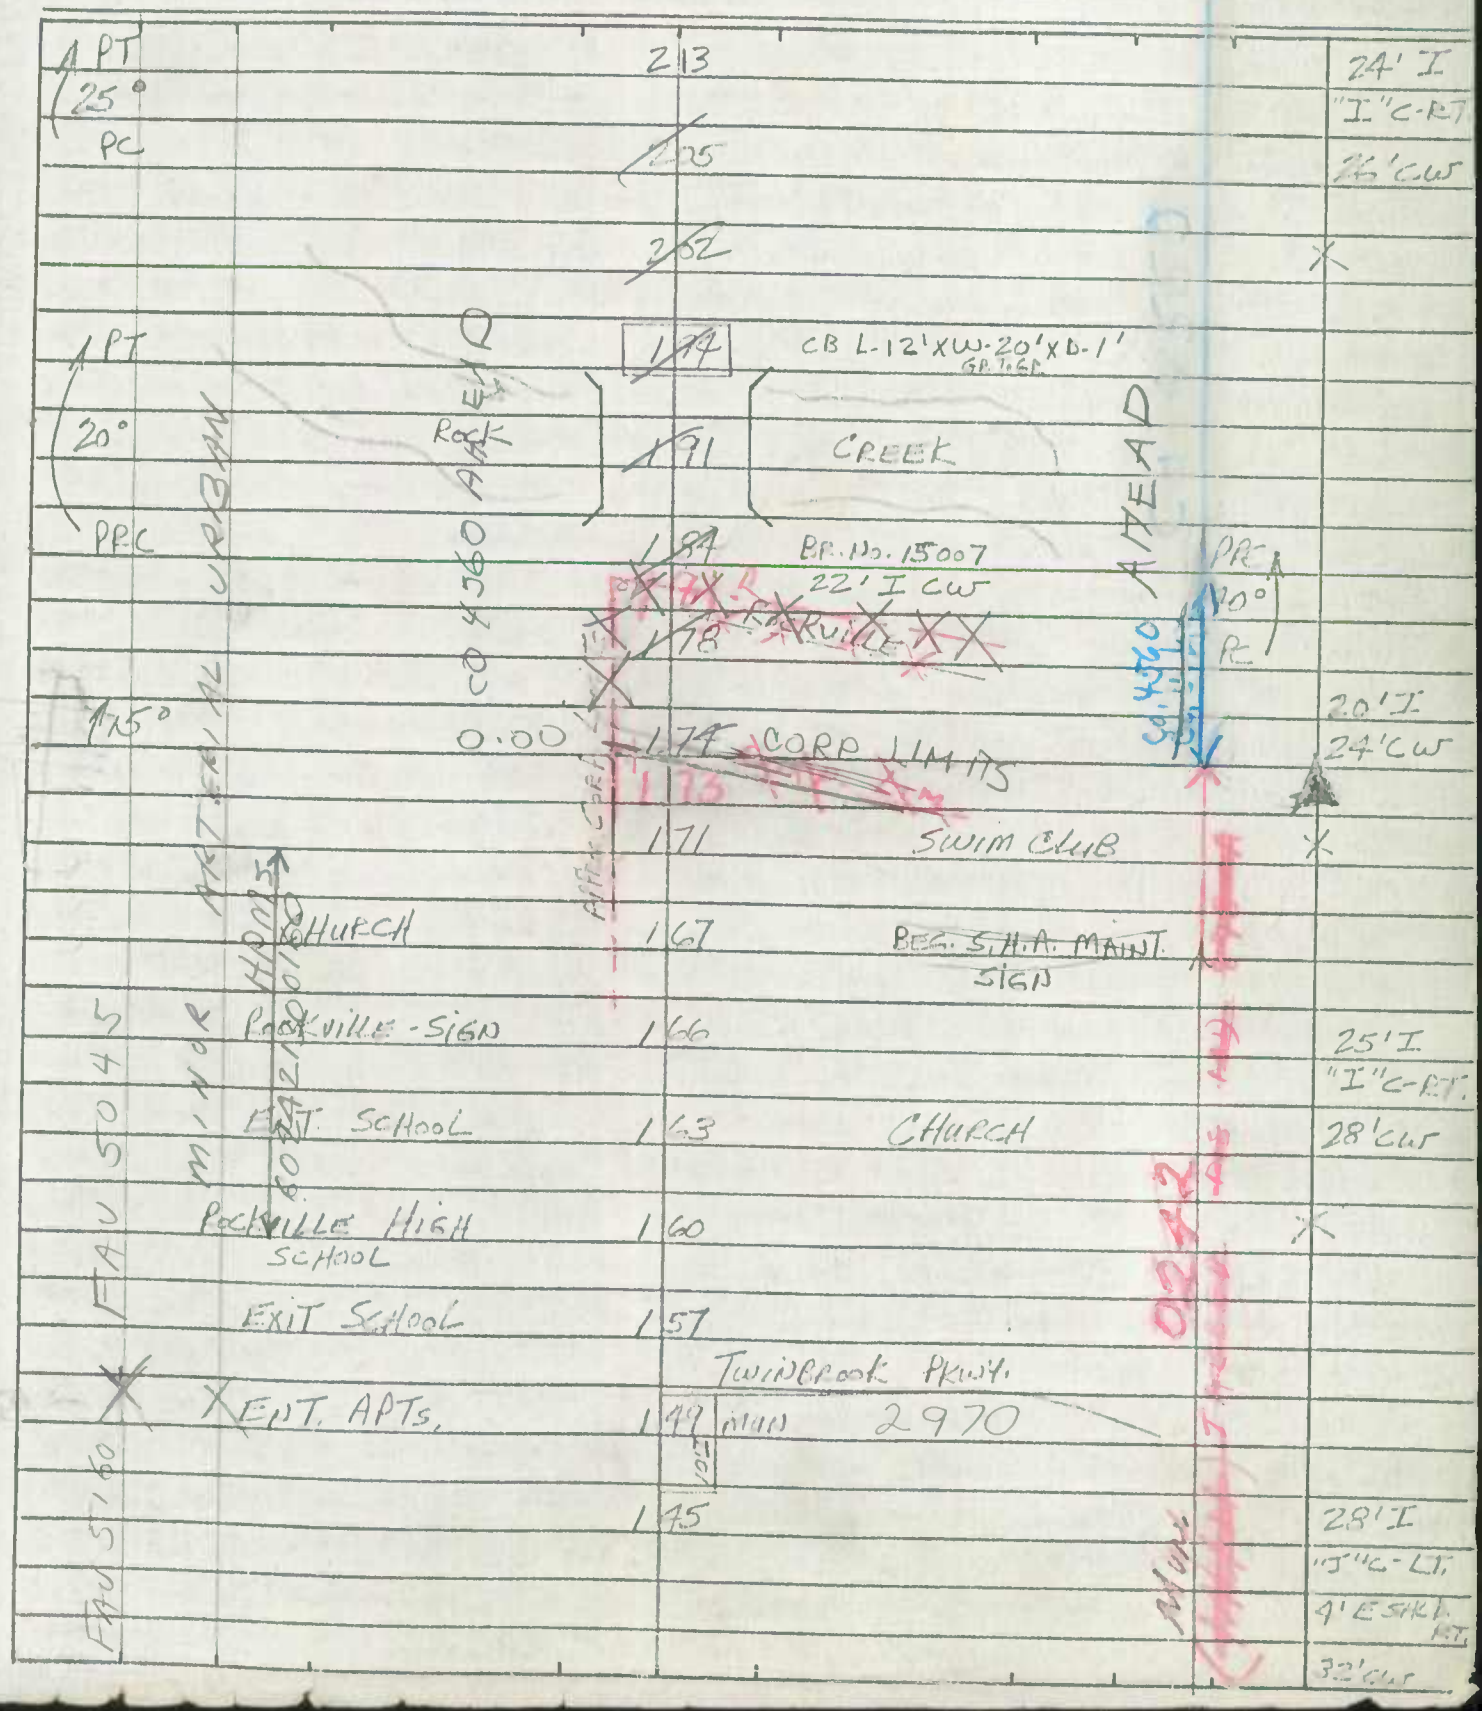

SHA 51.3-8
11-15-72

STATE HIGHWAY ADMINISTRATION OF MARYLAND

ROAD INVENTORY SHEET

Party Chief: T. LANDON
Recorder: T. ABBOTT
Helper:

Road No.: MUN. 0555
Road Name: CARNATION DR.
Sheet No.: 1 OF
Date: 12-14-73
County: MONT.
State Coordinates: 751-462

Map No.: 26
ROCKVILLE

BB REV FR 3-10-81
80-121

80-63

WOODLEY GARDENS ELE. SCHOOL

END

ROAD END

~~017~~ 035

↑60° ~~025~~ 033

CROCUS DR.
MUN. 0810 023 031

↑15° ~~020~~ 028

ASTER BLVD
MUN ~~018~~ 026 0170

219 ~~011~~ 2-84" CMP SOUTH

↑10° LARKSPUR TER
MUN 1595 ~~004~~ 012

26' I
"J" C-C

~~000~~ 008

BARRICADE

14' I
"J" C-C

CUL 000 SAC

SHA 51.3-8
11-15-72

ROAD INVENTORY SHEET

Road No. _____
Road Name _____
Sheet No. _____
Date _____
County _____
State Coordinates _____

SHA 51.3-8
11-15-72

MUN. 0650
OR 5718

ROAD INVENTORY SHEET

Party Chief I. LANDON
Recorder M. LABENSKI
Helper

Road No. CO. 3047
Road Name CHAPMAN AVE
Sheet No. 1 of 1
Date 3-25-74
County MONT
State Coordinates

Map No. 26 75-22 75-25

84-43 3R-25 JERM ROCKVILLE

91-88 GD JK 5-24-92

79-43

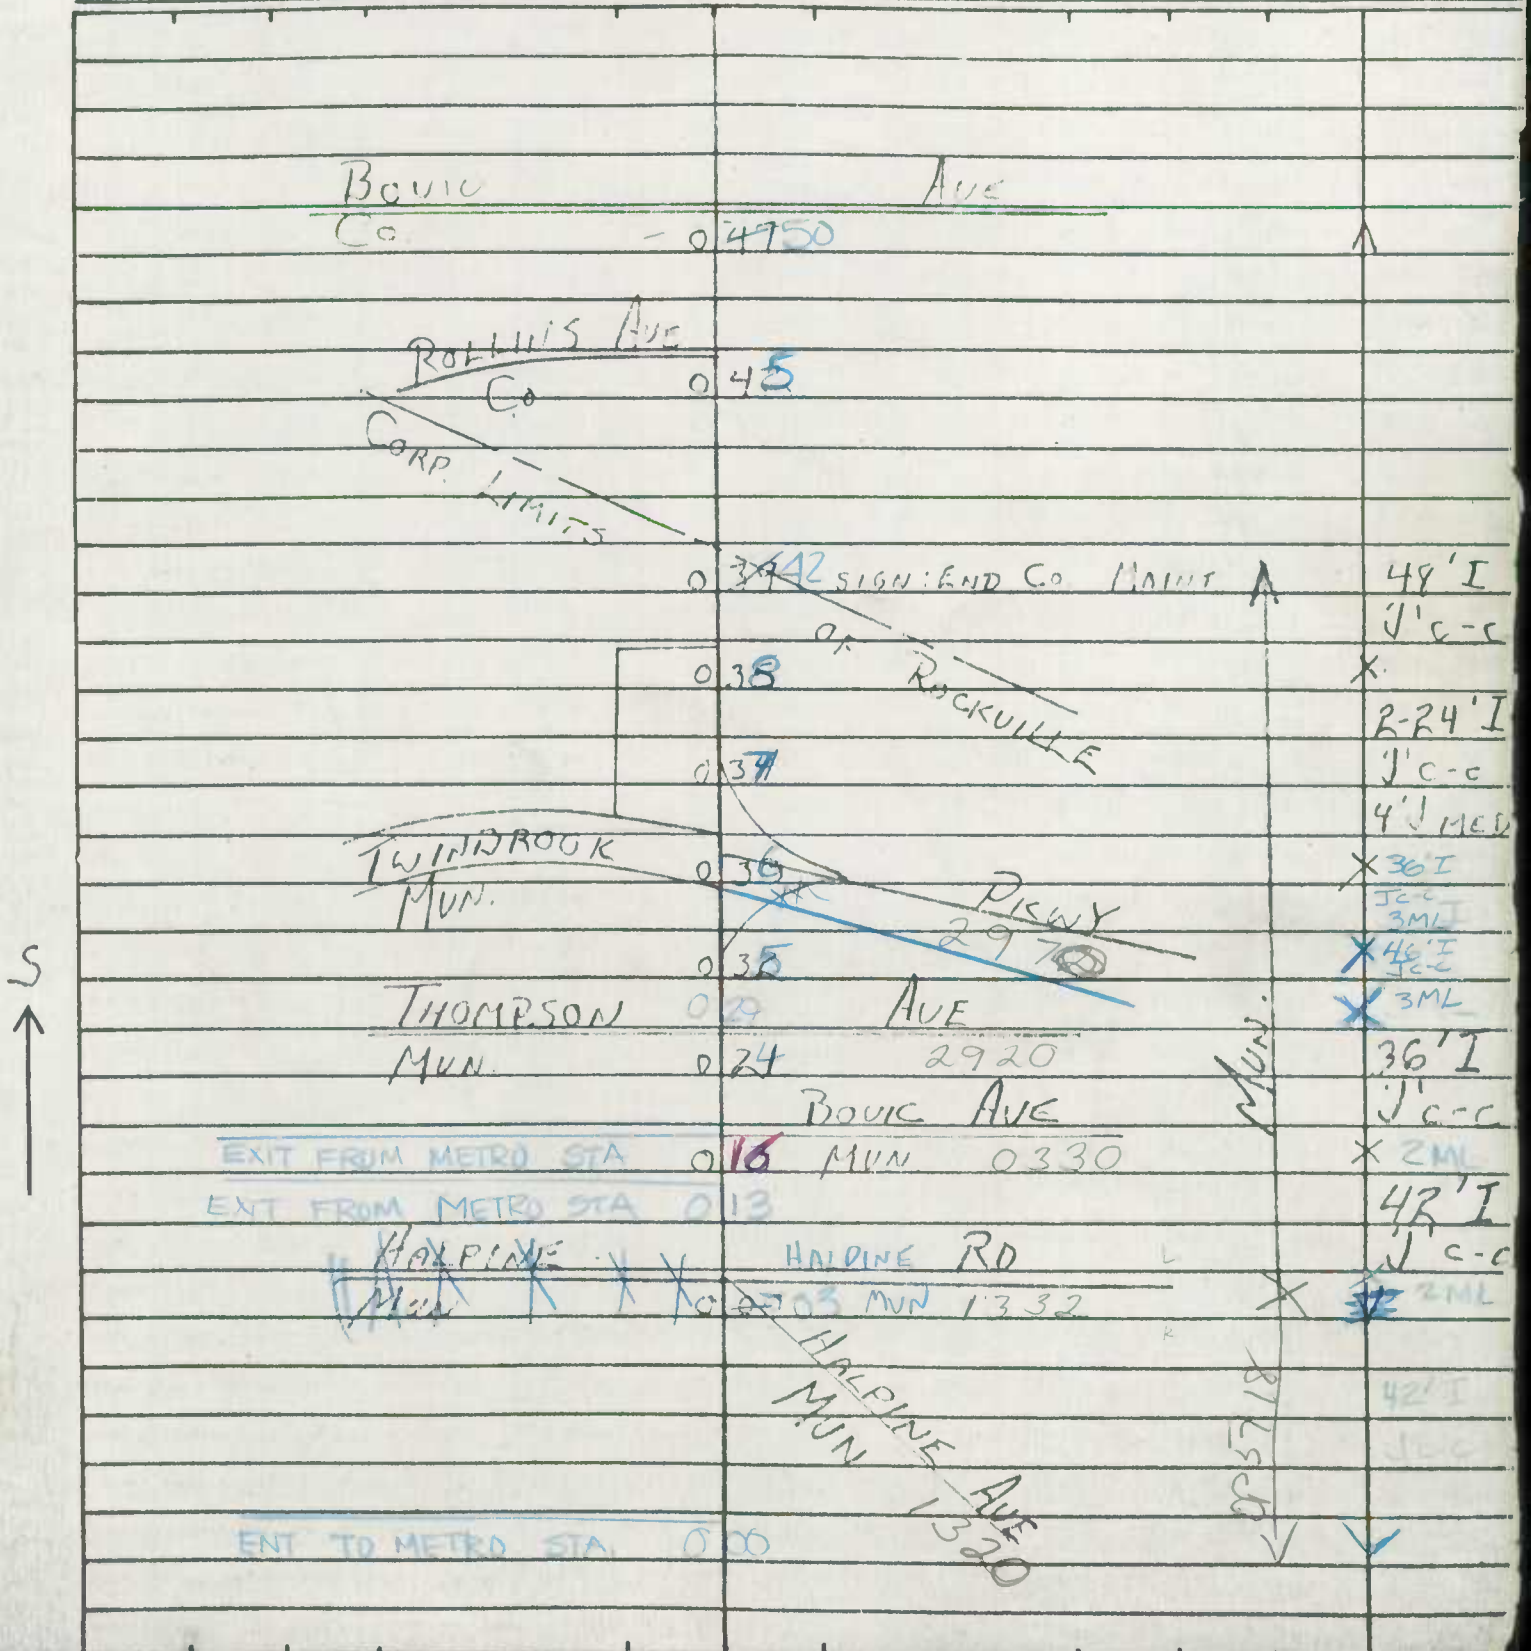

SHA 51.3-8
11-15-72

STATE HIGHWAY ADMINISTRATION OF MARYLAND

ROAD INVENTORY SHEET

Party Chief T. LANDON
Recorder M. ZALENSKI
Helper

Map No. 26
ROCKVILLE

Road No. MUN. 0660
Road Name CHARLES ST.
Sheet No. 1 OF 1
Date 1-30-74
County MONT.
State Coordinates

81-53

S

BALTIMORE RD
MUN. 0 16 0242

SETH PL
0 12 MUN 2720 PARK RD.
MUN. 2362
0 00

26' I
J'c-c

XXXX

CHARLES ST
MUN 0662

SHA 51.3-8
11-15-72

ROAD INVENTORY SHEET

Road No. _____
Road Name _____
Sheet No. _____
Date _____
County _____
State Coordinates _____

SHA 51.3-8
11-15-72

STATE HIGHWAY ADMINISTRATION OF MARYLAND

Rockville
MUN 0680

ROAD INVENTORY SHEET

Party Chief I Lawson
Recorder I Abbott
Helper

Map No. 26

State Coordinates

A/T
84-18

D E
COL 0.38 SEC
KIMBLEWICK Rd.
mid 0.35 1550
CORP LIMITS OF
0.31
AQUEDUCT Rd.
Co 0.27 3123
0.23
PT
25°
PC
0.18
ESPALIER Dr.
0.07 Co. 3520
FALLS Rd.
MD. 0.00 18 F

E

26' E
5' c-c
36' I
5' c-c

SHA 51.3-8
11-15-72

STATE HIGHWAY ADMINISTRATION OF MARYLAND

MUN 0865

ROAD INVENTORY SHEET

Party Chief T. LONDON
Recorder T. ABBOTT
Helper

Map No. 26

ROCKVILLE

Road No. ~~Co~~ 2785
Road Name DAY RD.
Sheet No. 1 OF 1
Date 12-13-73
County MONT.
State Coordinates 411-457

81-6

N

MD 0 22 25

60° 0 17

0 13 50' T 18' H

CORP. LIMITS OF ROCKVILLE 24' CW

0 03 END Co. PAINT SIGN 26' I

DUNDEE RD. 'J' c-c

MUN. 0 00 0 97 8

Co. 2785

SHA 51.3-8
11-15-72

STATE HIGHWAY ADMINISTRATION OF MARYLAND

ROAD INVENTORY SHEET

Party Chief: I. LANDON
Recorder: T. ABBOTT
Helper:

Map No. 26

Road No. MUN. 0870
Road Name DAWSON AV.
Sheet No. 1 OF 1
Date 1-2-74
County MONT.
State Coordinates 755-457

ROCKVILLE 76-11

SEE NEW INV. 79-48

E

N. WASHINGTON ST. 3150
MUN. 0 13

PKG. LOT 0 10 PKG. LOT

N. ADAMS ST.
MUN. 0 07 0040

N. VAN BUREN ST
MUN. 0 00 3000

36' I
"J" C-C

SHA 51.3-8
11-15-72

ROAD INVENTORY SHEET

Road No. _____
Road Name _____
Sheet No. _____
Date _____
County _____
State Coordinates _____

SHA 51.3-8
11-15-72 TL REV. FR. 2/28/78

STATE HIGHWAY ADMINISTRATION OF MARYLAND

M-1078 V

L

ROAD INVENTORY SHEET

Party Chief T. LANDON
Recorder M. ZALENSKI
Helper

Map No. 26

ROCKVILLE

Road No. MUN. 0920
Road Name DENHAM RD.
Sheet No. 1 OF 1
Date 2-20-74
County MONT.
State Coordinates 76-43

N

		EDMONSTON DR.	
DENHAM CT. MU 0922	0 34	MUN. 1000	
TEMPLAR CT. MU 2905	0 31		
BALTIMORE	0 26	RD.	
MUN.	0 18	0242	10°
	0 11		15°
		GILBERT RD	
	0 09	MUN 1200	
120°	0 04		26 I
MAPLE		AVE	c-c
MUN	0 00	1910	

SHA 51.3-8
11-15-72

ROAD INVENTORY SHEET

Road No. _____
Road Name _____
Sheet No. _____
Date _____
County _____
State Coordinates _____

SHA 51.3-8
11-15-72

STATE HIGHWAY ADMINISTRATION OF MARYLAND

M10-78 V

ROAD INVENTORY SHEET MUN. 0970

Party Chief T. LANDON
Recorder M. ZALENSKI
Helper

Map No. 26
ROCKVILLE

Road No. Co. 3076
Road Name DOVER RD
Sheet No. 1 OF 1
Date 1-31-74
County MONT
State Coordinates 759-462

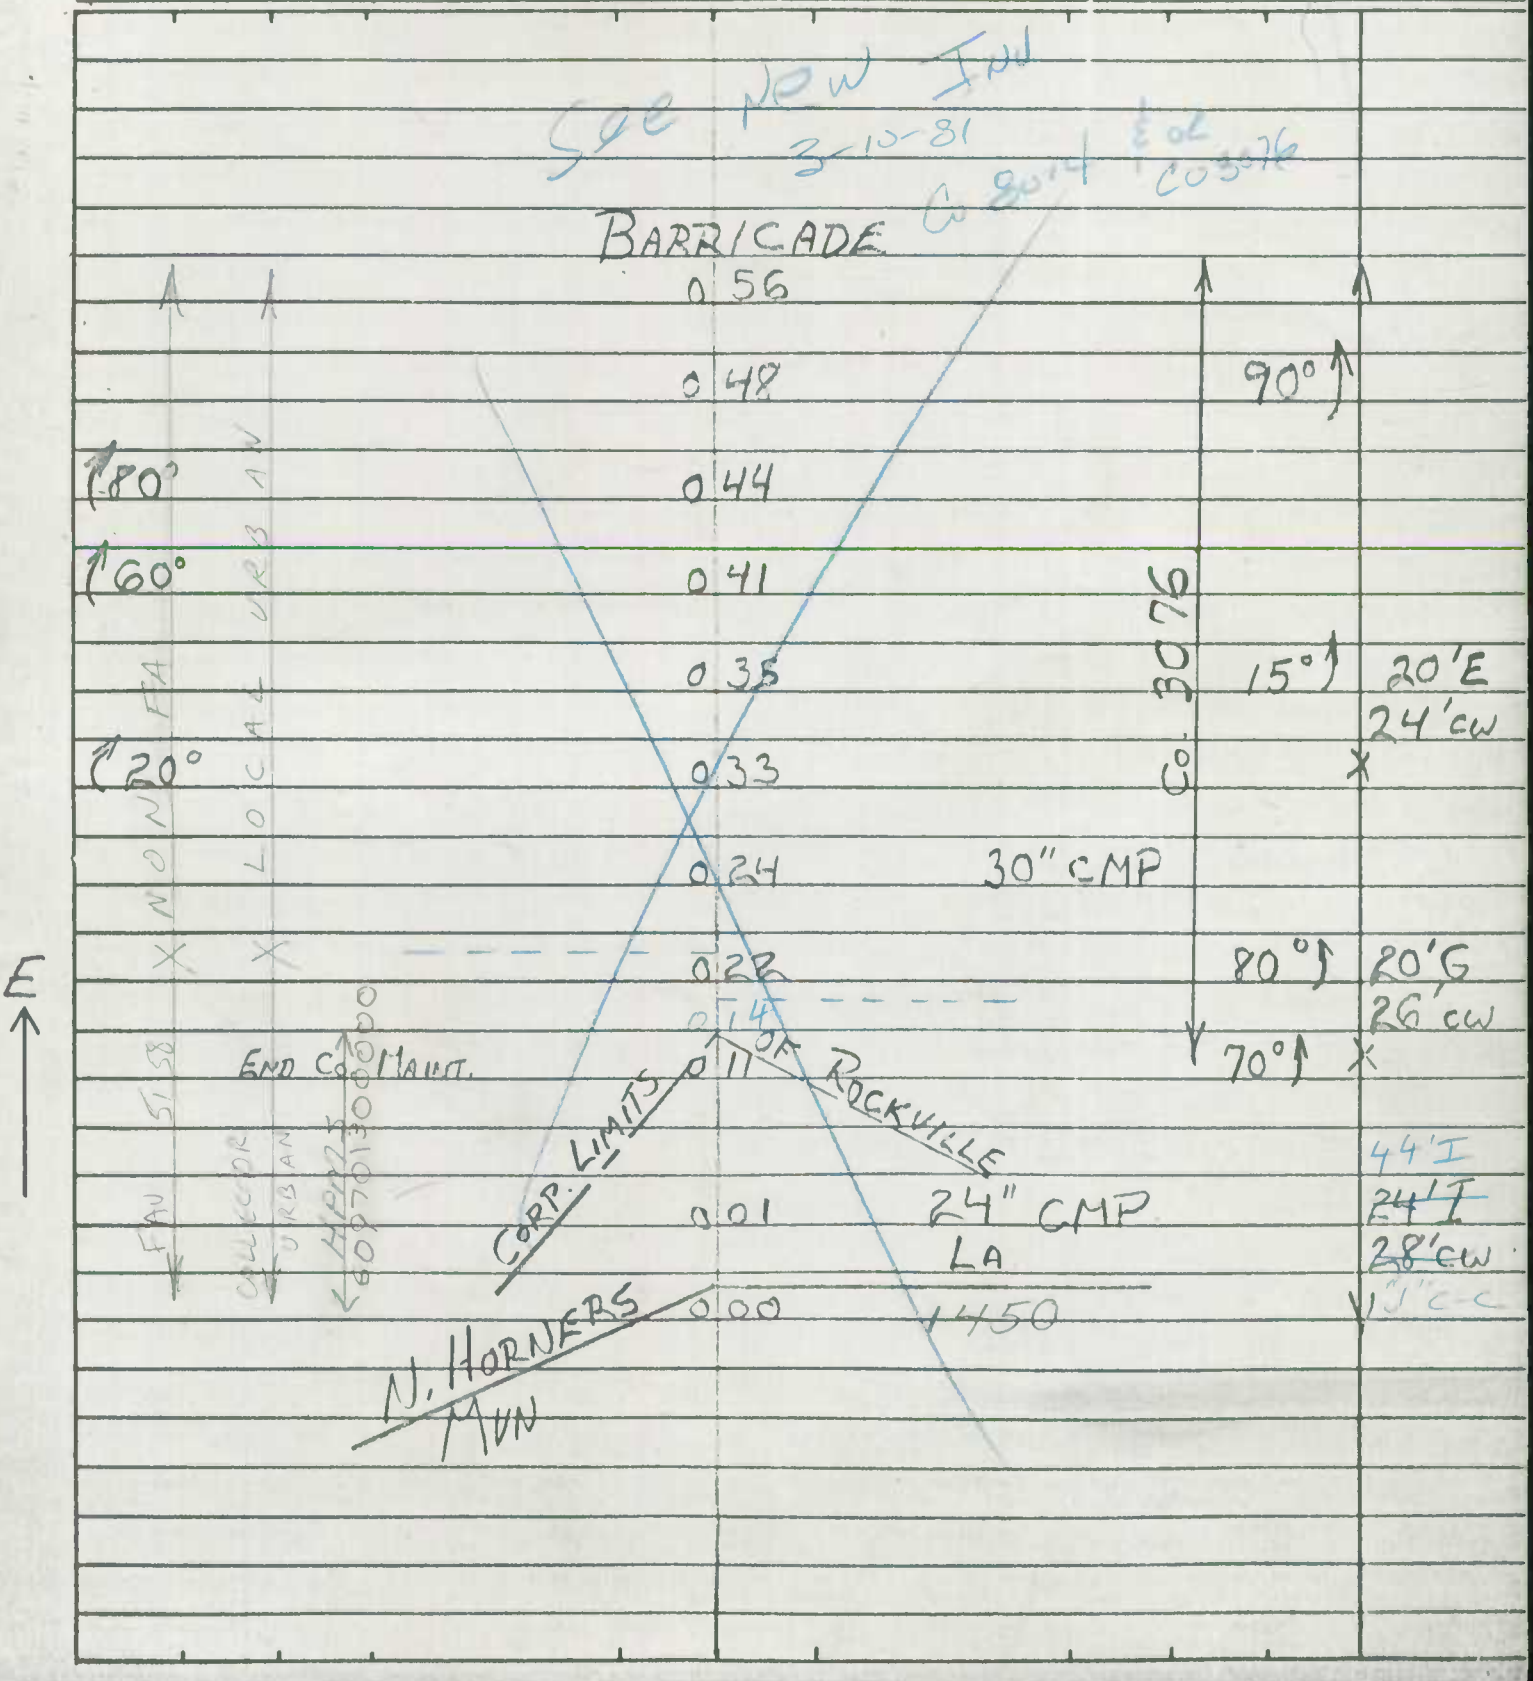

ROAD INVENTORY SHEET

MU 970

Party Chief BB
Recorder ER
Helper

Map No. 26D

ROCKVILLE

Road No. ~~CO 8014~~ 3076
Road Name DOVER RD
Sheet No. 1 OF
Date 3-10-81
County MONT.
State Coordinates 759-462

A/T
90-75
AL-JK
2-20-91

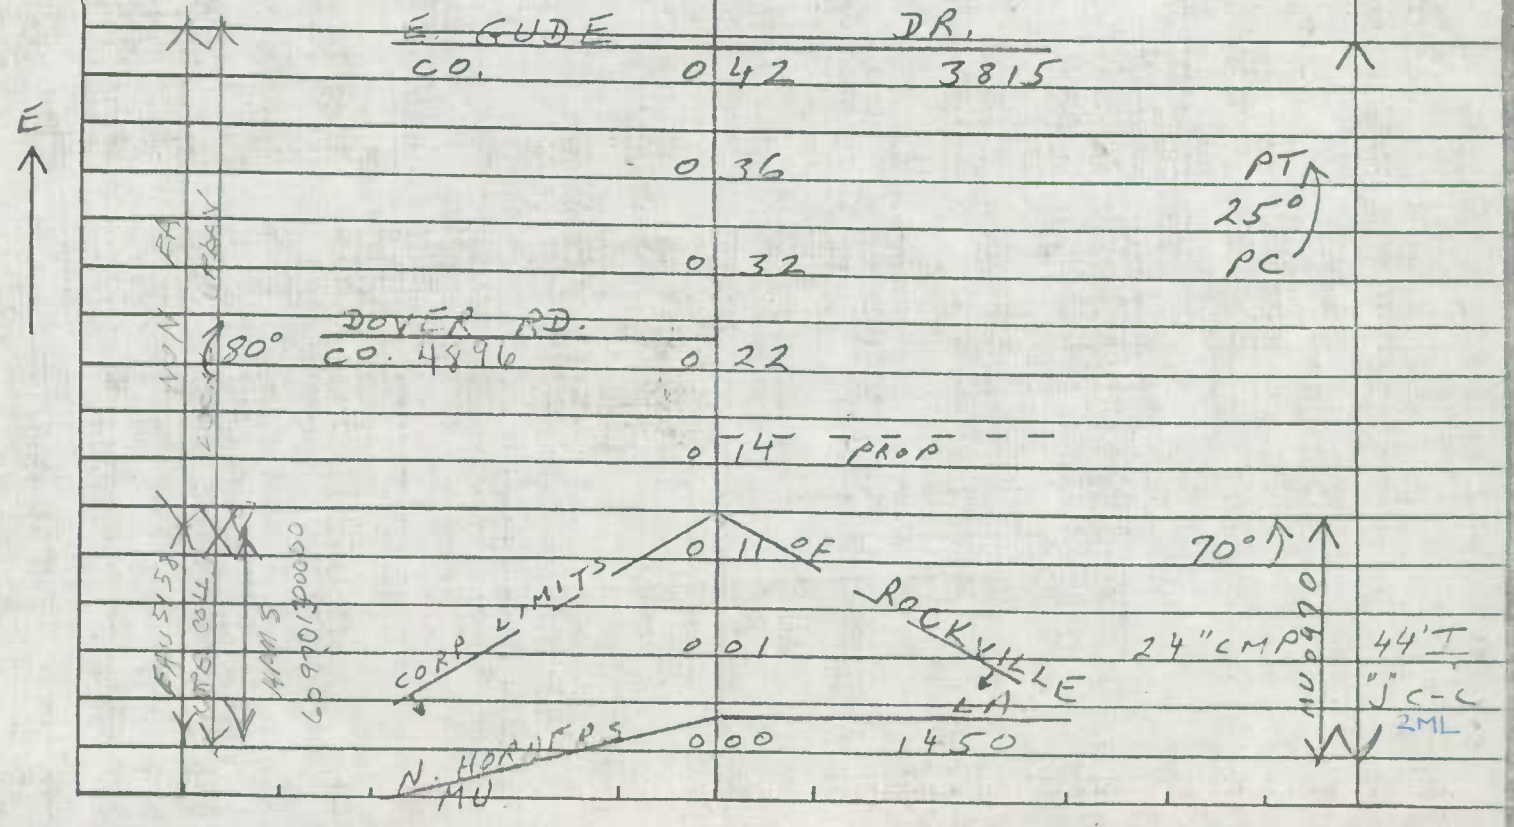

Form 5-HPS
(Revised 1961)

MARYLAND STATE ROADS COMMISSION
PLANNING AND PROGRAMMING DIVISION

S26130

MN 1002

IN COOPERATION WITH
U.S. BUREAU OF PUBLIC ROADS

EDMONSTON DR.

ROAD NO. _____

BRIDGE SHEET

SHEET NO. 1A

PARTY NO. _____

DATE 1-30-74

COUNTY MONT

RATED CAPACITY _____

FOR ALL STRUCTURES HAVING A TOTAL OPENING OF MORE THAN 20 FEET AS DEFINED IN NOTE 1.

ODOMETER READING _____ NAME OF STREAM, RAILROAD OR HIGHWAY CROSSED B+O R.R.

NUMBER OF RAILROAD TRACKS 2

KIND OF CROSSING (NOTE 2) _____

UNDERPASS-SIMPLE UNDERPASS-COMBINED (NOTE 3) OVERPASS BRIDGE OVER SYSTEM

DESCRIPTION

NUMBER OF SPANS	LENGTH EACH SPAN (NOTE 4)	TYPE (NOTE 5)
2	37'	I-BEAM
1	41'	"

TOTAL LENGTH-ON LINE OF ROAD OVER-ALL (NOTE 6) 123'

MATERIAL

SUBSTRUCTURE CONC + I-BEAM SUPERSTRUCTURE STEEL RAILS

FLOOR WOOD

CLEARANCES

ROADWAY (NOTE 7) 22' I WOOD C-C SIDEWALK WIDTHS: RIGHT NONE LEFT 4' WOOD

SURFACE OF ROAD TO STREAM BED _____ FOR OVERPASSES, SHOW DISTANCES TO TOP OF RAIL OR SURFACE OF LOWER ROAD. (NOTE 8)

SURFACE OF ROAD TO BOTTOM PORTAL 22' (MINIMUM OVERHEAD CLEARANCE

CLEAR DISTANCE OF OPENING ABOVE STREAM BED _____ (WATERWAYS ONLY)

POSTED LOAD LIMITS _____ BRIDGE NO. _____ CONSTRUCTION DATE 1948

GENERAL CONDITION OF BRIDGE: CHECK IF GOOD, FAIR, OR POOR, DESCRIBE DEFECTS IF SERIOUS.

	GOOD	FAIR	POOR
SUPERSTRUCTURE	✓		
FLOOR	✓		
SUBSTRUCTURE	✓		
PAINT		BADLY CORRODED OR RUSTED	

TYPE OF PROTECTION FOR DRAWBRIDGES (NOTE9) _____

(NOTES ON REVERSE SIDE)

S26130

Notes:

1. In agreement with Federal-aid standards, a bridge is defined as a structure including supports erected over a depression or an obstruction, as water, highway, or railway, and having a track or passageway for carrying traffic or other moving loads, and having a length measured along the center of roadway of more than 20 feet between undercoping of abutments or spring lines of arches, or extreme ends of openings for multiple boxes and pipes, where the clear distance between openings is less than half of the smaller contiguous opening.

2. Show kind of crossing by checking descriptive item applicable. For multiple-span bridges give complete information on each span including approach spans. Indicate on leg sheet the odometer reading, position, and angle of skew of structure with respect to center line of road and by arrow the direction of stream flow.

3. Give information on the span over the highway only.

4. For span length use center to center of bearings, otherwise the clear opening. Skew bridges will be measured along center line of road. See Note 1.

5. Show general type such as: Trestle, Truss, Girder, I-Beam, Rigid Frame, Arch, Slab, Suspension, or Covered Bridge. See illustrations attached. Describe draw spans by classifications listed in Article X, Section 2 of Manual.

6. The length of a bridge structure is the over-all length measured along the line of survey stationing back to back of back-walls of abutments, if present, otherwise end to end of bridge floor, but in no case less than the total clear opening of the structure.

7. Give minimum lateral clearance. Where traffic lanes are separated by bridge numbers, show clearance width of each lane separately. Special conditions should be explained by notes.

8. In case of overhead bracing or arch construction, measurement shall be made to the lowest point above the road surface.

9. Use classification listed on RR crossing sheets. Form 4 HPS.

Remarks:_____

A rearrangement of the form similar to that shown on the attachment may be used to provide space for coding.

A 51.3-8
-15-72

STATE HIGHWAY ADMINISTRATION OF MARYLAND

ROAD INVENTORY SHEET

Party Chief JE
Recorder CM
Helper

Map No.

ROCKVILLE 81-83

Road No. MUN 1076
Road Name FARMHAVEN DR.
Sheet No. 1 of 1
Date Oct 6, 1982
County MONTGOMERY
State Coordinates

NOW COMB. WITH MU. 1074 82-80

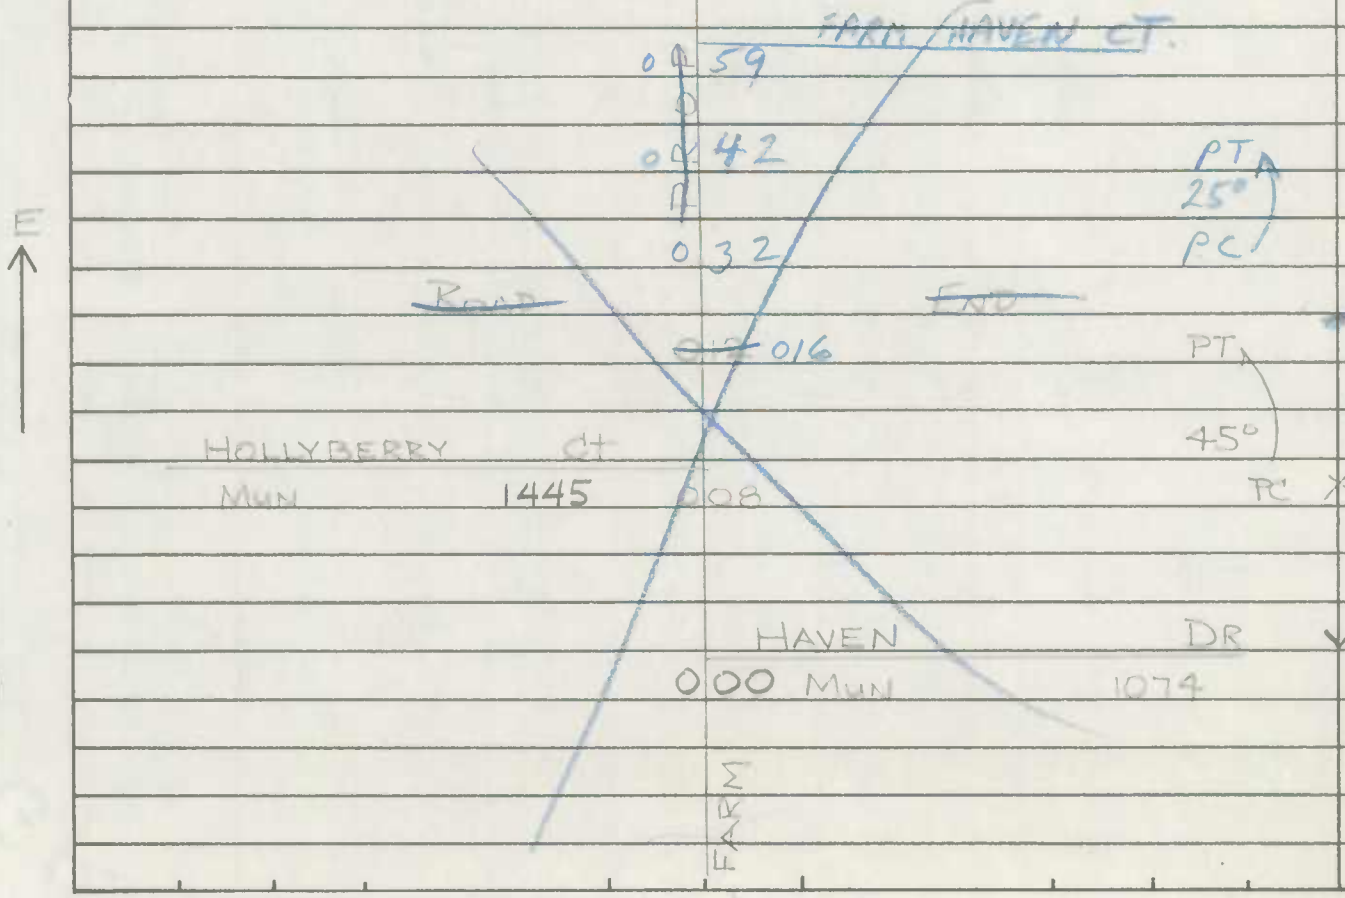

SHA 51.3-8
11-15-72

ROAD INVENTORY SHEET

Road No. _____
Road Name _____
Sheet No. _____
Date _____
County _____
State Coordinates _____

SHA 51.3-8
11-15-72

STATE HIGHWAY ADMINISTRATION OF MARYLAND

MUN 1125
FLEET ST

ROAD INVENTORY SHEET

Party Chief I. LONDON
Recorder I. ABBOTT
Helper

Map No. 26

Road No. MUN. 201
Road Name MARYLAND AVE.
Sheet No. 1 OF 1
Date 1-3-74
County MONT.
State Coordinates

ROCKVILLE

MONROE MUN. 0.83 ST. 2140

SEE NEW INV 3-9-81

PKG. LOT 0.78

0.76 SPUR

PKG. LOT 0.75 ST. SAME 0021.8 1" I "J" C-C

S. PERRY MUN. 2400 SPUR

0.73 S. WASHINGTON MUN. ST. 3150

LEXAND MUN. ST. 1650 0.65

S. ADAMS MUN. ST. 0030 0.62

0.53 ST. 0150

W. ARGYLE MUN. 0.51

0.45 48" CP

NEW MARK ESPLENDE MUN. 2230 0.44

PEDESTRIAN MONUMENT MUN. 2160 ST. 0.42 TUNNEL 90" CP

0.26 POTOMAC VALLEY RD. 0.05 MUN 2460

STREAM FALLS

0.00

29' I "J" C-C

FLEET ST 1125

46' I

ROAD

36' I "J" C-C

26' I

2.3' ESWI

36' CW


SHEET 51.53

URBAN

E

SHA 51.3-8
11-15-72

STATE HIGHWAY ADMINISTRATION OF MARYLAND

ROAD INVENTORY SHEET

FLEET ST #2
1126

Party Chief I. LANDON
Recorder I. ABBOTT
Helper

Map No. 26

Road No. MUN. ~~2290~~
Road Name OAK AVE.
Sheet No. 1 OF 1
Date 1-3-74
County MONT
State Coordinates

ROCKVILLE

NOW PART OF

MUN 1125

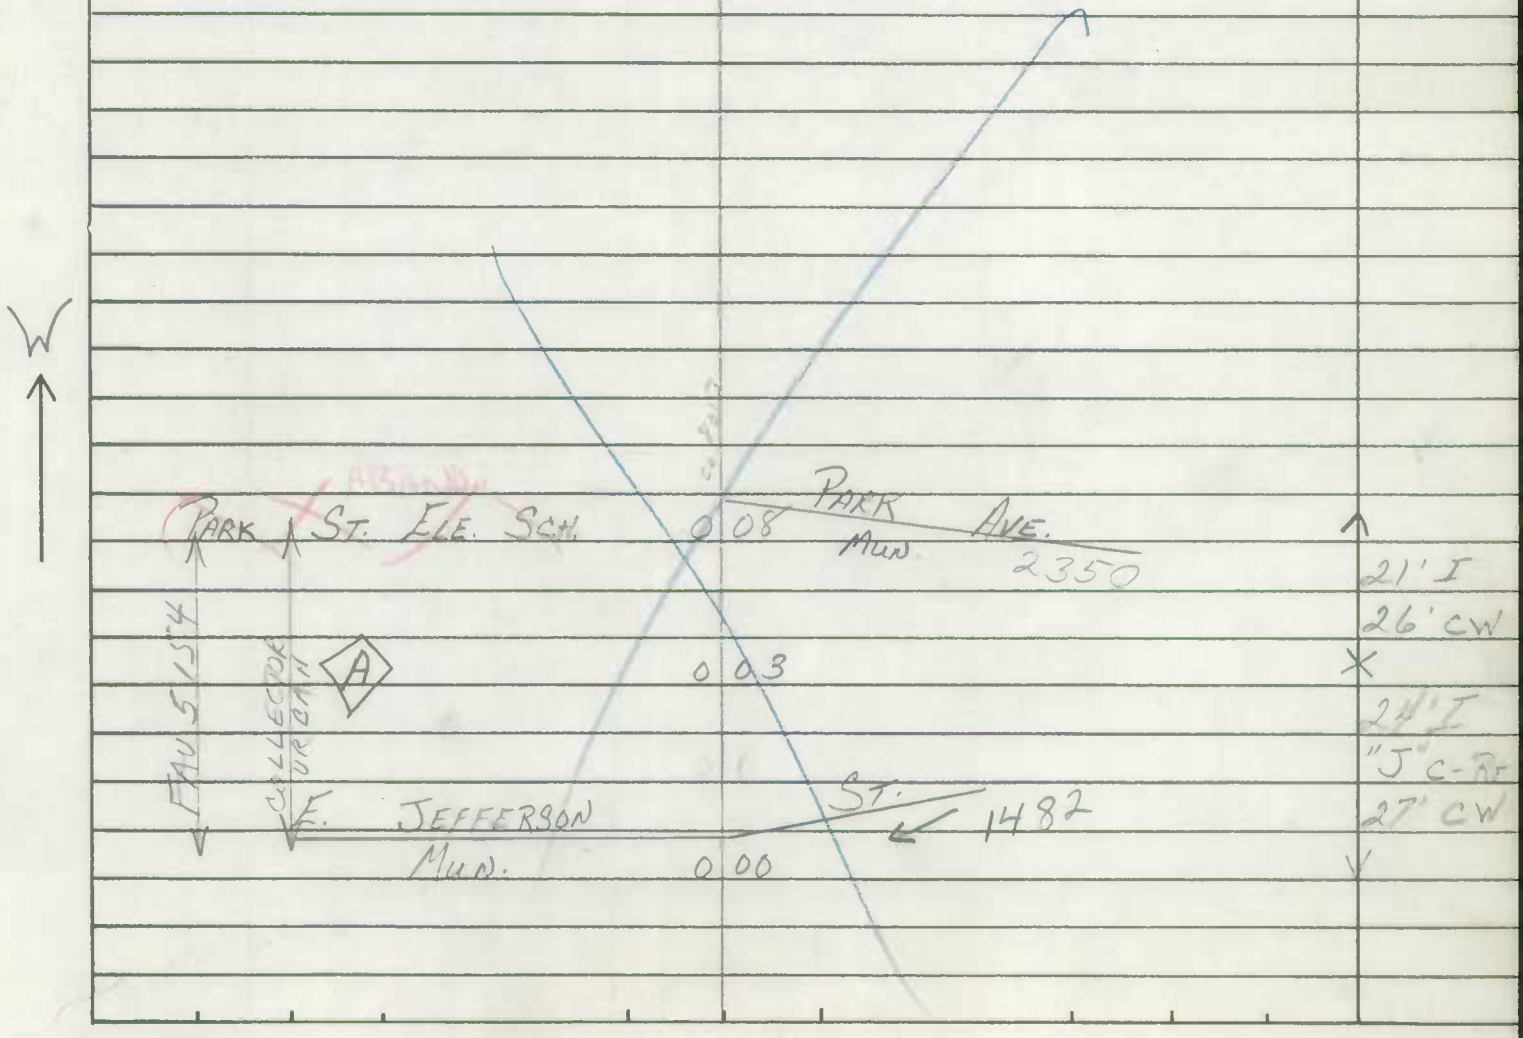

SHA 51.3-8
11-15-72

ROAD INVENTORY SHEET

Road No. _____
Road Name _____
Sheet No. _____
Date _____
County _____
State Coordinates _____

SHA 51.3-8
11-15-72

STATE HIGHWAY ADMINISTRATION OF MARYLAND

M10-78 ✓

ROAD INVENTORY SHEET

Party Chief T. LANDON
Recorder M. ZALENSKI
Helper

Map No. 26
BB REV. FR 3-10-81

Road No. MUN. 1160
Road Name FREDERICK AVE.
Sheet No. 1 OF 1
Date 1-31-74
County MONT.
State Coordinates

ROCKVILLE

SUBURBAN

N. HORNERS
MUN. 042 ~~050~~ LA
1450

039 047 REC. CENTER

037 ~~045~~ ENT TO LINCOLN PARK

CEM. 036 ~~044~~ 25°

JOHNSON DR.
034 ~~042~~ O.P. 342

MOORE AVE.
MUN. 2170 ~~037~~ 029 10°

~~033~~ 025 10°

ALLEY DOUGLASS AVE
MUN 8100 ~~032~~ 024 MUN 0960

WESTMORE AVE
MUN 3210 ~~030~~ 022 15°

LENMOR AVE
013 ~~021~~ MUN 1670

N. STONESTREET AVE.
MUN ~~014~~ 006 2850

36' I
J' C-C

RXR
B+O 007 R.R. #BO 140 499 K
RXR

~~36' I~~
~~J' C-C~~

HUNGERFORD DR.
MD 355

E

SHA 51.3-8
11-15-72

ROAD INVENTORY SHEET

Road No. _____
Road Name _____
Sheet No. _____
Date _____
County _____
State Coordinates _____

SHA 51.3-8
11-15-72

STATE HIGHWAY ADMINISTRATION OF MARYLAND

ROAD INVENTORY SHEET

8-5-37 BR/AL 4-8-86

Party Chief I LANDON
Recorder M ZALESKI
Helper

80-EXTRA-CO

Map No. 26

Road No. 1190
Road Name GAITHER RD
Sheet No. 1 of 1
Date 10-15-73
County MONT
State Coordinates 346-648

REVISIT 8-26-91 VTSC

91-1 A/T

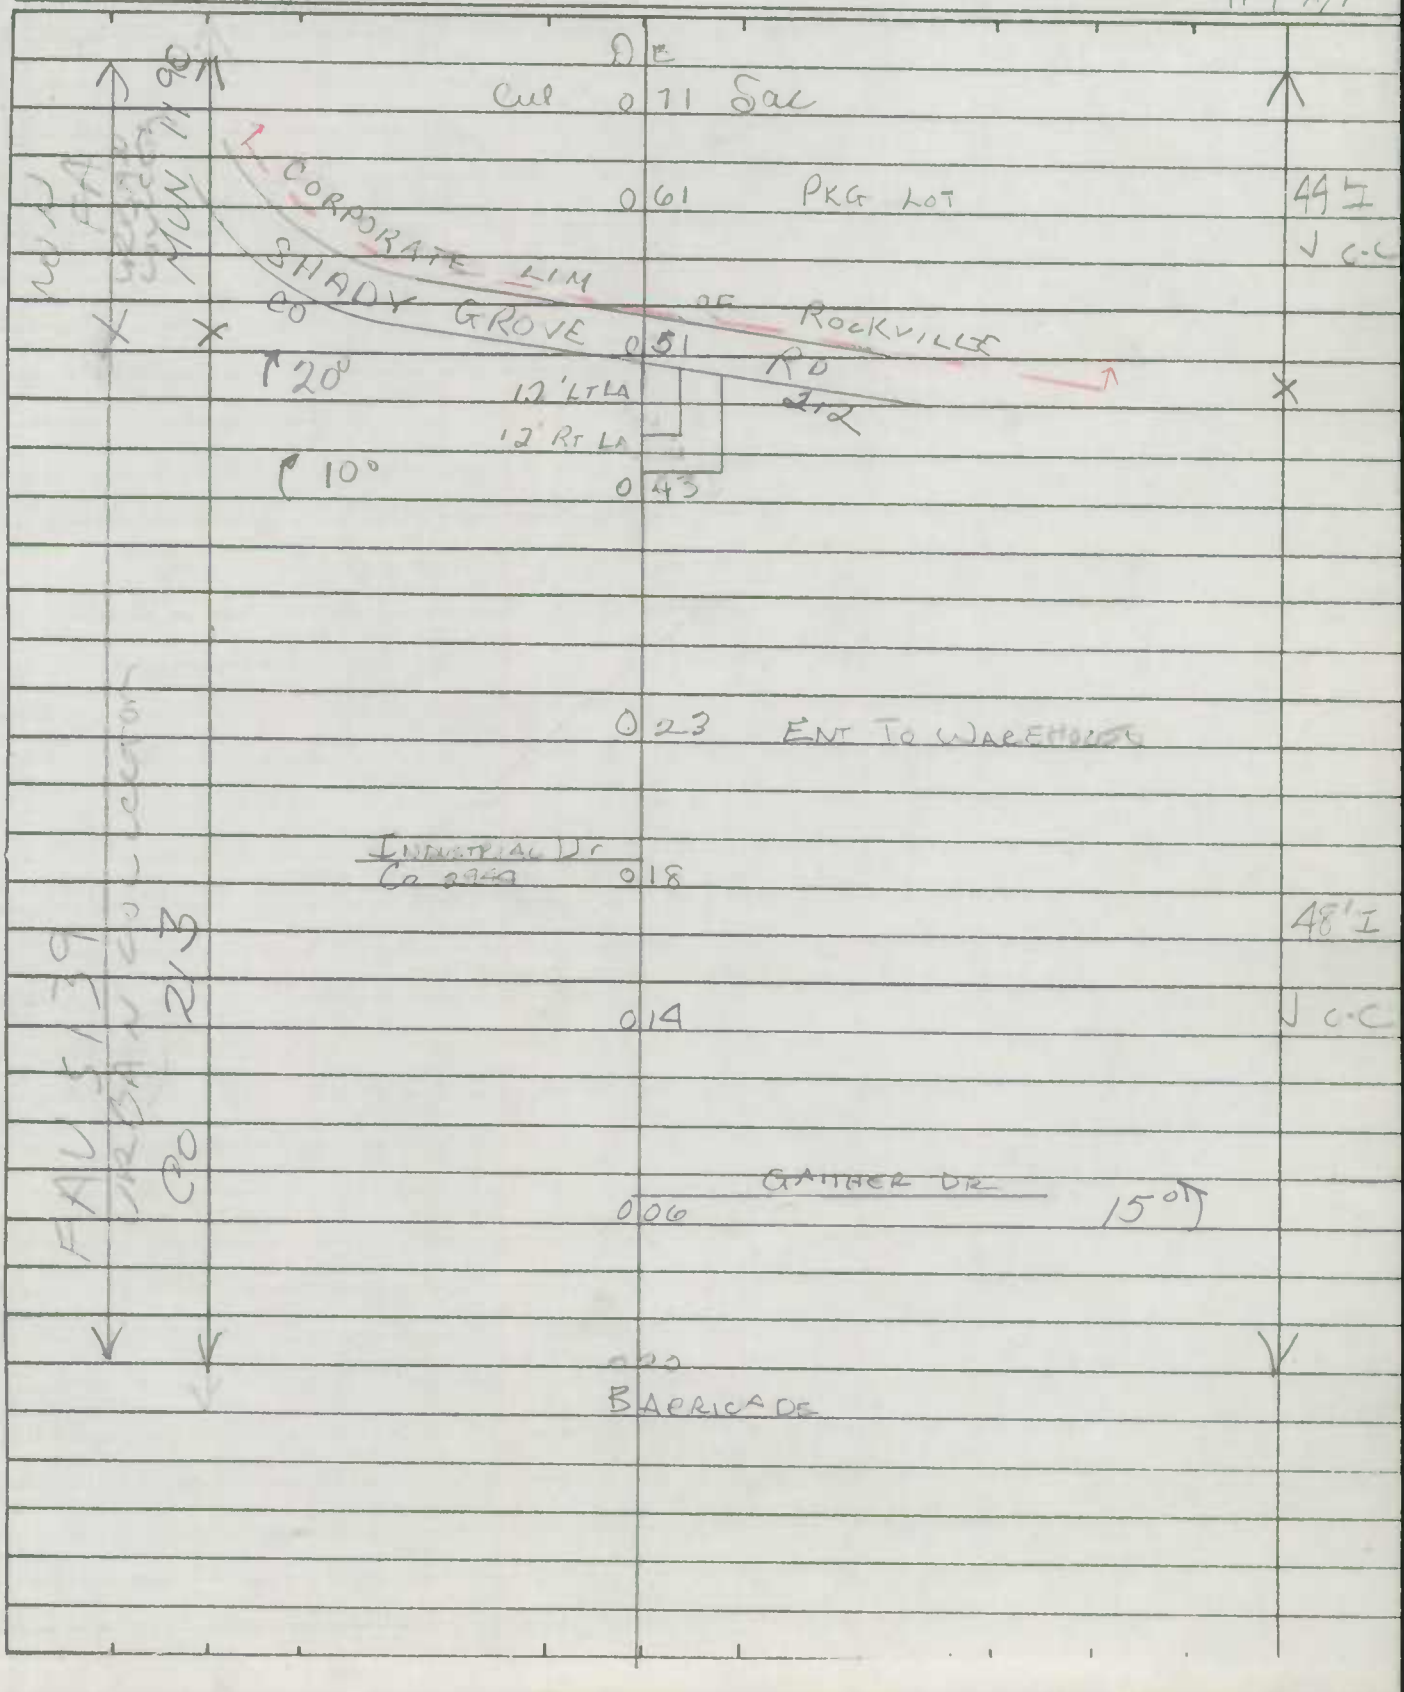

SHA 51.3-8
11-15-72

ROAD INVENTORY SHEET

Road No. _____
Road Name _____
Sheet No. _____
Date _____
County _____
State Coordinates _____

SHA 51.3-8
11-15-72

ROAD INVENTORY SHEET

MUN 1190

Party Chief I. LANDON
Recorder M. ZAJICKI
Helper

Map No. 26
40-EXTRA(CO.)

Road No. Co. 213
Road Name GAITHER RD
Sheet No. 1 OF 1
Date 10-15-73
County MONT.
State Coordinates 46-468

D COL
CUL 0 62 SAC
0 520.61 PKG LOT
CORP. LIMITS OF GAITHERSBURG
SHADY GROVE Co.
20° 0 92.51 ROCKVILLE RD 212
E
10° 0 72.43 23 ENT TO WAREHOUSE
INDUSTRIAL DR
Co 2944 0 09.18
0 .14
0 09.06 GAITHER DR
0 00
BARRICADE

MEDIAN
44' I
"J" c-c
15°
48' I
"J" c-c

SHA 51.3 - 8 Revised
4.83

MARYLAND STATE HIGHWAY ADMINISTRATION

ROAD INVENTORY SHEET

ROCKVILLE

97-2
12/8/78
SS/RB

Party Chief BB
Recorder AL
Assistant
Map No./Dir. / N
State Coordinates

Road No. MUN 1191
Road Name GAITHER RD
County MONT
Date 4-8-86
Sheet No. 1 OF 1

85-37

TRAFFIC CODES
TRAFFIC CONTROLS: STOP SIGN=SS, TRAFFIC LIGHT=T.L., FLASHING RED BALL=F.R.

TRAFFIC CODES
PARKING RESTRICTIONS: A.M. PEAK, P.M. PEAK, A.M./P.M. PEAK, NO PARKING ANYTIME=N.P., COMM/IND. ACCESS=E

SYSTEM				TRAFFIC		LINE DIAGRAM	TRAFFIC			PAVEMENT DATA
FED. AID.	FUNCT CLASS.	HWY. SYS.	HPMS SAMPLE	PRKG. REST.	COM/IND. ACCESS		CONTROL	COM/IND. ACCESS	PRKG. REST.	
						Unassigned now MU 1190				
						97-2				
						3-7-01				
						AD				
						ROAD 0 16 END				
						ENT TO PEPCO 0 15				24'I
										J CRB LT
										6'E SHO RT 2ML
						0 11				36'I ON TAPER
										J CRB LT 6'E SHO LT 2ML
						0 06				60'I
										J CRB LT 6'E SHO RT 3ML
						W. GUDE DRIVE MU 0 00 1295				

NON-FED Local Urban Collector

SYSTEM				TRAFFIC		LINE DIAGRAM	TRAFFIC			PAVEMENT DATA
FED. AID.	FUNCT. CLASS.	HWY. SYS.	HPMS SAMPLE	PRKG. REST.	COM/IND ACCESS		CONTROL	COM/IND ACCESS	PRKG. REST.	

MU 1295 IS CURRENTLY UNDER CONS. FROM MP 2.53 – 3.57 (LT LANES)

SHA 51.3 - 8 Revised
4.83

MARYLAND STATE HIGHWAY ADMINISTRATION

ROAD INVENTORY SHEET

AL TM
88-4
2-17-89

Party Chief AL
Recorder TM
Assistant
Map No./Dir. 1
State Coordinates

Road No. MU 1295
Road Name GUDE DR
County Mont
Date 2-17-88
Sheet No. OF

TRAFFIC CODES
TRAFFIC CONTROLS: STOP SIGN=SS, TRAFFIC LIGHT=T.L., FLASHING RED BALL=F.R.

TRAFFIC CODES
PARKING RESTRICTIONS: A.M. PEAK, P.M. PEAK, A.M./P.M. PEAK, NO PARKING ANYTIME=N.P., COMM/IND. ACCESS=E

SYSTEM				TRAFFIC		LINE DIAGRAM	TRAFFIC			PAVEMENT DATA
FED. AID.	FUNCT CLASS.	HWY. SYS.	HPMS SAMPLE	PKG. REST.	COM/IND. ACCESS		CONTROL	COM/IND. ACCESS	PKG. REST.	
						GUDE DR SERV. 12'C				
						J 3 26		E		
						TAFT LA				
						MU 2988 3 21 MU 2670 TL				
						3 15				
						SEE NEW INV. AL JK				
						ROTHGEB DR 2665 3 08				
						3 02				
						2-8-91 90-2663				
						J 2 95				36'I RT
						4 COMP limits Rockville				34'I LT
						2 89				16'GR.MED
						SOUTH LAWN DR CO 2 88 140		X		'J' C-C
						2 79				4 ML
						DOVER RD				24'I
						2 68 CO 3076				2-10'E SHL

F A U

LINE DIAGRAM

SYSTEM: FED. AID. | FUNCT. CLASS. | HWY. SYS. | HPMS SAMPLE

TRAFFIC: PRKG. REST. | COM/IND ACCESS

TRAFFIC: CONTROL | COM/IND ACCESS | PRKG. REST.

PAVEMENT DATA

6129513000289

NORDEC — RD

MD 3|55 28 TL

PL

3|52

SEE NEW INV 90-263

3|47

REDGATE FARMS CT

3|43 T.H E

AC JK 2-8-91

3|41 60" CMP

3|37

SEX. RD

GUIDE RL MM 13.96

36'IRT
34'ILT
16'GR MED
5' C-C
4 mL

SHA 51.3 - 8 Revised
4.83

MARYLAND STATE HIGHWAY ADMINISTRATION

ROAD INVENTORY SHEET

ROCKVILLE
CO 3815

89-19,20
GD/CG
3-27-90

Party Chief BB
Recorder AL
Assistant
Map No./Dir. E10-D / E
State Coordinates 24E-461

Road No. MU 1295
Road Name VGUDE DR
County MONT.
Date 4-8-86
Sheet No. 1 OF 5

85-31/32/35
92 Mun. #8
BB 1515
2/17/93
26-29 State

TRAFFIC CODES
TRAFFIC CONTROLS: STOP SIGN=SS, TRAFFIC LIGHT=T.L., FLASHING RED BALL=F.R.

TRAFFIC CODES
PARKING RESTRICTIONS: A.M. PEAK, P.M. PEAK, A.M./P.M. PEAK, NO PARKING ANYTIME=N.P., COMM/IND. ACCESS=E

SYSTEM				TRAFFIC		LINE DIAGRAM	TRAFFIC			PAVEMENT DATA
FED. AID.	FUNCT CLASS.	HWY. SYS.	HPMS SAMPLE	PRKG. REST.	COM/IND. ACCESS		CONTROL	COM/IND. ACCESS	PRKG. REST.	
	5015 FAU MINOR ARTERIAL					ENT TO PEPCO 60 046 12'H SRA DEW 0 42 55/40 47-A 50 36 0 34 12'H PISCARD PR MD 2405 40 29 12'H 37 23 I- 0 16 270 MAIN 27 13 12'H RESEARCH MD BLVD 42540 (West MD Montgomery 28		TL MU 1295 TL	28'I J C-C 4ML 2-24'I J C-C 16' CR. MED 4ML 2-24'I J" C-C 16' J MED 4ML

17-1

LINE DIAGRAM

SYSTEM: FED. AID. | FUNCT. CLASS. | HWY. SYS. | HPMS SAMPLE

TRAFFIC: PRKG. REST. | COM/IND ACCESS

TRAFFIC: CONTROL | COM/IND ACCESS | PRKG. REST.

PAVEMENT DATA

5015 FAU MINOR ARTERIAL

SEE NEW INVENTORY WITH 2D30 SSV AO 17-1

SPUR 0.01 20'I JCC

12'I H

1 30 12'N

1 43 46

1 29 43

MU 12 9 5'

12'H

W. GUIDE DR

ENT. TO VITRO CORP.

E 1 40 26 OPS a47 E

12'H

1 36 22

1 18 32

PT

1 14 00

Watkins Pond Blvd

40° M.a 3173 (Rocky) 1 10

PC

0 74 88

MU 12 9 5'

GAITHER RD MU 1191

0 84 78

12'H

75 64

0 (63 71)

24'I LT

12'I RT

J C-C

SMH

4'I MED

4 ML

2-24'I

J" C-C

16' GR PKWY

4 ML

SHA 51.3 - 8 Revised
4.83

MARYLAND STATE HIGHWAY ADMINISTRATION

90-263 (C6)

ROAD INVENTORY SHEET Mu 1295

92 Mu #8
BB/JS/JS
2/17/93

Party Chief A Lijewski
Recorder J Klausing
Assistant
Map No./Dir. E10D
State Coordinates

Road No. Co 3815
Road Name E GUDE DR
County Montgomery
Date 2-8-91
Sheet No. 3 OF 6

88-4 (Mum)

TRAFFIC CODES
TRAFFIC CONTROLS: STOP SIGN=S.S., TRAFFIC LIGHT=T.L., FLASHING RED BALL=F.R.

TRAFFIC CODES
PARKING RESTRICTIONS: A.M. PEAK, P.M. PEAK, A.M./P.M. PEAK, NO PARKING ANYTIME=N.P., COMM/IND. ACCESS=E

SYSTEM				TRAFFIC		LINE DIAGRAM	TRAFFIC			PAVEMENT DATA
FED. AID.	FUNCT CLASS	HWY. SYS.	HPMS SAMPLE	PRKG. REST.	COM/IND. ACCESS		CONTROL	COM/IND. ACCESS	PRKG. REST.	
										2-38' I
										J C-C
								E		12' GRS MED
										6 ML
							TL		X	
										2-38' I
										J C-C
										16' GRS MED
										6 ML
									X	
										36' I RT
										24' I LT
										J C-C
										16' GRS MED
										5 ML
									X	
										2-24' I
										J C-C
										16' GRS MED
										4 ML

FALL 2015 Urban Collector Arterial

See Rev. Written 2/10-11/94 SSRA, 17-11/94

(WAY) PAVEMENT

CO 4991

88

470

3815

67

60

METRO

SEE PR. SH. 1-A

E Gude Dr.

W. Gude Dr.

Rockville

Mu 1295

9ico ex #7
GD-JK
3-9-92

LINE DIAGRAM

SYSTEM: FED. AID. | FUNCT. CLASS. | HWY. SYS. | HPMS SAMPLE
TRAFFIC: PRKG. REST. | COM/IND ACCESS
TRAFFIC: CONTROL | COM/IND ACCESS | PRKG. REST.
PAVEMENT DATA

FAU 5015
Urban Arterial

See new inventory written 2/23/01
SS/AD
97-T
PT
70°
PC
Calhoun Dr
PVT RD
CO 38 1/2

2-24' I
JCRT OUT
2-5'F SHLD IN
12'GRS MED
12'F SHLD OUT LT
4ML
24' I RT
24' I LT
JC-C RT
2-5'F SHLD IN
12'GRS MED
4ML
2-38' I
taper to
2-24' I
JC-C
12'Grs Med
6ML
2-38' I
JC-C
12'GRS MED
6ML

SHA 51.3 - 8 Revised
4.83

MARYLAND STATE HIGHWAY ADMINISTRATION

90-263 (Co)

ROAD INVENTORY SHEET Mu 1295

Party Chief A Lijewski
Recorder J Krausing
Assistant
Map No./Dir. 6107
State Coordinates

Road No. Co 3815
Road Name GUDE DR
County Montgomery
Date 2-8-91
Sheet No. 5 OF 6

TRAFFIC CODES
TRAFFIC CONTROLS: STOP SIGN=S.S., TRAFFIC LIGHT=T.L., FLASHING RED BALL=F.R.

PARKING RESTRICTIONS: A.M. PEAK, P.M. PEAK, A.M./P.M. PEAK, NO PARKING ANYTIME=N.P., COMM/IND. ACCESS=E

SYSTEM				TRAFFIC		LINE DIAGRAM	TRAFFIC			PAVEMENT DATA
FED. AID.	FUNCT CLASS	HWY. SYS.	HPMS SAMPLE	PRKG. REST.	COM/IND. ACCESS		CONTROL	COM/IND. ACCESS	PRKG. REST.	
			6129513006289	BS	E	Corp Limits 328903 ± Rockville La. Co 140 Mu 2795 @1.28 Spec mv Inventory mv from 3/23/01 Co 140 97-1 DOVER RD CO. 3076 Co 3215	TL	E	BS	36' I RT 24' I LT J C-C 12' GRS MED 5" ML 38' I RT 24' I LT 12' SHLD OUT LT 12' GRS MED J CRT OUT 4 C-C IN 5" ML 2-24' I J CRT OUT 4ML

FAU 5015 Urban Extension

LINE DIAGRAM

SYSTEM: FED. AID. | FUNCT. CLASS. | HWY. SYS. | HPMS SAMPLE

TRAFFIC: PRKG. REST. | COM/IND ACCESS

TRAFFIC: CONTROL | COM/IND ACCESS | PRKG. REST.

PAVEMENT DATA

See new Inventory written 2/23/01 SS/AD

NORBECK RD

MD 3 ~~569~~ 28

3 ~~64~~

3 ~~48~~

3 ~~46~~

REDGATE FARMS CT

3 ~~57~~ Ent. T.H.

3 ~~29~~

TAFT CT

Mun 2881

3 ~~35~~ mun 2880

3 ~~29~~

ROTHGEB DR

Mun. 2665

3 ~~28~~

Mun 12915

6129513000289 HPMS

Urban Minor Arterial

TL

E

BS

TL

TL

224' I

12' GRS MED

J c-c

4 ML

36' IN

24' I LT

J c-c

12' GRS MED

5 ML

SHA 51.3 - 8 Revised 4.83

MARYLAND STATE HIGHWAY ADMINISTRATION

ROAD INVENTORY SHEET ROCKVILLE Co 3815

Party Chief BB
Recorder AL
Assistant
Map No./Dir. E10D / E
State Coordinates 248-462

Road No. MU 1295
Road Name GUDE DR
County MONT.
Date 4-8-86
Sheet No. 1 OF 5

85-31/32/35

SYSTEM: FED. AID. — FUNCT CLASS. — HWY. SYS. — HPMS SAMPLE
TRAFFIC: PKG. REST. — COM/IND. ACCESS

5015 — FAU — ARTERIAL — MINOR

LINE DIAGRAM

ENT TO PEPCO
0 46
12'H
0 42
0 36
0 34
12'H
DISCARD RD
MD 2405
0 29
12'H
0 23
1295
0 18
I -
0 16
270
Bridge #M 0131
0 13
0 07
12'H
RESEARCH BLVD
MU
0 00 2540
TL
Key West Ave
5161
2540

TRAFFIC: CONTROL — COM/IND. ACCESS — PKG. REST.

PAVEMENT DATA

28'I
J C-C
2ML
2-24'I
J" C-C
ON TAPER
16'GR MED
2ML
2-24'I
J C-C
16'GR.MED
4ML
2-24'I
J" C-C
16' J MED
4ML

TRAFFIC CODES
TRAFFIC CONTROLS: STOP SIGN=SS, TRAFFIC LIGHT=T.L., FLASHING RED BALL=F.R.

TRAFFIC CODES
PARKING RESTRICTIONS: A.M. PEAK, P.M. PEAK, A.M./P.M. PEAK, NO PARKING ANYTIME=N.P., COMM/IND. ACCESS=E

LINE DIAGRAM

SYSTEM: FED. AID. | FUNCT. CLASS. | HWY. SYS. | HPMS SAMPLE
TRAFFIC: PRKG. REST. | COM/IND ACCESS
TRAFFIC: CONTROL | COM/IND ACCESS | PRKG. REST.
PAVEMENT DATA

5015
FAU
MINOR ARTERIAL

SPUR
0.01
20'I JCC

12'I
1 38
12'I

1 32

1 29

12'I

E of TO
V. Tro Loop

W. Gate Dr
1 26.0P 5247

12'I

1 22

1 18

PT 1 00

90°

PC 0 74

GAITHER RD
MU 1190

0 70

12'I

0 64

MU 1285

PAVEMENT DATA
~~24'I LT~~
~~12'I RT~~
~~J" C-C~~
~~3ML~~
~~4'J MED~~

2-24'I
"J" C-C
16' GR PKWY
4ML

SAME

SHA 51.3 - 8 Revised
4.83

MARYLAND STATE HIGHWAY ADMINISTRATION

90-263 (Co)

ROAD INVENTORY SHEET Mu 1295

Party Chief A Lijewski
Recorder J Klausing
Assistant
Map No./Dir. /
State Coordinates

Road No. Co. 3815
Road Name GUDE DR
County Montgomery
Date 2-8-91
Sheet No. 3 OF 6

88-4 (Mun)

TRAFFIC CODES
TRAFFIC CONTROLS: STOP SIGN=S.S., TRAFFIC LIGHT=T.L., FLASHING RED BALL=F.R.

TRAFFIC CODES
PARKING RESTRICTIONS: A.M. PEAK, P.M. PEAK, A.M./P.M. PEAK, NO PARKING ANYTIME=N.P., COMM/IND. ACCESS=E

SYSTEM				TRAFFIC		LINE DIAGRAM	TRAFFIC			PAVEMENT DATA
FED. AID.	FUNCT CLASS.	HWY SYS.	HPMS SAMPLE	PKG. REST.	COM/IND ACCESS		CONTROL	COM/IND ACCESS	PKG. REST.	
						183				2-38' I
										J C-C
						180		E		12' GRS MED
						CRABB BRANCH RD Dec. 1 St				6ML
						CO 4991 174 CO 40'00	TL			X
						164				
						153				2-38' I
										J C-C
						METRO 152				16' GRS MED
						SEE BR. 54 1-A				6ML
						151				X
										36' I RT
										24' I LT
						146				J C-C
										16' GRS MED
						142 0.01, 20' I, J C-C				5ML
						Rockville				
						Corp. Limits of				
						MD 141				X
										2-24' I
										J C-C
										16' GRS MED
										4ML

FAU 6015
Urban Other Principal Arterial
E. Gude Dr.
W. Gude Dr.
U. Min. Arterial

LINE DIAGRAM

SYSTEM: FED. AID. | FUNCT. CLASS. | HWY. SYS. | HPMS SAMPLE
TRAFFIC: PKG. REST. | COM/IND ACCESS
TRAFFIC: CONTROL | COM/IND ACCESS | PKG. REST.
PAVEMENT DATA

FAU 5015
Urban ~~Principal~~ Arterial

2 50
H
12'
2 41
I
12'
2 38
2 33
I
12'
PT
70°
2 29
H
12'
2 21
I
12'
2 14
I
12'
2 07
2 05
PC
1 99
I
12'
1 95
Calhoun Dr
ST RD
1 90
I
12'
1 95

Co 38 J

E
E
E
TL E

2-24'I
J CRT OUT
2-5'F SHLD IN
12'GRS MED
12'F SHLD OUT LT
4ML
X 39'I RT
24'I LT
BS J C-C RT
2-5'F SHLD IN
12'GRS MED
5ML
X
X
2-39'I
J C-C
12'GRS MED
6ML

SHA 51.3 - 8 Revised 4.83

MARYLAND STATE HIGHWAY ADMINISTRATION

90-263 (Co)

ROAD INVENTORY SHEET MU 1295

Party Chief A Lijewski
Recorder J Klausing
Assistant
Map No./Dir. 1
State Coordinates

Road No. Co 3815
Road Name GUDE DR
County Montgomery
Date 2-8-91
Sheet No. 5 OF 6

TRAFFIC CODES
TRAFFIC CONTROLS: STOP SIGN=SS, TRAFFIC LIGHT=T.L., FLASHING RED BALL=F.R.

TRAFFIC CODES
PARKING RESTRICTIONS: A.M. PEAK, P.M. PEAK, A.M./P.M. PEAK, NO PARKING ANYTIME=N.P., COMM/IND. ACCESS=E

SYSTEM				TRAFFIC		LINE DIAGRAM	TRAFFIC			PAVEMENT DATA
FED. AID.	FUNCT CLASS	HWY. SYS.	HPMS SAMPLE	PKG. REST.	COM/IND ACCESS		CONTROL	COM/IND. ACCESS	PKG. REST.	
			K 6295 300289	BS	E	3+04			BS	
						3+00 MU 1295 S				36' I RT
						2+93				24' I LT
						Corp Limits 2+89 ± Rockville				J C-C
						Southlawn La.				12' SRS MED
						~~60~~ MU 2+88 ~~279+40~~	TL		X	5 ML
						2+78				
						2+70				
						DOVER RD				
						2+63 CO. 3076	TL			
										38 I RT
										24' I LT
										12' F SHLD OUT LT
						2+58				12' GRS MED
										J CRT OUT
										J C-C IN 5 ML
						2+54	TL		X	
						38/15 T				
										2-24' I
										J CRT OUT
										2.5' F SHLD IN
										12' GRS MED
										12' F SHLD OUT LT
										4 ML

FAU 5015 Urban Collector Arterial

9-mun ex #2
GD-JK 3/20/12

MU 92-13
BB-33-93

02/17/93

LINE DIAGRAM

SYSTEM: FED. AID. | FUNCT. CLASS. | HWY. SYS. | HPMS SAMPLE
TRAFFIC: PKG. REST. | COM/IND ACCESS
TRAFFIC: CONTROL | COM/IND ACCESS | PKG. REST.
PAVEMENT DATA

FAU 5015
URBAN PRINCIPAL ARTERIAL
6129513002089

NORBECK RD
MD
3 55 28
3 52
3 50
3 48
3 46
REDGATE FARMS CT
3 43 Ent. T.H.
OP 5480
3 37
Rd
Service
12'
Dr
Mun 1295
3 28
Taft Ct
Taft Lane St.
Mun 2881
3 21 Mun 2880
3 15
ROTHGEB DR
Mun. 2665
3 08

TL
TL
TL
BS
E

2-24' I
12' GRS MED
J c-c
4 ML
36' I
24' I
J c-c
12' GRS MED
5 ML

SHA 51.3 - 8 Revised 4.83

MARYLAND STATE HIGHWAY ADMINISTRATION

ROAD INVENTORY SHEET CO 3815

88-4 AL TM 2-17-89

Party Chief _____
Recorder _____
Assistant _____
Map No./Dir. / Rockville
State Coordinates _____

Road No. MUN 1295
Road Name Gude DR
County MONTGOMERY
Date orig. 2-15-74: rewrite 4-4-86
Sheet No. 3 OF 5

TRAFFIC CODES
TRAFFIC CONTROLS: STOP SIGN=SS, TRAFFIC LIGHT=T.L., FLASHING RED BALL=F.R.

TRAFFIC CODES
PARKING RESTRICTIONS: A.M. PEAK, P.M. PEAK, A.M./P.M. PEAK, NO PARKING ANYTIME=N.P., COMM/IND. ACCESS=E

SYSTEM: FED. AID. — FAU; FUNCT CLASS. — 5015 PRINCIPLE ARTERIAL URBAN; HWY. SYS. — OTHER; HPMS SAMPLE — MINOR ARTERIAL
TRAFFIC: PK.G. REST. — COM/IND. ACCESS

LINE DIAGRAM

2 67 60" CP PT 25 N
2 47 PC
PT 80°
2 26 see br sh 1A
PC 1 99
CRABB BRANCH Rd CECIL ST.
OP 4932 1 74 CO 4966
1 53
1 52 see br. sh. 1A
1 51
2
1 43
1 42 0.01/20'I J-C-C
Rockville RD 355
Corp Limits FREDERICK Md
1 41
12'H 12'H
SPHR 0.01/20'I J-C-C

SECTION 1 3 8 5 COUNTY JO

TRAFFIC: CONTROL; COM/IND. ACCESS; PK.G. REST.

PAVEMENT DATA

24'I
2-10'E SHLD
50'CW
36'I
2-10'E SHLD
60'CW
12'I RT
20'I LT
2-6'E SHLDS
"J" CURB INS
4'J MED
TL
~~SAME~~
2-24'I
J-C-C
16'6R. PMT
4 ML

UNDER Construction From MP. 2.88 - 3.55

LINE DIAGRAM

SYSTEM: FED. AID. | FUNCT. CLASS. | HWY. SYS. | HPMS SAMPLE
TRAFFIC: PRKG. REST. | COM/IND ACCESS
TRAFFIC: CONTROL | COM/IND ACCESS | PRKG. REST.
PAVEMENT DATA

5015
FAU
OTHER PRINCIPAL ARTERIAL URBAN

3 39 20°T

SERV DR 1296

3 38 See NEW INV. 88-4

10° DR 3 29 ALTM 2-17-89

GUDE MUN 3 26 INC 17.9 H 10

TAFT MUN CT 2881 TAFT MUN STR 2880

3 21 RT 10.1 OUT

3 14

PT 3 12

20° ROTHGEB DR RD 2475 3 08

PUBLIC MU

PC 3 03.2

2 95

CORP LMTS OF ROCKVILLE SIGN

2 89

SOUTHLAWN CO LA 140

2 88 RT 12.1 H OUT

2 79

Dover Rd 3076 Co

2 68

COUNTY CO 3815 SECTION

24' I
2-10'E SHLD
50'CW

36' I RT
34' I LT
16' GR med
5" C-C
4 ML
30' I RT
34' I LT
6" J med
5" C-C
34' I 4 ML
7" CURB LT
10'E SHLD RT
50'CW

SAME

MY 1295 is currently Under Const from MP. 2.88 – 3.55 (LT LANES)

SHA 51.3 - 8 Revised 4.83

MARYLAND STATE HIGHWAY ADMINISTRATION

ROAD INVENTORY SHEET

AL TM 88-4 2-17-89

Party Chief AL
Recorder TM
Assistant
Map No./Dir. /
State Coordinates

Road No. MY 1295
Road Name GUDE DR
County Mont
Date 2-17-88
Sheet No. OF

SYSTEM: FED. AID. | FUNCT CLASS. | HWY. SYS. | HPMS SAMPLE
TRAFFIC: PRKG. REST. | COM/IND. ACCESS

TRAFFIC CODES
TRAFFIC CONTROLS: STOP SIGN=SS, TRAFFIC LIGHT=T.L., FLASHING RED BALL=F.R.

TRAFFIC CODES
PARKING RESTRICTIONS: A.M. PEAK, P.M. PEAK, A.M./P.M. PEAK, NO PARKING ANYTIME=N.P., COMM/IND. ACCESS=E

LINE DIAGRAM

GUDE DR
12' I
12' I
3 26
JAFT
LA
MY 2881
3 21
MY 2880
12' I
12' I
3 15
ROTHGEB DR
MY 2665
3 08
12' I
12' I
3 02
2 95
12' I
12' I
2 89
SOUTH LAWN DR
CC
2 88
140
12' I
2 79
15 MPH
DOVER RD
2 68
CO 3076

TRAFFIC: CONTROL | COM/IND. ACCESS | PRKG. REST.
E
TL

PAVEMENT DATA
36' I RT
34' I LT
16' GR. MED
'J' C-C
4 ML
24' I
2-10' E SHLD

5015
FAU
ARTERIAL URBAN
OTHER PRINCIPAL
6129/300289
E

SYSTEM				TRAFFIC		TRAFFIC			PAVEMENT DATA
FED. AID.	FUNCT. CLASS.	HWY. SYS.	HPMS SAMPLE	PRKG. REST.	COM/IND ACCESS	CONTROL	COM/IND ACCESS	PRKG. REST.	

LINE DIAGRAM

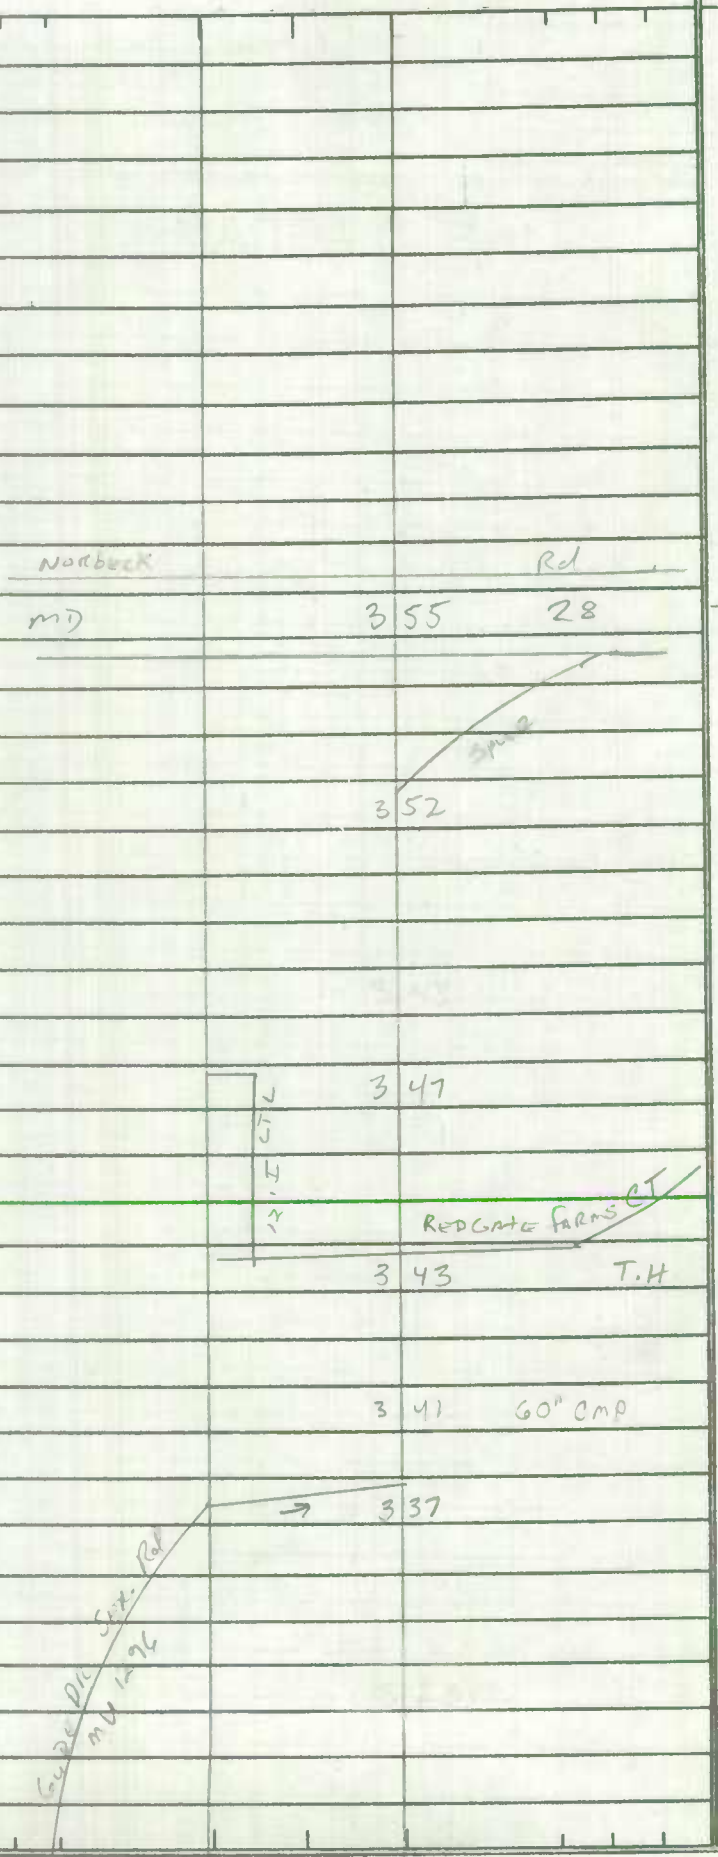

6129513002289

36' I RT
34' I LT
16' GR MED
5" C-C
4 lane

SHA 51.3 - 8 Revised
4.83

MARYLAND STATE HIGHWAY ADMINISTRATION

ROAD INVENTORY SHEET

Party Chief _____
Recorder _____
Assistant _____
Map No./Dir. 1
State Coordinates _____

Road No. MUN 1295
Road Name Gude DR
County MONTGOMERY
Date _____
Sheet No. 5 OF 5

SYSTEM: FED. AID. | FUNCT CLASS. | HWY. SYS. | HPMS SAMPLE
TRAFFIC: PRK.G. REST. | COM/IND. ACCESS

LINE DIAGRAM

SEE INV

NEW AL TM 88-4 2-17-89

1

Md 355 28

350

1

341 60" CP

TRAFFIC: CONTROL | COM/IND. ACCESS | PRK.G. REST.

PAVEMENT DATA

SAME

FAU 5015
OTHER PRINCIPLE ART. URB

TRAFFIC CODES

TRAFFIC CONTROLS: STOP SIGN=S, TRAFFIC LIGHT=T.L., FLASHING RED BALL=F.R.

TRAFFIC CODES

PARKING RESTRICTIONS: A.M. PEAK, P.M. PEAK, A.M./P.M. PEAK, NO PARKING ANYTIME=N.P., COMM/IND. ACCESS=E

SYSTEM				TRAFFIC		LINE DIAGRAM	TRAFFIC				PAVEMENT DATA
FED. AID.	FUNCT. CLASS.	HWY. SYS.	HPMS SAMPLE	PRKG. REST.	COM/IND ACCESS		CONTROL	COM/IND ACCESS	PRKG. REST.		

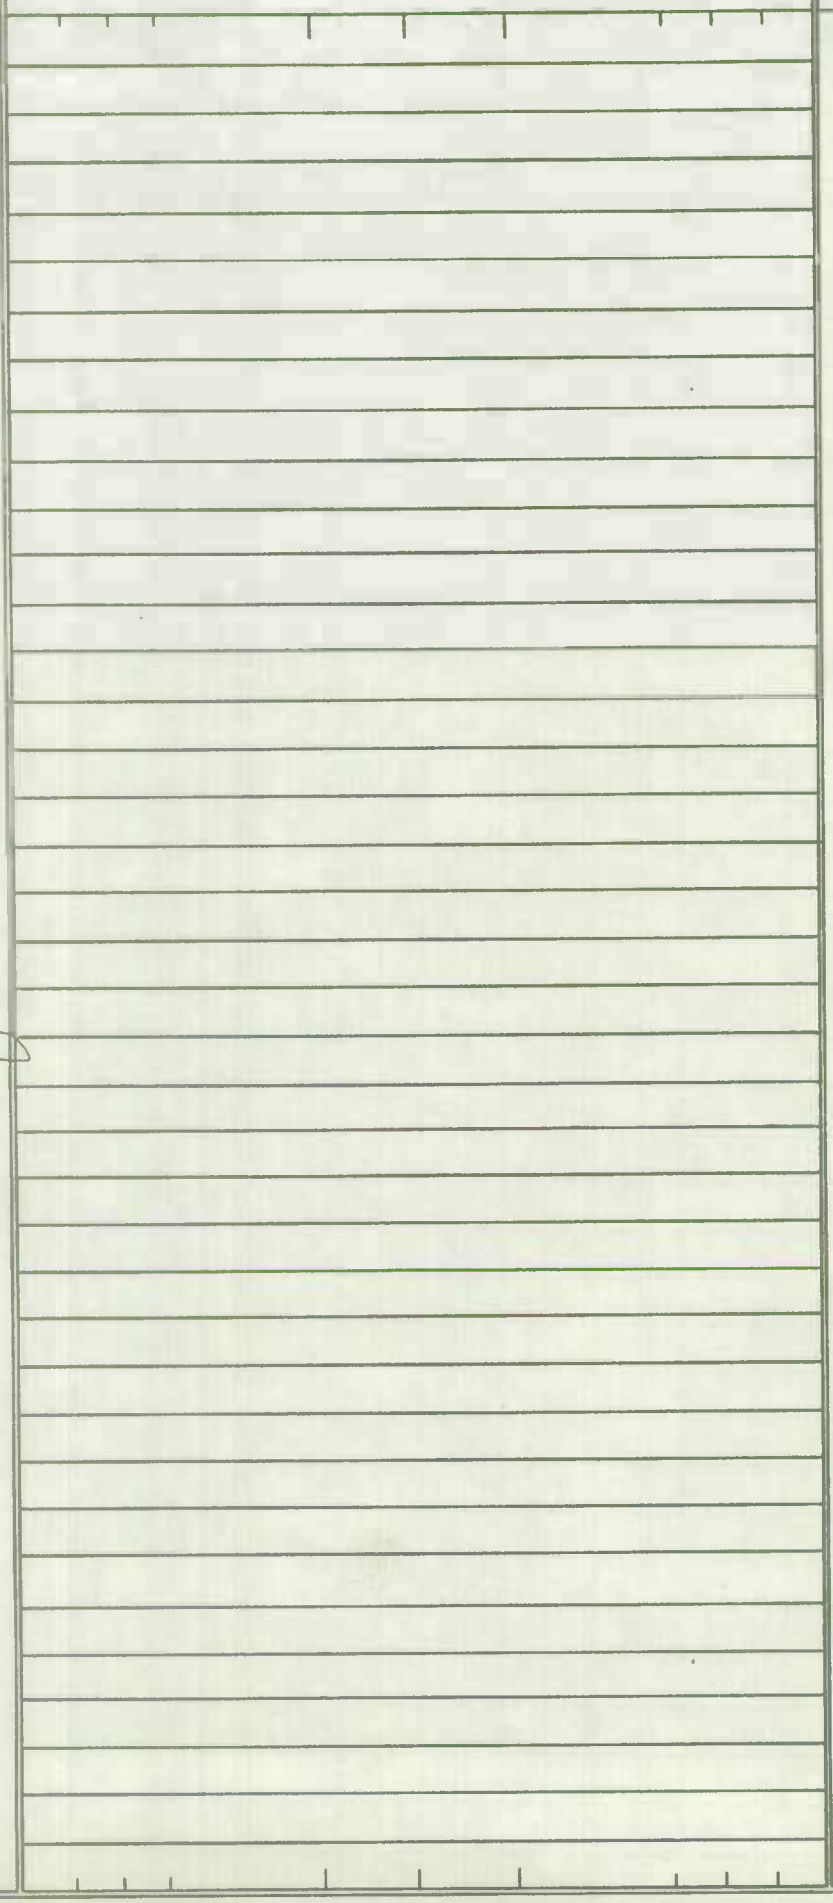

SHA 51.3-8
11-15-72

STATE HIGHWAY ADMINISTRATION OF MARYLAND

ROAD INVENTORY SHEET

Party Chief BB
Recorder FR
Helper

Map No.

Road No. MU 1295
Road Name W GUDE DR.
Sheet No. 1 OF 3
Date 3-22-83
County MONT
State Coordinates

A/T 84-24

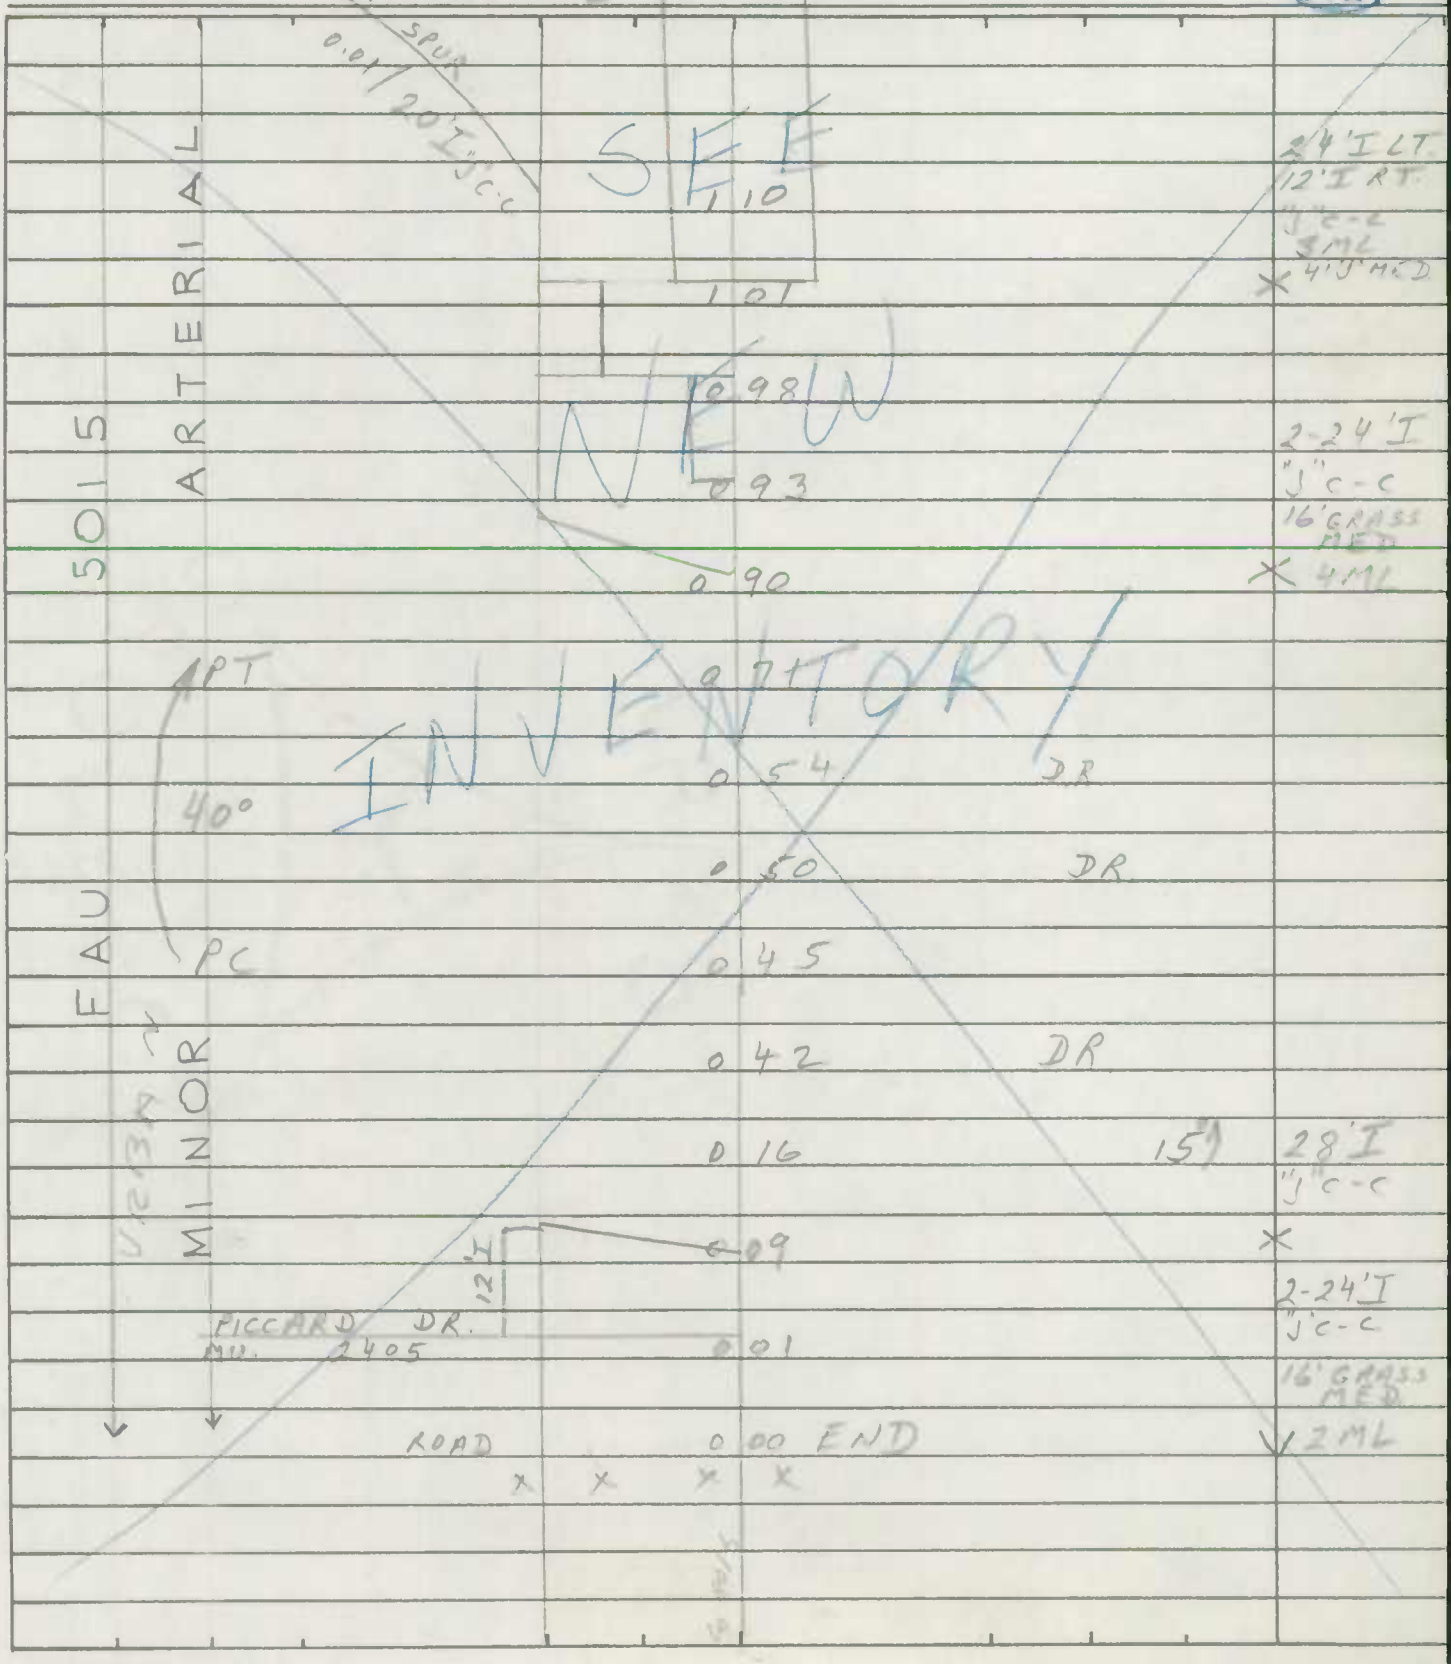

SHA 51.3-8
11-15-72

ROAD INVENTORY SHEET

Road No. _____
Road Name _____
Sheet No. _____
Date _____
County _____
State Coordinates _____

SHA 51.3-8
11-15-72

STATE HIGHWAY ADMINISTRATION OF MARYLAND

Co 3815

ROAD INVENTORY SHEET

Party Chief [illegible]
Recorder [illegible]
Helper

Road No. MD 1295
Road Name Cedar Dr
Sheet No. 2 of 3
Date 2-15-74
County Mont
State Coordinates

BB/AL 85-31/32 & 36 4-8-36

Map No. 26 82-77

BB REV, FR 3-22-83

Rockville

CORP. LIMITS OF ROCKVILLE

SOUTHERN PART CO

L-A

DOVER Rd CO 3096

60' CP

PT 25° PC

CRABB BRANCH WAY CO 4966

OP 4932

CECIL ST

P.R.

PT Y0° PC

see br. sh 1A

see br. sh 1A

CD. SECTION

24' I
2-10' Esh'd.
50' CW

36' I
2-10' Esh'd
60' CW

16' I PT
4' I LT
2 6' Esh'd
4' J MED

FAU

URBAN

PRINCIPAL ARTERIAL

OTHER

MINOR ARTERIAL

E

N

HA 51.3-8
1-15-72

L

ROAD INVENTORY SHEET

JTS 3-81
PER FR

Road No. MUN 1295
Road Name GUDE DR.
Sheet No. 2 of 2
Date 2-15-74
County Mont
State Coordinates

A/T 84-24

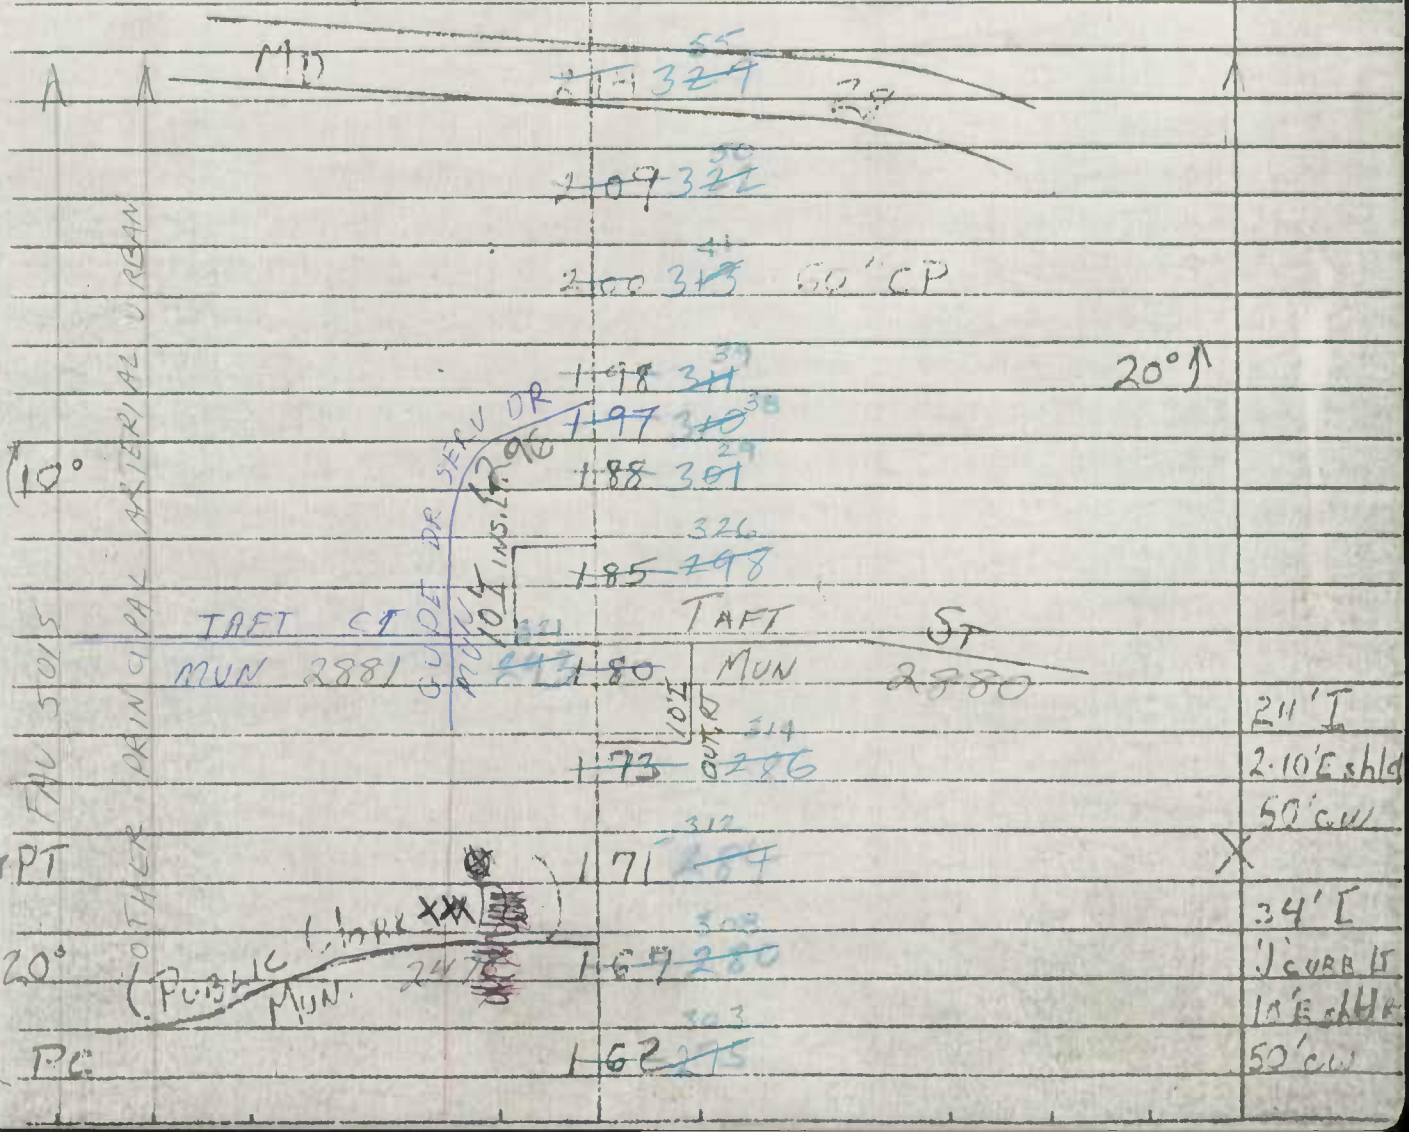

SHA 51.3-8
11-15-72

STATE HIGHWAY ADMINISTRATION OF MARYLAND

ROAD INVENTORY SHEET

Party Chief I. LANDON
Recorder I. ABBOTT
Helper

Plus 015

Map No. 26

ROCKVILLE

Road No. MUN. 1314
Road Name "H ST"
Sheet No. 1 OF 1
Date 12-12-73
County MONT.
State Coordinates 750-452

81-26

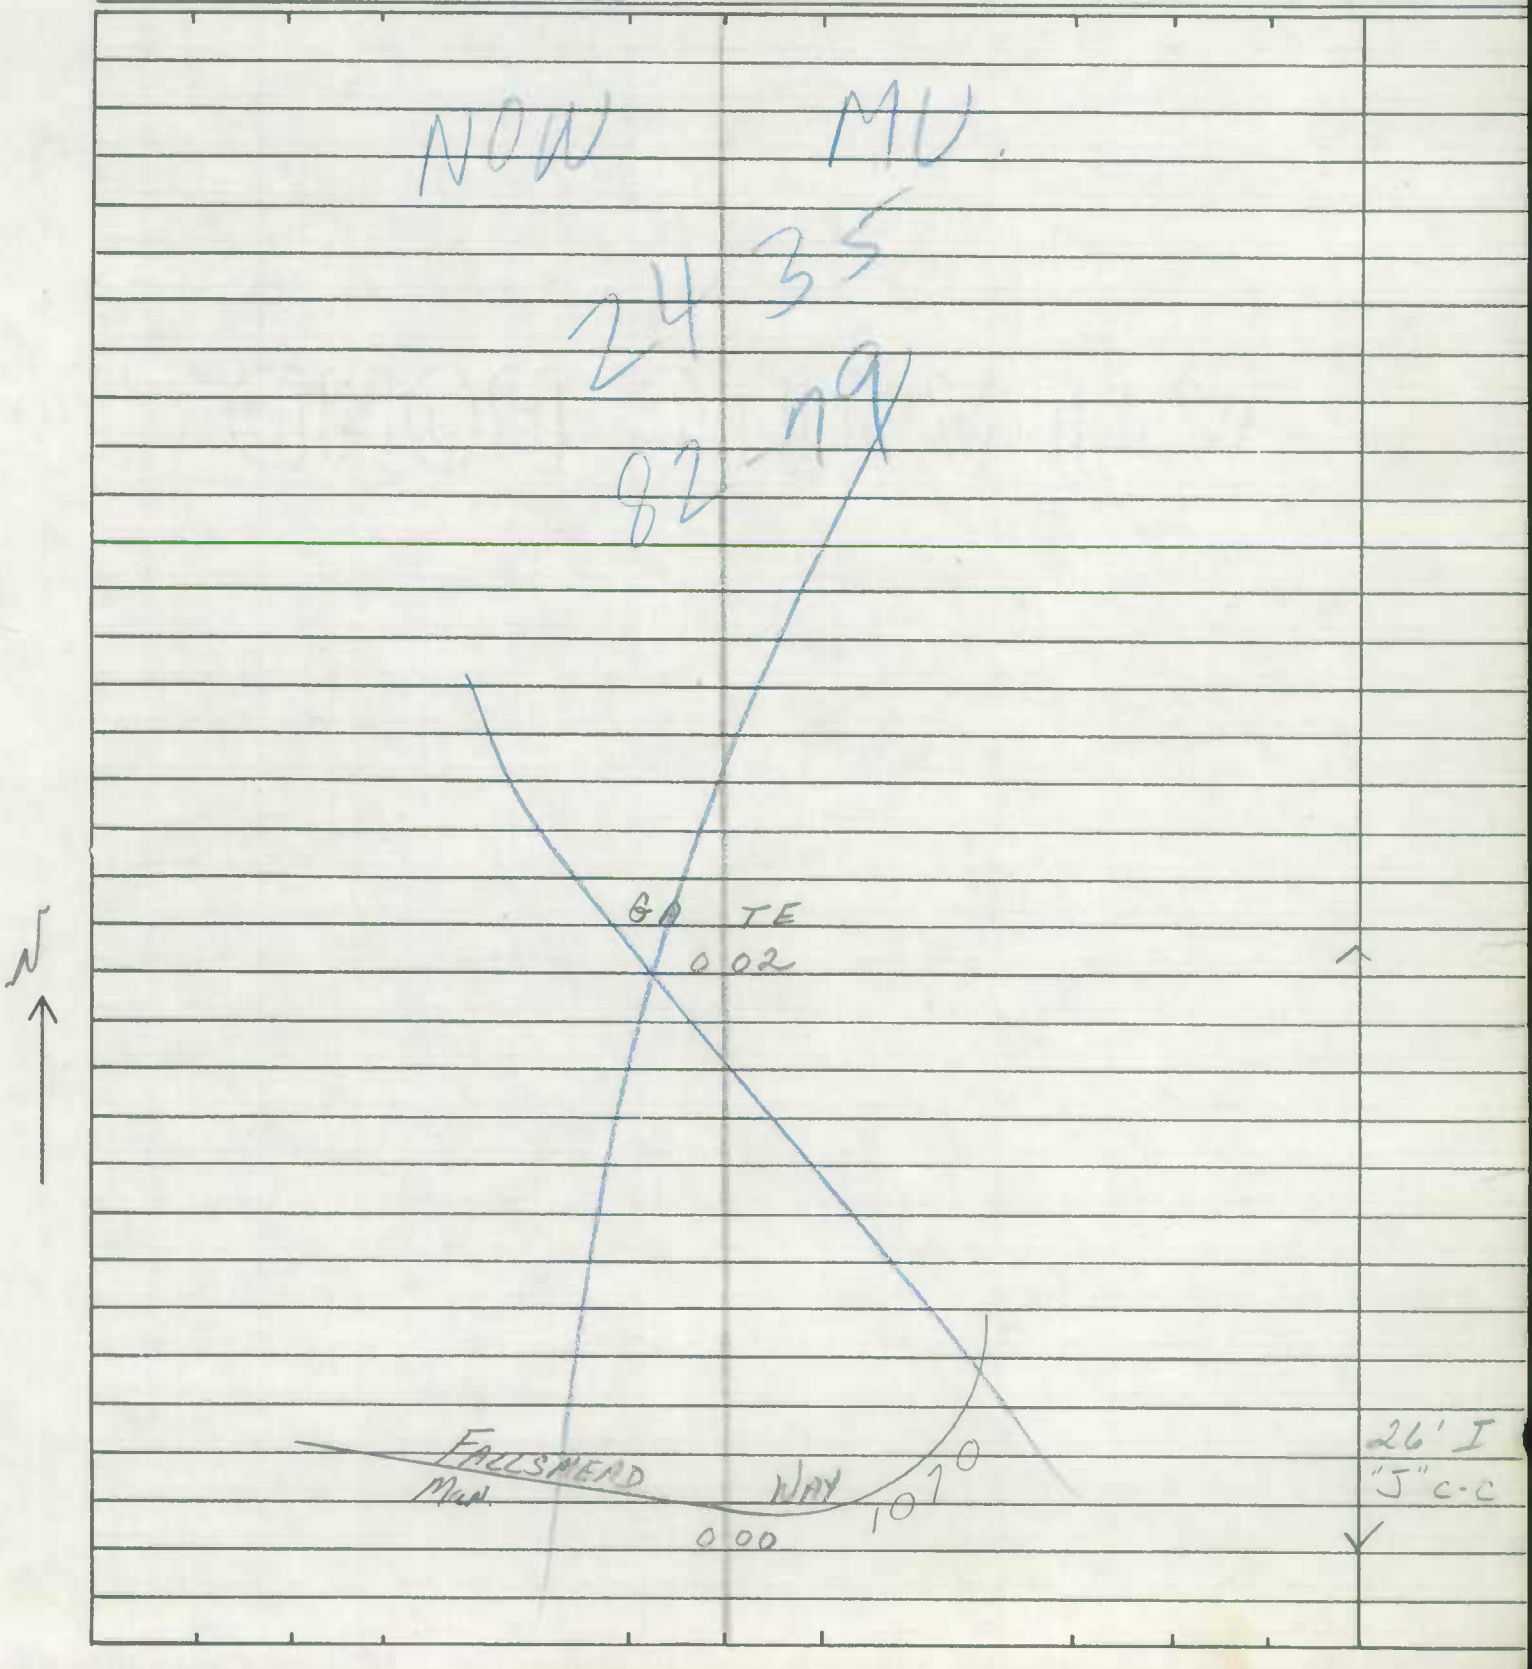

SHA 51.3-8
11-15-72

ROAD INVENTORY SHEET

Road No. _____
Road Name _____
Sheet No. _____
Date _____
County _____
State Coordinates _____

SHA 51.3-8
11-15-72

ROAD INVENTORY SHEET Co 143

Party Chief I. LANDAU
Recorder M. ZARENSKI
Helper

Map No. 26

Road No. MUN 1330
Road Name HALPINE RD
Sheet No. 1 OF 1
Date 2-25-74
County MONT
State Coordinates 767-449

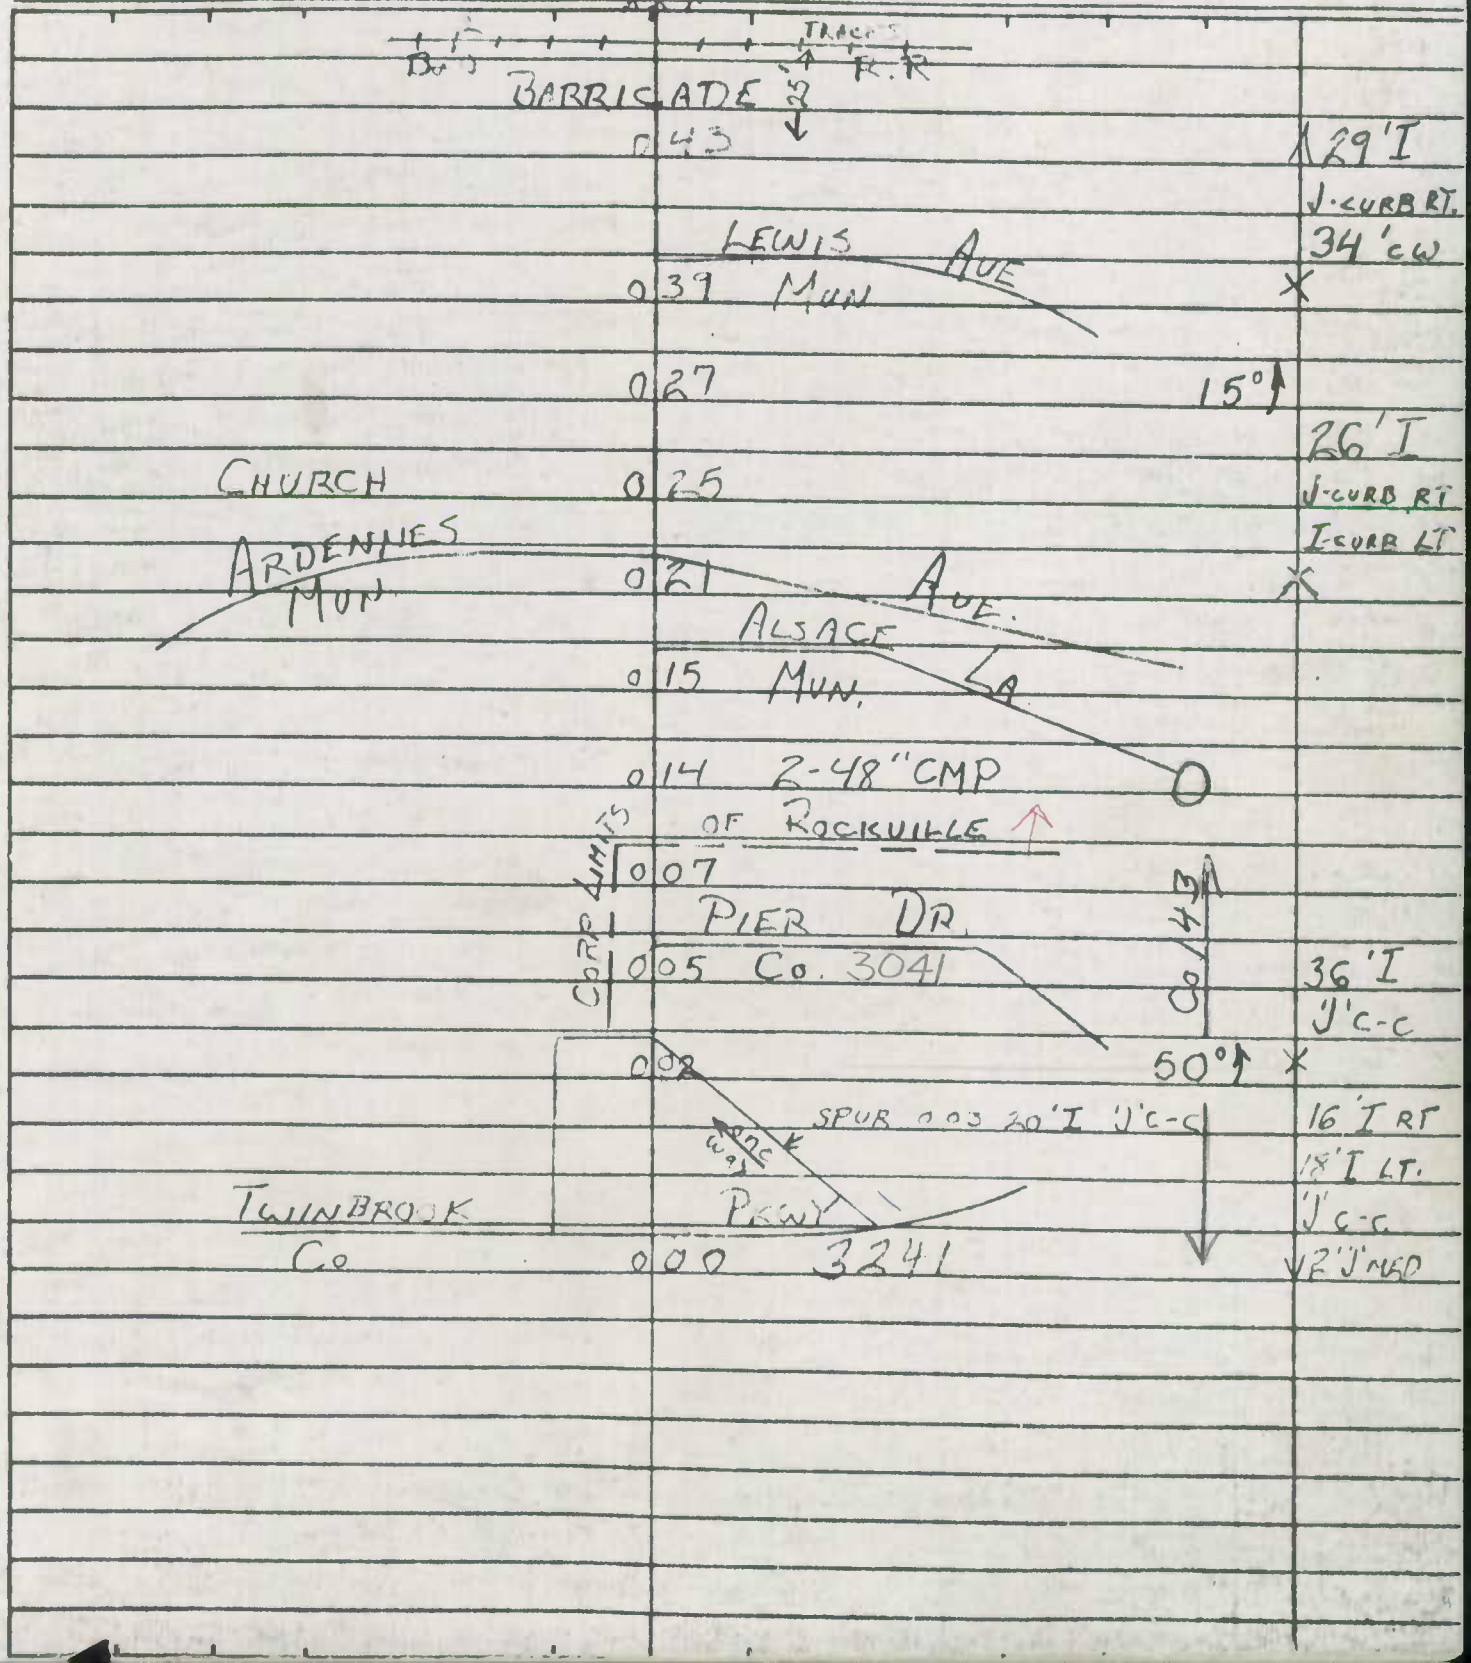

SHA 51.3-8
11-15-72

STATE HIGHWAY ADMINISTRATION OF MARYLAND

ROAD INVENTORY SHEET

Party Chief: BB
Recorder: NS
Helper:

80-123
Map No.:
ROCKVILLE

Road No.: MUN 1405
Road Name: HENSLOWE DRIVE
Sheet No.: 1 OF 1
Date: 3/13/84
County: MONTGOMERY
State Coordinates:

SEE NEW INVENTORY

385 AC
4-9-86
85-30

	D	E	
CUL	0	24	SAC
PT	0	16	
90° HENSLOWE CT. 80-124			
MUN 1407	0	12	
PC	0	06	26'I J-CC
HALESWORTH DR. 80-122			
MUN 1313	0	04	36'I J-CC
RICHIE PKWY			
MUN 2605	0	00	

S

PROPOSED

SHA 51.3-8
11-15-72

ROAD INVENTORY SHEET

Road No. _____
Road Name _____
Sheet No. _____
Date _____
County _____
State Coordinates _____

SHA 51.3-8
11-15-72

STATE HIGHWAY ADMINISTRATION OF MARYLAND

M10-18

ROAD INVENTORY SHEET

Party Chief T. LANDON
Recorder T. ABBOTT
Helper

Map No. 26

Road No. MUN. 1410
Road Name (HIGH ST.)
Sheet No. 1 OF
Date 1-30-74
County MONT.
State Coordinates

ROCKVILLE 76-75

SEE NEW INV. 61-84

E

CHURCH ST
0700
MUN
007

(MIDDLE ALLEY)
001 MUN 8032

20' I
26' CW

HUNGERFORD
MD
000
DR.
355

SHA 51.3-8
11-15-72

ROAD INVENTORY SHEET

Road No. _____
Road Name _____
Sheet No. _____
Date _____
County _____
State Coordinates _____

SHA 51.3-8
11-15-72

STATE HIGHWAY ADMINISTRATION OF MARYLAND

ROAD INVENTORY SHEET

Party Chief: T. LANDON
Recorder: M. ZALENSKI
Helper:

Map No. 26 80-135
BB REV. FR 3-10-81 ROCKVILLE

Road No. MUN. 1420
Road Name HIGHLAND AVE
Sheet No. 1 OF 1
Date 1-31-74
County MONT.
State Coordinates 76-30

BARRICADE
~~018~~ 016

20'E
26'CW

GRAND IN
MUN

AV.
~~013~~ 011 1255

26'I
C-C

E

~~004~~

~~MAPLE~~
MUN. 920 AVE

20'I
~~26'CW~~

S. STONESTREET
MUN

AVE
000 ~~2850~~ 2851

SHA 51.3-8
11-15-72

ROAD INVENTORY SHEET

Road No. _____
Road Name _____
Sheet No. _____
Date _____
County _____
State Coordinates _____

SHA 51.3-8
11-15-72

STATE HIGHWAY ADMINISTRATION OF MARYLAND

N. HORNERS LA.

ROAD INVENTORY SHEET

CO 4785

Party Chief T. LANDON
Recorder M. ZALENSKI
Helper

Map No. 26

Road No. MUN 1450
Road Name S. HORNERS LA
Sheet No. 1 OF 2
Date 1-31-74
County MONT.
State Coordinates

81-40/50

ROCKVILLE

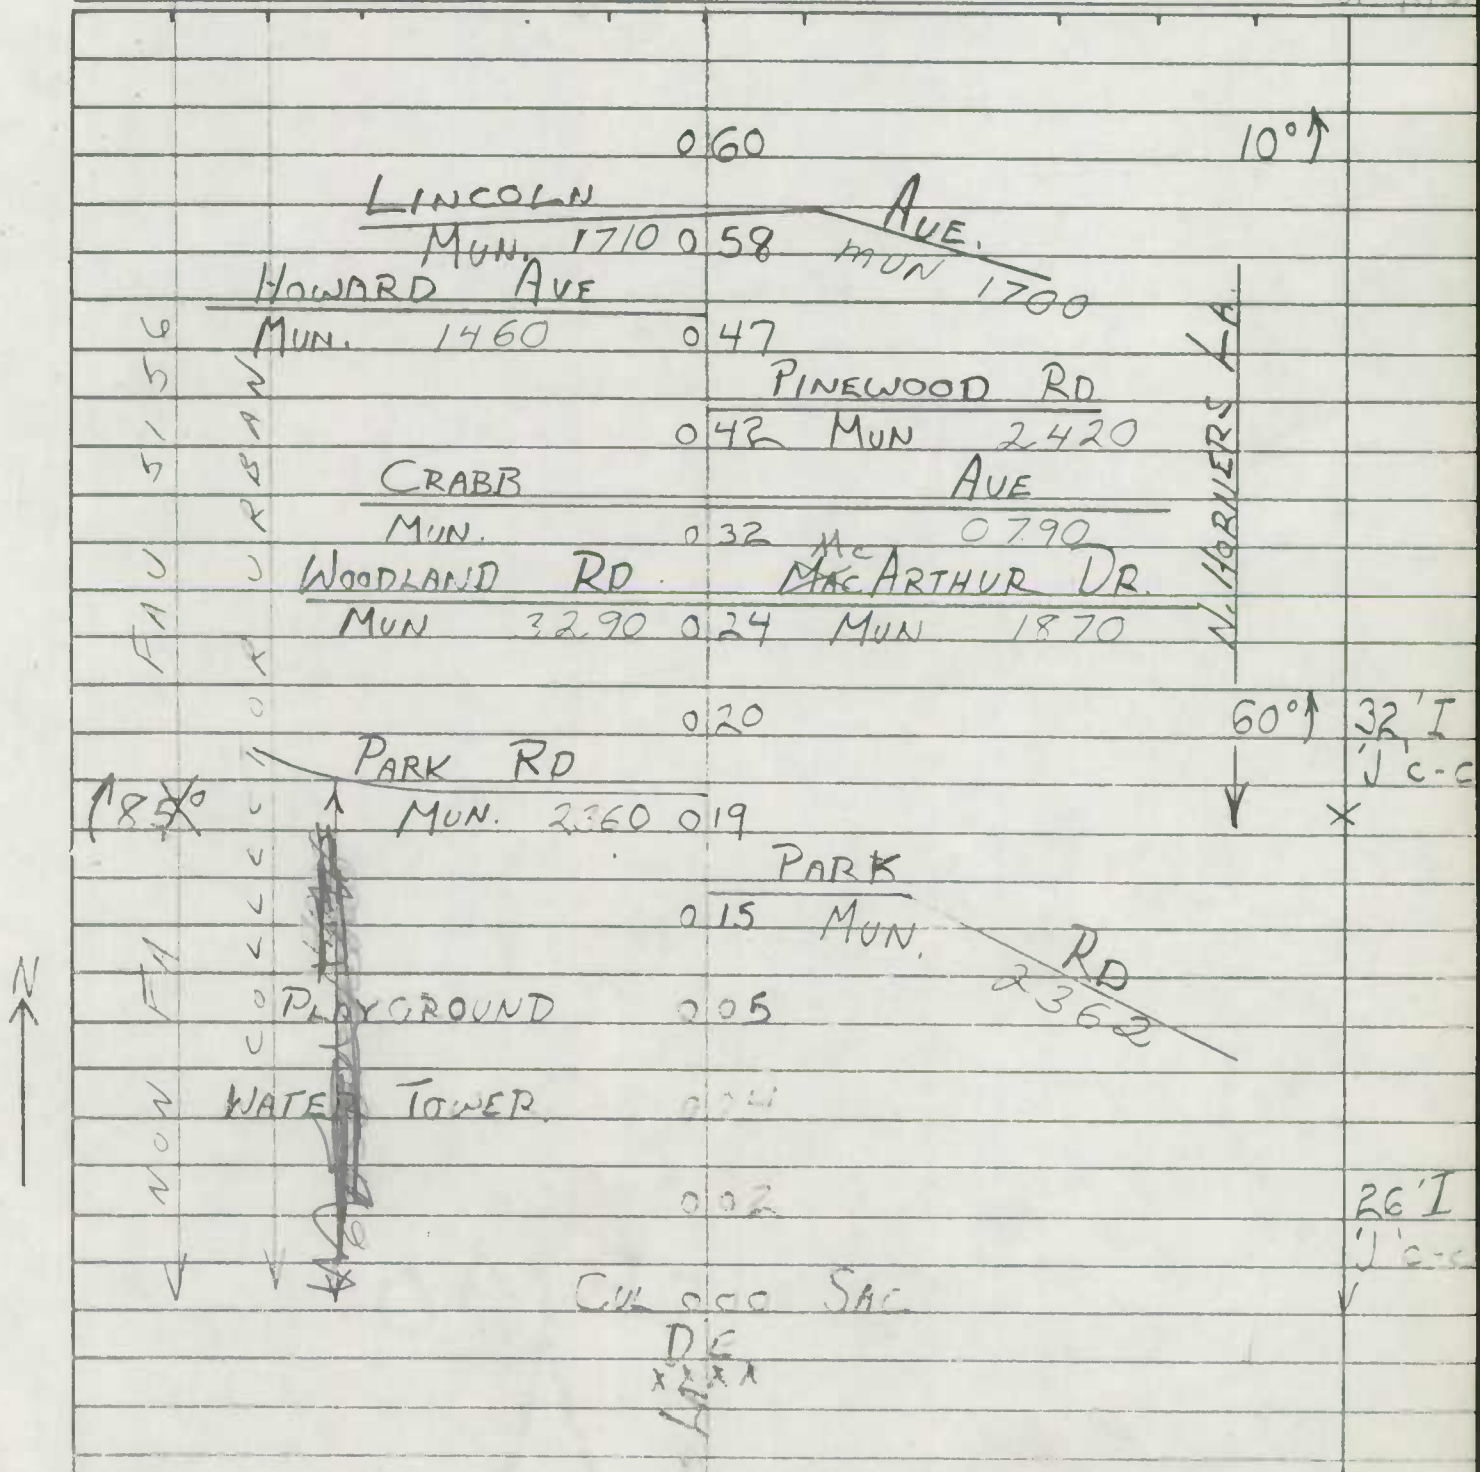

SHA 57.0-0
11-15-72

ROAD INVENTORY SHEET

CO 4785

Road No. MUN. 1450
Road Name S. HORNERS LA
Sheet No. 2 OF 2
Date 1-31-74
County MONT
State Coordinates

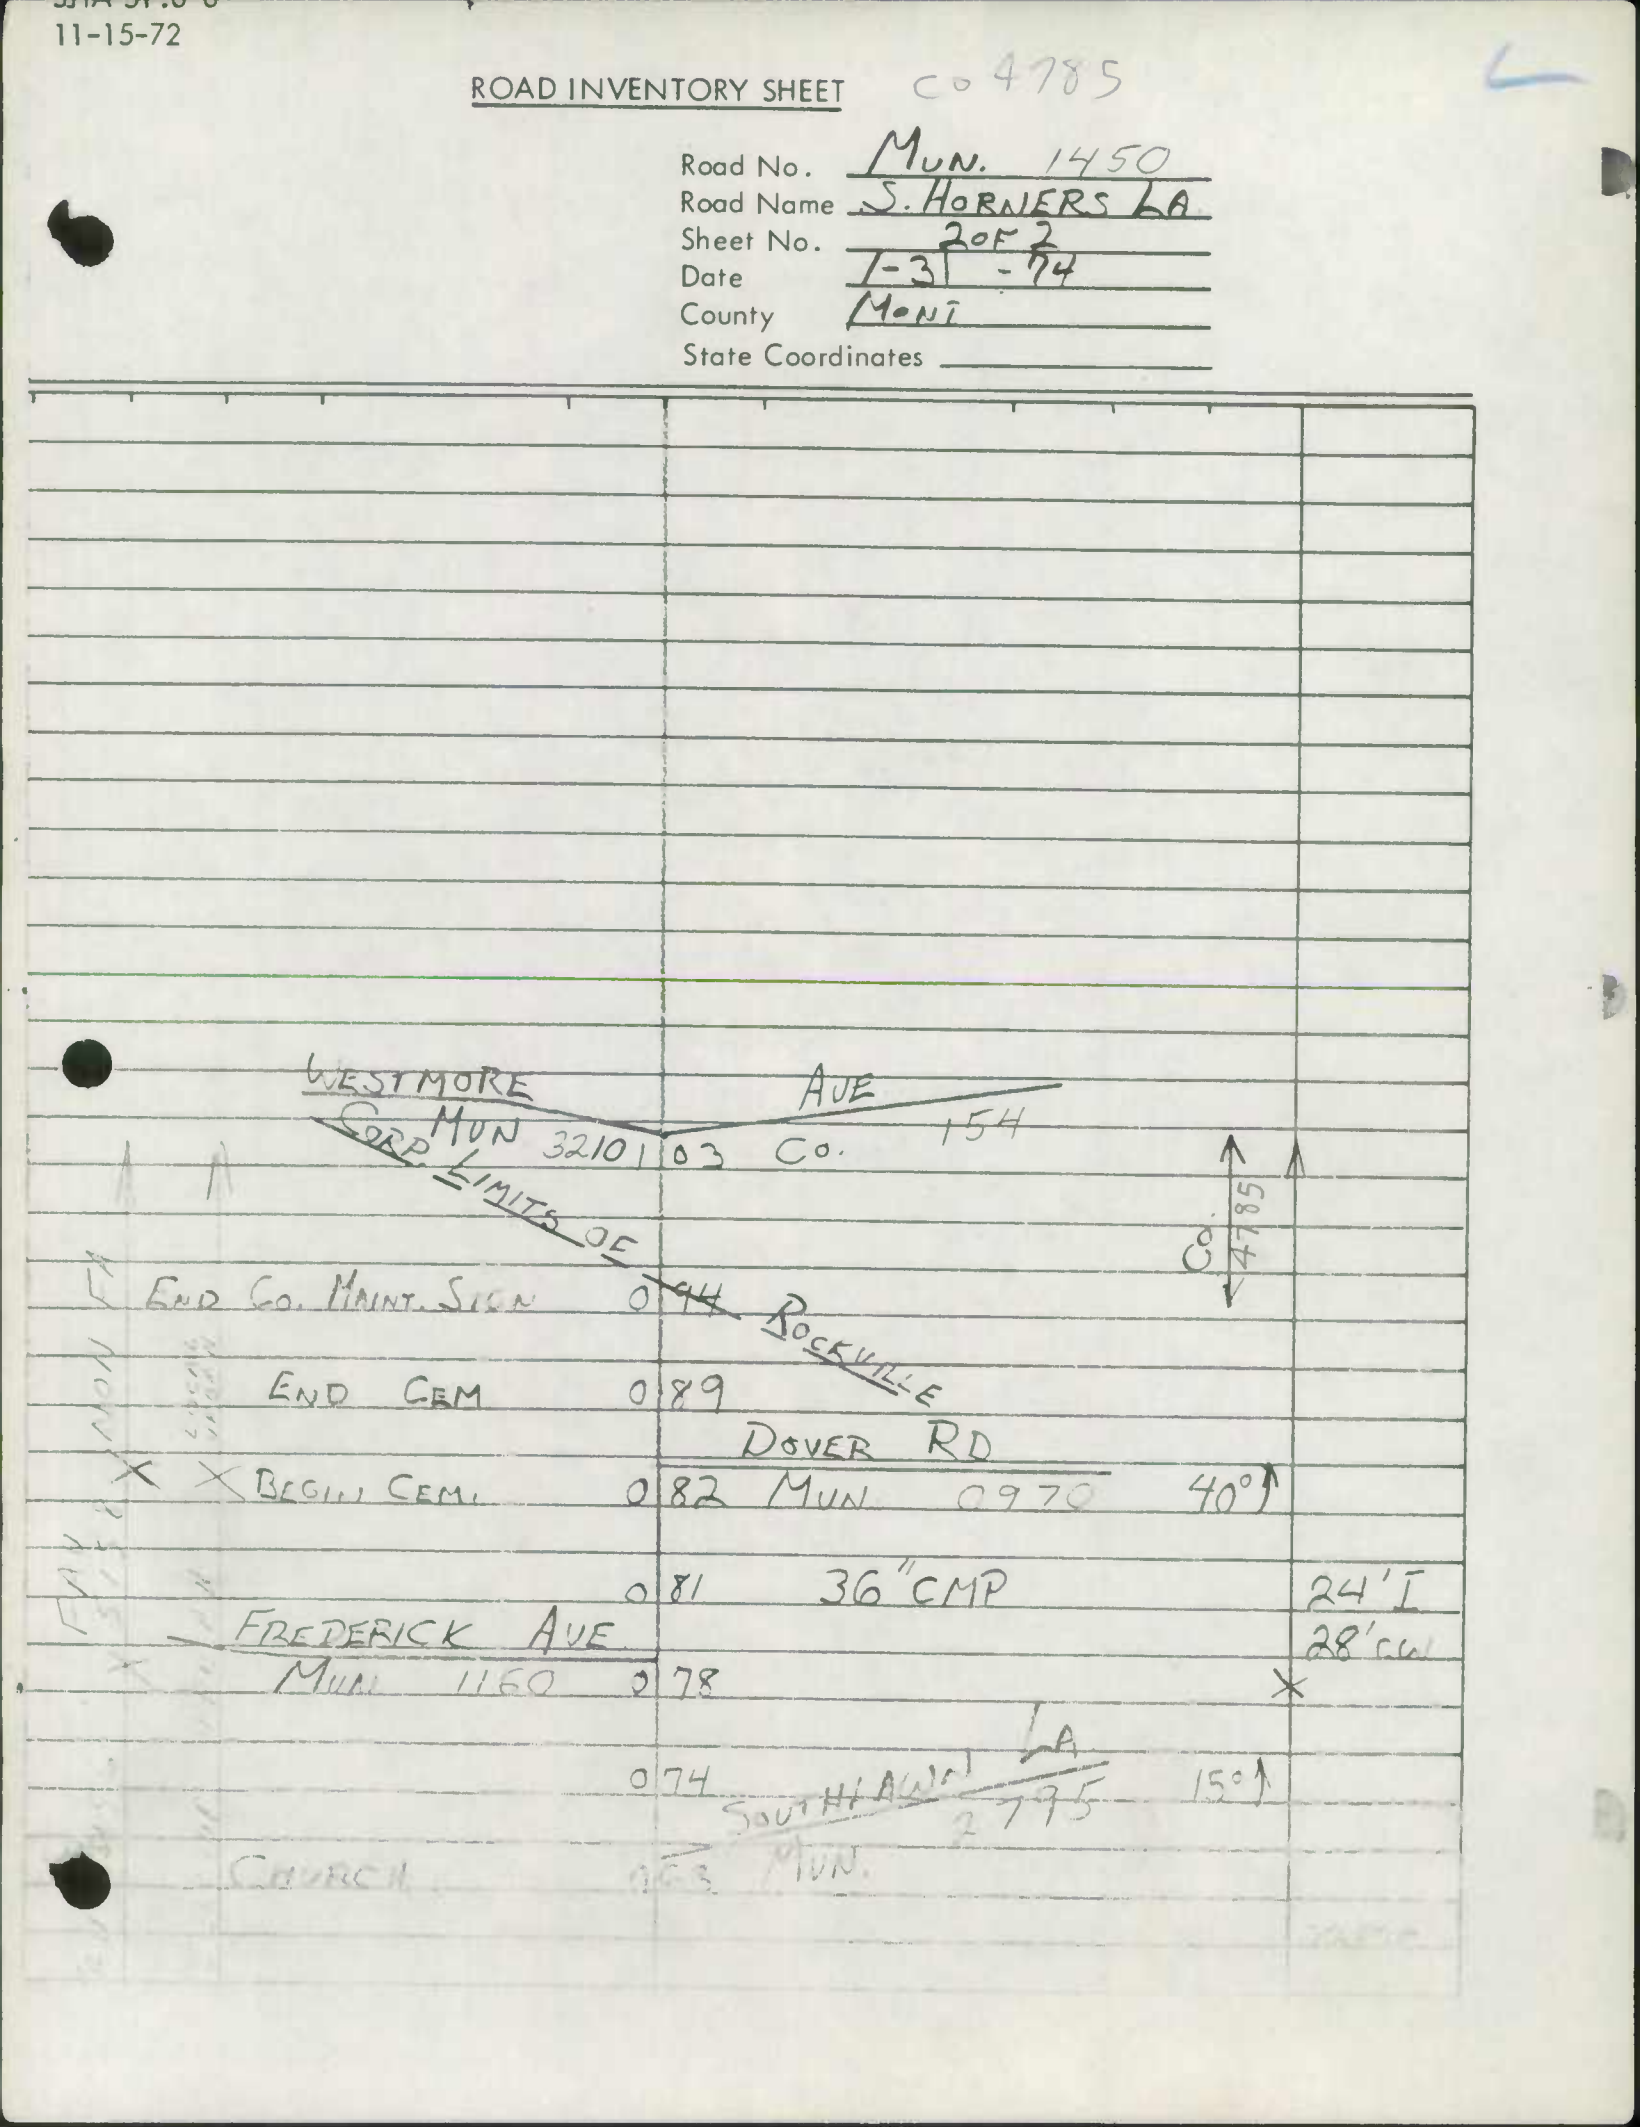

Form 5-HPS
(Revised 1961)

MARYLAND STATE ROADS COMMISSION
PLANNING AND PROGRAMMING DIVISION

S26130

NW1475

IN COOPERATION WITH
U.S. BUREAU OF PUBLIC ROADS

HURLEY AV.

ROAD NO. Mun.

BRIDGE SHEET

SHEET NO. 1-A

MAP # 26
749-457

PARTY NO.

DATE 12-13-73

COUNTY MONT.

RATED CAPACITY

FOR ALL STRUCTURES HAVING A TOTAL OPENING OF MORE THAN 20 FEET AS DEFINED IN NOTE 1.

ODOMETER READING 0.06 NAME OF STREAM, RAILROAD OR HIGHWAY CROSSED WATTS BRANCH

NUMBER OF RAILROAD TRACKS
KIND OF CROSSING (NOTE 2)

UNDERPASS-SIMPLE UNDERPASS-COMBINED (NOTE 3) OVERPASS BRIDGE OVER SYSTEM

DESCRIPTION

NUMBER OF SPANS	LENGTH EACH SPAN (NOTE 4)	TYPE (NOTE 5)
1	56'	I-BEAM

TOTAL LENGTH-ON LINE OF ROAD OVER-ALL (NOTE 6) 84'

MATERIAL
SUBSTRUCTURE CONC. & I-BEAM SUPERSTRUCTURE CONC. & STEEL RAILS
FLOOR CONC.

CLEARANCES
ROADWAY (NOTE 7) 36' I "J" c-c SIDEWALK WIDTHS: RIGHT 5' J LEFT 5' J
SURFACE OF ROAD TO STREAM BED 16' FOR OVERPASSES, SHOW DISTANCES TO TOP OF RAIL OR SURFACE OF LOWER ROAD. (NOTE 8)
SURFACE OF ROAD TO BOTTOM PORTAL (MINIMUM OVERHEAD CLEARANCE
CLEAR DISTANCE OF OPENING ABOVE STREAM BED 14' (WATERWAYS ONLY)
POSTED LOAD LIMITS BRIDGE NO. CONSTRUCTION DATE 1969

GENERAL CONDITION OF BRIDGE: CHECK IF GOOD, FAIR, OR POOR, DESCRIBE DEFECTS IF SERIOUS.

	GOOD	FAIR	POOR
SUPERSTRUCTURE	✓		
FLOOR	✓		
SUBSTRUCTURE	✓		

PAINT BADLY CORRODED OR RUSTED
TYPE OF PROTECTION FOR DRAWBRIDGES (NOTE9)

(NOTES ON REVERSE SIDE)

S26130

Notes:

1. In agreement with Federal-aid standards, a bridge is defined as a structure including supports erected over a depression or an obstruction, as water, highway, or railway, and having a track or passageway for carrying traffic or other moving loads, and having a length measured along the center of roadway of more than 20 feet between undercoping of abutments or spring lines of arches, or extreme ends of openings for multiple boxes and pipes, where the clear distance between openings is less than half of the smaller contiguous opening.

2. Show kind of crossing by checking descriptive item applicable. For multiple-span bridges give complete information on each span including approach spans. Indicate on leg sheet the odometer reading, position, and angle of skew of structure with respect to center line of road and by arrow the direction of stream flow.

3. Give information on the span over the highway only.

4. For span length use center to center of bearings, otherwise the clear opening. Skew bridges will be measured along center line of road. See Note 1.

5. Show general type such as: Trestle, Truss, Girder, I-Beam, Rigid Frame, Arch, Slab, Suspension, or Covered Bridge. See illustrations attached. Describe draw spans by classifications listed in Article X, Section 2 of Manual.

6. The length of a bridge structure is the over-all length measured along the line of survey stationing back to back of back-walls of abutments, if present, otherwise end to end of bridge floor, but in no case less than the total clear opening of the structure.

7. Give minimum lateral clearance. Where traffic lanes are separated by bridge numbers, show clearance width of each lane separately. Special conditions should be explained by notes.

8. In case of overhead bracing or arch construction, measurement shall be made to the lowest point above the road surface.

9. Use classification listed on RR crossing sheets. Form 4 HPS.

Remarks: _____

A rearrangement of the form similar to that shown on the attachment may be used to provide space for coding.

SHA 51.3-8
11-15-72

STATE HIGHWAY ADMINISTRATION OF MARYLAND

ROAD INVENTORY SHEET MU 1480

86-171 CA JE 4-6-71

Party Chief MZ
Recorder JE
Helper

Road No. Co 4132
Road Name EAST JEFFERSON ST
Sheet No. 1 of 2
Date 4-11-71
County MONT
State Coordinates

83-EXTRA #1 3/7/84 BB-NS

Map No. 26 ROCKVILLE
78-3E

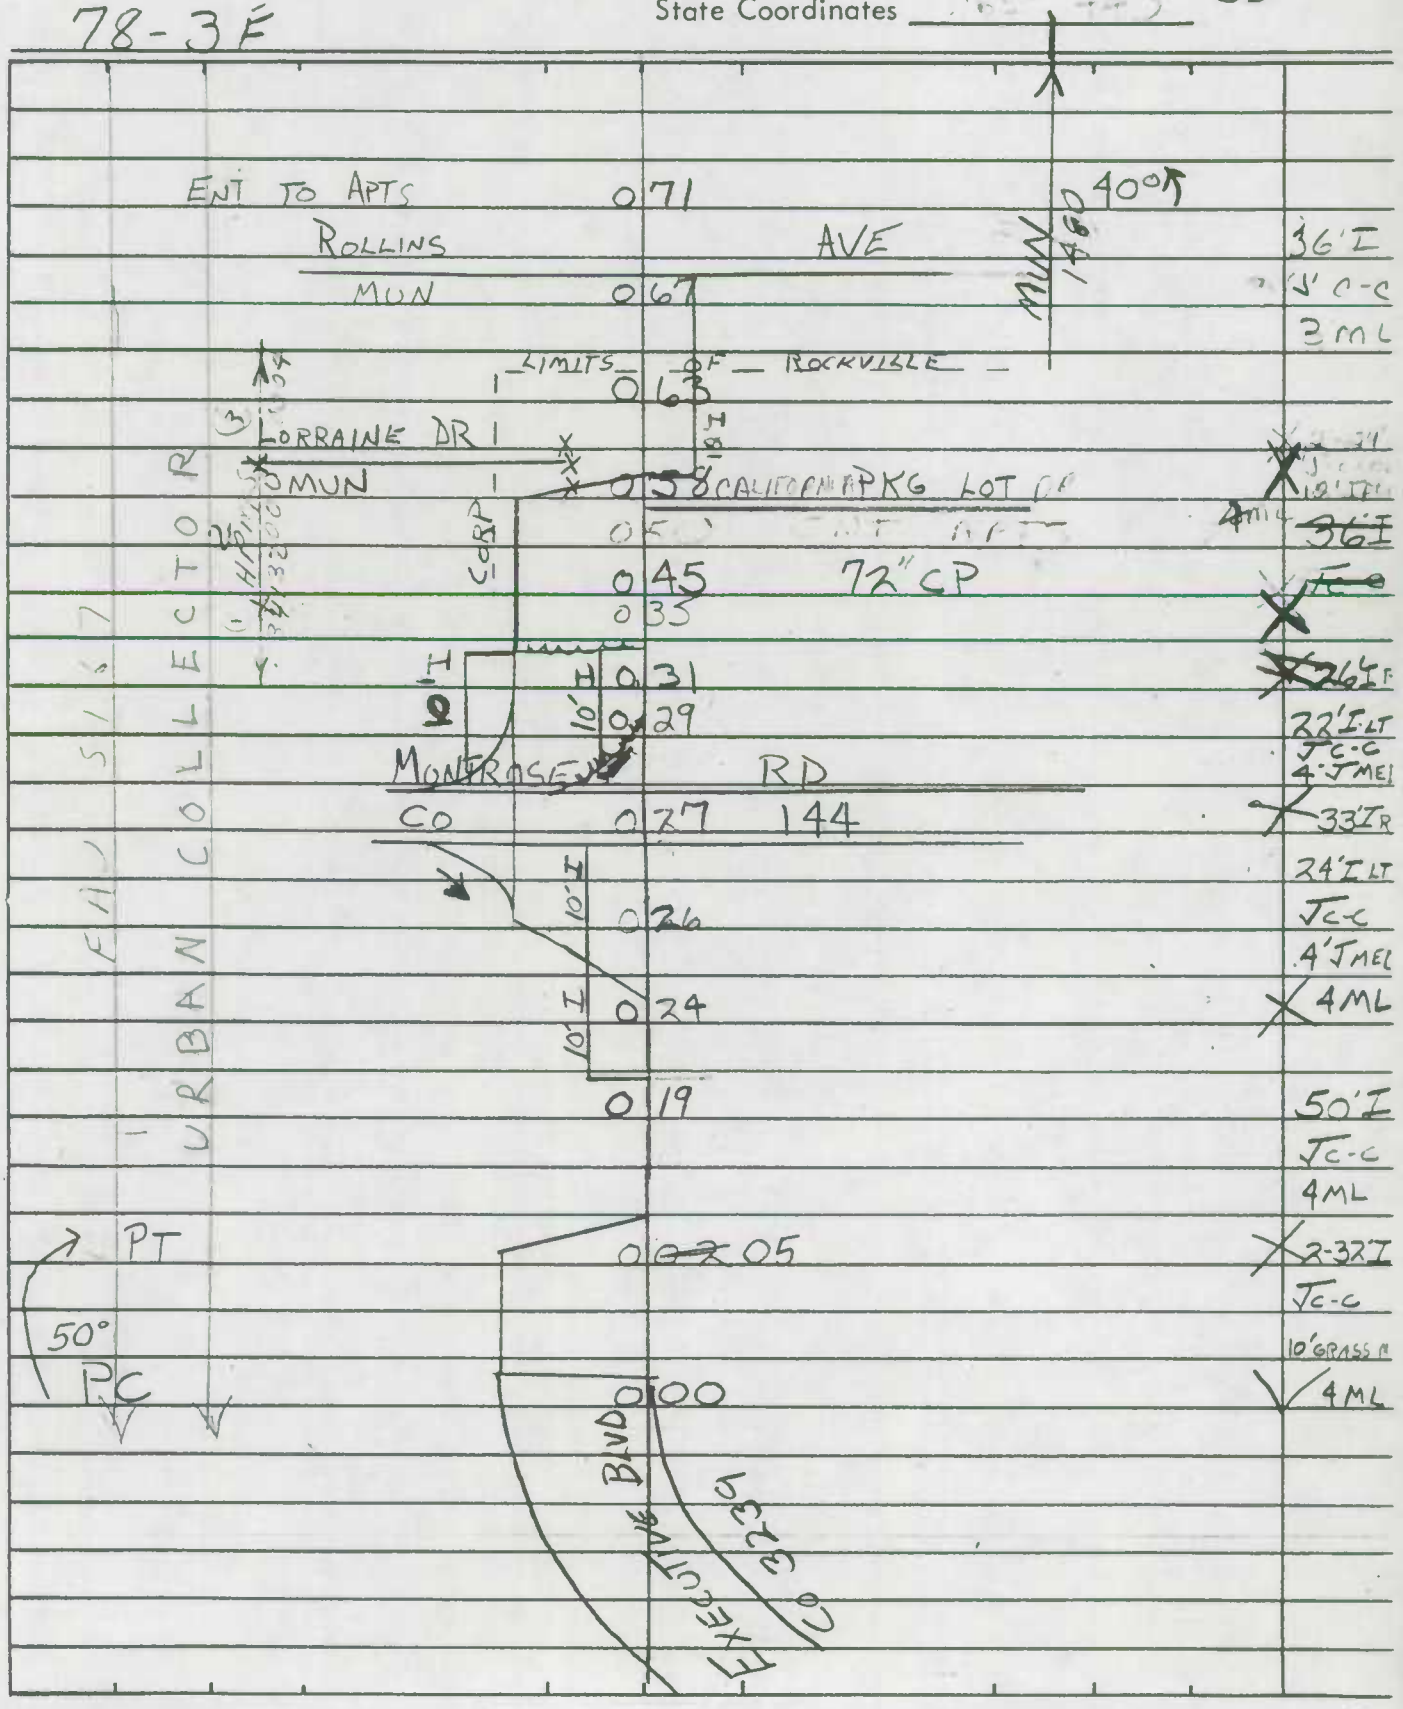

SHA 51.3-8
11-15-72

NEW INV.

ROAD INVENTORY SHEET

Road No. Co 4132
Road Name EAST JEFFERSON ST
Sheet No. 2 of 2
Date 4-11-79
County MONT
State Coordinates

BARRICADE

1 12

1 11 60" CMP

NON FA URBAN MAJ COLL — ENT TO APTS 1 06

ENT TO APTS 1 02

CONGRESSIONAL MUN 0 98 — FA 1110

EAU 5167 URBAN COLLECTOR — ENT TO APTS 0 91

ENT TO APTS 0 84 PKG LOT

MUN 1.4 mi

0 80 HALPINE RD MUN 1332

0 77 PKG LOT

SHA 51.3-8
11-15-72

STATE HIGHWAY ADMINISTRATION OF MARYLAND

ROAD INVENTORY SHEET

MU 1480 New INV. L

86-171

Party Chief MZ
Recorder JE
Helper

Road No. Co 4132
Road Name EAST JEFFERSON ST
Sheet No. 1 of 2
Date 4-11-71
County MONT
State Coordinates

Map No. 26D ROCKVILLE
78-13F

80-705

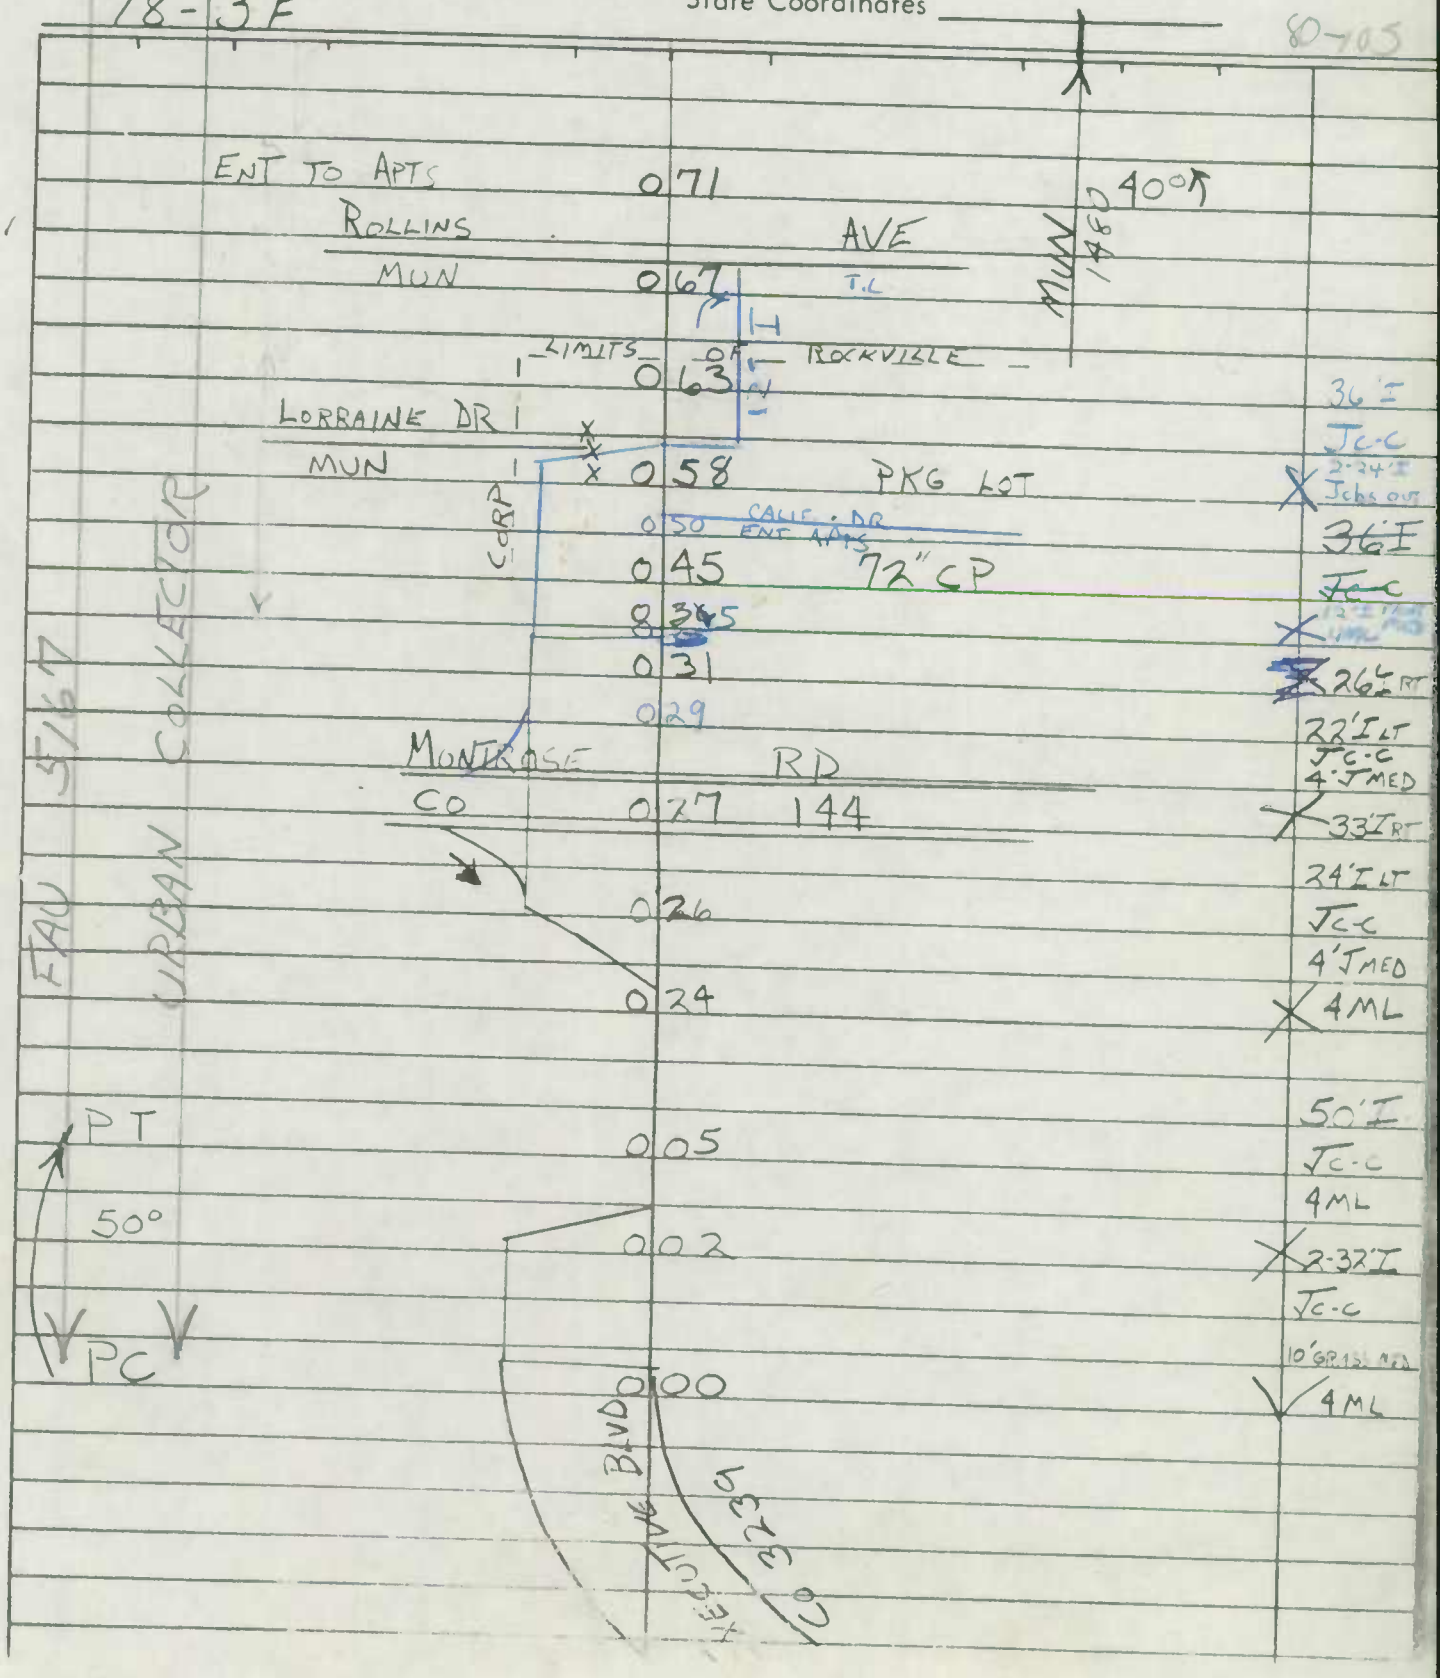

SHA 51.3-8
11-15-72

STATE HIGHWAY ADMINISTRATION OF MARYLAND

95-5
3-5-96
GD/TM

ROAD INVENTORY SHEET

Party Chief T. LANDON
Recorder I. ABBOTT
Helper

Map No. 26
ROCKVILLE

Road No. MUN. 1482
Road Name E. JEFFERSON ST
Sheet No. 1 OF 1
Date 1-3-74
County MONT.
State Coordinates 81-78 EXTRA A/T 1-28-80

SEE NEW INV
95-5
3-5-96
GD/TM

CORRECTIONS TO T.H. EXIT

RITCHIE PKWY.
MUN. 0 5014 2692 SS

PACA PL.
0 X306 MUN. 2340

MT. VERNON PL.
MUN. 0 3600 2180 SS

RICHARD MONTGOMERY DR.
MUN. 3540

PARK AVE.
MUN. 2350

S

SHA 51.3-8
11-15-72

ROAD INVENTORY SHEET

Road No. _____
Road Name _____
Sheet No. _____
Date _____
County _____
State Coordinates _____

SHA 51.3-8
11-15-72

STATE HIGHWAY ADMINISTRATION OF MARYLAND LINCOLN ST. M10-76 L

ROAD INVENTORY SHEET

1700

Party Chief I. LANDON
Recorder M. ZALENSKI
Helper

Road No. MUN. 1710
Road Name LINCOLN AVE
Sheet No. 1 OF 1
Date 1-31-73
County MONT.
State Coordinates

Map No. 26 75-31 76-59
ROCKVILLE

CM A/T R3-24

ALLAN RD 0094

PT 90° PRC

0 98
0 94
0 90

PRC 40° PC

25°

0 85

NEAL MUN 0 82 DR 2200

FIRST MUN 0 77 ST. 1110

SOUTH LAWN MIDDLE SCH. PROPERTY

0 75

PINEWOOD MUN 0 54 RD 2420

BURGUNDY MUN 0460 DR

0 38
0 35

30°

N. HORNERS MUN. 0 33 LA. 1450

ENT TO LINCOLN PARK 0 28

0 17

DOUGLASS AVE MUN 0960 0 11

N. STONESTREET MUN 0 00 AVE 2850

MUN 1710

LINCOLN ST

30°

MUN 1700

10°

26'I
J'c-c

X 28'I
J-curb lt.
36'cw

26'I
J'c-c

E

SHA 51.3-8
11-15-72

ROAD INVENTORY SHEET

Road No. _____
Road Name _____
Sheet No. _____
Date _____
County _____
State Coordinates _____

SHA 51.3-8
11-15-72

STATE HIGHWAY ADMINISTRATION OF MARYLAND

ROAD INVENTORY SHEET

Party Chief W. DOMBROSKI
Recorder M. ZALENSKI
Helper

Map No. 26

Road No. MUN. 1895
Road Name (MALL TURNAROUND)
Sheet No. 1 OF 1
Date 3-8-76
County MONT.
State Coordinates

ROCKVILLE

ABAN.

DUE TO

CONST

DE
CUL 004 SAC

W

52' I
JC-C

MONROE ST
MUN 2140 000

U
T

SHA 51.3-8
11-15-72

ROAD INVENTORY SHEET

Road No. _____
Road Name _____
Sheet No. _____
Date _____
County _____
State Coordinates _____

STATE HIGHWAY ADMINISTRATION OF MARYLAND

ROAD INVENTORY SHEET

T. LANDON
M. ZALENSKI

Map No. 26

ROCKVILLE

Road No. MUN. 1920
Road Name MAPLE AVE
Sheet No. 1 OF 1
Date 1-31-74
County MONT
State Coordinates

ABAN.
NOW PART OF
METRO PARK + RIDE
LOT 3-10-81
80-135

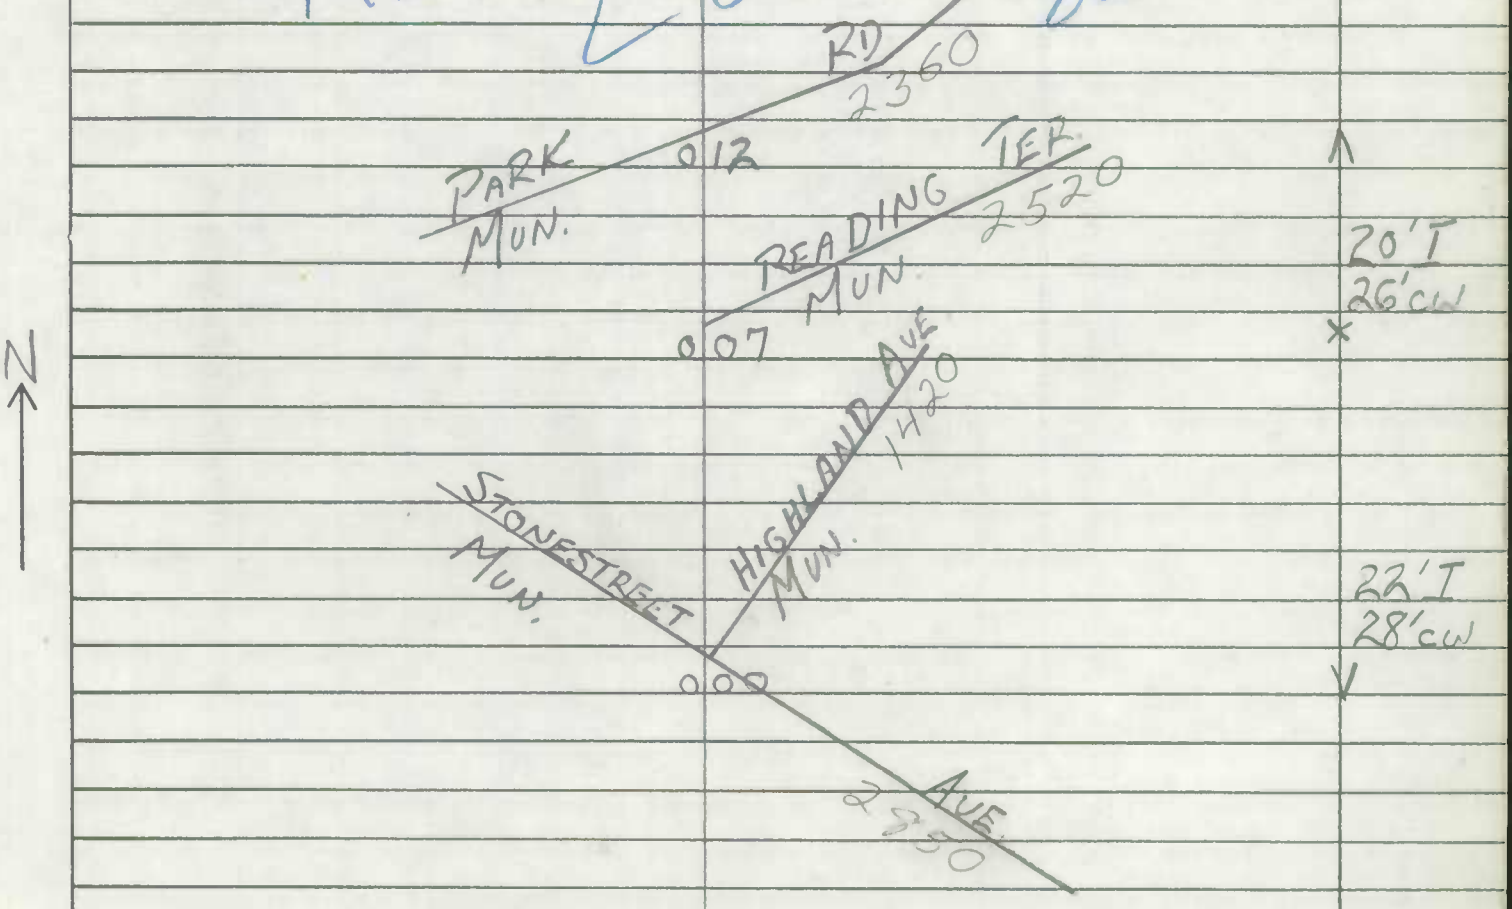

SHA 51.3-8
11-15-72

ROAD INVENTORY SHEET

Road No. _____
Road Name _____
Sheet No. _____
Date _____
County _____
State Coordinates _____

SHA 51.3-8
11-15-72

STATE HIGHWAY ADMINISTRATION OF MARYLAND

ROAD INVENTORY SHEET

Party Chief I. LANDON
Recorder I. ABBOTT
Helper

Map No. 26

Road No. MUN. 2012
Road Name MARYLAND AVE
Sheet No. 1 OF 1
Date 1-3-74
County MONT.
State Coordinates

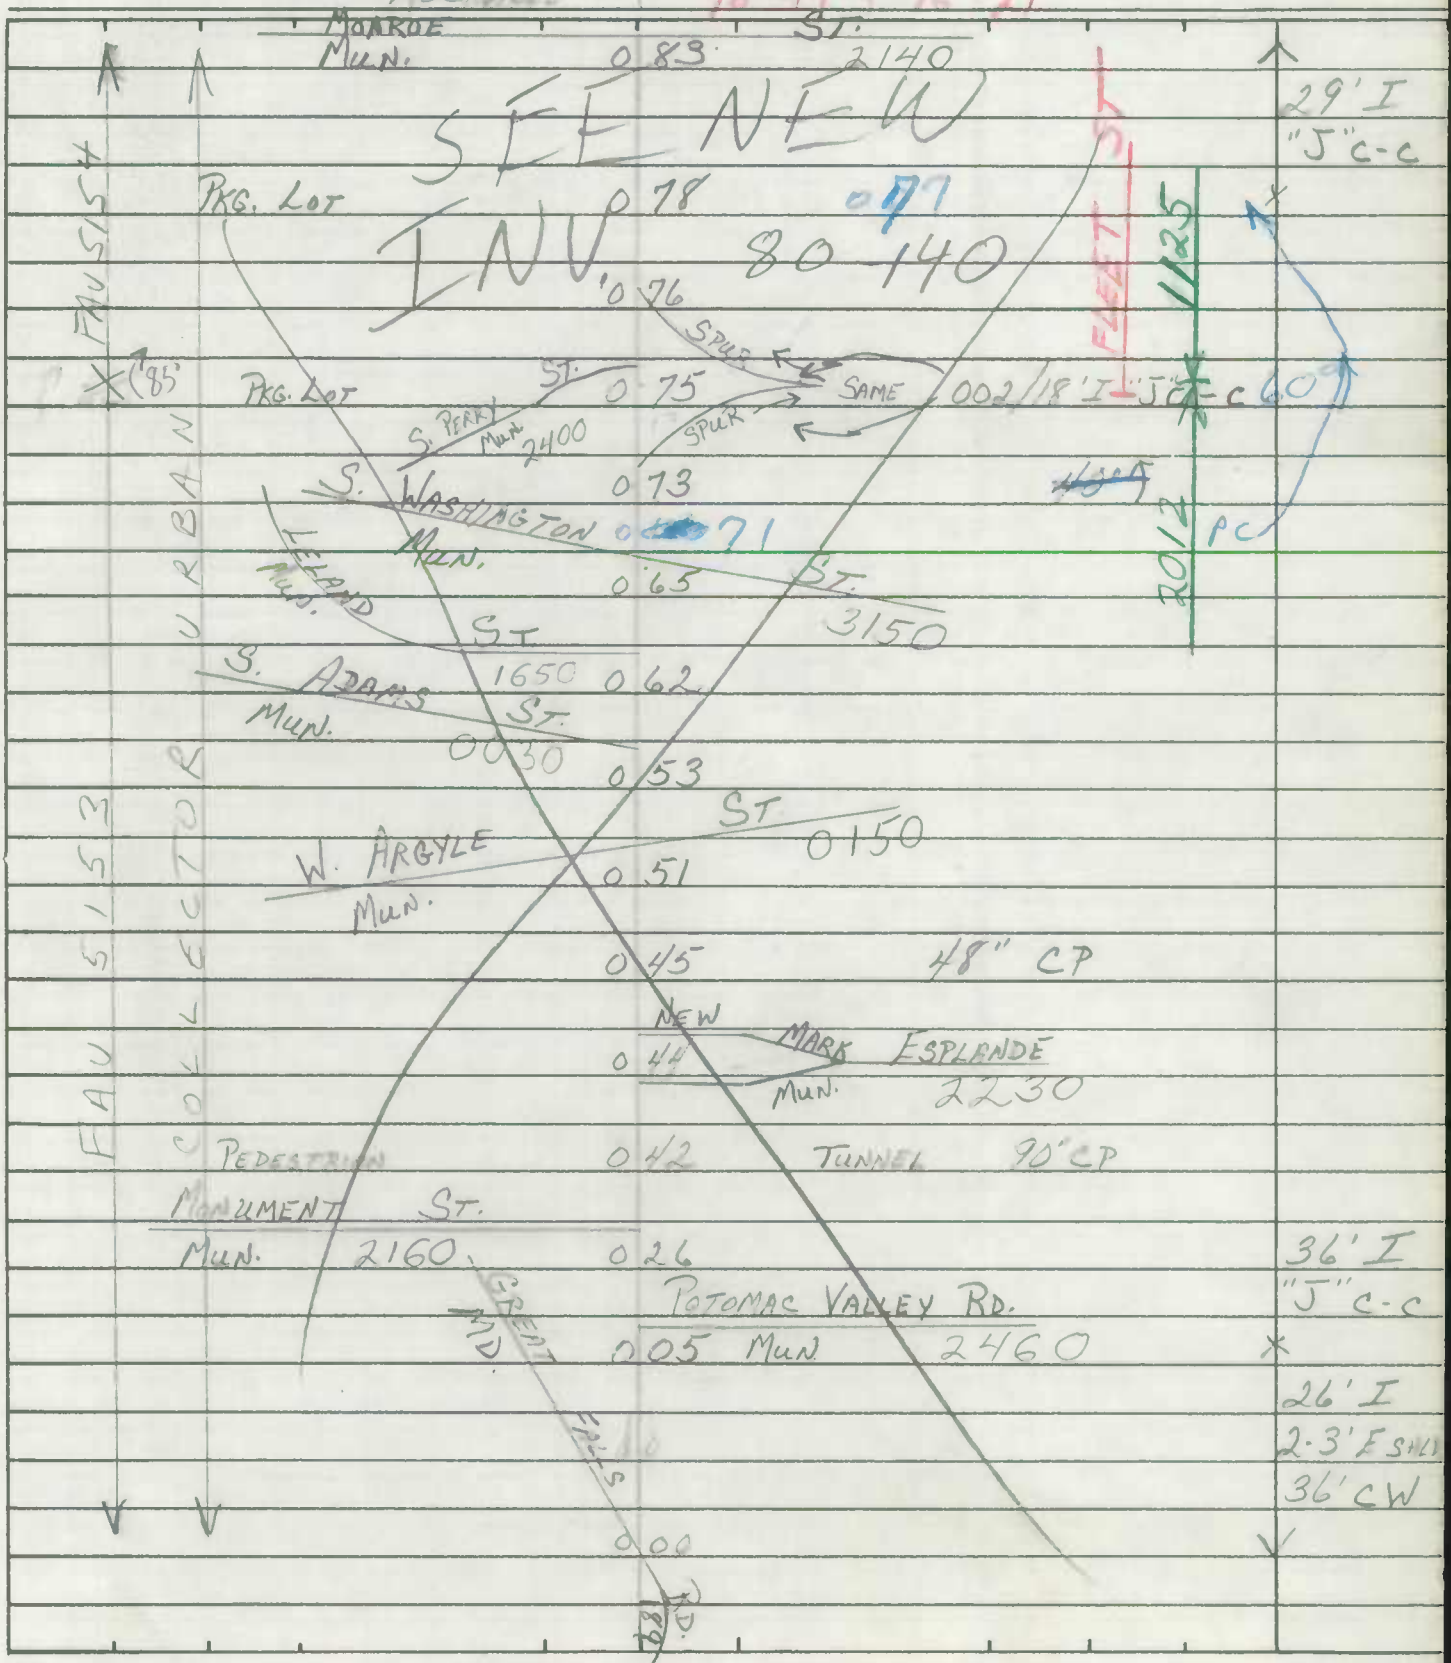

SHA 51.3-8
11-15-72

ROAD INVENTORY SHEET

Road No. _____
Road Name _____
Sheet No. _____
Date _____
County _____
State Coordinates _____

SHA 51.3-8
11-15-72

STATE HIGHWAY ADMINISTRATION OF MARYLAND

89-23
GD/CG
3-27-90

ROAD INVENTORY SHEET

Party Chief BB
Recorder FR
Helper

Map No. 26 ROCKVILLE
80-140

Road No. MU 2012
Road Name MARYLAND AVE
Sheet No. 1 OF 2
Date 3-9-81
County MONT.
State Coordinates

81-37

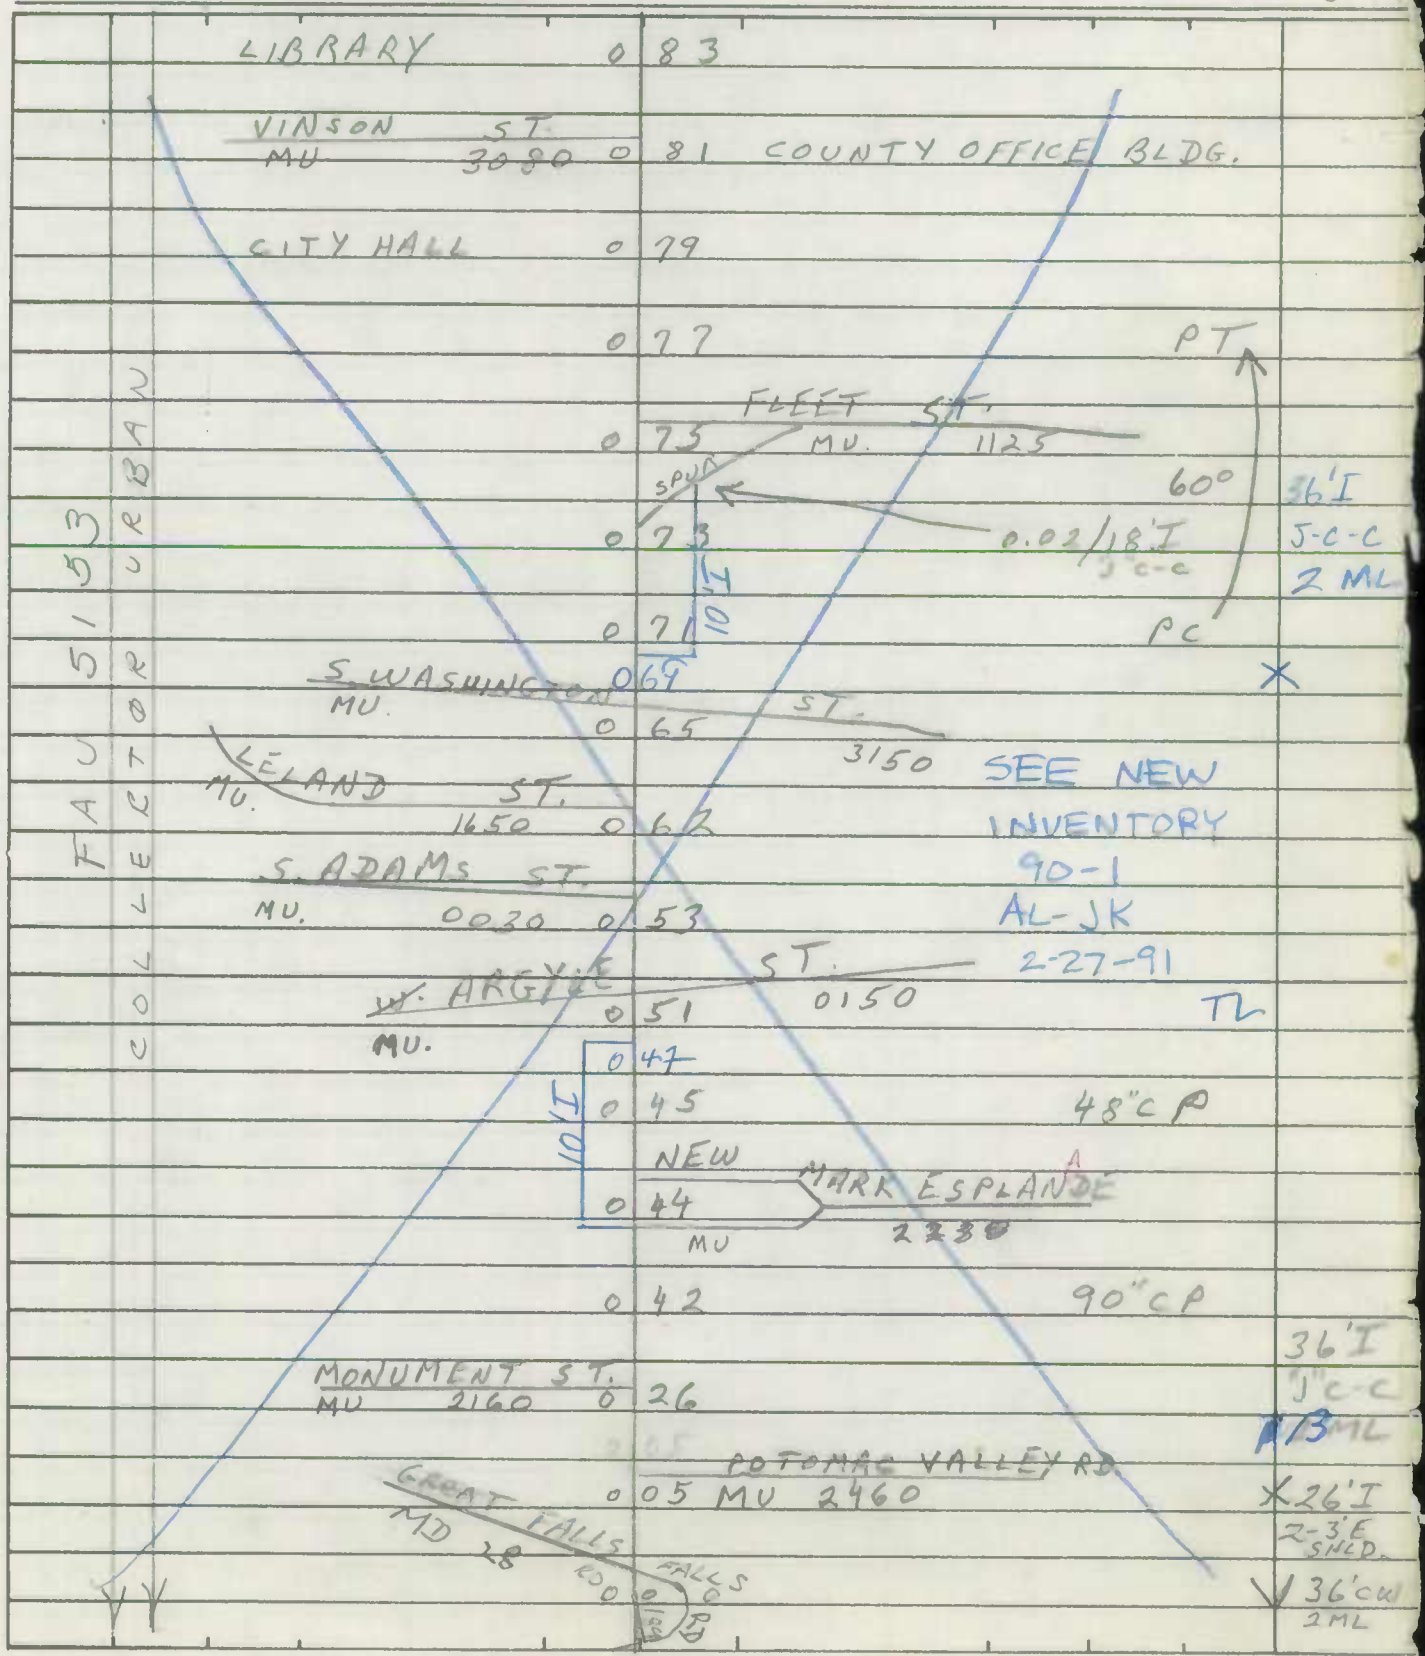

SHA 51.3-8
11-15-72

ROAD INVENTORY SHEET

Road No. MU. 2012
Road Name MARYLAND AVE.
Sheet No. 2 OF 2
Date 3-9-81
County MONT.
State Coordinates

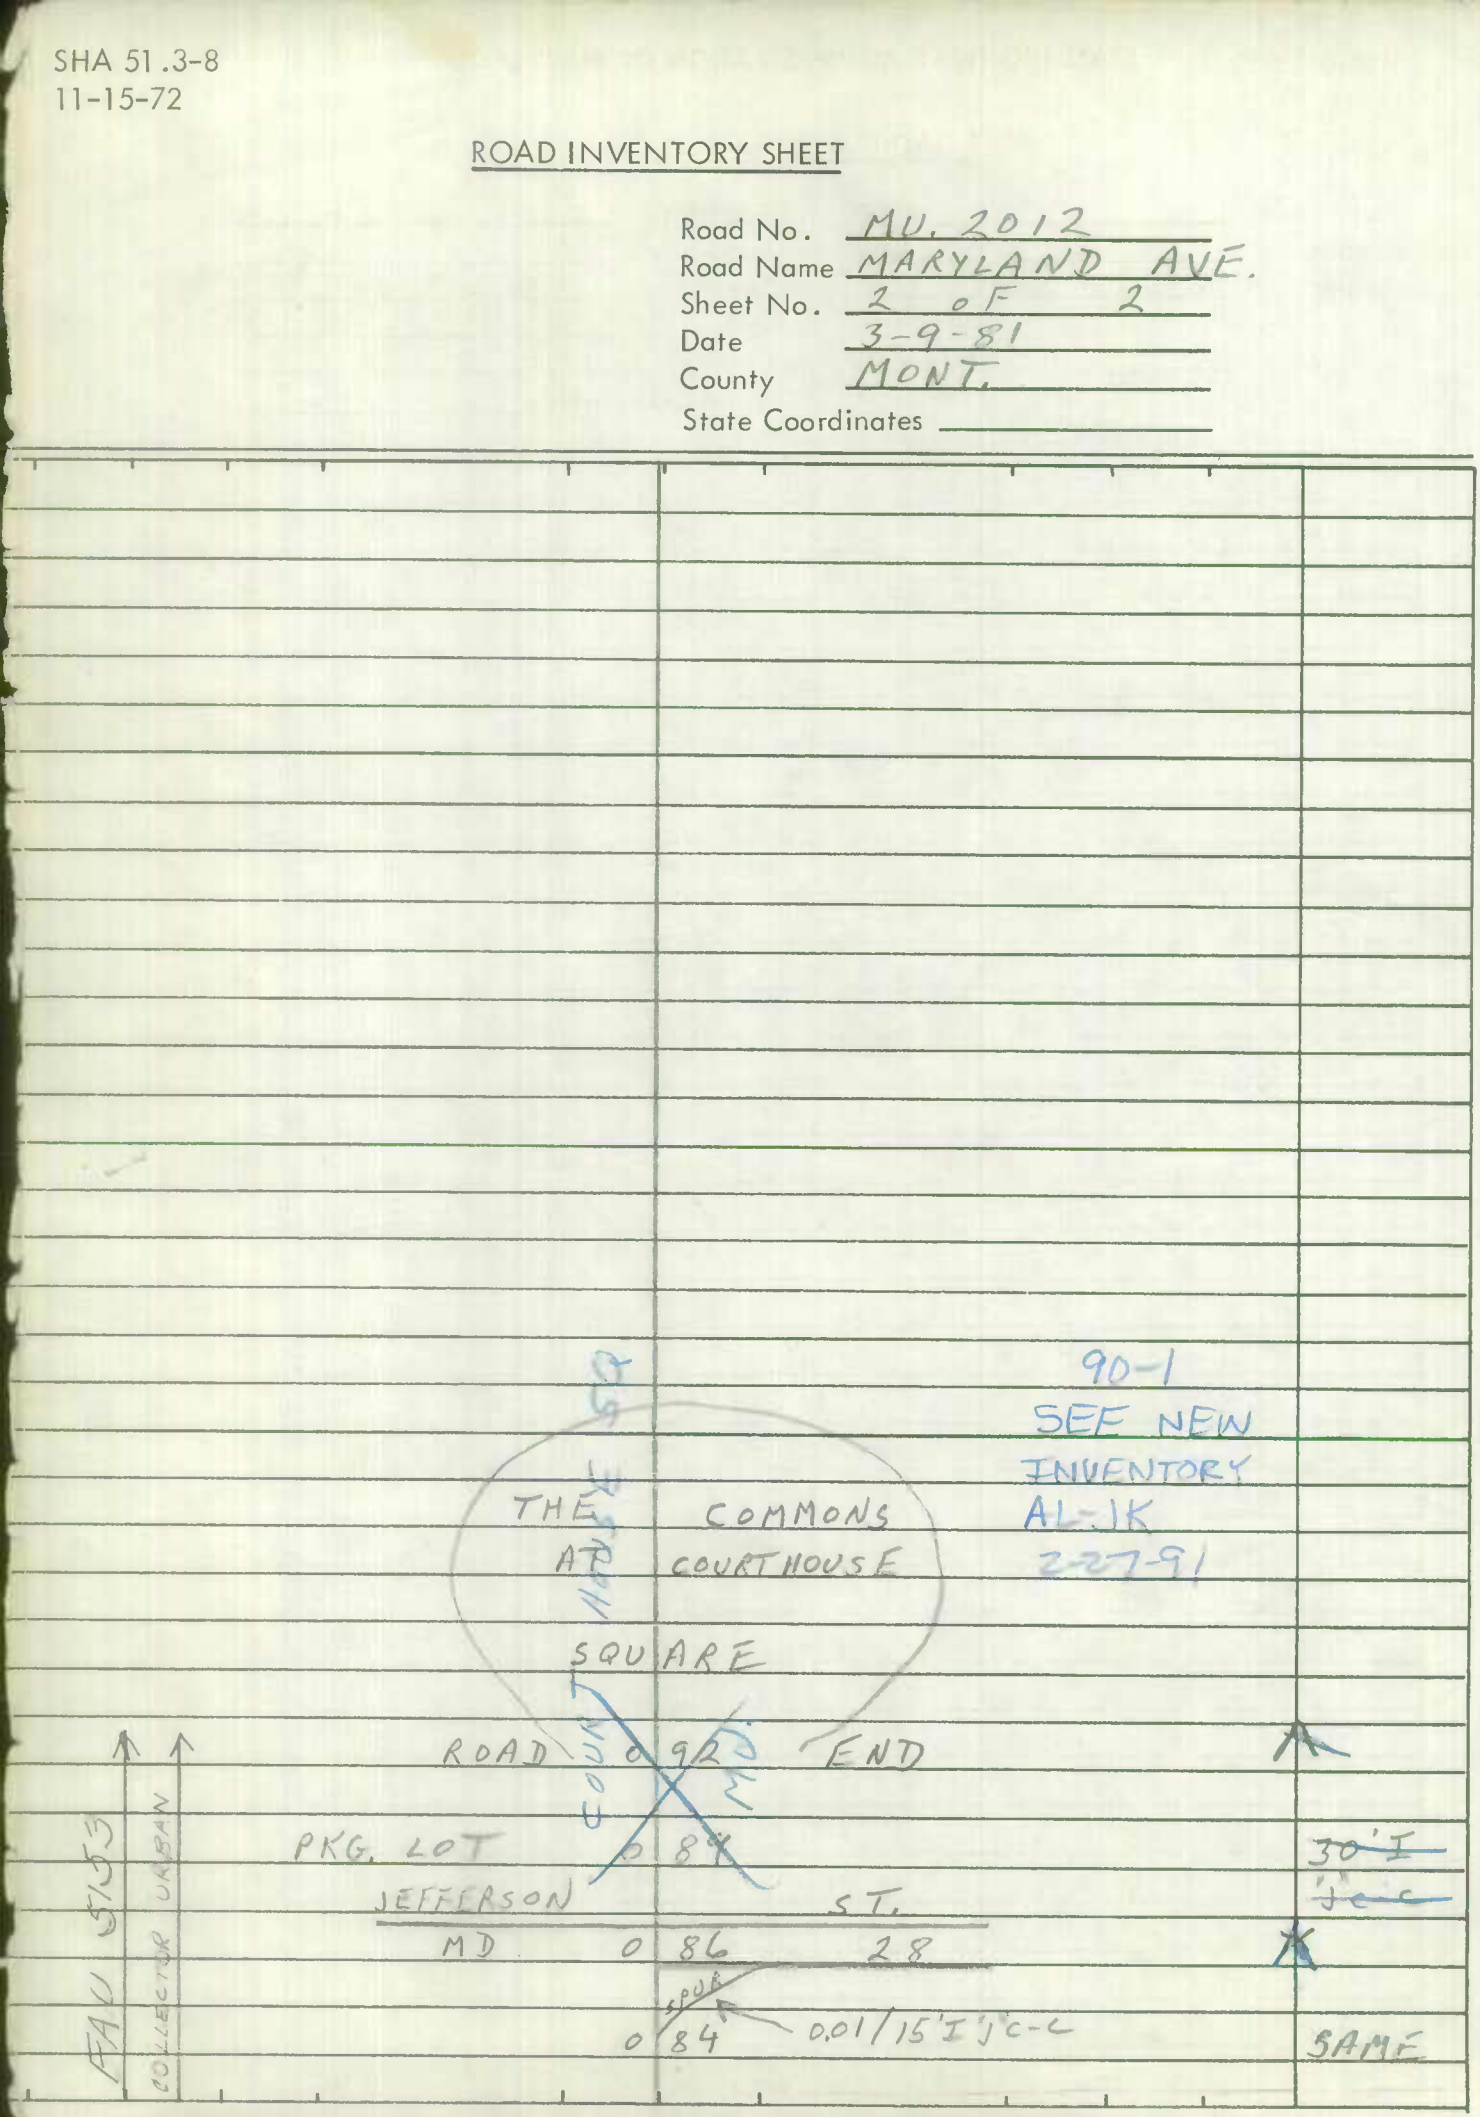

SHA 51.3-8
11-15-72

STATE HIGHWAY ADMINISTRATION OF MARYLAND

ROAD INVENTORY SHEET

Party Chief C. MURRAY
Recorder
Helper

Map No.

Road No. MUN 2015
Road Name MASON DRIVE
Sheet No. 1 OF 1
Date APRIL 26, 1985
County MONTGOMERY (ROCKVILLE)
State Coordinates

IN OFFICE INVENTORY

84-38

NOT BUILT

N

ROCKVILLE

ROAD 40 14 END

CORP LMTS

20'I
25'CW

SOUTHLAWN
MUN
000
LANE
2795

SHA 51.3-8
11-15-72

ROAD INVENTORY SHEET

Road No. _____
Road Name _____
Sheet No. _____
Date _____
County _____
State Coordinates _____

SHA 51.3-8
11-15-72

STATE HIGHWAY ADMINISTRATION OF MARYLAND

ROAD INVENTORY SHEET

Party Chief T. LANDON
Recorder T. ABBOTT
Helper

Map No. 26
FR JE 3-11-80
79-48 EXTRA ROCKVILLE

Road No. MUN. 2270
Road Name NORTH ST.
Sheet No. 1 OF 1
Date 1-2-74
County MONT.
State Coordinates 756-458

	ROAD END	
	0 ~~23~~ 20	
	MC LANE CT.	
	0 ~~47~~ MUN. 2040 0	26' I
N. VAN BUREN ST.	~~17~~ 09	"J" C-C
MUN. 3000	0 ~~13~~	X 10' I
	0 00	~~12' E~~
N. WASHINGTON ST.	ROAD X X X END	~~16' CW~~
MUN.	~~0 00~~ 3150	

SHA 51.3-8
11-15-72

ROAD INVENTORY SHEET

Road No. _____
Road Name _____
Sheet No. _____
Date _____
County _____
State Coordinates _____

SHA 51.3-8
11-15-72

STATE HIGHWAY ADMINISTRATION OF MARYLAND

ROAD INVENTORY SHEET

Party Chief W. DOMBROSKI
Recorder M. ZALENSKI
Helper

Map No. 26 74-40
ROCKVILLE

Road No. MUN 2273
Road Name NORTH COMMONS WAY
Sheet No. 1 OF 1
Date 3-8-76
County MONT.
State Coordinates

NOW COMBINED W/ CO 4196
IMP # 2001 MILEX # 3
01-31-02
SS/WP

NORTH COMMONS WAY
CO. 4196

XXX
ROAD 0.14 END
26' I
J c-c

PT
30°
PRC

0.12 32
X

SUNRISE
MUN

0.07 37
36' I
J c-c

PRC
30°
PC

PR
2863

0.05 39
X

0.03 41
26' I
J c-c

COL
D

0.00 44 SAC
E

S

SHA 51.3-8
11-15-72

ROAD INVENTORY SHEET

Road No. _____
Road Name _____
Sheet No. _____
Date _____
County _____
State Coordinates _____

SHA 51.3-8
11-15-72

STATE HIGHWAY ADMINISTRATION OF MARYLAND

ROAD INVENTORY SHEET

Party Chief I. Landon
Recorder E. Rhodes
Helper

Map No. Rockville 77-34
78-34 & 38 MZ JE

Road No. mun. 2285
Road Name Oakenshield DR
Sheet No. 1 of
Date 2-27-78
County Mont.
State Coordinates

ROAD END
0 38

SCOTCH MIST CT
MU 2689 0 36

~~ROAD 0 15 END~~

TWIN OAKS DR.
MUN ~~0 12~~ 2975
0 22

EAGLE BROOK CT
~~0 08~~ MUN. 0993
0 18

LOCKS POND
~~0 02~~ MUN. 1726 CT.)
0 12

~~ROAD 0 00 END~~

ARLIVE CT
MU 155 0 03

ROAD 0 00 END
X X Y

PT
40°
PC

15°

26'I
1"C-C

N

SHA 51.3-8
11-15-72

STATE HIGHWAY ADMINISTRATION OF MARYLAND

ROAD INVENTORY SHEET

Party Chief T. LANDON
Recorder M. ZALENSKI
Helper

Map No. 26
ROCKVILLE

Road No. MUN 2360
Road Name PARK RD.
Sheet No. 1 OF 1
Date 1-31-74
County MONT.
State Coordinates

76-31

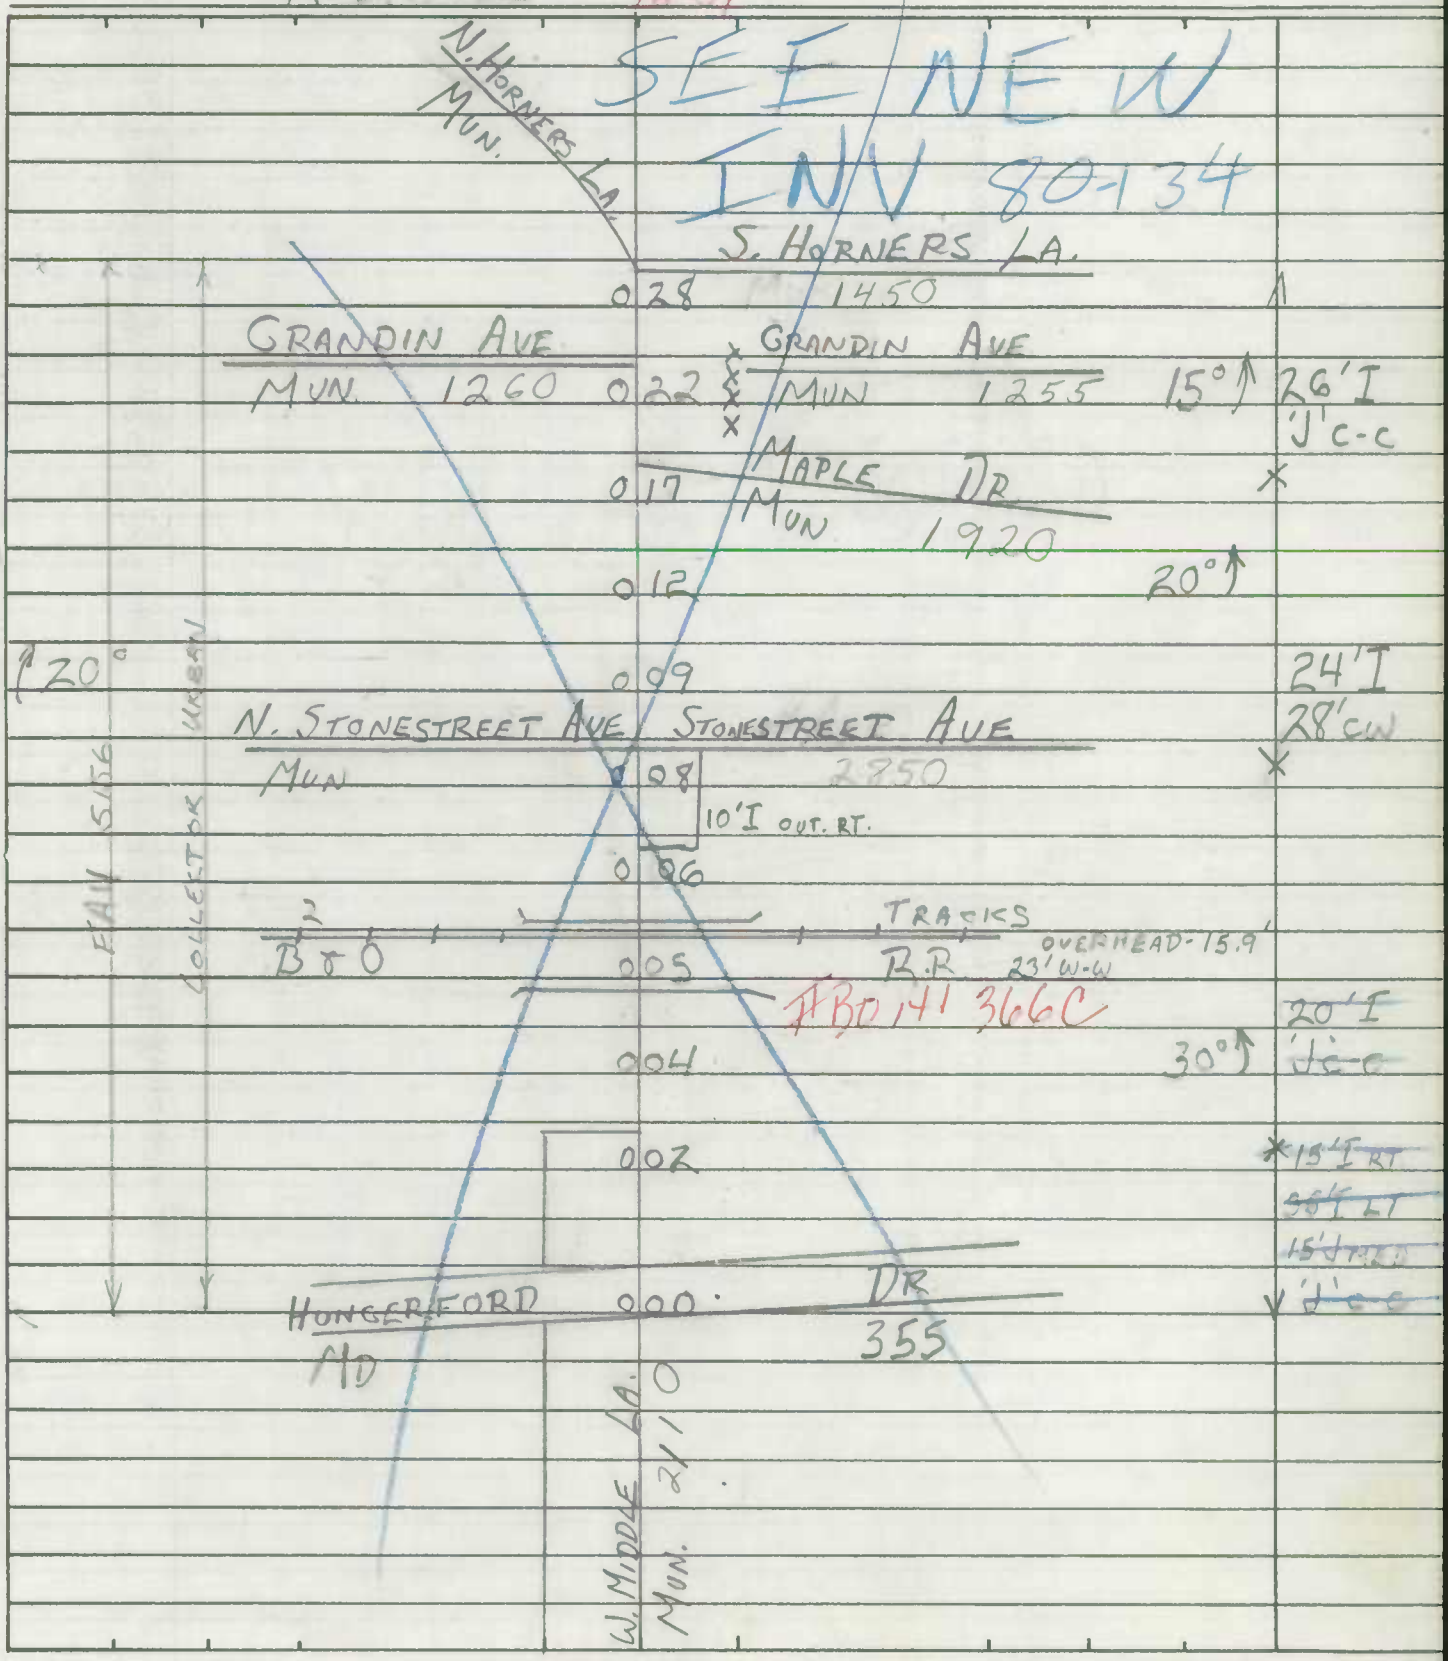

SHA 51.3-8
11-15-72

ROAD INVENTORY SHEET

Road No. _____
Road Name _____
Sheet No. _____
Date _____
County _____
State Coordinates _____

SHA 51.3 - 8 Revised
4.83

MARYLAND STATE HIGHWAY ADMINISTRATION

ROAD INVENTORY SHEET ROCKVILLE

8-89+85

Party Chief BB
Recorder AL
Assistant
Map No./Dir. / N
State Coordinates

Road No. MUN 2375
Road Name PASTURE BROOK DR ~~CT~~ (85-43) CA
County MONTGOMERY
Date 4-9-86 90-60,61 JE 4-13-87
Sheet No. 1 OF 1

TRAFFIC CODES

TRAFFIC CONTROLS: STOP SIGN=SS, TRAFFIC LIGHT=T.L., FLASHING RED BALL=F.R.

TRAFFIC CODES

PARKING RESTRICTIONS: A.M. PEAK, P.M. PEAK, A.M./P.M. PEAK, NO PARKING ANYTIME=N.P., COMM/IND. ACCESS=E

SYSTEM				TRAFFIC		LINE DIAGRAM	TRAFFIC			PAVEMENT DATA
FED. AID.	FUNCT CLASS.	HWY. SYS.	HPMS SAMPLE	PRKG. REST.	COM/IND. ACCESS		CONTROL	COM/IND. ACCESS	PRKG. REST.	

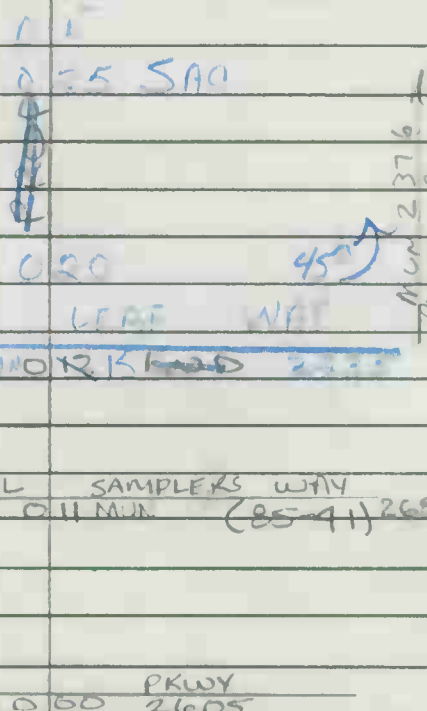

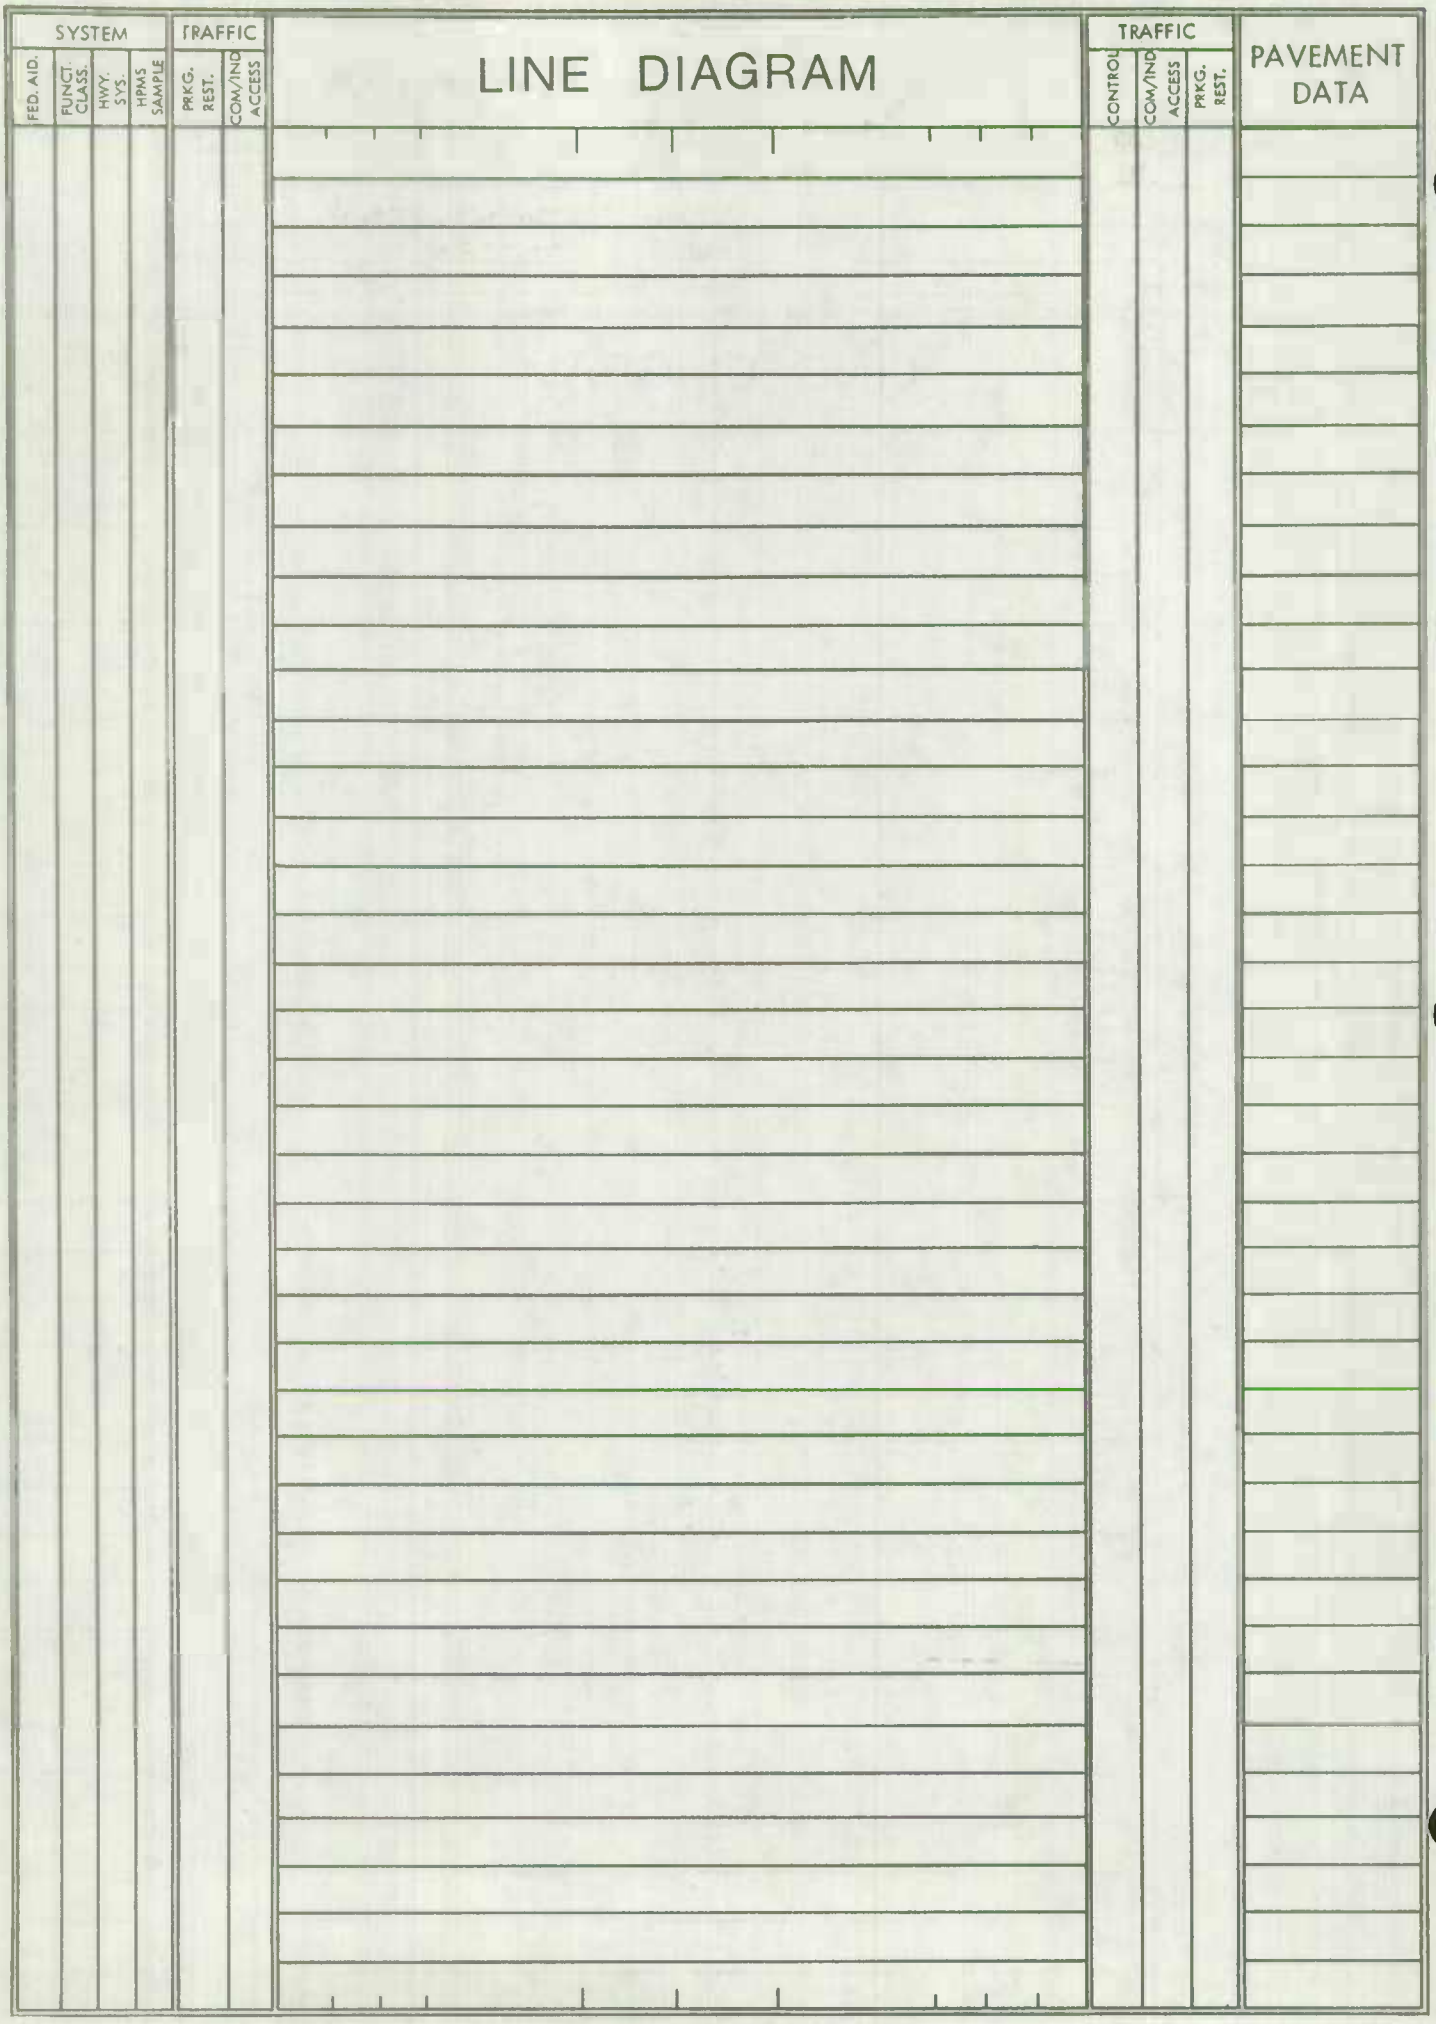
SYSTEM
FED. AID.
FUNCT. CLASS.
HWY. SYS.
HPMS SAMPLE
TRAFFIC
PRKG. REST.
COM/IND ACCESS
LINE DIAGRAM
TRAFFIC
CONTROL
COM/IND ACCESS
PRKG. REST.
PAVEMENT DATA

SHA 51.3-8
11-15-72

STATE HIGHWAY ADMINISTRATION OF MARYLAND

MIO-77 V

ROAD INVENTORY SHEET

Party Chief I. LONDON
Recorder I. ABBOTT
Helper

Map No. 26

Road No. MUN. 2400
Road Name S. PERRY ST.
Sheet No. 1 OF 1
Date 1-3-74
County MONT.
State Coordinates

ROCKVILLE

NOW MU 2012

80 140

THE COMMONS

AT COURT HOUSE

SQUARE

092

~~BARR~~ CAGE

014 089

PKG. LOT

JEFFERSON ST

MD. 086

SPUR 28

001/15' I "J" C-C

084 009

Co. LIBRARY 008 083

VINSON ST.

MUN. 3080 006 081 COUNTY OFFICE BLDG.

CITY HALL 079 004

076 001 FLEET ST 15°↓ 36' I "J" C-C

~~MARYLAND AVE.~~

075 ~~2012~~ MUN. 1125 V

MARYLAND AVE. MUN. 3080 SPUR

N

F.A.U. 5153 COLLECTOR URBAN

SHA 51.3-8
11-15-72

ROAD INVENTORY SHEET

Road No. _____
Road Name _____
Sheet No. _____
Date _____
County _____
State Coordinates _____

SHA 51.3-8
11-15-72

STATE HIGHWAY ADMINISTRATION OF MARYLAND

ROAD INVENTORY SHEET

Party Chief I. LANDON
Recorder I. ABBOTT
Helper

Map No. 26
BB REV. FR. 3-22-93
ROCKVILLE

Road No. MUN. 2405
Road Name PICCARD DR.
Sheet No. 1 OF 1
Date 12-14-73
County MONT.
State Coordinates 748-464

SNJ
(97-16A) HH
CDMP
2/24/98

~~BARR~~ ~~CADE~~
W GUDE 0 53H DR.
ROAD MU 1295

PROPOSED

0 35

0 21 15° ↑

CURIE CT
MU 995

0 19

0 15

20° ↑

0 04 PKG. LOT

0 01 20° ↑ HH I "J" C-C

REDLAND FIELDS RD.

0 00

MU

S ↑

SHA 51.3-8
11-15-72

ROAD INVENTORY SHEET

Road No. _____
Road Name _____
Sheet No. _____
Date _____
County _____
State Coordinates _____

SHA 51.3-8
11-15-72

646+14

ROAD INVENTORY SHEET

MUN. 2410

Party Chief I. LOUDON
Recorder M. ZALEWSKI
Helper

Map No. 26

ROCKVILLE

Road No. Co. 3041
Road Name PIER DR
Sheet No. 1 OF 1
Date 2-23-74
County MONT
State Coordinates

AT 1-25-83

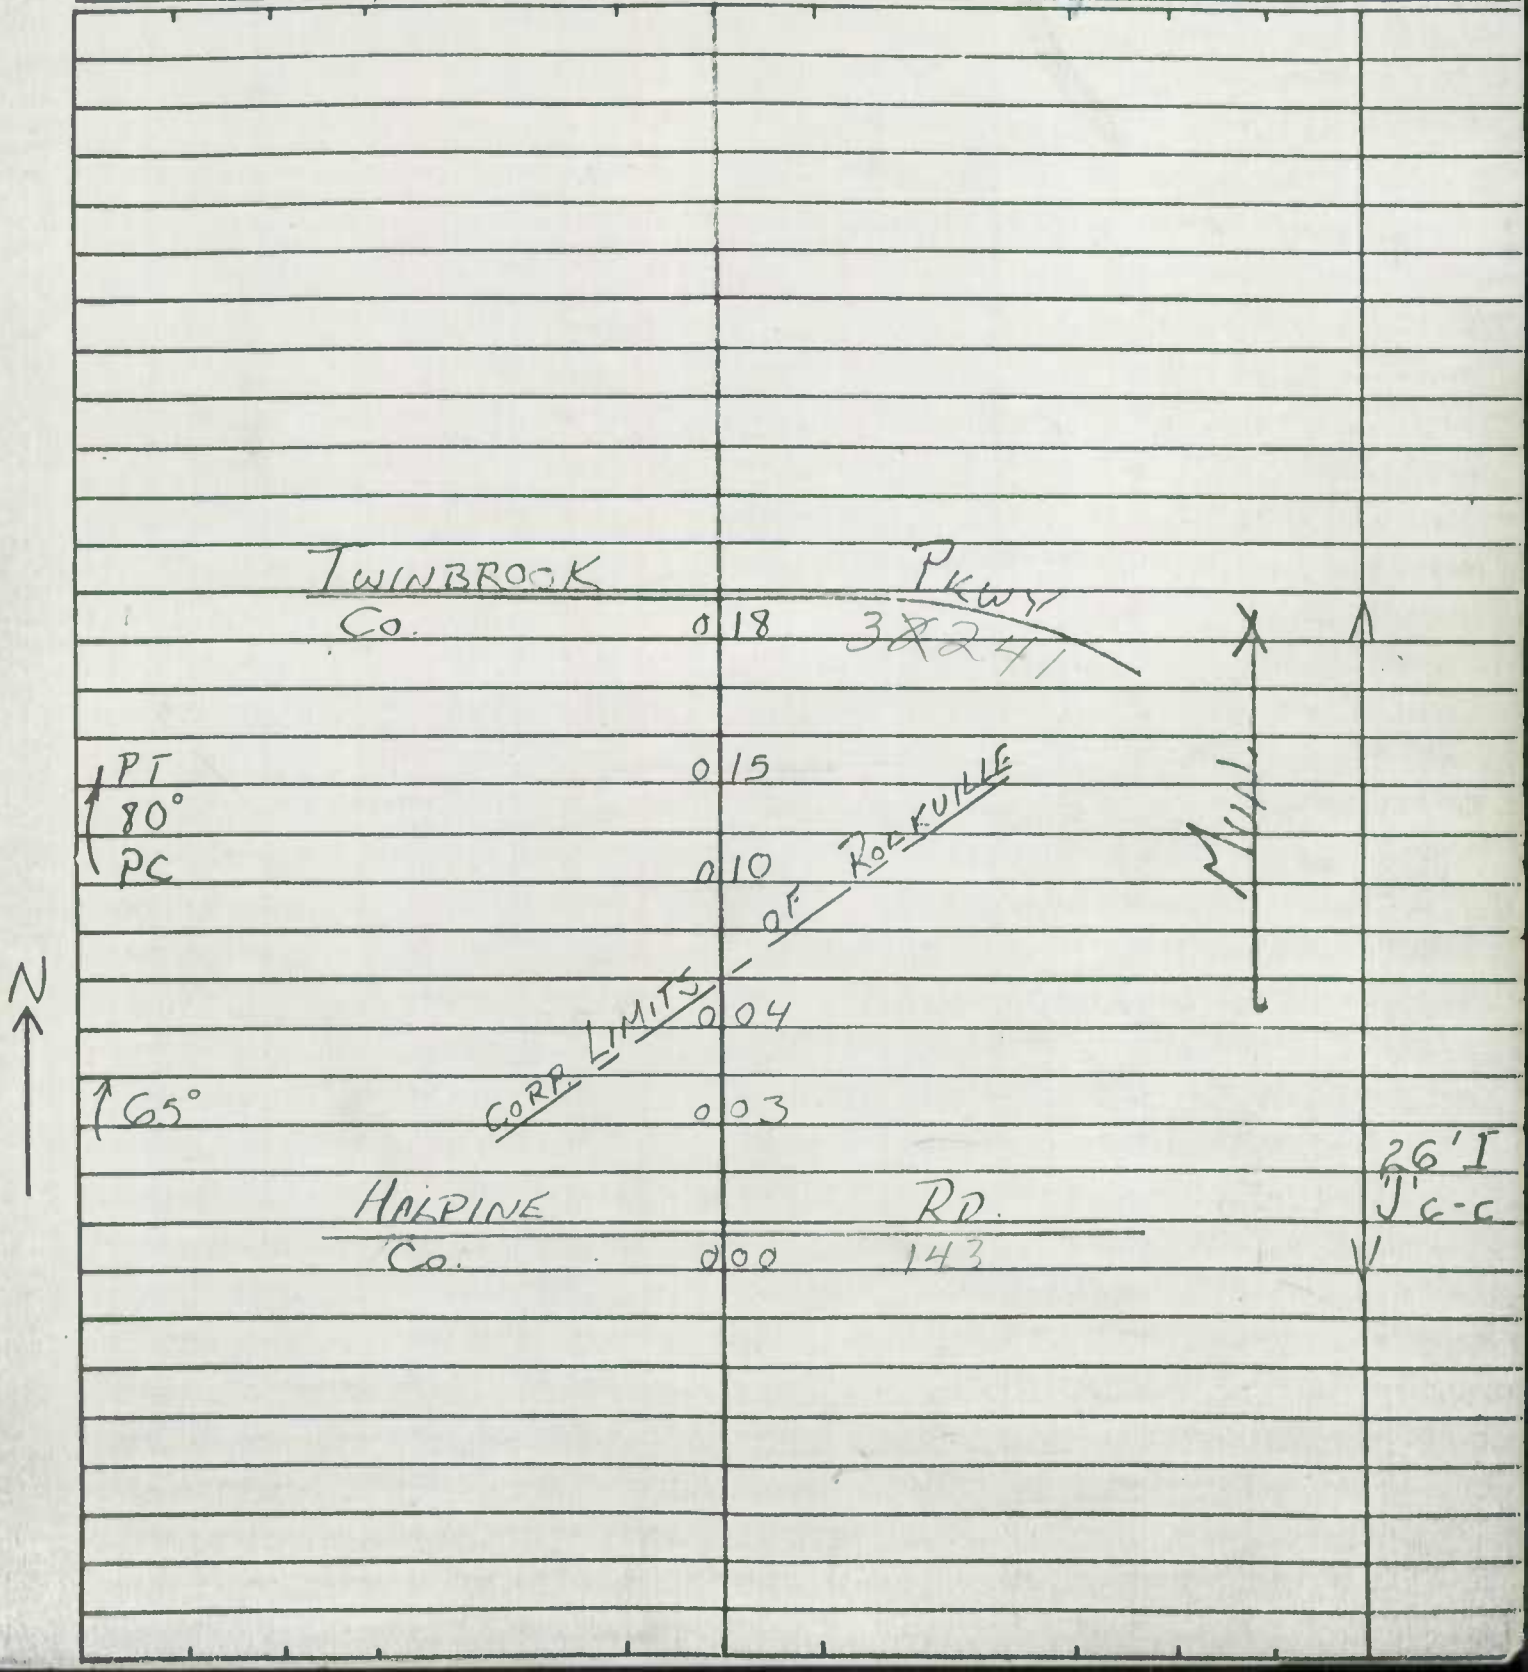

98-27 57
12/16/98
SJ/RB

SHA 51.3 - 8 Revised
4.83

ROCKVILLE (97-13,16)

MARYLAND STATE HIGHWAY ADMINISTRATION

ROAD INVENTORY SHEET

Party Chief GD
Recorder MP
Assistant
Map No./Dir. 1 W
State Coordinates

Road No. MU 2533
Road Name Redland Blvd
County Montgomery
Date 2/26/98
Sheet No. 1 OF 2

TRAFFIC CODES
TRAFFIC CONTROLS: STOP SIGN-SS, TRAFFIC LIGHT=T.L., FLASHING RED BALL=F.R.

TRAFFIC CODES
PARKING RESTRICTIONS: A.M. PEAK, P.M. PEAK, A.M./P.M. PEAK, NO PARKING ANYTIME=N.P., COMM/IND. ACCESS=E

SYSTEM				TRAFFIC		LINE DIAGRAM	TRAFFIC			PAVEMENT DATA
FUNCT CLASS	HWY SYS	HPMS SAMPLE		PREG. REST.	COMM/IND ACCESS		CONTROL	COMM/IND ACCESS	PREG. REST.	
					E	0 36 PT				
										2-22'I
					E	0 29				6'GrsMed
						30°				Jc-c
										4ML
						0 22 PC				
					E	0 19		E	X	
Collector										
					E	0 14				
						ELMCROFT BLVD				
					X	(PROP) 0 09 (PROP)				
						10' LT				
						RTL 0 06				2-22'I
										16'GrsMed
Urban						10' T 2-10' T LTL 0 04				Jc-c
										4ML
						Frederick Rd				
K						MD 0 00 355	TL		√	
						Redland Rd Co 1936				

COUNTY Mont. ROAD NO. Mu 2533 PAGE 2 OF 2

LINE DIAGRAM

SYSTEM: FUNCT CLASS	SYSTEM: HWY SYS	SYSTEM: NHS	SYSTEM: SAMPLE	TRAFFIC: PREG REST	TRAFFIC: OWN/MNT ACCESS	LINE DIAGRAM	TRAFFIC: CNTRLG	TRAFFIC: OWNING ACCESS	TRAFFIC: PREG. REST.	PAVEMENT DATA
						Piccard Dr				
						Mu 2405 0 99	TL			11'I RT 23'I LT 12'I SHD OUT/RT Jc-c 4'J Med 3 ML
						0 94				
					E	0 89				50'I Jc-c 4 ML
						0 69				
						0 66				
						0 64				
						(Gaither Rd) Gaither Rd				
						0 58 Mu 1190	TL			
						0 51				
					E	0 50				
										2-22'I 6'Grs Med Jc-c 4 ML
					E	0 45				
					E	0 40				
						Fields Rd 5896 OP 0				

Collector

Urban

MU 2533, REDLAND ROAD

MONTGOMERY COUNTY

ROCKVILLE

SEE INVENTORY OF

CO 1936, REDLAND ROAD

96-0 (CO.), 95-11 (MUN.)

ROCKVILLE LETTER 12/29/95

SHA 51.3-8
11-15-72

STATE HIGHWAY ADMINISTRATION OF MARYLAND

86 87-70 TR-3-31-88

ROAD INVENTORY SHEET

OP 5285

Party Chief I. LANDON
Recorder I. ABBOTT
Helper

Map No. 26

Road No. MUN. 2540
Road Name RESEARCH BLVD.
Sheet No. 1 OF 12
Date 12-14-73
County MONT.
State Coordinates 749-458

85-3 BB/AL 4-3-86

90-54 AL-JK 2-21-91

84-35 5-18-85 JEM ROCKVILLE

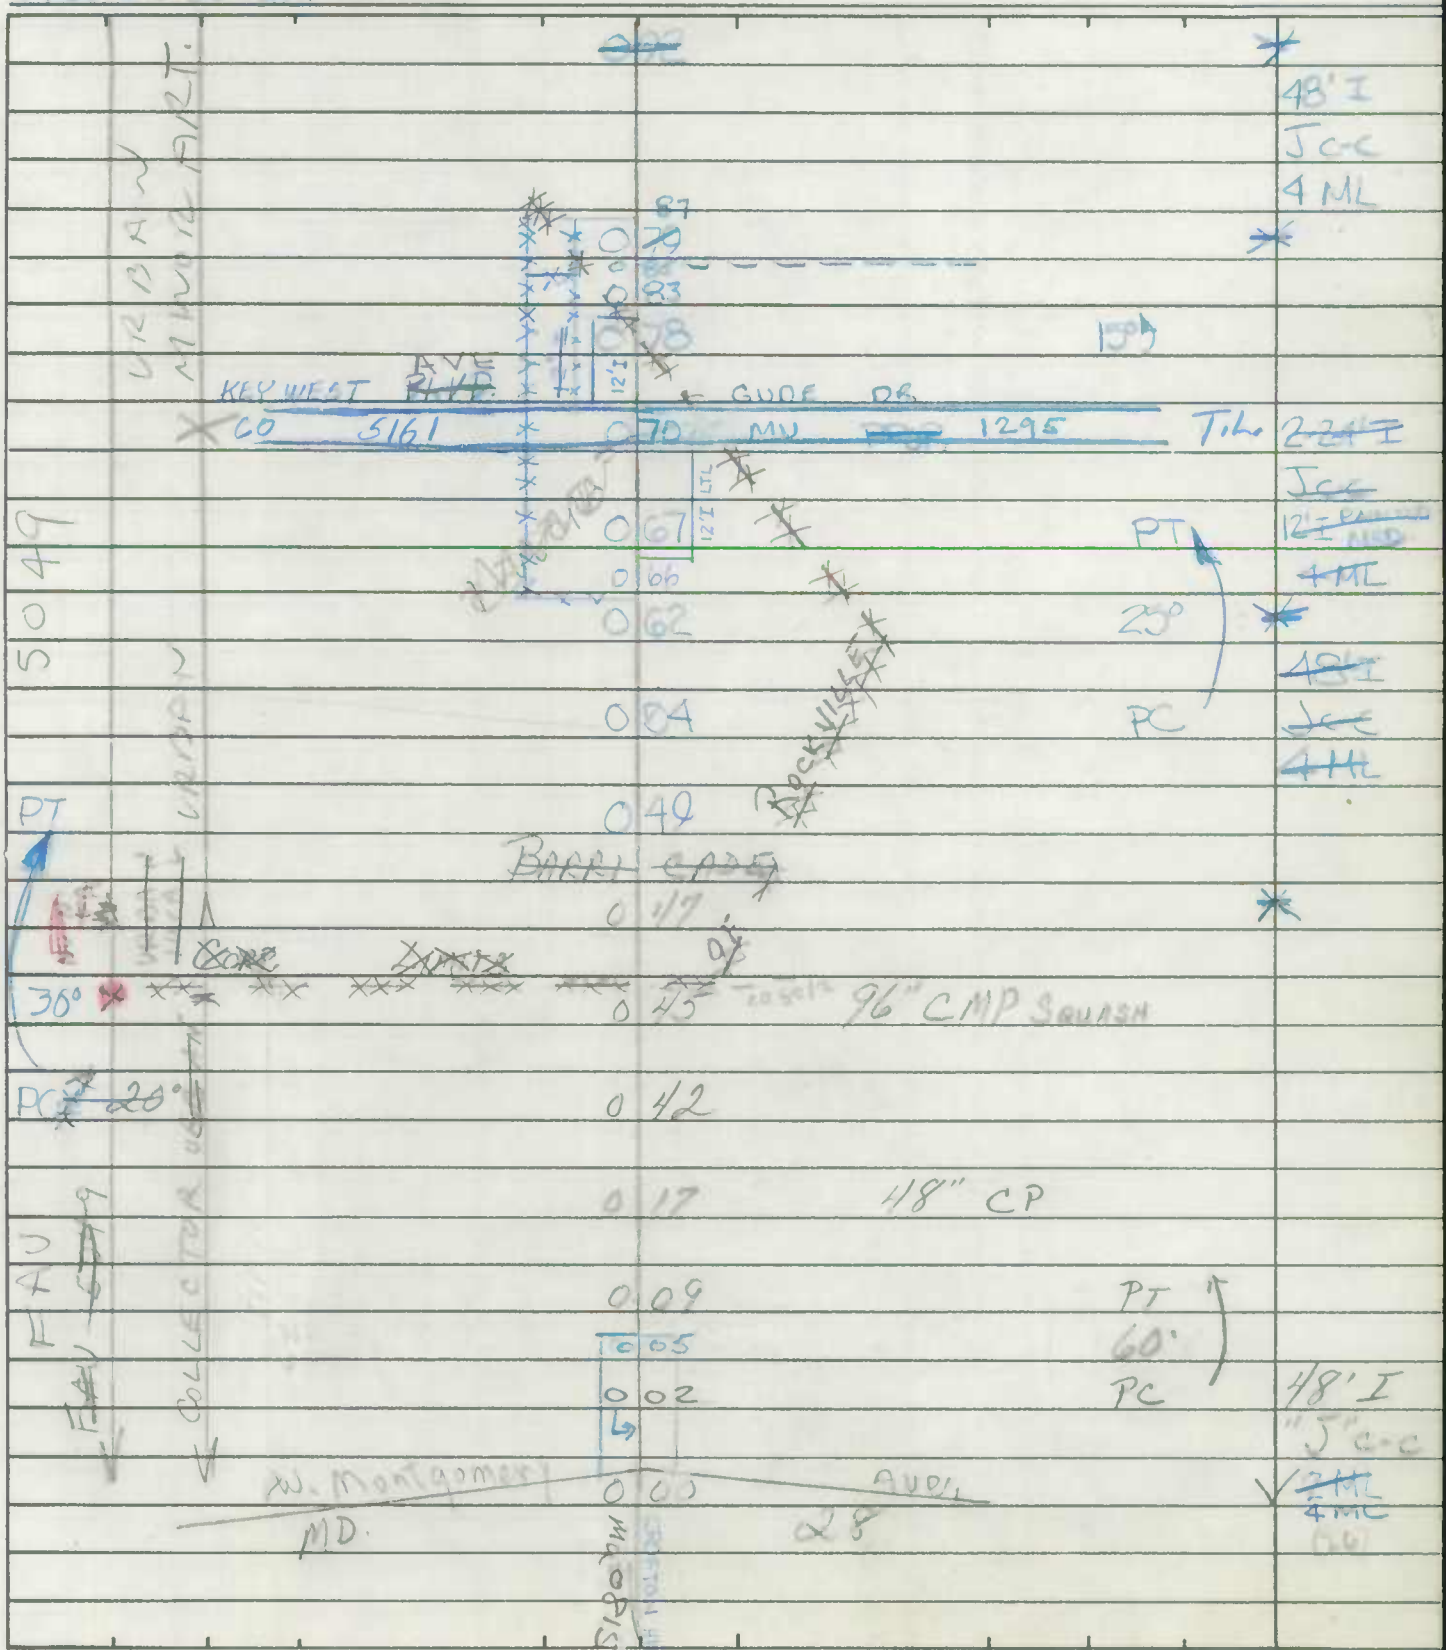

SHA 51.3-8
11-15-72

ROAD INVENTORY SHEET

Road No. MUN 2540
Road Name RESEARCH BLVD
Sheet No. 2 OF 2
Date 18 MAR 1985
County MONTGOMERY
State Coordinates

91 mun ex #1
GD-JK
3/26/91

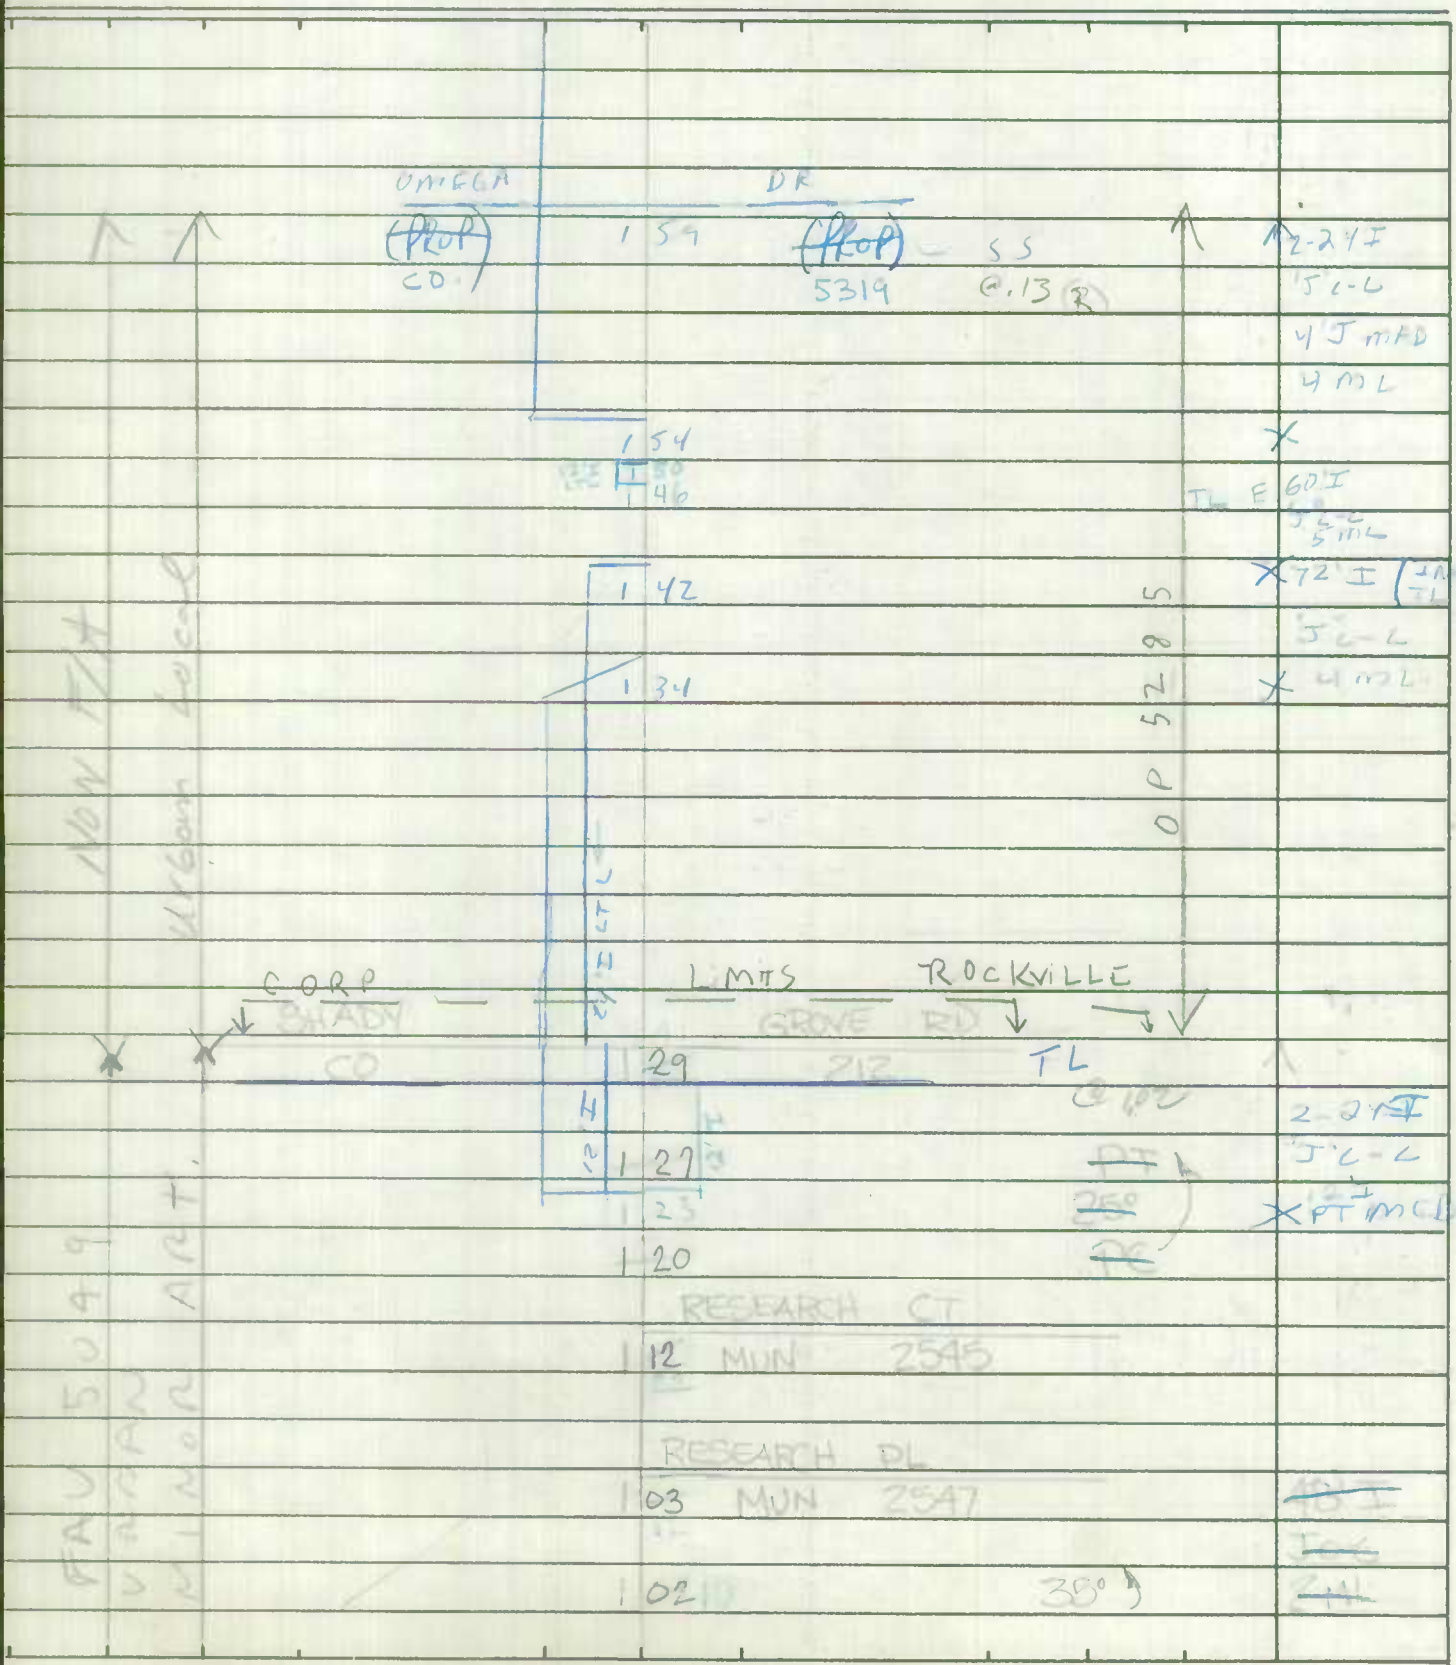

SHA 51.3-8
11-15-72

STATE HIGHWAY ADMINISTRATION OF MARYLAND

ROAD INVENTORY SHEET

Party Chief I. LANDON
Recorder I. ABBOTT
Helper

Map No. 26
ROCKVILLE

Road No. MUN. 2542
Road Name RESEARCH BLVD.
Sheet No. 1 OF 1
Date 12-14-73
County MONT.
State Coordinates 746-463

80-3

NOW PART OF

MUN 2540

84-35 3-18-85 JE BM

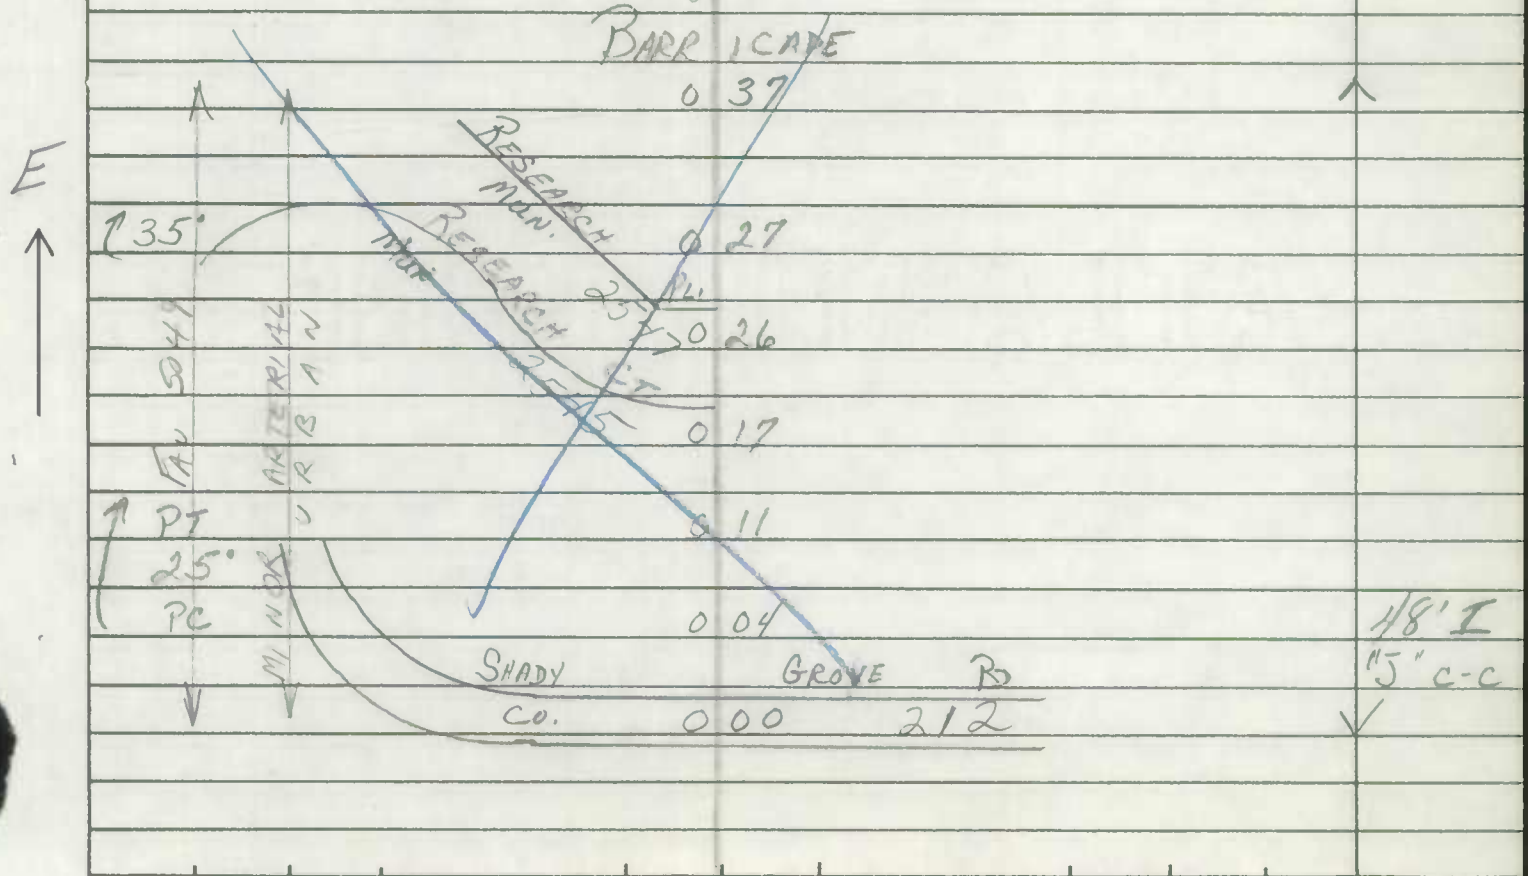

SHA 51.3-8
11-15-72

ROAD INVENTORY SHEET

Road No.' _____
Road Name _____
Sheet No. _____
Date _____
County _____
State Coordinates _____

SHA 51.3-8
11-15-72

STATE HIGHWAY ADMINISTRATION OF MARYLAND

ROAD INVENTORY SHEET

Party Chief: I. LANDON
Recorder: I. ABBOTT
Helper:

Map No. 26

Road No. MUN. 2592
Road Name RITCHIE PKWY.
Sheet No. 1 OF 1
Date 1-3-74
County MONT.
State Coordinates

85-48 RD/PK 4-10-86
86-81 SA JE

ROCKVILLE

See New Inventory
91-83-102B
GD-JK
3-25-92

PROPOSED

BARRICADE

0 60

W. EDMONSTON MUN. DR.

0 57 (S.S.) 10 10

0 52 KASH MUN.

0 45

0 41

15°

BRICE MUN. 30 FT. R/W RD.

0 35 (S.S.) 0400

0 33

0 29

CROTHERS MUN.

0 26

0 21

COPPER STONE CT

E. JEFFERSON MUN.

MU 0750 15

0 10

RITCHIE PKWY MUN. 2592

0 05

ROCKVILLE MD.

PIKE 355

0 00

15° 30° PT PC

20' I "J" C-RT "I" C-LT

20' I "J" C-RT "I" C-LT

30' I "I" C-LT "J" C-RT

22' I "J" C-RT

28' CW

S

EAU 50 I-270 SPUR TRAIL

SHA 51.3-8
11-15-72

ROAD INVENTORY SHEET

Road No. _____
Road Name _____
Sheet No. _____
Date _____
County _____
State Coordinates _____

SHA 51.3 - 8 Revised
4.83

MARYLAND STATE HIGHWAY ADMINISTRATION

ROAD INVENTORY SHEET ROCKVILLE

Party Chief BB
Recorder AL
Assistant
Map No./Dir. 1 W
State Coordinates

Road No. MUN 2593
Road Name RITCHIE PKWY
County MONTGOMERY
Date 4-10-86
Sheet No. 1 OF 1

85-48

SYSTEM: FED. AID. | FUNCT CLASS. | HWY. SYS. | HPMS SAMPLE
TRAFFIC: PRKG. REST. | COM/IND. ACCESS

LINE DIAGRAM

TRAFFIC: CONTROL | COM/IND. ACCESS | PRKG. REST.
PAVEMENT DATA

TRAFFIC CODES
TRAFFIC CONTROLS: STOP SIGN=SS, TRAFFIC LIGHT=T.L., FLASHING RED BALL=F.R.

TRAFFIC CODES
PARKING RESTRICTIONS: A.M. PEAK, P.M. PEAK, A.M./P.M. PEAK, NO PARKING ANYTIME=N.P., COMM/IND. ACCESS=E

Now
Wootton Pkwy

RITCHIE MUNI
PKWY 2542
ONE WAY
0.06
90°
0.03
0.03
12' H
RITCHIE PKWY MU 2594
ROCKVILLE PIKE MD 355
0.00
0.79
FIRST ST
911
MD
SS
T.L
24'I
40'CW
2ML

SYSTEM				TRAFFIC		LINE DIAGRAM	TRAFFIC			PAVEMENT DATA
FED. AID.	FUNCT. CLASS.	HWY. SYS.	HPMS SAMPLE	PRKG. REST.	COM/IND ACCESS		CONTROL	COM/IND ACCESS	PRKG. REST.	

SHA 51.3 - 8 Revised
4.83

MARYLAND STATE HIGHWAY ADMINISTRATION

ROAD INVENTORY SHEET

89-EX#1
GD/CG
3-21-90

Party Chief AL
Recorder Tm
Assistant
Map No./Dir. /
State Coordinates

Road No. MU 2605
Road Name W. Ritchie Pkwy
County Mont
Date 2-17-89
Sheet No. 1 OF 5

88-C-7

91-102
GD-JK
3-24-92

TRAFFIC CODES
TRAFFIC CONTROLS: STOP SIGN=SS, TRAFFIC LIGHT=T, L., FLASHING RED BALL=F.R.

TRAFFIC CODES
PARKING RESTRICTIONS: A.M. PEAK, P.M. PEAK, A.M./P.M. PEAK, NO PARKING ANYTIME=N.P., COMM/IND. ACCESS=E

SYSTEM				TRAFFIC	
FED. AID.	FUNCT CLASS.	HWY. SYS.	HPMS SAMPLE	PK.G. REST.	COM/IND. ACCESS
FAU	5010 MINOR ARTERIAL	URBAN		B.S.	B.S.

LINE DIAGRAM

Now Combined w. Rt MU 11-102 Wotton Pkwy GD-JK 3-24-92

0 40
Pastwood Brook DR
0 36 MU 2375
0 34
0 21
HENSLOWE DR
PT MU 0 17 1405
0 15
4/10° 0 12
PC 0 08
0 05
SEVEN COVES Rd
MU 0 00 2730

(PROP.)

TRAFFIC			PAVEMENT DATA
CONTROL	COM/IND. ACCESS	PK.G. REST.	
			2-28' I
			'J' C-C 5' 'J' MED
			4 ML
			2-28' I
1		BS	'J' C-C 14' GR. MED
			4 ML
		BS	
			2-28' I
			'J' C-C 5' GR MED
			4 ML
			2-28' I
			'J' C-C
			5' 'J' MED 4 ML
			2-28' I
			'J' C-C
			14' GR MED
			4 ML

mp 42 -.54 med has Const Barr.

2 of 5

SYSTEM | TRAFFIC | LINE DIAGRAM | TRAFFIC | PAVEMENT DATA

FED. AID. | FUNCT. CLASS. | HWY. SYS. | HPMS SAMPLE | PRKG. REST. | COM/IND ACCESS | CONTROL | COM/IND ACCESS | PRKG. REST.

See NEW LINE

Longhill Dr
mu 1735 0 82

Longhill Dr mu 1735 0 70 — PVT Dr

10'I

0 64

0 64

18'I RT, 12'I LT

0 60

0 58

0 56

MD

FALLS CREEK

0 54

189 feet

12'I LT

12'I LT

12'I RT

0 46

0 42

UNDER CONSTRUCTION

26'I
"J" C-C
2 ML
~~16'I~~
~~4" C-C LT~~
~~2 ML~~
80'I ON TAPER TO 26'I, 3'I SHD RT, J-C6 LT
3 ML
2-24'I JC-C
~~2" I~~ 4 ML
~~J-C LT~~
~~2 ML~~
~~2 ML I~~
~~J C LT~~
~~2 ML I~~
SAME

SHA 51.3-8
11-15-72

STATE HIGHWAY ADMINISTRATION OF MARYLAND

W. RITCHIE PKWY

ROAD INVENTORY SHEET

Party Chief I. LANDON
Recorder I. ABBOTT
Helper

Map No. 26
ROCKVILLE

Road No. MUN 2605
Road Name RITCHIE PKWY.
Sheet No. 1 OF 3
Date 12-11-73
County MONT.
State Coordinates 752-451

8-23

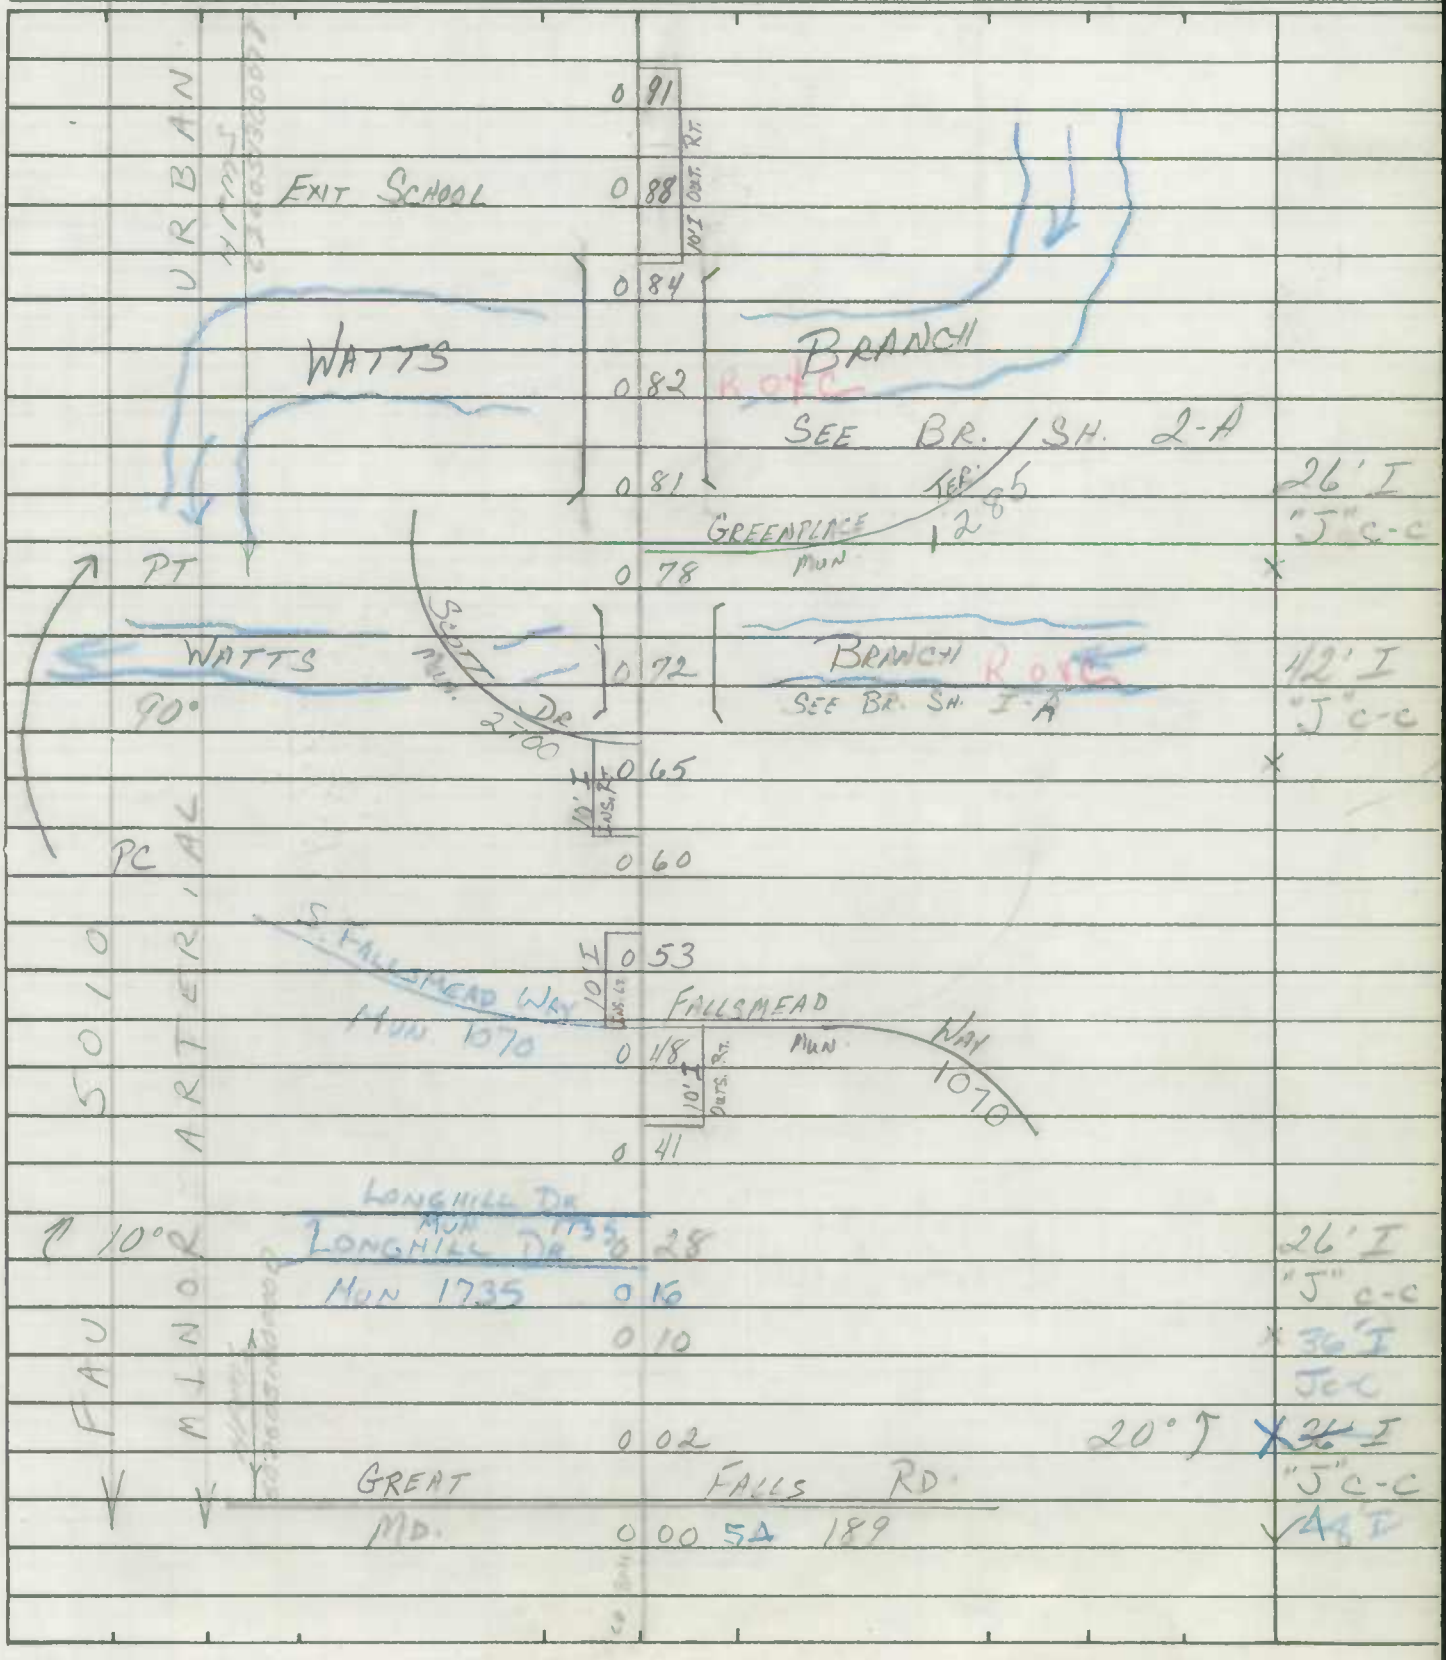

SHA 51.3-8
11-15-72

ROAD INVENTORY SHEET

W. RITCHIE PKWY.

Road No. MUN. 2605
Road Name RITCHIE PKWY
Sheet No. 2 OF 3
Date 12-11-73
County MONT.
State Coordinates

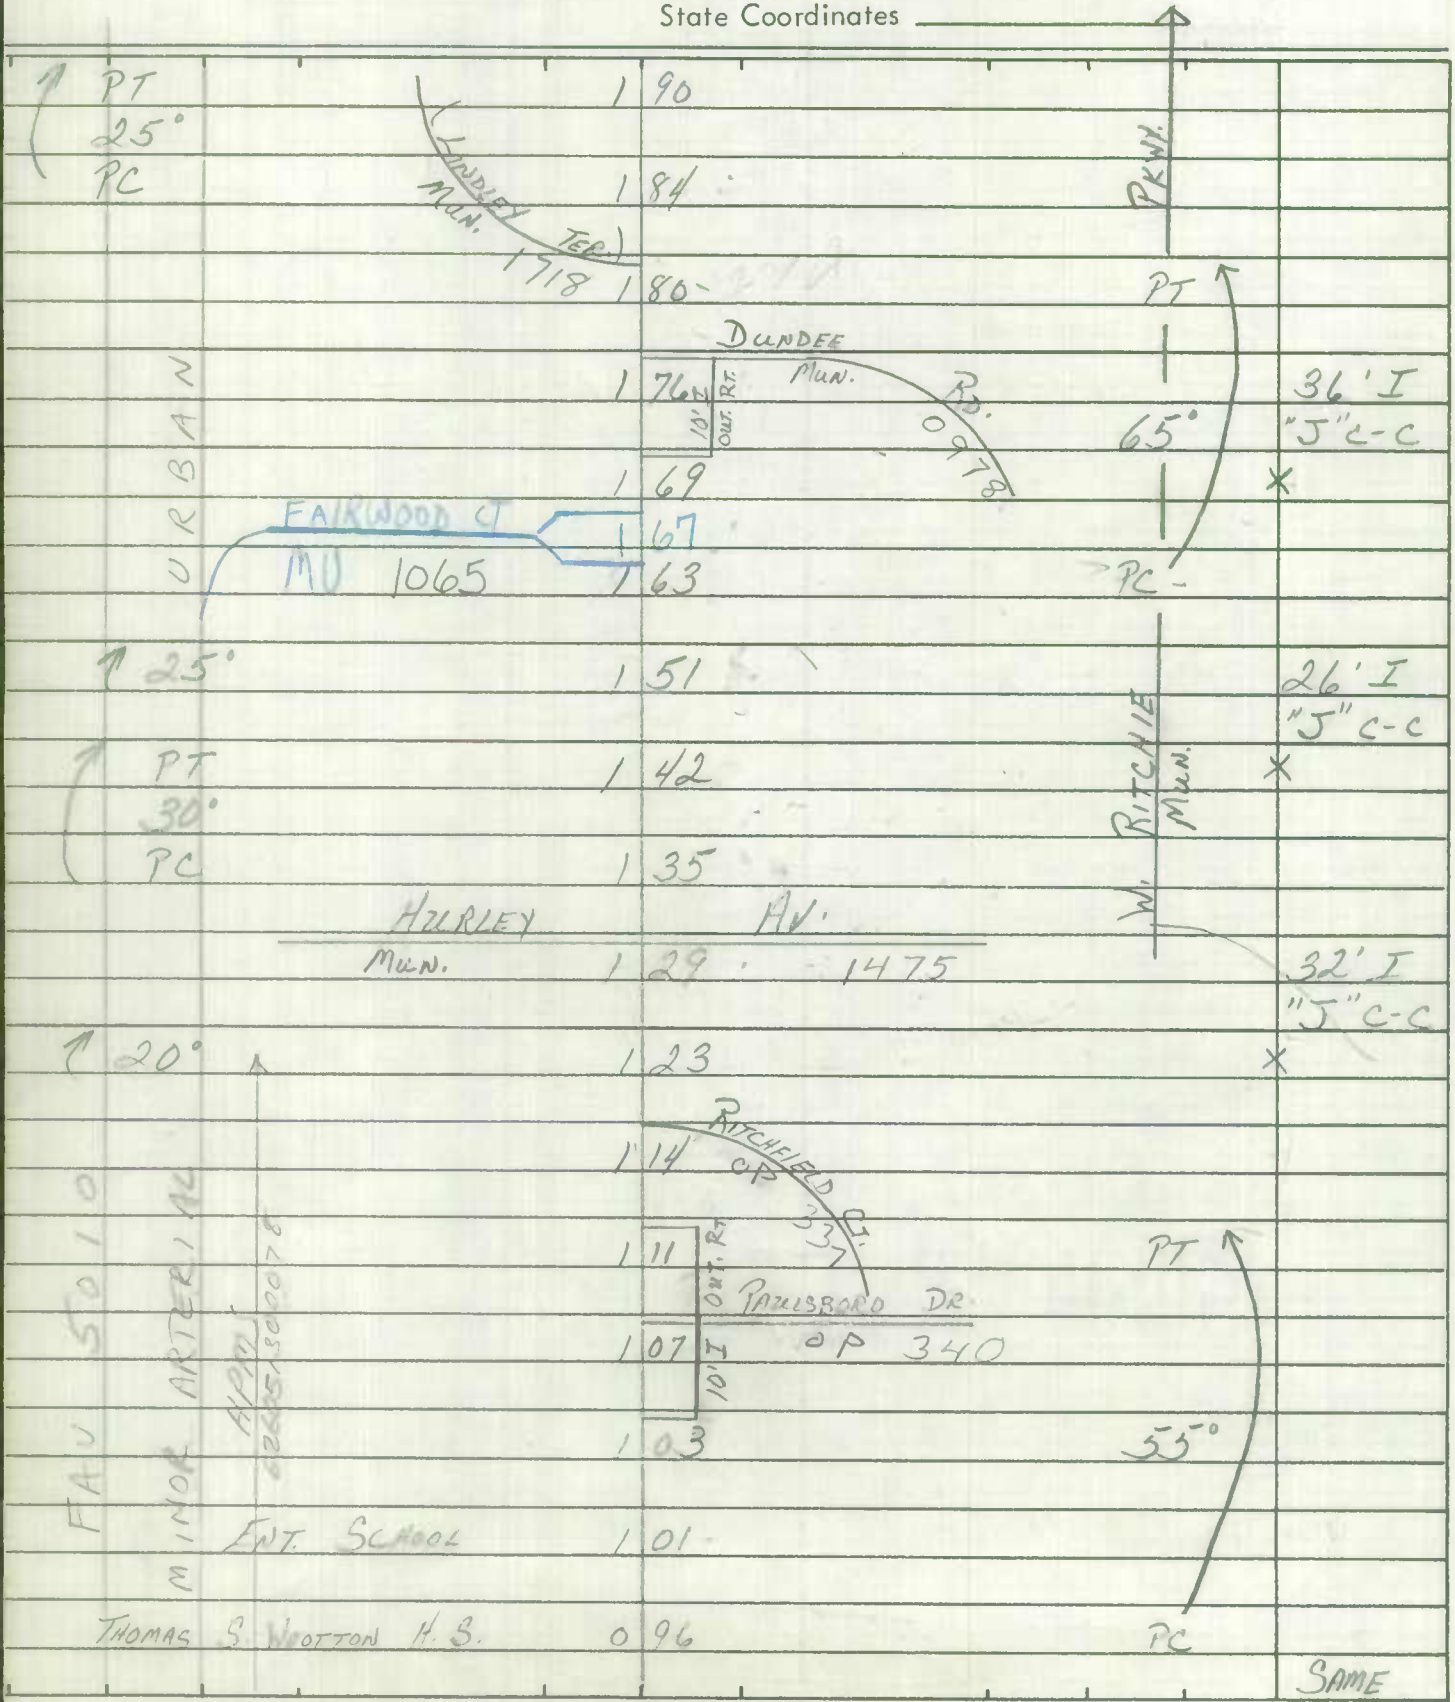

SHA 51.3-8
11-15-72

STATE HIGHWAY ADMINISTRATION OF MARYLAND

ROAD INVENTORY SHEET

Party Chief: I. LANDON
Recorder: I. ABBOTT
Helper:

Map No. 26
ROCKVILLE

Road No.: MUN 2605
Road Name: W. RITCHIE PKWY
Sheet No.: 3 OF 3
Date: 12-11-73
County: MONT.
State Coordinates:

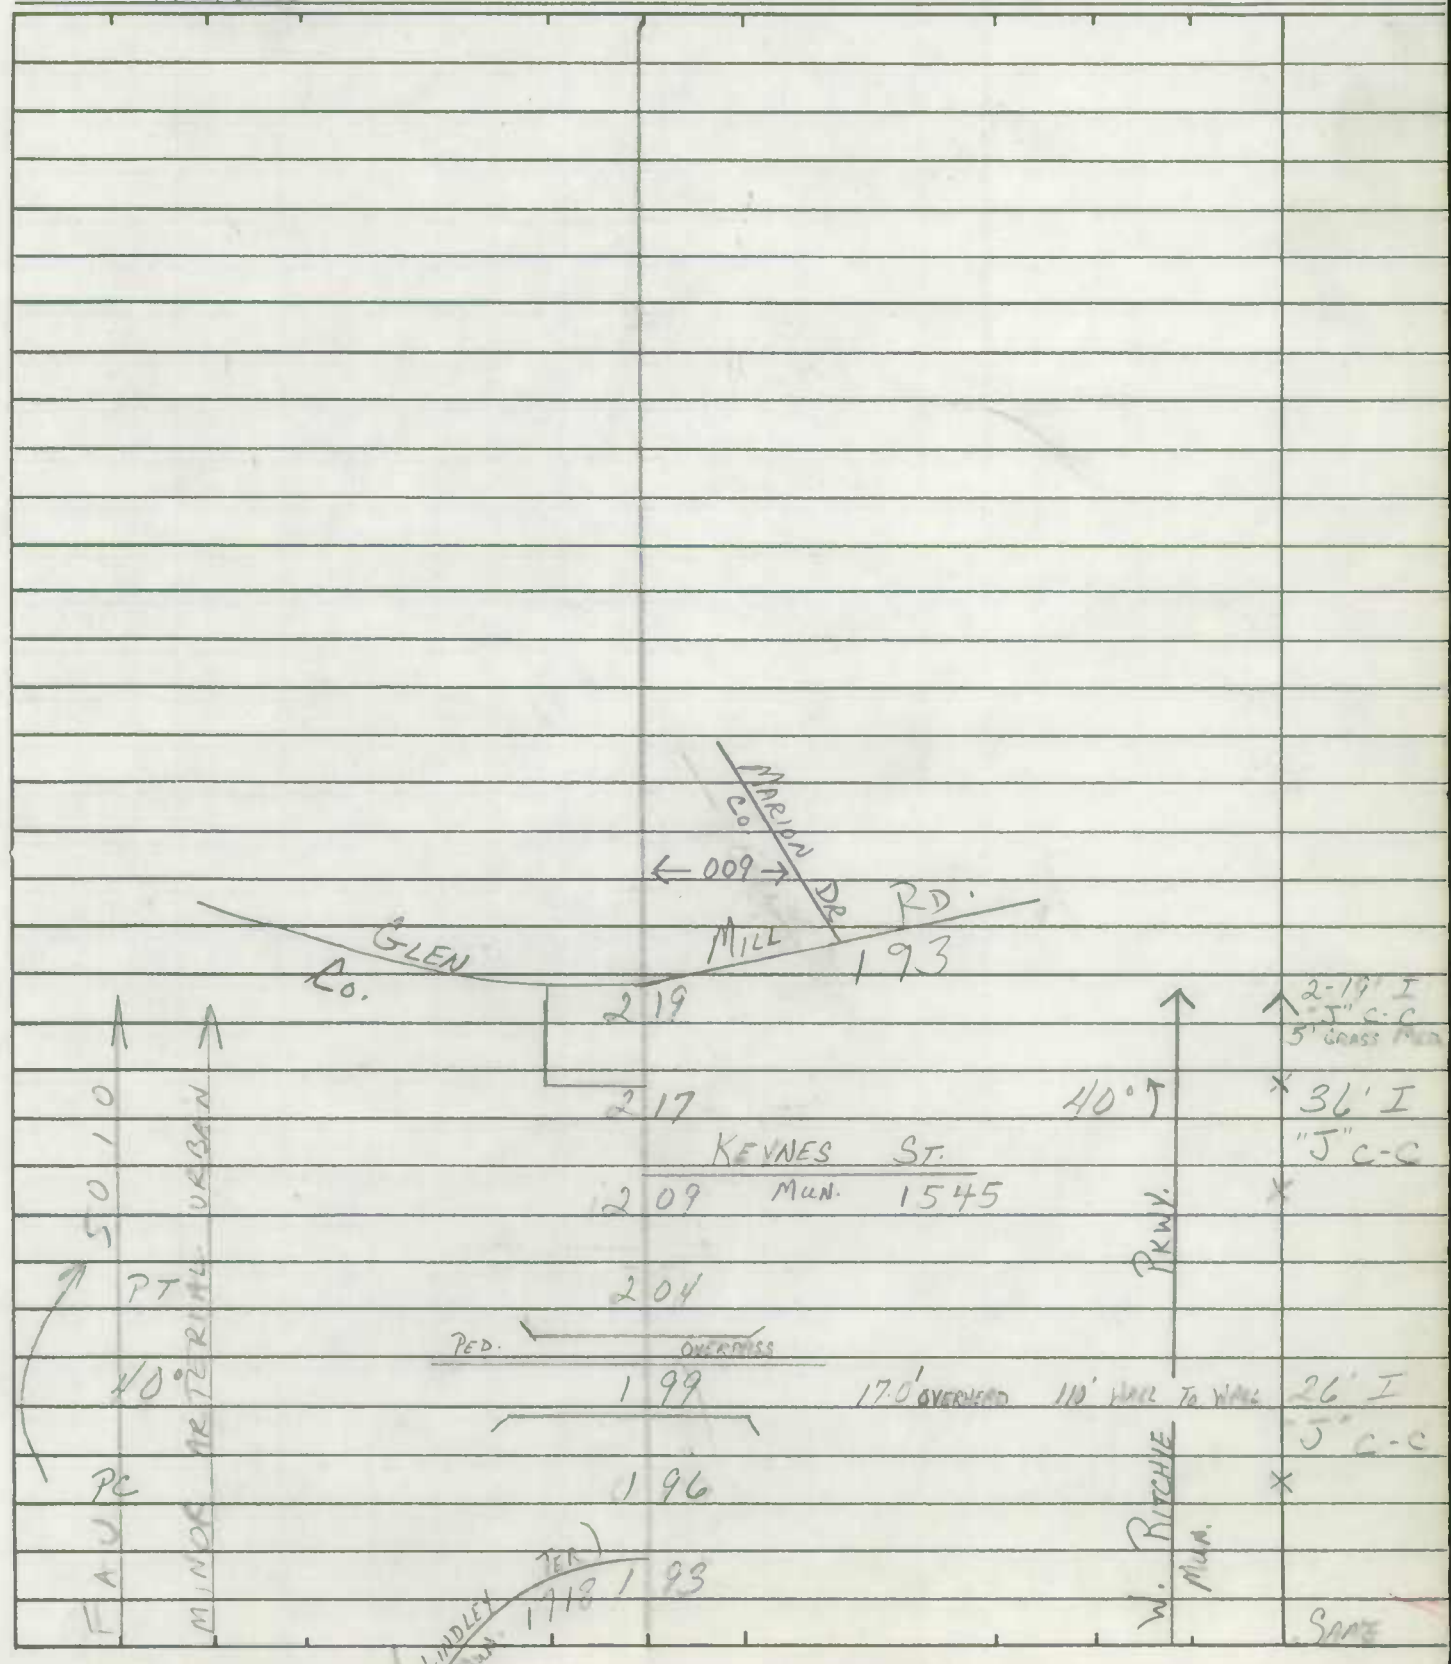

SHA 51.3-8
11-15-72

ROAD INVENTORY SHEET

Road No. _____
Road Name _____
Sheet No. _____
Date _____
County _____
State Coordinates _____

Form 5-HPS
(Revised 1961)

MARYLAND STATE ROADS COMMISSION
PLANNING AND PROGRAMMING DIVISION

S26130

IN COOPERATION WITH
U.S. BUREAU OF PUBLIC ROADS

RITCHIE PKWY.

ROAD NO. MUN.

BRIDGE SHEET

SHEET NO. 2-A

MAP # 26
748-452

PARTY NO.

DATE 12-11-73

COUNTY MONT.

RATED CAPACITY

FOR ALL STRUCTURES HAVING A TOTAL OPENING OF MORE THAN 20 FEET AS DEFINED IN NOTE 1.

ODOMETER READING 082 NAME OF (STREAM,) RAILROAD OR HIGHWAY CROSSED WATTS BRANCH

NUMBER OF RAILROAD TRACKS
KIND OF CROSSING (NOTE 2)

UNDERPASS-SIMPLE UNDERPASS-COMBINED (NOTE 3) OVERPASS BRIDGE OVER SYSTEM

2

DESCRIPTION

NUMBER OF SPANS	LENGTH EACH SPAN (NOTE 4)	TYPE (NOTE 5)
2	54'	I-BEAM

TOTAL LENGTH-ON LINE OF ROAD OVER-ALL (NOTE 6) 155'

MATERIAL
SUBSTRUCTURE I-BEAM & CONC. SUPERSTRUCTURE CONC. & STEEL RAILS
FLOOR CONC

CLEARANCES
ROADWAY (NOTE 7) 34'-I"-34' c-c SIDEWALK WIDTHS: RIGHT 5' J LEFT 9' J
SURFACE OF ROAD TO STREAM BED 17' FOR OVERPASSES, SHOW DISTANCES TO TOP OF RAIL OR SURFACE OF LOWER ROAD. (NOTE 8)
SURFACE OF ROAD TO BOTTOM PORTAL (MINIMUM OVERHEAD CLEARANCE
CLEAR DISTANCE OF OPENING ABOVE STREAM BED 14' (WATERWAYS ONLY)
POSTED LOAD LIMITS BRIDGE NO. CONSTRUCTION DATE 1972

GENERAL CONDITION OF BRIDGE: CHECK IF GOOD, FAIR, OR POOR, DESCRIBE DEFECTS IF SERIOUS.

	GOOD	FAIR	POOR
SUPERSTRUCTURE	✓		
FLOOR	✓		
SUBSTRUCTURE	✓		

PAINT BADLY CORRODED OR RUSTED
TYPE OF PROTECTION FOR DRAWBRIDGES (NOTE9)

(NOTES ON REVERSE SIDE)

S26130

Notes:

1. In agreement with Federal-aid standards, a bridge is defined as a structure including supports erected over a depression or an obstruction, as water, highway, or railway, and having a track or passageway for carrying traffic or other moving loads, and having a length measured along the center of roadway of more than 20 feet between undercoping of abutments or spring lines of arches, or extreme ends of openings for multiple boxes and pipes, where the clear distance between openings is less than half of the smaller contiguous opening.

2. Show kind of crossing by checking descriptive item applicable. For multiple-span bridges give complete information on each span including approach spans. Indicate on leg sheet the odometer reading, position, and angle of skew of structure with respect to center line of road and by arrow the direction of stream flow.

3. Give information on the span over the highway only.

4. For span length use center to center of bearings, otherwise the clear opening. Skew bridges will be measured along center line of road. See Note 1.

5. Show general type such as: Trestle, Truss, Girder, I-Beam, Rigid Frame, Arch, Slab, Suspension, or Covered Bridge. See illustrations attached. Describe draw spans by classifications listed in Article X, Section 2 of Manual.

6. The length of a bridge structure is the over-all length measured along the line of survey stationing back to back of back-walls of abutments, if present, otherwise end to end of bridge floor, but in no case less than the total clear opening of the structure.

7. Give minimum lateral clearance. Where traffic lanes are separated by bridge numbers, show clearance width of each lane separately. Special conditions should be explained by notes.

8. In case of overhead bracing or arch construction, measurement shall be made to the lowest point above the road surface.

9. Use classification listed on RR crossing sheets. Form 4 HPS.

Remarks:_____

A rearrangement of the form similar to that shown on the attachment may be used to provide space for coding.

SHA 51.3 - 8 Revised
4.83

MARYLAND STATE HIGHWAY ADMINISTRATION Rockville

ROAD INVENTORY SHEET

See 2002 IMPS

Party Chief _____
Recorder _____
Assistant _____
Map No./Dir. 1
State Coordinates _____

Road No. MU 2645
Road Name Rollins Ave
County Montgomery
Date 7-19-93
Sheet No. _____ OF _____

SYSTEM				TRAFFIC		LINE DIAGRAM	TRAFFIC			PAVEMENT DATA
FED. AID.	FUNCT CLASS.	HWY. SYS.	HPMS SAMPLE	PRKG. REST.	COM/IND. ACCESS		CONTROL	COM/IND. ACCESS	PRKG. REST.	
						SEE INVENTORY OF				
						CO 4252 7/19/93 T. MASSICOT				

TRAFFIC CODES

TRAFFIC CONTROLS: STOP SIGN=SS, TRAFFIC LIGHT=T.L., FLASHING RED BALL=F.R.

TRAFFIC CODES

PARKING RESTRICTIONS: A.M. PEAK, P.M. PEAK, A.M./P.M. PEAK, NO PARKING ANYTIME=N.P., COMM/IND. ACCESS=E

SHA 51.3-8
11-15-72

MUN. 2645 L V

ROAD INVENTORY SHEET

Party Chief I. LANDON
Recorder M. ZALENSKI
Helper

Map No. 26
ROCKVILLE

Road No. Co 425R
Road Name ROLLINS AVE
Sheet No. 1 of 1
Date 2-25-74
County MON
State Coordinates
A/T 10-6-82 ES

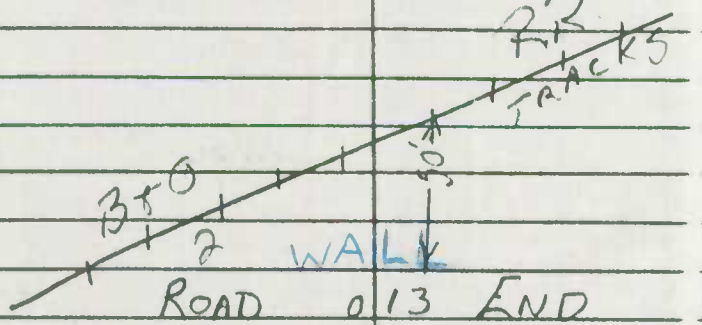

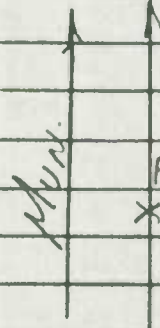

48' I
J'c-c
PKG LT.

190°
006
CORP. LIMITS OF ROCKVILLE
003
001
45°
36' I
J'c-c
CHAPMAN AVE
Co. 000 3047

N

SHA 51.3 - 8 Revised
4.83

MARYLAND STATE HIGHWAY ADMINISTRATION

ROAD INVENTORY SHEET Co 5609

87-220

Party Chief WB
Recorder CG
Assistant
Map No./Dir. E-10 D / N
State Coordinates ROCKVILLE 7240

Road No. MU 2665
Road Name ROTHGEB DR.
County MONT.
Date 3-29-88
Sheet No. 1 OF 1

TRAFFIC CODES
TRAFFIC CONTROLS: STOP SIGN=SS, TRAFFIC LIGHT=T.L., FLASHING RED BALL=F.R.

TRAFFIC CODES
PARKING RESTRICTIONS: A.M. PEAK, P.M. PEAK, A.M./P.M. PEAK, NO PARKING ANYTIME=N.P., COMM/IND. ACCESS=E

SYSTEM				TRAFFIC		LINE DIAGRAM	TRAFFIC			PAVEMENT DATA
FED. AID.	FUNCT CLASS.	HWY. SYS.	HPMS SAMPLE	PK.G. REST.	COM/IND ACCESS		CONTROL	COM/IND ACCESS	PK.G. REST.	
						P E				
						CUL 0.35 SAC				
					E	0.29				
						APPROX CORP LIMITS 0.24 ROCKVILLE				
					E	BURGUNDY PARK CONDOS 0.16 MONT CO. ANIMAL SHELTER		E		
						30° 0.11				
						0.04 SERVICE MU 90° DR 1475				36' I
										5 C-C
						E. GUDE MU 0.00 DR 1295				

SHA 51.3-8
11-15-72

STATE HIGHWAY ADMINISTRATION OF MARYLAND

87-220 ✓
WB/CG
2-27-88

ROAD INVENTORY SHEET

Party Chief BB
Recorder FR
Helper

Map No. 26D

Road No. MU. 2665
Road Name (ROTHGEB DR.)
Sheet No. 1 OF 1
Date 3-10-81
County MONT.
State Coordinates

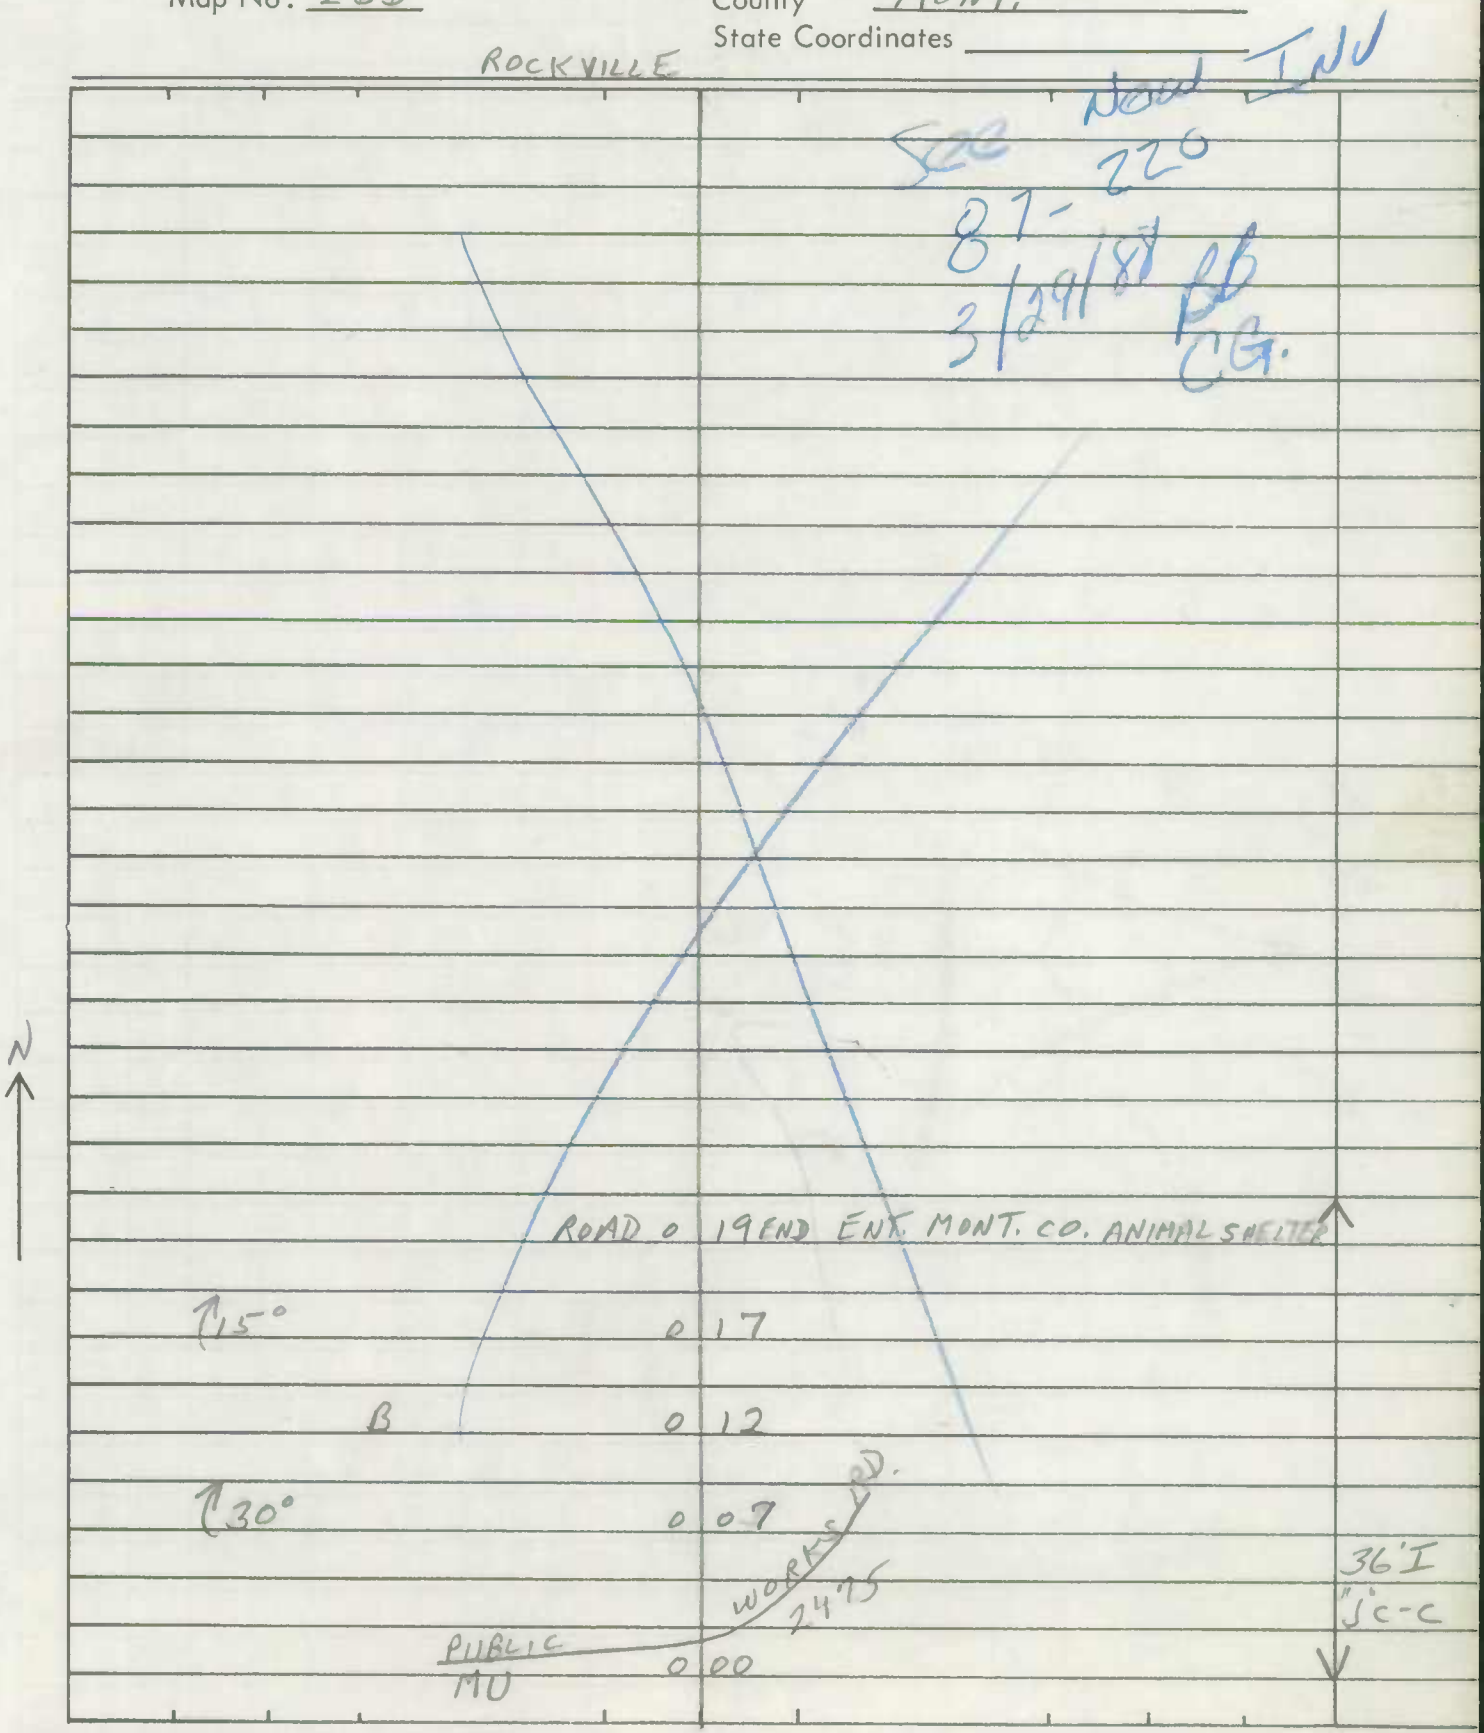

SHA 51.3-8
11-15-72

ROAD INVENTORY SHEET

Road No. _____
Road Name _____
Sheet No. _____
Date _____
County _____
State Coordinates _____

SHA 51.3 - 8 Revised
4.83

MARYLAND STATE HIGHWAY ADMINISTRATION

99-4 mu
00-7 mu
00-12,16 mu
SS/AG
2-21-01

ROAD INVENTORY SHEET

ROCKVILLE

Party Chief CG
Recorder TA
Assistant
Map No./Dir. E10 B / W (SW)
State Coordinates 752-465

Road No. Mu 2677
Road Name Saddle Ridge Circle
County Montgomery
Date 4/19/00
Sheet No. 1 OF

TRAFFIC CODES

TRAFFIC CONTROLS: STOP SIGN-SS, TRAFFIC LIGHT=T.L., FLASHING RED BALL=F.R.

TRAFFIC CODES

PARKING RESTRICTIONS: A.M. PEAK, P.M. PEAK, A.M./P.M. PEAK, NO PARKING ANYTIME-N.P., COMM/IND. ACCESS=E

SYSTEM				TRAFFIC		LINE DIAGRAM	TRAFFIC			PAVEMENT DATA
	FUNCT CLASS	HWY SYS	HPMS SAMPLE	PKG. REST.	COM/IND ACCESS		CONTROL	COM/IND ACCESS	PKG. REST.	
						see new Inv WRITTEN 02-21-01 SS/AG Imp # 00-7mu				
						Thompson Mu — Dairy Way 2925 — 0.25 — @.21				
						Alley — 0.23				
						Game Creek Dr Mu 1195 — 0.20 — @.00				
						0.148 PT 180°				
						Saddle Ridge Ln Mu 2678 — 0.14 — @.00				
						0.010 PC				
						Reserve Champion Dr Mu 2648 — 0.09 — @.17				2 I
						Alley (prop) — 0.07				2 UNC
						Thomason Mu — Dairy Way 2925 — 0.04 — @.11				
						(PROPOSED) Mu — Deer Meadow Ln — (PROPOSED) Saddle Ridge Dr — 0.00 — (Mu-8mu)				

COUNTY _____ ROAD NO. _____ PAGE ___ OF _____

SYSTEM				TRAFFIC			LINE DIAGRAM	TRAFFIC				PAVEMENT DATA
FUNCT CLASS	HWY SYS	HPMS SAMPLE		PKG RESE	COM/IND	ACCESS		CONTIG	COM/IND	ACCESS	PKG. RESE.	

SHA 51.3-8
11-15-72

STATE HIGHWAY ADMINISTRATION OF MARYLAND

ROAD INVENTORY SHEET MUN 2700

Party Chief I. LANDON
Recorder I. ABBOTT
Helper

Map No. 26
ROCKVILLE

Road No. ~~Co~~ ~~4250~~
Road Name SCOTT DR.
Sheet No. 1 OF 1
Date 12-11-73
County MONT.
State Coordinates 9'-21 A/T
A/T 1-28-83

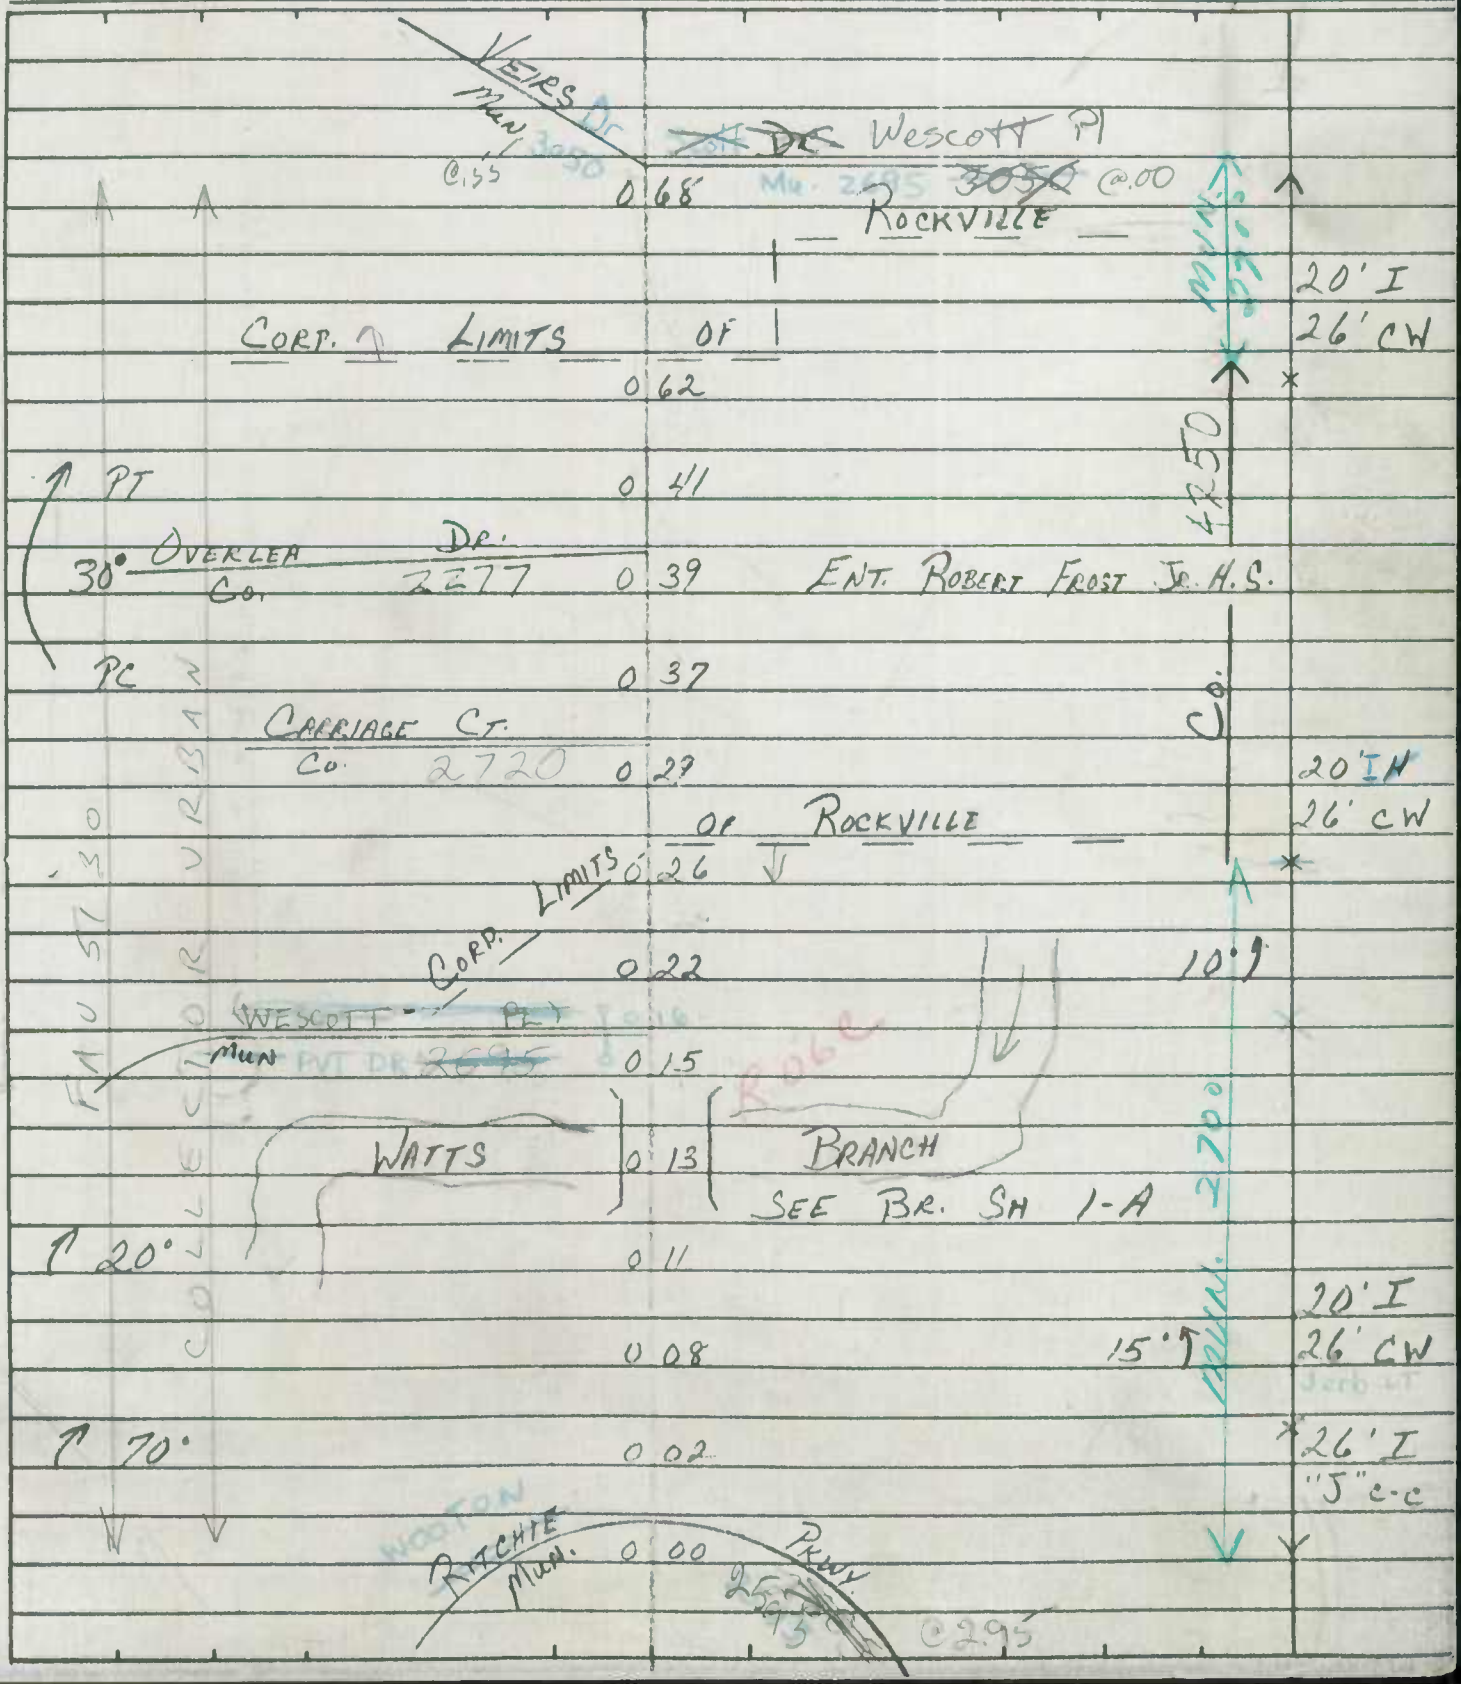

IN COOPERATION WITH
FEDERAL HIGHWAY ADMINISTRATION

BRIDGE SHEET

ROAD NO. SCOTT DR.
SHEET NO. _____
PARTY NO. _____
DATE Dec. 1, 1989
COUNTY MONTGOMERY

RATED CAPACITY 3 TONS

FOR ALL STRUCTURES HAVING A TOTAL OPENING OF MORE THAN 20 FEET AS DEFINED IN NOTE 1.

ODOMETER READING _____ NAME OF STREAM, RAILROAD OR HIGHWAY CROSSED WATTS BRANCH STREAM

NUMBER OF RAILROAD TRACKS N/A
KIND OF CROSSING (NOTE 2) STREAM

UNDERPASS-SIMPLE UNDERPASS-COMBINED (NOTE 3) OVERPASS BRIDGE OVER SYSTEM

DESCRIPTION

NUMBER OF SPANS	LENGTH EACH SPAN (NOTE 4)	TYPE (NOTE 5)
1	25'	I-BEAM

TOTAL LENGTH-ON LINE OF ROAD OVER-ALL (NOTE 6) 29.5'

MATERIAL

SUBSTRUCTURE CONC. ABUTM'T. SUPERSTRUCTURE TIMBER DECK
FLOOR

CLEARANCES

ROADWAY (NOTE 7) SIDEWALK WIDTHS: RIGHT N/A LEFT N/A

SURFACE OF ROAD TO STREAM BED 6.5' FOR OVERPASSES, SHOW DISTANCES TO TOP OF RAIL OR SURFACE OF LOWER ROAD. (NOTE 8)

SURFACE OF ROAD TO BOTTOM PORTAL N/A (MINIMUM OVERHEAD CLEARANCE

CLEAR DISTANCE OF OPENING ABOVE STREAM BED 4' (WATERWAYS ONLY) REM

POSTED LOAD LIMITS 3 TONS BRIDGE NO. MR-06 CONSTRUCTION DATE '79

GENERAL CONDITION OF BRIDGE: CHECK IF GOOD, FAIR, OR POOR, DESCRIBE DEFECTS IF SERIOUS.

	GOOD	FAIR	POOR
SUPERSTRUCTURE			POOR
FLOOR			POOR
SUBSTRUCTURE			POOR
PAINT			BADLY CORRODED OR RUSTED

TYPE OF PROTECTION FOR DRAWBRIDGES N/A

SHA 51.3 - 22
10-1-73

(NOTES ON REVERSE SIDE)

Form 5-HPS
(Revised 1961)

MARYLAND STATE ROADS COMMISSION
PLANNING AND PROGRAMMING DIVISION

IN COOPERATION WITH
U.S. BUREAU OF PUBLIC ROADS

MU 270 S26130
Co 4250
Scott Dr.

BRIDGE SHEET

ROAD NO. MUN.
SHEET NO. 1-A
PARTY NO.
DATE 12-11-73
COUNTY MONT.

MAP # 26
748-452

RATED CAPACITY

FOR ALL STRUCTURES HAVING A TOTAL OPENING OF MORE THAN 20 FEET AS DEFINED IN NOTE 1.

ODOMETER READING 013 NAME OF (STREAM), RAILROAD OR HIGHWAY CROSSED WATTS BRANCH

NUMBER OF RAILROAD TRACKS
KIND OF CROSSING (NOTE 2)

UNDERPASS-SIMPLE UNDERPASS-COMBINED (NOTE 3) OVERPASS BRIDGE OVER SYSTEM

DESCRIPTION

NUMBER OF SPANS	LENGTH EACH SPAN (NOTE 4)	TYPE (NOTE 5)
1	20'	I-BEAM

TOTAL LENGTH-ON LINE OF ROAD OVER-ALL (NOTE 6) 30'

MATERIAL
SUBSTRUCTURE I-BEAM & WOOD SUPERSTRUCTURE STEEL RAILS
FLOOR WOOD

CLEARANCES
ROADWAY (NOTE 7) 12' WOOD C-C SIDEWALK WIDTHS: RIGHT NONE LEFT -
SURFACE OF ROAD TO STREAM BED 6' FOR OVERPASSES, SHOW DISTANCES TO TOP OF RAIL OR SURFACE OF LOWER ROAD. (NOTE 8)
SURFACE OF ROAD TO BOTTOM PORTAL (MINIMUM OVERHEAD CLEARANCE
CLEAR DISTANCE OF OPENING ABOVE STREAM BED 5' (WATERWAYS ONLY)
POSTED LOAD LIMITS BRIDGE NO. CONSTRUCTION DATE 1950

GENERAL CONDITION OF BRIDGE: CHECK IF GOOD, FAIR, OR POOR, DESCRIBE DEFECTS IF SERIOUS.

	GOOD	FAIR	POOR
SUPERSTRUCTURE		✓	
FLOOR		✓	
SUBSTRUCTURE		✓	

PAINT BADLY CORRODED OR RUSTED
TYPE OF PROTECTION FOR DRAWBRIDGES (NOTE9)

(NOTES ON REVERSE SIDE)

S26130

Notes:

1. In agreement with Federal-aid standards, a bridge is defined as a structure including supports erected over a depression or an obstruction, as water, highway, or railway, and having a track or passageway for carrying traffic or other moving loads, and having a length measured along the center of roadway of more than 20 feet between undercoping of abutments or spring lines of arches, or extreme ends of openings for multiple boxes and pipes, where the clear distance between openings is less than half of the smaller contiguous opening.

2. Show kind of crossing by checking descriptive item applicable. For multiple-span bridges give complete information on each span including approach spans. Indicate on leg sheet the odometer reading, position, and angle of skew of structure with respect to center line of road and by arrow the direction of stream flow.

3. Give information on the span over the highway only.

4. For span length use center to center of bearings, otherwise the clear opening. Skew bridges will be measured along center line of road. See Note 1.

5. Show general type such as: Trestle, Truss, Girder, I-Beam, Rigid Frame, Arch, Slab, Suspension, or Covered Bridge. See illustrations attached. Describe draw spans by classifications listed in Article X, Section 2 of Manual.

6. The length of a bridge structure is the over-all length measured along the line of survey stationing back to back of back-walls of abutments, if present, otherwise end to end of bridge floor, but in no case less than the total clear opening of the structure.

7. Give minimum lateral clearance. Where traffic lanes are separated by bridge numbers, show clearance width of each lane separately. Special conditions should be explained by notes.

8. In case of overhead bracing or arch construction, measurement shall be made to the lowest point above the road surface.

9. Use classification listed on RR crossing sheets. Form 4 HPS.

Remarks: _____

A rearrangement of the form similar to that shown on the attachment may be used to provide space for coding.

SHA 51.3 - 8 Revised
4.83

MARYLAND STATE HIGHWAY ADMINISTRATION

ROAD INVENTORY SHEET

Rockville

Party Chief _____
Recorder _____
Assistant _____
Map No./Dir. 1
State Coordinates _____

Road No. Co 148 (mu 2730)
Road Name SEVEN LOCKS RDs
County Mont.
Date 2-17-79
Sheet No. 2 OF 2

TRAFFIC CODES
TRAFFIC CONTROLS: STOP SIGN=SS, TRAFFIC LIGHT=T.L., FLASHING RED BALL=F.R.

TRAFFIC CODES
PARKING RESTRICTIONS: A.M. PEAK, P.M. PEAK, A.M./P.M. PEAK, NO PARKING ANYTIME=N.P., COMM/IND. ACCESS=E

SYSTEM				TRAFFIC		LINE DIAGRAM	TRAFFIC			PAVEMENT DATA
FED. AID.	FUNCT CLASS.	HWY. SYS.	HPMS SAMPLE	PKG. REST.	COM/IND ACCESS		CONTROL	COM/IND ACCESS	PKG. REST.	
						MD 189				
						7 07 @ 675				
						.19				
						BARRA CADE				
						SIGN: ROAD CLOSED 6 88 715 Co. Police Station		E		
						6 73 Co. Jet Center		E		24'I
										2-16'F SHDs
										2
						6 64 CO. MAIN SHOP		E		
						6 62				24'I
						12' IATL				7'I SHD RT
						WOOTTEN Ritchie Pkwy				2 mL
						6 57 FRWY 2730				
						mu 2605 MU 2593 @1.76				
						6 51				SAME

FAU 5039 Minor Arterial Urban Comm Non EA

SYSTEM				TRAFFIC		LINE DIAGRAM	TRAFFIC			PAVEMENT DATA
FED. AID.	FUNCT. CLASS.	HWY. SYS.	HPMS SAMPLE	PRKG. REST.	COM/IND ACCESS		CONTROL	COM/IND ACCESS	PRKG. REST.	

91-85,102
OD, JK
3/25/92

SHA 51.3 - 8 Revised
4.83

MARYLAND STATE HIGHWAY ADMINISTRATION

ROAD INVENTORY SHEET

MU2730

Party Chief JE
Recorder CM
Assistant
Map No./Dir. /
State Coordinates

Road No. CO 148
Road Name SEVEN LOCKS Rds
County Montgomery
Date SEPT 30 1982
Sheet No. 7 OF 9

TRAFFIC CODES
TRAFFIC CONTROLS: STOP SIGN=SS, TRAFFIC LIGHT=T.L., FLASHING RED BALL=F.R.

TRAFFIC CODES
PARKING RESTRICTIONS: A.M. PEAK, P.M. PEAK, A.M./P.M. PEAK, NO PARKING ANYTIME=N.P., COMM/IND. ACCESS=E

SYSTEM FED. AID.	SYSTEM FUNCT CLASS.	SYSTEM HWY. SYS.	SYSTEM HPMS SAMPLE	TRAFFIC PKG. REST.	TRAFFIC COM/IND ACCESS	LINE DIAGRAM	TRAFFIC CONTROL	TRAFFIC COM/IND ACCESS	TRAFFIC PKG. REST.	PAVEMENT DATA
						Goya Dr				
						5 78 CO 3182				
										24' I
										2-8'G SHDS
						Inspection House Rd 5 67				2ML
						CO 3191				
						5 63			X	
						5 58				
						Post OAK Rd				
						CO 3300 5 56				2-10' I
										8'G SHD LT
										10'I PT MED
						5 51				2ML
						5 48			X	
						5 39 Church		E		
						Fortune ST				
						5 31 CO 2342				20' I
										2-8'G SHDS
										40' CW
										2ML
						5 27			X	
										2-10' I
										2-8'G SHDS
						GAINSBOROUGH Rd				
						CO 5 22 1757				10'I PT MED
										48' CW
										2ML
						5 19				

EAY 5039 MINOR ARTERIAL URBAN

SYSTEM | TRAFFIC | LINE DIAGRAM | TRAFFIC | PAVEMENT DATA

FED. AID. | FUNCT. CLASS. | HWY SYS | HPMS SAMPLE | PRKG. REST. | COM/IND ACCESS | CONTROL | COM/IND ACCESS | PRKG. REST.

FAU 5039 Mun 2230 MINOR ARTERIAL INC CO 148

MUN 27 30

MONT CO. Public [illegible]

6 50 — E

TWIN OAKS DR

MUN 2975

6 40

6 35

MONROE ST 45 MUN 1177

FORTUNE TERR

6 31 ~~CO 149~~ MUN 1155

MUN 27 30 TO MUN 27 45 TRANSIT 90-266 (CO)

6 27 ROCKVILLE

6 23

6 15

PT

35°

PRC

6 01 72" CMP PRC

5 97

5 94 45°

MONTROSE RD

5 93 CO 144

RT L

5 92 H

10

5 87 P.C

36 I
"J" C-C

418 I
"J" C-C

2-30' I
"J" C-C
10' J MED
4 ML

50' I
"J" C-C

2-10' I
I - C+
10' I PT MED
2 ML

SAME

SHA 51.3-8
11-15-72

STATE HIGHWAY ADMINISTRATION OF MARYLAND

Rockville

MUN 2730

ROAD INVENTORY SHEET

Party Chief I. LANDON
Recorder I. ABBOTT
Helper

Map No. 26
BB REV. FR 2-9-81 80-128

Road No. ~~Co. 148~~
Road Name SEVEN LOCKS RD.
Sheet No. 7 of 7
Date 12-6-73
County MONT.
State Coordinates

CM A/T 83-28

SEE NEW INV. 88-8 ALTM 4-17-89

FALLS RD
MD 189

7 15
7 12
7 11
7 07
7 02
6 96 Co. POLICE STA.
6 92
6 81 Co. DETENTION CTR.
6 72 Co. COMM MAINT. SHOP
6 64
6 58

PT 45° PC
15° ↑
20° ↑
20°

MUNICIPAL

CORP LIMITS OF ROCKVILLE
END Co. MAINT. SIGN
MONT CO PUBLIC WORKS DEPOT

36'I
10'SHD LT.
50'CW
X 3ML
80-128
80-128
24'I
2-10'I
SHLD
50'CW
2ML
X 24'I
2-6'E SHLD
1/0'CN
48'I
4ML

SHA 51.3 - 8 Revised
4.83

MARYLAND STATE HIGHWAY ADMINISTRATION

ROAD INVENTORY SHEET

ROCKVILLE

Party Chief T. Landon
Recorder M. Zalenski
Assistant Rewritten JEL (3/27/92)
Map No./Dir. / W
State Coordinates ROCKVILLE

Road No. MU 2795
Road Name Southlawn La
County Montgomery
Date 2-15-74
Sheet No. 3 OF 4

TRAFFIC CODES
TRAFFIC CONTROLS: STOP SIGN=SS, TRAFFIC LIGHT=T.L., FLASHING RED BALL=F.R.

TRAFFIC CODES
PARKING RESTRICTIONS: A.M. PEAK, P.M. PEAK, A.M./P.M. PEAK, NO PARKING ANYTIME=N.P., COMM/IND. ACCESS=E

SYSTEM				TRAFFIC		LINE DIAGRAM	TRAFFIC			PAVEMENT DATA
FED. AID.	FUNCT CLASS.	HWY. SYS.	HPMS SAMPLE	PRKG. REST.	COM/IND. ACCESS		CONTROL	COM/IND. ACCESS	PRKG. REST.	
	URBAN Local					SPC mod Inv 1 70 10 SS CORP LMTS ROCKVILLE SSIWB 1 66 IMPR 2nd CURB 1 55 ROCKVILLE MU 2795 IN CORP LMTS 1 46 ROCKVILLE CORP LMTS 1 42 ROCKVILLE LEFSTRAND LA MU 1730 1 44 PT 025 1 33 ROCKVILLE				20'H 26(W)

SYSTEM: FED. AID. | FUNCT. CLASS. | HWY. SYS. | HPMS SAMPLE

TRAFFIC: PRKG. REST. | COM/IND ACCESS

LINE DIAGRAM

TRAFFIC: CONTROL | COM/IND ACCESS | PRKG. REST.

PAVEMENT DATA

SEE [illegible] 01 30-02

SSLOP

R/ HORNERS MIL

LA 1888 1450

MASON DR

182 MIL 2015

LA 1730

MU

MVA BLDG 2 DRIVER TESTING

+73

20' H

26'(W)

SHA 51.3-8
11-15-72

STATE HIGHWAY ADMINISTRATION OF MARYLAND

ROAD INVENTORY SHEET

MUN 2860

Party Chief T. LANDON
Recorder I. ABBOTT
Helper

Map No. 26 Rockville

Road No. Co 3619
Road Name STRATTON DR.
Sheet No. 1 of 2
Date 12-11-73
County MONT.
State Coordinates 750-446

AT 84-5

		CANTERBURY WAY	
	0	78 MUN. 0530	50°
PRC	0	70	PRC
MILLARD MUN. DR. 2130	0	65	
100°		SELNORTH RD	
	0	58 MUN. 2710	
PC	0	56	
DUNSTER RD.			MUNICIPAL
MUN. 0990	0	52	
		DUNSTER RD. 1980	
	0	45 MUN. 0980	15°
KIMBLENICK RD			
MUN.	0	37 1550	
CORP. LIMITS OF		ROCKVILLE	
25°	0	33 — END CO MAINT. SIGN	36' I "J" C-C
AQUEDUCT RD. 3423			
CO.	0	29	
	0	25	PT 50°
	0	19	PC
		ATWELL RD.	
	0	13 CO. 3617	
	0	10	40°
STRATTON CT.			
CO. 3618	0	07	26' I "J" C-C
ESPALIER		PL.	
CO.	0	00 3620	

E

SHA 51.3-8
11-15-72

ROAD INVENTORY SHEET

Road No. Mun. 2860
Road Name STRATTON DR.
Sheet No. 2 OF 2
Date 12- 11 -23
County MONT.
State Coordinates

ROAD	END		
1	11		
		POTOMAC WOODS PARK	
1	09	REC. CTR.	24' E
			30' CW
↑ 15°	1	02 ◈	X
	0	99	PT
			15° ↑
↑ PRC	0	95	PRC
100°			26' I
PC			"J" C-C
	0	92	X
			18' I
			"J" CURB
			RT.
			22' CW
	0	90	X
LANCASHIRE DR.			
MUN. 1580	0	87	
	0	80	PT ↑
			SAME

MUNICIPAL

99-10 MU
00-7 MU
SS/AQ
2-21-01

SHA 51.3 - 8 Revised 4.83

MARYLAND STATE HIGHWAY ADMINISTRATION

ROAD INVENTORY SHEET

ROCKVILLE

Party Chief CG
Recorder TA
Assistant
Map No./Dir. E10 B I N
State Coordinates 752-464

Road No. MU 2925
Road Name Thompson Dairy Way
County Montgomery
Date 4/19/00
Sheet No. 1 OF 1

TRAFFIC CODES
TRAFFIC CONTROLS: STOP SIGN-SS, TRAFFIC LIGHT=T.L., FLASHING RED BALL=F.R.

TRAFFIC CODES
PARKING RESTRICTIONS: A.M. PEAK, P.M. PEAK, A.M./P.M. PEAK, NO PARKING ANYTIME=N.P., COMM/IND. ACCESS=E

SYSTEM				TRAFFIC		LINE DIAGRAM	TRAFFIC			PAVEMENT DATA
	FUNCT CLASS	HWY SYS	HPMS SAMPLE	PEAK REST	COMM/IND ACCESS		CONTROL	COMM/IND ACCESS	PEAK REST	
						See new Inv WRITTEN 02-21-01 SS/AQ Imp # 00-7 MU				
						Redland Blvd 0.32 MU 2533 @.68 (R)				
						Alley 0.30				
						0.27 305				
						Longhorn Crescent private rd 0.21				
						Watkins Circle MU 3171 @.38 0.10				
						Saddle Ridge Cir MU 2677 @.00 0.11 MU RIDGE CIR 00-7 MU				
						Saddle Ridge Circle MU 2677 @.21 0.05				26' F J C-C 2 UMC
						Watkins Circle MU 3171 @.00 0.00 Watkins Overlook MU 3172 @.00				

COUNTY _____ ROAD NO. _____ PAGE ___ OF ___

SYSTEM				TRAFFIC		LINE DIAGRAM	TRAFFIC				PAVEMENT DATA
FUNCT CLASS	HWY SYS	HPMS SAMPLE		PRES	DES		CAPACITY	COMMUNITY ACCESS	PRES. DEF.		

SHA 51.3 - 8 Revised
4.83

MARYLAND STATE HIGHWAY ADMINISTRATION

ROAD INVENTORY SHEET

00-1mJ
55/40
2-21-01

90-31, 56
AL-JK
2-21-91

Rockville 89-24, 25

91-87
GD-JK
3-25-92

GD/DR
8-14-90

Party Chief GD
Recorder OG
Assistant
Map No./Dir. I N
State Coordinates

Road No. Mun. 2934
Road Name Tower Oaks Blvd
County Montgomery
Date 3-21-89
Sheet No. 1 OF 1 2 3

TRAFFIC CODES
TRAFFIC CONTROLS: STOP SIGN=S.S., TRAFFIC LIGHT=T.L., FLASHING RED BALL=F.R.

TRAFFIC CODES
PARKING RESTRICTIONS: A.M. PEAK, P.M. PEAK, A.M./P.M. PEAK, NO PARKING ANYTIME=N.P., COMM/IND. ACCESS=E

SYSTEM | TRAFFIC | LINE DIAGRAM | TRAFFIC | PAVEMENT DATA

FED. AID. | FUNCT CLASS | HWY. SYS. | HPMS SAMPLE | PRKG. REST. | COM/IND ACCESS | CONTROL | COM/IND ACCESS | PRKG. REST.

NON FA
URBAN COLLECTOR FOLLOWS TOM
UNDER CONST

RAMP #2 LT
RAMP #9 TO
Fred
270
0 27
0 26
#10 FROM MAP #4
RAMP #10 TO 270
0 22 CBC (3x12' BOX) 24'-12'-12'
FROM I
ENT TO MONTROSE BAPTIST PARK
0 13
See new Inv
WRITTEN 2-2
SSIAS
Stop Ahead
0 11
0 15
0 10
0 04
30°
0 03
SPUR C.03/20' I 2 LT
2 ML
MONTROSE RD
0 00
RD 144
RAMP #10

E
E
TH

44' I
J-C-C
48 ML
5 ML
2-22' I
12' MIT
J-C-C
24' I
4 ML
2 ML
21' I RT
26' I LT
J-C-C
10' GR. MED
42 ML

See new Inv written 02-21-01

SS/RC Imp # 00-1014

LINE DIAGRAM

SYSTEM: FED. AID. | FUNCT. CLASS. | HWY. SYS. | HPMS SAMPLE

TRAFFIC: PRKG. REST. | COM/IND ACCESS

TRAFFIC: CONTROL | COM/IND ACCESS | PRKG. REST.

PAVEMENT DATA

found

End

0 91

0 87

0 86

0 84

(Proposed Ent)

0 82

0 78

(Proposed Ent)

PT

0 75 72

45°

0 71 68

PC

0 70

0 65

(Proposed Ent)

0 60

0 57

X-OVER

(Proposed Ent)

36' I J C-C

0 55

SPUR 0.02/18' I J C-C

0 51

PT

0 49

0 44

30°

0 41

PC

0 38

0 31

2-24' I

4-J CRB

15' GR MED

4 mi

~~44' I~~

~~FCC 20 mi~~

UNDER CONSTRUCTION

SHA 51.3 - 8 Revised
4.83

MARYLAND STATE HIGHWAY ADMINISTRATION

Rockville
91-84

ROAD INVENTORY SHEET

Party Chief GD
Recorder JK
Assistant
Map No./Dir. 1
State Coordinates

Road No. Mu 2934
Road Name Tower Oaks Blvd
County Montgomery
Date 3-25-92
Sheet No. 3 OF 3

92-2
2-18-93
BB/JS

TRAFFIC CODES
TRAFFIC CONTROLS: STOP SIGN=SS, TRAFFIC LIGHT=T.L., FLASHING RED BALL=F.R.

TRAFFIC CODES
PARKING RESTRICTIONS: A.M. PEAK, P.M. PEAK, A.M./P.M. PEAK, NO PARKING ANYTIME=N.P., COMM/IND. ACCESS=E

SYSTEM				TRAFFIC		LINE DIAGRAM	TRAFFIC			PAVEMENT DATA
FED. AID.	FUNCT CLASS	HWY. SYS.	HPMS SAMPLE	PKG. REST.	COM/IND. ACCESS		CONTROL	COM/IND. ACCESS	PKG. REST.	
	URBAN COLLECTOR									2-24'I 8'GRSMED 4 Jcrbs 4ML
							TL			2-24'I 15'Grs Med 4 Jcrbs 4 ML

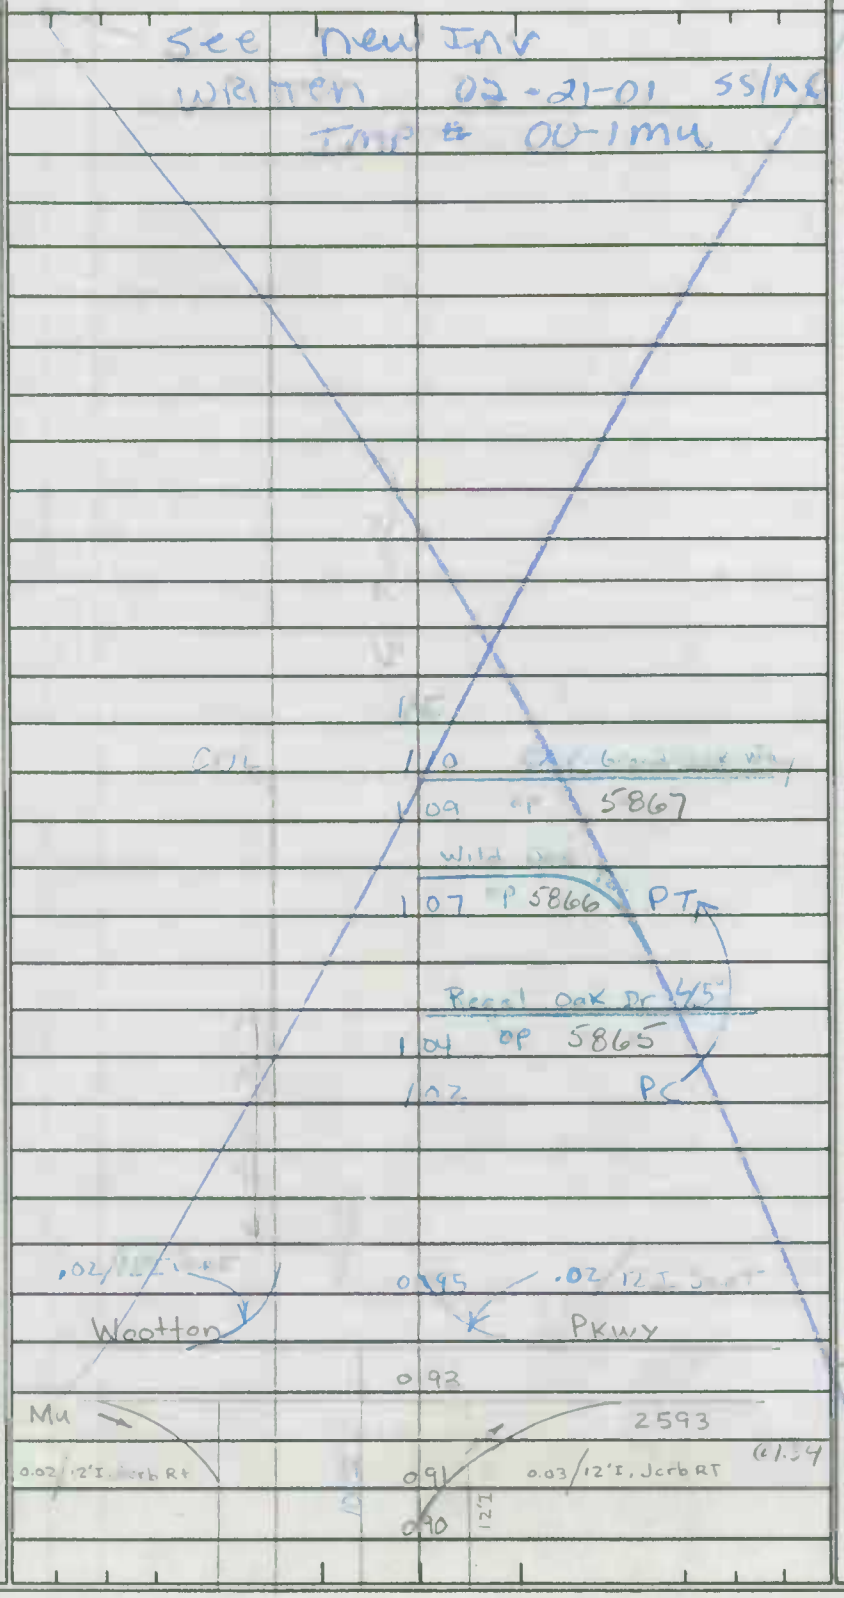

SYSTEM				TRAFFIC		LINE DIAGRAM	TRAFFIC				PAVEMENT DATA
FED. AID.	FUNCT. CLASS.	HWY. SYS.	HPMS SAMPLE	PRKG. REST.	COM/IND ACCESS		CONTROL	COM/IND ACCESS	PRKG. REST.		

ROCKVILLE

Washington Urban 98MU-4
12/7/98
SS/RB

SHA 51.3 - 8 Revised
4.83

MARYLAND STATE HIGHWAY ADMINISTRATION

ROAD INVENTORY SHEET

Party Chief SNYDER
Recorder BOOTH
Assistant
Map No./Dir. E10D / E
State Coordinates 754-455

Road No. MU 2936
Road Name TROTTER FARM DR
County MONTGOMERY
Date 12/7/98
Sheet No. 1 OF 1

TRAFFIC CODES
TRAFFIC CONTROLS: STOP SIGN-SS, TRAFFIC LIGHT=T.L., FLASHING RED BALL=F.R.

TRAFFIC CODES
PARKING RESTRICTIONS: A.M. PEAK, P.M. PEAK, A.M./P.M. PEAK, NO PARKING ANYTIME=N.P., COMM/IND. ACCESS=E

SYSTEM				TRAFFIC		LINE DIAGRAM	TRAFFIC			PAVEMENT DATA
FUNCT CLASS	HWY SYS	HPMS SAMPLE		PKG. REST.	COM/IND ACCESS		CONTROL	COM/IND ACCESS	PKG. REST.	
						See new inventory written 2/21/01 SS/AO 00-11MU				
						CREEK VALLEY LA				
						MU 0 05 0804 @.07				
										26'I
										JC-C
						WATKINS POND BLVD		SS		2UML
						MU 0 00 3173 @.34				
						(PK) 00 (PK)				

COUNTY _____ ROAD NO. _____ PAGE ___ OF ___

SYSTEM				TRAFFIC		LINE DIAGRAM	TRAFFIC				PAVEMENT DATA
FUNCT CLASS	HWY SYS	HPMS SAMPLE		PKG. REST.	OWN/INT ACCESS		CONTROL	COMMUNITY	ACCESS	PKG. REST.	

SHA 51.3-8
11-15-72

ROAD INVENTORY SHEET

~~Co 3241~~

Party Chief T. LANDON
Recorder M. ZALENSKI
Helper

Map No. 26 · 75-13
ROCKVILLE

Road No. MUN 2970
Road Name TWINBROOK PKWY
Sheet No. 1 OF 4
Date 5-21-74
County MONT.
State Coordinates 765 · 456

84-42
JE
BM
3-18-85

			LINTHICUM ST.
		0.41	MUN. 1720
PT		0.37	
30°	ENT SCHOOL	0.33	
PC		0.30	
			MARSHALL AVE.
	EXIT SCHOOL	0.27	MUN 1970
	EDWIN W. BROOMS J. HIGH SCH.	0.25	
		0.17	SHETLAND ST.
			MUN 2760
15°	EXIT SCHOOL	0.15	
ENT.	MEADOW HALL ELEM. SCH.	0.10	
	EXIT SCHOOL	0.07	
			FLETCHER PL.
		0.04	MUN. 1130
	CHURCH	0.02	
	BALTIMORE		RD
	MUN	0.00	0242

FAY
SPRINGLAKE
MINER
ENT TO APTS
MILL
2970
40' I
TC-C

HA 51.3-8
1-15-72

ROAD INVENTORY SHEET

~~Co 3241~~

85-29
RR/AL
4-9-86

Road No. MUN. 2970
Road Name TWINBROOK PKWY
Sheet No. 2 OF 4
Date 2-21-74
County MONT
State Coordinates

A/T 84-28

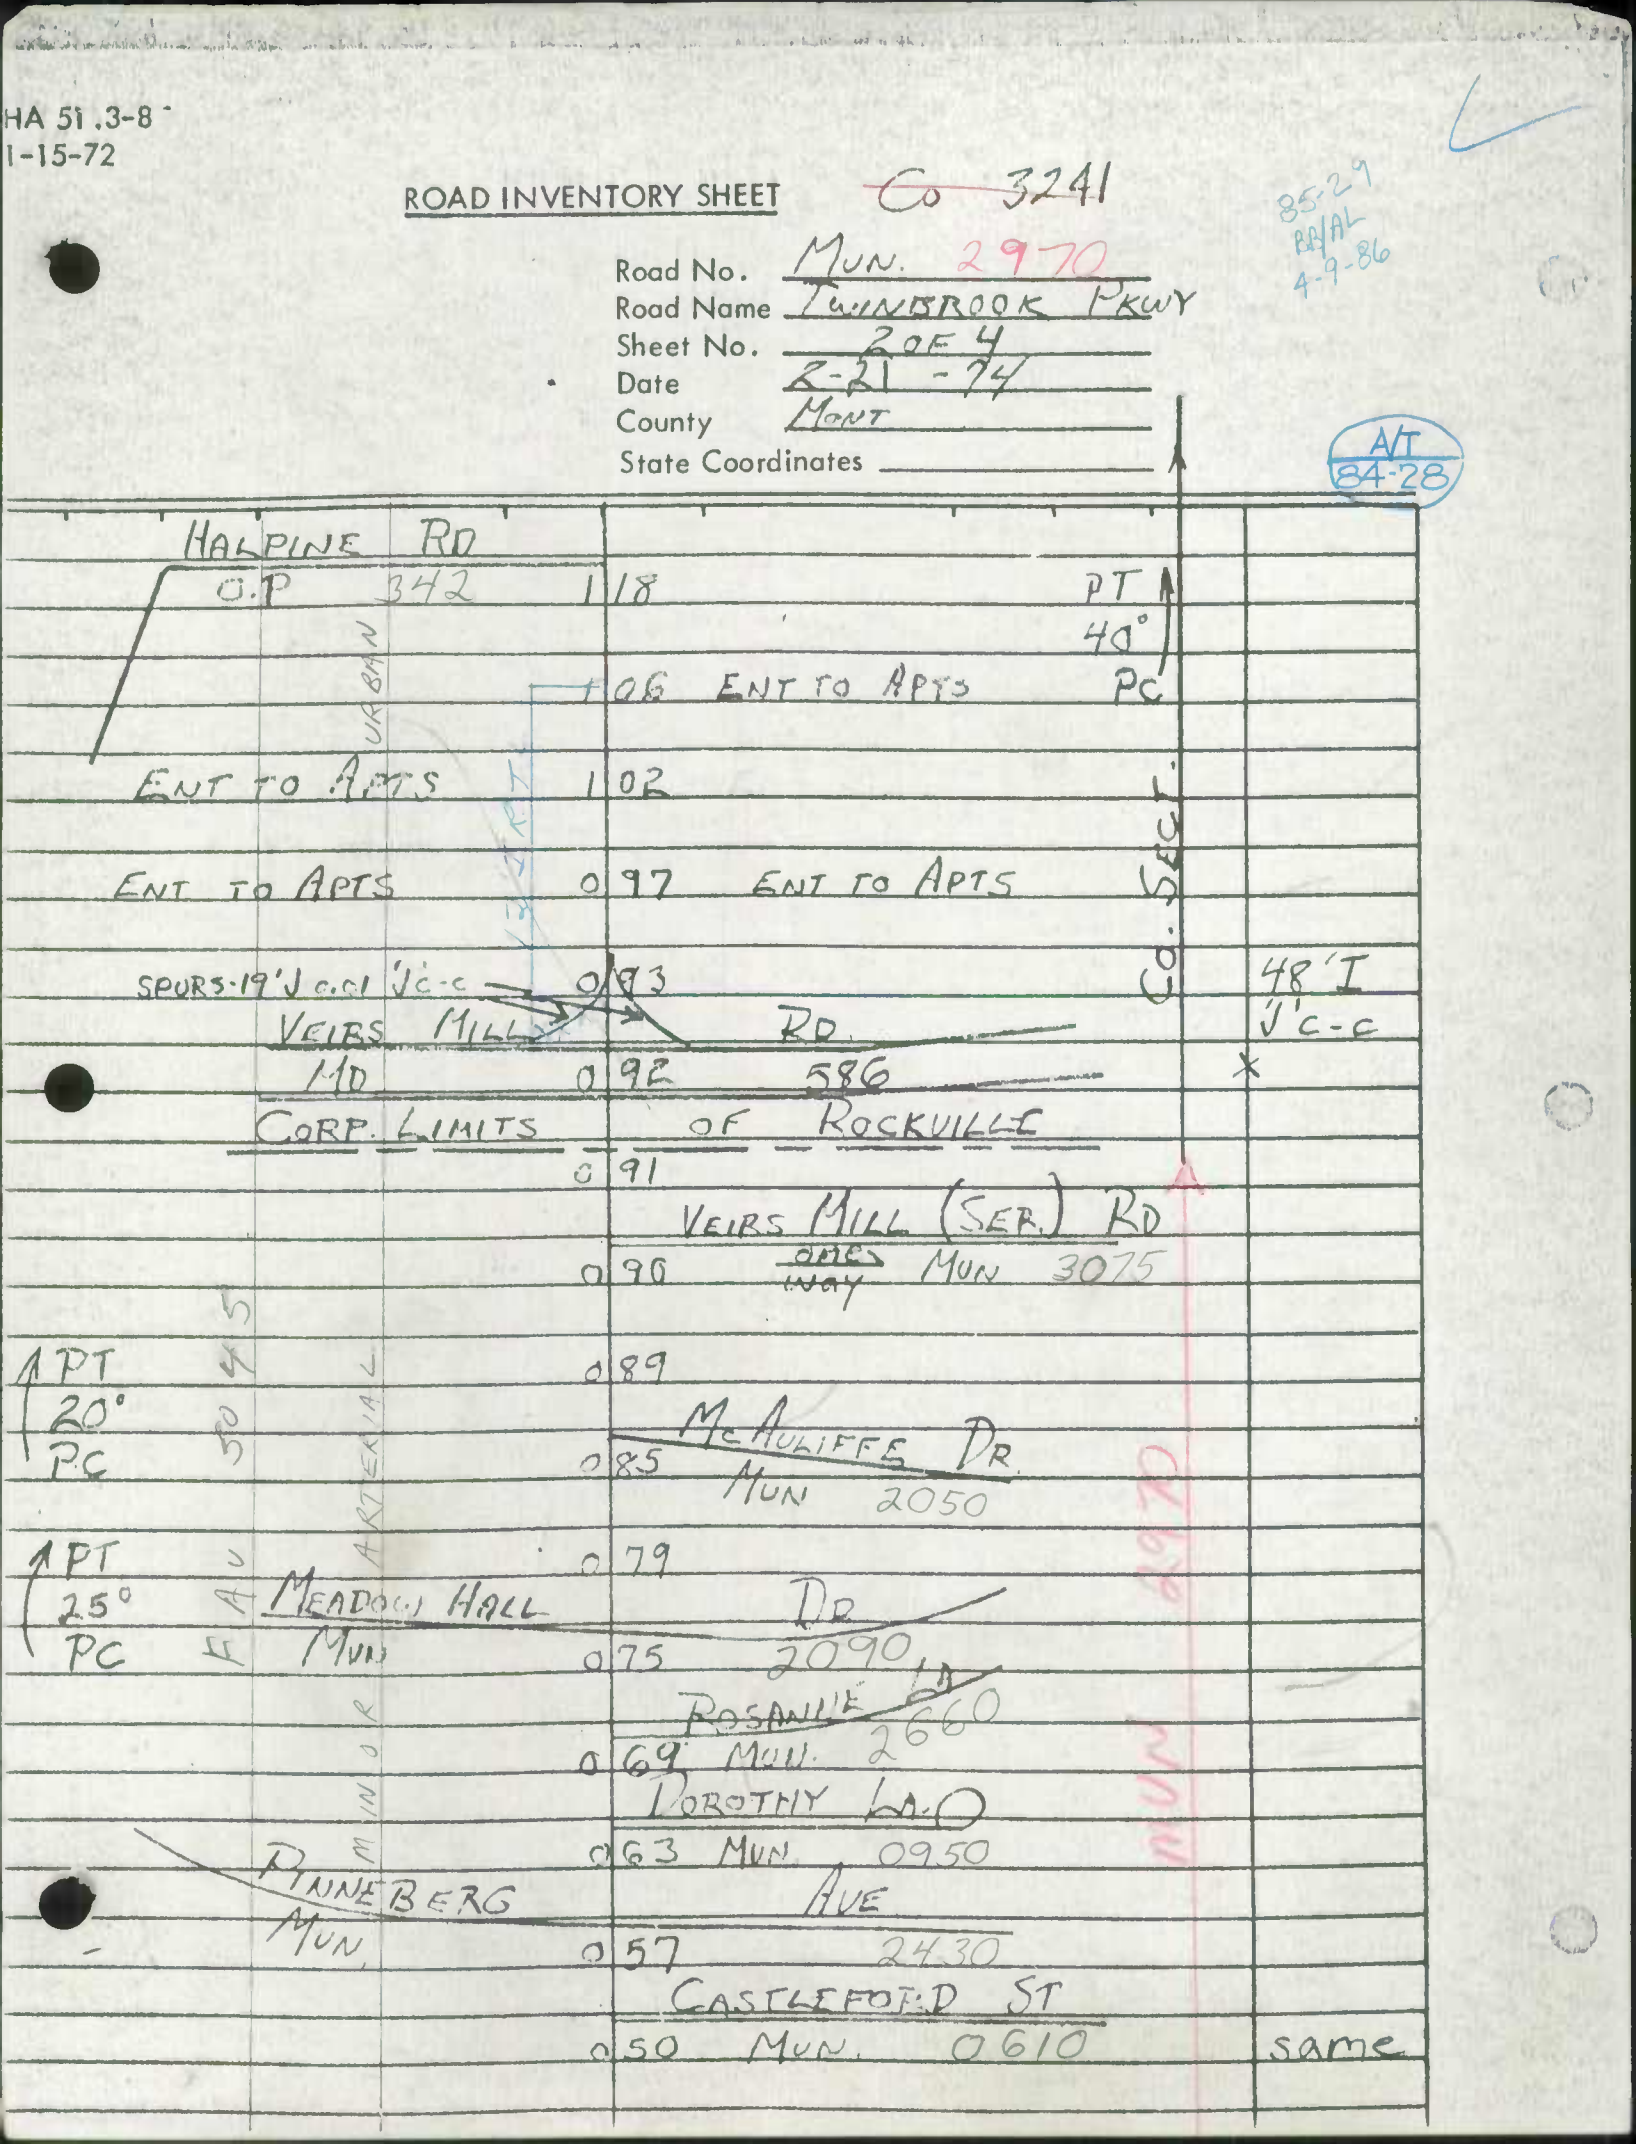

SHA 51.3-8
11-15-72

STATE HIGHWAY ADMINISTRATION OF MARYLAND

ROAD INVENTORY SHEET

~~Co 3241~~

Party Chief I. LANDON
Recorder M. ZALESKI
Helper

Road No. MUN. 2970
Road Name TWINBROOK PKWY
Sheet No. 3 OF 4
Date 2-21-74
County MONT.
State Coordinates

Map No. 26

ROCKVILLE

SOUTH URBAN — FAIRFIELD MINOR ARTERIAL

PARKLAWN ~~DR~~
Co. 3234

12'

WORCESTER ~~AVE~~ DR
~~CT~~ ~~4251~~ 3234

181
12'
10'I
175
12'T
FISHERS
Co.
LA.
172
150
RT
170
20°
168
12'T
ARDENNES AVE.
165 Co 3162
Co. HEALTH DEPT.
164
162
152 FOOD & DRUG ADMIN.
ENT TO DEPT OF H.E.W.
149
ENT TO APTS
147
RD
43
HALPINE
145
Co
ALDERBROOK CT
MON OP 349
142
BESLEY CT
125°
O.P. 348
136
PIER DR
134 MON CO 3041
ENT TO APTS
128
126 ENT TO TWINBROOK PARK

2-33I
~~2-26~~ I
1'c-c
16'grass med
~~X~~ 16ML
X
SAME

SHA 51.3-8
11-15-72

~~MUN 2972~~
~~Co 3241~~

ROAD INVENTORY SHEET

Road No. MUN 2970
Road Name TWINBROOK PKWY
Sheet No. 4 OF 4
Date 2-21-74
County MONT
State Coordinates

75-24.

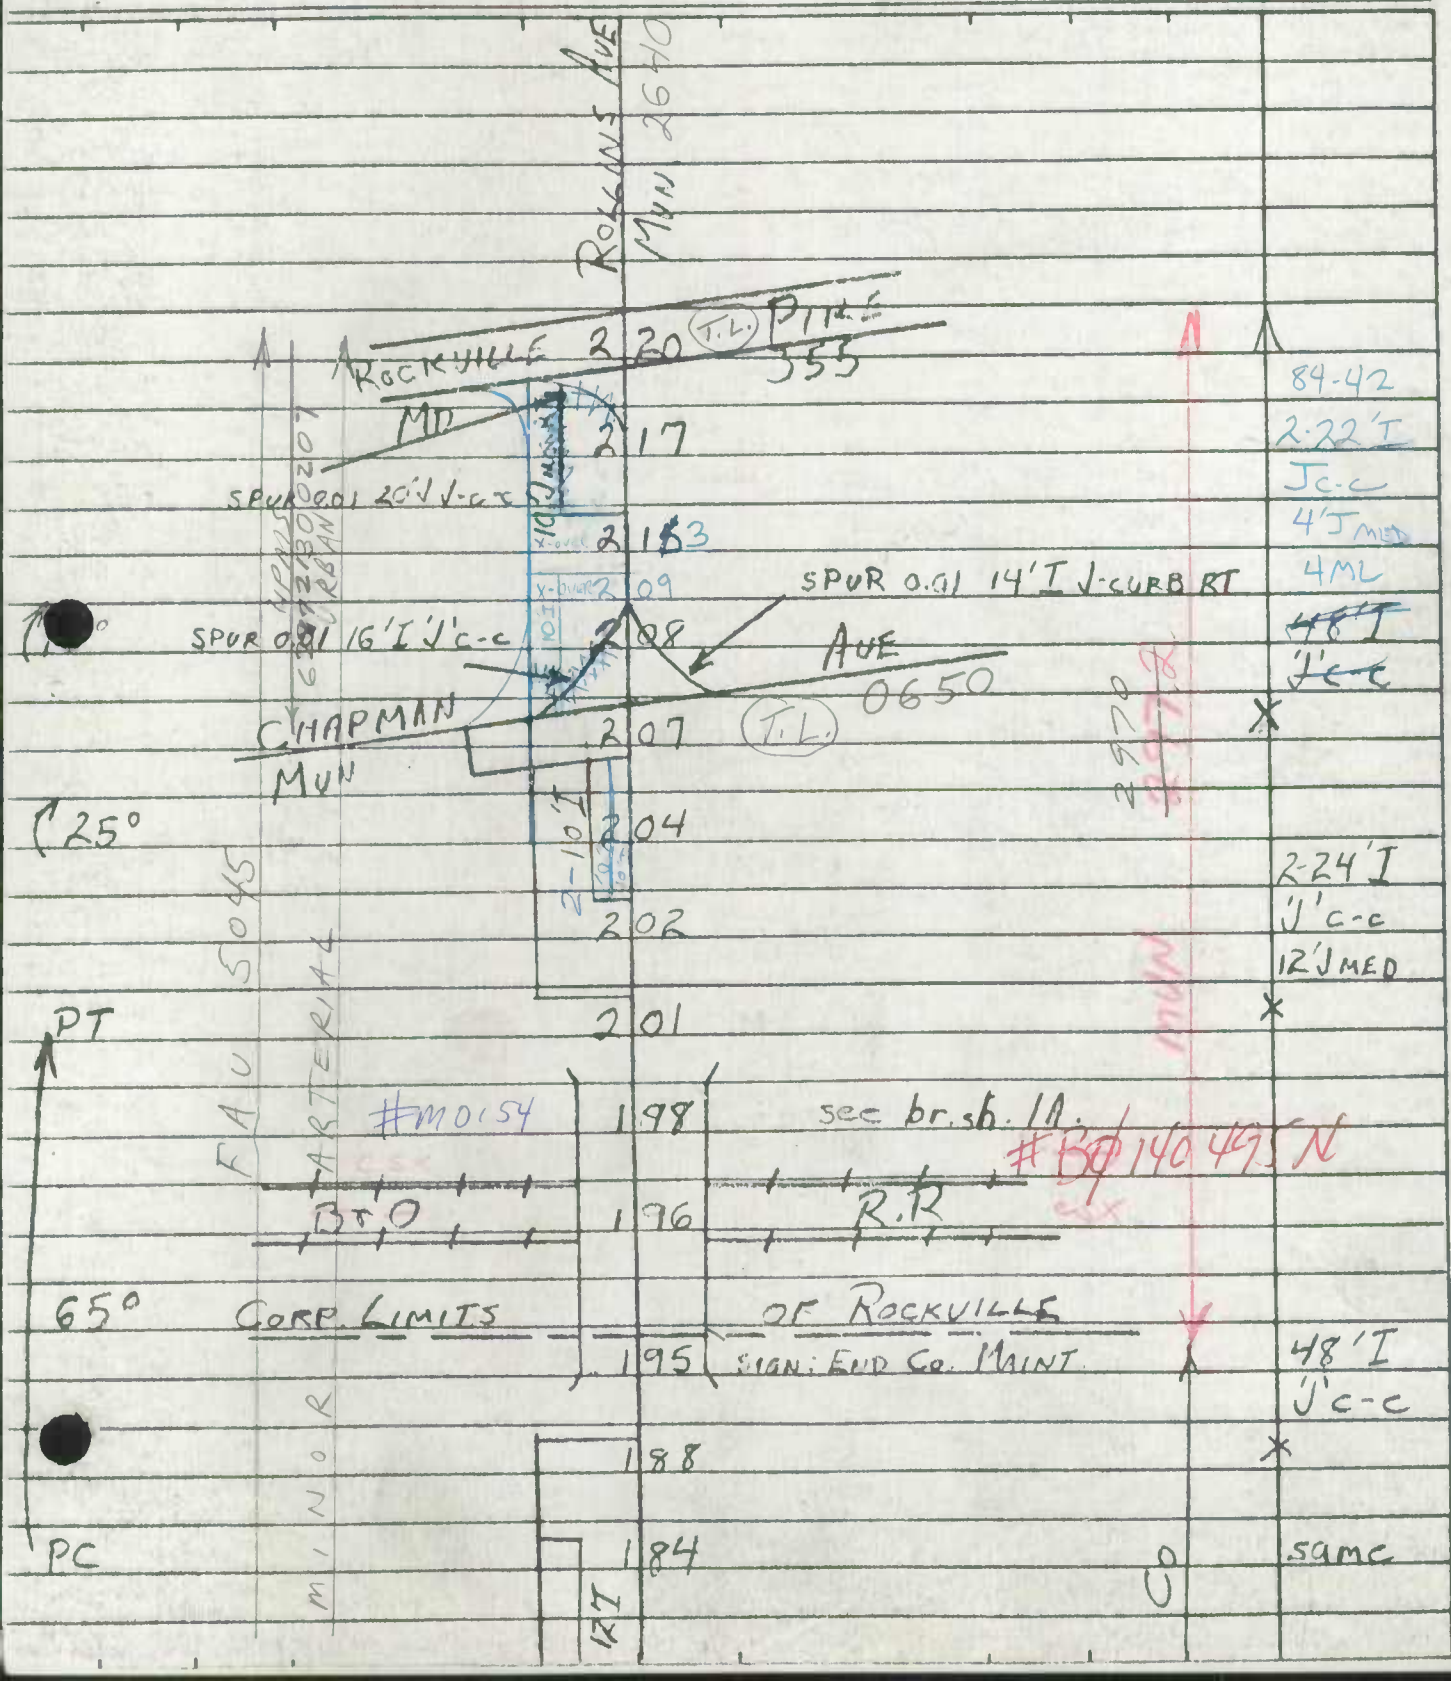

Form 5-HPS
(Revised 1961)

MARYLAND STATE ROADS COMMISSION
PLANNING AND PROGRAMMING DIVISION

S26130

~~Co 3241~~
MU 2970
TWINBROOK PKWY

IN COOPERATION WITH
U.S. BUREAU OF PUBLIC ROADS

ROAD NO. MUN.

BRIDGE SHEET

SHEET NO. 1A

PARTY NO.

DATE 2-21-74

COUNTY MONT

RATED CAPACITY

FOR ALL STRUCTURES HAVING A TOTAL OPENING OF MORE THAN 20 FEET AS DEFINED IN NOTE 1.

ODOMETER READING 1.96 NAME OF STREAM, RAILROAD OR HIGHWAY CROSSED B+O R.R.

NUMBER OF RAILROAD TRACKS 2
KIND OF CROSSING (NOTE 2)

UNDERPASS-SIMPLE UNDERPASS-COMBINED (NOTE 3) OVERPASS BRIDGE OVER SYSTEM

DESCRIPTION

NUMBER OF SPANS	LENGTH EACH SPAN (NOTE 4)	TYPE (NOTE 5)
1	37'	I-BEAM
1	42'	"
1	79'	"

TOTAL LENGTH-ON LINE OF ROAD OVER-ALL (NOTE 6) 178'

MATERIAL
SUBSTRUCTURE CONC & I BEAM SUPERSTRUCTURE CONC. & STEEL RAILS
FLOOR CONC.

CLEARANCES
ROADWAY (NOTE 7) 48'1"c-c SIDEWALK WIDTHS: RIGHT 5'J LEFT 5'J
SURFACE OF ROAD TO STREAM BED FOR OVERPASSES, SHOW DISTANCES
TO TOP OF RAIL OR SURFACE OF LOWER ROAD. 25' (EST.) (NOTE 8)
SURFACE OF ROAD TO BOTTOM PORTAL (MINIMUM OVERHEAD CLEARANCE
CLEAR DISTANCE OF OPENING ABOVE STREAM BED (WATERWAYS ONLY)
POSTED LOAD LIMITS BRIDGE NO. CONSTRUCTION DATE 1964

GENERAL CONDITION OF BRIDGE: CHECK IF GOOD, FAIR, OR POOR, DESCRIBE DEFECTS IF SERIOUS.

	GOOD	FAIR	POOR
SUPERSTRUCTURE	✓		
FLOOR	✓		
SUBSTRUCTURE	✓		

PAINT BADLY CORRODED OR RUSTED

TYPE OF PROTECTION FOR DRAWBRIDGES (NOTE9)

ROCKVILLE

Washington Suburban

98MU-10
12/7/98
SS/RB

SHA 51.3 - 8 Revised 4.83

MARYLAND STATE HIGHWAY ADMINISTRATION

ROAD INVENTORY SHEET

Party Chief SNYDER
Recorder BOOTH
Assistant
Map No./Dir. END / E
State Coordinates 754-455

Road No. MU 3172
Road Name WATKINS OVERLOOK
County MONTGOMERY
Date 12/7/98
Sheet No. 1 OF 1

TRAFFIC CODES
TRAFFIC CONTROLS: STOP SIGN-SS, TRAFFIC LIGHT=T.L., FLASHING RED BALI=F.R.

TRAFFIC CODES
PARKING RESTRICTIONS: A.M. PEAK, P.M. PEAK, A.M./P.M. PEAK, NO PARKING ANYTIME=N.P., COMM/IND. ACCESS=E

SYSTEM				TRAFFIC		LINE DIAGRAM	TRAFFIC			PAVEMENT DATA
	FUNCT CLASS	HWY SYS	HPMS SAMPLE	PKG. REST.	COM/IND ACCESS		CONTROL	COM/IND ACCESS	PKG. REST.	
						See Next Sheet MU 3172				
						(SILVER KING LA) MU 2775 0 16				
						30° 0 13				
						(BARNSIDE PL) MU 0245 0 09				
						CREEK VALLEY LA MU0804 0 05				
										26' I
						WATKINS POND BLVD				JC-C
						MU 0 00 3173		SS		2UML
						@.43				
						WATKINS Overlook (Barnes)				

COUNTY _____ ROAD NO. _____ PAGE ___ OF ___

SYSTEM				TRAFFIC		LINE DIAGRAM	TRAFFIC				PAVEMENT DATA
FUNCT. CLASS	HWY SYS	HPMS SAMPLE		PREG.	COM/IND ACCESS		CONTROL	COM/IND ACCESS	PREG.		

SHA 51.3-8
11-15-72

STATE HIGHWAY ADMINISTRATION OF MARYLAND

ROAD INVENTORY SHEET

Party Chief T. LANDON
Recorder T. ABBOTT
Helper

Road No. MUN. 3176
Road Name WATTS BRANCH PKWY
Sheet No. 1 OF 1
Date 12-12-73
County MONT.
State Coordinates 752 - 452

Map No. 26 NOW MUN. 3175
ROCKVILLE

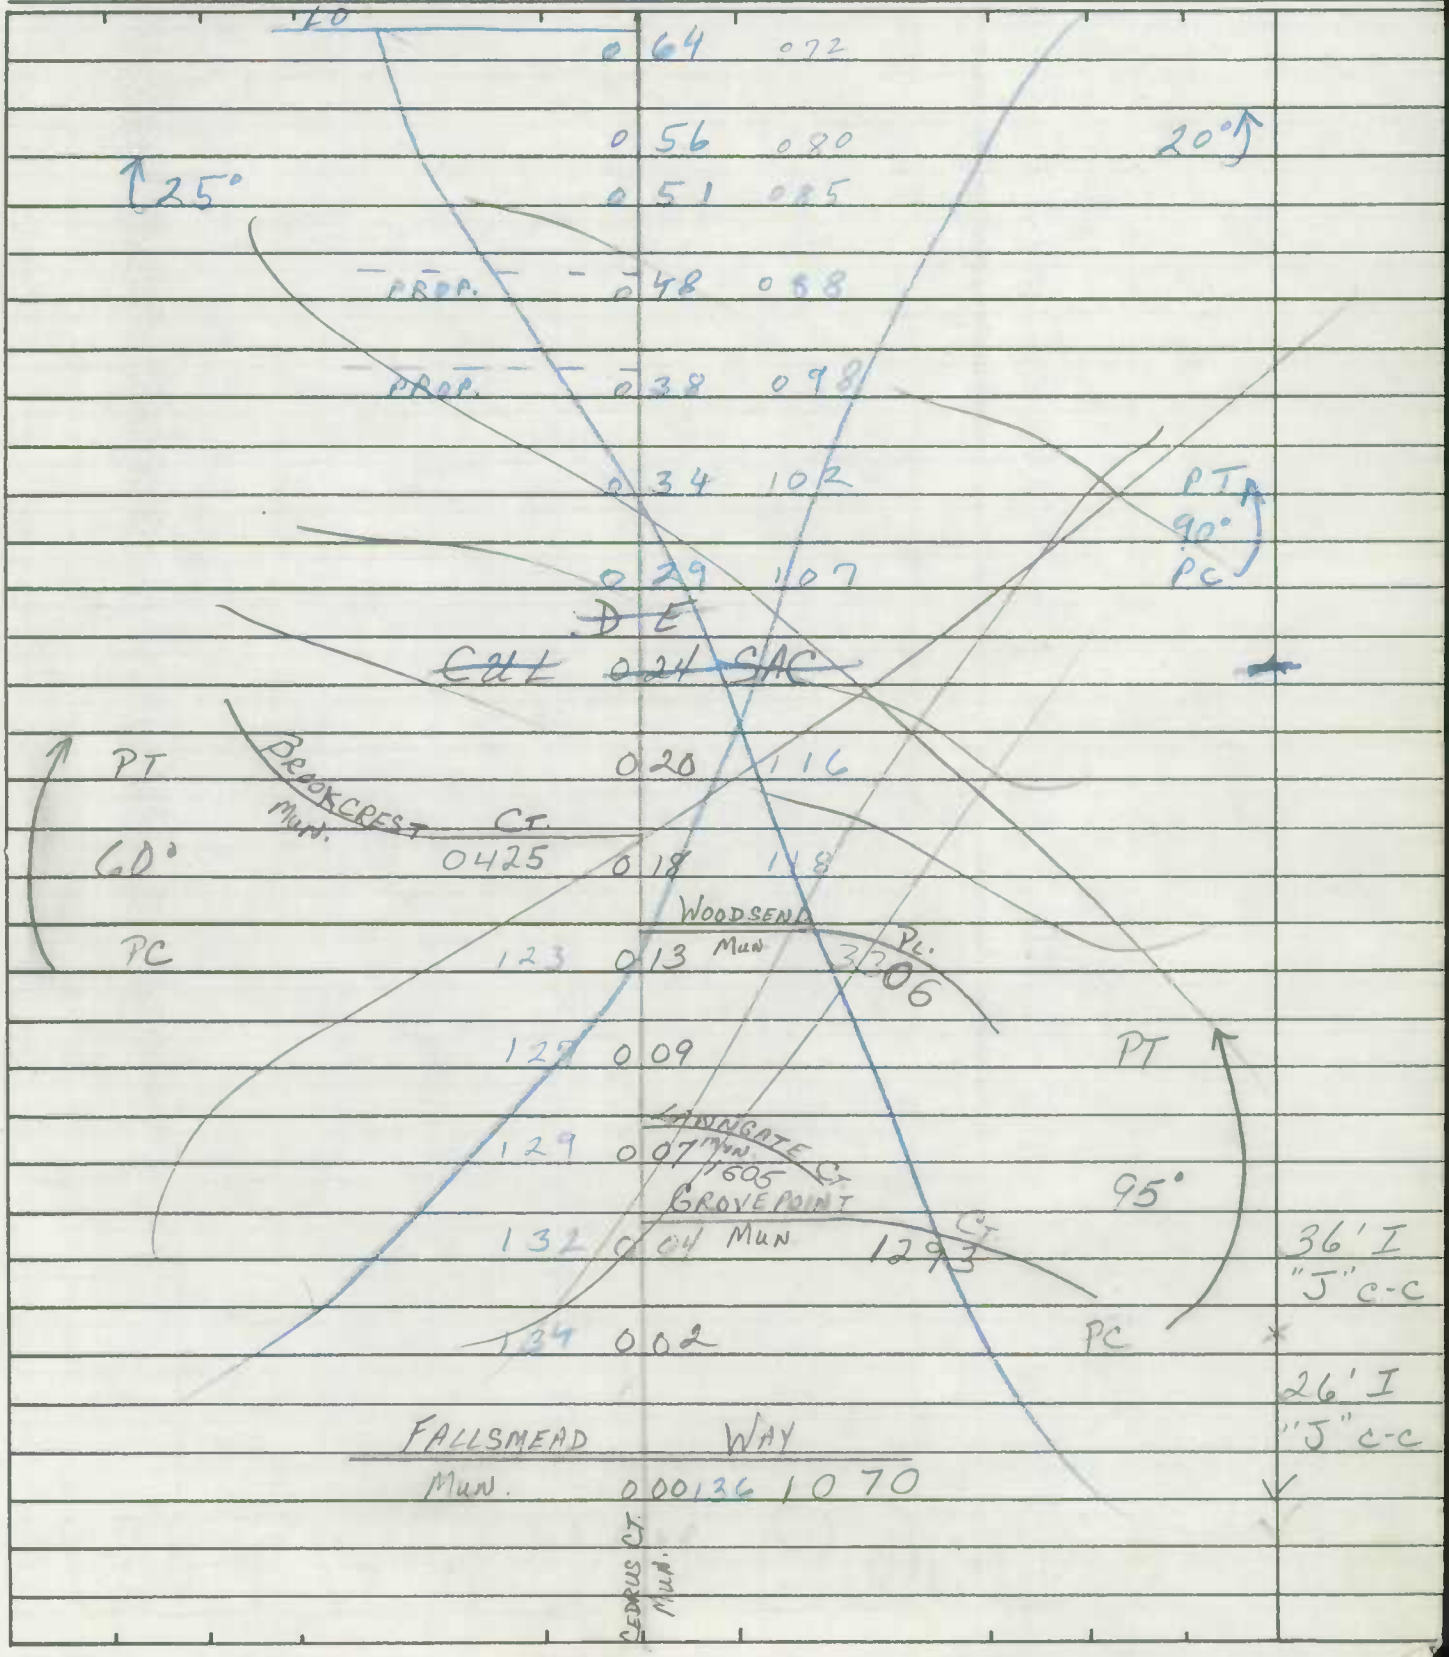

SHA 51.3-8
11-15-72

ROAD INVENTORY SHEET

Road No. _____
Road Name _____
Sheet No. _____
Date _____
County _____
State Coordinates _____

SHA 51.3-8
11-15-72

STATE HIGHWAY ADMINISTRATION OF MARYLAND WESTMORE AVE

ROAD INVENTORY SHEET

~~CO 154~~

Party Chief T. LANDON
Recorder M. ZALENSKI
Helper

Map No. 26

Road No. MUN 3210
Road Name WESTMORE RD
Sheet No. 1 OF 1
Date 3-15-74
County MONT.
State Coordinates 7510-A61

ROCKVILLE

80-80

FREDERICK AVE
MUN.
0 69 1160
0 65
0 62 CHURCH
0 58
ELIZABETH AVE
0 61 MUN. 1030
MOORE DR.
MUN 2175
0 58
T. HERBERTS LA. 350
CORP LIMITS
ASHLEY AVE
0 52 MUN 0160
WESTMORE AVE
MUN
26' I
1 C-C
0 51 OF ROCKVILLE
40°
30°
0 50
0 49
10°
90°
0 34
ROCKVILLE
24 I
30 C-W
E
NATURAL GAS PUMPING STA
0 31
CORP LIMITS (E)
0 02
RXR
ABAN. 6-24-80
BTO
0 01
R.R.
24' I
30' C-W
HUNGERFORD
MD
RXR
DR
0 00
355

SHA 51.3-8
11-15-72

STATE HIGHWAY ADMINISTRATION OF MARYLAND

ROAD INVENTORY SHEET

Party Chief W. DOMBROSKI
Recorder M. ZALENSKI
Helper

Map No. 26 75-48
ROCKVILLE

Road No. MUN 3268
Road Name W. MONTGOMERY AVE
Sheet No. 1 OF 1
Date 3-8-76
County MONT.
State Coordinates

A/T 84-22 CM
A/T 83-63 B4J

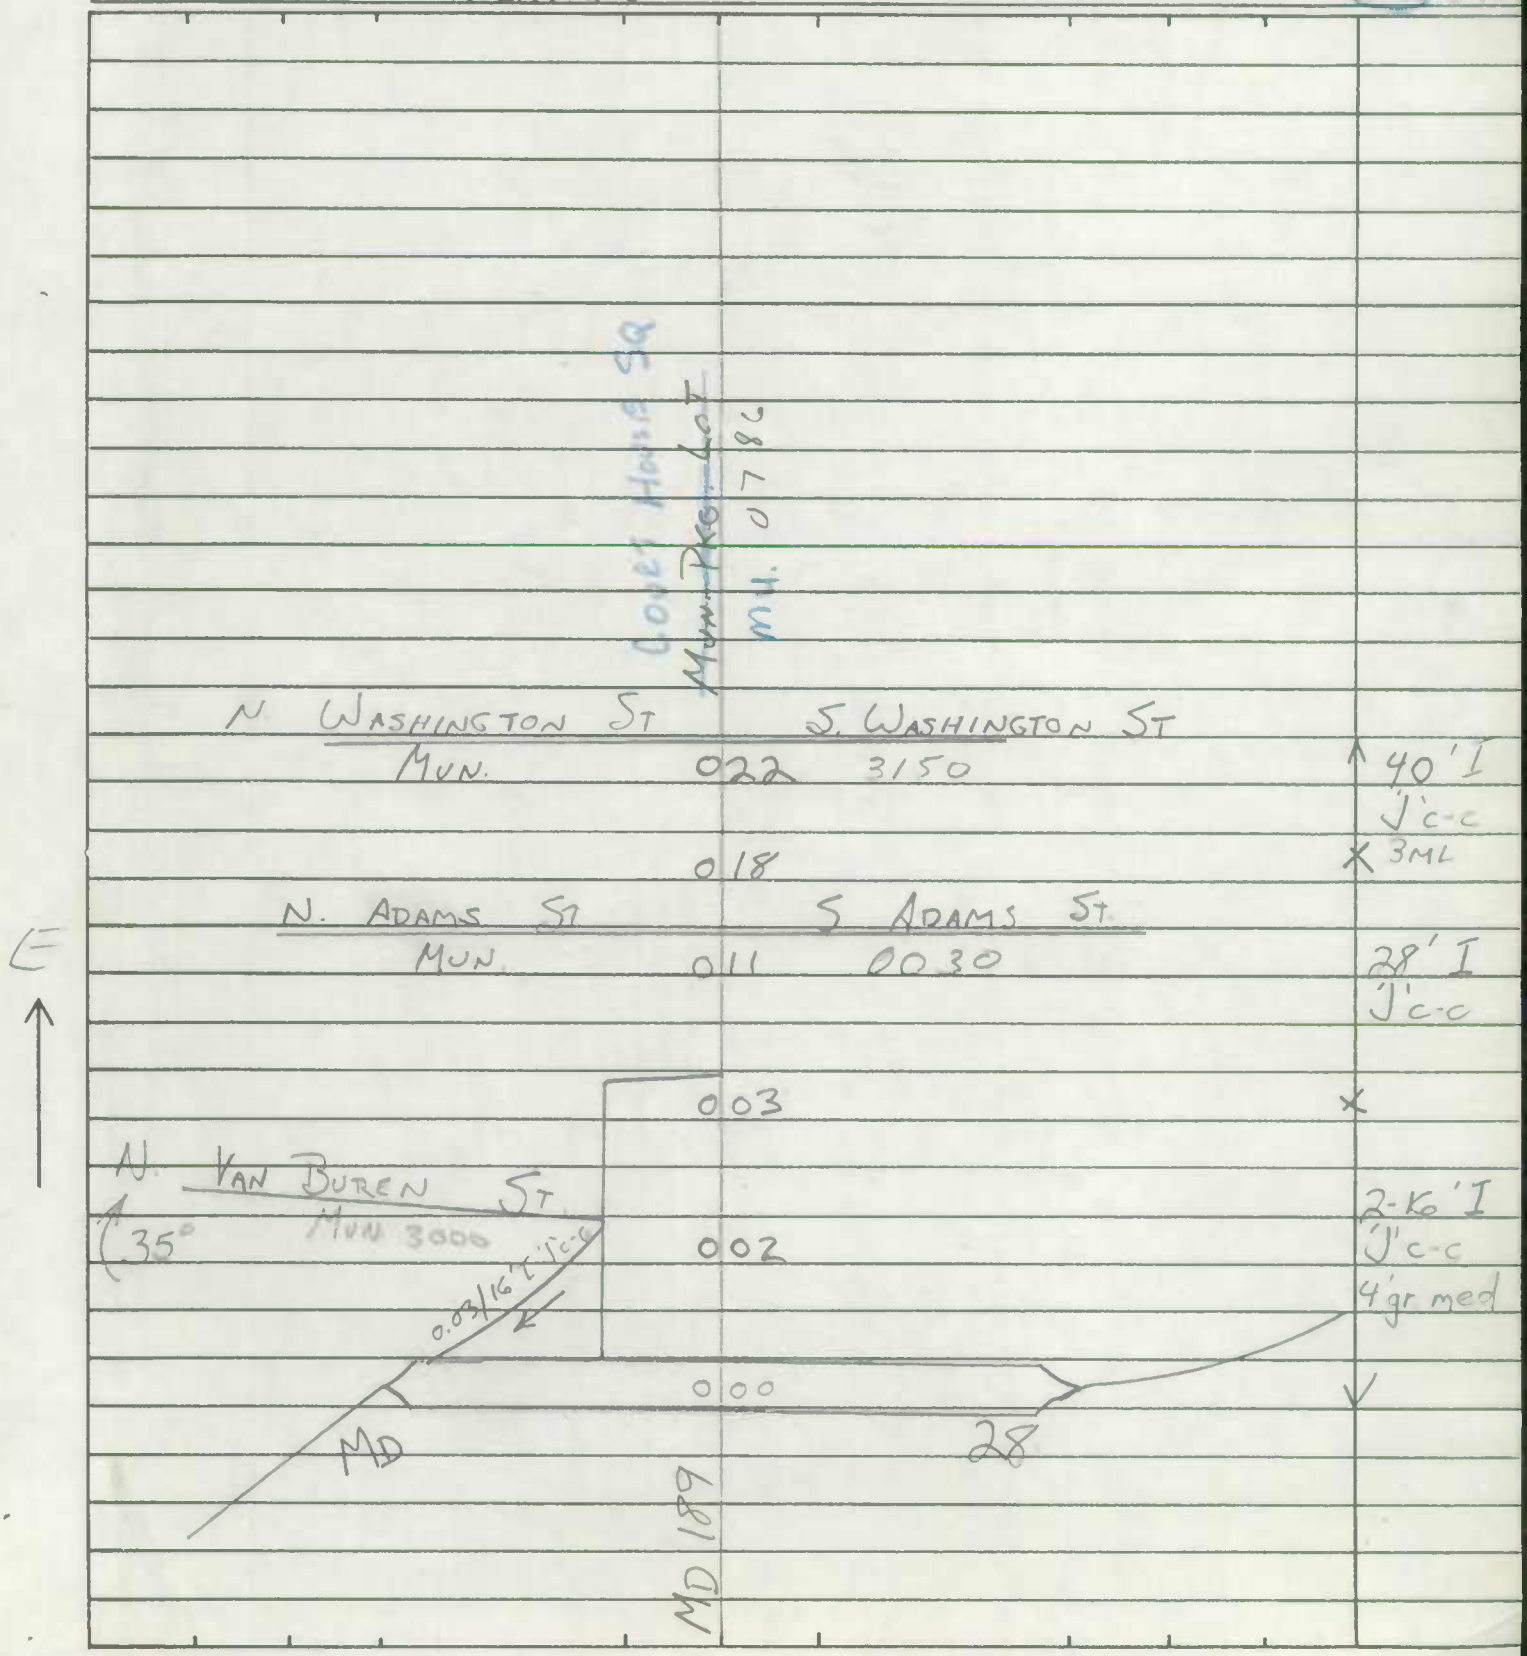

SHA 51.3-8
11-15-72

ROAD INVENTORY SHEET

Road No. _____
Road Name _____
Sheet No. _____
Date _____
County _____
State Coordinates _____

ROCKVILLE Washington Urban

98MU-6
12/7/98
SS/RB

SHA 51.3 - 8 Revised 4.83

MARYLAND STATE HIGHWAY ADMINISTRATION

00-13MU
SS/AP
2-21-01

ROAD INVENTORY SHEET

Party Chief SNYDER
Recorder BOOTH
Assistant
Map No./Dir. E10D / E
State Coordinates 754-455

Road No. MU 1247 3348
Road Name GRAND CHAMPION DR
County MONTGOMERY
Date 12/7/98
Sheet No. 1 OF 1

SYSTEM: FUNCT CLASS | HWY SYS | HPMS SAMPLE
TRAFFIC: PREG. REST. | COM/IND ACCESS

LINE DIAGRAM

TRAFFIC: CONTROL | COM/IND ACCESS | PREG. REST.
PAVEMENT DATA

TRAFFIC CODES
TRAFFIC CONTROLS: STOP SIGN-SS, TRAFFIC LIGHT=T.L., FLASHING RED BALI=F.R.

TRAFFIC CODES
PARKING RESTRICTIONS: A.M. PEAK, P.M. PEAK, A.M./P.M. PEAK, NO PARKING ANYTIME=N.P., COMM/IND. ACCESS=E

See new IMP written 02-21-01 SS/AP

ROAD END

Imp # 0 1842 00-13.22MU

SILVER KING LA

0 ~~17~~ MU 2775 @.17 PT

0 ~~16~~ 90°

0 ~~32~~ PC

BARNSIDE PL

0 ~~34~~ MU 0245 @.18

CREEK VALLEY LA

MU 0 ~~0529~~ 0804 @.21

26'I
JC-C
2UML

WATKINS POND BLVD

MU 0 ~~0024~~ 3173 SS

GRAND CHAMPION (PROP)

COUNTY _____ ROAD NO. _____ PAGE ___ OF _____

SYSTEM				TRAFFIC		LINE DIAGRAM	TRAFFIC				PAVEMENT DATA
FUNCT CLASS	HWY SYS	HPMS SAMPLE		PKG. REST.	COM/IND ACCESS		CONTROL	COM/IND ACCESS	PKG. REST.		

SHA 51.3 - 8 Revised
4.83

Rockville

MARYLAND STATE HIGHWAY ADMINISTRATION

00-20 MV
SS1AQ
2-21-01

ROAD INVENTORY SHEET

Party Chief S. SNYDER
Recorder A. QUATTROCHI
Assistant
Map No./Dir. E10-D/E
State Coordinates 754 - 455

Road No. OP 6058
Road Name GRAND CHAMPION DR
County MONTGOMERY
Date 2-21-01
Sheet No. 1 OF 1

TRAFFIC CODES
TRAFFIC CONTROLS: STOP SIGN=SS, TRAFFIC LIGHT=T.L., FLASHING RED BALL=F.R.

TRAFFIC CODES
PARKING RESTRICTIONS: A.M. PEAK, P.M. PEAK, A.M./P.M. PEAK, NO PARKING ANYTIME=N.P., COMM/IND. ACCESS=I

SYSTEM			TRAFFIC		LINE DIAGRAM	TRAFFIC			PAVEMENT DATA
FUNCT CLASS	HWY SYS	HPMS SAMPLE	PEAK REST	COMM/IND ACCESS		CONTROL	COMM/IND ACCESS	PEAK REST	
urban local					now combined w/ OP6056 01-25,33 3-25-02 AMD (KING FARM BLVD) @14 MV 0016 1555 0008 0006 PROP 0004 PROP REDLAND BLVD @84 MV 0000 2333 PROP		I		36'G JC-C 2UML
						SS			

COUNTY _____ ROAD NO. _____ PAGE ___ OF ___

SYSTEM				TRAFFIC		LINE DIAGRAM	TRAFFIC				PAVEMENT DATA
FUNCT CLASS	HWY SYS	HPMS SAMPLE		PREG	REST	OM/IND ACCESS			OM/IND ACCESS	PREG. REST.	

SHA 51.3-8
11-15-72

STATE HIGHWAY ADMINISTRATION OF MARYLAND

ROAD INVENTORY SHEET

Party Chief T. London
Recorder E. Rhodes
Helper

Map No. Rockville 77-43

Road No. Mun. 8150
Road Name ALLEY 15
Sheet No. 1 of
Date 2-28-78
County Mont.
State Coordinates

E

ROAD 0 17 END

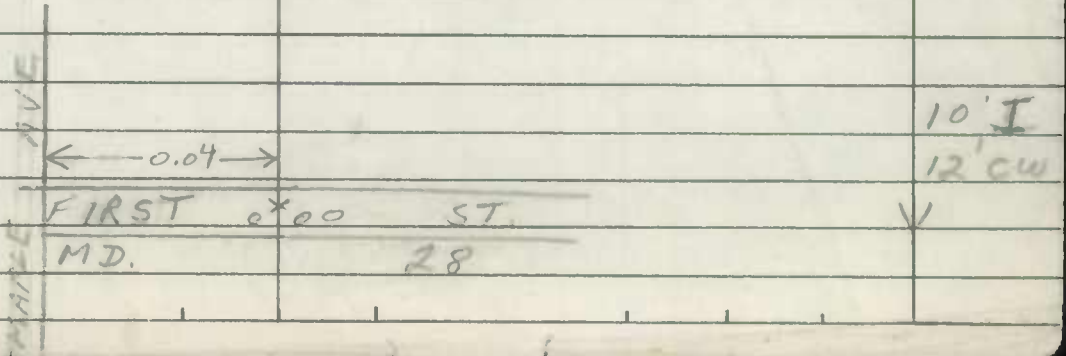

SHA 51.3-8
11-15-72

ROAD INVENTORY SHEET

Road No. _____
Road Name _____
Sheet No. _____
Date _____
County _____
State Coordinates _____

SHA 51.3 - 8 Revised
4.83

MARYLAND STATE HIGHWAY ADMINISTRATION

Rockville

ROAD INVENTORY SHEET

Party Chief _____
Recorder _____
Assistant _____
Map No./Dir. 1
State Coordinates _____

Road No. MU 8080
Road Name Alley 8
County Montgomery
Date _____
Sheet No. _____ OF _____

SYSTEM				TRAFFIC		LINE DIAGRAM	TRAFFIC			PAVEMENT DATA
FED. AID.	FUNCT CLASS.	HWY. SYS.	HPMS SAMPLE	PRKG. REST.	COM/IND. ACCESS		CONTROL	COM/IND. ACCESS	PRKG. REST.	

UNASSIGNED

NOW

OP 5716

91-86

Now MU 8080

per MUN Imp. 92-9 9/19/93 T.M.

TRAFFIC CODES

TRAFFIC CONTROLS: STOP SIGN=SS,
TRAFFIC LIGHT=T.L.,
FLASHING RED BALL=F.R.

TRAFFIC CODES

PARKING RESTRICTIONS: A.M. PEAK,
P.M. PEAK, A.M./P.M. PEAK, NO PARKING
ANYTIME=N.P., COMM/IND. ACCESS=E

SYSTEM				TRAFFIC		LINE DIAGRAM	TRAFFIC			PAVEMENT DATA
FED. AID.	FUNCT. CLASS.	HWY. SYS.	HPMS SAMPLE	PRK.G. REST.	COM/IND ACCESS		CONTROL	COM/IND ACCESS	PRK.G. REST.	

SHA 51.3-8
11-15-72

STATE HIGHWAY ADMINISTRATION OF MARYLAND

Somerset

ROAD INVENTORY SHEET

MUN 0050

Party Chief T. LANDON
Recorder M. GALEWSKI
Helper

Map No. 30

Road No. ~~C 439~~
Road Name Somerset Ave
Sheet No. 1 of 2
Date 9-1-74
County Wic
State Coordinates 22E - 41S

Somerset

W

HILLSBORO
Co.
1989
108
DP
447
HIGHLAND
Co
102
BROOKSIDE
96
DP
DP
CORR.
SORREY ST
MUN 0102
0.40
SORREY ST
0.37 MUN 0100
WARWICK
MUN
0.24
PL
0150
DEAL PL
0.16 MUN 0030
AVE
0.20
355
WISONSIN
MD
MONUMENTATION
COLLECTOR
FA
MUN

29' I
J'c-c
X 2 UML
2-14' I
J'c-c
Triangular
X 2 UML
61' I
J'c-c
2 UML

SHA 51.3-8
11-15-72

STATE HIGHWAY ADMINISTRATION OF MARYLAND

Somerset

ROAD INVENTORY SHEET

MUN 0050

Party Chief T. LANDON
Recorder M. MALINOSKI
Helper

Map No. 30

Road No. ~~C 4139~~
Road Name
Sheet No. 1 of 1
Date 9-[illegible]-74
County
State Coordinates 413

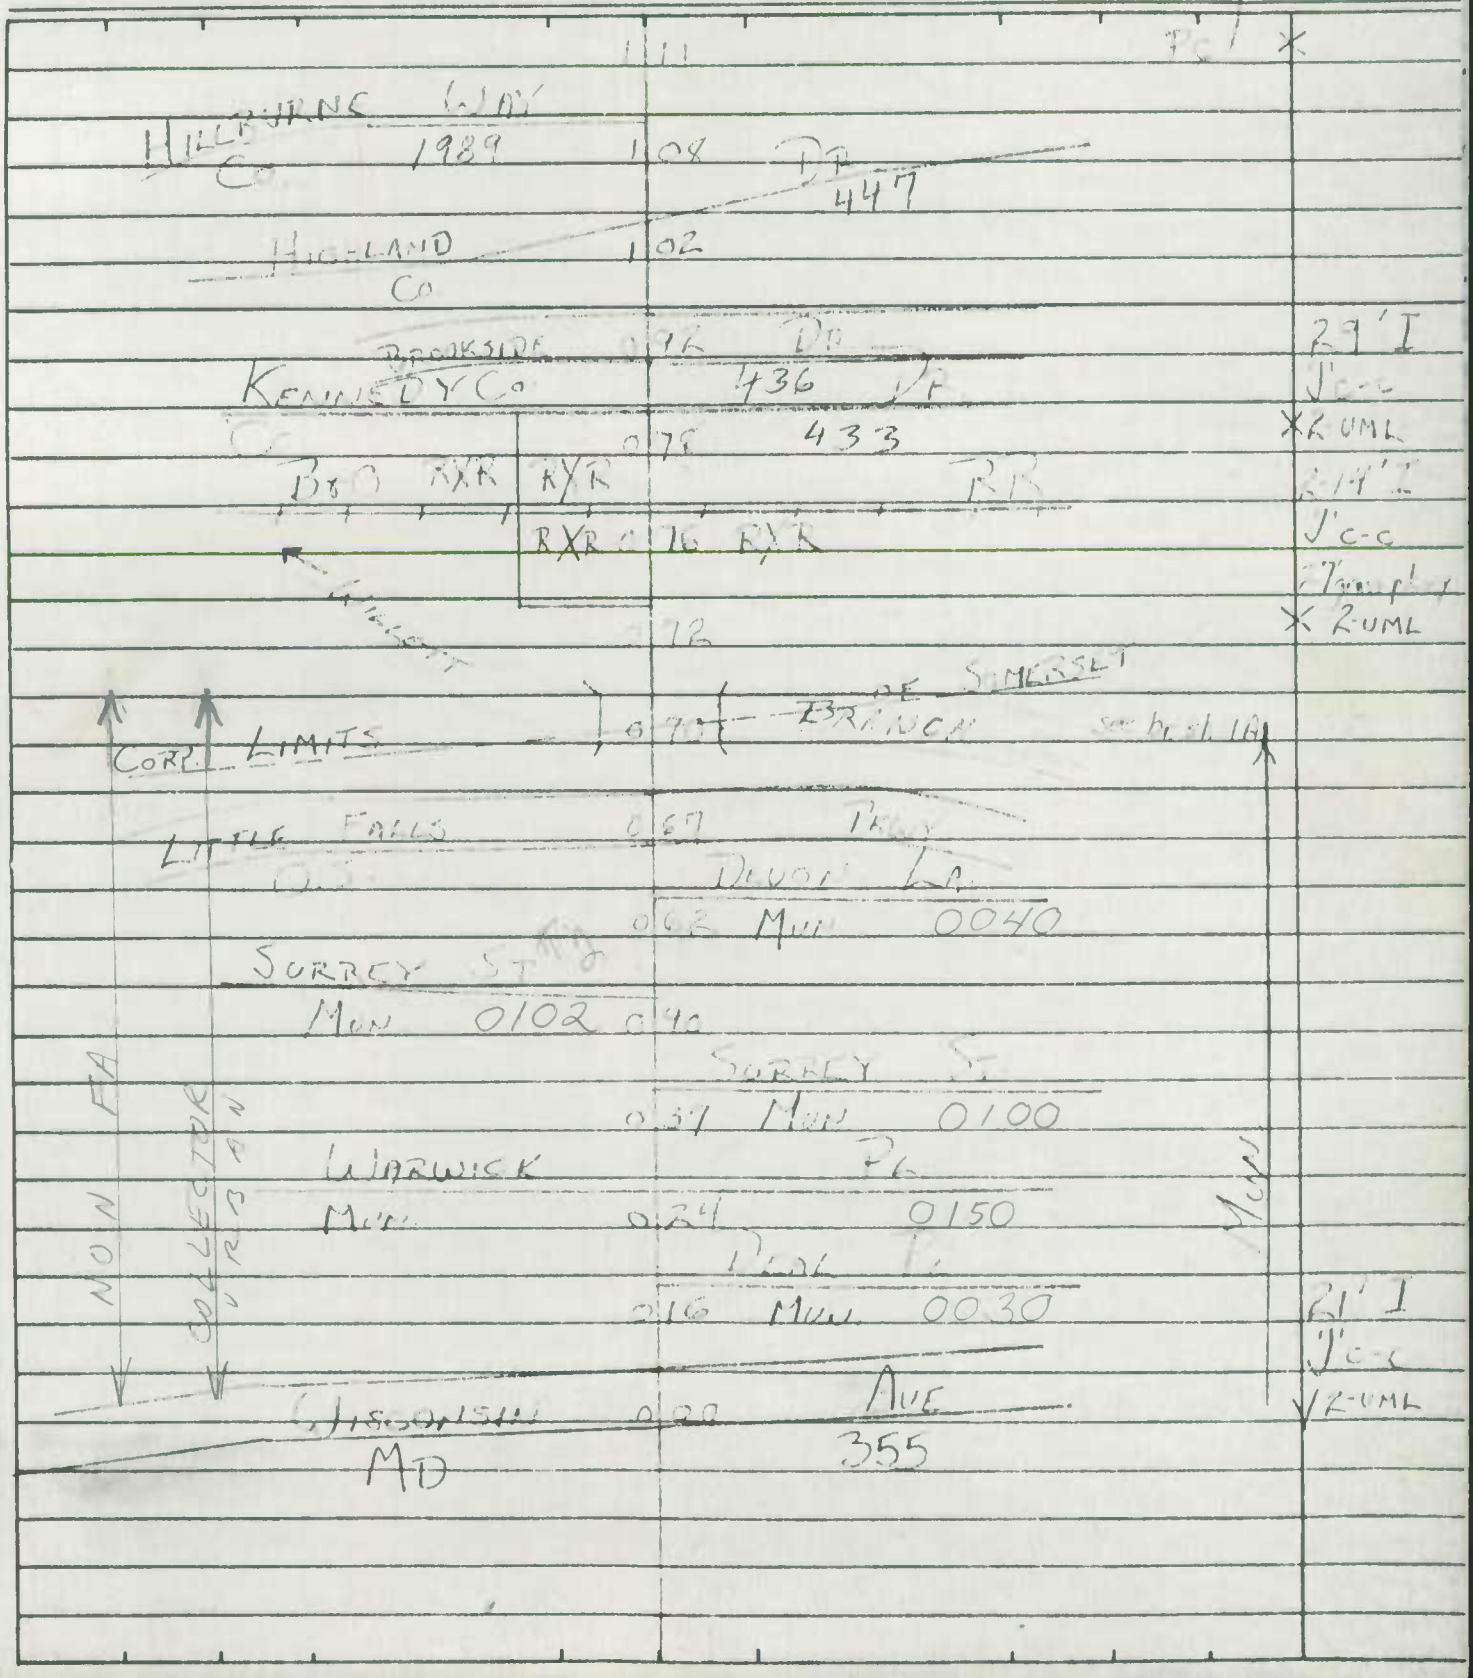

Form 5-HPS
(Revised 1961)

MARYLAND STATE ROADS COMMISSION
PLANNING AND PROGRAMMING DIVISION

S26130

IN COOPERATION WITH
U.S. BUREAU OF PUBLIC ROADS

MAP # 30
721-413

BRIDGE SHEET

DORSET AVE
ROAD NO. Co 438
SHEET NO. 1A
PARTY NO.
DATE 4-1-74
COUNTY MONT

RATED CAPACITY

FOR ALL STRUCTURES HAVING A TOTAL OPENING OF MORE THAN 20 FEET AS DEFINED IN NOTE 1.

ODOMETER READING 0.70 NAME OF STREAM, RAILROAD OR HIGHWAY CROSSED WILLETT BRANCH

NUMBER OF RAILROAD TRACKS
KIND OF CROSSING (NOTE 2)

UNDERPASS-SIMPLE UNDERPASS-COMBINED (NOTE 3) OVERPASS BRIDGE OVER SYSTEM

DESCRIPTION

NUMBER OF SPANS	LENGTH EACH SPAN (NOTE 4)	TYPE (NOTE 5)
1	9'	Conc Box
1	16	Conc Box

TOTAL LENGTH-ON LINE OF ROAD OVER-ALL (NOTE 6) 26'

MATERIAL
SUBSTRUCTURE Conc SUPERSTRUCTURE None
FLOOR Conc

CLEARANCES
ROADWAY (NOTE 7) 21' Curb to Curb SIDEWALK WIDTHS: RIGHT None LEFT
SURFACE OF ROAD TO STREAM BED 6' FOR OVERPASSES, SHOW DISTANCES TO TOP OF RAIL OR SURFACE OF LOWER ROAD. (NOTE 8)
SURFACE OF ROAD TO BOTTOM PORTAL (MINIMUM OVERHEAD CLEARANCE
CLEAR DISTANCE OF OPENING ABOVE STREAM BED 6' (WATERWAYS ONLY)
POSTED LOAD LIMITS BRIDGE NO. CONSTRUCTION DATE

GENERAL CONDITION OF BRIDGE: CHECK IF GOOD, FAIR, OR POOR, DESCRIBE DEFECTS IF SERIOUS.

	GOOD	FAIR	POOR
~~SUPERSTRUCTURE~~			
FLOOR		✓	
SUBSTRUCTURE		✓	

~~PAINT~~ BADLY CORRODED OR RUSTED

TYPE OF PROTECTION FOR DRAWBRIDGES (NOTE9)

(NOTES ON REVERSE SIDE)

SHA 51.3-8
11-15-72

STATE HIGHWAY ADMINISTRATION OF MARYLAND

Takoma Park

ROAD INVENTORY SHEET

MUN 0020

Party Chief T. LANDON
Recorder M. GALENSKI
Helper

Map No. 31

Road No. C-704
Road Name ALFRED, DR
Sheet No. 1 of 1
Date 5-17-74
County MONT
State Coordinates 795-419

Takoma Park

N

CORP LIMITS OF TAKOMA PARK

0004

BOSTON MUN.

0000

ALT

0110

20' H
26' CW
2 UML

26' I
4 C.C.
2 UML

SHA 51.3-8
11-15-72

STATE HIGHWAY ADMINISTRATION OF MARYLAND

Takoma Park

ROAD INVENTORY SHEET

MUN 0020

Party Chief T. LANDON
Recorder M. GALENSKI
Helper

Map No. 31

Road No. C - 4
Road Name ALFRED DR
Sheet No. 1 of 1
Date 5-17-74
County MONT
State Coordinates 715 419

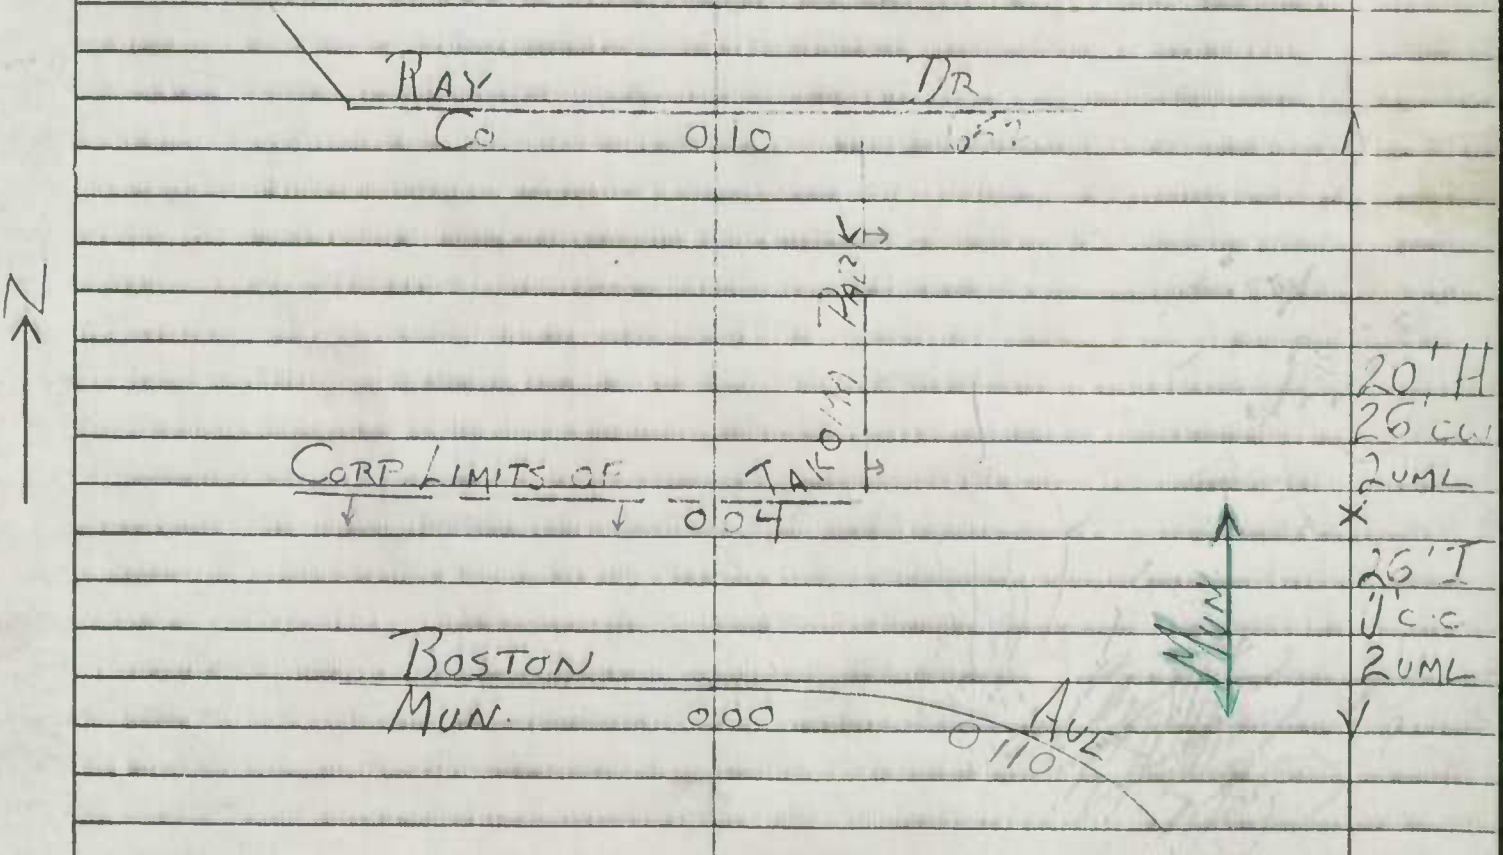

SHA 51.3-8
11-15-72

STATE HIGHWAY ADMINISTRATION OF MARYLAND

91-3
GD-JK
3-24-92

ROAD INVENTORY SHEET

Party Chief W. Dombroski
Recorder M. Zakenski
Helper

Map No. 31
TAKOMA PARK

Road No. MUN. 0030
Road Name ALLEGHENY AVE
Sheet No. 1 of 1
Date 5-23-74
County Montgomery & PR. GEO
State Coordinates 798-415

92 10 80-2

ALLEGHENY AVE
P.G. Co RD 465

C/L HIGHLAND AVE OF TAKOMA PARK
~~P.G. Co. RD~~ 0129
MUN 0640

0128 — 23'I, ~~19'I~~, J'c-c, 2UML

SECOND AVE
MUN 0120 1160 ~~0030~~ — X

CO LINE
LINE

SE ↑

PR. GEO CO 0117
MONT CO

21', ~~19'I~~, J'c-c, 2UML

0107 — 30°, X

23'I, J'c-c, 2UML

ELM AVE
MUN 0000 0390

LANDUSE PHOTOS VERIFIED 7/11/80

SHA 51.3-8
11-15-72

ROAD INVENTORY SHEET

Road No. _____
Road Name _____
Sheet No. _____
Date _____
County _____
State Coordinates _____

SHA 51.3-8
11-15-72

STATE HIGHWAY ADMINISTRATION OF MARYLAND

ROAD INVENTORY SHEET

MUN 0230

Party Chief: T. LANTON
Recorder: M. ZALESKI
Helper:

Map No.: 31

Road No.: Co 656
Road Name: CHICAGO AVE
Sheet No.: 1 of 3
Date: 5-17-74
County: MONT
State Coordinates: 711-421

MUN
RTE 95

0.40 FENTON ST
Co 629
AVE
NEW YORK
MUN 1030 0.37
Co 1388
ISLINGTON ST
0.32 Co 683
PHILADELPHIA
MD
AVE
0.27 410
Co 658
BOSTON
MUN 0110 0.20
AVE
0.16
CL BOUNDARY AVE
C/L Co 654
0.11 657
RICHMOND
Co
AVE
GIST
AVE
Co
0.06
CHESAPEAKE
Co
0.01 AVE
AVE
339
0.00
SLIGO
MD

20'H
24'CW
2 UNL

25'H
2 UNL

25'H
30'CW
2 UNL

30'H
1 C-C
2 UNL

S

SHA 51.3-8
11-15-72

STATE HIGHWAY ADMINISTRATION OF MARYLAND

ROAD INVENTORY SHEET

Party Chief W. Dombroski
Recorder M. Zalenski
Helper

Map No. 31

Road No. MUN. 0250
Road Name COCKERILLE AVE
Sheet No. 1 of 1
Date 5-23-74
County Montgomery + PR. Geo
State Coordinates 799-414

TAKOMA PARK 81-10

FIRST AVE ~~ROAD~~ ~~END~~
MUN 0458 0 19

NW

MONT CO. / PR. GEO — 0 15 Co — LINE / LINE

SPRING AVE
0 11 MUN 1190

SECOND AVE
MUN 1160 0 10

↑ CORP LIMITS OF TAKOMA PARK ↑
0 00

HIGHLAND AVE
P.G. Co. RD

COCKERILLE AVE
P.G. Co. RD

24' I
JC-C
~~26' I~~
~~30' CW~~
~~2 UML~~
X
23' I
1 C-C
2 UML

SHA 51.3-8
11-15-72

ROAD INVENTORY SHEET

Road No. _____
Road Name _____
Sheet No. _____
Date _____
County _____
State Coordinates _____

SHA 51.3-8
11-15-72

STATE HIGHWAY ADMINISTRATION OF MARYLAND

ROAD INVENTORY SHEET

MUN 0340

Party Chief: T. LANDON
Recorder: M. ZALENSKI
Helper:

Map No. 31

Road No. Co 119
Road Name RIVER AVE
Sheet No. 1 OF 1
Date 5-16-74
County MONT
State Coordinates 719-123 - 92-2

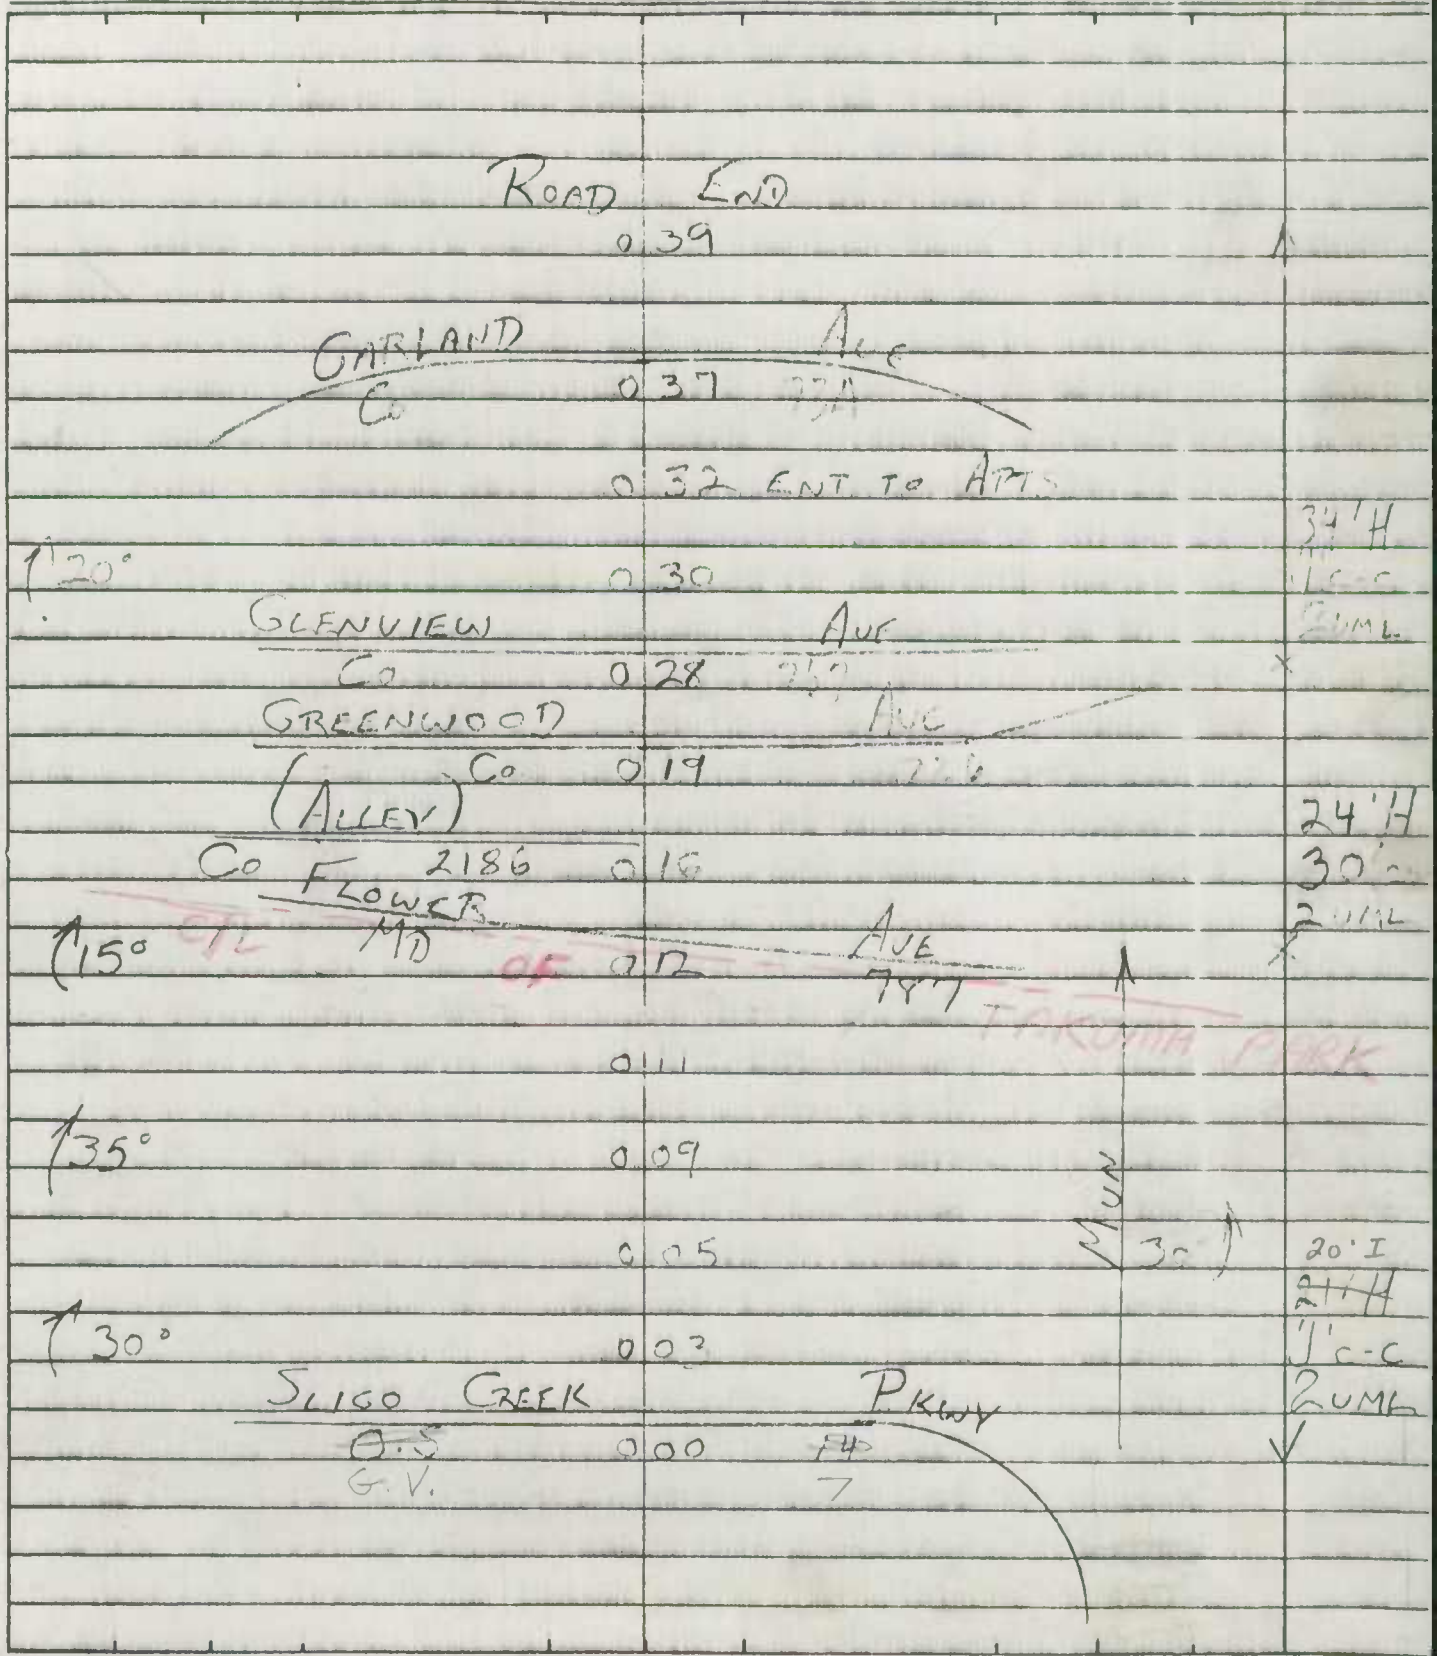

SHA 51.3-8
11-15-72

460

ROAD INVENTORY SHEET

MUN. ~~460~~ 455

Road No. Co. ~~629~~
Road Name FENTON ST
Sheet No. 2 of 2
Date 3-15-74
County MONT
State Coordinates

Takoma Park

79-1

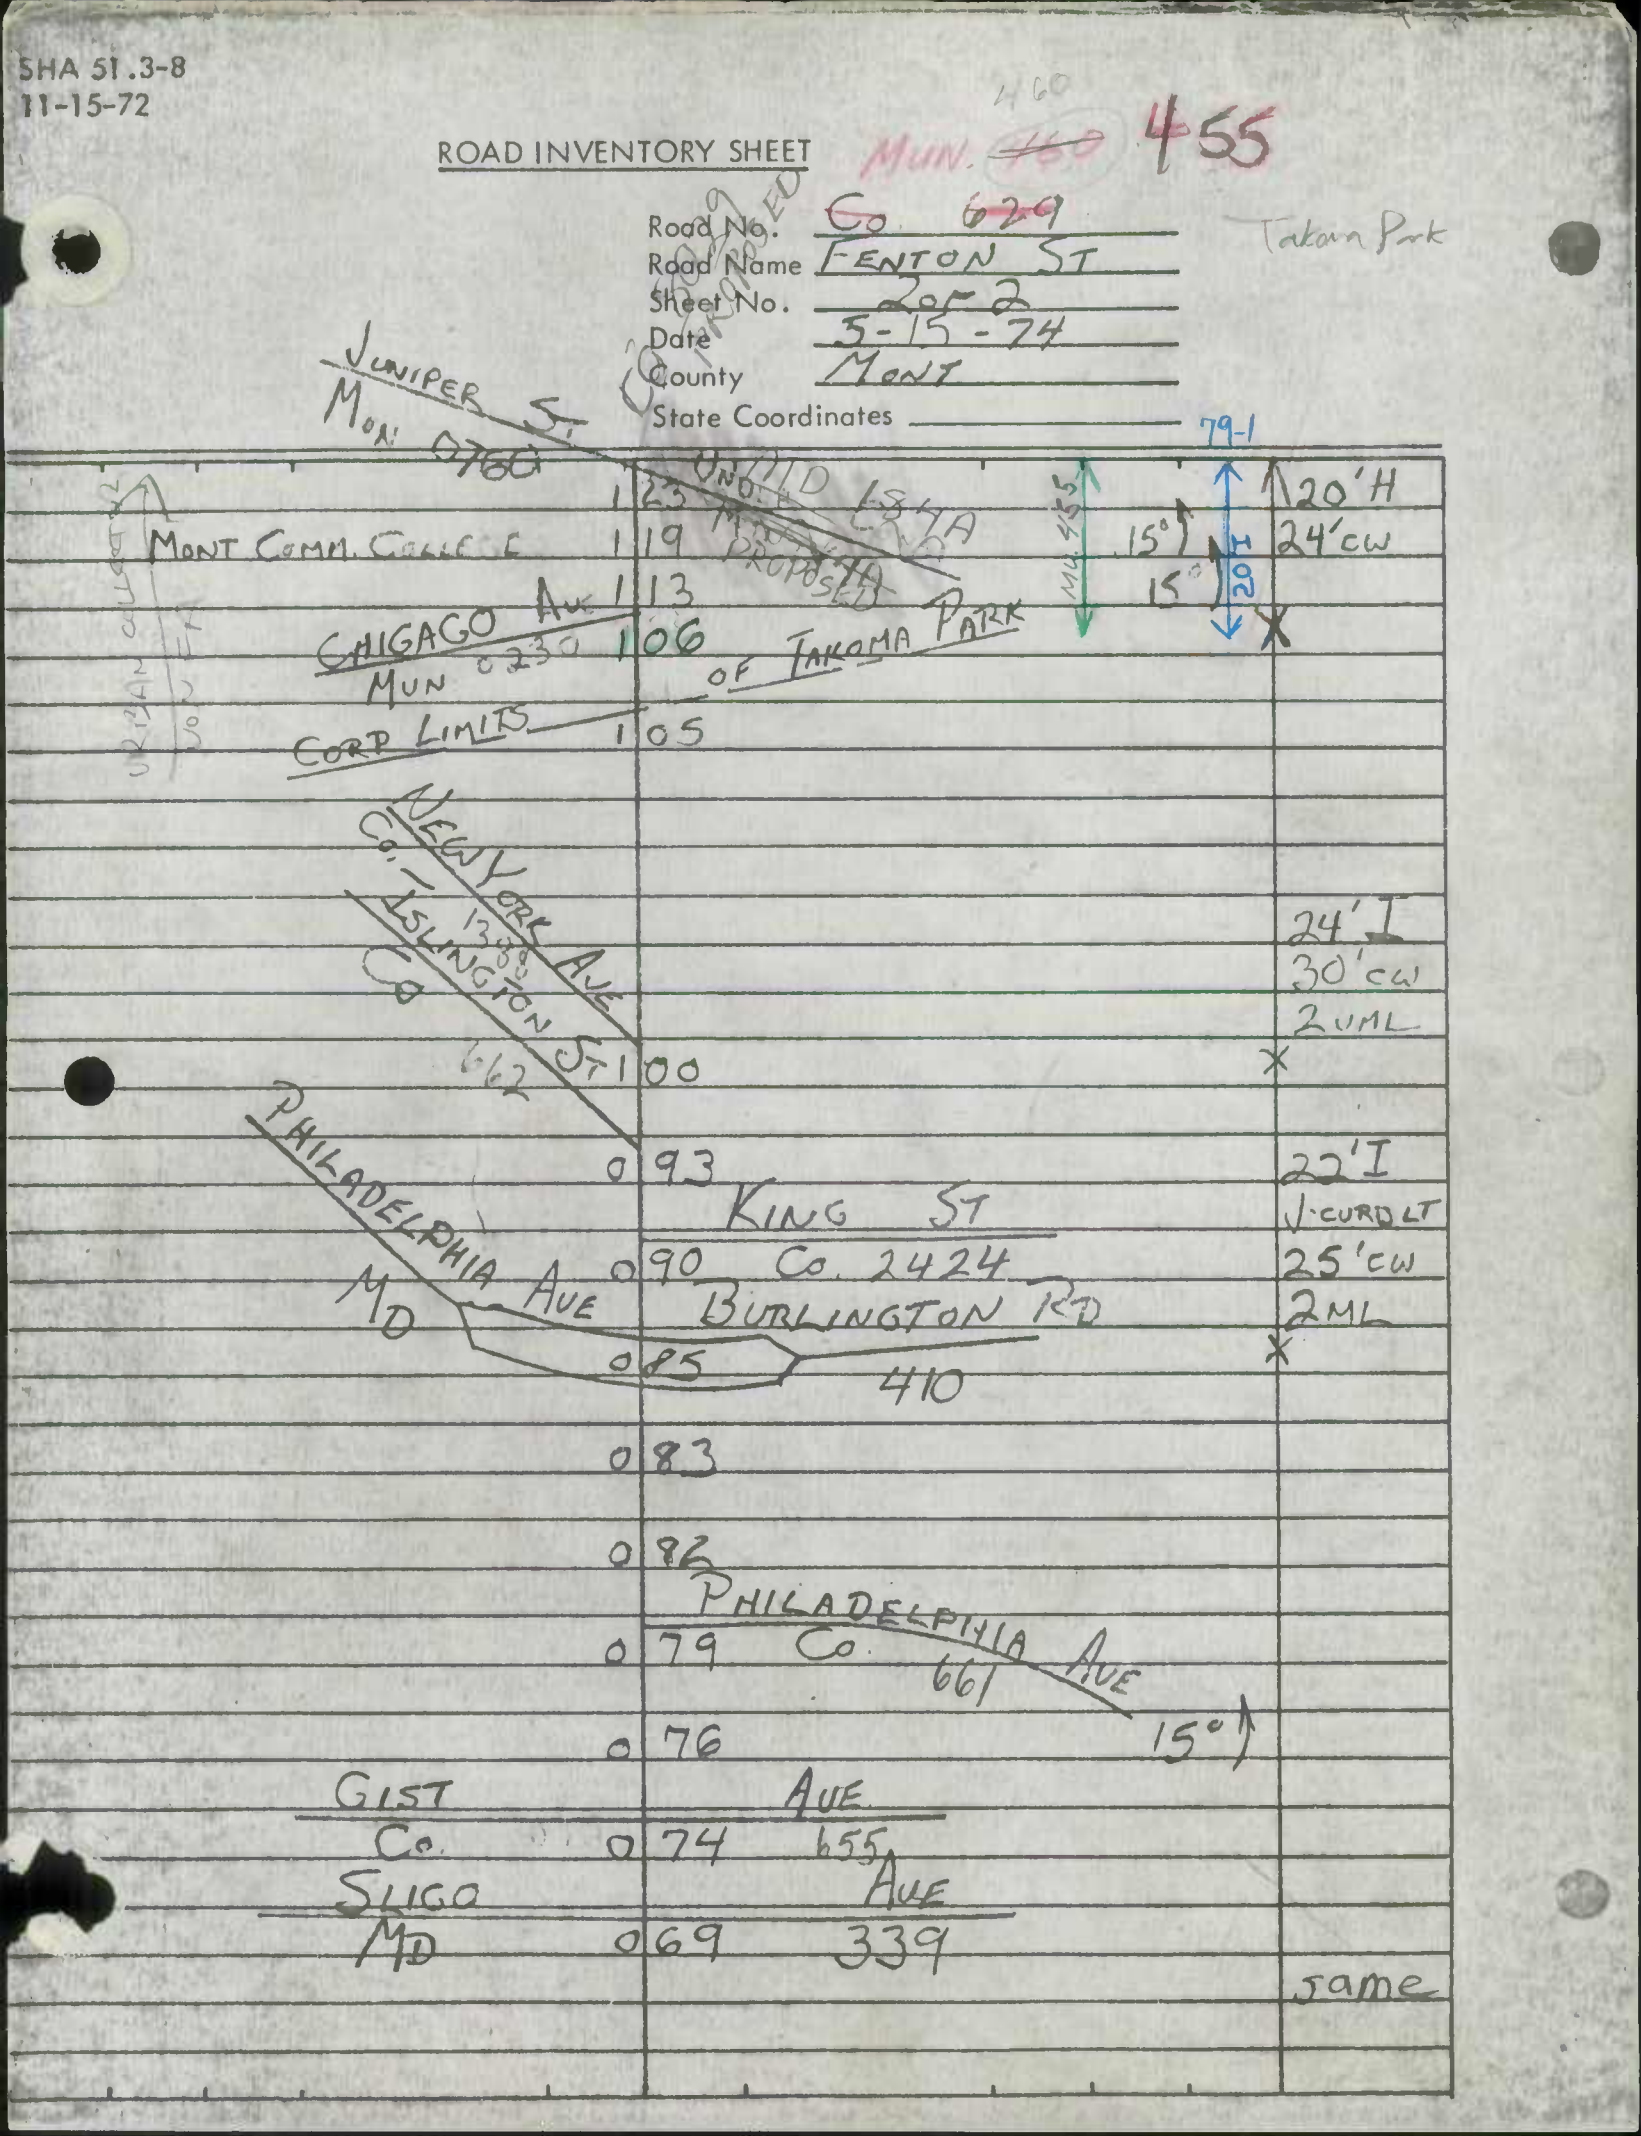

SHA 51.3-8
11-15-72

STATE HIGHWAY ADMINISTRATION OF MARYLAND

ROAD INVENTORY SHEET

Party Chief W. DOMBROSKI
Recorder M. ZALENSKI
Helper

Map No. 31

Road No. ~~MD. 787~~ MUN. 0460
Road Name FLOWER HUE
Sheet No. 1 OF 1
Date 5-24-74
County ~~PG CO~~ Mont.
State Coordinates 802 - 418

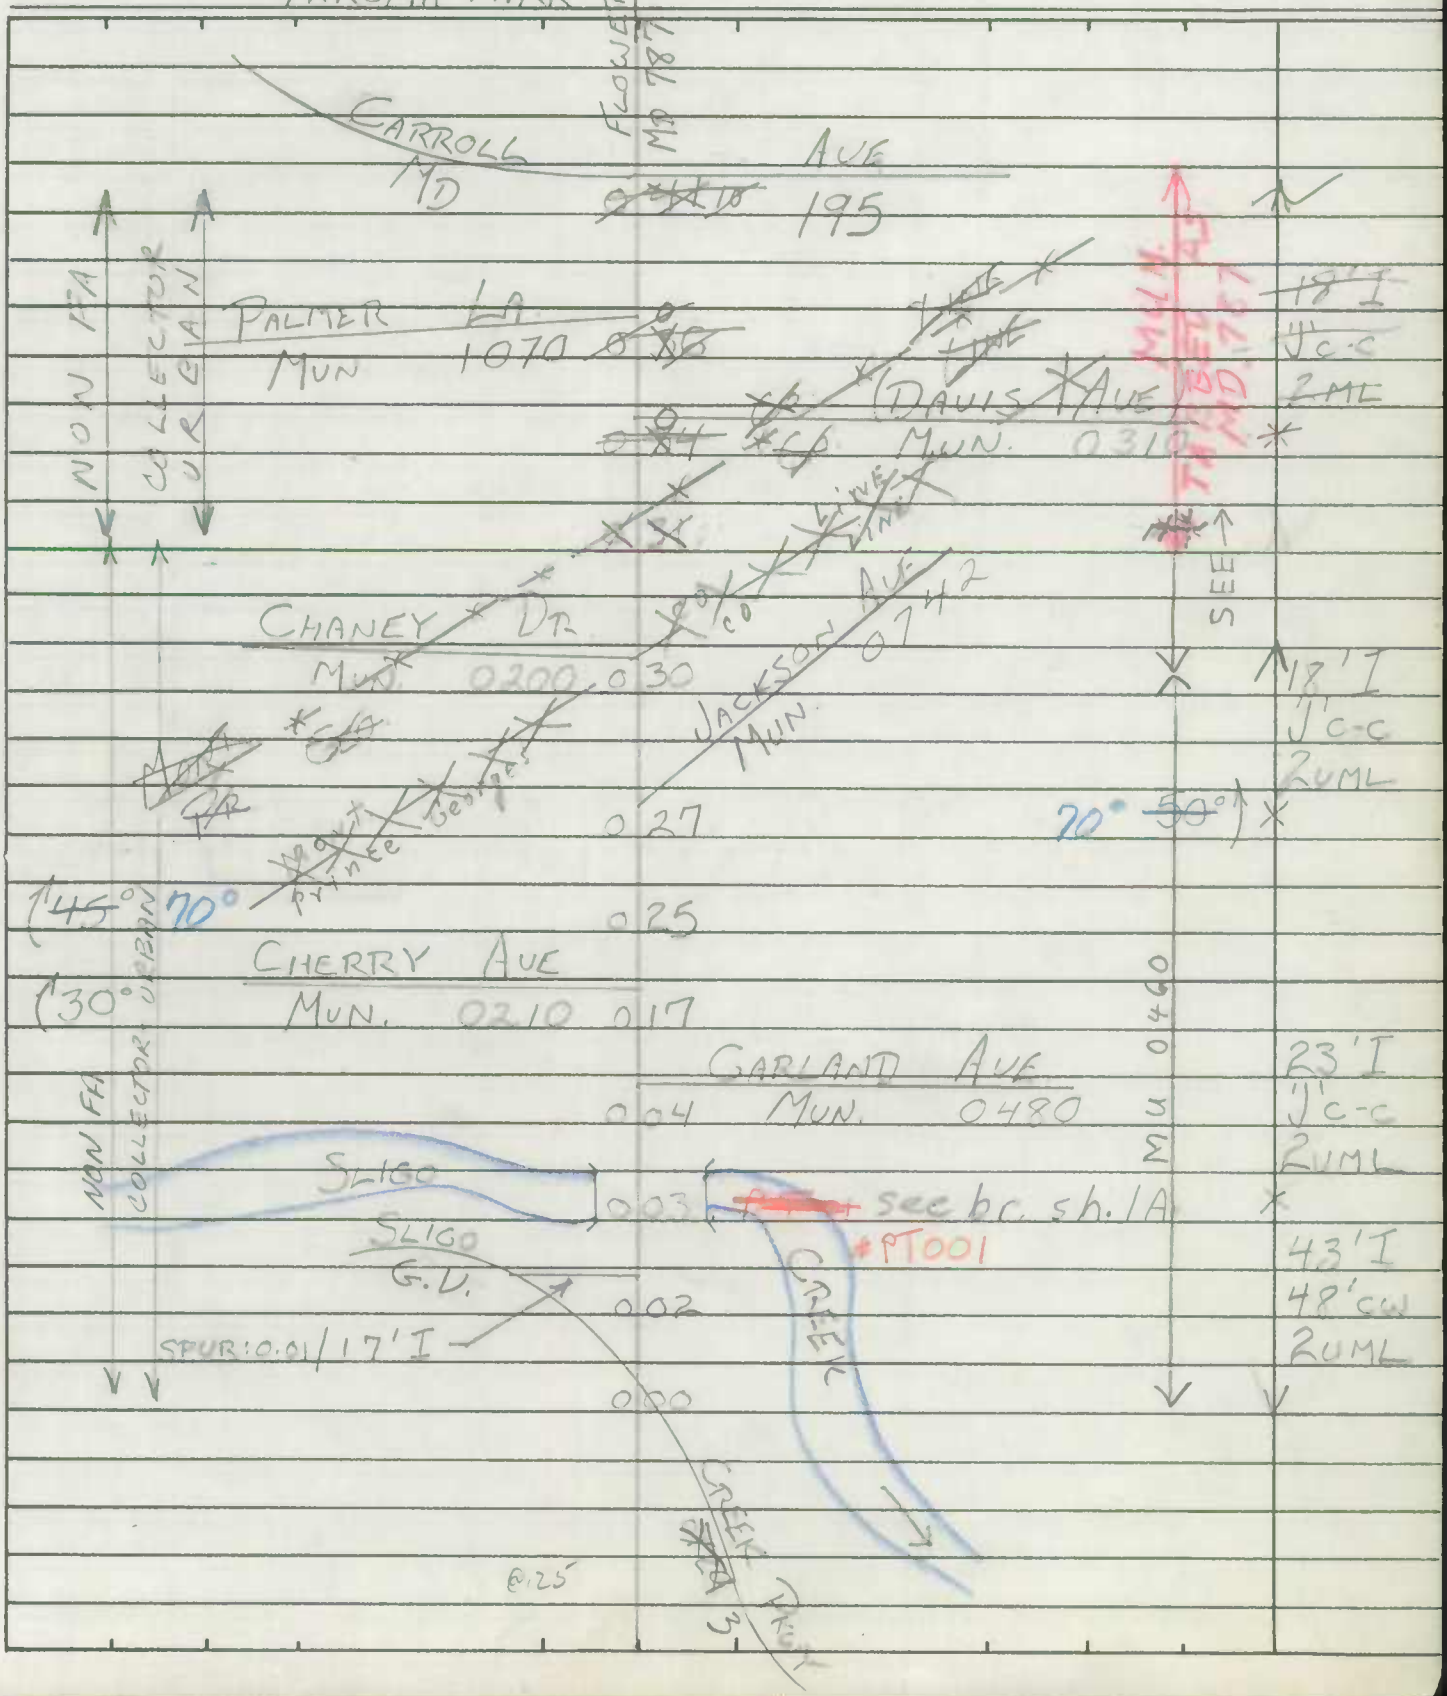

SHA 51.3-8
11-15-72

ROAD INVENTORY SHEET

Road No. _____
Road Name _____
Sheet No. _____
Date _____
County _____
State Coordinates _____

Form 5-HPS
(Revised 1961)

MARYLAND STATE ROADS COMMISSION
PLANNING AND PROGRAMMING DIVISION

S26130

IN COOPERATION WITH
U.S. BUREAU OF PUBLIC ROADS

FLOWER AVE

MAP #31
802-418

BRIDGE SHEET

ROAD NO. MUN

SHEET NO. 1A

PARTY NO.

DATE 5-24-74

COUNTY PR. GEO

RATED CAPACITY

FOR ALL STRUCTURES HAVING A TOTAL OPENING OF MORE THAN 20 FEET AS DEFINED IN NOTE 1.

ODOMETER READING 0.03 NAME OF (STREAM), RAILROAD OR HIGHWAY CROSSED SLIGO CREEK

NUMBER OF RAILROAD TRACKS

KIND OF CROSSING (NOTE 2)

UNDERPASS-SIMPLE UNDERPASS-COMBINED (NOTE 3) OVERPASS BRIDGE OVER SYSTEM

DESCRIPTION

NUMBER OF SPANS	LENGTH EACH SPAN (NOTE 4)	TYPE (NOTE 5)
1	31'	CONC. BOX

TOTAL LENGTH-ON LINE OF ROAD OVER-ALL (NOTE 6) 36'

MATERIAL

SUBSTRUCTURE CONC. SUPERSTRUCTURE STEEL RAILS

FLOOR CONC.

CLEARANCES

ROADWAY (NOTE 7) 23'I J'c-c SIDEWALK WIDTHS: ~~RIGHT~~ LEFT 4'J

SURFACE OF ROAD TO STREAM BED 9' FOR OVERPASSES, SHOW DISTANCES TO TOP OF RAIL OR SURFACE OF LOWER ROAD. (NOTE 8)

SURFACE OF ROAD TO BOTTOM PORTAL (MINIMUM OVERHEAD CLEARANCE

CLEAR DISTANCE OF OPENING ABOVE STREAM BED 7' (WATERWAYS ONLY)

POSTED LOAD LIMITS BRIDGE NO. CONSTRUCTION DATE

GENERAL CONDITION OF BRIDGE: CHECK IF GOOD, FAIR, OR POOR, DESCRIBE DEFECTS IF SERIOUS.

	GOOD	FAIR	POOR
SUPERSTRUCTURE	✓		
FLOOR	✓		
SUBSTRUCTURE	✓		

~~PAINT~~ BADLY CORRODED OR RUSTED

TYPE OF PROTECTION FOR DRAWBRIDGES (NOTE9)

(NOTES ON REVERSE SIDE)

S26130

Notes:

1. In agreement with Federal-aid standards, a bridge is defined as a structure including supports erected over a depression or an obstruction, as water, highway, or railway, and having a track or passageway for carrying traffic or other moving loads, and having a length measured along the center of roadway of more than 20 feet between undercoping of abutments or spring lines of arches, or extreme ends of openings for multiple boxes and pipes, where the clear distance between openings is less than half of the smaller contiguous opening.

2. Show kind of crossing by checking descriptive item applicable. For multiple-span bridges give complete information on each span including approach spans. Indicate on leg sheet the odometer reading, position, and angle of skew of structure with respect to center line of road and by arrow the direction of stream flow.

3. Give information on the span over the highway only.

4. For span length use center to center of bearings, otherwise the clear opening. Skew bridges will be measured along center line of road. See Note 1.

5. Show general type such as: Trestle, Truss, Girder, I-Beam, Rigid Frame, Arch, Slab, Suspension, or Covered Bridge. See illustrations attached. Describe draw spans by classifications listed in Article X, Section 2 of Manual.

6. The length of a bridge structure is the over-all length measured along the line of survey stationing back to back of back-walls of abutments, if present, otherwise end to end of bridge floor, but in no case less than the total clear opening of the structure.

7. Give minimum lateral clearance. Where traffic lanes are separated by bridge numbers, show clearance width of each lane separately. Special conditions should be explained by notes.

8. In case of overhead bracing or arch construction, measurement shall be made to the lowest point above the road surface.

9. Use classification listed on RR crossing sheets. Form 4 HPS.

Remarks: _____

A rearrangement of the form similar to that shown on the attachment may be used to provide space for coding.

SHA 51.3-8
11-15-72

STATE HIGHWAY ADMINISTRATION OF MARYLAND

ROAD INVENTORY SHEET

MUN 0482

Party Chief I. LANDON
Recorder M. ZALENSKI
Helper

Map No. 31

Road No. Co. 734
Road Name GARLAND AVE
Sheet No. 1 OF 2
Date 5-16-74
County MONT.
State Coordinates 800-424

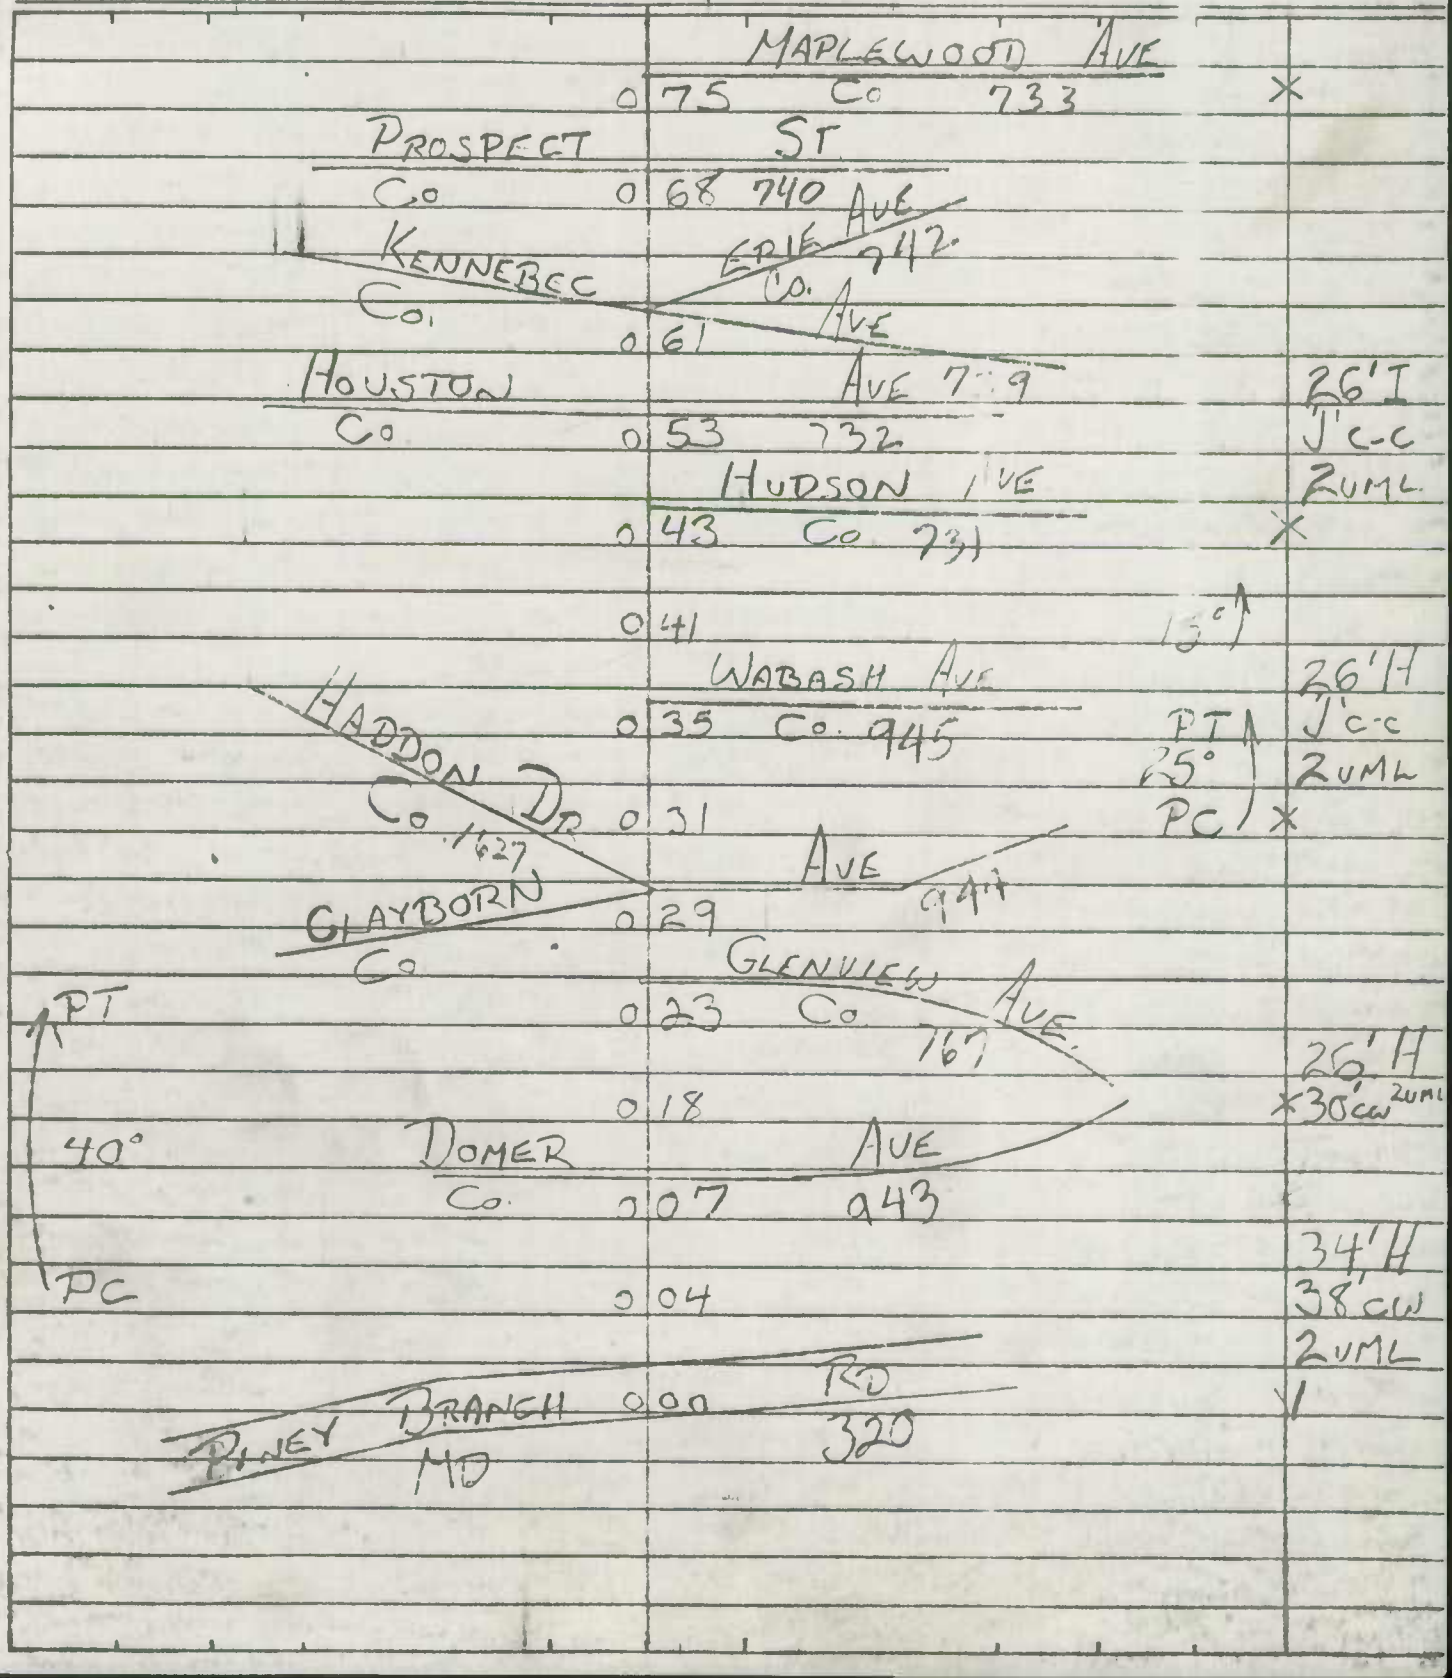

SHA 51.3-8
11-15-72

ROAD INVENTORY SHEET

MUN 0482

Road No. ~~Co 734~~
Raad Name GARLAND AVE
Sheet Na. 2 OF 2
Date 5-16-74
Caunty MONT.
State Caardinates

AVE

CARROLL 0 94 195

MD

23' I
1'c c
2 UML

CORP LIMITS 0 84 OF TAKOMA PARK

MUL

23'
1'c-c
2UML

0 78 15°

SHA 51.3-8
11-15-72

STATE HIGHWAY ADMINISTRATION OF MARYLAND

ROAD INVENTORY SHEET MUN 0570

Party Chief J. LANDON
Recorder M. ZALENSKI
Helper

Map No. 31

Road No. ~~Co~~ 738
Road Name GREENWOOD AVE
Sheet No. 1 OF 1
Date 5-16-74
County MONT.
State Coordinates 801-419

KENNEBEC Co — AVE 739
0.37
ERIE AVE Co 742
0.32
PROSPECT ST. Co 740
0.31
MAPLEWOOD AVE Co. 736
0.26
MAPLEWOOD AVE Co. 737
0.23
0.22
DIVISION ST Co 735
0.16
CORP. LIMITS OF TAKOMA PARK
0.14
PKG LOT
0.07
CARROLL MD
0.00
AVE 195
15°
15°
N

26 I
U C C
2 UL
26 I
30' CW
2 UL
24' H
2' CW
2 ML
26' I
U C C
2 UL

SHA 51.3-8
11-15-72

STATE HIGHWAY ADMINISTRATION OF MARYLAND

ROAD INVENTORY SHEET MUN. 655

Party Chief T. LANDON
Recorder M. ZALENSKI
Helper

Map No. 31

Road No. ~~Co~~ 745
Road Name HILLTOP RD
Sheet No. 1 OF 1
Date 5-16-74
County MONT
State Coordinates 799-420

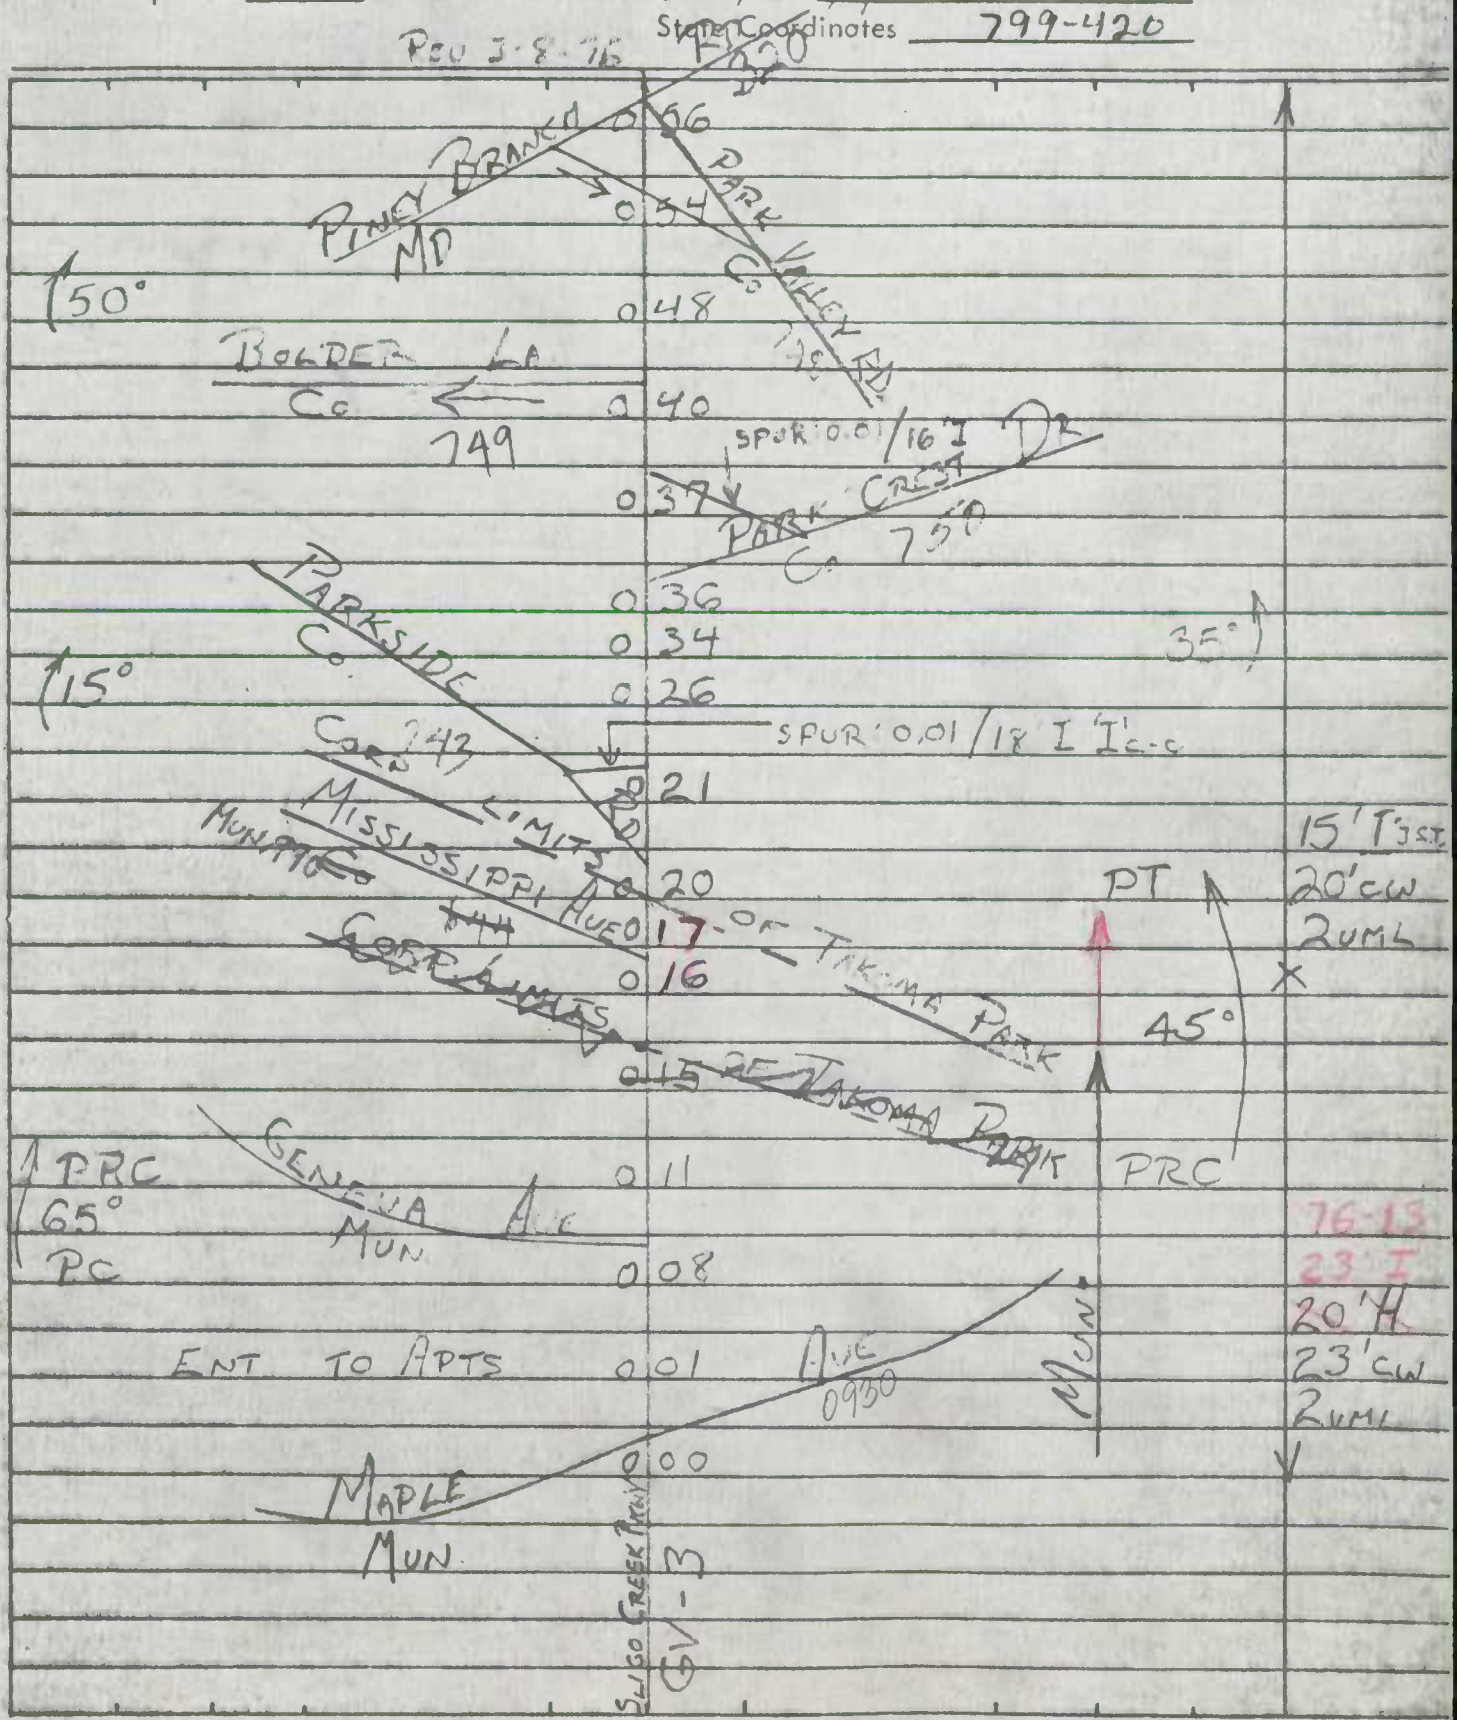

SHA 51.3-8
11-15-72

STATE HIGHWAY ADMINISTRATION OF MARYLAND

ROAD INVENTORY SHEET

MUN 0710

Party Chief: I. LANDON
Recorder: M. ZALENSKI
Helper:

Map No. 31

Road No. Co 73.2
Road Name HOUSTON AVE
Sheet No. 1 OF 1
Dote 5-16-74
County MONT
Stote Coordinates 800-422

AVE
KENNEBEC MUN. 0 44 0780
0 40
20° 0 34
0 32
BRIGHTON AVE
0 30 MUN 0140
0 28
ROANOKE MUN AVE 0 26 1150
FLOWER MD 0 17 AVE 1127
GREENWOOD CO 0 10 AVE 734
GARLAND CO 0 05 734
HATTON DR CO 1629

MUN
40°
15°
40°
20'
179.3

26'I
1 C-C
2 UML
18'H
22 CW
2 UML
26'I
1 C-C
2 UML
26'H
1 C-
2 UML

W

SHA 51.3-8
11-15-72

STATE HIGHWAY ADMINISTRATION OF MARYLAND

ROAD INVENTORY SHEET

MUN 0730

Party Chief T. LANDON
Recorder M. ZALENSKI
Helper

Map No. 31

Road No. Co 731
Road Name HUDSON AVE
Sheet No. 1 of
Date 5/16/74
County ANT.
State Coordinates 800-422

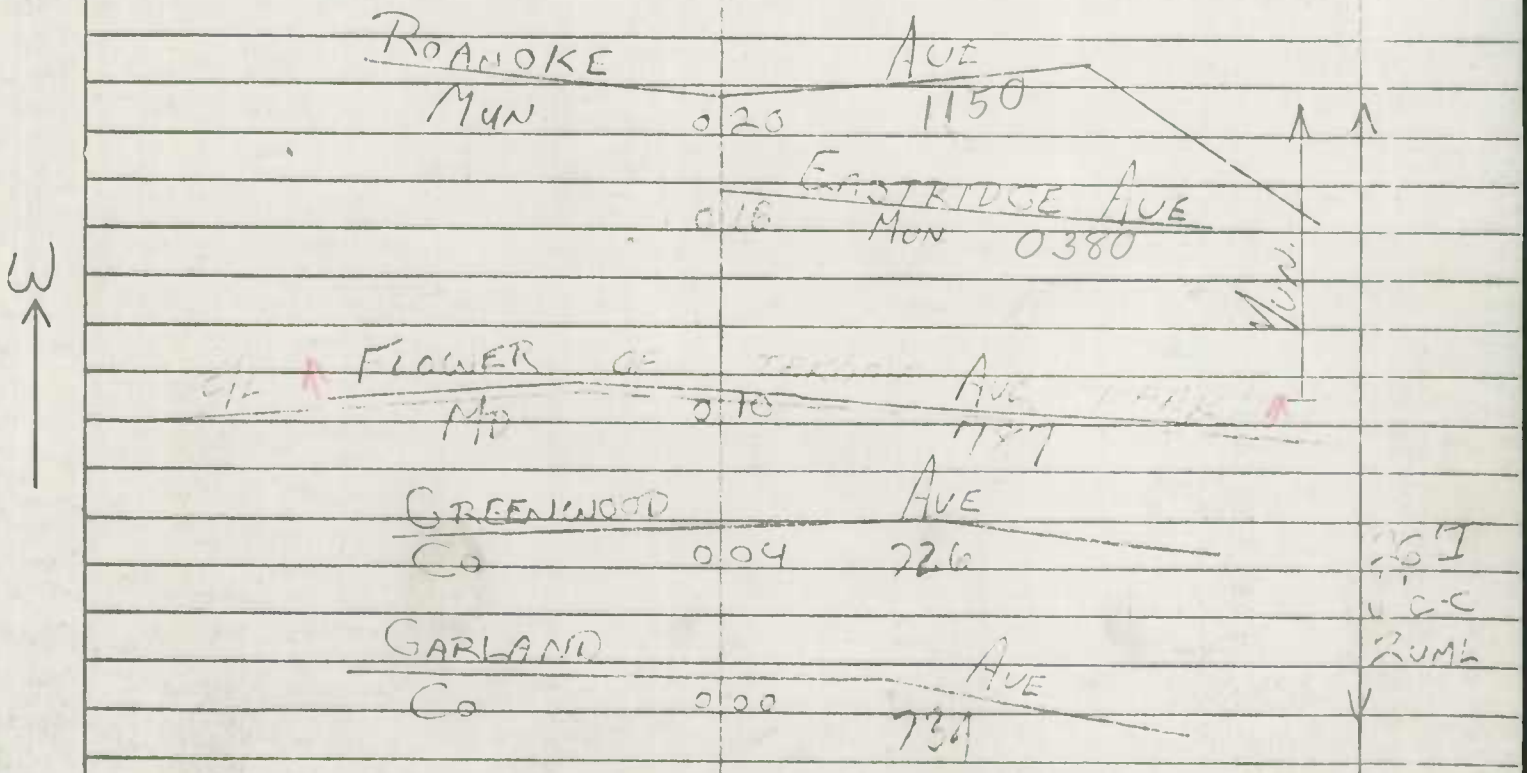

SHA 51.3-8
11-15-72

STATE HIGHWAY ADMINISTRATION OF MARYLAND

ROAD INVENTORY SHEET

Party Chief B. DOMBROSKI
Recorder C. FORREST
Helper

Map No. 31

Road No. MU 0760
Road Name JUNIPER ST
Sheet No. 1 OF 1
Date 9-23-75
County MONT.
State Coordinates 793-429

TAKOMA PK

NON Part of MU 455
AL YM
2-16-89

UNASSIGNED - Abandoned

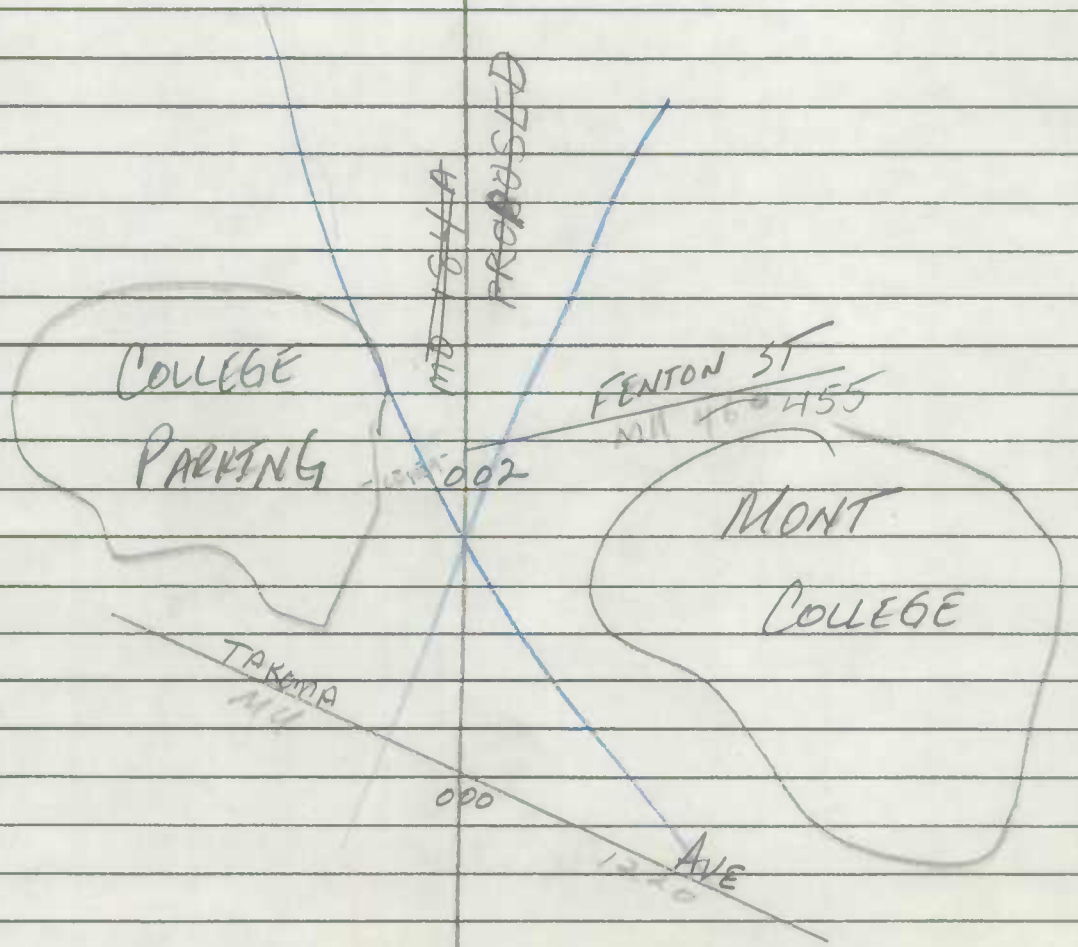

SHA 51.3-8
11-15-72

ROAD INVENTORY SHEET

Road No. _____
Road Name _____
Sheet No. _____
Date _____
County _____
State Coordinates _____

SHA 51.3-8
11-15-72

STATE HIGHWAY ADMINISTRATION OF MARYLAND

ROAD INVENTORY SHEET

MUN 0780

Party Chief: T. LANDON
Recorder: M. ZALENSKI
Helper:

Map No. 31

Road No. Co. 739
Road Name KENNEBEC AVE
Sheet No. 1 OF 1
Date 5-16-74
County MONT.
State Coordinates 798-421

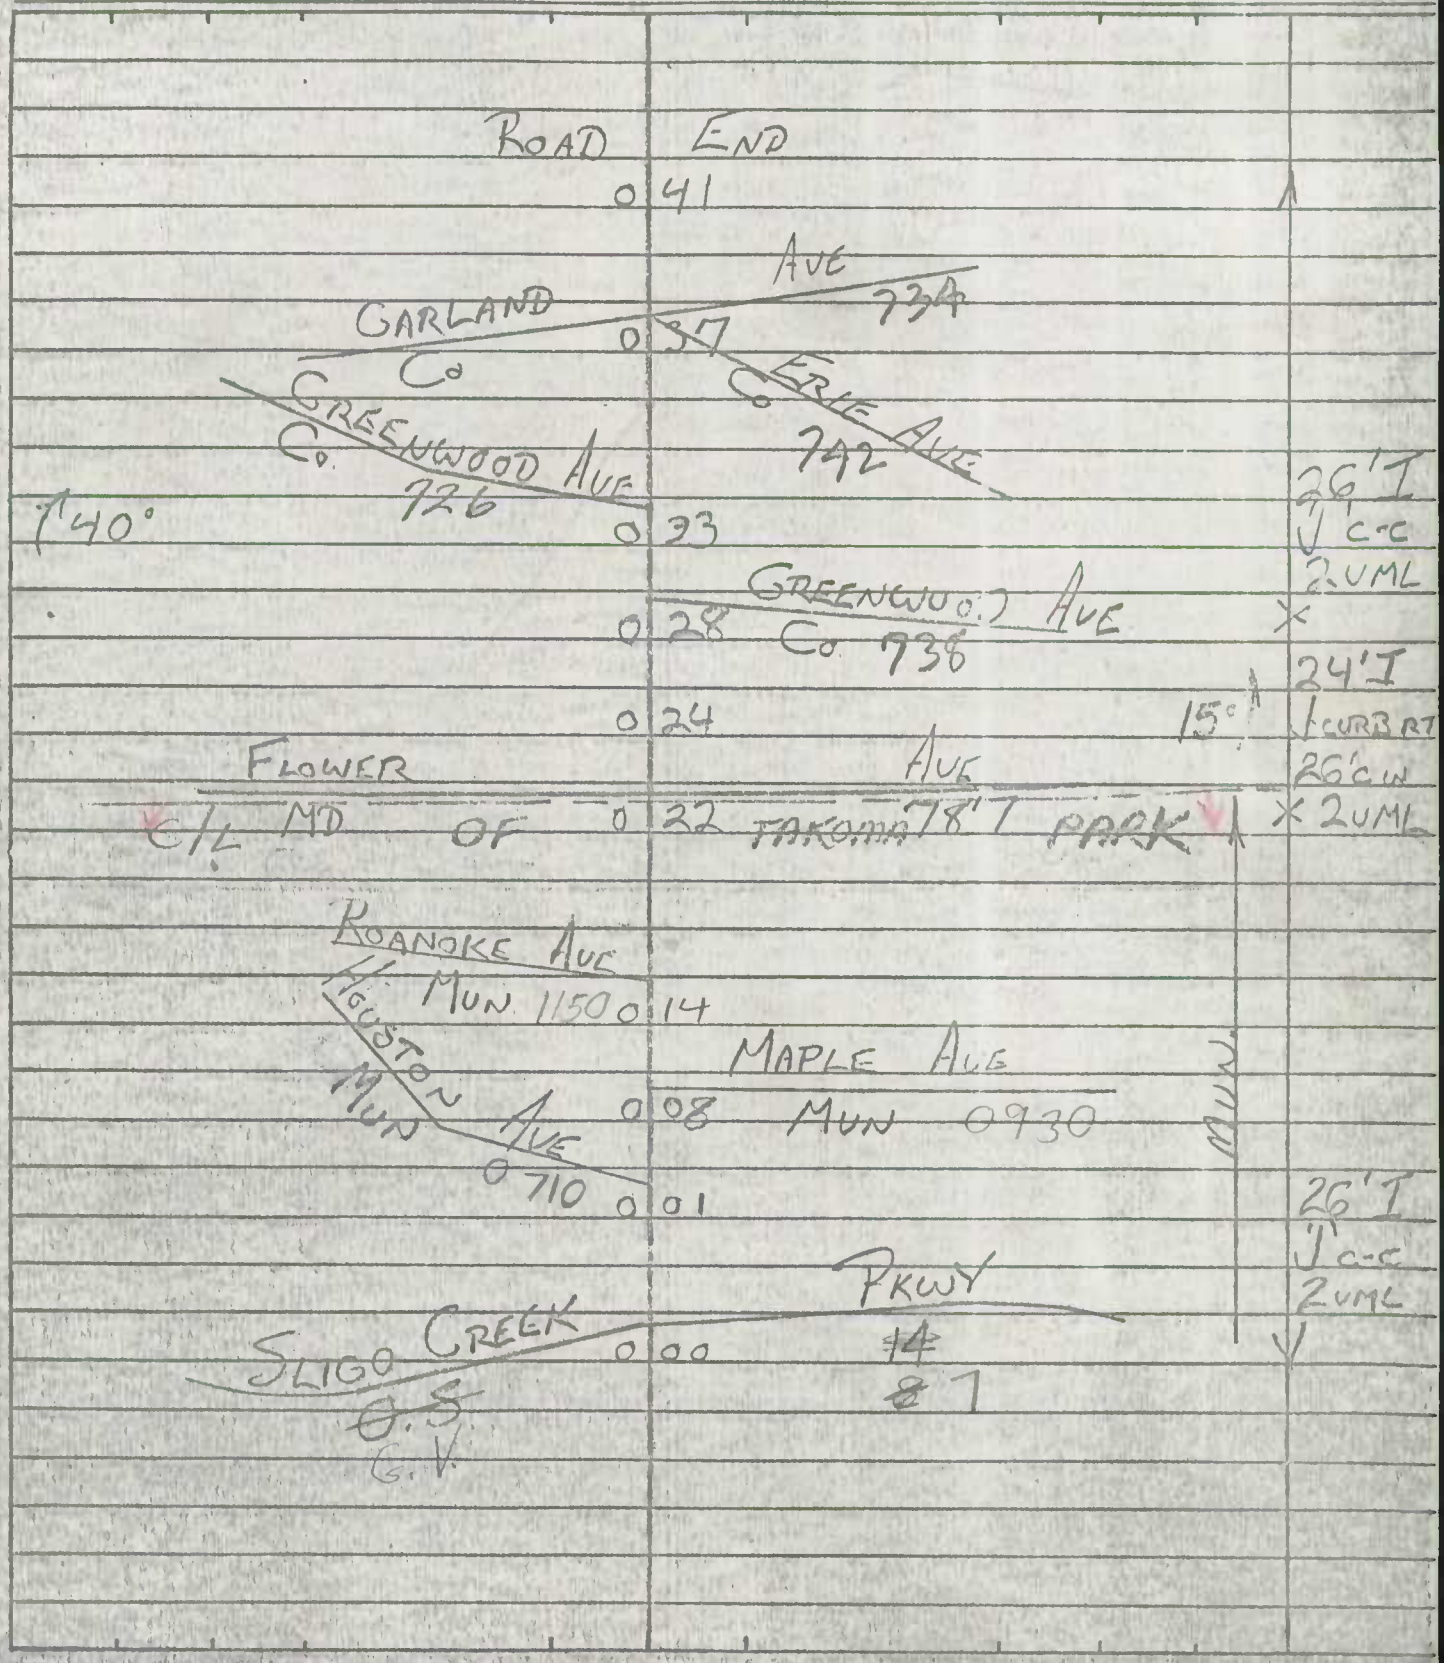

SHA 51.3-8
11-15-72

STATE HIGHWAY ADMINISTRATION OF MARYLAND

ROAD INVENTORY SHEET MON 0950

Party Chief T. LANDON
Recorder M. ZALENSKI
Helper

Map No. 31

Road No. Co 772
Road Name MARGARET DR.
Sheet No. 1 OF 1
Date 5-17-74
County MONT
State Coordinates 795-420

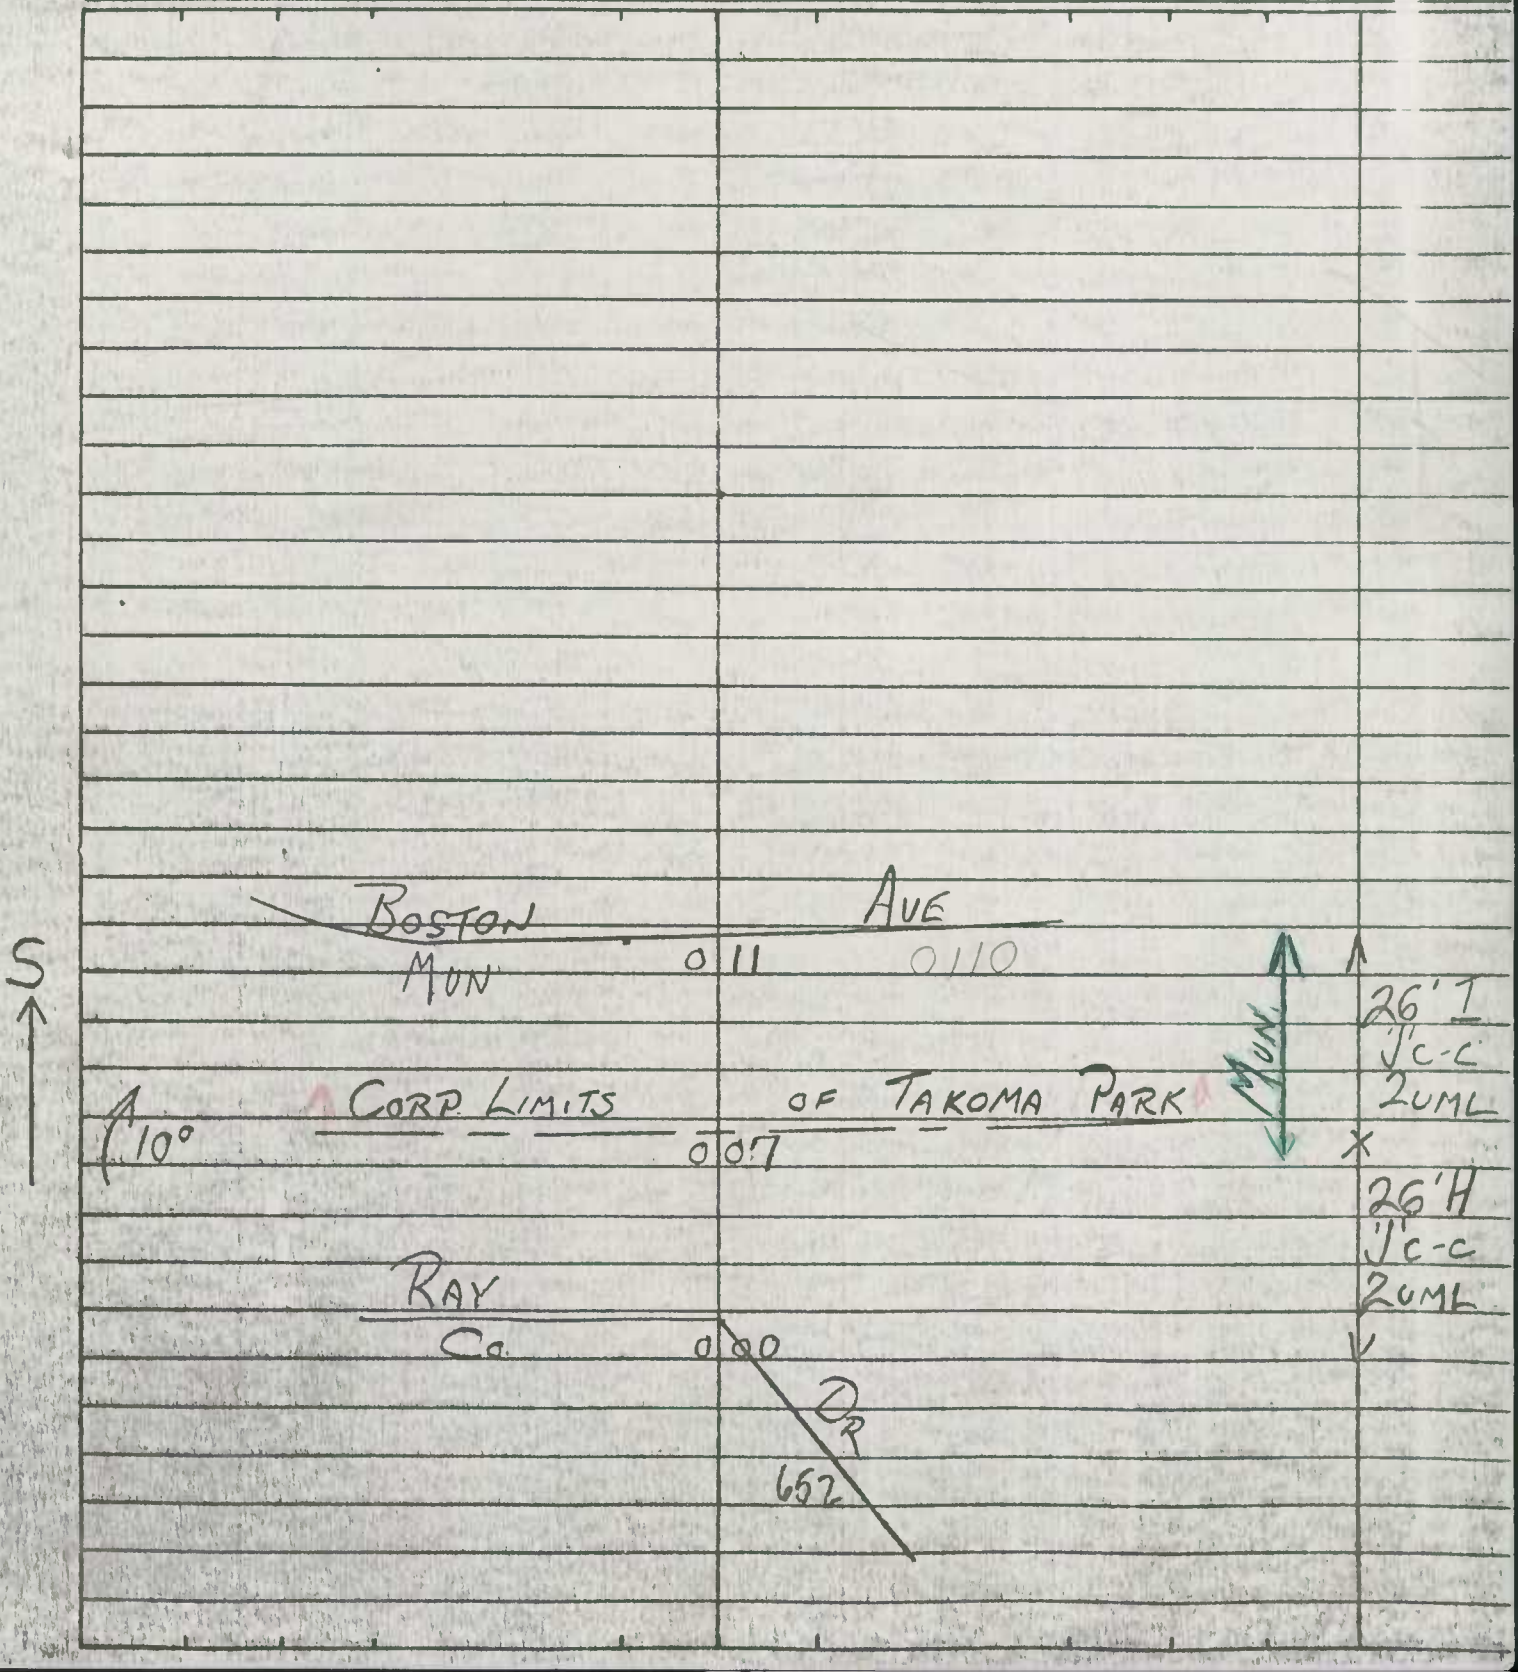

SHA 51.3-8
11-15-72

STATE HIGHWAY ADMINISTRATION OF MARYLAND

MUN 0990

ROAD INVENTORY SHEET

Party Chief T. L[illegible]
Recorder
Helper

Map

644
SSIPPI AVE
SF
2-74
795-421

*Place this note on Mississippi Ave's. inventory

.00-.28 - County maintained
.28-.67 - Takoma Park maintained
per Mike Shell, Mont. Co. - by phone 7/27/93
and
Richard Knauf, Takoma Park - by phone 7/7/93

Noted on Inventory CO 644
8/3/93 T.M.

* Type up - place w/ Mont. Co., Takoma Park Folder

76-11
23'I
16'H
1 CURB RT
18' CW
2 UML
35°
3 SIGNS
40°
10°
TAKOMA PK
15°
22'H
1 CURB RT
23' CW 2 UML
320
MD
0.28
20'J
26' CW
2 UML
E
VALLEY JT
CO 1373
15°
0.23
15°
0.14
SLIGO
MD
0.04
15°
36'H
30' CW
2 UML
AVE
339
0.00

SHA 51.3-8
11-15-72

STATE HIGHWAY ADMINISTRATION OF MARYLAND

MUN 0990

ROAD INVENTORY SHEET

Party Chief T. [illegible]
Recorder
Helper

Map - 644
SSIPPI AVE
OF 1
2-74
795-421

7-7-93

- Corp limits now extend to MD 320 (.28)
- 76 mun. report shows resurfacing from MD 320 to Hilltop Dr
- No Co. imp report since at least 1973 mentions this road

Call ~~on 7-19~~ Mont. Co. + Takoma Park

- I called Richard Kraut of Takoma Park on 7-7-93. He says The Town maintains from MD 320 To Hilltop DR.

- Called M. Sholl 7-20-93, left message
- called 7-22, said he won't know until 7-26.

- Mike Sholl called 7/27/93 - says Mont. Co. maintains from ~~MD 320~~ ~~To~~ Sligo Ave TO Piney Branch Rd .00-.28

76-11
23'I
16'H
1-CURB RT
~~18'~~ CW
2 UML
35°
3 LANES
40'
10°
TAKOMA PK
22'H
1-CURB RT
23' CW 2 UML
15°
320
.28
MD
20'J
26' CW
2 UML
E
VALLEY JT
CO 1373
.23
15°
.14
26'H
30' CW
2 UML
15°
.04
SLIGO
MD
.00
AVE
339

SHA 51.3-8
11-15-72

STATE HIGHWAY ADMINISTRATION OF MARYLAND

MUN 0490

ROAD INVENTORY SHEET

Party Chief T. LANDON
Recorder M. ZALENSKI
Helper

Map No. 31

REV 3-8-76

Road No. Co. 644
Road Name MISSISSIPPI AVE
Sheet No. 1 OF 1
Date 5-16-74
County MONT.
State Coordinates 795-42.1

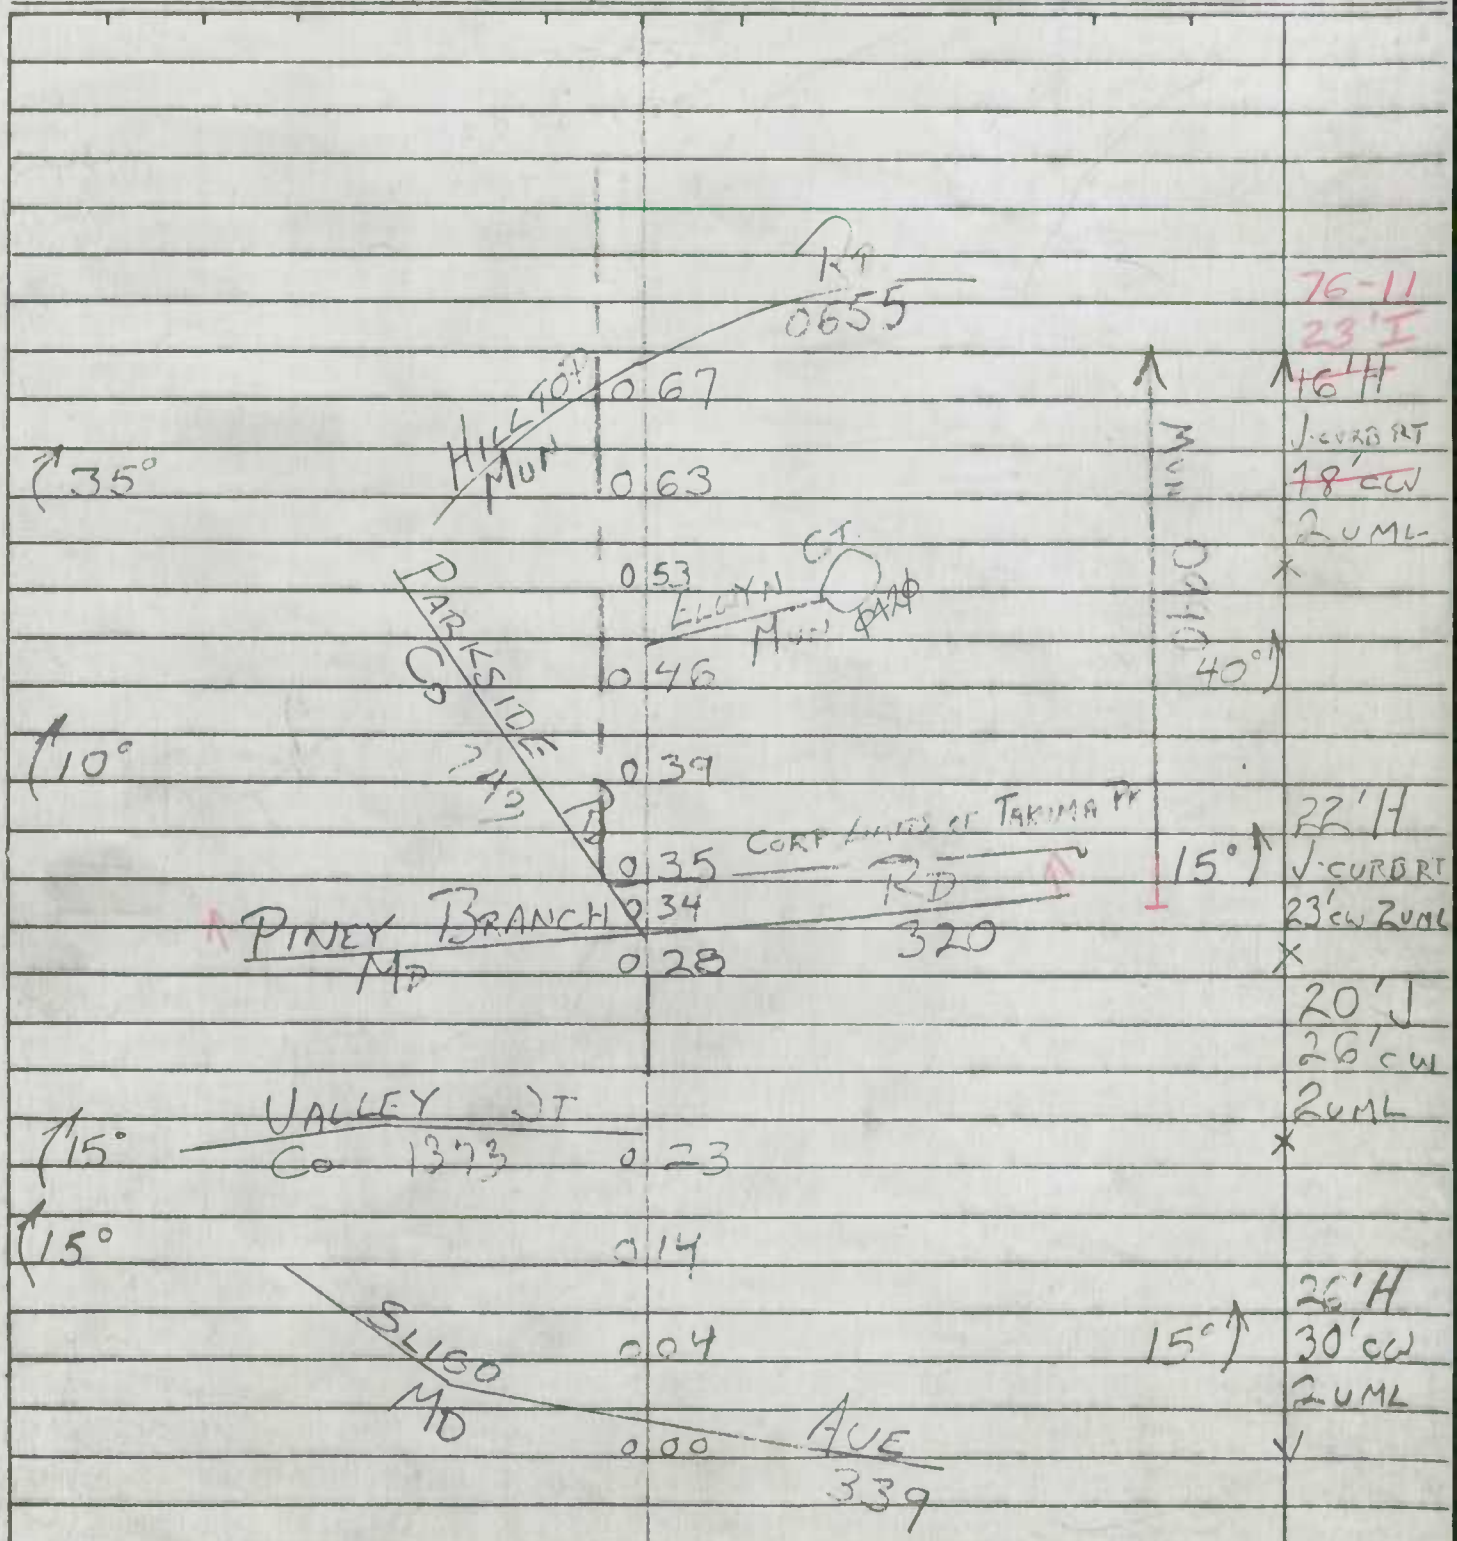

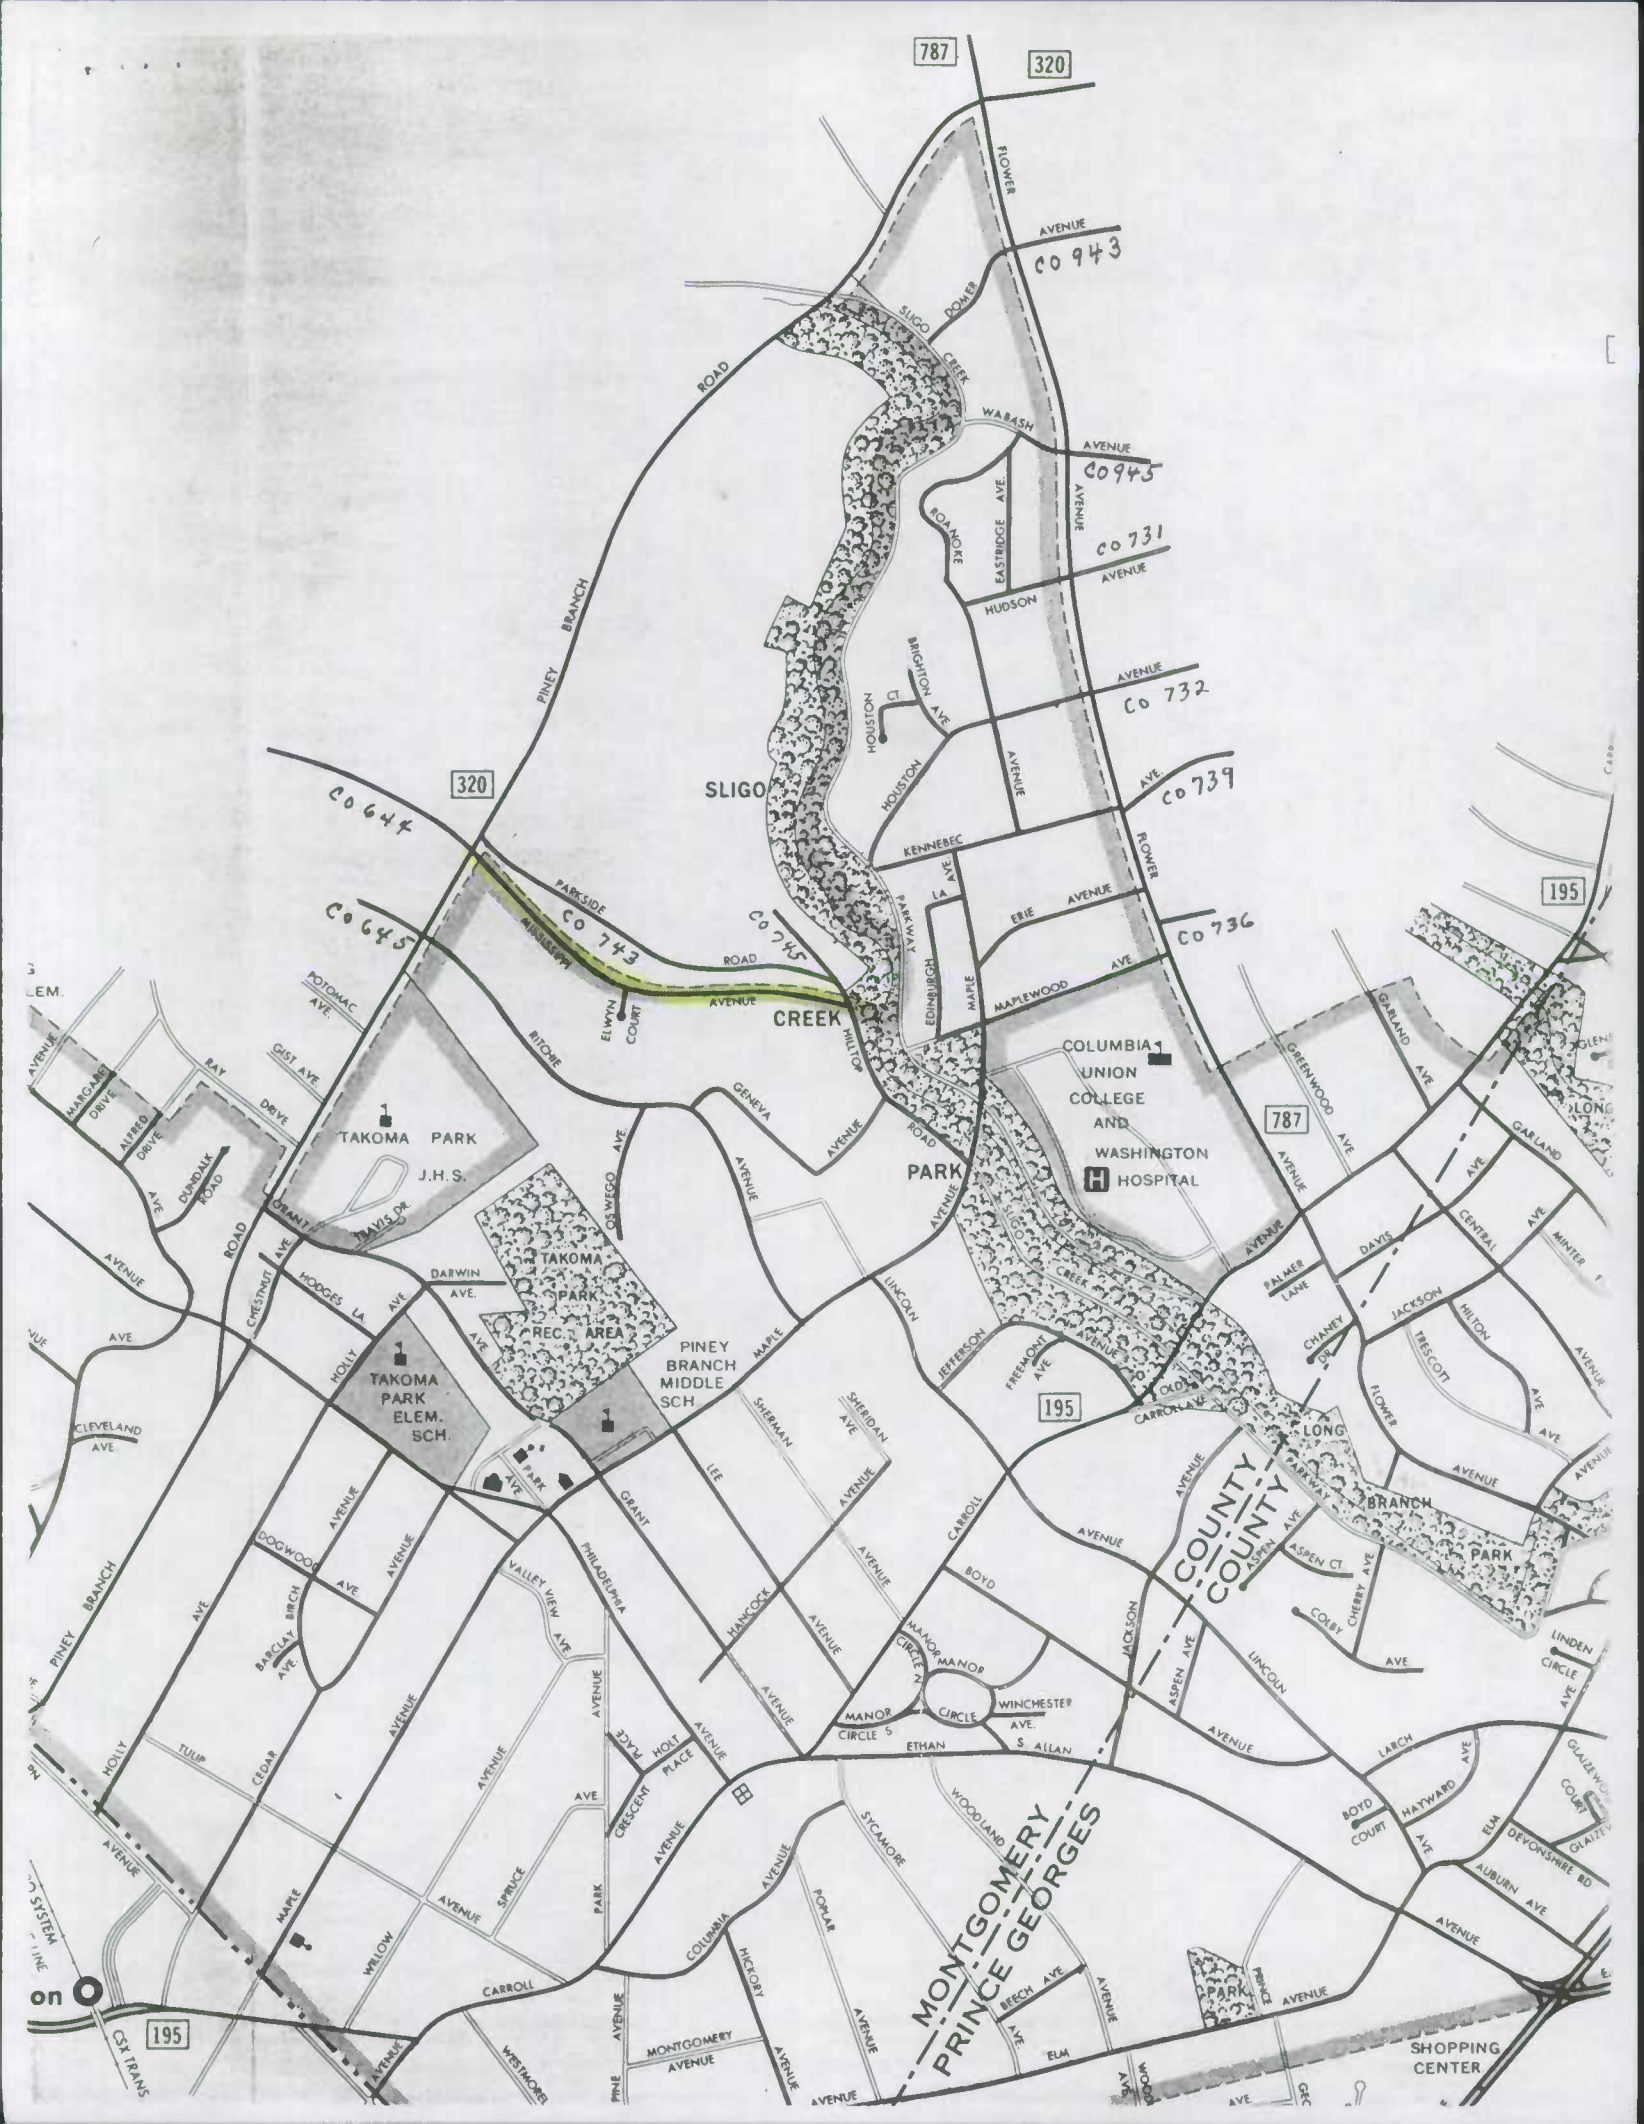
787
320
FLOWER AVENUE
CO 943
SLIGO CREEK
PINEY BRANCH ROAD
WABASH AVENUE
CO 945
EASTRIDGE AVE.
ROANOKE AVENUE
CO 731
HUDSON AVENUE
BRIGHTON AVE
HOUSTON CT
HOUSTON AVENUE
CO 732
SLIGO
320
CO 644
CO 739
KENNEBEC AVE
PARKSIDE
CO 743
CO 645
CO 745
ROAD
AVENUE
ELWYN COURT
CREEK PARKWAY
LA
ERIE AVENUE
CO 736
EDINBURGH
MAPLE
MAPLEWOOD AVE
195
COLUMBIA UNION COLLEGE AND WASHINGTON HOSPITAL
HOSPITAL
787
GREENWOOD AVE
GARLAND AVE
TAKOMA PARK J.H.S.
TAKOMA PARK REC. AREA
TAKOMA PARK ELEM. SCH.
PINEY BRANCH MIDDLE SCH
PARK
DAVIS
CENTRAL AVE
MINTER
PALMER LANE
JACKSON
HILTON
TRESCOTT
CHANEY DR
JEFFERSON
FREMONT AVE
CARROLL AVE
195
LONG BRANCH PARKWAY
LONG BRANCH PARK
COUNTY
COUNTY
ASPEN CT
CHERRY AVE
COLBY AVE
LINDEN CIRCLE
MANOR CIRCLE N
MANOR CIRCLE S
WINCHESTER AVE.
S. ALLAN
ETHAN
BOYD
BOYD COURT
LARCH
HAYWARD AVE
GLAZEWOOD COURT
DEVONSHIRE RD
AUBURN AVE
MONTGOMERY
PRINCE GEORGES
SHOPPING CENTER
PARK
WOODLAND
SYCAMORE
POPLAR
HICKORY
BEECH AVE
ELM
MONTGOMERY AVENUE
WESTMORE
CSX TRANS
195
on
PINEY BRANCH
DOGWOOD AVE
BIRCH AVE
BARCLAY AVE.
VALLEY VIEW AVE
PHILADELPHIA
HOLLY
TULIP
CEDAR
SPRUCE
MAPLE
WILLOW
CRESCENT
HOLT PLACE
PARK
CARROLL
GRANT
LEE
SHERMAN AVE
SHERIDAN AVE
HANCOCK
LINCOLN
CLEVELAND AVE
HODGES LA
DARWIN AVE.
CRESTVIEW
DUNDALK ROAD
TRAVIS DR
OSWEGO AVE
GENEVA AVENUE
RITCHIE
HILLTOP
POTOMAC AVE
GIST AVE
BAY DRIVE
ALFRED DRIVE
MARGARET DRIVE

SHA 51.3-8
11-15-72

STATE HIGHWAY ADMINISTRATION OF MARYLAND

MUN 1030

ROAD INVENTORY SHEET

Party Chief: I. LANDON
Recorder: M. ZALENSKI
Helper:

Map No. 31
TAKOMA PARK

Road No. Co 1388
Road Name NEW YORK AVE
Sheet No. 1 OF 1
Date 5-17-74
County MONT.
State Coordinates 293 - 420

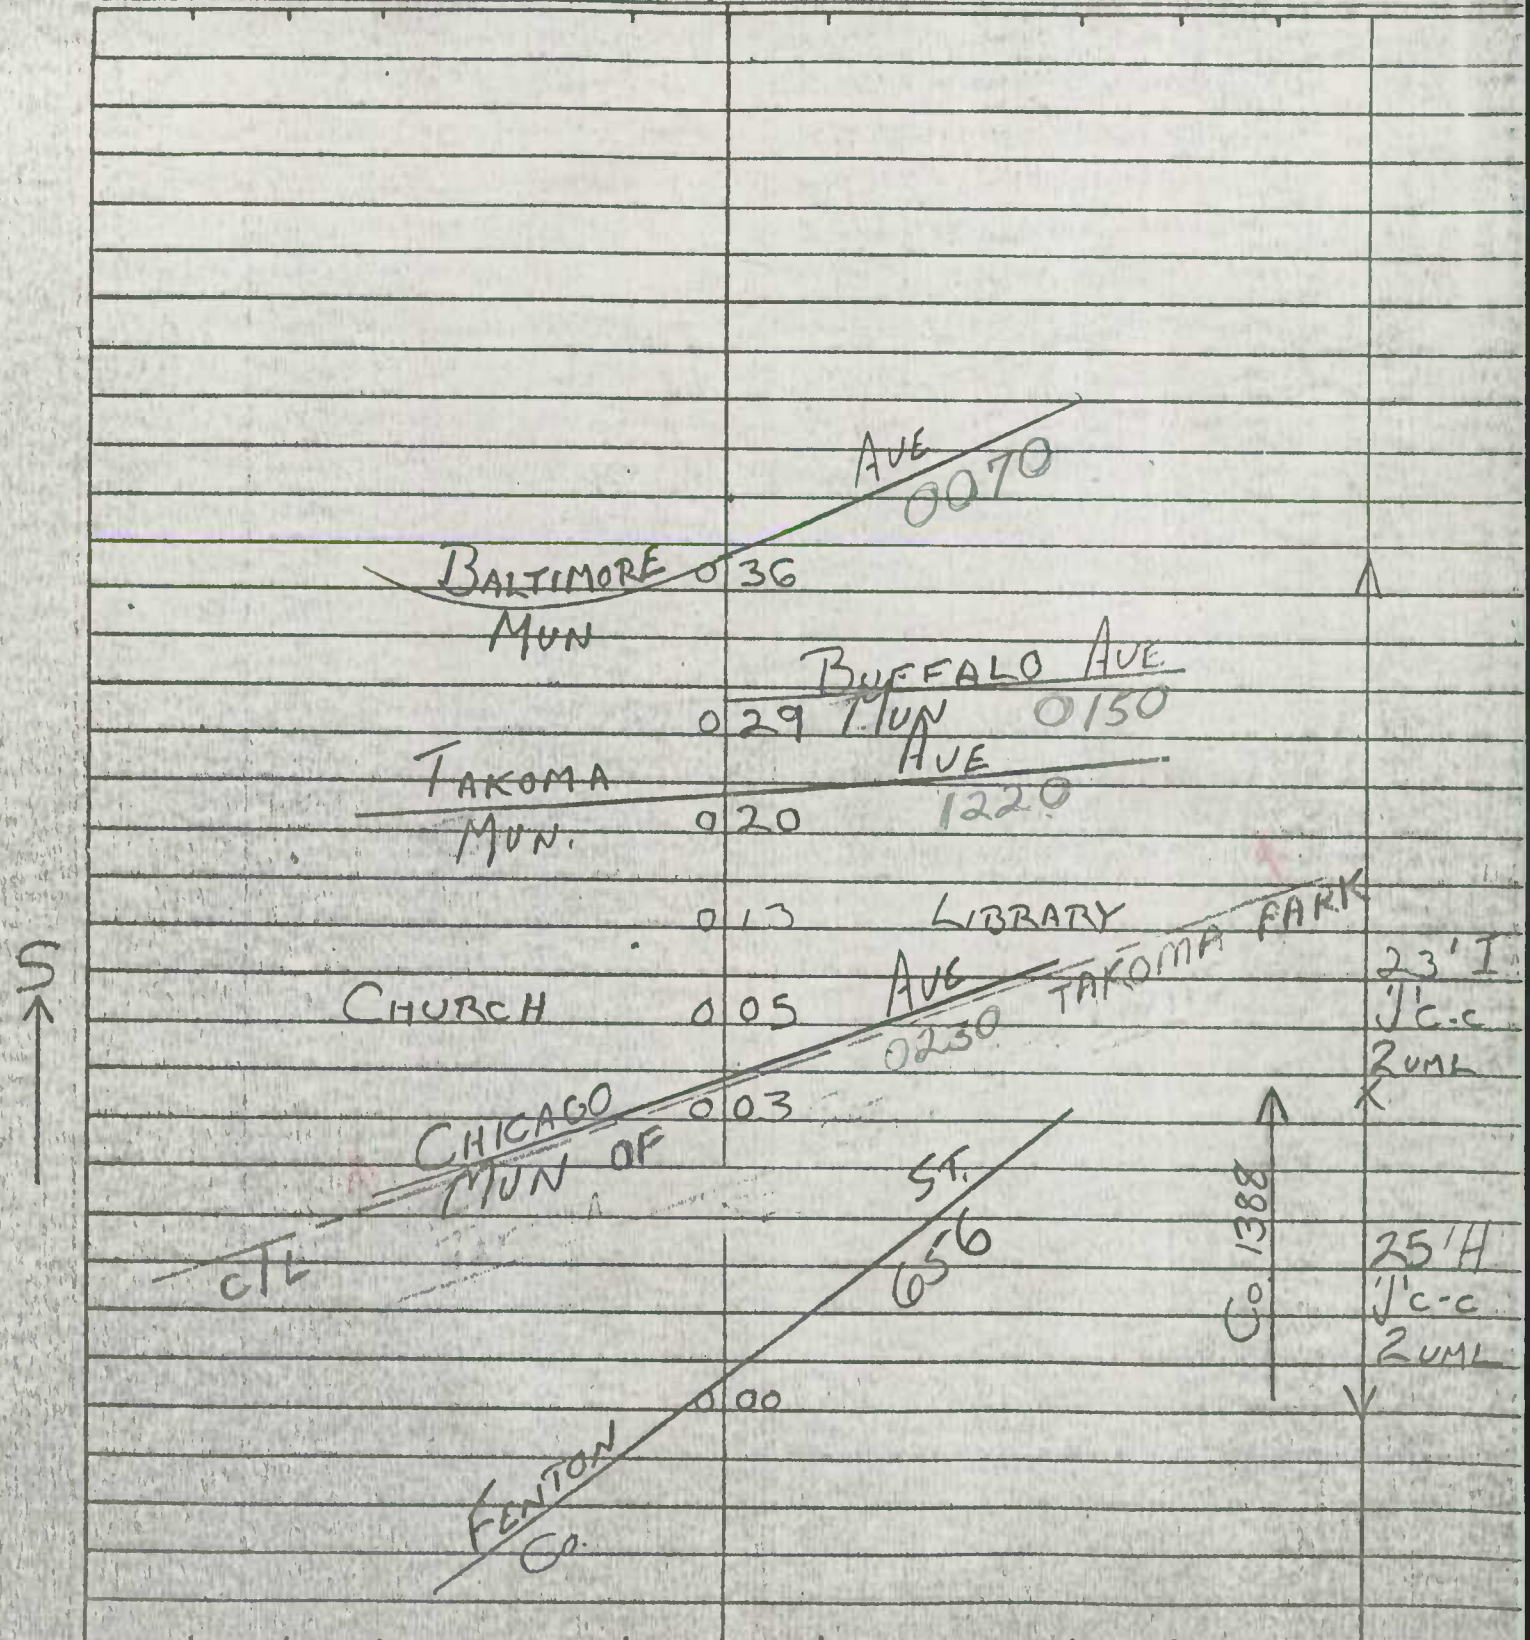

SHA 51.3-8
11-15-72

STATE HIGHWAY ADMINISTRATION OF MARYLAND

ROAD INVENTORY SHEET

T. LANDON
F. RHODES
VERIFIED 6/1/78

Party Chief W. Dombroski
Recorder M. Zalenski
Helper

Road No. MUN 1110
Road Name POPLAR AVE
Sheet No. 1 of 1
Date 5-23-74
County Montgomery + Pr. Geo
State Coordinates 798-416

Map No. 31

TAKOMA PARK

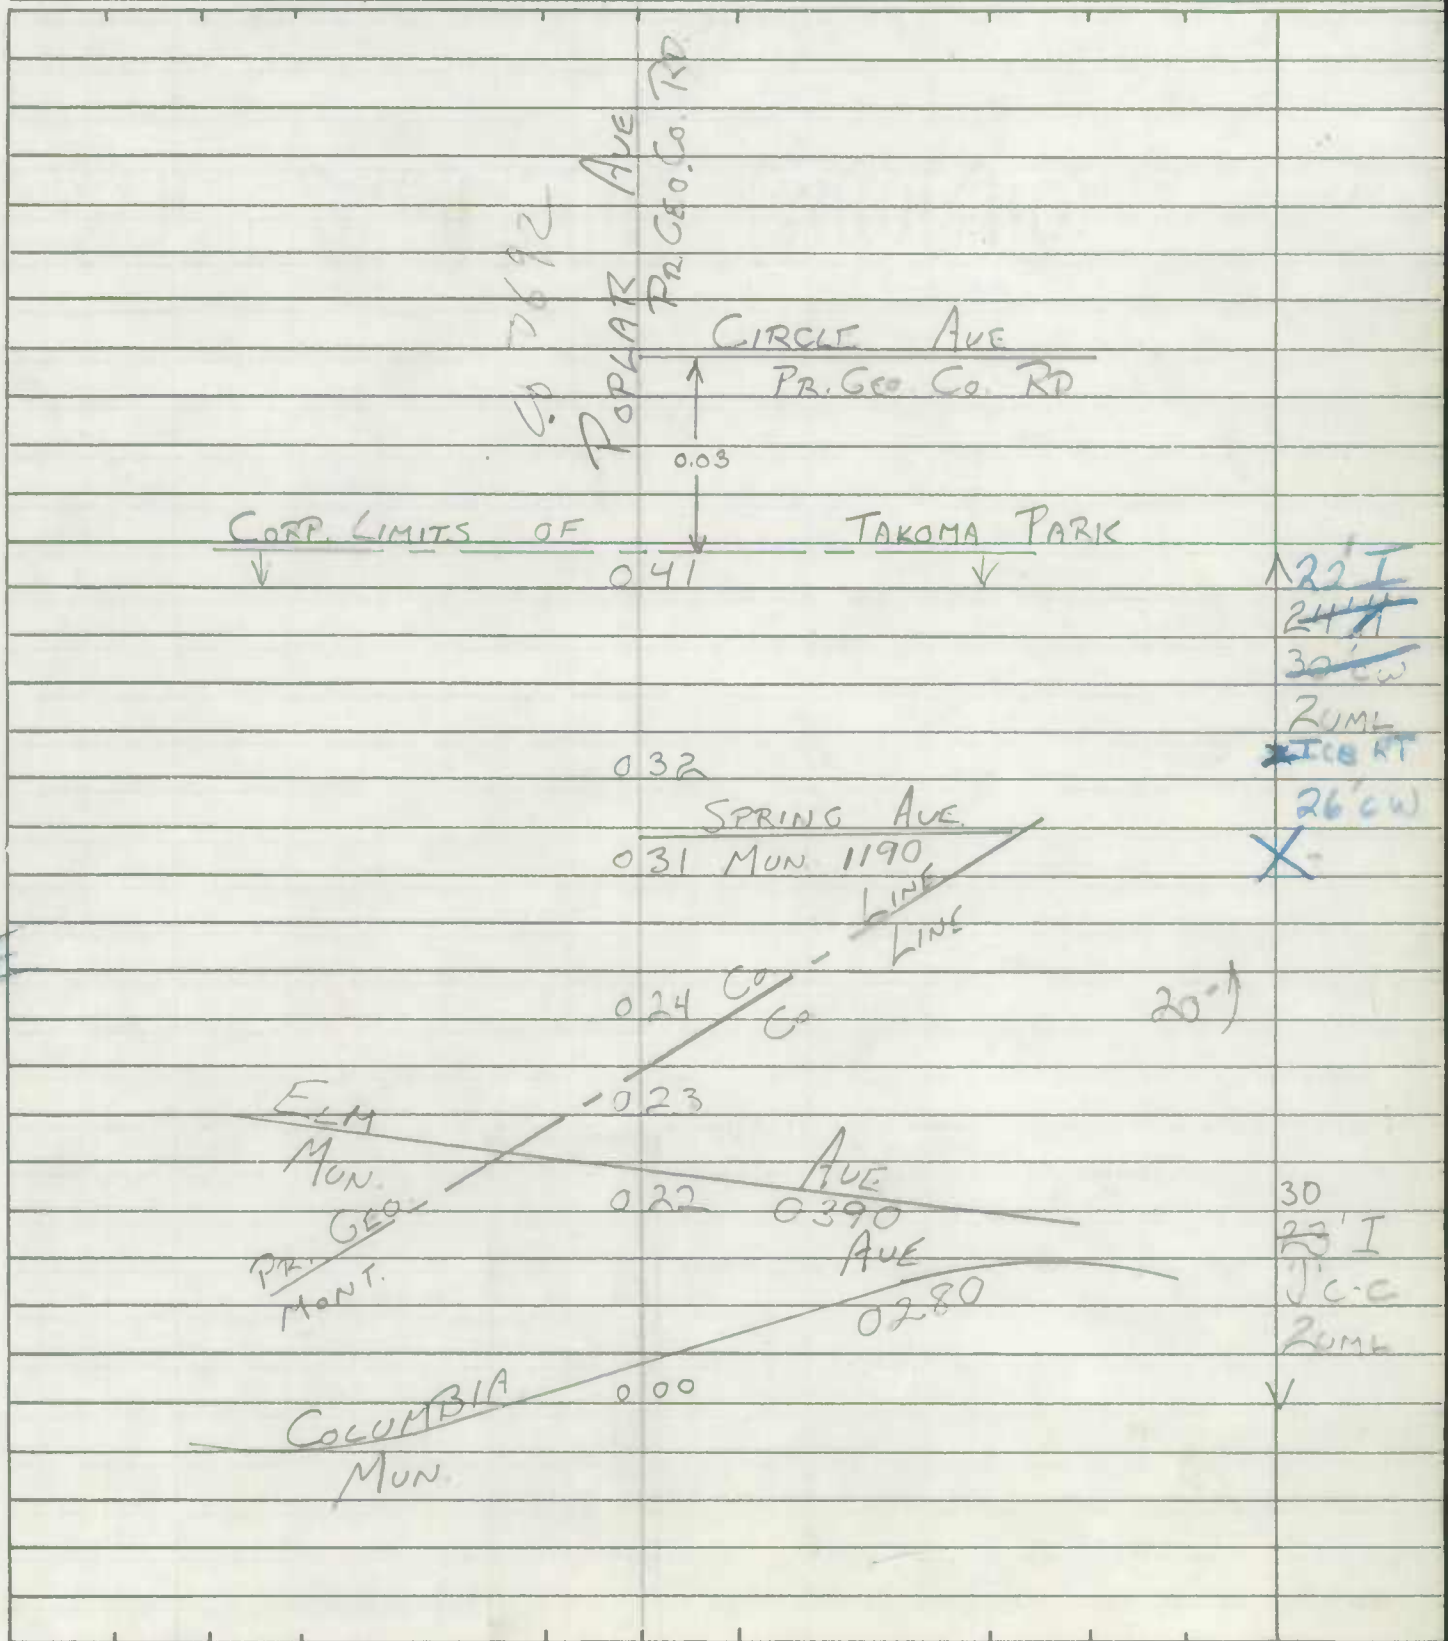

SHA 51.3-8
11-15-72

ROAD INVENTORY SHEET

Road No. _____
Road Name _____
Sheet No. _____
Date _____
County _____
State Coordinates _____

SHA 51.3-8
11-15-72

STATE HIGHWAY ADMINISTRATION OF MARYLAND

ROAD INVENTORY SHEET MUN 1140

Party Chief I. LANDON
Recorder M. [illegible]
Helper

Map No. 31

Road No. [illegible]
Road Name RITCHIE AVE
Sheet No. 1 of 1
Date 2-16-72
County MONT
State Coordinates 735-419

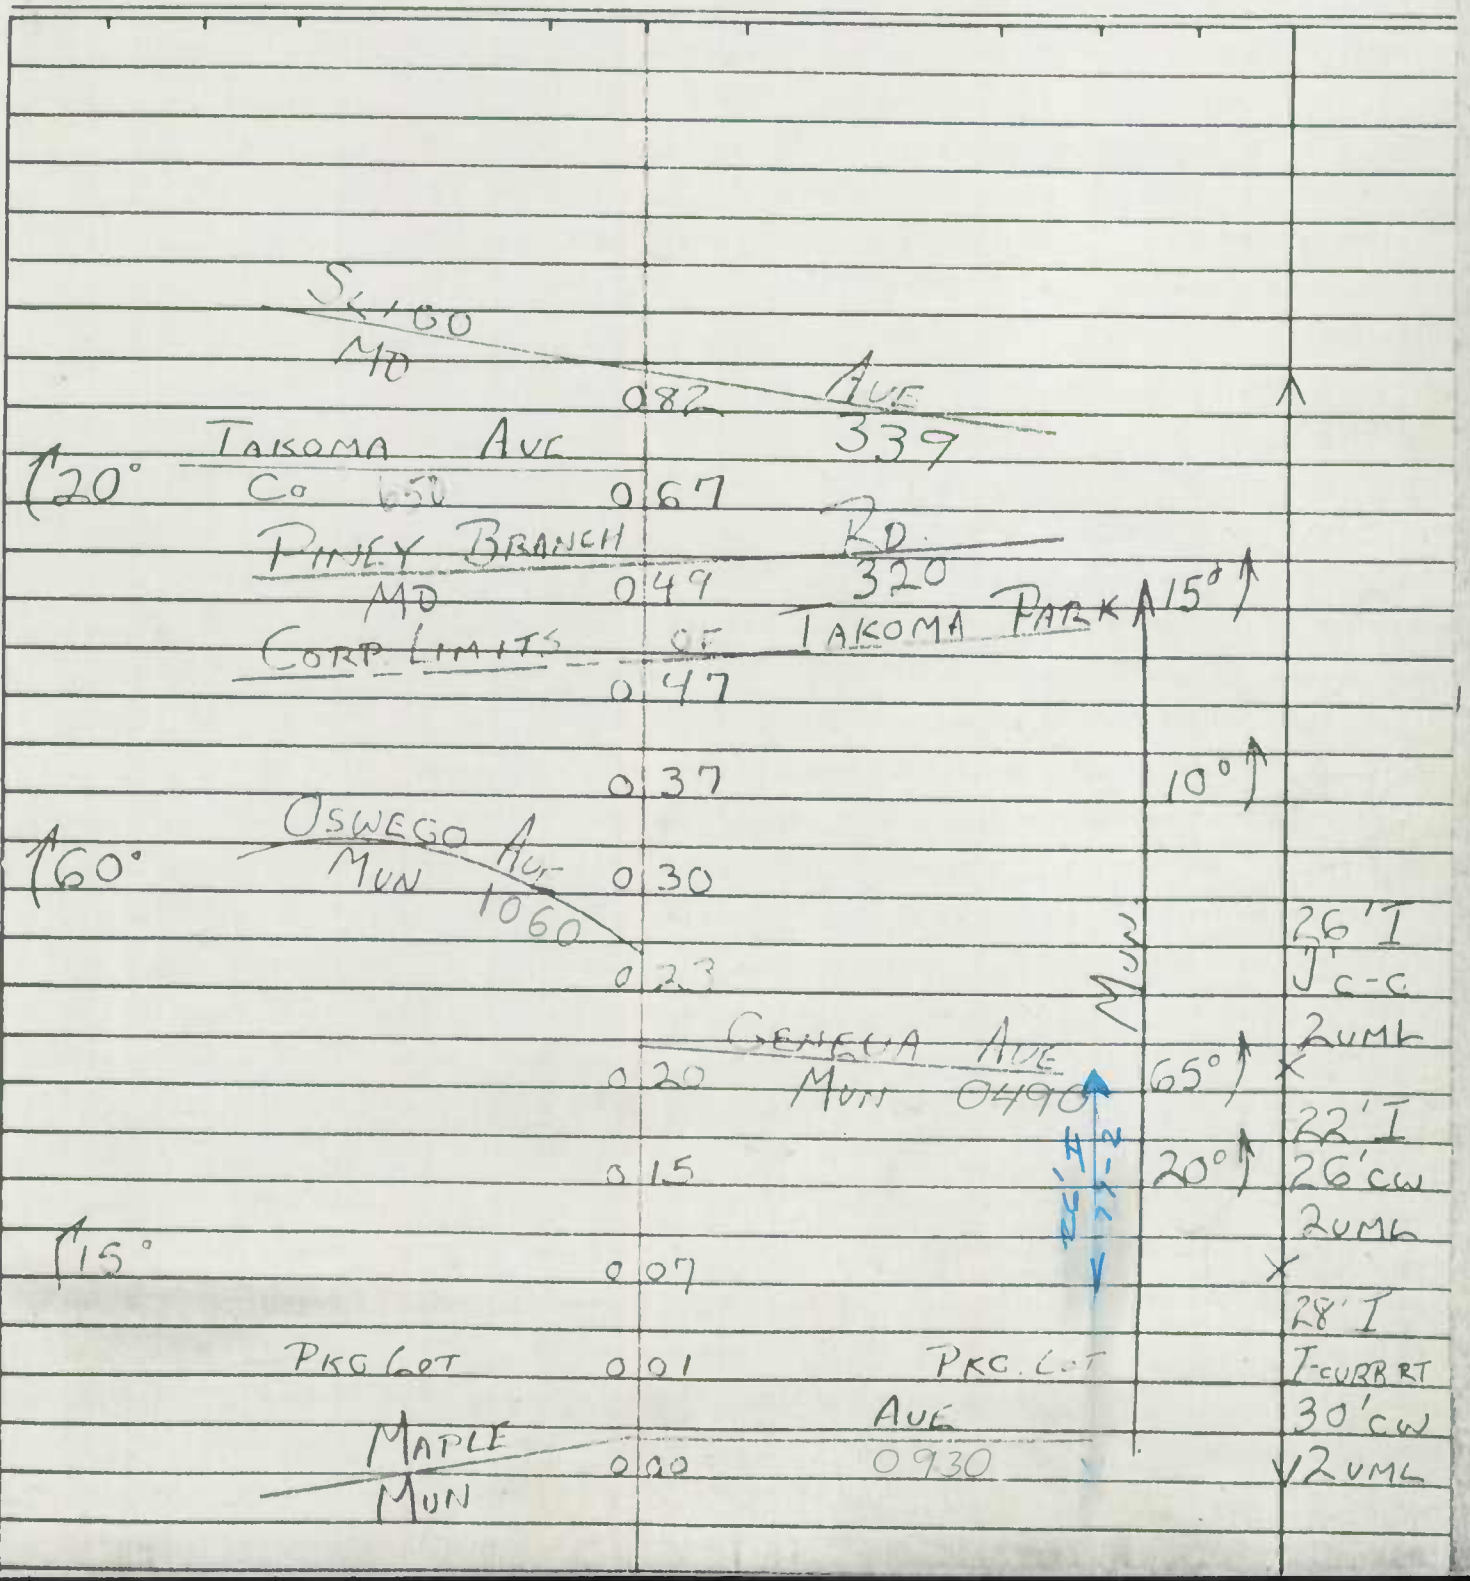

SHA 51.3-8
11-15-72

MUN 1220
00.650

ROAD INVENTORY SHEET

Party Chief T. LANDON
Recorder W. WARFIELD
Helper

Map No. 31

Road No. MD. 605
Road Name TAKOMA AVE
Sheet No. 1 of 2
Date 8-1-73
County MONT.
State Coordinates 797-419

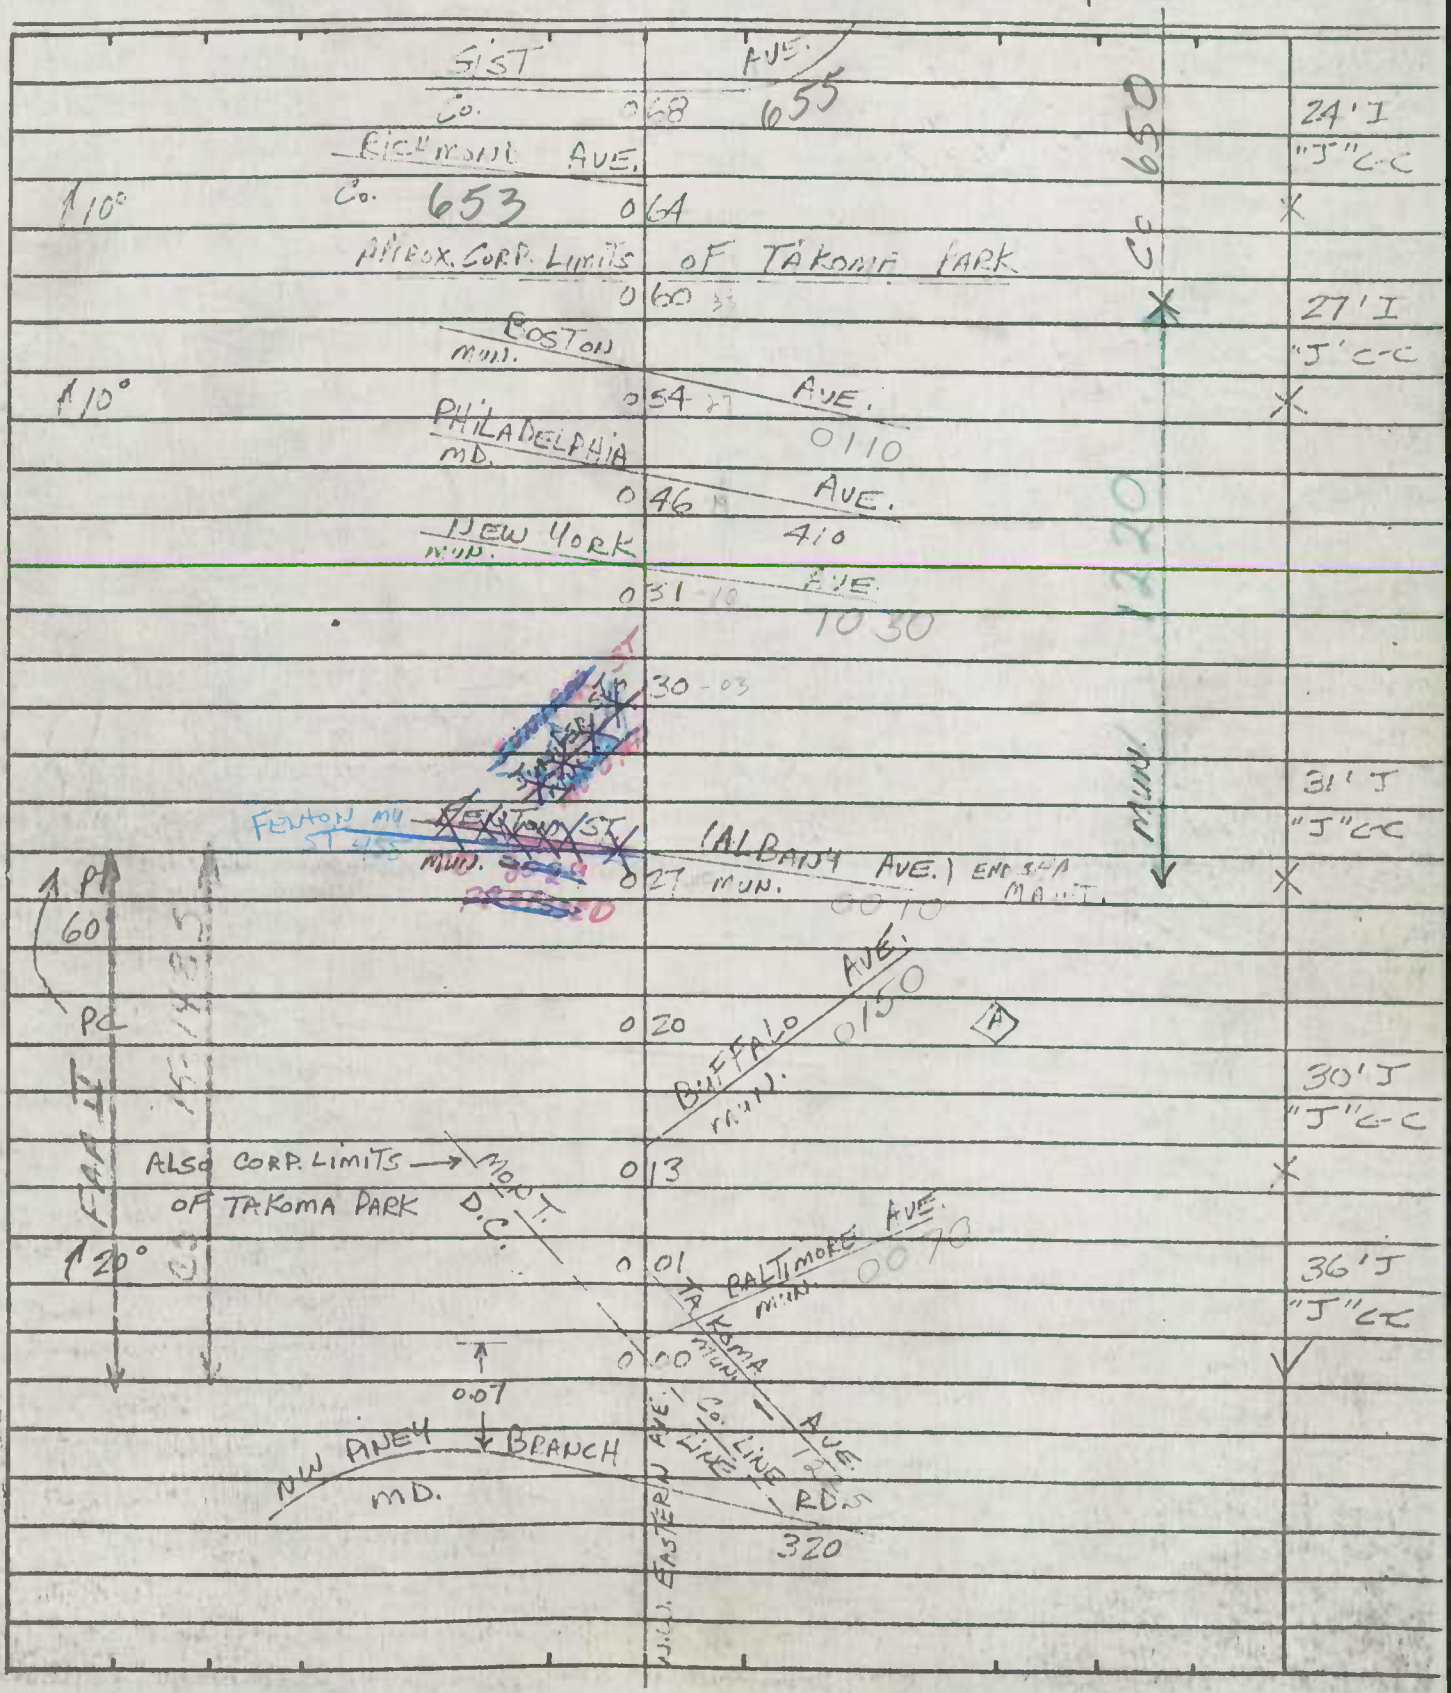

SHA 51.3-8
11-15-72

STATE HIGHWAY ADMINISTRATION OF MARYLAND

BB 87.6 A/2
MUN 12.80

ROAD INVENTORY SHEET

Party Chief T. LANDON
Recorder M. ZALENSKI
Helper

Map No. 31

Road No. Co. 945
Road Name WABASH AVE
Sheet No. 1 OF 1
Date 5-16-74
County MONT.
State Coordinates 800-422

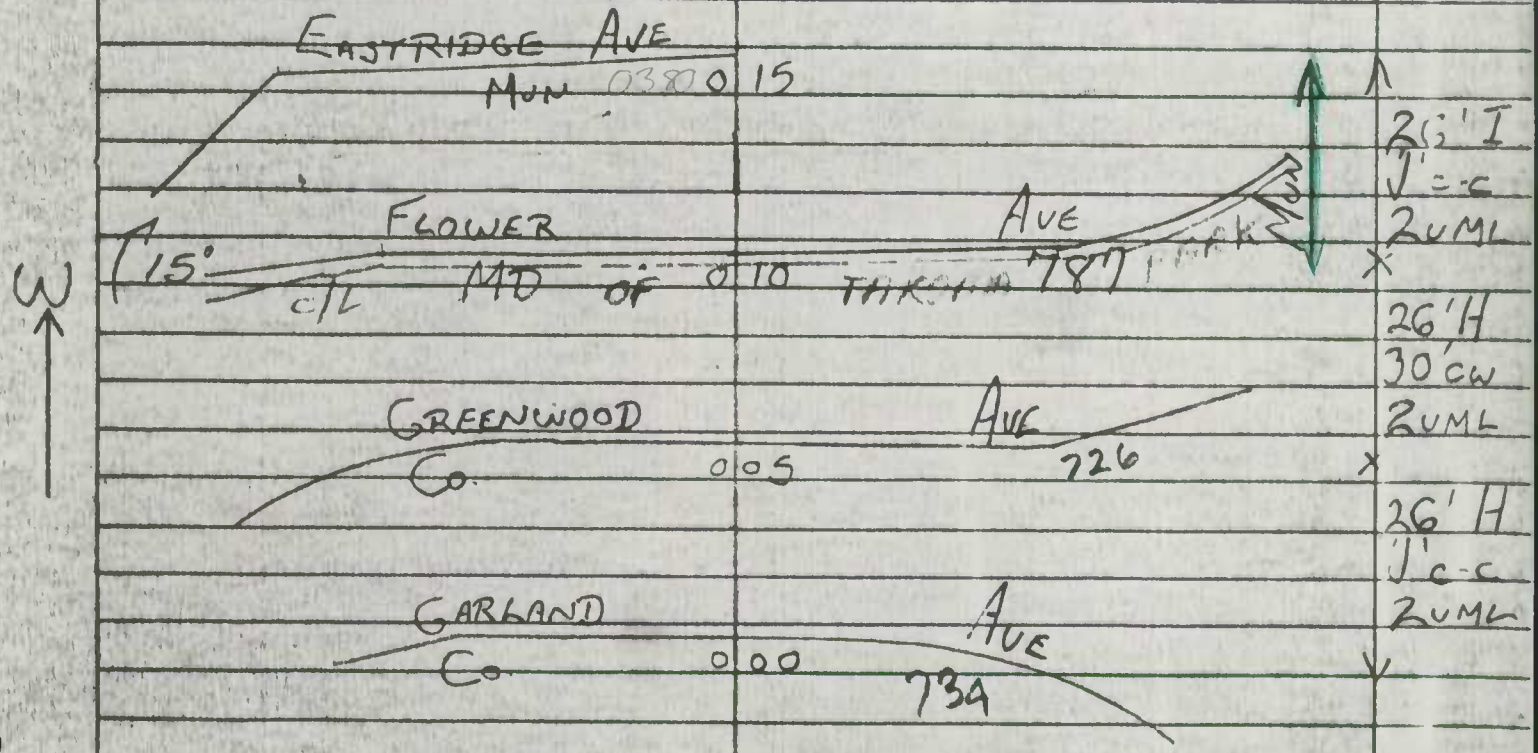

SHA 51.3-8
11-15-72

ROAD INVENTORY SHEET

MD. 195
~~MUN 0160~~

Party Chief J. LANDON
Recorder W. WARFIELD
Helper

Map No.

Road No. MD. 195
Road Name CARROLL AVE
Sheet No. 3 OF 5
Date 7-30-73
County MONT.
State Coordinates

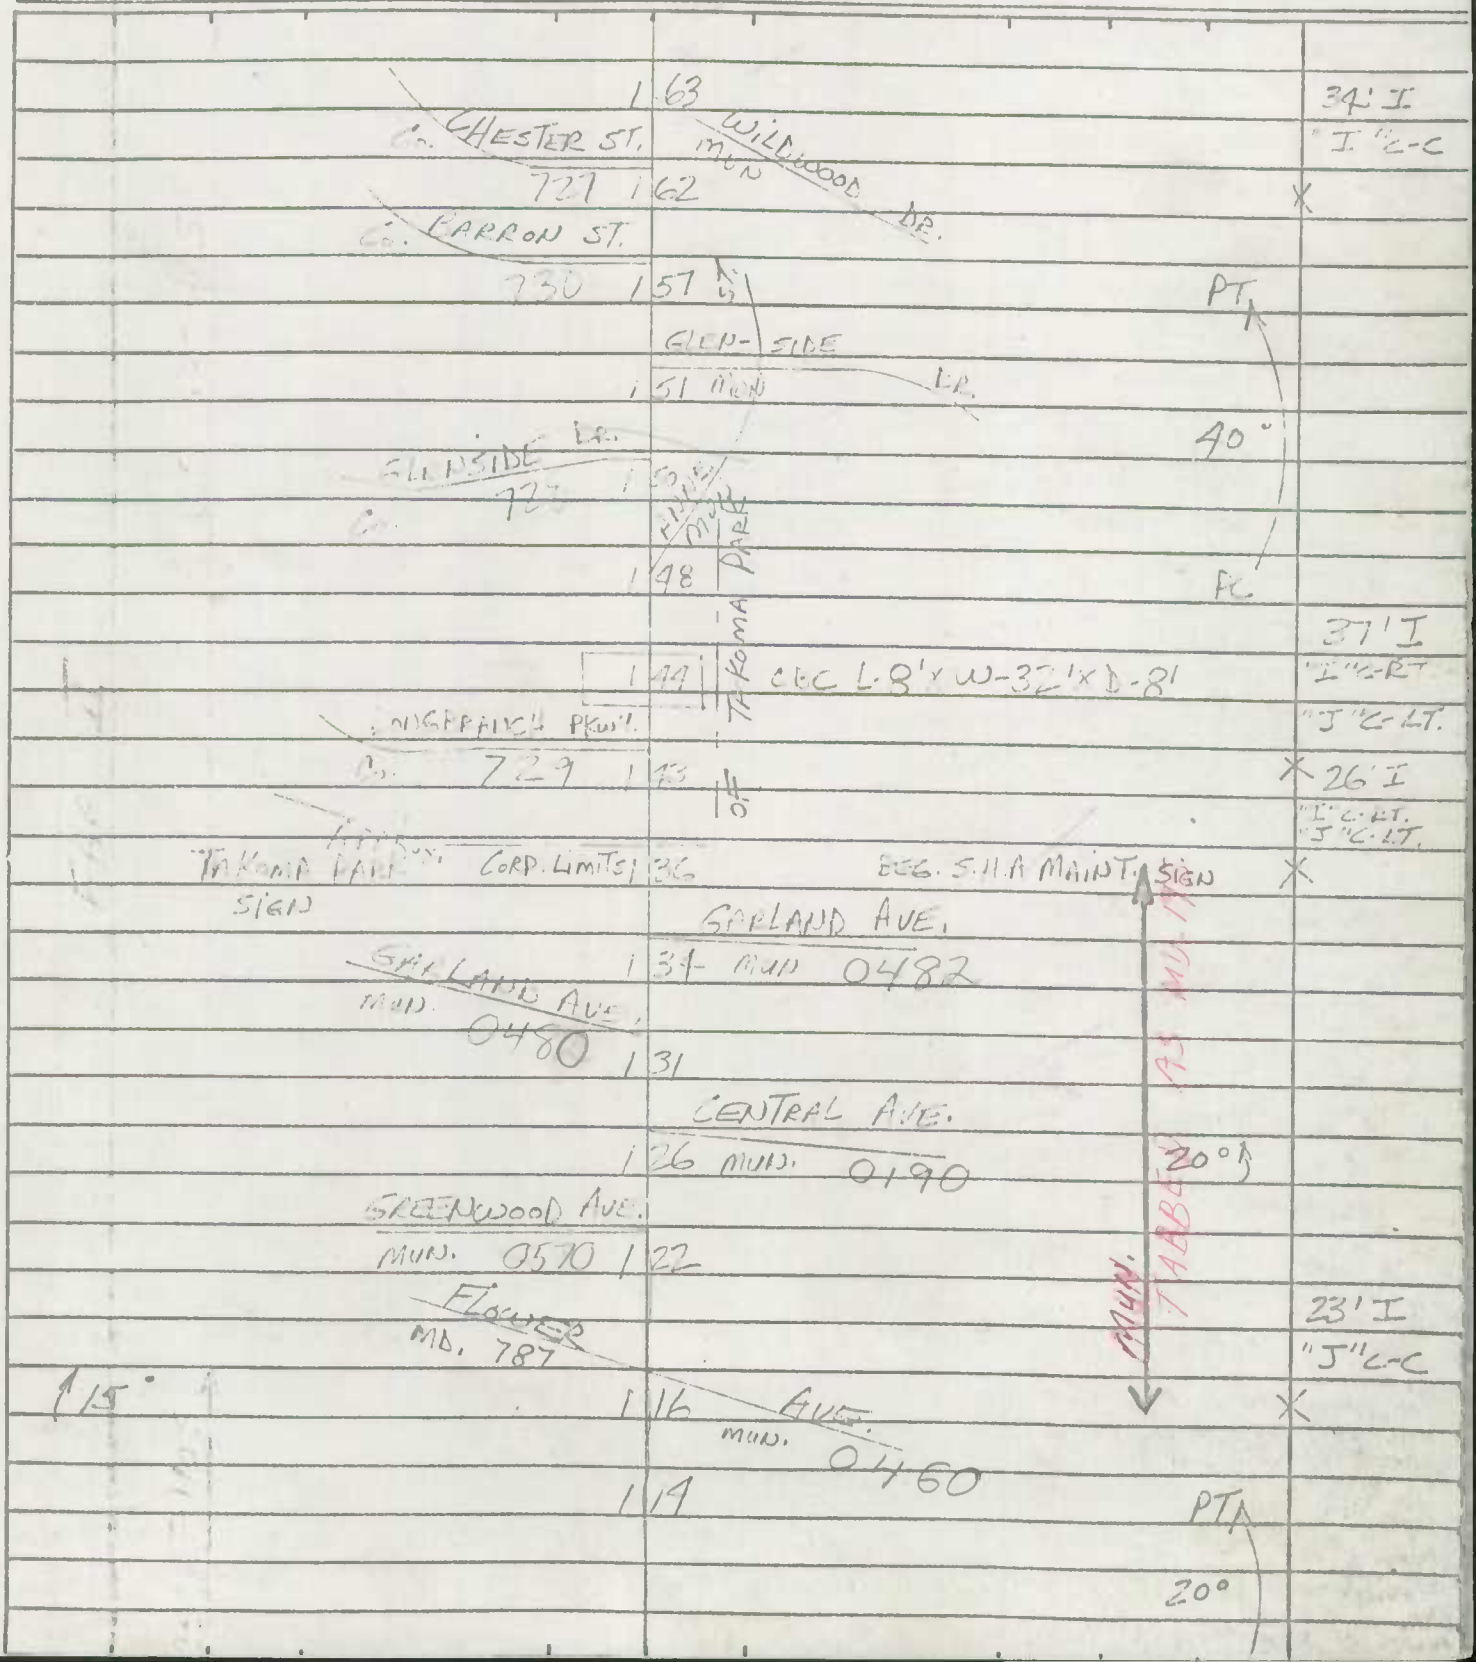

SHA 51.3-8
11-15-72

STATE HIGHWAY ADMINISTRATION OF MARYLAND

ROAD INVENTORY SHEET

Md. 410

T. LANDON
F. RHOADES
VERIFIED 6/11/78

Party Chief W. Dombroski
Recorder M. ZALENSKI
Helper

Road No. ~~MUN 0450~~
Road Name ETHAN ALLEN AVE
Sheet No. 1 of 1
Date 5-23-74
County Montgomery & PR. GEO
State Coordinates 298- 417

Map No. 31

TAKOMA PARK

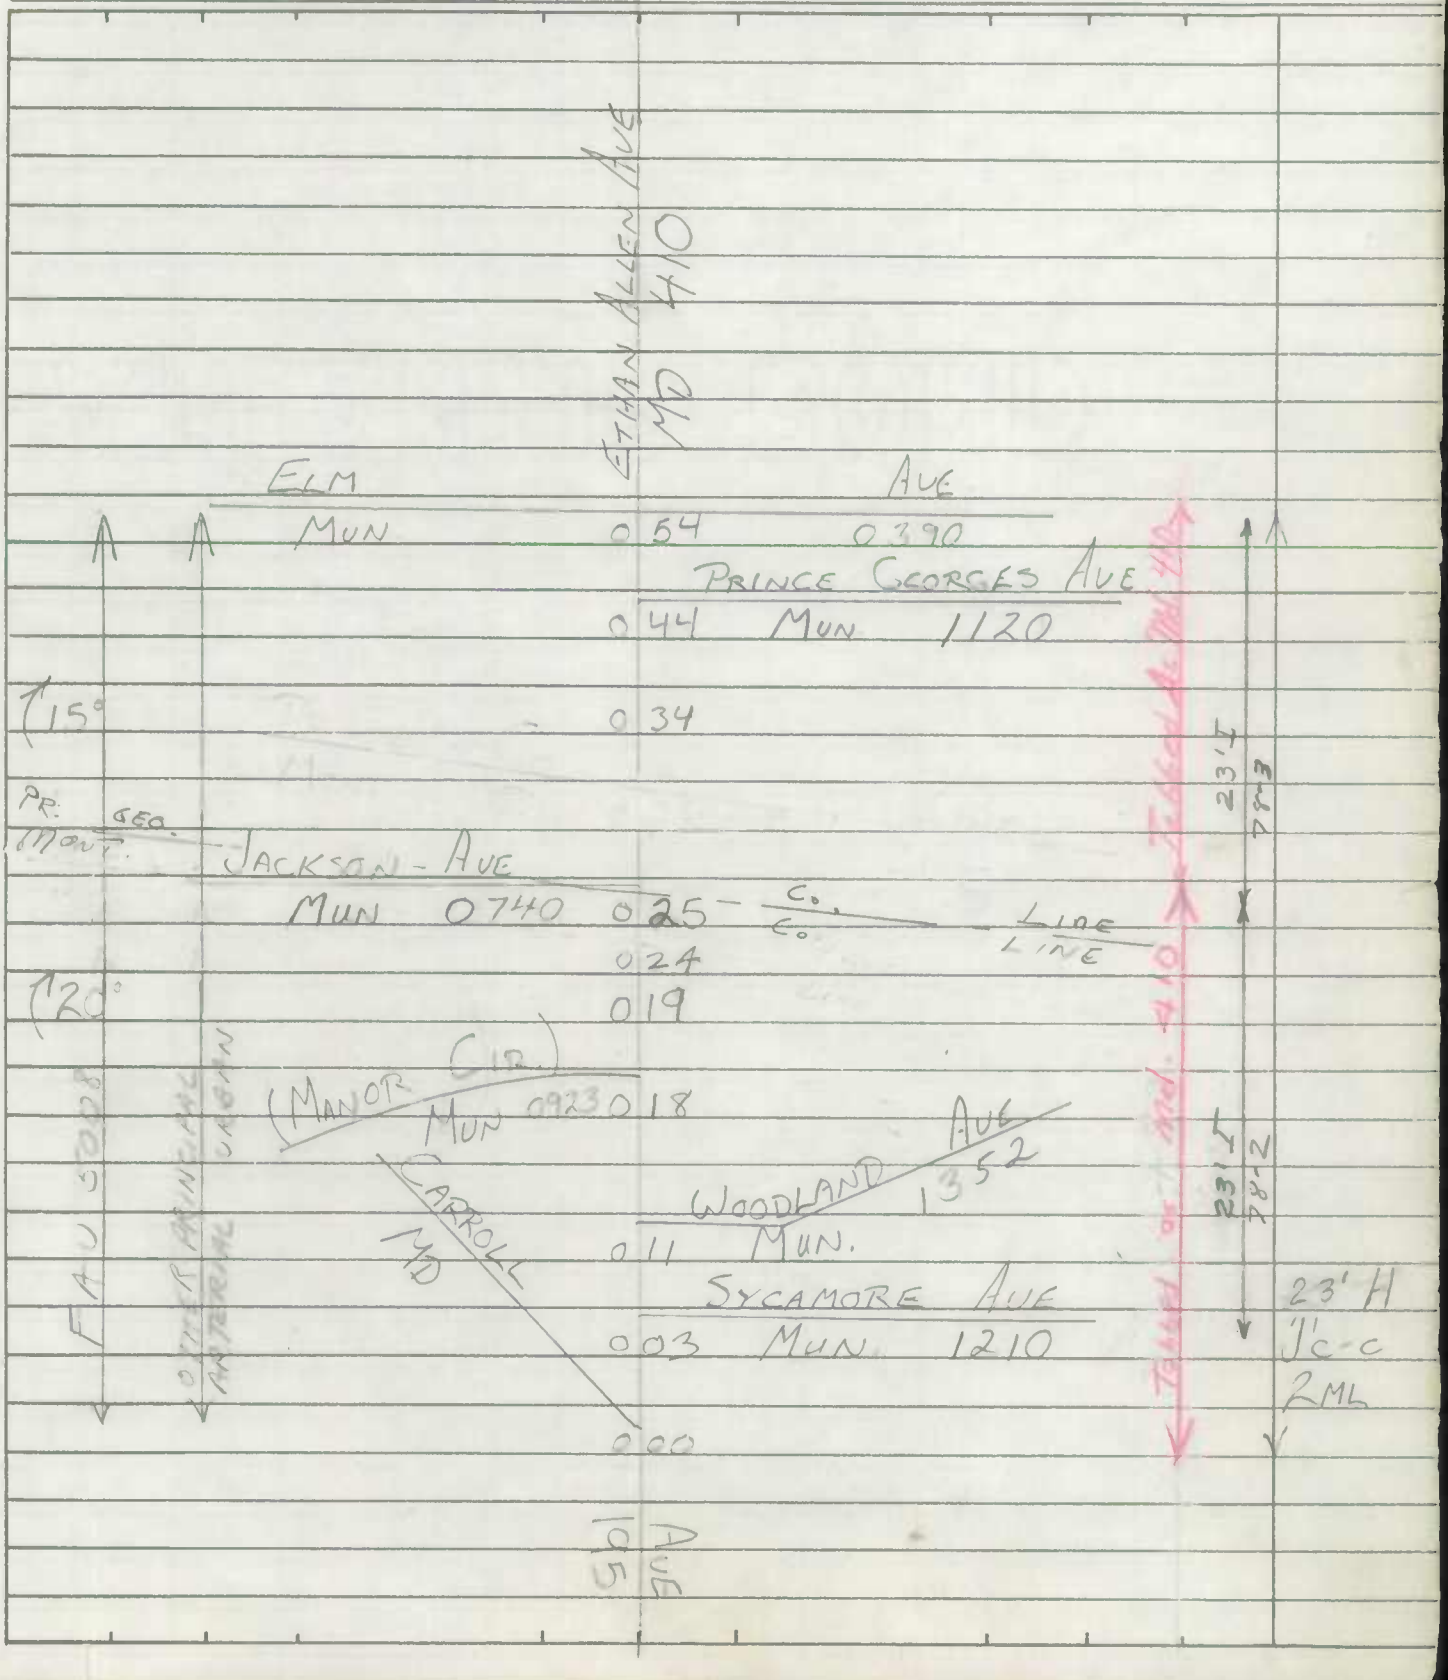

SHA 51.3-8
11-15-72

ROAD INVENTORY SHEET

Road No. _____
Road Name _____
Sheet No. _____
Date _____
County _____
State Coordinates _____

SHA 51.3-8
11-15-72

ROAD INVENTORY SHEET

MD. 410
PHILADELPHIA AVE.

Party Chief T. LANDON
Recorder W. WARFIELD
Helper

Map No. _____ Takoma Park

Road No. MD. 410
Road Name BURLINGTON AVE.
Sheet No. 7 of 9
Date 8-21-73
County MONT.
State Coordinates

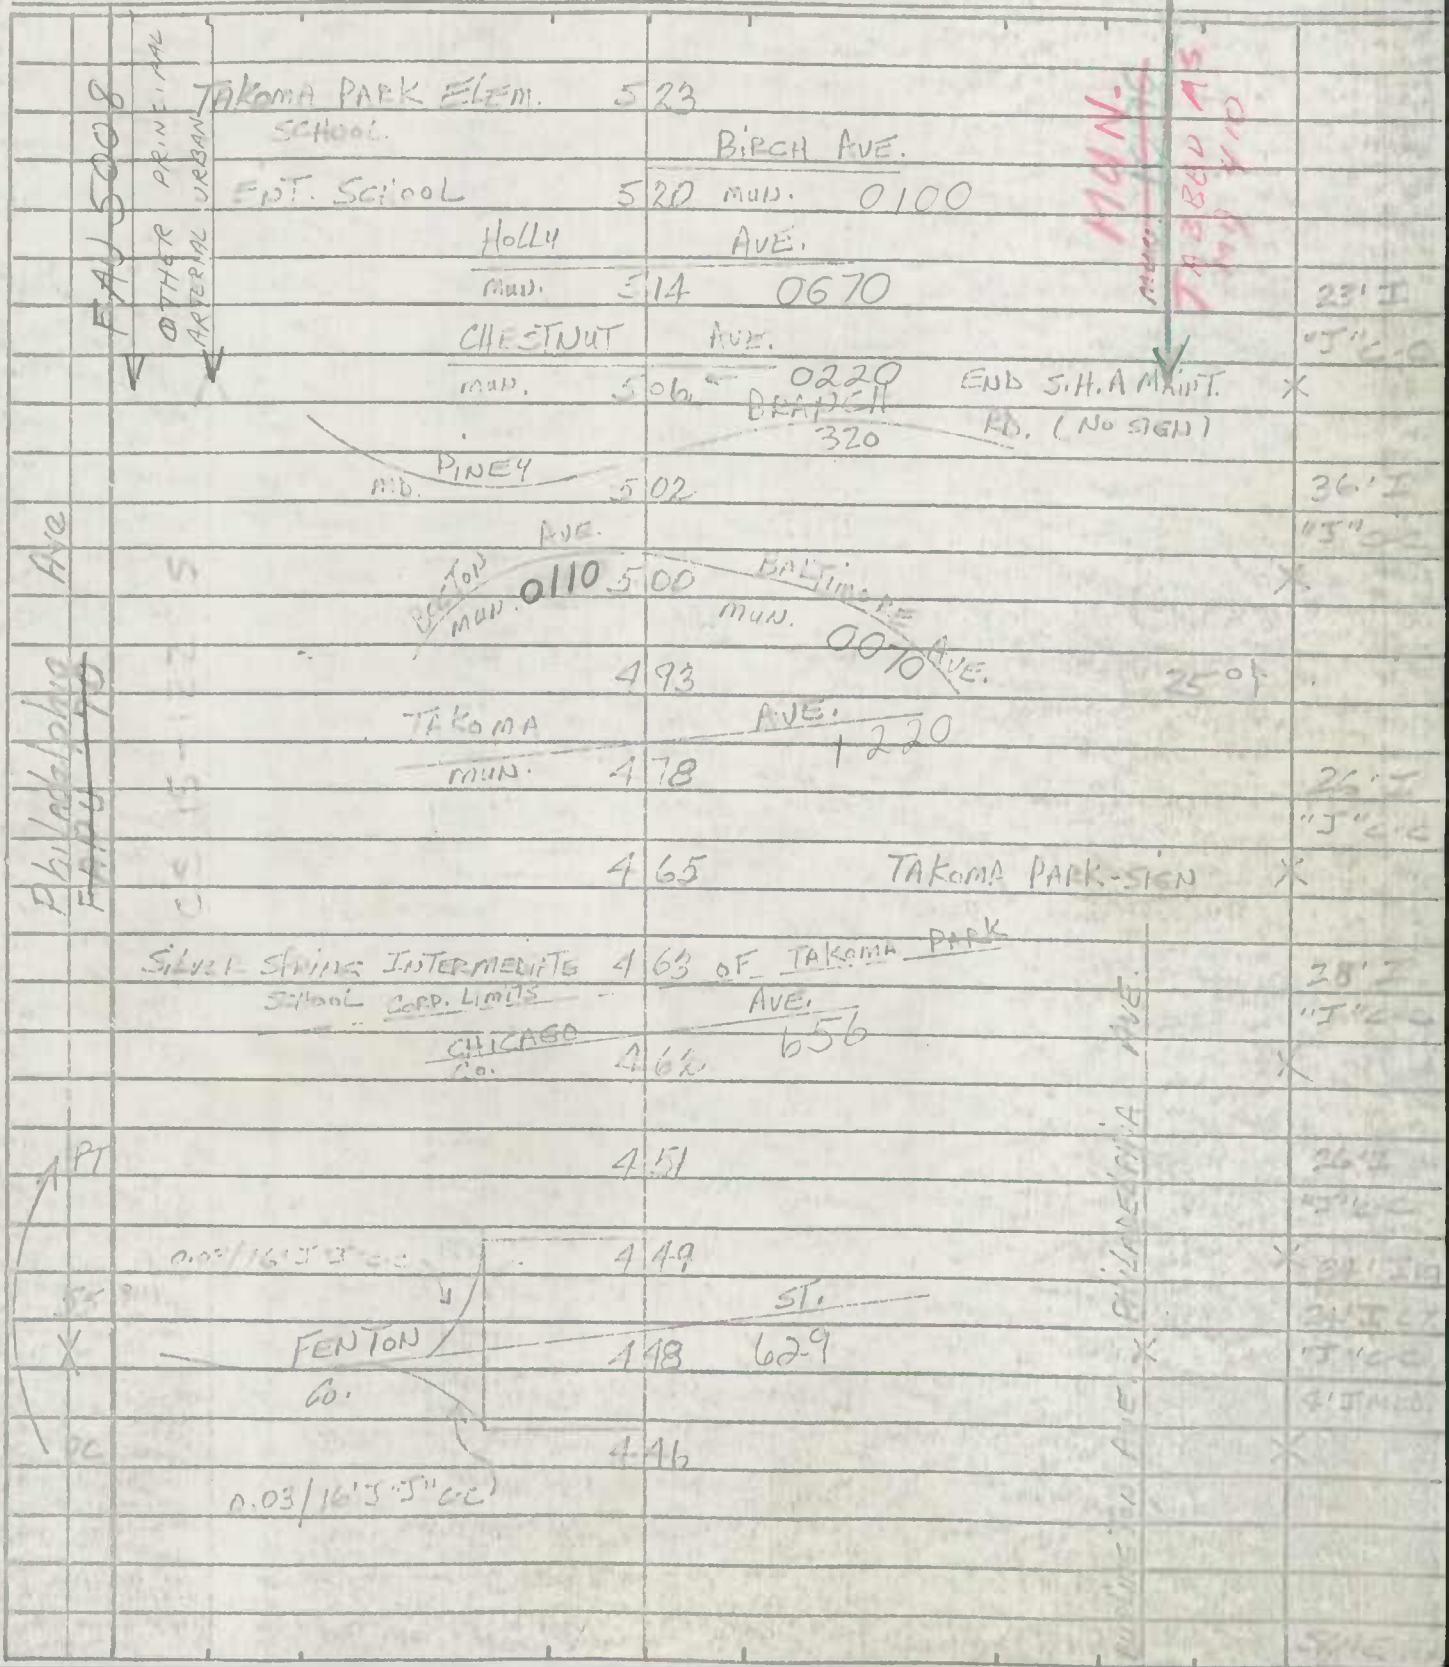

SHA 51.3-8
11-15-72

ROAD INVENTORY SHEET

MD. 410

Road No. MD. 410 ~~MD 1090~~
Road Name PHILADELPHIA AVE.
Sheet No. 8 OF 9
Date 8-21-73
County MONT.
State Coordinates 76-15 15

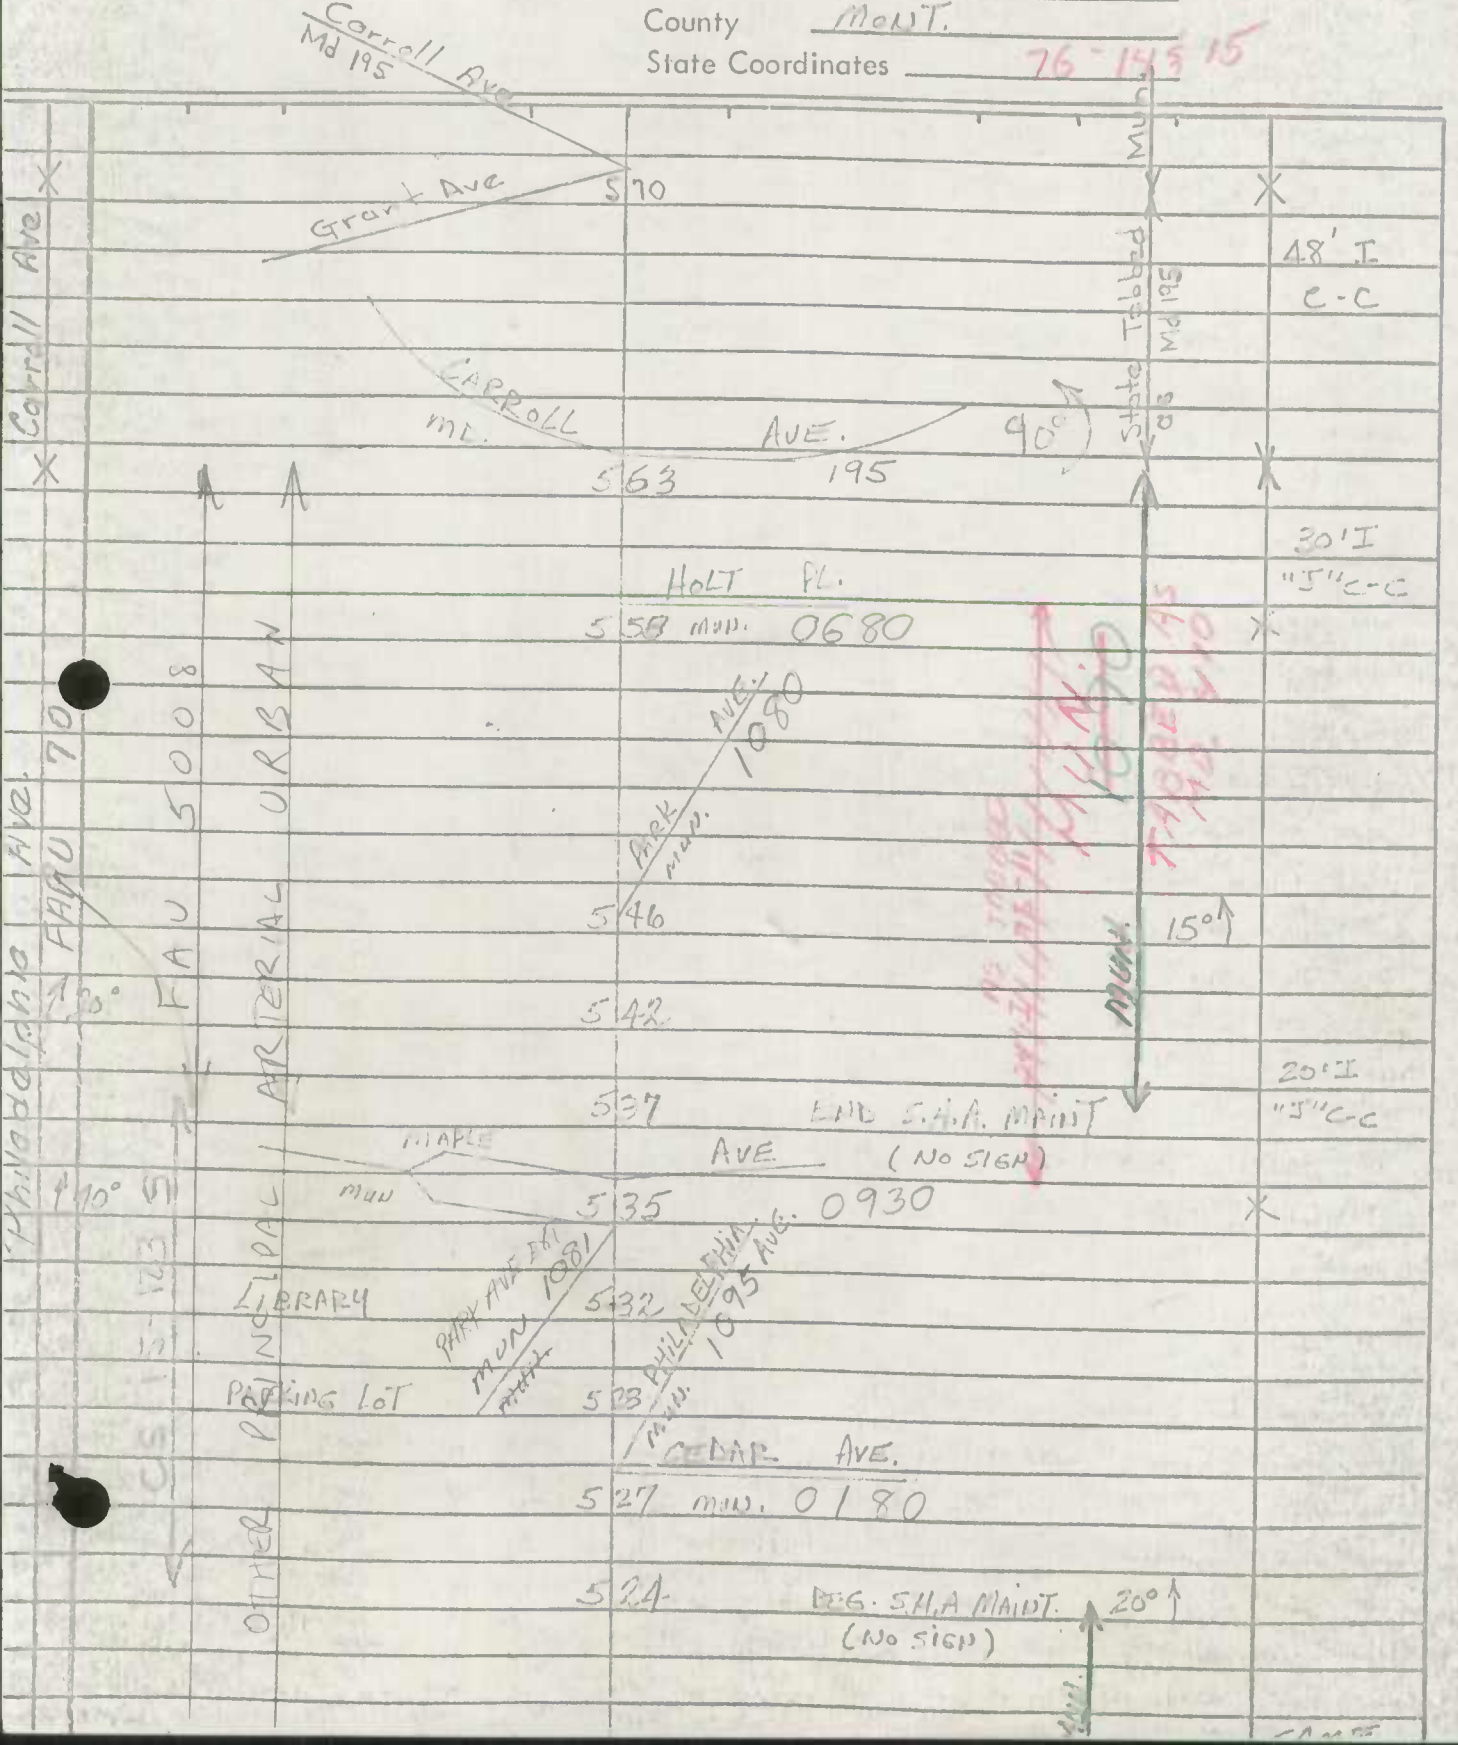

SHA 51.3-8
11-15-72

STATE HIGHWAY ADMINISTRATION OF MARYLAND

ROAD INVENTORY SHEET

MUN 0030

Party Chief T. LANDON
Recorder M. ZALENSKI
Helper

Map No. 31

CHEVY CHASE III

Road No. ~~CO~~ 4489
Road Name BLACKTHORN ST.
Sheet No. 1 OF 1
Date 4-16-74
County MONT
State Coordinates

91-2 A/T

Town of Chevy Chase

E

CONNECTICUT 0013 AVE
MD 193189

MUN 0030

MEADOW LA
MUN. 0000 0080

20'

26'I
3'c-c
2 UNL

24'I
3'c-c
2 UNL

SHA 51.3-8
11-15-72

STATE HIGHWAY ADMINISTRATION OF MARYLAND

MUN 0030

ROAD INVENTORY SHEET

Party Chief I. LANDON
Recorder M. ZALENSKI
Helper

Map No. 31

CHEVY CHASE III

Road No. ~~Co~~ 4489
Road Name BLACKTHORN ST.
Sheet No. 1 OF 1
Date 4-16-74
County MONT
State Coordinates

91-2 A/T

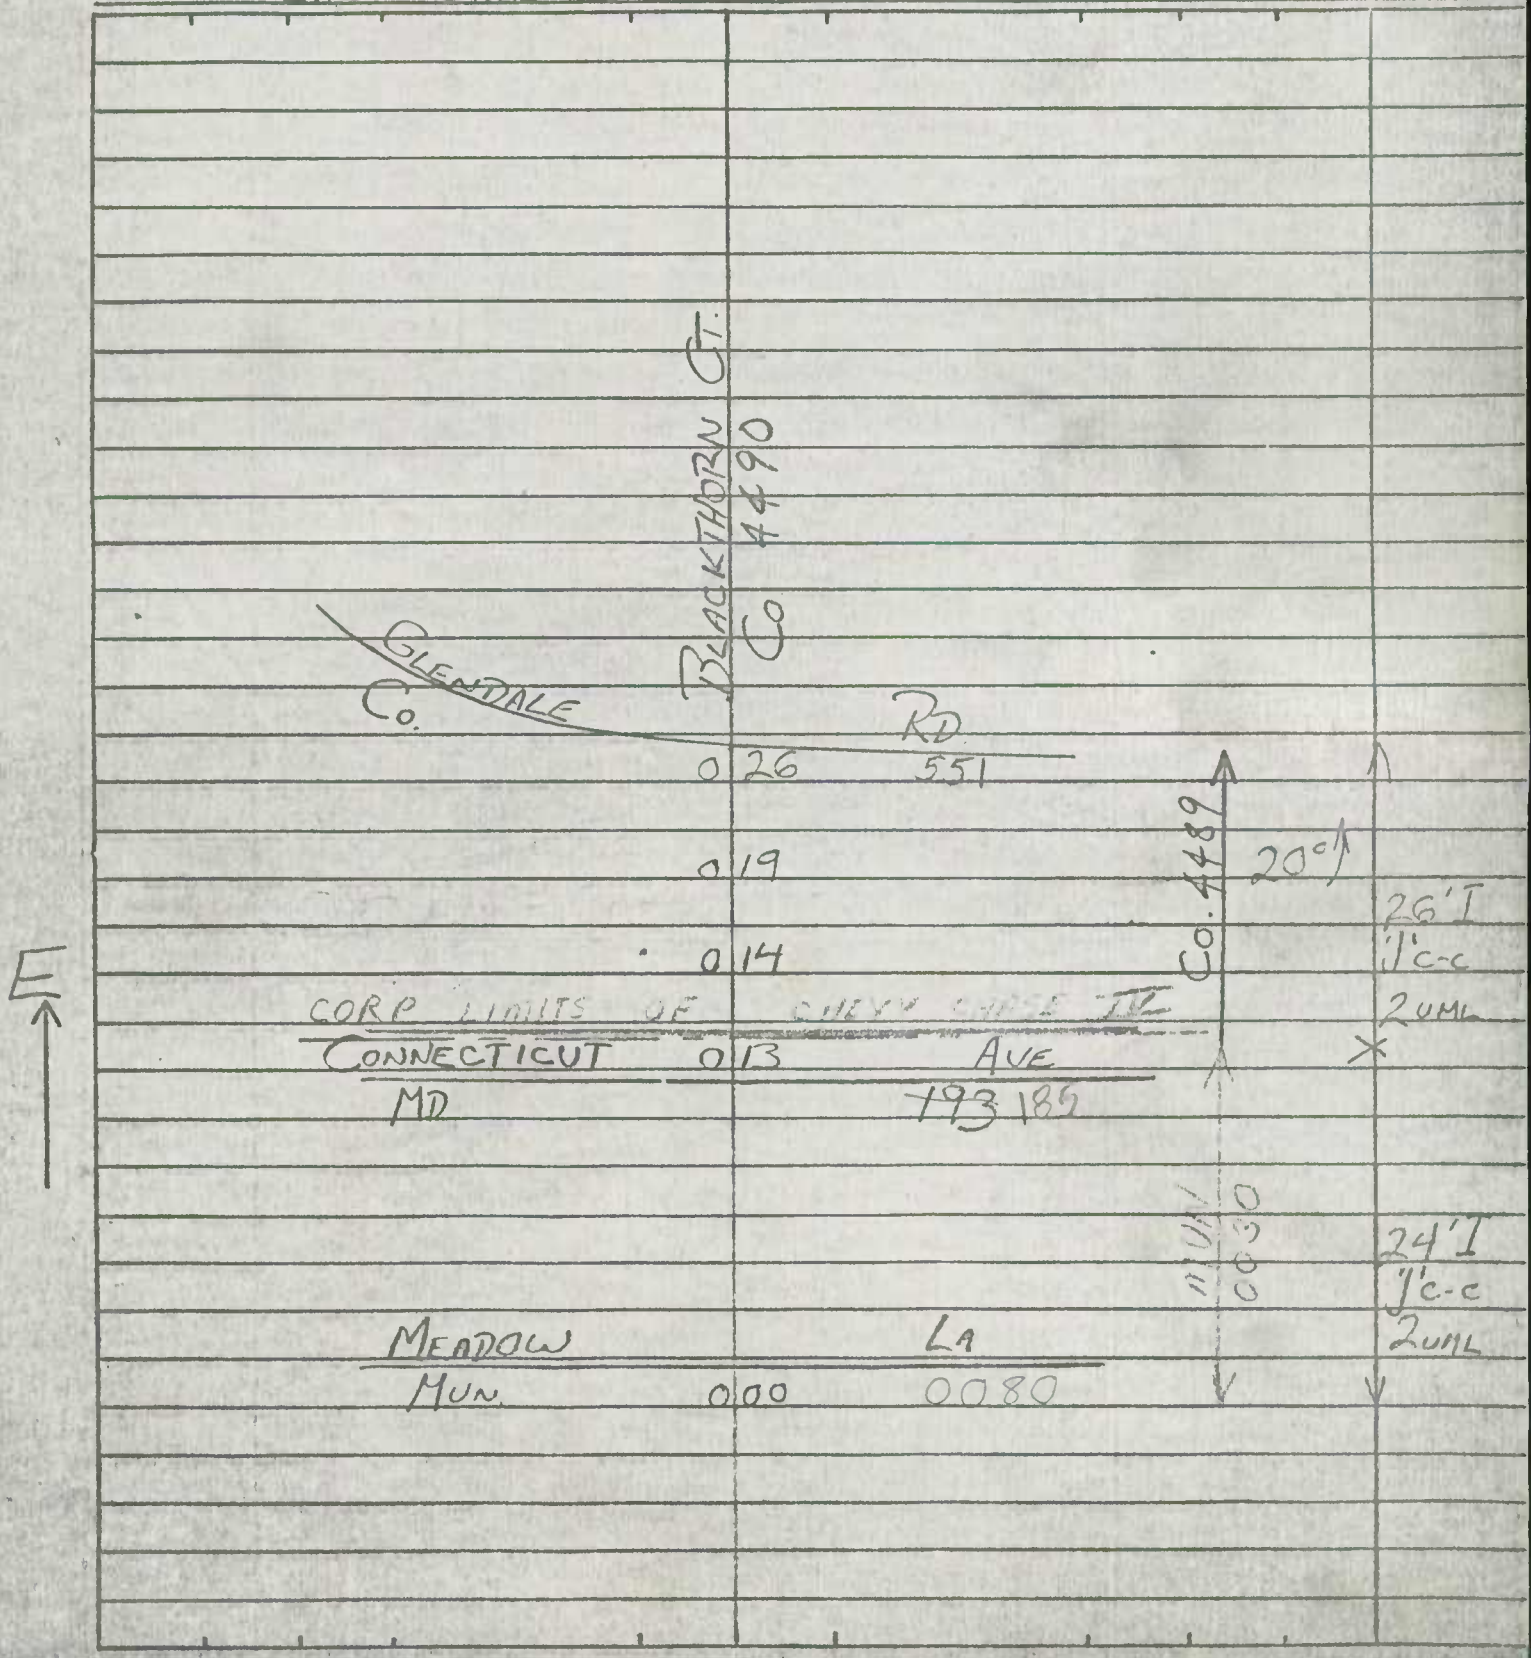

SHA 51.3-8
11-15-72

STATE HIGHWAY ADMINISTRATION OF MARYLAND

ROAD INVENTORY SHEET

Mun. 0048

Party Chief T. LANDON
Recorder M. LASENSKI
Helper

Map No. 30

Road No. Co. 409
Road Name ELM ST #1
Sheet No. 1 OF 1
Date 4-19-74
County MONT
State Coordinates 225-419
29-4

CHEVY CHASE IV

76-16

SEE NEW INV. NOW COMB. WITH MU0049

80-5

WISCONSIN 024 AVE
MD 355

W

Corp 47TH ST Limits — Chevy Chase IV

MU 0250 Co. 414 → 019
46TH ST

MU Co. 0255 → 413 014
45TH ST

MU 0260 Co. 412 ← 007
44TH ST

Co. → 445 000
MU 0256

36'I
1-CURB RT
1-CURB LT
2 UML

23'I
1 C-C
2 UML

SHA 51.3-8
11-15-72

ROAD INVENTORY SHEET

Road No. _____
Road Name _____
Sheet No. _____
Date _____
County _____
State Coordinates _____

SHA 51.3-8
11-15-72

STATE HIGHWAY ADMINISTRATION OF MARYLAND

ROAD INVENTORY SHEET MUN. 0049

Party Chief T. LANDON
Recorder M. ZALENSKI
Helper

Map No. 30

Road No. ~~Co 4450~~
Road Name ELM ST #2
Sheet No. 1 OF 1
Date 4-17-74
County MONT.
State Coordinates 775-419

CHEVY CHASE IV

NOW PART OF

MU 0048

80-5

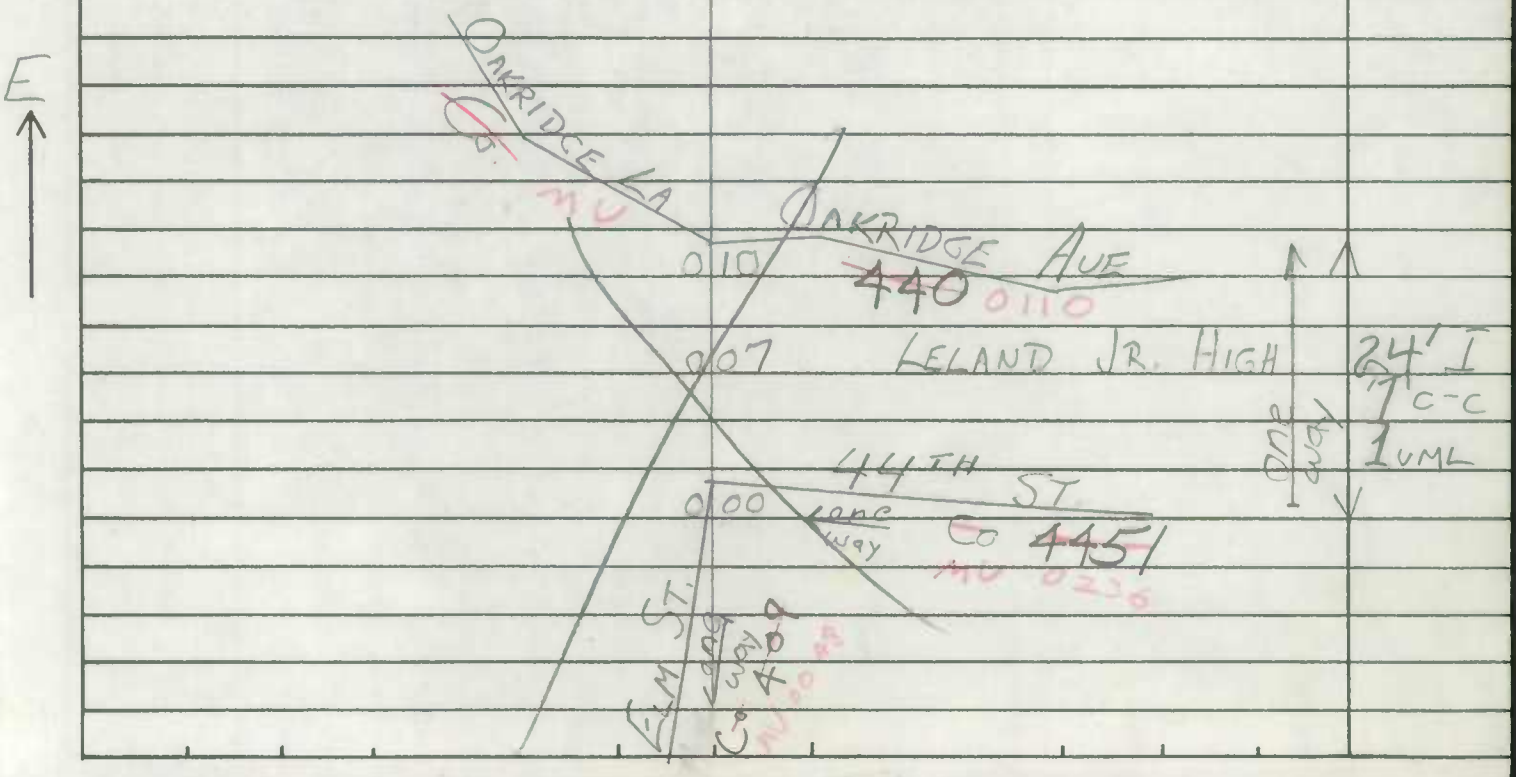

SHA 51.3-8
11-15-72

ROAD INVENTORY SHEET

Road No. _____
Road Name _____
Sheet No. _____
Date _____
County _____
State Coordinates _____

SHA 51.3-8
11-15-72

MD 82

Town of Chevy Chase

ROAD INVENTORY SHEET

C/S 1-25

MUN 0055

Party Chief T. LANDON
Recorder W. WARFIELD
Helper

Map No. 30 & 31

Road No. ~~MD 82~~
Road Name LELAND ST. #2
Sheet No. 1 OF 2
Date 7-24-73
County MONT.
State Coordinates 772-417

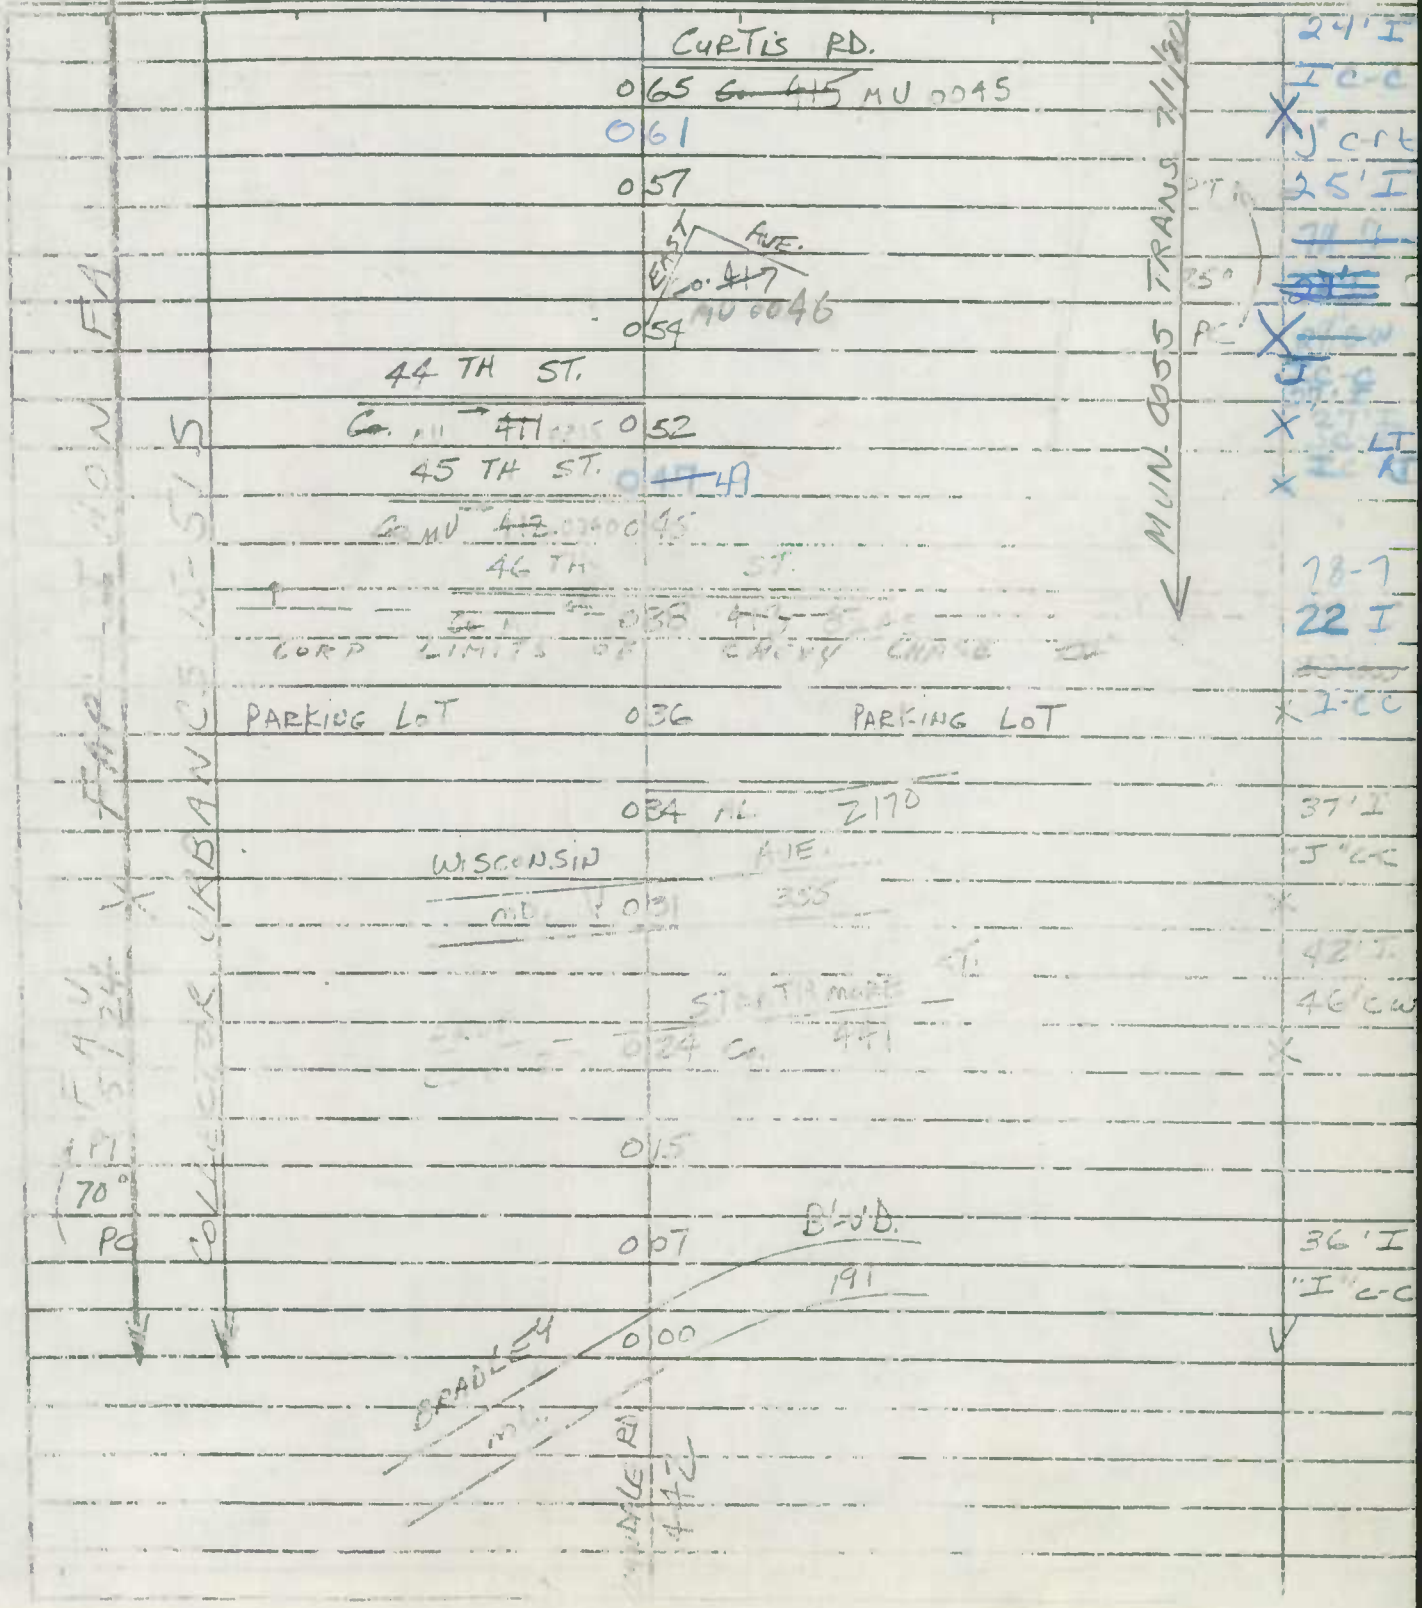

SHA 51.3-8
11-15-72

MUN 0055

ROAD INVENTORY SHEET

[redacted] AVE.

Road No. ~~MD. 82~~
Road Nome LELAND ST. #2
Sheet No. 2 OF 2
Date 7-24-73
County MONT.
State Coordinates

8611
CA
JE

81-7

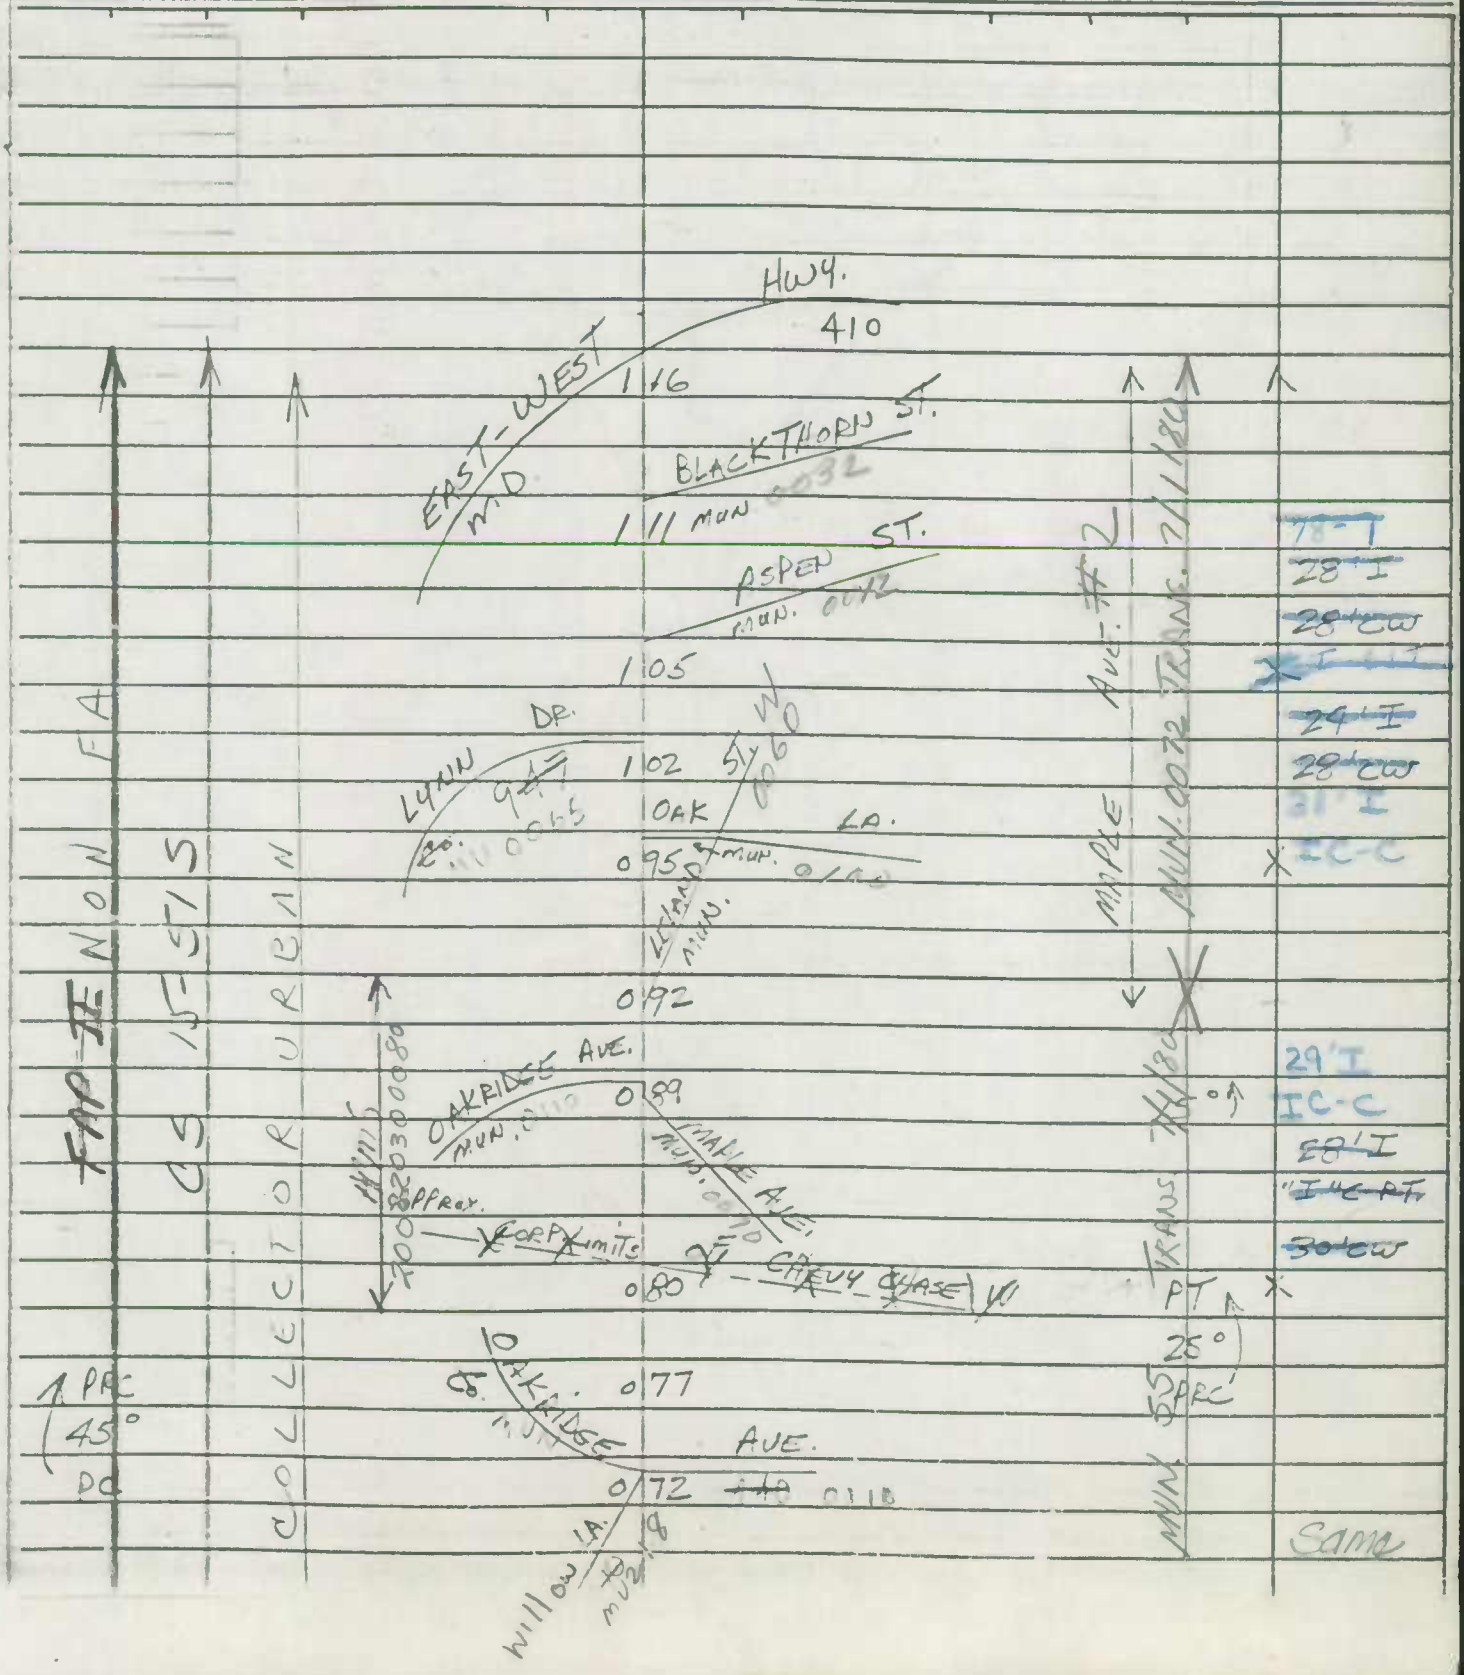

SHA 51.3-8
11-15-72

STATE HIGHWAY ADMINISTRATION OF MARYLAND LELAND ST.

ROAD INVENTORY SHEET Co 408

Town of Chevy Chase

0055

Party Chief I. LANDON
Recorder M. ZALENSKI
Helper

Road No. MUN 0060
Road Name W. LELAND ST.
Sheet No. 1 of 2 3 of 4
Date 4-16-74
County MONT
State Coordinates

9 miles
GD-JK
3-23-92

Map No. 31

CHEVY CHASE IV & VI

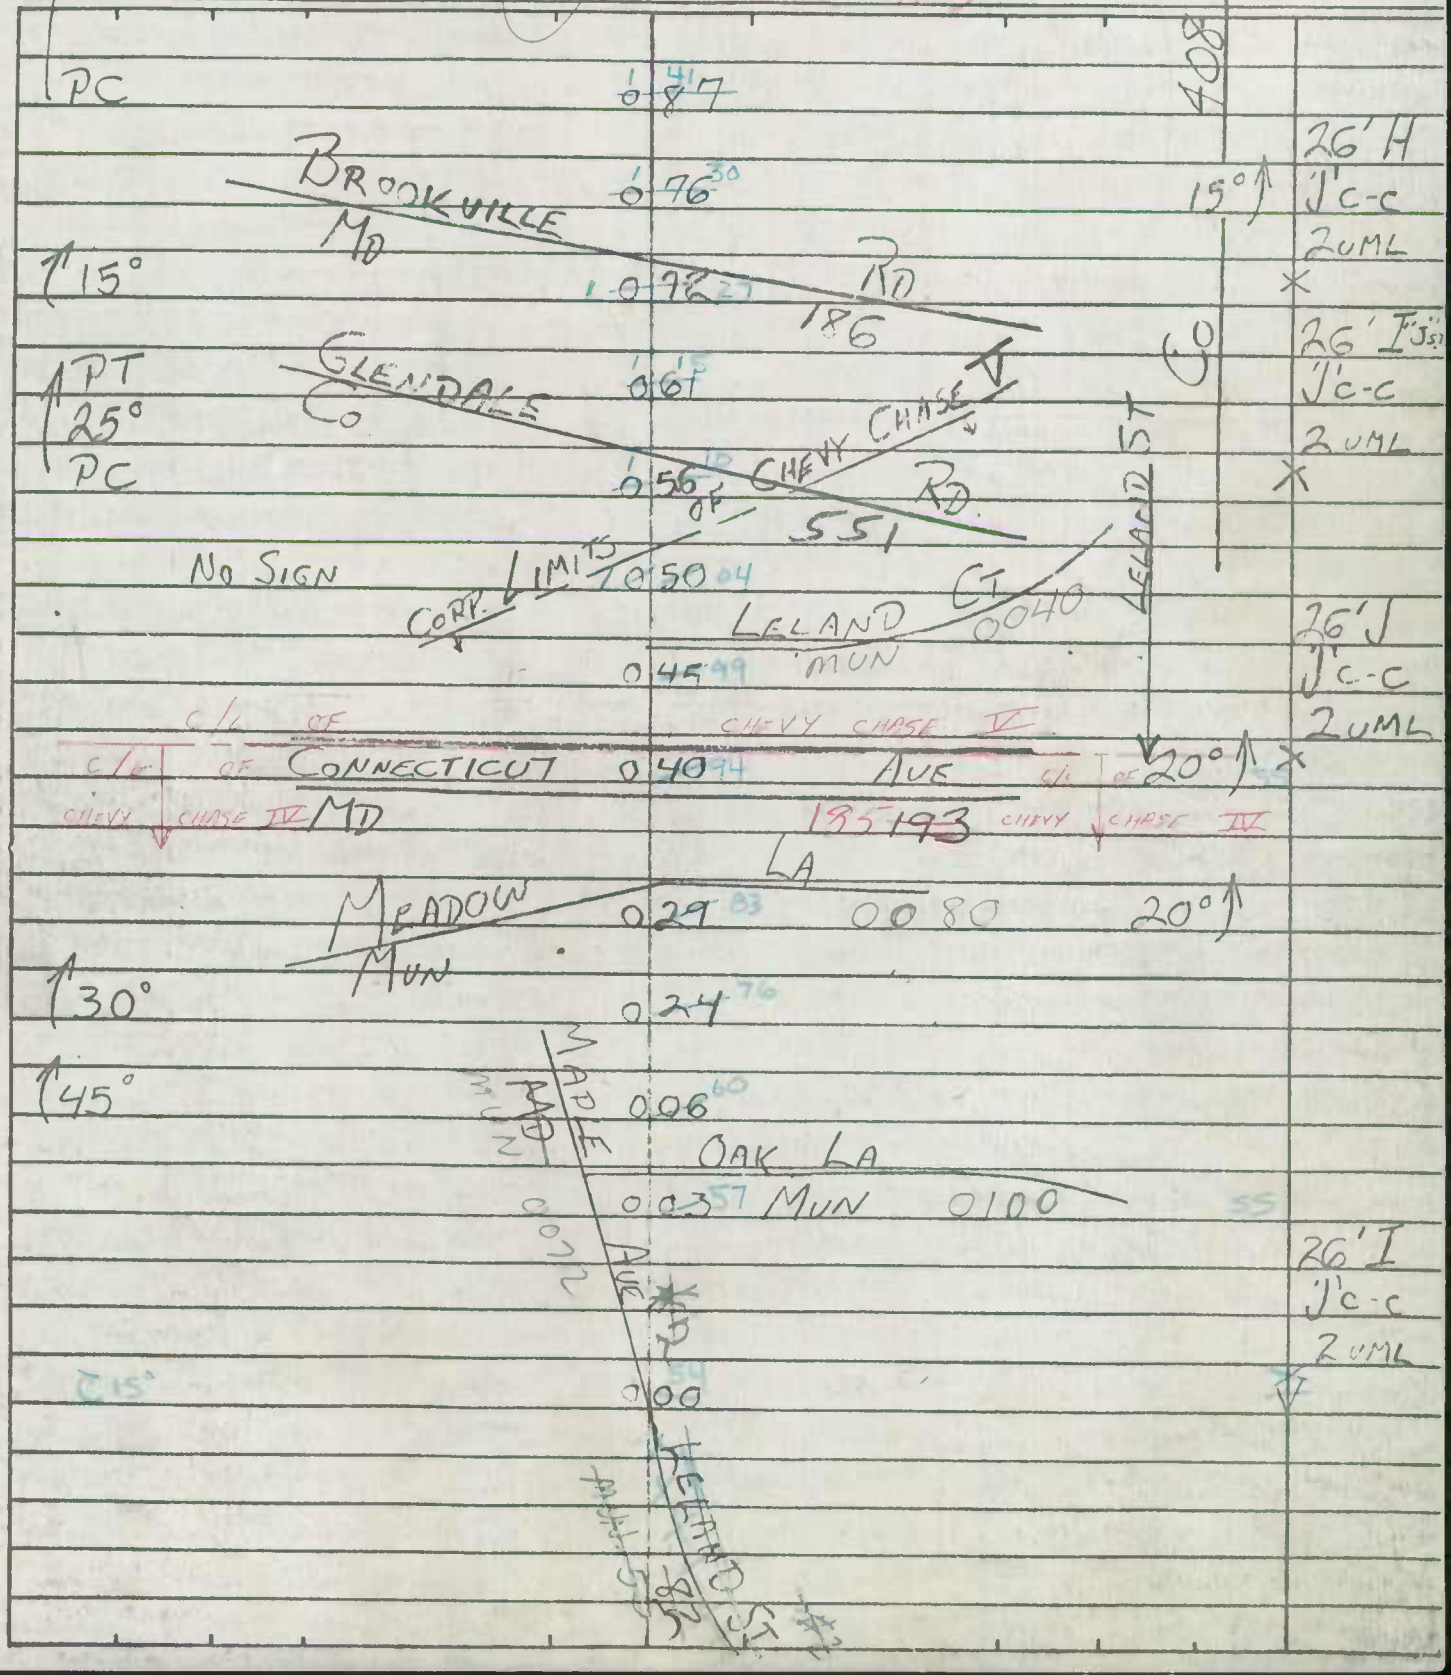

11-15-72

ROAD INVENTORY SHEET

MUN 0072
MAPLE AVE. #2

Road No. ~~MD. 82~~
Road Name ~~LELAND CT. #2~~
Sheet No. 2 of 2
Date 7-25-73
County MONT.
State Coordinates

Town of Chevy Chase

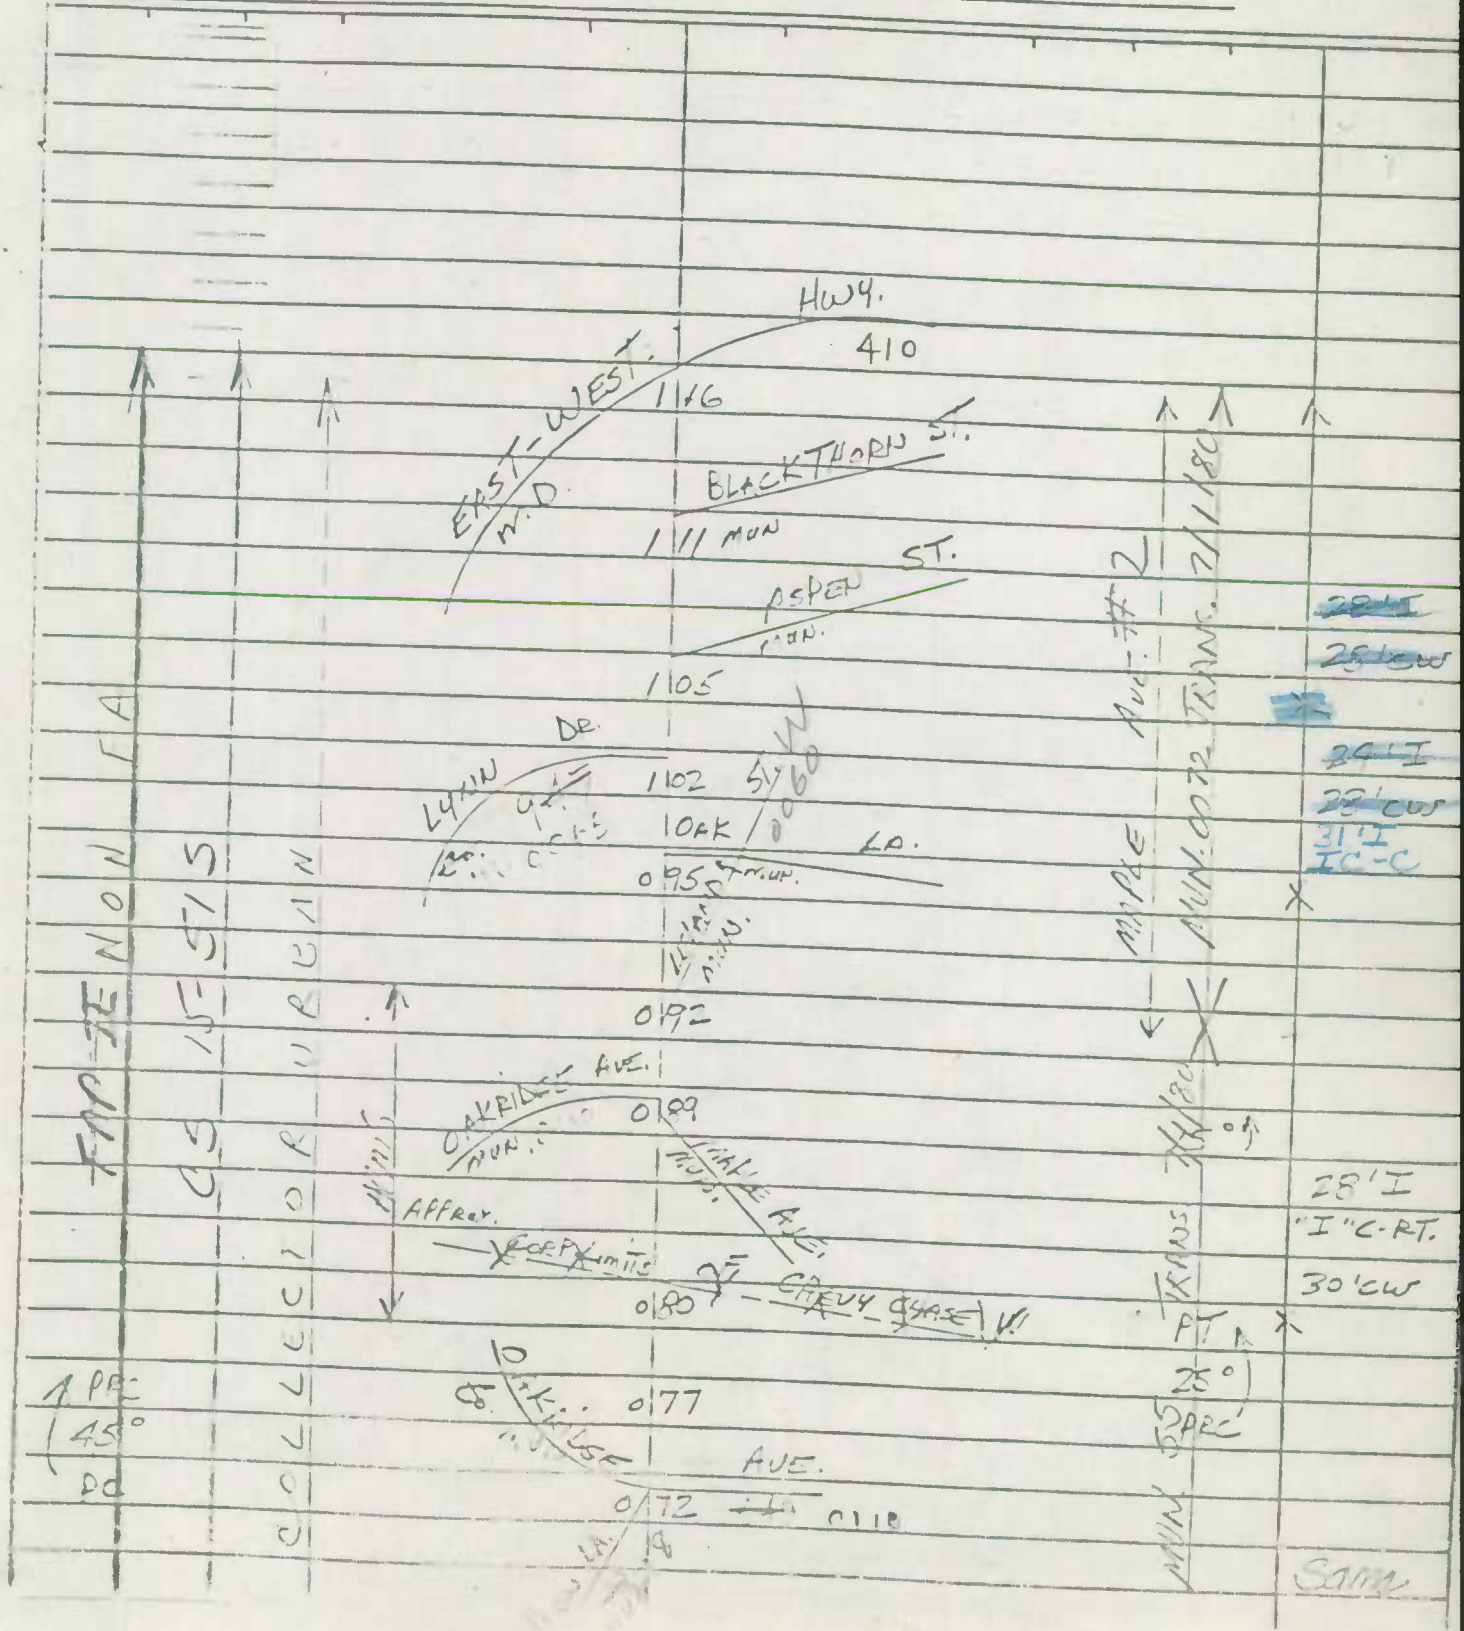

SHA 51.3-8
11-15-72

STATE HIGHWAY ADMINISTRATION OF MARYLAND OAKRIDGE LA

ROAD INVENTORY SHEET ~~Co 440~~

Party Chief I. LANDOL
Recorder M. ZALENSKI
Helper

Map No. 30

Road No. MUN. 0110
Road Name OAKRIDGE AVE
Sheet No. 1 OF 2
Date 4-16-74
County MONT
State Coordinates 776-417

76-21
76-23

CHEVY CHASE IV

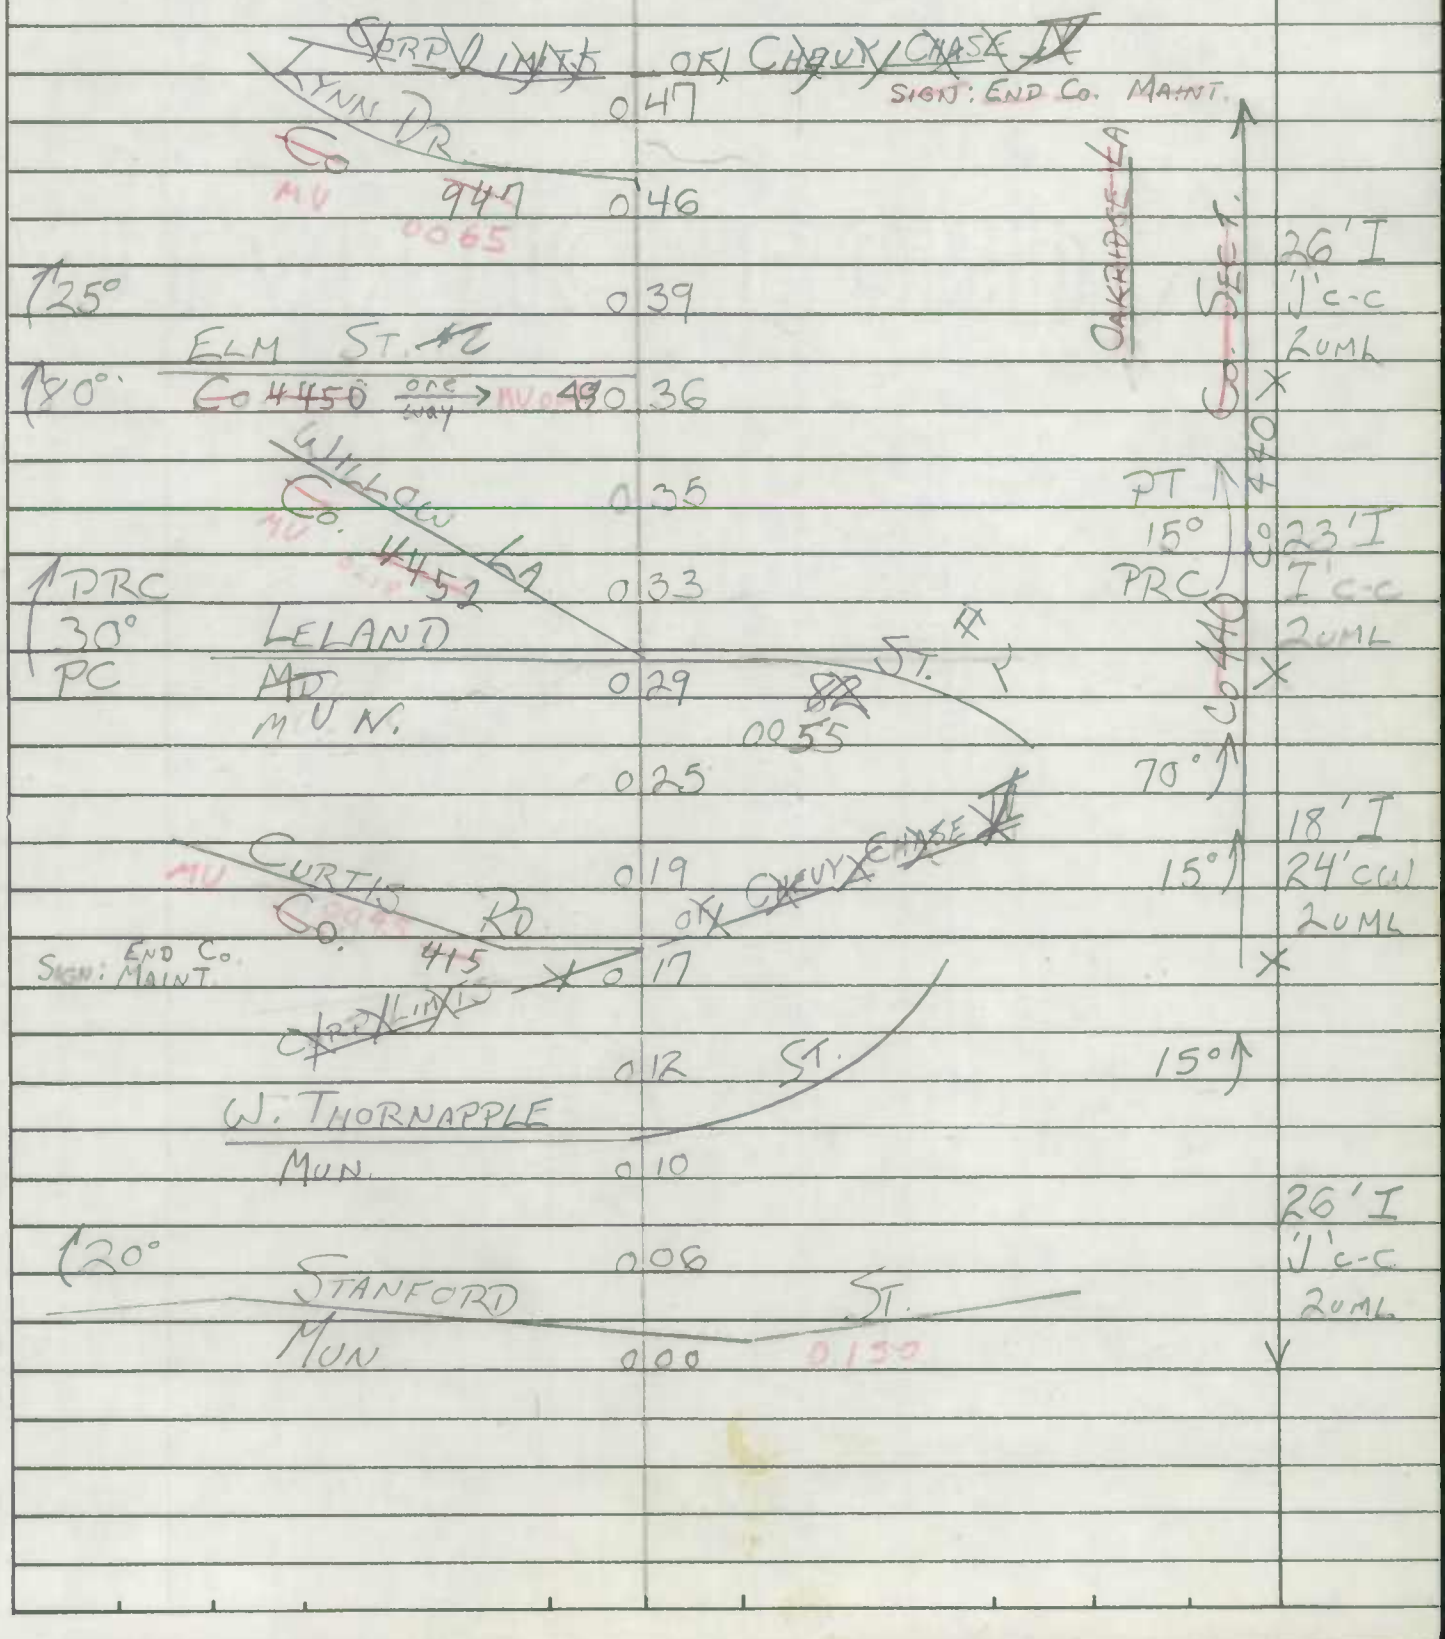

SHA 51.3-8
11-15-72

ROAD INVENTORY SHEET

Road No. MUN 0110
Road Name OAKRIDGE LA
Sheet No. 2 OF 2
Date 4-16-74
County MONT
State Coordinates _____

	MAPLE AVE. MUN 0010	
LELAND MD MUN.	0055	
	0055	
TARRYTOWN RD MUN	051	
130°	049	same

SHA 91.2-11
11-15-72

STATE HIGHWAY ADMINISTRATION OF MARYLAND

Co 418

ROAD INVENTORY SHEET

Party Chief [illegible]
Recorder [illegible]
Helper

Map No. 31C3

Road No. Mun 0150
Road Name STAFFORD ST
Sheet No. 1 of 1
Date 7-16-74
County
State Coordinates 328-416

76 B

CHEVY CHASE IV

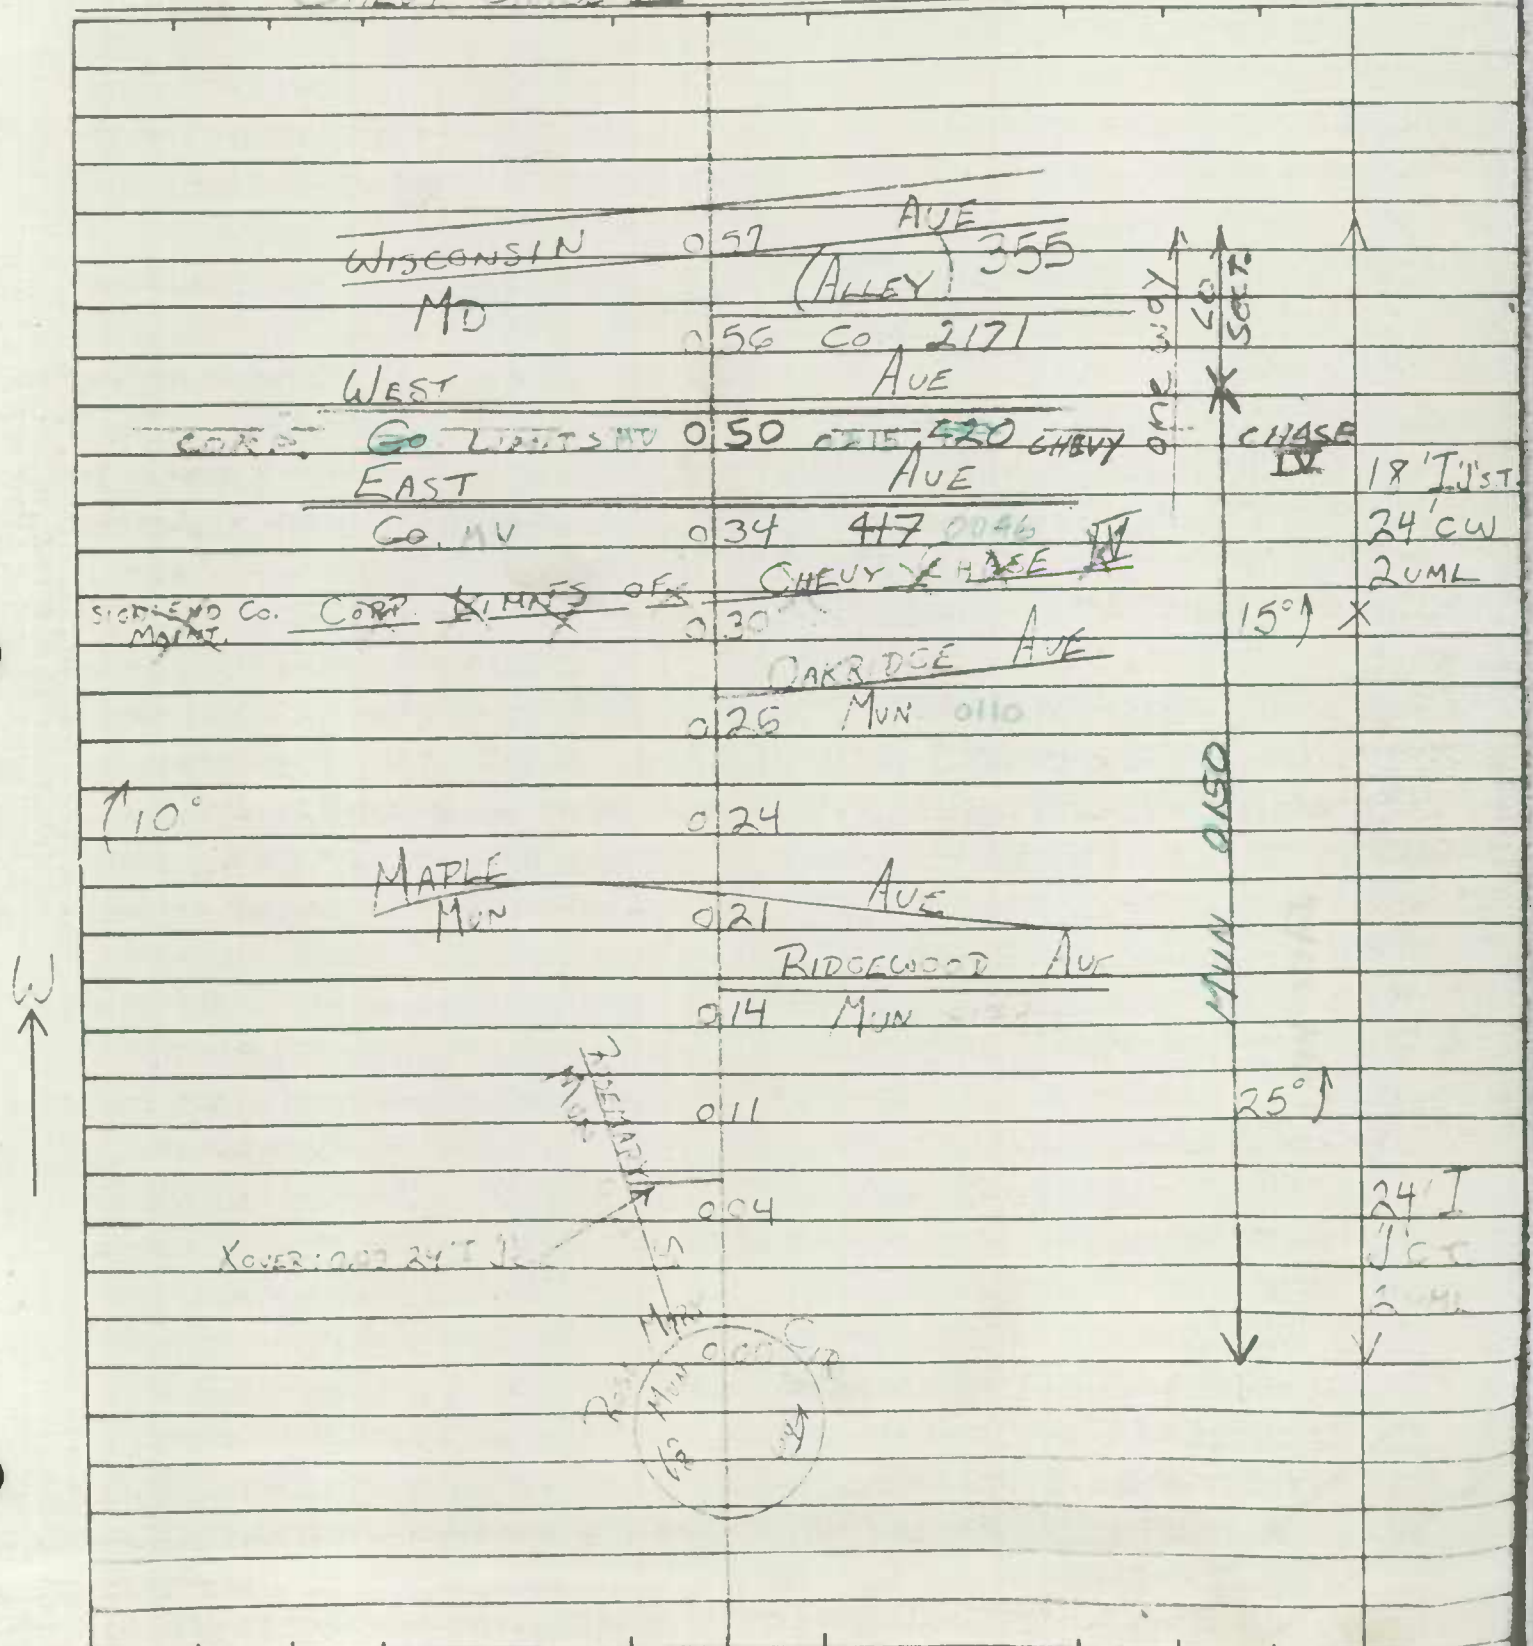

SHA 81.3-8
11-15-72

STATE HIGHWAY ADMINISTRATION OF MARYLAND

ROAD INVENTORY SHEET MY 0212

Party Chief [illegible]
Recorder [illegible]
Helper

Map No. 30
CHEVY CHASE III

Road No. Co. A16
Road Name WALSH ST
Sheet No. 1 OF 1
Date 4-17-74
County MONT
State Coordinates 224-417

16-14

EAST
CO MD

0.24 449 0.46

WEST AVE

0.09 Co. 420 MU 0215

46TH ST
MU0245 Co. ← 45 0.05

CORP LIMITS

(ALLEY)

0.03 Co. 2171

(ALLEY)
Co 2110 0.01

WISCONSIN
MD

0.00 AVE
355

E

SHA 91,3-11
11-15-72

STATE HIGHWAY ADMINISTRATION OF MARYLAND

ROAD INVENTORY SHEET MW 0217

Party Chief T. Landau
Recorder M. Kwiecinski
Helper

Map No. 30

CHEVY CHASE IV

Road No. Co. 410
Road Name Willow La
Sheet No. 1 OF 1
Date 4-17-74
County Mont.
State Coordinates 274-418

76-15

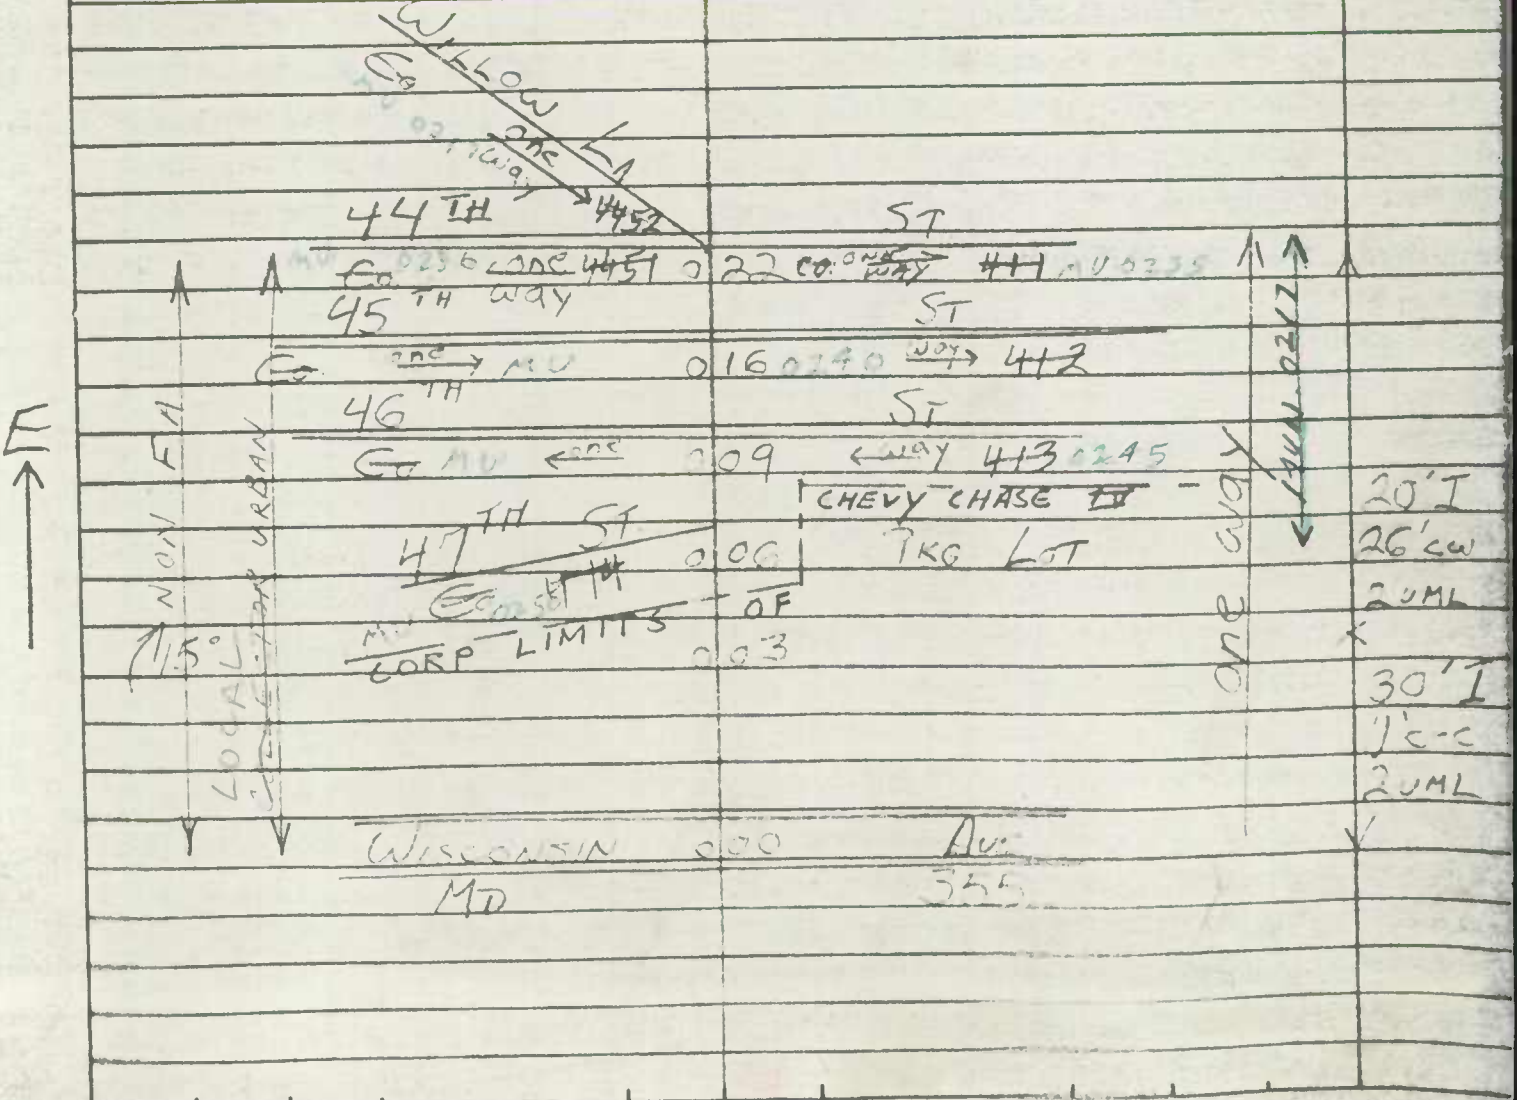

SHA 51.3-8
11-15-72

STATE HIGHWAY ADMINISTRATION OF MARYLAND

ROAD INVENTORY SHEET MUN. 0218

Party Chief T. LANDON
Recorder M. ZALENSKI
Helper

Map No. 30 Town of Chevy Chase
A/T 10/5/82

Road No. ~~C~~ ~~4452~~
Road Name WILLOW LA. # 2
Sheet No. 1 OF 1
Date 4-17-74
County MONT.
State Coordinates 225-418

91-42 A/T

SEE NEW INV. OF MU 218
BB AH
4B-MUEXT 1
3-9-99

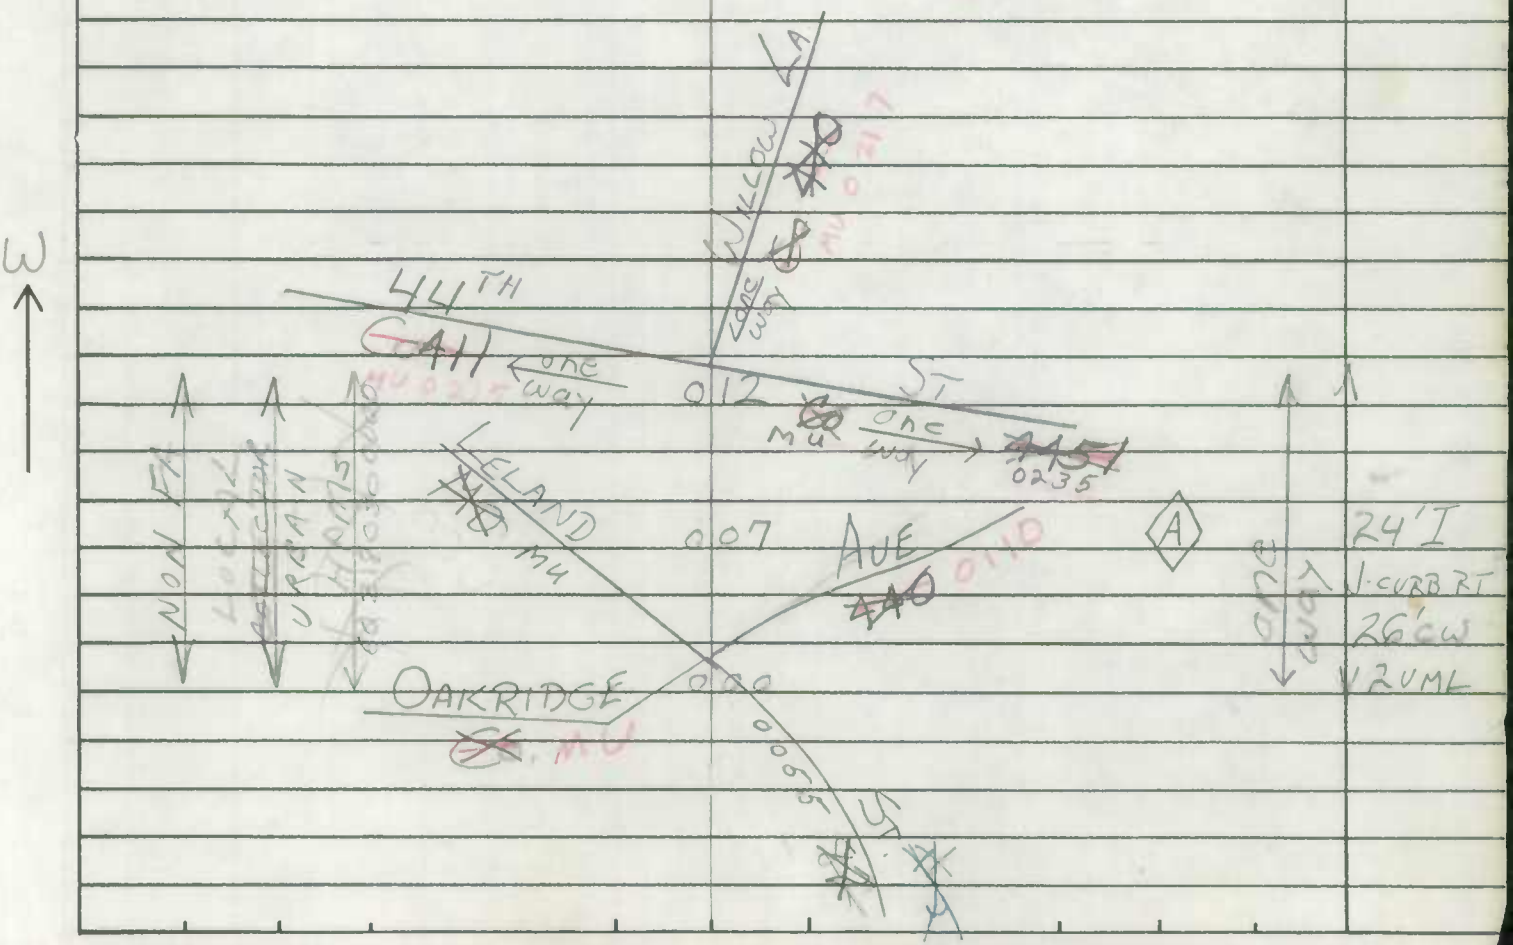

SHA 51.3-8
11-15-72

ROAD INVENTORY SHEET

Road No. _____
Road Name _____
Sheet No. _____
Date _____
County _____
State Coordinates _____

SHA 51.3-8
11-15-72

STATE HIGHWAY ADMINISTRATION OF MARYLAND

Town of Chevy Chase

ROAD INVENTORY SHEET

MUN 0235

86-112

Party Chief T. LANDON
Recorder M. ZALENSKI
Helper

Map No. 30

Road No. ~~G~~ 411
Road Name 44TH ST.
Sheet No. 1 OF 1
Date 4-17-74
County MONT.
State Coordinates 774-419

JE
CA

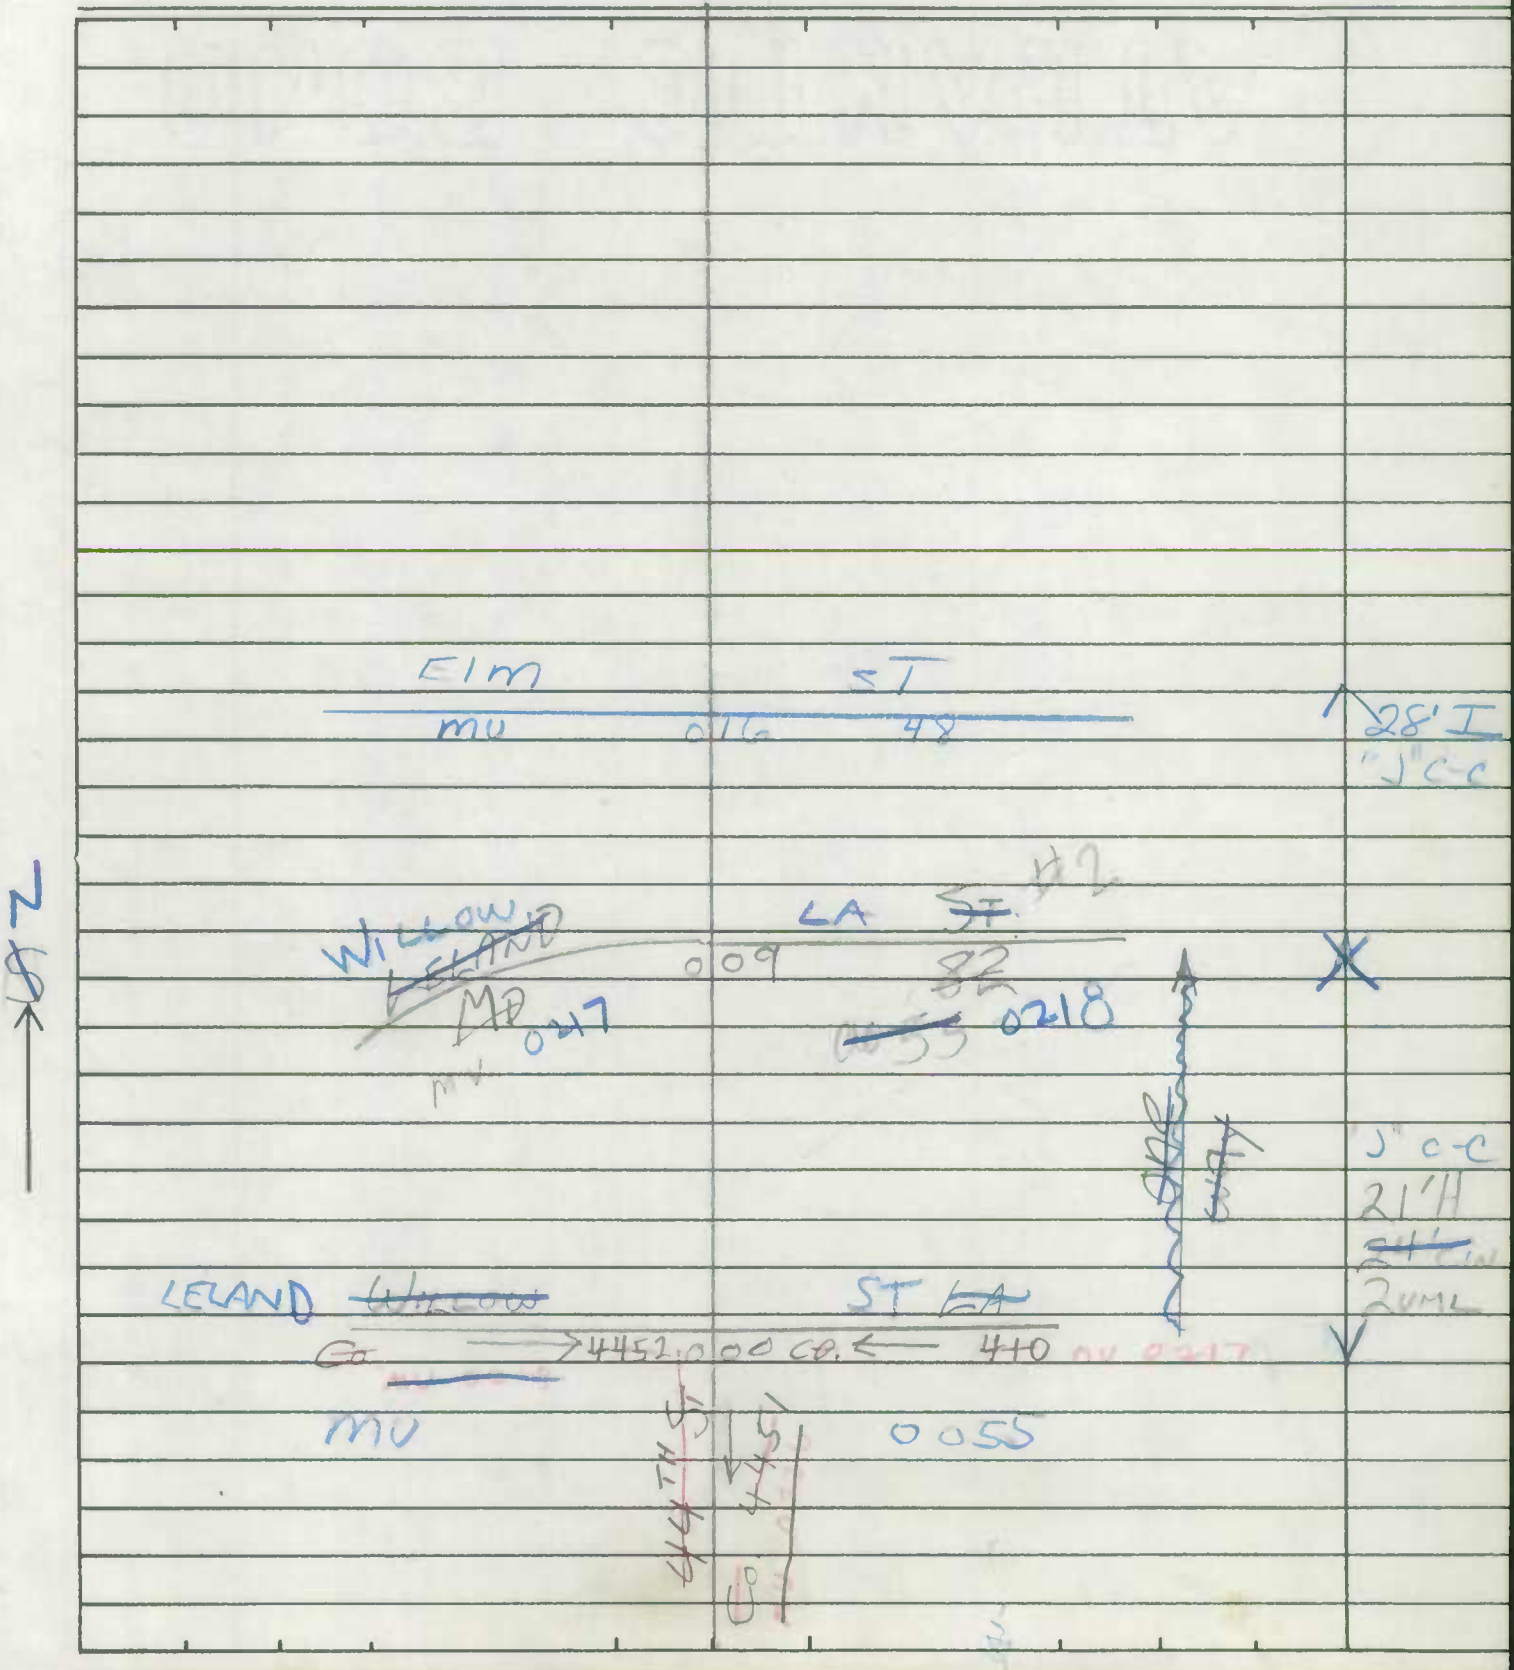

SHA 51.3-8
11-15-72

ROAD INVENTORY SHEET

Road No. _____
Road Name _____
Sheet No. _____
Date _____
County _____
State Coordinates _____

SHA 51.3-8
11-15-72

STATE HIGHWAY ADMINISTRATION OF MARYLAND

ROAD INVENTORY SHEET MUN. 0236

Party Chief T. LANDON
Recorder M. ZALENSKI
Helper

Map No. 30

Road No. ~~Co.~~ 4451
Road Name 44TH ST.
Sheet No. 1 OF 1
Date 4-17-74
County MONT.
State Coordinates 774-419

CHEVY CHASE III

NOW COMBINED WITH MUN 235

N

ELM ST
~~Co~~ 4409 ← 0007 → ~~Co~~ 4450

WILLOW LA. / WILLOW LA #2
~~Co~~ 4410 → 0000 ← ~~Co~~ 4452

44TH ST

25' VI
J-CURB RT
28' C-W
2 UNL

SHA 51.3-8
11-15-72

ROAD INVENTORY SHEET

Road No. _____
Road Name _____
Sheet No. _____
Date _____
County _____
State Coordinates _____

SHA 51.3-8
11-15-72

ROAD INVENTORY SHEET

Party Chief J. LANDON
Recorder J. ABBOTT
Helper M. ZALENSKI

Map No. 26

Road No. MUN. 0020
Road Name BROWN ST
Sheet No. 1 OF 1
Date 10-31-73
County MONT.
State Coordinates

WASHINGTON GROVE

 

SHA 51.3-8
11-15-72

ROAD INVENTORY SHEET

Road No. MU00 20
Road Name BROWN ST
Sheet No. _____
Date _____
County _____
State Coordinates _____

SHA 51.3-8
11-15-72

ROAD INVENTORY SHEET

Party Chief J. LANDON
Recorder J. ABBOTT
Helper M. ZALENSKI

Map No. 26

Road No. MUN. 0020
Road Name BROWN ST
Sheet No. 1 OF 1
Date 10-31-23
County MONT.
State Coordinates

WASHINGTON GROVE

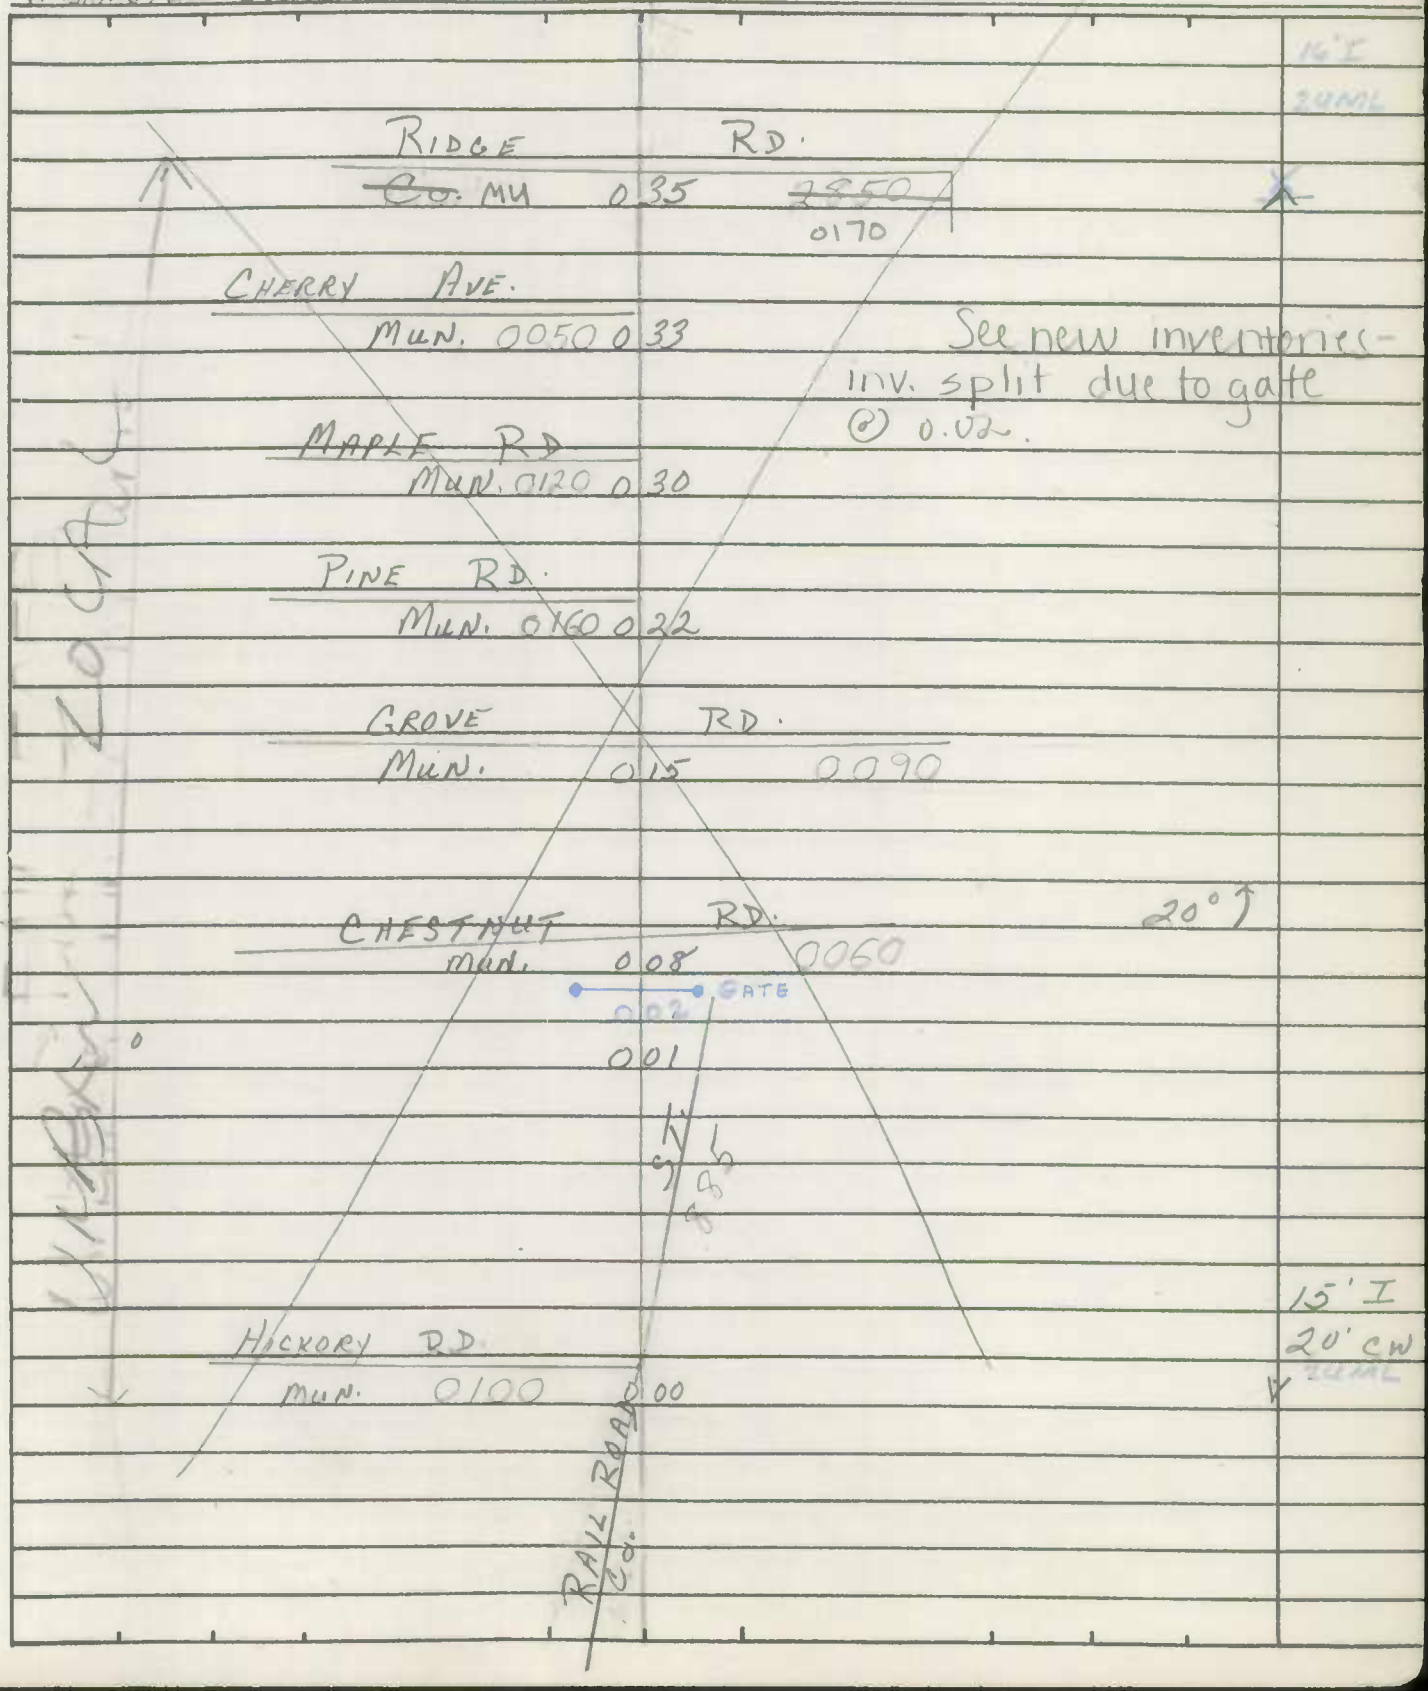

SHA 51.3-8
11-15-72

ROAD INVENTORY SHEET

Road No. MU00 20
Road Name BROWN ST
Sheet No. _____
Date _____
County _____
State Coordinates _____

SHA 51.3-8
11-15-72

ROAD INVENTORY SHEET

Party Chief T. LANDON
Recorder T. ABBOTT
Helper M. ZALENSKI

Map No. 26 TR REV. JE 5-4-80
WASHINGTON GROVE 79-2

Road No. MUN. 0040
Road Name CENTER ST.
Sheet No. 1 OF 1
Date 10-31-23
County MONT.
State Coordinates

ROAD END

~~025~~ 023 MUN. MAIT. GARAGE ^

GROVE RD.
MUN. ~~019~~ 017 0090 X 12' E 16' CW

CHESTNUT RD.
MUN. ~~012~~ 010 0060

15' I 20' CW

HICKORY RD
MUNI. ~~004~~ 002 0100 X

ROAD 0 00 END
SIGN-ROAD CLOSED
MD. ~~000~~ 124 ✓ 24' I 26' CW

E

SHA 51.3-8
11-15-72

ROAD INVENTORY SHEET

Road No. _____
Road Name _____
Sheet No. _____
Date _____
County _____
State Coordinates _____