Form 6 HPS (Rev. 1961)

92 PAVING 6/1/92
AL/JS
2/25/93

96-5 MU
BO/MG
1-28-97

ROAD INVENTORY SHEET

Party Chief R. VOUGHT
Recorder L. COFFELT JR.
Chainman

TV
RC
VER. 10/28/96

LEONARDTOWN

Road No. 0010
Name ~~BLAIR S~~ ~~A~~ AVE
Sheet No. 1 OF 1
Date 1-30-64
County ST MARYS

COGPS 2002
8-1-02
SS/WP
Gone - House now located where road was.

Leonard town

N

Road Enl
0025

0001

Barthelme
~~STATE ROAD~~
MUN

STADDICK ST
200

10E
12'CW

Form 6 HPS (Rev. 1961)

92 MW, 91 AZ
AL/JS
2/25/93

96-5 MU
BD/MG
1-28-97

ROAD INVENTORY SHEET

Party Chief R. VOUGHT
Recorder L. COFFELT JR.
Chainman

LEONARDTOWN

TV
RC
VER. 10/28/96

Road No. 0010
Name BLAIR S~~t~~ AVE.
Sheet No. 1 OF 1
Date 1-30-64
County ST MARYS

CO GPS 2002
8-1-02
SS/WP
Gone - House now located where road was.

N

Road ~~Ent~~
005

001

10E
12'CW

Bartholne
~~Shirley Rd~~
MUN

SHIPPERS ST
MUN 200

Form 6 HPS (Rev. 1961)

ROAD INVENTORY SHEET

Party Chief R. VOUGHT
Recorder L. COFFELT JR.
Chainman

LEONARDTOWN

BRETON BAY DR.

Road No. 0030
Name ~~G. LIBRARY Ends~~
Sheet No. 1 OF 1
Date 1 - 30 - 64
County ST MARYS

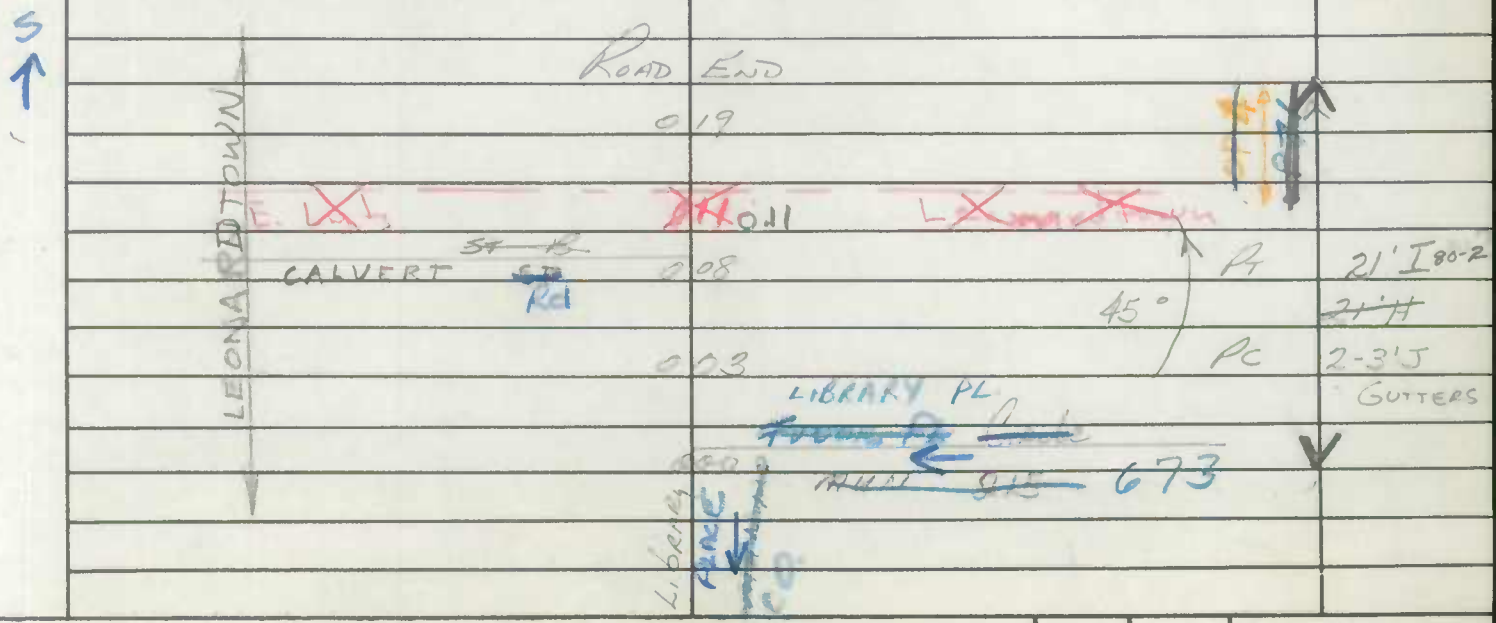

Form 6 HPS (Rev. 1961)

ROAD INVENTORY SHEET

Party Chief
Recorder
Chainman

Within Leonard Town

T4 KC VER. 10/18/72 CHARLES ST

903-171

Road No. ~~SP~~ MUN 0045 OF 158
Name ~~JAM~~ ~~STREET~~
Sheet No. 1 OF 1
Date 1-30-64
County

91-5

Road End

0.17

0.13 (DOWNS CIR.) 60

0.09 MAIN

0.05

4 H

~~MAIN~~ ~~STREET~~ MARK

0.00

~~ST~~ AVE

0.05

28' I
I CL

20' I
26' CW

~~MAIN~~

Form 6 HPS (Rev. 1961)

ROAD INVENTORY SHEET

Party Chief R. VOUGHT
Recorder
Chainman L. COFFELT JR.

TK KC VER. 10/18/78

LEONARDTOWN

Road No. 0050
Name CHURCH ST
Sheet No. 1 OF 1
Date 1-30-64
County ST MARYS

A3-1

ALLEY
MUN 8520 0 16

DUKE ST
MUN 0 14 0065

RILEY
MUN 0 12 5010 1

LAWRENCE AVE
MUN 0 10 110

POPE ST
MUN 100 0 04 WATER TOWER

WASHINGTON ST
MUN 0 00 5

10'E
16'CW

20'H
24'CW

30'H
C-C

SHA 51.3-8
11-15-72

STATE HIGHWAY ADMINISTRATION OF MARYLAND

TL KC VER 10/18/76

ROAD INVENTORY SHEET

KEYWAY

Party Chief office Inventory
Recorder
Helper

Map No.

Road No. 0080
Road Name ~~E. Keyway~~
Sheet No. 1 of 1
Date
County St. Mary's
State Coordinates

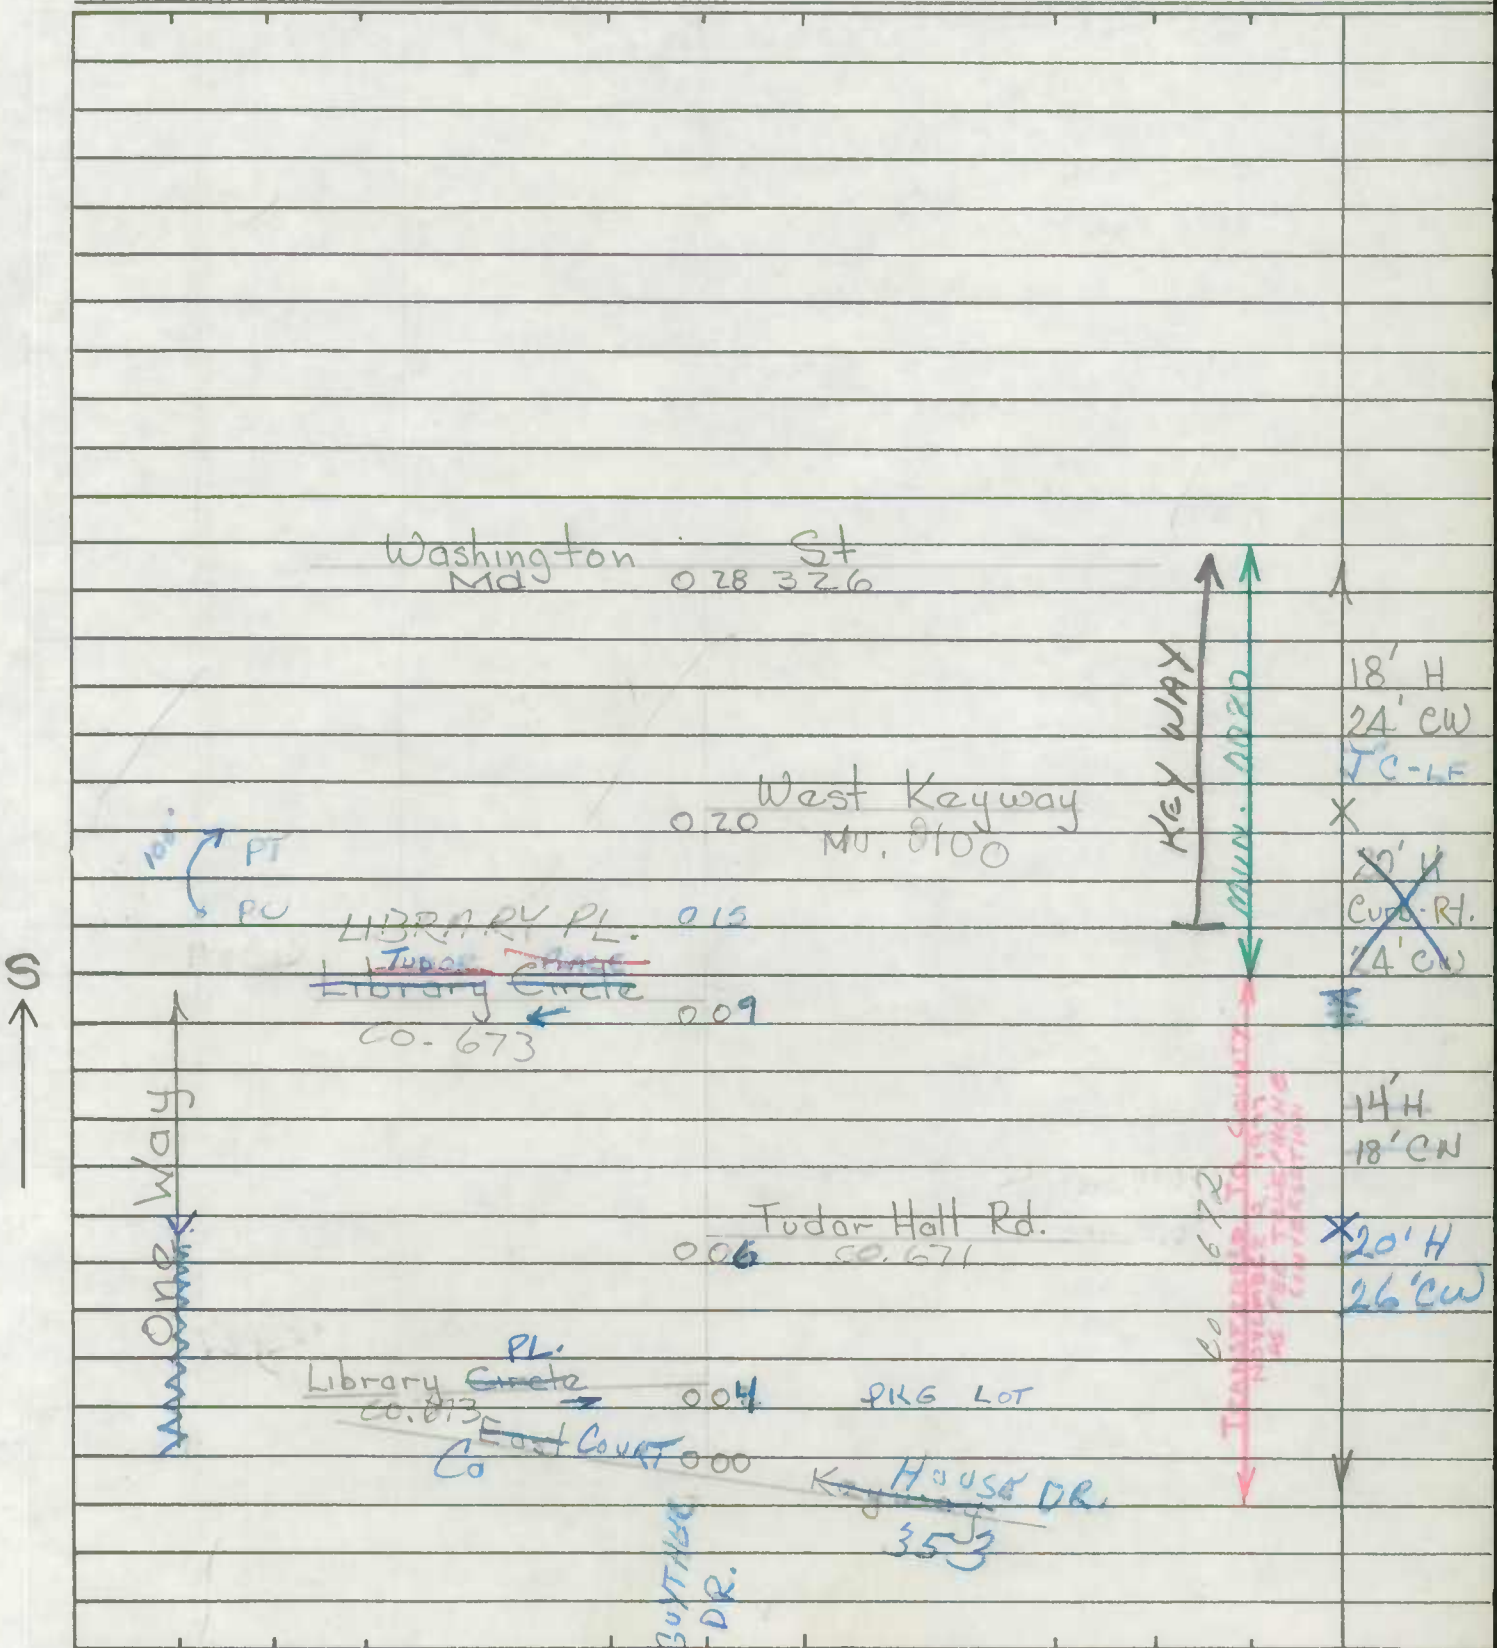

SHA 51.3-8
11-15-72

ROAD INVENTORY SHEET

Road No. _____
Road Name _____
Sheet No. _____
Date _____
County _____
State Coordinates _____

SHA 51.3-8
11-15-72

STATE HIGHWAY ADMINISTRATION OF MARYLAND

ROAD INVENTORY SHEET Co 672

Party Chief office Inventory
Recorder
Helper

Map No. _____ TC KC VER 10-18-76

Permit 8-26-81 JTG

Road No. 0080
Road Name (E ~~Keyway~~ Key Way)
Sheet No. 1 of 1
Date
County St Mary's
State Coordinates

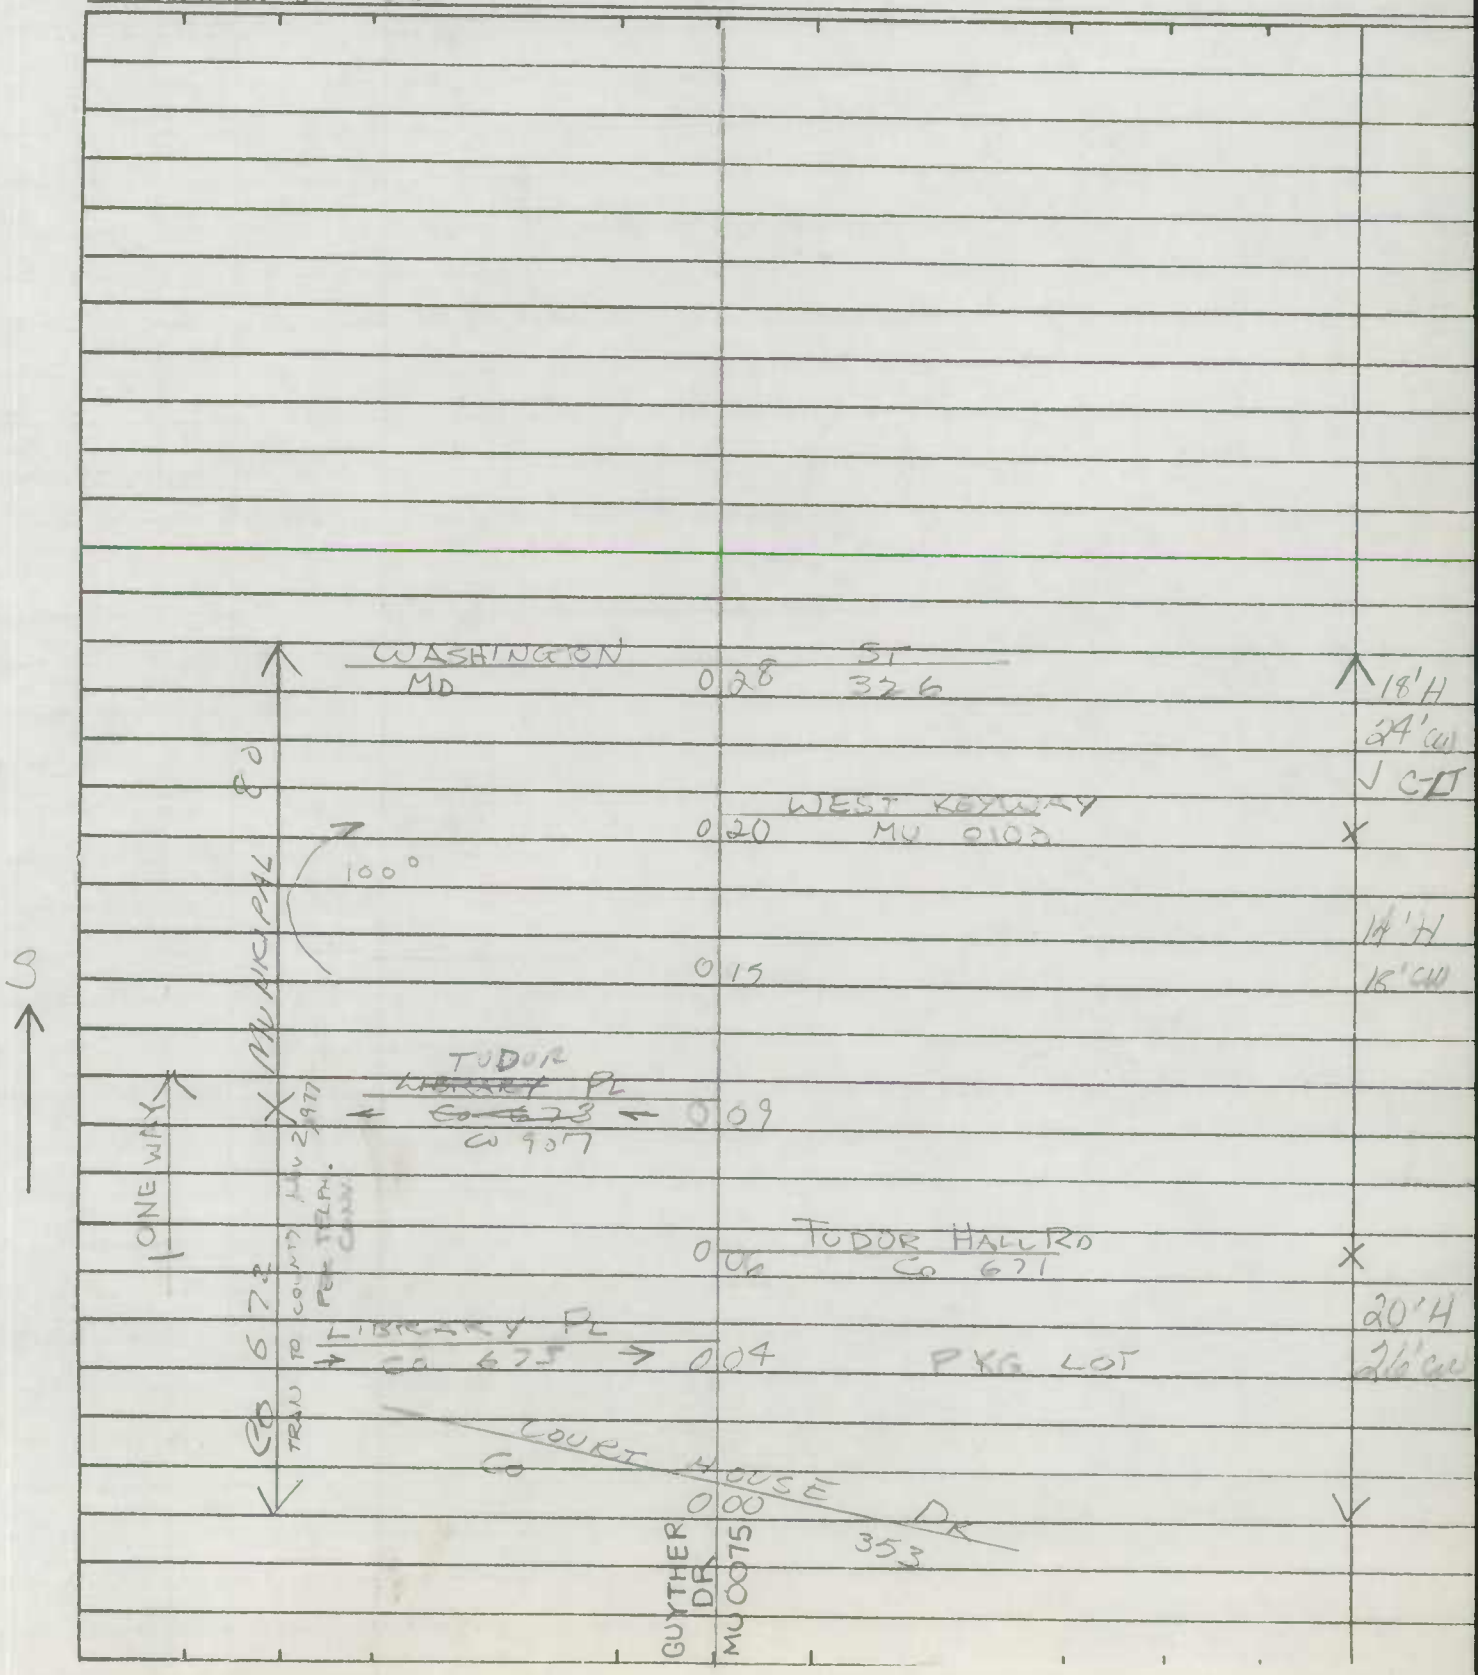

SHA 51.3-8
11-15-72

ROAD INVENTORY SHEET

Road No. _____
Road Name _____
Sheet No. _____
Date _____
County _____
State Coordinates _____

Form 6 HPS (Rev. 1961)

TV KC VER. 10/18/72

ROAD INVENTORY SHEET

Party Chief F. VAUGHT
Recorder L. COFFELT JR.
Chainman

LEONARDTOWN

Road No. 0110
Name LAWRENCE AVE
Sheet No. 1 of 1
Date 1-31-64 Rev. 4-6-72
County ST MARYS

67-1 DUE TO NEW INV. MD 326 DA13

CO 671

MD 326
NASH. 0.65 ST.

16'H

30° 24'CW

0.52

PARK AVE 0.60 0.50

30'I C-C 2ML

FENWICK ST 0.44

0.37 LEONARDTOWN VED SHADRICK ST

27'I C-C 2ML

0.35

30'I C-C 2ML

SHADRICK ST 0.33

CHURCH 0.22 ST 0.050

34'I C-C 2ML

0.17

0.14 RESCUE SQUAD ST

30'I C-C 2ML

0.12

0.00 ST

SHA 51.3-8
11-15-72

STATE HIGHWAY ADMINISTRATION OF MARYLAND

ROAD INVENTORY SHEET

Party Chief T LANDON
Recorder K CORBETT
Helper

Map No. LEONARDTOWN

Road No. MUR 0120
Road Name LIBRARY PL.
Sheet No. 1 OF 1
Date 10/18/76
County ST MARYS
State Coordinates

TRANSFERRED TO COUNTY NOV. 2, 1977

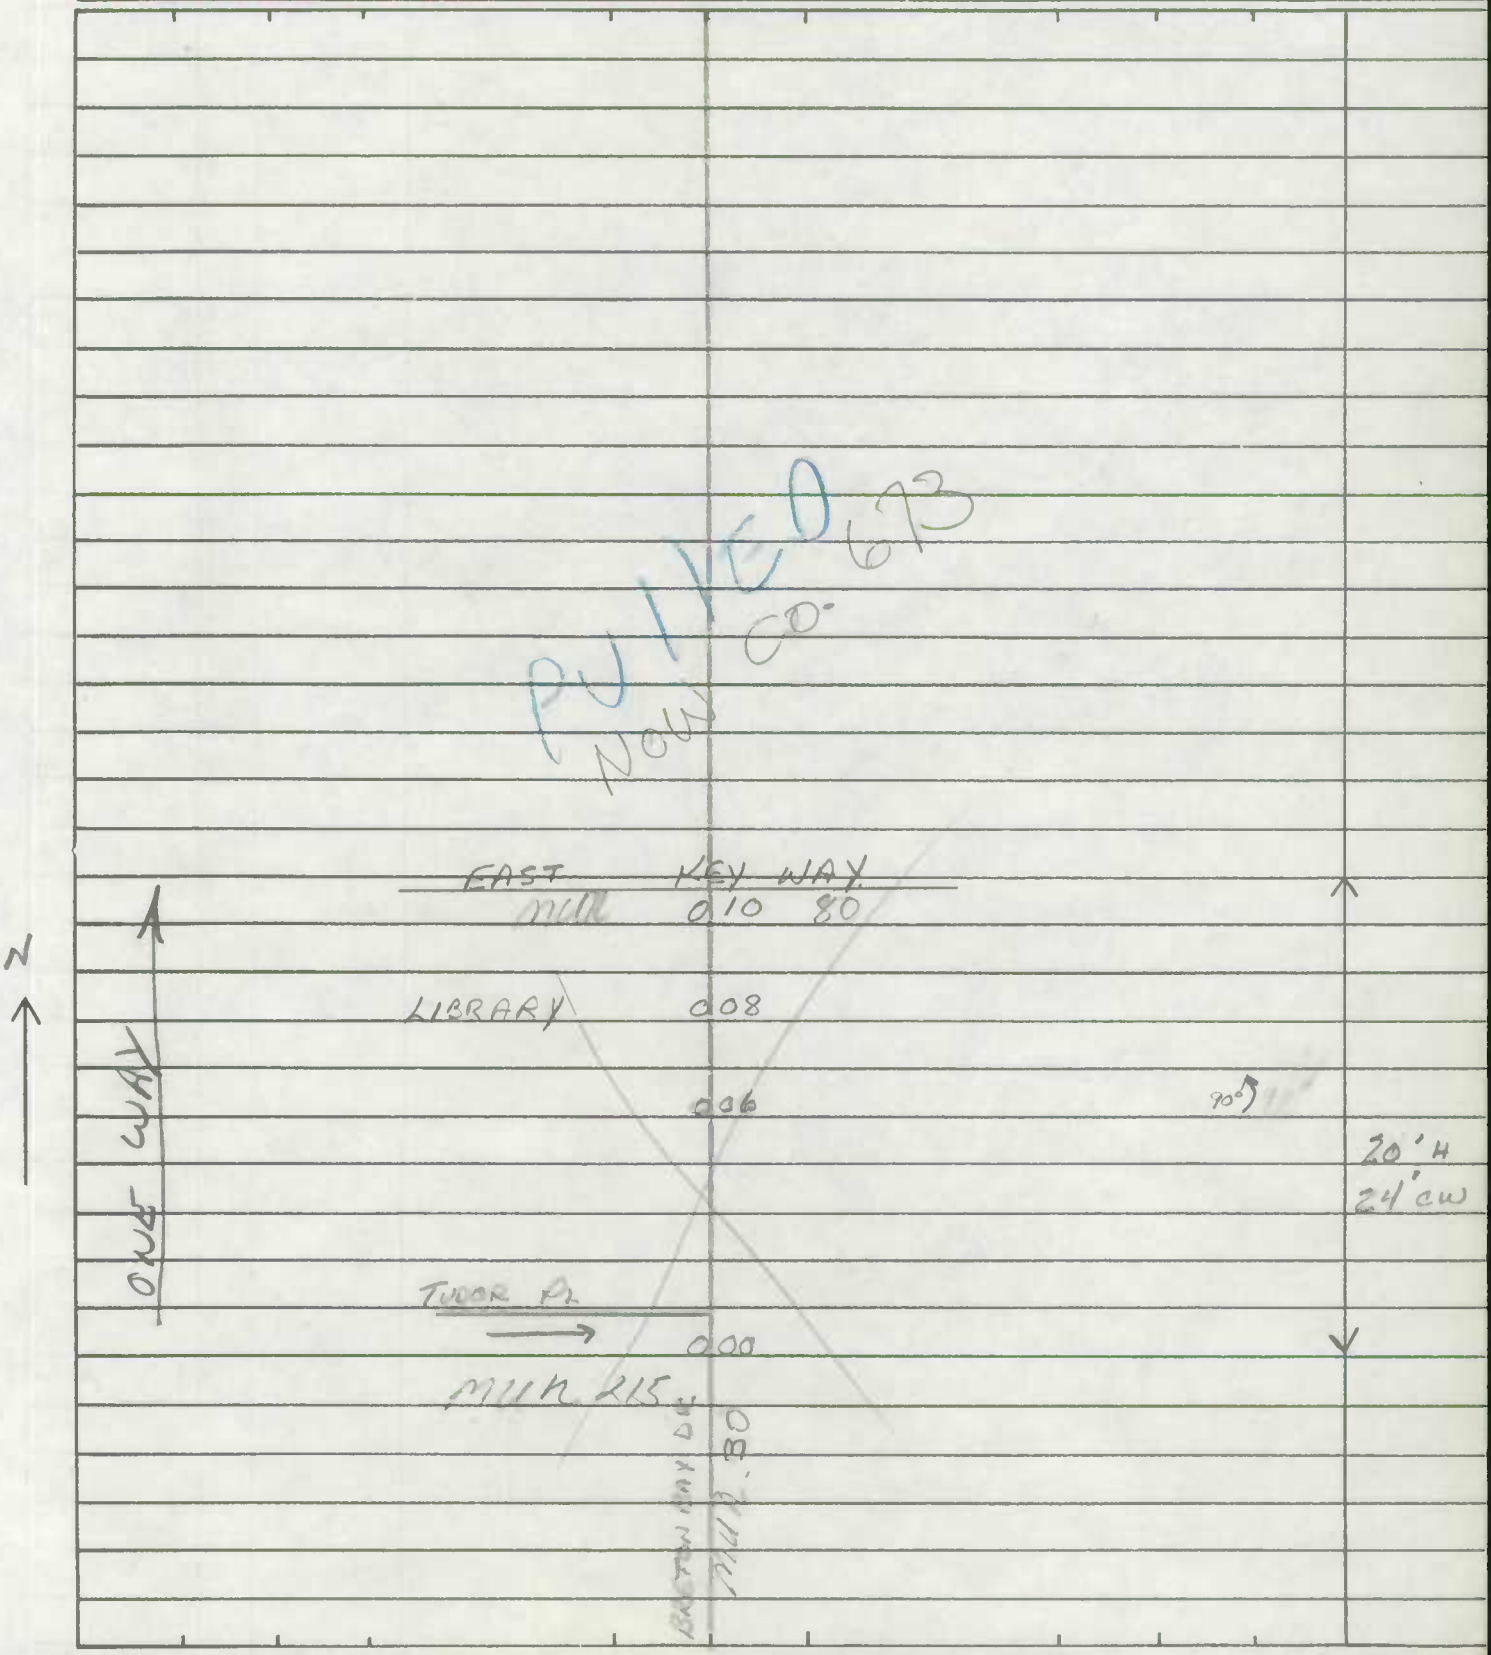

SHA 51.3-8
11-15-72

ROAD INVENTORY SHEET

Road No. _____
Road Name _____
Sheet No. _____
Date _____
County _____
State Coordinates _____

SHA 51.3 - 8 Revised
4.83

MARYLAND STATE HIGHWAY ADMINISTRATION

ROAD INVENTORY SHEET

* per telephone conversation with Travis Clark - Scheduled Developer doing road improvements & Extension, to be completed in 1993. T. Massicot 4/26/93

98-5 MU
GD-CG 3-8-99

00-MU Ex #1 SS/AQ 3/12/01

2000 MU EX #3 SS/AQ 3-15-01

92 MU, Ex #7 AQ/JS 2/25/93

96-3 MU DELETED 1-28-97

Leonardtown 88-1

93-MU Ex #1

90-6 AL/SM/AR AL-JK 3-5-91 A/T

97-1,2,3,4,5,6 2-24-98 - RR/DO,

Party Chief BB
Recorder AL
Assistant
Map No./Dir. / N
State Coordinates

Road No. Mun 0156
Road Name Moakley St
County St. Mary's
Date 4-4-89
Sheet No. 1 OF ~~3~~ 2

TRAFFIC CODES
TRAFFIC CONTROLS: STOP SIGN=SS, TRAFFIC LIGHT=T.L., FLASHING RED BALL=F.R.

TRAFFIC CODES
PARKING RESTRICTIONS: A.M. PEAK, P.M. PEAK, A.M./P.M. PEAK, NO PARKING ANYTIME=N.P., COMM/IND. ACCESS=E

SYSTEM				TRAFFIC		TRAFFIC			PAVEMENT DATA
FED. AID.	FUNCT CLASS.	HWY. SYS.	HPMS SAMPLE	PRKG. REST.	COM/IND. ACCESS	CONTROL	COM/IND. ACCESS	PRKG. REST.	
					E		E		20'I
									5'I CHN RT
									8'I CHN RT
									2 ML
									~~20'I~~
									~~30' CW~~
									2430'I
									40' CW
									5'I SHD RT
									2 ML
						SS			

LINE DIAGRAM

See new Inv written 03-12-01

SS/AQ Impt's 00-1MU EX #1, 00-1mu, 00-2mu & 00-3mu

Miss June Ct
MU 0159 0 35

~~Road~~ 0 41 ~~Ford~~
~~T.F.~~ 0 2

MARIE
~~OP~~ ~~506~~ 0 20
Mu 0077

0 29

BEA CT
~~DR~~ ~~0556~~ Mu0008 0 26

0 24

~~DOTTIE~~ ~~SO~~ NS RD
0 19 ~~X~~ MU 0053 (90-6)

0 05 30°

8'I RT 0 02

(POINT LOOKOUT ~~X~~)
MD 0 00 5

St. Mary's County

ABELL MD

See new Inv written 03-12-01 SS/AQ

SYSTEM: FED. AID. | FUNCT. CLASS. | HWY. SYS. | HPMS SAMPLE

TRAFFIC: PRKG. REST. | COM/IND ACCESS

LINE DIAGRAM

TRAFFIC: CONTROL | COM/IND ACCESS | PRKG. REST.

PAVEMENT DATA

Imp #15

00-1 MU

00-2 MU, 00-3 MU, 00-1 MU EX #1

OXEN CT

MU (00-2 MU) 0

YOKE CT

72 MU (00-1 MU)

24'I

2 UML

~~Rt~~ ~~Ent~~

0 6X8

TRACE CT

MU 0215

0 66

HAME CT

MU 0076

Reins Ct

MU 0185

SUSIE CT

0 61 MU (00-3 MU)

0 50 36" C-P

SINGLETREE RD

0 48

20'I

5' I and RI

~~X'I~~

2 X ML

MISS BESSIE LANE

0 41

Garrett Ct

MU 0072

0 39

24' I

5' I and RI

2 ML

Form 6 HPS (Rev. 1961)

ROAD INVENTORY SHEET

TL KC VER. 10/19/76

Party Chief R. VOUGHT
Recorder I. COFFELT JR.
Chainman

LEONARDTOWN

Road No. 0180
Name POPE ST
Sheet No. 1 OF 1
Date 1-30-64
County ST MARYS

83-2

S

MUN
FENWICK 0.27 0070 ST

0.19

SHADRICK 0.11 0200 ST

CHURCH MUN 0.00 0050 ST

14'I
18'CW
J'C-RT

Form 6 HPS (Rev. 1961)

TV KC JER 10/18/76

ROAD INVENTORY SHEET

Party Chief R VAUGHT
Recorder L. COFFELT JR
Chairman

LEONARDTOWN

Road No. 0210
Name TUDOR HALL RD
Sheet No. 1 OF 1
Date 1-30-64 REV. 4-6-72
County ST. MARYS

TRANSFERRED TO COUNTY NOV. 2, 1977 DUE TO NEW INV. OF MD 326 DATE

DELETED

EAST

011 KEYWAY →

006 WEST KEYWAY

28'H
32'CW

MD 326
MIA-H. 000 ST.

LANDMARK ICE AGE MUN 0110

SHA 51.3-8
11-15-72

STATE HIGHWAY ADMINISTRATION OF MARYLAND

ROAD INVENTORY SHEET

Party Chief: T LANDON
Recorder: K CORBETT
Helper:

Map No.: LEONARDTOWN

Road No.: MUN 0215
Road Name: TUDOR PLACE
Sheet No.: 1 OF 1
Date: 10/18/76
County: ST. MARYS
State Coordinates:

NOW
CO. 673
TO COUNTY
TELEPHONE
TRANSFERRED PER
AS
CONVERSATION

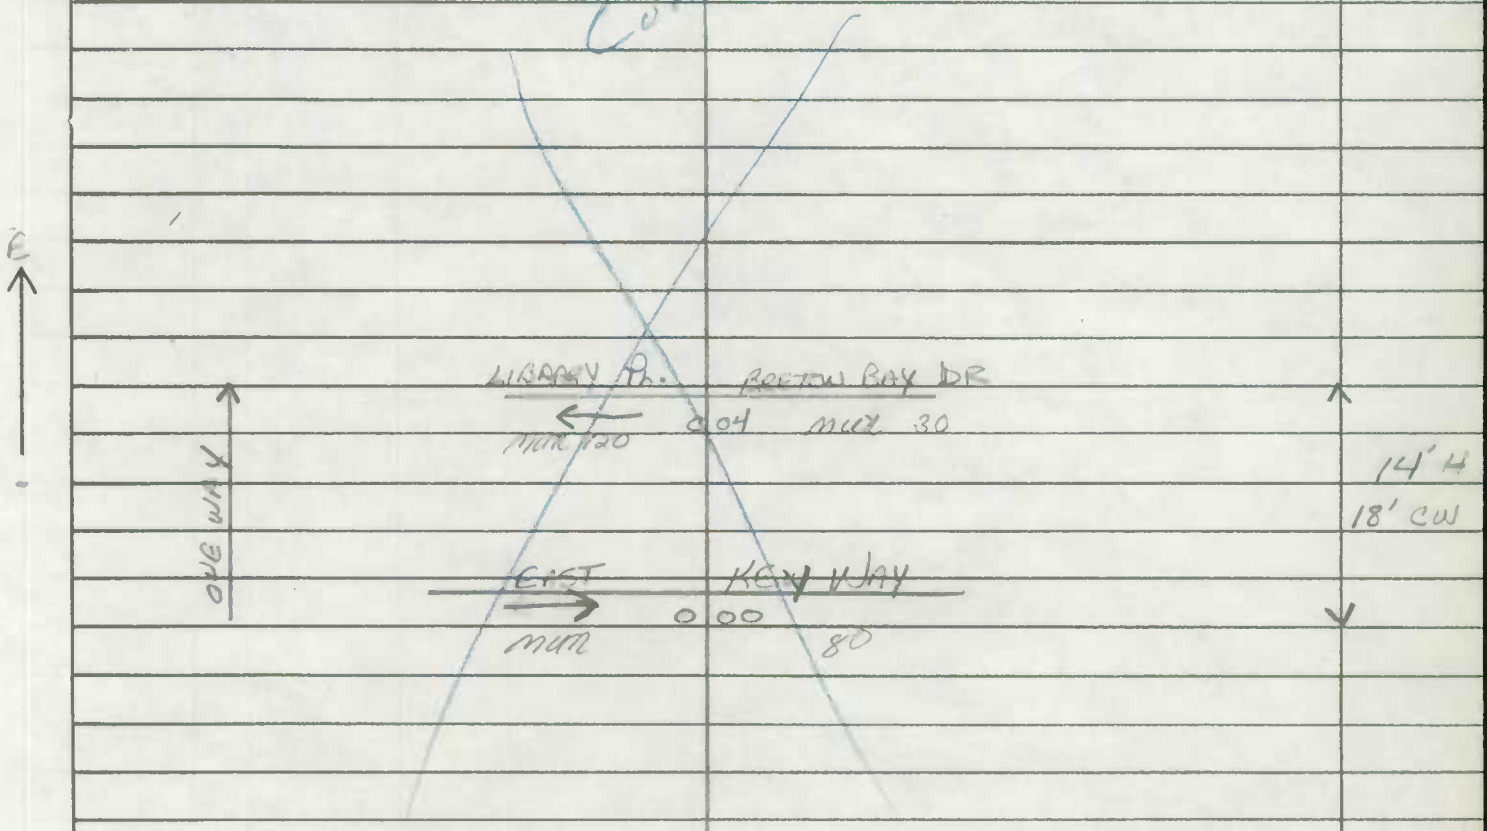

SHA 51.3-8
11-15-72

ROAD INVENTORY SHEET

Road No. _____
Road Name _____
Sheet No. _____
Date _____
County _____
State Coordinates _____

Form 6 HPS (Rev. 1961)

96-5 MV
BB/MG
1-28-97

ROAD INVENTORY SHEET

Party Chief ~~R. VOUGHT~~
Recorder
Chainman ~~L. COFFELT~~ JR.

LEONARDTOWN

TV
KC
JCR. 10/18/76

Road No. 8030
Name ALLEY 3
Sheet No. 1 OF 1
Date 1-30-64
County ST MARYS

CO GPS 2002
8-1-02
SS/WP
Road now inaccessible + overgrown

N

Road END
0.07

~~RIGHT ALE~~

10'E
14'CW

Barthelme
~~STRAIGHT~~
MUN 220 0200 ST

Form 6 HPS (Rev. 1961) Revised 2-18-71 GJG
(Previous OP 11 Now Co. 422 66-17)

ROAD INVENTORY SHEET

URBAN

Party Chief R. ~~VOUGHT~~
Recorder
Chainman L. ~~OFFELT~~ JR.

K-10
905-173

Within LEONARD TOWN

TL KC VER. 10/18/76

Road No. OP 11
Name (N. LAWRENCE AVE.)
Sheet No. 1 OF 1
Date 1-30-64
County ST MARYS

S ↑

ROAD END 900' H

0 22

0 21 H

MATTINGLY ST

0 18

0 06

3H

0 01 10'E 16'W

GREENBRIAR CO. 0 00 170