SHA 51.3 - 8 Revised
4.83

MARYLAND STATE HIGHWAY ADMINISTRATION

ROAD INVENTORY SHEET MUN0016

Party Chief BB
Recorder DW
Assistant
Map No./Dir. GH 20 / 1135-63
State Coordinates Crisfield

Road No. CO 377
Road Name ANchor Dr
County Somerset
Date 1-24-89
Sheet No. 1 OF 1

87-6

TRAFFIC CODES
TRAFFIC CONTROLS: STOP SIGN=SS, TRAFFIC LIGHT=T.L., FLASHING RED BALL=F.R.

TRAFFIC CODES
PARKING RESTRICTIONS: A.M. PEAK, P.M. PEAK, A.M./P.M. PEAK, NO PARKING ANYTIME=N.P., COMM/IND. ACCESS=E

SYSTEM				TRAFFIC		LINE DIAGRAM	TRAFFIC			PAVEMENT DATA
FED. AID.	FUNCT CLASS.	HWY. SYS.	HPMS SAMPLE	PRKG. REST.	COM/IND. ACCESS		CONTROL	COM/IND. ACCESS	PRKG. REST.	
NON FA	RURAL LOCAL					(ANchor Dr)				
						MUN 007 0015				
						CORP LIMITS 004 CRISFIELD				
K	K CO. RURAL					MD 358				20'F
						000				

Crisfield

SHA 51.3 - 8 Revised
4.83

MARYLAND STATE HIGHWAY ADMINISTRATION

ROAD INVENTORY SHEET MUN0016

Party Chief BB
Recorder DW
Assistant
Map No./Dir. GH 20 / 1135-63
State Coordinates Crisfield

Road No. CO 377
Road Name ANchor Dr
County Somerset
Date 1-24-84
Sheet No. 1 OF 1

87-6

TRAFFIC CODES
TRAFFIC CONTROLS: STOP SIGN=SS, TRAFFIC LIGHT=T.L., FLASHING RED BALL=F.R.

TRAFFIC CODES
PARKING RESTRICTIONS: A.M. PEAK, P.M. PEAK, A.M./P.M. PEAK, NO PARKING ANYTIME=N.P., COMM/IND. ACCESS=E

SYSTEM				TRAFFIC		LINE DIAGRAM	TRAFFIC			PAVEMENT DATA
FED. AID.	FUNCT CLASS.	HWY. SYS.	HPMS SAMPLE	PKG. REST.	COM/IND. ACCESS		CONTROL	COM/IND. ACCESS	PKG. REST.	
						(ANchor Dr)				
						MUN 0107 0015				
						CORP LIMITS 0104 CRISFIELD				
						MD 358				
						0100				

NON FA K CO RURAL / RURAL LOCAL

20'F

Form 6 HPS (Rev. 1961)

ROAD INVENTORY SHEET

Party Chief F. SUTTAN
Recorder T. LANDON
Chainman

0075

CRISFIELD

Road No.
Name BROADWAY ~~AVE~~
Sheet No. 2 OF 2
Date 8-17-65
County SOMERSET

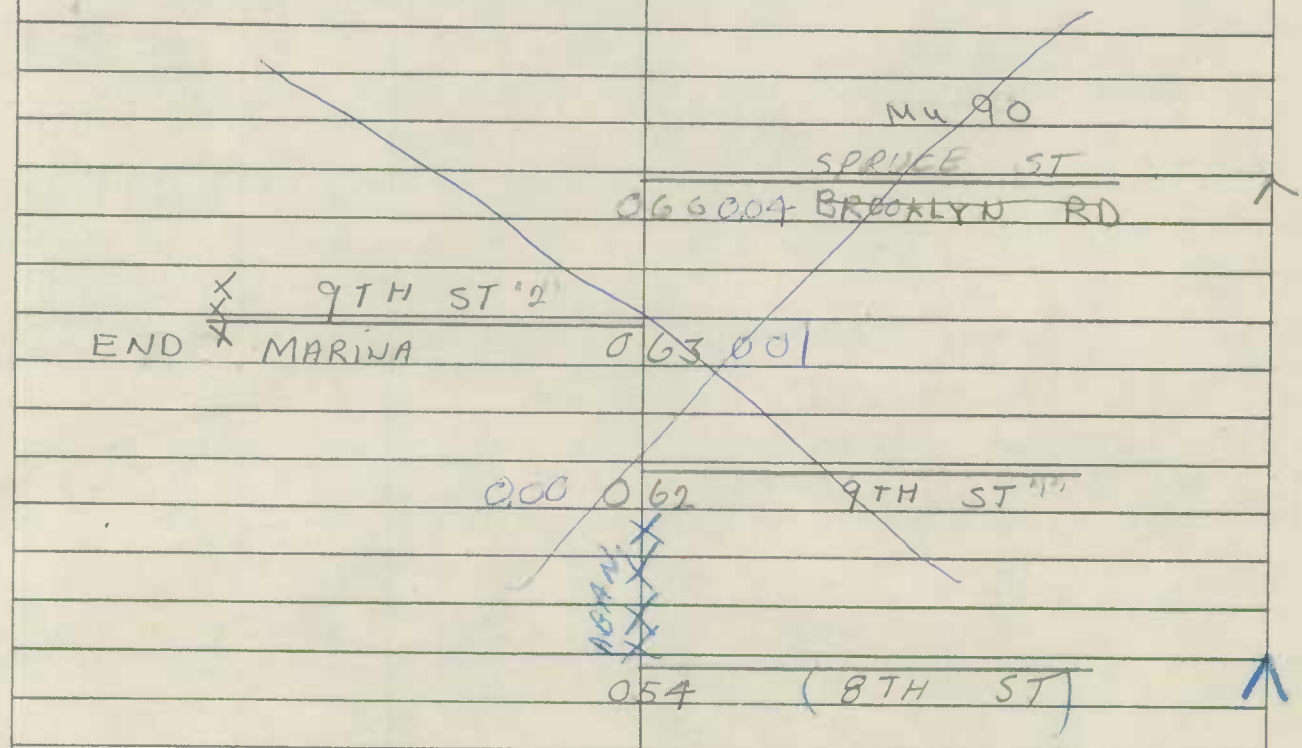

~~BEG MARINA~~ ~~066~~

24'I
30'CW

SAME

Form 6 HPS (Rev. 1961)

ROAD INVENTORY SHEET

Party Chief F. SETIAN
Recorder T. LANDON
Chainman

T. LANDON
T. HODES
VERIFIED
1/3/70
CRISFIELD

Road No. A110
Name (CHARLOTTE ST.)
Sheet No. 1 OF 1
Date 8-17-65
County SOMERSET

B/F 7546

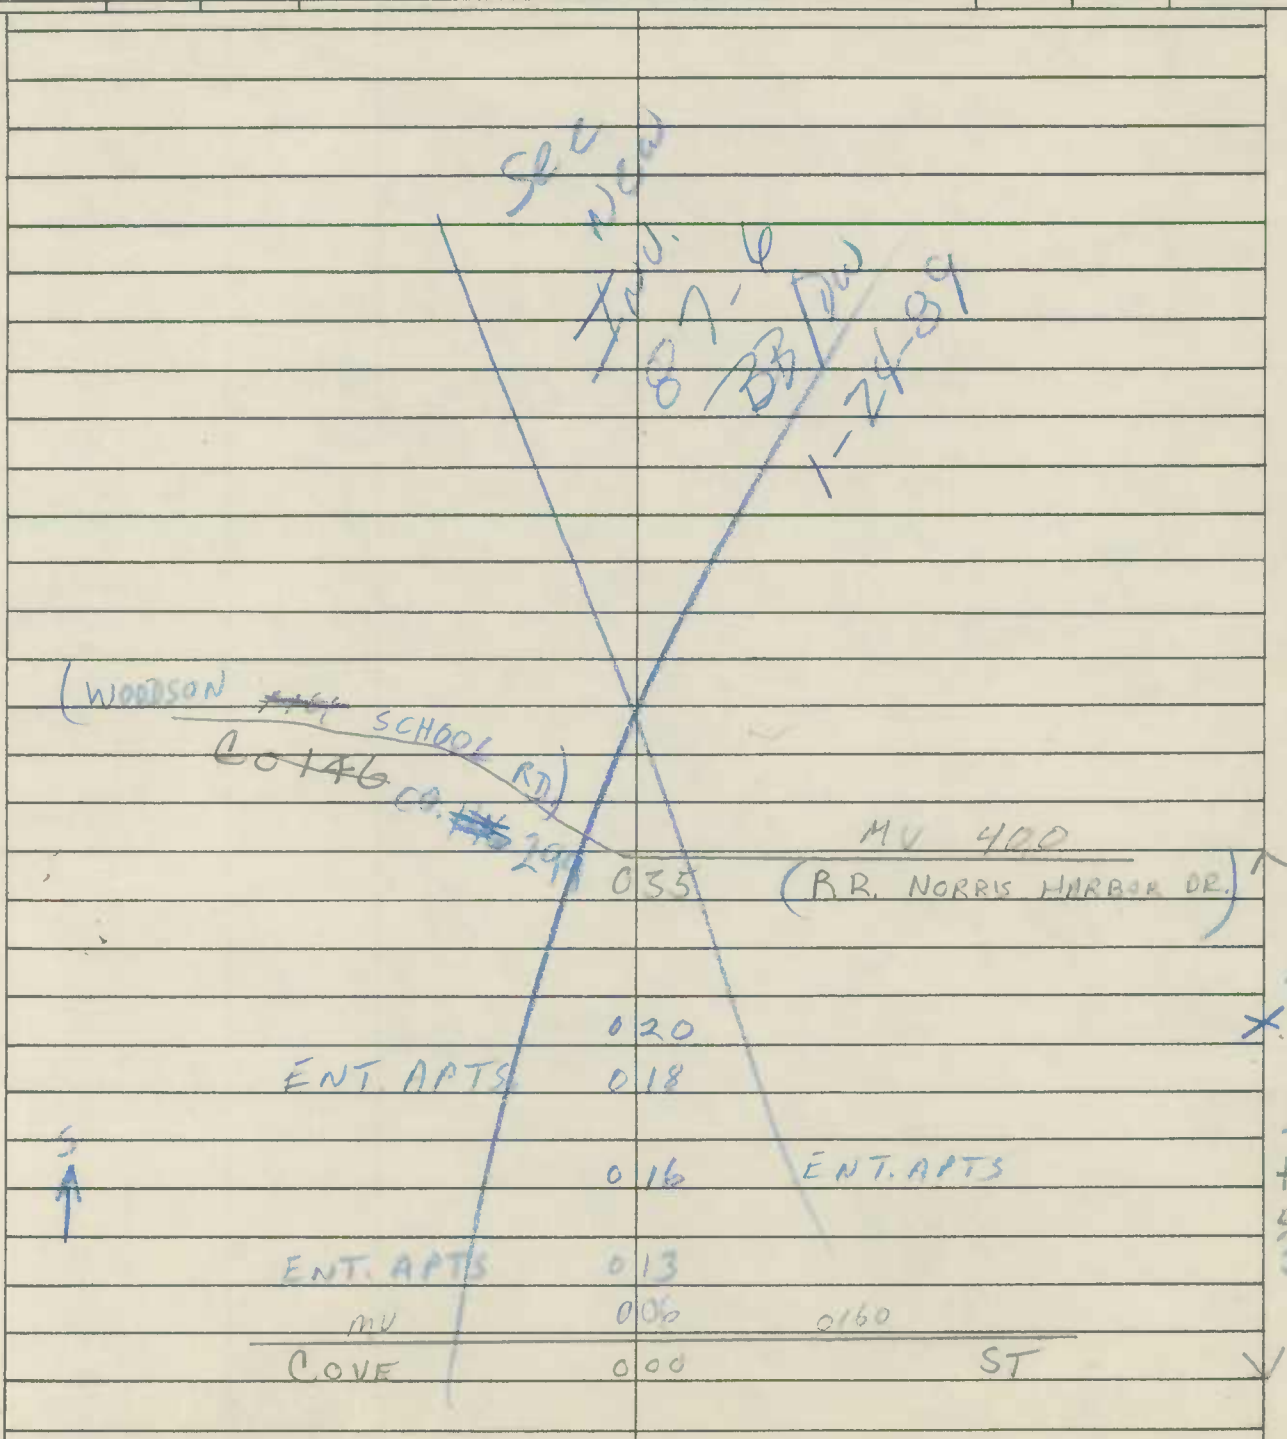

Form 6 HPS (Rev. 1961)

ROAD INVENTORY SHEET

Party Chief F. SETTAN
Recorder T. LANDON
Chainman

T. LANDON
F. HUGHES
VERIFIED
1/4/77
CRISFIELD

Road No. 0120
Name CHESAPEAKE AVE
Sheet No. 1 OF 4
Date 8-6-65
County SOMERSET

		014	H
COLLEGE	MU0270 LAIRD AVE →	013	H
		012	
		011	H
MANOR	9 H	MU0180 010 → CANAL ST ~~AVE.~~ ST.	
		009	11 H
E. A.		002 (N. 4TH ST. EXT.)	
	RICHARDSON	001	AVE.
	MD S.B. MARYLAND	000	413 AVE LA.

73-4
70-9
16' ~~SRI~~
2-7' SHLD
1 L
30' I
C-C

Form 6 HPS (Rev. 1961)

ROAD INVENTORY SHEET

Party Chief F SETTAN
Recorder T. LANDON
Chainman

Road No. 0120
Name CHESAPEAKE AVE
Sheet No. 20 PA
Date 8-6-65
County SOMERSET

CRISFIELD

	028	H
		MUN 9012
H	027	N. 1ST STREET #2
MUN 9010		
N. 1ST STREET #1	026	T
	025	
4 H		9 H
	020	
MUN 190		
DAVIS LANE	019	
	018	
	017	B-VAC H-ABAN
	016	H
		MUN ~~9030~~ 9031
	015	N. 3RD ST
3 H		

Collector

MINOR

SAME

Form 6 HPS (Rev. 1961)

ROAD INVENTORY SHEET

Party Chief F. SETTIN
Recorder T. LANDIN
Chainman

Road No. 0120
Name CHESAPEAKE AVE
Sheet No. 3 OF 4
Date 8-6-65
County SOMERSET

CRISFIELD

70-91

~~L8' S.T.~~
~~2' SHLD.~~
~~5' SHLD RT~~
~~30' CC~~

	053	H	
		MUN	430
N. SOMERSET	050		AVE
			See New INV
END CEM	049		FC/RI-95
			7-12-95
			GD/TM
	048	T	
REG CEM	037		15 H
	036		
3 H			
	032		
		MUN	260
MYRTLE ST	031		
	030	B-BROC	
B-BROC	029	H	

Collector

M/WOK

SAME

Form 6 HPS (Rev. 1961)

ROAD INVENTORY SHEET

Party Chief F. SETTAN
Recorder T. LANDON
Chairman

Road No. 0120
Name CHESAPEAKE AVE
Sheet No. 4 OF 4
Date 8-6-65
County SOMERSET

CRISFIELD

MD 667

CORP LMTS — CRISFIELD

BEG STATE 065 MAIN MD 667

4 H

064 CHURCH

061 H

MINOR COLLECTOR

SANDY LANE

~~Da~~ ~~38~~ MH0250 060 H

058 H

4 H

055

SAME

Form 6 HPS (Rev. 1961)

ROAD INVENTORY SHEET

Party Chief F SETTAN
Recorder T. LANDON
Chainman

T. LANDON
F. HOLMES
VERIFIED
12/30/76
CRISFIELD

Road No. 0130
Name (CINDER ST)
Sheet No. 1 OF 1
Date 8-13-76
County SOMERSET

ALBAN

NOW

MD.

MD 130

RICHARDSON
~~MARYLAND~~ AVE
MD 413
S.B. MARYLAND 002 AVE LA.

CROCKETT AVE 000

12'F
16'CW

Form 6 HPS (Rev. 1961)

1133-62

ROAD INVENTORY SHEET

MU 130

Party Chief T. LANDOW

Recorder W. WARFIELD

Chainman

Road No. Co 270

Name ~~CLAUDE~~ CHRISTY DR

Sheet No. 1 OF 1

Date 1-3-69

County SOMERSET

70-22
STA 0.00 STA 0.13
20'F

68-7
T. LANDON
F. RHODES
VERIFIED

16

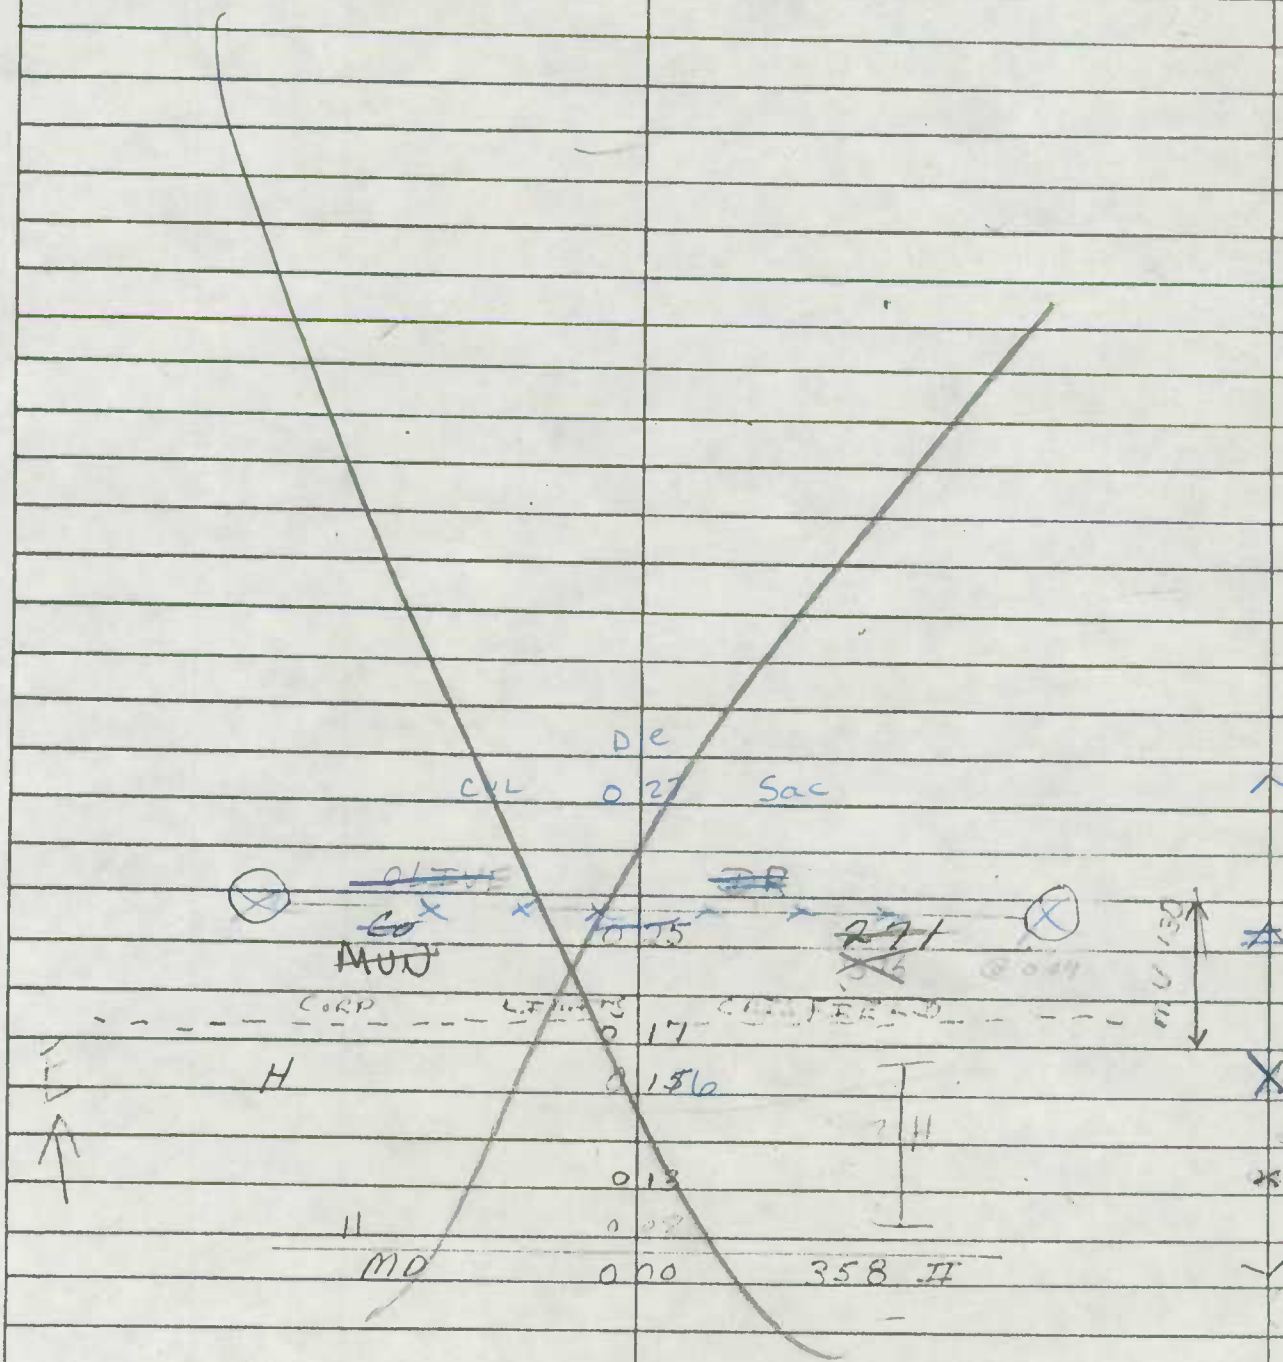

Form 6 HPS (Rev. 1961)

Mun. No. 0220

ROAD INVENTORY SHEET

T. LANDON
F. HOLES
VERIFIED
12/30/76
CRISFIELD

Party Chief F. SETTAN
Recorder T. LANDON
Chainman

82-5

Road No. (ELZIE LANE)
Name
Sheet No. 1 OF 1
Date 8-18-65
County SOMERSET

71-3

ROAD END
0 12

3 H

CORD LATS 0 09 CRISFIELD

SW

MIL 2.0
0 00 (ASBURY AVE)

ASBURY AVE

0241

MLN

16'CW
10'F
16'CW
10'I
16'CW
82-5

Form 6 HPS (Rev. 1961)

ROAD INVENTORY SHEET

Party Chief F. SETTIA
Recorder T. LANDON
Chainman

T. LANDON
F. RHODES
VERIFIED
1/4/76
CRISFIELD

Road No. 0230
Name ("F" ST)
Sheet No. 1 OF 1
Date 8-13-65
County SOMERSET

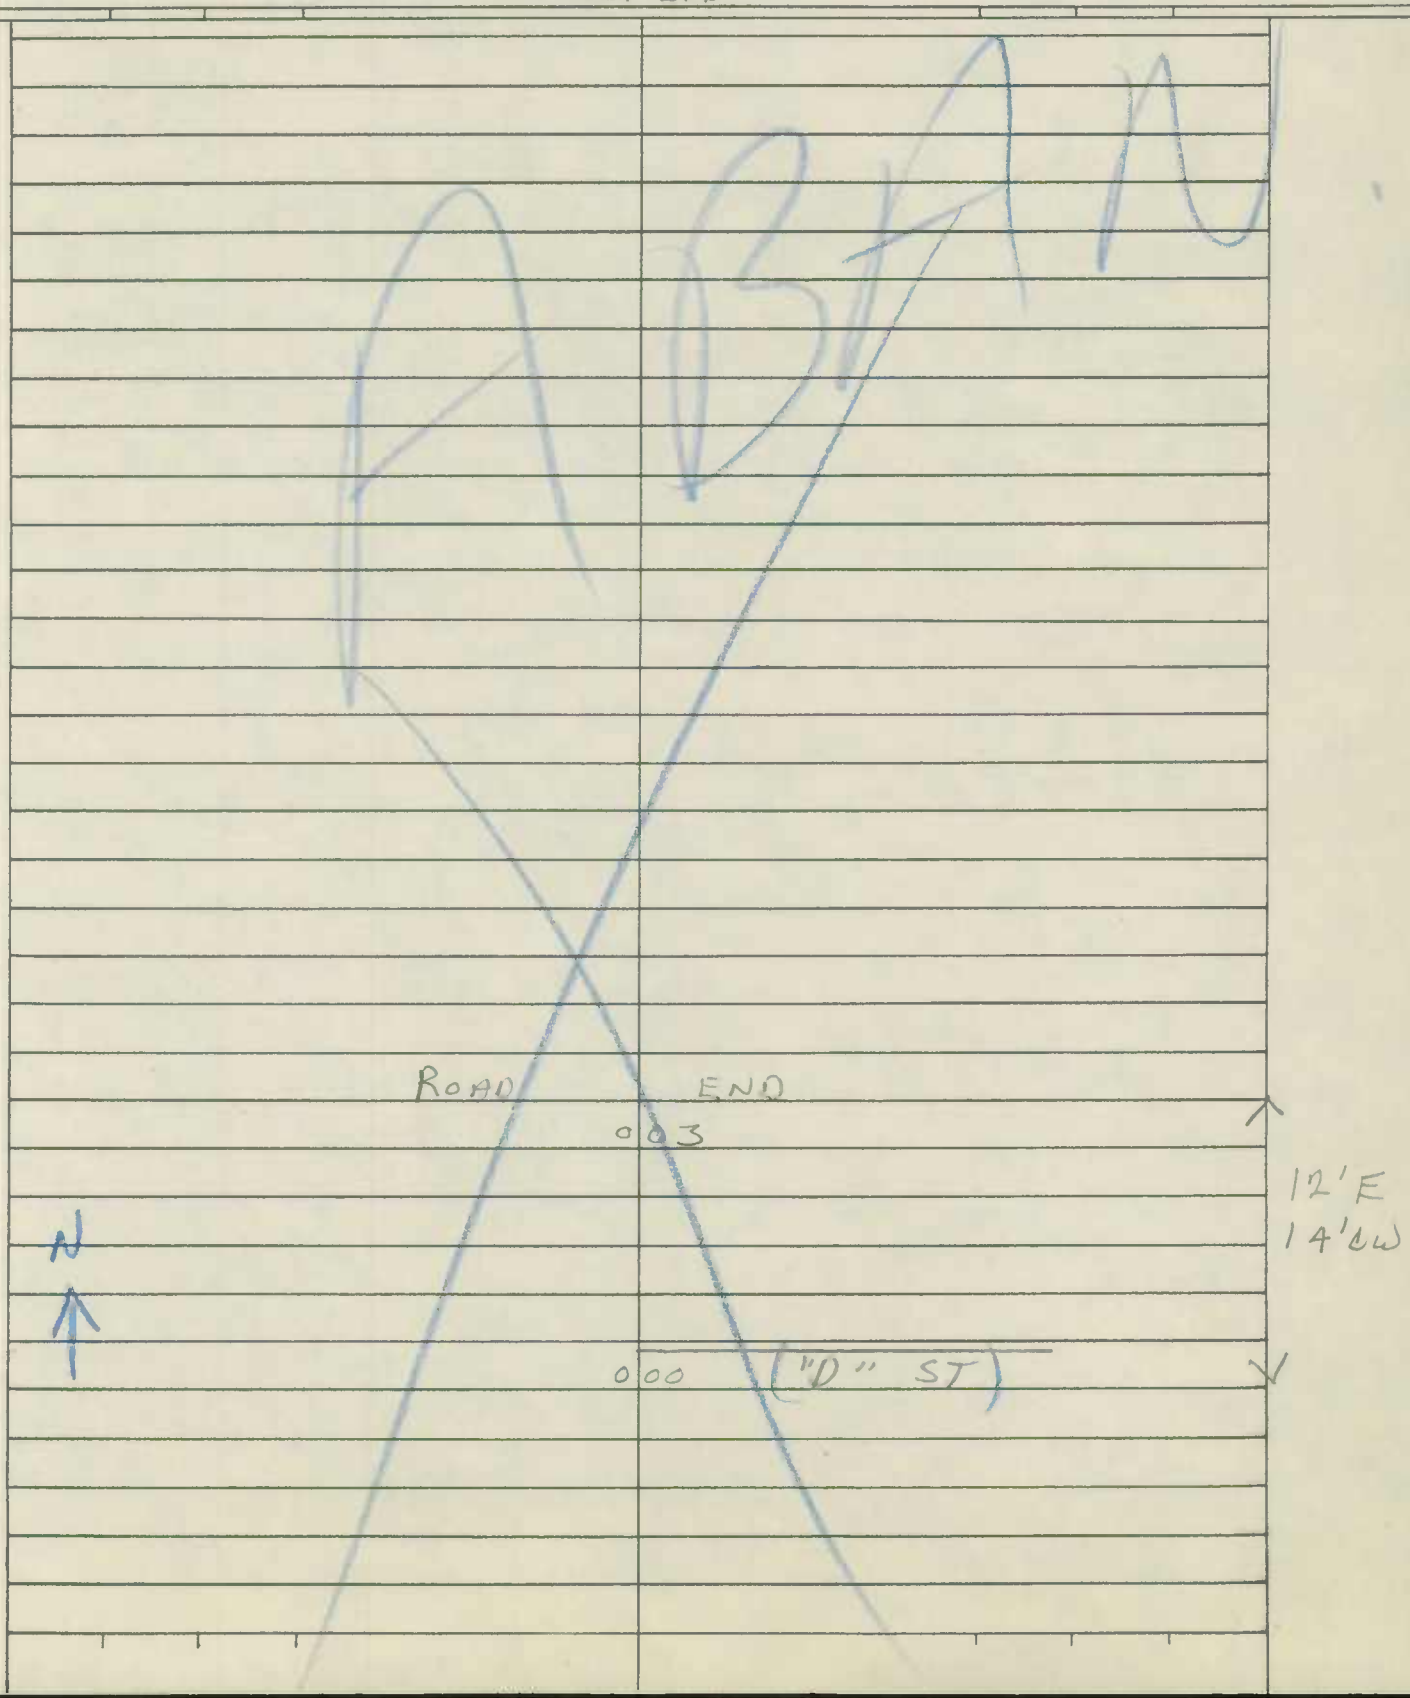

Form 6 HPS (Rev. 1961)

Mun No. ~~265~~
Jacksonville Rd mp 265

ROAD INVENTORY SHEET

Party Chief F. SETTON
Recorder T. LANDON
Chainman

T. LANDON
T. HOLES
VERIFIED
76
CRISFIELD

Road No. MD 358-H
Name Somerset Ave.
Sheet No. 3 OF 6
Date 8-18-65
County SOMERSET

1 14
1 13
H
1 12
Co 135
PEACH ST
1 09
1 10
1 08
3 H
1 06
6 H
16'J
2-5'Fs
30'CW
B-VAC
1 05
H-50'-H
MAIN MD 358
CRD H LMTS
1 04
1 08
CRISFIELD
JACKSONVILLE RD
CRISFIELD SCHOOL NO. 3
1 00
1 04
RD "A"
MD.
413
S.B.
0 93
0 97
L.A.
RXRSIGN
P.A.
0 92
0 96
R.R.
RXRSIGN
CRISFIELD MUNICIPAL
18'J
30'CW
SAME

SHA 51.3-8
11-15-72

STATE HIGHWAY ADMINISTRATION OF MARYLAND

REWRITTEN 4-8-75

ROAD INVENTORY SHEET ~~MD 265~~ Tabbed

Party Chief T. LANDON
Recorder F. RHODES
Helper

Map No.

Road No. MD 358
Road Name Jacksonville Rd
Sheet No. 1 OF 2
Date 6-4-74
County SOMERSET
State Coordinates

CRISFIELD

(OUTTEN RD.)
Co 134 027

026

(BURTON AVE.)
4 H 025 Co 132

022 H

(OUTTEN RD.)
Co ~~304~~ 134 021 H

(PEAR ST.)
020 Co 133

3 H 019

015

(PEACH ST.)
Co 135 014

7 H

3 H 013

011

(MILL LA)
010 Co 337

CORP. LIMITS 009

CRISFIELD ELE. SCHOOL 005 MUN. 0010

004

413

000

MD

SOMERSET AVE. MUN. 4130

MAIN ST. MD 413

25' LT RT 6' JACKSONVILLE RD. MUN. 0010

30' LT RT 37' LT RT

22' I
~~30 000~~
2 m L

~~30' I~~
~~"J" C~~ ~~CT.~~
36' CW
2 m 2

SHA 51.3-8
11-15-72

STATE HIGHWAY ADMINISTRATION OF MARYLAND

REWRITTEN 4-8-75

ROAD INVENTORY SHEET

MU 265

Party Chief I. LANDON
Recorder F. RHODES
Helper

Map No.

Road No. ~~MD 358~~
Road Name
Sheet No. 1 OF 2
Date 6-4-74
County SOMERSET
State Coordinates

(OUTTEN RD.)
Co 134 027

026

(BURTON AVE.)
025 Co 132

4 H 022 H

(OUTTEN RD.)
Co 134 021 H

(PEAR ST.)
020 Co 133

3 H 019

015

(PEACH ST.)
Co 135 014

7 H

3 H 013

011

(MILL LA)
010 Co 337

22'I
30'cw
2mL

CORP. LIMITS 009

25' ↑ OF CRISFIELD
(EAST A.RD)

30'I

CRISFIELD ELE. SCHOOL 005 MUN.

"J"C-LT.
36'cw
2mL

MD 413

000

Somerset Ave. MUN. 4430

Tackhannock Rd. MUN. 3430

Form 6 HPS (Rev. 1961)

91-MU EX #2
AL-JK
1-28-92

OP 51

T. LANDON
F. RHOUES
VERIFIED
1/4/76

ROAD INVENTORY SHEET

Party Chief T. LANDON
Recorder W. WARFIELD
Helper

CRISFIELD

GH2C

3-5-71

Road No. MUN. 02-15
Road Name LAVALETTE RD.
Sheet No. 1 OF 1
Date 1-17-71
County SOMERSET

1128-52

DUMP

SITE

ROAD 0.63 END OF CRISFIELD
CORP. LIMITS 0.55 0.50
0.49

H-600'

OP GOES TO END OF ROAD

10°

Private 0.33 Per
Road End 0.29 IMPASSABLE
0.24
0.04
0.15

10°

12' E

18' E
18' W

10°

NORRIS
MUN. 0.00 HARBOR DR. ST.

0.14

10

Form 6 HPS (Rev. 1961)

ROAD INVENTORY SHEET

Party Chief F. SETTAN
Recorder T. L ANDON
Chainman

T. LANDON
F. HOLES
VERIFIED
12/30/76
CRISFIELD

Road No. 0290
Name LORIE C. QUINN SR. DR.
Sheet No. 1 OF 1
Date 8-13-65
County SOMERSET

LITTLE ANNEMESSEX RIVER		
	ROAD	END
	0	42
	0	39 ENT. AMERICAN LEGION & BEACH CRISFIELD
Corp DEL. - ENT. Limits	0	37 -
0.04 16'F C-C	0	35
UNIVERSITY OF MARYLAND		
NATURAL RESOURCES INSTITUTE	0	34 CORP LIMITS CRISFIELD
SEAFOOD PROCESSING LABORATORY		
MAIN ENT.		
0.05 16'F- C-C	0	33 ATA. FIELD
	0	27 SARAH M. PEYTON SCHOOL
MUN 50		
(BRICK KILN RD)	0	24
PT	0	15
20°		
PC	0	04
MUN		490
WYNFALL	0	00 AVE

Co Rural
CO 259
Rural
Urban

24'C
40'CW

WYNFALL ST

Form 6 HPS (Rev. 1961)

MUN No. 0310 W. MAIN

ROAD INVENTORY SHEET

Party Chief E. SETTAN
Recorder T. LANDON
Chainman

T. LANDON
I. HUGES
VERIFIED
1/3/67

Road No. MD 380
Name E. Main St
Sheet No. 6 OF 8
Date 7-30-65
County SOMERSET
70-4

175

MAIN ST.

MASONIC LODGE HALL 174 H

26' H I
C-C

MUN

S. SOMERSET AVE. 173 N. SOMERSET AVE

171 H

170 H

166

PUBLIC LIBRARY 165

6 H

H 161

MD NATIONAL GUARD 158

CORP LMTS

~~157~~ CRISFIELD
156

35' H I
C-C

MINOR COLLECTOR

SHA 51.3-8
11-15-72

STATE HIGHWAY ADMINISTRATION OF MARYLAND

ROAD INVENTORY SHEET

Party Chief _____
Recorder _____
Helper _____

Map No. _____ VER. TL & FD 12-30-76

Road No. MUN 325
Road Name MERCURY DR
Sheet No. 1 of 1
Date 7-21-65
County SOMERSET
State Coordinates _____

Revisit 8-27-81, TSC.

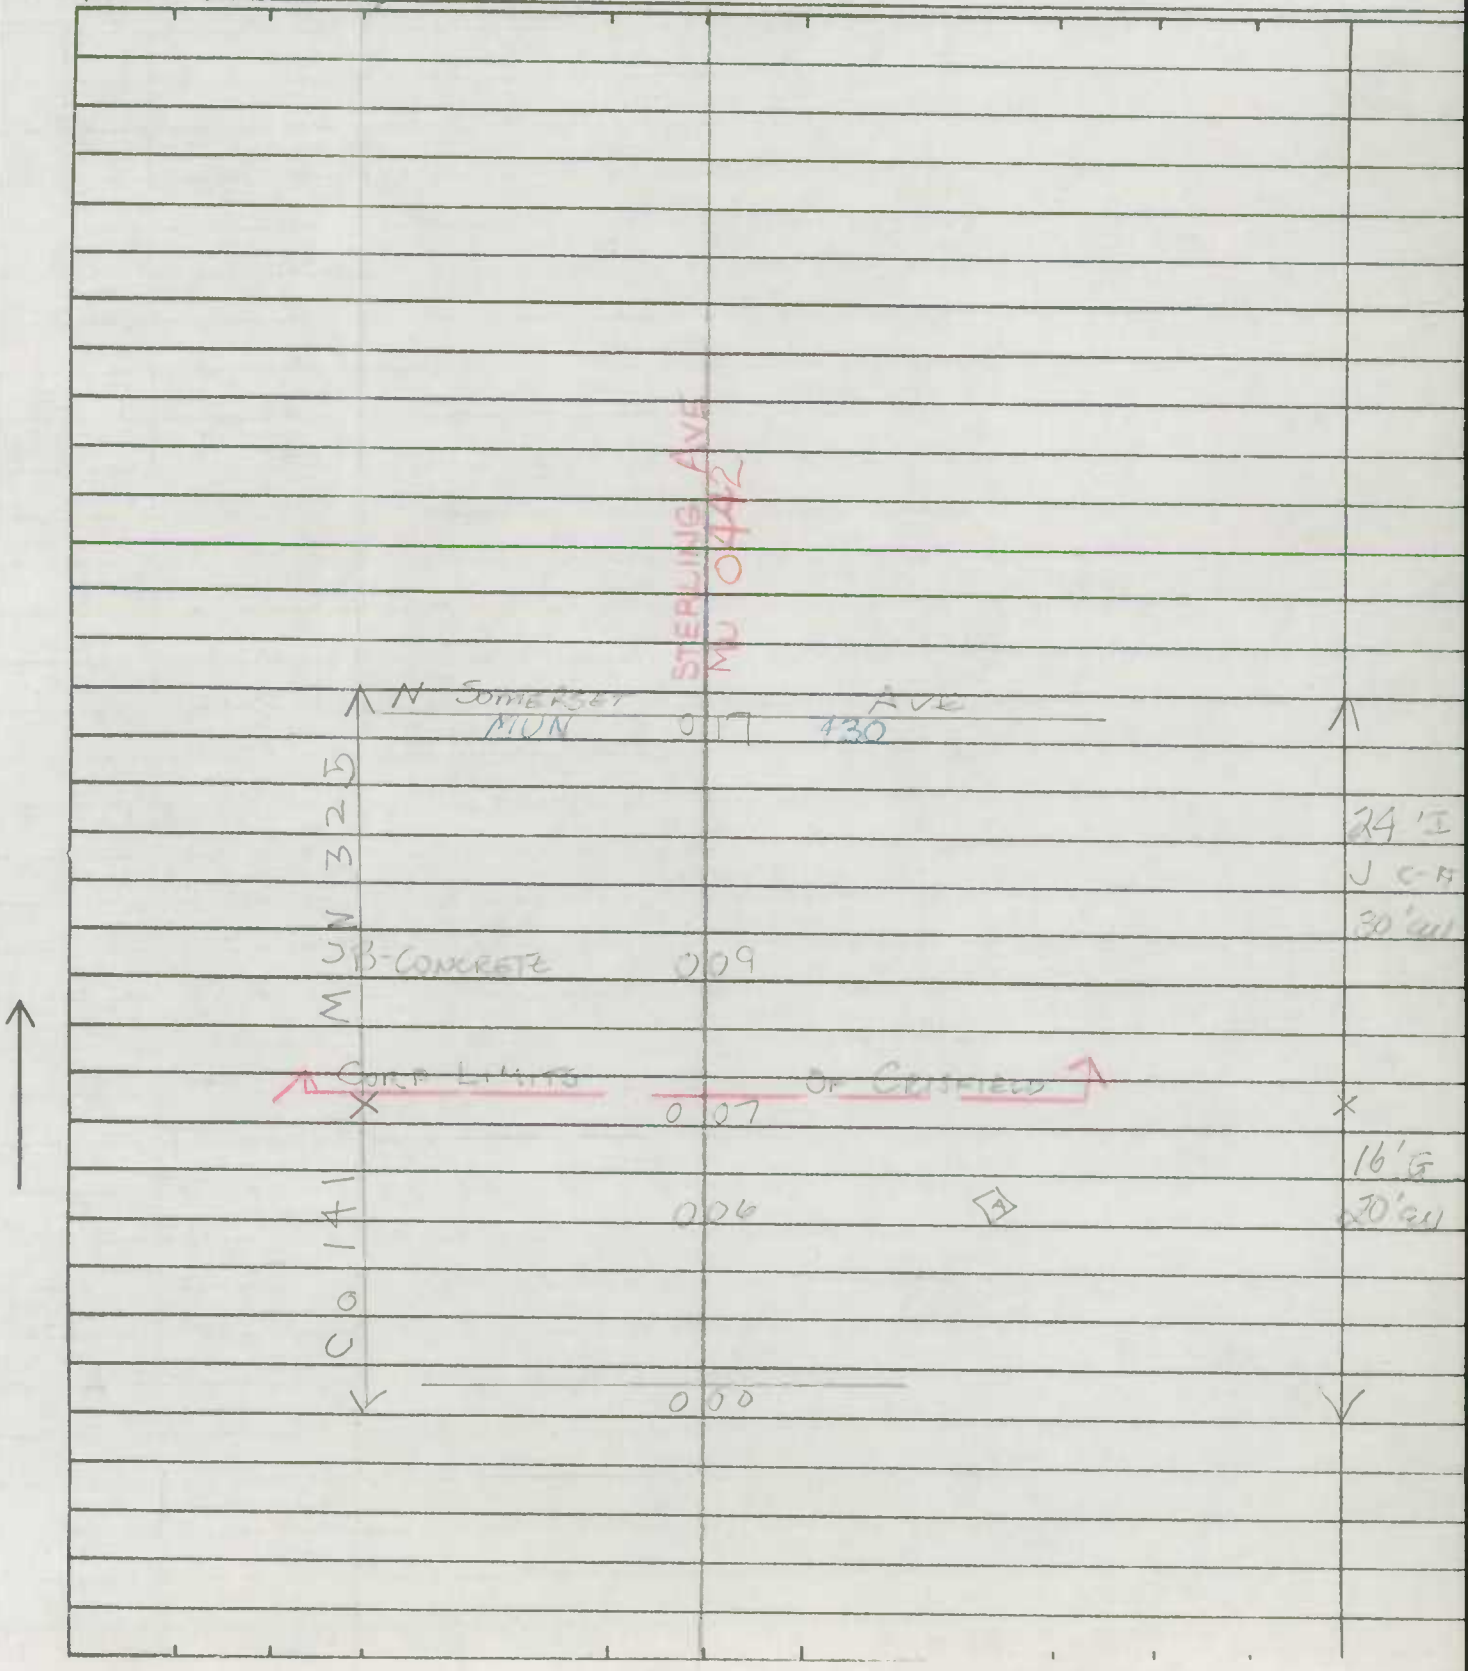

SHA 51.3-8
11-15-72

ROAD INVENTORY SHEET

Road No. _____
Road Name _____
Sheet No. _____
Date _____
County _____
State Coordinates _____

Form 6 HPS (Rev. 1961)

0325

Mun. No. ~~AR~~ MERCURY DRIVE

ROAD INVENTORY SHEET

Party Chief F. SETTAIO
Recorder T. LANDON
Chainman

T. LANDON
VERIFIED
12/30/76

Road No. Co 141
Name ~~School~~ RD
Sheet No. 1 OF 1
Date 7-21-65
County SOMERSET

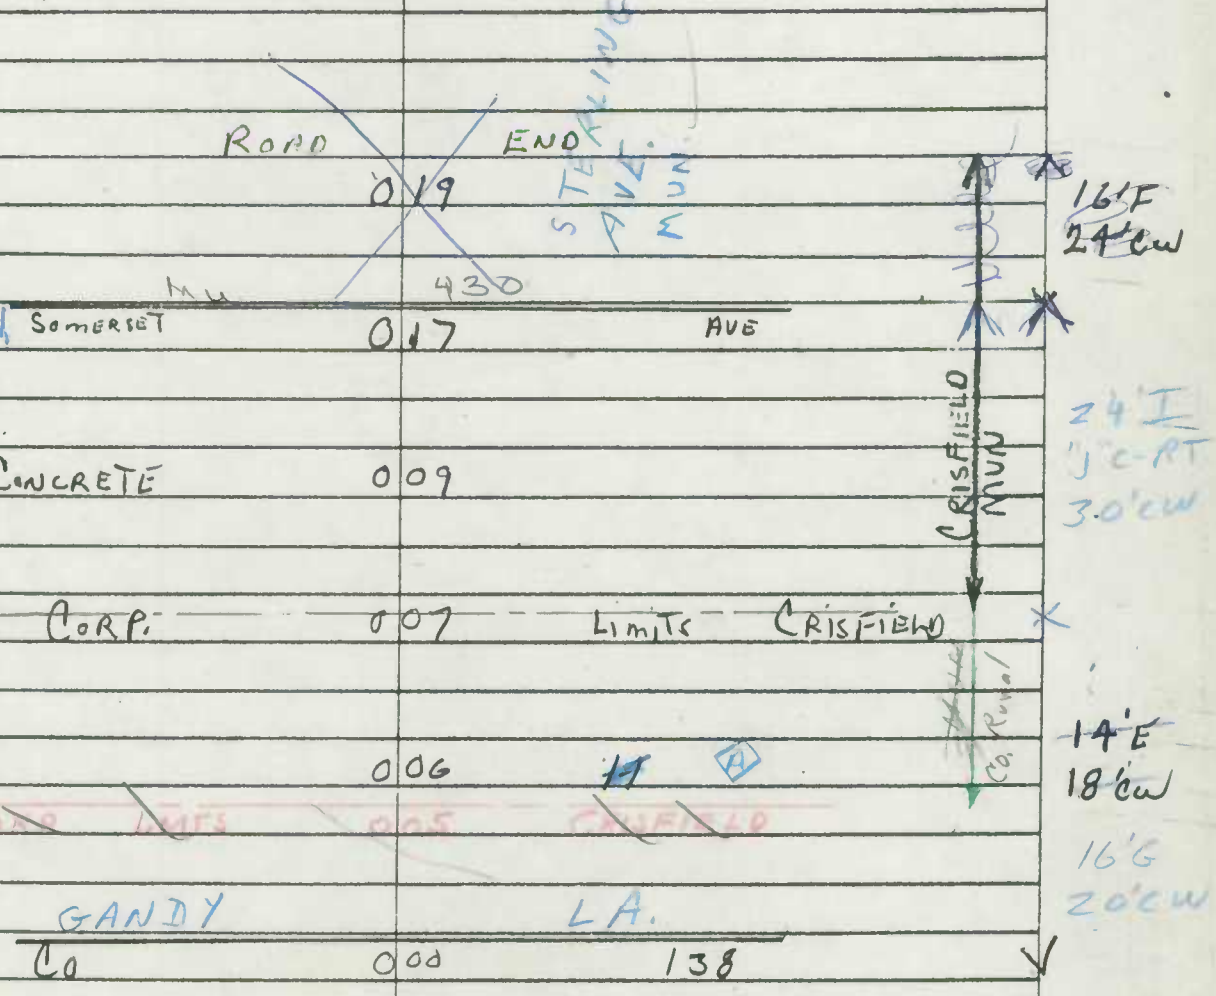

SHA 51.3-8
11-15-72

STATE HIGHWAY ADMINISTRATION OF MARYLAND

(Crisfield)

T. LANDON
F. RHODES
VERIFIED 12/30/76

ROAD INVENTORY SHEET

Party Chief I. LANDON
Recorder E. RHODES
Helper

Map No. 75-31
CRISFIELD 25-3 MD 85-17 CW

Road No. MD 0341 GO 337
Road Name (MILL LA.)
Sheet No. 1 OF 1
Date 11/20/76
County SOMERSET
State Coordinates 1133-060

88-21

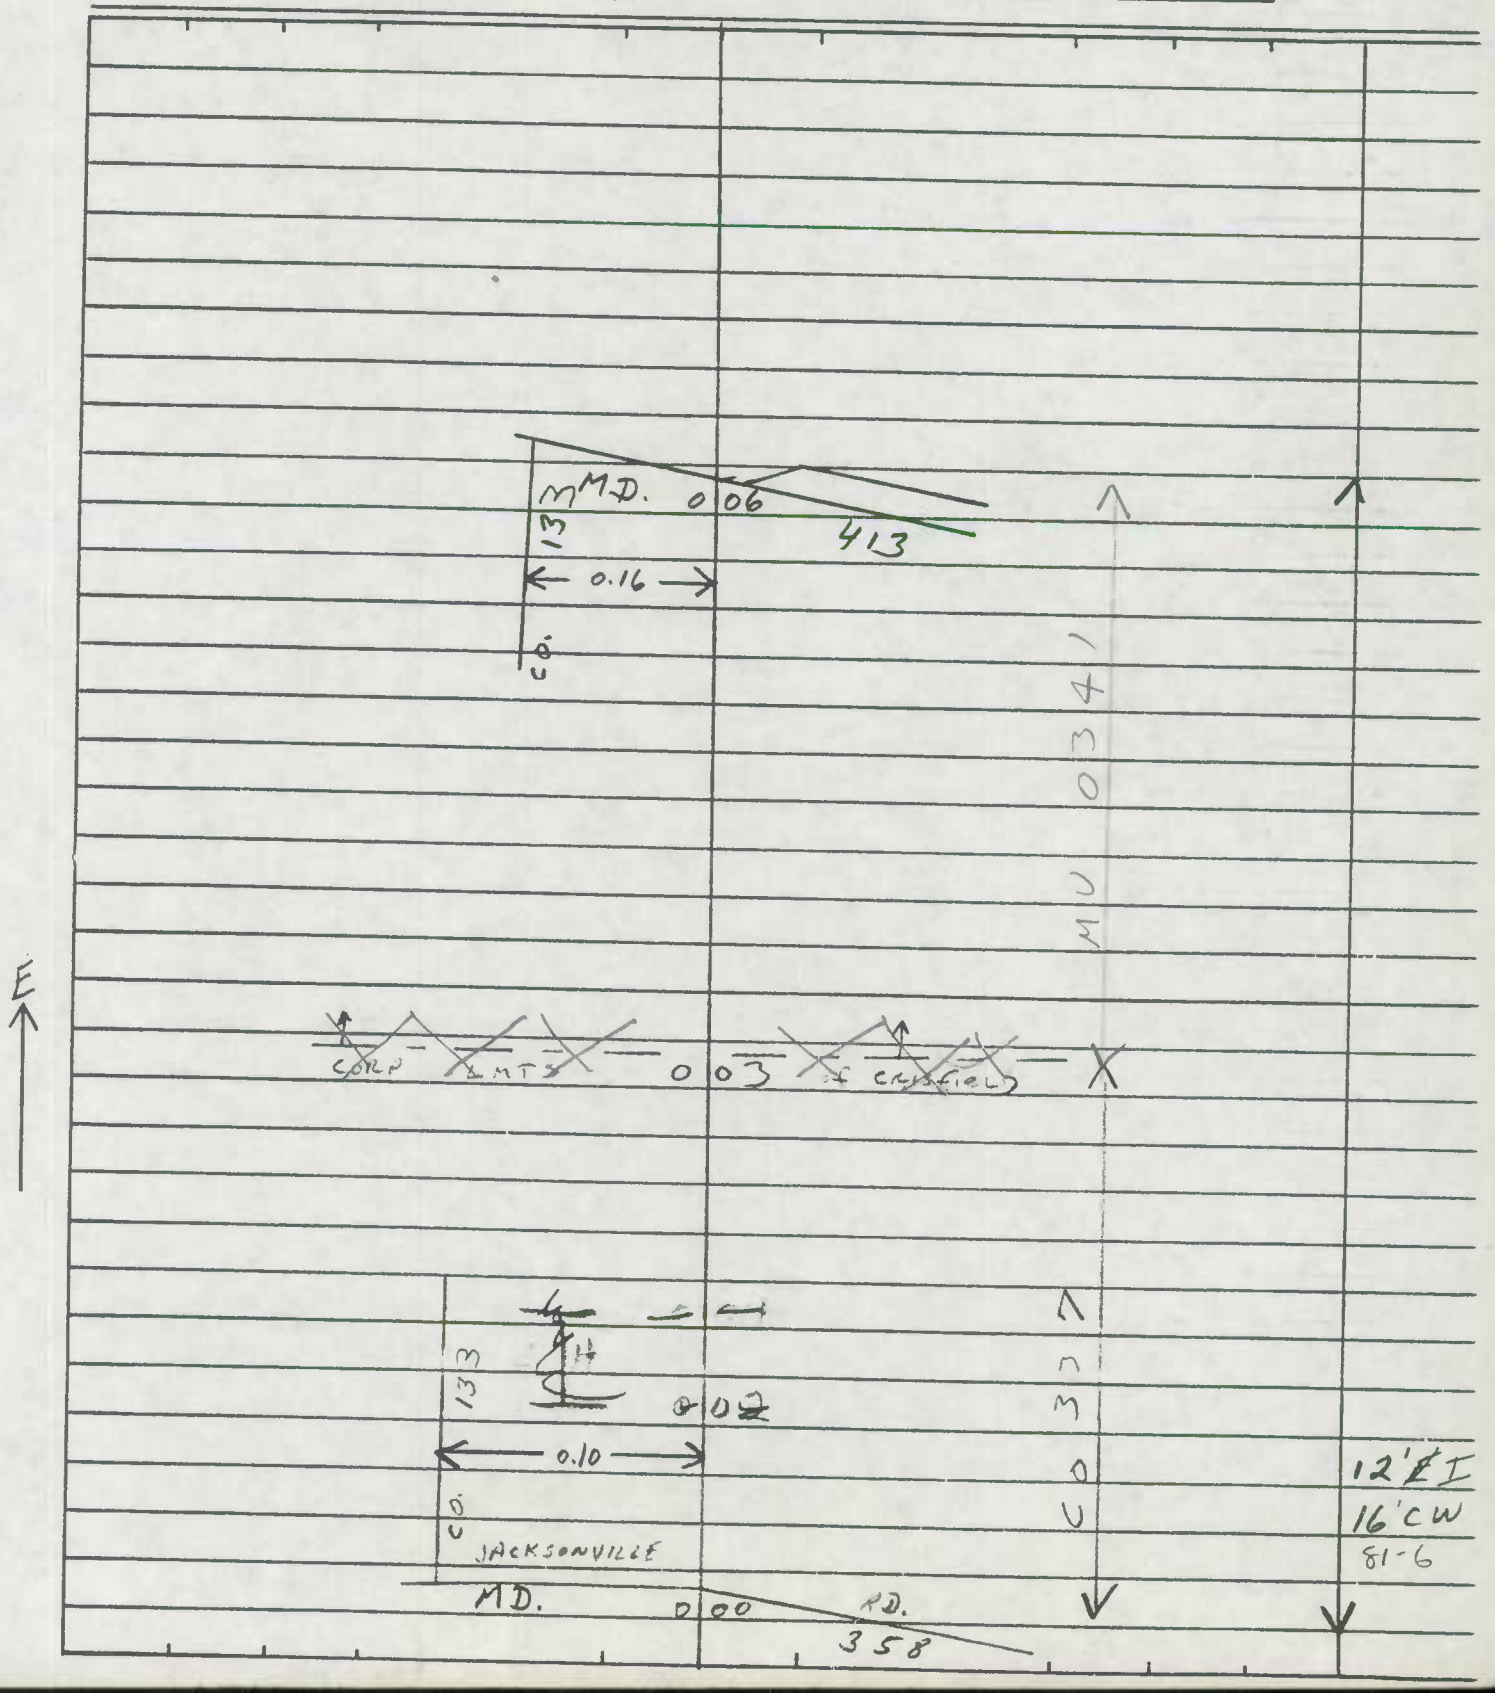

Form 6 HPS (Rev. 1961)

MUN. No. 0350

ROAD INVENTORY SHEET

Party Chief F. SETTAN
Recorder T. LANDON
Chainman

T. LANDON
VERIFIED
12/30/76

Road No. Co 139
Name MINDEN AVE
Sheet No. 1 OF 2
Date 7-21-65
County SOMERSET

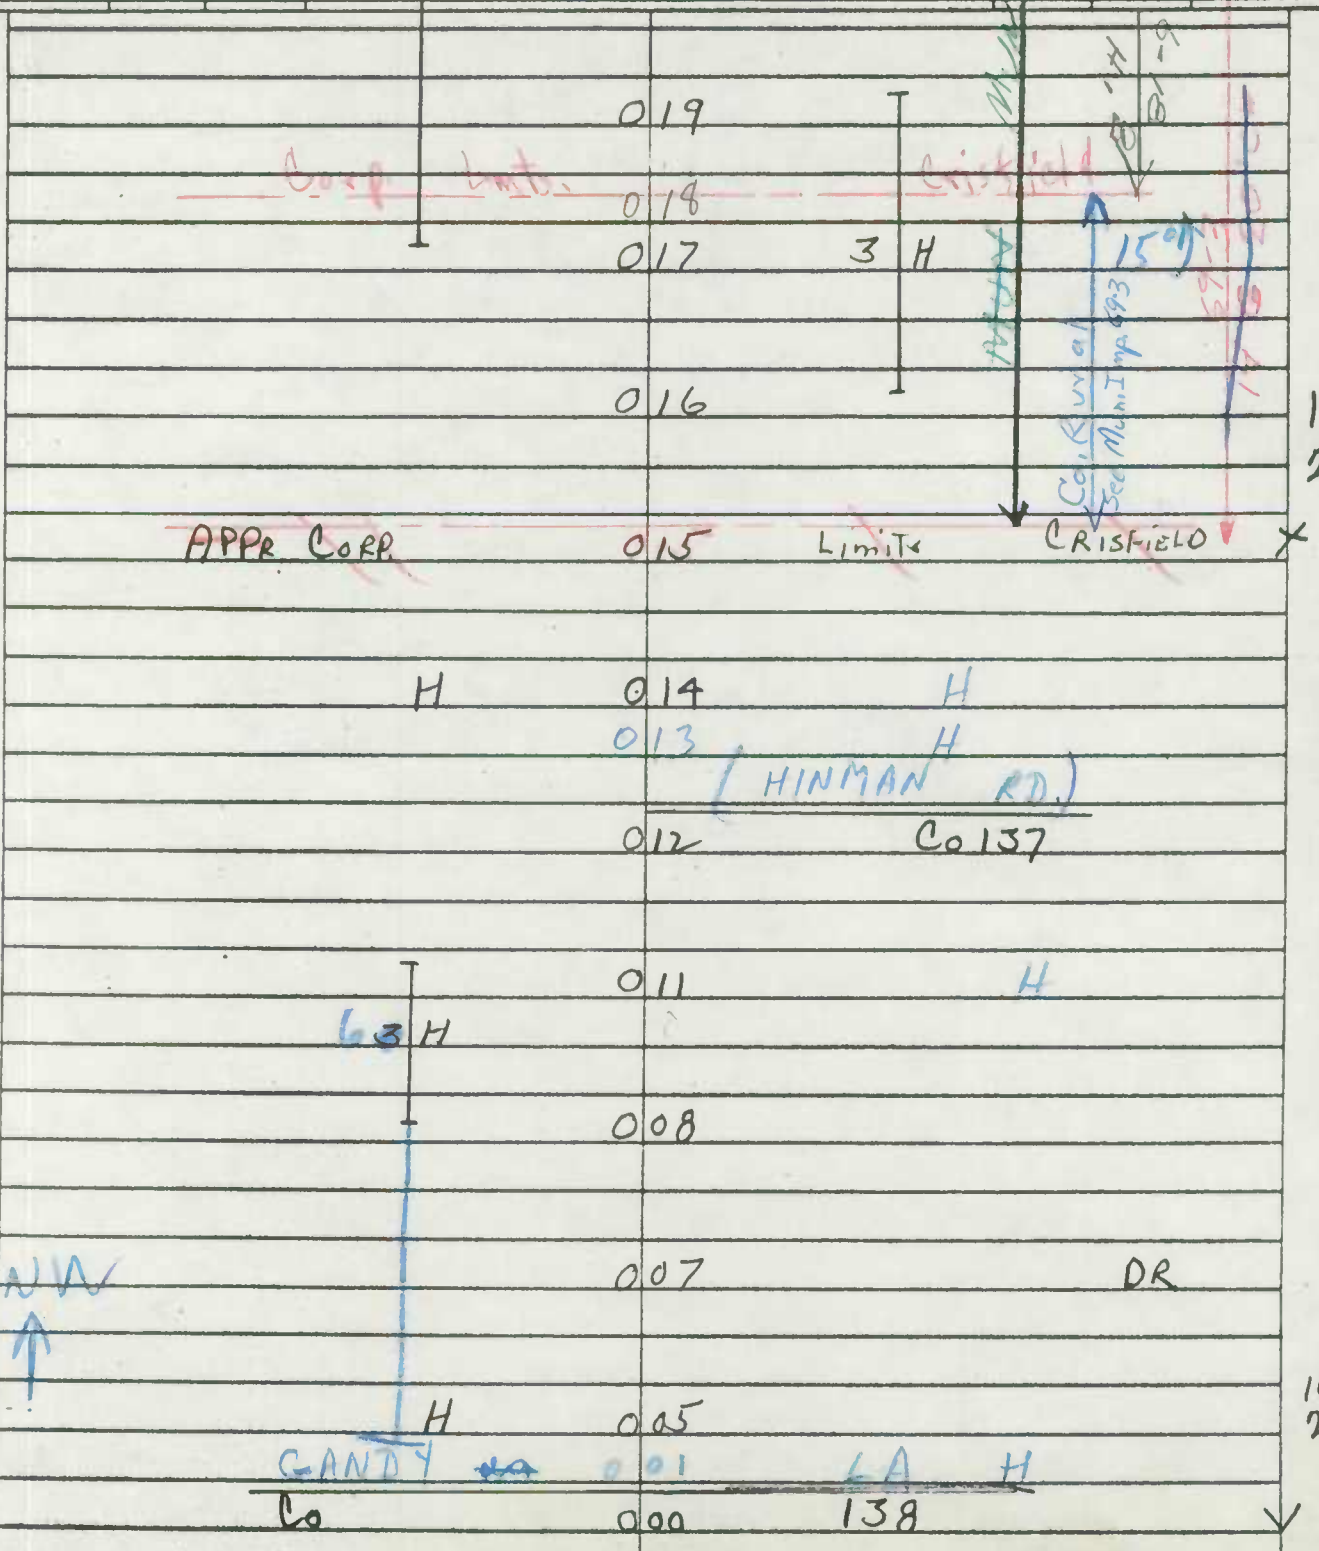

Form 6 HPS (Rev. 1961)

Mun. No. 0350

ROAD INVENTORY SHEET

Party Chief F. SMITH
Recorder T. LYNDON
Chairman

Road No. Co 139
Name Minden Ave
Sheet No. 2 OF 2
Date 7-21-65
County SOMERSET

MUN.
N. SOMERSET 026 0430 AVE

020

3 H

CRISFIELD MUNICIPLE

SAME

Form 6 HPS (Rev. 1961)

0370
NORRIS DRIVE

ROAD INVENTORY SHEET

T. LANDON
F. HOLES
VERIFIED
1/3/78
CRISFIELD

Party Chief T. SISTRUNK
Recorder T. LANDON
Chairman

Road No. 9140
Name ~~4TH ST~~
Sheet No. 1 OF 2
Date 8-17-65
County SOMERSET

81-8

30.5 J
C-C

mu 310
MAIN 053 ST

18'J
2-6' H SHLDS
30'CL

mu 70
BROADWAY 045 AVE

CHURCH 044

mu 450
040 TYLER ST

30'H
C-L

mu 330
035 MILES COURT

5.4TH ST 9040

mu 160
029 COVE ST

24'I
40'CL

017 ENT. APTS
006 ENT. APTS.

NORRIS DR 0370

mu 400
R.R. NORRIS 000 HARBOR DR

Form 6 HPS (Rev. 1961)

ROAD INVENTORY SHEET

Party Chief F. SETTAN
Recorder T. LAWSON
Chainman

1132-53

DT REV. FR. 3-12-79 BB REV. FR. 1-12-80 6 20
Crisfield

Road No. ~~CO 45~~ MUN 0375 ~~956~~
Name (OLD CALVERY RD)
Sheet No. ~~1~~ 1 OF 1
Date 7-22-65
County SOMERSET

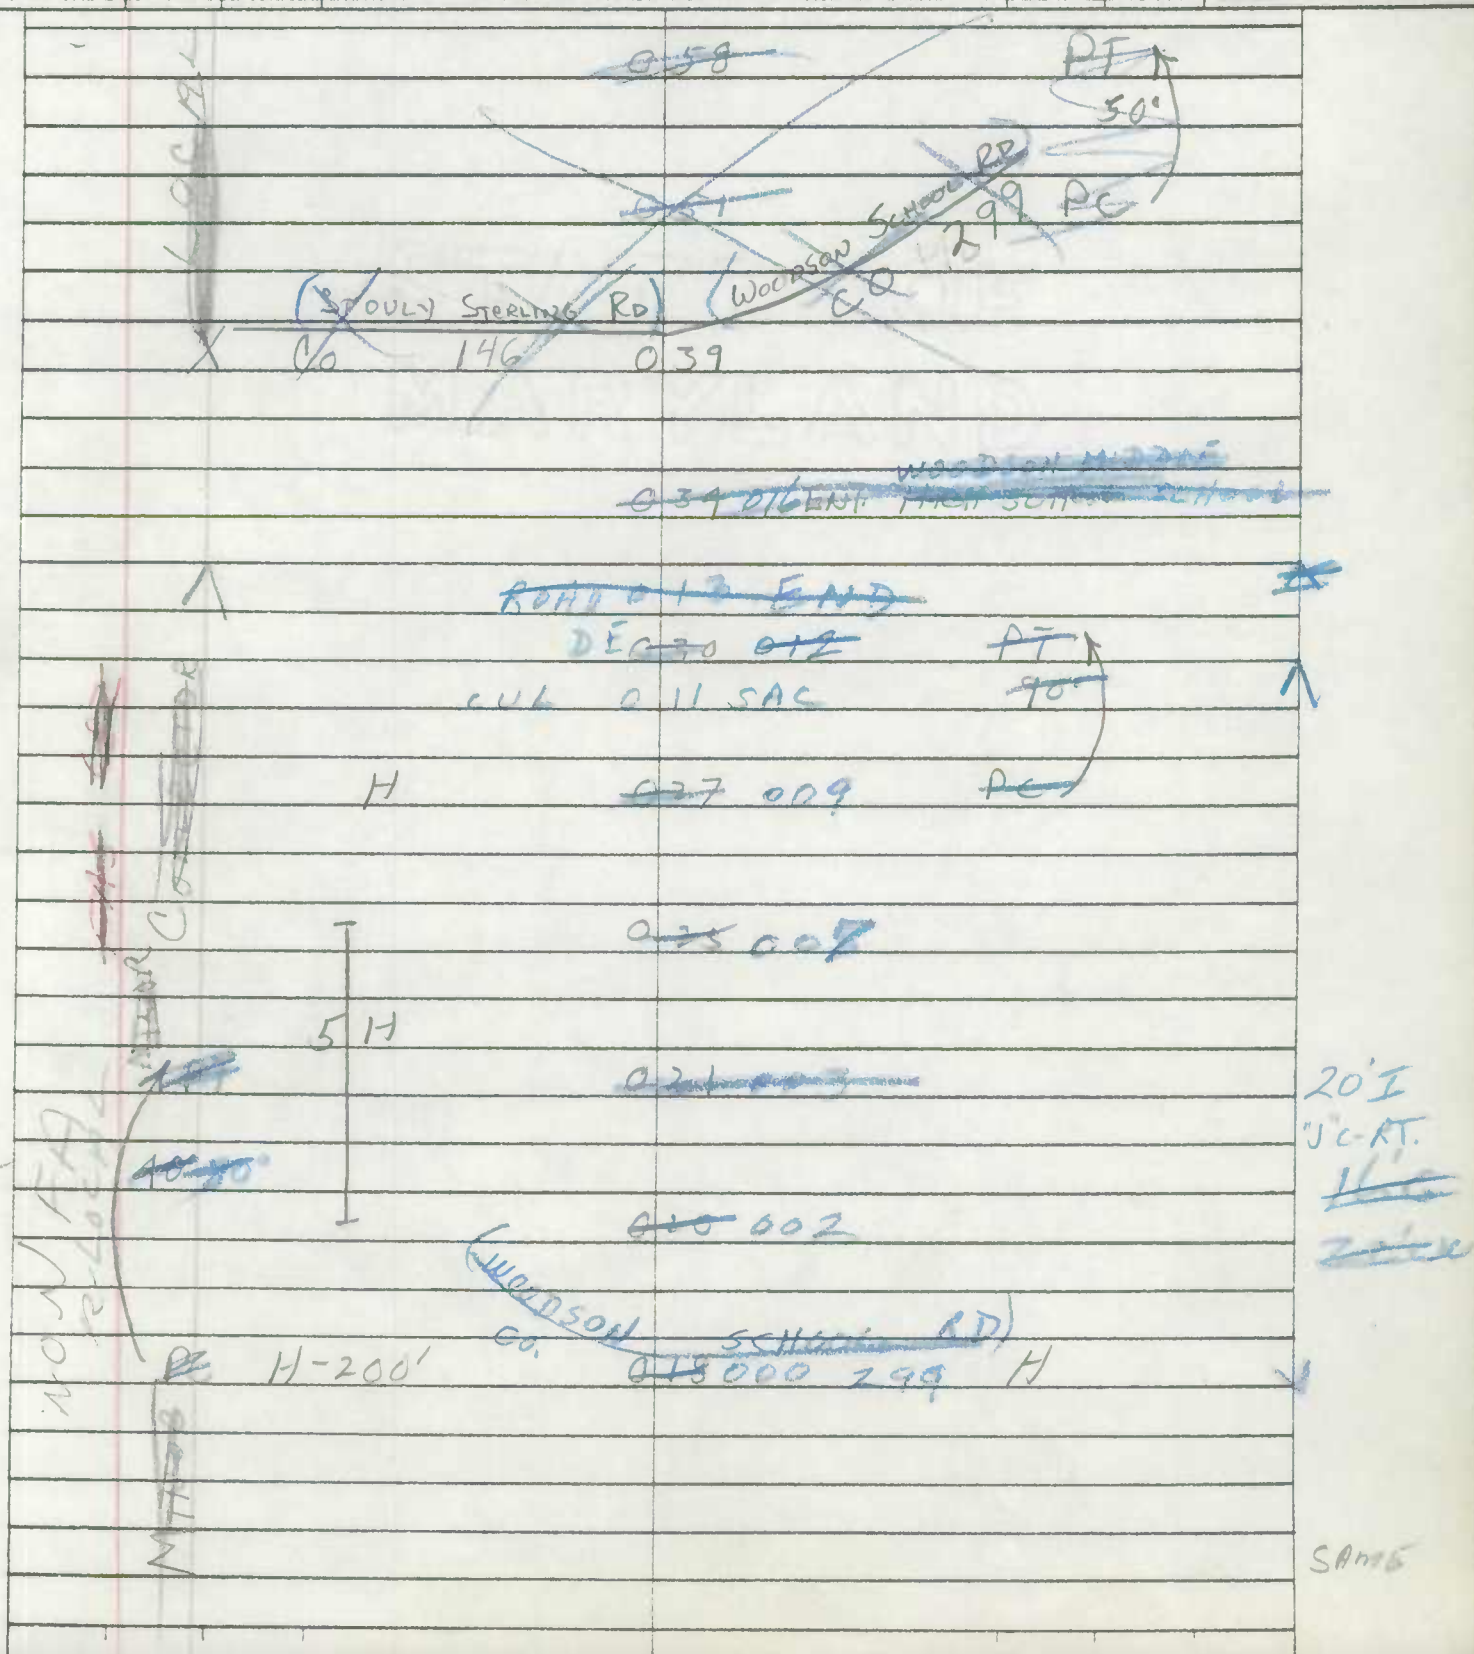

SHA 51.3-8
11-15-72

STATE HIGHWAY ADMINISTRATION OF MARYLAND

(92 MU EXT 7, 8)
GD/A HATTON
1/26/93

ROAD INVENTORY SHEET

Party Chief F SETTAN
Recorder I LANDON
Helper

Map No. _____

TL & FR VER
1-4-77

Road No. MU 430
Road Name N & S SOMERSET AVE
Sheet No. 1 of
Date 8-18-65
County Somerset
State Coordinates

REVISED 4-26-81 JTSC CRISFIELD

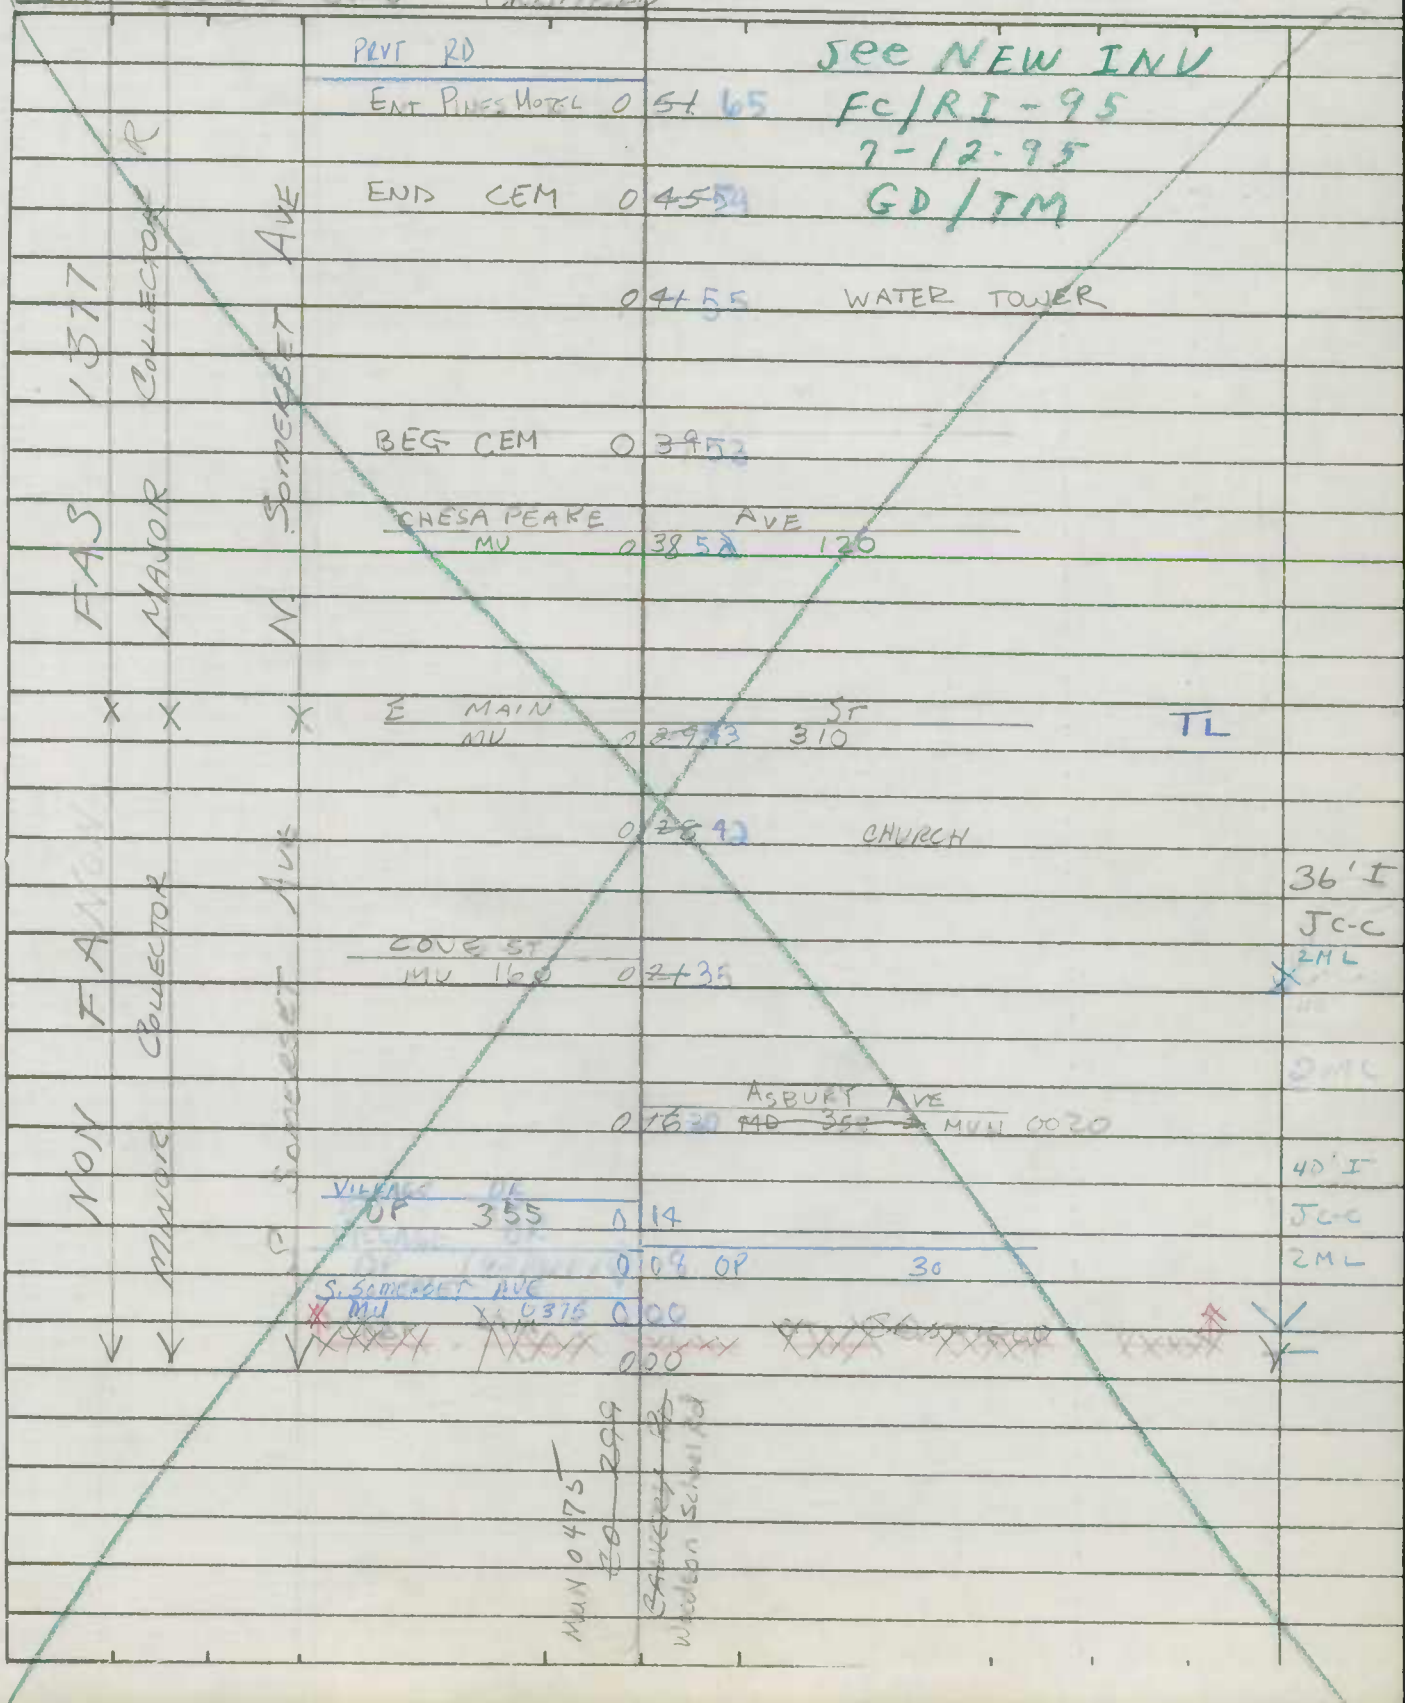

See NEW INV
FC/RI-95
7-12-95
GD/TM

SHA 51.3-8
11-15-72

ROAD INVENTORY SHEET

Road No. MU 430
Road Name SOMERSET AVE
Sheet No. 2 of 3
Date 5-18-65
County SOMERSET
State Coordinates

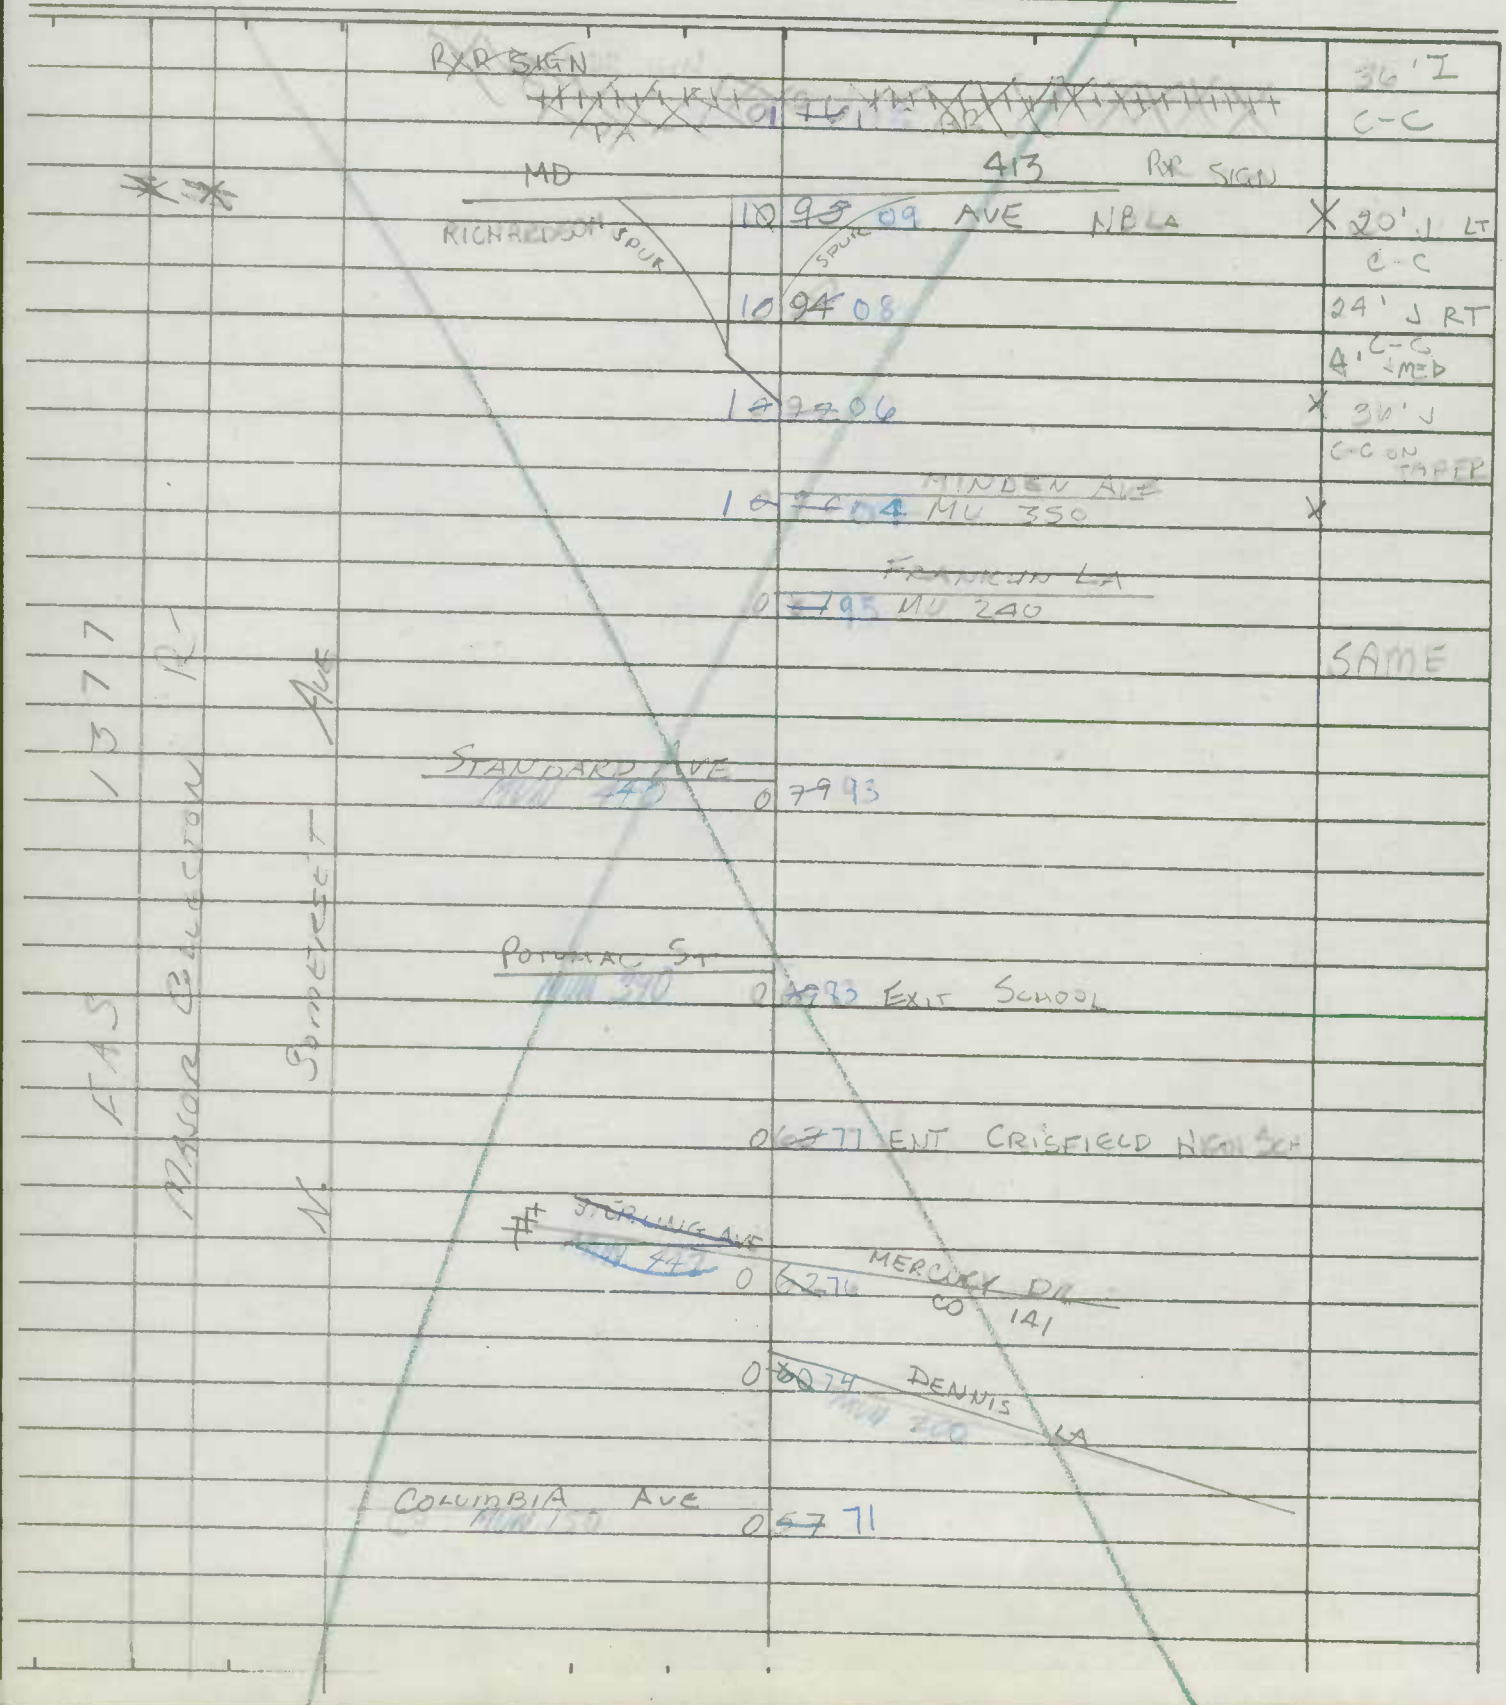

SHA 51.3-8
11-15-72

STATE HIGHWAY ADMINISTRATION OF MARYLAND

ROAD INVENTORY SHEET

Party Chief F SETTAN
Recorder T LANDON
Helper

Map No.

Road No. MU 430
Road Name SOMERSET AVE
Sheet No. 3 OF 3
Date 8-18-65
County SOMERSET
State Coordinates

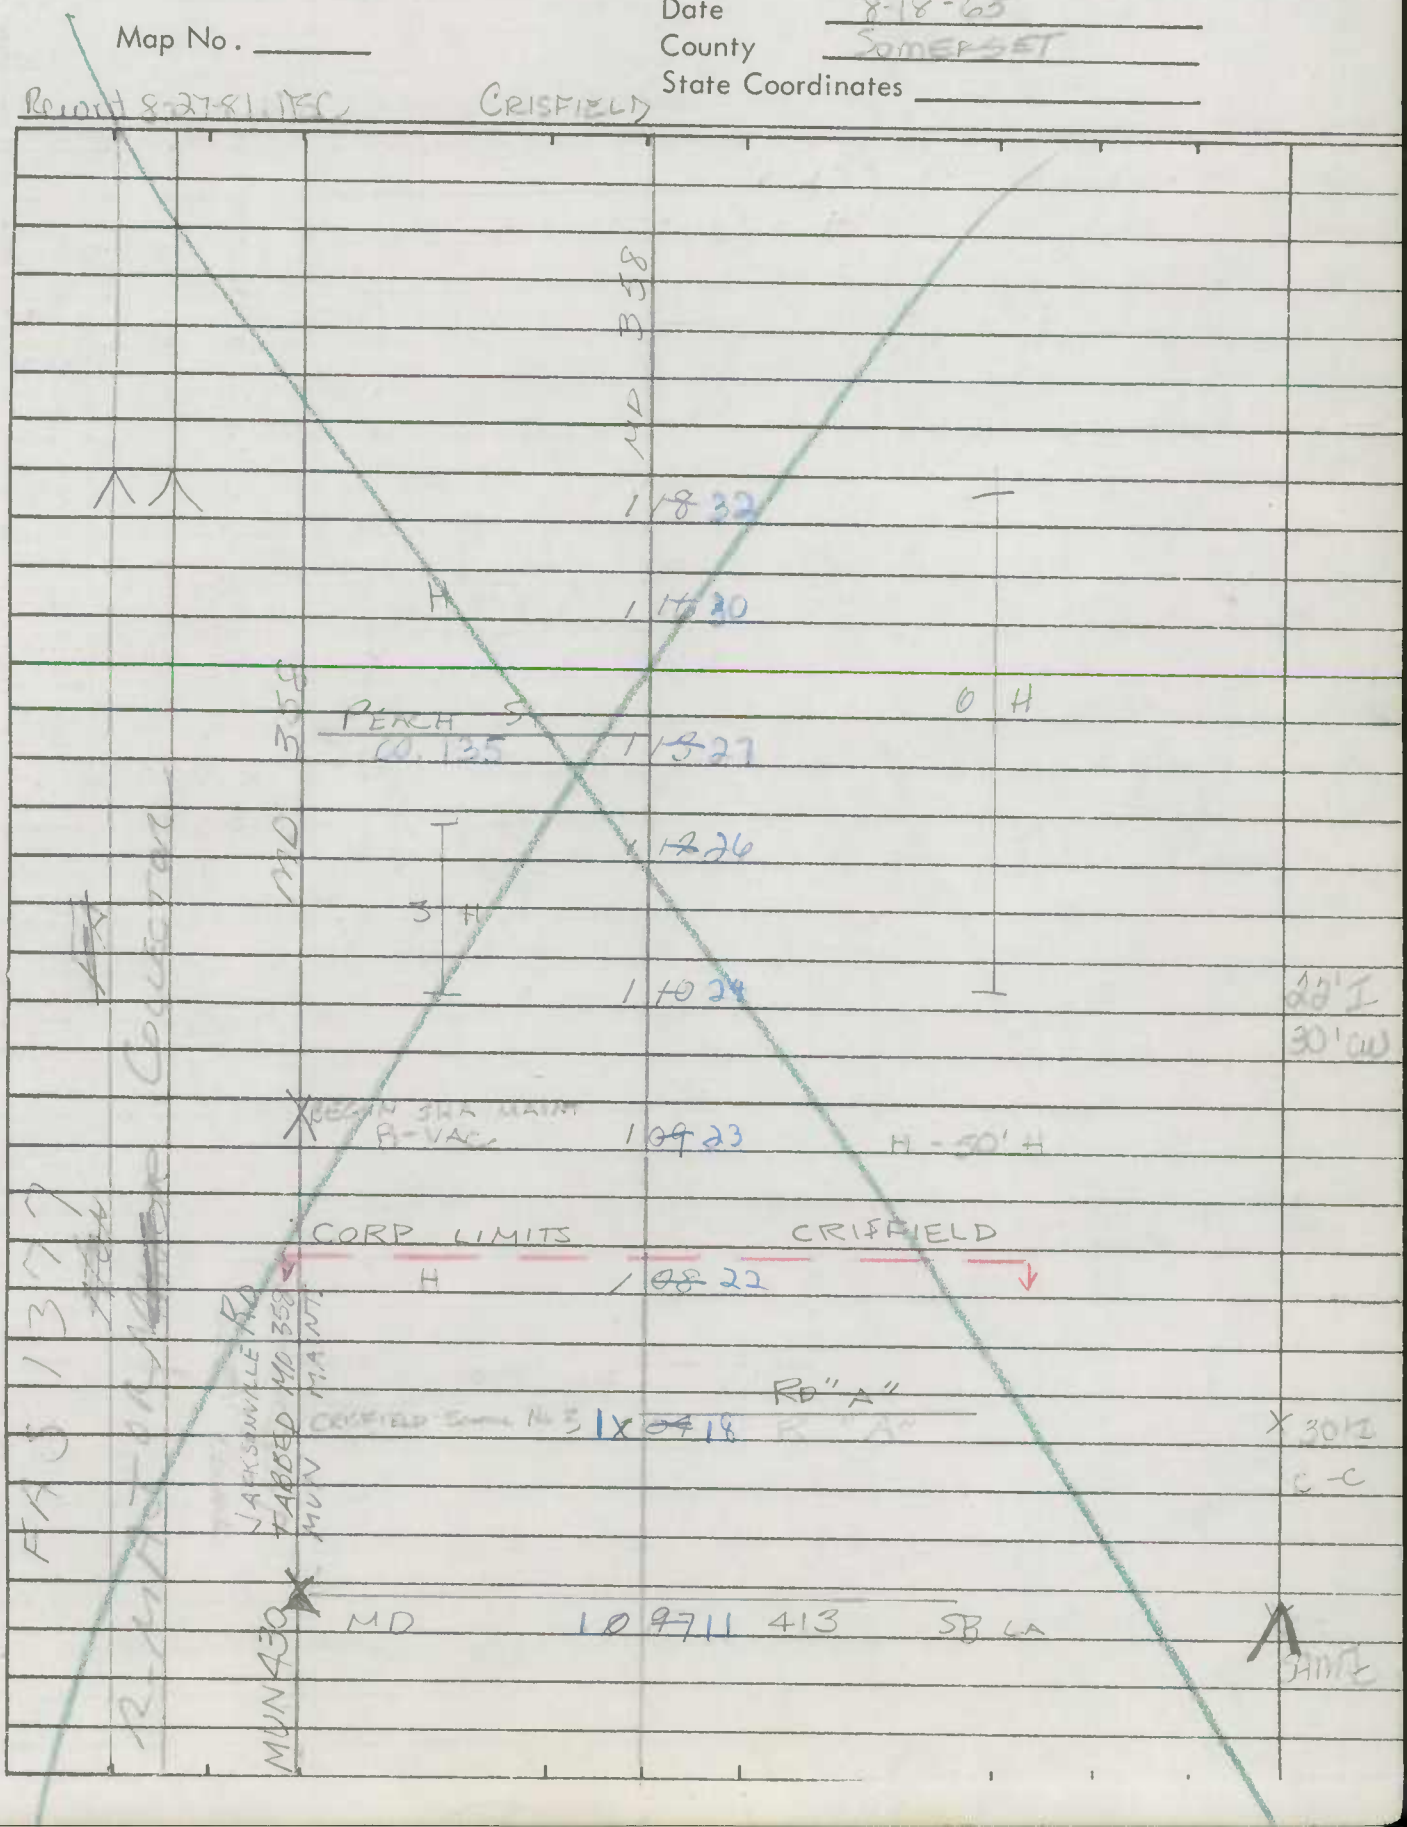

SHA 51.3-8
11-15-72

ROAD INVENTORY SHEET

Road No. _____
Road Name _____
Sheet No. _____
Date _____
County _____
State Coordinates _____

Form 6 HPS (Rev. 1961)

N. SOMERSET

ROAD INVENTORY SHEET

JACKSONVILLE RD

MU 0430

Party Chief E. SETTIAN
Recorder T. LANDON
Chainman

T. LANDON
HSN No. 0430
VERIFIED
1/4/78
CRISFIELD

Road No. MD 358-II
Name S. SOMERSET AVE
Sheet No. 1 OF 6
Date 8-18-66
County SOMERSET

ENT PINES MOTEL	0	47	
END CEM	0	41	
	0	37	WATER TOWER
BEG. CEM	0	35	
W. CHESAPEAKE	0	34	AVE
W. MAIN	0	25	ST
	0	24	CHURCH
COVE ST	0	17	
			MD 358-I (MON.)
	0	12	ASBURY AVE
APPR. CORP	0	00	LIMITS CRISFIELD

FAS 1377 Collector
N SOMERSET AVE
MATOR
Minor Collector
Non F.A.

MU 120
MU 0310
MU 160
MU 20

36' H I
C-C

Co 745
299
(CALVERT RD)

Form 6 HPS (Rev. 1961)

ROAD INVENTORY SHEET

MU 0430

Party Chief F. SETIAN
Recorder T. LANDON
Chainman

T. LANDON
VERIFIED
76

Road No. ~~MD 358-F~~
Name Somerset Ave
Sheet No. 2 OF 6
Date 8-18-65
County SOMERSET

CRISFIELD 413

MD
N.B.
RICHARDSON SPUR
SPUR
AVE LA.
091
090
088
MU 350
CO 139
086 MINDEN AVE
CO 140 MU 240
083 FRANKLIN LANE
STANDARD AVE 075
POTOMAC ST 065 EXIT END SCHOOL
059 BEG. ENT CRISFIELD HIGH SCHOOL
STERLING AVE.
MERCURY DR.
SCHOOL RD
058
CO 141
DENNIS LANE
056
COLUMBIA AVE 053

20'J LT
C-C
24'J RT
C-C
4'J MEDIUM
36'J
C-C
ON TAPER

SAME

FAS 13 77
MAJOR Collector

Form 6 HPS (Rev. 1961)

ROAD INVENTORY SHEET

Party Chief F. SETTLE
Recorder T. LANDON
Chainman

Road No. ~~MD 338 H~~ MD 0430
Name Somerset Ave.
Sheet No. 3 OF 6
Date 8-18-65
County SOMERSET

CRISFIELD

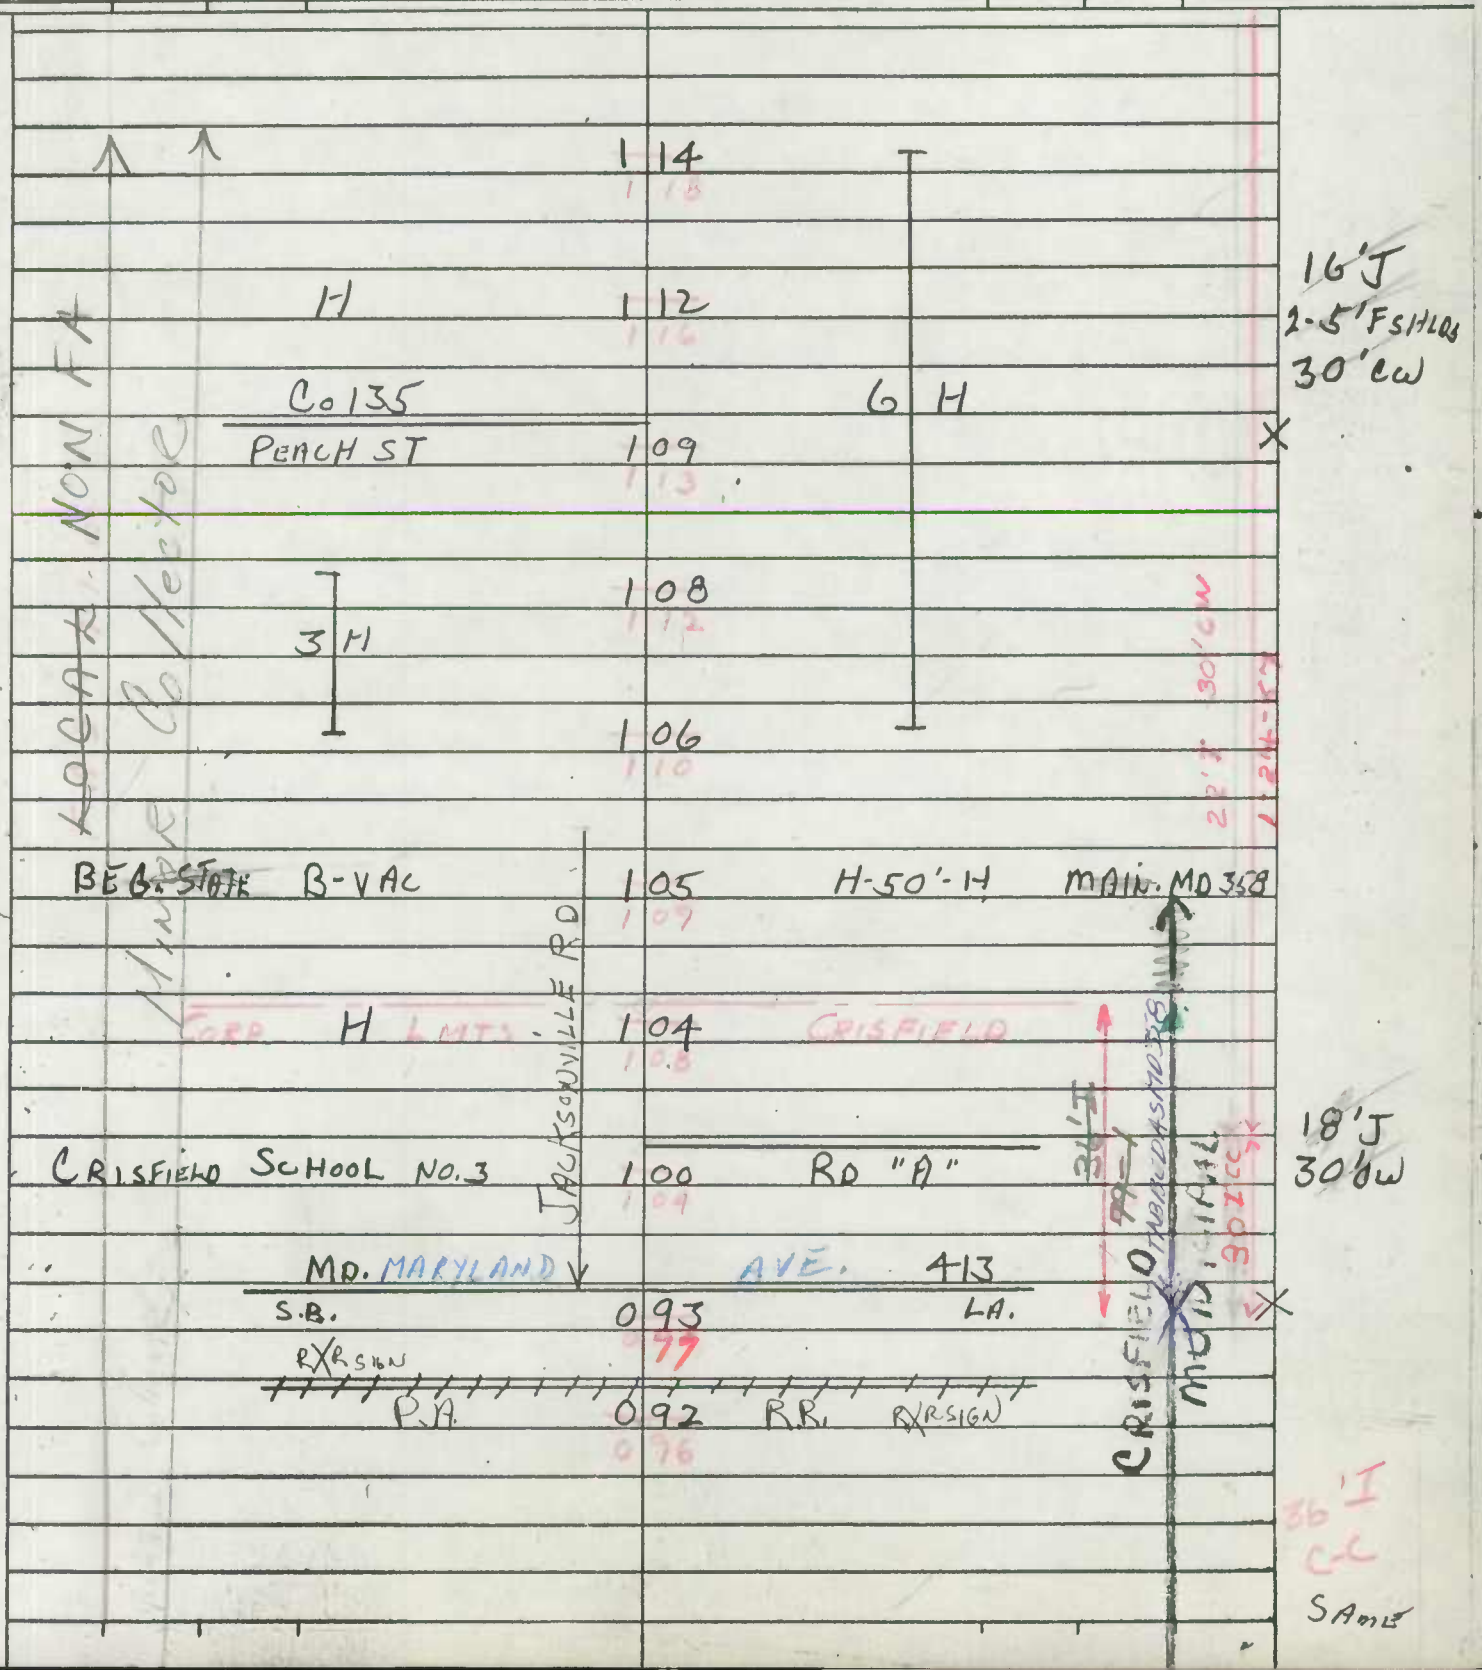

Form 6 HPS (Rev. 1961)

ROAD INVENTORY SHEET

Party Chief F. SUTTON
Recorder T. LANDON
Chainman

F. LANDON
F. THL
VERIFIED
12/30/66
CRISFIELD

Road No. 0470
Name (WELLINGTON RD)
Sheet No. 1 OF 1
Date 8-13-65
County SOMERSET
90-7 (c)

LITTLE ANNEMESSEX RIVER

ROAD END

0 35
0 32 H
4/H
0 29 CORP LMTS CRISFIELD ENT. TO TRAILER PARK 8 UNITS
0 25
0 16
PT
40°
PC
0 12
80-5
0 06 MUN END BOAT HARBOR
HARBOR
0 02 BEG BOAT HARBOR
MUN
0050
BRICK KILN 0 00 RD

I
16'
22'CW
15°
I
18'
22'E
40'CW

Form 6 HPS (Rev. 1961)

T. LANDON
F. RHODES

DT REV.
FR 3-12-79

ROAD INVENTORY SHEET

VERIFIED
12/29/76

Mu 0475
(WOODSON SCHOOL RD)

Party Chief F. SLETTEN
Recorder T. LANDON
Chairman

1133-54

T. LANDON
F. RHODES
REVISED 1-14-75

Road No. ~~80 145~~ 299
Name ~~CHERRY RD~~
Sheet No. 1 OF ~~2~~ 2
Date 7-22-65
County SOMERSET

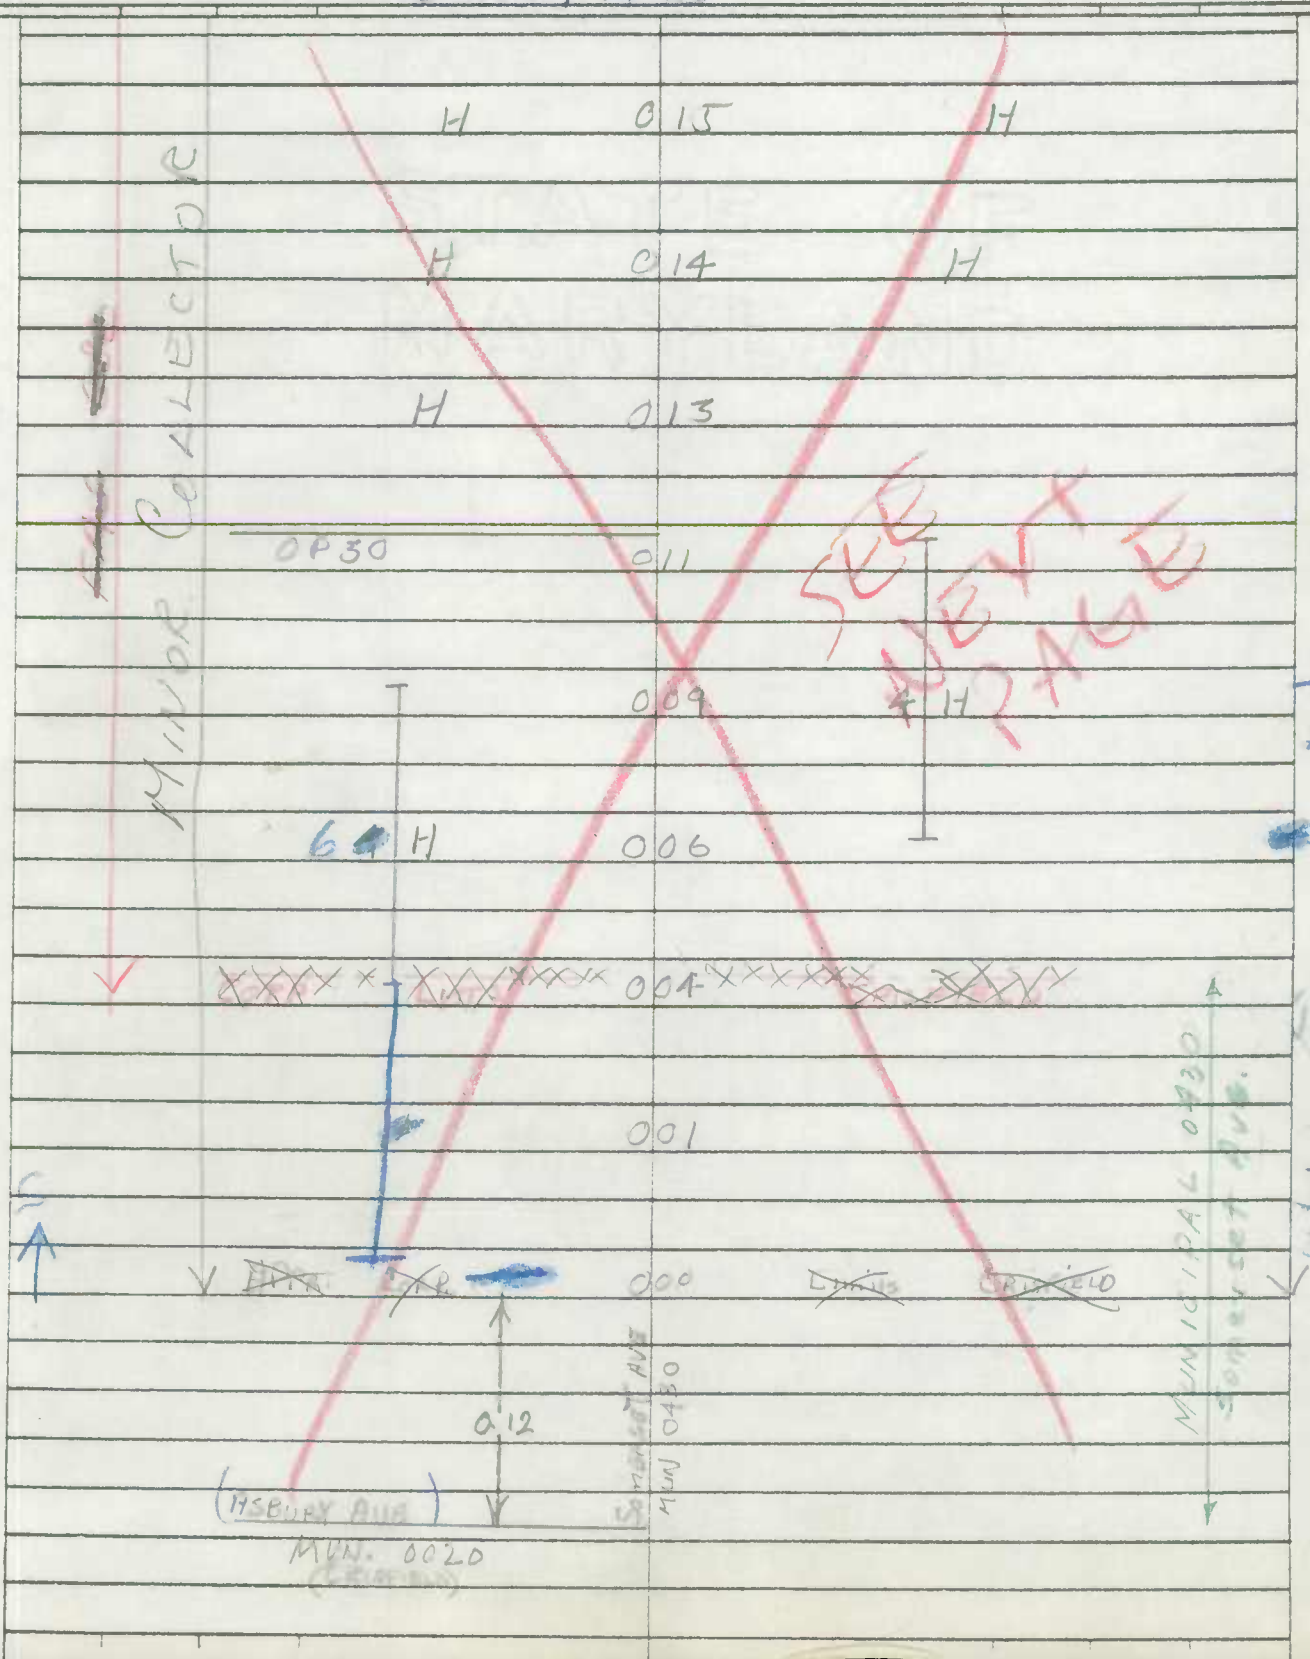

SHA 51.3-8
11-15-72

STATE HIGHWAY ADMINISTRATION OF MARYLAND

(92 MU EX 8) GD/A.HATTON 1/26/93 (92 47,48) GD 1/22/93 P589

ROAD INVENTORY SHEET

Party Chief DT
Recorder FR.
Helper

Map No. _____ 78-22+24

Road No. ~~CO.~~ MUN 0475 299
Road Name (WOODSON SCHOOL RD.)
Sheet No. ~~1~~ 1 OF 2
Date 3-12-79
County SOMERSET
State Coordinates

SEE NEW INV
FC/RI-95
7-12-95
GD/TM

(RR NORRIS HARBOR DR.) MUN 400

CHARLOTTE ST. MUN. 410

0 62 41

0 55 37

~~CORP LIMITS~~ ~~0 54 36 CRESTFIELD~~

0 52 34 20'I 28'CW

(CALVARY CO. RD.) 145

0 ~~40~~ 38 ENT. WOODSON MID. SCHOOL X 2ML

ST. 0 35 17

STERLING RD. 146

0 33 15 ENT WOODSON MID. SCHOOL 36'I 2-6"SHLD 50'CW

PT 50° PC 0 30 12 X 3ML

0 22 04 22'I 2-6"SHLD 40'CW

S. SOMERSET AVE (OLD CALVARY RD.)

0 18 00 MUN. 0375 X 2ML

SHA 51.3-8
11-15-72

ROAD INVENTORY SHEET

Road No. _____
Road Name _____
Sheet No. _____
Date _____
County _____
State Coordinates _____

Form 6 HPS (Rev. 1961)

N. FOURTH ST.

ROAD INVENTORY SHEET

Party Chief F. SLETTAN
Recorder T. LANDON
Chainman

VERIFIED 1/3/19

Road No. 9040
Name S. 4TH ST
Sheet No. 1 OF 2
Date 8-17-65
County SOMERSET

CRISFIELD

N. FOURTH ST

W. MAIN ST.

Mu 310

053 E. MAIN ST

Mu 70

BROADWAY 045

CHURCH 044

Mu 450

040 TYLER ST

Mu 330

035 MILES COURT

S. 4TH ST

Mu 160

029 COVE ST

N

Mu 400

R.R. NORRIS 000 HARBOR DR

30'
C-C

24'I
40'CW

1
000
2900
6 0

Form 6 HPS (Rev. 1961)

ROAD INVENTORY SHEET

Party Chief F. SETTAN
Recorder T. LANDON
Chainman

T. LANDON
J. HOGES
VERIFIED

9040
CRISFIELD 76

Road No.
Name N. 4TH ST
Sheet No. 2 OF 2
Date 8-17-65
County SOMERSET

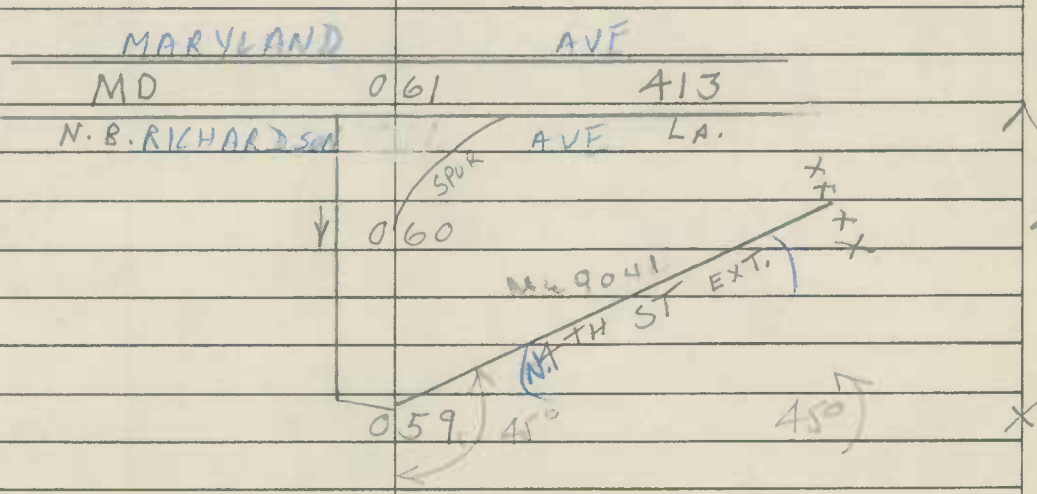

2-27'J
4'J MEDIUM
C-C

SAME

Form 6 HPS (Rev. 1961)

ROAD INVENTORY SHEET

Party Chief F. SUTTON
Recorder T. LANDON
Chainman

T. LANDON
I. HOGES
VERIFIED
1/3/78
CHRIS FIELD

Road No. 9060
Name (6TH ST)
Sheet No. 1 OF 1
Date 8-20-65
County SOMERSET
70-27

MW 70

BROADWAY S 97006

20'G
30'CW

W. MAIN

S 97000

S 7

N. B. RICHARDSON AVE.

MD

MARYLAND AVE

413

W. MAIN ST.

Form 6 HPS (Rev. 1961)

ROAD INVENTORY SHEET

(MD 918)

Party Chief F. SETTAN
Recorder T. LANDON
Chainman

Road No. ~~Co 31~~ 005
Name W
Sheet No.
Date 7
County S

Princess Anne

N BECKFORD AVE	782	010	
	780	008	
N. CHURCH	777	005	ST
MD		675	
N SOMERSET	772	000	AVE
	769		CHURCH
N. BEECHWOOD	767		ST
Upr. Corp. Lmts. P.A.	762	WPC 25' X 18' X 5°	
HALL	755		

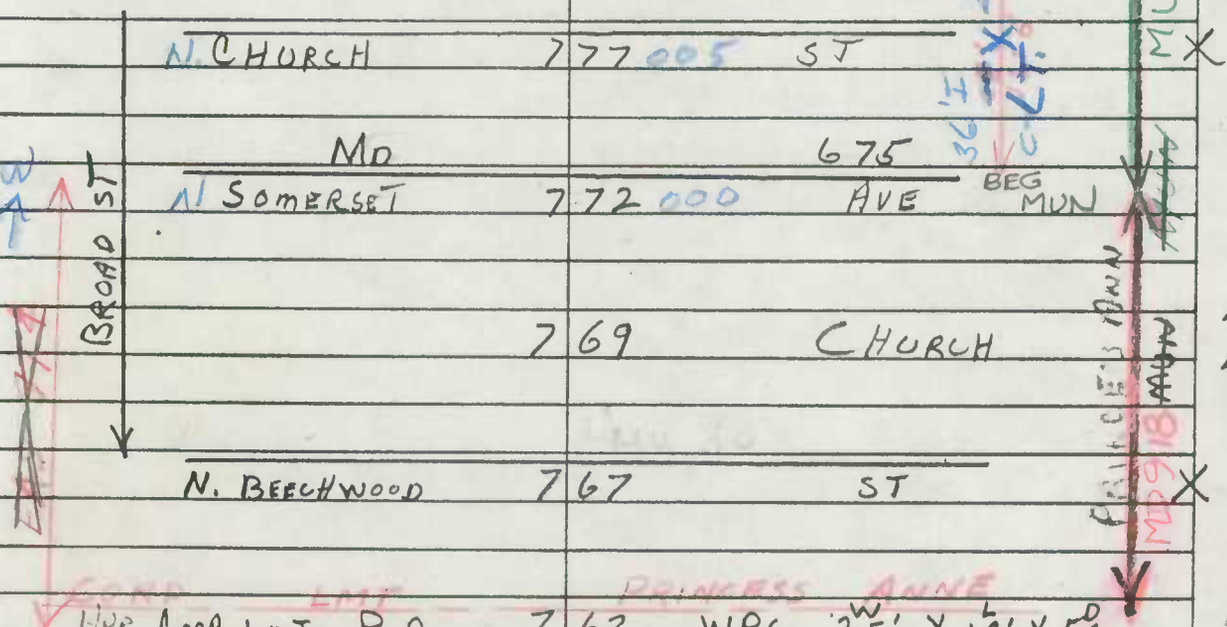

Form 6 HPS (Rev. 1961)

ROAD INVENTORY SHEET

(MD 918)

Party Chief F. SETTAN
Recorder T. LANDON
Chainman

Road No. ~~Co 31~~ 0050
Name W Broad St.
Sheet No. 8 OF 8
Date 7-1-65
County SOMERSET

N BECKFORD AVE	782	010	
	780	008	
N CHURCH	777	005	ST
MD			675
N SOMERSET	772	000	AVE
	769		CHURCH
N. BEECHWOOD	767		ST
Upr. Corp. Lmts. P. A.	762		WPC 25' X 18' X 5D
HALL	755		

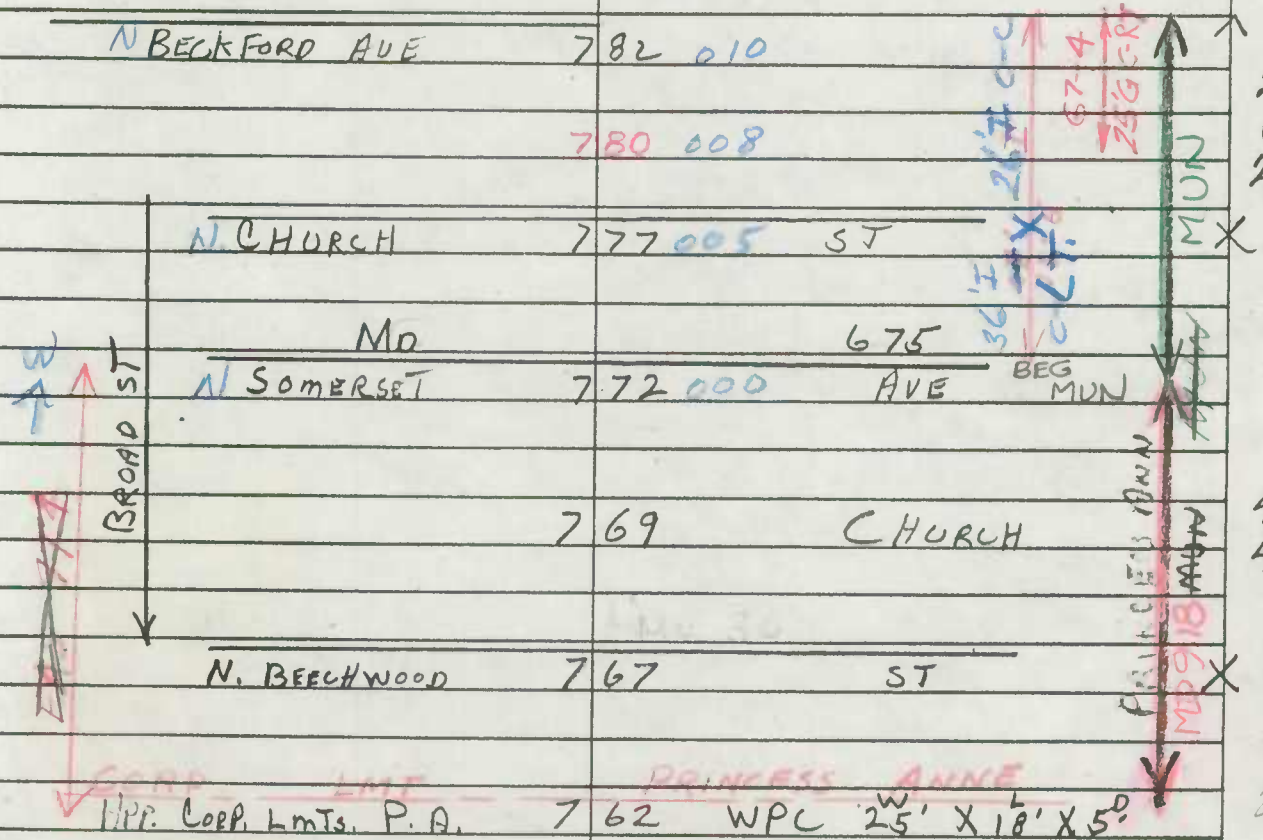

25'G
C-RT
28'CW

44'G
48'CW

17 G
24 CW

SAME

Form 6 HPS (Rev. 1961)

P584

ROAD INVENTORY SHEET

Party Chief F. SETIA T. LANDON
Recorder T. LANDEN F. [illegible]ES
Chainman

VERIFIED 12/21/76 PRINCESS ANNE

Road No. 0060
Name (CEMETERY LANE)
Sheet No. 1 OF 1
Date 7-23-65
County SOMERSET

SNI
97-4 B
60. MP
2/3/98

N. SOMERSET — AVE
MD 0.16 — 67.5
0.15 END CEM
0.12
0.08
0.03 BEG. CEM
CORP LMTS 0.00 PRINCESS ANNE
CO 231 (OLD LA)

20'F C-C
20'F C-C
67-8 MUN
~~18'F~~
~~C LT~~
~~22'CW~~
14'F 20'CW
14'F 20'CW

Form 6 HPS (Rev. 1961)

ROAD INVENTORY SHEET

Party Chief FISHER
Recorder T. LANDON
Chainman

VERIFIED 12/20/76 PRINCESS ANNE

Road No. 0110
Name ("F" AVE)
Sheet No. 1 OF 1
Date 9-24-75
County SOMERSET

CO359

O.P. SEC. ~~Co 91 40~~	008		
H	007	H	
H	006		
H	005		
CORP LMTS		PRINCESS ANNE	
~~2560~~	004	(PETERS AVE)	
		~~20~~	
S. BECKFORD	000	AVE	

(BRATTEN AVE)

14' D
18' CW

16' E
20' CW

W

Form 6 HPS (Rev. 1961)

ROAD INVENTORY SHEET

T. LANDON

Party Chief F. SETTIAN
Recorder T. LANDON
Chainman

F. [illegible]
VERIFIED
12/21/76
PRINCESS ANNE

Road No. 0130
Name W (FRONT ST)
Sheet No. 1 OF 1
Date 7-23-65
County SOMERSET

MH 30
011 N. BEECHWOOD ST

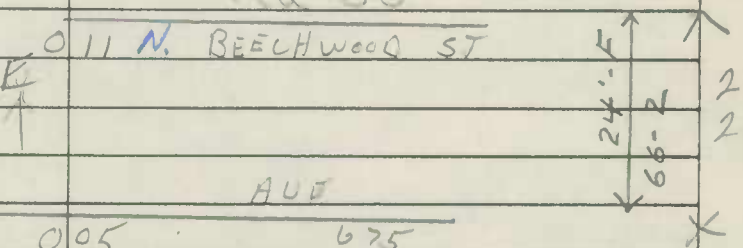

N. SOMERSET
MD

AUB
005 675

12'E
16'W

MH 70
000 N. CHURCH ST

Form 6 HPS (Rev. 1961)

MUN. No. 0150

ROAD INVENTORY SHEET

Party Chief F. SETTAN
Recorder T. LANDON
Chairman

T. LANDON
I. [illegible]
VERIFIED
12/20/76

BB REV FR 4-27-83 82-22

PRINCESS ANNE

Road No. Co 218
Name E. HAMPDEN AVE
Sheet No. 1 OF 2
Date 8-24-65
County SOMERSET

RX RR SIGN FLASHING RED LIGHTS		RR
PENNA	0 55	RX RR SIGN FLASHING RED LIGHTS 26'I JCC
		#RR 530 247 S
~~ABAN.~~ LAND AVE	0 53	
LAND AVE	0 52	
~~(LAND AVE)~~ ~~DASHIELL LA.~~		~~(LAND AVE)~~ ~~PVT.~~
~~Co 235 MUN.~~	0 46	
	0 40 MUN. 0360	
~~X X X X X X X~~	~~0 39~~	
CHURCH	0 34	
RUTGER ~~ANN~~ ST.		~~18'G~~ ~~22'G~~ ~~30'CW~~ 40'I JCC
Co 237	0 28	
15° MCCORMICK ~~ANTIOCH~~	0 19	SWAMP RD. AVE EXT.
CORP Co LMTS	0 14	PRINCESS 199 ANNE
W		
H	0 08	
H	0 03	16'G 22'CW
	0 00	
		MD

Form 6 HPS (Rev. 1961)

ROAD INVENTORY SHEET

Party Chief F. SETTMAN
Recorder T. LANDON
Chainman

Road No. Co 718
Name W. HAMPDEN AVE
Sheet No. 2 OF 2
Date 8-24-65
County SOMERSET

PRINCESS ANNE

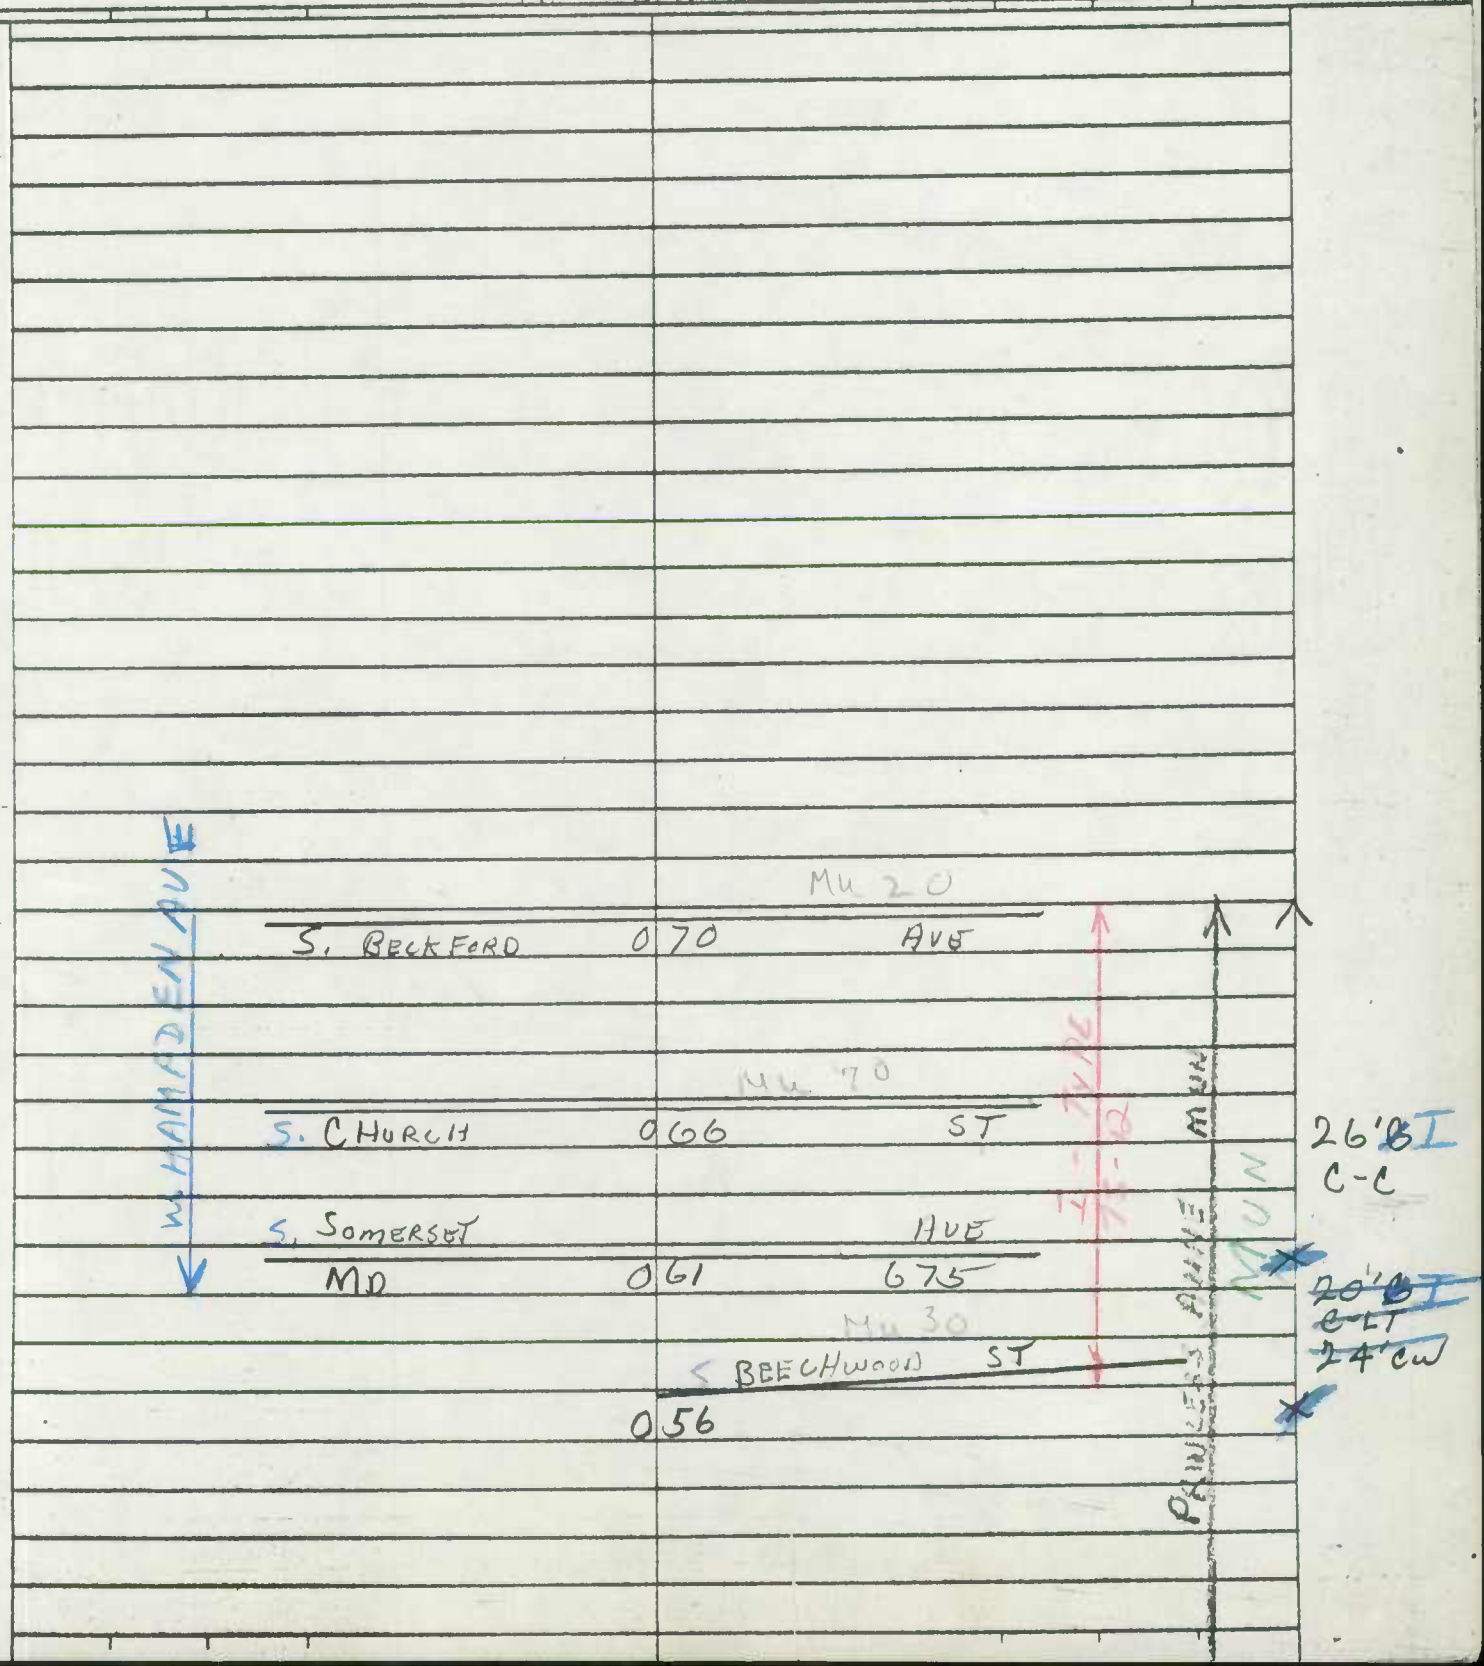

Form 6 HPS (Rev. 1961)

T. LAND
F. RHO
VERIFIED
12/13/76

ROAD INVENTORY SHEET

MD 0157 5-1689-4 87-16 A/T 11/19/90 CG/BB

(CHECKED ~~FOR~~)

Party Chief F. SETTLE
Recorder T. LANDON
Chainman

1175-143

Road No. ~~Co 42~~ RD)
Name (~~PET Food PLANT RD~~)
Sheet No. 1 OF 1
Date 7-6-65
County SOMERSET

PRINCESS ANNE

SEE NEW INV.
2/26/02
01-1 ST Ex #1

PENNA RR

ROAD END

20'

WATER TANK	028	
B. ~~PET Food~~ MODULAR HOMES	024	
~~Corp limits~~	015	~~PRINCESS ANNE~~
E	014	30'
~~Corp limits~~	012	~~PRINCESS ANNE~~
20°	007	24" CP
MD	000	675

20'F 34' 6-6

28'F 34'CW

Form 6 HPS (Rev. 1961)

ROAD INVENTORY SHEET

Party Chief F. SETTIN
Recorder T. LANDON
Chairman

Road No. 0180
Name LAND AVE
Sheet No. 1 OF 1
Date 8-24-65
County SOMERSET

PRINCESS ANNE

12/20/76
(ABAN.)

ROAD END

0.07

CORP LMTS 0.05 PRINCESS ANN

HAMPDEN AVE

~~Co~~ MG 0.00 150 2TB

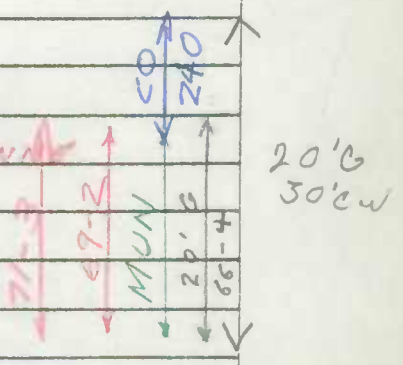

Form 6 HPS (Rev. 1961)

0180

Mun. No. ~~0080~~ (LANO AVE.)

ROAD INVENTORY SHEET

T. LANDON

Party Chief F. SETTAN
Recorder T. LANDON
Chairman

VERIFIED 12/20/76

Road No. Co 235
Name ~~DASHIELL LANE~~
Sheet No. 1 OF 1
Date 8-23-65
County SOMERSET

PRINCESS ANNE

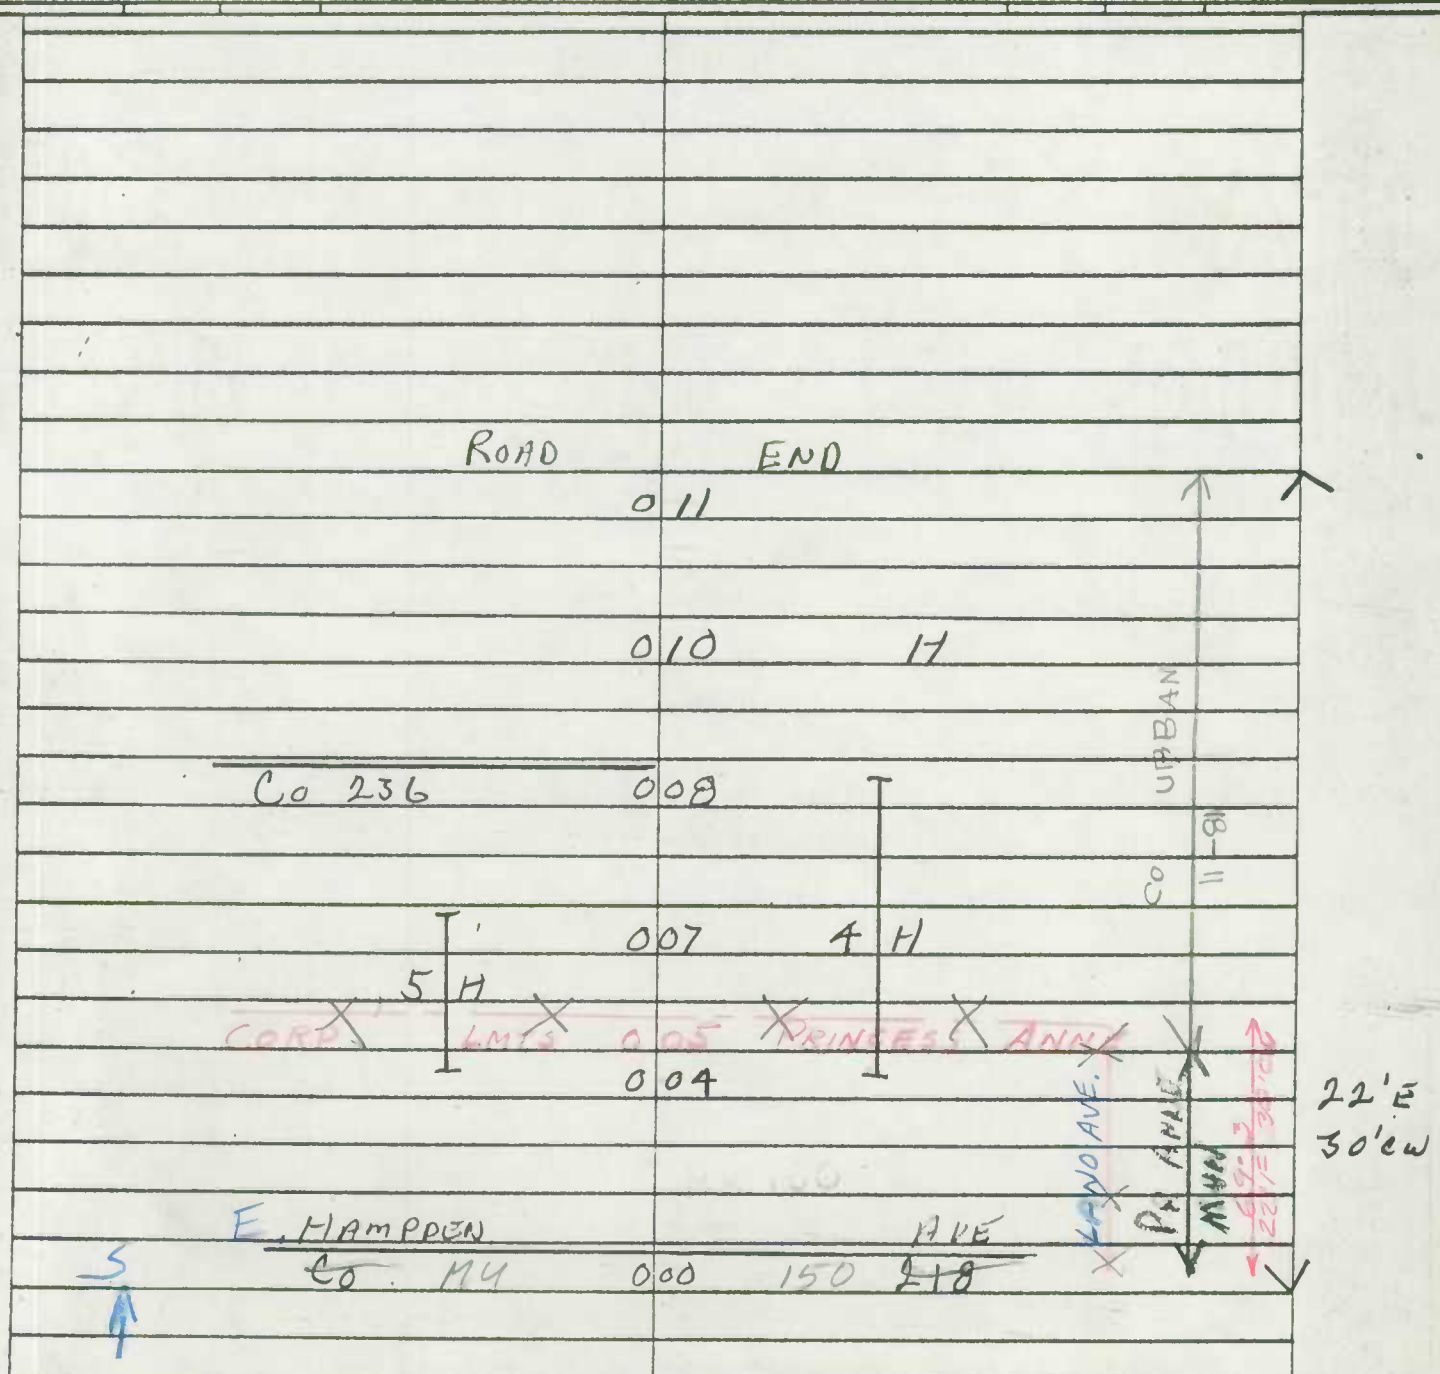

Form 6 HPS (Rev. 1961) PRINCESS ANNE

ROAD INVENTORY SHEET

Party Chief F. SETTAN
Recorder T. LANDEN
Chainman
REVISED G.R.G. 3/24/69

T. LANDON
F. [illegible]
VERIFIED
12/21/76

Road No. 0210
Name MANSION AVE
Sheet No. 1 of 1
Date 8-24-65
County SOMERSET

See New INV
Fc/RI-95
7-14-95
GD/TM

ROAD 013 END

33'6 I
C-C

MD 280
W. PRINCE WILLIAM ST 006 H TEACKLE MANSION

23'H
C-RT
25'cw

001 H

MD 200
(MANOKIN AVE) 000 MD 363

Form 6 HPS (Rev. 1961)

ROAD INVENTORY SHEET

Party Chief F. SETIAS T. LANDON
Recorder T. LANDON F. [illegible]
Chainman

VERIFIED 12/21/76 PRINCESS ANNE

Road No. 0220
Name MAPLE ST
Sheet No. 1 OF 1
Date 7-23-65
County SOMERSET

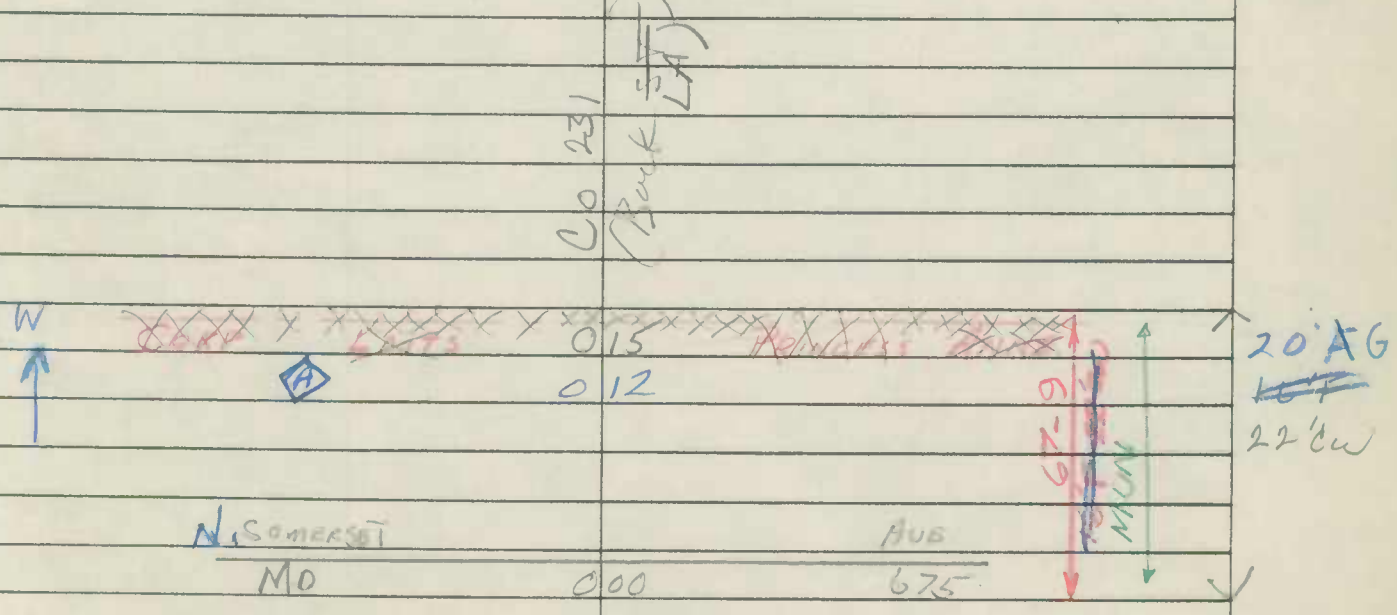

Form 6 HPS (Rev. 1961)

ROAD INVENTORY SHEET

Mun. No. 0240
(E. Antioch Ave Ext.)

91-4
AL-JK
1-29-92

Party Chief F. GETTIAN
Recorder TILANDON
Chainman

TL VER.
FR. 12/20/96
82-1

OBREV
FR 4-21-83

Road No. Co 199
Name ~~McCormick Swamp Rd~~
Sheet No. 1 OF 3
Date 8-12-65
County SOMERSET

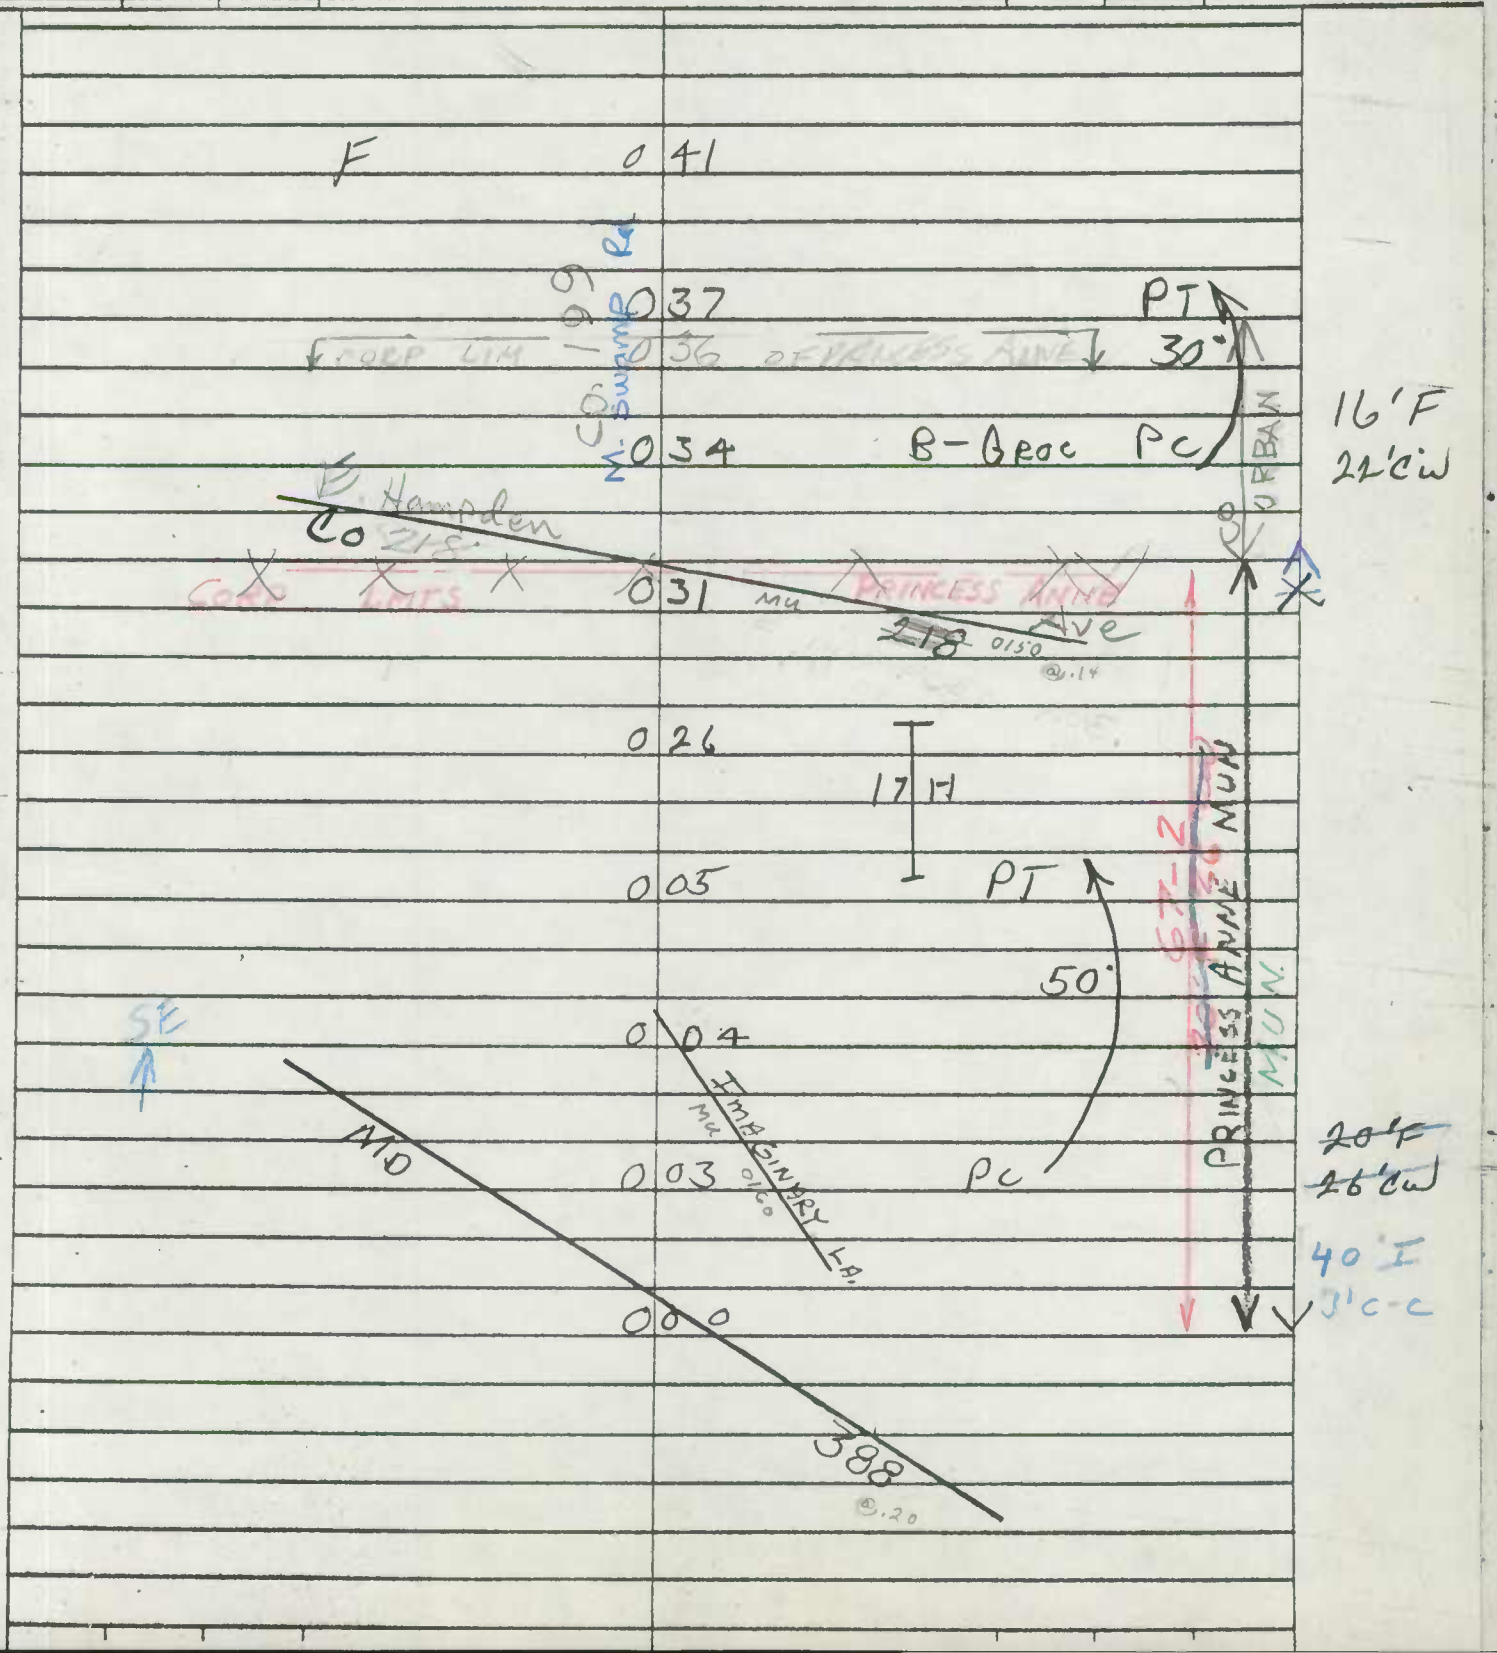

SHA 51.3 - 8 Revised 4.83

MARYLAND STATE HIGHWAY ADMINISTRATION

ROAD INVENTORY SHEET MU 0252

Party Chief C.G
Recorder L.W
Assistant ~
Map No./Dir. K16 / N
State Coordinates 1177-133

Road No. ~~MD 598~~
Road Name OLD PRINCESS ANNE ~~WESTOVER~~ RD.
County Somerset
Date 7-19-89
Sheet No. 1 OF 1

PRINCESS ANNE

SYSTEM: FED. AID. | FUNCT CLASS. | HWY. SYS. | HPMS SAMPLE
TRAFFIC: PRKG. REST. | COM/IND. ACCESS

LINE DIAGRAM

~~RELOCATED~~
SEE INV.
CO 86
FSRI-95
GD/TM
4-22-95

ABANDONED

OLD PRINCESS ANNE RD. CO 86 @ 5.20
SOMERSET CONRAIL
MD 675 @ 0.05
CR 530 24-84
0.01 MILES
PARK DR.
WESTOVER
0.00
0.04
0.01
R.I.T.
R.I.T.

TRAFFIC: CONTROL | COM/IND. ACCESS | PRKG. REST.
SS
FR E

PAVEMENT DATA
20'I
2 ML

TRAFFIC CODES
TRAFFIC CONTROLS: STOP SIGN=SS, TRAFFIC LIGHT=T.L., FLASHING RED BALL=F.R.

TRAFFIC CODES
PARKING RESTRICTIONS: A.M. PEAK, P.M. PEAK, A.M./P.M. PEAK, NO PARKING ANYTIME=N.P., COMM/IND. ACCESS=E

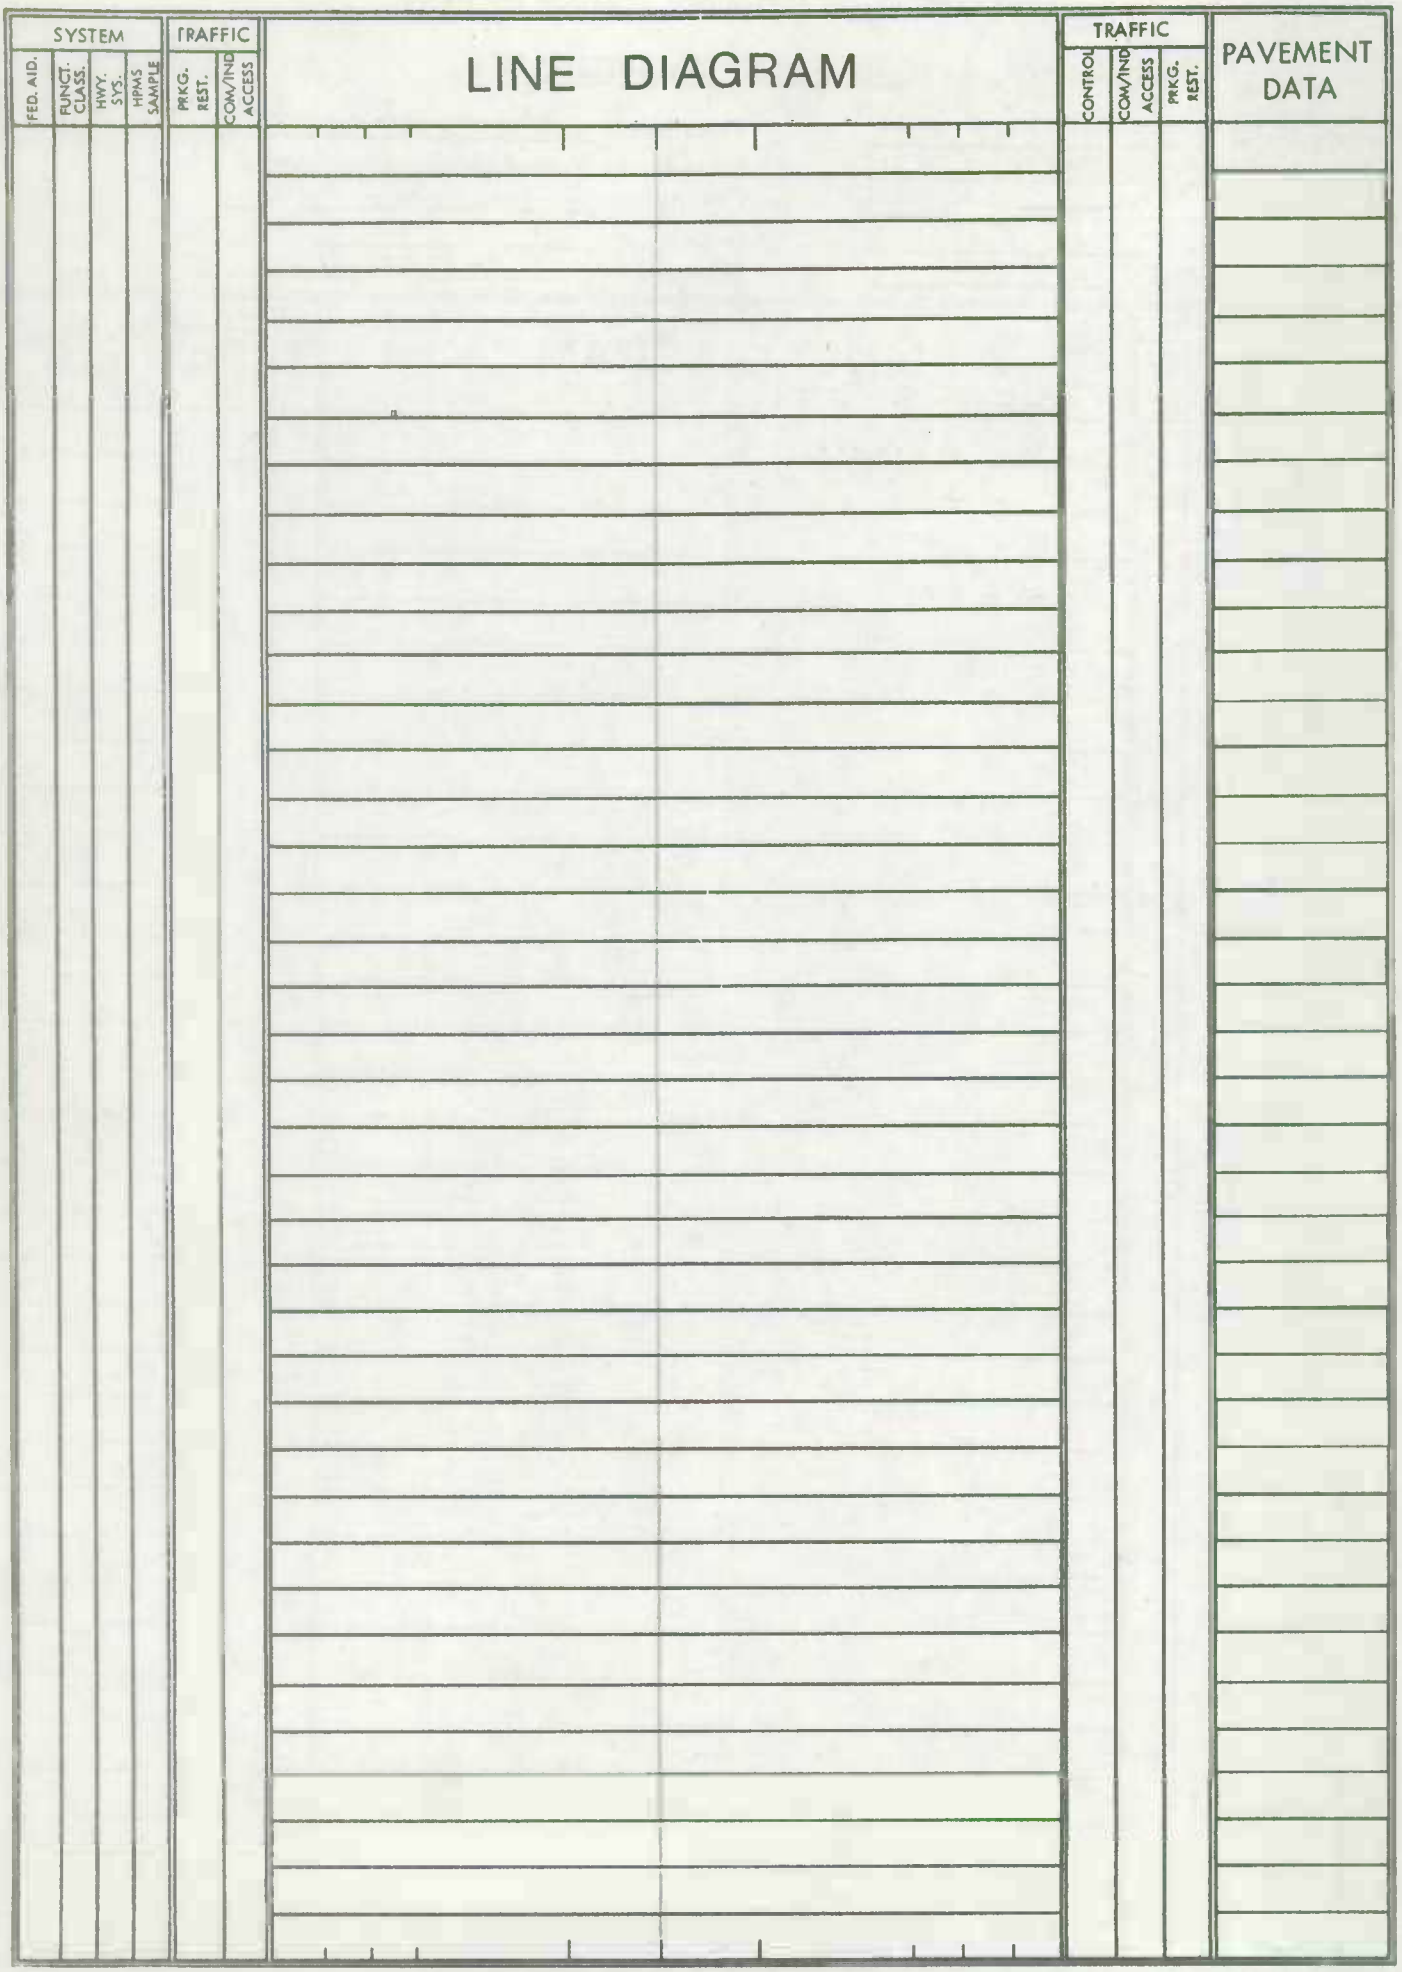
SYSTEM
FED. AID.
FUNCT. CLASS.
HWY. SYS.
HPMS SAMPLE
TRAFFIC
PRKG. REST.
COM/IND ACCESS
LINE DIAGRAM
TRAFFIC
CONTROL
COM/IND ACCESS
PRKG. REST.
PAVEMENT DATA

SHA 51.3 - 8 Revised 4.83

MARYLAND STATE HIGHWAY ADMINISTRATION

SR-95 EX.2 P587
6-22-95
GD/TM

ROAD INVENTORY SHEET

Party Chief BB
Recorder AL
Assistant
Map No./Dir. 1 SW
State Coordinates

Road No. MUN. 0253
Road Name PARK DR (85-1)
County SOMERSET
Date 1-22-86
Sheet No. 1 OF 1

TRAFFIC CODES
TRAFFIC CONTROLS: STOP SIGN=SS, TRAFFIC LIGHT=T.L., FLASHING RED BALL=F.R.

TRAFFIC CODES
PARKING RESTRICTIONS: A.M. PEAK, P.M. PEAK, A.M./P.M. PEAK, NO PARKING ANYTIME=N.P., COMM/IND. ACCESS=E

SYSTEM				TRAFFIC		LINE DIAGRAM	TRAFFIC			PAVEMENT DATA
FED. AID.	FUNCT CLASS.	HWY. SYS.	HPMS SAMPLE	PRKG. REST.	COM/IND. ACCESS		CONTROL	COM/IND. ACCESS	PRKG. REST.	
						Old Princess Anne Rd SC				
						OLD PRINCESS ANNE RD CO. SC 0 91 ~~WESTOVER RD~~ SC	SS	E		
						0 65 PT 30° PC				
						0 61				
						PROGRESS LA. MU 0180 0 52 ~~OP~~				
						PT 50° PC 0 11 0 07				29'I J-CC 2 ML
						Corp Limits of Princess Anne McCORMICK CO. SWAMP RD. 0 00 199				

SYSTEM				TRAFFIC		LINE DIAGRAM	TRAFFIC			PAVEMENT DATA
FED. AID.	FUNCT. CLASS.	HWY. SYS.	HPMS SAMPLE	PRK'G. REST.	COM/IND ACCESS		CONTROL	COM/IND ACCESS	PRK'G. REST.	

Form 6 HPS (Rev. 1961)

ROAD INVENTORY SHEET

Party Chief F. SETTAN
Recorder T. LANDON
Chainman
Revised GRG 3/24/69

T. LANDON
F. HOUES
VERIFIED
76

Road No. 0280
Name PRINCE WILLIAM ST.
Sheet No. 1 of 2
Date 7-13-65
County SOMERSET

Princess Anne

10-24-80

			H	18	48	H
				18	47	H
			H	18	46	008 CHURCH
1374	RURAL MAJOR Collector	PRINCE WILLIAM ST	MUN N. BECKFORD AVE	18	45	007 30 ~~AVE~~ S. BECKFORD AVE. H
			H	18	44	H
			H	18	42	H
			H	18	40	H
				000 18	38	MUN 210 MANSION ST 90° H
FAS		MANSION ST		18	33	H
			90° MANOKIN AVE	18	32	BEG MUN. ST.

30'H
35'cw

23'H
C-RT
25'cw

MD 363

ROAD INVENTORY SHEET

Mun. No. 0280

E. PR. WILLIAM ST.

Party Chief F. Sattan
Recorder T. Landon
Chainman

T. LANDON
VERIFIED
76

Road No. Md. 363
Name W. Pr. William St.
Sheet No. ~~2 of 2~~ 2 of 2
Date 7-13-65
County Somerset

| | | |

PS81

SHA 51.3 - 8 Revised
4.83

MARYLAND STATE HIGHWAY ADMINISTRATION

ROAD INVENTORY SHEET

Party Chief F.S. Tom
Recorder T. LANDON
Assistant Revision 10-24-86 - KSP
Map No./Dir. 1 E
State Coordinates

Princess Anne
Road No. MUN. 0280
Road Name PRINCE WILLIAM ST. (E+W)
County SOMERSET
Date 7-13-65
Sheet No. 1 OF 1

TRAFFIC CODES: STOP SIGN=SS, TRAFFIC LIGHT=T.L., FLASHING RED BALL=F.R.

PARKING RESTRICTIONS: A.M. PEAK, P.M. PEAK, A.M./P.M. PEAK, NO PARKING ANYTIME=N.P., COMM/IND. ACCESS=E

SYSTEM FED. AID.	SYSTEM FUNCT CLASS.	SYSTEM HWY. SYS.	SYSTEM HPMS SAMPLE	TRAFFIC PRKG. REST.	TRAFFIC COM/IND. ACCESS	LINE DIAGRAM	TRAFFIC CONTROL	TRAFFIC COM/IND. ACCESS	TRAFFIC PRKG. REST.	PAVEMENT DATA
						See New INV				
						FC/RI-95 7-14-95 GDL/TM				
						N. Beechwood ST. — S. Beechwood ST.				
						MUN 0 22 0030				
						Public Library 0 21				
						N. Somerset ST. — S. Somerset ST. E. Prince William ST.				
						MD 0 16 675				
						County Courthouse 0 14				
						Board of Education 0 12				51' I
						N. Church ST. — S. Church ST.				I-"C-C"
						MUN. 0 11 0070				
						008 Church ST.		E		
						N. BECKFORD AVE. — S. BECKFORD AVE.				
						MUN. 0 07 0020 W. Prince William ST.				30' I
										35' CW
						MANSION ST.				
						MUN 0 00 210				
					E					
					E					

SYSTEM				TRAFFIC		LINE DIAGRAM	TRAFFIC			PAVEMENT DATA
FED. AID.	FUNCT. CLASS.	HWY. SYS.	HPMS SAMPLE	PRK.G. REST.	COM/IND ACCESS		CONTROL	COM/IND ACCESS	PRK.G. REST.	

Form 6 HPS (Rev. 1961)

MUN. No. 0300

ROAD INVENTORY SHEET

Party Chief F. SETTAN
Recorder T. LANDON
Chainman

T. LANDON
F. HOGES
VERIFIED
Z6

Road No. Co 237
Name RUTGER ~~LANE~~ ST
Sheet No. 1 OF 1
Date 8-23-65
County SOMERSET

PRINCESS ANNE

E. HAMPDEN

~~Co~~ MU	~~005~~ 005	150 ~~L~~ 18	AVE
	004	H	
CORP LMTS	001	PRINCESS H	ANNE
Co	000	236	

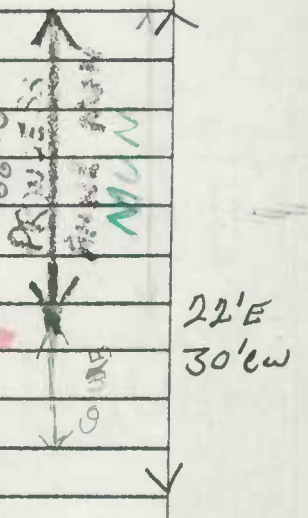

CO 237

Form 6 HPS (Rev. 1961)

ROAD INVENTORY SHEET

Party Chief F. SETTAN T. LANDON
Recorder T. LANDON T. JONES
Chainman

VERIFIED 12/21/76 PRINCESS ANNE

Road No. 0310
Name (SCHOOL DRIVE WAY)
Sheet No. 1 OF 1
Date 7-23-65
County SOMERSET

NOT MAINT. BY MUN.

→ MD 363

N. SOMERSET AVE
MD 010 675

009 PT

180°

005 WASHINGTON HIGH SCHOOL

001 PC

15'G
C-C

W
N SOMERSET AVE
MD 000 675

→ MD 362

PS87

Form 6 HPS (Rev. 1961)

W. WILLIAM ST.

ROAD INVENTORY SHEET

T. LANDON

Party Chief F SETTAN
Recorder T. LANDON
Chainman

VERIFIED 12/20/76 PRINCESS ANNE

Road No. 0350 CO. 242
Name WILLIAM ST
Sheet No. 1 OF 1
Date 7-23-65
County SOMERSET

ANNA-TANEY AVE

LINDEN AVE 026 Co 230 WHART RD AVE — 18'I 24'CW

CORP LMTS 020 90° ELE. SCHOOL — 26'CI 26'CW

S. BECKFORD MUN 015 30 AVE — 25'CI C-C

W. WILLIAM ST

S. CHURCH MUN 010 70 ST

MUN

S SOMERSET MD 008 675 AVE — 20'I 24'CW

S. BEECHWOOD MUN 008 30 ST — 24'I C-C

W

Form 6 HPS (Rev. 1961)

1172-141

ROAD INVENTORY SHEET

T. LANDON
F. RHODES
VERIFIED 12/13/76

PARTY CHIEF Frederick Settan
RECORDER Thomas Landon
CHAINMAN

ROAD NO. Co 38
NAME CRISFIELD LA.
SHEET NO. 1 OF 1
DATE 1-24-67
COUNTY SOMERSET
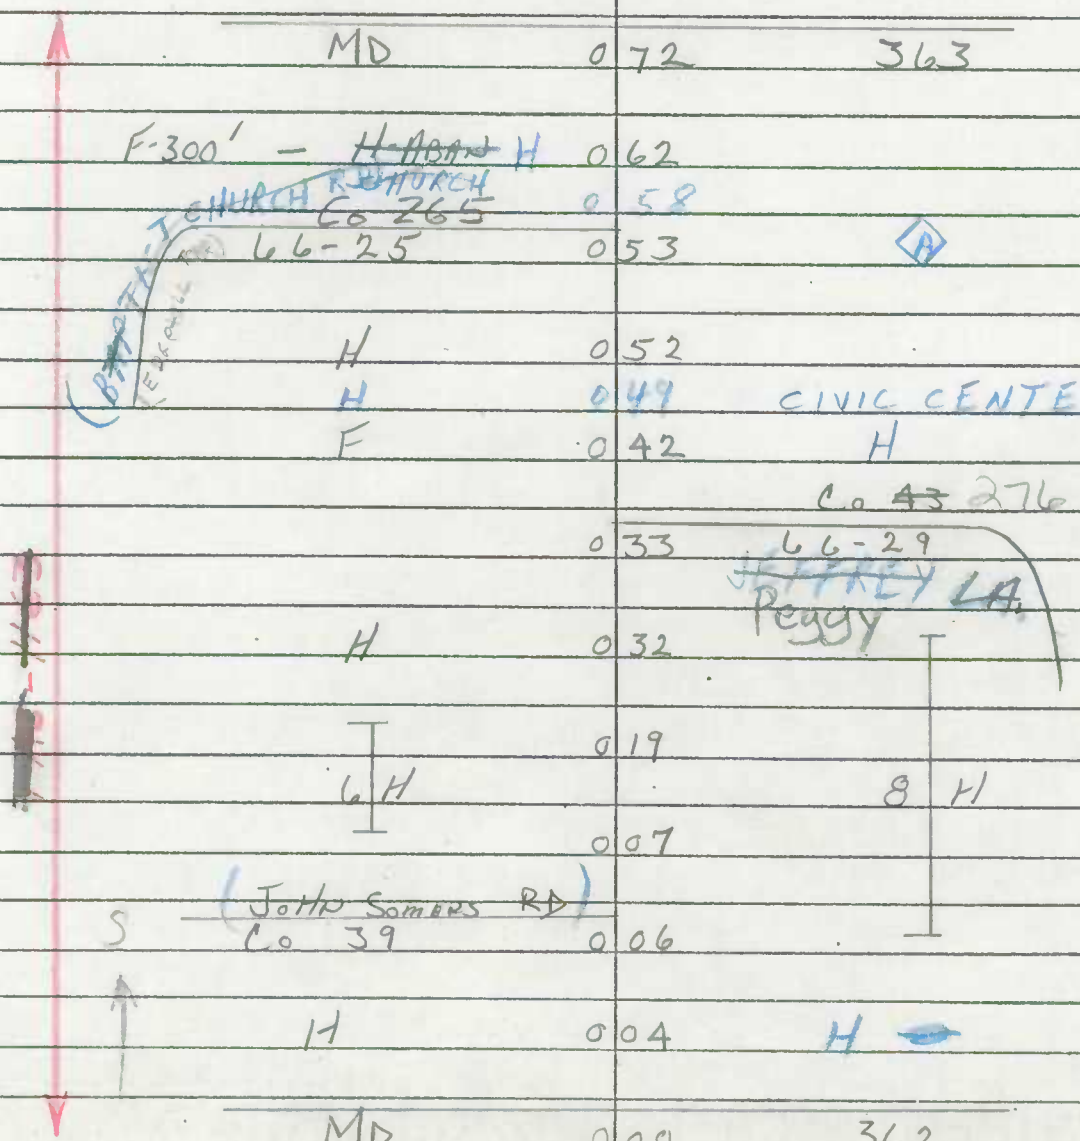
PRINCESS ANNE