Form 6 HPS (Rev. 1961)

TL VER.
F.R 5/11/77

ROAD INVENTORY SHEET

Party Chief F. SETTAN
Recorder T. LANDON
Chainman

Road No. 0010
Name "A" Rd.
Sheet No. 1 OF 1
Date 7-12-66
County TALBOT

EASTON

ABAN.

Easton

ROAD 0006 END

XXXXXX

E

ST.

15'6
20'(+)

0000

N. AURORA

Form 6 HPS (Rev. 1961)

TL VER.
F.R 5/11/77

ROAD INVENTORY SHEET

Party Chief F. SETTAN
Recorder T. LANDON
Chainman

Road No. 0010
Name "A" Rd.
Sheet No. 1 OF 1
Date 7-12-66
County TALBOT

EASTON

ABAN.

XXXXXX
ROAD 000 END

E

15'6
20'+/-

ST.

000

N. AURORA

SHA 51.3-8
11-15-72

STATE HIGHWAY ADMINISTRATION OF MARYLAND

10-5-77 meeting with Mr. VandeVisser, Wilson Toll, Dave Applebach, Ed Dawn, it was decided that this rd should be OP. The county has no proof of ownership.

ROAD INVENTORY SHEET 0025

Party Chief T. LANDON
Recorder F. RHODES
Helper

Map No. G21 81-1
G15

Road No. ~~CO. 308~~ OP153
Road Name (Airpark Dr.)
Sheet No. 1 OF 1
Date 6/16/77
County TALBOT
State Coordinates 1067-352

BB 84-1
RM 1-25-85

FASTON

SEE NET IN INV

92-1 ST
GD AH
2-5-93

W

B ROAD 016 END
(GLEBE PARK DR.
~~YELLOW BRICK RD.~~)
~~CO. 309~~ OP T54 MD 0408
0 11

B 007 B
(~~RD~~ RD.)
188

CENTREVILLE
5 000
OLD TOWN
3.C

0025
1-18

36'H
20'E
40'CW

36'I
24'F
30'CW
JC-C

SHA 51.3-8
11-15-72

ROAD INVENTORY SHEET

Road No. _____
Road Name _____
Sheet No. _____
Date _____
County _____
State Coordinates _____

HA 51.3-8
1-15-72

STATE HIGHWAY ADMINISTRATION OF MARYLAND

10-5-77 Meeting with Mr. VandeVisser, Wilson Tull, Dave Bachiero, Bob Burn. It was decided that this rd should be OP. The County has no proof of ownership

ROAD INVENTORY SHEET ~~0025~~

Party Chief T. LANDON
Recorder F. RHODES
Helper
Map No. G21

Road No. ~~CO. 308~~ OP 153
Road Name (Airport Dr.)
Sheet No. 1 OF 1
Date 6/16/77
County TALBOT
State Coordinates 1067-352

MUN 0025

EASTON

B ROAD 016 END
(CLERE PARK DR.
(YELLOW BRICK RD.)
CO. 309
OF 154

B 007 B
RD.)
188

OP 153

0025

30' F
40' CW
36' I
24' F
30' CW
2' C-C

S 000
(JONES
CO.

Form 6 HPS (Rev. 1961)

ROAD INVENTORY SHEET

T. LANDON
F. RHODES
VERIFIED
77

Party Chief F. SETTAN
Recorder T. LANDON
Chainman

615

Road No. 0080
Name S. AURORA ST
Sheet No. 2 OF 3
Date 7-6-66
County TALBOT

MU 700 EASTON

88-17

		MELFIELD AVE	112		
				MU 0302	
			108	EARLE AVE #2	
		MU 760			
		NEEDWOOD AVE	106		
				MU 9050	
			104	(MASON ALLEY)	
		MU 1130			
		WINTON AVE	100		40'H
				MU 150	C-C
			094	(BROOK LANE)	X
				MU 0160	
		BROOKLEA	091	AVE	
		MU		1020	37'I
		POWERS	087	LANE)	C-C
		MU		0980	
		TALBOT	084	ST	X
		MU		0922	
		SOUTH	077	ST #2	34.5'I
		MU		0910	C-C
	X	SOUTH	072	← LANE	X 30'I
		MU		0280	C-C
		DOVER	066	ST	X
S		MU ←		0060 ←	
		(HUGUST	060	ST)	40'I
					C-C
		~~MD~~ MUN.		0430	
	X	(GOLDSBOROUGH	054	ST	X
					SAME

FAU 7605 MINOR ARTERIAL AURORA ST URBAN

Form 6 HPS (Rev. 1961)

ROAD INVENTORY SHEET

T. LANDON
F. RHODES
VERIFIED
77

Party Chief F. SETTON
Recorder T. LANDON
Chainman

Road No. 0080
Name S. AURORA ST
Sheet No. 3 OF 3
Date 7-6-66
County TALBOT

EASTON

MU 0750
(MYRTLE LANE) 172
MU 0610
LINDEN AVE 167
MU 480
(HICKORY LANE) 164
DUTCHMANS LANE
TO MU 160 293
156
140
MU 0540
IDLEWILD AVE 132
MU 9160
(WARRINGTON ALLEY) 128
MU 0950
STEWART ST 125
MU 0940
(STATION LANE) 119
MU 0660
MARYLAND AVE 115

FAIRGROUND ARTERIAL
NONCULVERT URBAN
MINOR

34'H C-LT
34'H C-C
30'I C-C
30'I C-LT
SAME

SHA 51.3-8
11-15-72

STATE HIGHWAY ADMINISTRATION OF MARYLAND

TL VER. FR 5/17/77

ROAD INVENTORY SHEET

Party Chief T. LANDON
Recorder F. RHODES
Helper _____

Map No. _____

Road No. ~~OP~~ ~~103~~ 0085
Road Name (BAINBRIDGE PL.)
Sheet No. 1 OF 1
Date 1/13/76
County TALBOT
State Coordinates 1166-337

TRANS. - 77-13 IN EASTON

ELWOOD AVE.		
MUN ~~MUN~~ ~~OP 48~~	0009 ~~TRON~~	0350
		36' I
		1"c-c
MECKLENBURG AVE.		
MUN.	0000	0680

W

Form 6 HPS (Rev. 1961)

ROAD INVENTORY SHEET

Mun. No. 0170 ↓ BROOKWOOD AVE

T. LANDON
F. RHODES
VERIFIED
5/16/77

Party Chief F. SETTIHN
Recorder T. LANDON
Chairman

Road No. 0100
Name BIBBY ST
Sheet No. 1 OF 1
Date 7-11-66
County TALBOT

EASTON

91-13 A/T 93-24

CUL DE SAC

0 32 H

0 21

0 17

MUN 1150
NYE AVE 0 14

PENNSFIELD LA.
MUN. 0820 0 11

MUN 22
ADKINS LANE AVE. 0 08

MUN 1110
0 07 S. WEST ST

PKG. LOT 0 02 LANE

S. WASHINGTON ST
MD 0 00 56.5A

BROOKWOOD AVE
90°
0170

30'I
C-C

22'I
C-C

Form 6 HPS (Rev. 1961)

ROAD INVENTORY SHEET

Party Chief F. SETTAN
Recorder T. LANDON
Chainman

T. LANDON
T. CHOUES
VERIFIED
5/16/77
EASTON

Road No. 0160
Name BROOKLETTS AVE
Sheet No. 10F2
Date 7-7-66
County TALBOT

95-33 80-8

			MUN		450		
		S. HANSON	045		ST		
			MUN		90		
		S AURORA	037		ST		
		mu 9100			SEE NEW INV		
N		(POPLAR ALLEY)	034		6D AH		
					FCR-95		
		MUN 0250			4-10-95		
		DAVIS AVE	031				
U							
R		mu			0490		
S		S HIGGINS	028		ST		
A		1 TRACK 2 REPEATERS	019				39'I
		MUN 0312			ATC 509 9886		C-C
F		EAST AVE #2	018		MDDE RXR sign		
		MUN		570			
C			013		KEMPSLANE		
O							39'J
N			MUN		000		C-C
V			009		PARK ST		
E					130		
C			MUN		LANE		
T			BOUNDARY				
O			007		15°J		
R							40'~~J~~I
		MUN.		1020			C-C
		TRED AVON	000		AVE		

Form 6 HPS (Rev. 1961)

4

ROAD INVENTORY SHEET

Party Chief F. SETTIN
Recorder T. LANDON
Chainman

T. LANDON
F. RHODES
VERIFIED
77

Road No. 0160
Name BROOKLYN AVE
Sheet No. 2 OF 2
Date 7-7-66
County TALBOT

EASTON

SHA 51.3 - 8 Revised
4.83

MARYLAND STATE HIGHWAY ADMINISTRATION

ROAD INVENTORY SHEET OP 239

89-1

Party Chief BB
Recorder BB
Assistant
Map No./Dir. 1 S
State Coordinates EASTON

Road No. MU 0165
Road Name BROOKS DR.
County TALBOT
Date 2/2/90
Sheet No. 1 OF 1

SYSTEM: FED. AID. | FUNCT CLASS | HWY. SYS. | HPMS SAMPLE
TRAFFIC: PRKG. REST. | COM/IND. ACCESS

LINE DIAGRAM

TRAFFIC: CONTROL | COM/IND. ACCESS | PRKG. REST.

PAVEMENT DATA

TRAFFIC CODES
TRAFFIC CONTROLS: STOP SIGN=S.S., TRAFFIC LIGHT=T.L., FLASHING RED BALL=F.R.

TRAFFIC CODES
PARKING RESTRICTIONS: A.M. PEAK, P.M. PEAK, A.M./P.M. PEAK, NO PARKING ANYTIME=N.P., COMM/IND. ACCESS=E

D-E
239 OP
COL 0 37 SHC
F/A LOCAL
NON RURAL
E
0 27
GLEBE Rd
CO. 000 37
36'I
JC-C

SYSTEM				TRAFFIC		LINE DIAGRAM	TRAFFIC			PAVEMENT DATA
FED. AID.	FUNCT. CLASS.	HWY. SYS.	HPMS SAMPLE	PRKG. REST.	COM/IND ACCESS		CONTROL	COM/IND ACCESS	PRKG. REST.	

ROAD INVENTORY SHEET

Party Chief F SETTAN
Recorder T LANDON
Chainman
REVISED BY
GRG 3-13-68

T. LANDON
F. RHODES
VERIFIED
5/16/77

Road No. 0170
Name BROOKWOOD AVE
Sheet No. 1 of 1
Date 7-11-66
County TALBOT

EASTON

91-12 A/T

~~ROAD~~ D E END

H CUL 0 18 SA C

0 07

W

20°

0 03

WYE AVE
Mod. 1150

0 00

BIERLY

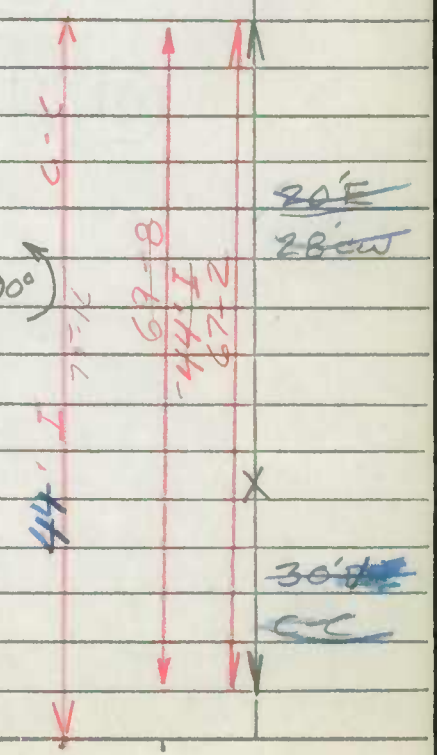

Form 6 HPS (Rev. 1961)

1067-346

ROAD INVENTORY SHEET

MUN 0190

Party Chief F. Setfan
Recorder T. Landen
Chainman

TL VER. FR. 5/13/77

Road No. ~~OP 90~~
Name Calvert ~~Terrace~~ ST.
Sheet No. 1 of 1
Date 7-12-66
County Talbot

Easton 1970 ANNEX

Road		End		
DOVE LA. MUN. 0275	0 31	H		
	0 23			
LOMAX		~~LOMAX~~ ST		24'D
MUN 0625	0 20	~~OP 72~~ MUN 0625		30'cw
~~BRANCH~~ LA	0 17	~~F~~ Easton		
Howard St.	0 13			
Kasten Lane	0 10			
Elizabeth St.	0 06			
		Max Lane		34'F
N	0 03			C-C
Goldsborough		St.		
MD	0 00	328		

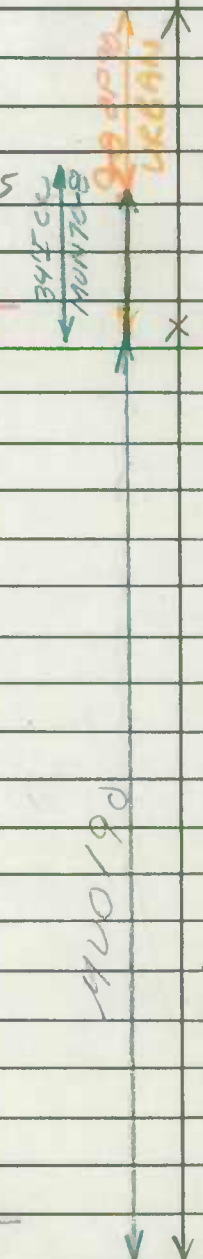

Form 6 HPS (Rev. 1961)

4

ROAD INVENTORY SHEET

Party Chief F. SETTAN
Recorder T. LANDON
Chainman

T. LANDON
F. RHODES
VERIFIED
5/13/77
EASTON

TL REV.
F.R. 1/26/77

Road No. 0190 ST.
Name (TALBERT ~~FORK~~)
Sheet No. 1 OF 1
Date 7-12-66
County TALBOT

As Traced 76-7

85-20

ROAD			END	
(DOVE LA.)	0	31	H	
MUN. ~~LMAX .0275~~	0	23	[redacted] ST.	24'D
~~LMAX~~ MUN. .0625	0	20	~~OP~~ 72 MUN	
(BRANCH ~~ST~~ ~~OF~~ LA. ~~MU 330~~ ~~OF MU 135~~ ST	0	17	Limits of EASTON	30'CW
HOWARD ST	0	13		
MU560 (EASTON LANE)	0	10		
MU330 ELIZABETH ST	0	06		
	0	03	MUN (MAX LANE)	34'F C-C
CADDSBOROUGH ~~RD~~ MU.	0	00	0430 ~~390~~ ST	

N

(92-12)
60 / A. HATTEN
2-5-93

SHA 51.3 - 8 Revised
4.83

MARYLAND STATE HIGHWAY ADMINISTRATION

ROAD INVENTORY SHEET

89-14

Party Chief BB
Recorder BB
Assistant
Map No./Dir. 1 E
State Coordinates EASTON

Road No. MD. 0193
Road Name CANVASBACK DR.
County TALBOT
Date 2/2/90
Sheet No. 1 OF 2

91-16
91-18 ALT

TRAFFIC CODES
TRAFFIC CONTROLS: STOP SIGN=SS, TRAFFIC LIGHT=T.L., FLASHING RED BALL=F.R.

TRAFFIC CODES
PARKING RESTRICTIONS: A.M. PEAK, P.M. PEAK, A.M./P.M. PEAK, NO PARKING ANYTIME=N.P., COMM/IND. ACCESS=E

SYSTEM				TRAFFIC		LINE DIAGRAM	TRAFFIC			PAVEMENT DATA
FED. AID.	FUNCT CLASS.	HWY. SYS.	HPMS SAMPLE	PRKG. REST.	COM/IND. ACCESS		CONTROL	COM/IND. ACCESS	PRKG. REST.	
	URBAN Local					0 ~~45~~ 25 PT 110° BRANT CT 0 ~~35~~ 15 MU 0136 0 ~~25~~ 07 PC (TEAL DR.) MU. 0 ~~20~~ 00 0990 30° MU PC ELLIOTT RD CO 297V				36'I JC-C 2 V.ML

SYSTEM				TRAFFIC		LINE DIAGRAM	TRAFFIC			PAVEMENT DATA
FED. AID.	FUNCT. CLASS.	HWY. SYS.	HPMS SAMPLE	PRKG. REST.	COM/IND ACCESS		CONTROL	COM/IND ACCESS	PRKG. REST.	
						(PINTAIL DR)				
						MU 0847 054 39				
										36 'I
										JC-C
				E		0 35				

URBAN LOCAL

SHA 51.3-8
11-15-72

STATE HIGHWAY ADMINISTRATION OF MARYLAND

90-1
2-6-91
BB/TM

EASTON
ROAD INVENTORY SHEET MUN. 0215

Party Chief T. LANDON
Recorder F. RHODES
Helper

Transfer Co To Mun
Map No. co. imp 88-5
mun. imp. 88-1,2,3

Road No. CO. 14
Road Name CHAPEL RD.
Sheet No. 1 OF 5
Date 5/20/77
County TALBOT
State Coordinates 1066-350

91-01 A/T

	1 30		
3 H			
AUTO JUNKYARD -100'	1 26		
	1 02	60" CMP	
	0 96	15°	
	0 87	H	CO 14
F 900'	0 85	F	
	0 56	15°	18'F
CORP. LIMITS OF EASTON			30'CW
NB US. SB	0 42	50 LA. LA	TL 2ML
	0 37		20'G
			2ML
	0 31	H	
12 H	0 27 (LAUREL ST)		
RXR	0 21 MU 85-2 0581		30'I
			JC-RT
	0 16		~~20'F~~
RXR SIGN		MDDE	~~30'CW~~
	0 14	~~PC~~ 529 983X	
RXR SIGN			
	0 10	H	
	0 08 CRABAPPLE CT. MUN. 0239		
	0 03	H	3G I E JC-RT.
N. WASH. MD.			
	0 00 ST. 565-A		30'CW

COUNTY-URBAN-MUN 09-15

* Entire Road is OP per K. Powers phone call with Brent Spicer 12/15/92 T.M.
* Now OP192 per 92-4-5 2/25/93 T.M

90-3
2-6-91
BB/TM

(92-5)
GD - AHATTEN
2-4-93

SHA 51.3 - 8 Revised 4.83

MARYLAND STATE HIGHWAY ADMINISTRATION

ROAD INVENTORY SHEET

OP 192

823

Party Chief BB
Recorder ~~BB~~
Assistant
Map No./Dir. / SW
State Coordinates EASTON

Road No. ~~MD. 0218~~
Road Name CHAPEL FARM DR.
County TALBOT
Date 2/2/90
Sheet No. 1 OF 1

91-03 A/T

TRAFFIC CODES
TRAFFIC CONTROLS: STOP SIGN=S.S., TRAFFIC LIGHT=T.L., FLASHING RED BALL=F.R.

TRAFFIC CODES
PARKING RESTRICTIONS: A.M. PEAK, P.M. PEAK, A.M./P.M. PEAK, NO PARKING ANYTIME=N.P., COMM/IND. ACCESS=E

SYSTEM				TRAFFIC		LINE DIAGRAM	TRAFFIC			PAVEMENT DATA
FED. AID.	FUNCT CLASS.	HWY. SYS.	HPMS SAMPLE	PRKG. REST.	COM/IND. ACCESS		CONTROL	COM/IND. ACCESS	PRKG. REST.	
						ROAD 0|19 END				
						~~ROAD~~ 0|16 ~~END~~				
						~~ROAD~~ 0|09 ~~END~~				
						0|05 30°				
NON F/A	URBAN LOCAL					~~LAUREL~~ ST~~~				36'I
						MU 0|00 0581	SS			JC-C
										24M2

SYSTEM				TRAFFIC		LINE DIAGRAM	TRAFFIC			PAVEMENT DATA
FED. AID.	FUNCT. CLASS.	HWY. SYS.	HPMS SAMPLE	PRKG. REST.	COM/IND ACCESS		CONTROL	COM/IND ACCESS	PRKG. REST.	

SHA 51.3 - 8 Revised
4.83

MARYLAND STATE HIGHWAY ADMINISTRATION EASTON

ROAD INVENTORY SHEET

Party Chief _____
Recorder _____
Assistant _____
Map No./Dir. 1
State Coordinates _____

Road No. MU 0218
Road Name Chapel Farm Dr
County TALBOT
Date _____
Sheet No. _____ OF _____

SYSTEM				TRAFFIC		LINE DIAGRAM	TRAFFIC			PAVEMENT DATA
FED. AID.	FUNCT CLASS.	HWY. SYS.	HPMS SAMPLE	PRKG. REST.	COM/IND. ACCESS		CONTROL	COM/IND. ACCESS	PRKG. REST.	
						UNASSIGNED Now				
						OP 192 per Imp 92-5				
						2-9-93 T.M.				
						This road not maintained by Mun per B. Spicer by phone to K. Powers 1/15/92				

TRAFFIC CODES

TRAFFIC CONTROLS: STOP SIGN=SS, TRAFFIC LIGHT=T.L., FLASHING RED BALL=F.R.

TRAFFIC CODES

PARKING RESTRICTIONS: A.M. PEAK, P.M. PEAK, A.M./P.M. PEAK, NO PARKING ANYTIME=N.P., COMM/IND. ACCESS=E

SYSTEM				TRAFFIC		LINE DIAGRAM	TRAFFIC			PAVEMENT DATA
FED. AID.	FUNCT. CLASS.	HWY. SYS.	HPMS SAMPLE	PRKG. REST.	COM/IND ACCESS		CONTROL	COM/IND ACCESS	PRKG. REST.	

SHA 51.3-8
11-15-72

STATE HIGHWAY ADMINISTRATION OF MARYLAND

ROAD INVENTORY SHEET

OP 0159

Party Chief BB
Recorder FR
Helper 82-16
BB 84-23

Map No. ~~MD~~ 24 82-13
EASTON

Road No. ~~MD 0296~~
Road Name CORBIN PKY.
Sheet No. 1 OF 1
Date 5-24-83
County TALBOT
State Coordinates

		DE	
Cul	0	47	SAC
PATRICK RD. ~~MD~~ SP 162	0	43	
PVT. RD	0	37	PVT. RD.
	0	30	~~BRETT RD~~ PVT
	0	20	BOYD CT. MU.
APT	0	14	
40° PC	0	05	60" CMP
SIGRID CT. MU.	0	01	
ROAD	0	00	END

NE

36 I
"J" c-c

prob.

SHA 51.3-8
11-15-72

ROAD INVENTORY SHEET

Road No. _____
Road Name _____
Sheet No. _____
Date _____
County _____
State Coordinates _____

SHA 51.3 - 8 Revised 4.83

MARYLAND STATE HIGHWAY ADMINISTRATION

ROAD INVENTORY SHEET

OP 241

Party Chief BB
Recorder AL
Assistant
Map No./Dir. 1 SW
State Coordinates

Road No. ~~OP 159~~ MU 0236
Road Name CORBIN PKWY. (85-41)
County TALBOT
Date 1-20-86
Sheet No. 1 OF X 2

TRAFFIC CODES
TRAFFIC CONTROLS: STOP SIGN=SS, TRAFFIC LIGHT=T.L., FLASHING RED BALL=F.R.

TRAFFIC CODES
PARKING RESTRICTIONS: A.M. PEAK, P.M. PEAK, A.M./P.M. PEAK, NO PARKING ANYTIME=N.P., COMM/IND. ACCESS=E

SYSTEM				TRAFFIC		LINE DIAGRAM	TRAFFIC			PAVEMENT DATA
FED. AID.	FUNCT CLASS.	HWY. SYS.	HPMS SAMPLE	PRKG. REST.	COM/IND. ACCESS		CONTROL	COM/IND. ACCESS	PRKG. REST.	
						D E				
						~~CUL~~ C 77 ~~SAC~~ (OP 241)				
						WILL ST. MU ~~OP 0165~~ C 64				
						FOURTH ST. MUN 0375 C 58 PT				
						C ~~50~~ SIGFRID ST. MUN 0908 50°				
						C 134 FC				
						BOYD ST. MUN 0133 C 28				
						BRETT RD. MU 0137 C 18				
						Shirley Dr OP MUN ~~OP 194~~ 0906 I 12				
						C ~~OP~~ PATRICK RD. MU. 0815				36'T J C
						CUL C 00 SAC				
						D E				

SYSTEM

FED. AID. | FUNCT. CLASS. | HWY. SYS. | HPMS SAMPLE

TRAFFIC

PRK'G. REST. | COM/IND ACCESS

LINE DIAGRAM

TRAFFIC

CONTROL | COM/IND ACCESS | PRK'G. REST.

PAVEMENT DATA

108

PT

40°

PC

102

FRANCIS ST

CP 096 242

PT

091

30°

PC

094

092

PT

60°

0241

SHA 51.3-8
11-15-72

STATE HIGHWAY ADMINISTRATION OF MARYLAND

92-9
92 MU
GB/AM
2-3-93

73-1

ROAD INVENTORY SHEET

COLONIAL COURTS

Party Chief W. Dombroski
Recorder D. Taylor
Helper

Map No.

Road No. 0238
Road Name ~~(Colonial Heights)~~
Sheet No. 1 of 1
Date 1-15-74
County Talbot
State Coordinates

L. LANDON RHODES VERIFIED 5/12/77

Easton

E

~~Colonial~~ ~~Hatts~~ ~~Rd~~
(Gunther ~~Alley~~ ~~Road~~ ~~End~~ LA)
MUN. 0 11 ~~1000~~ 9015

(Colonial Ct)
005 MU 0237

E

(Glebe Rd)
MUN 000 0410

34' E
2-Jcurbs

SHA 51.3-8
11-15-72

ROAD INVENTORY SHEET

Road No. _____
Road Name _____
Sheet No. _____
Date _____
County _____
State Coordinates _____

Form 6 HPS (Rev. 1961)

(64-6) FB/AL 1-26-66

4

ROAD INVENTORY SHEET

Party Chief F. SETTAN
Recorder T. LANDON
Chainman

T. LANDON REV.
F. RHODES 1/26/77

T. LANDON
F. RHODES
VERIFIED 5/12/77

Road No. 0260
Name DIAMOND ST
Sheet No. 1 OF 1
Date 7-12-66
County TALBOT

EASTON

83-5

ROAD 029 END

MUN 960
SYCAMORE 020 AVE

MUN 1120
WILLIS 011 AVE

MUN 290
N.W. DUKES AVE 005

MUN 1140
000 AVE

34'F
C-L

31'-7
79-4

28'F
32'CW

24'-1
(64-6)

NE

Form 6 HPS (Rev. 1961)

90-11 FCR 95
2-6-91 GO/TM 94-08 A/T
BB/TM 4/10/95 94-09 A/T

4

ROAD INVENTORY SHEET

Party Chief F. SETTAN
Recorder T. LANDON
Chainman

Revised 1-15-74 W.D DT. 73-16 A

F. RHODES VERIFIED 5/12/77 A/T

EASTON

BB RET FR 2-2-81

91-14 MV BBISP 2-26-92

Road No. 0280
Name DOVER ST
Sheet No. 1 OF 2
Date 7-11-66
County TALBOT

79-17A

| | | |

Form 6 HPS (Rev. 1961)

92-11
GD/A.H
2-4-93

ROAD INVENTORY SHEET

Party Chief F. SETTH
Recorder T. LANDON
Chainman

T. LANDON
F. RHODES
VERIFIED
77

Road No. 0280
Name DOVER ST
Sheet No. 2 of 2
Date 7-11-66
County TALBOT

SEE NEW INV. EASTON 82-16 79-178

FCR-95
GD AH
4-10-95

FAU 7600 NUN FA

PRINCIPAL ARTERIAL - URBAN — OTHER

LOCAL URBAN

	HOPKINS MUN 73-16	0 72	Pl. 0525
MUN	HAMMOND	0 69	470 ST
MUN	S. WEST ST.	0 50	1110 N. WEST ST
	S. WASHINGTON ST MD	0 43	N. WASH. ST 565A
MUN		0 36	6010 (HUGHES AL)
MUN	S. HARRISON ST.	0 34	470 N. HARRISON ST
		0 33	
MUN	TALBOT LANE	970 0 29	AMER. LEGION
	EASTON P.O.	0 27	

34'D
2-J curbs

44'G
J-C-C

25'I
C-C

ZZ'I
"J" C-C

24'I
C-C

34'I
C-C

SAME

DT/TT
12-29-94
94-11A

SHA 51.3 - 8 Revised
4.83

MARYLAND STATE HIGHWAY ADMINISTRATION

ROAD INVENTORY SHEET

Party Chief Powell Her 10-4-88 T.M
Recorder
Assistant
Map No./Dir. 1 NW
State Coordinates

Road No. MD 293 (CO 95)
Road Name Dutchmans LA.
County TALbot
Date
Sheet No. (1) OF (3)

SYSTEM: FED. AID. | FUNCT CLASS. | HWY. SYS. | HPMS SAMPLE
TRAFFIC: PRKG. REST. | COM/IND. ACCESS

LINE DIAGRAM

SEE NEW INV.
FCR-95
ED AM
4-6-95

Long Mount Pl Rd		
CO 9	1	66
Stoney Ridge Rd		
CO 222	1	53
STONEY RIDGE RD		
CO 222	1	27
Corp Line		
(Proposed)	1	18
Patrick Rd		
MD 0815	1	12

TRAFFIC: CONTROL | COM/IND. ACCESS | PRKG. REST.

PAVEMENT DATA

20' F
30' CW
2 MC
SAME

TRAFFIC CODES

TRAFFIC CONTROLS: STOP SIGN=SS, TRAFFIC LIGHT=T.L., FLASHING RED BALL=F.R.

TRAFFIC CODES

PARKING RESTRICTIONS: A.M. PEAK, P.M. PEAK, A.M./P.M. PEAK, NO PARKING ANYTIME=N.P., COMM/IND. ACCESS=E

SYSTEM | TRAFFIC | LINE DIAGRAM | TRAFFIC | PAVEMENT DATA

SYSTEM: FED. AID. | FUNCT. CLASS. | HWY. SYS. | HPMS SAMPLE
TRAFFIC: PRKG. REST. | COM/IND ACCESS
TRAFFIC: CONTROL | COM/IND ACCESS | PRKG. REST.

K CROSBY COLLECTOR

(CADMUS LN)

2 31 ~~MU 1160~~ (S-4)
Private

WAYSIDE AVE
MU 1100 2 30

(ELK LA)
MU 0330 2 27

ELWOOD AVE
MU 0350 2 24 Apts.

MECKLENBURG AVE
MU 0680 2 13

2 11

1 95

US 1 91 50

1 82

CORP Limits Easton
WINDMILL 1 74 Branch

MU 0293 MU 0293 MU

E

PAVEMENT DATA:
43'I
"J" C-C
2 ML

43'I
"J" C-C

36'I
"J" C-L4

SHA 51.3 - 8 Revised
4.83

MARYLAND STATE HIGHWAY ADMINISTRATION

ROAD INVENTORY SHEET

Party Chief Rewritten TM
Recorder
Assistant Rewritten 10-4-88
Map No./Dir. /
State Coordinates

Road No. MU 293
Road Name Dutchmans LA
County Talbot
Date 5-24-66
Sheet No. (3) OF (3)

SYSTEM: FED. AID. | FUNCT CLASS. | HWY. SYS. | HPMS SAMPLE
TRAFFIC: PRK.G. REST. | COM/IND. ACCESS

LINE DIAGRAM

TRAFFIC: CONTROL | COM/IND. ACCESS | PRK.G. REST.
PAVEMENT DATA

TRAFFIC CODES
TRAFFIC CONTROLS: STOP SIGN=SS, TRAFFIC LIGHT=T.L., FLASHING RED BALL=F.R.

TRAFFIC CODES
PARKING RESTRICTIONS: A.M. PEAK, P.M. PEAK, A.M./P.M. PEAK, NO PARKING ANYTIME=N.P., COMM/IND. ACCESS=E

S. WASHington ST
MD 2 45 565-A

S. AURORA ST.
MU 2 43 0080

WALNUT LA
MU 1080 2 32

URBAN COLLECTOR

34'I
"J" c-c
2 ML

SKMF

SYSTEM				TRAFFIC		LINE DIAGRAM	TRAFFIC			PAVEMENT DATA
FED. AID.	FUNCT. CLASS.	HWY. SYS.	HPMS SAMPLE	PRK.G. REST.	COM/IND ACCESS		CONTROL	COM/IND ACCESS	PRK.G. REST.	

Form 6 HPS (Rev. 1961)

ROAD INVENTORY SHEET

MU 293

Party Chief F. SEFTAN
Recorder T. LANDON
Chainman S. MARTIN

Easton

Road No. Co 95
Name DUTCHMANS LA
Sheet No. 2 of 3
Date 5-12-66
County TALBOT

		CORP LIMITS OF EASTON	
	1	74	
H	1	71	20'F
H	1	60	30 CL
			2 ML
L	1	67	
LONGMOUNT RD.			
Co 9	1	66	
L-40'	1	61	
L	1	59	
L	1	57	
L	1	54	
	1	53	
	1	51	
50 H			
	1	42	E 700'
L	1	33	
L	1	30	
	1	27	
L	1	22	
H	1	19	
PROP	1	18	
FAIRICK RD			
MU.	1	12	

Form 6 HPS (Rev. 1961)

0293

ROAD INVENTORY SHEET

Party Chief F. SGTJAN
Recorder T. LANDON
Chainman S. MARTIN

Road No. Co 95
Name
Sheet No. 3 OF 3
Date 5-24-66
County TALBOT

Easton

SEE NEW INV

80-10

S. WASHINGTON MD	2	45	STREET 565-A	
S. AURORA	2	43	STREET	34' I c-c
WALNUT LANE	2	32	CORP LIMIT OF EASTON	
WAYSIDE AVE (ELK LA)	2	30		40' I 1"c-c
	2	27		80-10
ELWOOD AVE	2	24		34 I 1" CRT 4'ESHLD LT
EAKS LODGE	2	20		
MECHLENBURG AVE	2	13		80-10
	2	12	F	
H	2	11		
H	2	06	40'CW 2ML	
	2	03	36'I 1"c AT 4'SHLDR	
NURSING HOME	1	95	MEDICAL CENTER	36'CW 2ML
FAU 05	1	91	BOUNDARY 50	24'I 2-4'SHLD
H	1	88		
	1	82		SAME

COLLECTOR - MAIN - URBAN

CO URBAN MUNICIPAL

30°

SHA 51.3-8
11-15-72

STATE HIGHWAY ADMINISTRATION OF MARYLAND

ROAD INVENTORY SHEET

(85-AZ) BB/AL 1-20-86

Party Chief BB
Recorder ER
Helper

BB REV: 4-82 FR 10-4-82 81-20

Map No. 83-46 1/24/84 F.R.N.S

Road No. MUN. 293
Road Name DUTCHMANS LA.
Sheet No. 3 OF 3
Date 2-2-81
County TALBOT
State Coordinates

EASTON

		S. WASHINGTON MD.	2	45	ST. 565-A	
		S. AURORA MUN. 80	2	43	ST.	34'I J-C-C 2 ML
	AV	WALNUT LA. MUN.	2	33	WAVERLY PRESS LANE	
			2	31	MUN 1160	
	RB	WAYSIDE AVE. MUN. 1100	2	30		
	UR	(ELK LA.) MUN. 330	2	27		~~40'I J-C-C 2 ML~~
		ELWOOD AVE. MUN. 350	2	24	ENT. APTS. + HEALTH CTR. ~~FROM~~	
EASTON	TO	ELKS LODGE	2	20	LIMITS	(83-46) J-CC 43I
	WE	MECKENBURG AVE. MUN. 680	2	13		
NOVLL			2	12	F	~~J-C-AT 2 ML~~
	CO	H	2	11		24'I
		H	2	06	EASTON	
			2	03		3L'I
		NURSING HOME	1	95	MEDICAL CENTER	36'I 2 ML
		US	1	91	50	
		CORP LIMITS				
		H	1	88		
			1	82	30°	SAME

SHA 51.3-8
11-15-72

ROAD INVENTORY SHEET

Road No. _____
Road Name _____
Sheet No. _____
Date _____
County _____
State Coordinates _____

Form 6 HPS (Rev. 1961)

T. LANDON
F. RHODES
VERIFIED
5/7/74

ROAD INVENTORY SHEET

Party Chief F. SETTAN
Recorder T. LANDON
Chainman

D. TAYLOR
F. RHODES
11/28/75 REVISED

T.L REVISED
F.R 1/13/76

Road No. 0350
Name ELWOOD AVE
Sheet No. 1 OF 1
Date 7 - 6 - 66
County TALBOT

EASTON

BRIDGE

MUN. ~~PROP.~~ 044 0145 ~~PROP~~ ST.

(WIND MILL LA.)

~~PROPOSED~~ MUN TO# 1123 042 040

(BAINBRIDGE PL.)

MU 0095 ~~PROPOSED~~ RD ~~#3~~ 036

(PREBLE LA.)

~~PROPOSED~~ MU 885 RD ~~121~~ 033

mu 255 (DECATUR PL)

~~PROPOSED~~ RD 101 029

(EAST PINE LA.)

~~PROPOSED~~ MU 843 TO# 023

MUN 780

E. OAK AVE 019

mu 0340

012 ELM AVE

DUTCHMANS LANE

TO MU 000 293 95

0350 MUN

~~20'D~~
~~24'CW~~
18'F
~~34'CW~~
36' I
C-C

ENTRANCE

Form 6 HPS (Rev. 1961)

~~OP 98~~ TL VER F.R 5/17/77 AT

ROAD INVENTORY SHEET

Party Chief E. SMITH
Recorder T. HARDIN
Chainman T. TAYLOR E. RHODES

T.L REVISED F.R 10/3/76

Road No. 0350
Name ELWOOD AVE
Sheet No. 1 OF 1
Date 7-6-76
County TALBOT

1165-338

BRIDGE		ST.	
MUN. ~~TROY~~	C	0145	
(WIND MILL LA)			
OP ~~[illegible]~~ 104	C	40	
(BANDRIDGE LA)			
OP ~~MUN 0085~~ 103	C	36	
(PREBLE LA)			
OP ~~TROY RD~~ 102	C	33	
(DECATUR PL)			
OP ~~[illegible]~~ MW 255	C	27	
(EAST PINE LA)			
OP ~~TROY~~ 100	C	23	
E. OAK AVE	C	19	
	C	12	ELM AVE
DUFFY'S CO	C	00	~~[illegible]~~ 95

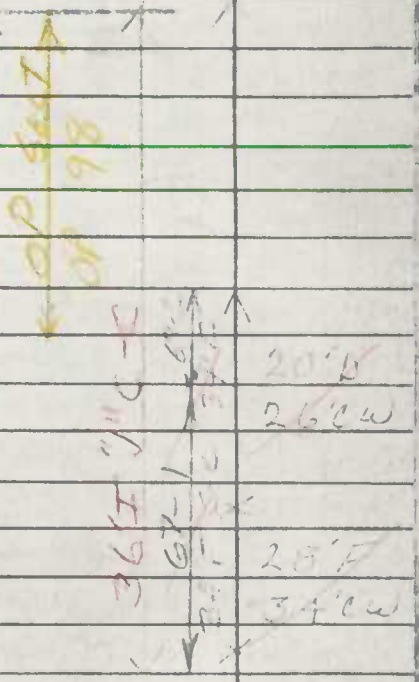

36'R.T.
C.C.

SHA 51.3 - 8 Revised
4.83

MARYLAND STATE HIGHWAY ADMINISTRATION

Easton
OP 242
ROAD INVENTORY SHEET MU 0378

89-45, 46
2/2/90
BB/BB

Party Chief BB
Recorder DW
Assistant
Map No./Dir. G-21 / W
State Coordinates Easton

Road No. ~~OP~~ ~~172~~
Road Name ~~X~~ Francis St ~~X~~
County Talbot
Date 1-18-89
Sheet No. 1 OF 1

Mun.
88-40

SYSTEM: FED. AID. | FUNCT CLASS. | HWY. SYS. | HPMS SAMPLE
TRAFFIC: PRKG. REST. | COM/IND. ACCESS

LINE DIAGRAM

TRAFFIC: CONTROL | COM/IND. ACCESS | PRKG. REST.

PAVEMENT DATA

OP 242

ROAD 0 25 END

WILL ST
0 22 ~~OP~~ MUN ~~MUN~~ 1115 SS
C.109

4150 28
0 17

0 0 85 30

Proposed Nancy ~~Nancy~~ St
OP 244 0 00 MUN ~~OP~~ ~~178~~ 0755 SS

36'I
J-CC

TRAFFIC CODES

TRAFFIC CONTROLS: STOP SIGN=SS, TRAFFIC LIGHT=T.L., FLASHING RED BALL=F.R.

TRAFFIC CODES

PARKING RESTRICTIONS: A.M. PEAK, P.M. PEAK, A.M./P.M. PEAK, NO PARKING ANYTIME=N.P., COMM/IND. ACCESS=E

SYSTEM				TRAFFIC		LINE DIAGRAM	TRAFFIC			PAVEMENT DATA
FED. AID.	FUNCT. CLASS.	HWY. SYS.	HPMS SAMPLE	PRKG. REST.	COM/IND ACCESS		CONTROL	COM/IND ACCESS	PRKG. REST.	

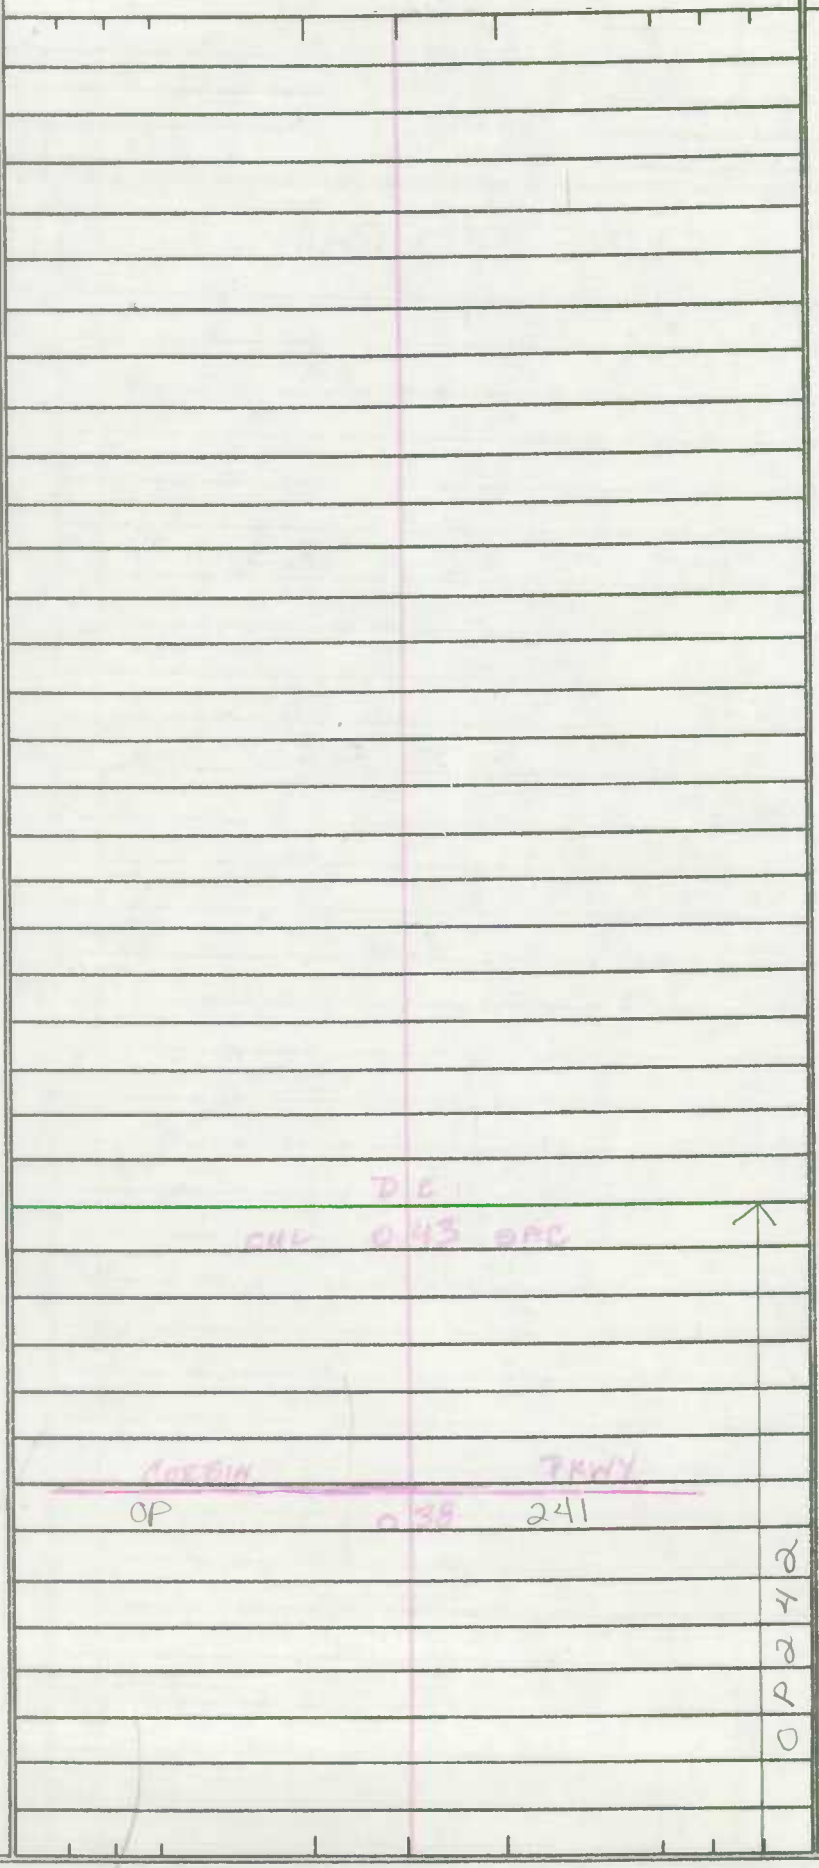

SHA 51.3-8
11-15-72

STATE HIGHWAY ADMINISTRATION OF MARYLAND

ROAD INVENTORY SHEET

Party Chief F Settan
Recorder I LAWSON
Helper S Martin

Map No. _____

Road No. MV 04.0
Road Name Glebe Rd
Sheet No. 1 of 2
Date 5-17-66
County TALBOT
State Coordinates _____

Revised 8-27-81 JTSC EASTON

91-06 A/T

SEE NEW INV
92 MU EX # 2
GD / AH
2-3-93

0 43 15°

ST ROBBINS TERR
MUN 0900

0 32

Optimal Heights
0 31 MUN 276 C

45'I

J'C-C

0 29

MD 579 Urban Collector

HARLEMOOD RD
MUN 650

0 12

N

0 04 SPUR

X 2-15'J

RD "B"

C-C
8' SHLD

0 01 N. WASHINGTON ST SPUR MD 579

0 00

SHA 51.3-8
11-15-72

ROAD INVENTORY SHEET

Road No. MV
Road Name _____
Sheet No. 2 of 2
Date _____
Caunty _____
State Coordinates _____

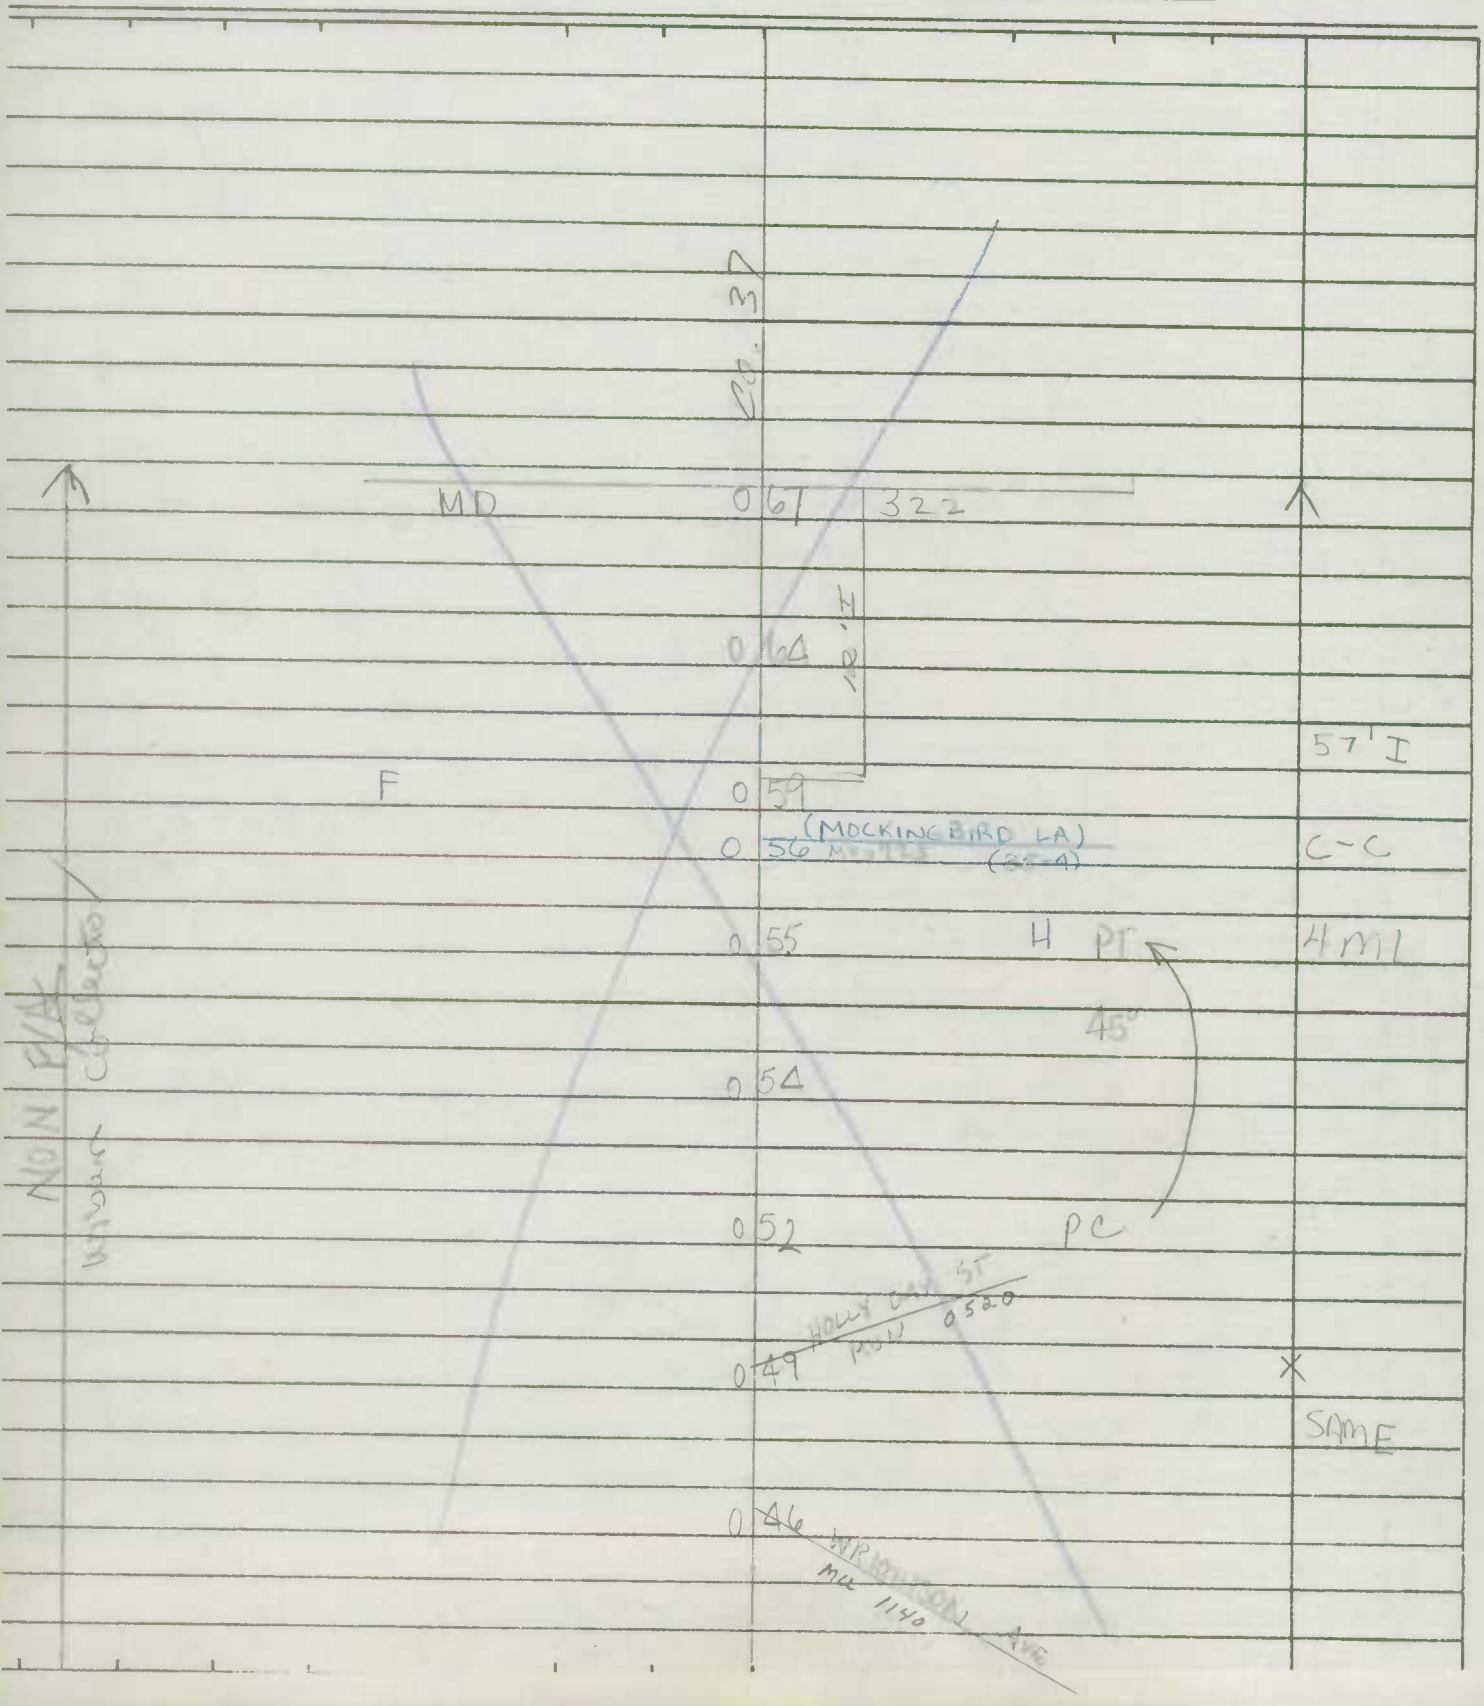

Form 6 HPS (Rev. 1961)

ROAD INVENTORY SHEET

MUN. No. 0410

T. LANDON
F. RHODES
VERIFIED 5/13/77

Revised 1-15-77 WD

Party Chief	E. SETTAN
Recorder	T. LANDON
Chainman	S. MARTIN

Road No.	Co 37
Name	GLEBE RD
Sheet No.	1 OF 3
Date	5-17-66
County	TALBOT

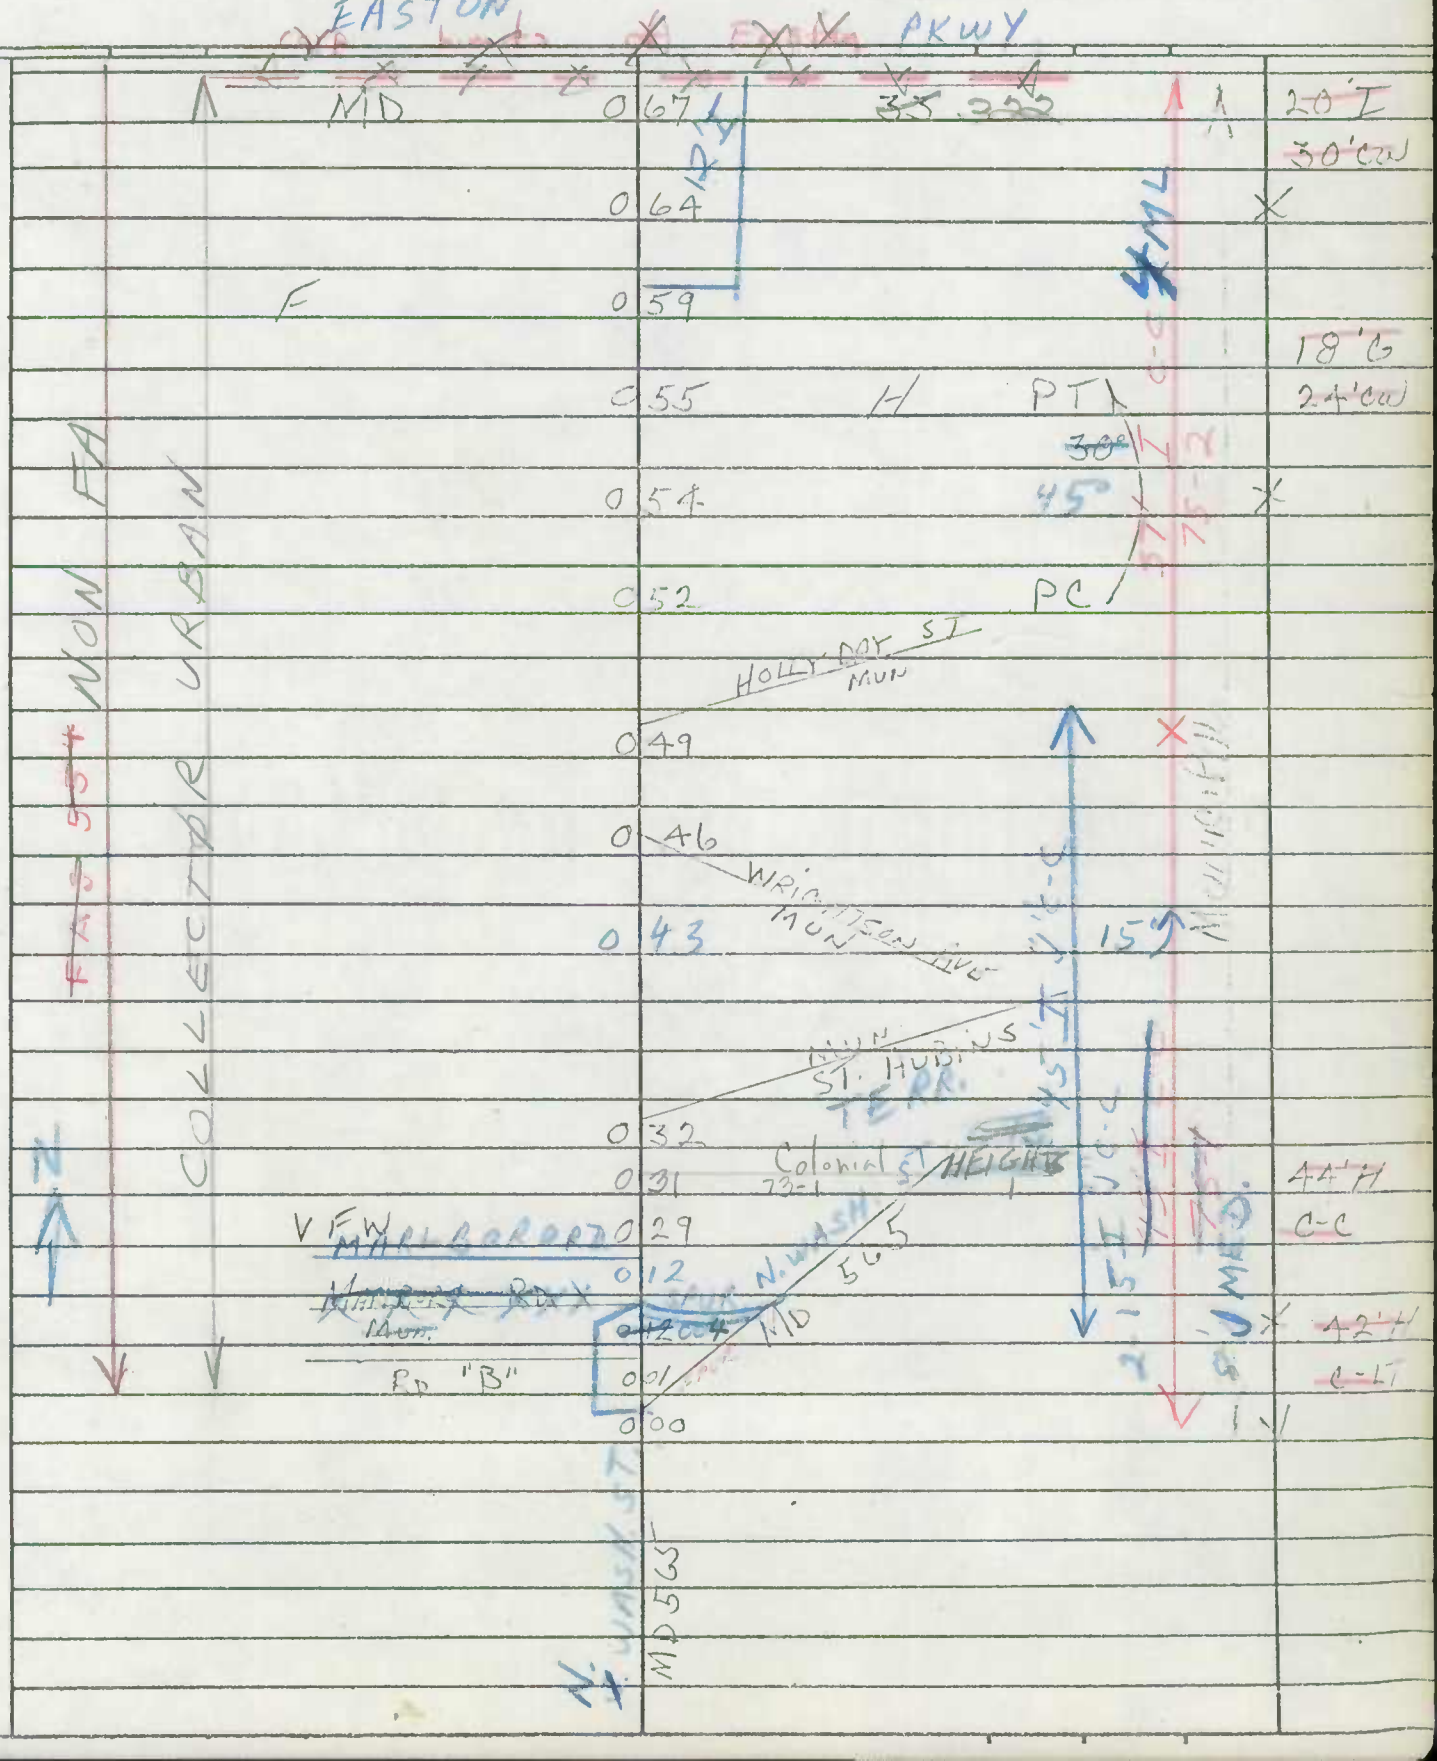

Form 6 HPS (Rev. 1961)

ROAD INVENTORY SHEET

MUN. No. 0420

Party Chief F. SETTIN
Recorder T. L. LANDON
Chainman

T. LANDON
Revised P. RHODES
1-15-74
WD VERIFIED
DT 5/12/77

Road No. ~~A 0 211~~
Name COLEWOOD AVE
Sheet No. 1 of 3
Date 7-11-66
County TALBOT

AS AGREED | 15-11 | EASTON

			32'I
	0	40	"J"C-RT.
Jowite St.			36'CW
~~to~~ 82	0	39	X
MUN. 0545			
	0	38	
	0	37	COLEWOOD ELE. SCHOOL
3 H			
	0	36	CNT. TO SCHOOL
			42'I
	0	34	"J"C-C
			~~26'C~~
LINK ST			
Co 243	0	33	X ~~34'CW~~
			26'C
ABR. CORP. LIMIT	0	31	SE EASTON X 34'CW
	0	26	HAMMOND ST
DENSITY PLOT	0	17	32'C
			C-C
S. WEST	0	06	ST X
N			32'I
			C-C
S. EASTON		S.	
MD	0	00	36 ST A. X

COUNTY

Form 6 HPS (Rev. 1961)

BP 87-11
TM 1-12-88

4

ROAD INVENTORY SHEET

T. LANDON
F. RHODES
VERIFIED
5/13/22

Party Chief F. SETTIN
Recorder T. LANDON
Chairman

BG REV.
FR. 2-2-81

Road No. 0430
Name GOLDSBOROUGH ST
Sheet No. 1 OF 2
Date 7-15-66
County TALBOT

EASTON

85-22,23

	N. HIGGINS	MUN	O	34	490 ST	X
	CHURCH		O	32		
	N. LOCUST	MUN	O	30	620 ST	
	N. AURORA	MUN	O	26	80 ST	
	CHURCH		O	24		
	THOROUGHGOOD	MUN	O	22	1010 LANE	
						31'I C-C
		MUN			150	
	N. HANSON		O	17	ST	X
		MUN	MUN			
	TURNERS LANE		O	14		
					MUN 210	
			O	13	(CENTER LANE)	
			O	11	10 FT.	27'I C-C
		MUN			450	
E	N. HARRISON		O	07	ST	X
						29'I C-C
A	N. WASHINGTON				ST	
	MD		O	00	56.5 A	

HPMS BOARD OF COUNTY ROAD COMMISSIONERS OF TALBOT COUNTY MARYLAND (2) (1)

ONE WAY

Form 6 HPS (Rev. 1961)

1

ROAD INVENTORY SHEET

T. LANDON
F. RHODES
VERIFIED
77

Party Chief E. SETTON
Recorder T. LANDON
Chainman

Road No. 0430
Name GOLDSBOROUGH ST
Sheet No. 2 OF 2
Date 7-13-66
County TALBOT

EASTON

79-11B

MD 328

12' ILTD

US 0 90 50 LD.
EB.
0 89
MUN 190
ALVERT ST 0 83 COUNTRY ELE. SCH 30' I
MUN 710 0 78
MERCER LANE 0 70
0 68
0 61 CHURCH
MUN 0 56 800 15°
PARK 0 53 ST
MUN 310
EAST 0 44 AVE
RXR SIGN FLASHING RED LIGHT
0 43 EXCESS FLASHING LED LIGHTS
MDDE
MUN 930
PENNSYLVANIA 0 42 AVE
25' I
2-C

0430049068

SHA 51.3 - 8 Revised 4.83

MARYLAND STATE HIGHWAY ADMINISTRATION

89-10,11 FCR 95 2-2-90 GD/AH 4/10/95 BB/BB

B.B Rev F.R 2-2-81 85-22,23 BB 97-11 TM 1-12-88

ROAD INVENTORY SHEET

EASTON

Party Chief F. Settan
Recorder I LANDON
Assistant rewritten 11/30/89 JB.
Map No./Dir. / E
State Coordinates

Road No. MU 0430
Road Name Goldsborough ST
County TALBOT
Date 7-15-66
Sheet No. 1 OF 3

SEE NEW INV GD/AH FCR-95 4-6-95

TRAFFIC CODES
TRAFFIC CONTROLS: STOP SIGN=SS, TRAFFIC LIGHT=T.L., FLASHING RED BALL=F.R.

TRAFFIC CODES
PARKING RESTRICTIONS: A.M. PEAK, P.M. PEAK, A.M./P.M. PEAK, NO PARKING ANYTIME=N.P., COMM/IND. ACCESS=E

SYSTEM				TRAFFIC		LINE DIAGRAM	TRAFFIC			PAVEMENT DATA
FED. AID.	FUNCT CLASS.	HWY. SYS.	HPMS SAMPLE	PKG. REST.	COM/IND. ACCESS		CONTROL	COM/IND. ACCESS	PKG. REST.	
			2							35' I
										JC-C
						N. AURORA ST				
						Mun 0 26 0080	TL		X	
			1							
						Church 0 24				
						~~Thoroughgood~~ LA				
						mun 0 22 1010				31' I
										C-C
						N. Hanson ST				
						mun 0 17 0450			X	
						Turners LA				
						mun 1050 0 14				
						(Center LA)				
						0 13 mun 0210				
										27' I
						0 11				C-C
						N. Harrison ST				
						MUN 0 07 0470			X	
						WYNAN				29' I
						N Washington ST.				C-C
						MD 0 00 565 A				

FAP 308 URBAN EXTENSION

LINE DIAGRAM

SYSTEM: FED. AID. | FUNCT. CLASS. | HWY. SYS. | HPMS SAMPLE (6043004900 68)
TRAFFIC: PRKG. REST. | COM/IND ACCESS
TRAFFIC: CONTROL | COM/IND ACCESS | PRKG. REST.
PAVEMENT DATA

FAP 308 URBAN MINOR ARTERIAL

		PAVEMENT DATA
		35' I
		J C-C
0	68	X
0	61 church	
0	56 15° ↑	
Park ST		
mun 0	53 0800	25' I
		JC-C
EAST AVE		
mun 0	44 0310	X
~~X X X X X X X X X~~ 0	~~43 MODE 32.7 455 J~~	~~30' I~~
Pennsylvania Avc		~~JC-C~~
mun 0	42 0830	~~X 35' I~~
		~~C~~
		30' I
N. Higgins ST		JC-C
mun 0	34 0490	X
church 0	32	35' I
		JCC
N. LOCUST ST		
MUN 0	30 0620	

SHA 51.3 - 8 Revised 4.83

79-11B

MARYLAND STATE HIGHWAY ADMINISTRATION

ROAD INVENTORY SHEET

EASTON

Party Chief F Settan
Recorder T LANDON
Assistant rewritten 11/30/89 JB
Map No./Dir. / E
State Coordinates

Road No. MU 0430
Road Name GOLDSBOROUGH ST
County TALBOT
Date 7-15-66
Sheet No. 3 OF 3

TRAFFIC CODES
TRAFFIC CONTROLS: STOP SIGN=SS, TRAFFIC LIGHT=T.L., FLASHING RED BALL=F.R.

TRAFFIC CODES
PARKING RESTRICTIONS: A.M. PEAK, P.M. PEAK, A.M./P.M. PEAK, NO PARKING ANYTIME=N.P., COMM/IND. ACCESS=E

SYSTEM				TRAFFIC		LINE DIAGRAM	TRAFFIC			PAVEMENT DATA
FED. AID.	FUNCT CLASS.	HWY. SYS.	HPMS SAMPLE	PRKG. REST.	COM/IND. ACCESS		CONTROL	COM/IND. ACCESS	PRKG. REST.	
FAP 308	URBAN MINOR ARTERIAL		HPMS X			8 RD 3 WESTOVER MD MATT HE US 0 90 50 EB WB LA 12' I LTL 0 89 CALVERT ST mun 0190 0 83 school 0 78 merrick LA mun 0710 0 70				36' I J C-C ~~30' I~~ ~~J-C LX~~

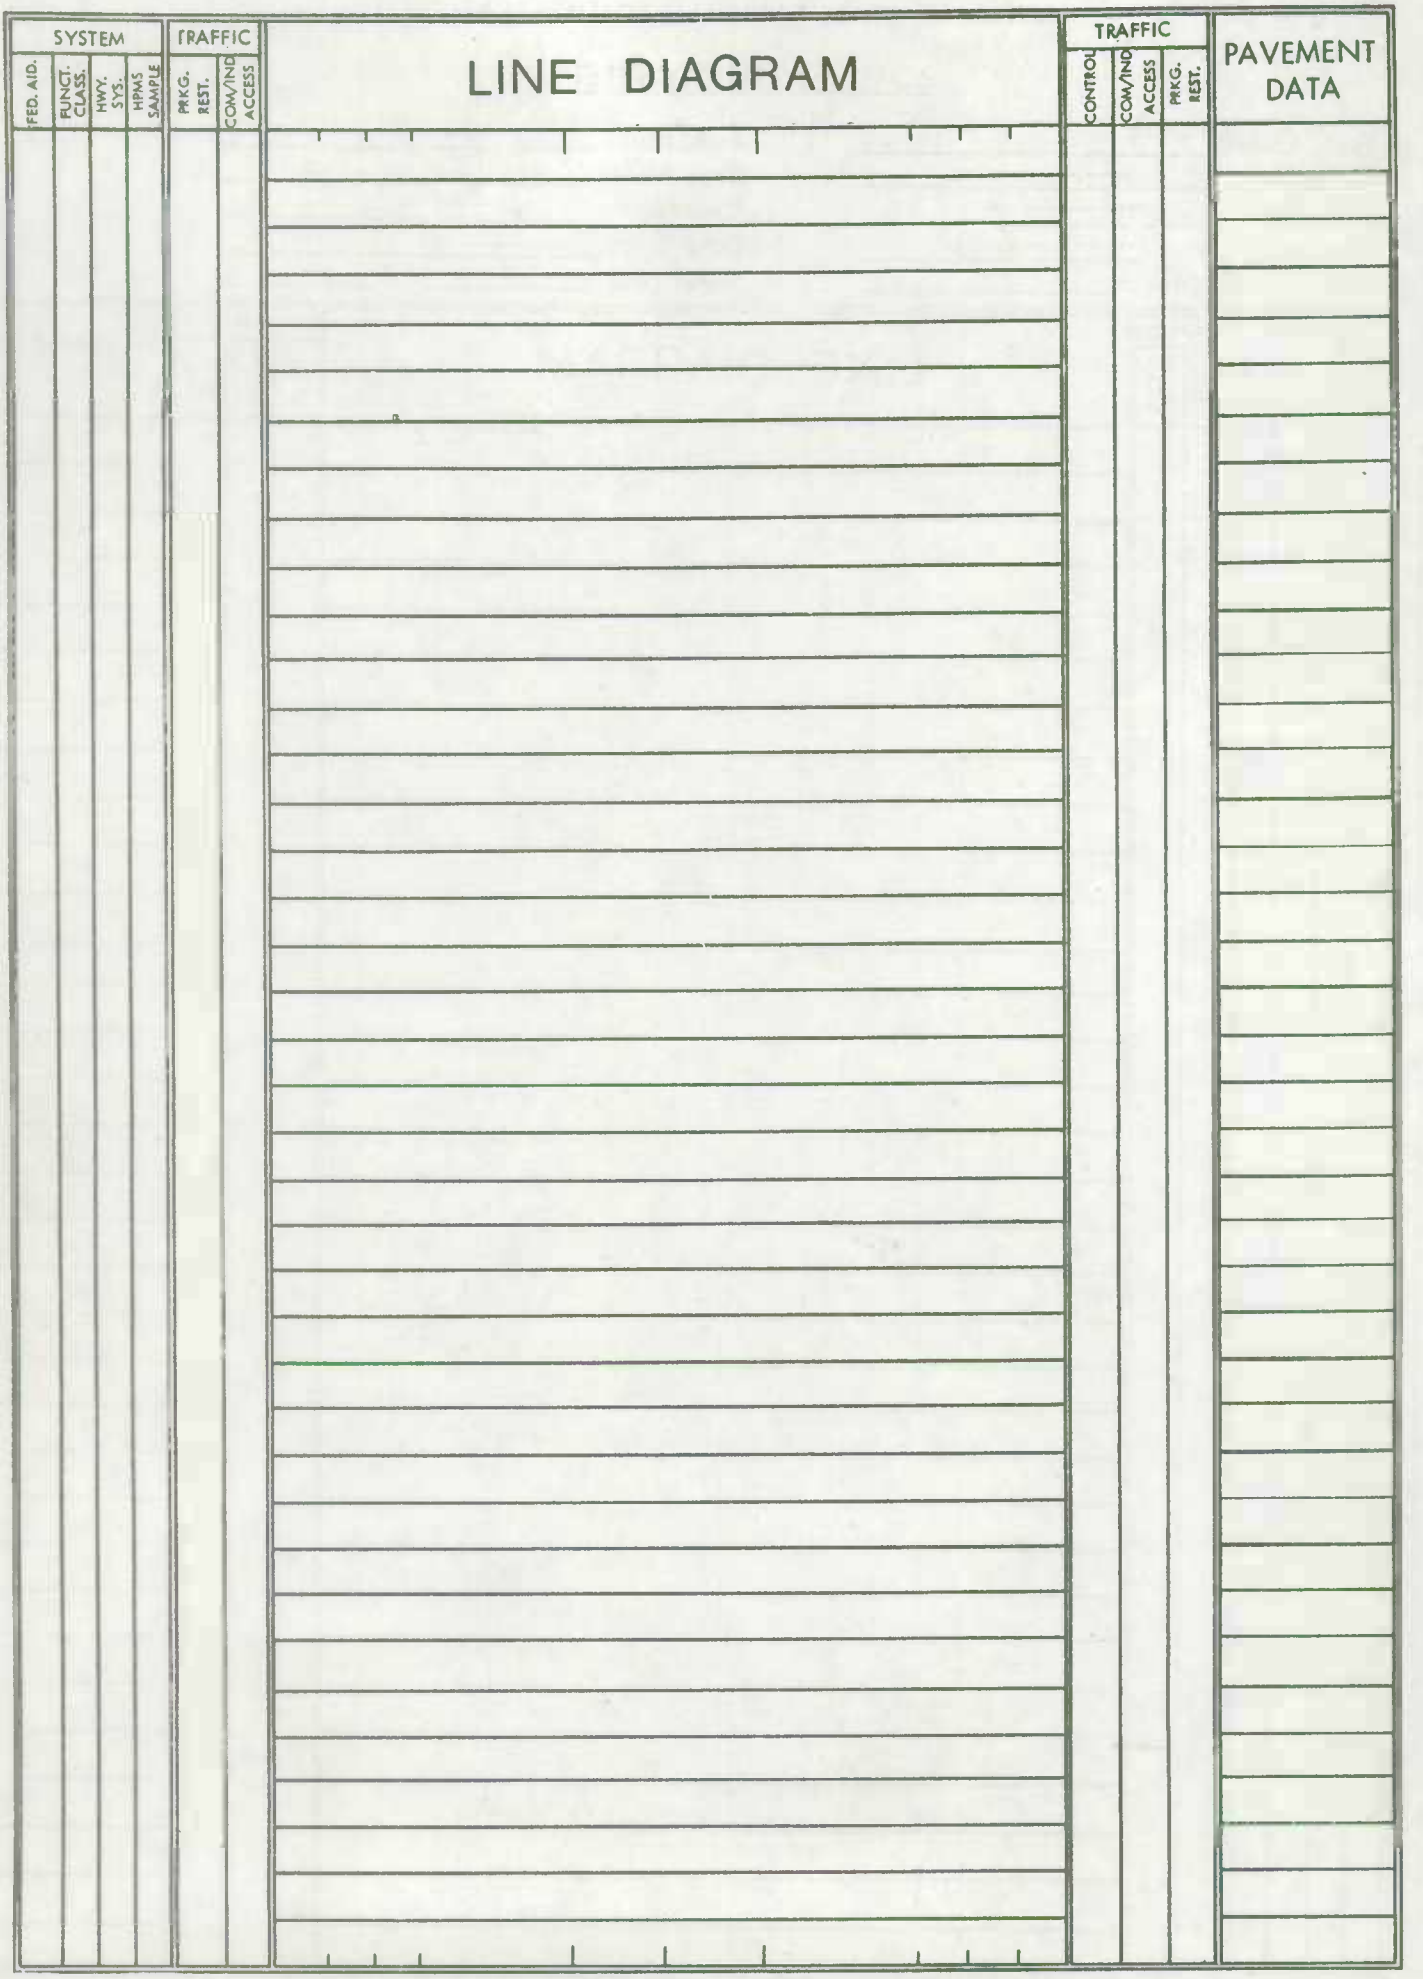
SYSTEM
FED. AID.
FUNCT. CLASS.
HWY. SYS.
HPMS SAMPLE
TRAFFIC
PRKG. REST.
COM/IND ACCESS
LINE DIAGRAM
TRAFFIC
CONTROL
COM/IND ACCESS
PRKG. REST.
PAVEMENT DATA

SHA 51.3-8
11-15-72

STATE HIGHWAY ADMINISTRATION OF MARYLAND

TL VER F.R. 5/11/77 A/T

ROAD INVENTORY SHEET

Party Chief I. LANDON
Recorder E. RHODES
Helper

Road No. MUN. 0435
Road Name (COLTON DR.)
Sheet No. 1 OF 1
Date 1/26/77
County TALBOT
State Coordinates

Map No. EASTON 76-16

BB REV. FR 2-2-81 80-2

ROAD EXTENDED GD KS 96-23 MU 1-24-97

S NI.

ROAD 0 24 END

15°

0 21

0 15

15°

ROAD 0 11 END

(MILES CT.) MUN. 0715

(KING CT.) 09 MUN. 0575

SW

PT 30° PC

0 07

0 04

36 I 1 C-C

(DYOTT MUN. 0 00

CT.) 0295

SHA 51.3-8
11-15-72

ROAD INVENTORY SHEET

Road No. _____
Road Name _____
Sheet No. _____
Date _____
County _____
State Coordinates _____

Form 6 HPS (Rev. 1961)

93-14
2-2-94
RD/TM

4

ROAD INVENTORY SHEET

N. HARRISON ST.

Party Chief E. SETTI T. LANDON
Recorder T. LANDON F. RHODES
Chainman VERIFIED 5/12/77 EASTON

SEE NEW INV
FCR-95
GD/AH 4-6-95

Road No. 0470
Name S. HARRISON STREET
Sheet No. 1 OF 3
Date 7-8-66
County TALBOT

91-25 ALT

SOUTH MUN	0	52	922 ST #2	20
	0	50		
MUN			980	
TALBOT	0	45	ST	
MUN			1020	
(TOWERS	0	42	LANE)	
MUN			160	
BEACHLETTS	0	39	AVE	FY
MUN			150	
(BROOK	0	35	LANE)	
	0	33		
	0	29	BEECH PLACE MU 0090	
MUN			300	
EARLE AVE	0	23	MUN 307	
XRXSIDE X X X X X X	0	22	EARLE AVE #2	
	0	14	0940 SIDE	
	0	13	(STATION LA.)	
MUN			950	
	0	25	STEWART ST	
MUN			9160	
WASHINGTON	0	02	(WARRINGTON ALLEY)	
BEACHLETTS MD 333			MU 0540	
	0	00	IDLEWILD AVE MU 540	

36'I
J C-C
2 ML

32'I
C-C

36'I
C-C

36'I
J C-C
2 ml

36'H
C-C

Form 6 HPS (Rev. 1961)

4

ROAD INVENTORY SHEET

Party Chief F. SETTANI T. LANDON
Recorder T. LANDON F. RHODES
Chainman VERIFIED EASTON

Road No. 0470
Name N. HARRISON ST
Sheet No. 2 OF 3
Date 7-8-66
County TALBOT

81-15

				44'I
		MUN 9030		C-C
	XXXXXXXXX GRAVEL	087 ~~GRAVEL~~ ALLEY GRAVEL		X 2 M↓
		MUN 140		
		084 BREWERS LANE		
				30'I
		MUN 430		C-C
	MUN GOLDSBOROUGH	076 ~~ST~~ ST	TL	X
		MUN 220		
		071 MILL PLACE		
	MUN.	0280		
	← DOVER	065 ST	TL	
		061 POLICE DEPT & MUN. BLDG		
	CLEARWOOD AVE #2			
	MU 0422	060		
		MUN 920		36'I
		058 SOUTH LANE		TC-C
				2 U↓ M↓
		055		X
	↑25°			
		053 ARMORY		
				36'I
				TC-C
				2 M↓
				~~SHOOL~~

Form 6 HPS (Rev. 1961)

ROAD INVENTORY SHEET

Party Chief F. SETTAN
Recorder T. LANDON
Chainman

Road No. 0470
Name N. HARRISON ST
Sheet No. 3 OF 3
Date 7-8-66
County TALBOT

EASTON

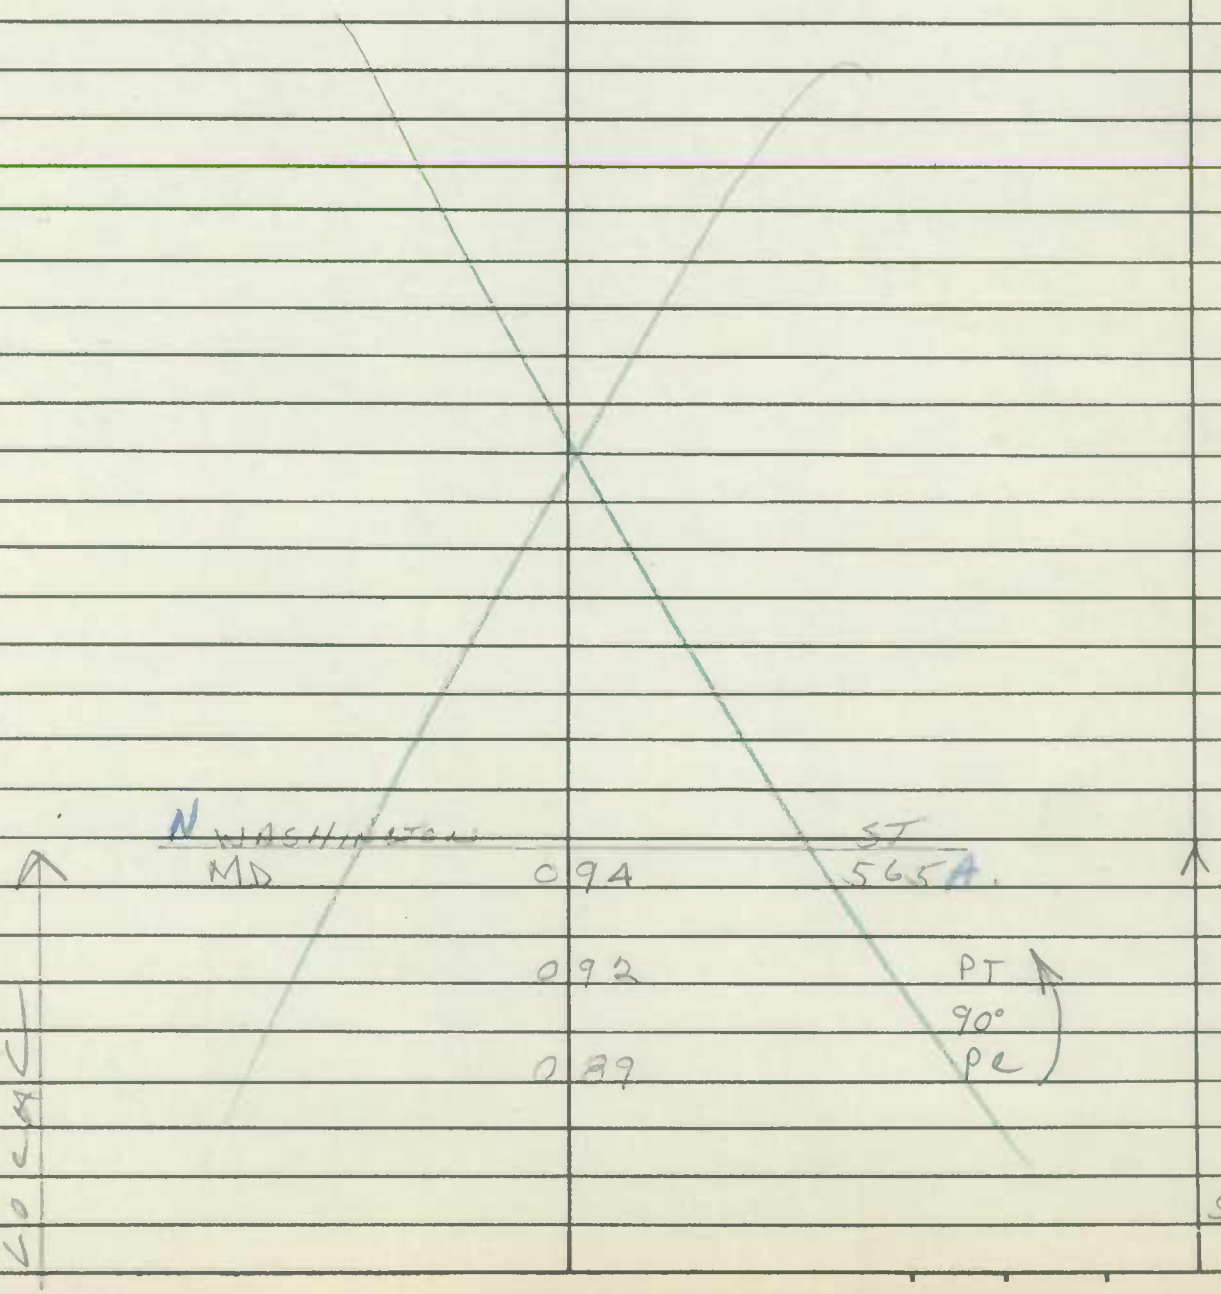

Form 6 HPS (Rev. 1961)

AT 92-18
GD/AH
2-5-93

4/7

ROAD INVENTORY SHEET

T. LANDON
F. RHODES
VERIFIED
5/16/77

Party Chief F. SETTAN
Recorder T. LANDON
Chairman

Road No. 0500
Name HIGH STREET
Sheet No. 1 OF 1
Date 7-7-66

EASTON

SEE NEW INV
GD / AH
4-10-95
FCR-95

| | | |

Form 6 HPS (Rev. 1961)

ROAD INVENTORY SHEET

Party Chief F.SETTAN
Recorder T. LANDON
Chairman

T. LANDON
F. RHODES
VERIFIED
77

Easton

Road No. 0510
Name HILL LANE
Sheet No. 1 OF 1
Date 7-8-66
County TALBOT
ADJUSTED 1-16-70 ALLEY #3 NOW HILL AVE DAB

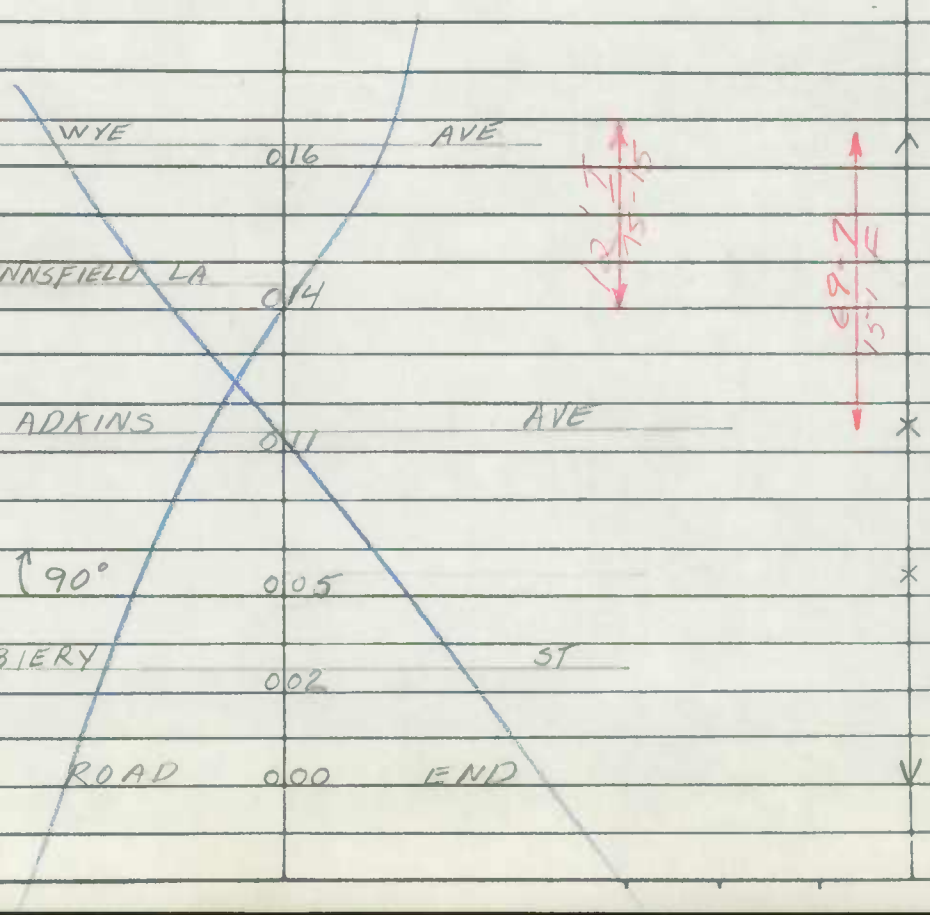

Form 6 HPS (Rev. 1961)

4

ROAD INVENTORY SHEET

T. LANDON
F. RHODES
VERIFIED
5/16/77
EASTON

Party Chief F. SCITAN
Recorder T. LANDON
Chairman

Road No. 0540
Name IDLEWILD AVE
Sheet No. 1 OF 1
Date 7-8-66
County TALBOT

81-19

SEE NEW INV. 83-44

50

ROAD 027 END

WATER STORAGE TOWER 021 (YARD LANE)

34.5'G
C-C

S. AURORA 017 ST

FA 1604 MINOR ARTERIAL URBAN
X X LOCAL URBAN

S. HANSON ST 008

CHURCH 006 EASTON ELE. SCHOOL

34.5'I
C-C

0.01/20 Ice 001 ST. 565 A.

S. HARRISON ST 000

S. WASHINGTON MD

PEACH ORCHARD RD MD

SHA 51.3 - 8 Revised 4.83

MARYLAND STATE HIGHWAY ADMINISTRATION

ROAD INVENTORY SHEET

OP 0160

Party Chief F.R. 83-44+45
Recorder N.S. 1/24/84 FR NS
Assistant
Map No./Dir. 1 W
State Coordinates

Road No. MUN 0540
Road Name IDLEWILD AVE.
County TALBOT
Date 1/24/84
Sheet No. 1 OF 2

BB 34 20 21 22 RM 1-24-95

TRAFFIC CODES
TRAFFIC CONTROLS: STOP SIGN=SS, TRAFFIC LIGHT=T.L., FLASHING RED BALL=F.R.

TRAFFIC CODES
PARKING RESTRICTIONS: A.M. PEAK, P.M. PEAK, A.M./P.M. PEAK, NO PARKING ANYTIME=N.P., COMM/IND. ACCESS=E

SYSTEM				TRAFFIC		EASTON LINE DIAGRAM	TRAFFIC			PAVEMENT DATA
FED. AID.	FUNCT CLASS.	HWY. SYS	HPMS SAMPLE	PKG. REST.	COM/IND ACCESS		CONTROL	COM/IND. ACCESS	PKG. REST.	
						AURORA ST.				
						MUN 0 56				
						WAVERLY PRESS LA.				
						0 53				34'I J-CC
						0 46			X	
						No PROTECTION				37'I J-CC 40'CW
						SPUR 0 45				
						0 21			X	
						MACKEL CT				37'I J.CB. RT 40'CW
						0 18				
						0 14			X	
						PROPOSED				
						0 11				36'I 40'CW
						0 09		E		
						PROPOSED				
						0 06				
				E		0 03		E		
						US 0 00 50	SS.			

OP 0160 TRANS CO

SHA 51.3 - 8 Revised 4.83

MARYLAND STATE HIGHWAY ADMINISTRATION

87-22 OP 1-12-88 TMB T.M 94-20-21-22

ROAD INVENTORY SHEET OP 0160

Party Chief F.R. 83-44+45
Recorder N.S 1/24/84
Assistant FR NS
Map No./Dir. 1 W
State Coordinates

Road No. MUN 0540
Road Name IDLEWILD AVE.
County TALBOT
Date 1/24/84
Sheet No. 1 OF

86-22,23,24, 2-11-87 25 A/T

TRAFFIC CODES
TRAFFIC CONTROLS: STOP SIGN=S.S., TRAFFIC LIGHT=T.L., FLASHING RED BALL=F.R.

TRAFFIC CODES
PARKING RESTRICTIONS: A.M. PEAK, P.M. PEAK, A.M./P.M. PEAK, NO PARKING ANYTIME=N., P., COMM/IND. ACCESS=E

EASTON

LINE DIAGRAM

SYSTEM: FED. AID.	SYSTEM: FUNCT CLASS.	SYSTEM: HWY. SYS.	SYSTEM: HPMS SAMPLE	TRAFFIC: PRKG. REST.	TRAFFIC: COM/IND. ACCESS	LINE DIAGRAM	TRAFFIC: CONTROL	TRAFFIC: COM/IND. ACCESS	TRAFFIC: PRKG. REST.	PAVEMENT DATA
						MINOR ARTERIAL				
						AURORA				
						MUN 0 56				
						WAVERLY PRESS LA.				
						0 53				34'I J-CC
						0 46				
						NO PROTECTION				37'I J-CC 40'CW
						SPUR 0 45				
						0 39 martin ct				
						0 34 33 MU 0653				37'I J.CB. RT. 40'CW
						0 31				
						0 14				
						PROPOSED				36'I 40'CW 2mL 1-CC
						0 11				
						0 09	E			
						PROPOSED				
						0 06				
E						0 03	E			
						US 0 00 50	S.S.			

SYSTEM				TRAFFIC		LINE DIAGRAM	TRAFFIC			PAVEMENT DATA
FED. AID.	FUNCT. CLASS.	HWY. SYS.	HPMS SAMPLE	PRK'G. REST.	COM/IND ACCESS		CONTROL	COM/IND ACCESS	PRK'G. REST.	

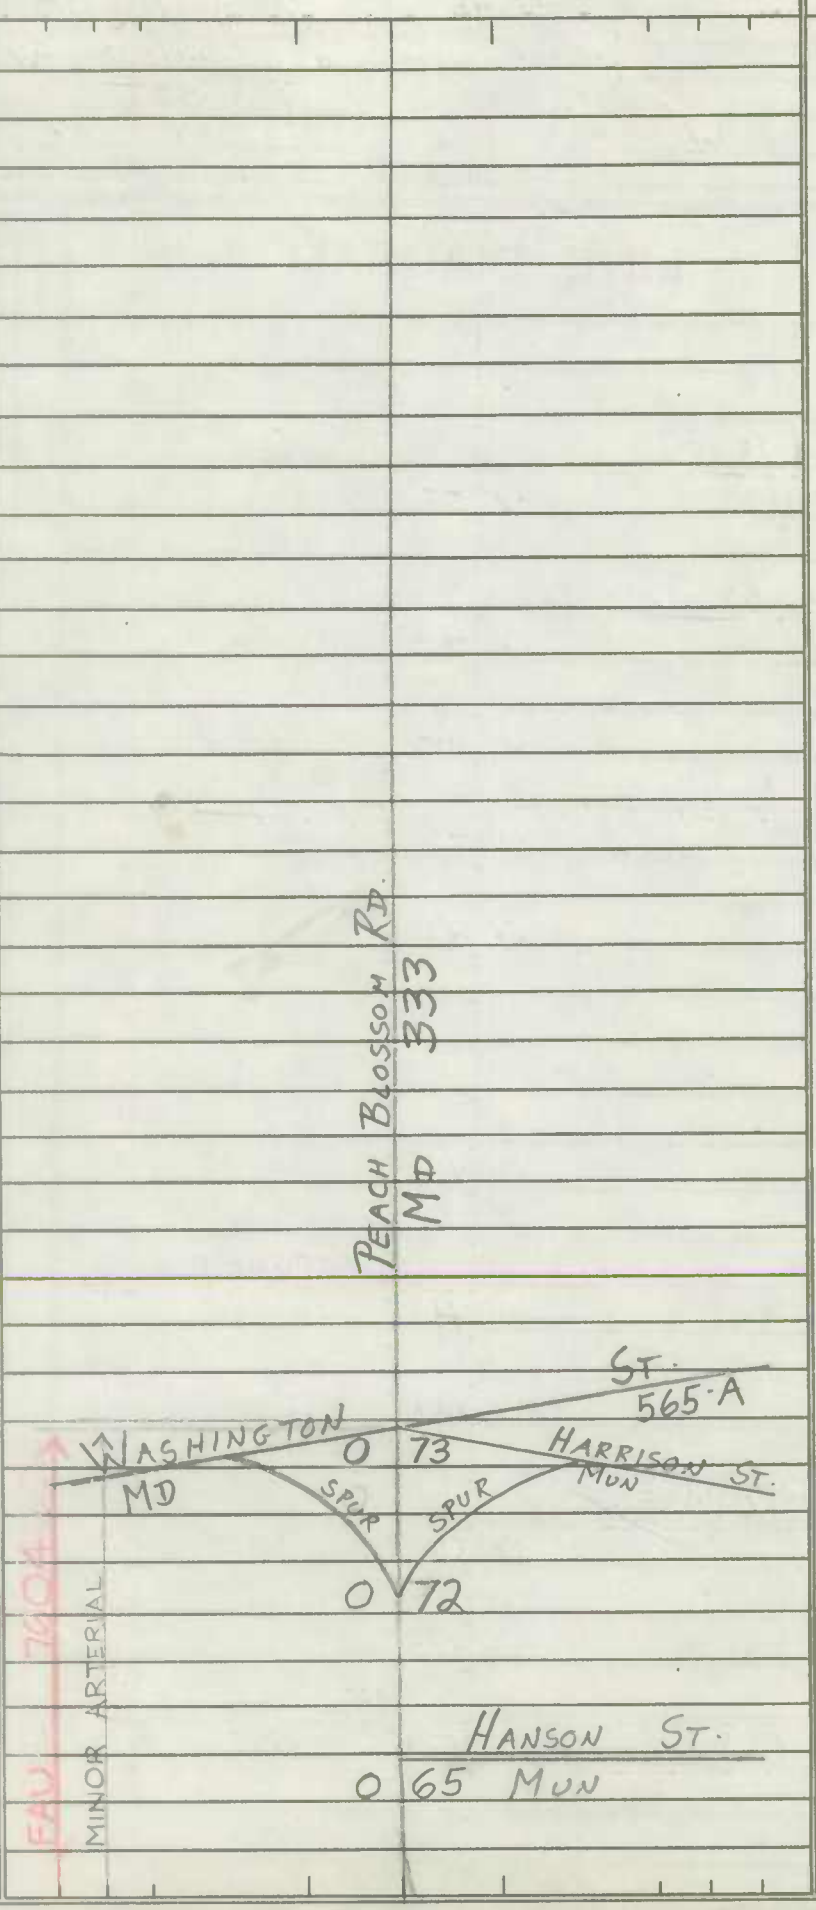

34'I
J-CC
2-ML

93-17
2-21-94
BB/TM

93-16
A/T

DT/TT
12 29 94
94-11

SHA 51.3 - 8 Revised
4.83

MARYLAND STATE HIGHWAY ADMINISTRATION

ROAD INVENTORY SHEET ~~DR DTOE~~

58-29

Party Chief BB
Recorder DW
Assistant
Map No./Dir. EASTON / W
State Coordinates

Road No. MU 0540
Road Name IDLEWILD AVE
County Talbot
Date 1-FE-89
Sheet No. 1 OF 2

92-19
84-20, 21

TRAFFIC CODES
TRAFFIC CONTROLS: STOP SIGN=SS, TRAFFIC LIGHT=T.L., FLASHING RED BALL=F.R.

TRAFFIC CODES
PARKING RESTRICTIONS: A.M. PEAK, P.M. PEAK, A.M./P.M. PEAK, NO PARKING ANYTIME=N.P., COMM/IND. ACCESS=E

SYSTEM				TRAFFIC		LINE DIAGRAM	TRAFFIC			PAVEMENT DATA
FED. AID.	FUNCT CLASS.	HWY. SYS.	HPMS SAMPLE	PRK.G. REST.	COM/IND. ACCESS		CONTROL	COM/IND. ACCESS	PRK.G. REST.	
						SEE NEW INV 4-6-95				
						FCR-95 0.46 GD/AH			X	
						No Protection 0.45		X		
						Caulk LN MUN 0195 0.40 ~~OP~~ 0177 @ 90				
						Proposed 0.36				
						Martin Ct 0.33 MU 0653 @ 90				37'I J-CC 2mL
						0.21 MARVEL CT			X	
						0.18 MU 0655 @ 90				37'I J-CRT 2mL 40° CW
						CYNWOOD DR 0.14 OP 202 0.12			X	
						Proposed (Commercial) 0.11				
						0.09		E		
						Proposed (Raymond Ln) 0.06			X	
						0.03		E		36'I J-CC 2mL
						US 0.00 50 @ 1209 (R)		SS	X	

SYSTEM: FED. AID. | FUNCT. CLASS. | HWY. SYS. | HPMS SAMPLE

TRAFFIC: PRKG. REST. | COM/IND ACCESS

LINE DIAGRAM

TRAFFIC: CONTROL | COM/IND ACCESS | PRKG. REST.

PAVEMENT DATA

FAU 7604

MINOR ARTERIAL

Peach Blossom Rd

383

MD

@ 9.79

565-A

Washington

MD

0.73

Harrison St

MU 0470

@ 1.00

SPUR

SPUR

0.72

Hanson St

0.65 MU 0450

@ .83

MU 0

S. Aurora St.

MU 0.56 80

@ 1.32

55

CADMUS LN

MU 1160 0.53

@ 1.00

34'I

J-CC

SHA 51.3 - 8 Revised
4.83

MARYLAND STATE HIGHWAY ADMINISTRATION

EASTON

ROAD INVENTORY SHEET

OP 0160

58-29

Party Chief BB
Recorder DW
Assistant
Map No./Dir. /W
State Coordinates

Road No. MU 0540
Road Name IDLEWILD AVE
County TalBot
Date 1-18-89
Sheet No. OF

TRAFFIC CODES
TRAFFIC CONTROLS: STOP SIGN=SS, TRAFFIC LIGHT=T.L., FLASHING RED BALL=F.R.

TRAFFIC CODES
PARKING RESTRICTIONS: A.M. PEAK, P.M. PEAK, A.M./P.M. PEAK, NO PARKING ANYTIME=N.P., COMM/IND. ACCESS=E

SYSTEM				TRAFFIC		LINE DIAGRAM	TRAFFIC			PAVEMENT DATA
FED. AID.	FUNCT CLASS	HWY. SYS.	HPMS SAMPLE	PRKG. REST.	COM/IND. ACCESS		CONTROL	COM/IND. ACCESS	PRKG. REST.	
						0.46				
						No Protection Spar 0.45				
						Coutts Ln 0.40 OP 0171				
						Proposed 0.38				
						Martin Ct 0.33 MU 0653				37'I J-CC 2mL
						0.21 MARVEL CT				
						0.18 MU 0655				37'I J-CRT 2mL 40 CW
						0.14				
						Proposed (Commerce ST) 0.11				
						0.09				
						Proposed (RAYMOND LA) 0.06				
						OP 0160				36'I J-CL 2mL
						0.03		E		
						US 0.00 50	SS			

MU 0540 COLLECTOR
MU 0655 LOCAL

SYSTEM				TRAFFIC		TRAFFIC			PAVEMENT DATA
FED. AID.	FUNCT. CLASS.	HWY. SYS.	HPMS SAMPLE	PRKG. REST.	COM/IND ACCESS	CONTROL	COM/IND ACCESS	PRKG. REST.	
NHS FIX	6 1 1 2								

LINE DIAGRAM

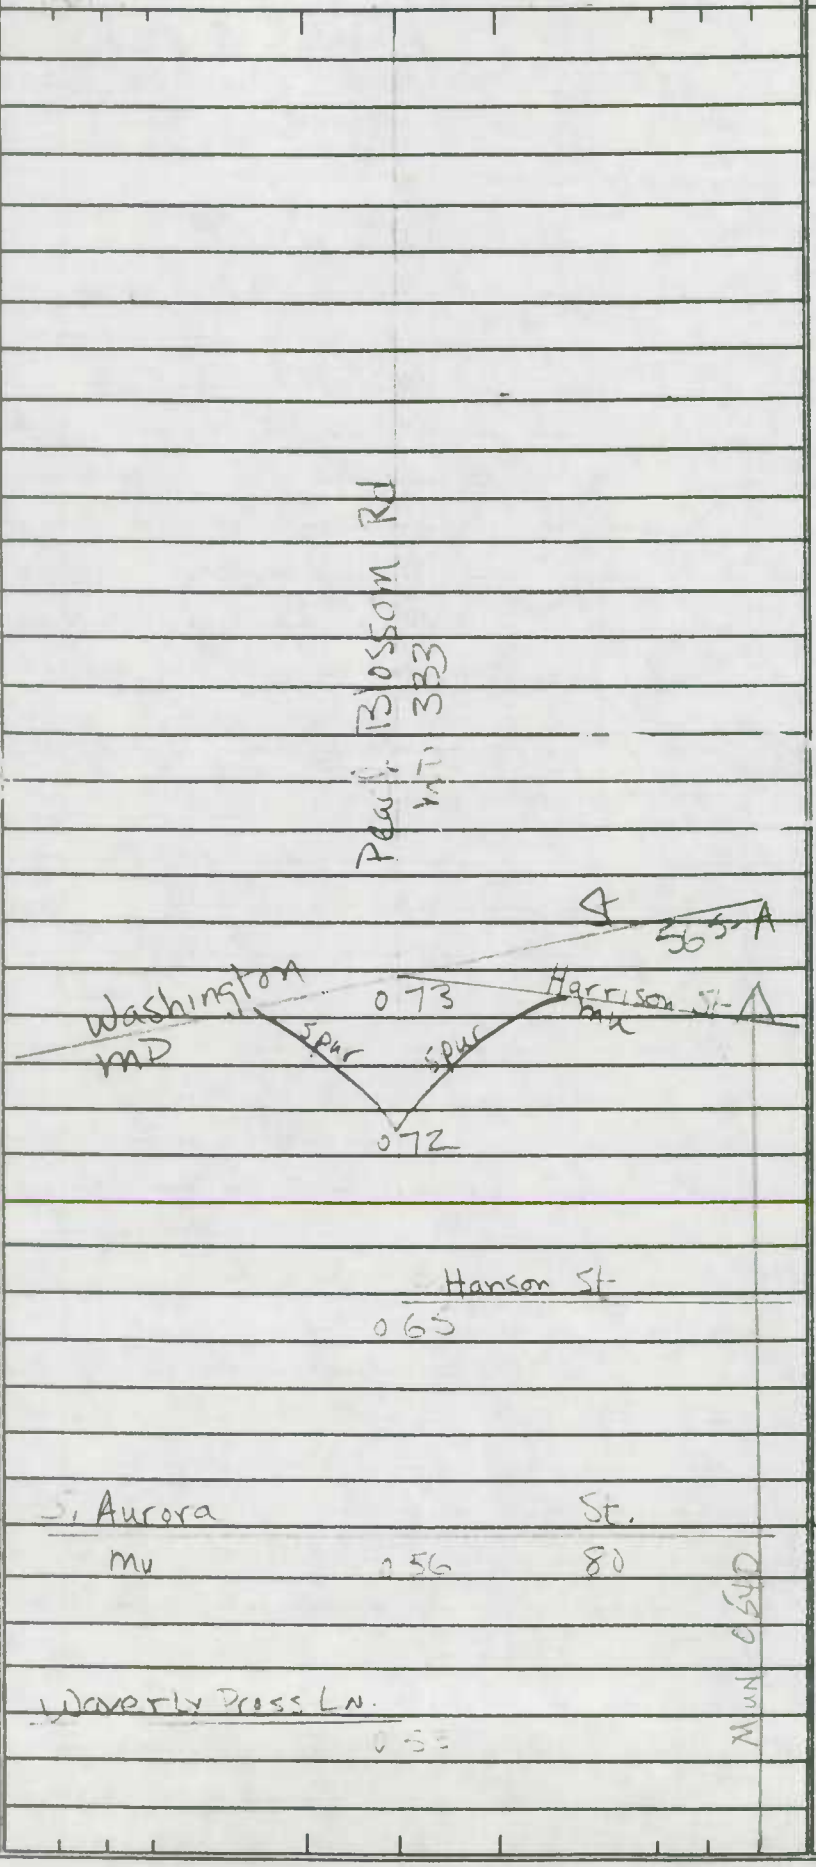

FAU 7604
MINOR ARTERIAL

34'E
J-CC

Form 6 HPS (Rev. 1961)

4

ROAD INVENTORY SHEET

Party Chief F. SETTAN
Recorder T. LANDON
Chainman

T. LANDON
F. RHODES
VERIFIED
5/16/77
EHS

Road No. 0602
Name (LIBERTY LANE #2)
Sheet No. 1 OF 1
Date 7-8-66
County TALBOT

NOW COMB.
WITH MU. 603

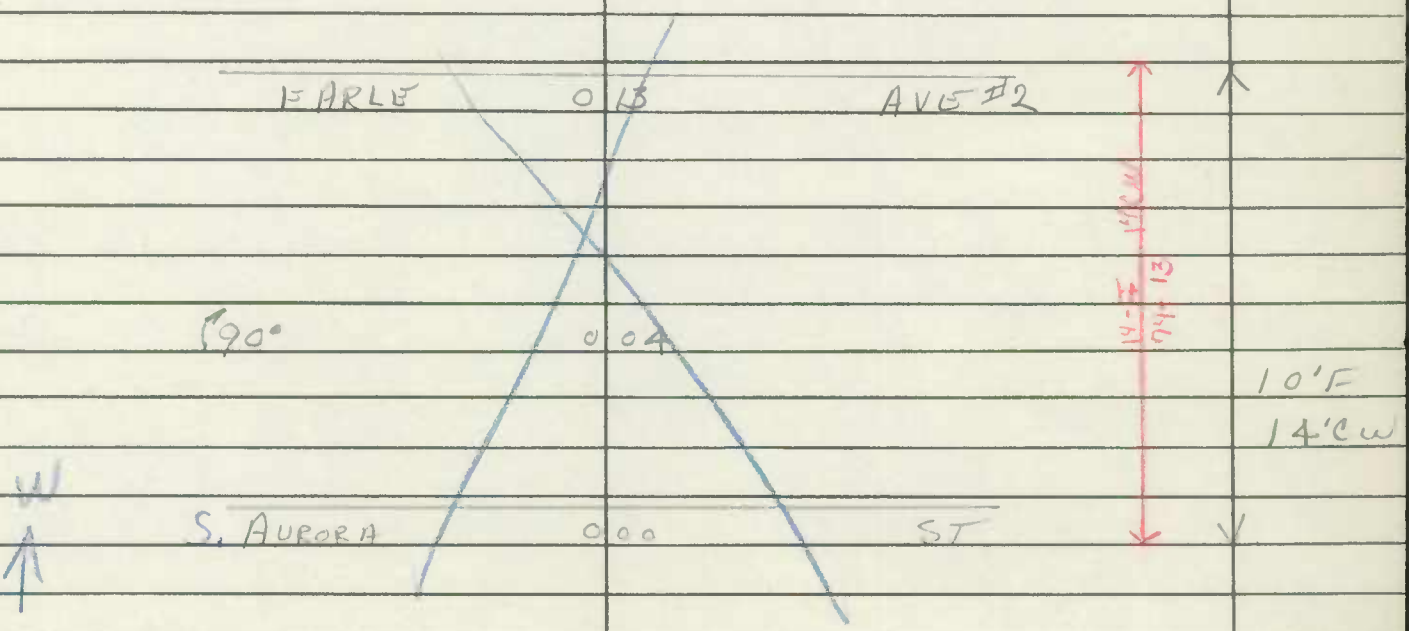

Form 6 HPS (Rev. 1961)

4/7

ROAD INVENTORY SHEET

Party Chief F. SCOTT T.L. REVISED
Recorder T. LANDON F.R. 6/76
Chainman

T. LANDON
F. RHODES
VERIFIED
5/19/77

Road No. 0680
Name MECKLENBURG AVE
Sheet No. 1 OF 1
Date 7-6-66
County TALBOT

Easton

8013

ENT. Ⓐ ROAD	0 46 ~~(BRIDGE END ST.)~~	120'G
	0 44 MUN. 0145	N 40'CH
	(WIND MILL LA.)	
	0 41 MUN ~~PROPOSED RD~~ TOT 1123	
ENT. SCHOOL	(BAINBRIDGE PL.)	
	0 36 ~~PROPOSED RD~~ TO MUN 95	
	(PREBLE LA.)	
EASTON SENIOR HIGH SCHOOL	0 33 MUN ~~PROPOSED RD~~ 885 TO2	
	(DECATUR PL.) MU 2:5	
EXIT SCHOOL	0 29 ~~PROPOSED RD~~ TO1	
	(E. PINE LA.)	
	0 25 ~~PROPOSED RD~~ 100	
	MU 843	
ENT EASTON HIGH SCHOOL	0 22 EASTOAK AVENUE	
		4-4 LT
	~~2.7~~	C-C
~~DUTCH HOUSE~~ ~~CR~~ MU	0 00 293 ~~LANE~~	
5		

SHA 51.3 - 8 Revised
4.83

MARYLAND STATE HIGHWAY ADMINISTRATION

Easton

ROAD INVENTORY SHEET MUN 0755

Party Chief BB
Recorder DJ
Assistant
Map No./Dir. 62 / SE
State Coordinates Easton

Road No. ~~OP~~ ~~173~~
Road Name NANCY ST
County TALBOT
Date 1-18-89
Sheet No. 1 OF 1

Mun. 88-39

89-44

TRAFFIC CODES

TRAFFIC CONTROLS: STOP SIGN=SS, TRAFFIC LIGHT=T.L., FLASHING RED BALL=F.R.

TRAFFIC CODES

PARKING RESTRICTIONS: A.M. PEAK, P.M. PEAK, A.M./P.M. PEAK, NO PARKING ANYTIME=N.P., COMM/IND. ACCESS=E

SYSTEM				TRAFFIC		LINE DIAGRAM	TRAFFIC			PAVEMENT DATA
FED. AID.	FUNCT CLASS.	HWY. SYS.	HPMS SAMPLE	PKG. REST.	COM/IND. ACCESS		CONTROL	COM/IND. ACCESS	PKG. REST.	

Proposed

(FRANCIS ST)

0 14 ~~OP 172~~
MU 0378

DT 0 10

40°

PC 006

Shirley Dr

MUN ~~OP~~ 000 ~~174~~ 0906

SS

36 I
J-CC

SYSTEM				TRAFFIC		LINE DIAGRAM	TRAFFIC			PAVEMENT DATA
FED. AID.	FUNCT. CLASS.	HWY. SYS.	HPMS SAMPLE	PRKG. REST.	COM/IND ACCESS		CONTROL	COM/IND ACCESS	PRKG. REST.	

Form 6 HPS (Rev. 1961)

ROAD INVENTORY SHEET

NORTH ST. 4

Party Chief F. SETTAN
Recorder T. LANDON
Chainman

F. LANDON
F. RHODES
VERIFIED
5/13/67
EASTON

Road No. ~~0812~~ 0775
Name ~~(PARRIS LANE TO~~
Sheet No. 1 OF 1
Date 7-11-66
County TALBOT

MUN. 0810
(PARRIS ~~0 04 011~~ LANE)

14' ~~XI~~
18' CW

MUN 0800
PARK ~~000007~~ ST.

LOMAX ST.
MUN 0625 003

20' E
~~20' CW~~
34' I
40' CW

ROAD 000 END

Form 6 HPS (Rev. 1961)

4

ROAD INVENTORY SHEET

Party Chief E. SOTTAN
Recorder T. LANDON
Chainman

T. LANDON
F. RHODES
VERIFIED
EASTON 27

Road No. 0800
Name PARK ST
Sheet No. 2 OF 2
Date 7-6-66
County TALBOT

ROAD	0 50 44	END		
				12'E
				14'CW
NORTH		ST	MUN. ~~0812~~ 0775	
~~PARTS~~	0 42	~~LANE #2~~		×
MUN		9132		18'C
(SCOTT'S	0 40	ALLEY #2)		24'CW
		ST		
~~GOLDSBOROUGH~~ ~~AV~~ MUN.	0 37	430	~~220~~	×
MUN		9110		20'H
(POWELL'S	0 34	ALLEY)		C-C

Form 6 HPS (Rev. 1961)

(85-16) 8 B/1 1-20-86

4

ROAD INVENTORY SHEET

Party Chief F. SETTIN
Recorder T. LANDON
Chainman

T. LANDON
Revised 1-15-77 WD
E. RHODES VERIFIED
DT 5/13/77

TL REV. F.R. 1/26/77 RM 1-25-85 A.I.

EASTON

Road No. 0810
Name (PARRIS LANE)
Sheet No. 1 OF 1
Date 7-6-66
County TALBOT

ROAD	0	23	END	
~~ROAD~~			~~END~~ DOVE LA)	
	0	20	MUN ~~Rural Rd~~ 73-9	
73-9 Lomax	0	17	ST.	12'E
	0	14	OF (Branch) 107	16'W
	0	11	HOWARD ST 0530	
			MUN ~~0560~~	
	0	08	(KRSTEN LANE)	
			MUN ~~0320~~	14'E
	0	04	ELIZABETH ST	18'W
NORTH ST (~~PARRISLANE #2~~ MV. 0775)	0	02		
			9132	14'E
MUN. (SCOTTS	0	00	ALLEY #2)	18'W

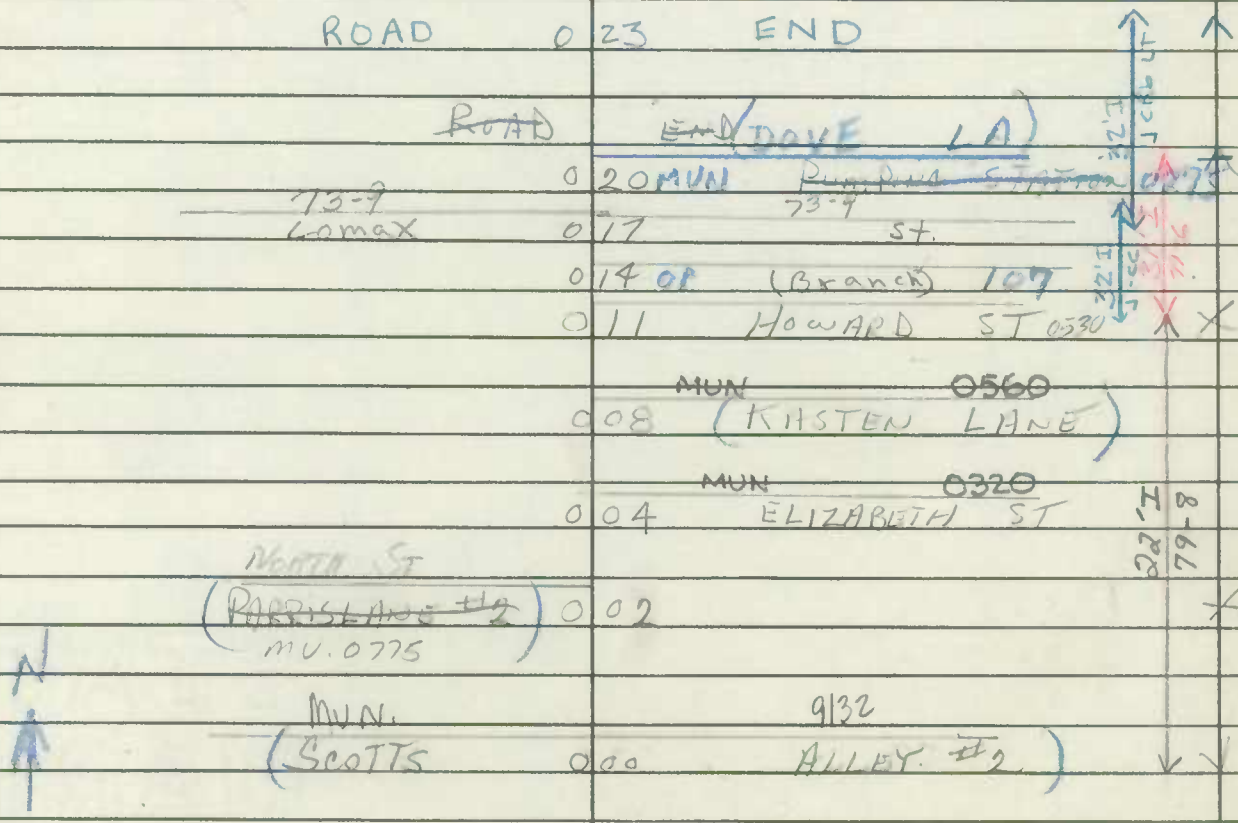

Form 6 HPS (Rev. 1961)

ROAD INVENTORY SHEET

Party Chief F. SETTAN
Recorder T. LANDON
Chainman

T. LANDON
F. RHODES
VERIFIED
5/13/77
EASTON A/T

Road No. 0830
Name PENNSYLVANIA AVE
Sheet No. 1 OF 1
Date 7-7-66
County TALBOT

ABREV
FR 5-24-83

824

99.3 A/T

MUN 0220 CHERRY ST	0	26		
MUN 9040 (MARTINS ALLEY)	0	23		20'I
MUN 220 NORTH ST	0	20		26'CW
MUN 905 (SCOTT'S ALLEY)	0	17		20'BI
MUN	0	14	+30 ST	C-LT 24'I
MUN 9110 (POWELL'S ALLEY #2)	0	11		JC-LT 30'CW
MUN AUGUST	0	08	60 ST	
9152 MUN (SMITH'S ALLEY #2)	0	05		
DOVER ST MUN 260	0	02		20'I
DOVER MD	0	00	331 RD	C-LT

SHA 51.3-8
11-15-72

STATE HIGHWAY ADMINISTRATION OF MARYLAND

ROAD INVENTORY SHEET

MUN. 835

Party Chief T. LANDON
Recorder F. RHODES
Helper

Map No.

EASTON

Road No. OP 444
Road Name Pin Oak Way
Sheet No. 1 OF 1
Date 5/16/77
County TALBOT
State Coordinates 1068-333

(85-59/66) RB/AL 1-20-86

TRANS — 72-73

See NEW INV. 87-29 BB/TM 1-12-88

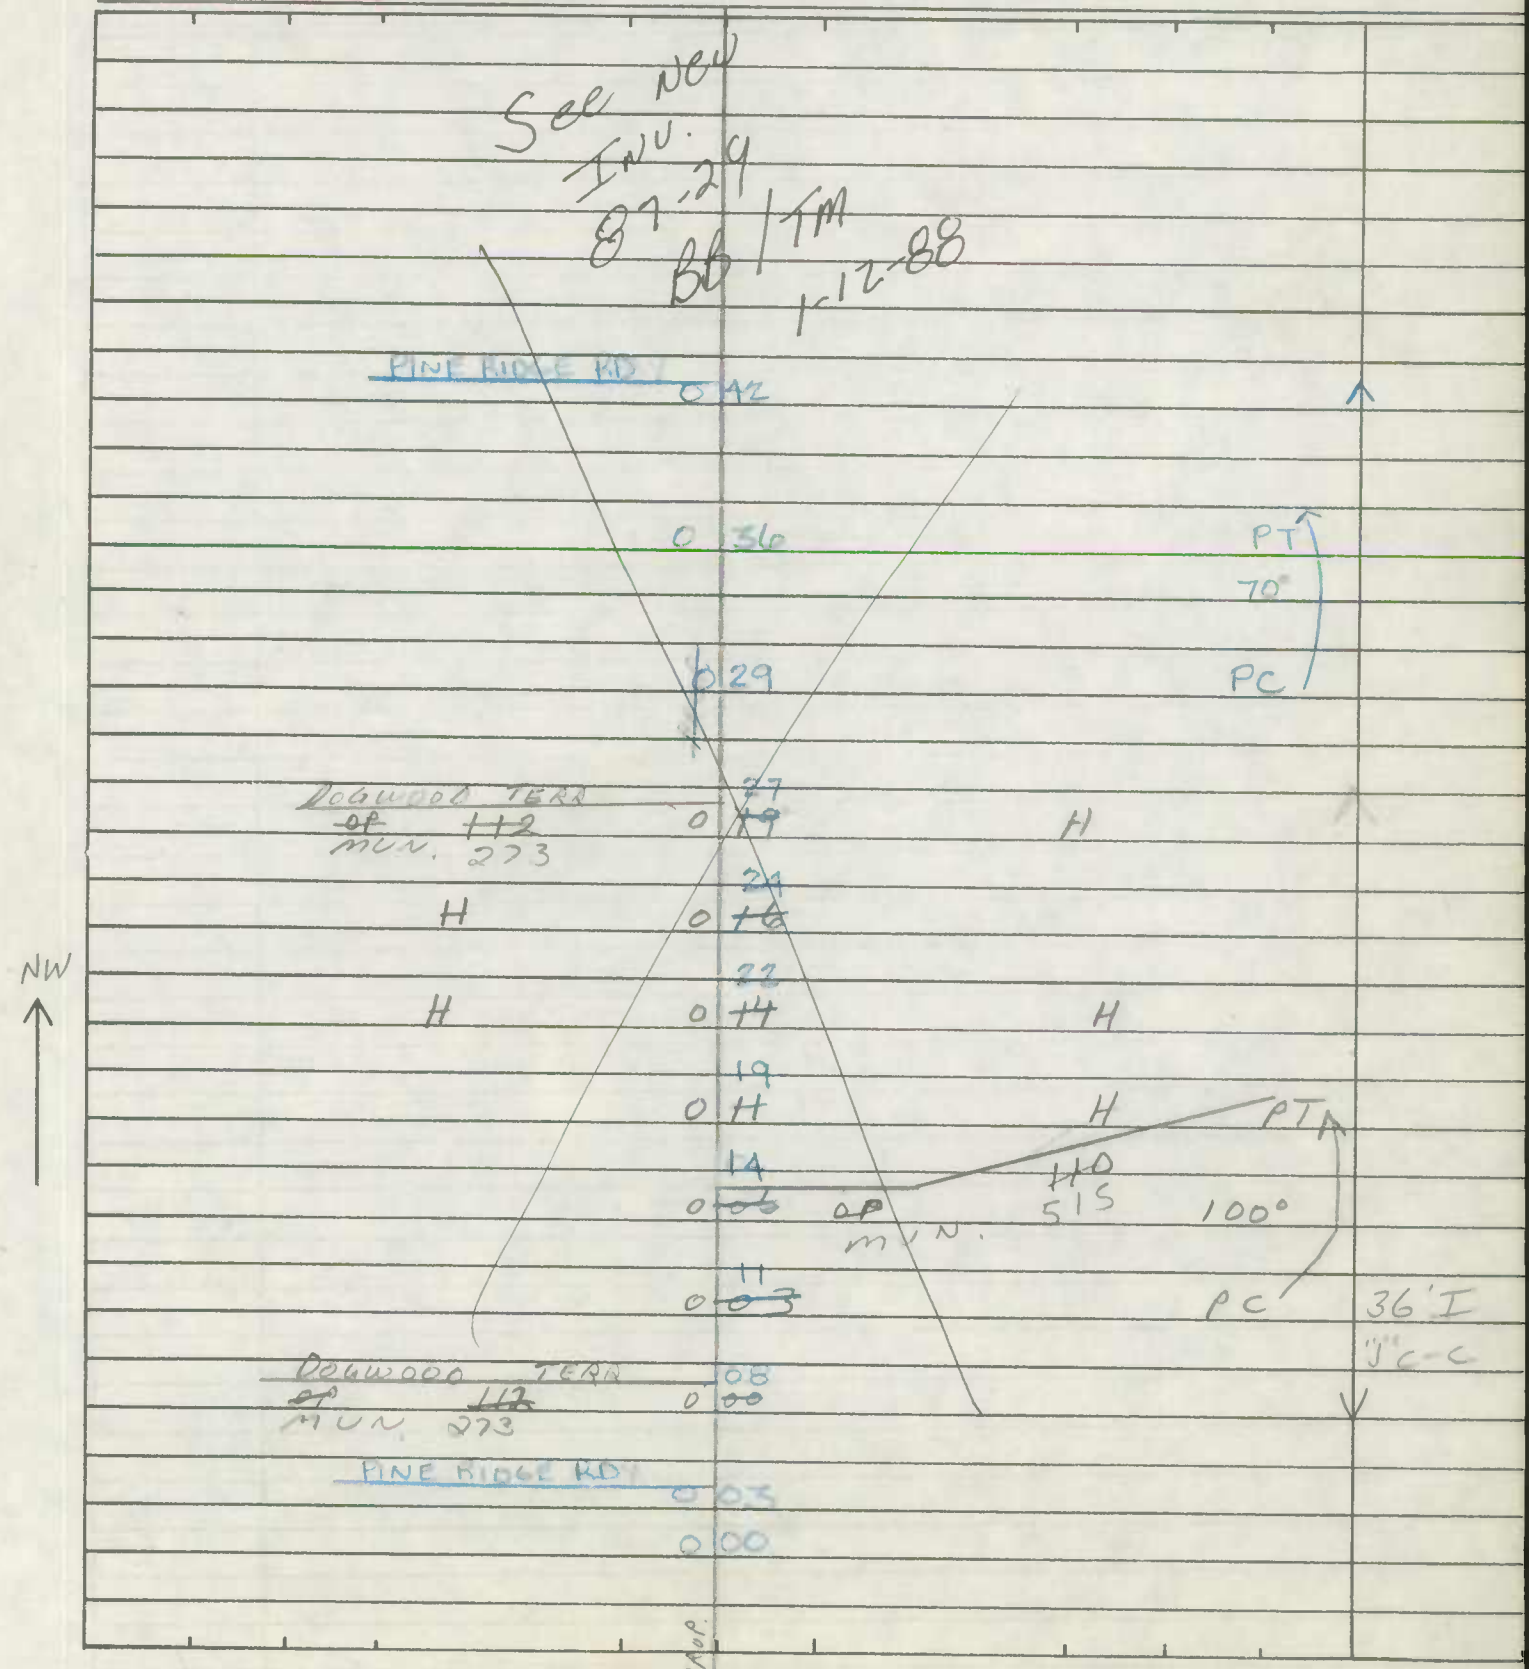

SHA 51.3-8
11-15-72

ROAD INVENTORY SHEET

Road No. _____
Road Name _____
Sheet No. _____
Date _____
County _____
State Coordinates _____

Form 6 HPS (Rev. 1961)

4

ROAD INVENTORY SHEET

Party Chief F. SETTAN — T. LANDON
Recorder T. LANDON — F. RHODES
Chainman

VERIFIED 5/16/77 A/T EASTON

BB REV. FR 2-2-81

Road No. 0890
Name PROSPECT AVE
Sheet No. 1 OF 1
Date 7-6-66
County TALBOT

DOVER MD	033 044	RD 331	↑
(FRONT	~~027~~ 040	LANE)	
SOUTH	~~025~~ 036	ST	
N ↑ HIGH	~~011~~ 022	ST	34'I C-C
(NEEDWOOD MU	~~011~~ 002	AVE #2)	
			80-9
CUL	0 00 D E	SAC	↓

Form 6 HPS (Rev. 1961)

ROAD INVENTORY SHEET

Party Chief F. SETTAN
Recorder T. LANDON
Chairman

T. LANDON
F. RHODES
VERIFIED
5/12/67
EASTON

Road No. 0900
Name ST. AUBINS TERR.
Sheet No. 1 OF 1
Date 7-12-66
County TALBOT

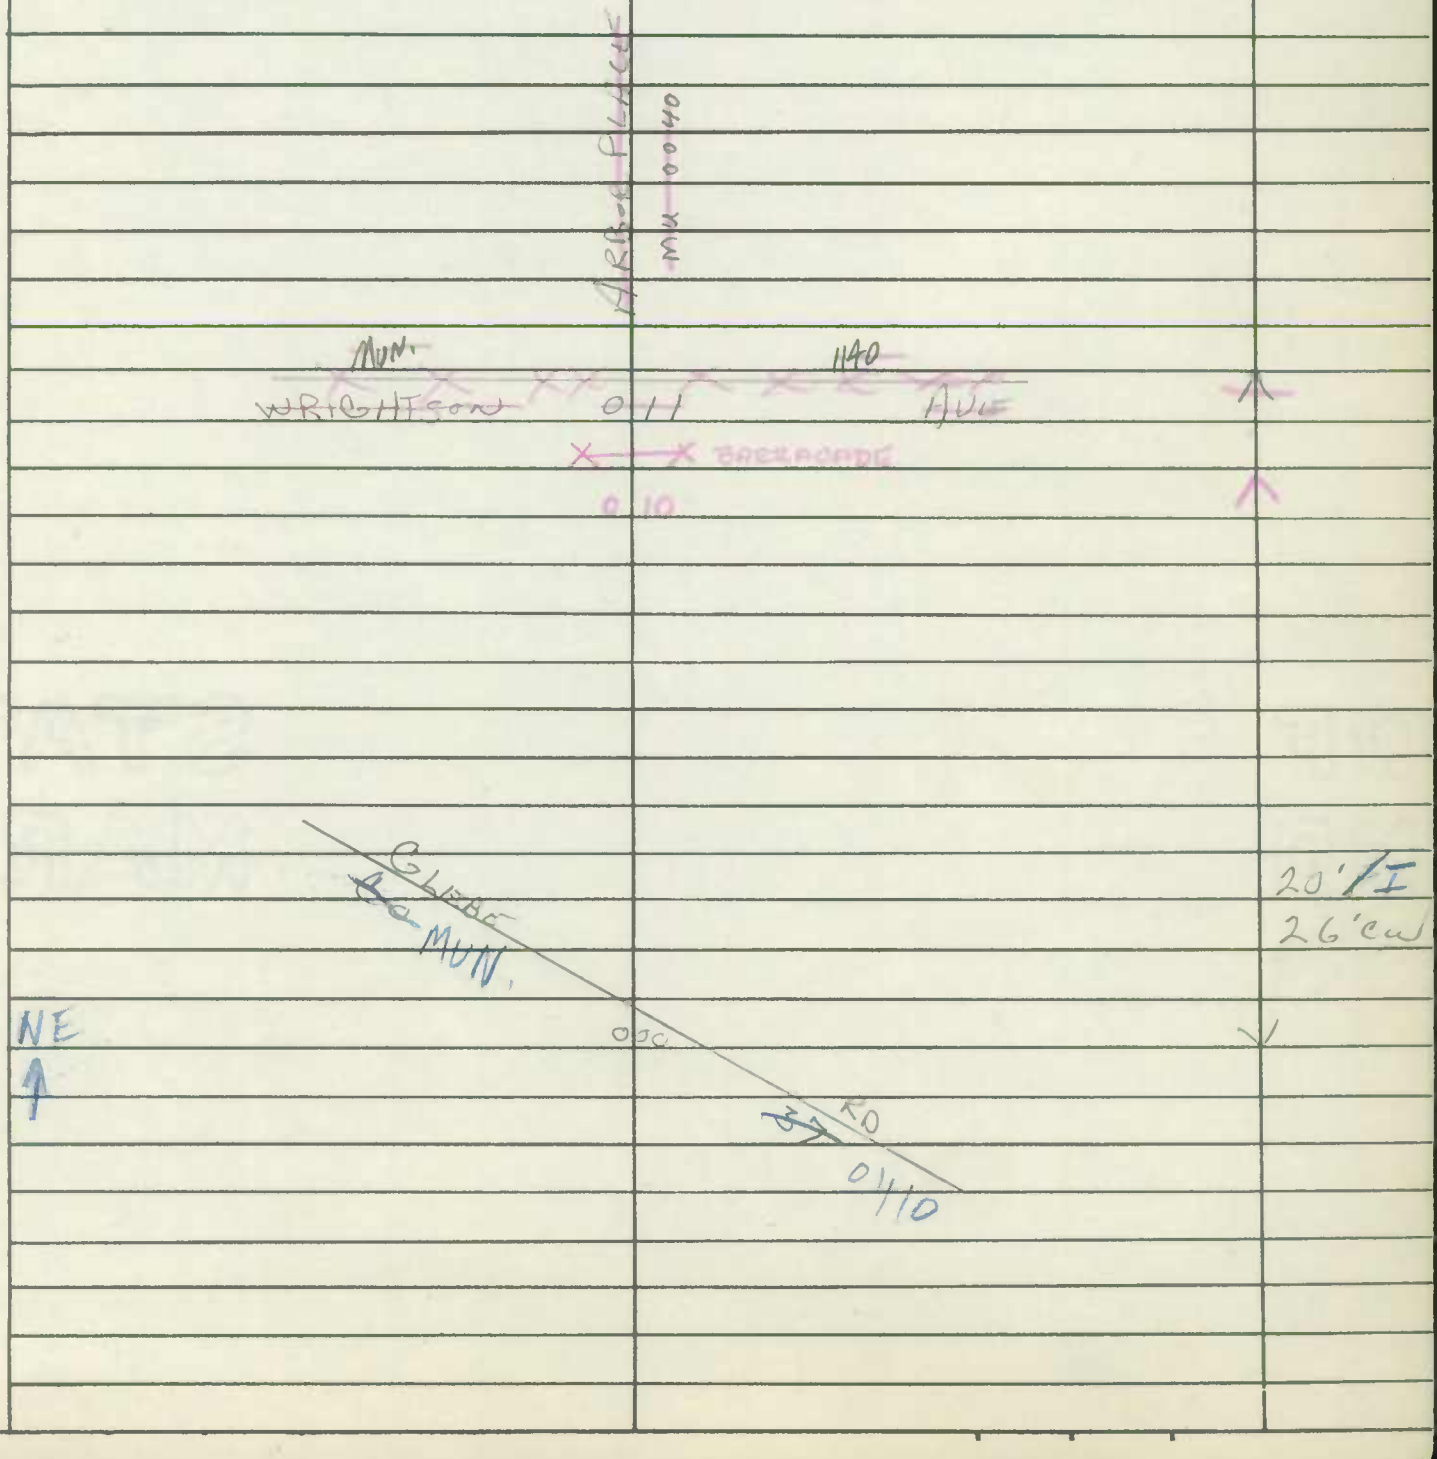

Form 6 HPS (Rev. 1961)

FCR-93
CDAH
41/MS

276+19

ROAD INVENTORY SHEET

Party Chief F. SEITZ
Recorder T. LANDON
Chainman

T. LANDON
F. RHODES
VERIFIED
5/16/27
EAST 2 27

Road No. 0922
Name SOUTH STREET #2
Sheet No. 1 OF 1
Date 7 - 7 - 26
County TALBOT

A TAKEN 77-10

93-25

URBAN / LOCAL	ROAD	0	43	END	
	MUN 9020 (GRAHAMS ALLEY)	0	40	SEE NEW INV. 6D / AH 4-10-95 FCR-95	
	MUN 490 S. HIGGINS	0	34	ST	
	MUN S. LOCUST	0	30	620 ST	30'C C-C
FA	MUN S. AUBURN	0	25	90 ST	X
NON URBAN / COLLECTOR	MUN ~~THOROUGHGOOD~~ THOROGOOD	0	21	1010 LANE	30'I C-C
	MUN S HANSON	0	17	450 ST	
	MUN TALBOT	0	12	970 LANE	~~30'I C-C~~
	MUN S. HARRISON	0	08 007	490 ST CHURCH	30'I C-C
	~~S WASHINGTON~~ MD	0	00	ST 565 A	

Form 6 HPS (Rev. 1961)

4

ROAD INVENTORY SHEET

T. LANDON
F. RHODES
VERIFIED
5/16/77
EASTON

Party Chief F. SETTAN
Recorder T. LANDON
Chainman

Road No. 0950
Name STEWART ST
Sheet No. 1 OF 1
Date 7-8-66
County TALBOT

MUN		470		
S. HARRISON	0	16	ST	
MUN		9160		
	0	12	(WILSON ALLEY #2)	
MUN		450		
S. HANSON	0	08	ST	
MUN		603		
	0	04	(LIBERTY LANE #3)	
				23.5' I
				C-L
W				
MUN		90		
S. AURORA	0	00	ST	

SHA 51.3 - 8 Revised
4.83

MARYLAND STATE HIGHWAY ADMINISTRATION

ROAD INVENTORY SHEET

OP 0175

Party Chief BB
Recorder TM
Assistant
Map No./Dir. 1 W
State Coordinates EASTON

Road No. MU 0985
Road Name TALBOT VILLAGE
County TALBOT
Date 2.6.91
Sheet No. 1 OF 1

90-2

TRAFFIC CODES
TRAFFIC CONTROLS: STOP SIGN=SS, TRAFFIC LIGHT=T.L., FLASHING RED BALL=F.R.

TRAFFIC CODES
PARKING RESTRICTIONS: A.M. PEAK, P.M. PEAK, A.M./P.M. PEAK, NO PARKING ANYTIME=N.P., COMM/IND. ACCESS=E

SYSTEM FED. AID.	SYSTEM FUNCT CLASS.	SYSTEM HWY. SYS.	SYSTEM HPMS SAMPLE	TRAFFIC PRKG. REST.	TRAFFIC COM/IND. ACCESS	LINE DIAGRAM	TRAFFIC CONTROL	TRAFFIC COM/IND. ACCESS	TRAFFIC PRKG. REST.	PAVEMENT DATA
						(ROAD) 0 25 END			X	
						0 21 SPEED BUMP				
						0 19 90°				
						0 18 ENT TO T H.		E		
						0 17 SPEED BUMP				
				E	ENT TO [illegible]	0 14				
						0 12 SPEED BUMP				
						0 11 ENT TO T.H		E		26'I
										I C·C
										2 UML
						0 09			X	
				E	ENT TO T H.	0 08 ENT TO T.H.		E		
				E	ENT TO T.H.	0 06				
						0 03 ENT TO T H		E		
										38'I
				E	ENT TO T.H.	0 02				JC·C
										2 UML
						N WASHINGTON ST				
						MD 0 00 565-A	SS		V	

K MUN 0985 K OP 175

Form 6 HPS (Rev. 1961)

TLVER. FR. 5/11/77 PRIVATE 85-3

4

ROAD INVENTORY SHEET

~~MUN 0990~~ OP 94

Party Chief T. LANDON
Recorder W. WARFIELD
Helper

EXTRA

Road No.
Road Name TALBOT VILLAGE
Sheet No. 1 OF 1
Date 1-20-71
County TALBOT

79-2

UNASSIGNED

ROAD 0 25 END

0 19 ENT. APTS. 80° ↑ 24' I "I" C-C

PARKING LOT 0 15

0 11 ENT. APTS.

↑ 20° 0 09

NW ↑ 0 05 15° ↑ 40' I "J" C-C

N. WASHINGTON ST.

MD 0 00 365 BA

Form 6 HPS (Rev. 1961)

ROAD INVENTORY SHEET

Road No. _____
Road Name _____
Sheet No. _____
Date _____
County _____

Form 6 HPS (Rev. 1961)

Easton

4

ROAD INVENTORY SHEET

MUN 1090

T. LANDON - F. RHS VERIFIED 5/17/77

83-31
1/31/84
FRONS

Road No. MD 565 A
Road Name WASHINGTON ST.
Sheet No. 2 of 5
Date 1-20-11
County TALBOT

VINE ST. 85-31

	1	79 MU 1070			
BIERY ST. MUN 100	1	73			
		BROCKLETT BAIE.			
	1	71 MUN 160 (Brook LA.)			38'I J-CC
	1	67 MUN. 0150			
ENT. HOSPITAL	1	66			44'I J-CC
EXIT Hospital	1	64			
EARLE	1	63 AVE. MUN 300			38'I "J"C-C
	1	55			
PENN	1	51			
PENN.	1	48 (PENN) Av. M.R.			
	1	30 S. WEST ST. 0.02/12' I "J" C-C			30'I "J" C-C
MD 333 0.02/18' I "J" C-C	1	29 0.02/16' I "J" C-C IDLEWILD AVE.			38'I "J" C-LT.
CHURCH	1	28 N. ST. 12'			
	1	23 AUBURN ST. SCHOOL			32'I "J" C-LT. 6' E SHLD. LT. 40' CUR
		DUTCHMANS LA.			
	0	38 Co 95 MU 293 MYRTLE LA.			
	0	37 MUN 750			
		ELM AVE. MU 340			
	0	34			
					SAME

MUNICIPAL 2 MOSTLY PAVED MD 565 A

Form 6 HPS (Rev. 1961)

N. WASH. ST. 4

ROAD INVENTORY SHEET

Party Chief: T. LANDON
Recorder: W. WARFIELD
Helper:

Road No.: MD 565 BA
Road Name: S. WASHINGTON ST.
Sheet No.: 3 of 5
Date: 1-20-71
County: TALBOT

BB REV.
FR 2-2-81
5-24-83

825

81-16

EASTON UTILITIES PLANT 225 — 44' I

HARRISON MU 470 ST. — "J" C-C

229 — X 29' I

GRADED — "J" C-C

219 — X

218

BAY ST — 30' / 40' I

MD 33 — 217 — "J" C-C

215 — X 2 ML

10' I — 211 GOLDSBOROUGH ST. — 28' I

207 MUN MD 328 — X T C-C

FEDELA ST. — 2 ML

MUN 360 — 204 — X 52' I

COURT HOUSE — 202 — "J" C-C

DOVER ST — 2 TFC LINES

MUN 200 — 199 — X 30' I

196 — "J" C-C

GLENWOOD AVE. 192 — 2 ML

MUN 420 — 193 — 22 I

GLENWOOD AVE — J C C

MU 420 — 192 — X

FOLT ST. — 34' I

MUN 880 — 186 — J C C

SOUTH ST.

MUN 770 — 184 — X

27' I

"J" C-C

FPS 112

ST

W. MAIN ST.

Municipal Parking Lot

NO PARKING 15 TABLED

 

Form 6 HPS (Rev. 1961)

TL VER. FR. 5/11/79

ROAD INVENTORY SHEET

Party Chief F. SETTIN
Recorder T. LANDON
Chairman

Road No. 1140
Name WRIGHTSON AVE
Sheet No. 1 OF 1
Date 7-12-66
County TALBOT

EASTON

91-05 A/T

SEE NEW INV
GD AH PCR-95
4-10-95

N. WASHINGTON MD 0 23 ST

565-A

~~COLONIAL MALL~~ (Gunther Ln)

0 18 MUN 9015

MUN 390
GARDEN ST 013

MUN 40
ARBOR PLACE 009

MUN 900
ST. AUBINS TERR

MUN 100
DIAMOND ST 004

NAUBERA ST. MUN 0090

FA NON CONVENTIONAL URBAN

SF

34'F
C-C

ED 51
0410

ALLEE MUN.

SHA 51.3-8
11-15-72

STATE HIGHWAY ADMINISTRATION OF MARYLAND

92-10,92 MU 6.72
GD/AH
2-3-92

ROAD INVENTORY SHEET ~~COLONIAL HEIGHTS A1~~

Party Chief I. LANDON
Recorder E. RHODES
Helper _____

Map No. _____ BB 84-9 NE RM 1-25-95

EASTON

Road No. MUN. ~~8080~~ 9015
Road Name ~~ALLEY 8~~ (Gunther LANE)
Sheet No. 1 OF 1
Date 5/12/77
County TALBOT
State Coordinates _____

86-4 BG
2-11-87 TM
A/T

NE

WRIGHTSON AVE.
MUN. 0 1006 1140

COLONIAL HEIGHTS (COURTS)
MUN. 0238 0040

12'E
16'CW

0 0 0

ROAD END

SHA 51.3-8
11-15-72

ROAD INVENTORY SHEET

Road No. _____
Road Name _____
Sheet No. _____
Date _____
County _____
State Coordinates _____

Form 6 HPS (Rev. 1961)

4 C

ROAD INVENTORY SHEET

(GRAVEL ALL.)

Party Chief F. SOTTAK
Recorder T. LANDON
Chainman

T. LANDON
F. RHODES
VERIFIED
5/13/77
EASTON

Road No. 9030
Name ~~(GRAVES ALLEY~~)
Sheet No. 1 OF 1
Date 7-12-66
County TALBOT

MUN. 9060
~~00~~ 003 (NEW ALLEY)

18'F
22'CW

0470
~~00~~ 000 ST

MUN.
HARRISON
N.

WASHINGTON
MD

ST
565

SHA 51.3-8
11-15-72

STATE HIGHWAY ADMINISTRATION OF MARYLAND

ROAD INVENTORY SHEET

Party Chief F SETTAN
Recorder T LANDON
Helper

Map No. VER-TLEFR 5/13/77

Permit 8-2151 JTSC EASTON

Road No. G9030 AL
Road Name GRAVEL AL
Sheet No. 1 of 1
Date 7-12-66
County TALBOT
State Coordinates

E

NEW ALLEY
0 03 9060

ST
0 03 470

HARRISON
MD

18' F
22' Cu

SHA 51.3-8
11-15-72

ROAD INVENTORY SHEET

Road No. _____
Road Name _____
Sheet No. _____
Date _____
County _____
State Coordinates _____

Form 6 HPS (Rev. 1961)

ROAD INVENTORY SHEET

Party Chief F. SUTTON
Recorder T. LANDON
Chainman

T. LANDON
F. RHODES
VERIFIED
77
EASTON

Road No. 9120
Name REAR ALLEY
Sheet No. 1 OF 1
Date 7-8-66
County TALBOT

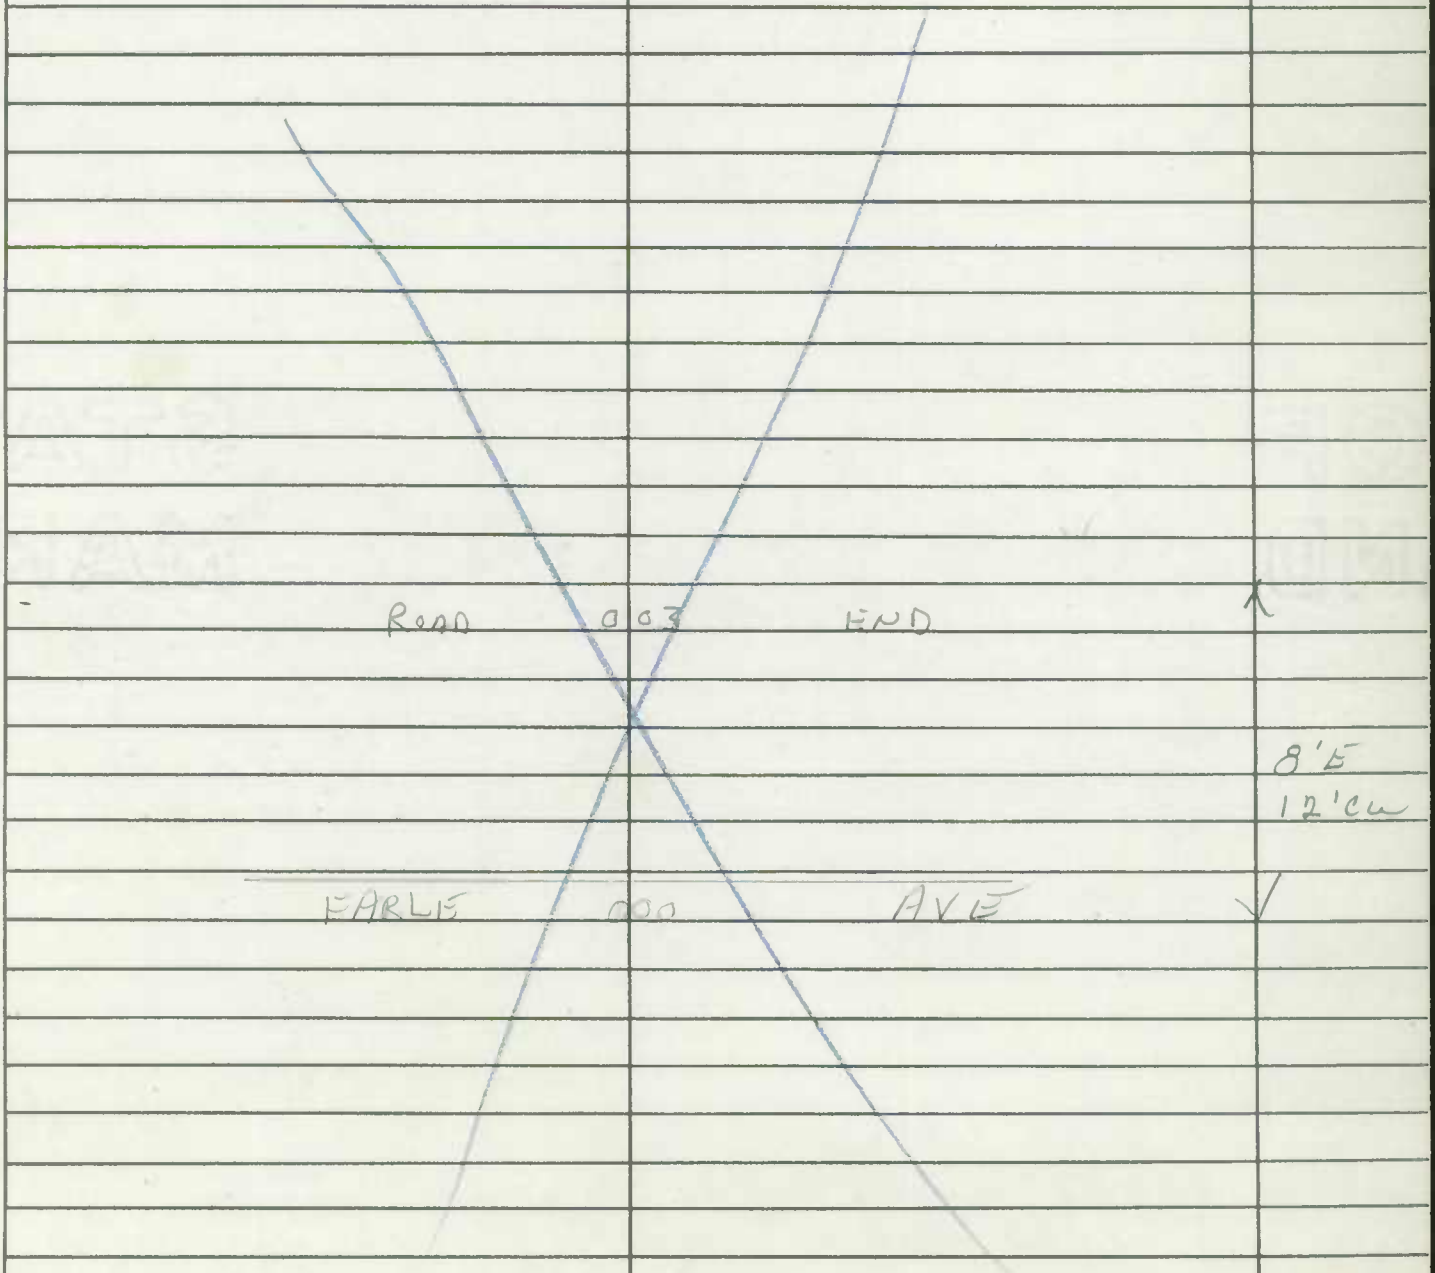

Form 6 HPS (Rev. 1961)

ROAD INVENTORY SHEET

Party Chief F. SCOTTEN
Recorder T. LANDON
Chainman

F. LANDON
F. RHODES
VERIFIED
5/13/77
EASTON

Road No. 9132
Name (SCOTTS ALLEY #2)
Sheet No. 1 OF 1
Date 7-6-60
County TALBOT

Form 6 HPS (Rev. 1961)

4

ROAD INVENTORY SHEET

EASTON POINT RD

Party Chief F SETTAN
Recorder T. LANDON
Chainman

T. LANDON
F. MANNOCES
VERIFIED
5/13/77
EASTON

Revised 1-15-74 WD DT 73-14

Road No. MD 33A
Name PORT ST
Sheet No. 10F2
Date 7-11-66
County TALBOT

91-11 A/T 83-19 79-21

		0 59		X
	RXR SIGN	0 55		
	RXR SIGN	0 48	RXR SIGN	
		0 42	RXR SIGN	
			Jowhite St.	
		0 41	~~to~~ ~~82~~ Mun. 0545	
			Unk ST	
		0 34	to 243	
	ROAD STATION WENDD	0 33		19'H
	~~CHP to Fe~~	X 0 26	~~at Easton~~	30'Ca.
		0 25		X
			MUN 9090	
		0 17	PLEASANT ALLEY	
	MUN		MD	
SW	S. WEST	0 07	ST	
				25 IN
				C-C
	S. WASHINGTON		ST	
	MD	0 00	565A	

Goldsboro

TANNER AT MD 314

SHA 51.3 - 8 Revised 4.83
86-4 BB
2-11-87 TM

MARYLAND STATE HIGHWAY ADMINISTRATION
EASTON
ROAD INVENTORY SHEET

~~MD 565~~ TABBED AS MD 565A

Party Chief T. Landon
Recorder F. Rhodes
Assistant Rewritten 10-21-87 KJP
Map No./Dir. 21-inset / N
State Coordinates 1065-335

Road No. MD 565-A
Road Name S. Washington ST.
County Talbot
Date 7-12-84
Sheet No. 1 OF 8

SYSTEM: FED. AID. | FUNCT. CLASS. | HWY. SYS. | HPMS SAMPLE
TRAFFIC: PRKG. REST. | COM/IND. ACCESS

LINE DIAGRAM

TRAFFIC: CONTROL | COM/IND. ACCESS | PRKG. REST.

PAVEMENT DATA

TRAFFIC CODES
TRAFFIC CONTROLS: STOP SIGN=SS, TRAFFIC LIGHT=T.L., FLASHING RED BALL=F.R.

TRAFFIC CODES
PARKING RESTRICTIONS: A.M. PEAK, P.M. PEAK, A.M./P.M. PEAK, NO PARKING ANYTIME=N.P., COMM/IND. ACCESS=E

NON F/A URBAN Collector

PT
0|36
24' I
3' E shd RT
10' E shd. LT
50' CW
2 ML

MALLARD BRIDGE
0|34
25°

0|31 X

PC
0|28 Tennis Club
E

0|15 Proposed

0|06
PT
90°

Service Rd
0|01 0.15/18' I
PC
24' I
2-10' I shd.
50' CW
2 ML

V V
MD
0|00
322

SYSTEM: FED. AID. | FUNCT. CLASS. | HWY. SYS. | HPMS SAMPLE
TRAFFIC: PRKG. REST. | COM/IND ACCESS

LINE DIAGRAM

TRAFFIC: CONTROL | COM/IND ACCESS | PRKG. REST.

PAVEMENT DATA

NON FLA
URBAN Collector
Municipally Maintained - Transferred - August 25, 1987

ELM Ave. #2
0 84 Mu. 0342

(Cedar La.)
0 80 Mu. 0200

OAK Ave.
Mu. 0 77 0 782

(Pine La.)
0 73 Mu. 0840

Papermill St
MP 0795 072

MAPLE Ave.
0 70 Mu. 0640

20' I
2-10' I shd.
2 ML

0 66 X

Papermill St
MP 0795 059

30' I
5 cb. RT.

Lee Terrace
0 58 Mu. 0590 X

—T—T—T—T—>
0 57 15°

0 50 6-48" C.P. #2028

24' I
2-3' E shd.

E Pumping Station 0 49

0 42 X

Same

SHA 51.3 - 8 Revised 4.83

MARYLAND STATE HIGHWAY ADMINISTRATION

ROAD INVENTORY SHEET

Party Chief _____
Recorder _____
Assistant _____
Map No./Dir. 21-inset / N
State Coordinates _____

Road No. MD 565-A
Road Name S. Washington ST
County Talbot
Date 7-12-74
Sheet No. 3 OF 8

TRAFFIC CODES
TRAFFIC CONTROLS: STOP SIGN=SS, TRAFFIC LIGHT=T.L., FLASHING RED BALL=F.R.

TRAFFIC CODES
PARKING RESTRICTIONS: A.M. PEAK, P.M. PEAK, A.M./P.M. PEAK, NO PARKING ANYTIME=N.P., COMM/IND. ACCESS=E

SYSTEM				TRAFFIC		LINE DIAGRAM	TRAFFIC			PAVEMENT DATA
FED. AID.	FUNCT CLASS.	HWY. SYS.	HPMS SAMPLE	PRKG. REST.	COM/IND. ACCESS		CONTROL	COM/IND. ACCESS	PRKG. REST.	
X	FALL 7603									
X	URBAN MINOR ARTERIAL		20565A000129							
						0.02/24'I, "J"c-c				
						1 30 S. HARRISON ST Mu. 0490				30'I
										"J"c-c
						Peachblossom RD				2 ML
						MD 333 1 29 Idlewild Ave Mu. 0540	TL		X	
						0.02/18'I, J c-c				
						0.02/16'I, J c-c				
				E		Church 1 28				38'I
										"J"c-LT
										2 ML
						1 23 School		E	X	
						1 04 20°				
						Linden Ave.				
						0 98 Mu. 0293				
						S. AURORA ST Mu. 0080				
						(MYRTLE La.)				
						0 87 Mu. 0750				
										Same

NON FA
URBAN Collector
Municipally Maintained 8-25-87

SYSTEM: FED. AID. | FUNCT. CLASS. | HWY. SYS. | HPMS SAMPLE
TRAFFIC: PRKG. REST. | COM/IND ACCESS

LINE DIAGRAM

TRAFFIC: CONTROL | COM/IND ACCESS | PRKG. REST.

PAVEMENT DATA

FAU 7603
URBAN MINOR ARTERIAL
Municipally Maintained
Municipally Maintained 1-8-25-87
20565A000129

Vine ST.
Mu. 1070 — 1 79 — 34' I "J" C-C

Biery ST.
Mu. 0100 — 1 73

Brooklets Ave.
1 71 Mu. 0160 — 38' I "J" C-C

(Brook La.)
1 67 Mu. 0150

E Hospital — 1 66

E Hospital — 1 64 — 44' I "J" C-C

1 63

EARLE Ave
Mu. 1 55 0300 — 38' I "J" C-C 2 ML

PT — 1 51

30° Penn. — 1 48 — RxR
Abandoned — Abandoned

PC

Historical Sign — 1 45 — Same

SHA 51.3 - 8 Revised 4.83

MARYLAND STATE HIGHWAY ADMINISTRATION

ROAD INVENTORY SHEET

Party Chief _____
Recorder _____
Assistant _____
Map No./Dir. 21-inset / N
State Coordinates _____

Road No. MD 565-A
Road Name S. Washington ST. / N. Washington ST.
County Talbot
Date 7-12-74
Sheet No. 5 OF 8

TRAFFIC CODES
TRAFFIC CONTROLS: STOP SIGN=SS, TRAFFIC LIGHT=T.L., FLASHING RED BALL=F.R.

TRAFFIC CODES
PARKING RESTRICTIONS: A.M. PEAK, P.M. PEAK, A.M./P.M. PEAK, NO PARKING ANYTIME=N.P., COMM/IND. ACCESS=E

SYSTEM				TRAFFIC		LINE DIAGRAM	TRAFFIC			PAVEMENT DATA
FED. AID.	FUNCT CLASS.	HWY. SYS.	HPMS SAMPLE	PRKG. REST.	COM/IND. ACCESS		CONTROL	COM/IND. ACCESS	PRKG. REST.	
										28' I
										J-C-C
										2 ML
						Federal ST.				
						Mu. 0360 204			X	
						N. Washington ST.				
						Historical Sign Courthouse 202				
										52' I
										J C-C
										2 ML
						DOVER ST				
						Mu. 199 0280	TL		X	
FAU 7603	URBAN MINOR ARTERIAL	Municipally Maintained			E	Parking 196				
						Glenwood Ave # 2				
						193 Mu. 0422				30' I
										J C-C
						Glenwood Ave				2 ML
						Mu. 0420 192			X	
						Port ST.				
						MD 334 186				
						South ST. #2				
						184 Mu. 0922				
										same

LINE DIAGRAM

SYSTEM: FED. AID. — FAP 308 | FUNCT. CLASS. — URBAN Other Principal Arterial | HWY. SYS. — Municipally Maintained | HPMS SAMPLE — 20565 00235

TRAFFIC: PRKG. REST. | COM/IND ACCESS

TRAFFIC: CONTROL | COM/IND ACCESS | PRKG. REST.

FAUL 7603 | FAUL 7603 | URBAN Minor Arterial | Transfer Agreement May 1, 1984

			PAVEMENT DATA
			24' I 2-10' I shld
	CREAMERY La.		Jcb. out
242	Mu. 0240	X	
			44' I J-C-C
			2 UML
235		X	
	2-17' I J-C-C 4.5 med 0101 / SPUR		
			2-20' I
			J-C-C
			4' J MED.
	GLEBE RD Mu. 0410 25°		2 M.L.
231		TL X	
E	Easton Utilities Plant		
225			
	N. HARRISON ST.		
222	Mu. 0470		44' I.
			J-C-C
			2 ML
219	Graves Alley (Aban.)	X	
218	SPUR		
	BAY ST.		
	MD 33	TL	40' I
217			J-C-C
			2 ML
213		X	
211			24' I
			J-C-C
	Goldsborough ST.		2 ML
207	Mu. 0430	X	
			Same

FAUL 7603 | U min Art | Mun. Maint.

SHA 51.3 - 8 Revised 4.83

MARYLAND STATE HIGHWAY ADMINISTRATION

ROAD INVENTORY SHEET

Party Chief _____
Recorder _____
Assistant _____
Map No./Dir. 21-inset / N
State Coordinates _____

Road No. MD 565-A
Road Name N. Washington ST.
County TALBOT
Date 7-12-74
Sheet No. 7 OF 8

SYSTEM: FED. AID. | FUNCT CLASS. | HWY. SYS. | HPMS SAMPLE
TRAFFIC: PRKG. REST. | COM/IND. ACCESS

TRAFFIC CODES
TRAFFIC CONTROLS: STOP SIGN=S.S., TRAFFIC LIGHT=T.L., FLASHING RED BALL=F.R.

TRAFFIC CODES
PARKING RESTRICTIONS: A.M. PEAK, P.M. PEAK, A.M./P.M. PEAK, NO PARKING ANYTIME=N.P., COMM/IND. ACCESS=E

FAU 7603
URBAN MINOR ARTERIAL
Municipally Maintained - 5-1-84

LINE DIAGRAM

TRAFFIC: CONTROL | COM/IND. ACCESS | PRKG. REST.

PAVEMENT DATA

Judas ST.
299 Mu. 0550 15°↑

PLUM ST
292 Mu. 0860 15°↑

Sycamore Ave.
Mu. 0960 — 290

Willis Ave
Mu. 1120 281

MT. PLEASANT AVE
277 Mu. 0730

S.E. Dukes Ave
Mu. 0291 275

24'I
2-8' Isld.
J-cb. out

Wrightson Ave
Mu. 1140 269

N. AURORA ST.
Mu. 0080

15°↑ 253

Same

LINE DIAGRAM

SYSTEM: FED. AID. | FUNCT. CLASS. | HWY. SYS. | HPMS SAMPLE
TRAFFIC: PRKG. REST. | COM/IND ACCESS
TRAFFIC: CONTROL | COM/IND ACCESS | PRKG. REST.
PAVEMENT DATA

FAU 7603
URBAN MINOR ARTERIAL
Municipality Maintained 5-1-84

PARKWAY
MD 382

3 58

EASTON
322

Centreville RD
Co. 188

MD

spur 3 53 MD 839

one WAY

E Boats 3 47

LYNNBROOK CT.
Mu. 0627 3 30

Chapel RD
3 25 Co. 14

TALBOT Village
(PVT. RD.) 3 21

Laurel ST.
E church 3 05 Mu. 0580

14' I
10' H Shd. RT.
16' I Shd. LT.
"J" C-LT
1 ML

24' I
2-10' F Shd.
50' CW
2 ML

Same

Rewritten (1-8-91) JEL

90-25(Co)
80-1

SHA 51.3 - 8 Revised
4.83

MARYLAND STATE HIGHWAY ADMINISTRATION

* Was Co 199-

ROAD INVENTORY SHEET

Party Chief F. SeHAN
Recorder T. LANDON
Assistant S. MARTIN
Map No./Dir. G-12 / S
State Coordinates

Road No. MU 0005
Road Name ATLANTIC AVE
County Talbot
Date 6-7-66
Sheet No. 1 OF 1

TRAFFIC CODES
TRAFFIC CONTROLS: STOP SIGN=S.S., TRAFFIC LIGHT=T.L., FLASHING RED BALL=F.R.

TRAFFIC CODES
PARKING RESTRICTIONS: A.M. PEAK, P.M. PEAK, A.M./P.M. PEAK, NO PARKING ANYTIME=N.P., COMM/IND. ACCESS=E

SYSTEM				TRAFFIC		Oxford LINE DIAGRAM	TRAFFIC			PAVEMENT DATA
FED. AID.	FUNCT CLASS.	HWY. SYS.	HPMS SAMPLE	PKG. REST.	COM/IND. ACCESS		CONTROL	COM/IND. ACCESS	PKG. REST.	
						US Department of Commerce N.O.A.A. + National Marine Fisheries Service				
						(Rhonda Ave.)				
X	X					OP 29 0.12				
						OP 113 0.09				
K	K	NON F/A Rural Local				Riverview Ave. — Corp Lmts Oxford MU 0200 0.00				20' G 30' CW

Oxford

Mulberry St.

SYSTEM
FED. AID.
FUNCT. CLASS.
HWY. SYS.
HPMS SAMPLE
TRAFFIC
PRKG. REST.
COM/IND ACCESS
LINE DIAGRAM
TRAFFIC
CONTROL
COM/IND ACCESS
PRKG. REST.
PAVEMENT DATA

Rewritten (1-8-91) JEL

90-25(CO)
80-1

SHA 51.3 - 8 Revised
4.83

MARYLAND STATE HIGHWAY ADMINISTRATION

* Was Co 199-

ROAD INVENTORY SHEET

Party Chief F. SeHAN
Recorder T. LANDON
Assistant S. MARTIN
Map No./Dir. G-12 / S
State Coordinates

Road No. MU 0005
Road Name ATLANTIC AVE
County Talbot
Date 6-7-66
Sheet No. 1 OF 1

TRAFFIC CODES
TRAFFIC CONTROLS: STOP SIGN=S.S., TRAFFIC LIGHT=T.L., FLASHING RED BALL=F.R.

TRAFFIC CODES
PARKING RESTRICTIONS: A.M. PEAK, P.M. PEAK, A.M./P.M. PEAK, NO PARKING ANYTIME=N.P., COMM/IND. ACCESS=E

SYSTEM				TRAFFIC		LINE DIAGRAM (Oxford)	TRAFFIC			PAVEMENT DATA
FED. AID.	FUNCT CLASS.	HWY. SYS.	HPMS SAMPLE	PRK.G. REST.	COM/IND. ACCESS		CONTROL	COM/IND. ACCESS	PRK.G. REST.	
						US Department of Commerce N.O.A.A. + National Marine Fisheries Service				
						(Rhonda Ave.)				
X	X					OP 29 0.4			X	
						OP 113 0.09				
						Riverview Ave. — Corp Lmts Oxford				20' GI 30' CW
K	K					MU 0200 0.00 ↓			Y	

NOT FIA
Rural Local

Mileage

SYSTEM				TRAFFIC		LINE DIAGRAM	TRAFFIC			PAVEMENT DATA
FED. AID.	FUNCT. CLASS.	HWY. SYS.	HPMS SAMPLE	PRKG. REST.	COM/IND ACCESS		CONTROL	COM/IND ACCESS	PRKG. REST.	

SHA 51.3 - 8 Revised 4.83

MARYLAND STATE HIGHWAY ADMINISTRATION

ROAD INVENTORY SHEET

ATLANTIC AVE ~~CO 0199~~ MU0005

Oxford

Party Chief F. SETTAN
Recorder T. LANDON
Assistant S. MARTIN
Map No./Dir. 1 S
State Coordinates

Road No. MUN 0180
Road Name S. MORRIS ST
County TALBOT
Date 6-7-66
Sheet No. 1 OF 2

TRAFFIC CODES
TRAFFIC CONTROLS: STOP SIGN=SS, TRAFFIC LIGHT=T.L., FLASHING RED BALL=F.R.

TRAFFIC CODES
PARKING RESTRICTIONS: A.M. PEAK, P.M. PEAK, A.M./P.M. PEAK, NO PARKING ANYTIME=N.P., COMM/IND. ACCESS=E

SYSTEM				TRAFFIC		LINE DIAGRAM	TRAFFIC			PAVEMENT DATA
FED. AID.	FUNCT CLASS.	HWY. SYS.	HPMS SAMPLE	PRK.G. REST.	COM/IND. ACCESS		CONTROL	COM/IND. ACCESS	PRK.G. REST.	
										20'C
										30'CW
						OP 113				
						0.40				
						Corp Limits of Oxford				
						RIVERVIEW AVE 0.31				
										20'I
										30 CW
						WILLOWS AVE 0.26				
						OP 114				
						E. PIER ST 0.20				
						MUN 160				
						0.19 W. PIER ST				
						MUN 0170				
						0.09 PLEASANT ST				
						MD 349 SPUR				24'I
						OP 118'I 0.03				30'CW
						0.00				
						333				

NON EA
RURAL LOCAL

SYSTEM				TRAFFIC		LINE DIAGRAM	TRAFFIC				PAVEMENT DATA
FED. AID.	FUNCT. CLASS.	HWY. SYS.	HPMS SAMPLE	PRKG. REST.	COM/IND ACCESS		CONTROL	COM/IND ACCESS	PRKG. REST.		

U.S. DEPT of Commerce
N.O. A.A. + National Marine Fisheries Service

OP 29

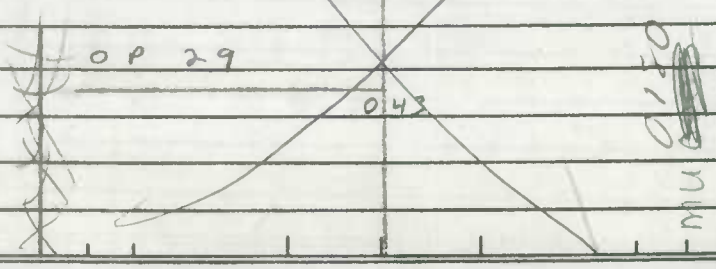

Form 6 HPS (Rev. 1961)

1039-312

ROAD INVENTORY SHEET

TL VER.
F.R. 5/17/77

Party Chief F. SETTAN
Recorder T. L ANDON
Chainman S. MARTIN

Road No. OP89
Name DIVISION STREET
Sheet No. 1 OF 1
Date 6-7-66
County TALBOT

OXFORD 0050

TOWN CREEK

H H

H ROAD 007 END

H 005

H 004

Corp limits of Oxford

003

OP 2

14'P

20'CW

Macadam

BONFIELD 002 AVE

E

Form 6 HPS (Rev. 1961)

1038-312

TL 5/17/77
FR. VER.

ROAD INVENTORY SHEET

Party Chief F. COTTON
Recorder TURNDEN
Chairman S. MARTIN

Road No. OP 88
Name EAST STREET
Sheet No. 1 of 1
Date 6-7-66
County TALBOT

OXFORD - 0070

TOWN

CREEK

H

ROAD

H

0.5

Corp limits of Oxford
0.03

20'6
26'6W

E

0.00 RONFIELD AVE.

SHA 51.3-8
11-15-72

STATE HIGHWAY ADMINISTRATION OF MARYLAND

ROAD INVENTORY SHEET

OP 114

(E. PIER ST)

Party Chief T. LANDON
Recorder F. RHODES
Helper

Map No.

OXFORD

Road No. MU 0161
Road Name ~~PIER ST EXT~~
Sheet No. 1 OF 1
Date 5/17/77
County

State Coordinates 1040-311

88-1
(92 MU EX 1,2)
CD/A. HATTEN
2/3/93

86-2

W

S. MORRIS ~~RAILROAD~~ MUN. 0 13

22 ~~AVE~~ ST 0180

0 15

J.L. THOMPSON DR ~~PVT~~ ~~ST~~ MUN ~~0400~~ 0350

0 04

0 07

SECOND ST. ~~0 80~~ MUN. 0210

CUL DE SAC

20'T 20'CW

16'G ~~20'CW~~

~~16'T~~ ~~20'CW~~ 30'T 30'CW

(92-2)

OFFICE

SHA 51.3-8
11-15-72

ROAD INVENTORY SHEET

Road No. _____
Road Name _____
Sheet No. _____
Date _____
County _____
State Coordinates _____

SHA 51.3-8
11-15-72

STATE HIGHWAY ADMINISTRATION OF MARYLAND

MU0161

ROAD INVENTORY SHEET (E. PIER ST)

Party Chief T. LANDON
Recorder F. RHODES
Helper

Map No.

OXFORD

Road No. OP 114
Road Name ~~(PIER ST EXT.)~~
Sheet No. 1 OF 1
Date 5/17/77
County
State Coordinates 1040-311

88-1
1-17-89
BB DW
(92 MD CVM 12 ODA HATTEN 2/2/93)

S. MORRIS ST
~~RAILROAD~~
MUN. 0

AVE.
0 +522 0180

55

20'I
20'CW

0 15

X 16'G
20'CW

E

J.L. THOMPSON DR 0 0412

~~PT~~ ~~SE~~
MUN

~~0410~~ 0350

0 ~~04~~ 11

+6'E
20'CW
30'~~I~~ I

SECOND ST.

0 0007 MUN. 0210

30 (86-21)

OFFICE

Cyl 0 00 Sac

D E

Form 6 HPS (Rev. 1961)

MUN. No. 0120 S. MORRIS ST

ATLANTIC AVENUE

ROAD ~~INVENTORY~~ SHEET

T. LANDON
F. RHODES
VERIFIED
5/17/77
OXFORD

Party Chief	F. SETTAN
Recorder	T. LANDON
Chairman	S. MARTIN

Road No.	Co 199
Name	~~RAILROAD AVENUE~~
Sheet No.	1 OF 1
Date	6-7-66
County	TALBOT

50-1

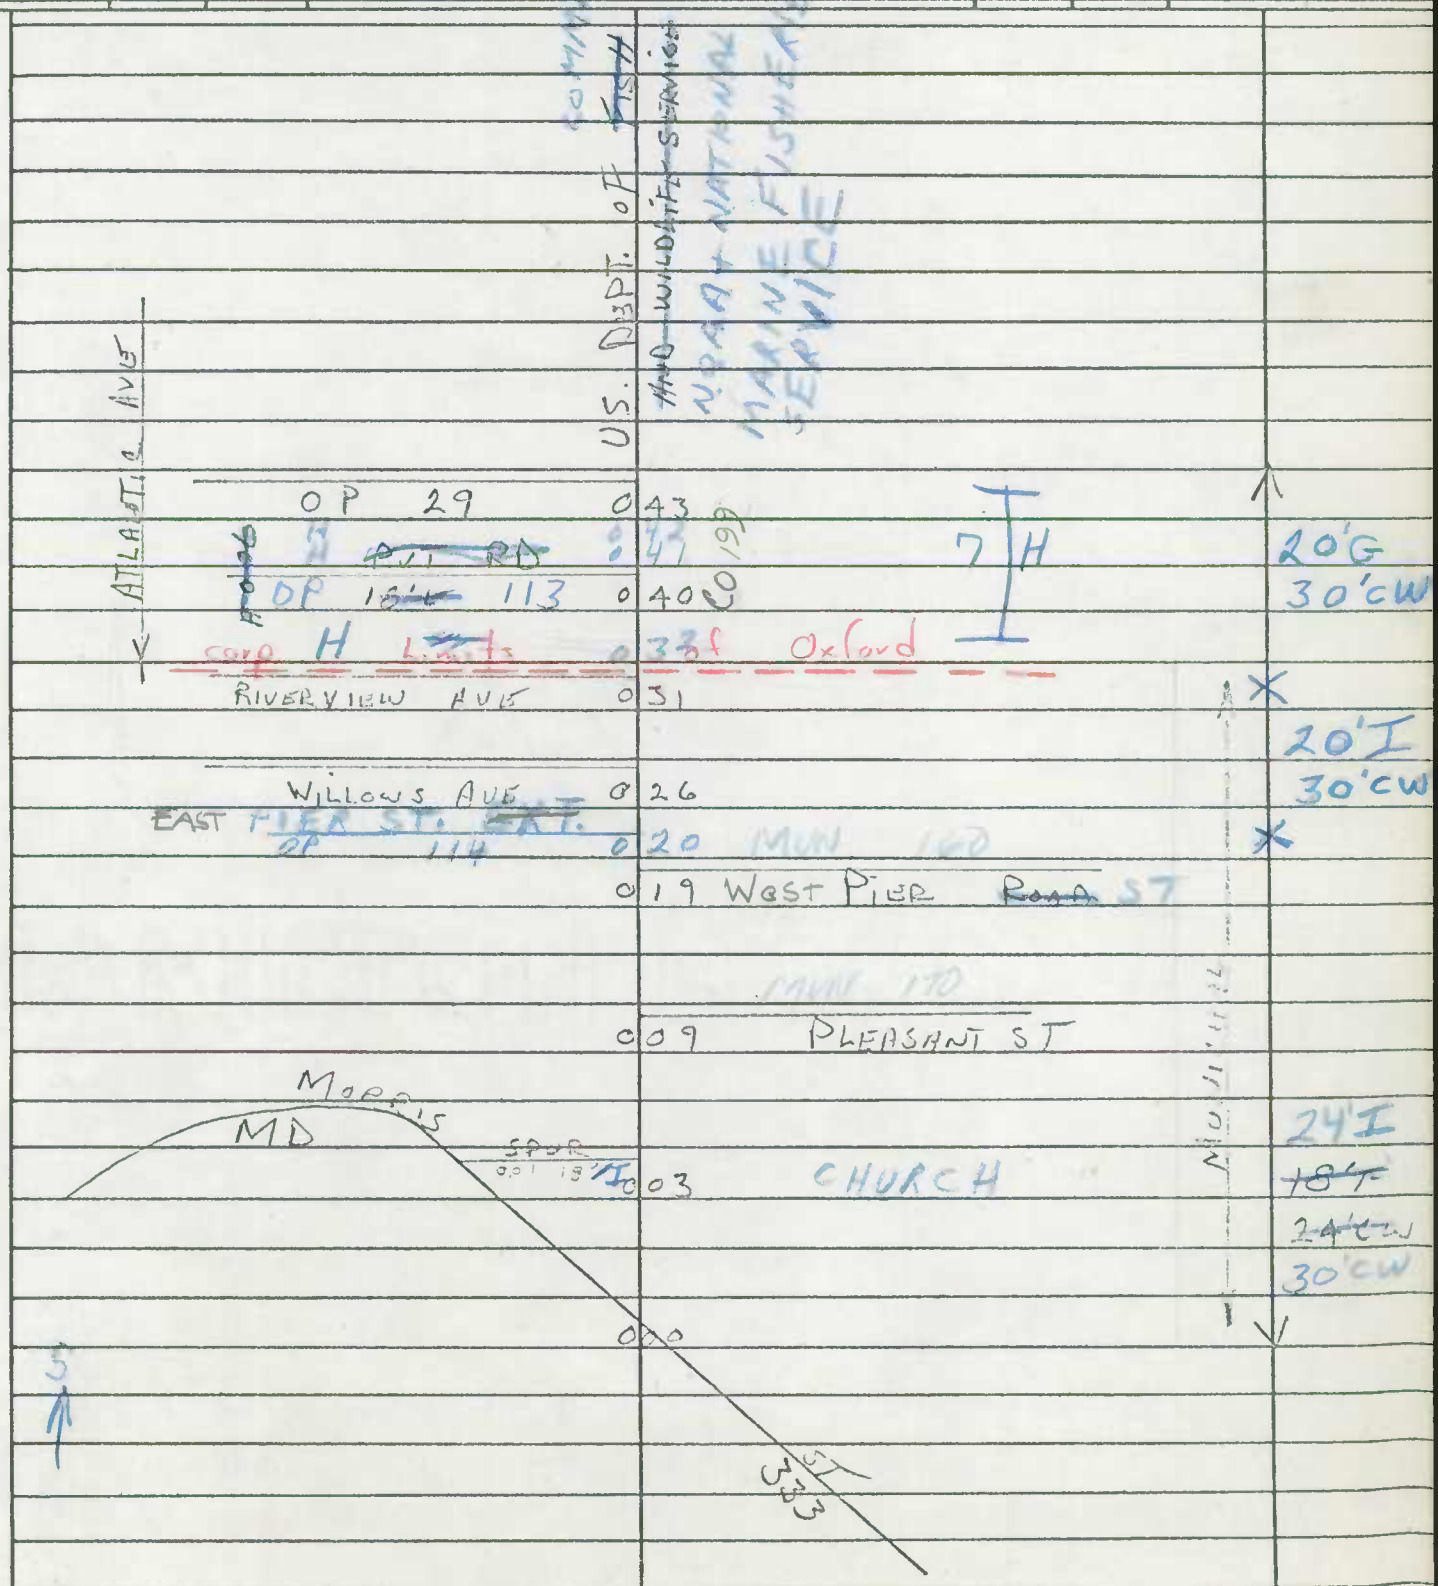

SHA 51.3-8
11-15-72

STATE HIGHWAY ADMINISTRATION OF MARYLAND

ROAD INVENTORY SHEET

8-2
1-17-89
BB, DW

Porty Chief E Sutton
Recorder T Landon
Helper S Martin
VER. FIELD 5/19/77

Mop No. _____

Rood No. 0200
Rood Name (River View Ave)
Sheet No. 1 of 2
Dote 6-7-66
County Talbot
Stote Coordinates _____

83-A2
1/31/84
FL + NS

Road # 8-27 SIU BC OXFORD

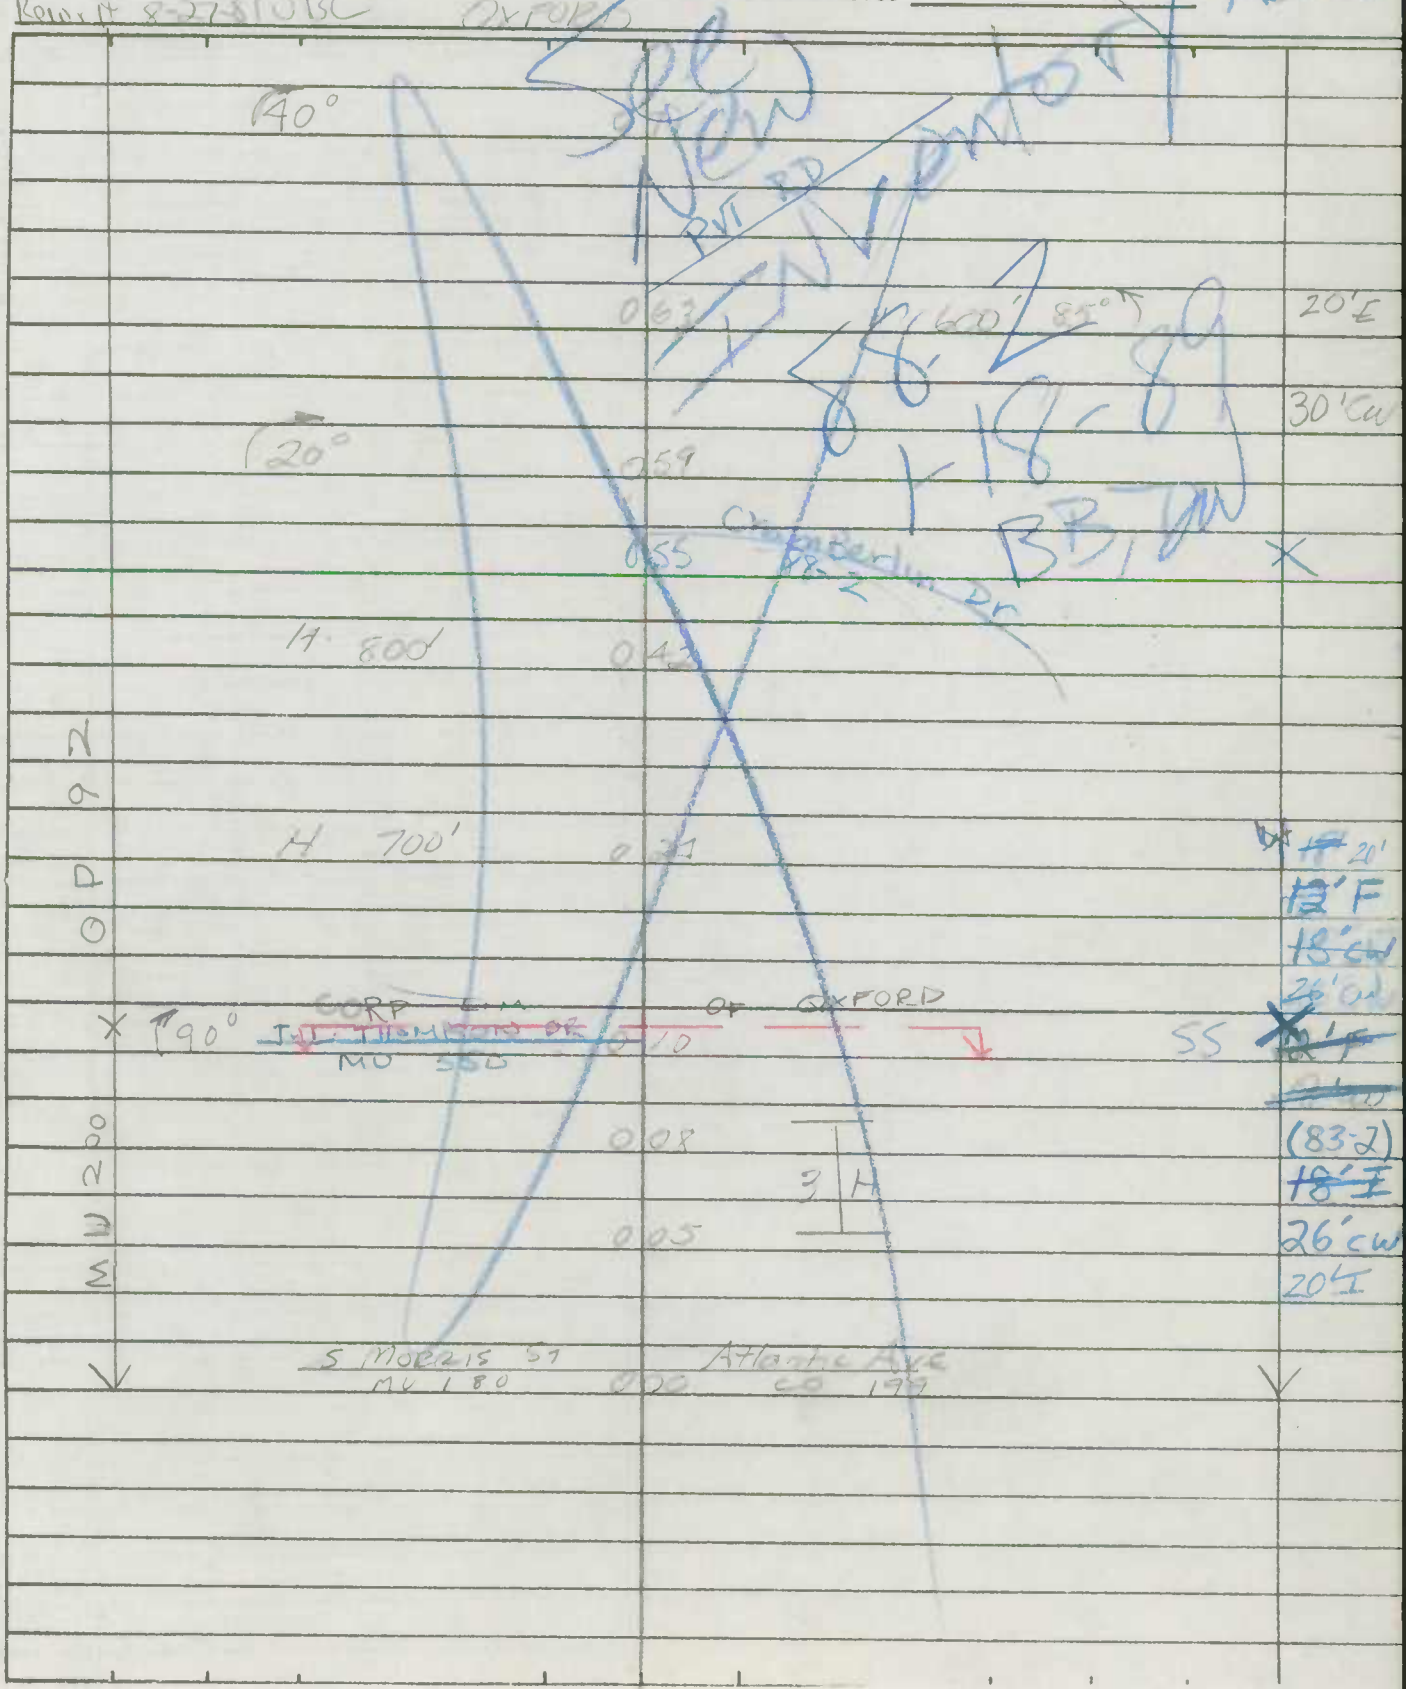

SHA 51.3-8
11-15-72

ROAD INVENTORY SHEET

Road No. 0200
Road Name RIVER VIEW AVE
Sheet No. 2 of 2
Date 6-7-66
County TALBOT
State Coordinates

Form 6 HPS (Rev. 1961)

ROAD INVENTORY SHEET

T. LANDON
F. RHODES
VERIFIED
5/17/77
OXFORD

Party Chief F. SETTAN
Recorder T. LANDON
Chainman S. MARTIN

Road No. 0200
Name RIVER VIEW AVENUE
Sheet No. 1 OF 1
Date 6-7-66
County TALBOT

D E
CULO 94 SAC

0 90 H

↑40° 0 71

0 63 H 600' 85°↗

↑20° 0 59

H 800' 0 42

~~Route~~ 0 39 ~~Limits~~ *20'E
30'CW
~~12'E~~

H 700' 0 24 ~~10'CW~~

Corp Limits of Oxford

190° 0 10

0 08 3TH

0 05 12'E
18'CW

E ↑

S. MORRIS ST. ~~RAILROAD~~ AVE ATLANTIC AVE.

~~Co~~ M4 180 00 CO. ~~180~~ ~~199~~ 199

Form 6 HPS (Rev. 1961)

ROAD INVENTORY SHEET

T. LANDON
F. RHODES
VERIFIED
5/17/67
OXFORD

Party Chief F. SETTAN
Recorder T. LANDON
Chainman S. MARTIN

Road No. 0230
Name SHIPYARD LANE
Sheet No. 1 OF 1
Date 6-7-66
County TALBOT

ABAN.

MARINA

ROAD 003 END

12'F
16'CW

MILL 006 ST

Form 6 HPS (Rev. 1961)

STRAND ST 270

~~SETH STREET 0220~~

ROAD INVENTORY SHEET

T. LANDON
F. RHODES
VERIFIED
5/17/77
OXFORD

Party Chief F SETTIN
Recorder T. LANDON
Chainman S. MARTIN

Road No.
Name STRAND STREET 0270
Sheet No. 1 OF 1
Date 6-7-66
County TALBOT

80-13

OLD (UNDATED)

TRED AVON RIVER

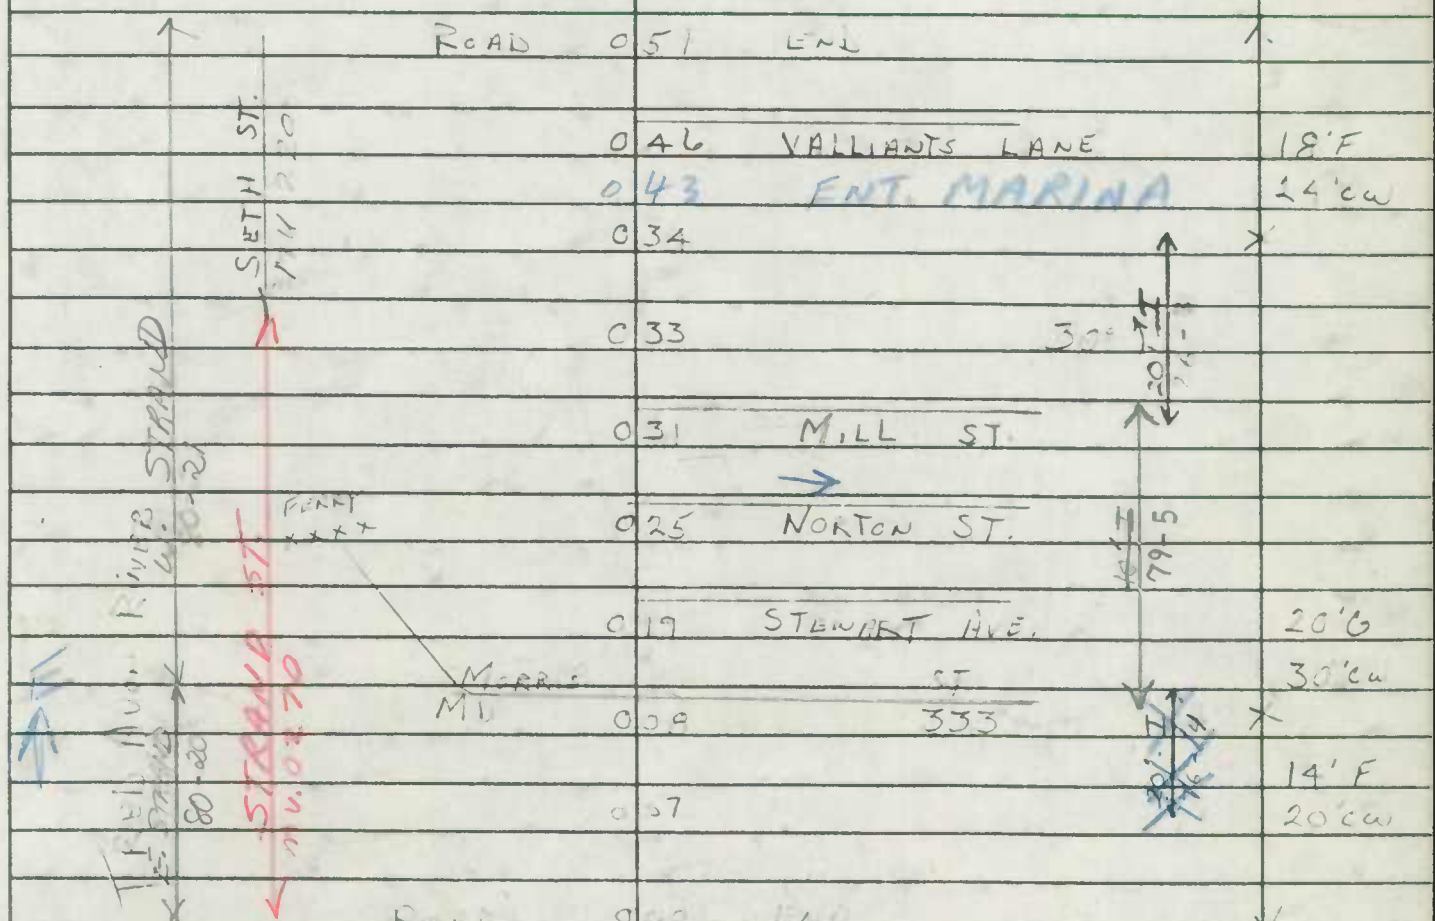

TRED AVON RIVER

Form 6 HPS (Rev. 1961)

OP 116 (BROOKS LA.)

ROAD INVENTORY SHEET

Party Chief F SUTTAN
Recorder T LANDON
Chainman S. MARTIN

T. LANDON
T. RODES
VERIFIED
5/18/77
ST. MICHAELS

Road No. ~~OP 50~~ 00 15
Name ~~CHESTER PARISH~~
Sheet No. 1 OF 1
Date 6-23-66
County TALBOT

S Michaels

	H			
ROAD		END		
	0	3319	H	
5 H	0	~~3320~~	H	
	0	~~22~~ 20	4 H	
	0	197		
H (VAC)	0	~~18~~ 13		
H	0	~~14~~ 12		16'E 20'CW
90° Strip limits	0	131		
	0			
ROAD	0	~~3806~~	END of St Michaels	
				14'F 20'CW
MH @ 300 (PERRY ST.)	0	020		
				~~12'E~~ 16'CW
ROAD	0	000	END	

W

Form 6 HPS (Rev. 1961)

ROAD INVENTORY SHEET

of 116 (BROOKS LA.)

T. LANDON
I. RODES
VERIFIED
5/18/77
ST. MICHAELS

Party Chief F. SETTAN
Recorder T LANDON
Chainman S. MARTIN

Road No. ~~00 20~~ 00 15
Name ~~(CHESTER PARK RD)~~
Sheet No. 1 OF 1
Date 6-23-66
County TALBOT

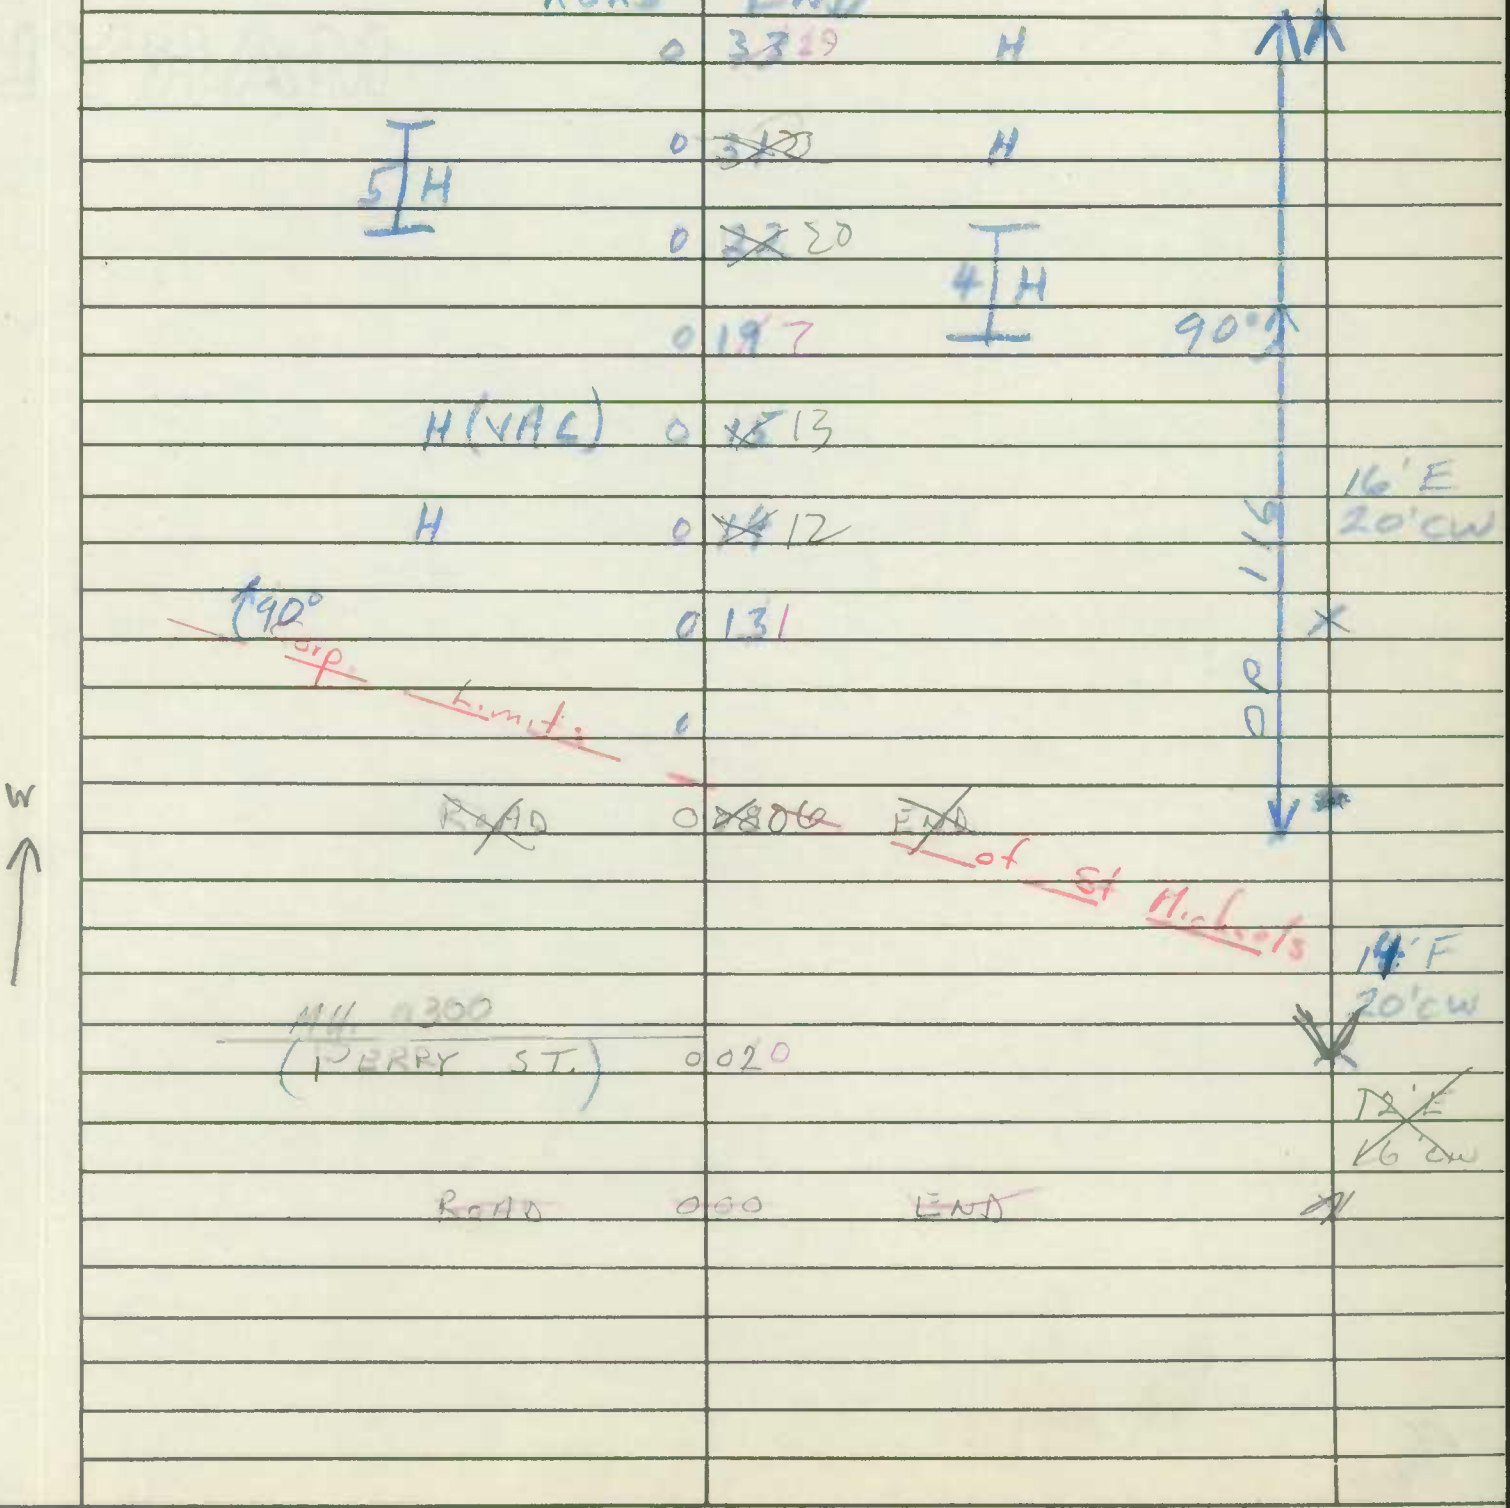

SHA 51.3-8
11-15-72

STATE HIGHWAY ADMINISTRATION OF MARYLAND

73-

ROAD INVENTORY SHEET

Party Chief W. Dombroski
Recorder D. Taylor
Helper

Map No.

St. Michaels

Road No. (0030)
Road Name (Canton St)
Sheet No. 1 of 1
Date 1-15-75
County Talbot
State Coordinates

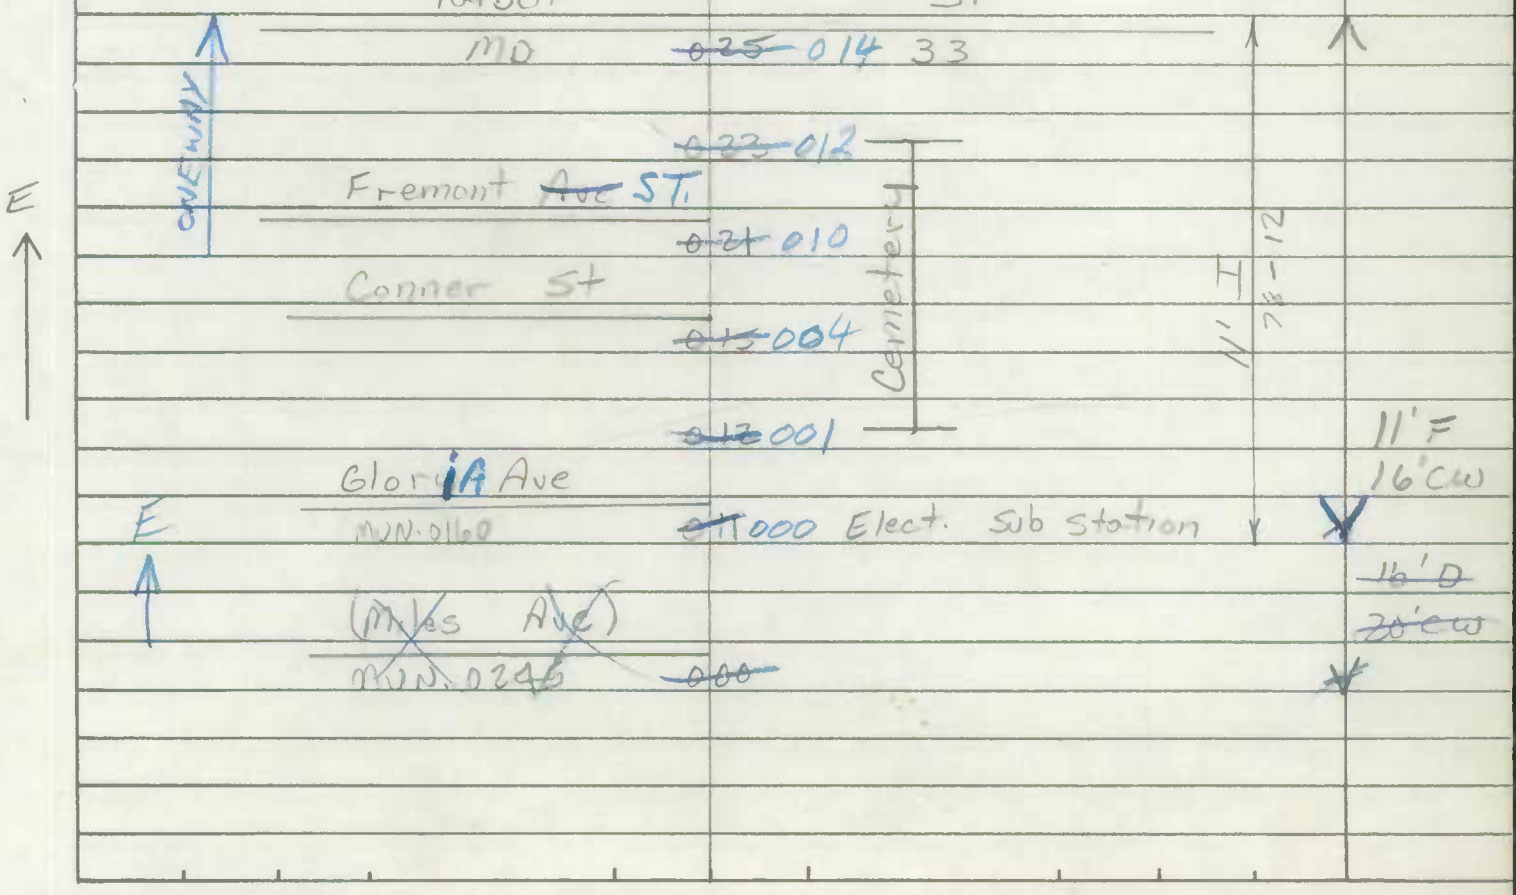

SHA 51.3-8
11-15-72

ROAD INVENTORY SHEET

Road No. _____
Road Name _____
Sheet No. _____
Date _____
County _____
State Coordinates _____

Form 6 HPS (Rev. 1961)

E. CHEW AVE
Mun. No. 0100

ROAD INVENTORY SHEET

Party Chief F. SETTH
Recorder T. LANDON
Chainman S. MARTIN

T. LANDON
F. ANGLES
VERIFIED
5/18/77
ST. MICHAELS

BB 84-1
RM 1-23-85

Road No. Co 151
Name W. CHEW AVE
Sheet No. 1 OF 1
Date 6-15-66
County TALBOT.

VOID
See New Inv.
91-103 2-21-92
BB/SP

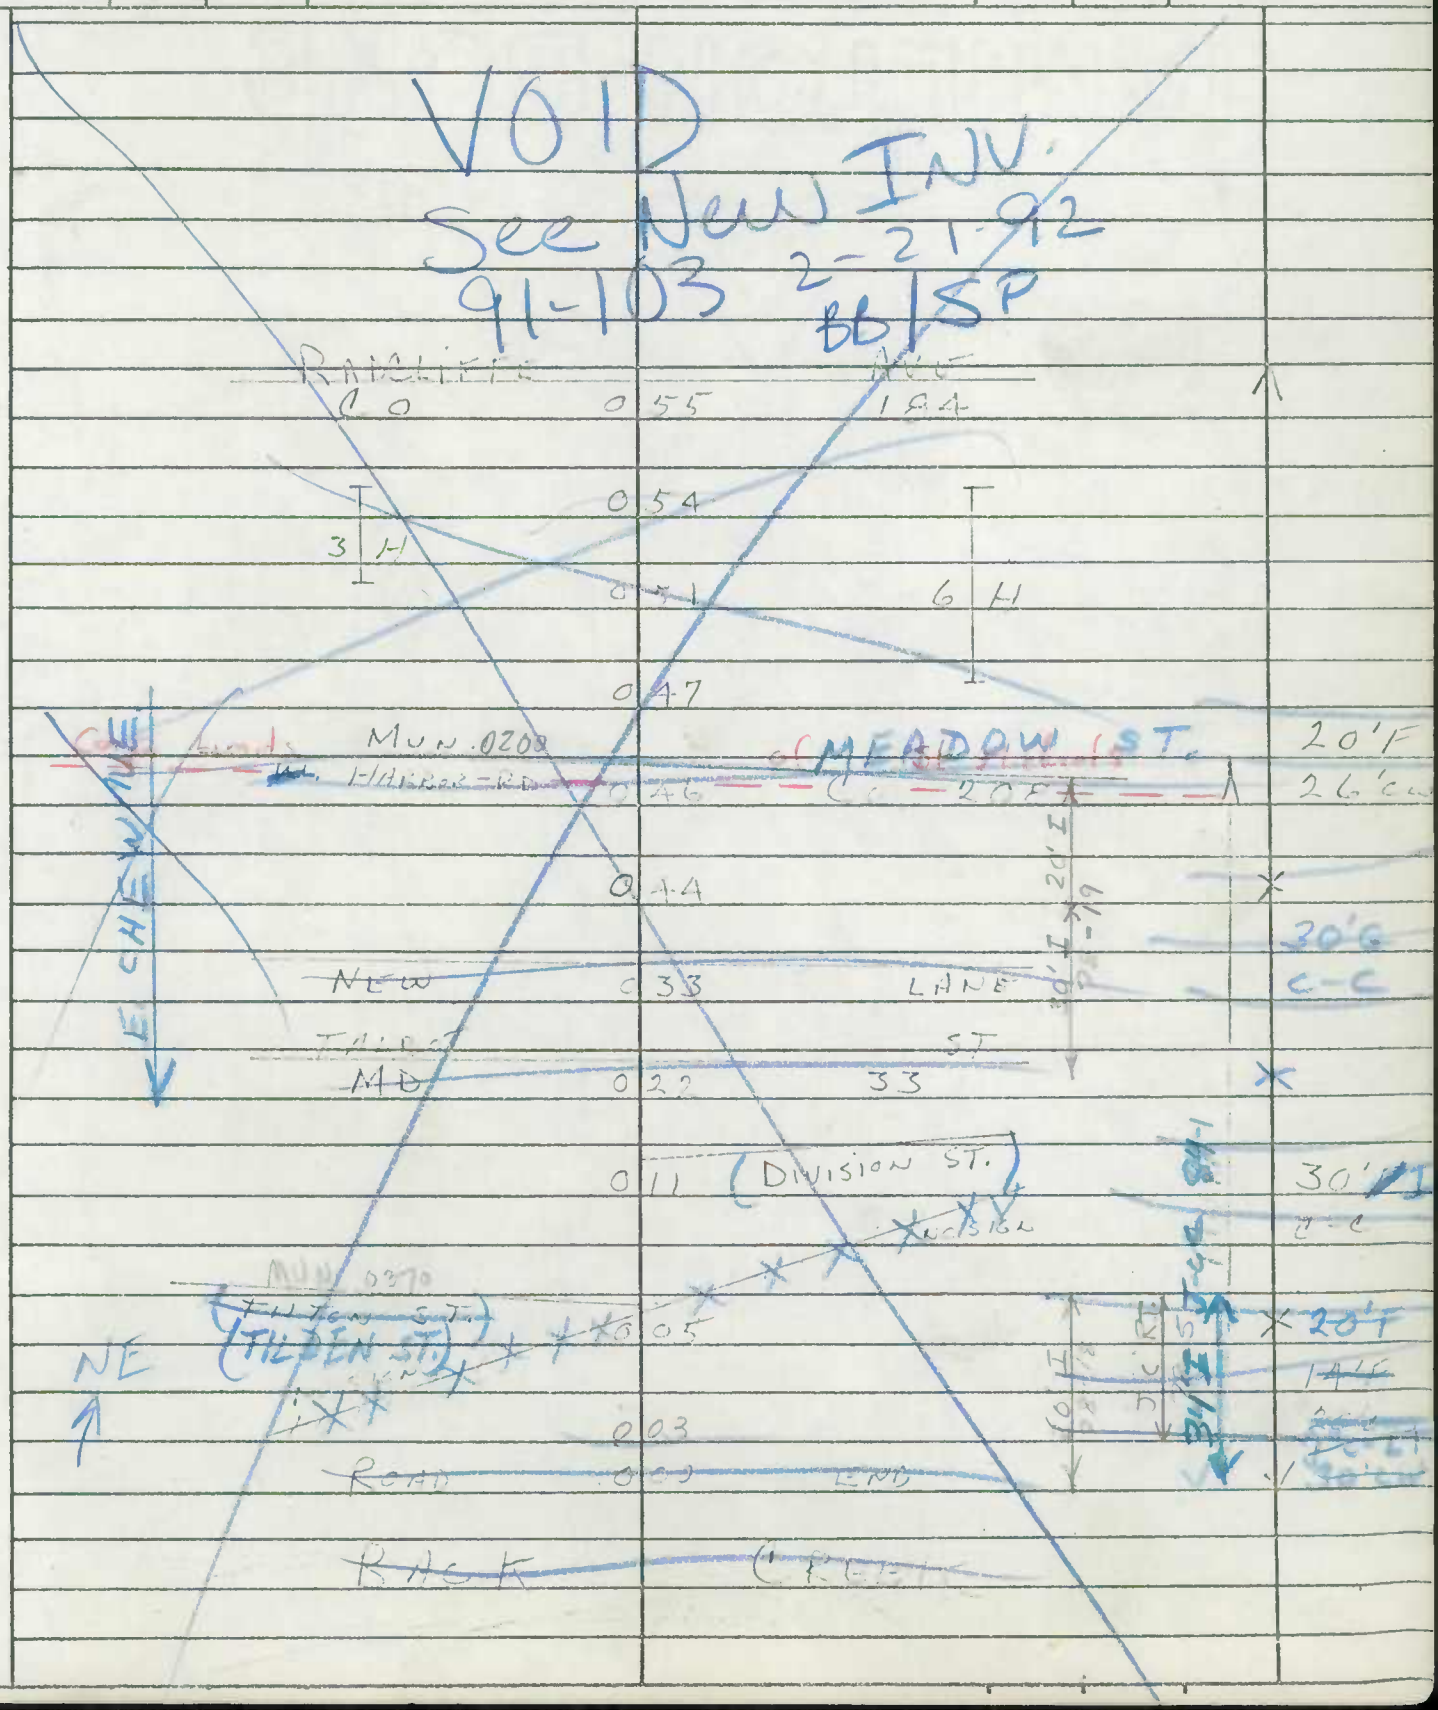

Form 6 HPS (Rev. 1961)

ROAD INVENTORY SHEET

Party Chief F. SIETTAN
Recorder T. LANDON
Chainman S. MARTIN

83-6
1/31/84
FR - NS ST. MICHAELS

5/18/11

Road No. 0290
Name NORTH STREET
Sheet No. 1 OF 1
Date 6-23-66
County TALBOT

71-3 737

RAILROAD MUN.	0	38	AVE. 0320	16'E 20'CW
CHURCH ~~ROAD~~	0	32	~~END~~	90°
END CEM	0	14		~~14'E 20'CW~~ 14'I 20'CW
BEG CEM	0	11		30'I
~~T~~	0	09	MV. 0295 ~~AVE~~	J-C-RT
FREMONT AVE	0	04	~~AVE~~ ST.	40'CW
CHURCH ABAN	0	03		~~14'E 20'CW~~ 20'I J-CC
~~TALBOT~~ MD	000		~~ST~~ 33	

W

Form 6 HPS (Rev. 1961)

ROAD INVENTORY SHEET

Mun. No. 0310

Party Chief F. SETTAN
Recorder T. LANDON
Chainman S. MARTIN

T. LANDON
F. NOLES
VERIFIED
5/18/77
ST. MICHAELS A/T

Road No. Co 184
Name RADCLIFFE AVE
Sheet No. 1 OF 2
Date 6-15-66
County TALBOT

H	34	SEE CO 184		
H	21			
H	30			
	29	(H)	90°) CO 320	
H	26			22'E
SEYMOUR		ST		30'CW
CO	22	193		
	18	OP 48		
	16	H		
		MANOR ST	CO 184	
	14	Co 219		
H	13	H	CO	
		E CHURCH ST		
H	08	Co 151		
PVT CEM	05	NORTH LANE RD		18'F
				24'CW
CORP LIMITS	004	OF ST. MICHAELS		
	002		MUN 0310	16'F
				22'CW
CO		TRANS 0200 N. HARRIS RD		

Form 6 HPS (Rev. 1961)

Mun. No. 0320 ✓

~~CHURCH NECK RD~~

ROAD INVENTORY SHEET

Party Chief E. SETTA
Recorder T. LANDON
Chainman C. MARTIN

T. LANDON
Revised F. MILES
1-15-74
WD
VERIFIED
DT 5/18/77

Road No. Co 68
Name RAILROAD AVE
Sheet No. 1 OF 2
Date 1-16-76
County TALBOT

73-1

ST. MICHAELS

	0 73	6 14	
H 4T	0 65		
PVT RD 10'E	0 41		
	0 36	36" CMP	
~~RXRS CL~~	0 34		19'E
core limits	of St Michaels		30'CW
Limits	0 33	~~Tracks~~ (Abandoned) ST. MICHAELS	
	0 32	NORTH ST. ~~EXT~~ 119 MV 0290	
(Miles Ave) MM 2.45 73-38	0 26		
(CHESAPEAKE AVE)	0 20		
MAIN 160			
CLARA AVE	0 14		16'E
MAIN 10			
CONNER ST.	0 10		22'CW
	0 08	ST. MICHAELS UTILITIES ~~TANK~~ WATER TOWER	
HALL	0 06	CHURCH	20'E
MAIN			24'CW
W FREMONT	0 05	~~AVE~~ ST.	
		SL 33	
TALBOT MD	0 00		
		ST. MARY'S CHURCH	

SHA 51.3 - 8 Revised
4.83

MARYLAND STATE HIGHWAY ADMINISTRATION

ROAD INVENTORY SHEET MV 320 Railroad Ave

(92 MUCS #1)
CO/A. MATTEW
2 1343

Party Chief BB
Recorder T-M.
Assistant
Map No./Dir. 6-21 / W
State Coordinates 1021 348

Road No. CO ~~6869~~
Road Name CHURCH NECK Rd
County TALbot
Date 2-10 87
Sheet No. 1 OF 2

91-61
BB/SP
2-20-92

St. MichaELS

TRAFFIC CODES
TRAFFIC CONTROLS: STOP SIGN=SS, TRAFFIC LIGHT=T.L., FLASHING RED BALL=F.R.

TRAFFIC CODES
PARKING RESTRICTIONS: A.M. PEAK, P.M. PEAK, A.M./P.M. PEAK, NO PARKING ANYTIME=N.P., COMM/IND. ACCESS=E

SYSTEM FED. AID.	SYSTEM FUNCT CLASS.	SYSTEM HWY. SYS.	SYSTEM HPMS SAMPLE	TRAFFIC PRKG. REST.	TRAFFIC COM/IND. ACCESS	LINE DIAGRAM	TRAFFIC CONTROL	TRAFFIC COM/IND. ACCESS	TRAFFIC PRKG. REST.	PAVEMENT DATA
						CHURCH NECK RD (EAST)				
						CHURCH NECK RD (WEST)				20' F
						Corp Limits St Michaels				30' CW
						0 33 NORTH ST				X
						0 52 MI 290				
						MILES AVE				
						MV 0145 0 26				
						CHESAPEAKE AVE				
						MV 0173 0 20				
						GLORY AVE				
						MV 0160 0 14				
						CONNER ST				
						MV 0110 0 10				16' I
						MAPLE AVE				22' C W
						0 08				X
										27' I
						FREMONT ST				"J" C-C
						MD 0 05 150				X
						RAILROAD				
										25' I
										"J" C-C
						TALBOT ST.				
						MD 0 00 33				
						MD 00 60 CHERRY ST				

Form 6 HPS (Rev. 1961)

ROAD INVENTORY SHEET

Mun. No. 0340

Party Chief F. SUTTAN — T. LANDON
Recorder T. LANDON — F. HUGHES
Chainman S. MARTIN — VERIFIED 5/18/77

Road No. Co 185
Name SEYMOUR AVE
Sheet No. 1 OF 3
Date 6-15-66
County TALBOT

MEADOW ST
0 3833 Co 208
0 36
3 H
0 33
0 26 H
CP Section
Co 0 2520 184
0 24
5 H
0 18
H 0 1409 PROPOSED RD
CP Section
Co 184 0 1308
0 12 H
0 10 H
0 9 PVT PD 9'E 0 905 PVT PD 9'E 0
Riverview Co 0 805 0 Terrace 186
0 00 ROAD 0 00 END

MILES RIVER

Form 6 HPS (Rev. 1961)

MU 340

ROAD INVENTORY SHEET

Party Chief F. SETTLE
Recorder T. LANDON
Chainman S. MARTIN

T. LANDON
I. HUGES
VERIFIED
5/18/77

Road No. Co 185
Name Seymour Ave.
Sheet No. 2 OF 2
Date 6-15-66
County TALBOT

TALBOT
MD

ST

0 54 49 33 — 34'F

0 51 46 H — C-C 2ML

0 44 3 H

0 42

MUN 280
0 41 NEW LANE

0 35 3 H — A.L.'F C-LT. 2ML

0 35

corp limits — of St Nicholls

0 39 34 H

Spire

Form 6 HPS (Rev. 1961)

ROAD INVENTORY SHEET

Party Chief F. SETTA
Recorder T. LANDON
Chainman S. MARTIN

VERIFIED 5/18/77 ST. MICHAELS

Road No. 9020
Name (SKINNER ALLEY)
Sheet No. 1 OF 1
Date 6-23-66
County TALBOT

CARPENTER ST

TALBOT ~~FREMONT~~ MD. 0.05 33 ST. ~~AVE~~ ~~ST~~

N 16'I 20'CW ~~18'I~~ ~~14'CW~~

~~FREMONT~~ TALBOT ~~MD~~ MUN. 0.00 ST. ~~33~~ 33 0150

CARPENTER ST

SHA 51.3-8
11-15-72

STATE HIGHWAY ADMINISTRATION OF MARYLAND

91 MUEX#1
BB/SP
2-14-92

ROAD INVENTORY SHEET

Harrison Circle

Party Chief D. TAYLOR
Recorder E. RHODES
Helper

Road No. MUN. 0012
Road Name ~~HARRISON DR.~~
Sheet No. 1 OF 1
Date 11/28/75
County TALBOT
State Coordinates

T. LANDER
E. RHODES
VERIFIED
6/13/77

Map No. TRAPPE 74-5

Trappe

GREENFIELD MUN. 0 44 001

0 39

↑90° 0 35

PUMPING STA. 0 30

S ↑

↑20° 0 27

(HARRISON CT. ~~DR.~~)
↑80° MUN. ~~0010~~ 0011 0 22

0 20 DR.

0 17

24'FI
30'CW

↑80° 10 H 0 15

SCHOOL ST. 0 00

←005 ←010 004

0 02

GREENFIELD MUN. AVE.

MUN. 0 00 0010

~~20'D~~
~~30'CW~~

55

SHA 51.3-8
11-15-72

ROAD INVENTORY SHEET

Road No. _____
Road Name _____
Sheet No. _____
Date _____
County _____
State Coordinates _____

SHA 51.3-8
11-15-72

STATE HIGHWAY ADMINISTRATION OF MARYLAND

91 MUEX#1
BA/SP
2-19-92

ROAD INVENTORY SHEET

Harrison Circle

Party Chief D. TAYLOR
Recorder E. RHODES
Helper

Map No. TRAPPE 74-5

Road No. MUN. 0012
Road Name ~~HARRISON DR.~~
Sheet No. 1 OF 1
Date 11/28/75
County TALBOT
State Coordinates

L. RHODES F. VERIFIED 6/13/77

GREENFIELD MUN. 0 44 AVE. 0010 SS 30'I 40'CW

0 39 90° X

90° 0 35

PUMPING STA. 0 30

S 20° 0 27

(HARRISON CT. ~~DR.~~)

80° MUN. ~~0010~~ 0011 0 22

0 20 DR.

0 17

80° 10 H SCHOOL ST. 0 15 24'I 30'CW

0 005 0 10 004

0 02 ~~20'D~~ ~~30'CW~~

GREENFIELD MUN. AVE. 0 00 0010 SS

SHA 51.3-8
11-15-72

ROAD INVENTORY SHEET

Road No. _____
Road Name _____
Sheet No. _____
Date _____
County _____
State Coordinates _____

Form 6 HPS (Rev. 1961)

ROAD INVENTORY SHEET

OP 0185

Party Chief F. SETTON
Recorder T. LANDON
Chainman S. MARTIN

91-1
BBISP
2-19-92 :

T. LANDON
6/13/91

Road No. ~~0020~~
Name (LOCUST STREET)
Sheet No. 1 OF 1
Date 6-8-66
County TALBOT

TRAPPE

ROAD ~~TS~~ H END

PVT RD

PVT RD

SS X 18

~~Cap~~ ~~Lots~~ ~~of~~ ~~Trees~~

011

12' D

~~16' ED~~

~~20' ED~~

200°

005

N. MAIN

003

ST

MD

000

565

16' D

W

SHA 51.3 - 8 Revised 4.83

MARYLAND STATE HIGHWAY ADMINISTRATION

TRAPPE (147)

ROAD INVENTORY SHEET

91 MU EX #3
BB/SP
2-1-92

Party Chief E. Settam
Recorder T. Lawton - S Mantin
Assistant Rewritten 11-27-89 KJP
Map No./Dir. 1 E
State Coordinates

Road No. MUN 0030
Road Name MAPLE AVE. E & W
County TALBOT
Date 5-25-66
Sheet No. 1 OF 1

TRAFFIC CODES
TRAFFIC CONTROLS: STOP SIGN=SS, TRAFFIC LIGHT=T.L., FLASHING RED BALL=F.R.

TRAFFIC CODES
PARKING RESTRICTIONS: A.M. PEAK, P.M. PEAK, A.M./P.M. PEAK, NO PARKING ANYTIME=N.P., COMM/IND. ACCESS=E

SYSTEM: FED. AID. | FUNCT. CLASS. | HWY. SYS. | HPMS SAMPLE
TRAFFIC: PRKG. REST. | COM/IND. ACCESS

LINE DIAGRAM

SLD NEW INV
FCR-95
GD AH
4/6/95
Corp. Limits of Trappe
US 0.66 50
0.42 Church
Powell Ave.
0.57 MUN. 0050
Maple Ave
S. Main ST 565
N. Main ST MD
0.41
0.21 * site at old Corp. Limits.
W. Maple Ave
Hennessee Ave
MU 0013 0.43
Corp. Limits
0.45
0.00
Co 115
Piney Hill Rd Co 288
Non F/A Rural Local Minor Collector
MUN. 0030
URBAN
TRAPPE

TRAFFIC: CONTROL | COM/IND. ACCESS | PRKG. REST.
E

PAVEMENT DATA
29' I
J c-c
34' I
J c-c
18' F
30' CW

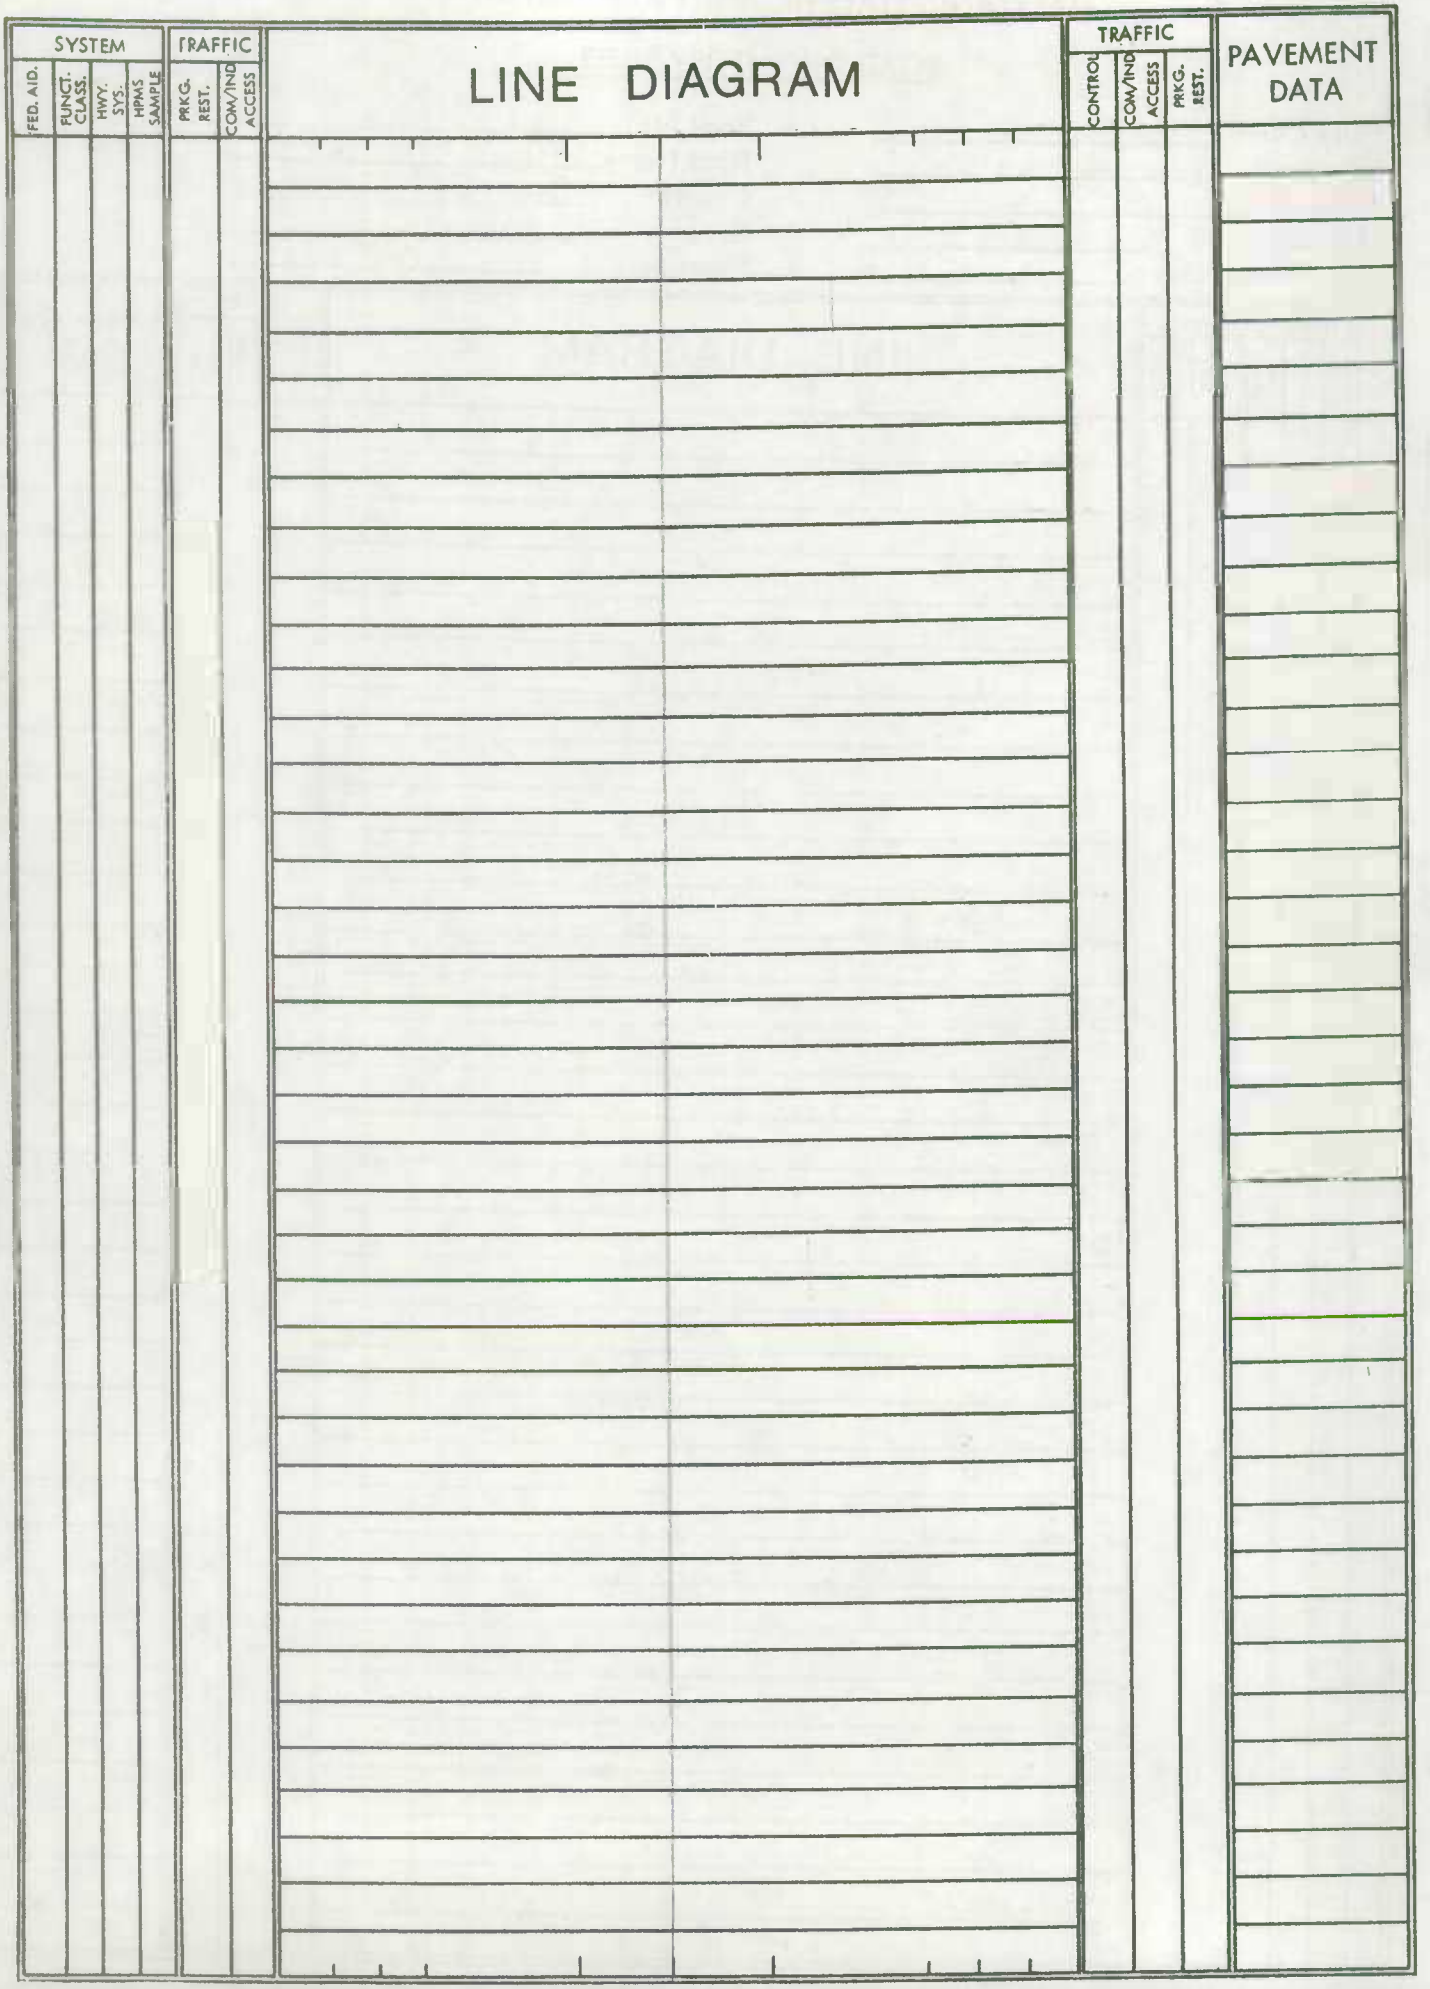
SYSTEM
FED. AID.
FUNCT. CLASS.
HWY. SYS.
HPMS SAMPLE
TRAFFIC
PRKG. REST.
COM/IND ACCESS
LINE DIAGRAM
TRAFFIC
CONTROL
COM/IND ACCESS
PRKG. REST.
PAVEMENT DATA

Form 6 HPS (Rev. 1961)

Trappe 0030

PINEY HILL RD

ROAD INVENTORY SHEET

MUN. NO. 0030 W. MAPLE AVE

Party Chief F. SETTAN
Recorder T. LANDON
Chainman S. MARTIN

T. LANDON
F. [illegible]
VERIFIED

Revised 1-14-74 DT MK

Road No. Co 111
Name ISLAND CREEK RD
Sheet No. 1 OF 3
County TALBOT

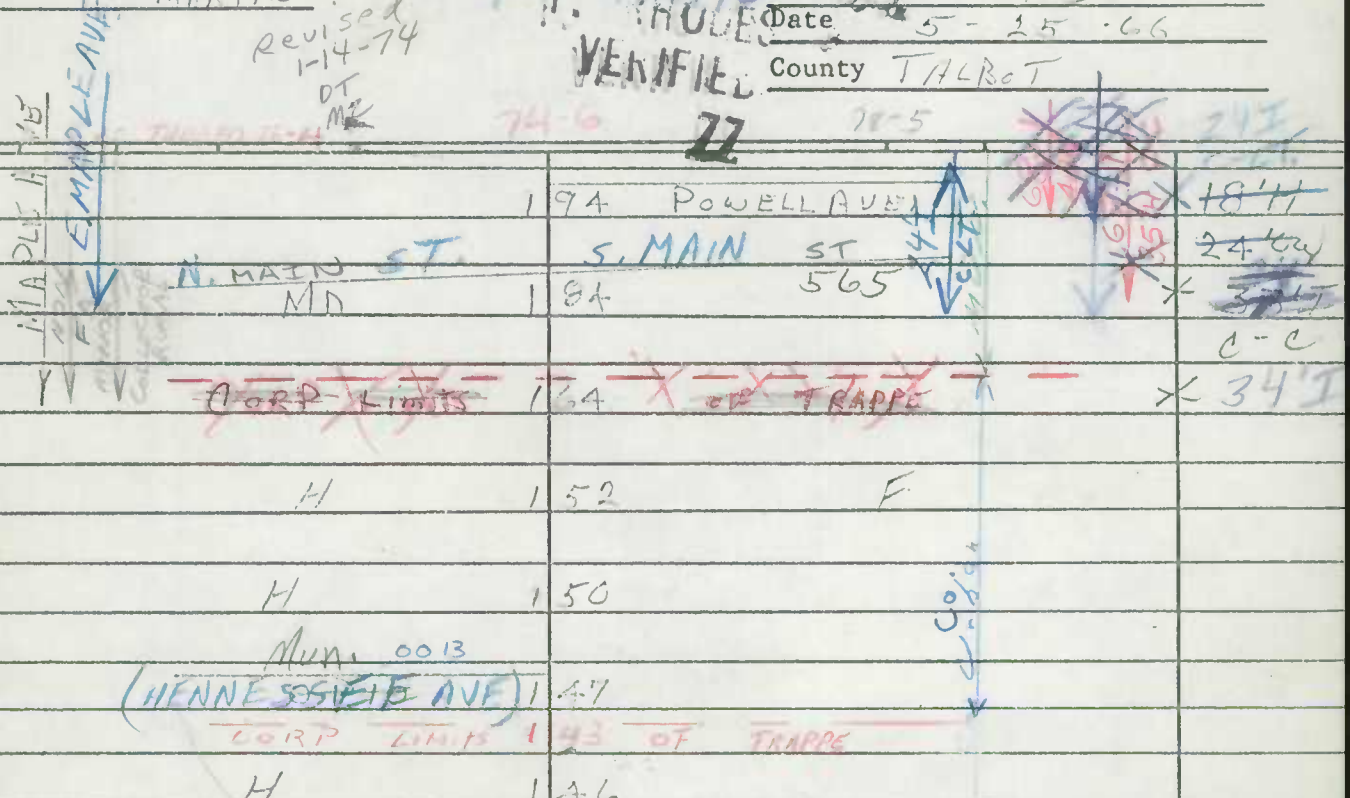
MAPLE AVE
EMMAPLE AVE
N. MAIN ST
MD
CORP LIMITS
CORP LIMITS OF TRAPPE
H
H
Mun. 0013
(HENNESSEE AVE)
CORP LIMITS OF TRAPPE
H
CORP LIMITS
POWELL AVE
S. MAIN ST
565
OLIVE ST
18'11
24' Cov
34'
C-C
34'
F
F
F

Form 6 HPS (Rev. 1961)

ROAD INVENTORY SHEET

Party Chief F. SETTAN
Recorder T. LANDON
Chainman S. MARTIN

T. LANDON
I. [illegible]
VERIFIED
6/13 77

Road No. C O ~~111~~ 0030
~~Name~~ E. Maple Ave
Sheet No. 2 OF 3
Date 5-25-66
County TALBOT

77-3

PVT Section of C O 119	3	02	
H	2	96	
PT 30°	2	82	
H	2	80	12" CMP
PC	2	79	
PVT [illegible] 18'E	2	58	
	2	56	PT 90°
	2	51	PC
	2	49	H
F	2	37	18'E 30 c.m.
	2	17	X
	2	13	H 16'E
Corp Limits VS	2	08	of TRAFFIC 50 LT. X 22' c.m.
~~Corp. Limits~~	2	07	~~of TRAFFIC~~ 29' WI 1" C-C
	1	95	CHURCH
			SAME

HILLSDALE CO. 288

PINEY

SHA 51.3-8
11-15-72

STATE HIGHWAY ADMINISTRATION OF MARYLAND

ROAD INVENTORY SHEET

T. LANDON
F. RHODES
VERIFIED
6/13/77
A/T

Party Chief T.LANDON
Recorder F.RHODES
Helper

Road No. MUN. 0065
Road Name (RUMSEY DR.)
Sheet No. 1 OF 1
Date 11/13/76
County TALBOT
State Coordinates

Map No. 75-5
TRAPPE

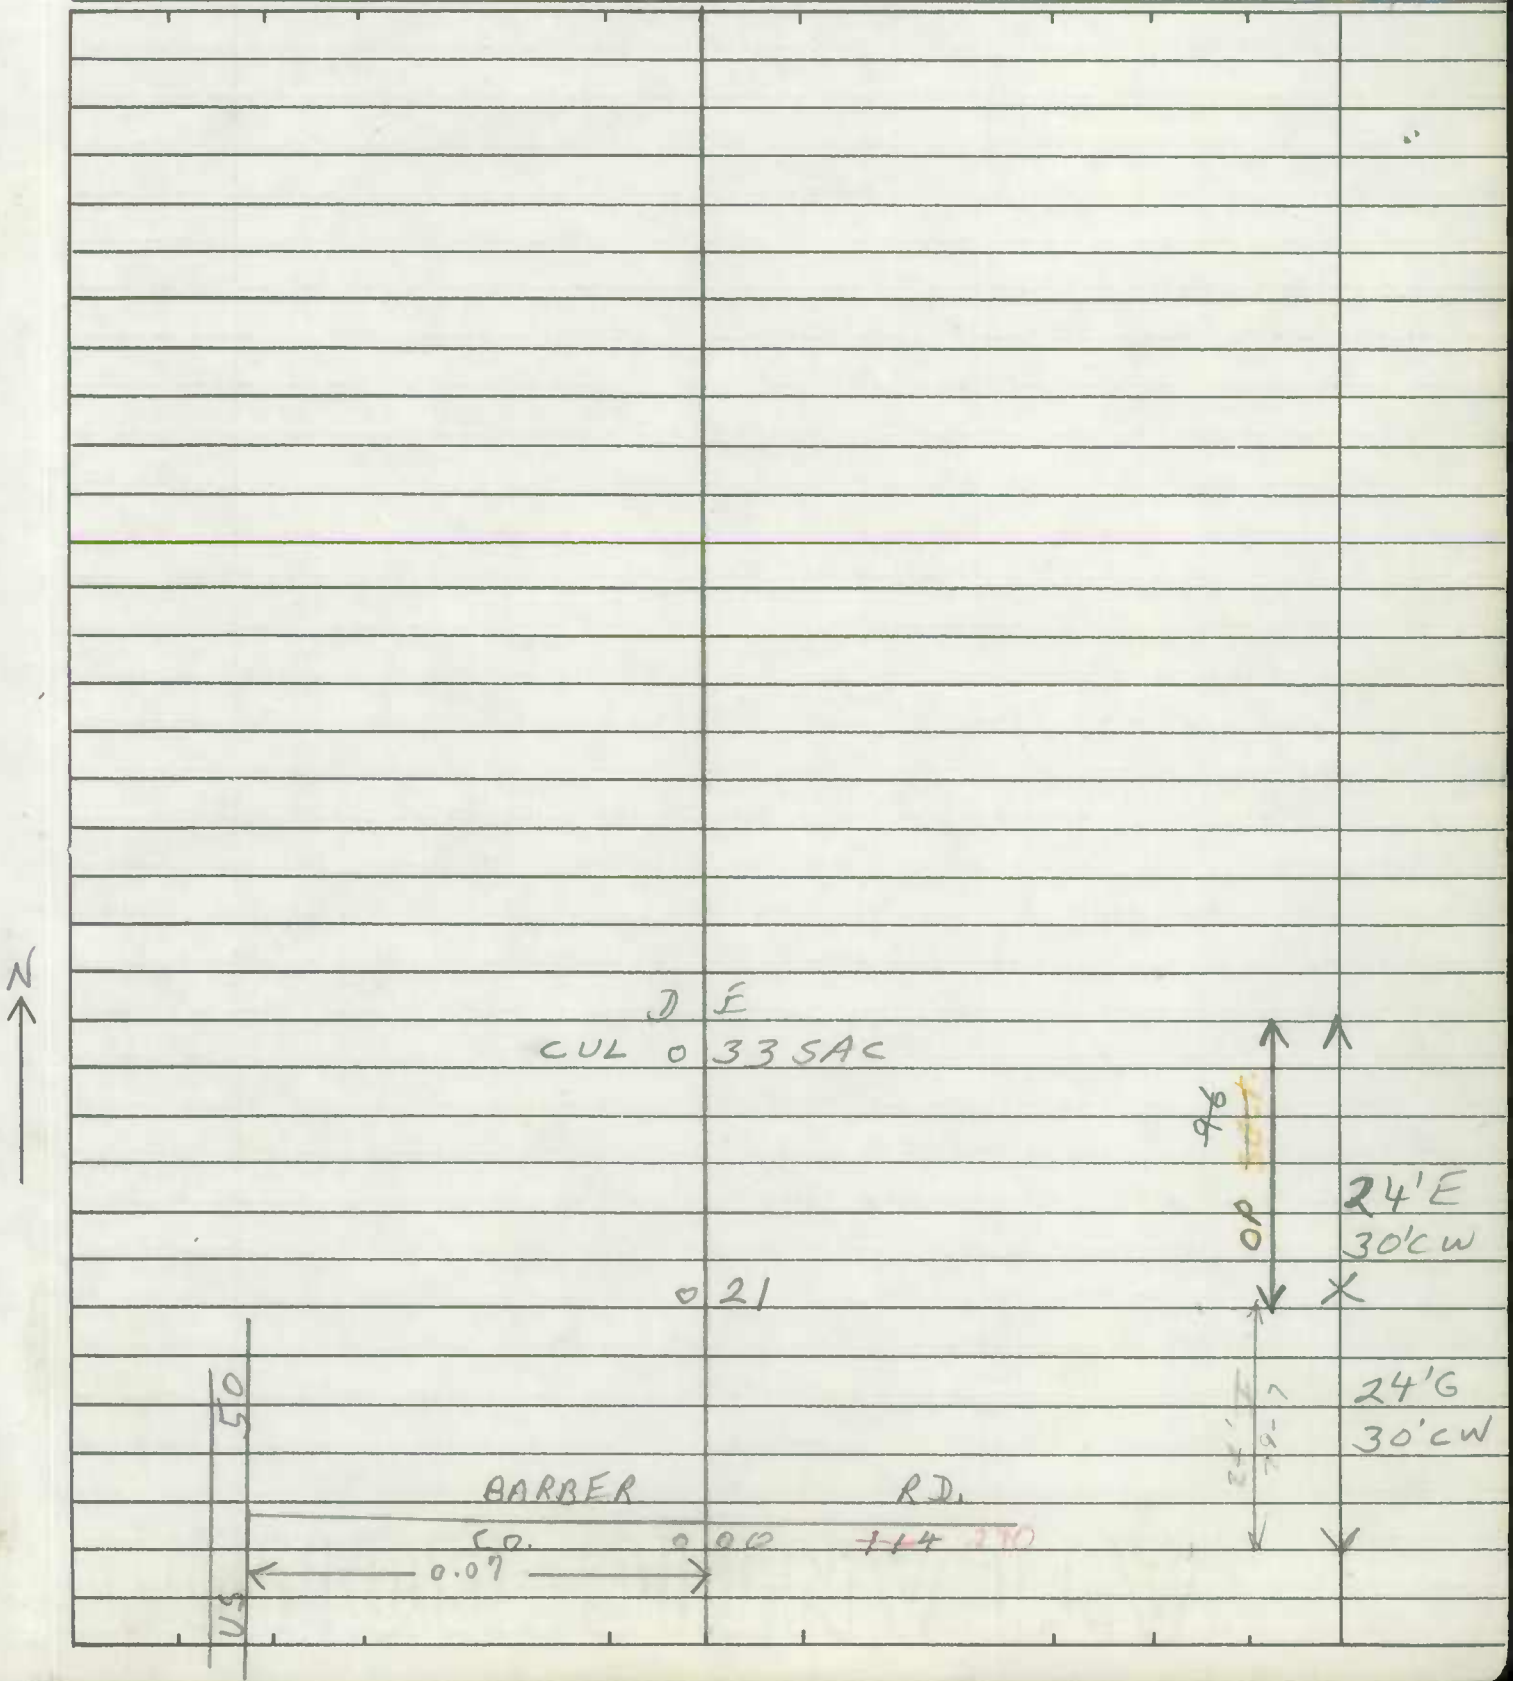

SHA 51.3-8
11-15-72

ROAD INVENTORY SHEET

Road No. _____
Road Name _____
Sheet No. _____
Date _____
County _____
State Coordinates _____

SHA 51.3-8
11-15-72

STATE HIGHWAY ADMINISTRATION OF MARYLAND

ROAD INVENTORY SHEET

OP 96

T. LANDON
F. RHODES
VERIFIED 11/13/76

Party Chief T. LANDON
Recorder F. RHODES
Helper

Map No. 75-5

Road No. MUN. 0055
Road Name (RUMSEY DR.)
Sheet No. 1 OF 1
Date 11/3/76
County TALBOT
State Coordinates 1070 - 300

IN TRAFFIC

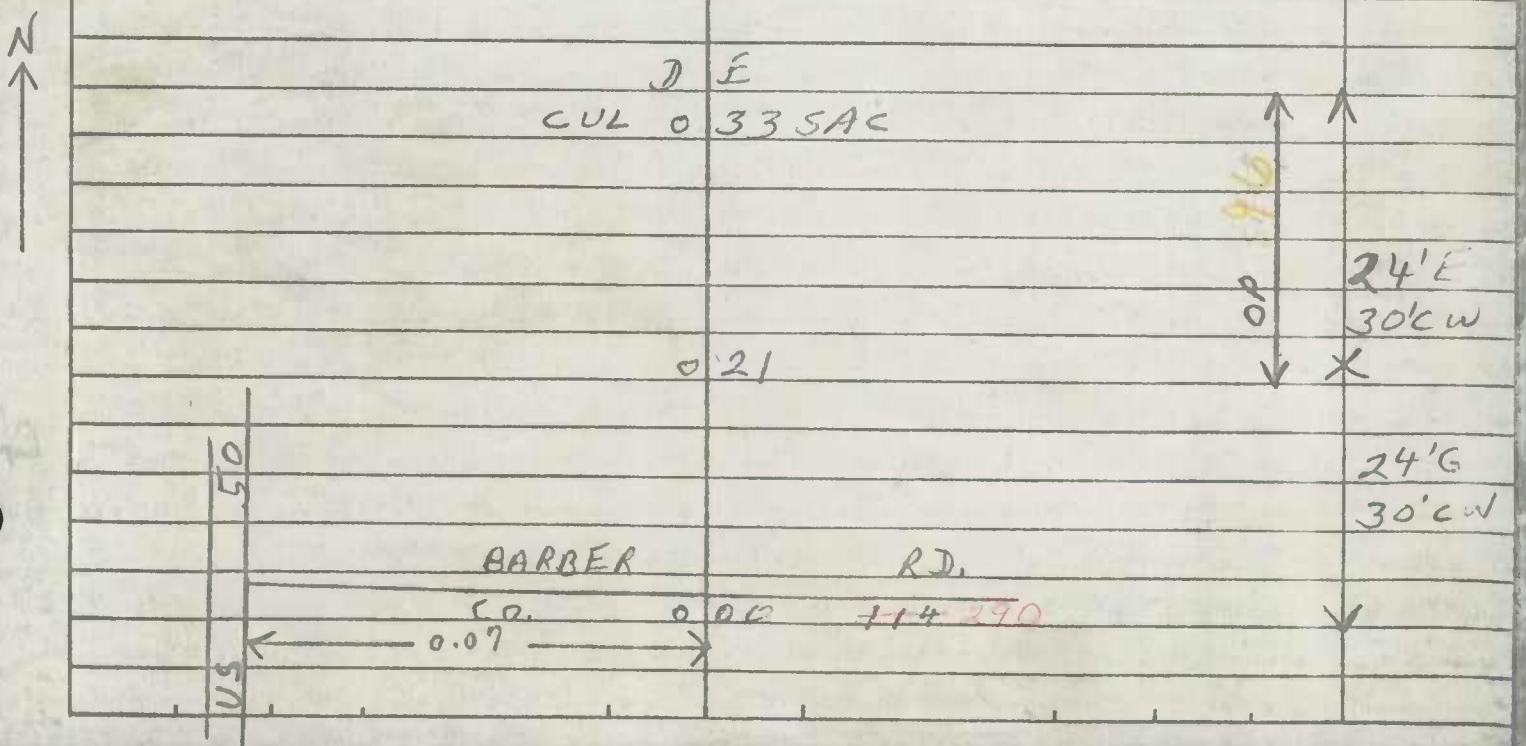

SHA 51.3-8
11-15-72

STATE HIGHWAY ADMINISTRATION OF MARYLAND

m/c/A

ROAD INVENTORY SHEET

Party Chief D. TAYLOR
Recorder M. ZALENSKI
Helper _____

Map No. _____

Road No. MUN. 0075
Road Name SLAUGHTER RD.
Sheet No. 1 OF 1
Date 1-14-74
County TALBOT
State Coordinates _____

F. VERIFIED 6/13/77

TRAPPE

D E
CUL 0 57 SAC.

0 56 FARM

APPROX. CORP. LMTS. 0 21
HIRST AVE. 0 07
MUN 0017 0 06

W

S. MAIN ST.
MD. 0 00 565

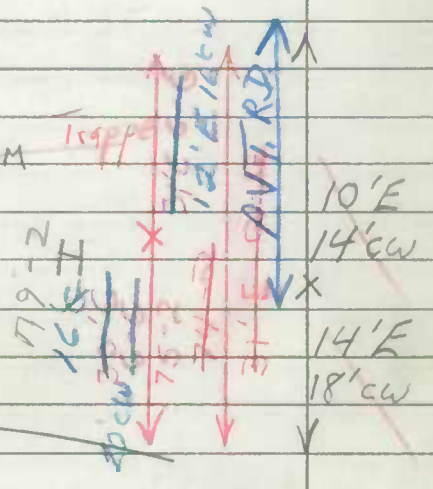

SHA 51.3-8
11-15-72

ROAD INVENTORY SHEET

Road No. _____
Road Name _____
Sheet No. _____
Date _____
County _____
State Coordinates _____

SHA 51.3-8
11-15-72

STATE HIGHWAY ADMINISTRATION OF MARYLAND

ROAD INVENTORY SHEET

Party Chief F SETTAN
Recorder I LANDON
Helper S MARTIN

Map No. _____

REV 7/13/76 TL & FR

Revisit 8-27-81 JTSC

Road No. MD 30
Road Name MAPLE AVE E&W
Sheet No. 1 of 3
Date 5-25-66
County TALTOT
State Coordinates _____

1 21

1 00 F

← OVERS LA
CO 115

0 98

0 85 F

1/1

TRAPPE

TRAPPE LANDING RD
CO 118

0 76

30 CO

0 50 36" CMP

0 12 F

SANDERTOWN RD
CO

0 00

ISLAND CREEK RD
110

SHA 51.3-8
11-15-72

ROAD INVENTORY SHEET

Road No. _____
Road Name _____
Sheet No. _____
Date _____
County _____
State Coordinates _____

			2 07		29' I
					J' C-C
			1 95	CHURCH	
	MAPLE	30	1 94 51	POWELL AVE	X
	MD				34' I
					C-C
			1 84 41	N MAIN ST / S MAIN ST 565	X
	MD				
	W MAPLE	30			
	MD		1 64 21		
			1 64		18' F
Urban III	H		1 52	F	30' C-C
	H		1 50		
CO			HENNESSEY AVE MD 13 1 47 04		
	H		1 46		
			CORP LIMITS 1 43 00	OF TRAPPE	

SHA 51.3-8
11-15-72

STATE HIGHWAY ADMINISTRATION OF MARYLAND

ROAD INVENTORY SHEET

Party Chief F SETTAN
Recorder I LANDON
Helper S MARTIN

REV 7/5/76 TL & FR

Map No. _____

Road No. MD 30
Road Name MAPLE AVE E&W
Sheet No. 1 of 3
Date 5-25-66
County TALTOT
State Coordinates _____

Revisit 8-27-81 JTBC

1 21

1 00 F

K OVER 2 LA
CO 115

0 98

0 85 F

18' F

N

TRAPPE LANDING RD
CO 118

0 76

20' CW

0 50 36" CMP

0 12 F F

SANDERTOWN RD
CO

0 00

ISLAND CREEK RD
110

SHA 51.3-8
11-15-72

ROAD INVENTORY SHEET

Road No. _____
Road Name _____
Sheet No. _____
Date _____
County _____
State Coordinates _____

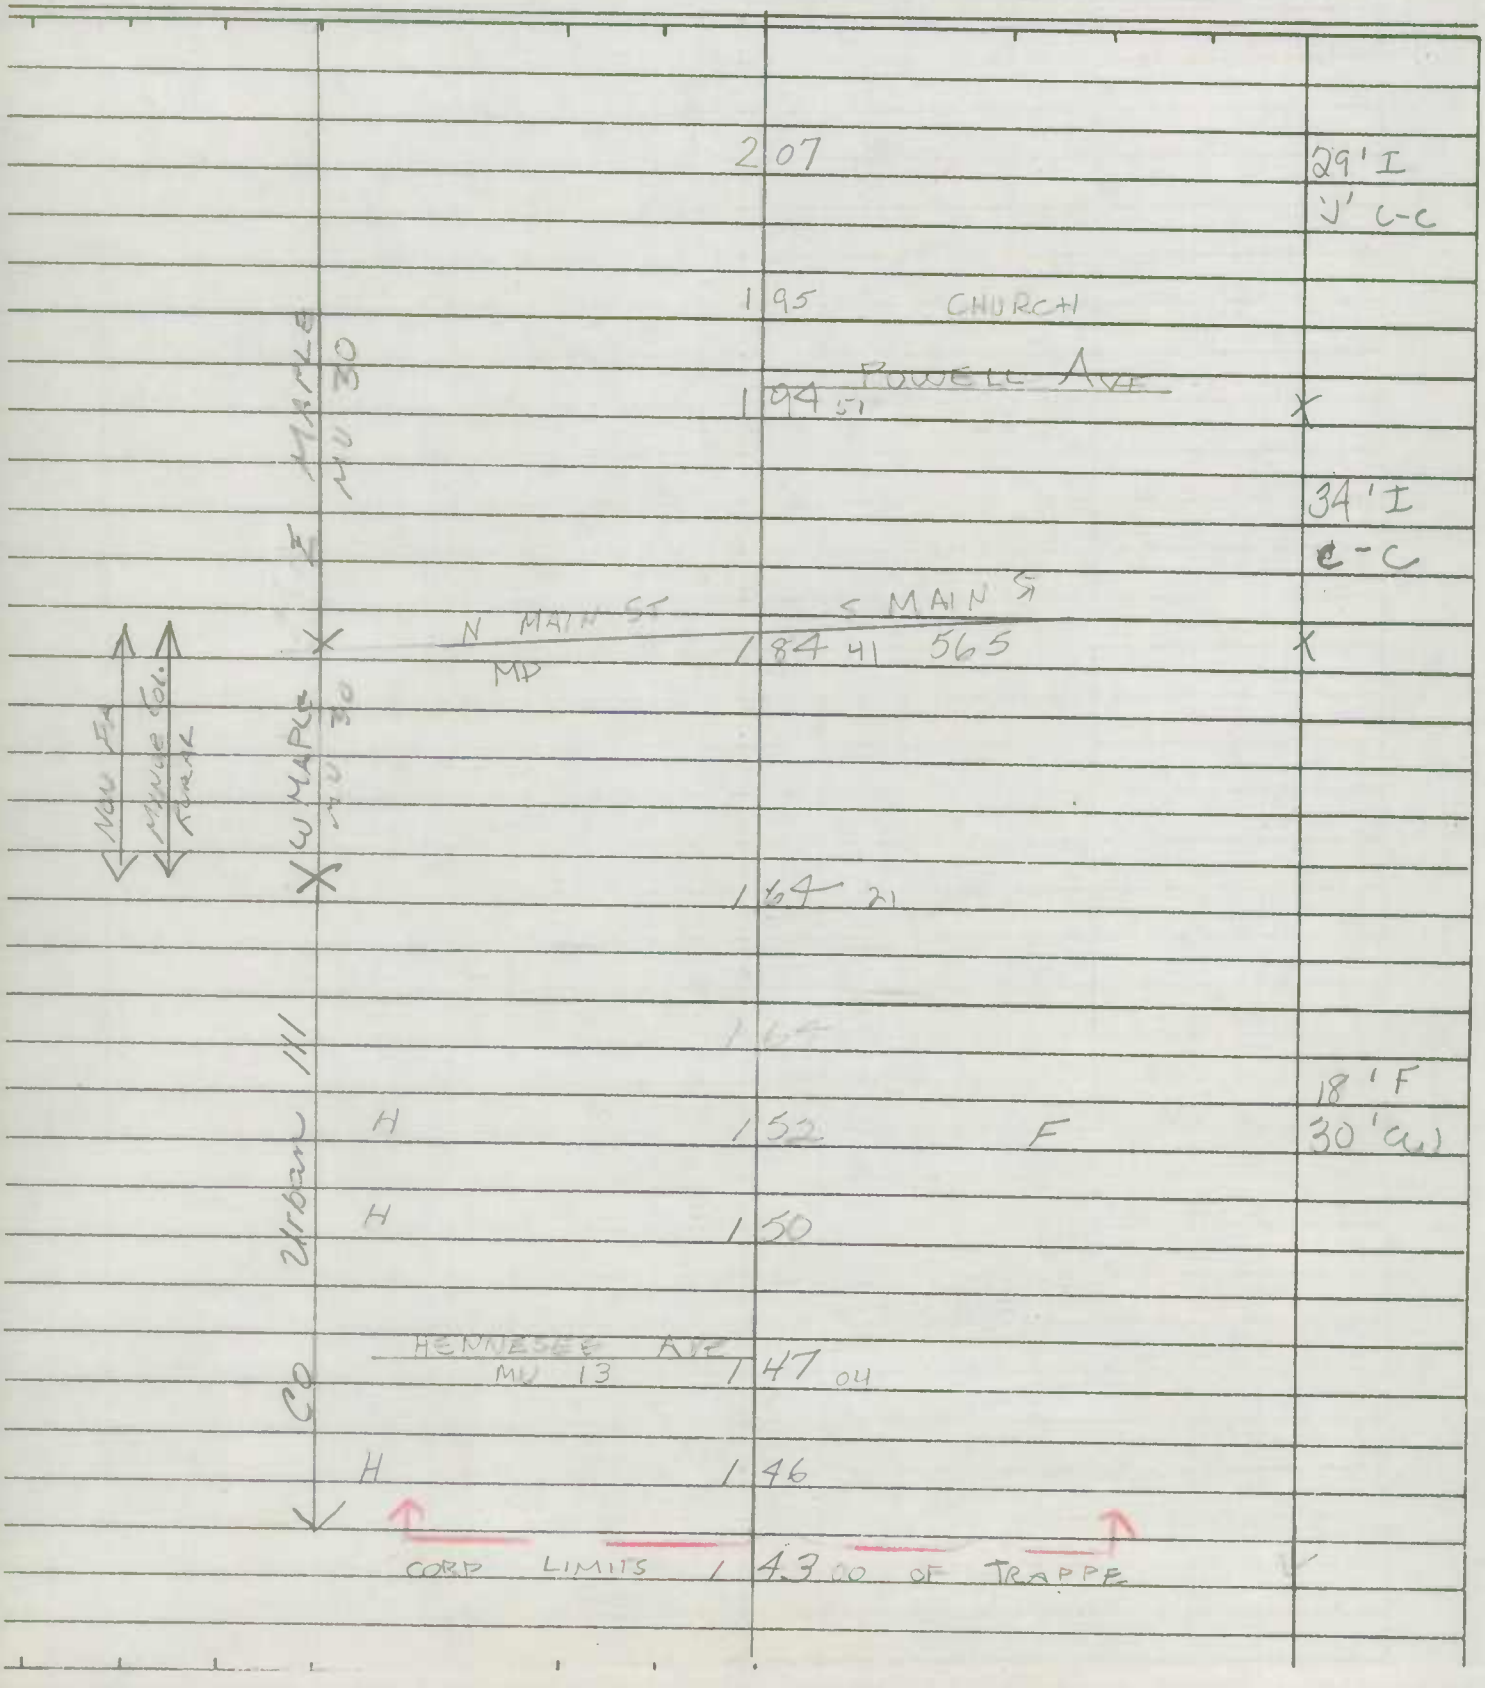

SHA 51.3-8
11-15-72

STATE HIGHWAY ADMINISTRATION OF MARYLAND

ROAD INVENTORY SHEET

Party Chief _____
Recorder _____
Helper _____

Map No. _____

Road No. Co 30
Road Name E MAPLE AVE
Sheet No. 3 of 3
Date 5-25-66
County TALBOT
State Coordinates _____

Report 8-27-81 JTC

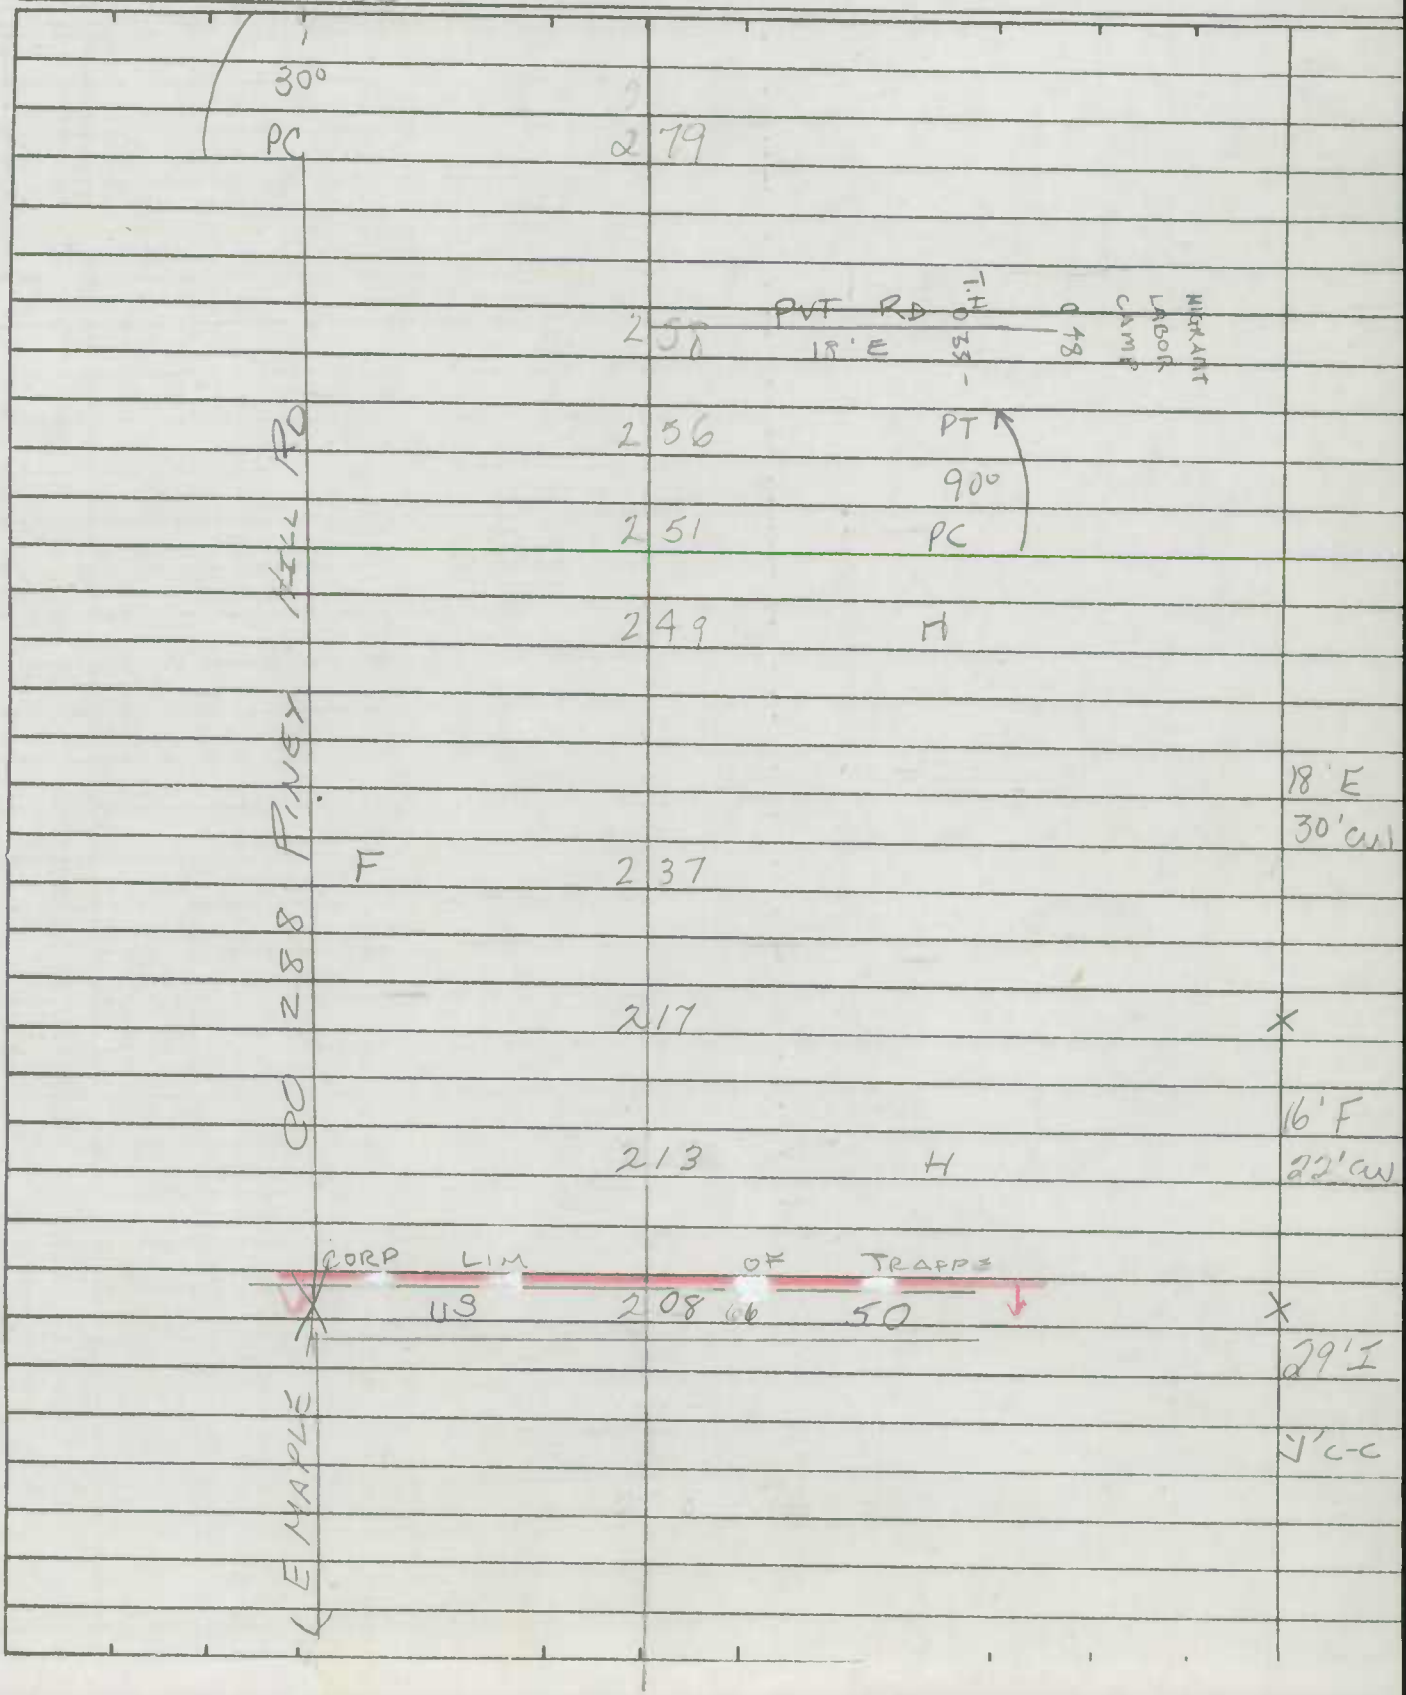

SHA 51.3-8
11-15-72

ROAD INVENTORY SHEET

Road No. _____
Road Name _____
Sheet No. _____
Date _____
County _____
State Coordinates _____