Form 6 HPS (Rev. 1961)

PS177

ROAD INVENTORY SHEET

Party Chief R. VOUGHT
Recorder L. COFFELT JR.
Chainman

BOONSBORO

VER 7-8-76

21 012

Road No. 0030
Name CENTER ST
Sheet No. 1 OF 1
Date 10-10-63
County WASHINGTON

School		St.
OP	0 46	L
	0 45	S
	0 44	S
RD A.		
	0 43	
130°	0 41	
	0 35	
ORCHARD ~~Alley~~		DR ~~?~~
MUN	0 25	MD
	0 21	
FORD AVE		FORD
	0 19	Co
ALLEY 4		
MUN ROAD	0 14	
LAKIN		AVE
MUN	0 10	20
	0 08	
		ALLEY 15
	005	MUN 8150
ST PAUL		ST
MUN	000	~~540~~ 0160

Boys Scout

24'I
26'CW
~~20'I~~
~~26~~ CW

19'I
C-C

16'I
CURB RT
18'CW

~~14'I~~
~~20'CW~~

Form 6 HPS (Rev. 1961)

PS:17

ROAD INVENTORY SHEET

Party Chief R. VOUGHT
Recorder L. COFFELT JR.
Chainman

BOONSBORO

VER 7-8-76

Road No. 0030
Name CENTER ST
Sheet No. 1 OF 1
Date 10-10-63
County WASHINGTON

School		ST.	
0	46	167	
0	45	School Pking	20'I 30'CW
0	44	School	
Rd A.			
0	43		12'I 18'CW
30°	0	41	16' F 18'CW
0	35		18'H Curb LT. 24'CW
ORCHARD ~~Alley~~		DR ~~?~~	
MUN	0	25	ITD
0	21		
FORD AVE		FORD AVE	
0	19	Co. 541	~~24'I 24'CW~~ 24'I 26'CW
ALLEY 4			
MUN BOAD	0	14	
LAKIN		AVE	
MUN	0	10	19'I C-C
0	08		16'I CURB RT 18'CW
		ALLEY 15	
0	05	MUN 8150	~~14'I 20'CW~~
ST PAUL		ST	
MUN		~~540~~ 0160	

SHA 51.3-8
11-15-72

STATE HIGHWAY ADMINISTRATION OF MARYLAND

ROAD INVENTORY SHEET

Party Chief R Voight
Recorder J Corbett Jr
Helper

Map No. BB FR REV 4-14-81

Road No. 0040
Road Name DELLA LA
Sheet No. 1 of 1
Date 10-10-83
County WASHINGTON
State Coordinates

Count 8-26-81 VTSC Boonesboro

SEE NEW INVENTORY

STOUFFER MU 0 52 AVE 170 PT

1-31-90 DT

0 47 CG PC 80°

(89-3)

15° 0 44

THOMAS MUN 0 32 LA

0 17 WINNER MU (49-4) LA

0 10

24'H

PT 85°

PC

0 07

0 03

ROAD 0 00 END

29'Z
30'cw
32-Z

SHA 51.3-8
11-15-72

ROAD INVENTORY SHEET

Road No. _____
Road Name _____
Sheet No. _____
Date _____
County _____
State Coordinates _____

Form 6 HPS (Rev. 1961)

ROAD INVENTORY SHEET

Party Chief R. VOUGHT
Recorder
Chainman

VER. 7-8-76

Boonsboro
80-9

BB REV. FR. 4-14-81

Road No. 0040
Name DELCA LA
Sheet No. 1 OF 1
Date 10-10-63
County WASHINGTON

79-2

STOUFFER			AVE
MUN	0	~~34~~ 052	170
		~~043~~	
		~~030~~ 047	
		~~034~~	
↑15°			
+HOMES	0	44	LA
ALLEY		~~014~~ 032	16
		~~023~~	
	0	10	
↑PT 85°	0	07	
PC	0	03	
ROAD	000		END

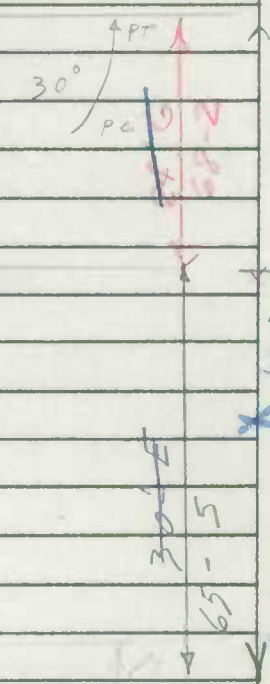

Form 6 HPS (Rev. 1961)

COPY

ROAD INVENTORY SHEET

MUN. No. 0050

Party Chief R. VOUGHT
Recorder L. COFFELT JR
Chainman

BB REV.
FR 4-14-81

VER
7-8-76

Road No. ~~CO~~ ~~541~~
Name FORD AVE
Sheet No. 1 of 1
Date 10-10-63
County WASHINGTON

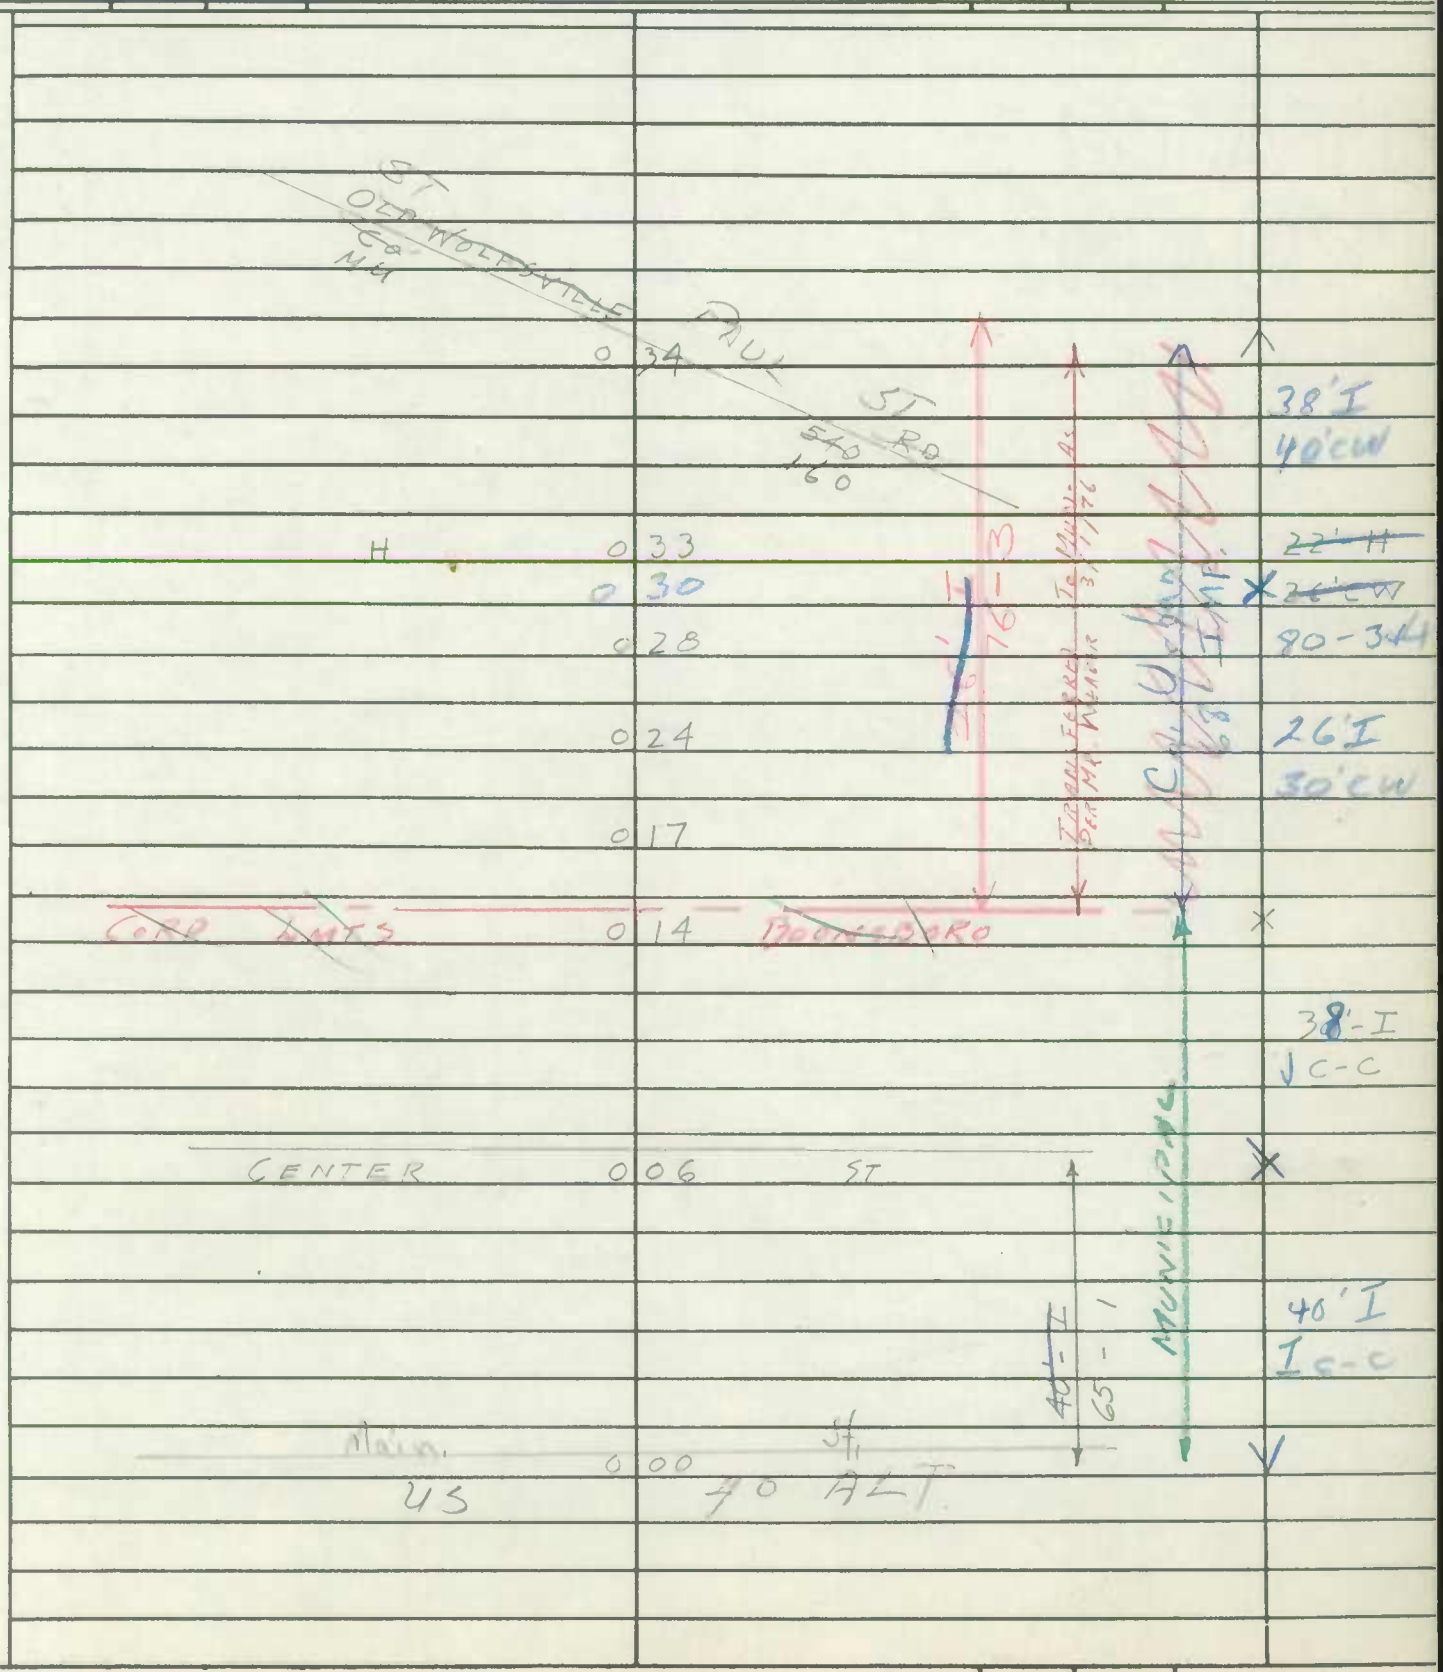

Form 6 HPS (Rev. 1961)

A/T
57-62
AL1K3
3-21-58
Mun. 0063

P8-77

ROAD INVENTORY SHEET

Party Chief R. VOUGHT
Recorder L. COFFELT JR.
Chainman

VERIFIED
6-29-76

Boundary 614-613
82-4 NS EM

Road No. Co. 638
Name KNODE CIRCLE
Sheet No. 1 OF 1
Date 10-10-63
County WASHINGTON

KNODE
MUN ~~CO~~ 012
011
010
008
005
KNODE
MUN. CO. 004

CIRCLE #2
~~637~~ 0064
S H
1/26/27
CIRCLE
~~637~~
0064

16'I
22'CW
18'I
26'CW
16'I
~~4~~ 11
2 2 CW

E

ALT. 000 US 40

Form 6 HPS (Rev. 1961)

P8-11

Mun 0064

ROAD INVENTORY SHEET

Party Chief R. VOUGHT
Recorder L. COFFELT JR.
Chainman

VERIFIED 6-29-76
613-615

Road No. Co 639
Name Knode Circle #2
Sheet No. 1 OF 1
Date 10-10-63
County WASHINGTON

BOUNDARY

KNODE
MUN. ~~CO~~ 0 27 ~~640~~ 0065

0 26
0 18
0 16

LINE

KNODE
CORP ~~CO~~ MU 0 09 0063 ~~638~~

0 07

0 05

S
Knode Circle
MU ~~CO 638~~ 0063 0 03 BOUNDARY 3 H
CORP LINE 0 02

0 01

Knode
MUN. ~~CO~~ 0 00 Circle #3 ~~640~~ 0065

Circle #3

10'H 14'cw

14'H 18'cw

16'H 18'cw

Form 6 HPS (Rev. 1961)

MUN. 0065

ROAD INVENTORY SHEET

Party Chief R. VOUGHT
Recorder L. ~~COFF~~ELT JR. VERIFIED 6-29-76
Chainman

Boonsboro 613-615

Road No. Co. 640
Name KNODE CIRCLE #3
Sheet No. 1 OF 1
Date 10-10-63
County WASHINGTON

ROAD, END

0.09

KNODE CIRCLE #2

MUN. 0064 ~~Co 639~~ 0.08

~~SCHL WKG~~ 0.07

~~H~~ 0.06

0.05

KNODE CIRCLE #2

MUN. 0064 ~~Co 639~~ 0.03

MARIESVILLE

n/d. 0.00

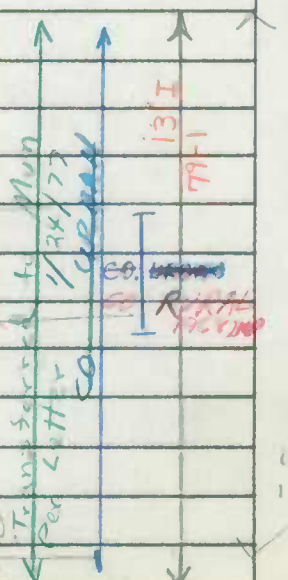

SHA 51.3-8
11-15-72

STATE HIGHWAY ADMINISTRATION OF MARYLAND

90-#7
2-28-91
GD/TM

ROAD INVENTORY SHEET

Party Chief W. DOMBROSKI
Recorder M. ZALENSKI
Helper

Map No. ~~B-8~~ (SE) VERIFIED 7/8/76
"BOONSBORO"

Road No. ~~OP 169~~ MD 70
Road Name LAKIN AVE
Sheet No. 1 OF 1
Date 10-10-63
County WASHINGTON
State Coordinates 619 - 611

UNASSIGNED
ABAND'D
90-1

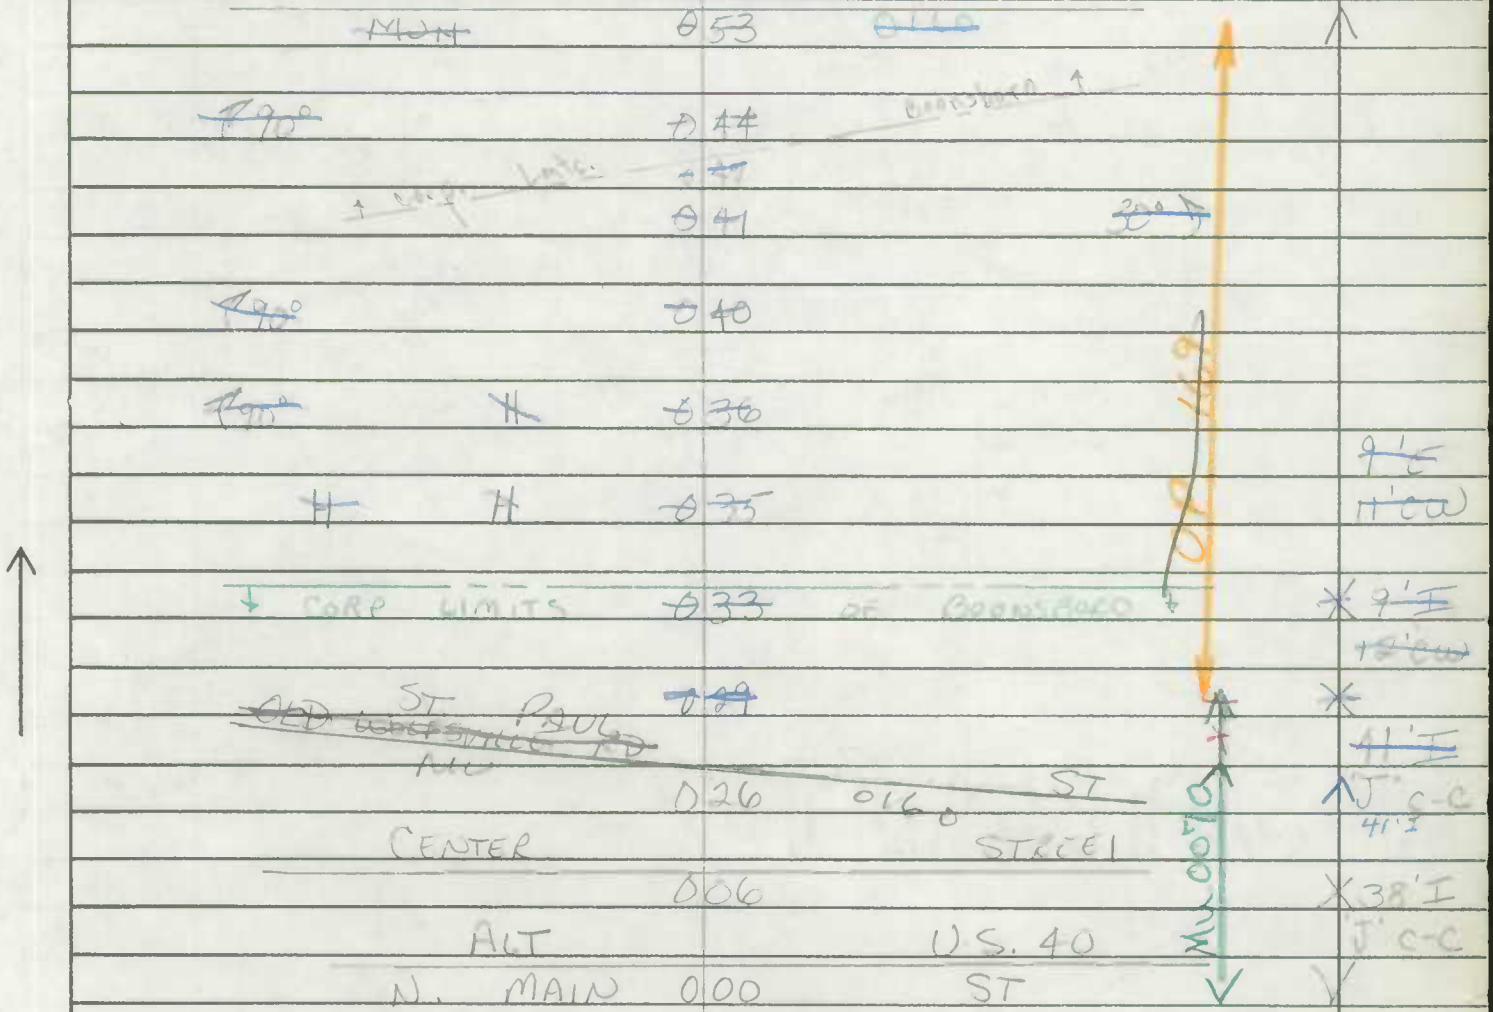

SHA 51.3-8
11-15-72

ROAD INVENTORY SHEET

Road No. _____
Road Name _____
Sheet No. _____
Date _____
County _____
State Coordinates _____

Form 6 HPS (Rev. 1961)

~~AH~~

ROAD INVENTORY SHEET

Mun. No. 0090

Party Chief R. Vought
Recorder L. Coffelt, Jr.
Chainman

VERIFIED
6-29-76

Road No. Co 546
Name Mousetown Rd.
Sheet No. 1 of 2
Date 9-27-63
County Wash.

		0.77		
40°				
		0.67		
30°				
		0.61		
30°				
		0.59	WPC 6' x 8' x 17'	
		0.58	30°	
F		0.50	CO 546	
P.T.		0.46	10' Multi Plate Arch	10'H ~~11'~~ C.W.
			O.P. 89	
		0.43		
45°				
P.C.	H	0.42	298	
	H	0.29		12'H
	H	0.30	CO	16'CW
		0.27	F 45°	
		0.07	Approx. Corp. Limits — Mannington	
			Municipal	14'H ~~12'H~~ 16'C.W.
AH.		0.00	U.S. 40	

Form 6 HPS (Rev. 1961)

ROAD INVENTORY SHEET

Party Chief R. Vought
Recorder L. Coffelt, Jr.
Chainman

VERIFIED 6-29-76

Road No. 0100 Co. 540
Name Old Wolfsville Rd.
Sheet No. 1 of 1
Date 9-26-63
County Wash.

Boonsboro

Pvmt
St Paul St.
016
Mun.

Ford Ave. Co. 541 012
009
008
Corp. Limits 006
Boonsboro
Lattig Ave. 000
Lattig Ave. 70 MUN
C.L. Sign
Int. Ave.
12 H
22 C.W.
C.P. Sect.

SHA 51.3-8
11-15-72

STATE HIGHWAY ADMINISTRATION OF MARYLAND

P8-17

73-2

ROAD INVENTORY SHEET

Party Chief W. Dombroski
Recorder D. Taylor
Helper

Map No. _____ VER 7-8-76

Boonesboro

Road No. 0110
Road Name Orchard Dr
Sheet No. 1 of 1
Date 1-29-74
County Washington
State Coordinates

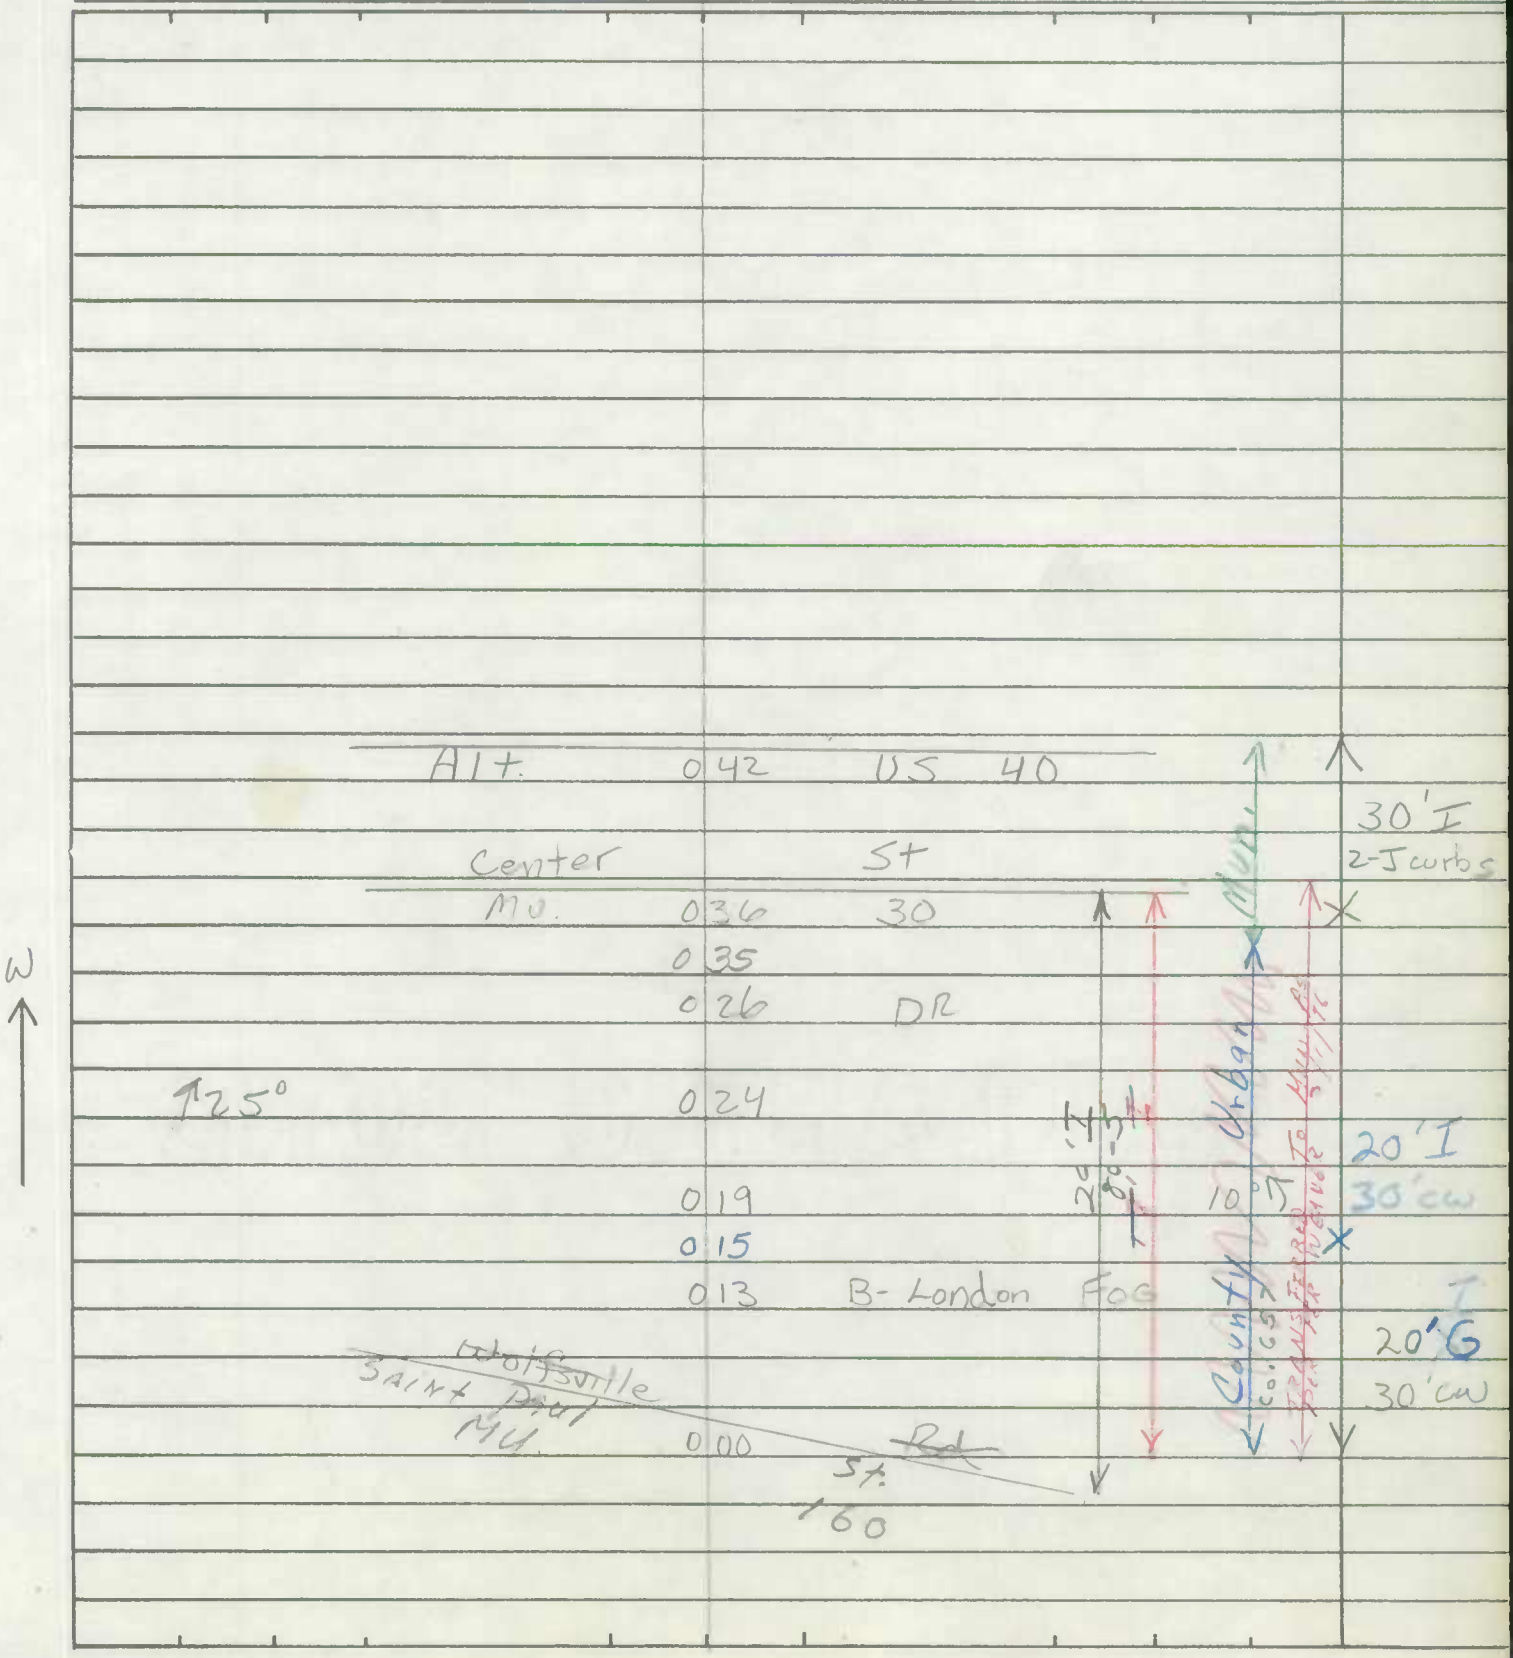

SHA 51.3-8
11-15-72

ROAD INVENTORY SHEET

Road No. _____
Road Name _____
Sheet No. _____
Date _____
County _____
State Coordinates _____

Form 6 HPS (Rev. 1961)

P3-17

ROAD INVENTORY SHEET

Party Chief R. Vaught
Recorder L. Coffelt, Jr.
Chainman

VER
7-8-76

Boonsboro

Road No. 0140
Name Park La.
Sheet No. 1 of 1
Date 10-10-63
County Wash.

S83 AT

PARK DR
MU 120

PARK

Park Dr.
MUN ~~130~~ 120 011

McKeldin Dr.
MUN 80 007

ONE WAY

MUN 80 ft 005

Potomac
Md 000

St
34

24' A I
Curb Lt.
26' C-C.

← RESERVE ALLEY

MU 80 ft

SHA 51.3 - 8 Revised 4.83

MARYLAND STATE HIGHWAY ADMINISTRATION

ROAD INVENTORY SHEET

ST. PAUL ST

Party Chief Rewritten THR
Recorder
Assistant
Map No./Dir. 1E
State Coordinates G16 - 610

Road No. MU 0160
Road Name ~~OLD Waltsville~~ Rd
County WAshington
Date 10-4-88
Sheet No. 1 OF 2

91-2 A/T
89-2
88-1 A-T

TRAFFIC CODES
TRAFFIC CONTROLS: STOP SIGN=SS, TRAFFIC LIGHT=T.L., FLASHING RED BALL=F.R.

PARKING RESTRICTIONS: A.M. PEAK, P.M. PEAK, A.M./P.M. PEAK, NO PARKING ANYTIME=N.P., COMM/IND. ACCESS=E

SYSTEM				TRAFFIC		LINE DIAGRAM	TRAFFIC			PAVEMENT DATA
FED. AID.	FUNCT CLASS.	HWY. SYS.	HPMS SAMPLE	PRK.G. REST.	COM/IND. ACCESS	Boons boro	CONTROL	COM/IND. ACCESS	PRK.G. REST.	
						SNJ				29'I
										"J" C-C
						ALLEY / MU 8150 0 24			X	
						11/4/97				
						(LAKIN AVE)				
						0 20 op 169				
						0 17 45°				26'I
										"J" C-C
						0 16			X	
										28'I
										30'CW
						HIGH ST				
						0 11 MU 0060			X	
										30'I
										"J" C-Rt
						CENTER ST				36'CW
						MU 0030 0 06				
						ALLEY # 13				
						0 05 MU ~~8130~~ 8130			X	
						N MAIN ST / S MAIN ST				
						US 0 00 40 AL	TL		V	

SYSTEM: FED. AID. | FUNCT. CLASS. | HWY. SYS. | HPMS SAMPLE

TRAFFIC: PRKG. REST. | COM/IND ACCESS

LINE DIAGRAM

TRAFFIC: CONTROL | COM/IND ACCESS | PRKG. REST.

PAVEMENT DATA

Rural Minor collector

5+40

SHEET CO

PT

0 68

5+10

CO Boonsboro Mountain Rd

90° Mountain Laurel

~~Boonsboro~~ Rd

CO 539 0 63

Limits

0 62

CORP

P.C.

0 60

VALLEY VIEW DR.

0 57 MU 0172

ORCHARD DR

MU 0110 0 53

END MAIN BEGIN CO

FORD AVE

MU 0050 0 42

0 36

LAKIN AVE

MU 0070 0 30

18'H

30'CW

X

18'HI

30'CW

X

SAME

Boonsboro

Form 6 HPS (Rev. 1961)

OLD WOLFSVILLE 34

ROAD INVENTORY SHEET

MU.0160

Party Chief R. VOUGHT
Recorder L. COFFELT JR.
Chairman

618-612

Road No. 1 of 10
Name SAINT PAUL ST.
Sheet No. 1 of 3
Date 9-26-63
County WASHINGTON

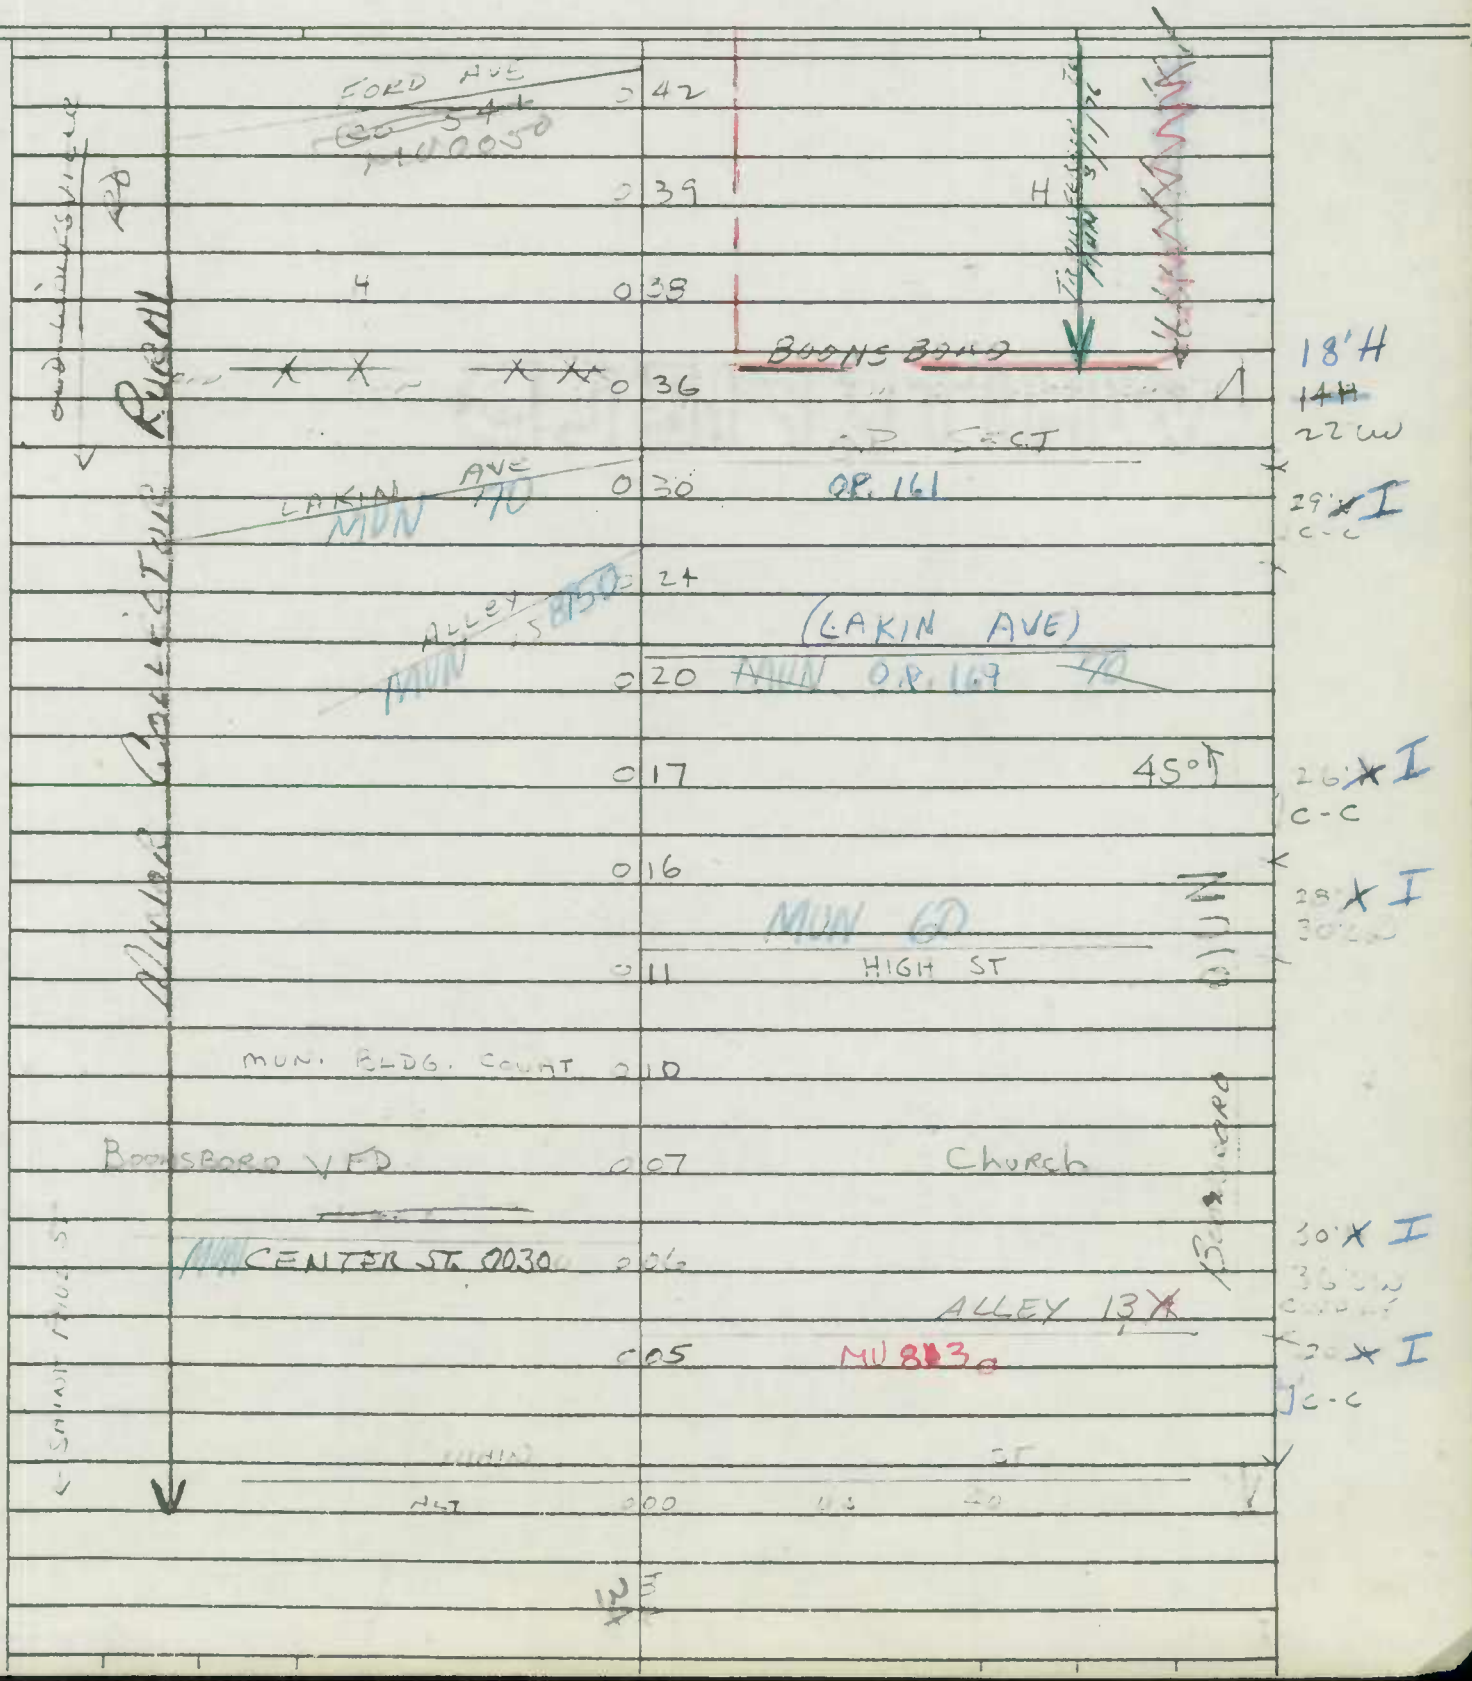

Form 6 HPS (Rev. 1961)

ROAD INVENTORY SHEET

MV. 0160

Party Chief R. VOUGHT
Recorder L. COFFELT JR.
Chainman

Road No. ~~C-540~~
Name
Sheet No. 2 OF 3
Date 9-26-63
County WASHINGTON

		1	43	E
	B-SAW MILL	1	33	
		1	31	
RURAL		1	30	3-18" CMP
	TH F	1	19	
		0	98	PWR. STA.
COLLECTOR	BOWSBORO MUN. WATER SUPPLY	0	90	T F
		0	89	
		0	EC	
		0	83	30°
PA		0	EE	
MINOR	B-RADITOR SHOP H	0	67	ENT TO APTS.
	90°	0	64	E
	BOWSBORO - ~~MUNI~~ RD			
	CO 539	0	63	
		0	62	
PC		0	60	
	CORP - - - -			
	ORCHARD DR			
	~~CO 657~~ MU 0110	0	53	H
		0	46	H
	H(V)	0	45	
		0	43	H

14'H
16'CW

Form 6 HPS (Rev. 1961) Boonsboro

ROAD INVENTORY SHEET

Party Chief T. LANDON
Recorder W. WARFIELD
Helper

Revised 1-29-74 W.D D.T.

VER 7-8-76 65-3

Road No. 0180
Road Name YOUNG AVE.
Sheet No. 1 OF 1
Date 2-7-73
County WASH.

77-10 91-4 A/T

	MD. ~~40~~ ~~34~~		~~20'C~~
		MONUMENT DR	26'CW
~~120~~°	0	34 MUN 0085	30'XI
		~~AL. #17~~ SINNISEN DR	30'CW
	0	23 ~~65-F~~ MU8170	X
		~~AL. #12~~ GANTZ ALLEY	
	0	17 MU8120	
	CEMETERY	LA.	
	MUN. 0	05 0020	40'I
Reeders	AL.	#8 Alley	"J" C-C
-13-4	MUN. 0	00 8080	

Form 6 HPS (Rev. 1961)

ROAD INVENTORY SHEET

Road No. _____

Road Name _____

Sheet No. _____

Date _____

County _____

Form 6 HPS (Rev. 1961)

ROAD INVENTORY SHEET

Party Chief R. VOUGHT
Recorder L. COFFELT JR.
Chainman

BOONSBORO

VER. 7-8-76

Road No. 8010
Name ALLEY 1
Sheet No. 1 OF 1
Date 10-10-63
County WASHINGTON

16-9

Road End
GATE
0 30

W

THOMAS

LANE

10'E
12'CW

MUN 0 21 8160

10'H
13'CW

1990 0 26

N MAIN ST

ALT 0 28 US 40

Form 6 HPS (Rev. 1961)

ROAD INVENTORY SHEET

Party Chief R. Vought
Recorder L. Coffelt, Jr.
Chainman

Boonsboro

85-09
VER 7-8-76 DT 3-1186
DC

Road No. 9090
Name Alley 9
Sheet No. 1 of 1
Date 10-12-83
County Wash.

91-2

Alley 3
MUN 8030

ROAD 0.15 END

20' I
30' CW

90°

Park Ave.
MUN 0130

Alley 4 (Walkway)
10' McH. - Plate Arch

Park Dr.
MUN. 130

PARK AREA

N

← PARK LA

MUN. 0140

Form 6 HPS (Rev. 1961)

AL/KS 87-5 3-21-88

64

ROAD INVENTORY SHEET

Party Chief R. VOUGHT
Recorder L. COFFELT JR.
Chainman
Boonsboro

83-1 3/22/84 BO-NS
VLR 7-8-76

Road No. 8100
Name ALLEY 10
Sheet No. 1 OF 1
Date 10-10-63
County WASHINGTON

Potomac ST
NB 0 27 34

SINNISEN Dr
~~Alley~~
MUN 8170 0 23

GANTZ ~~ALLEY~~ ~~T~~ AL
0 17

W
Cemetery 0 8 LA
0 25

REEDERS ~~ALLEY~~ ALLEY 8
MUN 0 00 8080

~~10~~ I
~~24'~~ CW
~~H~~ A
14'CW

I
~~9'~~ A
12'CW

10 ~~&~~ III
13'CW

Form 6 HPS (Rev. 1961)

GPS-02
4-17-02
GD/EF

THOMAS LANE

ROAD INVENTORY SHEET

Party Chief R. VOUGHT
Recorder L. COFFELT JR.
Chainman

Boonsboro

VER
7-8-76

Road No. 8160
Name ALLEY #6
Sheet No. 1 OF 1
Date 10-10-63
County WASHINGTON

MAIN ST N.
DELLA LA
MUN 40 0 09 MU 0040
US 40 ALT

W

ALLEY 1
MUN 0 05 8010
DELLA MU LA
0040

Form 6 HPS (Rev. 1961)

ROAD INVENTORY SHEET

MUN. No. 0010

MARTIN ST

Party Chief R. Vought
Recorder L. Coffelt, Jr.
Chainman

VCR.
7-12-76

Road No. ~~Co. Rt.~~ Clear
Name ~~Big Spring Rd.~~
Sheet No. 1 of 2
Date 8-20-63
County Wash.

0.44 — 6 H — 0.44 — 8-Funeral Home — 0.38 — High School — 0.36 — Approx. Corp. Limits — Clear Spring — West Alley — 0.35 MUN 9010 — Cem. 0.32 — Church 0.30 — Church — Mulberry St. 0.28 — South 0.23 — Alley — 0.19 — Alley — North 0.14 — Approx. Corp. Limits — 0.09 — Clear Spring

Clear Spring

Rd. 75

26' CU.

2 ML

broad forking 0.00 CO

Form 6 HPS (Rev. 1961)

ROAD INVENTORY SHEET

MUN. No. 0010

Party Chief R. Vaught
Recorder L. Coffelt, Jr.
Chainman

VER. 7-12-76

Road No. ~~C.9~~ C.100-2
Name ~~Big Spring Rd.~~ MARTIN ST
Sheet No. 1 of 2
Date 8-20-63
County Wash.

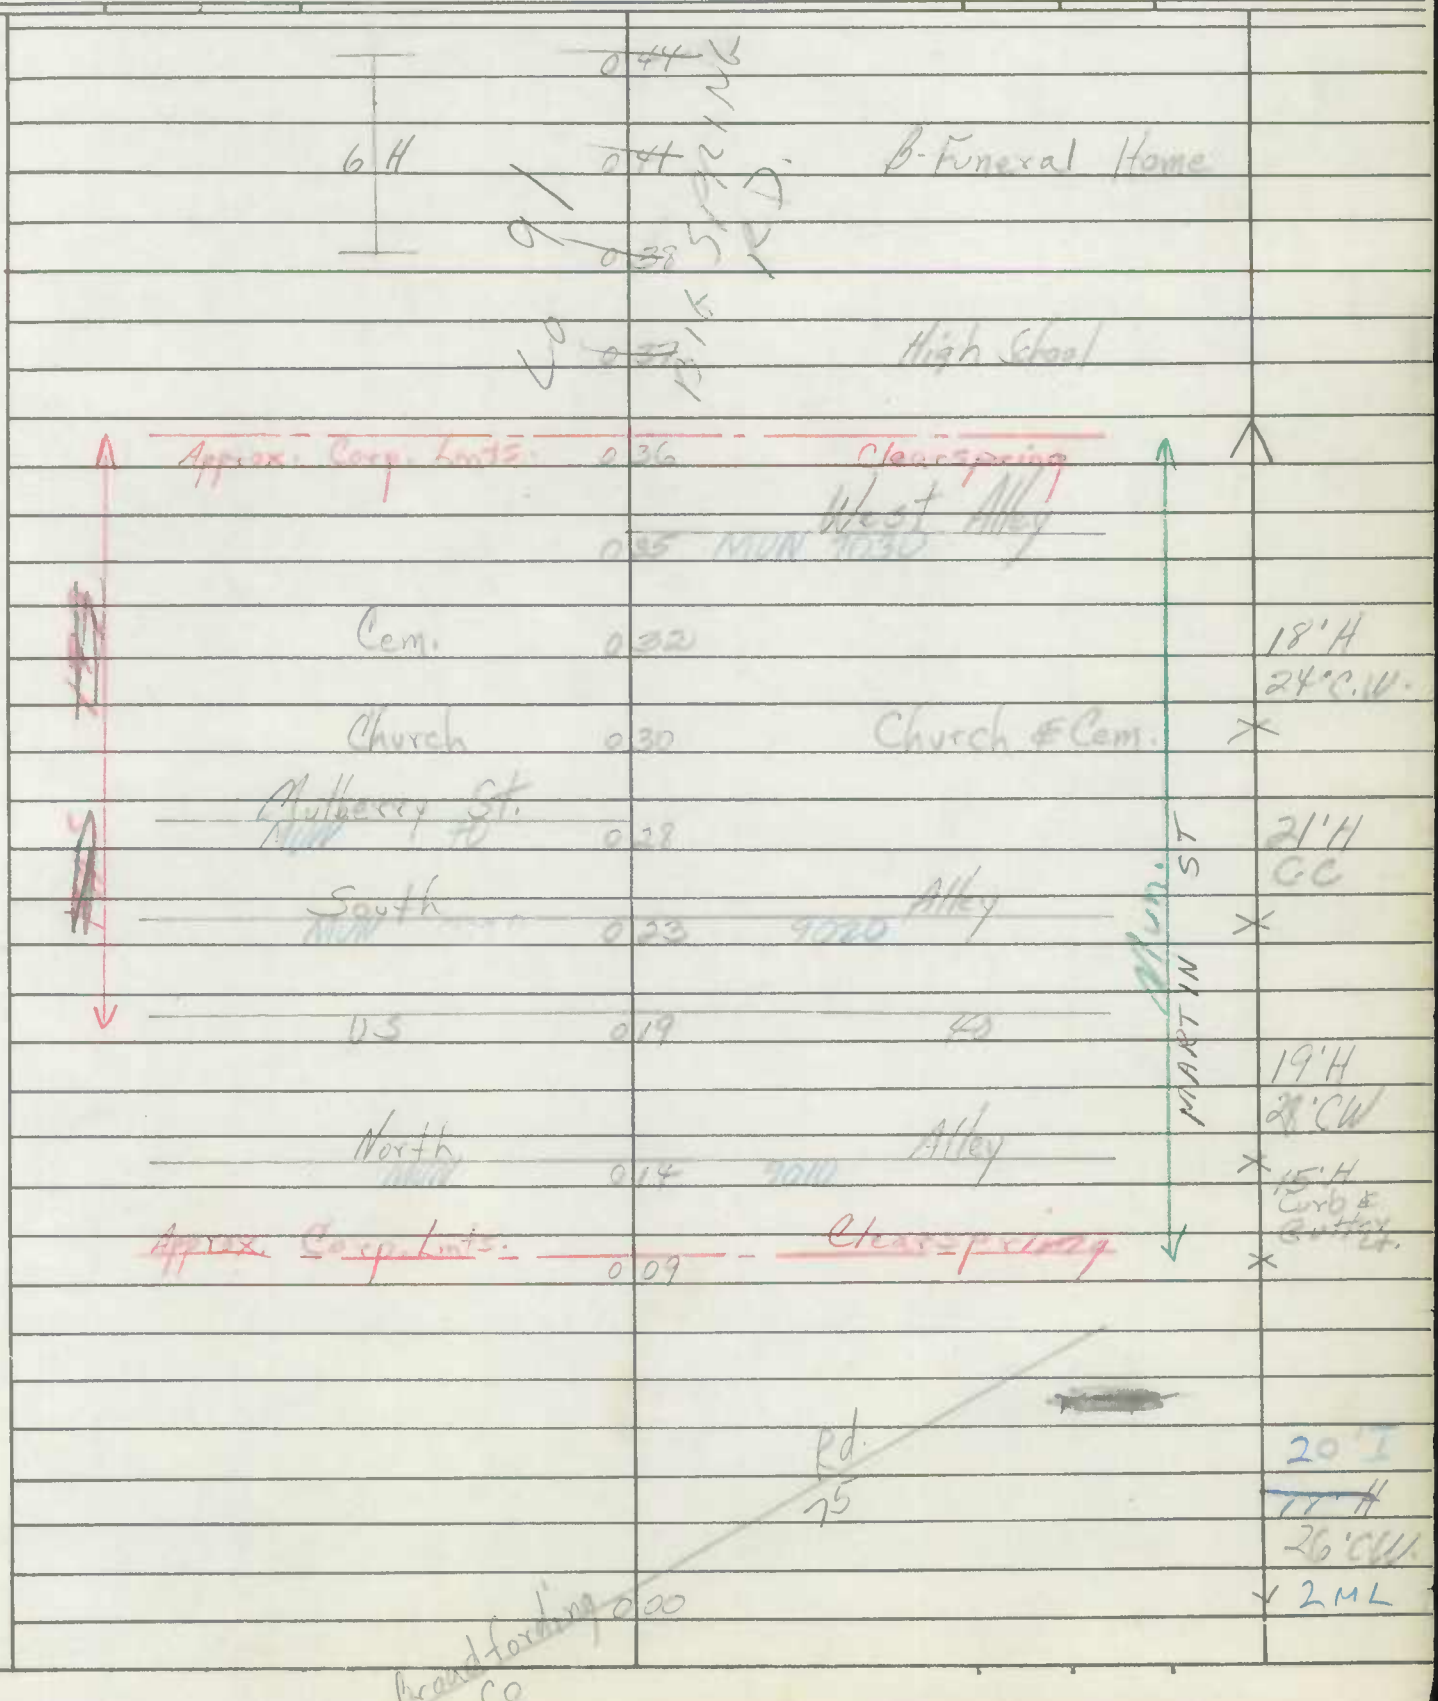

REWROTE SM 93 MU EX #3, #2 3-16-94 AL/TM

SHA 51.3 - 8 Revised 4.83

MARYLAND STATE HIGHWAY ADMINISTRATION

ROAD INVENTORY SHEET

Party Chief R VOUGHT
Recorder L COFFELT JR
Assistant
Map No./Dir. 1
State Coordinates 538 - 665

Road No. MUN 0030
Road Name MILL ST
County WASHINGTON CO.
Date 10-6-98
Sheet No. 1 OF 1

SYSTEM: FED. AID. | FUNCT CLASS. | HWY. SYS. | HPMS SAMPLE
TRAFFIC: PRKG. REST. | COM/IND. ACCESS

NON FA
MINOR COLLECTOR RURAL

TRAFFIC CODES
TRAFFIC CONTROLS: STOP SIGN=SS, TRAFFIC LIGHT=T.L., FLASHING RED BALL=F.R.

TRAFFIC CODES
PARKING RESTRICTIONS: A.M. PEAK, P.M. PEAK, A.M./P.M. PEAK, NO PARKING ANYTIME=N.P., COMM/IND. ACCESS=E

LINE DIAGRAM

CLEAR SPRING

CNI
FCR-97
10/29/97
GD, MP

Cumberland St
US 015 40

NORTH ~~NORTH~~ HANBAKER CIR ~~ALLEY~~
MU 010 ~~0010~~ 0050

Widmeyer Drive ~~ALLEY~~
MU 0150 005

Hollywood Drive #5
MU ~~0000~~ 0110

~~ALLEY~~
MU ~~0000~~ 00270 00

CORP LIMITS OF CLEAR SPRING

CO 0103 MT MILL

TRAFFIC: CONTROL | COM/IND. ACCESS | PRKG. REST.

PAVEMENT DATA
20' H
22' CW

SYSTEM				TRAFFIC		LINE DIAGRAM	TRAFFIC			PAVEMENT DATA
FED. AID.	FUNCT. CLASS.	HWY. SYS.	HPMS SAMPLE	PRKG. REST.	COM/IND ACCESS		CONTROL	COM/IND ACCESS	PRKG. REST.	

Form 6 HPS (Rev. 1961)

4

ROAD INVENTORY SHEET

M 2 D

Party Chief R. VOUGHT
Recorder L. DEFFELT JR.
Chainman

VERIFIED 6-23-76

538-667

CLEAR SPRING
A-7

Road No. C 103
Name MILL ST
Sheet No. 1 OF 1
Date 8-21-63
County WASHINGTON

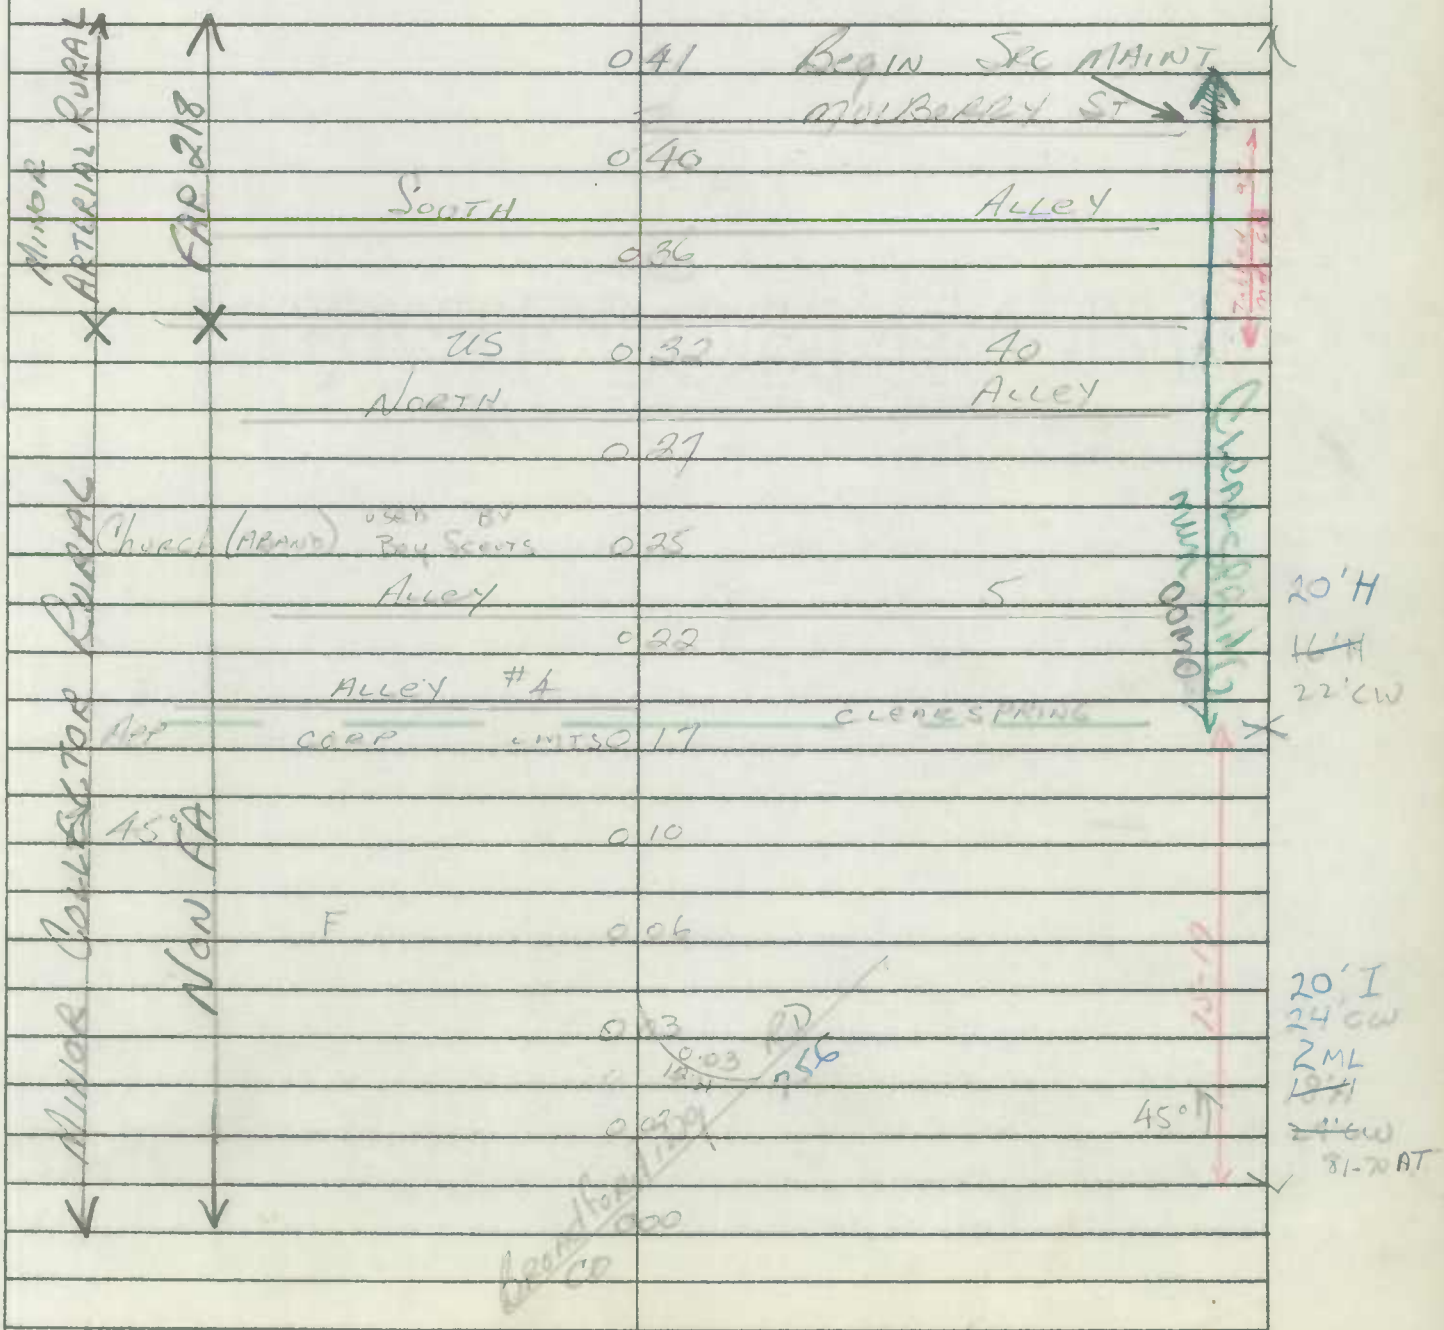

Form 6 HPS (Rev. 1961)

ROAD INVENTORY SHEET

MUN. No. 0040

Party Chief R. VOUGHT
Recorder L. COFFELT JR.
Chainman

VER. 7-12-76

CLEAR SPRING

Road No. Mulberry St
Name
Sheet No. 1 OF 1
Date 8-21-63
County WASHINGTON

MARTIN ST.

BIG SPRING Rd

MUN 0010 0.19 MUN 10'

14'H 22'CW

ALLEY #3

0.14 MUN 0030 X

0.09 Church

16'H

0.08 CBC 3/3 X 13X W

14'H 22'CW

0.07 CLEARSPRING V.F.D. 28 79-1

MILL ST

MD 68

Form 6 HPS (Rev. 1961)

D/T

MUN. No. 9010

ROAD INVENTORY SHEET

Party Chief R. VOUGHT
Recorder L. COFFELT JR.
Chainman
Clear Spring

VER 7-12-76

Road No. NORTH ALLEY
Name
Sheet No. 1 OF 1
Date 8-21-63
County ~~WASHINGTON~~

Form 6 HPS (Rev. 1961)

P9-17

M + C5

ROAD INVENTORY SHEET

Party Chief R. VOUGHT
Recorder L. COFFELT JR.
Chainman

FUNKSTOWN

Road No. ~~202~~
Name ~~ST~~ N
Sheet No.
Date 9—
County WASH

Funkstown

Ford End MUN # 019
0.31 0.17
WYE OAK DR

N. MAIN ST

W. POPLAR ST — E. POPLAR ST
0.28 0.11

W. CHESNUT ST — E. CHESNUT ST
0.23 0.06

W. BALTIMORE ST ALT — E. BALTIMORE ST US 40
0.17 0.00

W. MAPLE ST — E. MAPLE ST
0.11

W. CEMETERY ST — E. CEMETERY ST
0.06

W. GREEN ST — E. GREEN ST
0.00

30' CW
16 E
22 CW
30' T
Jct C
30' T

Form 6 HPS (Rev. 1961)

P9-17

M+C5

4

ROAD INVENTORY SHEET

Party Chief R. VOUGHT
Recorder L. COFFELT JR.
Chainman

FUNKSTOWN

Road No. ~~0020~~ -0010
Name ~~E~~ N ANTIETAM ST
Sheet No. 1 OF 1
Date 9 - 17 - 63
County WASHINGTON

	Ford End MUN # 0195
	0.31 0.17 WYE OAK DR
	22'I 30'CW
W. POPLAR ST	E. POPLAR ST
	0.28 0.11
N. ANTIETAM ST	
W. CHESTNUT ST	E. CHESTNUT ST
	0.23 0.06 30'I
W. BALTIMORE ST ALT	E. BALTIMORE ST US 40
	0.17 0.00
W. MAPLE ST	E. MAPLE ST
	0.11
W. CEMETERY ST	E. CEMETERY ST
	0.06
W. GREEN ST	E. GREEN ST
	0.00

Form 6 HPS (Rev. 1961)

MUN. No. 0040 E S. BALTO ST
BEAVER CREEK RD.

AT 9-77

ROAD INVENTORY SHEET

Party Chief R. VOUGHT
Recorder L. COFFELT JR.
Chainman

VER 7-7-76

COPY 12/9/63 AS PER E.T.S.

SEE NI
90 EX # 4 ST

Road No. CO 343
Name
Sheet No. 1 OF 5
Date 9-18-63
County WASHINGTON

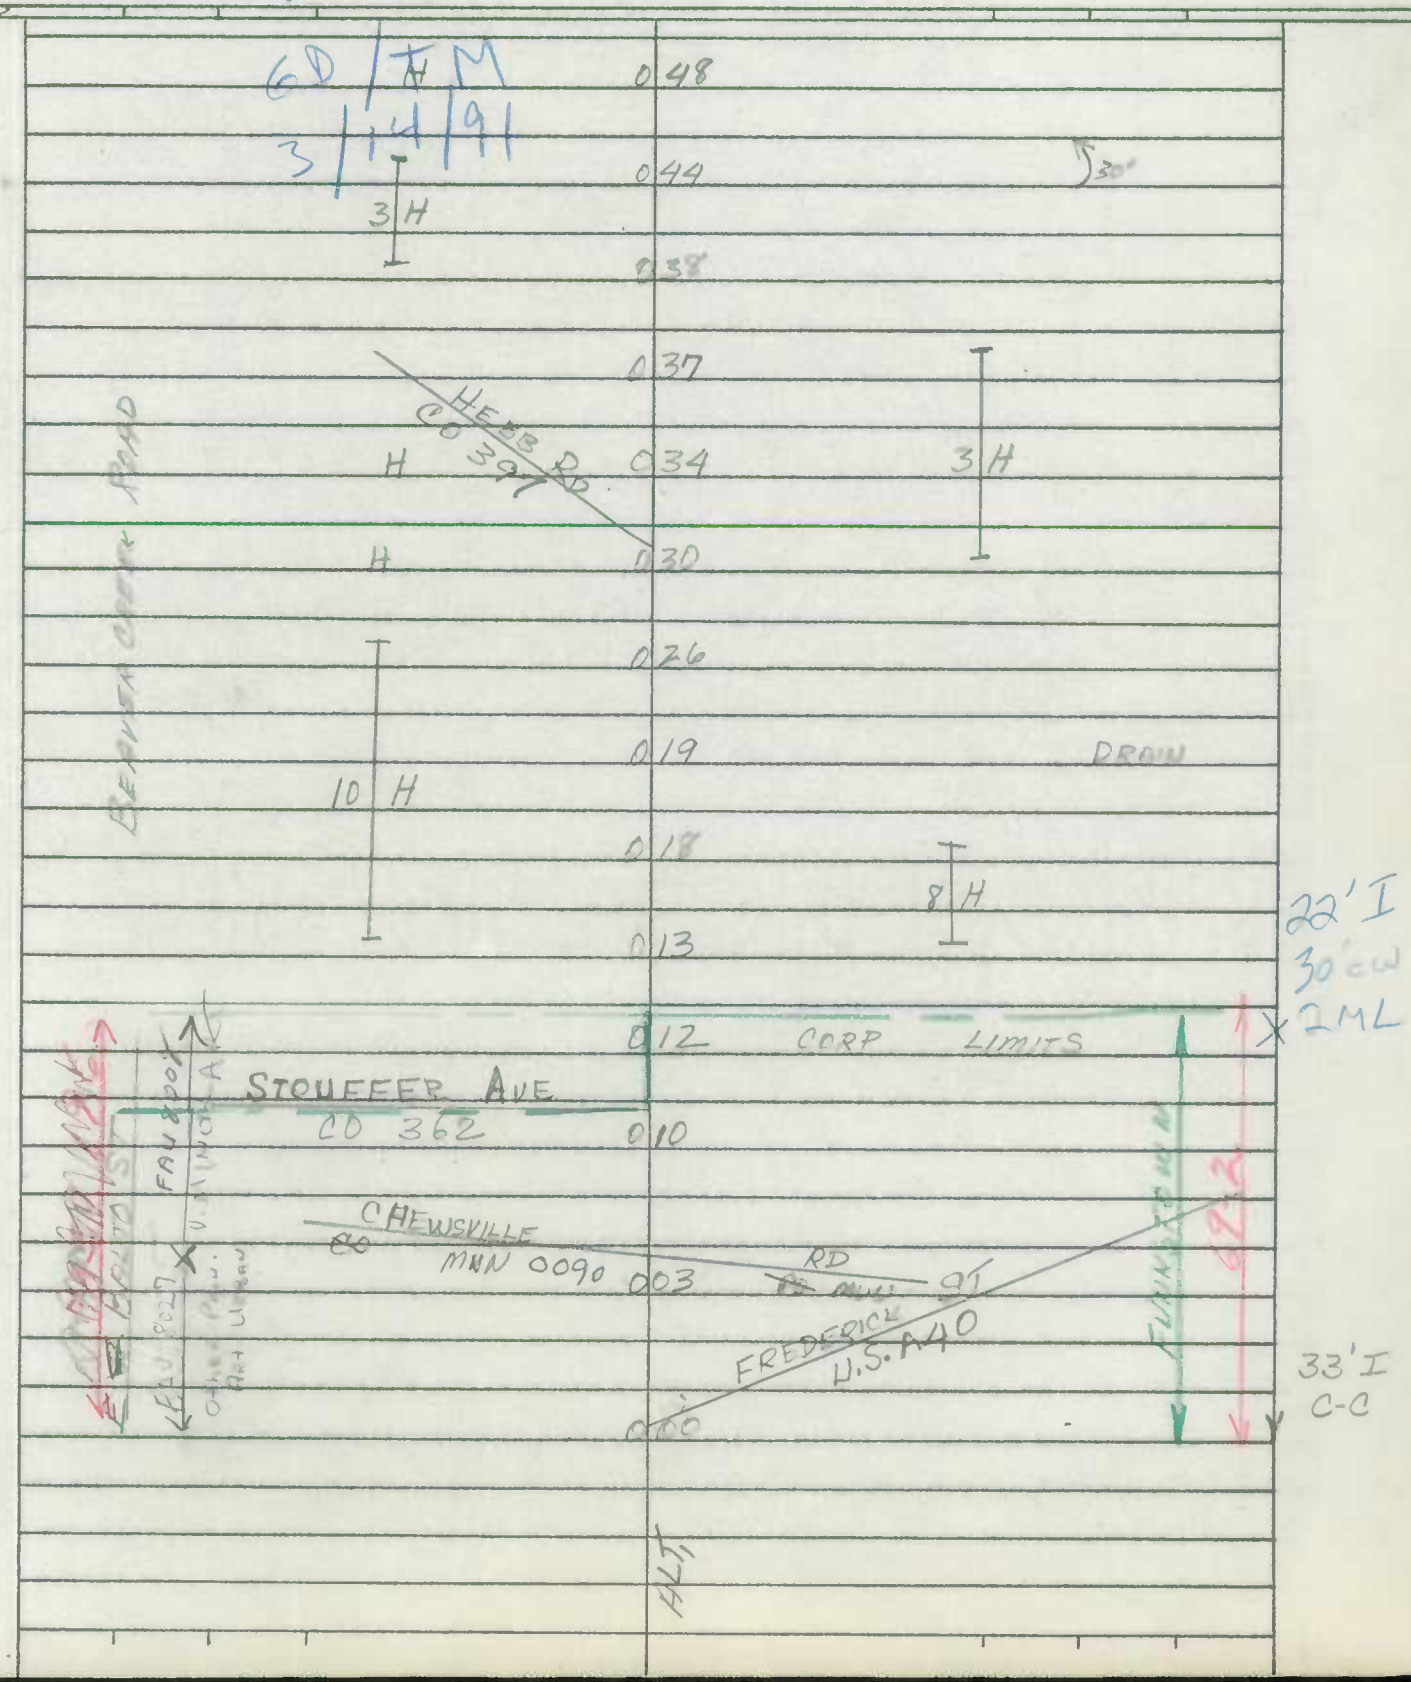

SHA 51.3-8
11-15-72

ROAD INVENTORY SHEET

Mv.0090

Road No. ~~C-316~~
Road Name CHEWSVILLE RD
Sheet No. 2 OF 2
Date
County WASHINGTON
State Coordinates

831
3/23/84
BB-NS

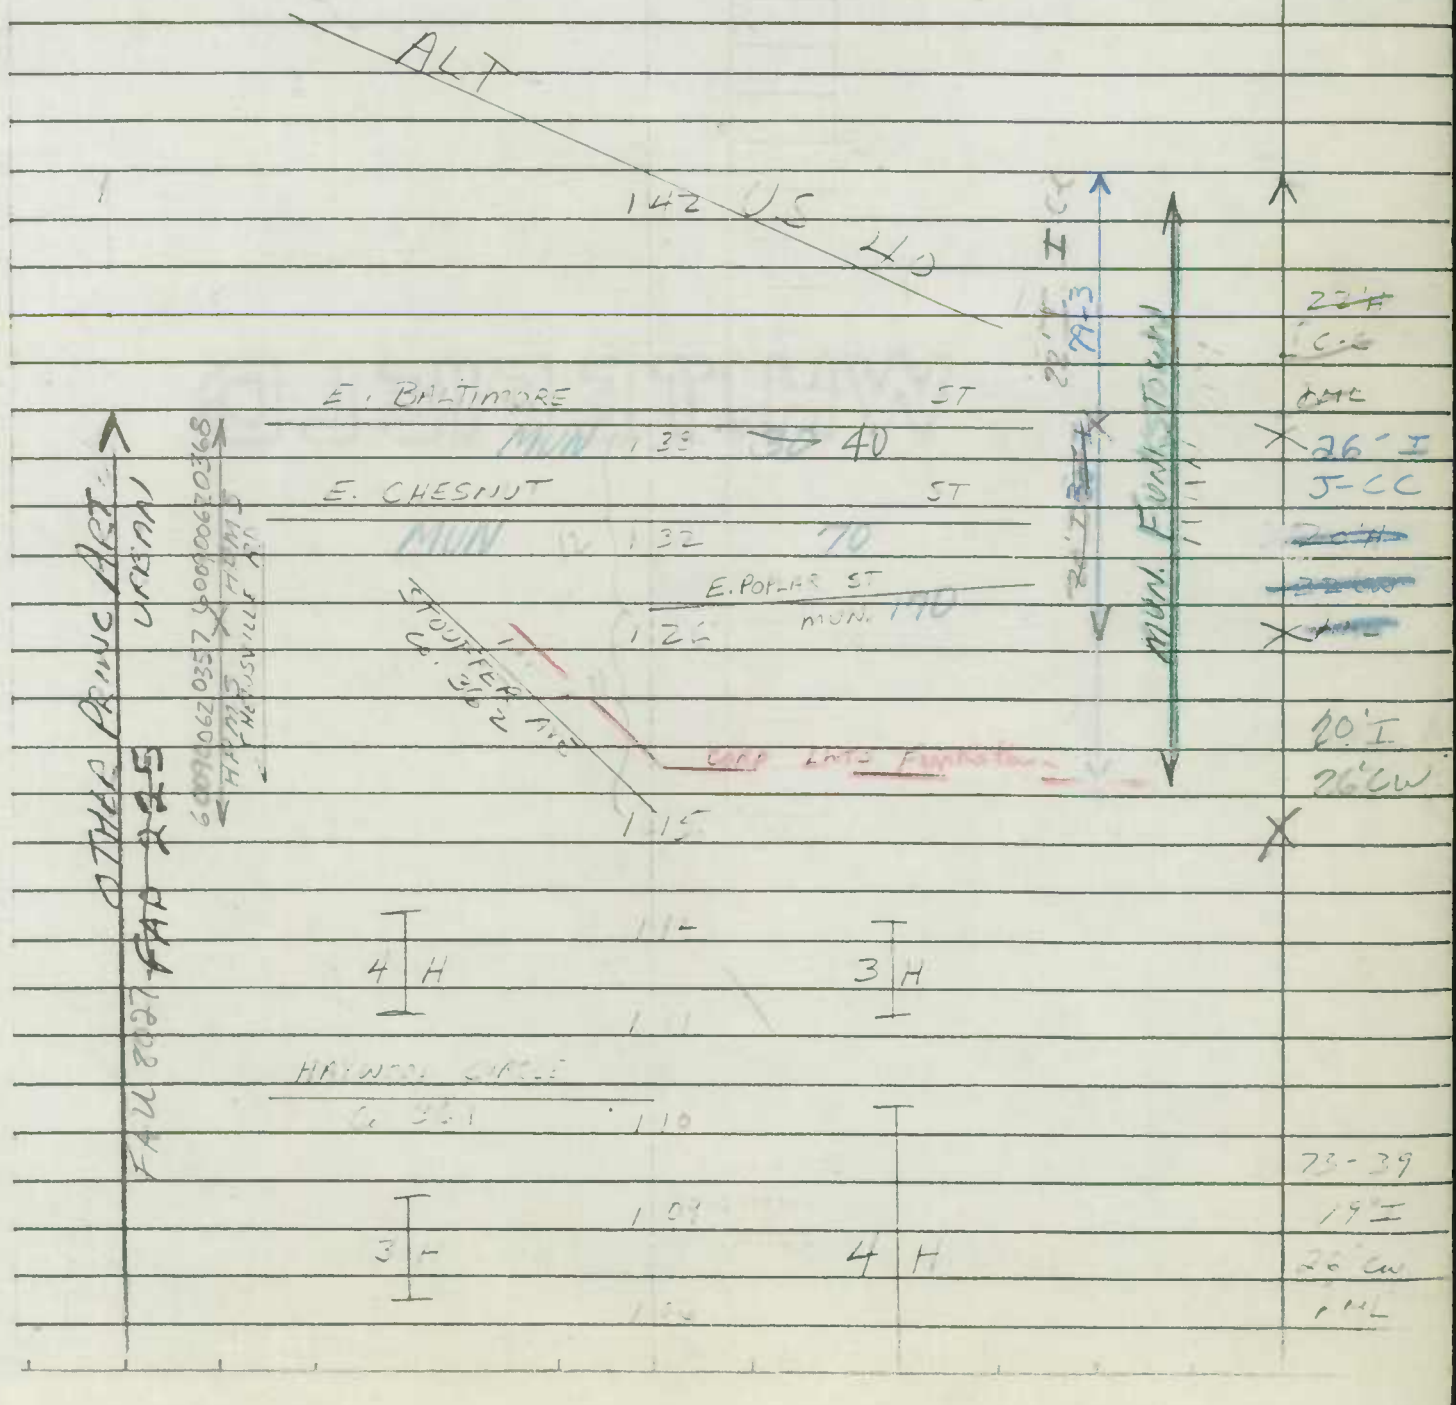

SHA 51.3-8
11-15-72

STATE HIGHWAY ADMINISTRATION OF MARYLAND

A/T

P7-77

ROAD INVENTORY SHEET

Party Chief J. LANDON
Recorder F. RHODES
Helper

Map No. VER. 7-7-76 FUNKSTOWN 75-2

Road No. MUN. 0135
Road Name (LAGOON RD.)
Sheet No. 1 OF 1
Date 3/23/76
County WASH.
State Coordinates

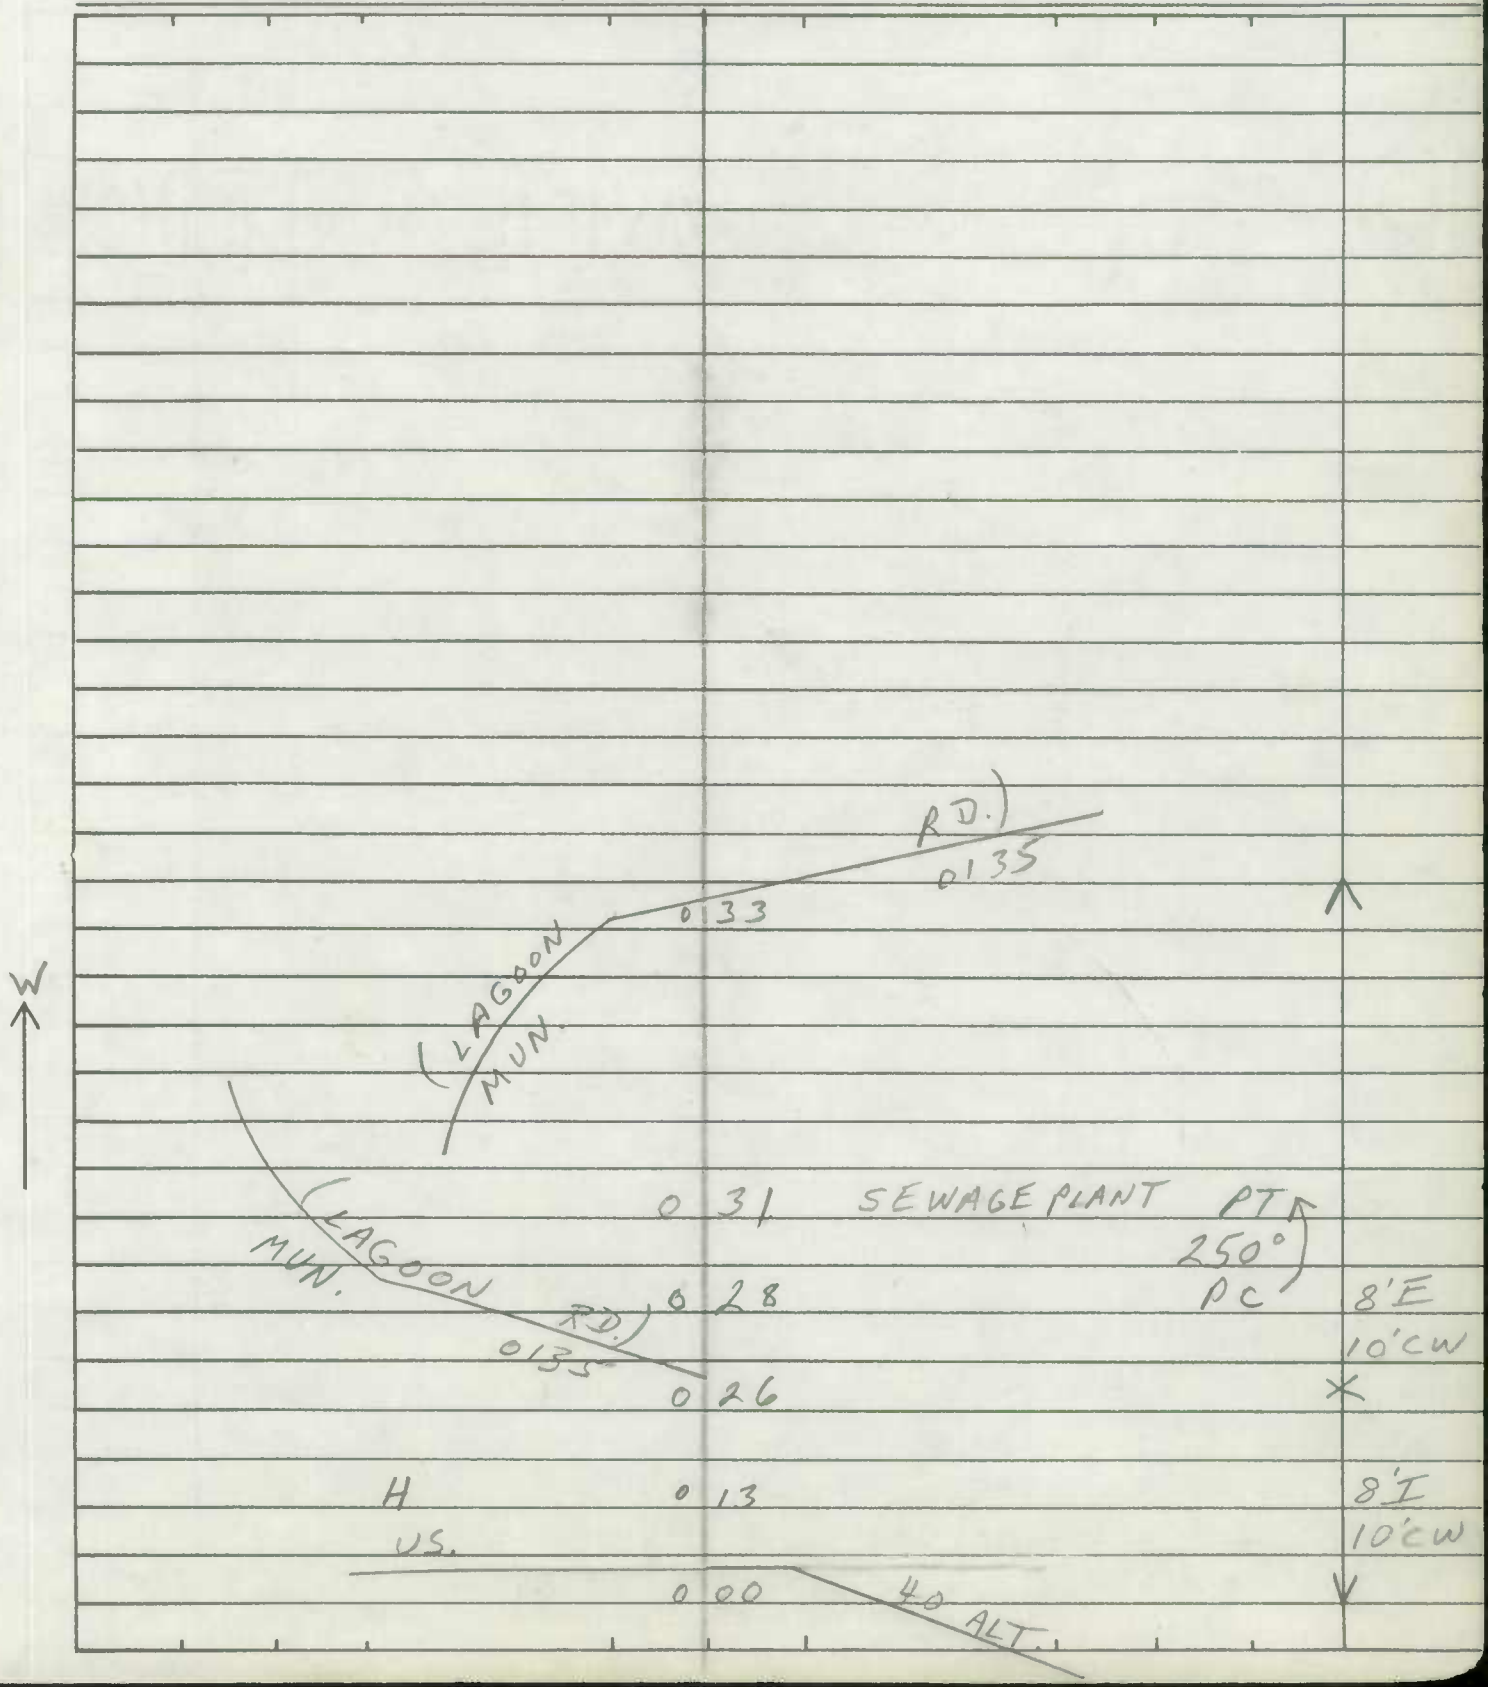

SHA 51.3-8
11-15-72

ROAD INVENTORY SHEET

Road No. _____
Road Name _____
Sheet No. _____
Date _____
County _____
State Coordinates _____

Form 6 HPS (Rev. 1961)

~~Mun. Off. No. 0010~~

ROAD INVENTORY SHEET

Party Chief R. VOUGHT

Recorder L. COFFELT J.L. VER. 7-7-76

Chainman

FUNKSTOWN

80' EXTRA JTS 05-26-81 72-3 81-2

Road No. 0150 - 0140

Name ~~White Plains~~ ST. Ave

Sheet No. ~~1~~ OF 1

Date 9 - 17 - 63

County WASHINGTON

A/T B-84

Funkstown Comm Pk.

Rd S.E.

~~456~~

ROAD END

0 55

0 43

Funkstown

Cont.

90°

0 40

Frederick

0 33

S. High

0 26

S. Antietam

MUN 0 13 20

S West Side Ave

MUN 190

MUN 18' PAVEMENT 60'

16' I
50' CW
~~10' H~~
~~14~~ CW

24' X I
32' CW

30' I
CW

Form 6 HPS (Rev. 1961)

p7-71

ROAD INVENTORY SHEET

Mun. No. ~~030~~ 0160

Party Chief R. Vought
Recorder L. Coffelt, Jr.
Chainman

SEE NI
90 EX # 3 ST
GD/TM
1/14/91

Road No. Co. 400
Name ~~E. X. St.~~ Oakhill Ln.
Sheet No. 1 of 3
Date 9-18-63
County Wash.

Funkstown

78-1

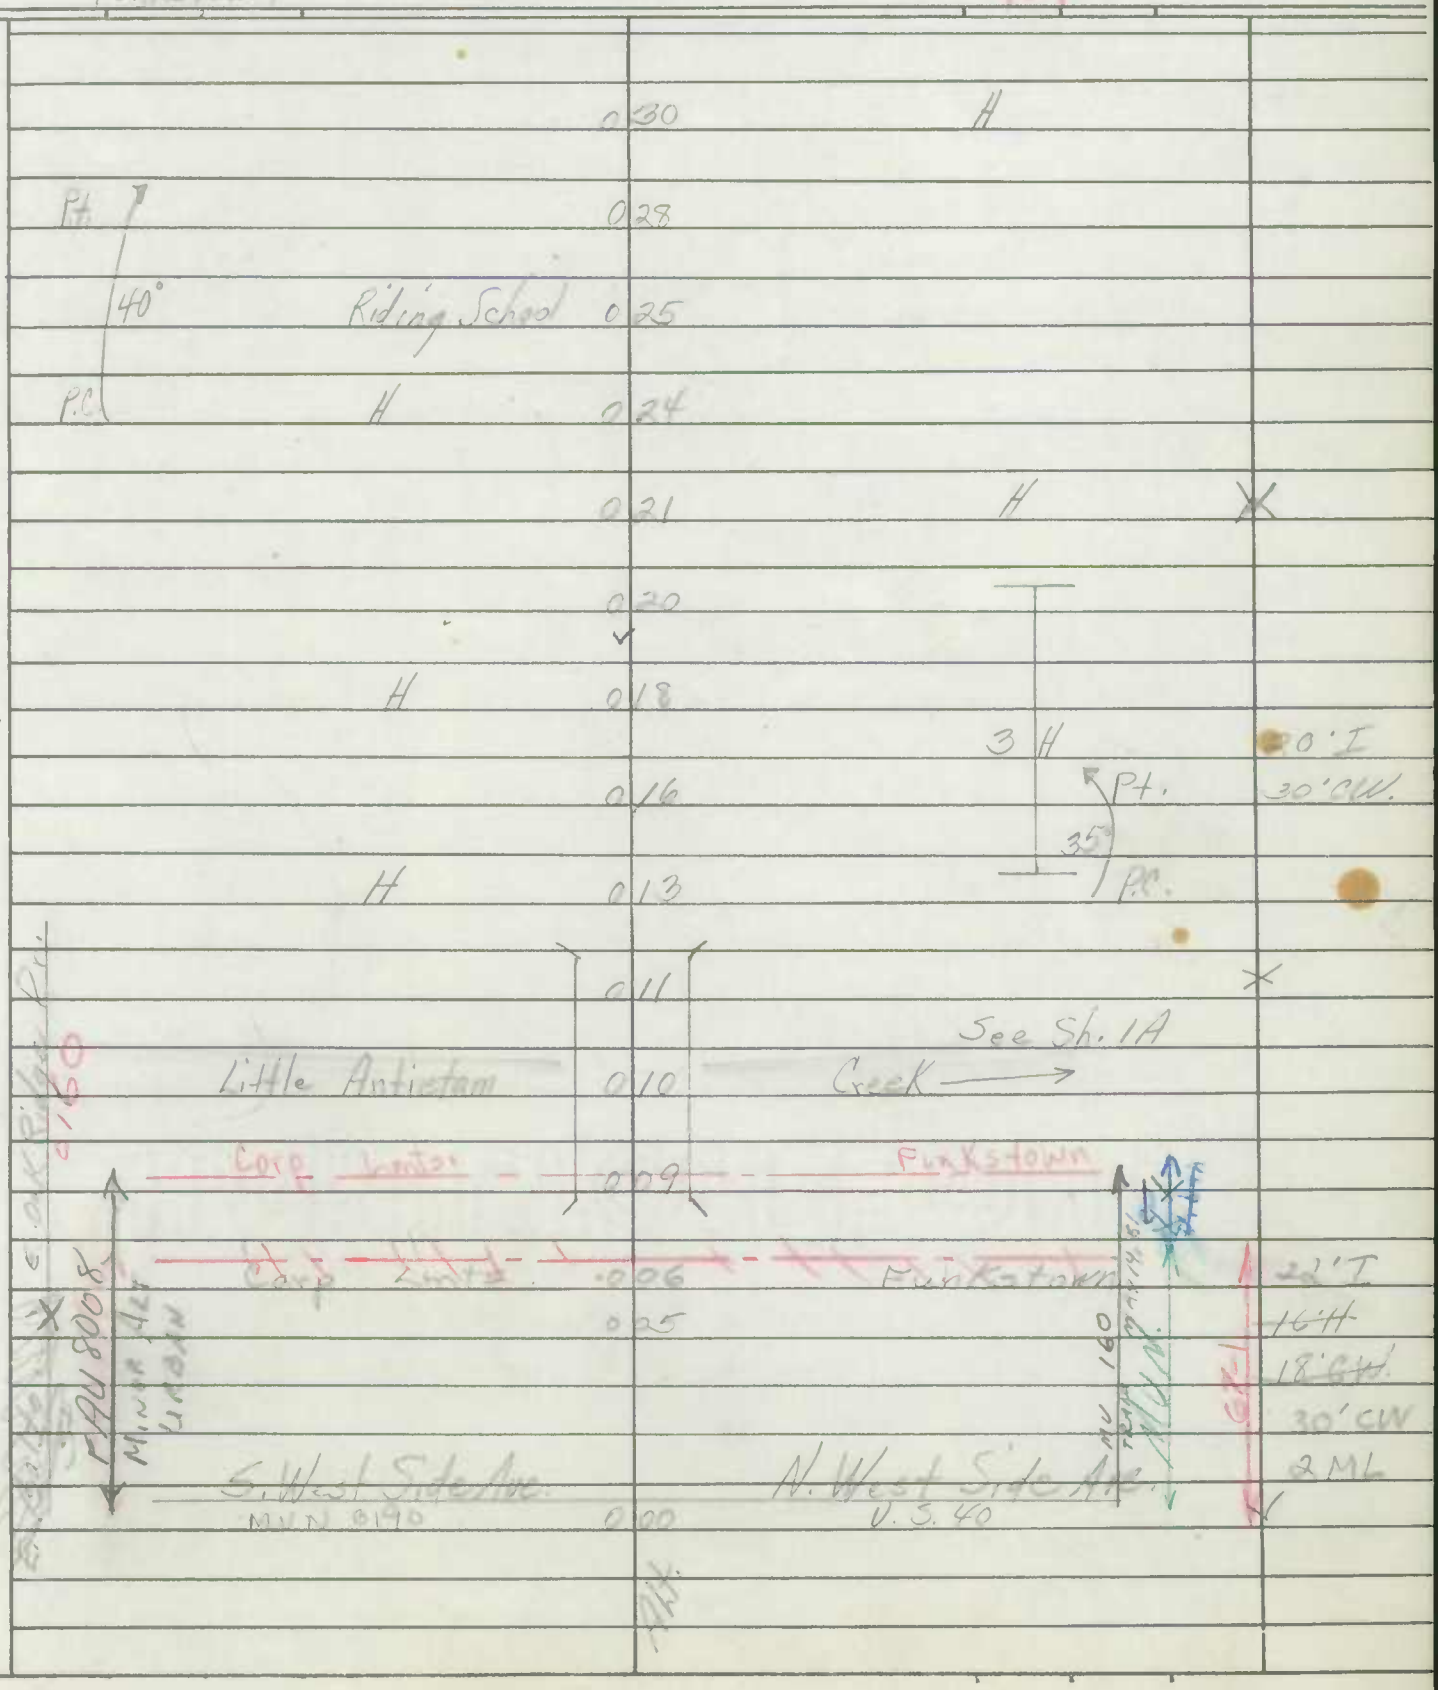

SHA 51.3-8
11-15-72

STATE HIGHWAY ADMINISTRATION OF MARYLAND

Mun 160

SEE NI 90 EX=2 ST

GD/TM 3/14/91

ROAD INVENTORY SHEET

OAK RIDGE DR (E & W)

Party Chief W. DOMBROSKI
Recorder M. ZALENSKI
Helper REWRITTEN 10-19-77 CFM
B-8; A-8 (W)
Map No. G-22
BB REV FR. 4-22-81

Road No. CO 400
Road Name ~~E. BALTIMORE ST~~
Sheet No. 1 OF 3
Date 7-7-76 (OR 9-18-63)
County WASH.
State Coordinates 599-647

OAK RIDGE PL. CO. 897

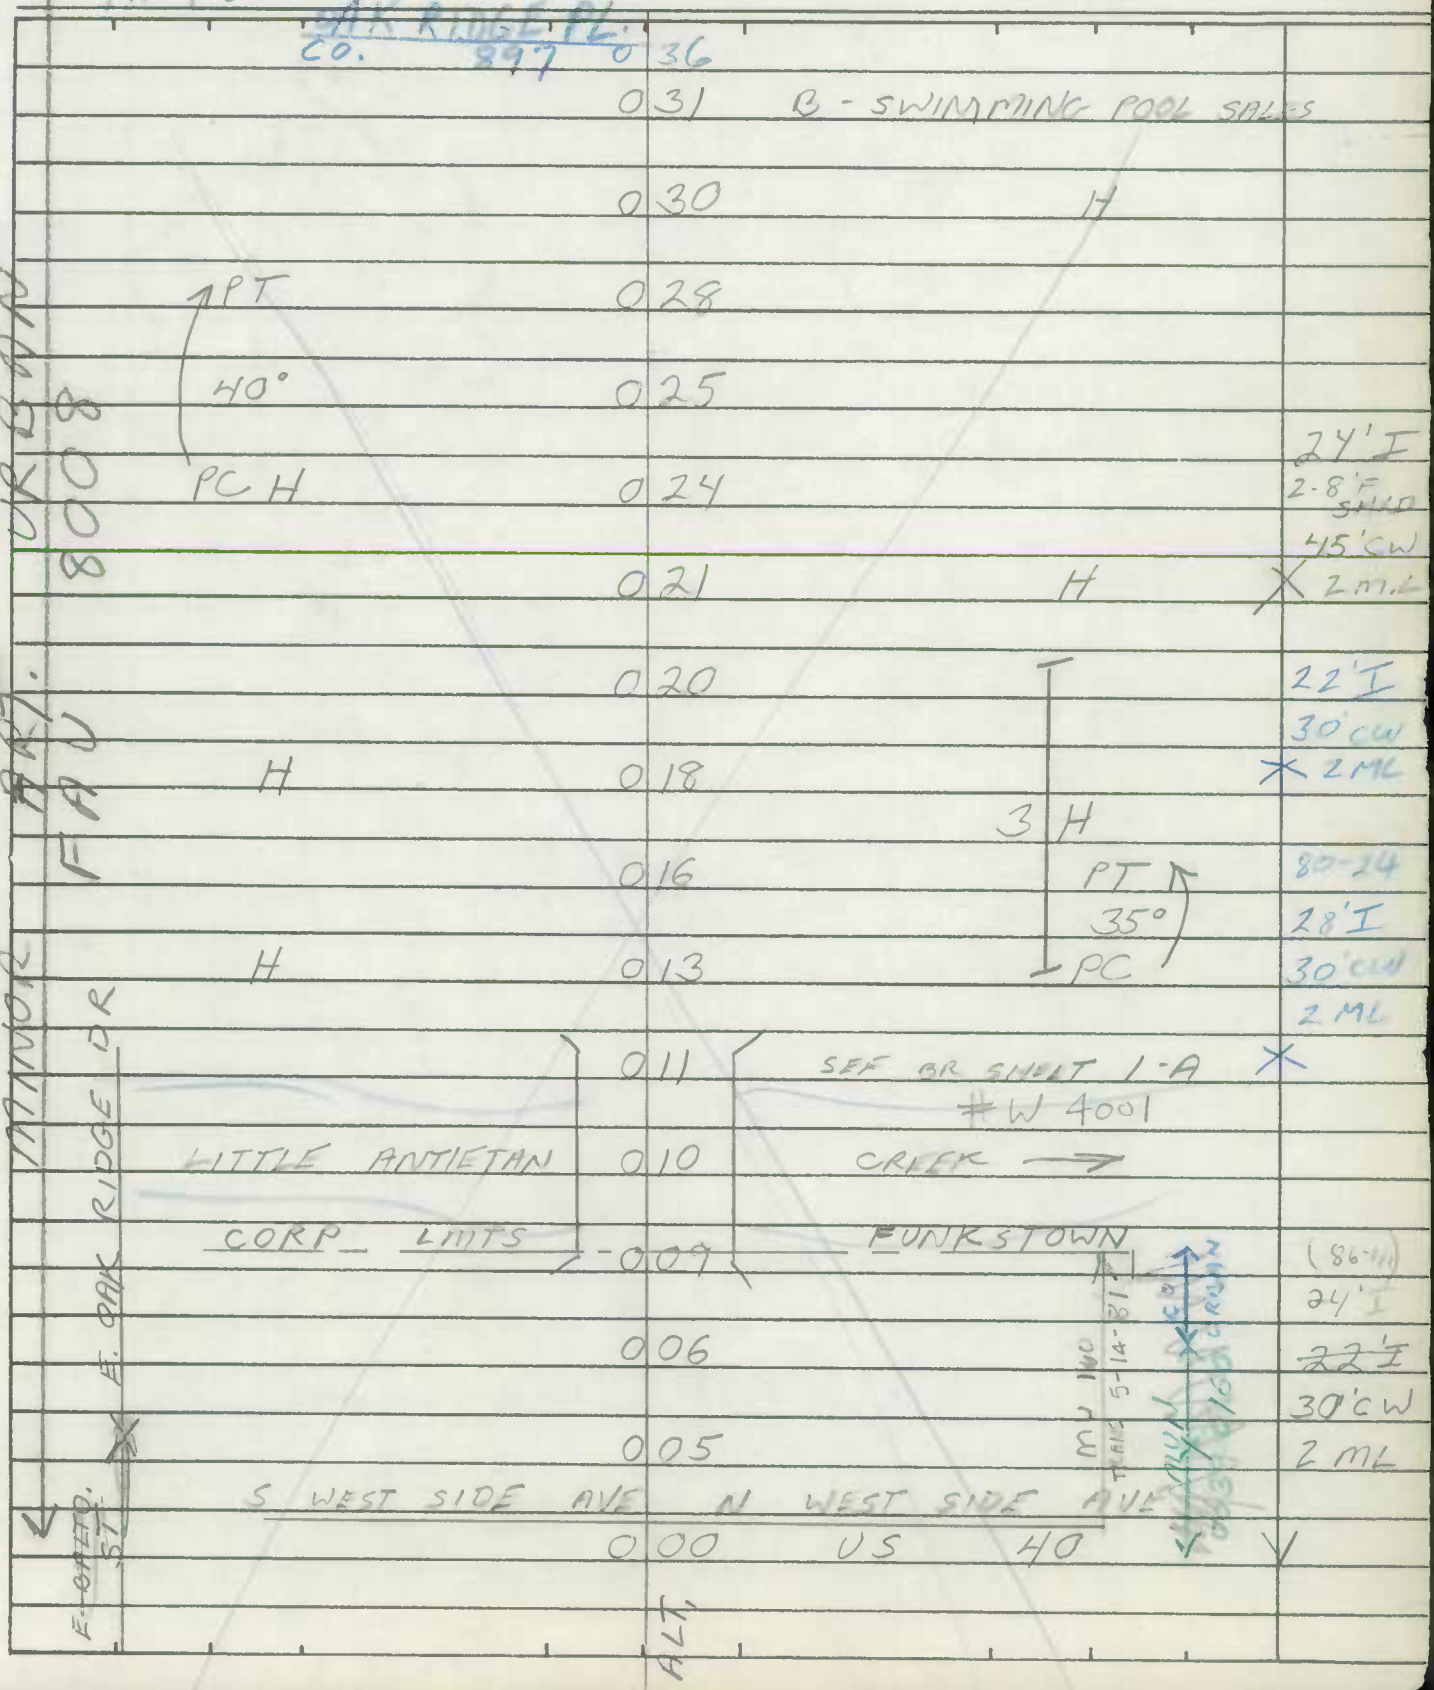

SHA 51.3-8
11-15-72

ROAD INVENTORY SHEET

Road No. CO 400
Road Name
Sheet No. 2 OF 3
Date
County
State Coordinates

A 8

E. OAK RIDGE RD
W. OAK RIDGE RD
URBAN
ART.
MINOR FAU

8008

4 LANES
34' MED

131	DRAIN	
125	7 H	
116		
115	B - GARAGE	22' I 28' CW
	MD 65	2 M.L
114	X	
111	H	
106	(R X R) 8 H B - DIST. CO	
		36' I J c-c
098		
	B & O RXR R.R	3 M.L
097	EXR #00 140 613 N	
093	B - OIL & GAS COMP.	
087	(RXR)	
	OAKMONT DR CO 876	
080		
	↑ 30°	
070		
069	B - U.P.S. 30°↓	
060	F	
048	B - TRUCKING CO.	
	3 H	SAME
042		

SHA 51.3-8
11-15-72

STATE HIGHWAY ADMINISTRATION OF MARYLAND

ROAD INVENTORY SHEET

Party Chief W. DOMBROSKI
Recorder M. ZALENSKI
Helper

Map No. A-8

Road No. Co. 400
Road Name
Sheet No. 3 OF 3
Date 7-7-76
County WASH.
State Coordinates

MD

632

166

36' I
28' FSHD
60' CW
3ML

158
147
136 VOC. SCHOOL

Minor Arterial Urban
800
15°
FAU
F

SHA 51.3-8
11-15-72

ROAD INVENTORY SHEET

Road No. _____
Road Name _____
Sheet No. _____
Date _____
County _____
State Coordinates _____

Form 6 HPS (Rev. 1961)

3/9/89
DT, GD
(89-15)

ROAD INVENTORY SHEET

Party Chief R. VOUGHT
Recorder
Chainman L. COFFELT JR.

HAGERSTOWN VER 7-14-76

CM A/I 83-6-17

Road No. 0030 - 0040
Name E & W ANTIETAM ST.
Sheet No. 1 OF 2
Date 11-13-63
County WASHINGTON

88-15, 11-25-88 92-12 AT

 

Form 6 HPS (Rev. 1961)

3/9/89 DT, GD (39-15)

ROAD INVENTORY SHEET

Party Chief R. ~~VOUGHT~~
Recorder
Chainman L. ~~COF~~FELT JR.

HAGERSTOWN VER 7-14-76

CM A/T 83-6+7

Road No. 0030 - ~~0040~~
Name E & W ANTIETAM ST.
Sheet No. 1 OF 2
Date 11-13-63
County WASHINGTON

88-15 11-25-88 82-12 AT

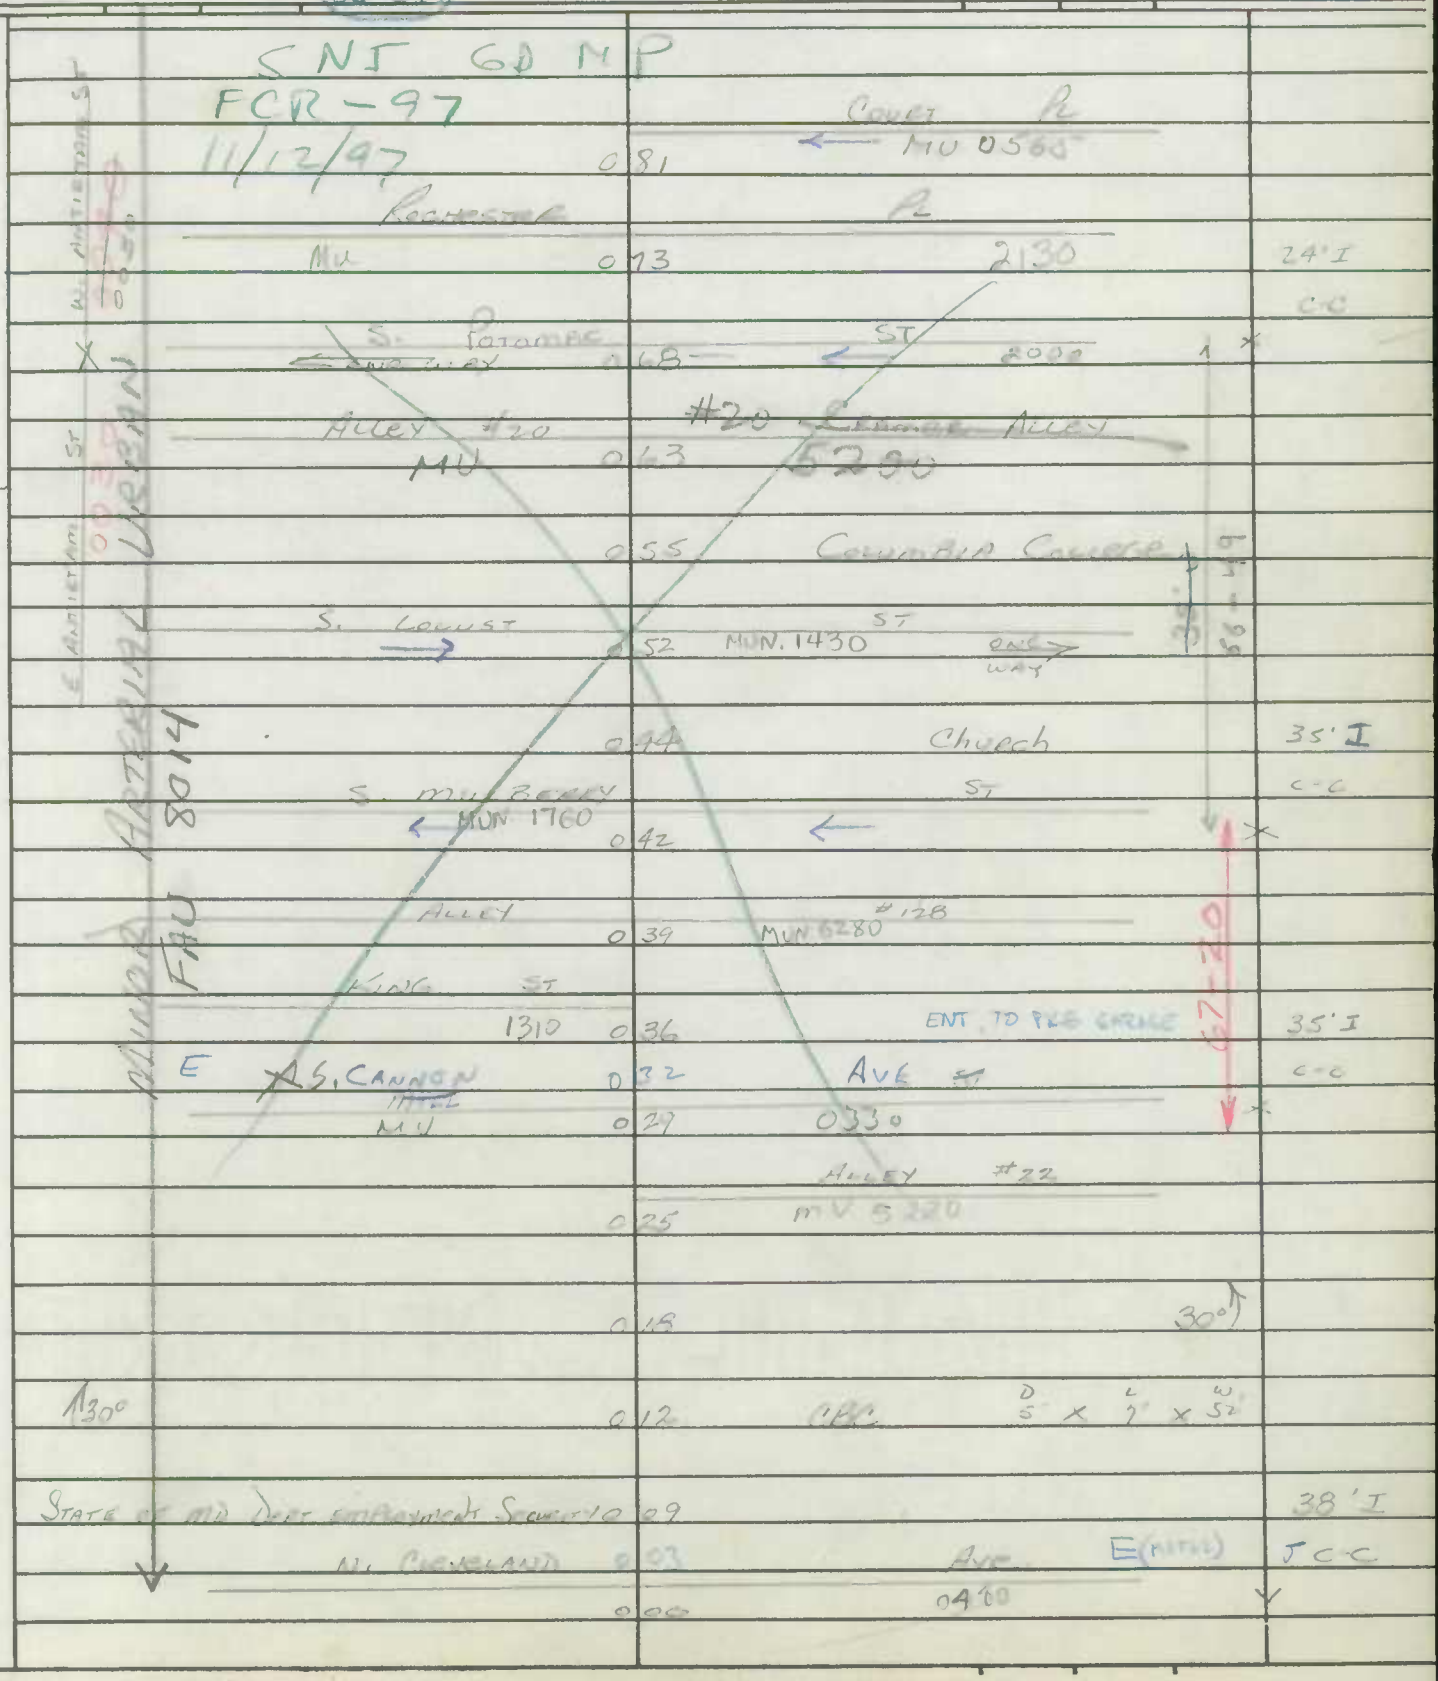

Form 6 HPS (Rev. 1961)

(92-23)
BOIAH
2-1-93

ROAD INVENTORY SHEET

Party Chief ~~R. VOUGHT~~
Recorder ~~L. GOFF~~FELT JR.
Chainman

HAGERSTOWN

Road No. OD30
Name ~~E FW~~ ANTIETAM ST
Sheet No. 2 OF 2
Date 11-13-63
County WASHINGTON

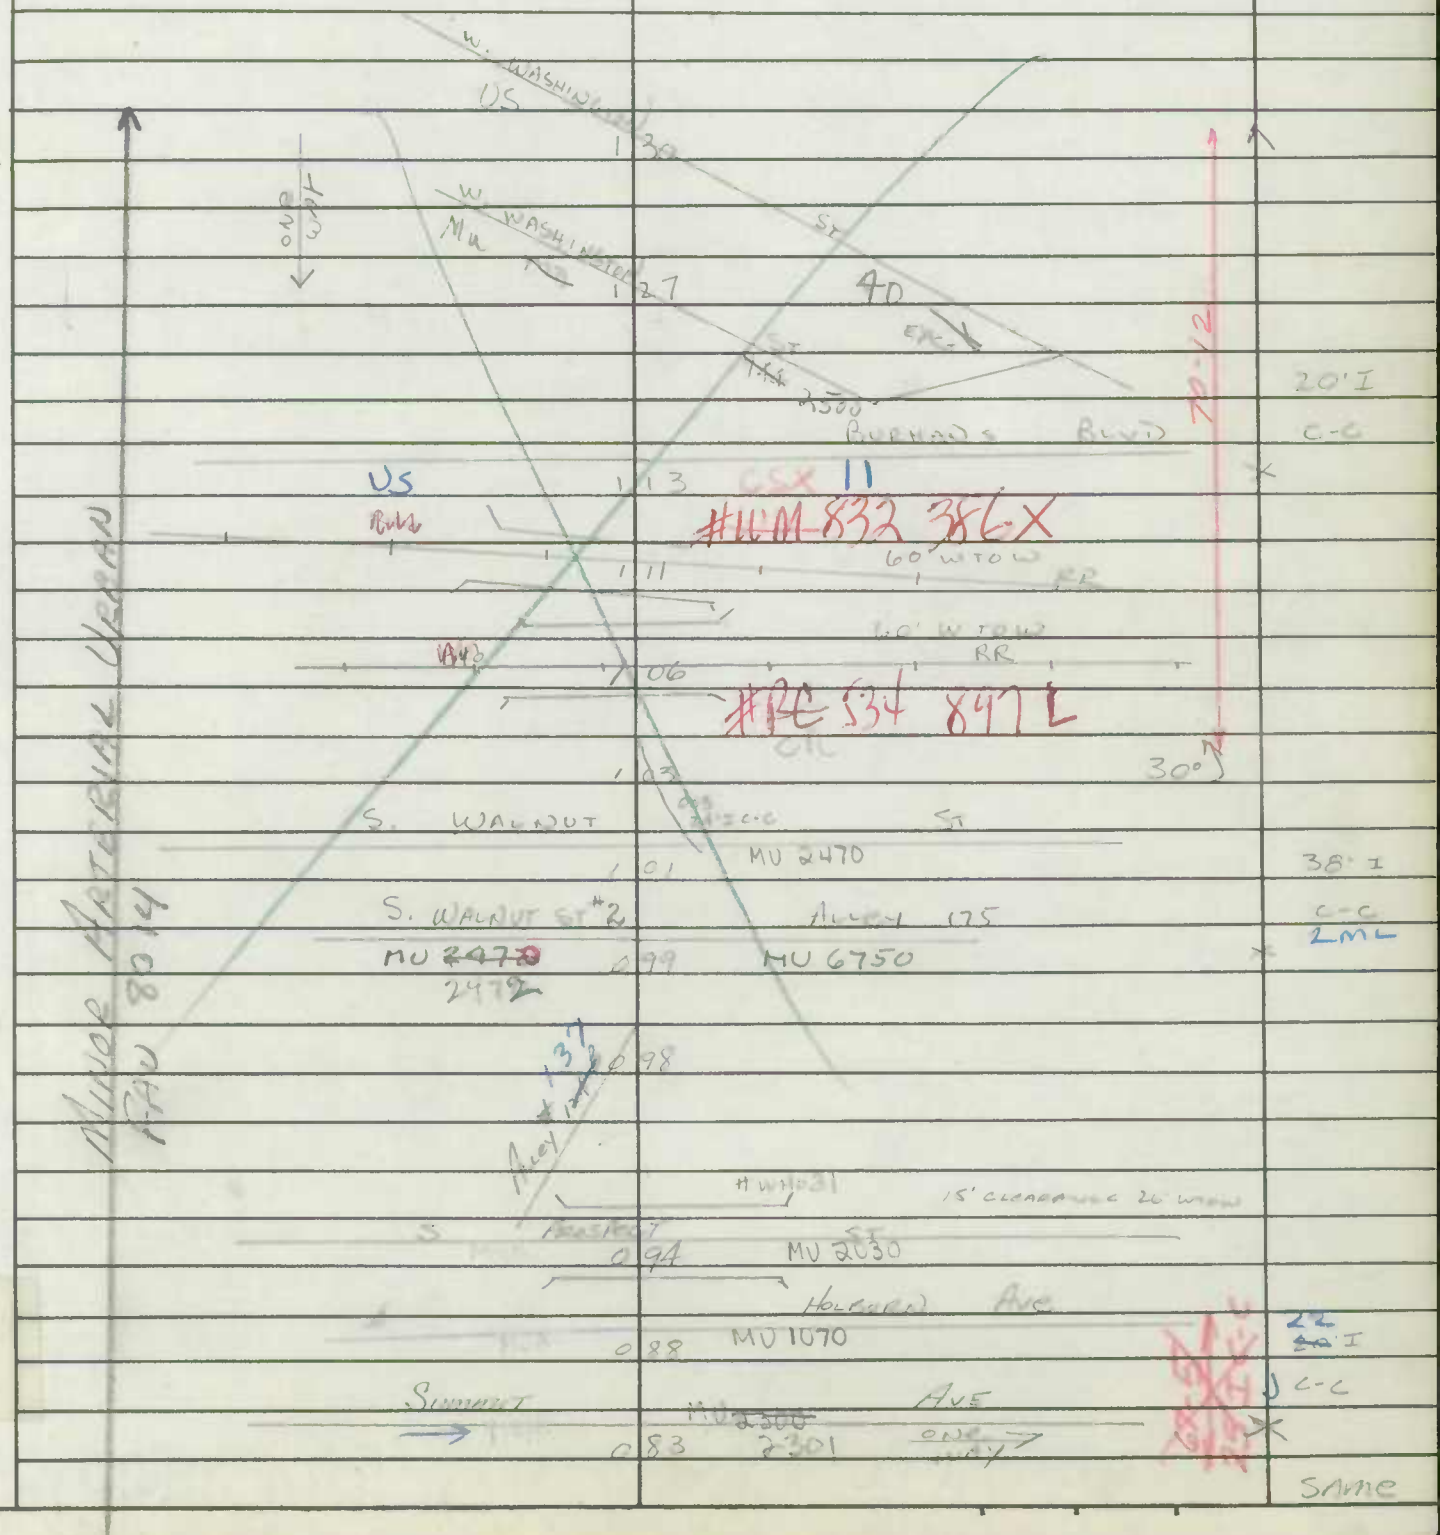

Form 6 HPS (Rev. 1961)

MUN. NO. 0050

ROAD INVENTORY SHEET

Party Chief R. VONGHT
Recorder L. COFFELT JR
Chainman

COPY 12/10/63 AS PER E.T.S.

VCF 7-15-76

Road No. CO 414
Name ARMSTRONG AVE
Sheet No. 1 OF 1
Date 9-19-63
County WASHINGTON

ROAD END
026
18' E
26' C.W.
025
H
023
H
VIRGINIA
W.S.
021
11 AVE
020
3 H
30' I
34' C.W.
APP CORP. H
017
9160
ALLEY 216
016
LINE HAGERS ADD
SHERMAN
CO
010
AVE
416
34' A I
C-C
005
CURB LT
32' A I
34' C.W.
ROAD END
000
CHAIN

Form 6 HPS (Rev. 1961)

ROAD INVENTORY SHEET

Party Chief R. Vaught
Recorder L. Coffelt, Jr.
Chainman

VER. 7-20-76

Road No. 0060
Name Avalon Ave.
Sheet No. 1 of 1
Date 10-28-63
County Wash.

Washington US	0	19	Ave. 40 East	
	0	16	Berner Ave	
40°	0	13		26' A C-6 Rt. 28' CW.
	0	11	Alley 28	
Alley	0	03	07	
W. Washington Rd.	0	00	St. 144	34' A C-C

87-3 A/T P97

SHA 51.3-8
11-15-72

STATE HIGHWAY ADMINISTRATION OF MARYLAND

ALT U.S. 40

ROAD INVENTORY SHEET

AL 1-3 87-4 3-28-88 A/T

Party Chief W. DOMBROSKI
Recorder M. ZALENSKI
Helper

Road No. MUN 0090
Road Name W/E BALTIMORE ST
Sheet No. 1 OF 2
Date 7-15-76
County WASHINGTON
State Coordinates

Map No.

AT 84-6

HAGERSTOWN

SNJ / FCR-97
GD. MP 11/12/97

	ALLEY #20	
0	54	MU5200
	GERBERS ALLEY MU 9100	
0	52	
	CHURCH & SCHOOL	
0	46	
	S. LOCUST ST	
0	44	MU → #440 → 1430
	ALLEY #174	
0	39	MU6740
	S. MULBERRY ST	
0	33	MU ← #1760
	FREDERICK ALT U.S. 40	
0	30	MU6280
	ALLEY #127 MU6270	
0	28	
	KING ST	
0	27	MU1310
	ALLEY #126	
	MU6260	
0	24	
	HAGER ST	
	MU 0950 →	
0	21	
	ALLEY #238	
	MU7380	
0	17	
	MILL ST	
	MU	
0	13	1670
	ALLEY #129 MU6290	
0	06	AVE
	S. CANNON MU	0342 0330
0	00	

URBAN MINOR ART.

ALT U.S. 40

E. BALTIMORE ST.

MUN 0090

W

38'1 J c-c

30'I J c-c

SHA 51.3-8
11-15-72

ROAD INVENTORY SHEET

Road No. MUN 0090
Road Name W&E BALTIMORE ST
Sheet No. 2 OF 3
Date 7-15-76
County WASH
State Coordinates

S. WALNUT ST.
0 91 2470

S. PROSPECT ST
MU ← 0 85 ← 2030

HOLBURN AVE
MU 0 79 1070

SUMMIT AVE
MU → 0 75 → 2301

ALLEY #122
MU6220 0 72

HOOD ST
MU 0 70 1080

B&O (SU) R.R.
0 69 (SU)

B&O (SU) R.R.
0 65 RXR #30 139 4941K
ROCHESTER Pk.
0 64 MU2130

S. POTOMAC ST
MU → 0 57 2000 →

ONE WAY

32' I
J'c-c

25' I
J'c-c

FAU 8003
OTHER PRINC. ART. - U.S. RTE
W. BALTO. ST.

MUN 0090

81-3 A/T P977

SHA 51.3-8
11-15-72

STATE HIGHWAY ADMINISTRATION OF MARYLAND

ALT U.S. 40

ROAD INVENTORY SHEET

Party Chief W. DOMBROSKI
Recorder M. ZALENSKI
Helper

Map No.

Road No. MUN 0090
Road Name W&E BALTIMORE ST
Sheet No. 1 OF 2
Date 7-15-76
County WASHINGTON
State Coordinates

ALIAS 87-4 3-28-85 A/T

ALT 84-6

HAGERSTOWN

		ALLEY #20	
U.S. 40	0 54	MU 5200	
	GERBERS ALLEY MU 9100 0 52		
	CHURCH & SCHOOL 0 46		
ALT	S. LOCUST	ST	
	MU → 0 44	~~HAG~~ → 1430	
		ALLEY #174	
	0 39	MU 6740	
	S. MULBERRY	ST	
	← MU 0 33	← 1760	
	FREDERICK 40 ALT U.S.	ALLEY #128	
	0 30	MU 6280	
	ALLEY #127 MU 6270 0 28		
		KING ST	
	0 27	MU 1310	
	ALLEY #126		
W	MU 6260 0 24		38' I J c-c
	HAGER ST		
	MU 0950 → 0 21		
ST.	ALLEY #238		
	MU 7380 0 17		
BALTIMORE	MILL	ST	
	MU 0 13	1670 #129	
		ALLEY MU 6290	
IC	0 06	AVE 0342	30' I J c-c
	S. CANNON MU 0 00		

Tabbed MUS 40 ALT.

MUN 0090

SHA 51.3-8
11-15-72

ROAD INVENTORY SHEET

Road No. MUN 0090
Road Name W&E BALTIMORE ST
Sheet No. 2 OF 3
Date 7-15-76
County WASH
State Coordinates

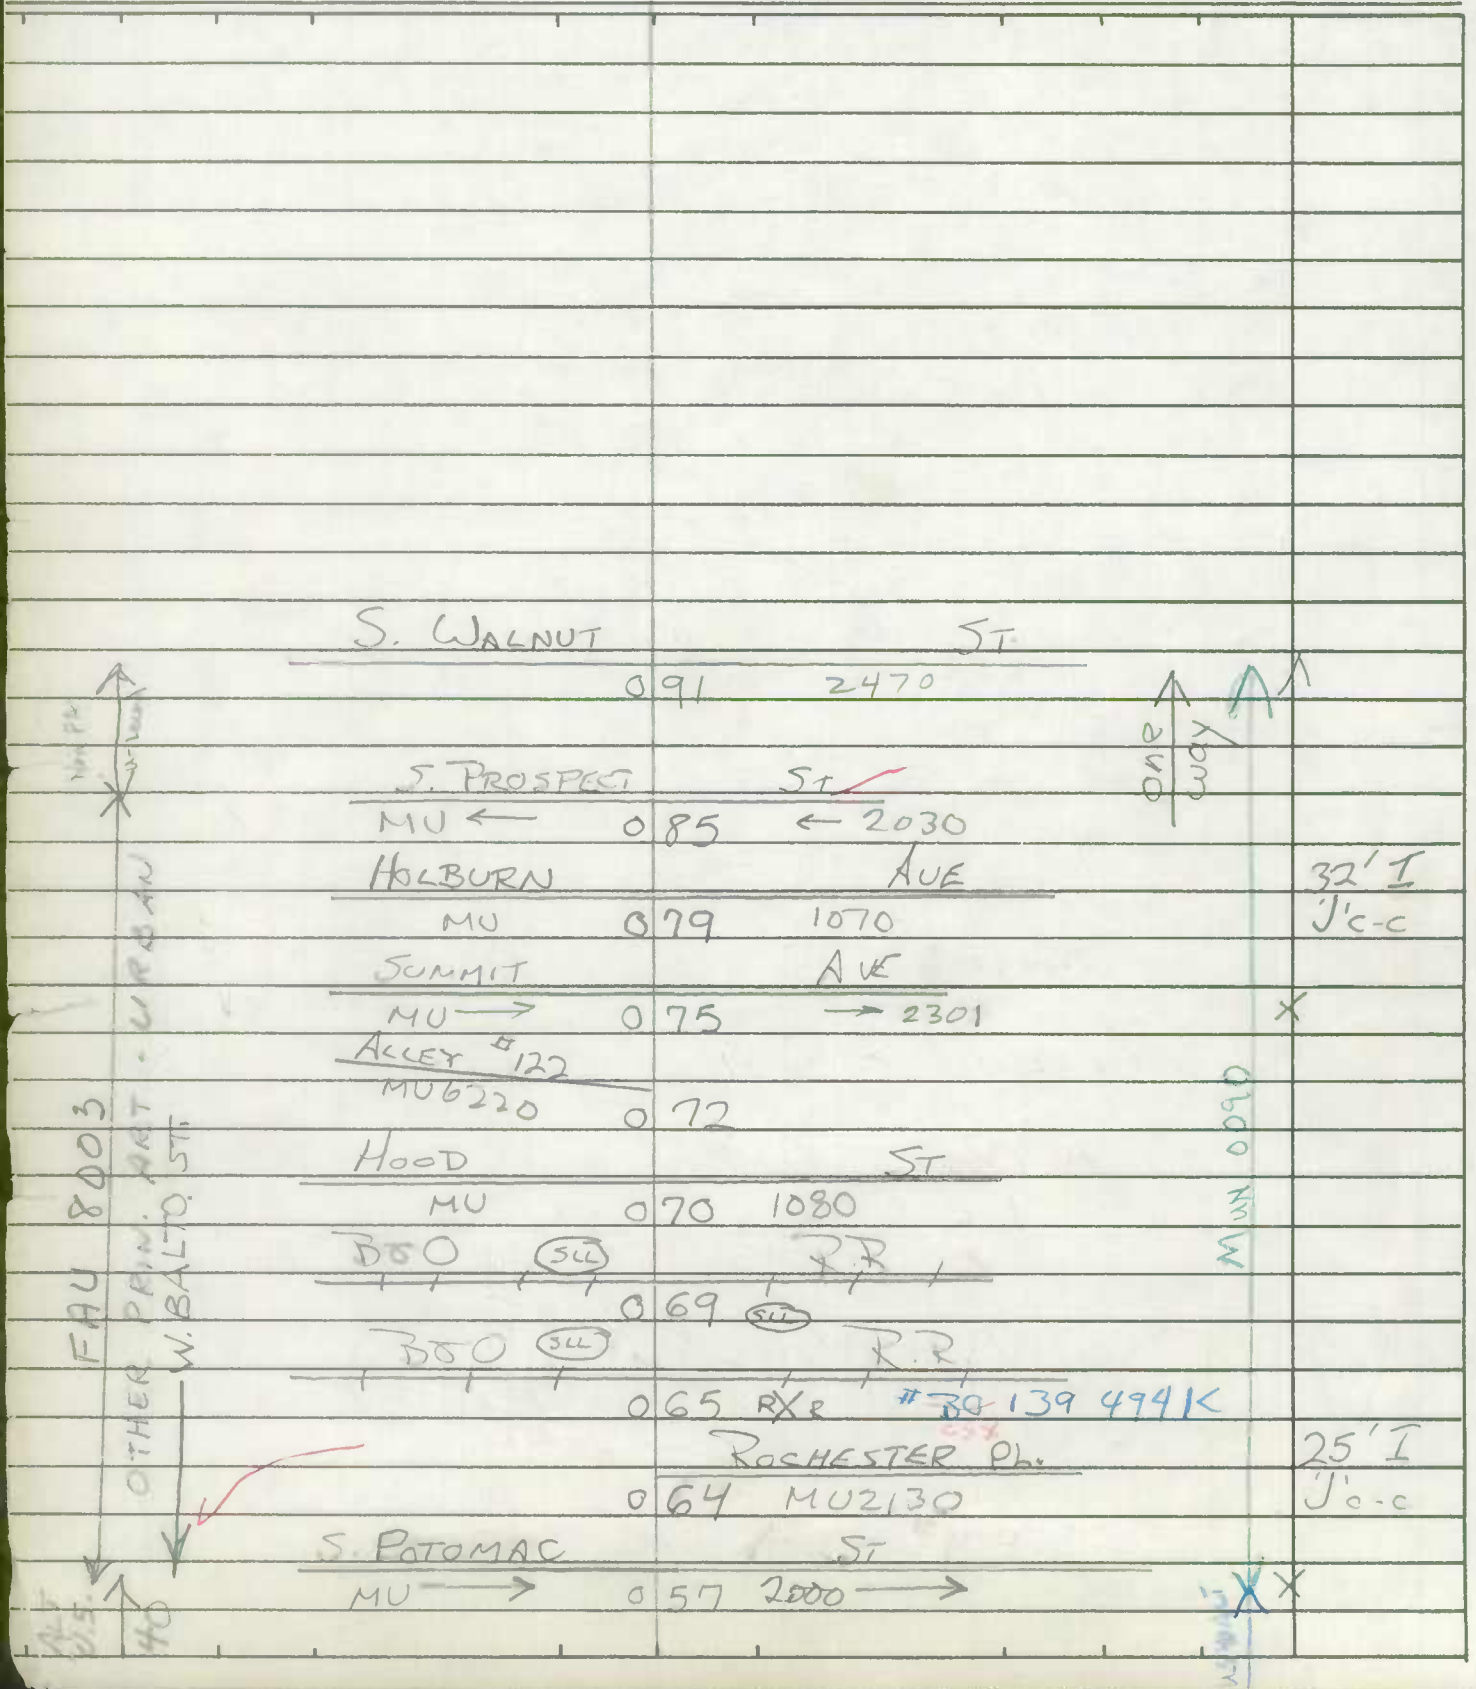

Form 6 HPS (Rev. 1961)

AT P207

ROAD INVENTORY SHEET

Party Chief R. Vought
Recorder L. Coffelt, Jr.
Chainman

VER. 7-14-76

Road No. 0160
Name W. Bethel St.
Sheet No. 1 of 1
Date 11-5-63
County Wash.

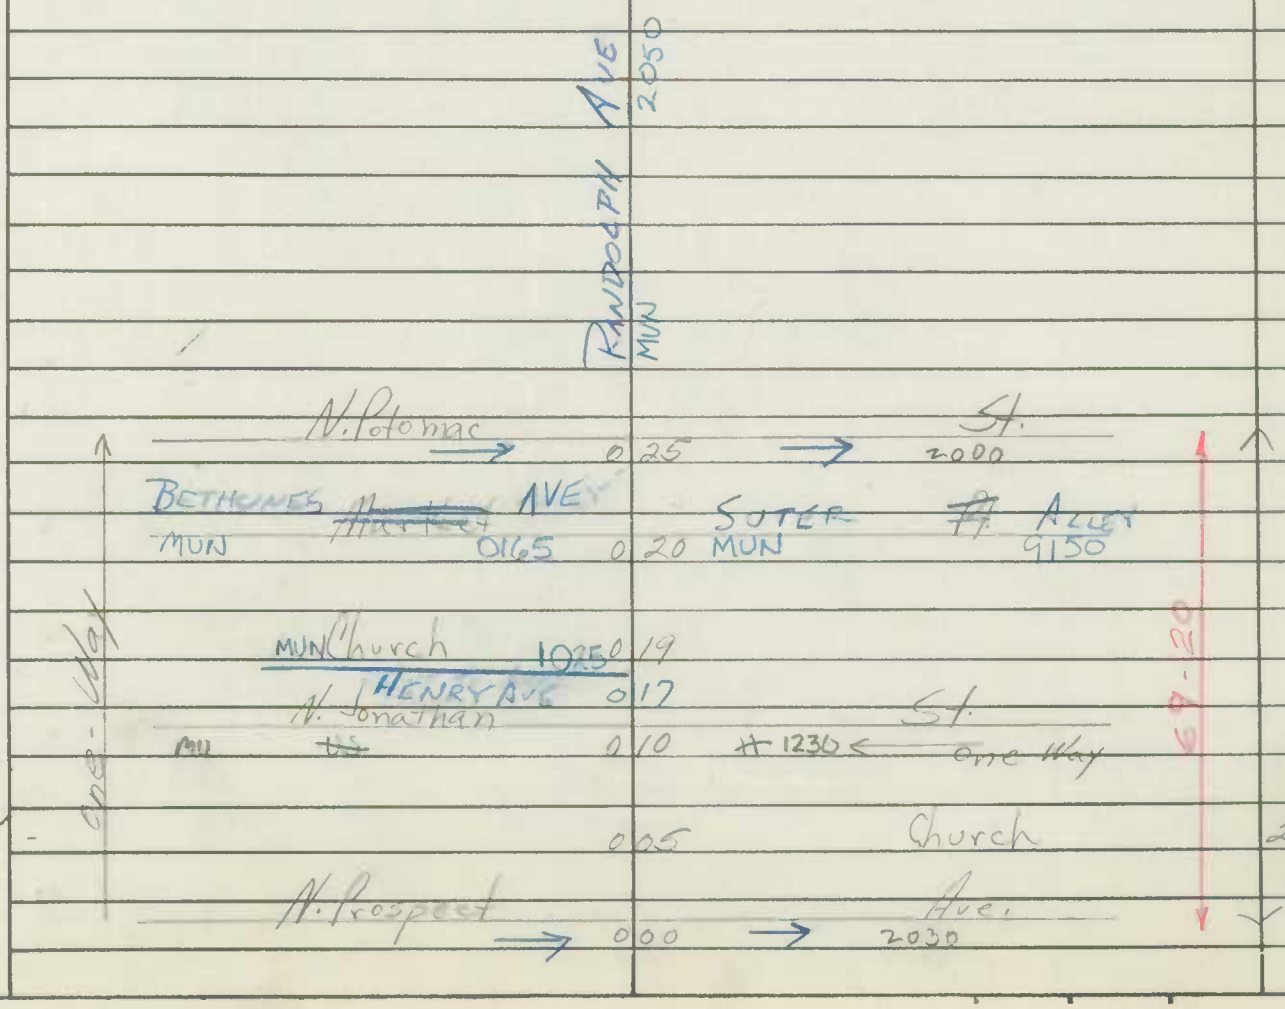

Form 6 HPS (Rev. 1961)

ROAD INVENTORY SHEET

Party Chief T. LANDON
Recorder W. WARFIELD
Chainman

A/T
83-11
4/9/84
DT-NS

VER
7-16-76

Road No. 0300
Name BURHANS BLVD
Sheet No. 1 OF 4
Date 3-5-70
County WASHINGTON

79-5

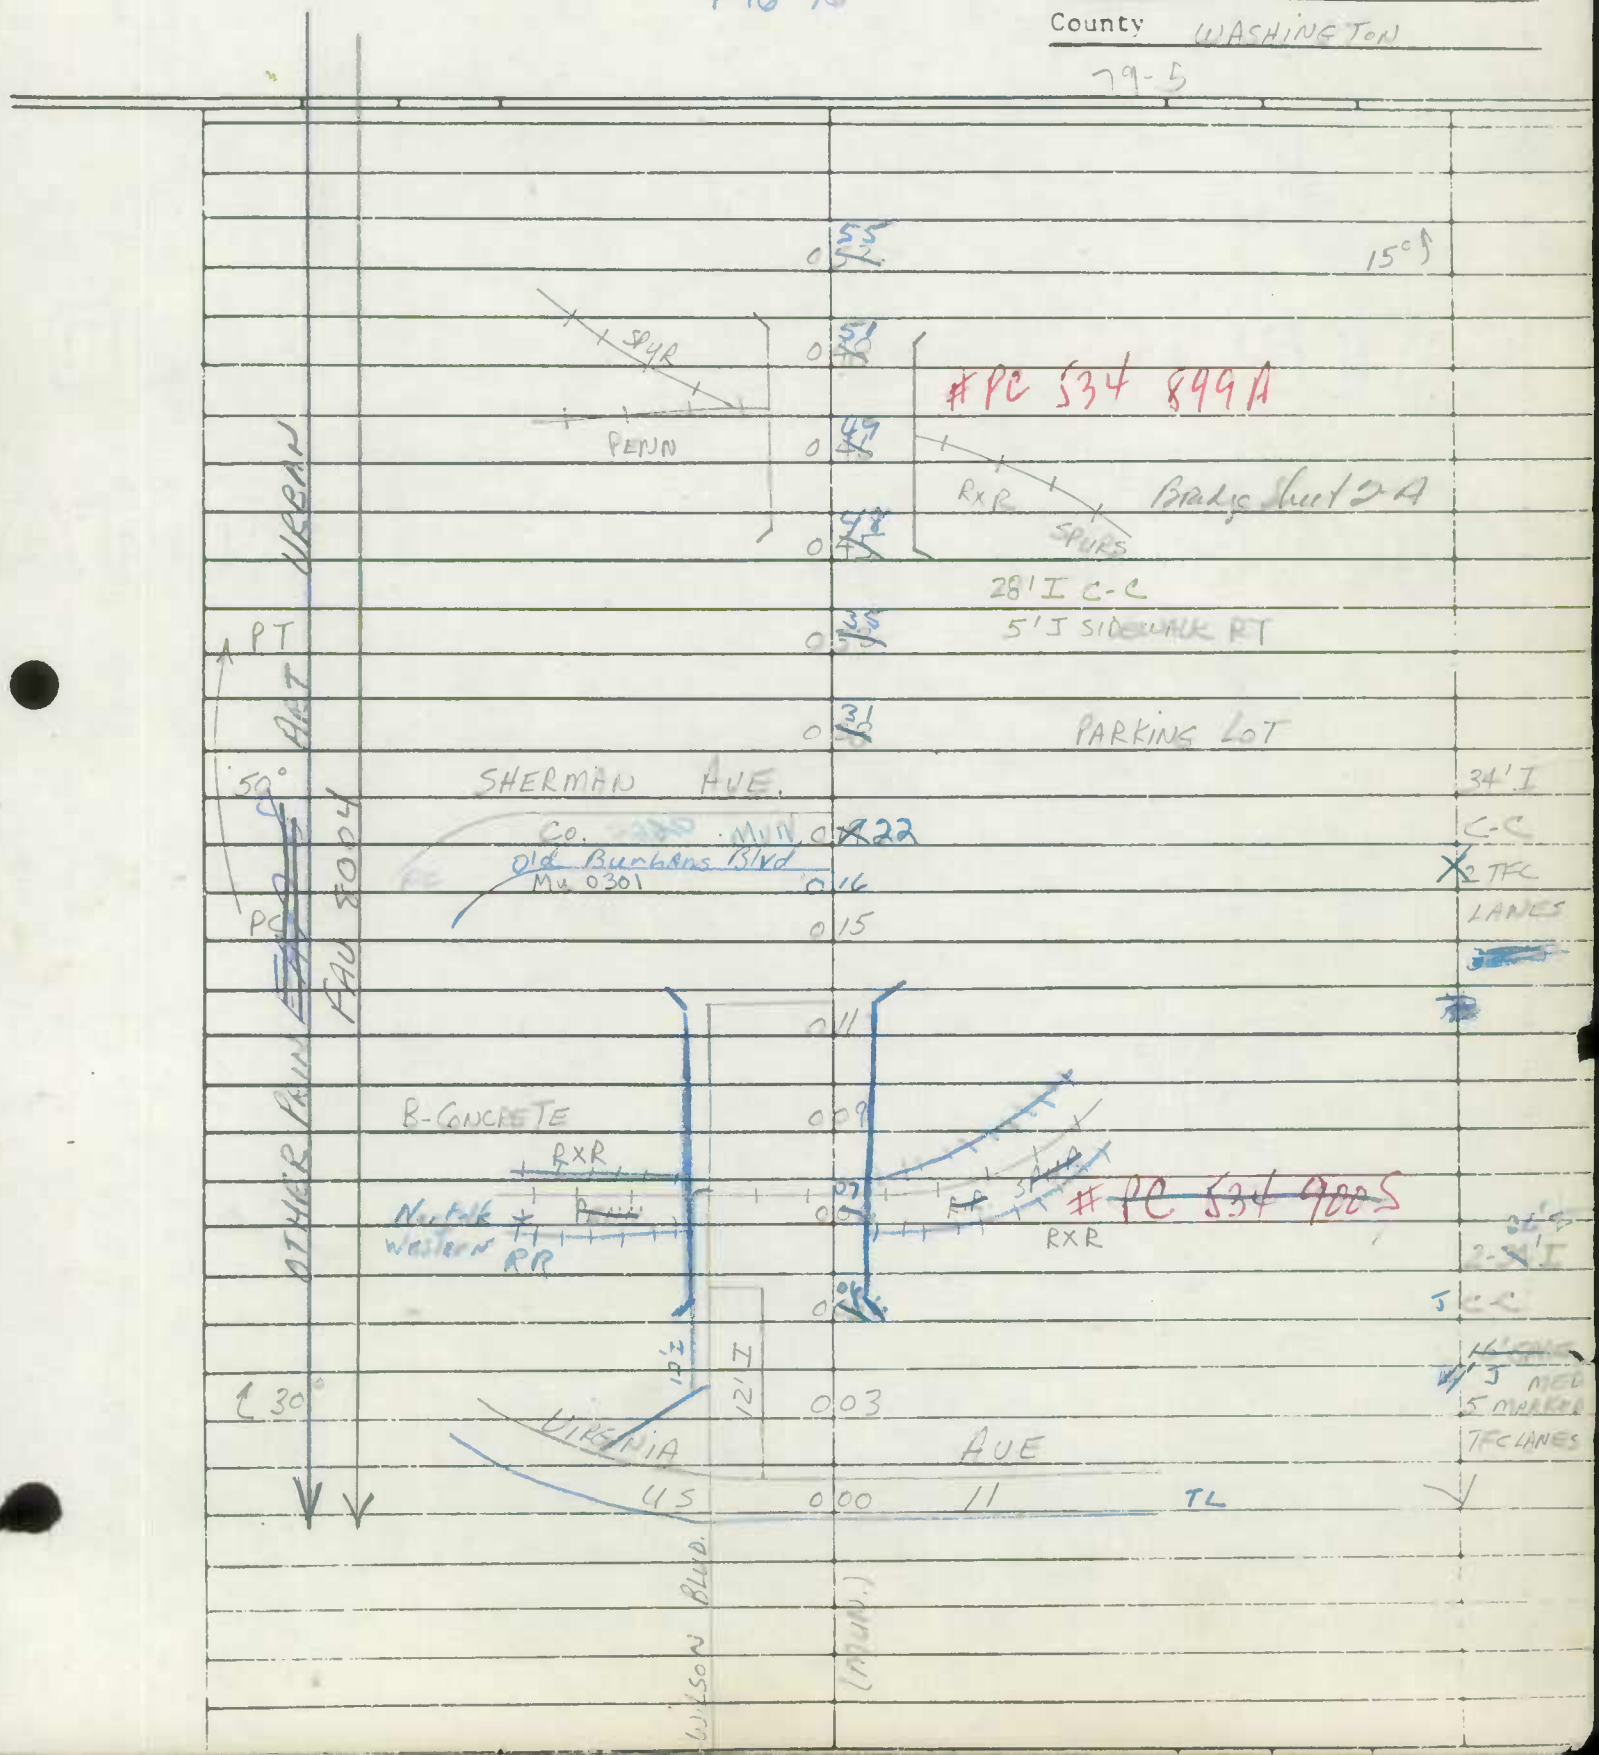

Form 6 HPS (Rev. 1961)

ROAD INVENTORY SHEET

Party Chief T. LANDON
Recorder W. WARFIELD
Chainman

Road No. 0300
Name BURHANS BLVD.
Sheet No. 2 OF 4
Date 3-5-70
County WASHINGTON

79-5

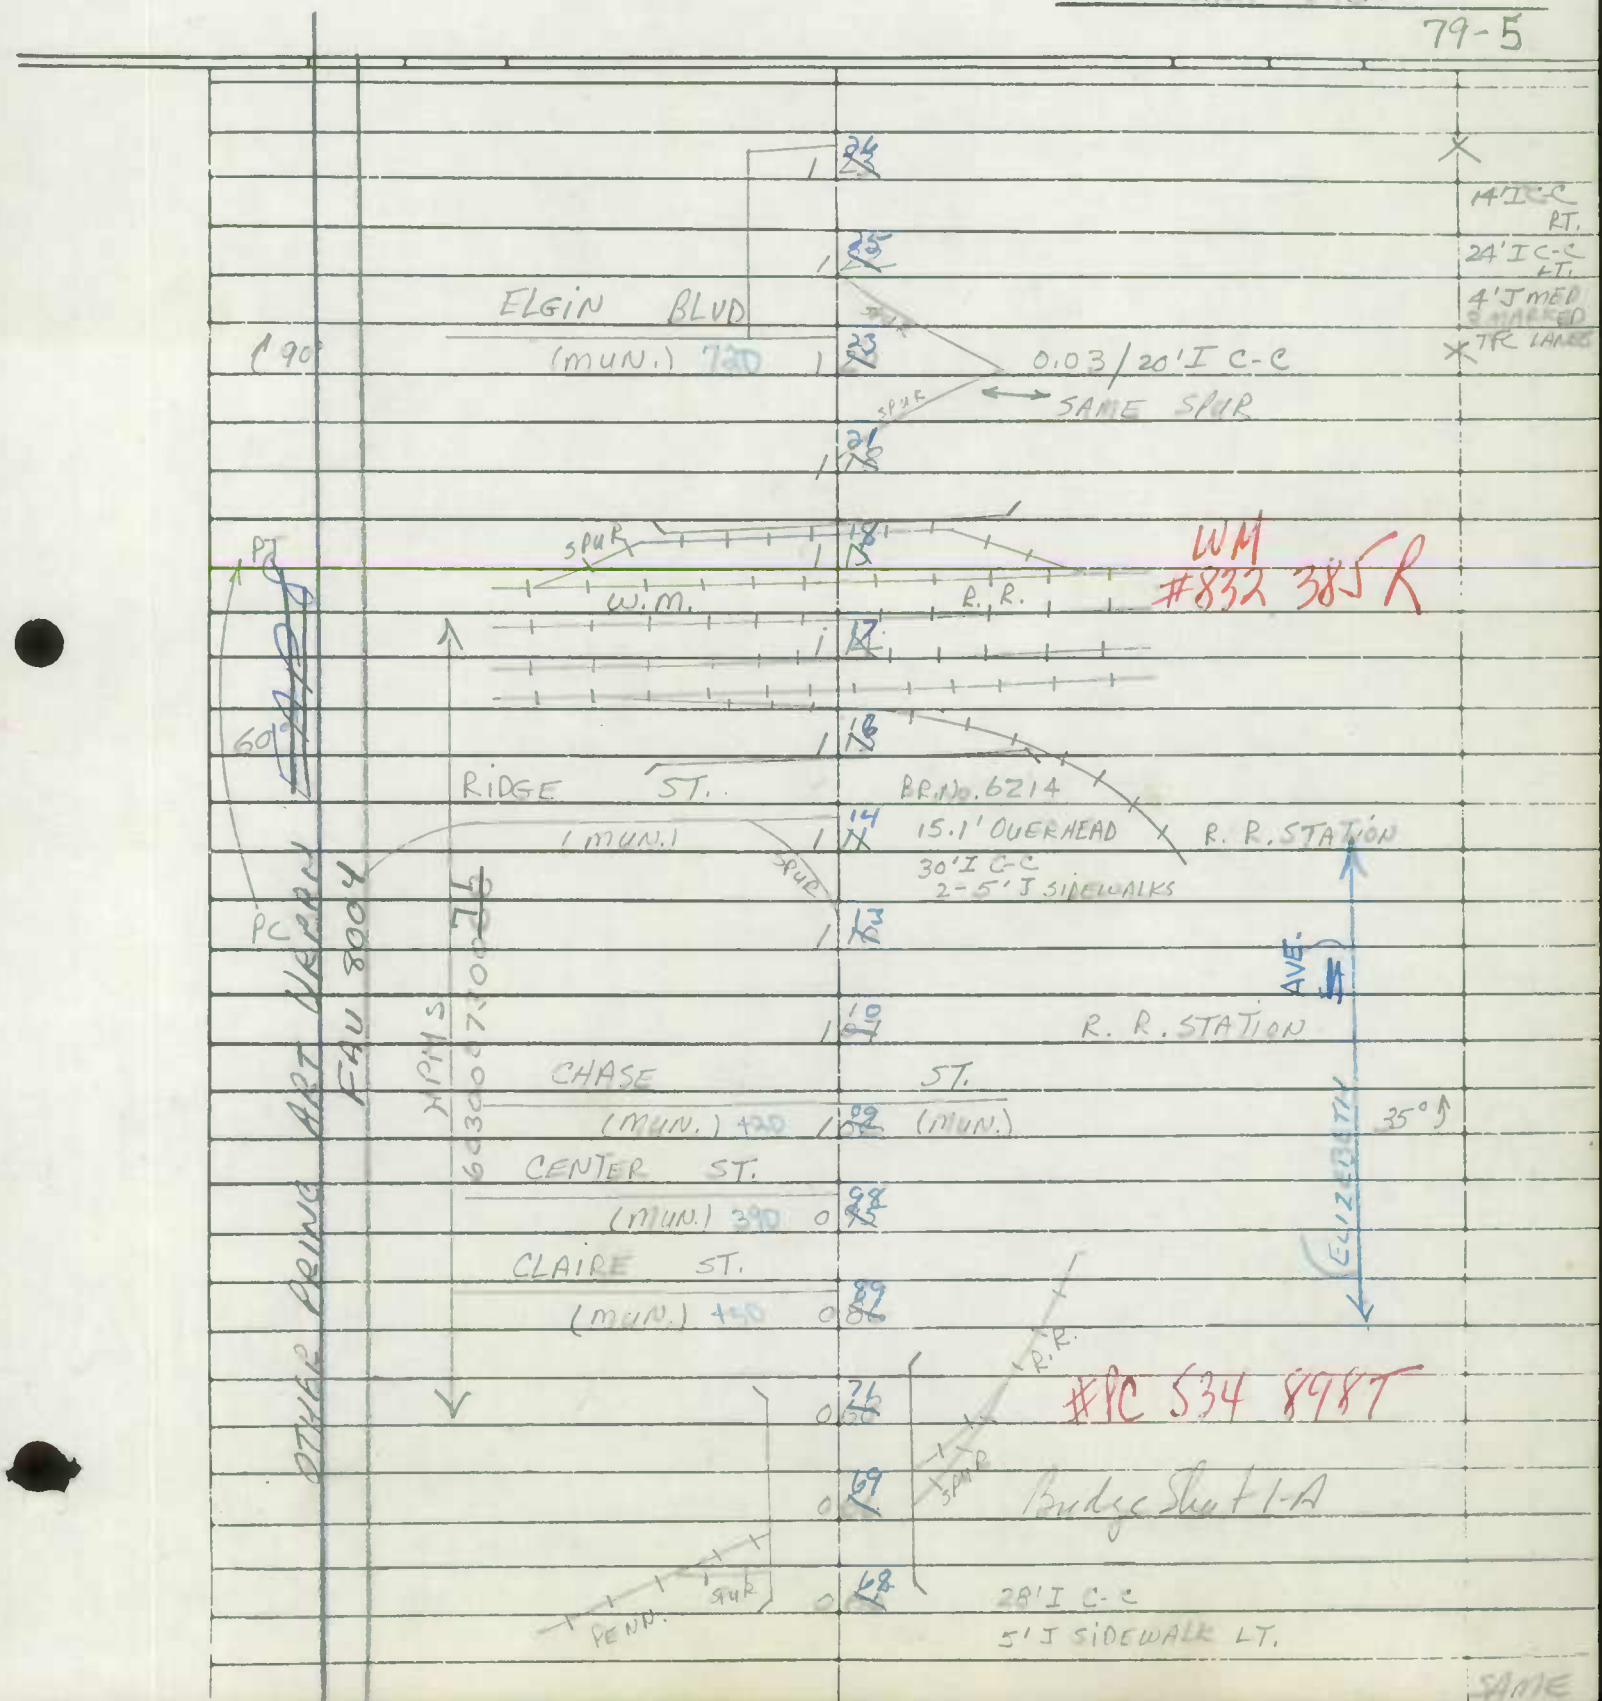

Form 6 HPS (Rev. 1961)

ROAD INVENTORY SHEET

Party Chief T. LANDON
Recorder W. WARFIELD
Chainman

Road No. 0300
Name BURHANS BLVD
Sheet No. 3 of 4
Date 3-5-70
County WASHINGTON

79-13

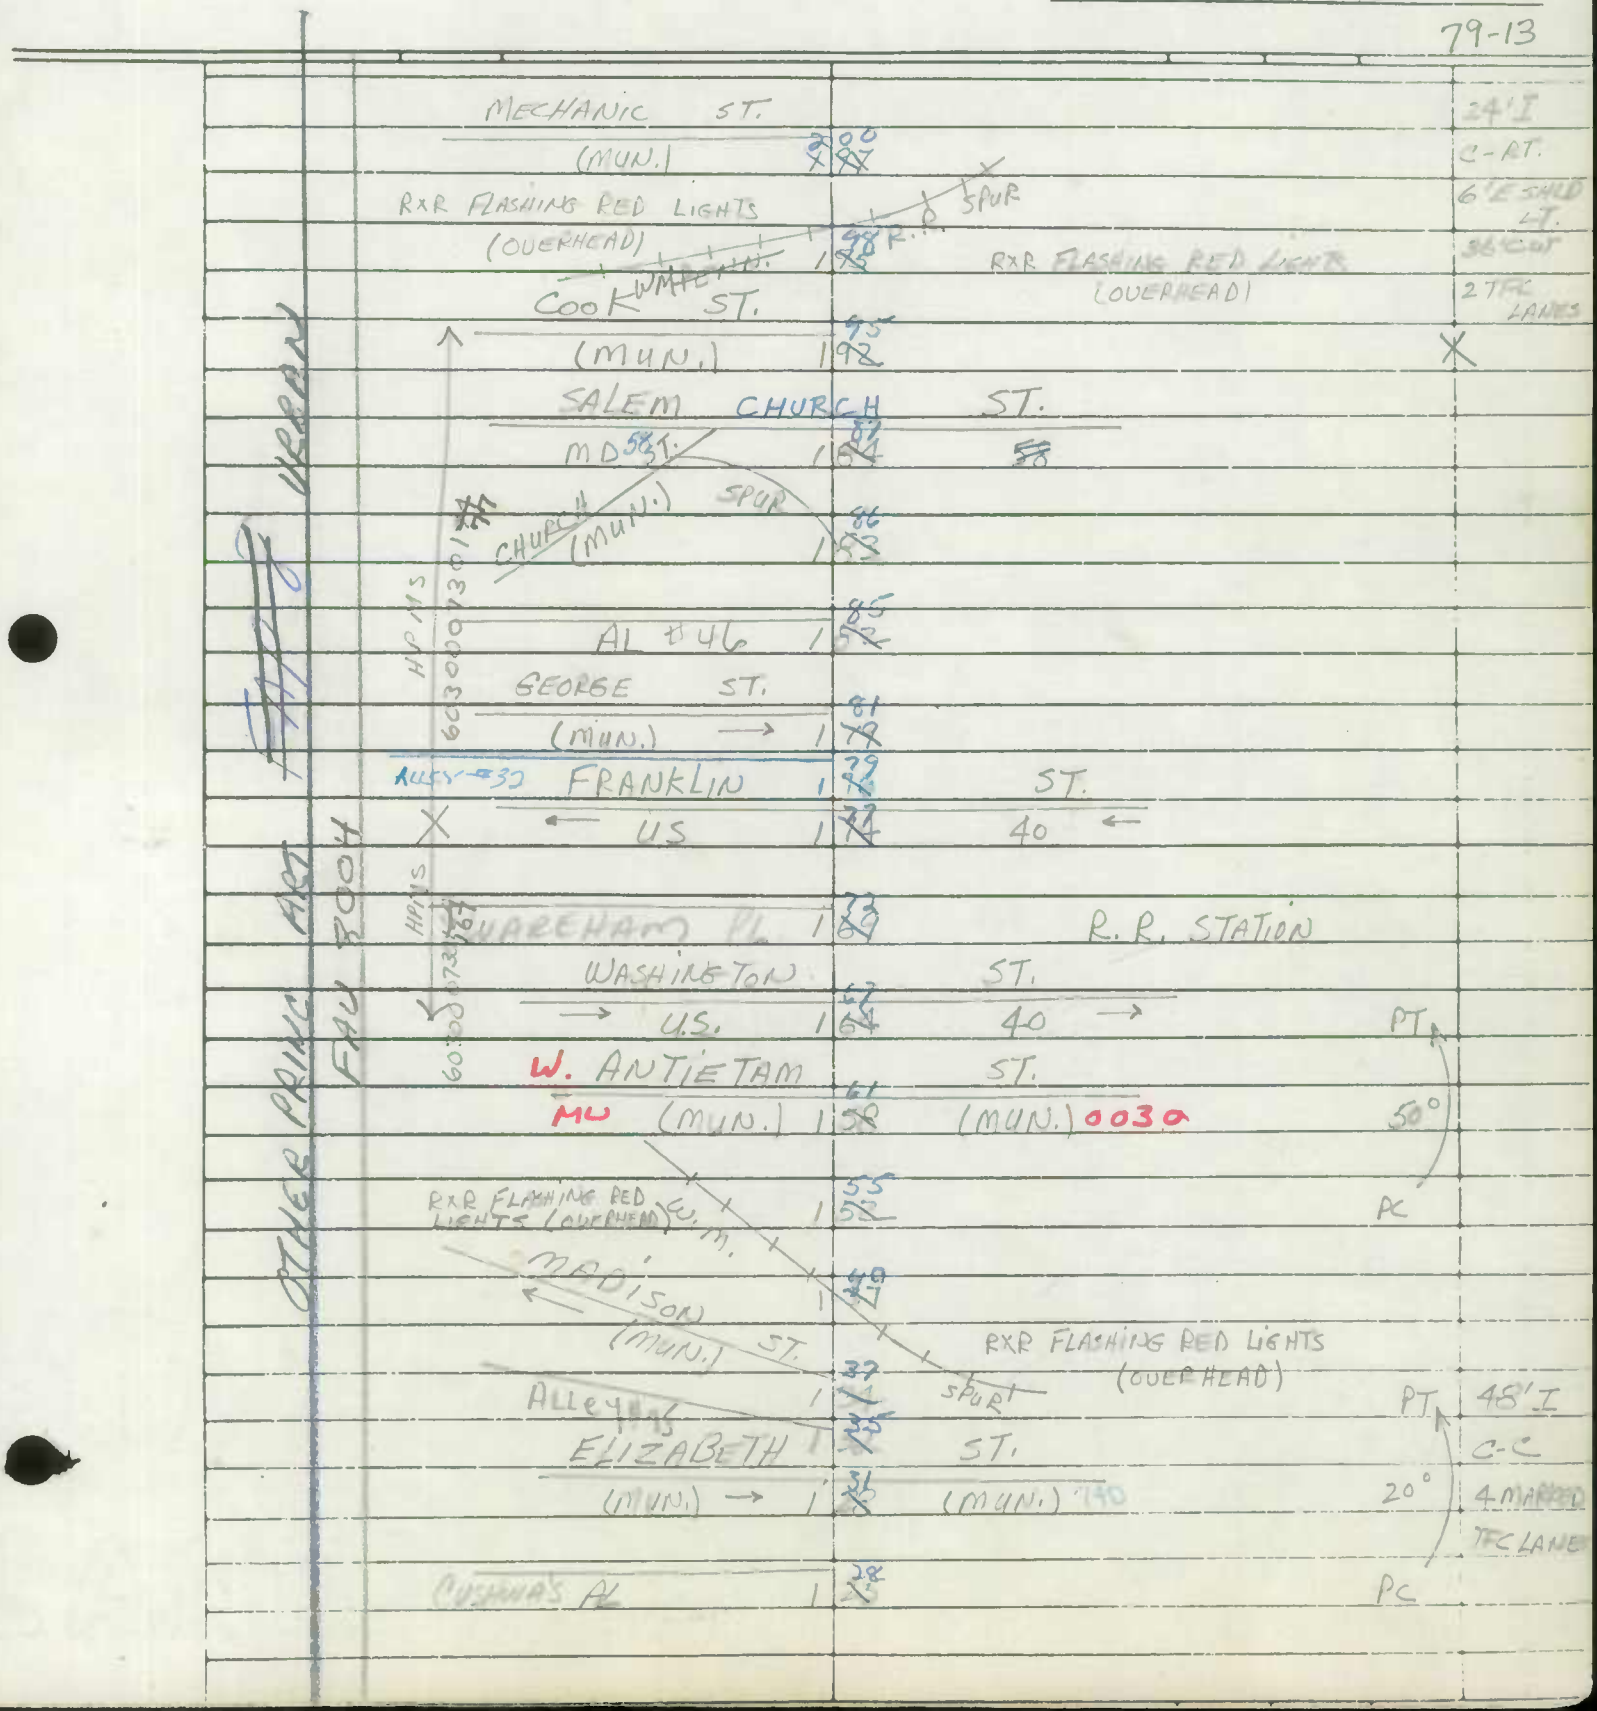

Form 6 HPS (Rev. 1961)

4

ROAD INVENTORY SHEET

Party Chief T. LANDON
Recorder W. WARFIELD
Chainman

Road No. 0300
Name BURHANS BLVD
Sheet No. 4 OF 4
Date 3-5-70
County WASHINGTON

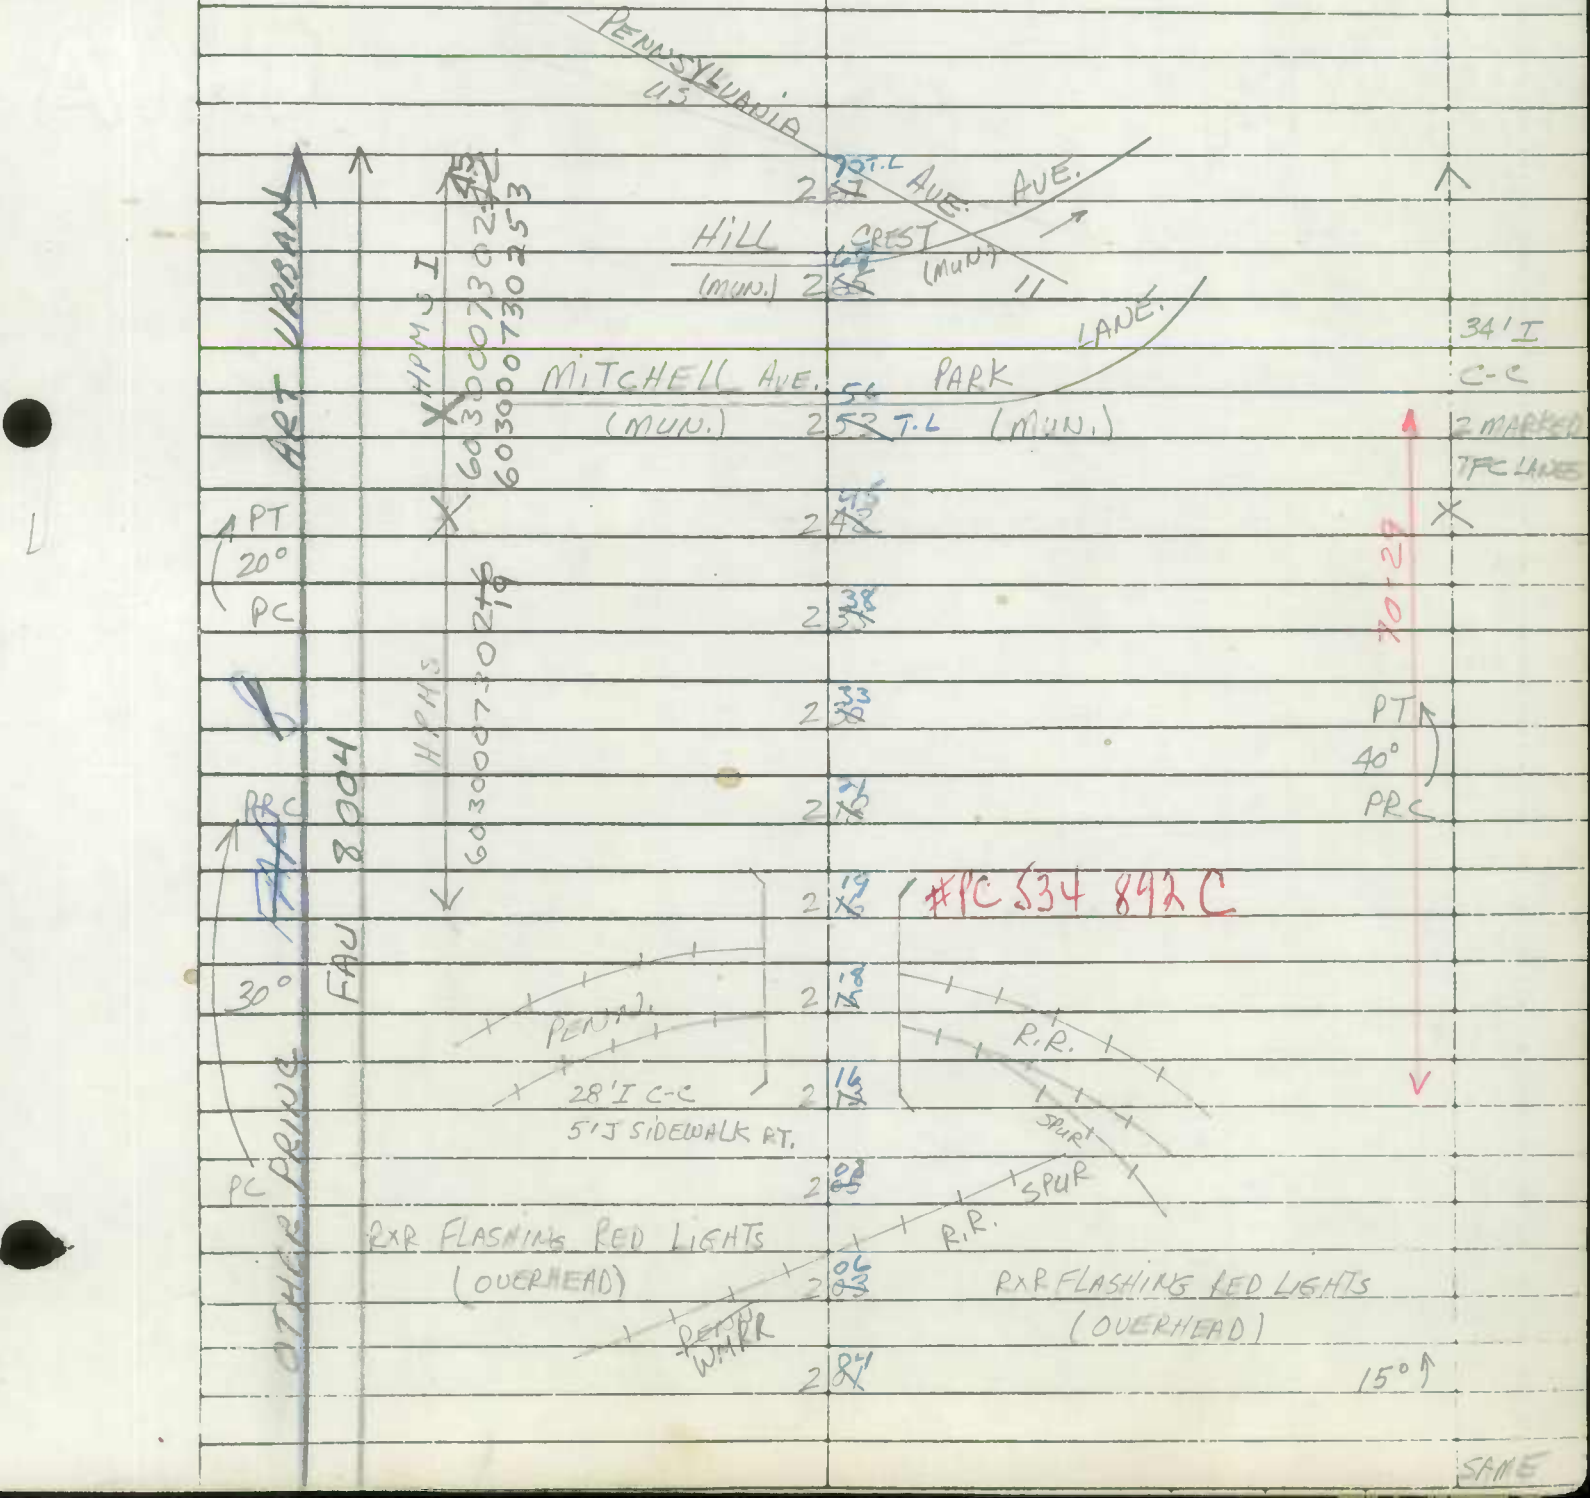

Form 6 HPS (Rev. 1961)

MACSPAN

ROAD INVENTORY SHEET

Party Chief R. Vought
Recorder L. Coffelt Jr.
Chainman

VER. 7-14-76

Road No. 0320
Name Calvert Terr.
Sheet No. 1 of 1
Date 10-5-63
County Wash.

Potomac
MUN
~~0.26~~ 0.28
Ave. 2000

ALLEY 222
MU 7220 0.25
51' I
C-C

85° Irvin Pkwy.
MU 1170
~~0.21~~ 0.23
0.22
~~0.12~~ 0.14
PT 850
PC

Irvin
MU
~~0.09~~ 0.11
1130 Ave
3010

POTOMAC 0.00 HEIGHTS
Beg End

40' I
C-C

Form 6 HPS (Rev. 1961)

ROAD INVENTORY SHEET

Party Chief R. Vaught
Recorder L. Coffelt, Jr.
Chainman

FCR-97
SNI

Hagerstown
VER
7-16-76

Road No. 0330 - 0340
Name ~~N. & S.~~ CANNON AVE. N+S
Sheet No. 1 of ~~X~~ 3
Date 11-4-63
County Wash.

92-9 A/T

82-KIN AT

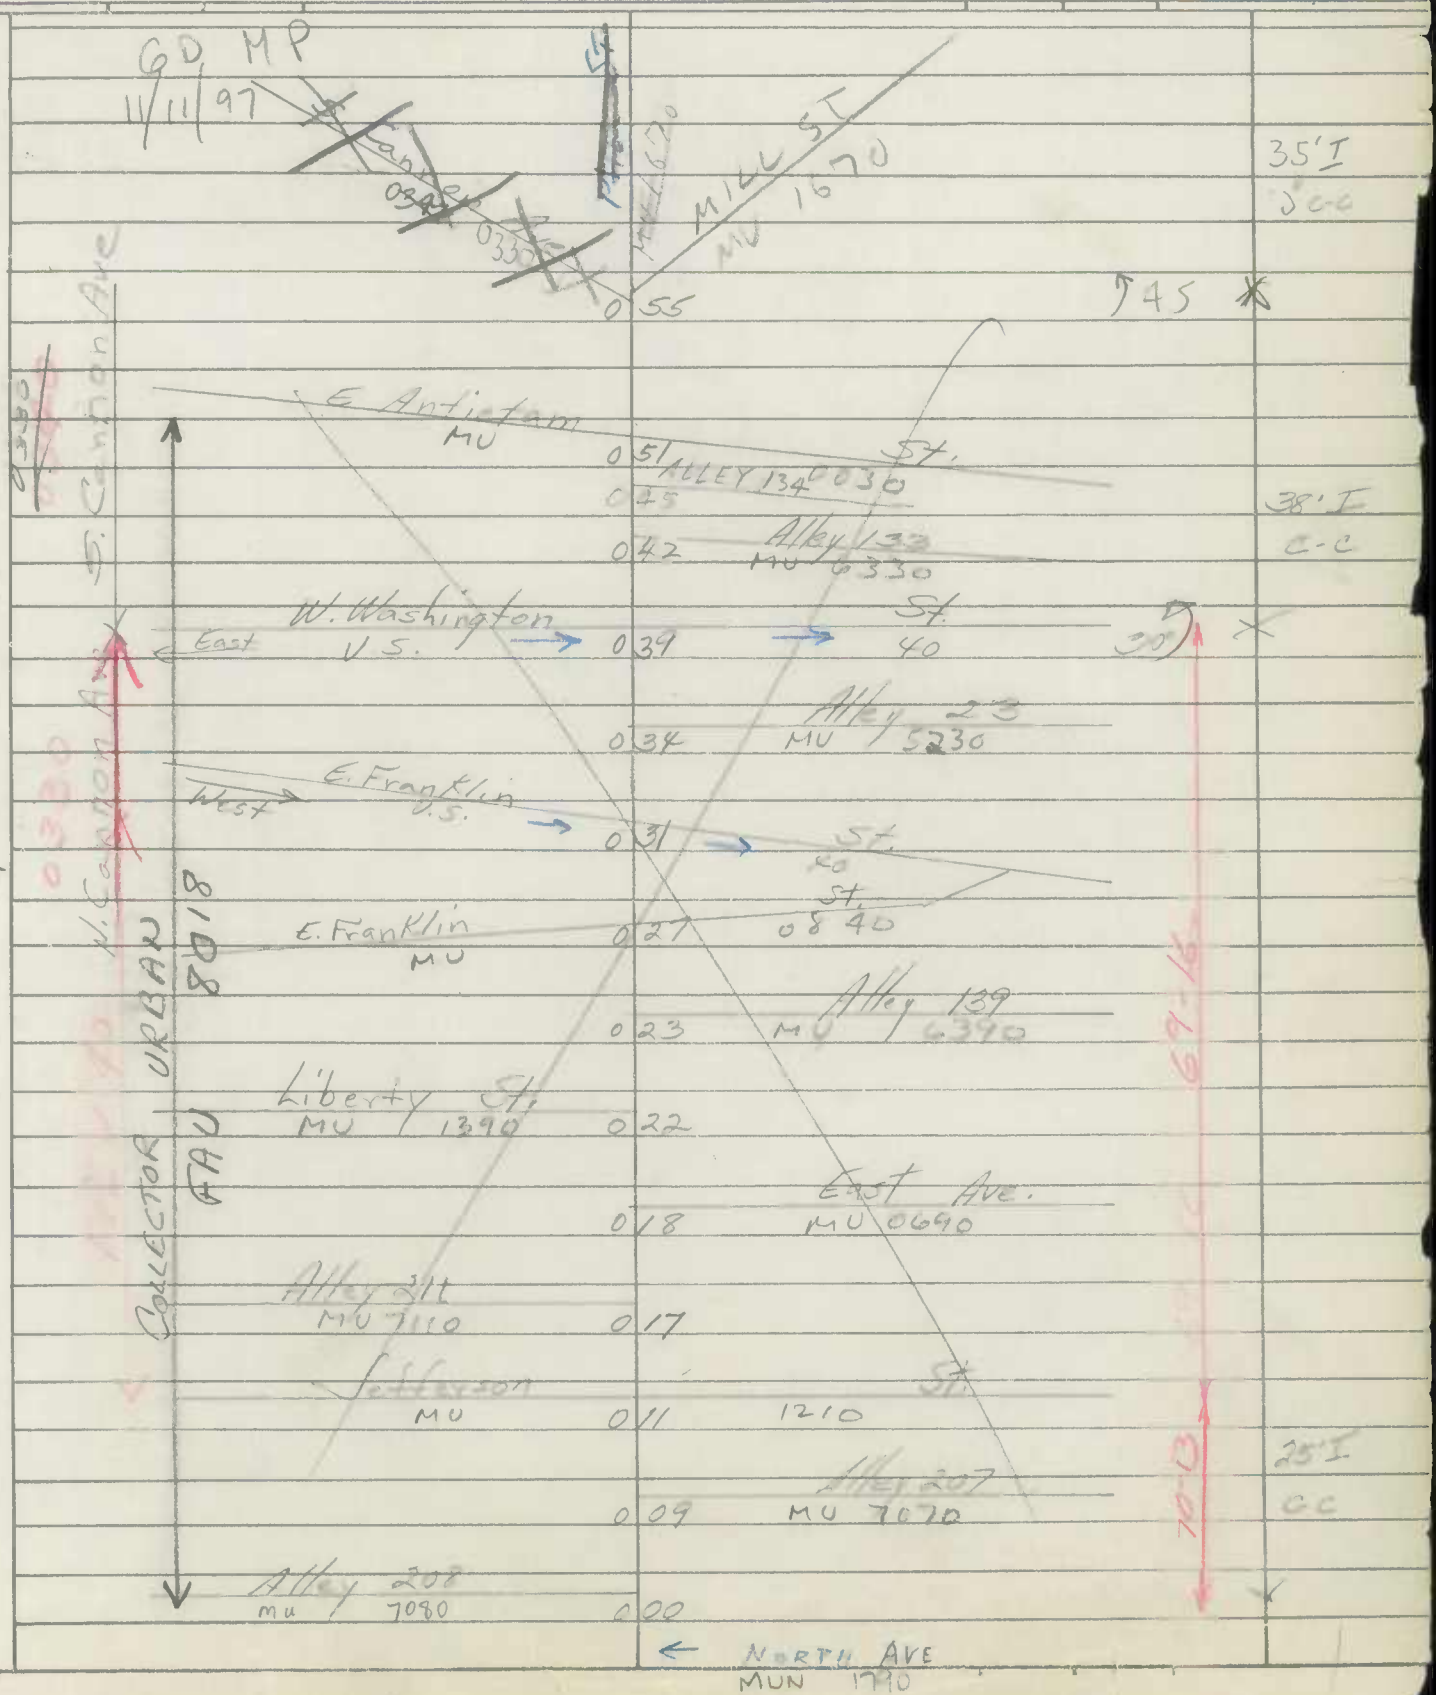

SHA 51.3 - 8 Revised
4.83

95-9,-11
11-7-95
GD/TM

MARYLAND STATE HIGHWAY ADMINISTRATION

ROAD INVENTORY SHEET

Party Chief REWRITTEN S.M.
Recorder
Assistant
Map No./Dir. /
State Coordinates

Road No. MUN ~~0342~~ 0330 ( )
Road Name ~~S.~~CANNON AVE ~~#2~~ NTS
County WASHINGTON
Date 10-7-88
Sheet No. ~~X~~ 2 OF ~~X~~ 3

SYSTEM: FED. AID. | FUNCT CLASS. | HWY. SYS. | HPMS SAMPLE
TRAFFIC: PRKG. REST. | COM/IND. ACCESS

LINE DIAGRAM

HAGERSTOWN

CLEVELAND AVE
MU 480
0 ~~35~~ 90

0 ~~24~~ 79 CBC D 9 × L 10 × W 50

0 ~~20~~ 75 E BALTIMORE ST
MU 0090

ALLEY #132
MU 6320
0 ~~19~~ 74

ALLEY #132
MU 6320
0 ~~03~~ 58

MIDDLE ST
CO

CANNON AVE
MU 0332
0.00

TRAFFIC: CONTROL | COM/IND. ACCESS | PRKG. REST.

PAVEMENT DATA
35'I
"J" C-C
2 ML

TRAFFIC CODES
TRAFFIC CONTROLS: STOP SIGN=SS, TRAFFIC LIGHT=T.L., FLASHING RED BALL=F.R.

TRAFFIC CODES
PARKING RESTRICTIONS: A.M. PEAK, P.M. PEAK, A.M./P.M. PEAK, NO PARKING ANYTIME=N.P., COMM/IND. ACCESS=E

SYSTEM | TRAFFIC | LINE DIAGRAM | TRAFFIC | PAVEMENT DATA

SYSTEM: FED. AID. | FUNCT. CLASS. | HWY. SYS. | HPMS SAMPLE
TRAFFIC: PRKG. REST. | COM/IND ACCESS
TRAFFIC: CONTROL | COM/IND ACCESS | PRKG. REST.

FAU 8005
MINOR ARTERIAL URBAN

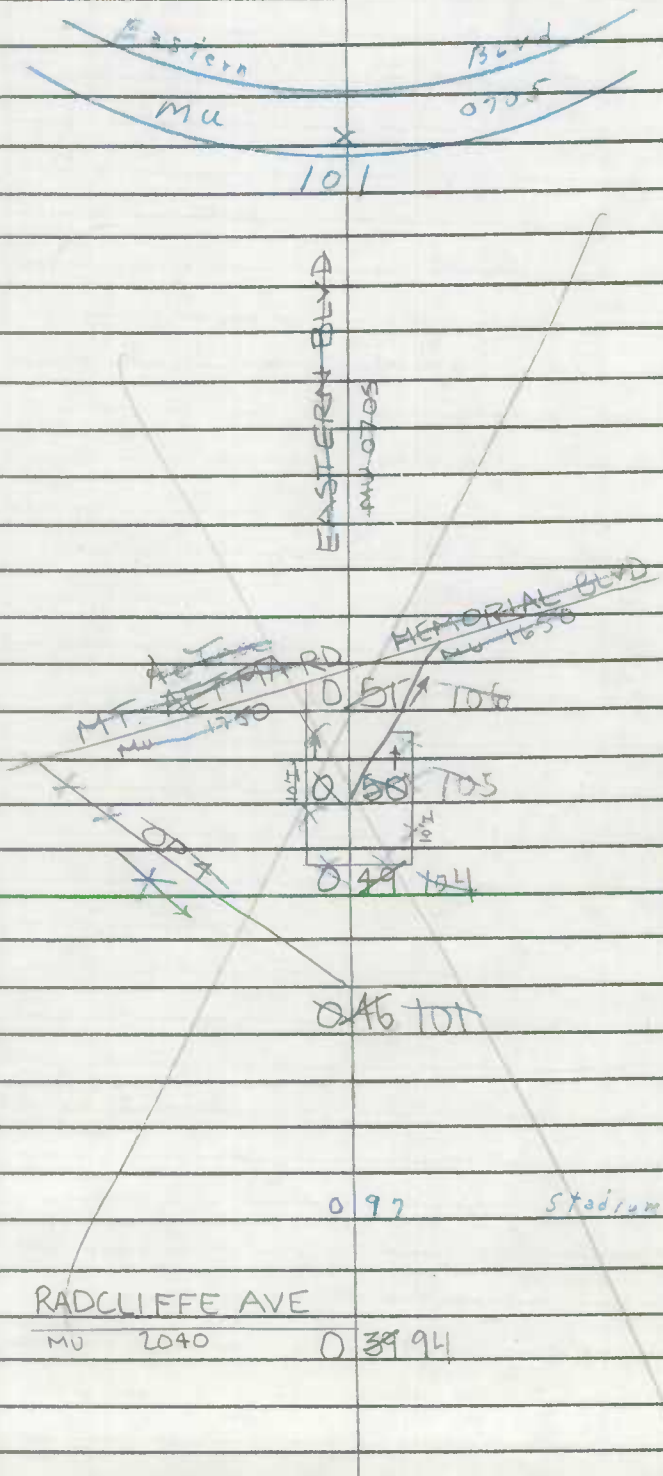

PAVEMENT DATA: SAME

Form 6 HPS (Rev. 1961)

ROAD INVENTORY SHEET

Party Chief R. VOUGHT
Recorder L. COFFELT JR.
Chainman

Road No. 0342
Name S. CANNON AVE HOL2
Sheet No. 1 OF 1
Date 11-5-63
County WASHINGTON

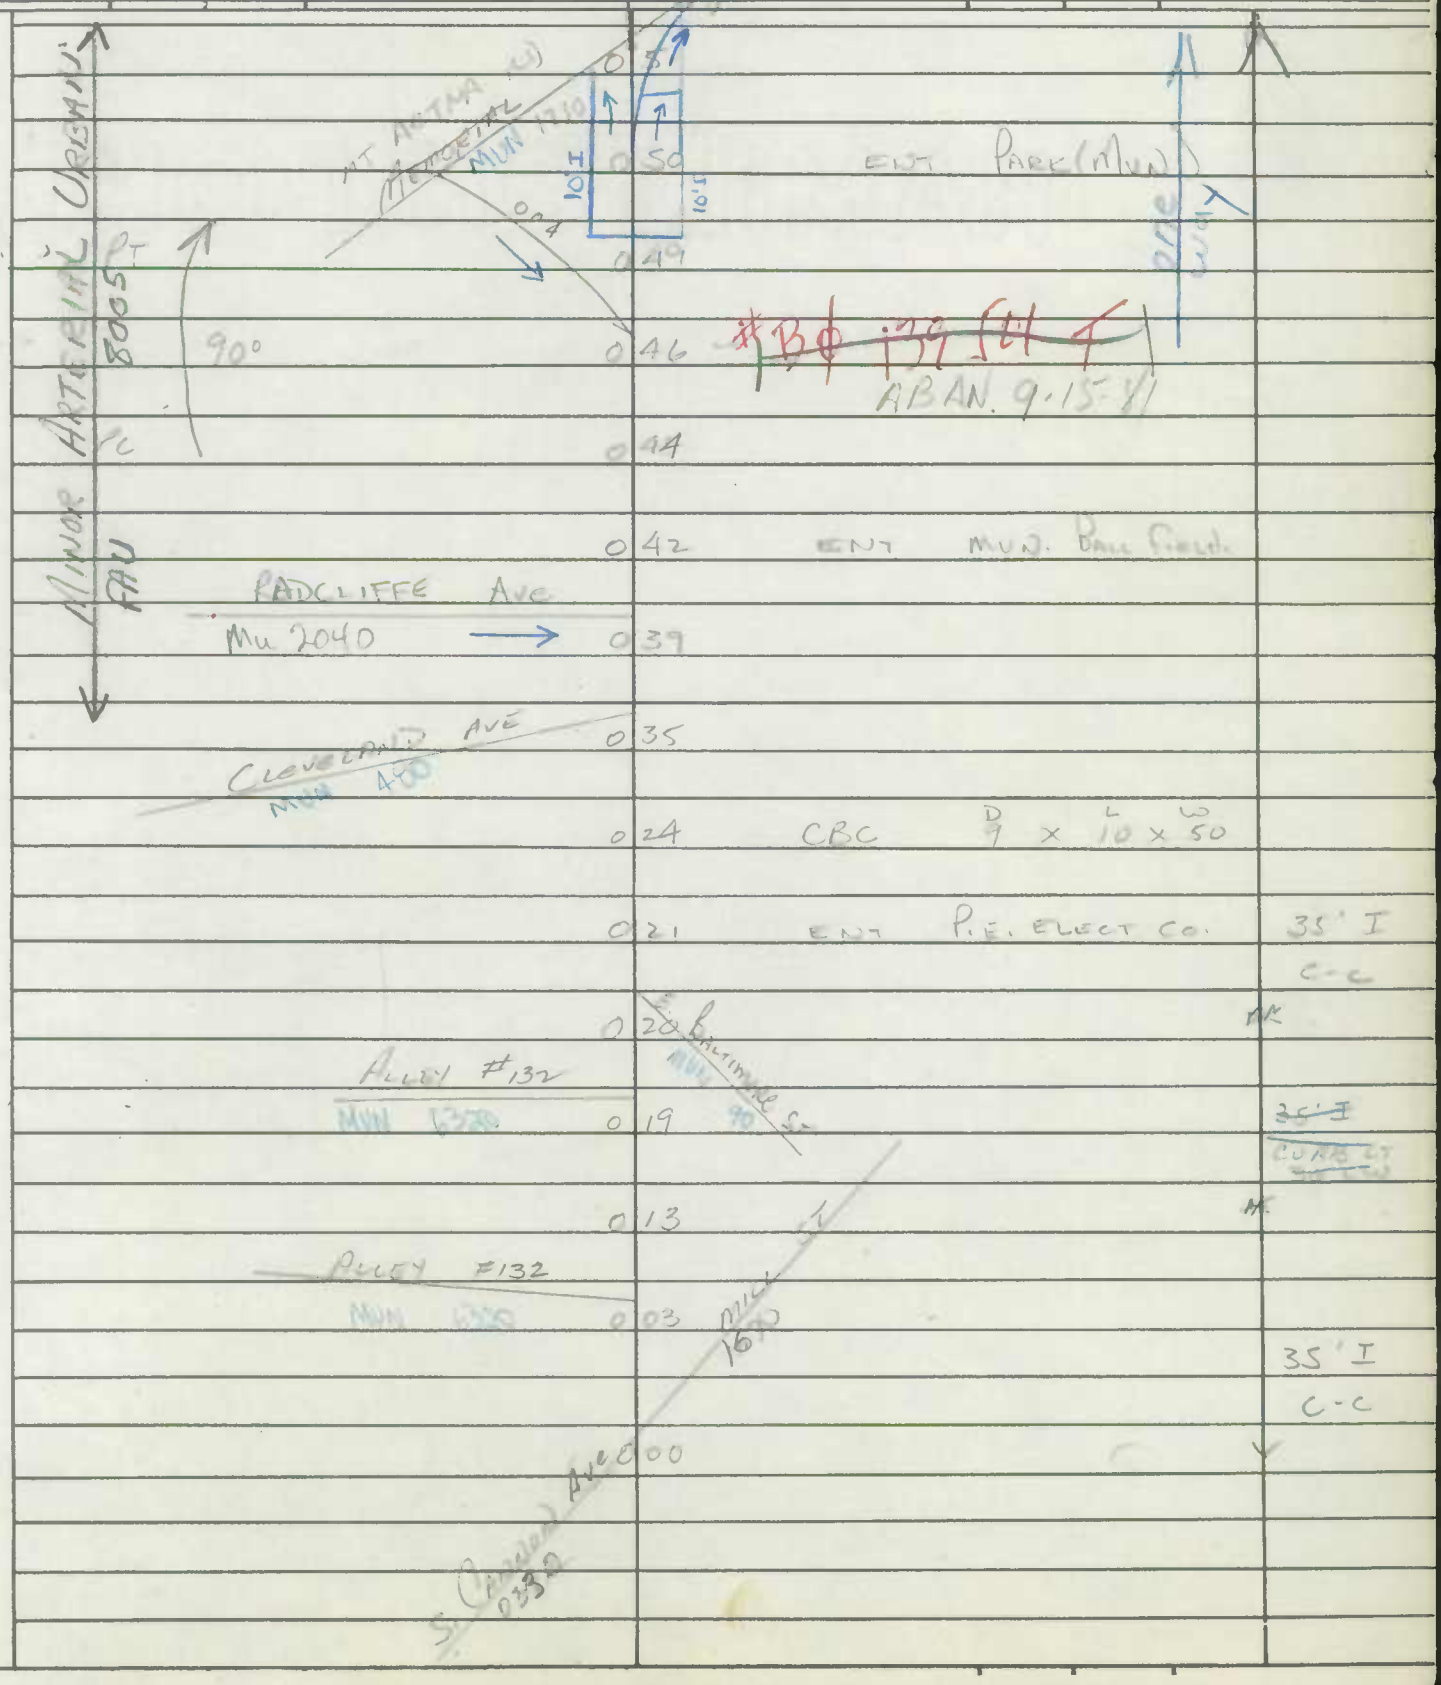

Form 6 HPS (Rev. 1961)

AT 79-77

ROAD INVENTORY SHEET

Party Chief R. ~~VOUGHT~~
Recorder
Chainman L. ~~COFFELT~~ JR.

VER 7-20-76

HAGERSTOWN

Road No. 0710
Name CHARLES ST
Sheet No. 1 OF 1
Date 10-31-63
County WASHINGTON

71-6

79-9

PLAYGROUND
ROAD END
023

PARK ~~SUMMIT~~ PL #2
MU. 1940
020

SUMANS AVE
MUN 2280
24' H CURB RT 28 CW

AVE
1960
017

PENNA.
MU
FOREST
MU.
015

DR No. 2
0832

BUBBLE AVE
MUN 2180
013

HAMILTON LA
MUN 0970
012

PARK PL
MUN 1940
010

BOWARD
MUN
008

ST
190

26' I
C'C

Potomac
MUN
000

ST
2000

Form 6 HPS (Rev. 1961)

ACS

ROAD INVENTORY SHEET

Party Chief R. VOUGHT
Recorder L. COFFELT JR.
Chainman

VER. 7-14-76

HAGERSTOWN

Road No. 0420
Name CHASE ST
Sheet No. 1 OF 1
Date 10-29-63
County WASHINGTON

Road End.
0.15
10'E 14'CW

ALLEY # 79
MUN 5790
0.12
10'E I 14'CW

RIDGE AVE
MUN 5790
0.09
11'I 22'CW

ALLEY #78
MUN 5790
0.06
25'I 28'CW

BURHANS ~~ELEVENTH~~ ~~AVE~~ BLVD
US ~~40~~
0.03
11
22'H 26'CW

ALLEY 77
5770 MUN
0.00

Form 6 HPS (Rev. 1961)

ROAD INVENTORY SHEET

Party Chief R. VOUGHT
Recorder L. COFFELT JR.
Chainman

VCR
7-15-76

HAGERSTOWN

Road No. 0440
Name Church St
Sheet No. 1 OF 3
Date 11-9-63
County WASHINGTON

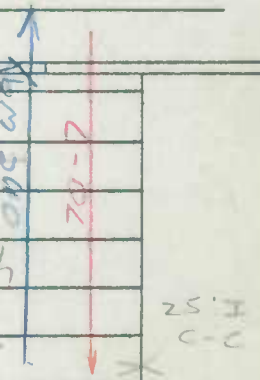

ALLEY		#43
MUN	0	75 S450
	0	73 Church
WEST SIDE		AVE
MUN	0	71 2580
ALLEY		#25
MUN	0	67 S250
BRYAN		PL
MUN	0	63 2480
ALLEY		#26
MUN	0	60 S260
AVON		RD.
	0	56 MU. 0070
WAKEFIELD		RD
2460	0	49 MUN
DEVONSHIRE		RD.
MUN	0	42 630
NOTTINGHAM		RD
MUN	0	34 1830
2003 ENT. ← →		
(School) School	0	29
		ROCK WILLOW AVE
	0	25 MUN 2192
130	0	20
KEY AVE		
MUN 1200	0	16
DAYSCTAH		AVE
MUN	0	07 MUN 476
WOODPOINT		AVE
MUN	0	00 MUN 2630

Form 6 HPS (Rev. 1961)

ROAD INVENTORY SHEET

Party Chief R. VOUGHT
Recorder L. OFFELT JR.
Chainman

HAGERSTOWN

Road No. 0440
Name W. CHURCH ST
Sheet No. 2 OF 3
Date 11-4-63
County WASHINGTON

Minor Art Urban 8002

	1.22	Mu 2470 N. WALNUT AVE
	1.22	RR
		ALLEY #55
	1.19	Mu 5550
RUM RUNNA CK	1.17	McPHERSON Ave
	1.15	Mu 1610 BLVD
BUCHANAN US	1.13	11
Salem Ave	1.11	
HIGH	1.02	ST
	0.99	ALLEY #53
JAMES ST	0.96	
ALLEY #50	0.93	
NORWAY AVE	0.91	
ALLEY #48	0.88	
WINTER	0.86	ST 2-610
Church	0.84	
ALEXANDER	0.78	ST

Form 6 HPS (Rev. 1961)

ROAD INVENTORY SHEET

Party Chief R. Vought
Recorder L. Cossett, Jr.
Chainman

Road No.
Name Church St.
Sheet No. 3 of 3
Date 11-4-63
County Wash.

EAST AVE 0690

N. Potomac → 1/33 → 2000 St.

Market 1/29 MUN 1530 Pk

Mun. Pk. Lot 1/45

Alley 59 MUN T30 1/42 Ent. Mun. Pking Lot

Jonathan ← 1 one way St.

Mu 1/39 1230

1/35 Berkeley Alley 25'I

1/33 Braxton Alley C-C

N. Prospect → MUN 1/29 2030 → St.

Penna 1/27 2.6 Sp-f tracks

Penna 1/23 R.R. Spur 25'I 2 C'CW.

MUNICIPAL ART VERSION FAU 8002

Form 6 HPS (Rev. 1961)

CS ✓ pg-77

ROAD INVENTORY SHEET

Party Chief R. VOUGHT
Recorder L. COFFELT JR.
Chainman

VER. 7-14-76

HAGERSTOWN

Road No. 0450
Name CLAIRE ST
Sheet No. 1 OF 1
Date 10-29-63
County WASHINGTON

R. R. PROPERTY
ROAD END
0.25
EDGEWOOD AVE
0.24
190°
0.21
ENT RR YARD
0.17
Breuce Ave
0.13
ALLEY
#79
0.10
Rider
AVE
0.06
Alley
#78
0.04
ELIZABETH
AVE
0.00
NO SEE 0140

20'L
24'W
18'H
26'W

Form 6 HPS (Rev. 1961)

ROAD INVENTORY SHEET

Party Chief R. VOUGHT
Recorder L. COFFELT JR.
Chainman

HAGERSTOWN

VER 7-15-76

11/12/97 SNT FCR-97

Road No. 0490
Name W. CLEVELAND AVE.
Sheet No. 1 OF 1
Date 11-13-63
County WASHINGTON

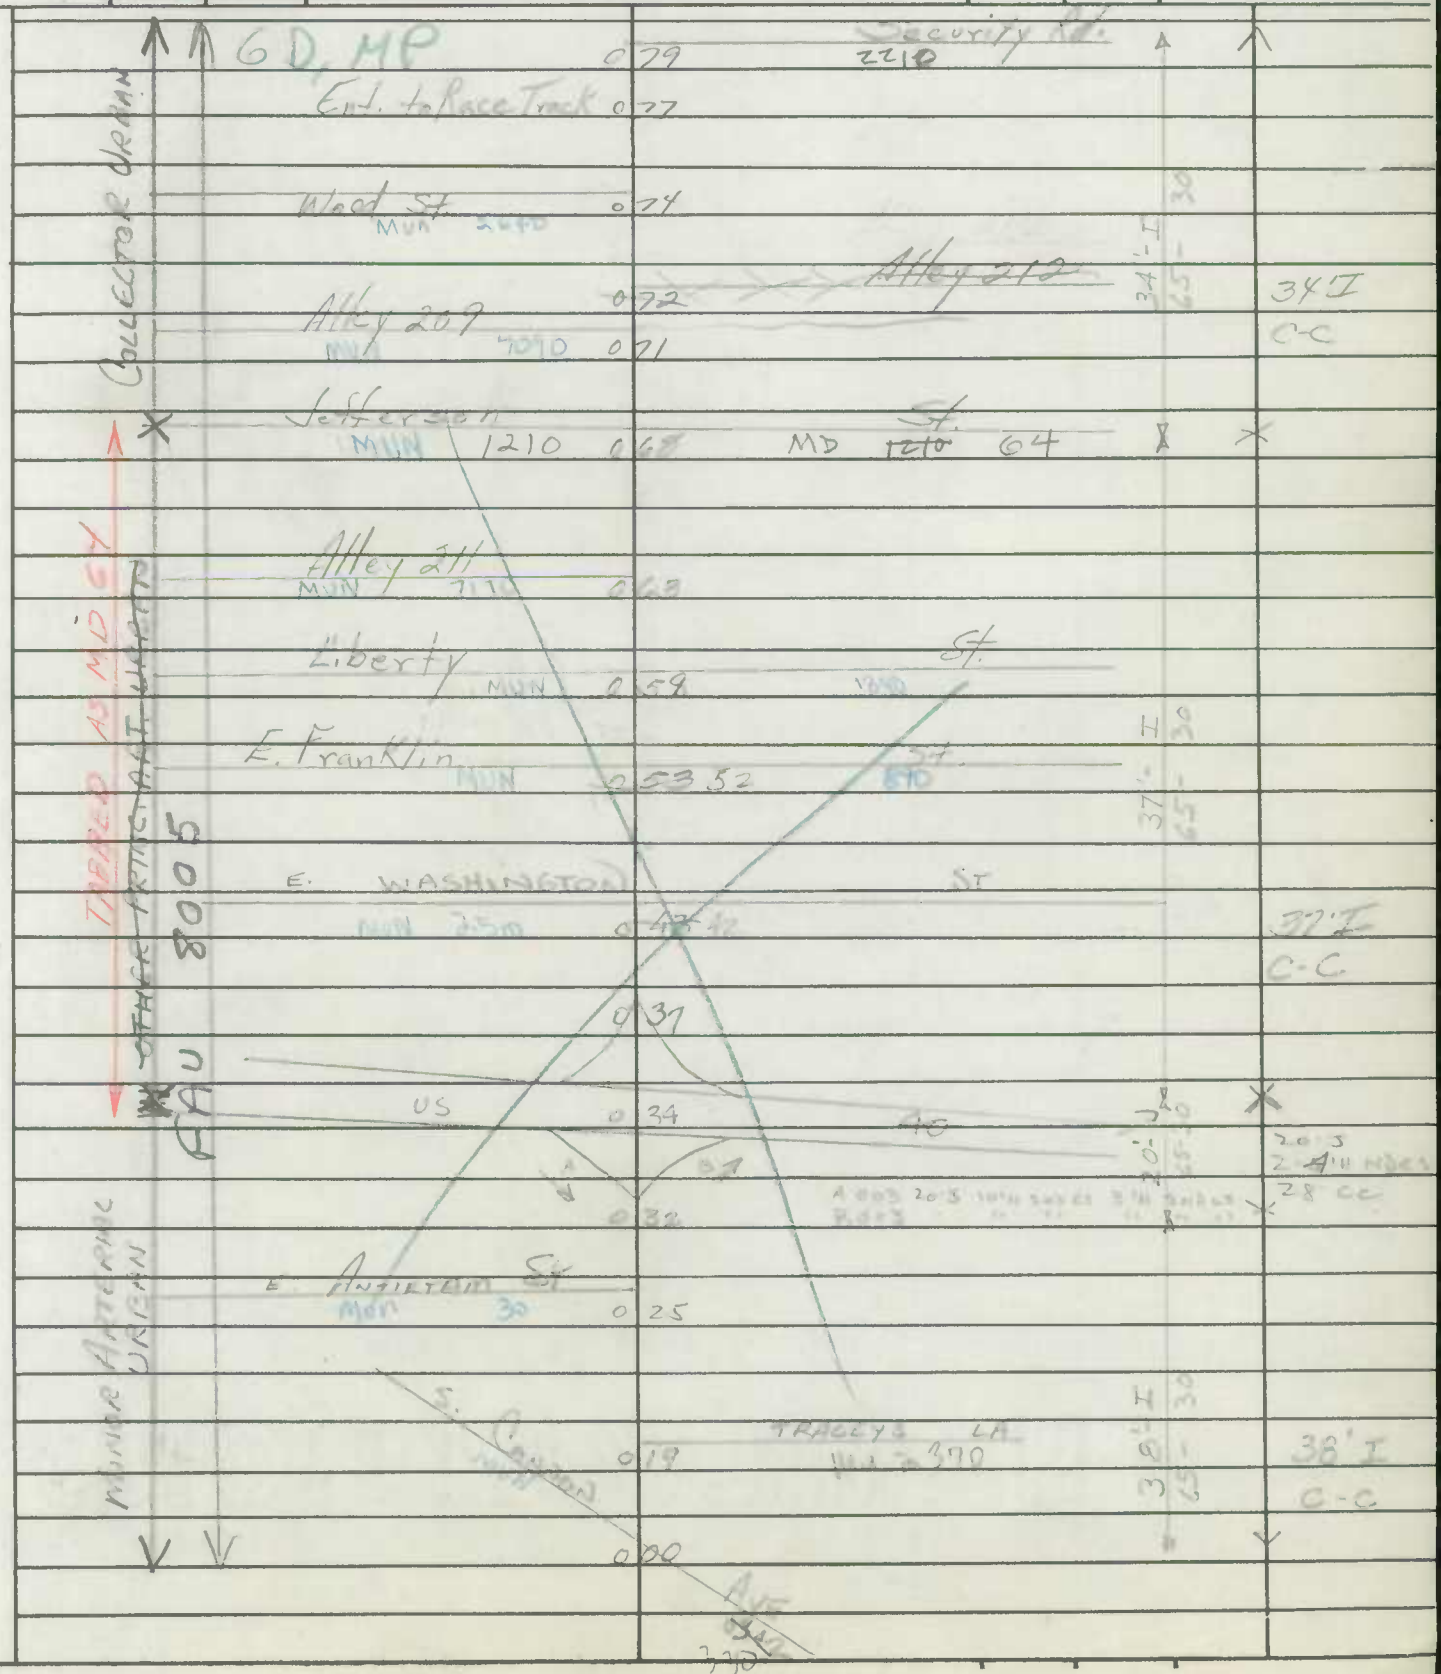

Form 6 HPS (Rev. 1961)

ROAD INVENTORY SHEET

Party Chief R. Vought
Recorder C. Coffelt Jr.
Chainman

VER.
7-14-76

Road No. 0490
Name Columbia Ave.
Sheet No. 1 of 1
Date 10-30-63
County Wash.

MU VALLEY BROOK	0.12	2405 DRIVE	
~~Road~~	~~End~~		
	0.09		
View			
	0.05	54.	
Alley 153		Blvd.	
	0.01	BLVD Pavement 1400	30' I C-C
	0.00		

RANGE BRM

Form 6 HPS (Rev. 1961)

MA C

ROAD INVENTORY SHEET

Party Chief R. ~~VOUGHT~~ VER. 7-16-76
Recorder
Chainman ~~L. COFFELT~~ JR.
HAGERSTOWN

REV: 3/23/76
TL FR 75-3

Road No. 0510
Name Commonwealth Ave
Sheet No. 1 of 1
Date 11-12-63
County WASHINGTON

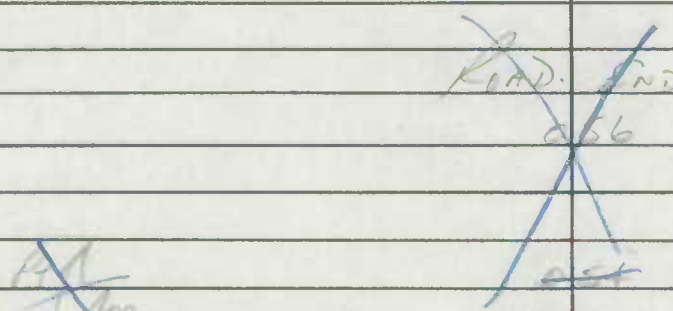

Ft (Willow
MUN 2595 0.42 (CIR.) 2595

0.40

BOWMAN
MUN. 0200 0.27 ~~BOWMAN AVE~~ ~~0200~~ OP 181

WAEM Radio Station 0.26

ENT Board Education WASH CO 0.07

Alley #92
MV 5920 0.04

~~Church~~ 0.07

FREDERICK ST
ALT (40) US 40

50' RI
C-C

H 17
5.0 6.9

SHA 51.3-8
11-15-72

STATE HIGHWAY ADMINISTRATION OF MARYLAND

94 MU. Ext #1
12/7/94
BB/AH

P9-77

ROAD INVENTORY SHEET

Party Chief W. DOMBROSKI
Recorder M. ZALENSKI
Helper

Map No. HAGERSTOWN

Road No. MUN. 0565
Road Name COURT PL.
Sheet No. 1 OF 1
Date 7-20-76
County WASHINGTON
State Coordinates

T6-7

S

W. ANTIETAM ST.
MUN. 005 0030

LIBRARY ALLEY
MUN 000 9120

8'J
12'CW

ALLEY #17
MUN. 5170

SHA 51.3-8
11-15-72

ROAD INVENTORY SHEET

Road No. _____
Road Name _____
Sheet No. _____
Date _____
County _____
State Coordinates _____

Form 6 HPS (Rev. 1961)

AT

ROAD INVENTORY SHEET

Party Chief R. Vaught
Recorder L. Coffelt, Jr.
Chainman

VER 7-15-76

Road No. 0620
Name Daycotah Ave.
Sheet No. 1 of 1
Date 9-23-63
County Wash.

See NEW INVENTORY

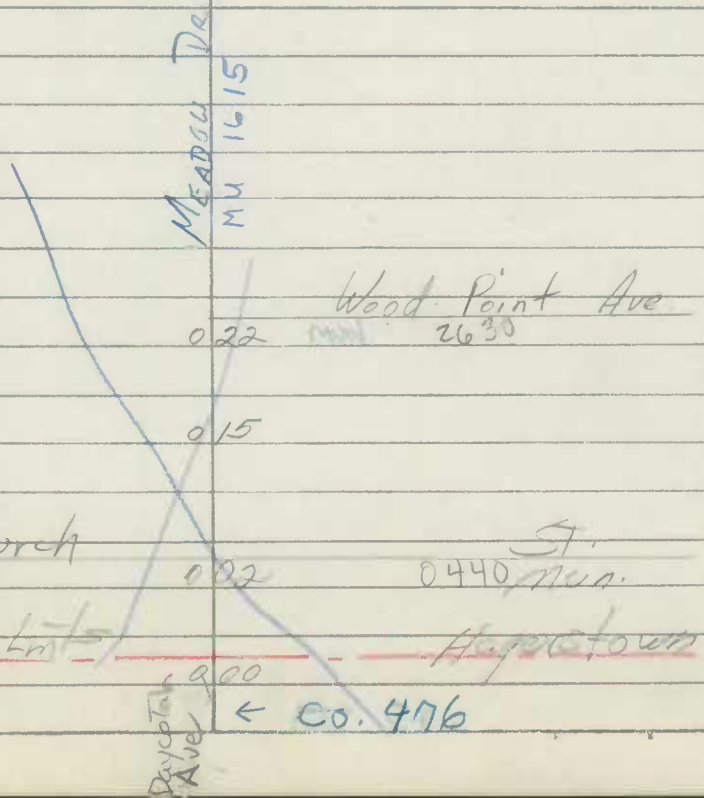

Form 6 HPS (Rev. 1961)

90-101
A/T

NW620 ✓
DAYCOTAH AVE
WOOD POINT AVE

ROAD INVENTORY SHEET

Party Chief R. VOUGHT
Recorder L. OFFELT JR. VER 7-15-76
Chainman

591-665

Road No. Co 476
Name KEY CIRCLE
Sheet No. 1 OF 1
Date 9-13-63
County WASHINGTON

Road End

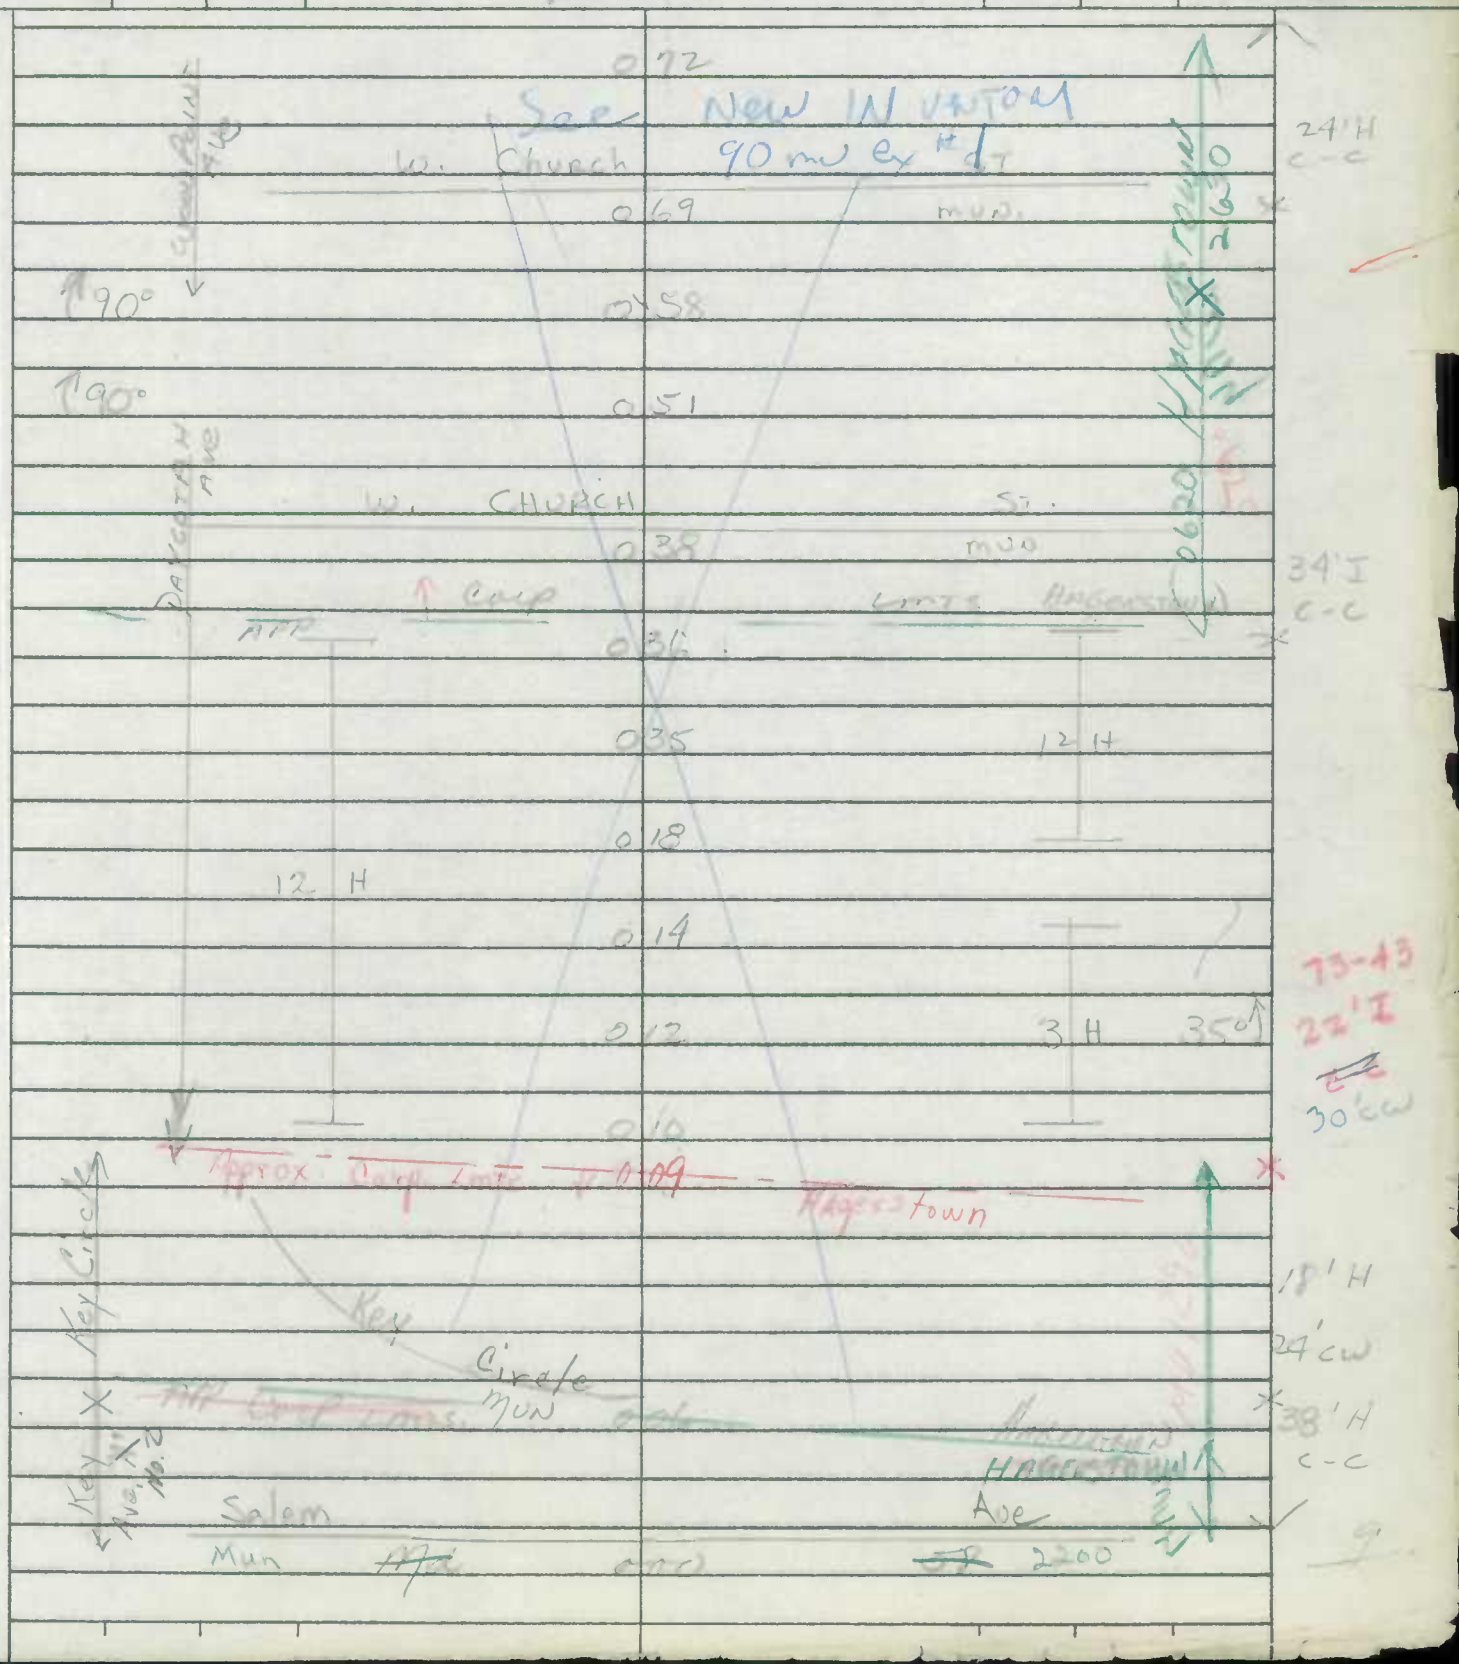

SHA 51.3-8
11-15-72

STATE HIGHWAY ADMINISTRATION OF MARYLAND

ROAD INVENTORY SHEET

Party Chief NS
Recorder CM
Helper

Map No.

Road No. MUN. 0625
Road Name DELAWARE LN
Sheet No. 1 OF 1
Date 5-4-83
County WASHINGTON
State Coordinates

82 - EXTRA

NW

KEY		AVE	KEY	Circle
MUN	1282	015	MUN	1290
		012		
		008		
		004		
SALEM			AVE	
MU		000	2200	

WANDA AVE 2480 MU

SCHOOL PLAYGROUND

90°

WANDA AVE MU 2480

10°

25 I JC-C

38 I JC-C

SHA 51.3-8
11-15-72

ROAD INVENTORY SHEET

Road No. _____
Road Name _____
Sheet No. _____
Date _____
County _____
State Coordinates _____

Form 6 HPS (Rev. 1961)

MUN. No. 0660

OP 139

ROAD INVENTORY SHEET

Party Chief R. VOUGHT

Recorder L. COFFELT JR.

Chainman

COPY 12/9/63

VER 7-14-76

Road No. CO 384

Name DIVISION AVE

Sheet No. 1 OF 1

Date 9 - 17 - 63

County WASHINGTON

92-7 A/T

SECURITY CO MU	021	Rd. 2210 ~~398~~	
PARK APP CORP MU 1945	015	LIMITS OF HAGERSTOWN CO ~~1945~~ RD 380	
ALLEY 219 HAGERSTOWN ~~MUN~~ CO OP 221	011		
MEDWAY CO MUN	008	Rd. 381	
Alley OP ~~220~~	004	# 220 ~~222~~ C.08	
INTERVAL CO MUN	000	RD 382	

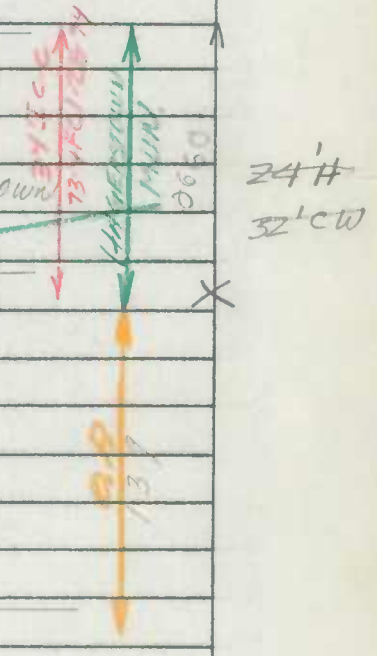

Form 6 HPS (Rev. 1961)

90-7
3-8-91
GD/TM
A/T

ROAD INVENTORY SHEET

Party Chief R. Vought
Recorder L. Coffelt, Jr.
Chainman

VER
7-15-76

Road No. 0690
Name East Ave.
Sheet No. 1 of 1
Date 11-4-63
County Wash.

SNI
FCR-97
GD. MP
11/13/97

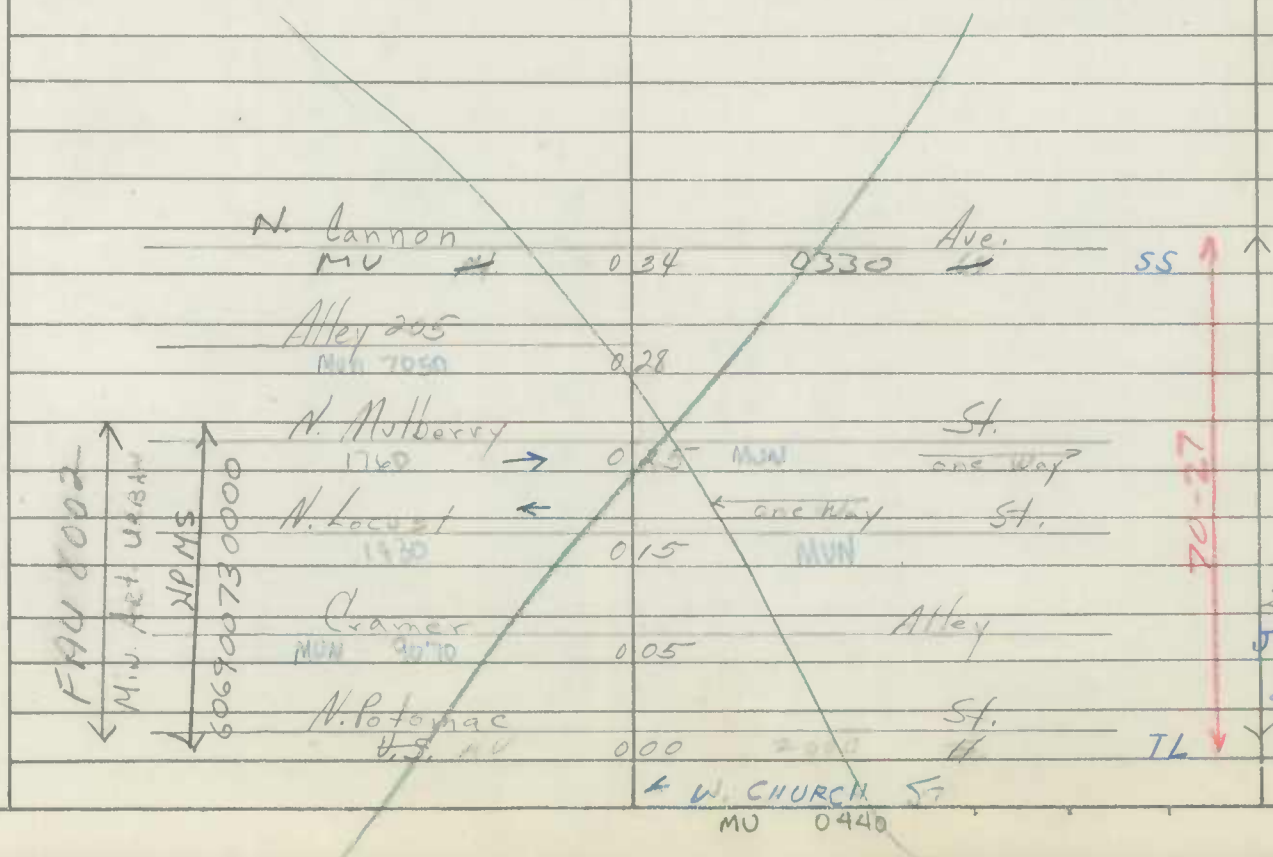

SHA 51.3 - 8 Revised
4.83

MARYLAND STATE HIGHWAY ADMINISTRATION

95-9,-11
11-7-95
GD/TM

ROAD INVENTORY SHEET

INGLESTOWN

86-1/3

Party Chief CB
Recorder AL
Assistant
Map No./Dir. 18 N
State Coordinates

Road No. MUN 0705
Road Name EASTERN BLVD
County WASHINGTON
Date 4-13-87
Sheet No. 1 OF X 2

TRAFFIC CODES
TRAFFIC CONTROLS: STOP SIGN=SS, TRAFFIC LIGHT=T.L., FLASHING RED BALL=F.R.

TRAFFIC CODES
PARKING RESTRICTIONS: A.M. PEAK, P.M. PEAK, A.M./P.M. PEAK, NO PARKING ANYTIME=N.P., COMM/IND. ACCESS=E

SYSTEM				TRAFFIC		LINE DIAGRAM	TRAFFIC			PAVEMENT DATA
FED. AID.	FUNCT CLASS.	HWY. SYS.	HPMS SAMPLE	PRKG. REST.	COM/IND. ACCESS		CONTROL	COM/IND. ACCESS	PRKG. REST.	
						24 I RT				
						12' I LT				
						5' Grs Med				
						J C C 3 ML C				
						SEE NEW	TL	X		
						INV. MUN 505 11/20/95				36'
						COMBINED		E	X	J C C 2 ML
				E		WITH			X	
				E		MU 707				33' I J C C 2 ML
						ALLEY 125 MUN. 6250			X	
						U.S. 40 ALT. Frederick ST.	TL		X	23' I J C C 2 ML

LINE DIAGRAM

SYSTEM: FED. AID. | FUNCT. CLASS. | HWY. SYS. | HPMS SAMPLE

TRAFFIC: PRKG. REST. | COM/IND ACCESS

TRAFFIC: CONTROL | COM/IND ACCESS | PRKG. REST.

PAVEMENT DATA

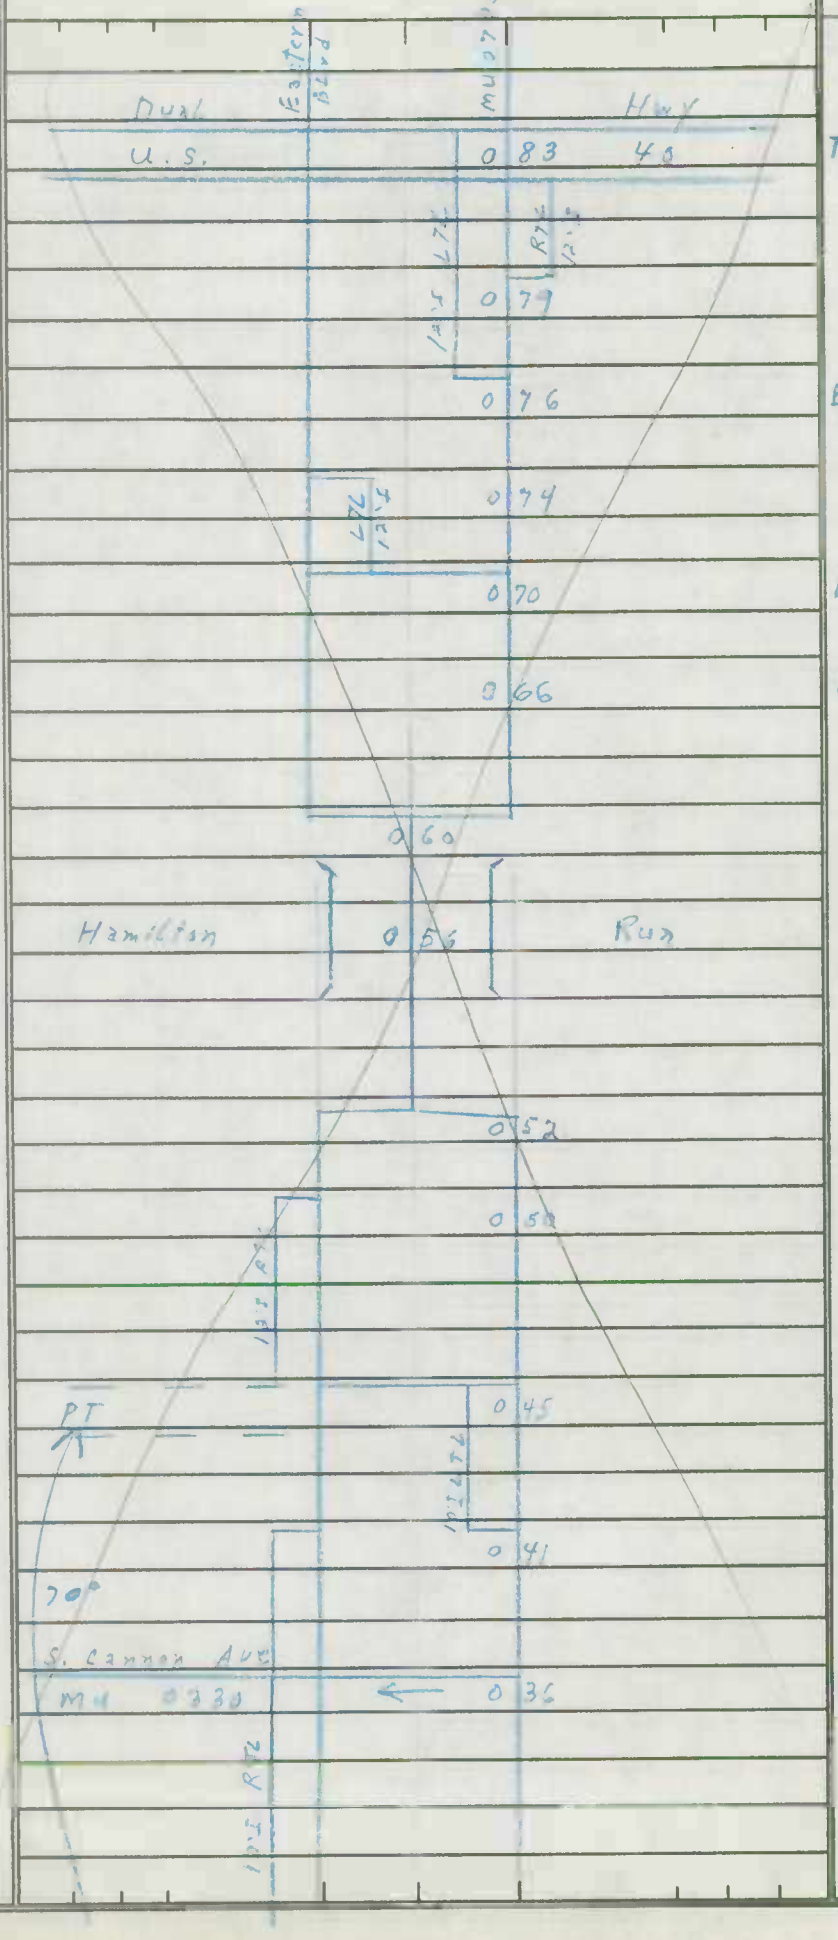

12' I RT
24' I LT
5' Grs Med
J c-c
3 ML

2-12' I
15' Grs Med
J c-c
2 ML

2-12' I
15' I Pnt Med
J-c RT
Grnd LT
2 ML

24' I
J c-c
2 ML

2-24' I
15' I Pnt Med
J c-c
4 ML

2-24' I
15' Grs Med
J c-c
4 ML

24' I RT
12' I LT
5' Grs Med
J c-c
3 ML

SHA 51.3 - 8 Revised
4.83

MARYLAND STATE HIGHWAY ADMINISTRATION

HAGERSTOWN

ROAD INVENTORY SHEET

Party Chief CB
Recorder KP
Assistant
Map No./Dir. A-8 / W
State Coordinates 604 - 665

Road No. MUN. 0706
Road Name EASTERN BLVD
County WASHINGTON
Date 6-17-97
Sheet No. 1 OF 1

SYSTEM: FED. AID. | FUNCT. CLASS. | HWY. SYS. | HPMS SAMPLE
TRAFFIC: PRKG. REST. | COM/IND. ACCESS

LINE DIAGRAM

SNI
FCR-97
10/31/97
6D MD

NORTHERN AVE
MAIN ST
PATTERSON AVE
MD 2000
0.36
MD 60
0.34H
0.33
0.32
MOLLER PKWY
MU. 1720
0.30
TRAFFIC LIGHTS
0.00
HAGERSTOWN
FAU 8020
URBAN MINOR ARTERIAL

TRAFFIC: CONTROL | COM/IND. ACCESS | PRKG. REST.

PAVEMENT DATA
24 I
2 LANE
44 CMD
2 ML

TRAFFIC CODES
TRAFFIC CONTROLS: STOP SIGN=SS, TRAFFIC LIGHT=T.L., FLASHING RED BALL=F.R.

TRAFFIC CODES
PARKING RESTRICTIONS: A.M. PEAK, P.M. PEAK, A.M./P.M. PEAK, NO PARKING ANYTIME=N.P., COMM/IND. ACCESS=E

SYSTEM				TRAFFIC		LINE DIAGRAM	TRAFFIC			PAVEMENT DATA
FED. AID.	FUNCT. CLASS.	HWY. SYS.	HPMS SAMPLE	PRKG. REST.	COM/IND ACCESS		CONTROL	COM/IND ACCESS	PRKG. REST.	

SHA 51.3 - 8 Revised
4.83

MARYLAND STATE HIGHWAY ADMINISTRATION

ROAD INVENTORY SHEET

Party Chief GD
Recorder TM
Assistant
Map No./Dir. 1 N
State Coordinates HAGERSTOWN

Road No. MU 0707
Road Name EASTERN BLVD
County WASHINGTON
Date 3-12-91
Sheet No. 3 OF 3

TRAFFIC CODES
TRAFFIC CONTROLS: STOP SIGN=SS, TRAFFIC LIGHT=T.L., FLASHING RED BALL=F.R.

TRAFFIC CODES
PARKING RESTRICTIONS: A.M. PEAK, P.M. PEAK, A.M./P.M. PEAK, NO PARKING ANYTIME=N.P., COMM/IND. ACCESS=E

SYSTEM				TRAFFIC		LINE DIAGRAM	TRAFFIC			PAVEMENT DATA
FED. AID.	FUNCT CLASS.	HWY. SYS.	HPMS SAMPLE	PKG. REST.	COM/IND. ACCESS		CONTROL	COM/IND. ACCESS	PKG. REST.	
						EASTERN BLVD				
						JEFFERSON BLVD				
						MD 64	TL			
						0 90				
						SPUR 0.10 / 1P'L JCT				
						0 88 RTE		E		
						0 86				
						0 85		E		
										48'I
										JC-C
						0 84 RTE				2 ML
					E	TO BUSINESS 0 83			X	
						0 81				
						BY PASS RTE 0 79 ENT. TO OIC CO		E		24'I
						0 77				10'I SHD LT
										12'I SHD RT
										2 ML

FAP 226
DRB OTHER PRINCIPAL ART.

SYSTEM				TRAFFIC		LINE DIAGRAM	TRAFFIC			PAVEMENT DATA
FED. AID.	FUNCT. CLASS.	HWY. SYS.	HPMS SAMPLE	PRKG. REST.	COM/IND ACCESS		CONTROL	COM/IND ACCESS	PRKG. REST.	

SHA 51.3-8
11-15-72

STATE HIGHWAY ADMINISTRATION OF MARYLAND

ROAD INVENTORY SHEET MU. 0710

85-extra BT BC AT 3-13-86

Party Chief M. BAXTER - OFF. INV.
Recorder
Helper

Map No. 22 VER.

Road No. Co. 316
Road Name EDGEWOOD RD
Sheet No. 1 OF 2
Date 9-12-63 REVISED 5-16-74
County WASHINGTON
State Coordinates 608 - 652

90-20 3-12-91 GD/TM

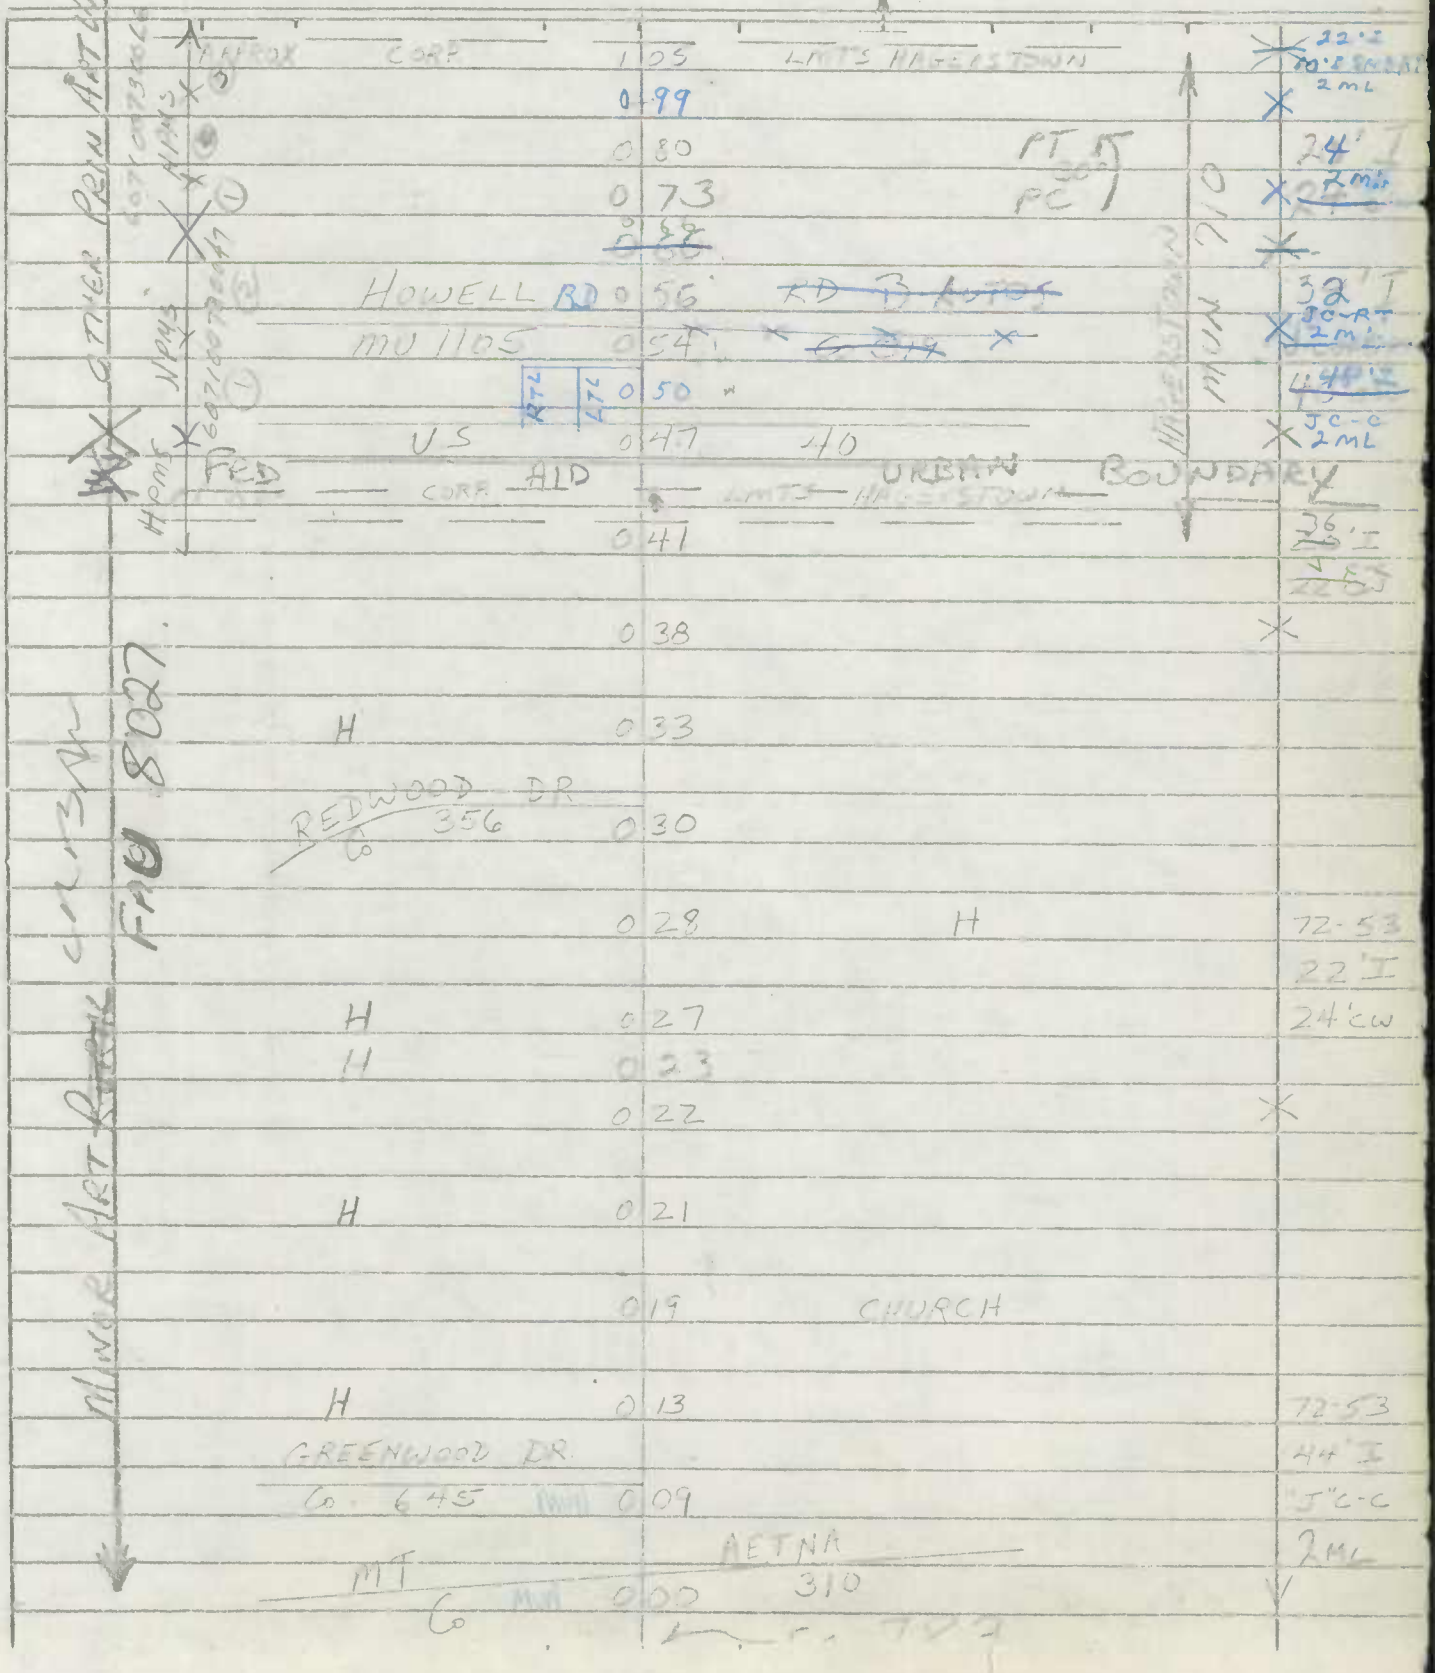

11-15-72

ROAD INVENTORY SHEET

Road No. C. 316
Road Name
Sheet No. 2 OF 2
Date
County WASHINGTON
State Coordinates

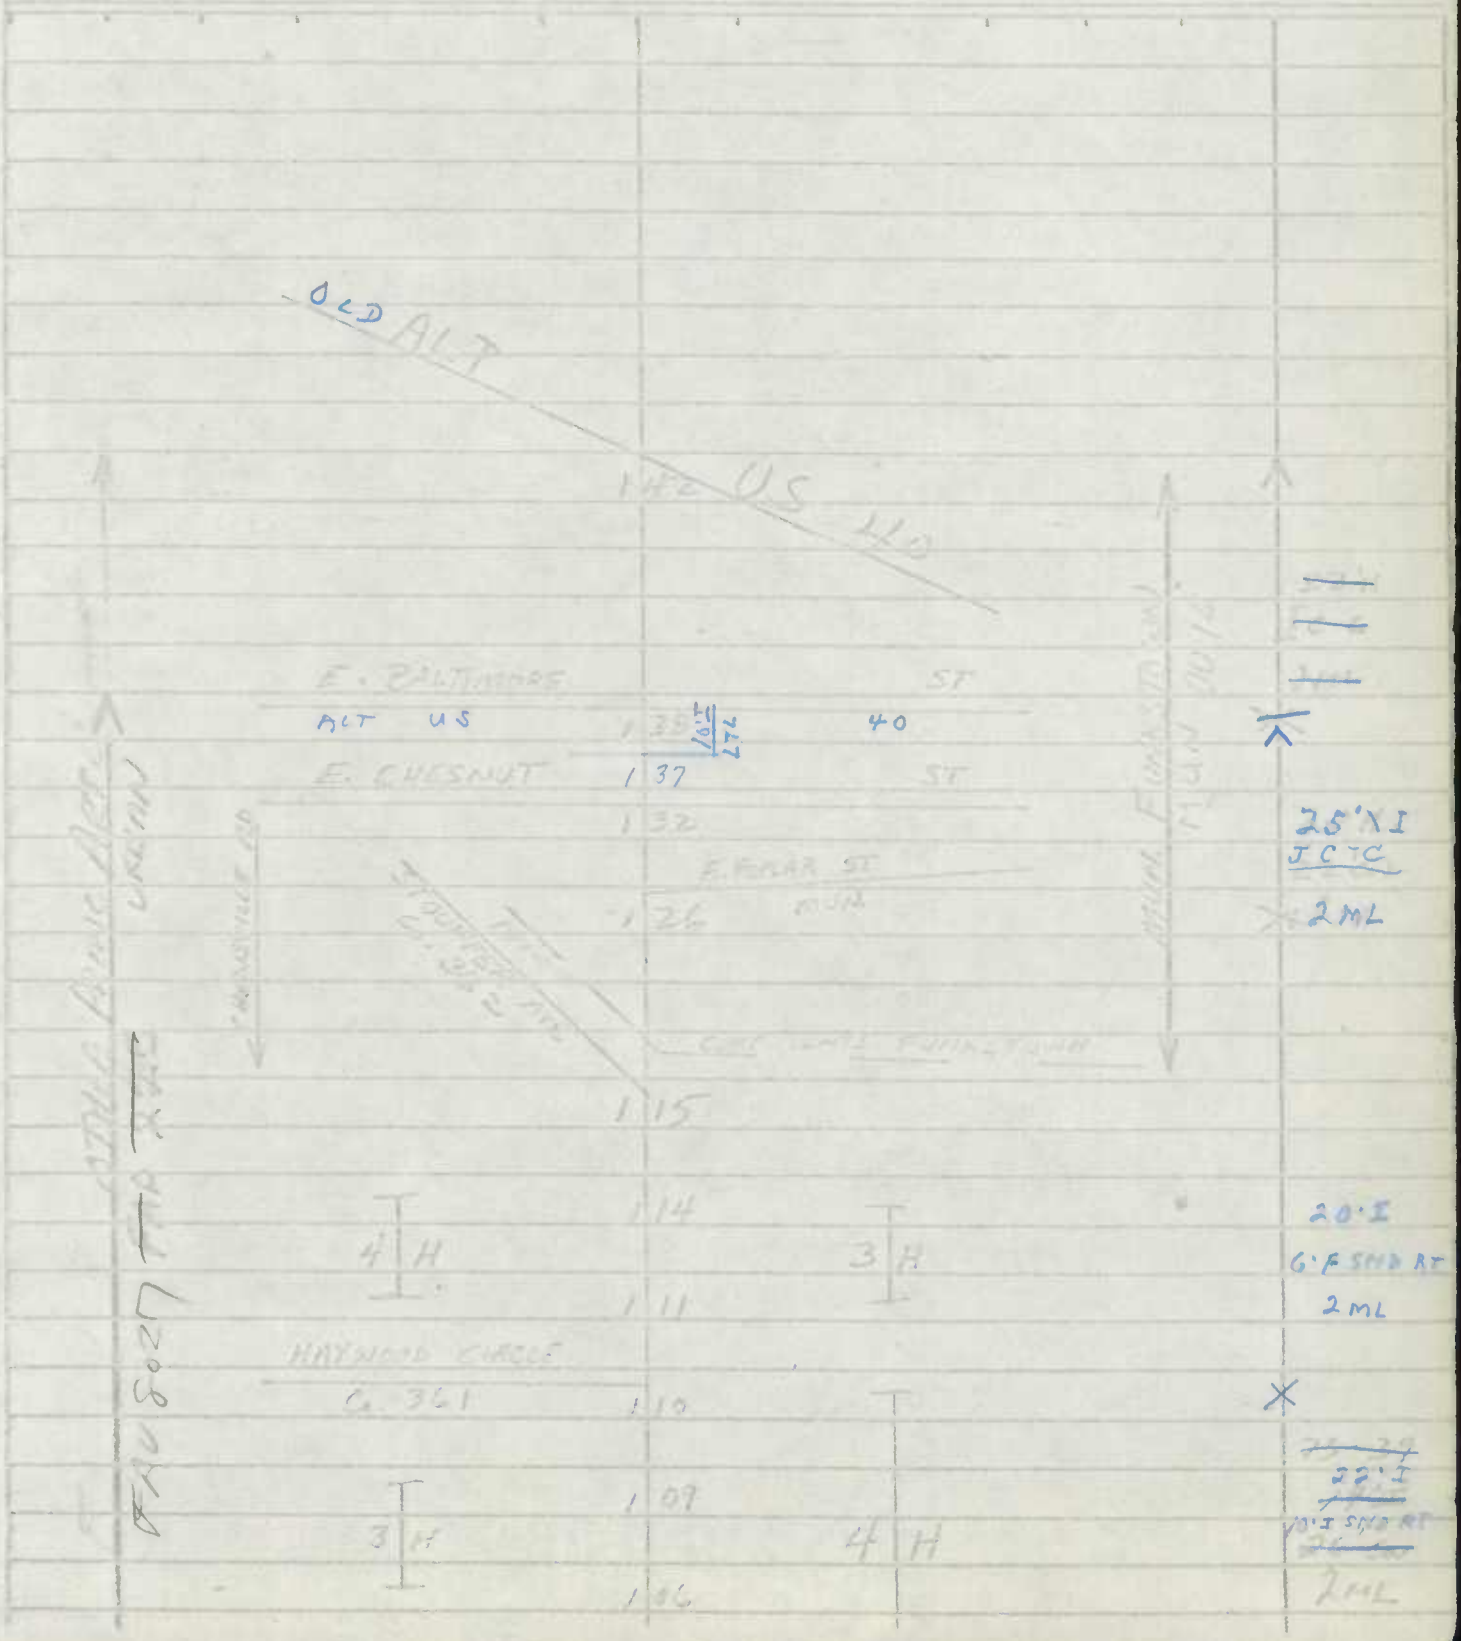

SHA 51.3 - 8 Revised
4.83

MARYLAND STATE HIGHWAY ADMINISTRATION
HAGERSTOWN
ROAD INVENTORY SHEET

92-15
BB-AH
4-1-93

Party Chief E. Schuyler
Recorder L. Dombroski
Assistant Rewritten 4-19-88 KJP
Map No./Dir. 1 S
State Coordinates

Road No. MUN 0720
Road Name ELGIN BLVD
County Washington
Date 4-30-79
Sheet No. 1 OF 1

TRAFFIC CODES
TRAFFIC CONTROLS: STOP SIGN=S.S., TRAFFIC LIGHT=T.L., FLASHING RED BALL=F.R.

TRAFFIC CODES
PARKING RESTRICTIONS: A.M. PEAK, P.M. PEAK, A.M./P.M. PEAK, NO PARKING ANYTIME=N.P., COMM/IND. ACCESS=E

SYSTEM: FED. AID. | FUNCT CLASS. | HWY. SYS. | HPMS SAMPLE
TRAFFIC: PRKG. REST. | COM/IND. ACCESS
LINE DIAGRAM
TRAFFIC: CONTROL | COM/IND. ACCESS | PRKG. REST.
PAVEMENT DATA

FAU 2013
URBAN MINOR ARTERIAL
HPMS-160720273 0000

JNT
EB
GD MP
11/1/.7

BLVD
US 11
SPUR

BURHANS
US 11
0 16
LANVALE ST.
MUN 1340

30'I

0 14

0 09

ALLEY # 73
MUN 5730
0 05

COURT ALLEY
0 03
MUN 9060

38'I
J c-c

W. WASHINGTON ST.
MUN.
0 00
2500

SYSTEM				TRAFFIC		LINE DIAGRAM	TRAFFIC			PAVEMENT DATA
FED. AID.	FUNCT. CLASS.	HWY. SYS.	HPMS SAMPLE	PRKG. REST.	COM/IND ACCESS		CONTROL	COM/IND ACCESS	PRKG. REST.	

Form 6 HPS (Rev. 1961)

ROAD INVENTORY SHEET

Party Chief E. SCHUYLER
Recorder I. DOMBROSKI
Helper

VER 7-14-76

Road No. 0720
Road Name ELGIN BLVD
Sheet No. 1 OF 1
Date 4-30-71
County WASHINGTON

79-16

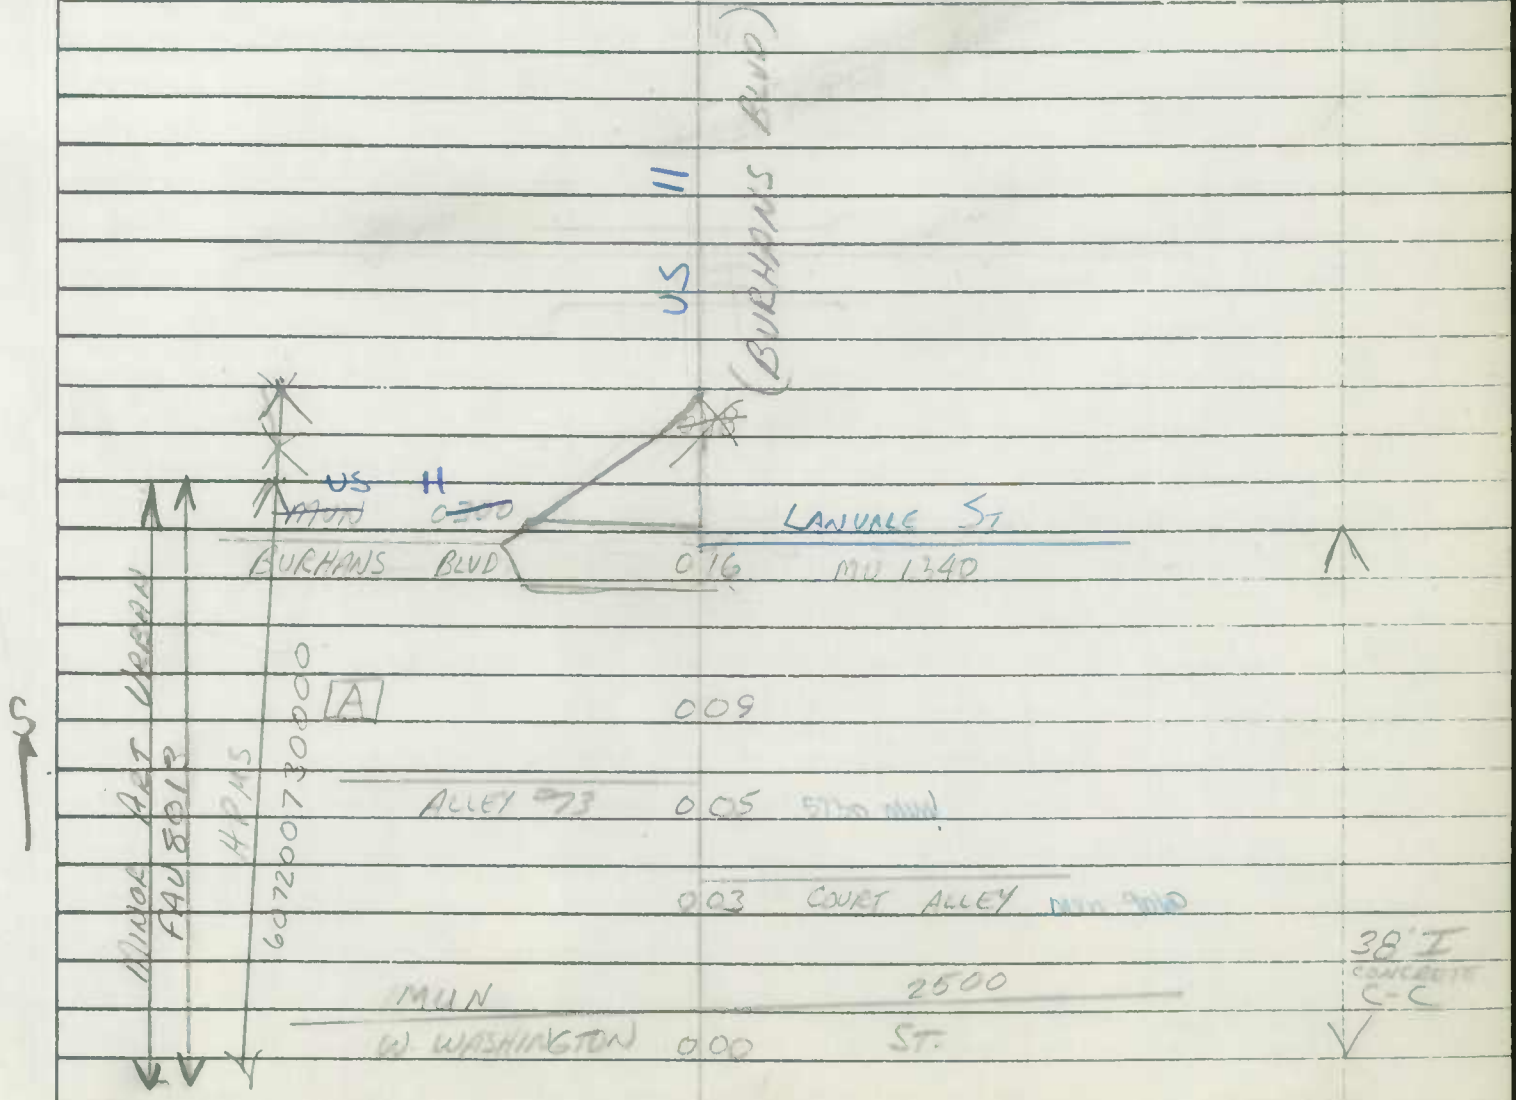

Form 6 HPS (Rev. 1961)

ROAD INVENTORY SHEET

Road No. _____
Road Name _____
Sheet No. _____
Date _____
County _____

Form 6 HPS (Rev. 1961)

AT

4

ROAD INVENTORY SHEET

Party Chief R. VOUGHT
Recorder L. COFFELT JR.
Chairman

VER 7-15-76

HAGERSTOWN

Road No. 0780
Name FAIRGROUND AVE.
Sheet No. 1 OF 1
Date 10-31-63
County WASHINGTON

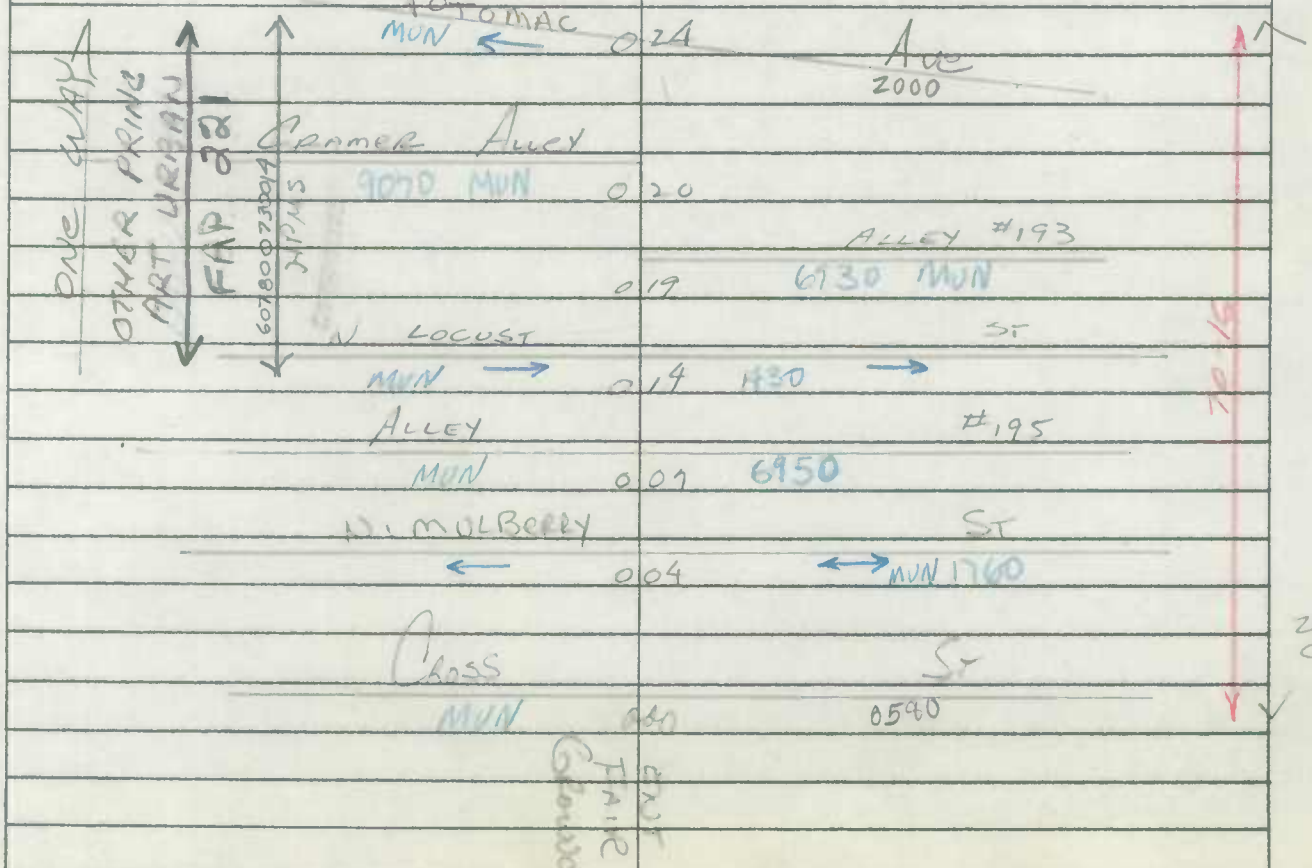

SHA 51.3 - 8 Revised
4.83

MARYLAND STATE HIGHWAY ADMINISTRATION

ROAD INVENTORY SHEET

CO 1074
~~OP 230~~

(89-29,40)
90-22
3-6-91
SD/TM
A/T

Party Chief DT
Recorder CG
Assistant
Map No./Dir. A-8 I S
State Coordinates 610 - 650

Road No. MU 0785
Road Name FAIRMEADOWS BLVD.
County WASHINGTON
Date 2/1/90
Sheet No. 1 OF 2

TRAFFIC CODES

TRAFFIC CONTROLS: STOP SIGN=SS, TRAFFIC LIGHT=T.L., FLASHING RED BALL=F.R.

TRAFFIC CODES

PARKING RESTRICTIONS: A.M. PEAK, P.M. PEAK, A.M./P.M. PEAK, NO PARKING ANYTIME=N.P., COMM/IND. ACCESS=E

SYSTEM				TRAFFIC		LINE DIAGRAM	TRAFFIC			PAVEMENT DATA
FED. AID.	FUNCT CLASS	HWY SYS	HPMS SAMPLE	PKG. REST.	COM/IND. ACCESS		CONTROL	COM/IND. ACCESS	PKG. REST.	
						054 PT				
						70°				
						044 PC				
						PT 037				
						90°				
						PC 020				
						LONDONTOWNE CIR. N				20'I
						TPROP.T 027 TPROP.T				2-3'E SHD
										2 UML
						025			X	
						024 SIGN: "END CO MAINT."				
						30° 009				
						CO 1074				30'I
										2 UML
						N CO METAL 000	SS			
						RD. 310				

SYSTEM				TRAFFIC		LINE DIAGRAM	TRAFFIC			PAVEMENT DATA
FED. AID.	FUNCT. CLASS.	HWY. SYS.	HPMS SAMPLE	PRKG. REST.	COM/IND ACCESS		CONTROL	COM/IND ACCESS	PRKG. REST.	
						ROAD 061 END				
						WINSTON MU 055 2605 (89-28) DR	55			20'I 2-3'E SHD 2 UML

Form 6 HPS (Rev. 1961)

ROAD INVENTORY SHEET

Party Chief R. Vought
Recorder C. Coffelt, Jr.
Chainman

VER
7-20-76

Road No. 0832
Name Forest St. - Rt. 2
Sheet No. 1 of 1
Date 11-4-63
County Wash

71-7

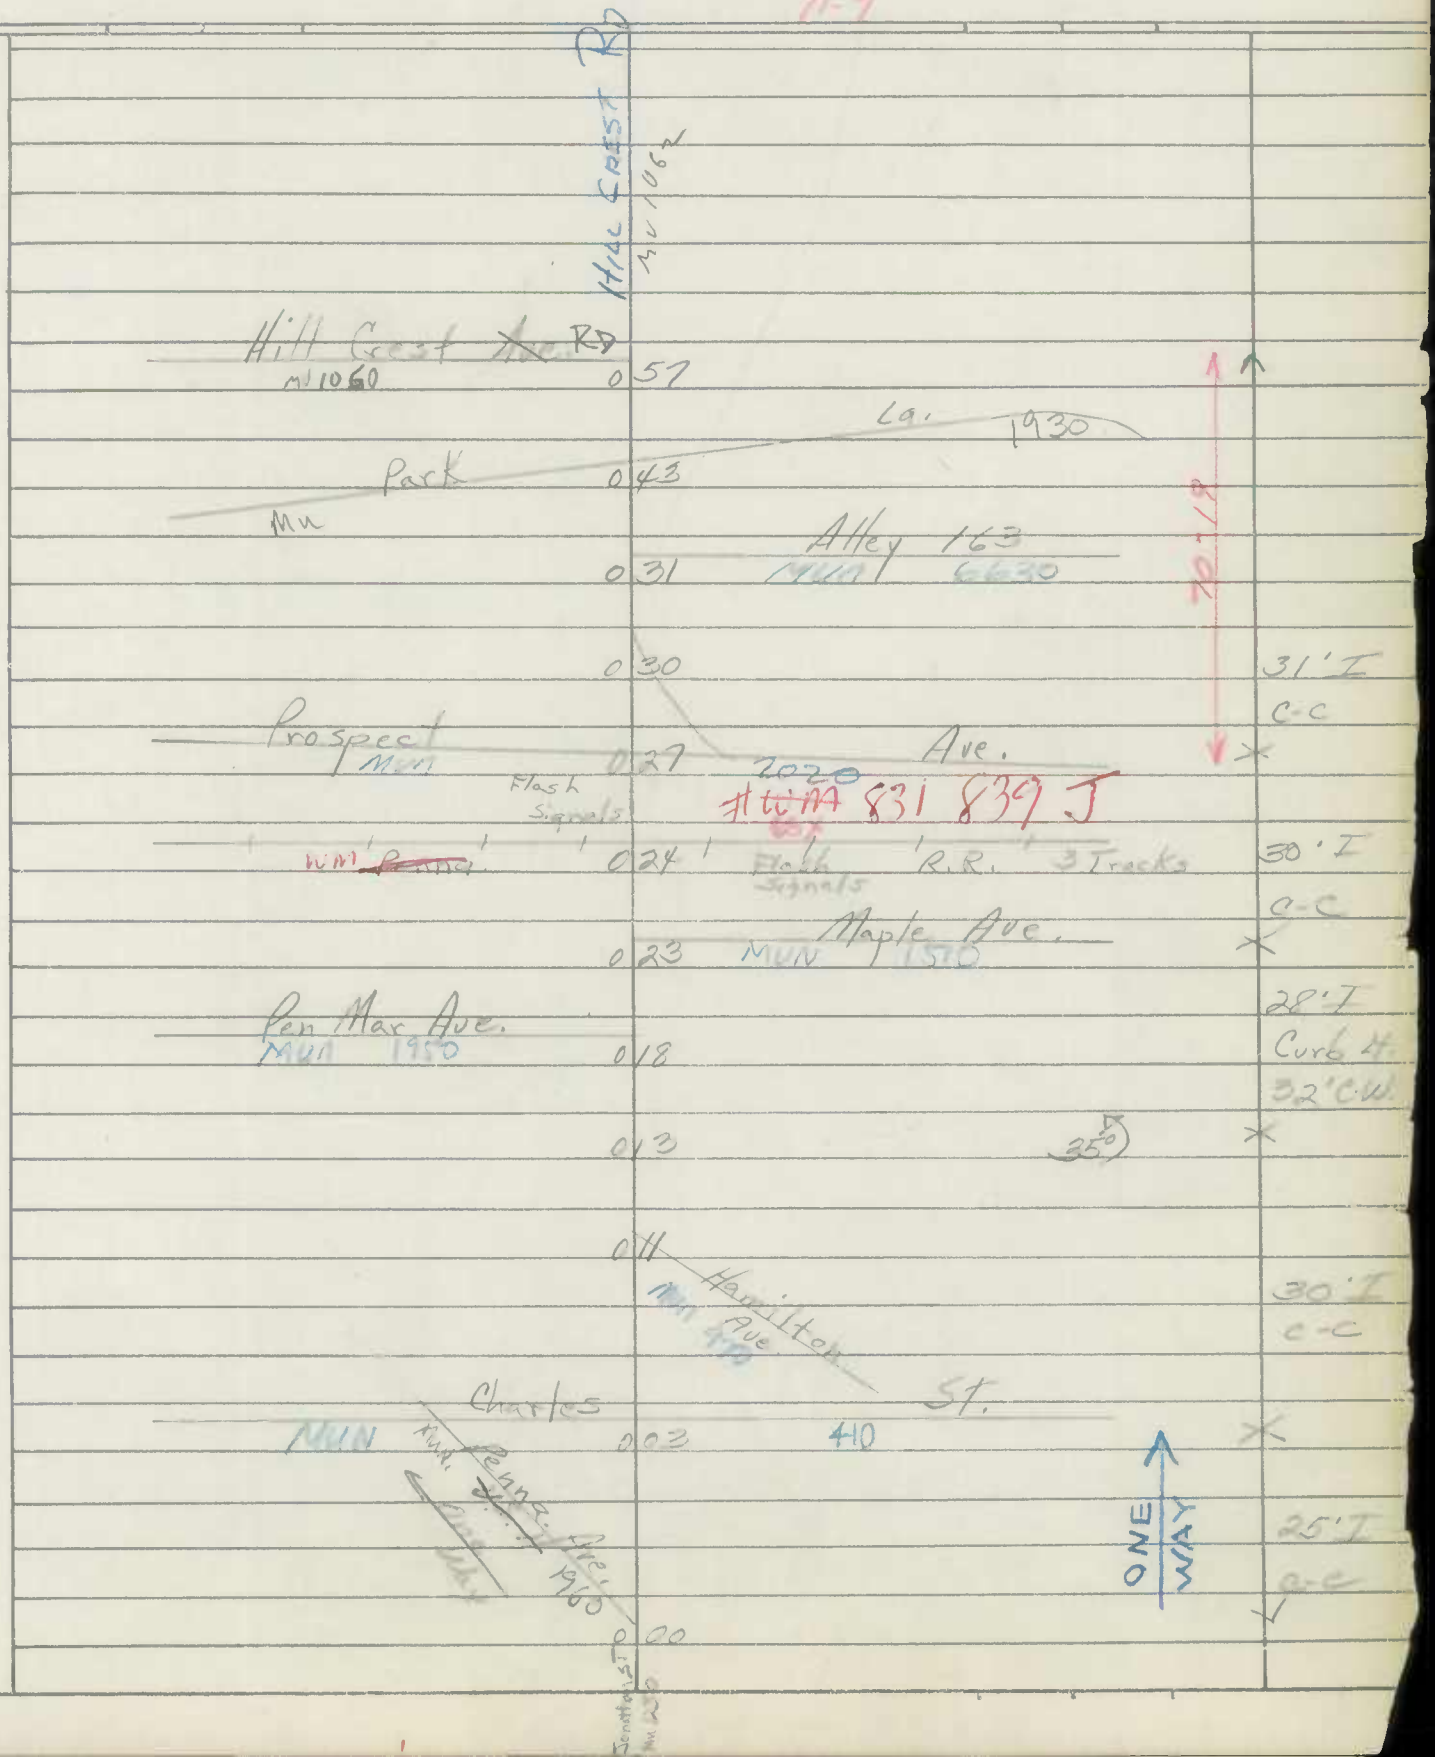

Form 6 HPS (Rev. 1961)

P9-77 AT

ROAD INVENTORY SHEET

Party Chief R. Vought
Recorder L. Cotterell, Jr
Chainman

VCR 7-20-76

Road No. ~~C950~~
Name Frederick St.
Sheet No. 1 of 2
Date 10-21-63
County Wash.

7249

Wilson Circle
MUN 2550

1 03

Ravenswood Dr.
MUN 2010

1 00

E. FIRST ~~Lombard St.~~ St.
0 93 MUN 0800

Commonwealth Ave.
MUN 510

0 75

Hagerstown Mun. Swim. Pool

0 71

B&O

#B0 139 499U

0 66

Bixler Ave.
MUN 1170

0 62

Taylor Ave.
0 56 MUN 2350

Alley 91
0 53 MUN 5510

Rowland
← to Savage MUN

0 47 2170 Ave.

Memorial
MUN 1650

0 35 Md. East

Mill St.
MUN 1670

0 29

0 20

E. Baltimore St.
MUN 150

Hager
MUN 150

265

0 07 MUN 7650

Alley
MUN

0 00 1760 St.

OTHER PRINC ART URBAN
FAU 8003

69-14

THROUGH MUNICIPALITY

44'I
44'C-C

38'I
C-C

5

Form 6·HPS (Rev. 1961)

ROAD INVENTORY SHEET

Party Chief R. Vaught
Recorder C. Coffelt, Jr.
Chainman

Road No.
Name Frederick St.
Sheet No. 2 of 2
Date 10-21-63
County Wash.

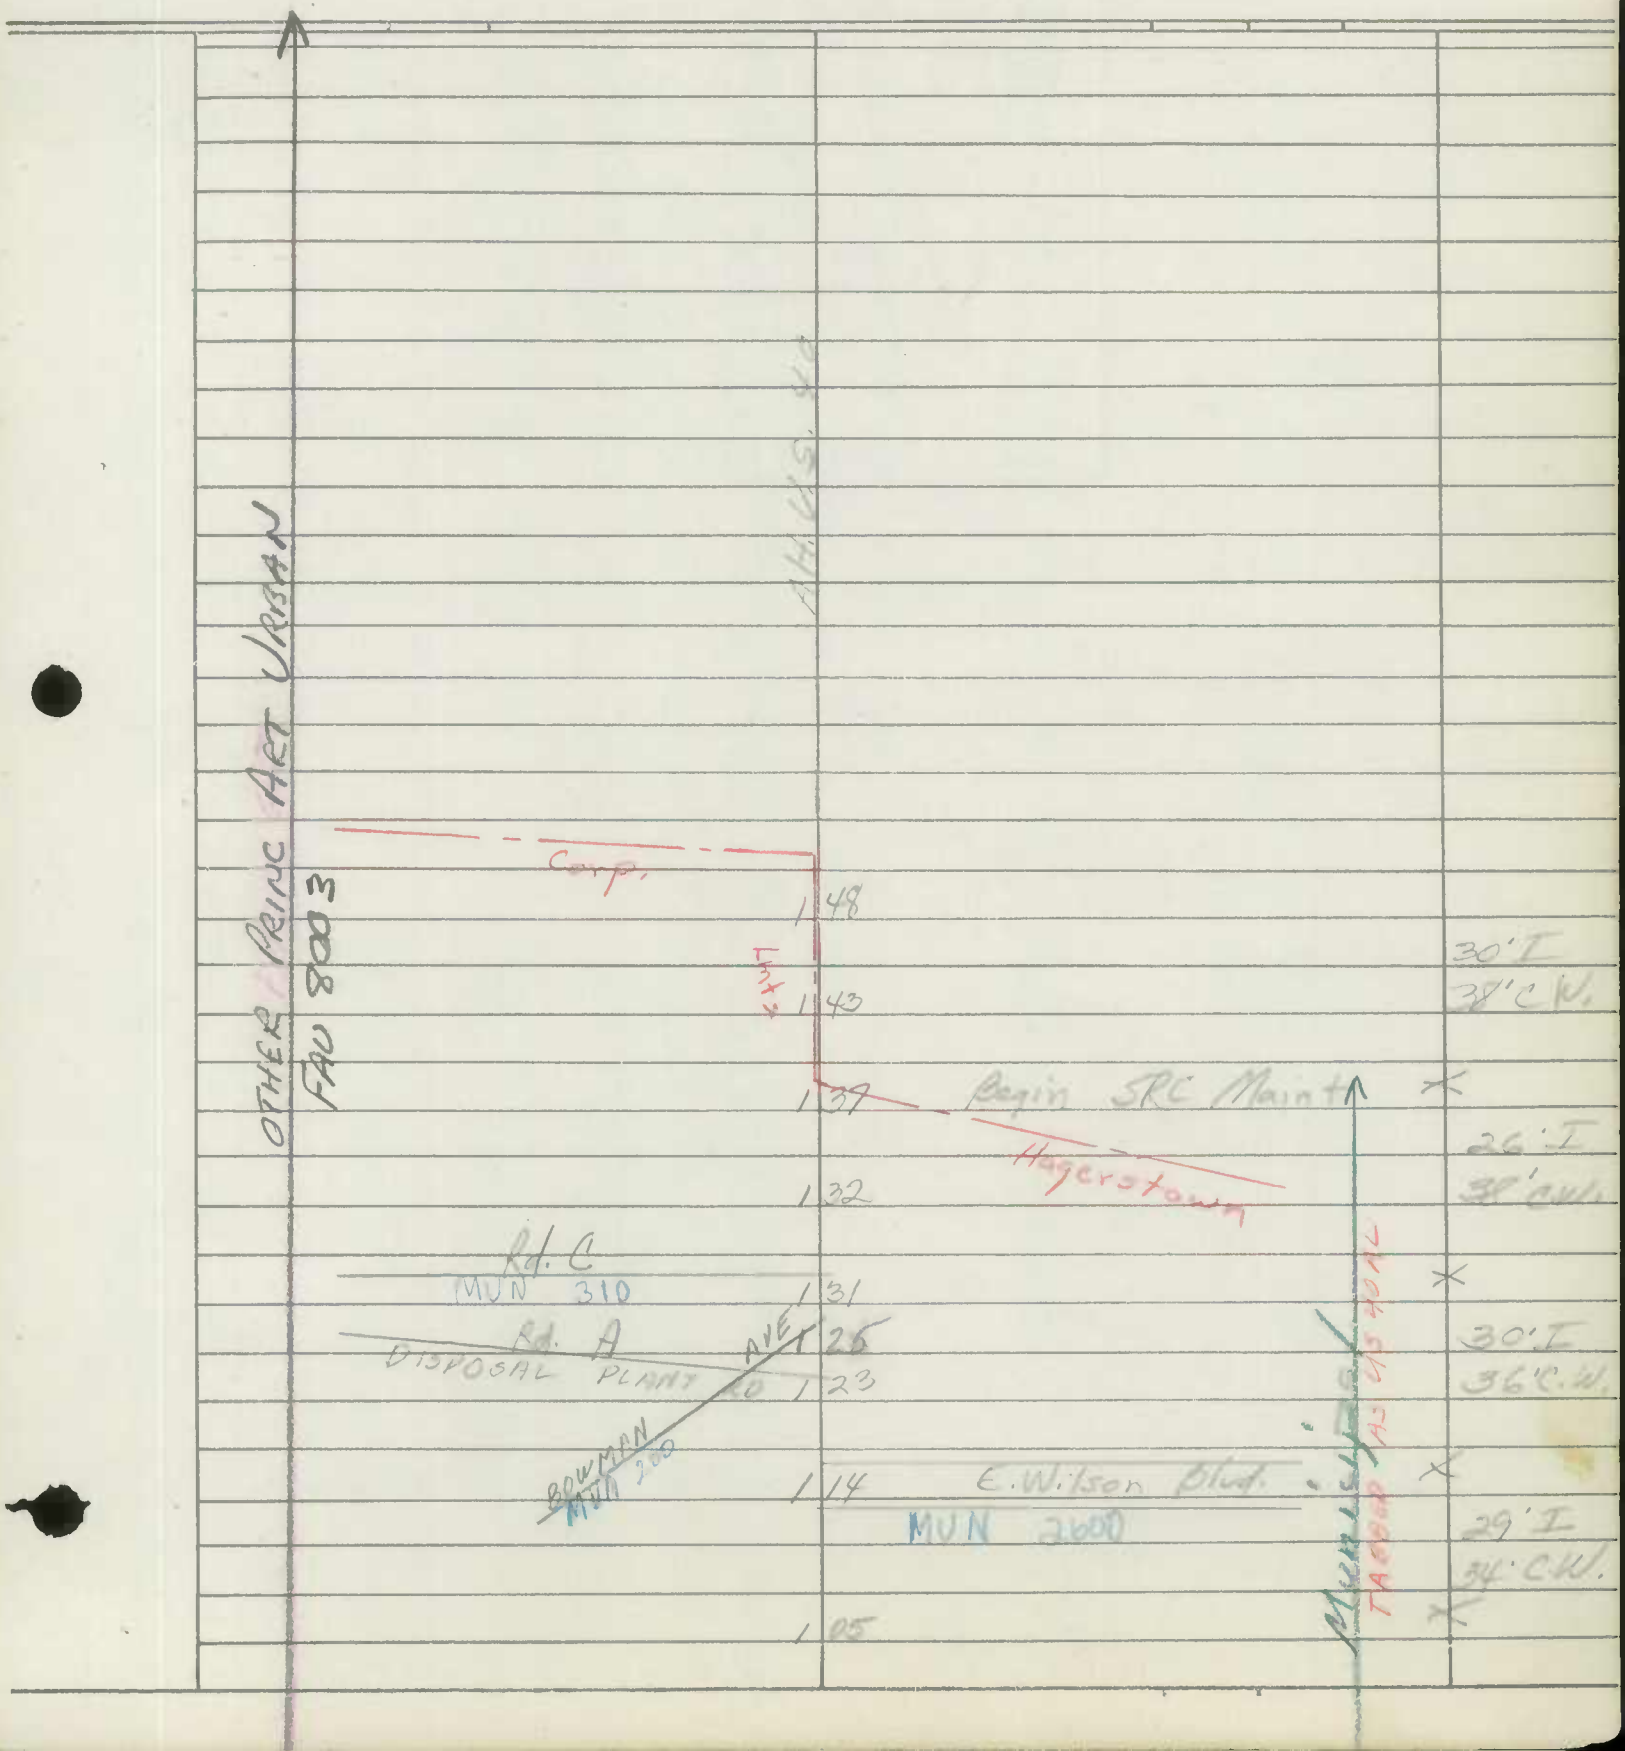

Form 6 HPS (Rev. 1961)

P9-77 AT

ROAD INVENTORY SHEET

Party Chief R. VOUGHT
Recorder L. COEFELT JR.
Chainman

VER 7-13-76

HAGERSTOWN

Road No. 0920
Name GEORGIA AVE
Sheet No. 1 OF 1
Date 10-28-63
County WASHINGTON

WELLINGTON ~~TERRACE~~	MU	041	DR ~~AVE #2~~ 2545 ~~2412~~
130°		026	
STRATFORD	MUN	022	AVE 2270
CENTRAL	MUN	007	AVE 400
ALLEY #83	MUN 5830	003	
LINGANORE	MUN	000	AVE 1420

30' H C-C

Form 6 HPS (Rev. 1961)

ROAD INVENTORY SHEET

Party Chief R. VOUGHT
Recorder L. COFFELT JR.
Chainman

HAGERSTOWN

VER 7-14-76

Road No. 0960
Name HAMILTON BLVD.
Sheet No. 1 of 1
Date 10-30-63
County WASHINGTON

NORTHERN		AVE	
MUN	0.85	MUN	1810
COUNTRY CLUB		RD	
MUN	0.71		560
W. MAGNOLIA		ST	
MUN	0.58		1470
CYPRESS		ST	
MUN	0.52		510
W. IRVIN		AVE	
MUN	0.34		1132
W. HILLCREST		RD	
MUN	0.22		1062
PARK		LA.	
MUN	0.12		1930
PROSPECT		AVE	
MUN	0.24		2020

40' I
C-C

Form 6 HPS (Rev. 1961)

4 AT

ROAD INVENTORY SHEET

Party Chief R. Vought
Recorder L. Coffelt/Vc
Chainman

VER
7-19-76

Road No. 0980
Name Hammond ST.
Sheet No. 1 of 1
Date 10-28-63
County Wash.

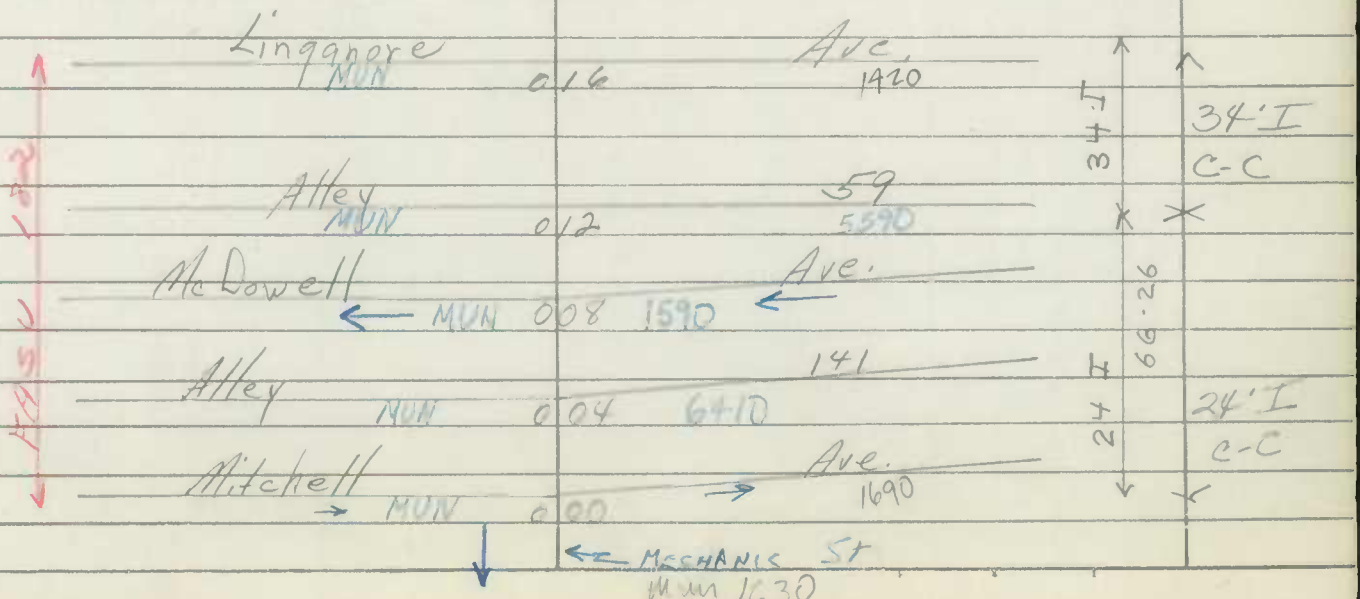

SHA 51.3-8
11-15-72

STATE HIGHWAY ADMINISTRATION OF MARYLAND

ROAD INVENTORY SHEET

Party Chief R. Vought
Recorder L. COFFELT JR.
Helper

Map No.

Road No. 0990
Road Name HARMAN AVE.
Sheet No. 1 of 1
Date 10-31-63
County Washington
State Coordinates

WILLIAMS AVE
MUN 2585

JONATHAN
MUN. — 011 — MUN. ST

ALLEY # 259
MUN 7590 008 8'J 10'CW

SUTER
MUN 000 AL. 9150

SHA 51.3-8
11-15-72

ROAD INVENTORY SHEET

Road No. _____
Road Name _____
Sheet No. _____
Date _____
County _____
State Coordinates _____

SHA 51.3 - 8 Revised
4.83

MARYLAND STATE HIGHWAY ADMINISTRATION
HAGERSTOWN
ROAD INVENTORY SHEET

MU 94-2
BB/AH
12-7-94

93-5,-6

Party Chief AL
Recorder TM
Assistant
Map No./Dir. / N
State Coordinates

Road No. MU 1035
Road Name Highland Ave
County WASHINGTON
Date 3-10-94
Sheet No. 1 OF 1

93-5,6
DT/AL
7-19-94

TRAFFIC CODES
TRAFFIC CONTROLS: STOP SIGN=SS, TRAFFIC LIGHT=T.L., FLASHING RED BALL=F.R.

TRAFFIC CODES
PARKING RESTRICTIONS: A.M. PEAK, P.M. PEAK, A.M./P.M. PEAK, NO PARKING ANYTIME=N.P., COMM/IND. ACCESS=E

SYSTEM				TRAFFIC		LINE DIAGRAM	TRAFFIC			PAVEMENT DATA
FED. AID.	FUNCT CLASS.	HWY. SYS.	HPMS SAMPLE	PRKG. REST.	COM/IND. ACCESS		CONTROL	COM/IND. ACCESS	PRKG. REST.	
						Ent to Museum				
						KEY ST				
						0 40 MU 1300	SS			
										24'I
					E	0 33				JC-C
						0 30				
						019				20'I 2 ML
						009				20'I 2 UL
										20'I I CRB EI 2 UML
						0 403				
										20'I J crb AT 2 UML
						CITY PARK DRIVE				
					E	0 00 MU 1920				
						Highland Way				
						0 40 MU				

SYSTEM				TRAFFIC		LINE DIAGRAM	TRAFFIC			PAVEMENT DATA
FED. AID.	FUNCT. CLASS.	HWY. SYS.	HPMS SAMPLE	PRKG. REST.	COM/IND ACCESS		CONTROL	COM/IND ACCESS	PRKG. REST.	

MACS P9-77

Form 6 HPS (Rev. 1961)

ROAD INVENTORY SHEET

Party Chief R. VOUGHT
Recorder L. COFFELT JR.
Chainman

HAGERSTOWN

VER 7-15-76

Road No. 1050
Name HILLCREST AVE
Sheet No. 1 OF 1
Date 10-28-63
County WASHINGTON

ST. CLAIR			ST
MUN	0.09		2190
ALLEY			135
MUN	0.05	6350	
PENN.			AVE
MU ~~US~~	0.02		1960
BURHANS			
US ~~MUN~~	0.00		BLVD.
ENT SHOP CTR			11 ~~0.00~~
~~0.00~~			ENT SHOP CEN.
~~0.00~~			
ROAD			END

40' I
C-C

~~2 LN~~
~~30 CON~~

Form 6 HPS (Rev. 1961)

ROAD INVENTORY SHEET

Party Chief R. Vought
Recorder L. Coffelt, Jr.
Chainman

VER 7-15-76

Road No. 1062
Name E. & W. Hill Crest Rd. #2
Sheet No. 1 of 1
Date 11-4-63
County Wash.

View	0.59	← St. 2420		
Alley	0.59	150	35'I 66-18	35'I C-C
Mulberry	0.53	Ave.		
Alley	0.50	152	34'I 66-18	34'I C-C
Dewey	0.47	Ave.		
Alley	0.43	154	40'I 66-18	40'I C-C
Potomac	0.38	Ave.		
Alley	0.33	18C		~~25'I~~ ~~C-C~~
Hamilton	0.29	Blvd.		
Alley	0.25	161		
Oak Hill	0.20	Ave.		
	0.19		Pt.	30'I
Alley	0.16	162	30°	C-C ~~26'I~~
	0.15		PC.	~~27'C-C~~
The	0.10	Terrace		
Pt. T	0.08			31'I
P.C. (140° Hill Crest Ave. 1060)	0.00			C-C
		← FOREST ST		

SHA 51.3 - 8 Revised
4.83

MARYLAND STATE HIGHWAY ADMINISTRATION

ROAD INVENTORY SHEET

Party Chief REWRITTEN SM
Recorder
Assistant
Map No./Dir. /
State Coordinates

Road No. MUN 1080
Road Name HOOD ST
County WASHINGTON
Date 10-11-88
Sheet No. 1 OF 1

TRAFFIC CODES
TRAFFIC CONTROLS: STOP SIGN=SS, TRAFFIC LIGHT=T.L., FLASHING RED BALL=F.R.

TRAFFIC CODES
PARKING RESTRICTIONS: A.M. PEAK, P.M. PEAK, A.M./P.M. PEAK, NO PARKING ANYTIME=N.P., COMM/IND. ACCESS=E

SYSTEM				TRAFFIC	
FED. AID.	FUNCT CLASS.	HWY. SYS.	HPMS SAMPLE	PKG. REST.	COM/IND. ACCESS

LINE DIAGRAM

HAGERSTOWN

SNJ
FCR-97
6D MP
SUMMIT
AVE
MU 0 24 2301
11/12/97
0 21
90°
W. BALTIMORE
ST
MU 0 16 0090
0 11
90°
0 02 #CSX 832 384 J
MU LEA
0 00
1360
ST

TRAFFIC			PAVEMENT DATA
CONTROL	COM/IND. ACCESS	PKG. REST.	
			28'I
			CURB LT
			28'I
			32'CW
			18'H
			22'CW
			32'H
			36'CW

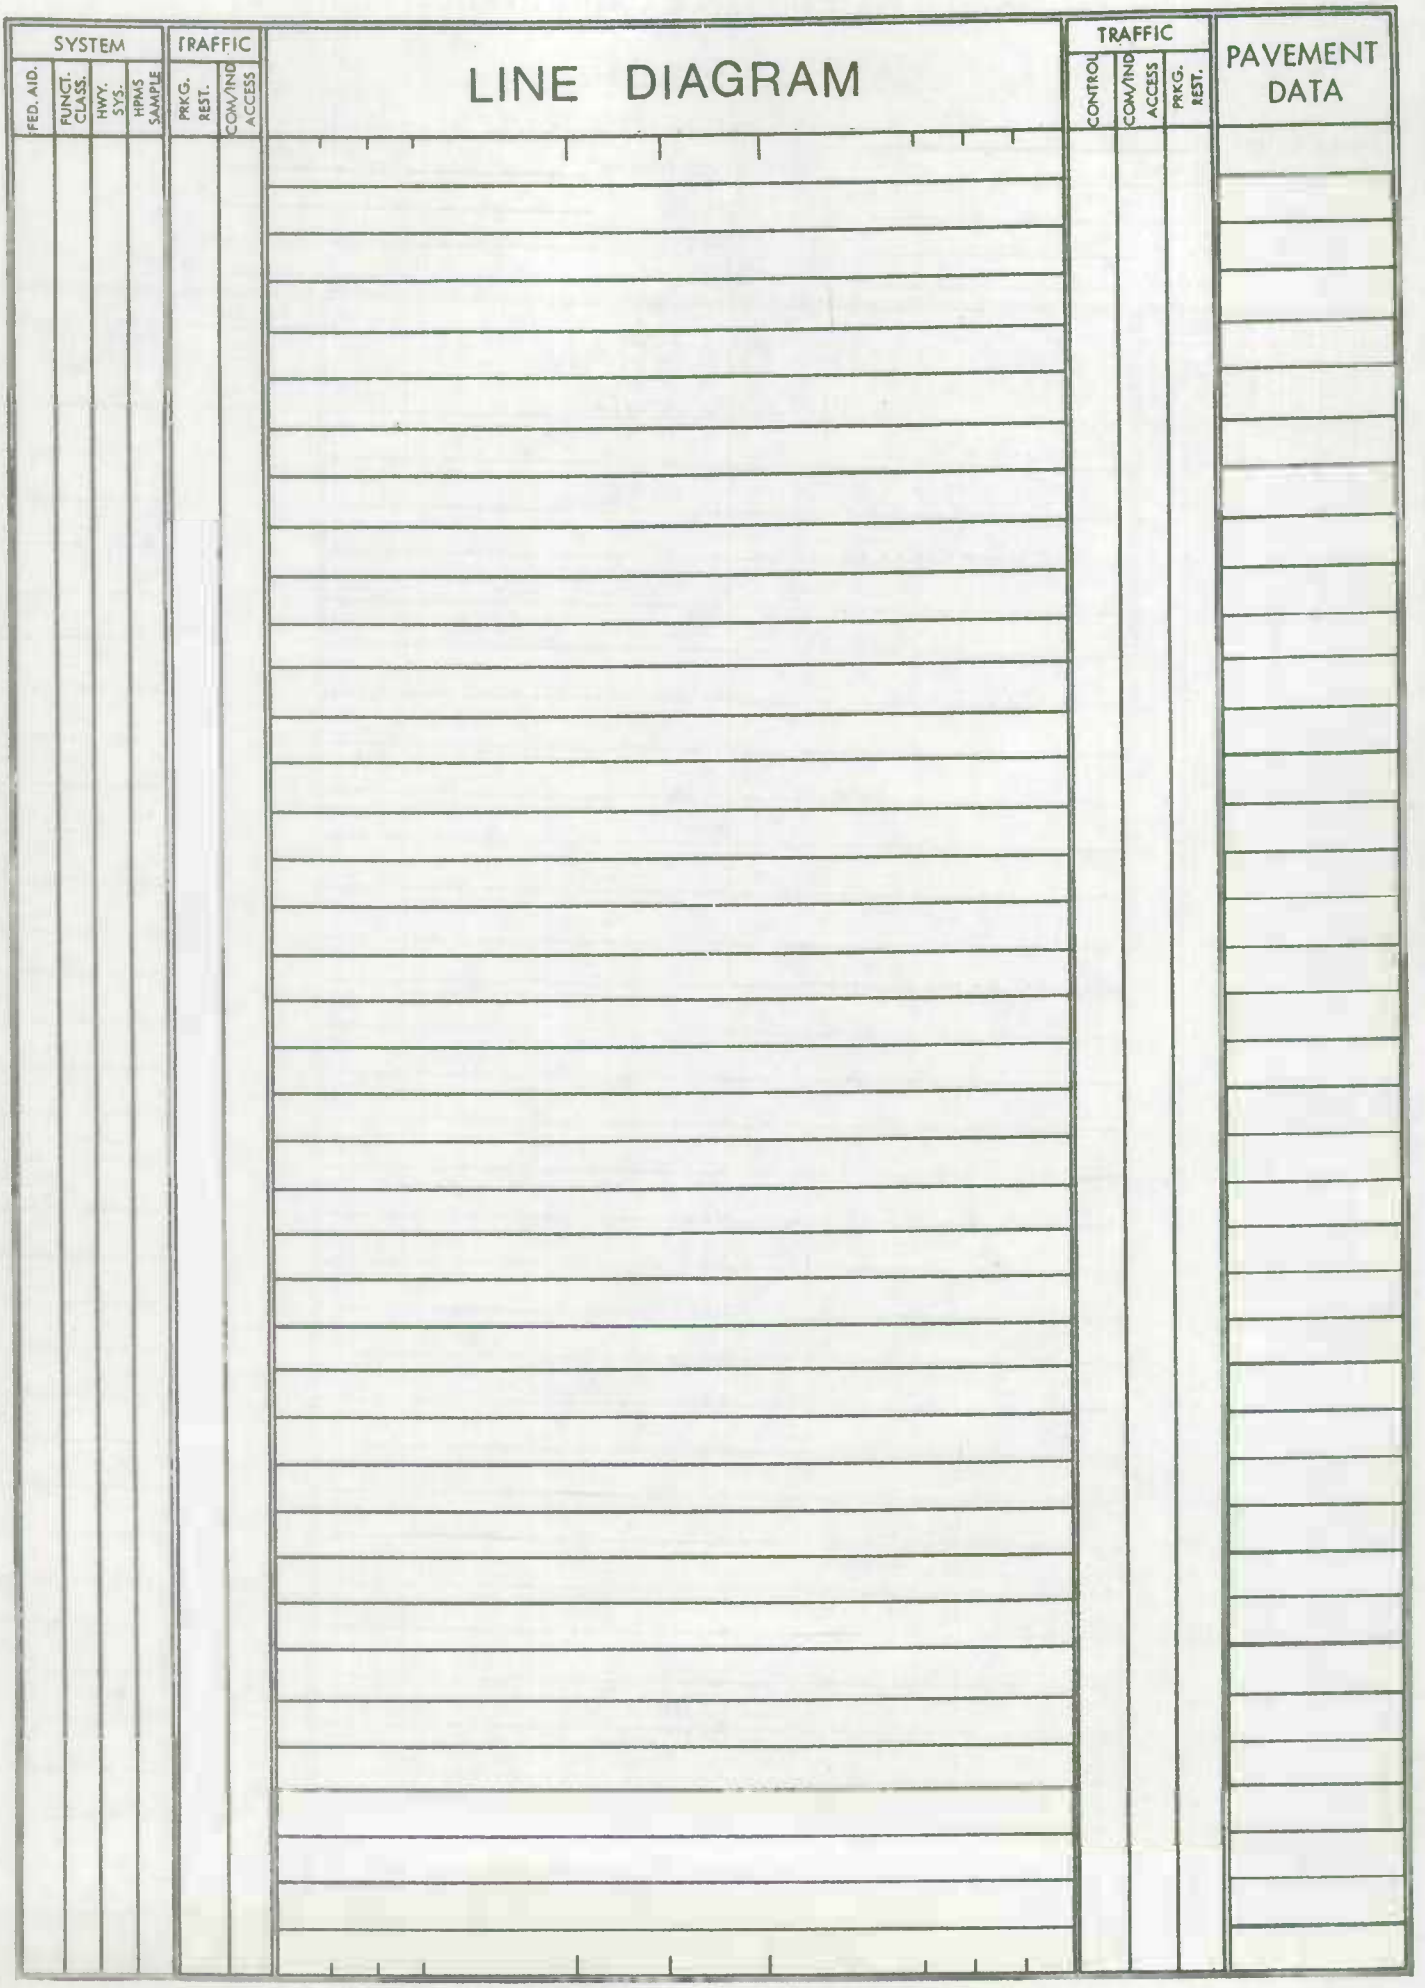
SYSTEM
FED. AID.
FUNCT. CLASS.
HWY. SYS.
HPMS SAMPLE
TRAFFIC
PRKG. REST.
COM/IND ACCESS
LINE DIAGRAM
TRAFFIC
CONTROL
COM/IND ACCESS
PRKG. REST.
PAVEMENT DATA

Form 6 HPS (Rev. 1961)

ROAD INVENTORY SHEET

Party Chief R. VOUGHT
Recorder L. COFFELT JR.
Chainman

HAGERSTOWN

VER 7-20-76

Road No. 1080
Name HOOD ST
Sheet No. 1 OF 1
Date 11-12-63
County WASHINGTON

SUMMIT AVE
MUN 0 24 2301
28'I
CURB LT
0 21 90°
28'J
W. BALTIMORE ST 32'CW
MUN
18'H
ALLEY # 1 22'CW
0 11
W.
190° B&O 0 07 RR # WH 832 384 J 32'N
36'CW
LEE
0 00
ST
1329
N 00

Form 6 HPS (Rev. 1961)

AT 9-17

ROAD INVENTORY SHEET

Party Chief R. VOUGHT
Recorder L. COFFELT JR.
Chainman

VER 7-14-76

HAGERSTOWN

Road No. 1100
Name W. HOWARD ST
Sheet No. 1 OF 1
Date 11-8-63
County WASHINGTON

VIRGINIA ~~ST~~ Ave

0 47 2430 7-16

MUN ALLEY #115 0 44 600

PINE ST

MUN 0 42 1980

ALLEY #112

MUN 6120 0 39

0 38 ALLEY #98 MUN 5980

SUMMIT AVE

MUN 0 36 2300

Church 0 33

ALLEY #113

MUN 0 32 6130

GUILFORD AVE

0 28

ALLEY #109

MUN 0 25 6090

Church 0 22

CHESTNUT ST

MUN 0 19 450

ALLEY #105

MUN 0 17 6050

MARYLAND AVE

MUN 0 13 1530

ALLEY #104

MUN 0 10 6040

SPRUCE ST

MUN 0 06 2260

ALLEY #96

MUN 0 03 5960

POTOMAC ST

MUN 0 00 2000

SNI
FCR-97
11/10/97
GD MP

MINOR ART URBAN
FAU 8046

Form 6 HPS (Rev. 1961)

AT

ROAD INVENTORY SHEET

Party Chief R. Vought
Recorder L. Coffelt
Chainman

VER. 7-13-76

Road No. 1110
Name Indiana Ave.
Sheet No. 1 of 1
Date 10-28-63
County Wash.

82-41AT

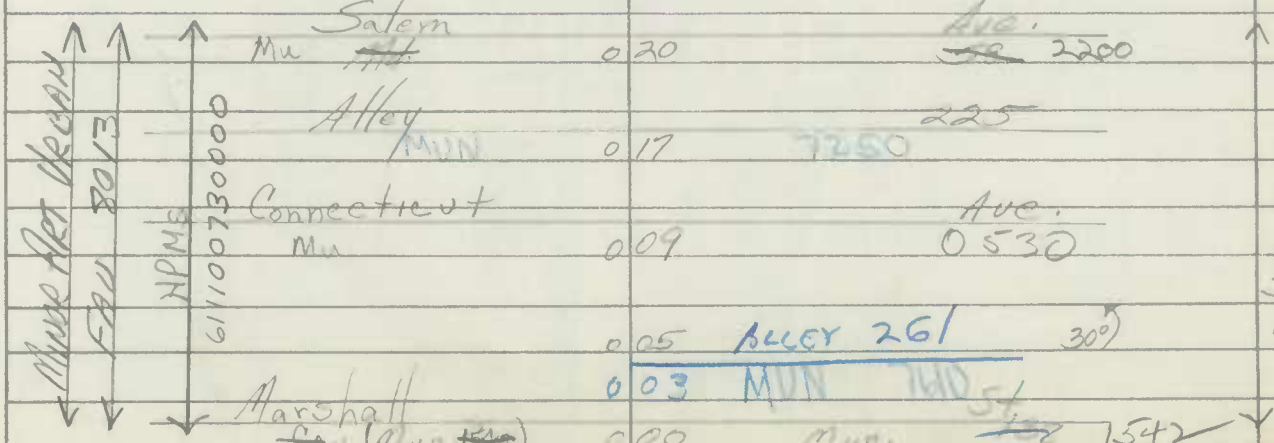

Form 6 HPS (Rev. 1961)

AT P1-77

ROAD INVENTORY SHEET

Party Chief R. Vought
Recorder L. Coffelt, Jr.
Chainman

VER. 7-15-76

Road No. 1130
Name Irvin Ave.
Sheet No. 1 of 1
Date 10-30-63
County Wash.

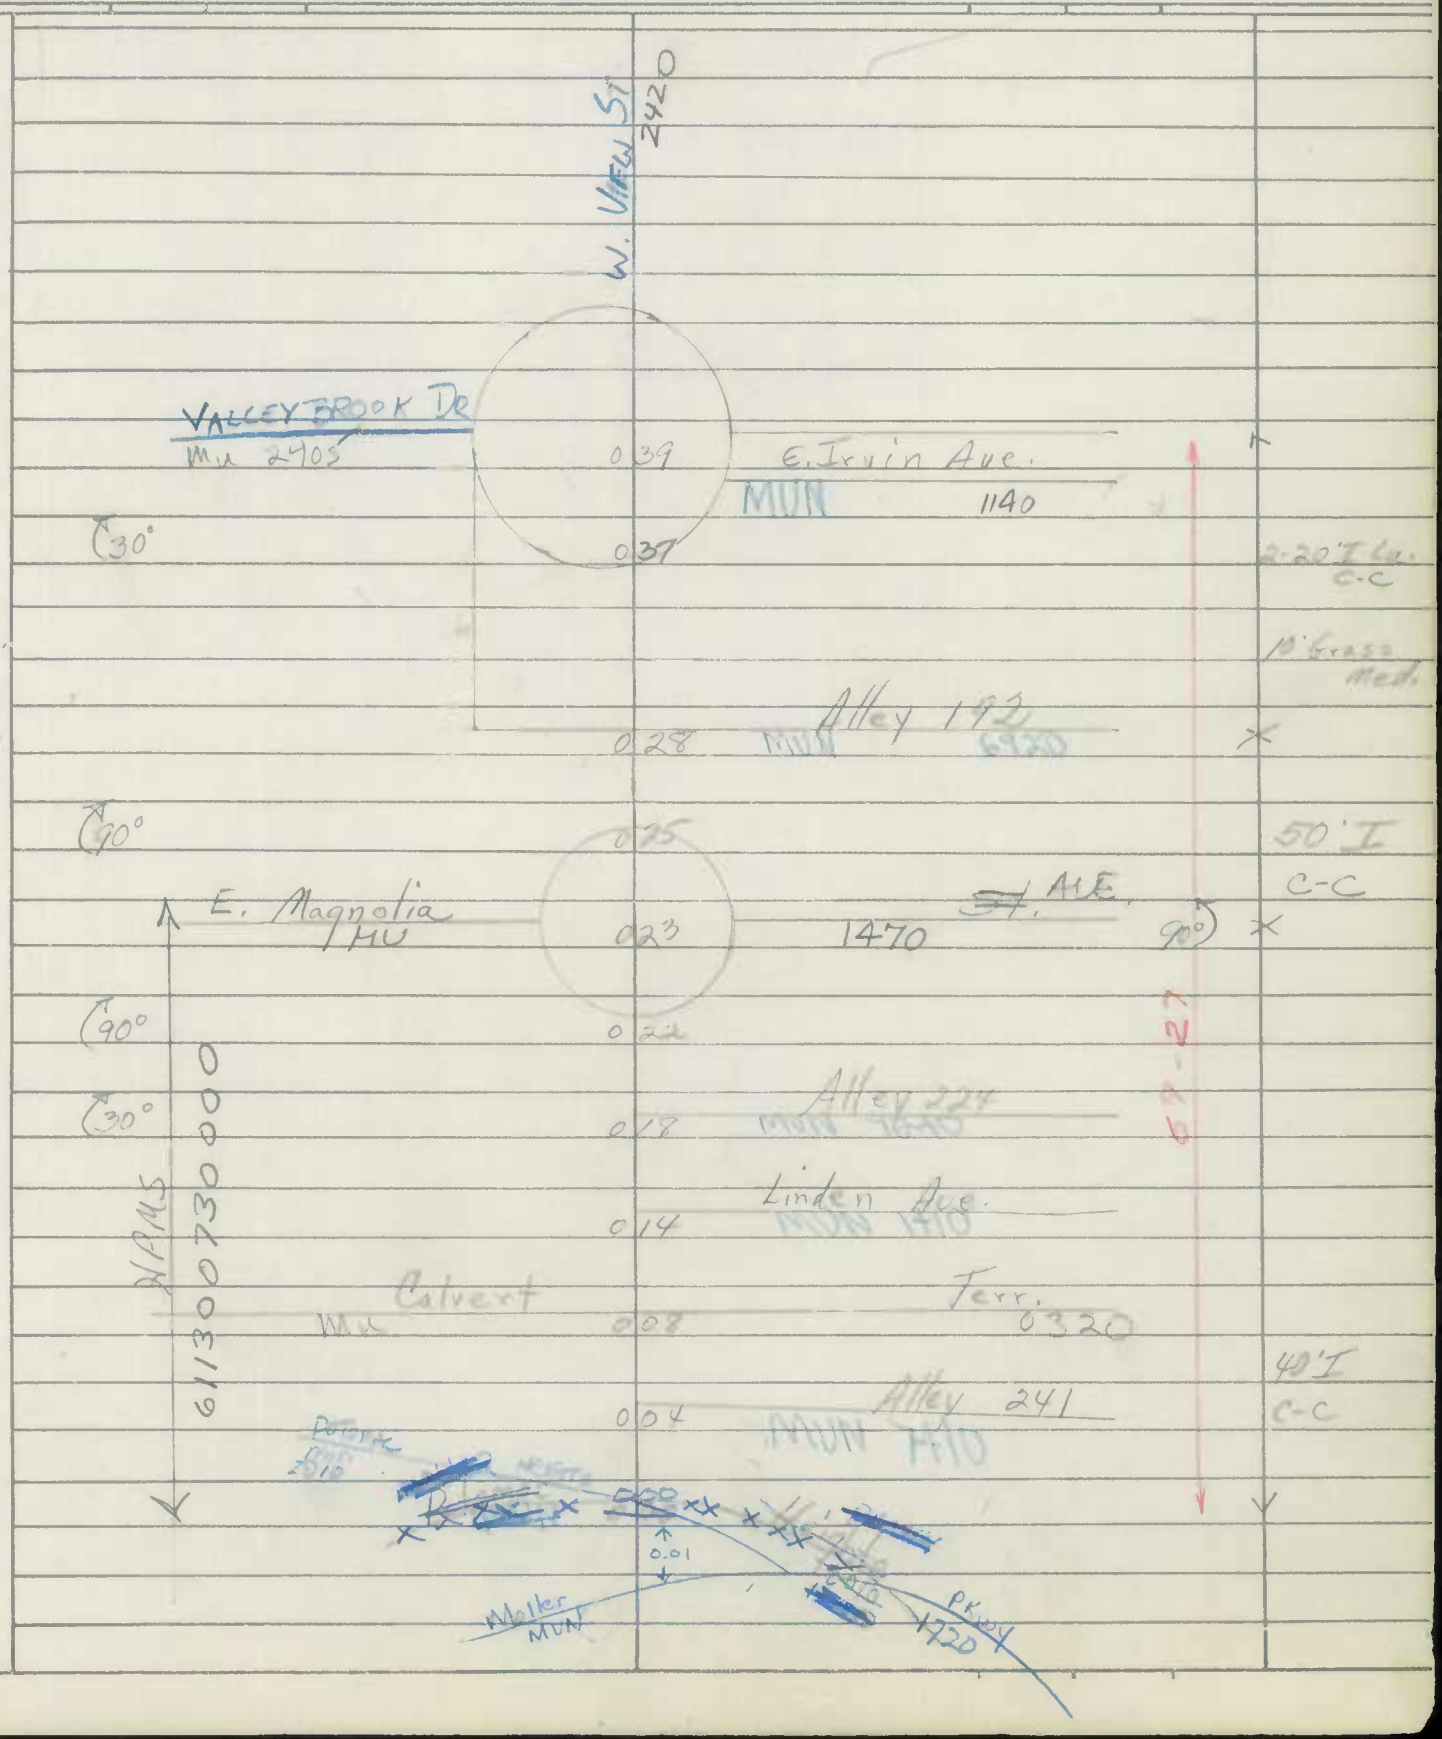

Form 6 HPS (Rev. 1961)

IRVIN AVE #2 1132

ROAD INVENTORY SHEET

Party Chief R. VOUGHT
Recorder L. COFFELT JR.
Chainman

VER 7-14-76

HAGERSTOWN

Road No.
Name W. IRVIN AVE #2 H50
Sheet No. 1 OF 1
Date 10-31-63
County WASHINGTON

		NOW ALL MUNI BY
E. IRVIN AVE		
	0 36	ALLEY ENDS LIBERTY AVE
		25'ILACC 26'ILACC 20'GRASS PKWY
	0 30	
	0 25	350
ALLEY		# 148
	0 24	
POTOMAC		AVE
	0 19	2000
ALLEY		#236
	0 15	
FRY AVE		
	0 13	
ALLEY		#186
	0 17	
HAMILTON		BLVD
	0 08	
ALLEY		#161
	0 04	30'I C-C
OAK HILL		AVE
	0 00	1630

Form 6 HPS (Rev. 1961)

AT

P77

ROAD INVENTORY SHEET

Party Chief R. VOUGHT
Recorder L. COFFELT JR.
Chainman

VER. 9-15-76

HAGERSTOWN

Road No. 1160
Name W IRVIN AVE #3
Sheet No. 1 OF 1
Date 10-30-63
County WASHINGTON

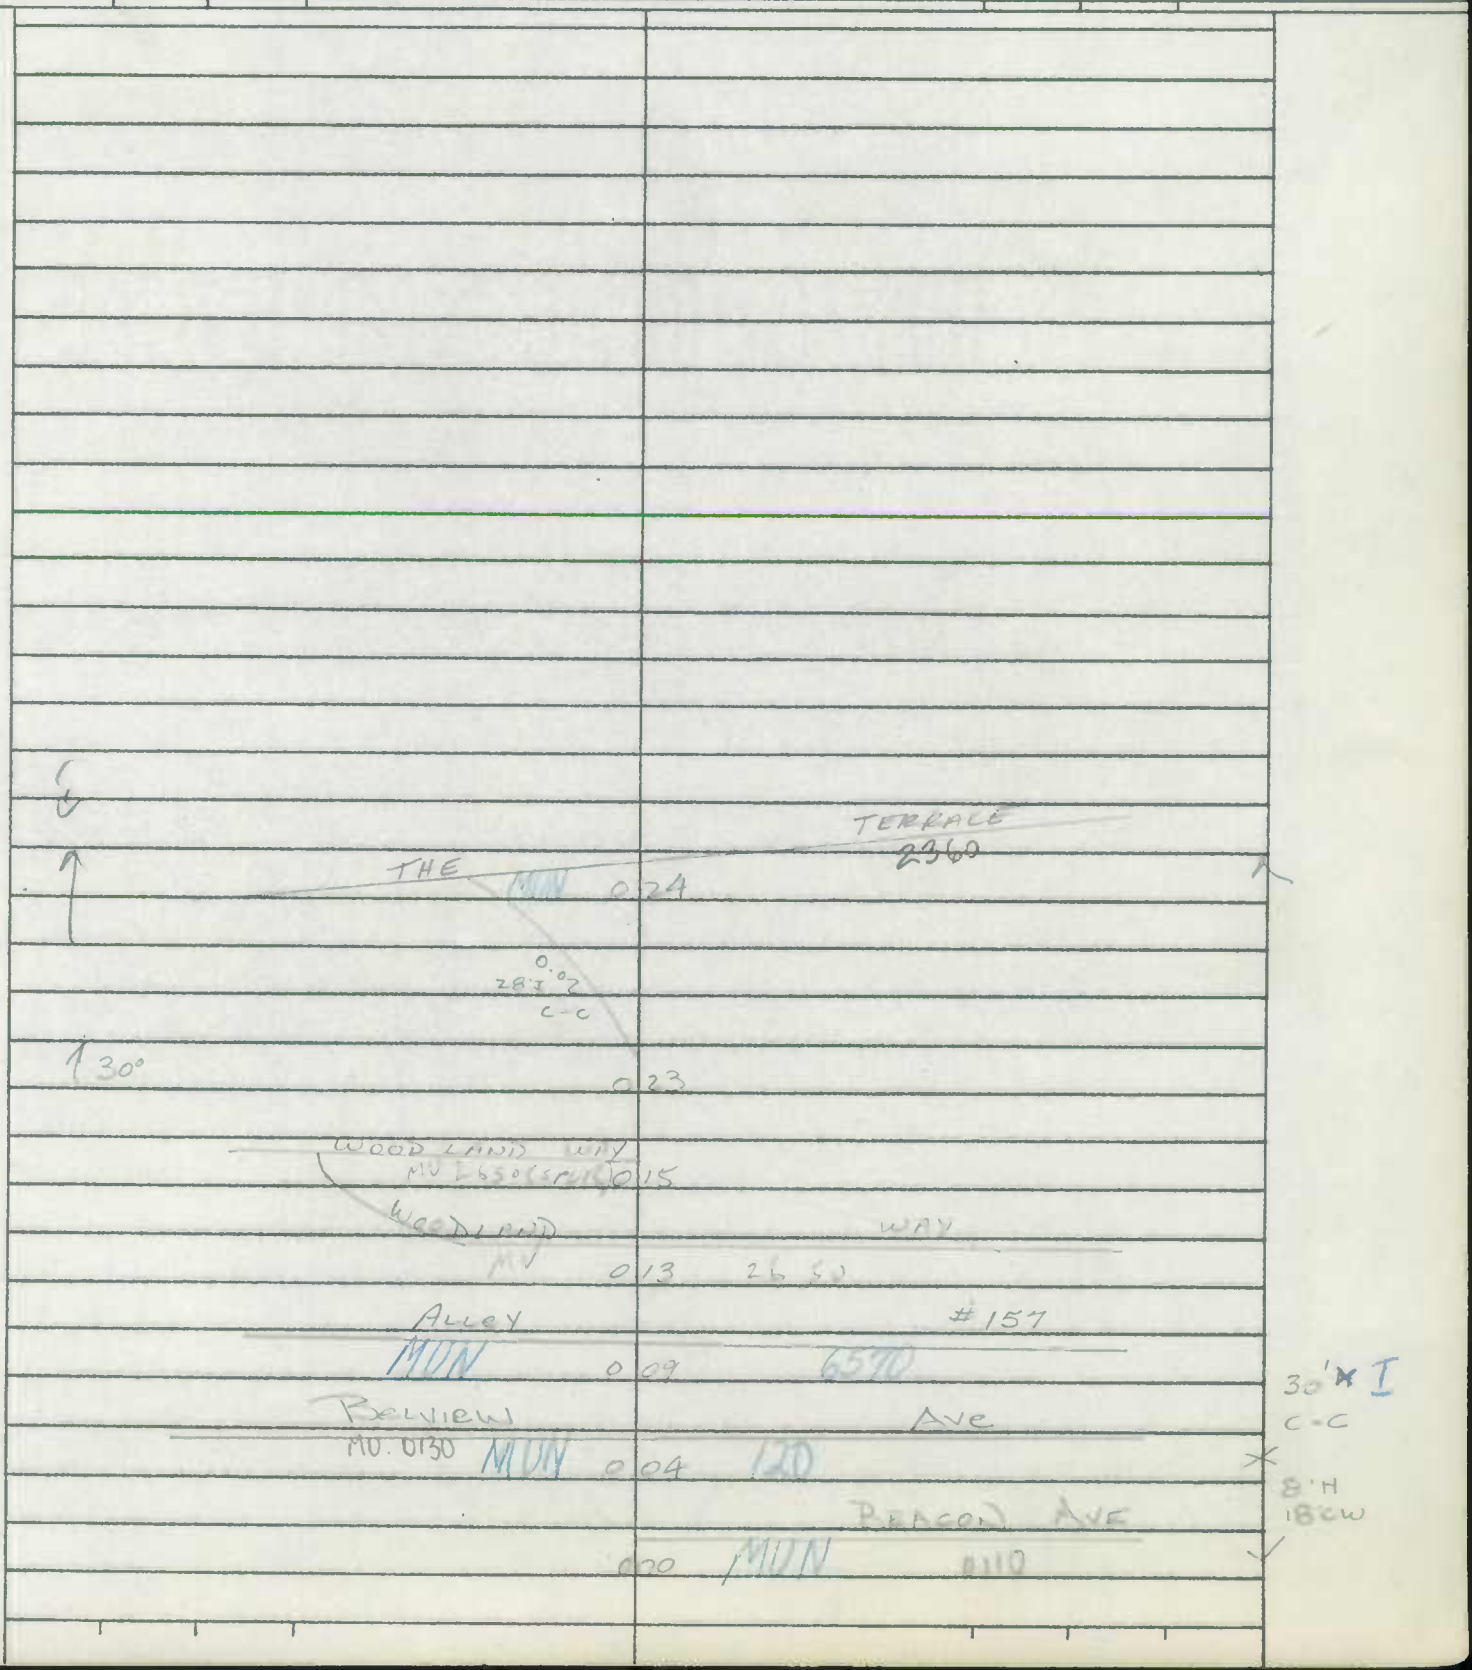

Form 6 HPS (Rev. 1961)

ROAD INVENTORY SHEET

Party Chief R. Vought
Recorder L. Coffelt Jr.
Chainman

VER 7-14-76

Road No. 1170
Name Irvin Pkwy
Sheet No. 1 of 2
Date 11-5-63
County Wash.

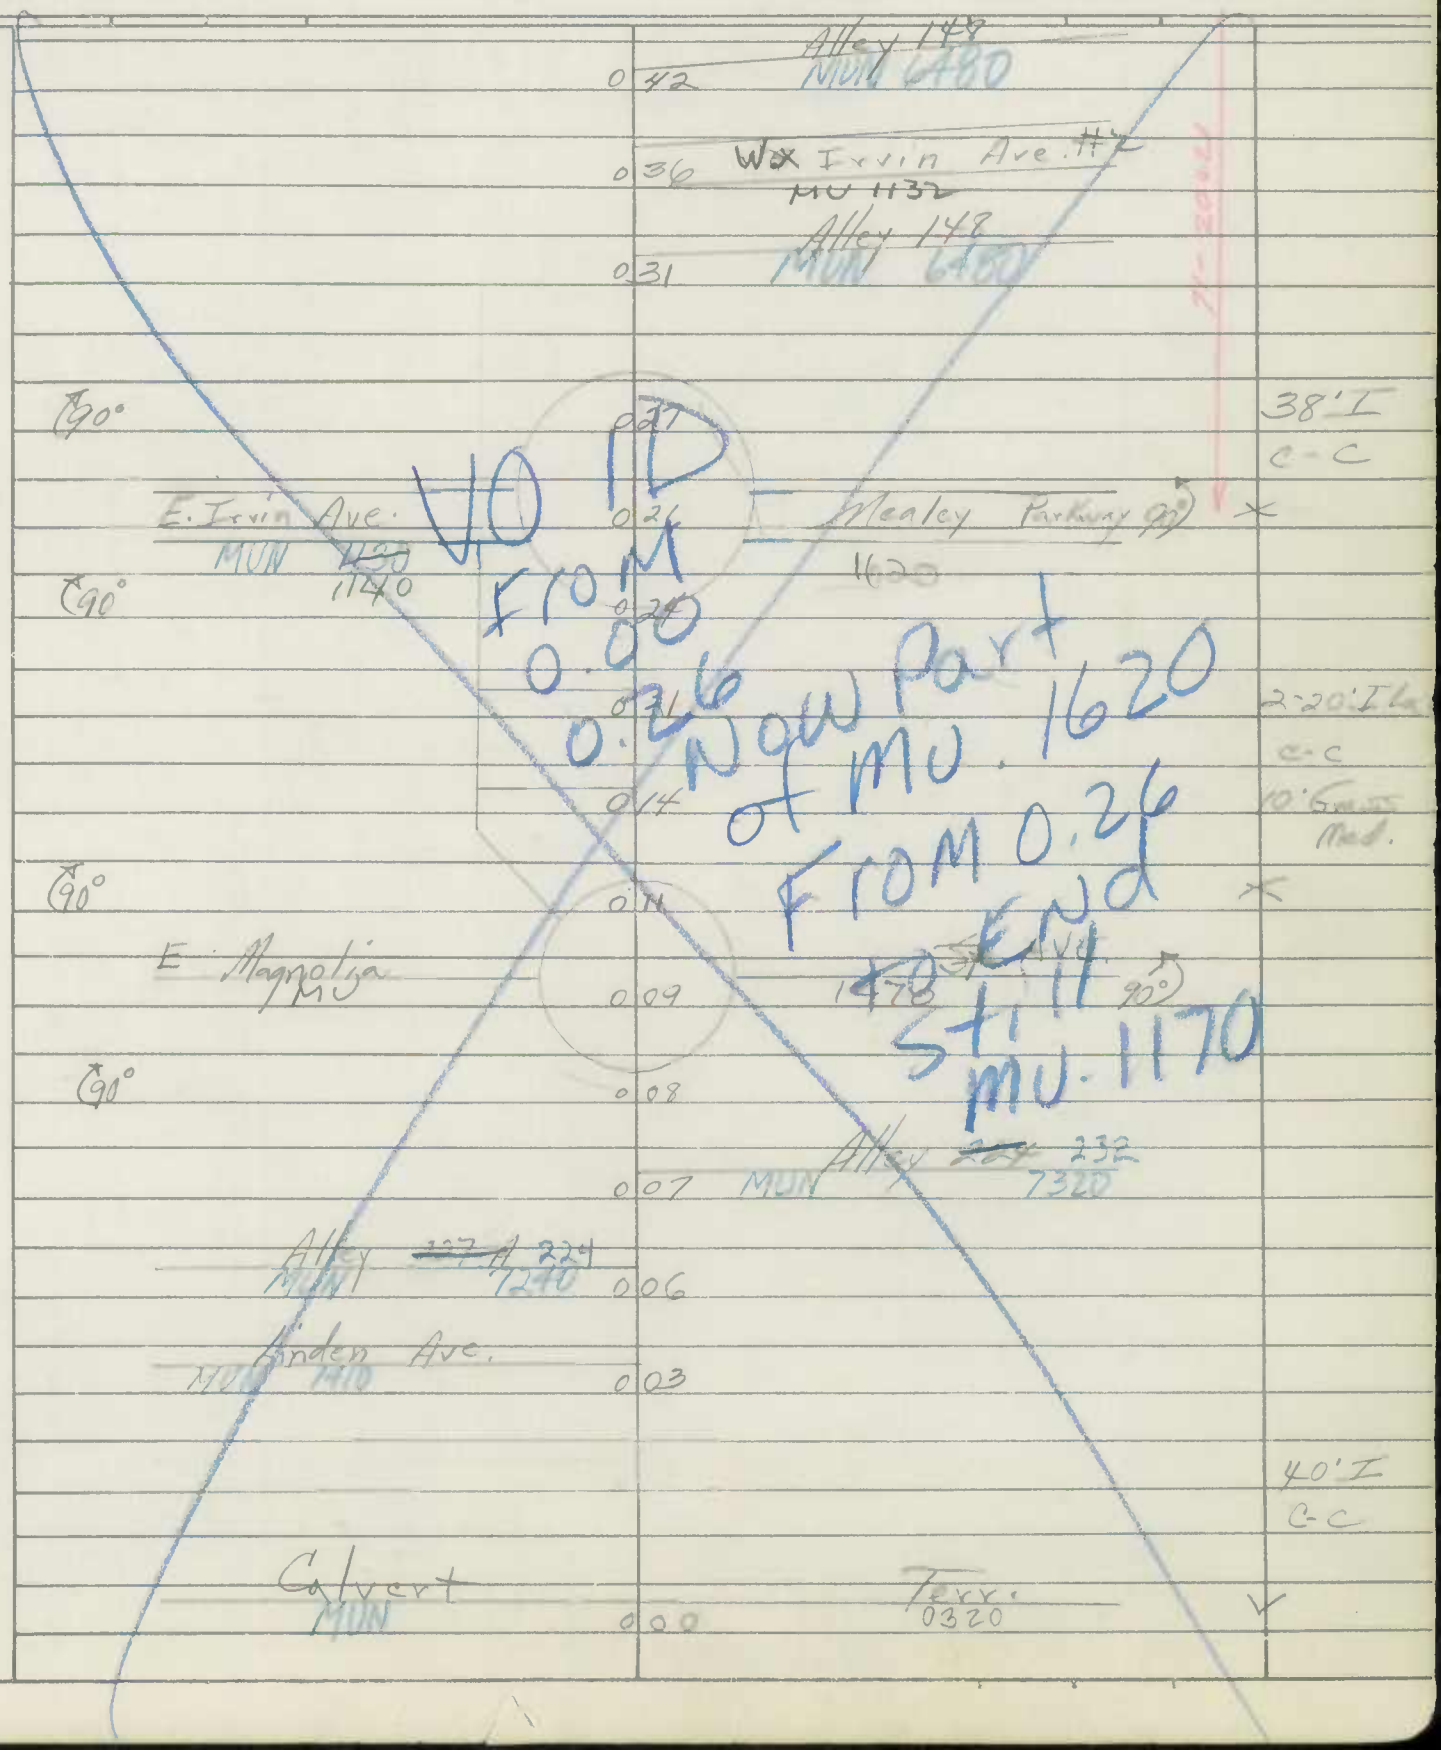

Form 6 HPS (Rev. 1961)

ROAD INVENTORY SHEET

Party Chief R. Vaught
Recorder L. Cosfelt, Jr.
Chainman

Road No.
Name Irvin PKwy
Sheet No. 2 of 2
Date 4-5-63
County Wash.

VOID
See
New
Inv.
91-17, MVEX #2
3-19-92
BB/SP

MULBERRY AVE

Langborn Blvd.
1900 0 46

Same

90-23
3-12-91
GD/TM

98-3mU
2/23/99
SS/RB

AT

Pg 27

Form 6 HPS (Rev. 1961)

ROAD INVENTORY SHEET

Party Chief R. VOUGHT
Recorder L. ~~COFFELT~~ JR.
Chainman

VER
7-15-76

HAGERSTOWN

Road No. 1180
Name W. IRVIN Ave
Sheet No. 1 OF 2
Date 10-29-63
County WASHINGTON

KASINOF AVE
MU 1235 0 36 ENT TO T.H.

MATTHEW CT
PT MU (98-2MU) 0 28

See new Inventory
98-3mU
2/23/99
SS/RB

30°

W. IRVIN AVENUE (799-991)
PC ENT TO T.H. 0 24

WEST IRVIN AVENUE (900-918)
0 21 ENT TO T.H.

BENJAMIN PL
MU (98-1MU) 0 17

W. IRVIN AVENUE
ENT TO T.H. (840-858)

FAIRCHILD AVE
0 13 ~~MU~~ OP ~~0220~~ 240

Road ~~End~~

~~END~~

0 09

PENNSYLVANIA ~~FRONTA~~ Ave

US 0 07 11 SS

ALLEY #135
MUN 6550 0 03

ST CLAIR ST
MUN 2190 0 00 W. HAGERSTOWN HIGH School

67'±

38' I
JC-C
2 UNE

39' I
C-C

SHA 51.3 - 8 Revised
4.83

MARYLAND STATE HIGHWAY ADMINISTRATION HAGERSTOWN

ROAD INVENTORY SHEET MU 1185

87-28 RX
91-34

Party Chief AL
Recorder KJ
Assistant
Map No./Dir. A-8 / NW
State Coordinates 593 · 670

Road No. ~~OP 226~~
Road Name W IRVIN AVE
County WASHINGTON
Date 3-28-88
Sheet No. 1 OF 1

TRAFFIC CODES
TRAFFIC CONTROLS: STOP SIGN=SS, TRAFFIC LIGHT=T.L., FLASHING RED BALL=F.R.

TRAFFIC CODES
PARKING RESTRICTIONS: A.M. PEAK, P.M. PEAK, A.M./P.M. PEAK, NO PARKING ANYTIME=N.P., COMM/IND. ACCESS=E

SYSTEM				TRAFFIC		LINE DIAGRAM	TRAFFIC			PAVEMENT DATA
FED. AID.	FUNCT CLASS.	HWY. SYS.	HPMS SAMPLE	PRKG. REST.	COM/IND. ACCESS		CONTROL	COM/IND. ACCESS	PRKG. REST.	
						COMBINED INVENTORY				
						w/MU 1180				
						98-3 MU				
						2/23/89				
						SSH				
						2				
						280 Paved				
					E	T-H9 PKG. KASHOFF AVE				
						0 15 MU 149-32 1235				
						014				
						PT 012				
						30' WAYNE AVE				
						OP 225 007				
						PC 002				
										38'I
										1-C-C
						Rural Fld				
						Paved				

SYSTEM				TRAFFIC		LINE DIAGRAM	TRAFFIC			PAVEMENT DATA
FED. AID.	FUNCT. CLASS.	HWY. SYS.	HPMS SAMPLE	PRK.G. REST.	COM/IND ACCESS		CONTROL	COM/IND ACCESS	PRK.G. REST.	

Form 6 HPS (Rev. 1961)

A9-77

ROAD INVENTORY SHEET

Party Chief R. VOUGHT
Recorder L. COFFELT JR.
Chainman

VER 7-16-76

Road No. 1210
Name Jefferson ST
Sheet No. 1 OF 2
Date 11-5-63
County WASHINGTON

92-8 A/T

A/T 84-7-8

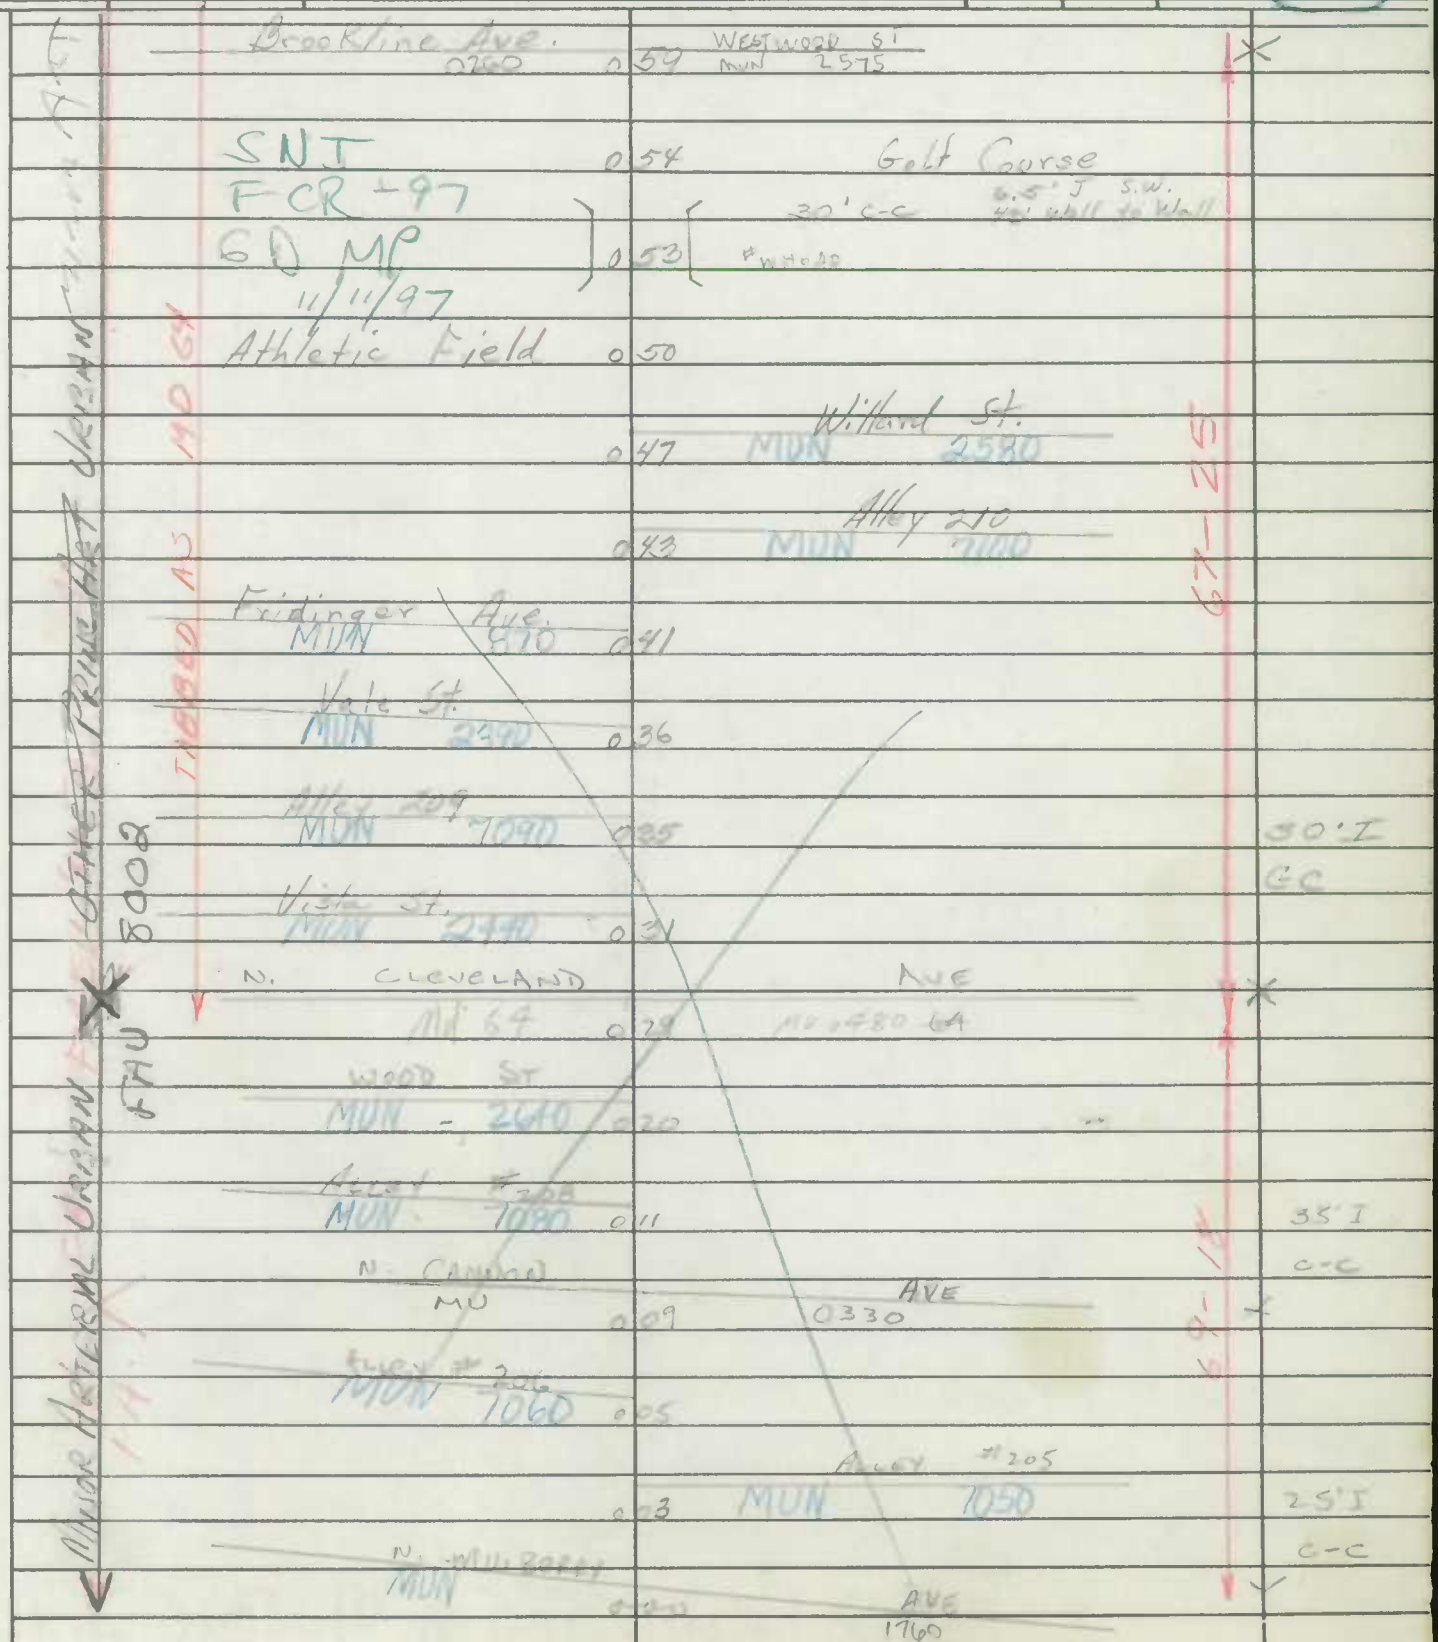

Form 6 HPS (Rev. 1961)

ROAD INVENTORY SHEET

Party Chief R. Vaught
Recorder L. Coffelt, Jr.
Chainman

Road No.
Name Jefferson St.
Sheet No. 2 of 2
Date 11-5-63
County Washi.

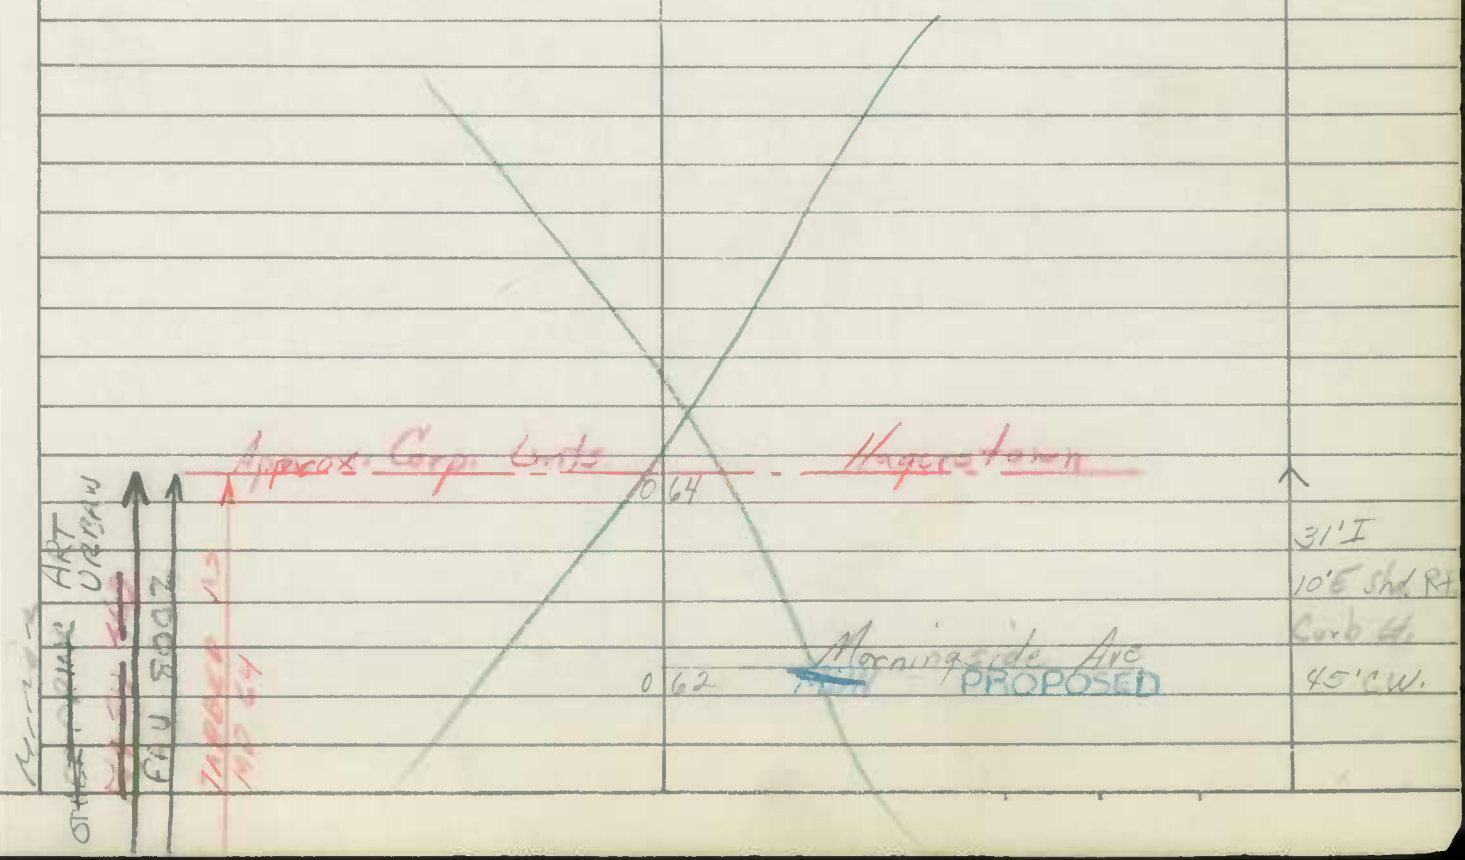

SHA 51.3-8
11-15-72

STATE HIGHWAY ADMINISTRATION OF MARYLAND

ROAD INVENTORY SHEET

Party Chief DT
Recorder FR.
Helper

Map No. GH 22 78-1
HAGERSTOWN

Road No. MUN. 1225
Road Name KENLY AVE.
Sheet No. 1 OF 1
Date 4-16-79
County WASH.
State Coordinates

SEE NEW INVENTORY OF MUN 1225

83-1
4/9/84
DT - NS

W

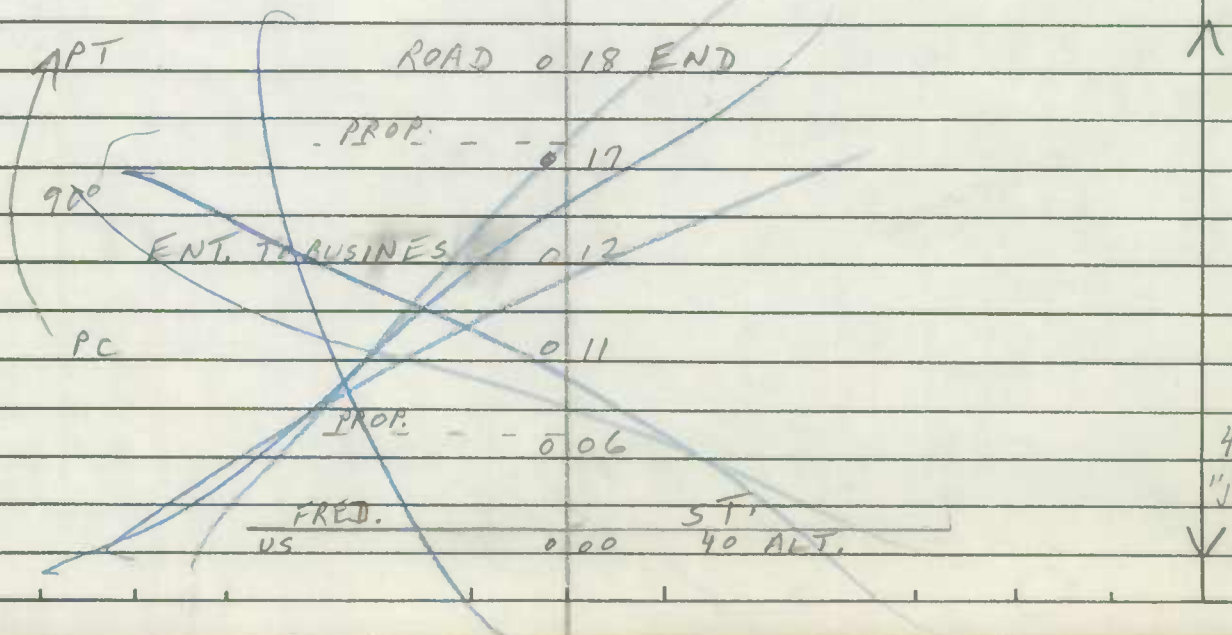

SHA 51.3-8
11-15-72

ROAD INVENTORY SHEET

Road No. _____
Road Name _____
Sheet No. _____
Date _____
County _____
State Coordinates _____

SHA 51.3 - 8 Revised
4.83

MARYLAND STATE HIGHWAY ADMINISTRATION

90-8
3-8-91
GD/TM

ROAD INVENTORY SHEET

(OLD US 11)

Hagerstown

Party Chief CB
Recorder AL
Assistant
Map No./Dir. A-8 / N
State Coordinates 595 - 660

Road No. MUN. 1230
Road Name JONATHAN ST.
County WASHINGTON
Date 4-22-87
Sheet No. 1 OF 2

91-11 A/T

TRAFFIC CODES
TRAFFIC CONTROLS: STOP SIGN=SS, TRAFFIC LIGHT=T.L., FLASHING RED BALL=F.R.

TRAFFIC CODES
PARKING RESTRICTIONS: A.M. PEAK, P.M. PEAK, A.M./P.M. PEAK, NO PARKING ANYTIME=N.P., COMM/IND. ACCESS=E

SYSTEM				TRAFFIC		LINE DIAGRAM	TRAFFIC			PAVEMENT DATA
FED. AID.	FUNCT CLASS	HWY. SYS.	HPMS SAMPLE	PRKG. REST.	COM/IND. ACCESS		CONTROL	COM/IND. ACCESS	PRKG. REST.	
						ALLEY 9140 — 41 — SNI FCR 97 11/11/87 GD MP				
						W. NORTH ST 1990 — 41	TL			
						CHURCH — 40 — CH				
						MURPH AVE MUN. 1765 — 36				
						W. BETHEL ST 0160 — 31	TL			
						CHARMAN MUN. 0990 — 26 — WILLIAMS MUN. 2585				
						CHURCH ST 0440 — 21	TL			
						CH — 19 — MUN. PARK LOT		E		25'I
						WELLER — ALLEY 9160 — 16				J CC
						W. FRANKLIN ST — US ← 11 40 WEST — ALLEY #18 07 MU 5 PD				STAL IUM
						(WAREHAM MU — PL #2 2492)				
						WASHINGTON US 05 100 40 EAST → SUMMIT AVE MU 23	TL			

FAU 800 (LOCAL OTHER PRINCIPAL ARTERIAL)

SYSTEM				TRAFFIC		LINE DIAGRAM	TRAFFIC			PAVEMENT DATA
FED. AID	FUNCT. CLASS.	HWY. SYS.	HPMS SAMPLE	PRKG. REST.	COM/IND ACCESS		CONTROL	COM/IND ACCESS	PRKG. REST.	
1	1									

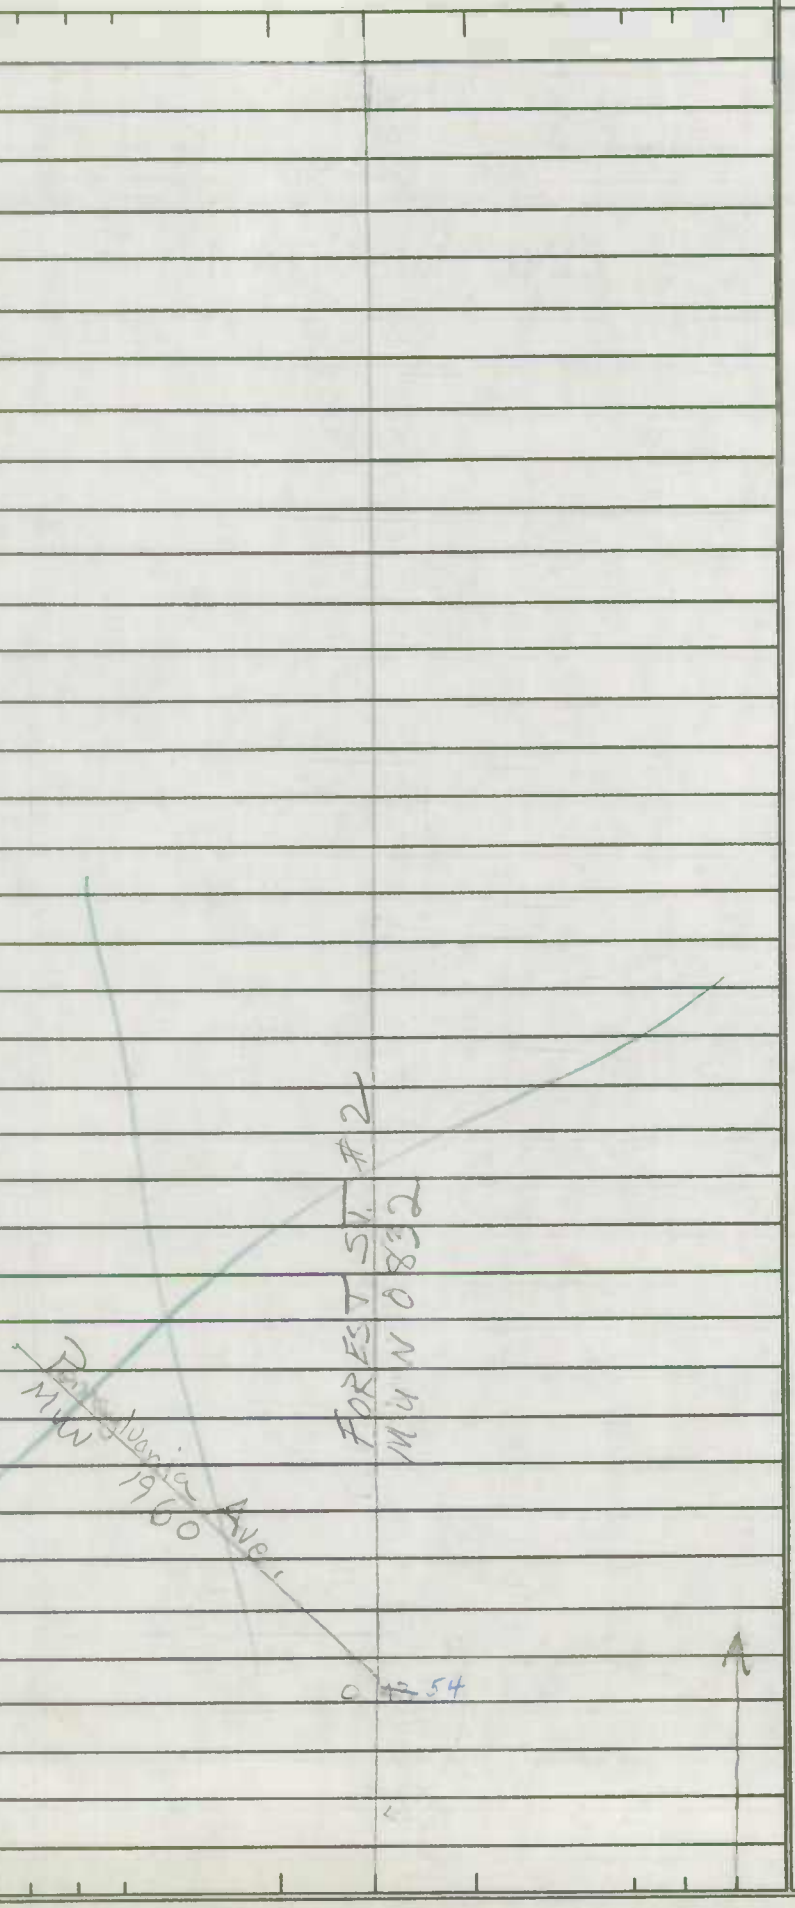

FAU 6001
U-STR Proj. #T

Form 6 HPS (Rev. 1961)

ROAD INVENTORY SHEET

Party Chief R. Vought
Recorder L. Coffelt, Jr.
Chainman

VER 7-20-76

Road No. 1230
Name Jonathan St.
Sheet No. 1 of 1
Date 11-4-63
County Wash.

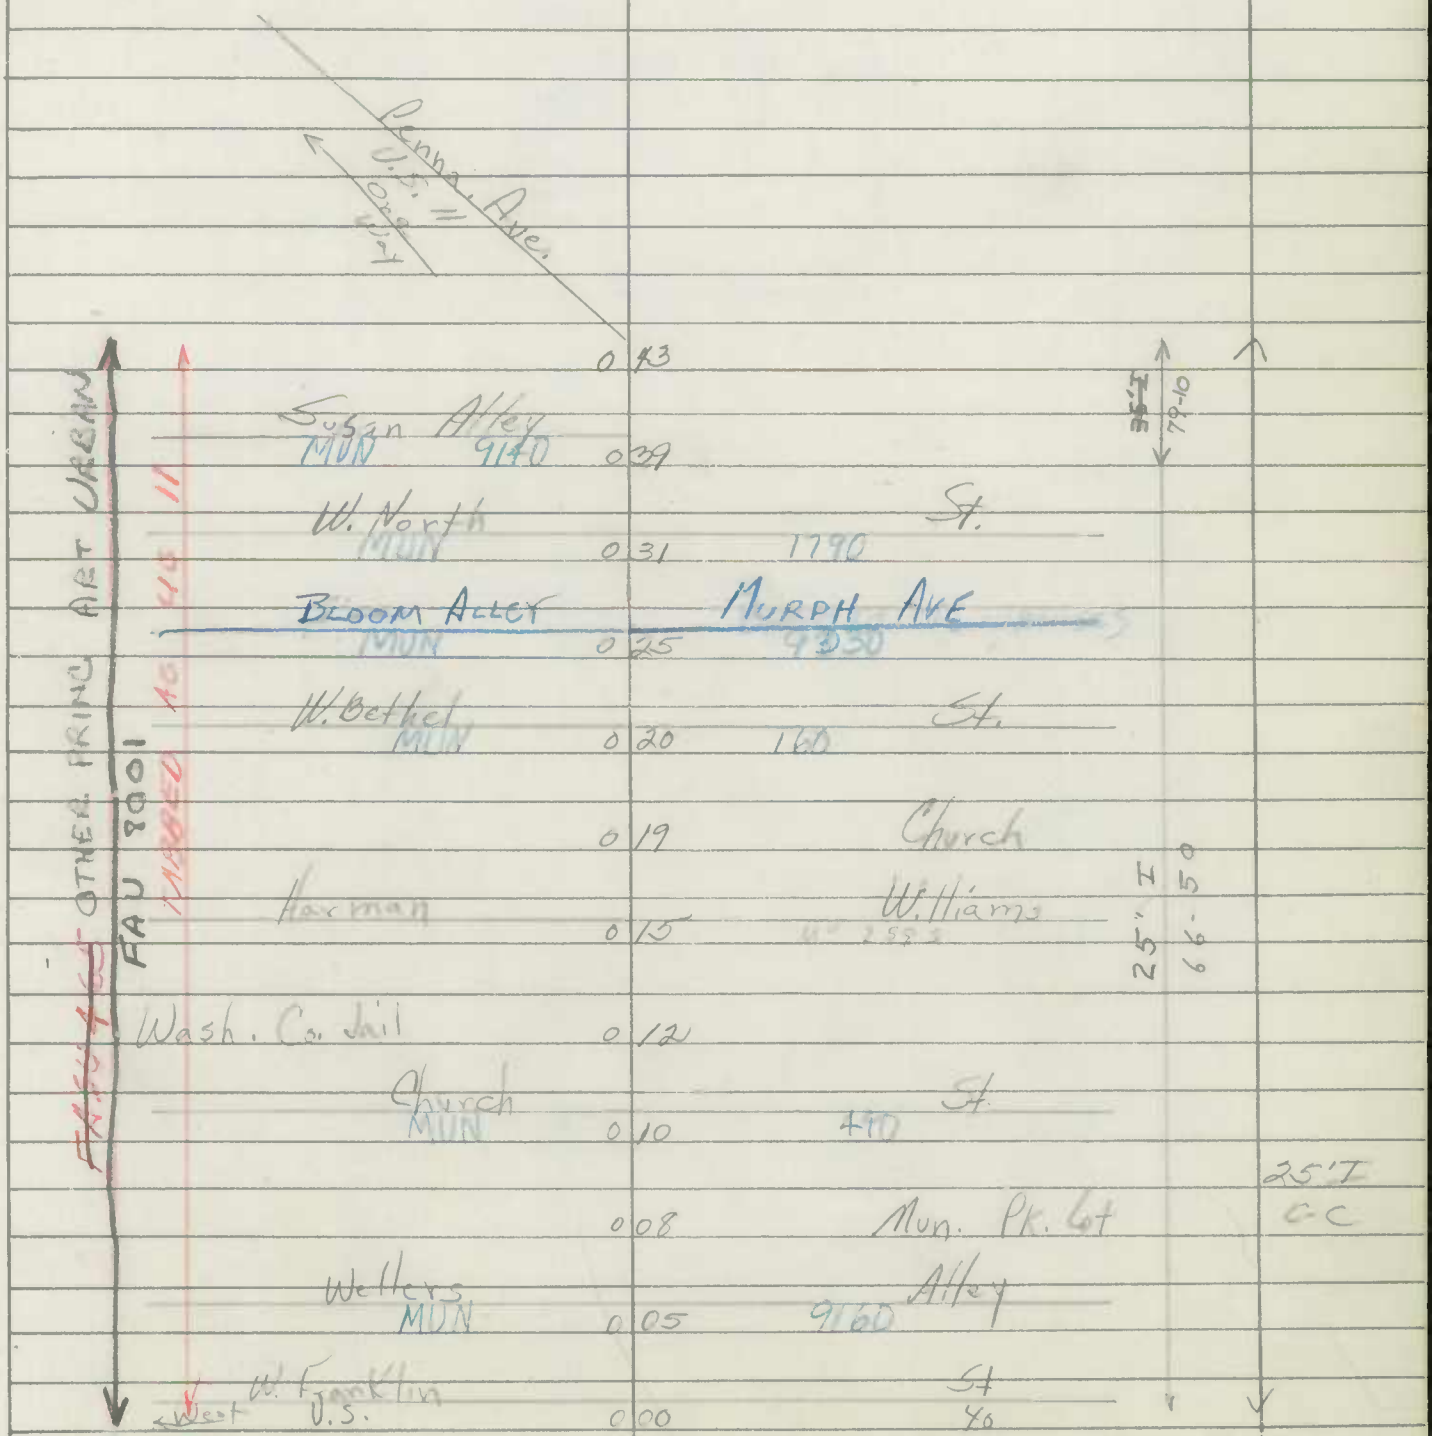

Form 6 HPS (Rev. 1961)

MACS

PG-T1

ROAD INVENTORY SHEET

Party Chief R. VOUGHT
Recorder L. COFFELT JR.
Chainman

HAGERSTOWN

VER 7-16-76

Road No. 1250
Name KENLEY AVE
Sheet No. 2 X OF * 2
Date 11-12-63
County WASHINGTON

0800

FIRST O 68 ~~LOMBARD~~ ST

38'I
C-C

Road End
O 65

Kenwood
80' 1270
O 62

Kenwood
MUN
O 55 2070
O 46

WILSON O 44 BLVD
MUN SS 2600

38'I
C-C

SHA 51.3-8
11-15-72

STATE HIGHWAY ADMINISTRATION OF MARYLAND

S7-24
ALIGNS
3-28-85

ROAD INVENTORY SHEET

Party Chief DT
Recorder NS
Helper

Map No. 83-2
HAGERSTOWN

Road No. MUN 1265
Road Name (KENSINGTON DR.)
Sheet No. OF
Date 4/9/84
County WASHINGTON
State Coordinates

			PARKing	T H.
				DE
			CUL	0216 SAC
PT			ENT APTS	24
90°			ENT APTS	23
			Woodlands Run	
			MU 87-25 2651	
PC				20
			PROPOSED	
				18 ENT APTS 33'I 39'CW
NW ↑				
	~~ROAD~~	0	16 ~~END~~	*
	ENT: APTS.	0	14 ENT. APTS	
	ENT: APTS.	0	08 ENT: APTS.	30.5 32'I J-CC
	OUTER		DR.	
	MUN	0	00 1890	↓

SHA 51.3-8
11-15-72

ROAD INVENTORY SHEET

Road No. _____
Road Name _____
Sheet No. _____
Date _____
County _____
State Coordinates _____

Form 6 HPS (Rev. 1961)

PG-77

AT

ROAD INVENTORY SHEET

Party Chief R. Vought
Recorder L. Coffelt, Jr.
Chainman

VER
7-15-76

Road No. 1280
Name Key Ave.
Sheet No. 1 of 1
Date 10-28-63
County Wash.

SEE N. I.
90 MUN EX #1

6D / TM

3/12/ 91

W. Church
MUN 0 21

St.
0440

38'H
C-C

Wanda Ave.
2440 MUN 000

← KEY CIR
1240

Form 6 HPS (Rev. 1961)

ROAD INVENTORY SHEET

Party Chief R. Vought
Recorder L. Coffelt Jr.
Chainman

Road No. 1290
Name Key Circle
Sheet No. 1 of 1
Date 10-28-63
County Wash.

VER
7-15-76

DAYCO TAH Auf
CD, 476

Approx Corp Limits

0 12 Hagerstown

18'H
24'C.W.
34 C-C

0 09 MUN Key Ave. #2
1292

0 02 30

38'H
C-C

Wanda Ave.

0 00 MUN 2480

← KEY AVE
1280

Form 6 HPS (Rev. 1961)

P4-77

ROAD INVENTORY SHEET

Party Chief R. VOUGHT
Recorder L. COFFELT JR.
Chainman

HAGERSTOWN

VER 7-15-76

Road No. 1300
Name Key St
Sheet No. 1 OF 1
Date 11-12-63
County WASHINGTON

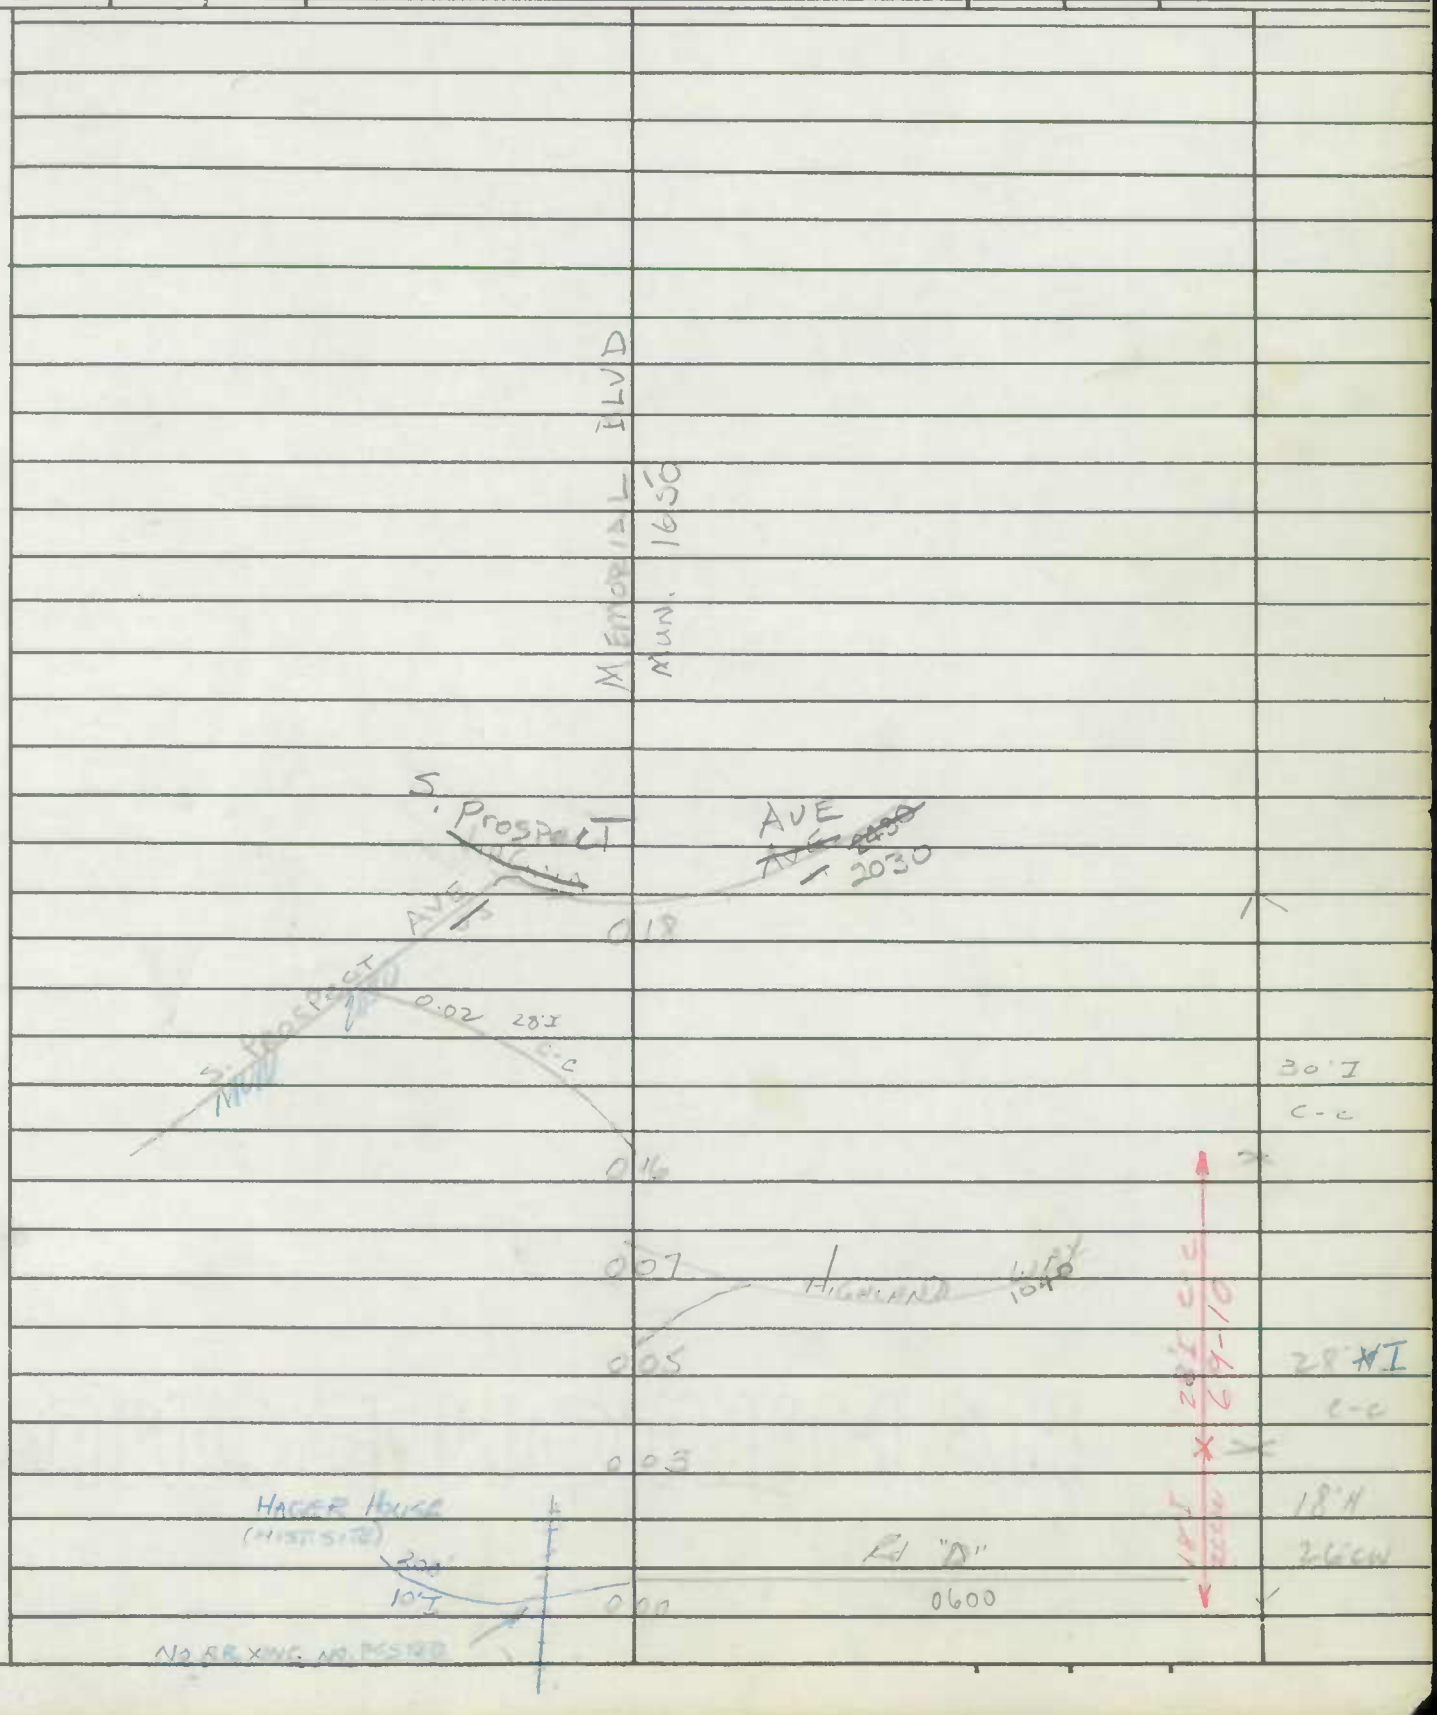

SHA 51.3 - 8 Revised
4.83

Hagerstown

MARYLAND STATE HIGHWAY ADMINISTRATION

91-33
91-33 EX.-1,-2,-3,-4

ROAD INVENTORY SHEET

Party Chief BB
Recorder SP
Assistant
Map No./Dir. 1 SE
State Coordinates

Road No. MU 1337
Road Name Langley DR
County Washington
Date 3-19-92
Sheet No. 1 OF 1

SYSTEM: FED. AID. | FUNCT CLASS. | HWY. SYS. | HPMS SAMPLE
TRAFFIC: PRKG. REST. | COM/IND. ACCESS

LINE DIAGRAM

TRAFFIC: CONTROL | COM/IND. ACCESS | PRKG. REST.

PAVEMENT DATA

NOW combined with
MU1335
00-4MU
3-8-01
C-D/E

Proposed

Road End
013

Lily CT
OP 0257

011

Tulip CT
OP 0259

Violet DR
008 OP 0258

Lily CT
OP 0257
004

Iris CT
003 OP 0256

Mt Aetna RD
CO 000 310

SS

32' I
J-CC
2 UML

TRAFFIC CODES

TRAFFIC CONTROLS: STOP SIGN=SS,
TRAFFIC LIGHT=T.L.,
FLASHING RED BALL=F.R.

TRAFFIC CODES

PARKING RESTRICTIONS: A.M. PEAK,
P.M. PEAK, A.M./P.M. PEAK, NO PARKING
ANYTIME=N.P., COMM/IND. ACCESS=E

SYSTEM				TRAFFIC		LINE DIAGRAM	TRAFFIC				PAVEMENT DATA
FED. AID.	FUNCT. CLASS.	HWY. SYS.	HPMS SAMPLE	PRKG. REST.	COM/IND ACCESS		CONTROL	COM/IND ACCESS	PRKG. REST.		

Form 6 HPS (Rev. 1961)

P9-77
AT

ROAD INVENTORY SHEET

Party Chief R. VOUGHT
Recorder L. COFFELT JR.
Chainman

HAGERSTOWN

VER 7-16-76

Road No. ~~1270~~ - 1360
Name W & E. LEE ST
Sheet No. 1 OF 1
Date 11-12-63
County WASHINGTON

SUMMIT MUN →	0 42	→ Ave 2300	
HAGERSTOWN ~~ALLEY #2~~ MUN ~~1220~~ 1062	0 39	ALLEY #122 MUN 6220	
		EAST PK. AREA	
	0 36		
FLASH SIGNALS		CLOSED 11/30/83 ~~#3~~ ~~#4 MUN 83X 3X8C~~	
	0 34	ST 100 HOOD RR	
	0 33		
CSX RR			
130° B40	0 26	RR ~~#BO-139493~~	
SOUTH ST MUN 2250	0 23		
SMITH ST MUN 2220	0 21		
		ALLEY #121	
	0 20	MUN 6210	
S. POTOMAC		ST	
MUN 2000	0 17	← ONE WAY	
		GERBERS ALLEY	
	0 13	MUN 9100	
S. LOCUST		ST	
ONE WAY	0 10	→ 1430 30°	
ALLEY #3			
MUN 5030	0 07		
		CROMERS ALLEY #2	
	0 04	MU 9082	
CROMERS ALLEY			
MU ~~2280~~	0 03		25' I
S. MULBERRY		ST	C-C
MUN	0 00	← 1760	

Form 6 HPS (Rev. 1961)

(92-14)
AH/BB
4-1-93

ROAD INVENTORY SHEET

Party Chief R. VOUGHT
Recorder L. COFFELT JR.
Chainman

HAGERSTOWN VER 7.13-76

Road No. 1420
Name LINGANORE ~~ST~~ AVE
Sheet No. 1 OF 1
Date 10-28-63
County WASHINGTON

SNI
FCR -97
GD MP
11/13/97

ROAD END
031
LANGDON ST
MUN 1330
026
BALL FIELD
FLORIDA AVE
MUN 920
024
Georgia Ave.
MUN 920
018
CARR ST
MUN 1350
015
MARSHALL ST
MUN 1540
011
HAMMOND ST
MUN 980
009
008
Church
#81
ALLEY
MUN
003
SALEM
MU
000
2200

28' I
J-C-C
I
34' I
J-C-C
34' I
66-23
UKRAINIAN POND
80 15
FAU

Form 6 HPS (Rev. 1961)

ROAD INVENTORY SHEET

Party Chief R. VOUGHT
Recorder L. JOFFELT JR.
Chainman

VER. 7-14-76

HAGERSTOWN

Road No. 1430 - ~~1440~~
Name N & S LOCUST ST
Sheet No. 1 OF 2
Date 11-4-63
County WASHINGTON

79-3 80-1

	E FRANKLIN			ST
WEST	US	0	62	40
	ALLEY			#21A "23
	MUN	0	56	5230
	E WASHINGTON			ST
	US	0	51	40 EAST
	MATHEWS AVE			ALLEY 134 E
	MU 1560	0	46	
				ALLEY #250
		0	43	MU 7500
	E. ANTIETAM			ST
	MU	0	40	0030
	BURGERS			ALLEY
	MU	0	35	9020
	ALLEY #173			
N	MU 6730	0	32	
	E. BALTIMORE			ST
	MU	0	28	0090
	BURGERKING			BRUCE AVE ALLEY
	MU 9310	0	23	MU 9050 250
				BUSTER ST
	ALLEY 254	0	20	MU 0150
	MU TC40			
	E. LEE	0	18	ST
	MU	0	15	1360
				ELD ST
		0	10	→ MU 0750
				RAX ST
		0	05	MU 2080

ARTHUR DRIVE ART URBAN
FAP 221

ALLEY 4
MU 5040

25' I
C-C

Form 6 HPS (Rev. 1961)

ROAD INVENTORY SHEET

Party Chief R. VOUGHT
Recorder L. COFFELT JR.
Chainman

HAGERSTOWN

Road No.
Name N#S LOCUST ST
Sheet No. 2 OF 2
Date 11-4-63
County WASHINGTON

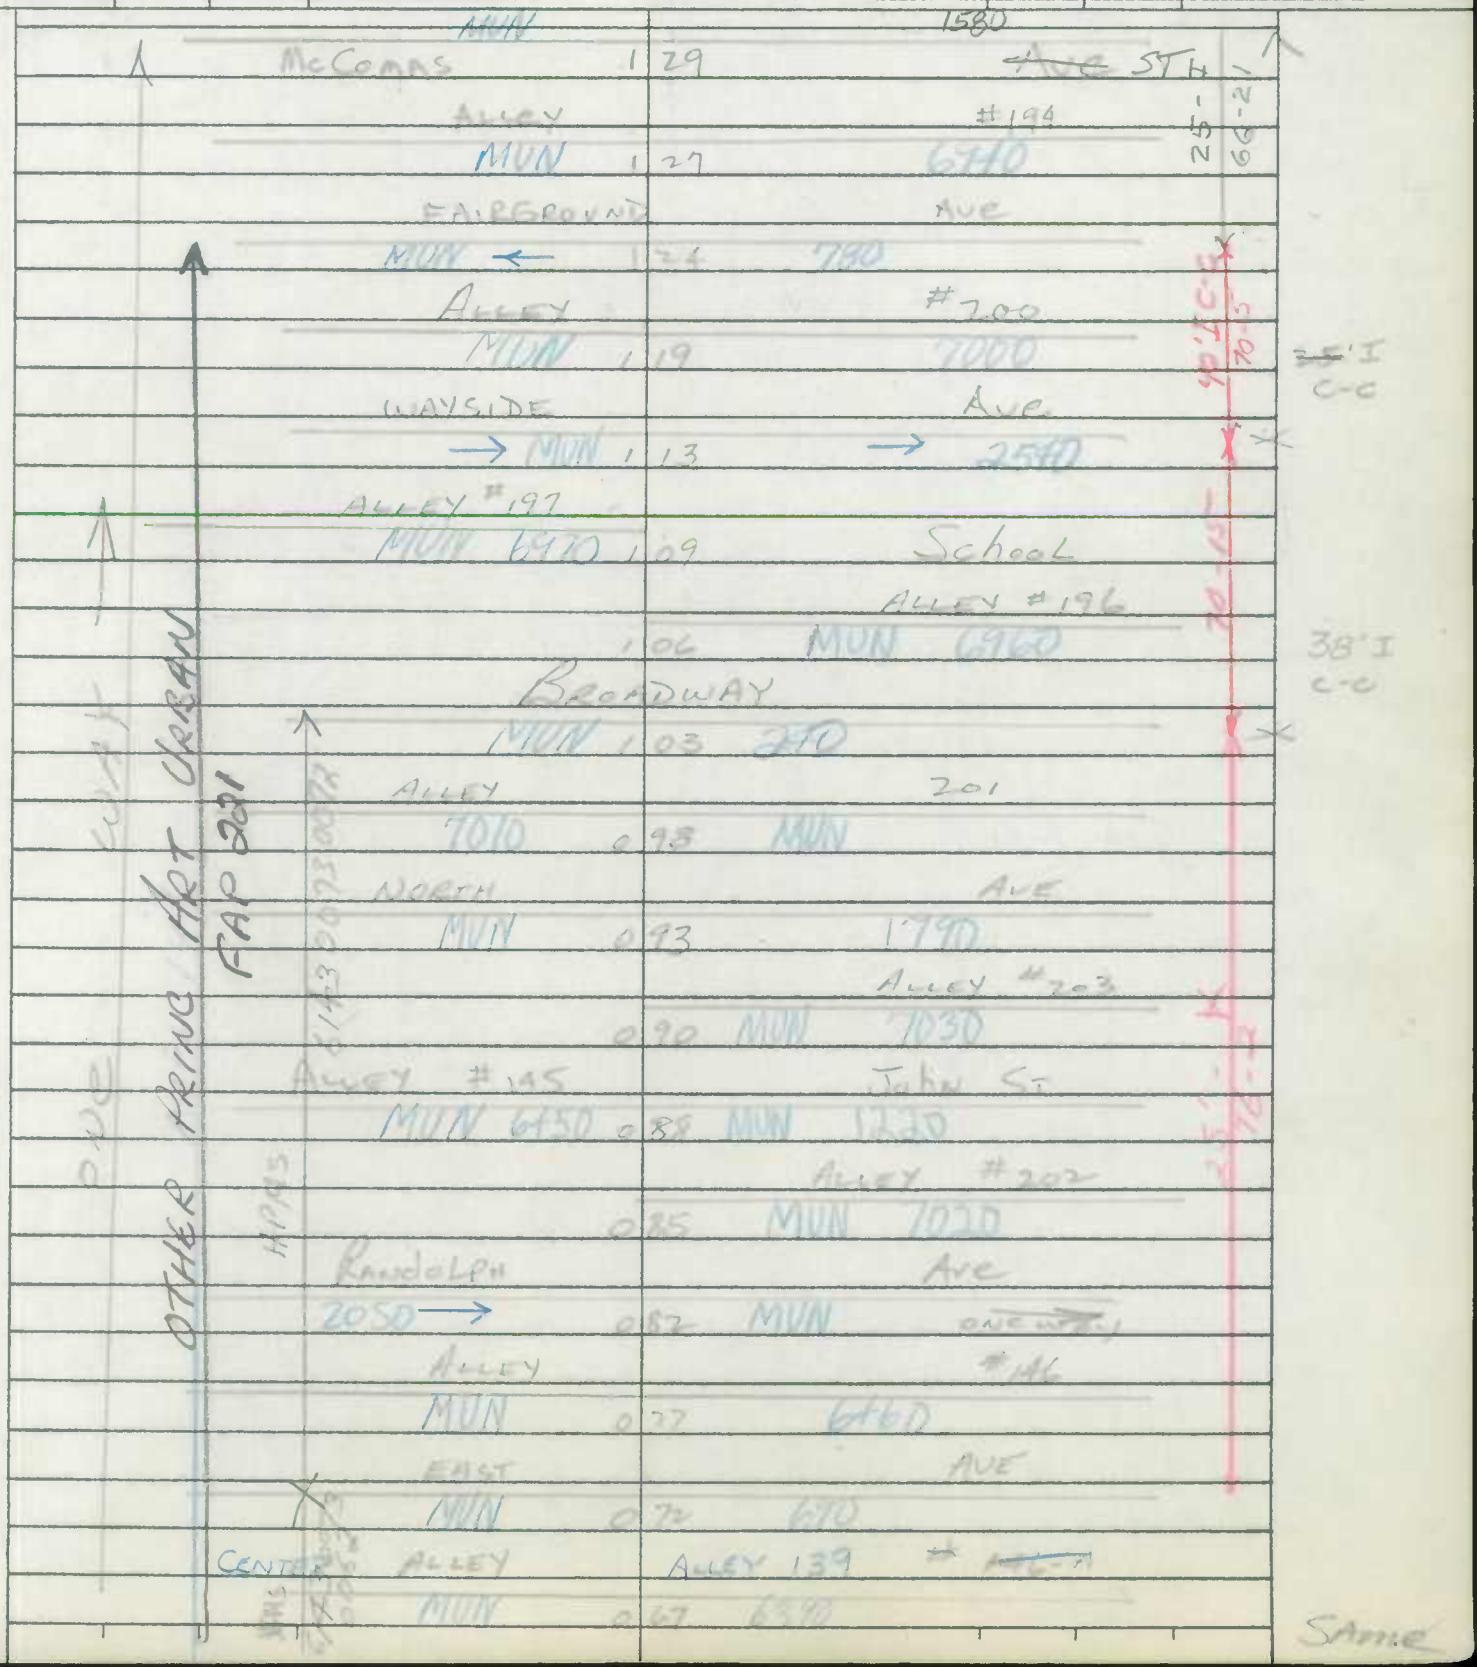

SHA 51.3-8
11-15-72

STATE HIGHWAY ADMINISTRATION OF MARYLAND

URBAN PSTD

Co. 852

BB84-99
RM 4-5585

ROAD INVENTORY SHEET

Party Chief W. DOMBROSKI
Recorder M. ZALENSKI
Helper ~~POTOMAC~~ "MAGNOLIA" HEIGHTS

Map No. A-8 (SE)

~~84~~ HAGERSTOWN

Road No. MD 1480 (~~1470~~)
Road Name E. MAGNOLIA AVE
Sheet No. 2 OF 2
Date 7-14-76
County WASH
State Coordinates 603-665

84.99

	0	DE	
CAL	0	81 SAC	
	0	Chartridge Dr	
PR	0	77 G 963	20'I 2 10'T T Sch I
~~ROAD~~	0	72 ~~END~~	
	0	Holly Mead Terr. 71 G 962	
	0	69 H	45½
7 H	0	65 EXIT SCHOOL	
	0	63 POTOMAC HEIGHTS (ELE.) SCHOOL	
	0	60 ENT TO SCHOOL	
SE PT APPOX. CORP	0	58 LIMITS OF HAGERSTOWN	
30°	0	57	
PRC	0	55	PRC
→	0	52 4-36" RCP	30° MD 1470
	0	50	PC 40'I. J'c.c
POTOMAC HEIGHTS	0	49	

SHA 51.3-8
11-15-72

STATE HIGHWAY ADMINISTRATION OF MARYLAND

ROAD INVENTORY SHEET

Party Chief W. DOMBROSKI
Recorder M. ZALENSKI
Helper

Map No. _____
BB REV. FR. 4-15-81 HAGERSTOWN

Road No. MUN 1500
Road Name MANILA AVE
Sheet No. 1 OF 1
Date 7-15-76
County WASHINGTON
State Coordinates

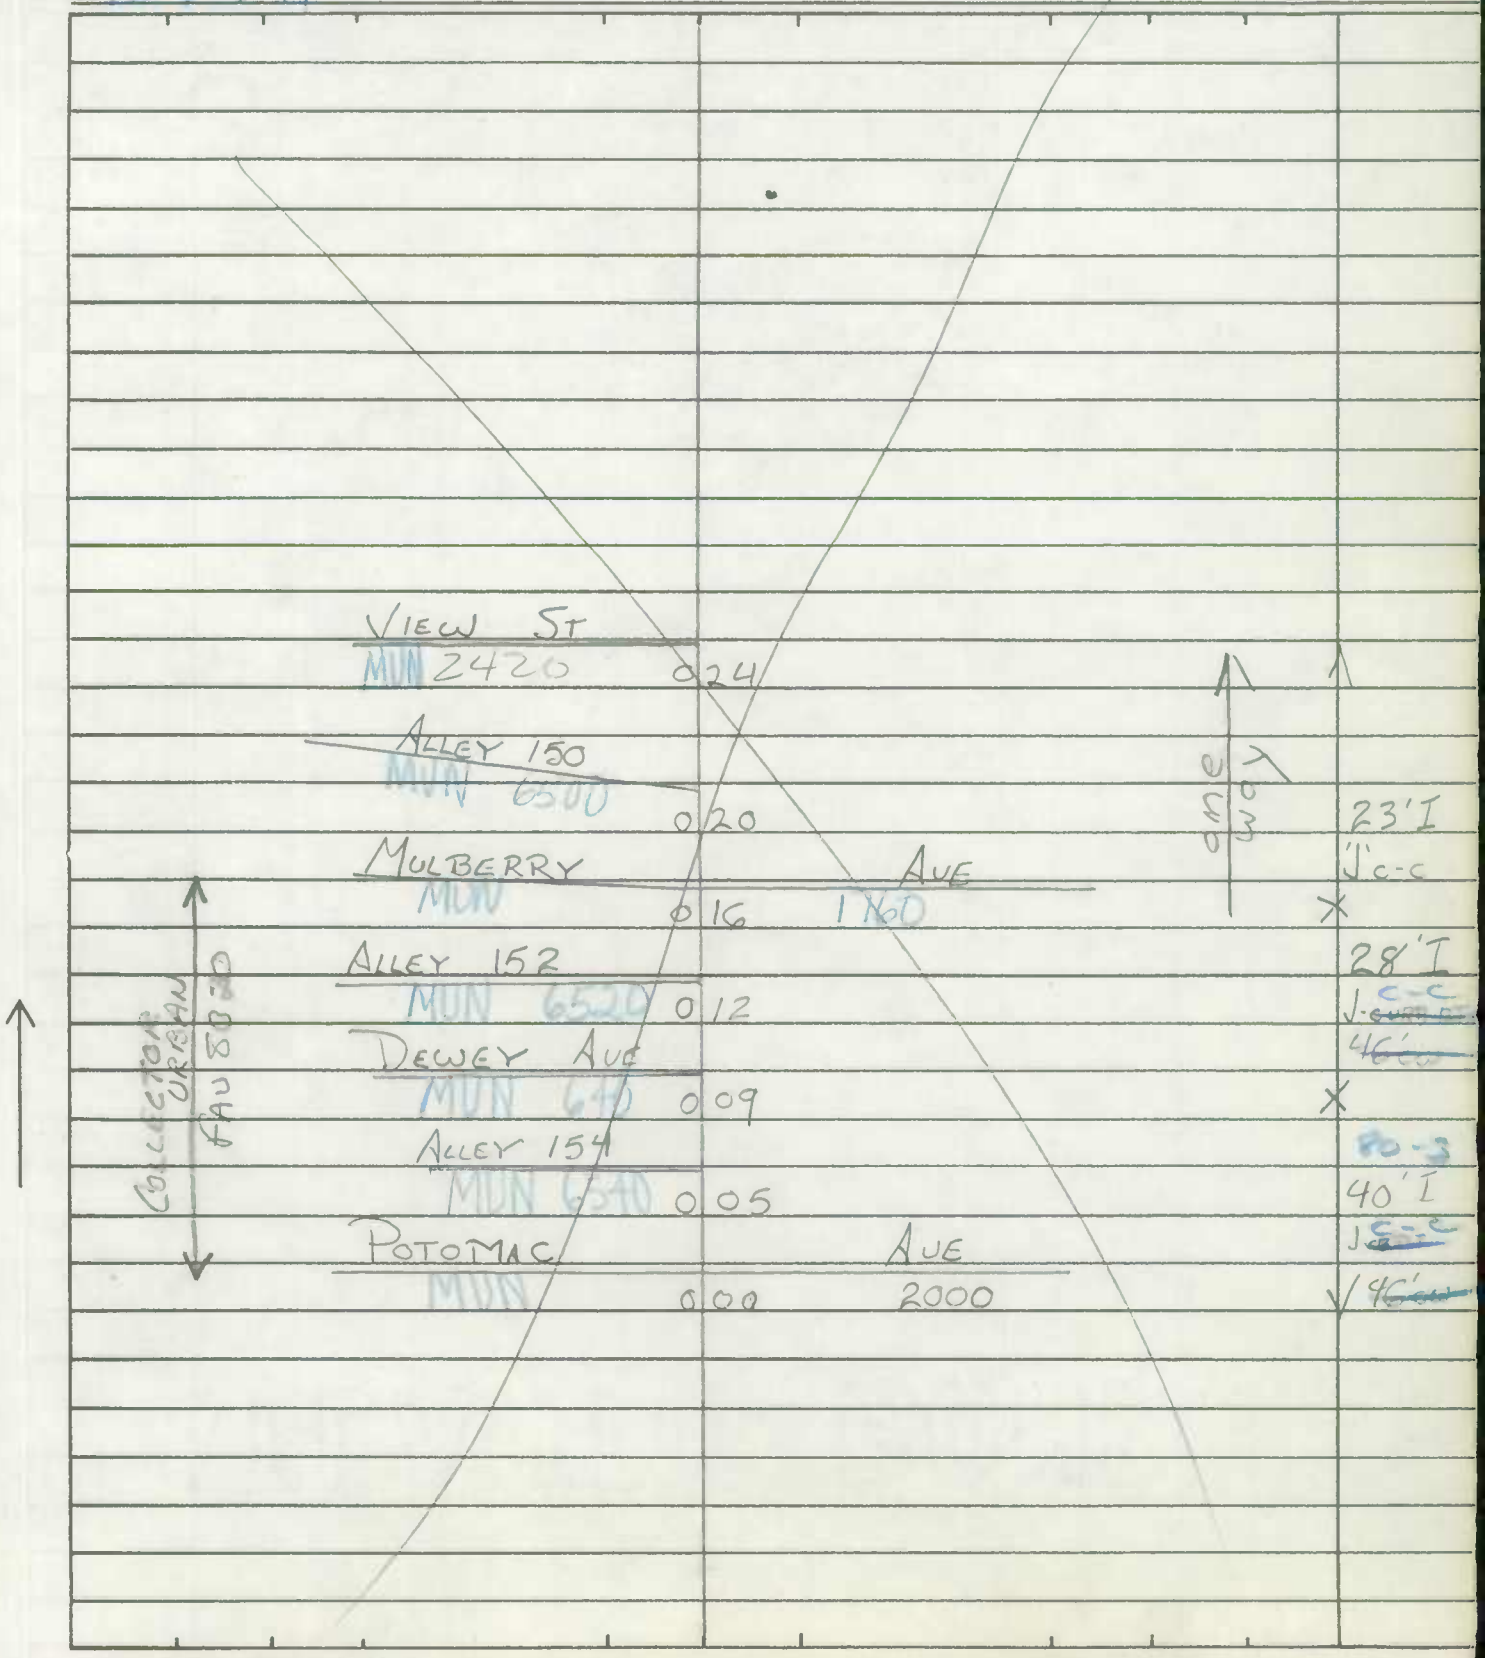

SHA 51.3-8
11-15-72

ROAD INVENTORY SHEET

Road No. _____
Road Name _____
Sheet No. _____
Date _____
County _____
State Coordinates _____

SHA 51.3-8
11-15-72

STATE HIGHWAY ADMINISTRATION OF MARYLAND

ROAD INVENTORY SHEET

Party Chief RV
Recorder LC JR
Helper

Road No. 1540
Road Name MARSHALL ST
Sheet No. 1 OF 1
Date 10-28-63
County WASHINGTON
State Coordinates

Ver 7-13-76
Map No. HAGERSTOWN
Rev 9-1-81

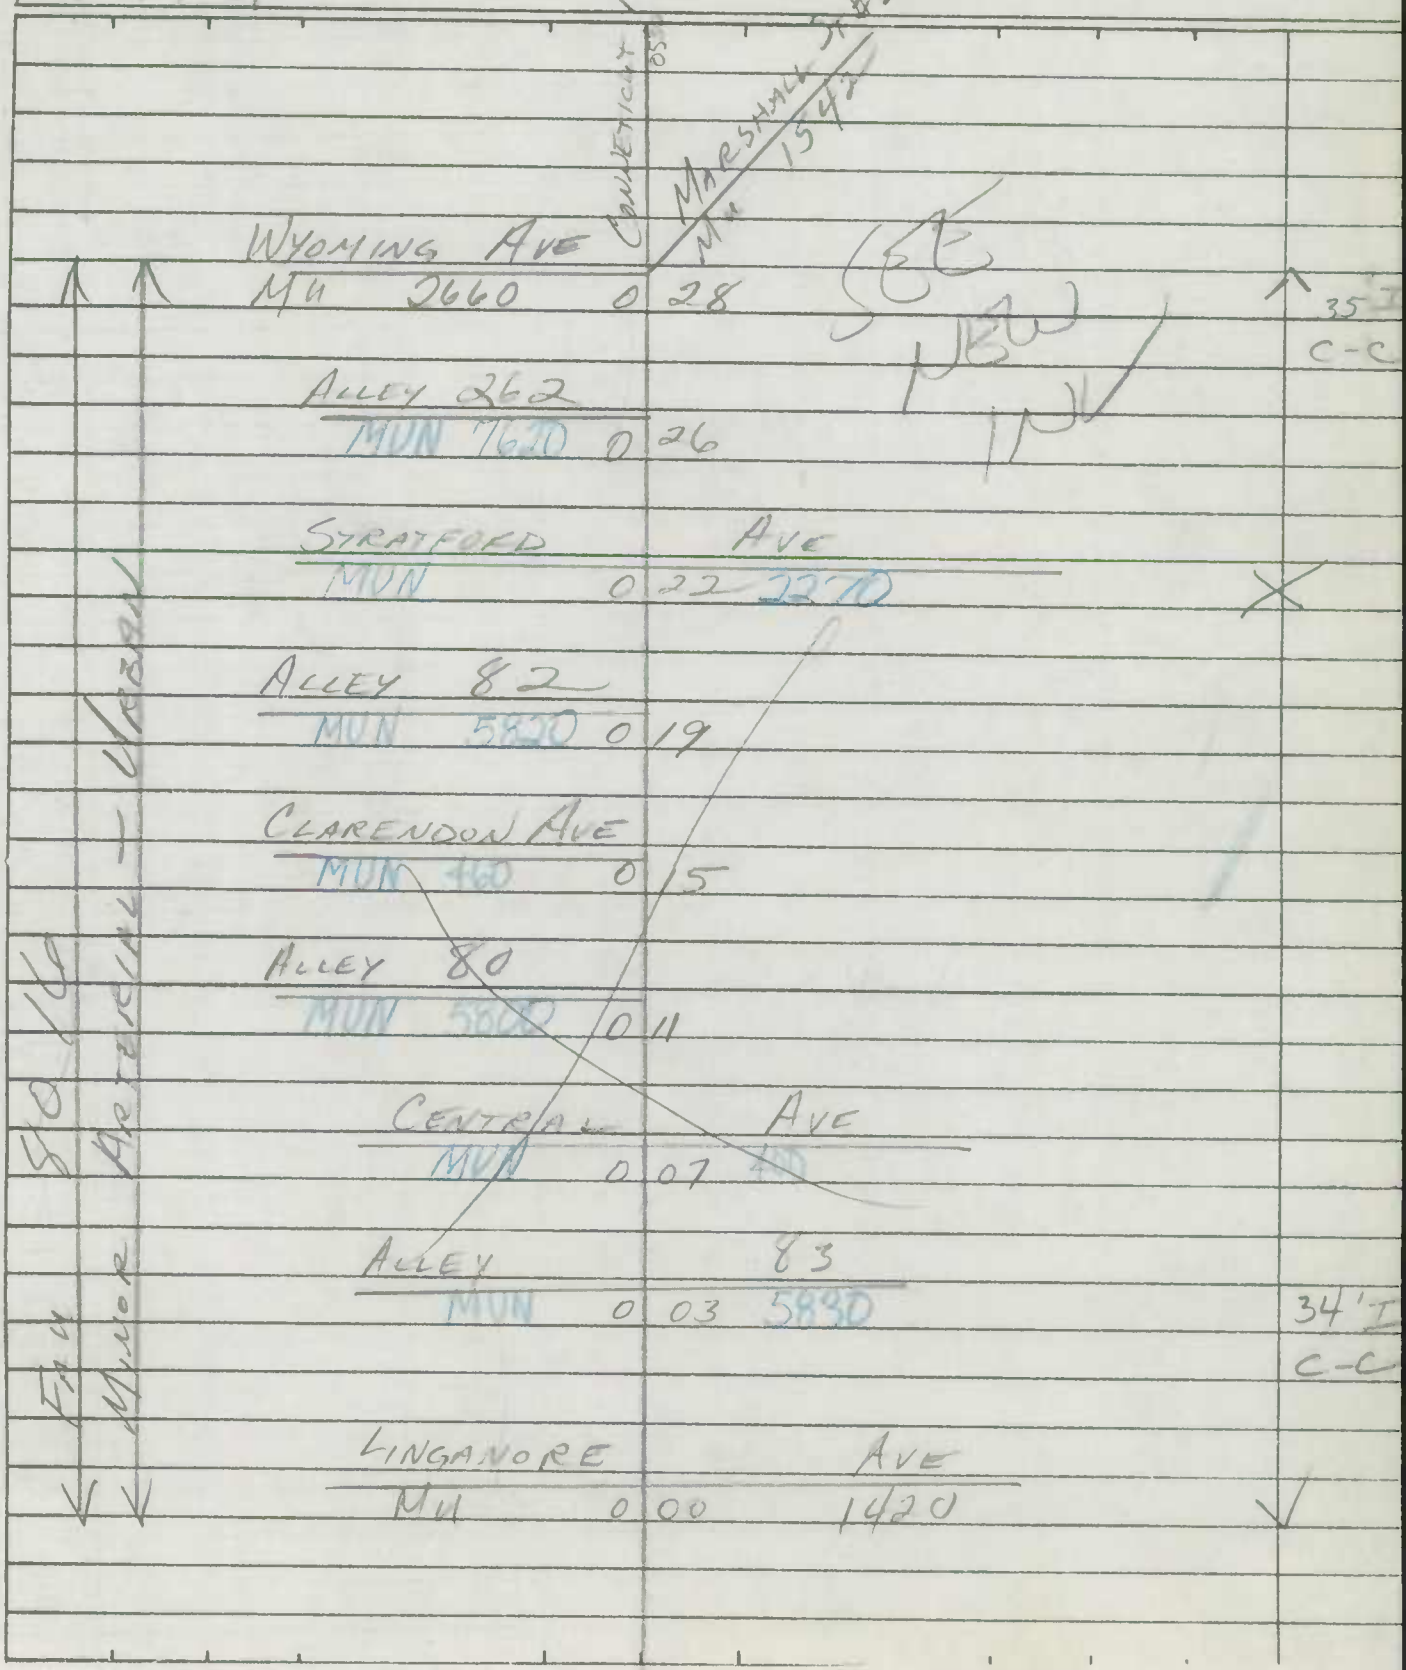

SHA 51.3-8
11-15-72

ROAD INVENTORY SHEET

Road No. _____
Road Name _____
Sheet No. _____
Date _____
County _____
State Coordinates _____

Form 6 HPS (Rev. 1961)

AT

ROAD INVENTORY SHEET

Party Chief R. Vaught
Recorder L. Coffelt, Jr.
Chainman

VER
7-13-76

Road No. 1540
Name Marshall St.
Sheet No. 1 of 1
Date 10-28-63
County Wash.

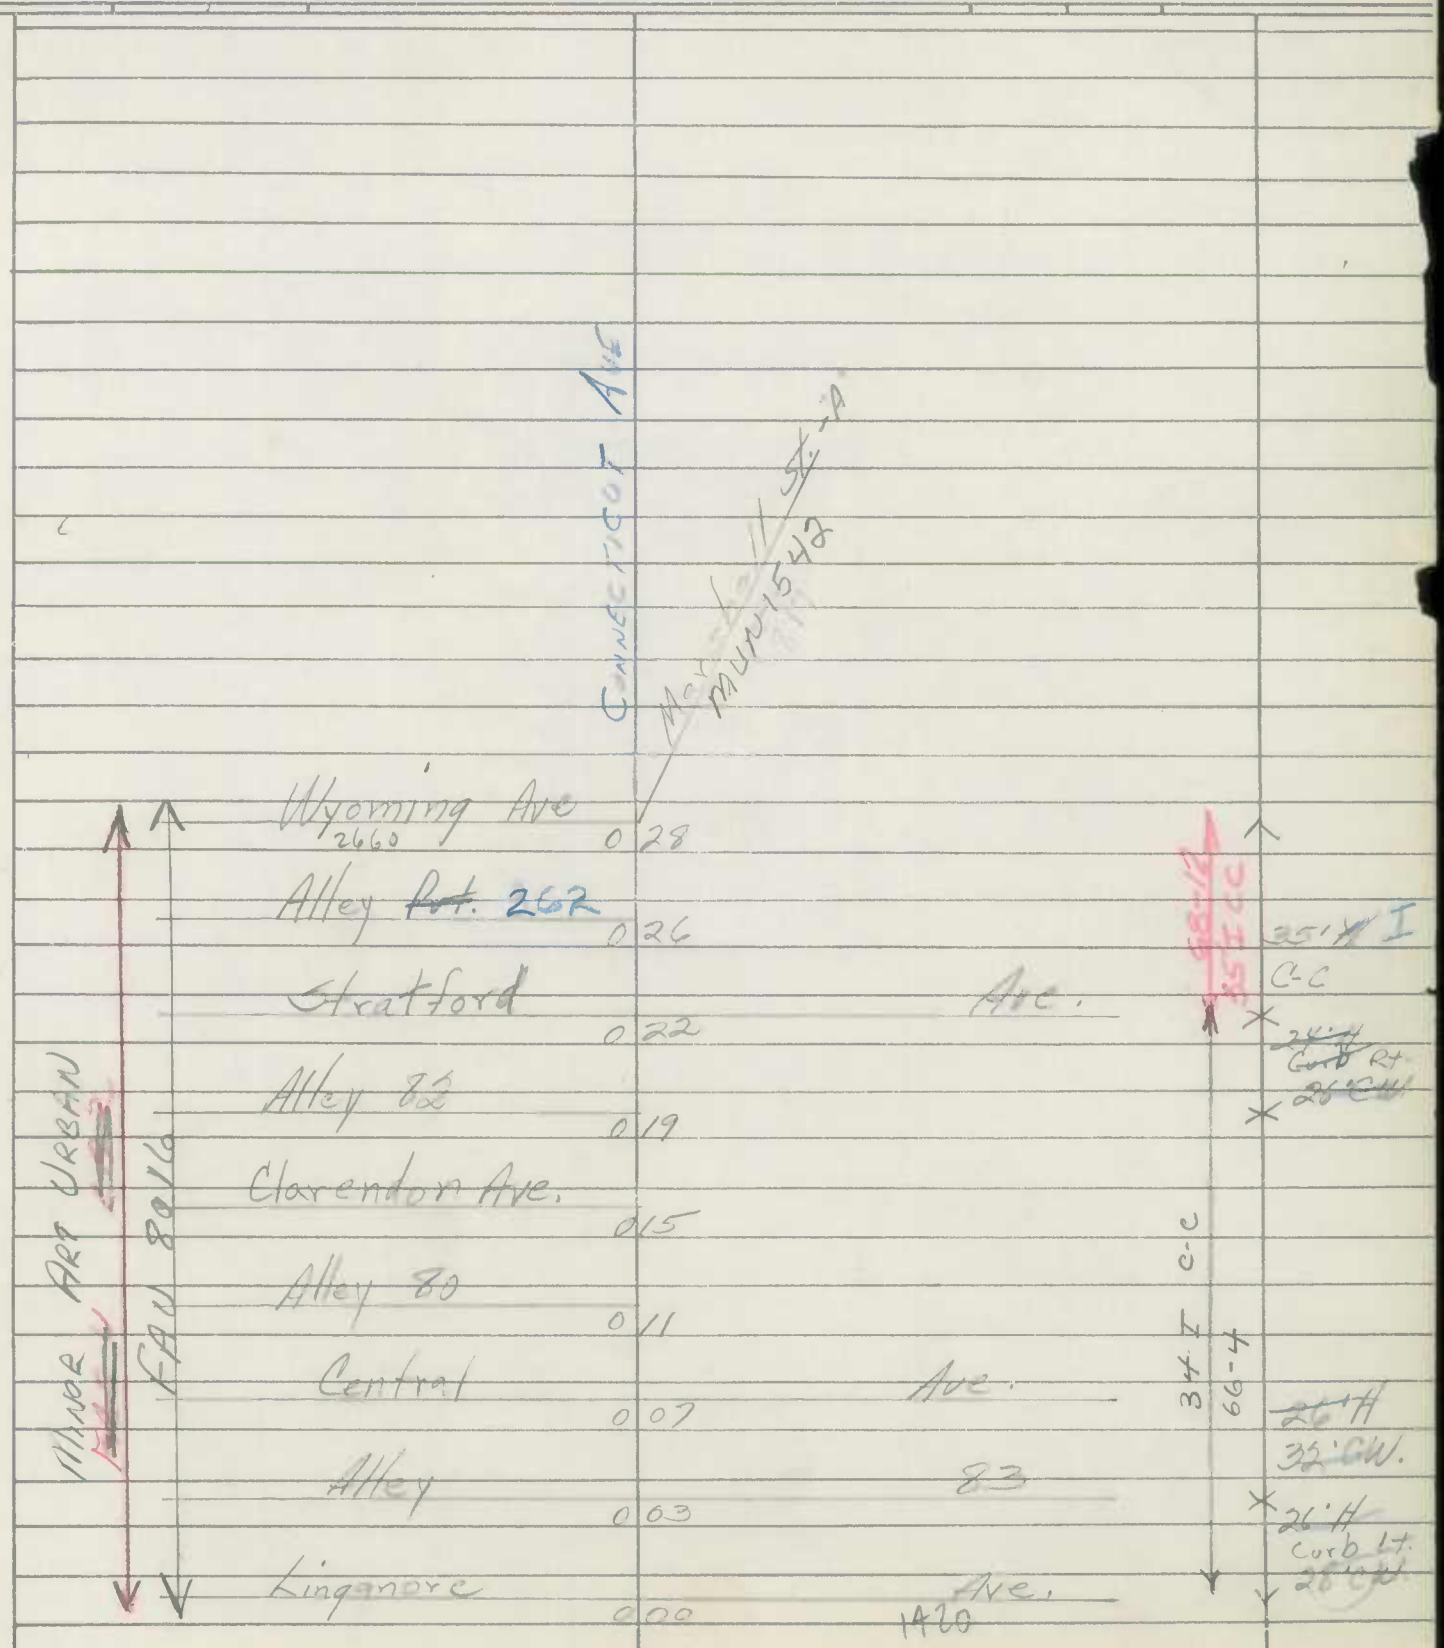

SHA 51.3-8
11-15-72

STATE HIGHWAY ADMINISTRATION OF MARYLAND

8 1 0 alt

ROAD INVENTORY SHEET

Party Chief M. BAXTER - OFF. INV.
Recorder
Helper

Map No.

Road No. MU 1542
Road Name MARSHALL ST #2
Sheet No. 1 OF 1
Date 6-10-76 REV 8-5-76
County WASH.
State Coordinates

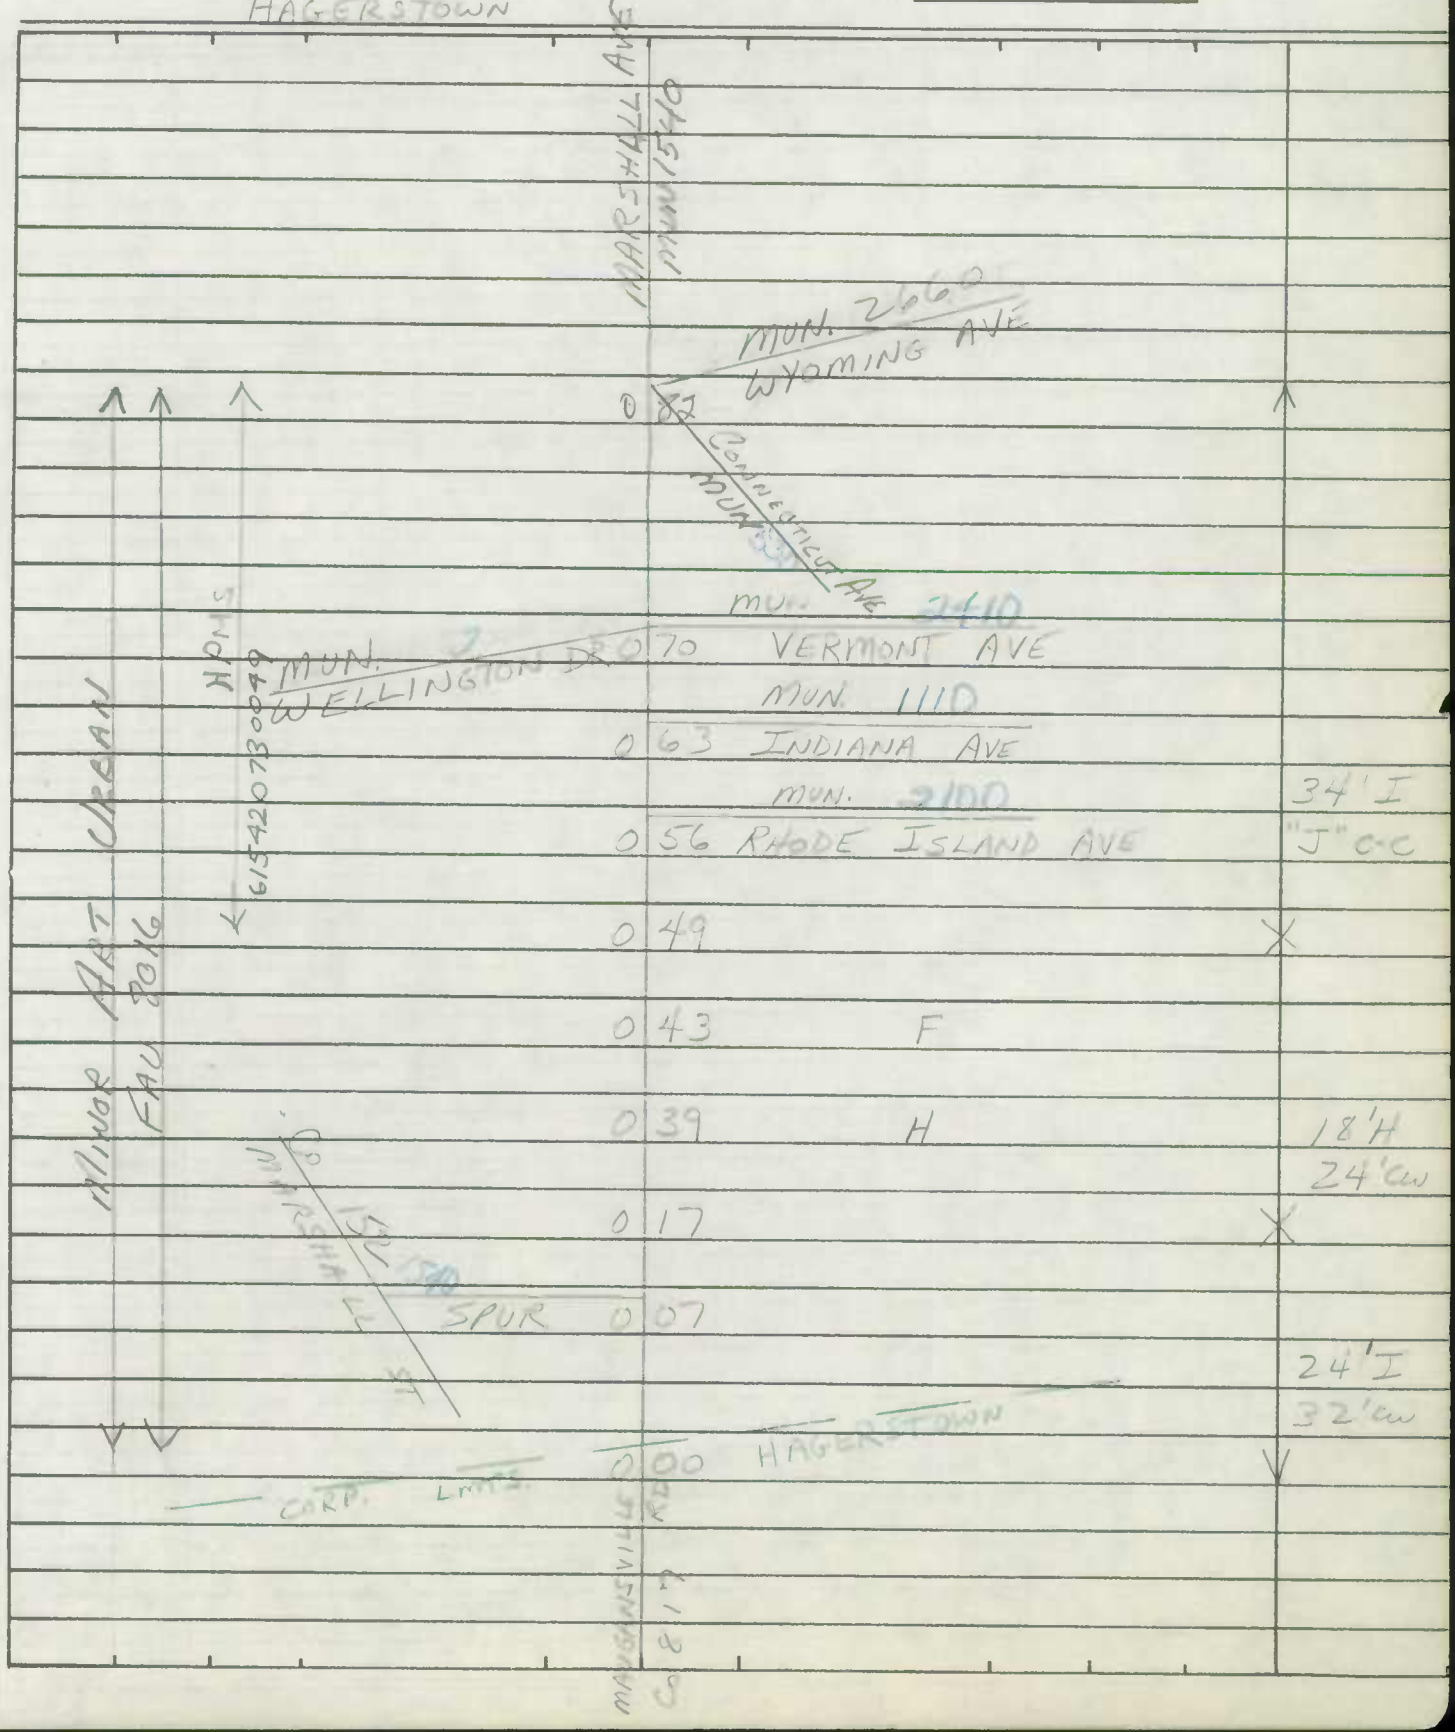

SHA 51.3-8
11-15-72

ROAD INVENTORY SHEET

Road No. _____
Road Name _____
Sheet No. _____
Date _____
County _____
State Coordinates _____

Form 6 HPS (Rev. 1961)

AT

ROAD INVENTORY SHEET

Party Chief R. ~~VOUGHT~~
Recorder
Chainman L. ~~JOFFELT~~ JR.

VER 7-14-76

HAGERSTOWN

Road No. 1550
Name MARYLAND AVE
Sheet No. 1 OF 1
Date 11-8-83
County WASHINGTON

91-4 A/T

SNJ
FCR-97
GD MP
11/10/97

MARYLAND AVE #32

MUN WILSON 0 61 2600 BLVD W

ALLEY #101
MUN 0 57 600 ST
W. FIRST ST
MUN 0 47 400
W. HOWARD ST
MUN 0 35 400
ALLEY #249
MUN 1770 0 32
ALLEY 249
MUN 1780 0 31
GARRETT ST
MUN 0 32 400
GARLINGER AVE
MUN 0 12 800
ALLEY #107
MUN 6070 0 03
MEMORIAL
MUN 0 00

54 I
C-C

FAU 8002 MINOR ART URBAN

5

Form 6 HPS (Rev. 1961)

AT

4

ROAD INVENTORY SHEET

Party Chief R. VOUGHT
Recorder L. ~~COFFELT~~ JR.
Chainman

VER 7-20-76

HAGERSTOWN

Road No. 1610
Name Mc PHERSON ST
Sheet No. 1 OF 1
Date 11-4-63
County WASHINGTON

W. WASHINGTON ST
← EAST US 0 21 40

W. FRANKLIN ST
US 40 0 11 → WEST US 40

0 05

W. CHURCH ST
0 08 0440

25'H C-C

35'J CURB CT 40'CW

35'I C-C

SHA 51.3 - 8 Revised
4.83

MARYLAND STATE HIGHWAY ADMINISTRATION

ROAD INVENTORY SHEET

Party Chief REWRITTEN SM
Recorder
Assistant
Map No./Dir. 1
State Coordinates

Road No. MUN 1620
Road Name MEALY PKWY
County WASHINGTON
Date 10-13-88
Sheet No. 1 OF 1

91-15 A/T

SYSTEM: FED. AID. | FUNCT CLASS. | HWY. SYS. | HPMS SAMPLE
TRAFFIC: PRKG. REST. | COM/IND. ACCESS

LINE DIAGRAM

HAGERSTOWN

VOID
See New I.N. 91-17 INDEX #2
3-19-92 BB/SP

MAIN AVE
M 1140

E. IRVIN PKWY
MU 1170
0 15
E. IRVIN PKWY
MU 1170
90°

90°
0 14

ALLEY 229
MU 7290
0 11

POTOMAC AVE
MU
0 00
2000

TRAFFIC: CONTROL | COM/IND. ACCESS | PRKG. REST.

PAVEMENT DATA

2-25' I LA
"J" C-C
VAR GRASS
PKWY

TRAFFIC CODES
TRAFFIC CONTROLS: STOP SIGN=SS, TRAFFIC LIGHT=T.L., FLASHING RED BALL=F.R.

TRAFFIC CODES
PARKING RESTRICTIONS: A.M. PEAK, P.M. PEAK, A.M./P.M. PEAK, NO PARKING ANYTIME=N.P., COMM/IND. ACCESS=E

SYSTEM				TRAFFIC		LINE DIAGRAM	TRAFFIC				PAVEMENT DATA
FED. AID.	FUNCT. CLASS.	HWY. SYS.	HPMS SAMPLE	PRKG. REST.	COM/IND ACCESS		CONTROL	COM/IND ACCESS	PRKG. REST.		

Form 6 HPS (Rev. 1961)

AT

ROAD INVENTORY SHEET

Party Chief
Recorder
Chainman

VER
7-20-76

Road No. 1620
Name Mealey Pkwy.
Sheet No. 1 of 1
Date 10-31-63
County Wash.

71-22-13

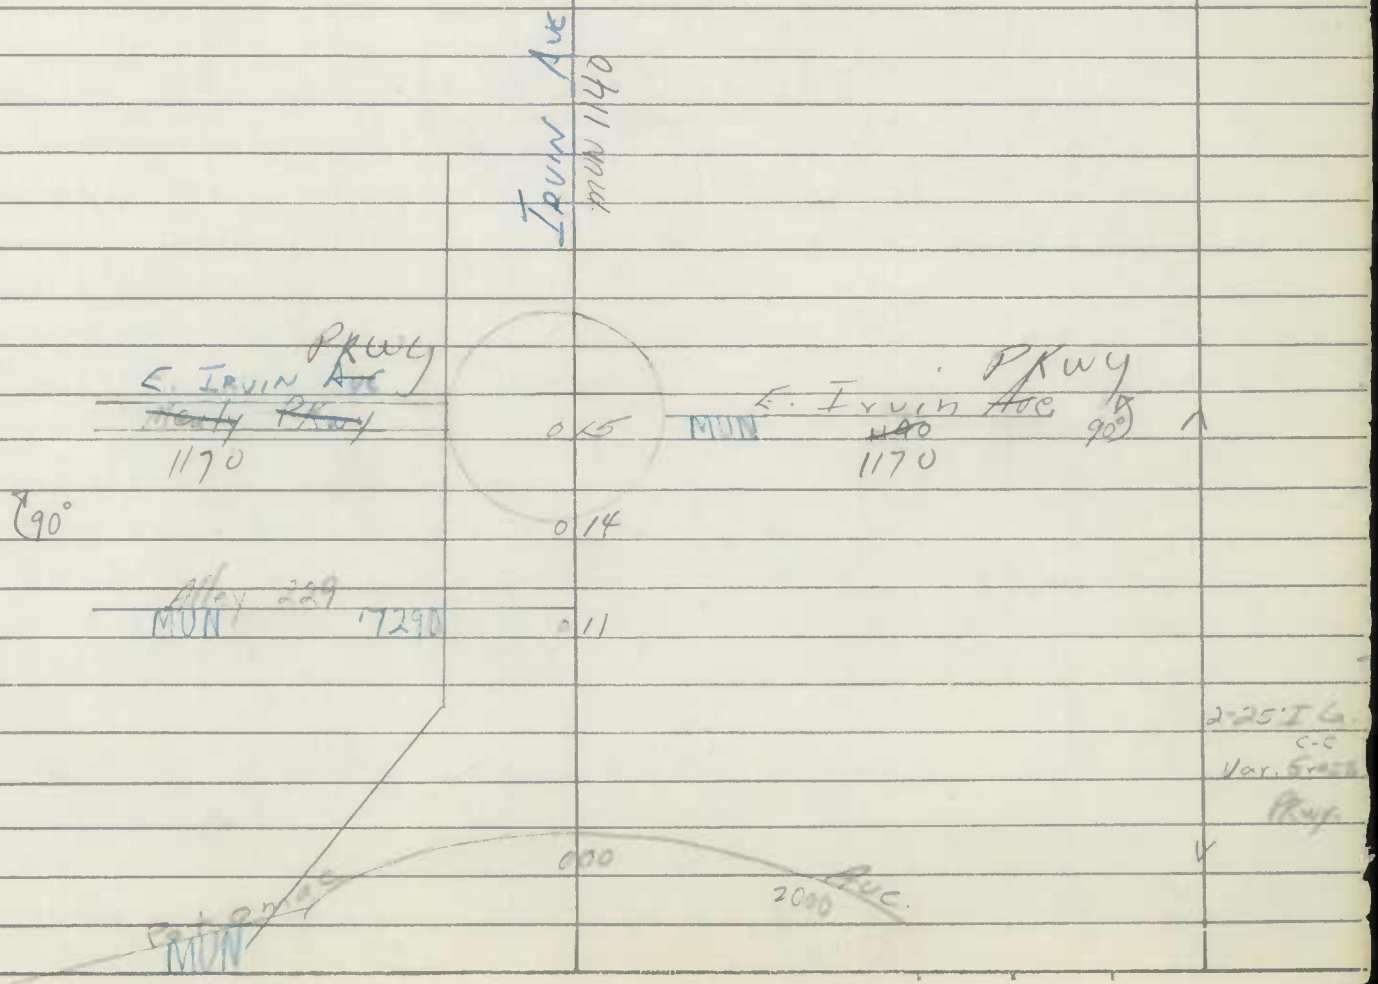

Form 6 HPS (Rev. 1961)

AT

4

ROAD INVENTORY SHEET

Party Chief R. Vought
Recorder L. Coffelt
Chainman

VER
7-14-76

Road No. 1640
Name Medway Rd.
Sheet No. 1 of 1
Date 9-17-63
County Wash.

W

A



0 07 CBC 1 W 10'x15'x63°

0 00 Mun. 2240 2212 Security Rd. 0.37 MI

← SECURITY RD

SHA 51.3 - 8 Revised
4.83

MARYLAND STATE HIGHWAY ADMINISTRATION

95-9, -11
11-7-95
GD/TM

ROAD INVENTORY SHEET

Party Chief REWRITTEN SM
Recorder
Assistant
Map No./Dir. I
State Coordinates

Road No. MUN 1650
Road Name MEMORIAL BLVD
County WASHINGTON
Date 10-13-88
Sheet No. 1 OF 4

88-13 11-25-88

TRAFFIC CODES
TRAFFIC CONTROLS: STOP SIGN=SS, TRAFFIC LIGHT=T.L., FLASHING RED BALL=F.R.

TRAFFIC CODES
PARKING RESTRICTIONS: A.M. PEAK, P.M. PEAK, A.M./P.M. PEAK, NO PARKING ANYTIME=N.P., COMM/IND. ACCESS=E

SYSTEM				TRAFFIC		LINE DIAGRAM	TRAFFIC			PAVEMENT DATA
FED. AID.	FUNCT CLASS.	HWY. SYS.	HPMS SAMPLE	PRKG. REST.	COM/IND. ACCESS	HAGERSTOWN	CONTROL	COM/IND. ACCESS	PRKG. REST.	
						SNI				~~28' I~~
						FCR 97				~~JC LT~~
						GD MP 0 23				
						11/11/87				25' I
										JC-C 2 ML
						0 19				
										34' I
										JC-C
										2 ML
						0 14 HAGERSTOWN MUN STADIUM				
										~~28' I~~
										~~36' GW~~
										24' I
										10' 2 SAG 2 FJ-C LT
						0 10				2 ML
						LTL 0 06				
						0 05		E		
										35'
										~~28' I~~
						0 03 4				JC LT
										2 ML
						LTL THE 0 01				
						EASTERN ~~BLVD~~ STATE ~~SCANNON AVE~~ Blvd				
K	K					MU ~~0705~~ 0 00 ~~MU 0342~~ 0705	TL			
						MTA ET MA 60				
						40				
						30				
						20				
						10				

LINE DIAGRAM

SYSTEM: FED. AID. | FUNCT. CLASS. | HWY. SYS. | HPMS SAMPLE

TRAFFIC: PRKG. REST. | COM/IND ACCESS

TRAFFIC: CONTROL | COM/IND ACCESS | PRKG. REST.

PAVEMENT DATA

FAU 8006
MINOR ART URBAN

30' WALL TO WALL

0 79 *CSX 139491P

30'I
"J" C-C

28'I
"J" C-C

ALLEY 120
MU 6200 0 72

S POTOMAC ST
MU 0 67 2000

25'I
"J" C-C

ALLEY 91
MU 5910 0 36

FREDERICK ST
US 40 0 33 AL

TL

ALLEY 125
MU 6250 0 28

SAME

SHA 51.3 - 8 Revised
4.83

MARYLAND STATE HIGHWAY ADMINISTRATION

ROAD INVENTORY SHEET

Party Chief REWRITTEN SM
Recorder
Assistant
Map No./Dir. 1
State Coordinates

Road No. MUN 1650
Road Name MEMORIAL BLVD
County WASHINGTON
Date 10-13-88
Sheet No. 3 OF 4

TRAFFIC CODES
TRAFFIC CONTROLS: STOP SIGN=SS, TRAFFIC LIGHT=T.L., FLASHING RED BALL=F.R.

TRAFFIC CODES
PARKING RESTRICTIONS: A.M. PEAK, P.M. PEAK, A.M./P.M. PEAK, NO PARKING ANYTIME=N.P., COMM/IND. ACCESS=E

SYSTEM				TRAFFIC		LINE DIAGRAM	TRAFFIC			PAVEMENT DATA
FED. AID.	FUNCT CLASS.	HWY. SYS.	HPMS SAMPLE	PRKG. REST.	COM/IND. ACCESS		CONTROL	COM/IND. ACCESS	PRKG. REST.	
						HAGERSTOWN				
						SURREY AVE MUN 2330				
						GUILFORD MUN 0940 1 06				26'I
										'J' C-C
						ALLEY 119 MUN 6190 1 02			X	
						1 01 PT				
						40°				
						0 96 PC				
						REYNOLDS AVE MUN 2090 PT 0 89				25'I
						0 88			X	'J' C-C
						MARYLAND AVE MUN T550 70° 0 85				
						1 PC 0 82				
										SME

FAU 8006
MINOR ART URBAN

SYSTEM | TRAFFIC | LINE DIAGRAM | TRAFFIC | PAVEMENT DATA

SYSTEM: FED. AID. | FUNCT. CLASS. | HWY. SYS. | HPMS SAMPLE
TRAFFIC: PRKG. REST. | COM/IND ACCESS
TRAFFIC: CONTROL | COM/IND ACCESS | PRKG. REST.

FAU 8006
MINOR ART URBAN

KEY ST. 800
KEY 3
M

S PROSPECT ST
MU 1 22 2030

MU VIRGINIA AVE
1 19 2330

ALLEY 118
MUN 6180 1 18

SUMMIT AVE
MUN 1 14 2300

76'I
"J" C-C

SAME

SHA 51.3-8
11-15-72

STATE HIGHWAY ADMINISTRATION OF MARYLAND

ROAD INVENTORY SHEET

Party Chief RV
Recorder LC JR
Helper

Map No. HAGERSTOWN

Road No. 1650
Road Name MEMORIAL BLVD
Sheet No. 1 OF 3
Date 9-10-43
County WASHINGTON
State Coordinates

Ver 7-10-76
Rev 9-1-81

82-1+2 NS EM

30' I
C-C
B & O
0 79
RR
30' Wall to Wall
Bø 139 491 P
CSX
28' I
C-C
ALLEY 120
MUN 6200
0 72
S POTOMAC ST
MUN
0 67
2000
CEMETARY
0 48
25'
I
C-C
ALLEY 91
0 36
FREDERICK ST
US 40
0 33
AL
28' I
J-c LT
ALLEY 125
0 28
0 23
28' I
36' CW
0 14
HAGERSTOWN MUN STADIUM
0 05
0 02
0 01
28' I
C LT
EASTERN BLVD
(86-1)
MUN 0705
0 00
SCANNON AVE
MUN 0342
RxR

SHA 51.3-8
11-15-72

ROAD INVENTORY SHEET

Road No. 1650
Road Name MEMORIAL BLVD
Sheet No. 2 OF 3
Date 9-10-63
County WASHINGTON
State Coordinates

HAGERSTOWN

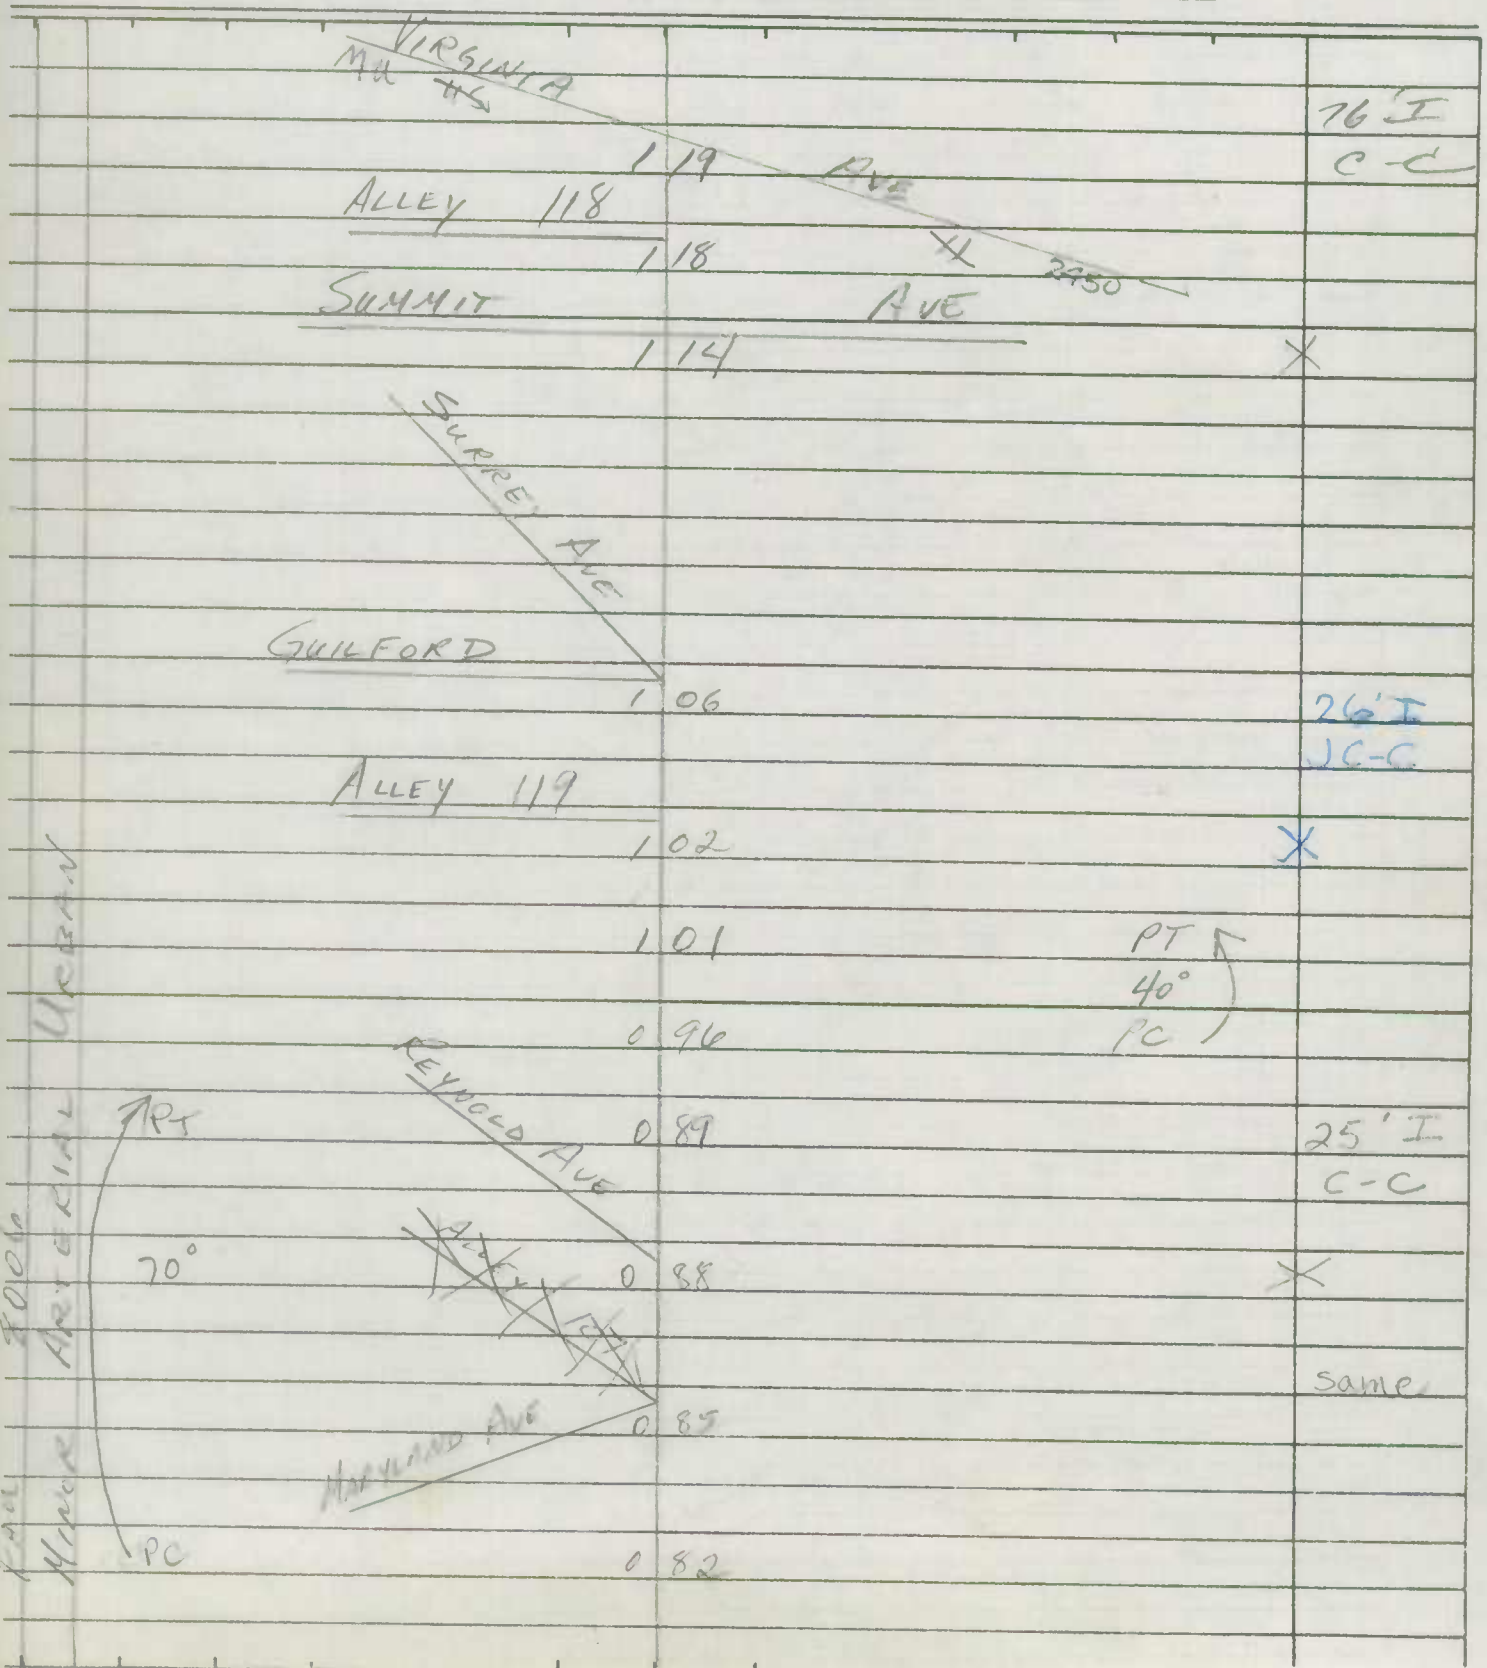

SHA 51.3-8
11-15-72

STATE HIGHWAY ADMINISTRATION OF MARYLAND

ROAD INVENTORY SHEET

Party Chief RV
Recorder KC
Helper

Map No. HAGERSTOWN

Road No. 1650
Road Name MEMORIAL BLVD
Sheet No. 3 OF 3
Date 9-10-63
County WASHINGTON
State Coordinates

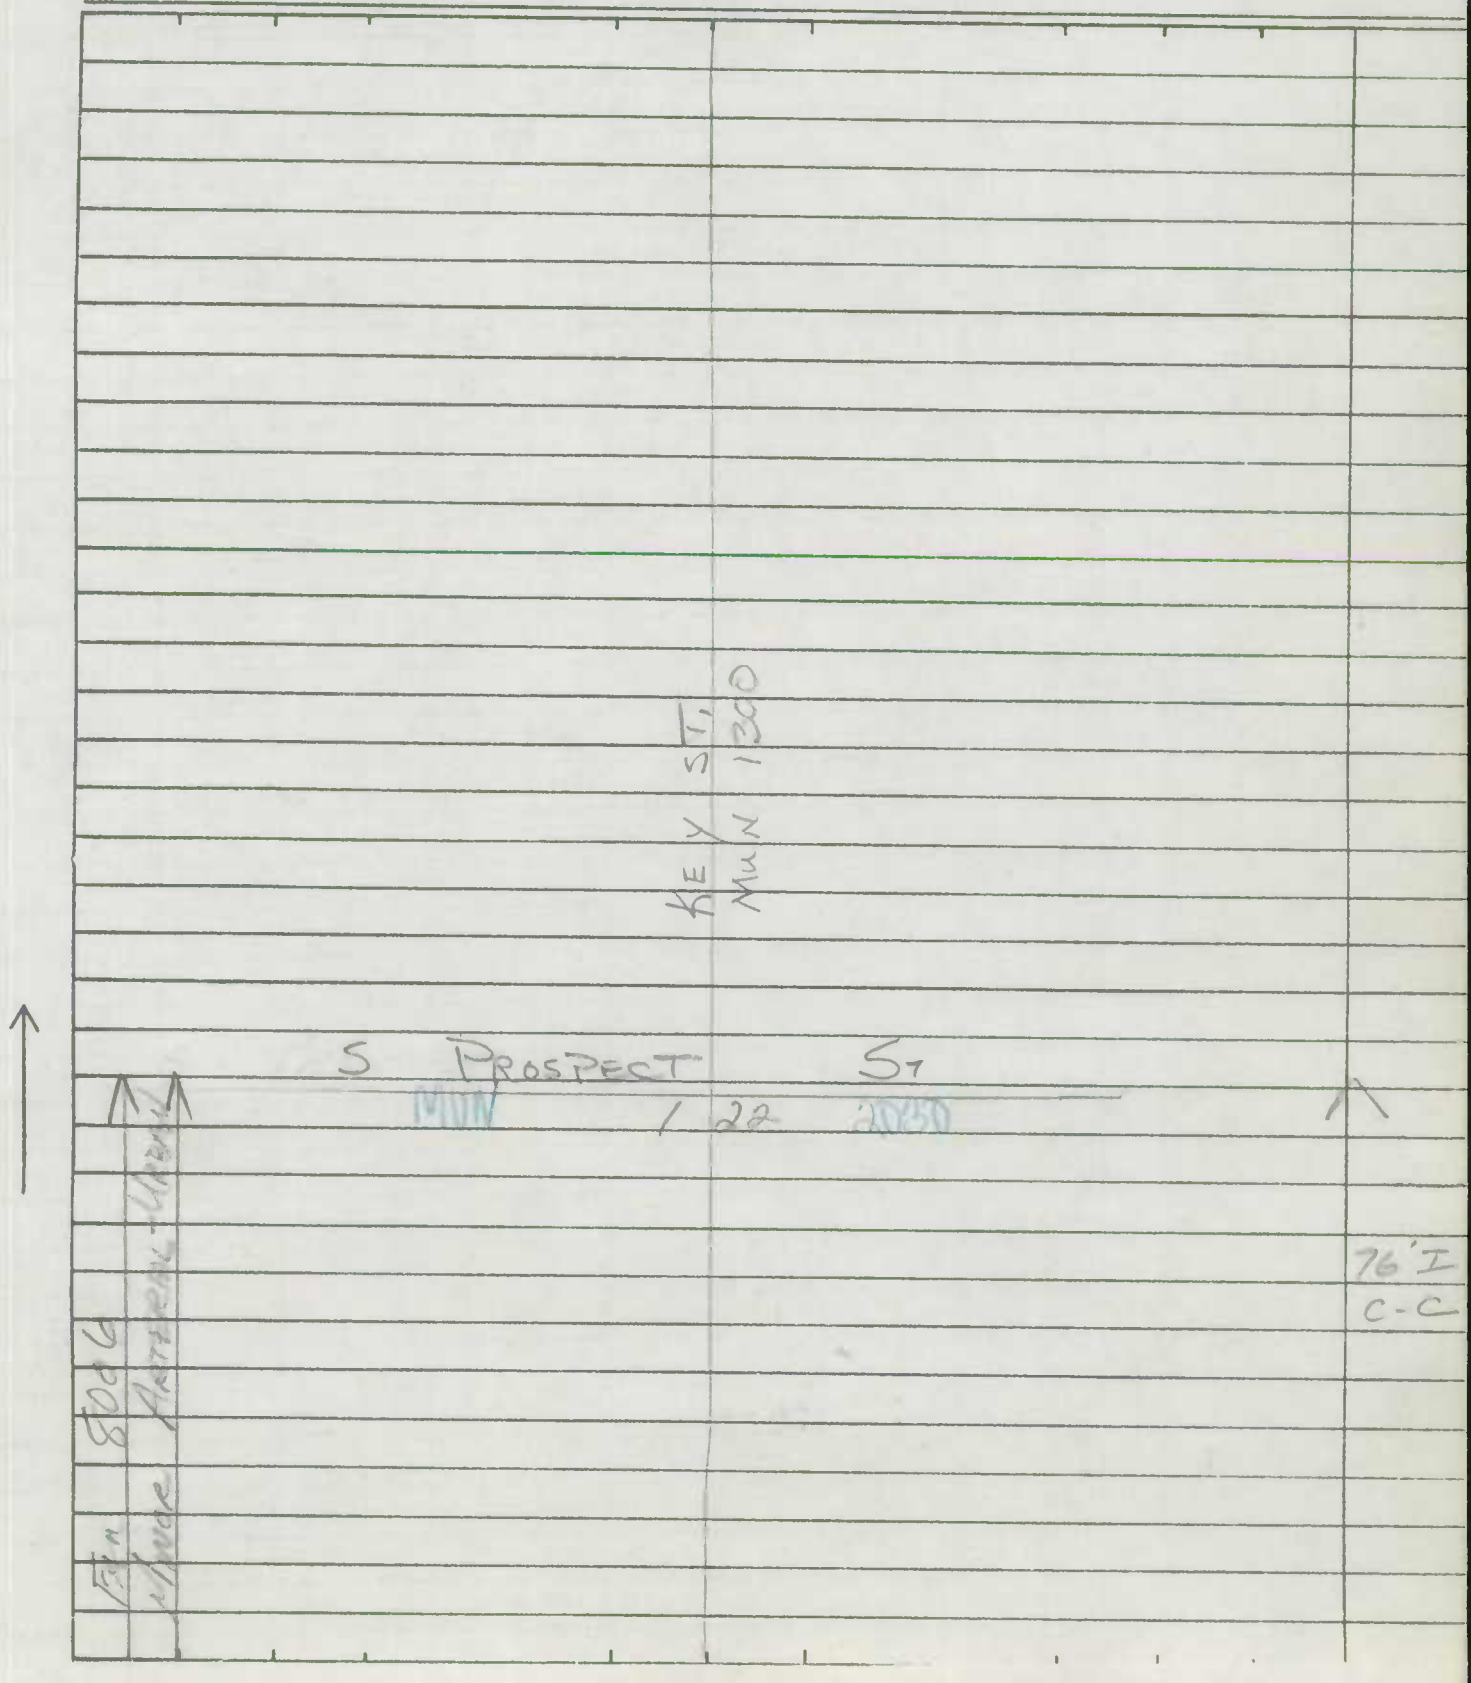

SHA 51.3-8
11-15-72

ROAD INVENTORY SHEET

Road No. _____
Road Name _____
Sheet No. _____
Date _____
County _____
State Coordinates _____

Form 6 HPS (Rev. 1961)

ROAD INVENTORY SHEET

Party Chief R. Vought
Recorder L. Coffelt Jr.
Chainman

VER
7-16-76

Road No. 1650
Name Memorial Blvd
Sheet No. 1 of 2
Date 9-10-63
County Wash.

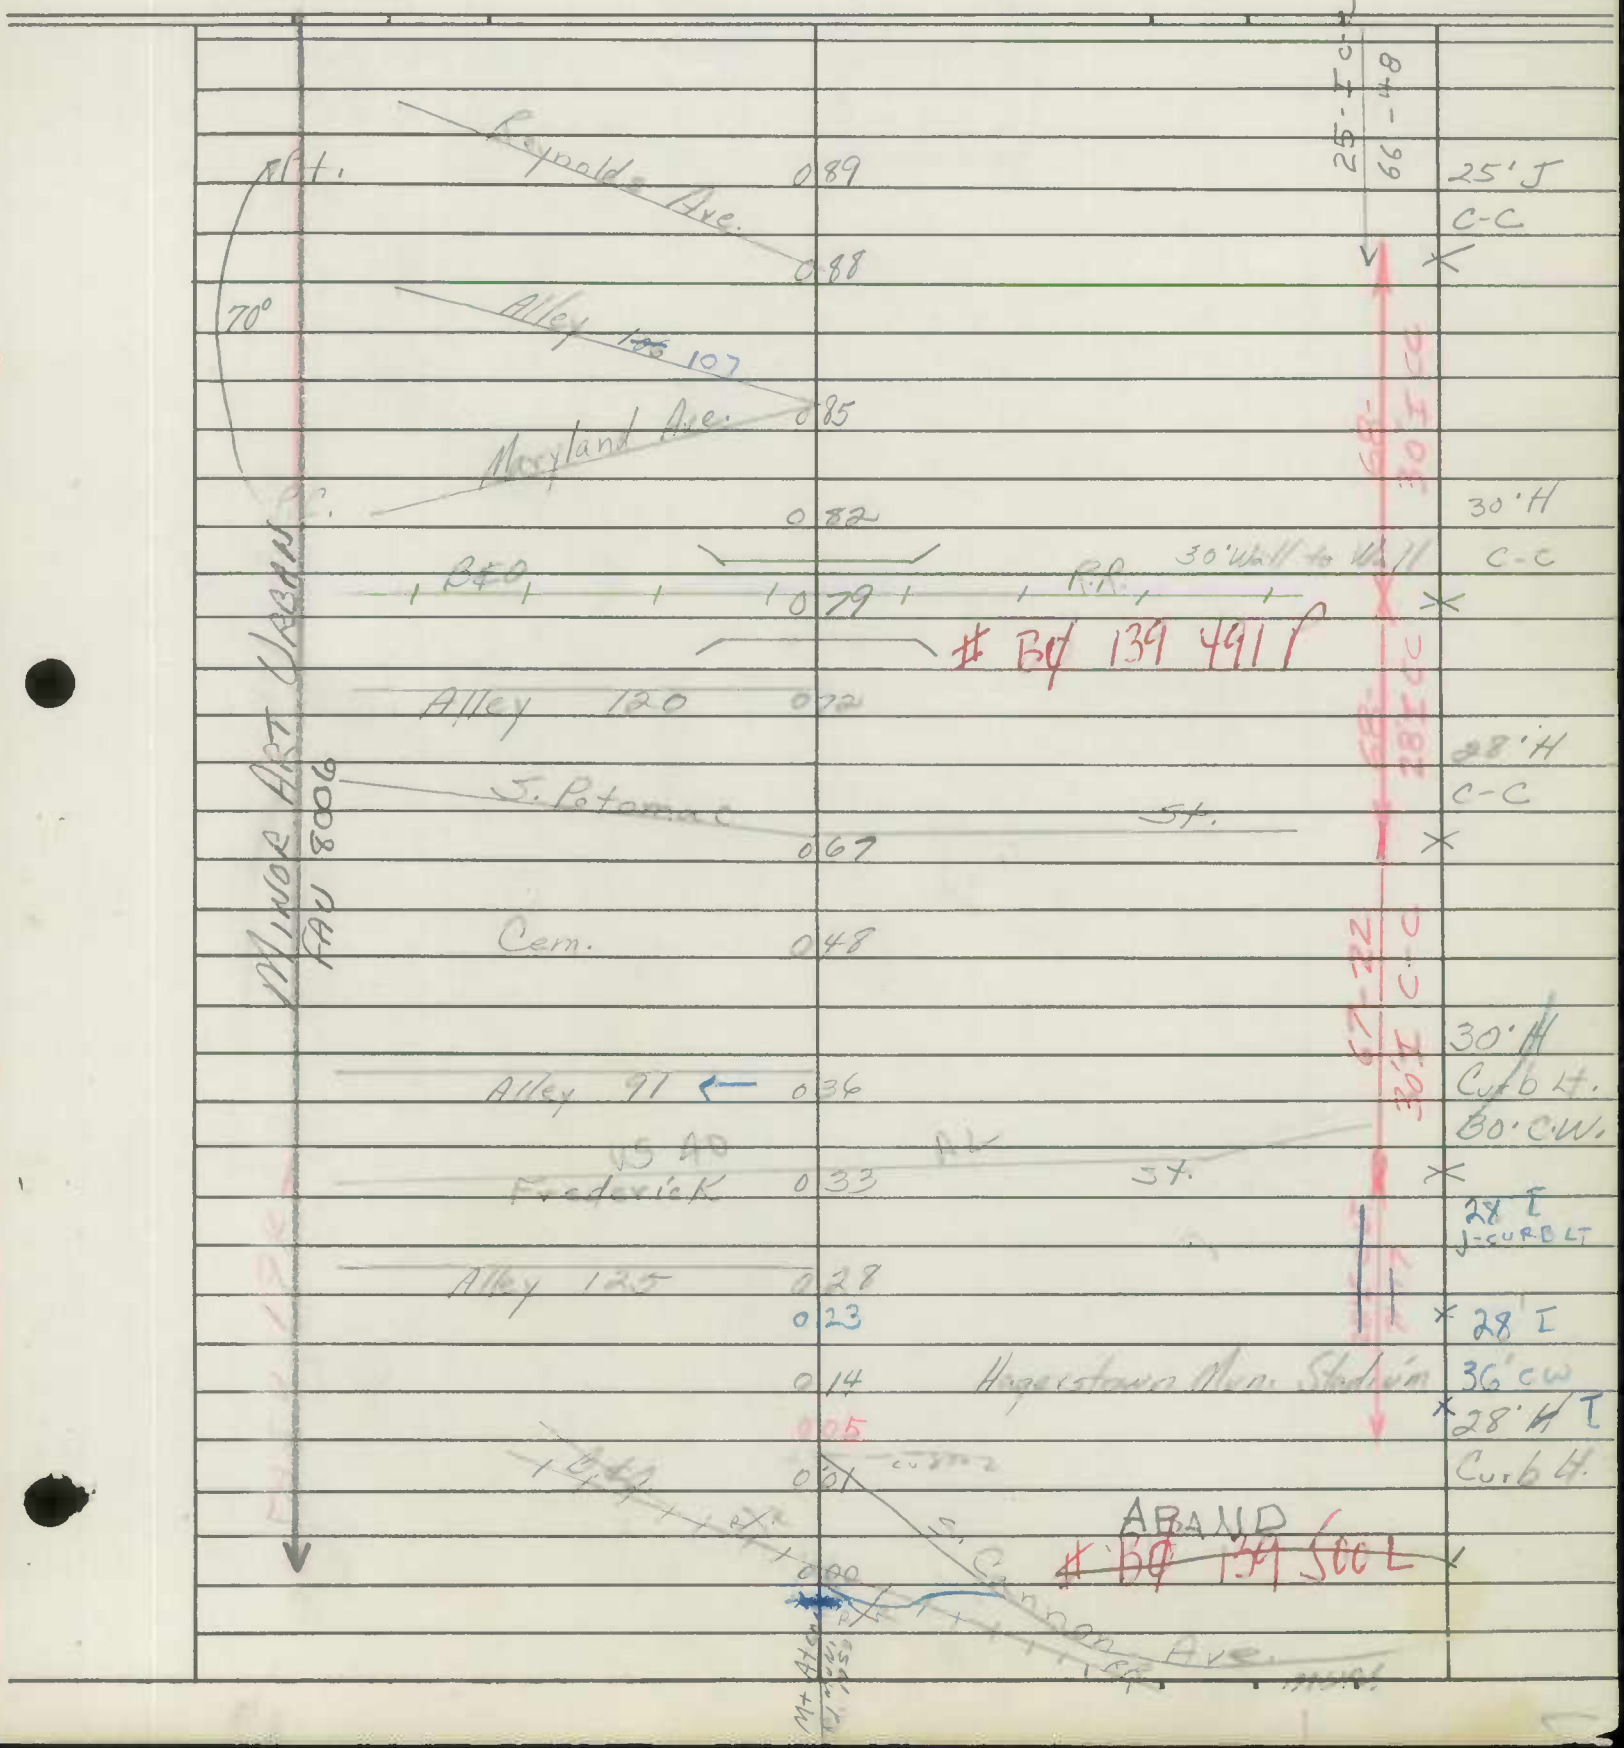

Form 6 HPS (Rev. 1961)

ROAD INVENTORY SHEET

Party Chief P. Vaught
Recorder L. Coffelt, Jr
Chainman

Road No.
Name Memorial Blvd.
Sheet No. 2 of 2
Date 9-10-63
County Wash.

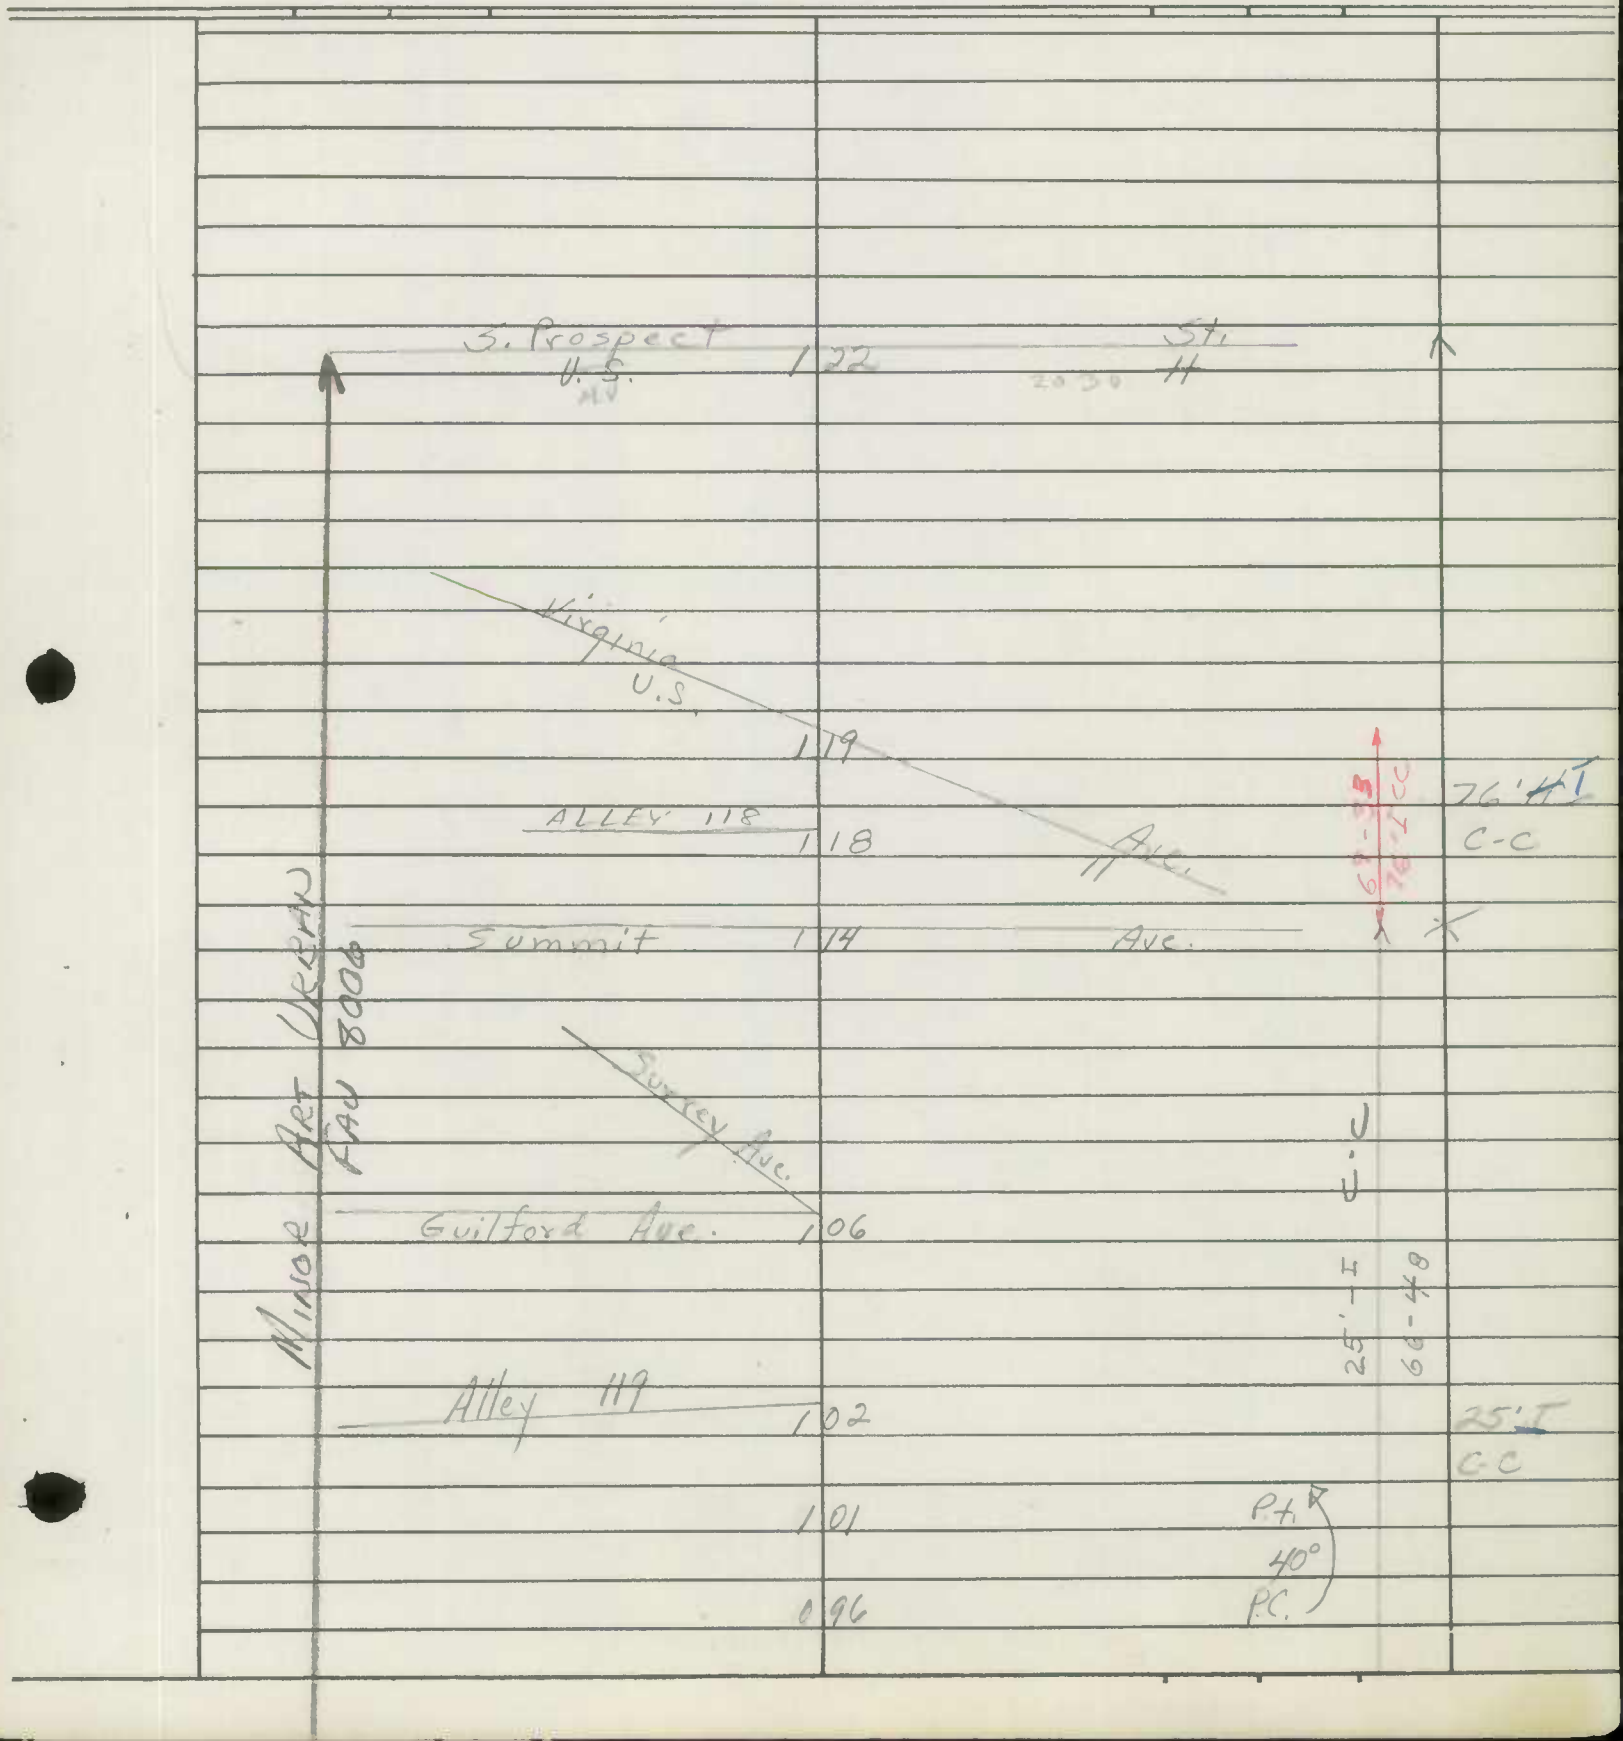

SHA 51.3-8
11-15-72

STATE HIGHWAY ADMINISTRATION OF MARYLAND

ROAD INVENTORY SHEET

Party Chief W. DOMBROSKI
Recorder M. ZALENSKI
Helper

Road No. MU 1690
Road Name MITCHELL AVE
Sheet No. 1 OF 1
Date 7-15-76
County WASH
State Coordinates

Map No.

HAGERSTOWN

BURHANS BLVD

PARK LANE 1930

0.73 — 0.300

0.70

0.64 — 90°

0.59 — 40°

0.44 — 30°

0.39

0.38

0.33

LANGDON ST — MUN 1330 — 0.29

CARR ST — MUN 350 — 0.20

FREEMONT ST. — MUN 860 — 0.15

HAMMOND ST — MUN 0980 — 0.08

MECHANIC ST — Mun 1630

ALLEY — MUN — 0.03 — 140 — 1400

SALEM AVE — MD — 0.00 — 2200

SNT
FCR - 97
60 MP
11/13/97

537 891 V

22'L 4 CONST 1917 M'U SW LT 12'6 OVERHEAD

90°
35°
40°

30'I J'c-c
31'I J'c-c
32'I J'c-c
30'I J'c-c
34'I J'c-c

FA RECTIFIER

NO 2 SOUTH BOUND

one way

N

SHA 51.3-8
11-15-72

ROAD INVENTORY SHEET

Road No. _____
Road Name _____
Sheet No. _____
Date _____
County _____
State Coordinates _____

Form 6 HPS (Rev. 1961)

AT

ROAD INVENTORY SHEET

Party Chief R. Vought
Recorder L. Coffelt, Jr.
Chainman

VER 7-13-76

Road No. 1700
Name Mitchell St.
Sheet No. 1 of 1
Date 10-28-63
County Wash.

Mechanic MUN 009 St. 1630

Alley 269

007 Cook St.

005 MUN 530

Alley 140 MUN 0400

004

Alley 143 MUN 0430

002

Salem Rd. MU 000 Ave. 58.

20' 66' 33'

20' AT
Curb Pt.
26' CW.

Form 6 HPS (Rev. 1961)

ROAD INVENTORY SHEET

MUN. No. 1710

Party Chief R. Vaught
Recorder L. Coffelt, Jr
Chainman

VER 7-15-76

Road No. ~~County~~
Name Moller Ave.
Sheet No. 1 of 1
Date 9-19-63
County Wash.

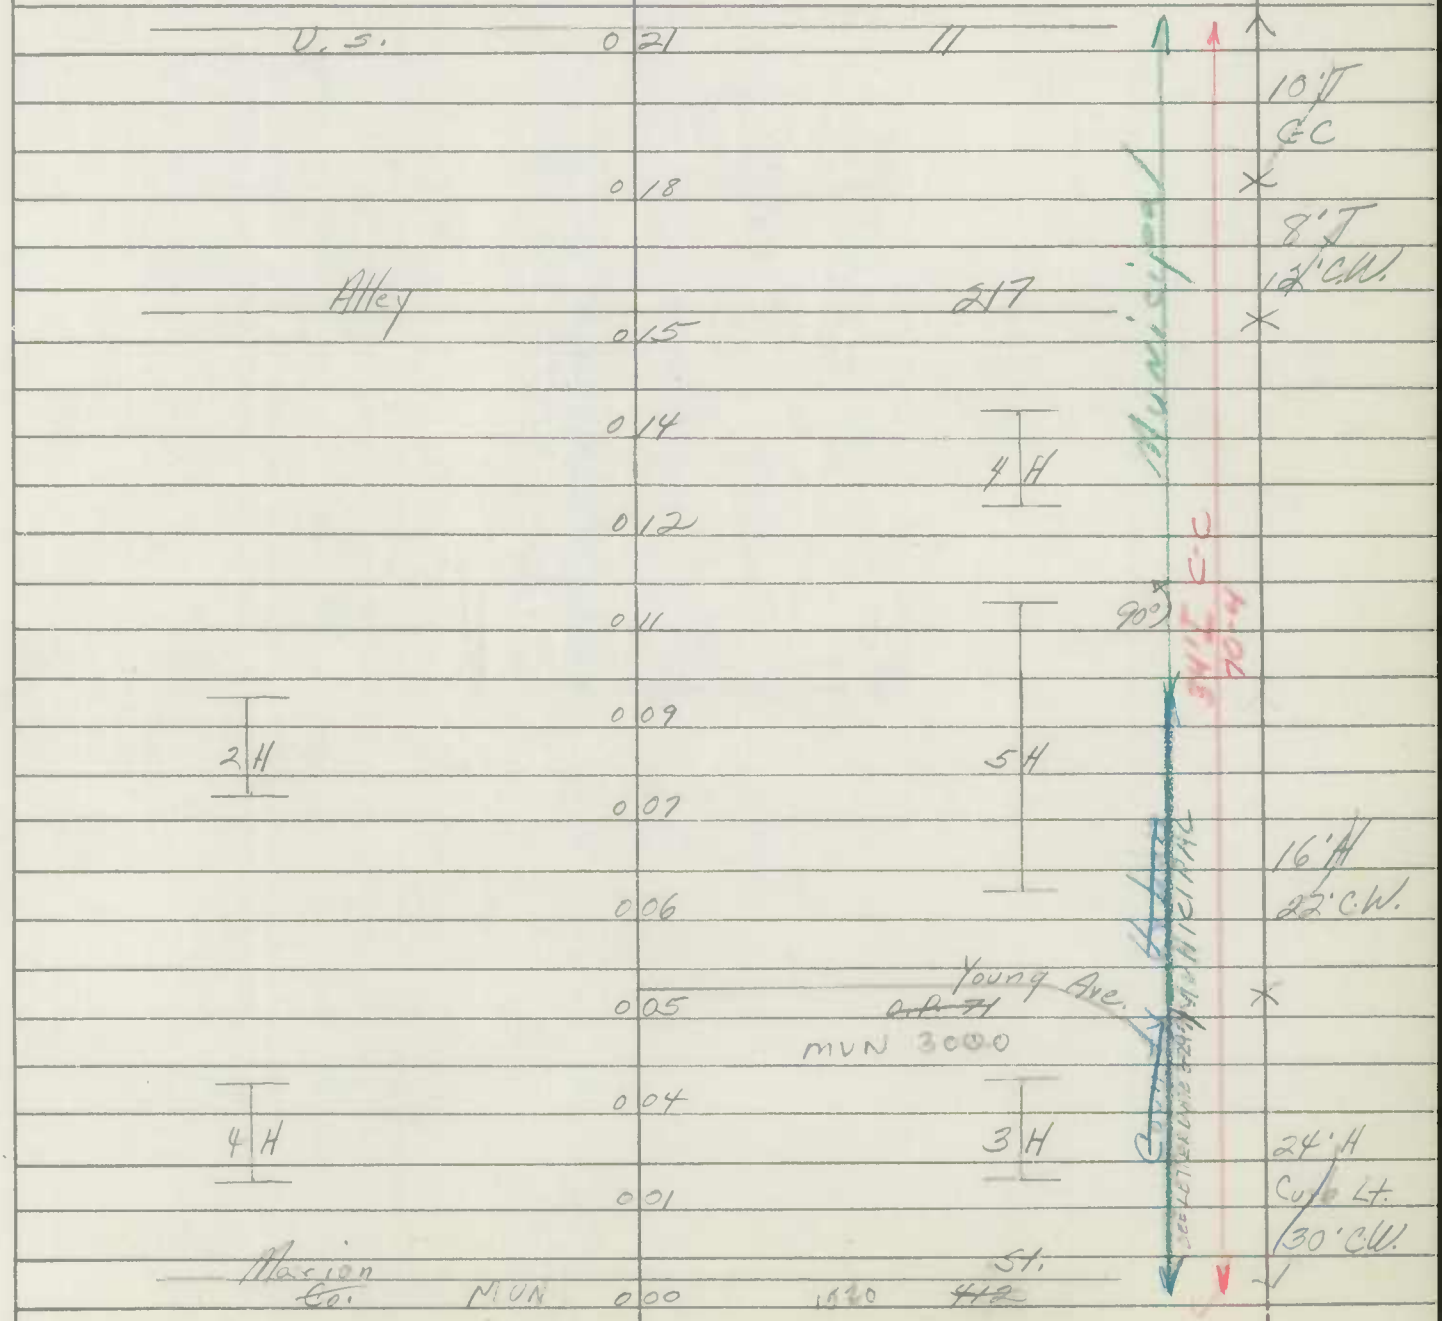

Form 6 HPS (Rev. 1961)

ALIKS 57-41 8-29-58

AT 09-71

ROAD INVENTORY SHEET

Party Chief R. VOUGHT
Recorder L. [illegible] JEFFELT JR.
Chainman

HAGERSTOWN

VER. 7-14-96

Road No. 1720
Name MOLLER PARKWAY
Sheet No. 1 OF 1
Date 10-30-63
County WASHINGTON

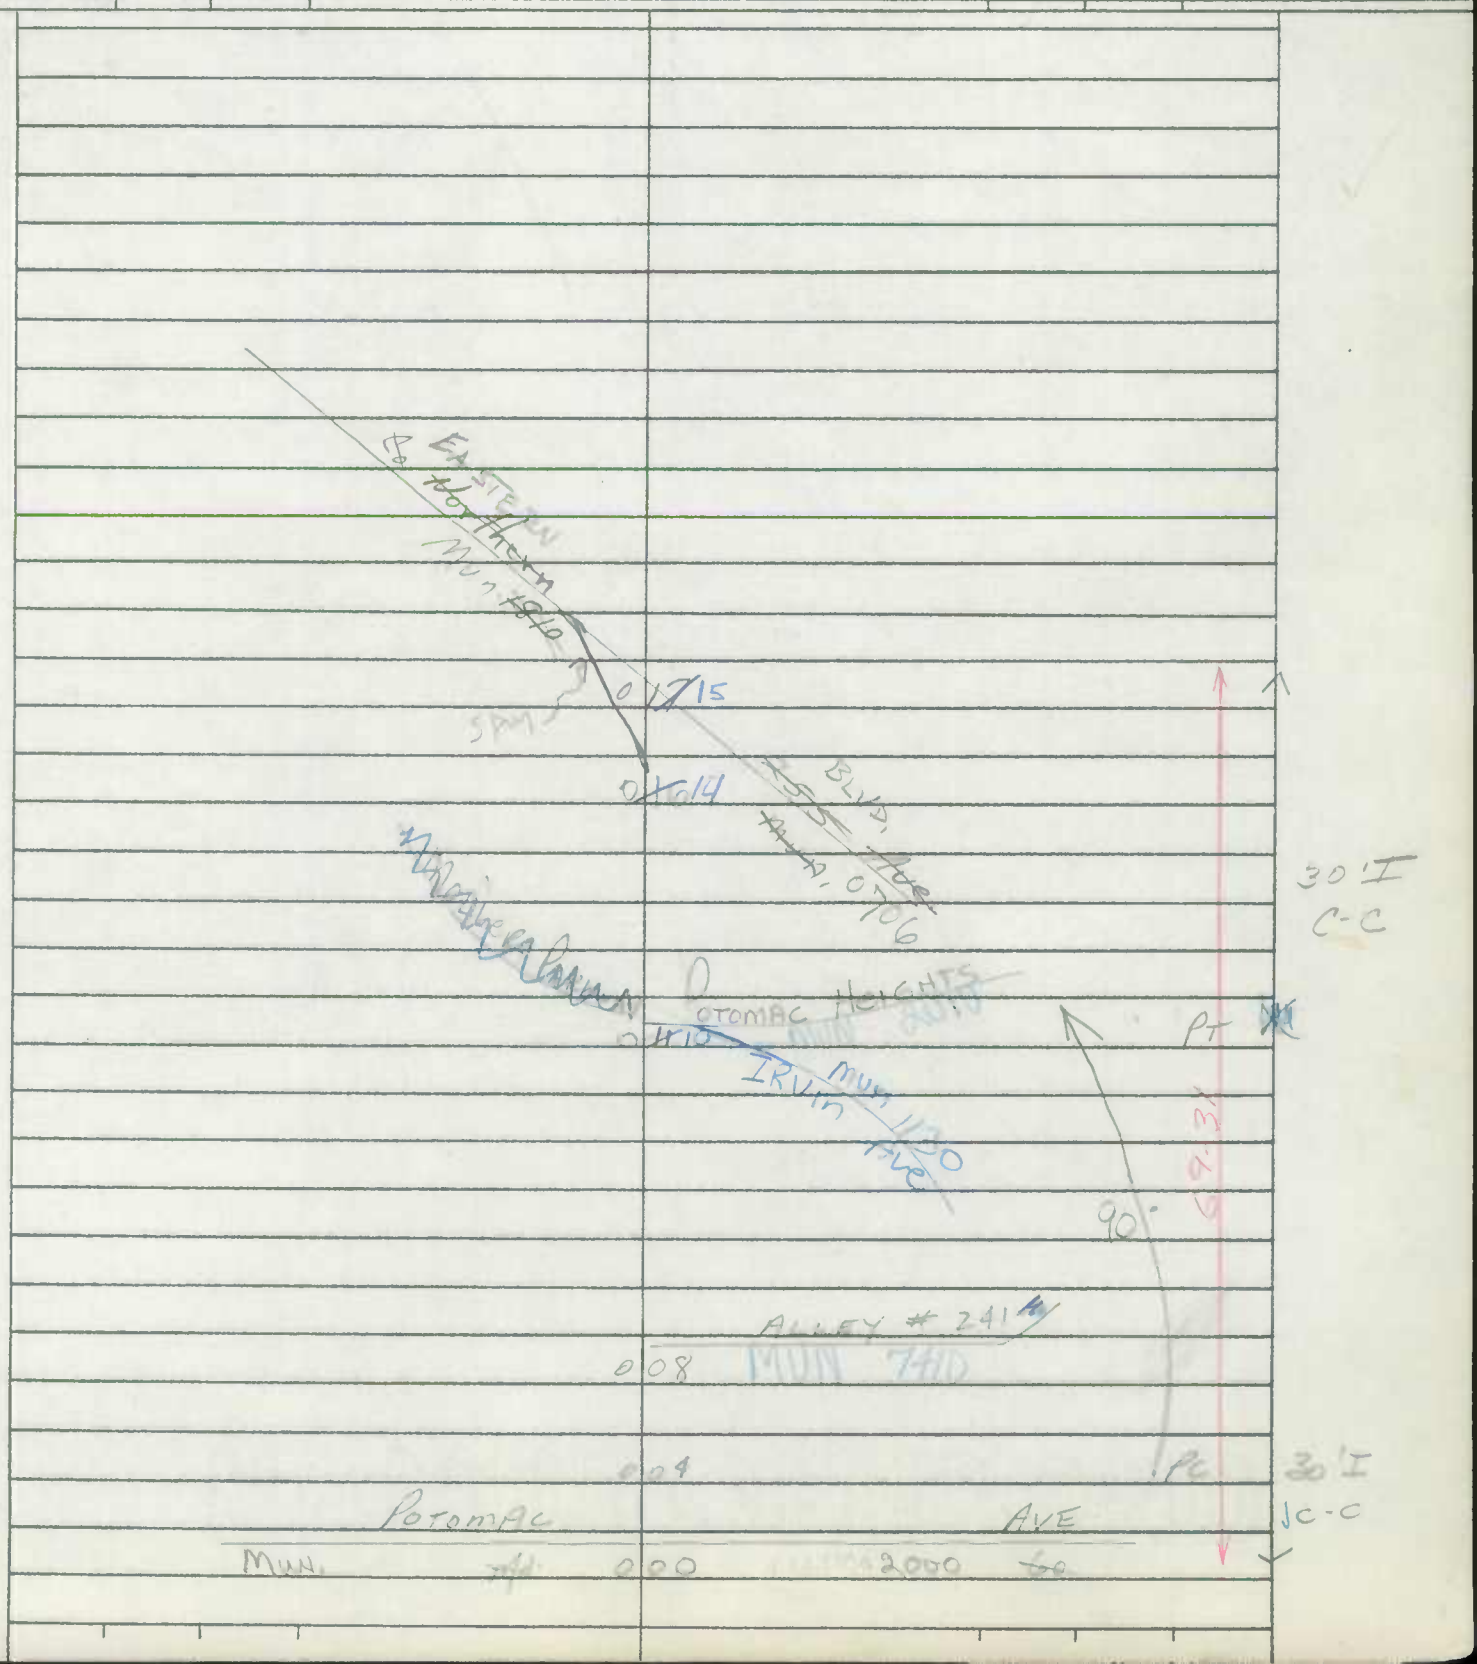

SHA 51.3 - 8 Revised
4.83

MARYLAND STATE HIGHWAY ADMINISTRATION Hagerstown

ROAD INVENTORY SHEET

Party Chief _____
Recorder _____
Assistant _____
Map No./Dir. 1
State Coordinates _____

Road No. MU 1750
Road Name Mt Aetna Rd
County Washington
Date 8-12-93
Sheet No. _____ OF _____

SYSTEM				TRAFFIC		LINE DIAGRAM	TRAFFIC			PAVEMENT DATA
FED. AID.	FUNCT CLASS.	HWY. SYS.	HPMS SAMPLE	PRKG. REST.	COM/IND. ACCESS		CONTROL	COM/IND. ACCESS	PRKG. REST.	

SEE Inventory of
CO 932 8-12-93 T. Massicot

TRAFFIC CODES

TRAFFIC CONTROLS: STOP SIGN=SS, TRAFFIC LIGHT=T.L., FLASHING RED BALL=F.R.

TRAFFIC CODES

PARKING RESTRICTIONS: A.M. PEAK, P.M. PEAK, A.M./P.M. PEAK, NO PARKING ANYTIME=N.P., COMM/IND. ACCESS=E

11-15-72

ROAD INVENTORY SHEET MV 1750

Party Chief BB
Recorder FR.
Helper

Map No. G22 MP 39-79 81-41

Road No. CO. 937
Road Name MT. AETNA RD.
Sheet No. 1 of 1
Date 11-4-82
County WASH.
State Coordinates 604-654

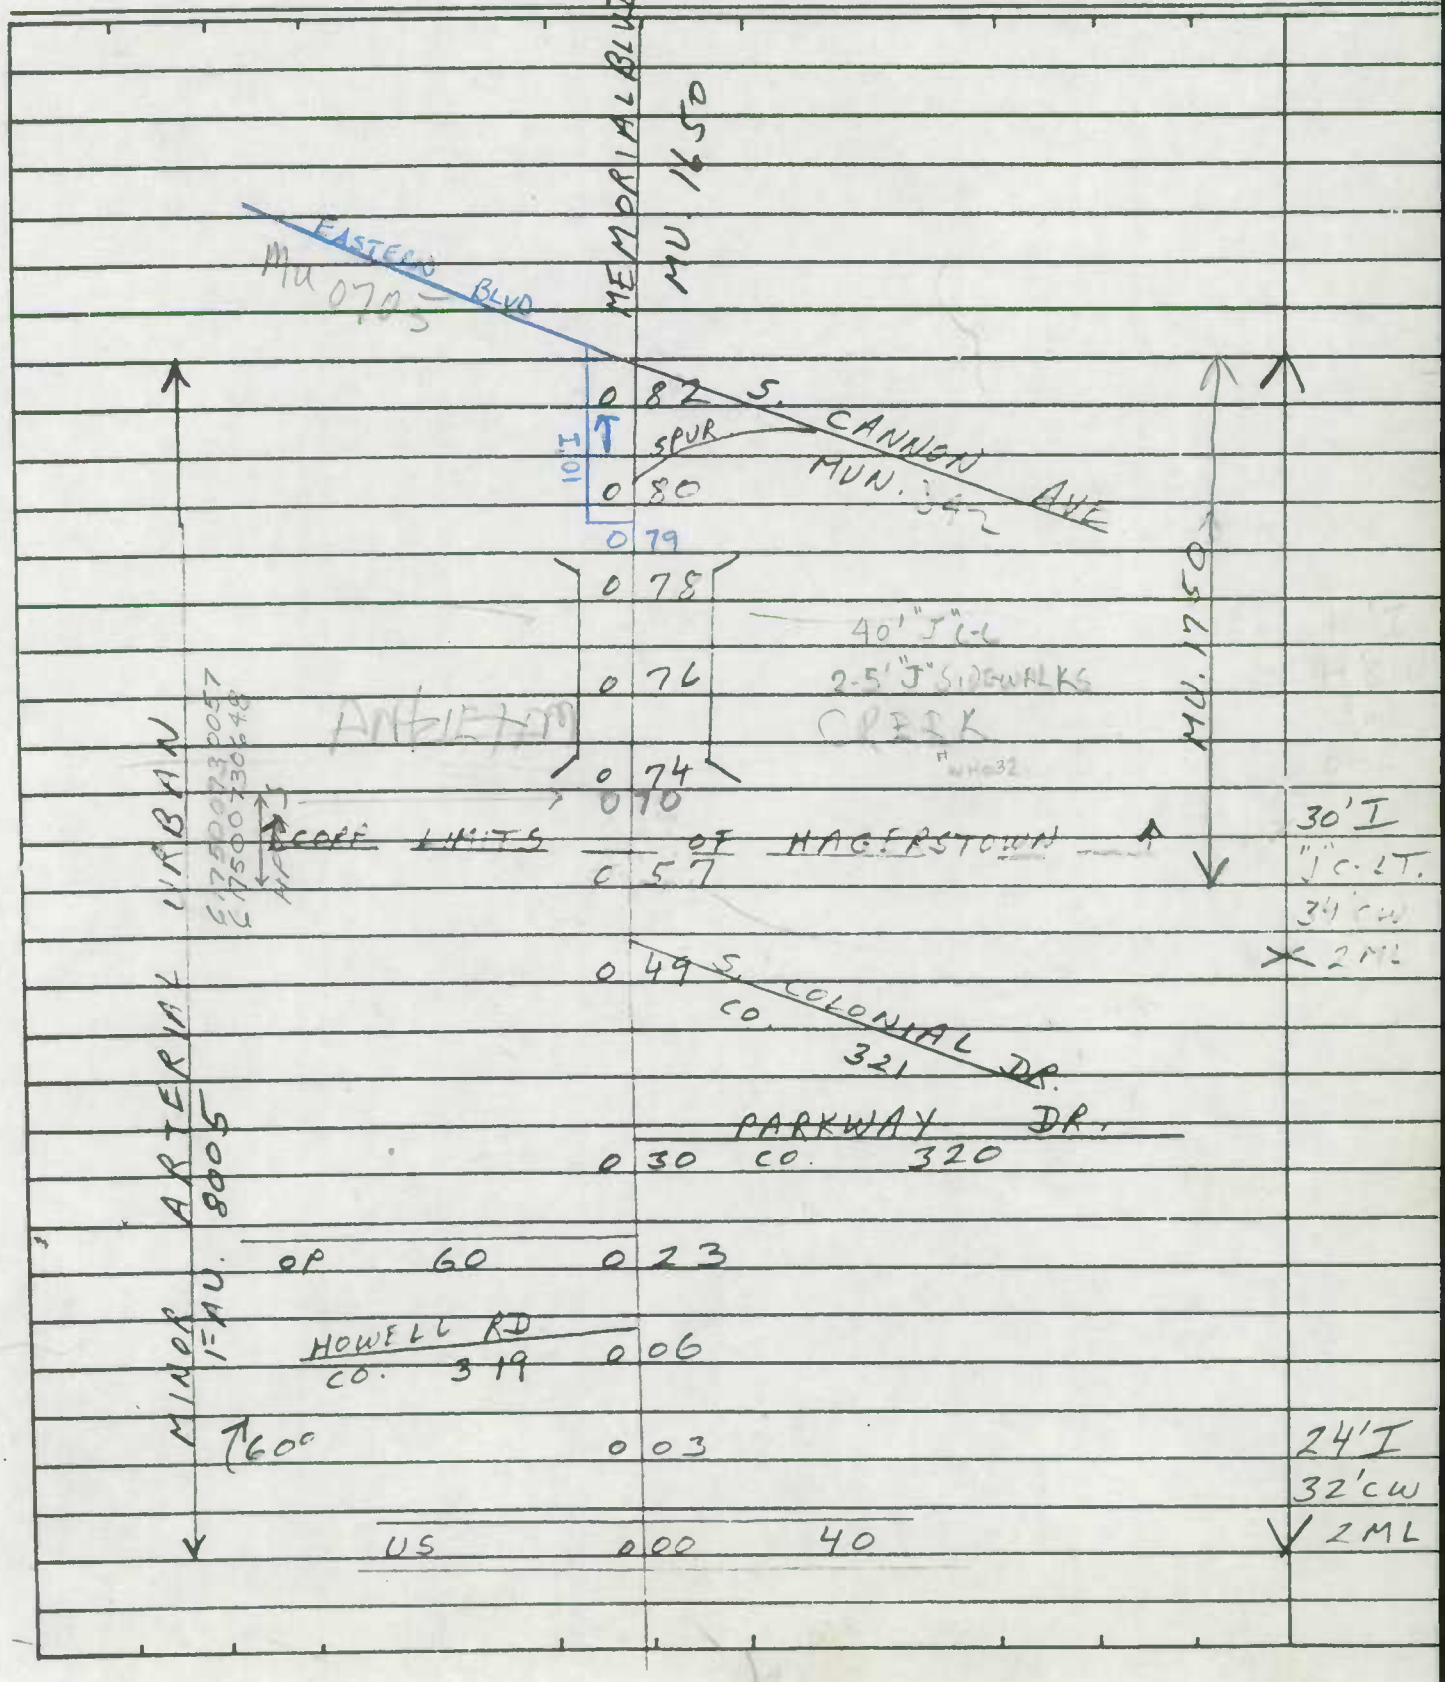

Form 6 HPS (Rev. '1961)

ROAD INVENTORY SHEET

1750

Party Chief	R. VOUGHT	Road No.	Co. 310
Recorder	L. COFFELT J...	Name	
Chairman		Sheet No.	5 OF ~~16~~
		Date	9 - 10
		County	WASHINGTON

BB REV.
FR 4-15-81 80-3

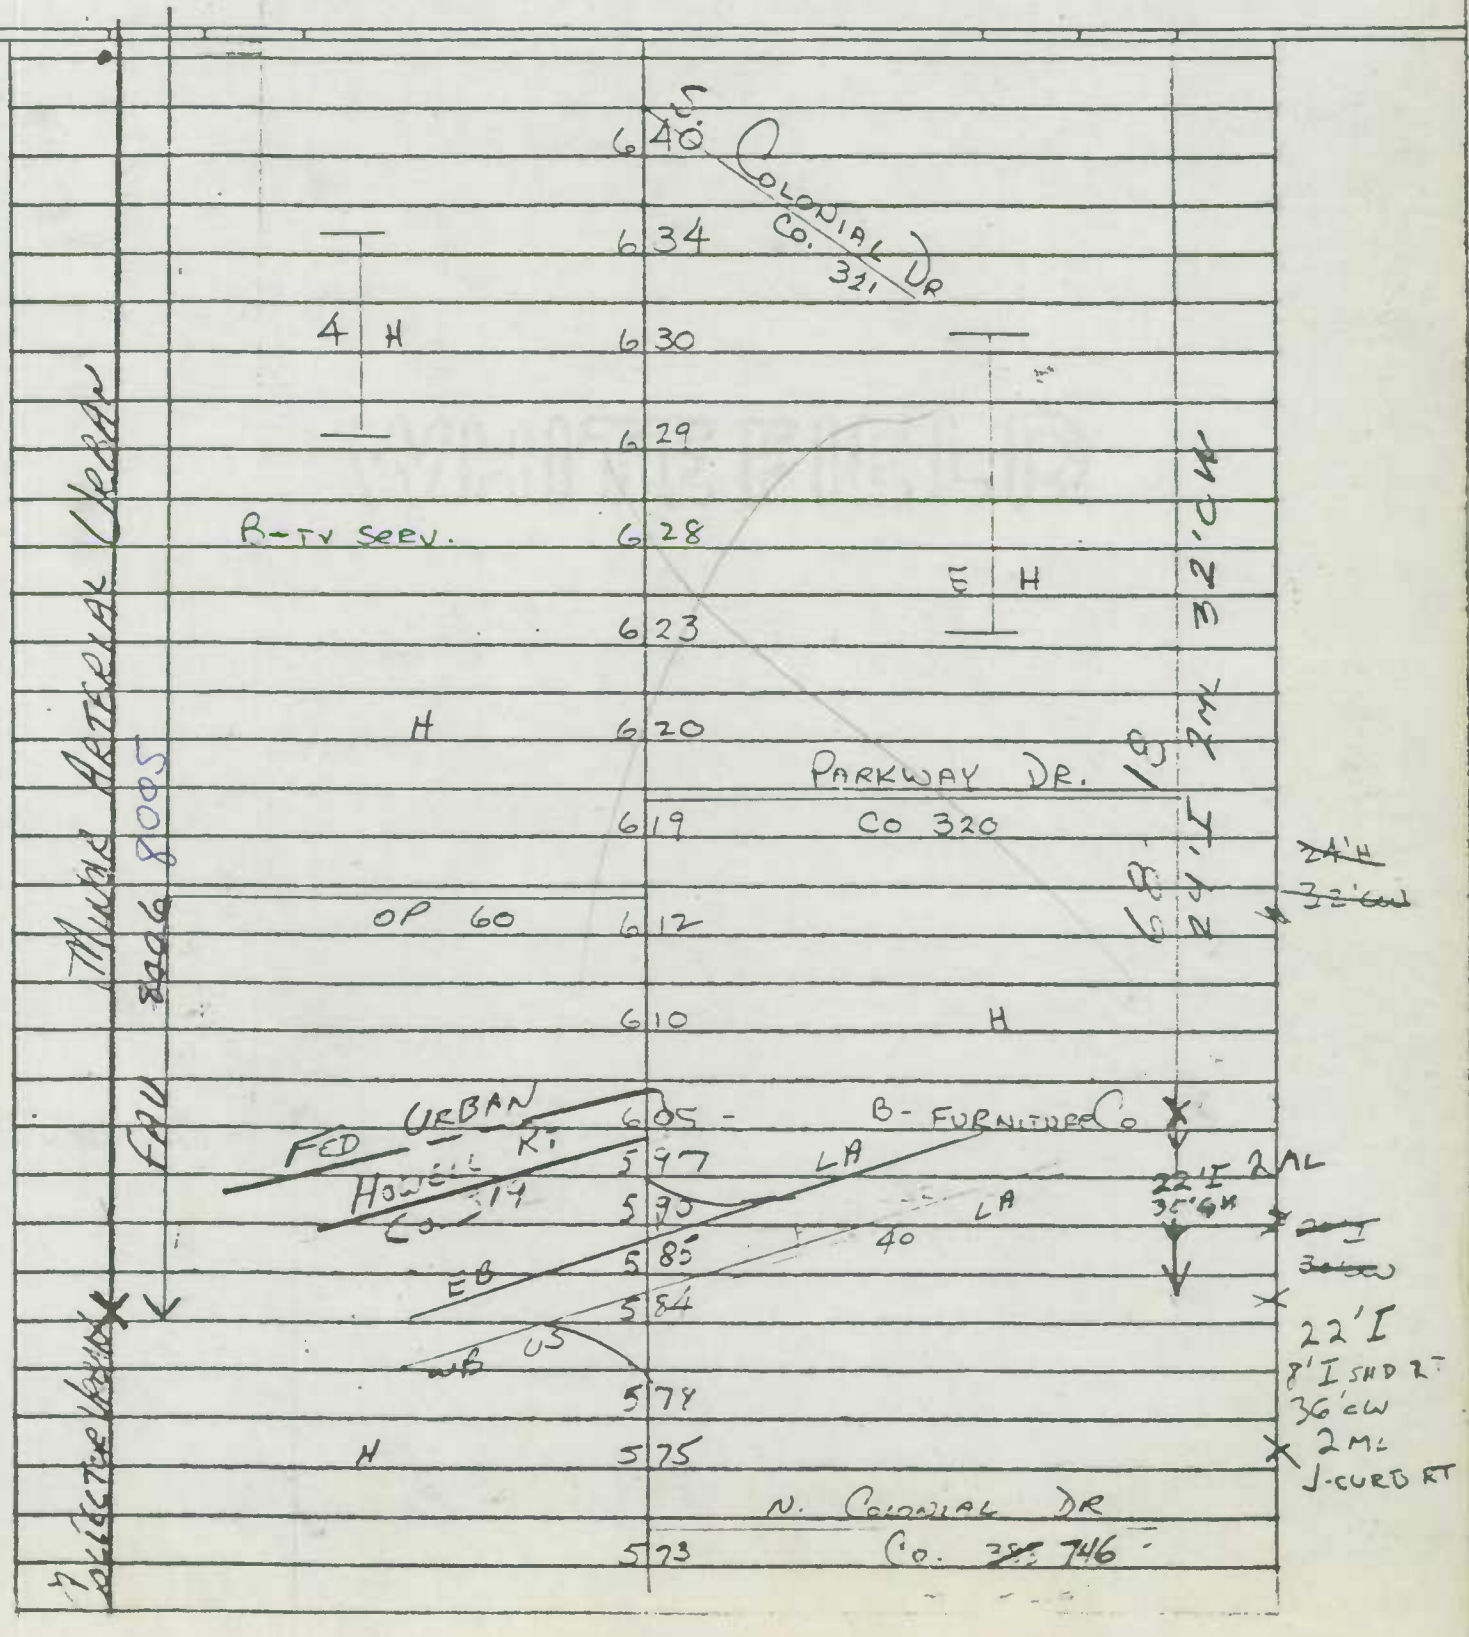

SHA 51.3-8
11-15-72

STATE HIGHWAY ADMINISTRATION OF MARYLAND

ROAD INVENTORY SHEET

MUN. 1750

Party Chief W. DOMBROSKI
Recorder M. ZALENSKI
Helper _____

Map No. _____

Road No. Co 310
Road Name MT AETNA RD
Sheet No. 6 OF 6
Date 6-7-76
County WASH.
State Coordinates _____

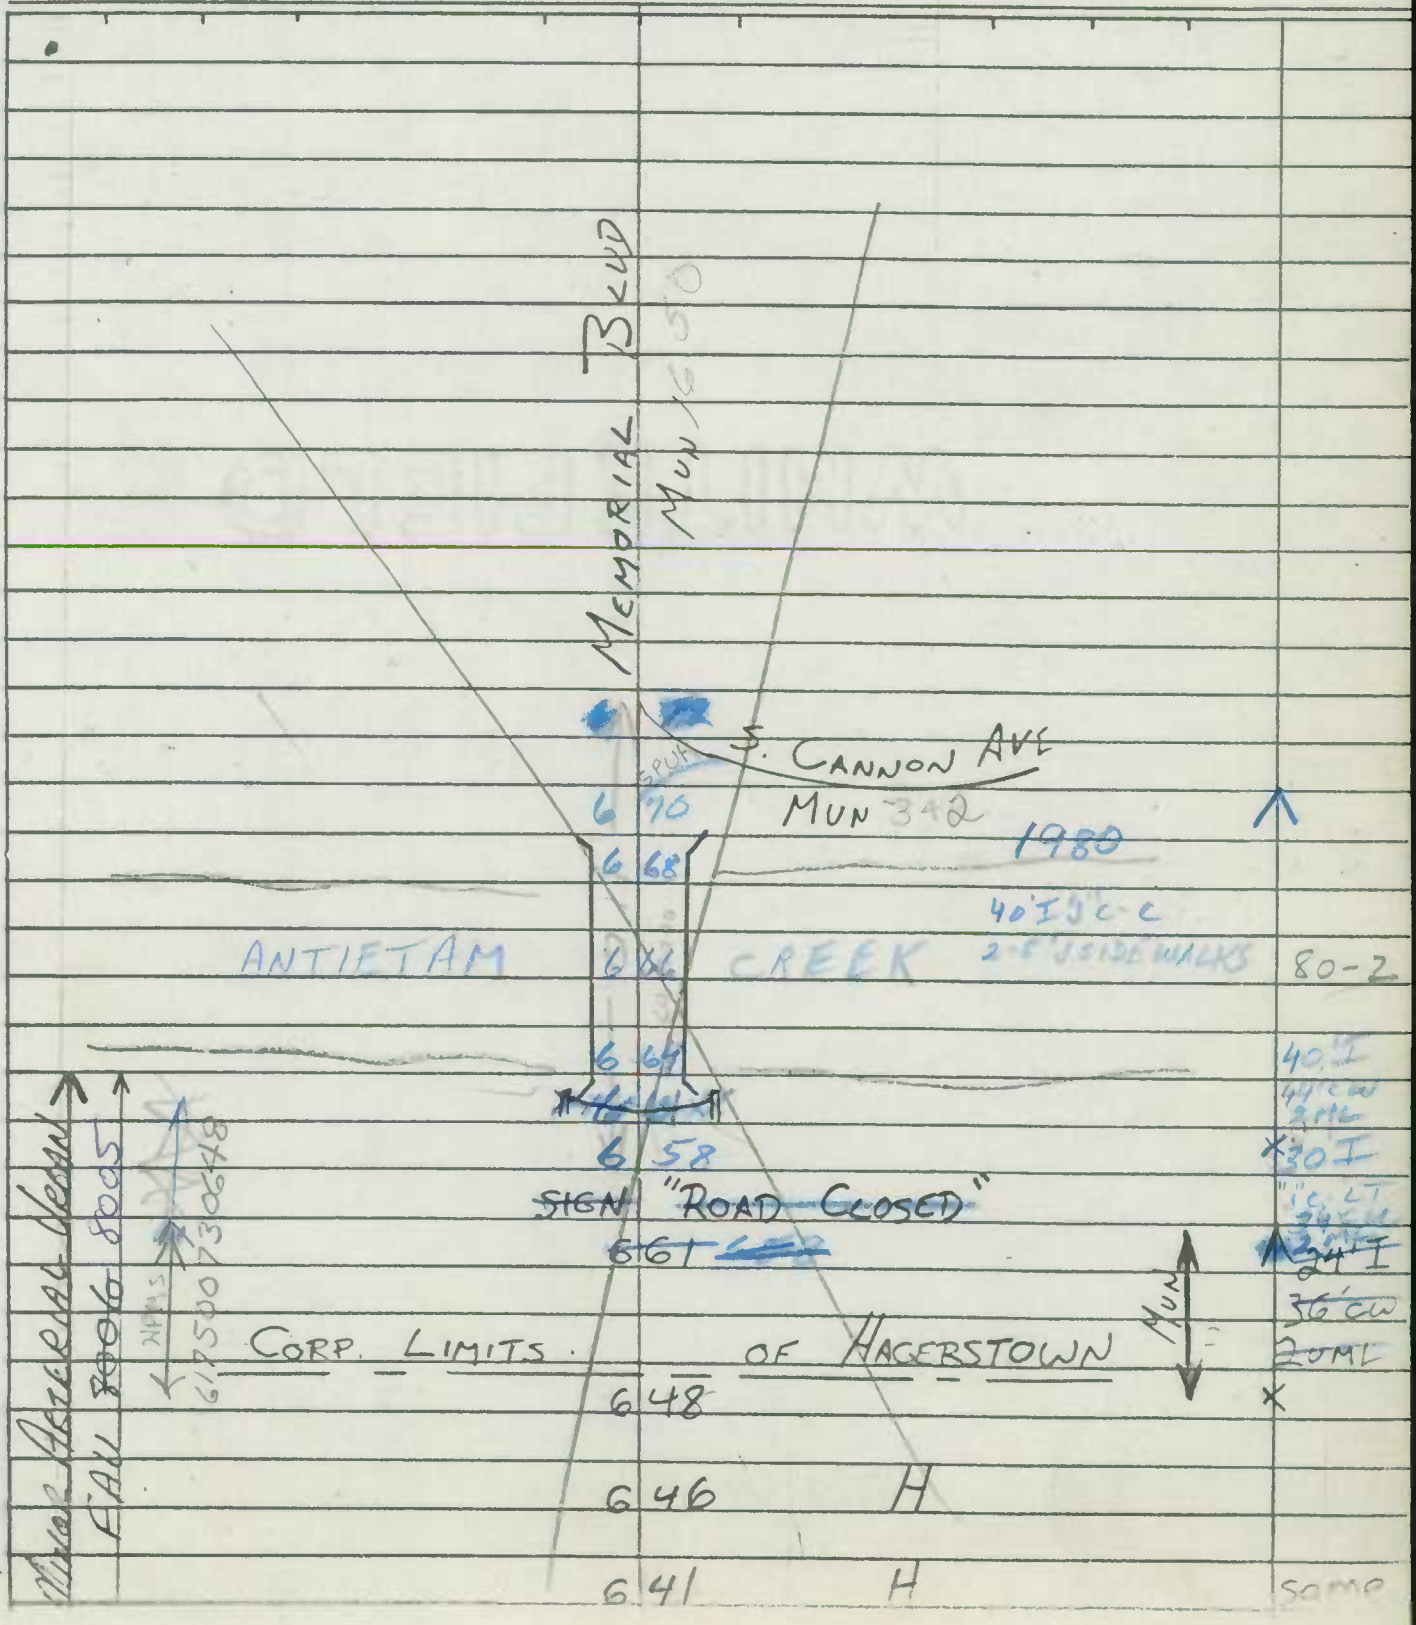

Form 6 HPS (Rev. 1961)

ROAD INVENTORY SHEET

MW1760

Party Chief R. Voughtt
Recorder L. Coffelt, Jr.
Chainman

Road No.
Name Mulberry Ave
Sheet No. 3 of B
Date 11-5-63
County Wash

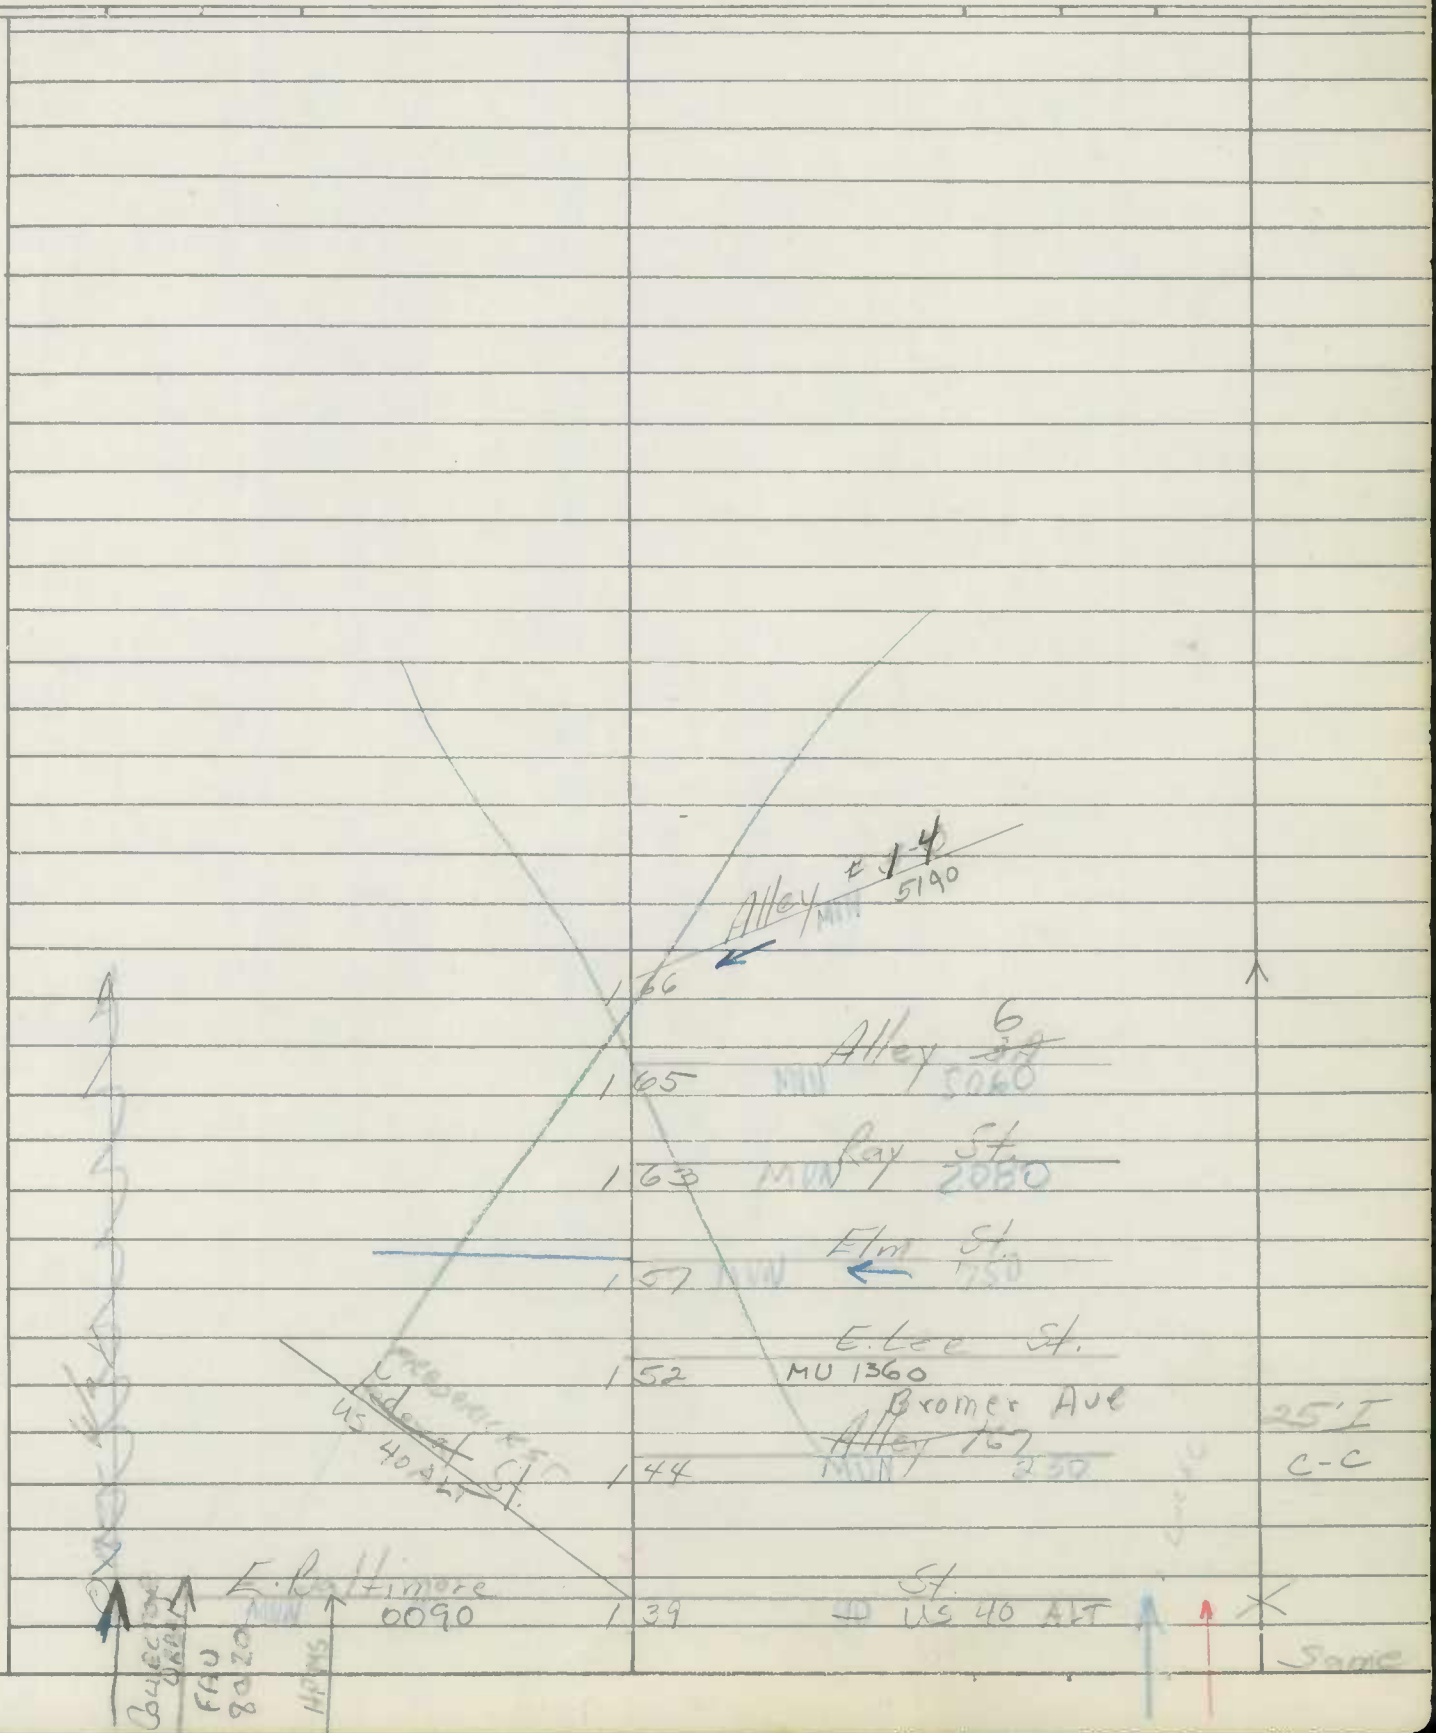

Form 6 HPS (Rev. 1961)

under Construction 93-6 3-10-94 3 VA-94 A+/TM

CS

OFFICE

~~ROAD~~ INVENTORY SHEET

Party Chief Tuvele

Recorder

Chainman

Road No. 1770

Name MUSEUM DRIVEWAY

Sheet No. 1 of 1

Date 1-28-66

County WASHINGTON

VER 7-20-76

94 mu ex #2 - under construction

COULD NOT LOCATE

95 MU EX # 1 4-8-96

GD. AH

APPEARS TO BE ENT. TO CONDOS @ MP .49 ON CITY PARK DR. MU 1920 WHICH WAS FORMERLY HIGHLAND WAY MU 1040 BEFORE CONVERSATION WITH A. MOYSEENKO 12/24/94, K.J.P.

Under const. 3-10-94
Field crew could not access to tie in

sent out as 94 extra call town to confirm completion? existence?

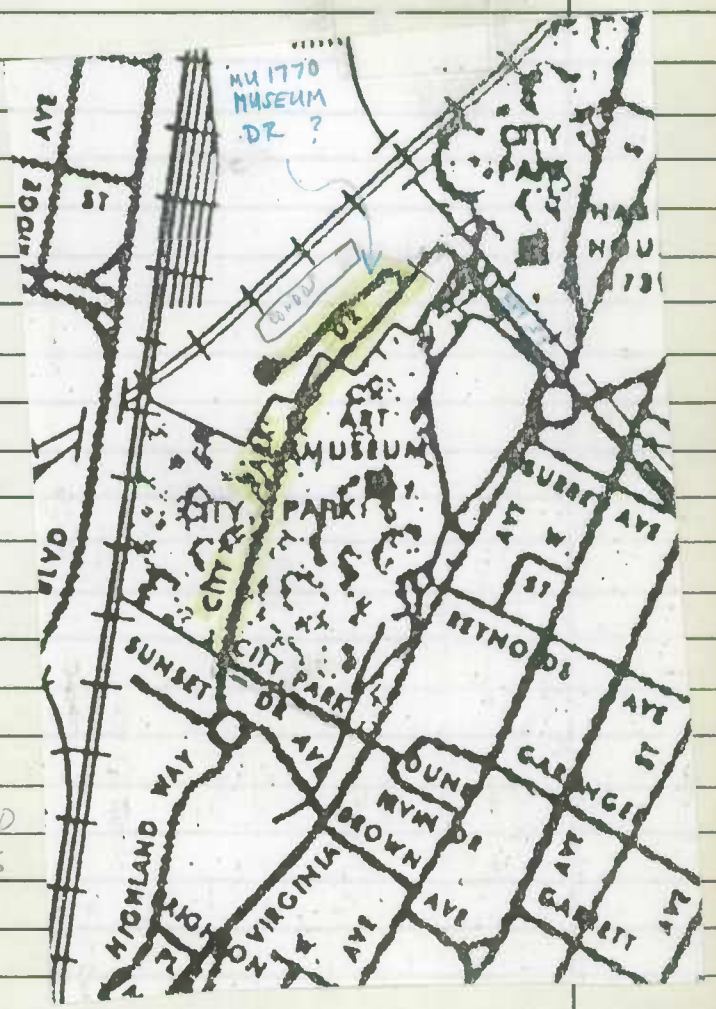

24'-I
65-15
Jc

HIGHLAND 0.00 1040 WAY

Form 6 HPS (Rev. 1961)

under Construction 93-6 3-10-94 3-10-94 A+/TM

CS

OFFICE

~~ROAD~~ INVENTORY SHEET

Party Chief Tuvele

Recorder

Chainman

Road No. 1770

Name MUSEUM DRIVEWAY

Sheet No. 1 OF 1

Date 1-28-66

County WASHINGTON

VER 7-20-76

94 mu ex #2 - under construction

COULD NOT LOCATE

95 MU EX # 1 4-8-96

GD. AH

APPEARS TO BE ENT. TO CONDOS @ MP .49 ON CITY PARK DR. MU 1920 WHICH WAS FORMERLY HIGHLAND WAY MU 1040 BEFORE CONVERSATION WITH A. MOYSEENKO 12/24/94, KJP.

RD END

0 06

24'-I

65-15

J'o

MU

HIGHLAND 0 00 1040 WAY

Form 6 HPS (Rev. 1961)

MASS WVS

ROAD INVENTORY SHEET

Party Chief R. VOUGHT
Recorder L. COFFELT JR,
Chainman

HAGERSTOWN

VER. 7-15-76

Road No. 1780
Name NOLAND DR.
Sheet No. 1 OF 1
Date 11-8-63
County WASHINGTON

AM 84-2

LINWOOD CO 070 — HAGERSTOWN RD 418 (County, Urban)

PT — CORP limits — PKG 066 PKG

35° PKG 062 REC. CTR

PC PKG 056 PKG

PKG 050 PKG PT 50° PC

042 TOWNHOUSE PKG

~~END~~ ~~END~~

~~039~~

MARION ST

MU 1520 ~~CO OLD HAGR~~ 030

SHERMAN AVE

~~CO.~~ ~~MU~~ 014 ~~MU~~ MU 2220

SNIDER AVE

009 MU 2240

30'-0" 44'-0"

38'XI

6-6

~~U.S~~ V. PC ~~INTER~~ 000 AVE ~~2430~~ 11

SHA 51.3 - 8 Revised 4.83

MARYLAND STATE HIGHWAY ADMINISTRATION

ROAD INVENTORY SHEET

Party Chief REWRITTEN SM
Recorder
Assistant
Map No./Dir. 1 E
State Coordinates

Road No. MUN 1790
Road Name W. NORTH AVE
County WASHINGTON
Date 10-14-88
Sheet No. 1 OF 3

92-10 A/T

TRAFFIC CODES
TRAFFIC CONTROLS: STOP SIGN=SS, TRAFFIC LIGHT=T.L., FLASHING RED BALL=F.R.

TRAFFIC CODES
PARKING RESTRICTIONS: A.M. PEAK, P.M. PEAK, A.M./P.M. PEAK, NO PARKING ANYTIME=N.P., COMM/IND. ACCESS=E

SYSTEM				TRAFFIC		LINE DIAGRAM	TRAFFIC			PAVEMENT DATA
FED. AID.	FUNCT CLASS.	HWY. SYS.	HPMS SAMPLE	PRKG. REST.	COM/IND. ACCESS	HAGERSTOWN	CONTROL	COM/IND. ACCESS	PRKG. REST.	
						SNI				
						PARK PL				
						MU 1940 0 19				
						COMP 11/11/87				
						HENRY AVE				
						0 18 MU 1025 ←				
						(RUBBIE AVE)				
						MU. 2180 0 17				
						N JONATHAN ST				
						MU ← 0 14 ← 1230	TL			
						ALLEY #176				25'I
						0 12 MU 6760				"J" C-C
						Sumans Ave				2 UML
						~~PARK PL~~				
						MU 1941 0 09				
						ALLEY #178				
						MU 0780 0 04				
						N PROSPECT ST				
						MU. 0 00 2030				
	FAU 808 MINOR ARTERIAL URBAN		K 6179007300 14							

SYSTEM: FED. AID. | FUNCT. CLASS. | HWY. SYS. | HPMS SAMPLE
TRAFFIC: PRKG. REST. | COM/IND ACCESS

LINE DIAGRAM

TRAFFIC: CONTROL | COM/IND ACCESS | PRKG. REST.

PAVEMENT DATA

FAU 8018
MINOR ARTERIAL URBAN
617900730014

ALLEY ~~206~~
0 ~~57~~ MU ~~7060~~

N MULBERRY ST
MU → 0 55 → 1760
TL

ALLEY #191
MU 6910 0 52

N LOCUST ST
MU ← 0 45 ← 1430
TL

CRAMERS ALLEY
MU 0 35 9070

N POTOMAC ST
MU → 0 30 → 2000
TL

BETHUNES AVE
0 24 MU 0165

BOWARD ST
MU 0190 0 21

~~25'I~~
~~"I" C C~~
~~24'I~~
~~"I" C C~~
2
SAME

SHA 51.3 - 8 Revised
4.83

MARYLAND STATE HIGHWAY ADMINISTRATION AT (92-EX#9)
4-1-93
BB-AH

ROAD INVENTORY SHEET

Party Chief REWRITTEN SM
Recorder
Assistant
Map No./Dir. 1
State Coordinates

Road No. MUN 1790
Road Name ~~W~~ NORTH AVE
County WASHINGTON
Date 10-14-88
Sheet No. 3 OF 3

TRAFFIC CODES
TRAFFIC CONTROLS: STOP SIGN=SS, TRAFFIC LIGHT=T.L., FLASHING RED BALL=F.R.

TRAFFIC CODES
PARKING RESTRICTIONS: A.M. PEAK, P.M. PEAK, A.M./P.M. PEAK, NO PARKING ANYTIME=N.P., COMM/IND. ACCESS=E

SYSTEM				TRAFFIC		LINE DIAGRAM	TRAFFIC				PAVEMENT DATA
FED. AID.	FUNCT CLASS.	HWY. SYS.	HPMS SAMPLE	PRKG. REST.	COM/IND. ACCESS	HAGERSTOWN	CONTROL	COM/IND. ACCESS	PRKG. REST.		
						NOW SIGNED "N. CANNON AVE" SEE NEW INV. MU 0330 FCR-07 CDMP 11/1/97					
						CANNON ST MU 0330					
						ALLEY 208 MU. 7080 0 62					
						PT 90° PC 0 58					
											SAME
	FAU 8018 MINOR ARTERIAL URBAN										

SYSTEM				TRAFFIC		LINE DIAGRAM	TRAFFIC			PAVEMENT DATA
FED. AID.	FUNCT. CLASS.	HWY. SYS.	HPMS SAMPLE	PRKG. REST.	COM/IND ACCESS		CONTROL	COM/IND ACCESS	PRKG. REST.	

Form 6 HPS (Rev. 1961)

ROAD INVENTORY SHEET

Party Chief R. VOUGHT
Recorder L. COFFELT JR.
Chainman

HAGERSTOWN

VER 7-16-76

Road No. ~~1800~~ 1790
Name W. NORTH ST AVE
Sheet No. 1 OF 2
Date 11-4-63
County WASHINGTON

82-9,10,11,18 AT

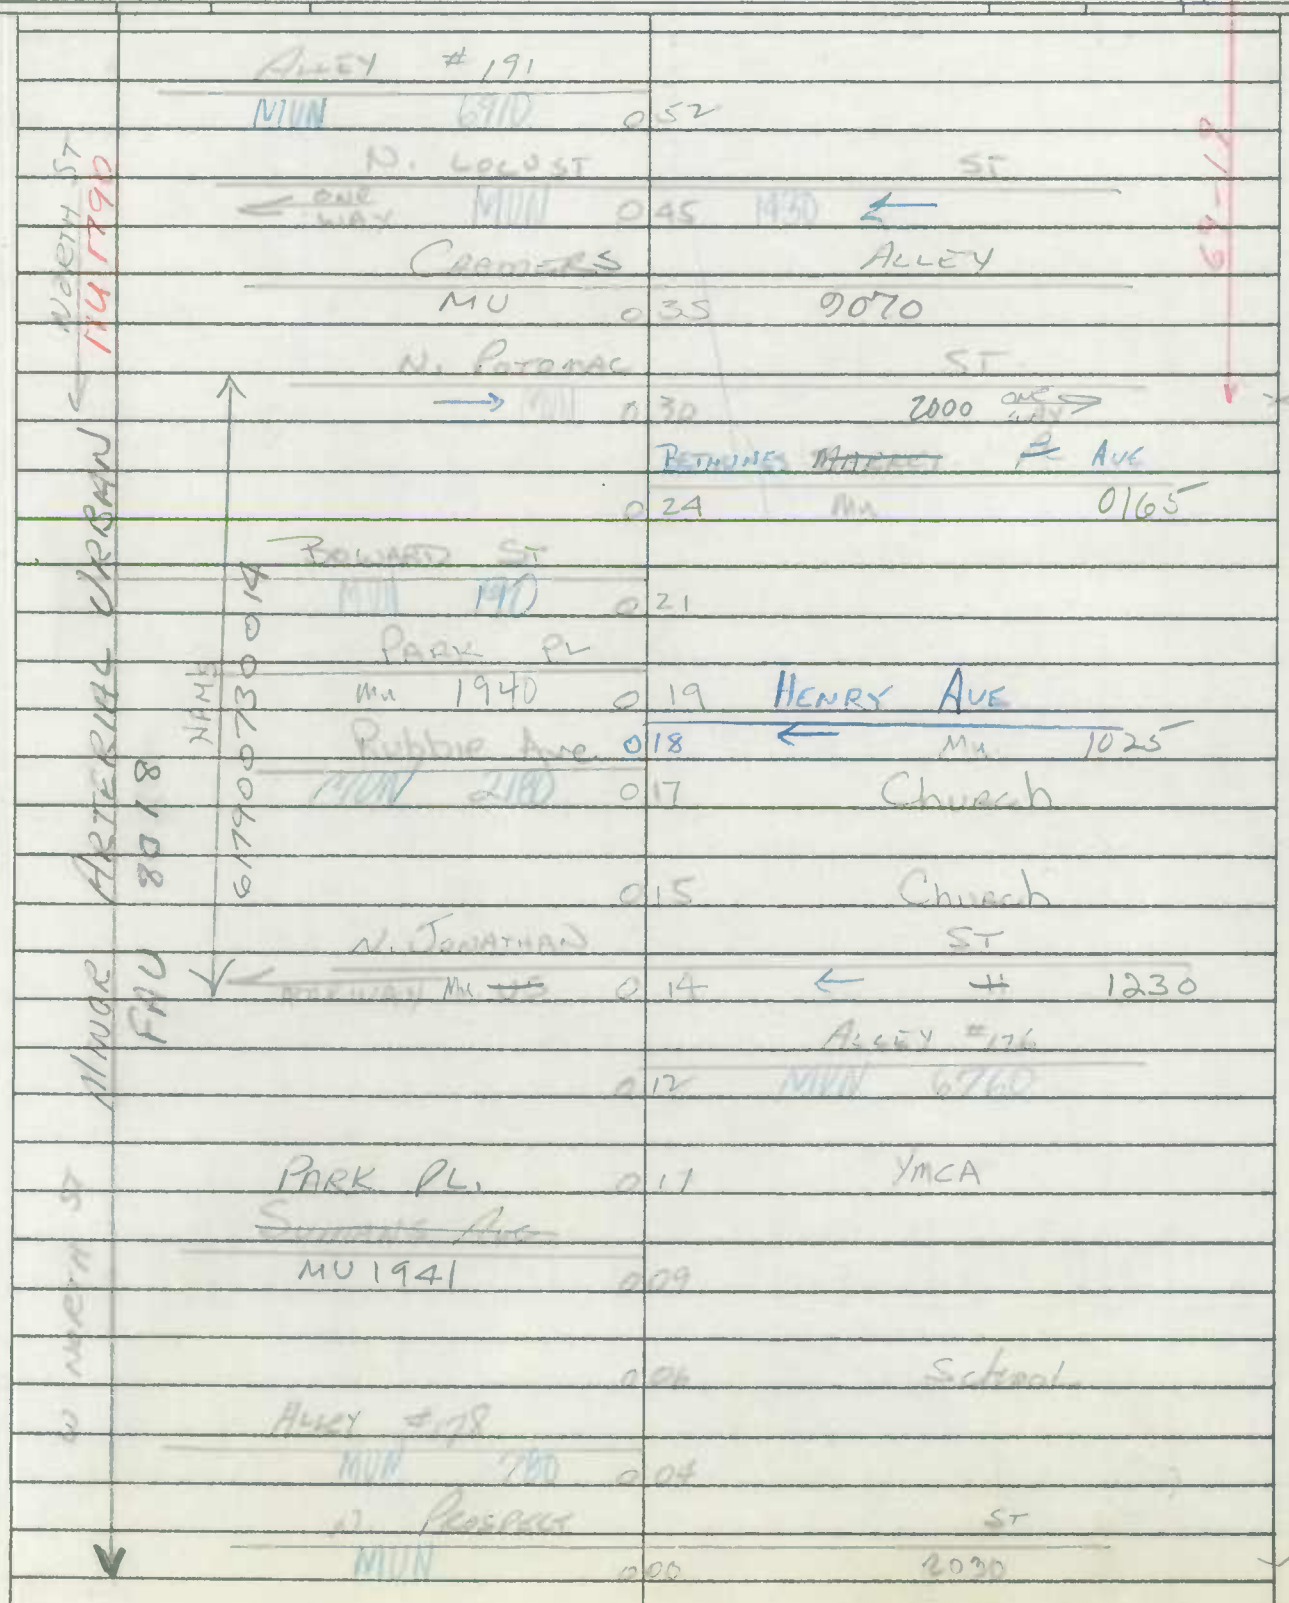

Form 6 HPS (Rev. 1961)

4

ROAD INVENTORY SHEET

Party Chief R. Vought
Recorder L. Coffelt, Jr.
Chainman

Road No.
Name W. North St. AVE
Sheet No. 2 of 2
Date 4-4-63
County Wash.

CANNON ST
0+50

ALLYAR HART ORIGIN
FAU 8218

Pt. of Beg. Alley 20' 7040 — 0+62
90°
P.C. Ent. Fairground — 0+58
Alley 20' — 0+57
N. Mulberry St. — 0+55
End Alley

25' I C-C

SHA 51.3-8
11-15-72

Transferred 6.2-1.16 from County - (M. 90-22)

STATE HIGHWAY ADMINISTRATION OF MARYLAND

90-99
3-7-91
GD/TM
A/T

88-77

ROAD INVENTORY SHEET

MU1810

Party Chief M. BAXTER - OFF. INV.
Recorder
Helper

Road No. ~~C.T.T.B~~
Road Name NORTHERN AVE
Sheet No. 1 OF 3
Date 7-16-63 REV. 5-13-74
County WASHINGTON
State Coordinates 604 - 667
91-23,24,25,26 A/T

A-8 (NW) VERIFIED 6-10-76

Map No. 22

80-19 A/T

91-22 A/T

FAU 8022

SNI
FCR-97
GD. MP
11/12/97

FOUNTAIN HEAD RD
CO. 210

T.L.

HPMS
LIBRARY
CHURCH

B- MEDICAL BUILDING

40' I

W. M.

FLASHING SIGNALS

R.R.

CURB LT

W.M. ~~851~~ 852X

FLASHING SIGNALS

NORTHERN STATION US POST OFFICE

AMERICAN LEGION POST 45

THE TERRACE

ALLEY 185

OAK HILL AVE.

ALLEY 181

HAMILTON BLVD

ENT TO SHOP CENTER

40 I
J'C-C
4 ML

ALLEY ~~186~~ 177

POTOMAC AVE

~~MD~~ 60

MUN. 1810 HAGERSTOWN

MINERAL Co. Rd. Urban

FAU 8022

NW

EASTERN BLVD

MUN

SHA 51.3-8
11-15-72

ROAD INVENTORY SHEET

Mu 1810

91-51Ex #1,44
BBISP
3-18-92

Road No. ~~Co. 778~~
Road Name
Sheet No. 2 OF 3
Date
County WASHINGTON
State Coordinates

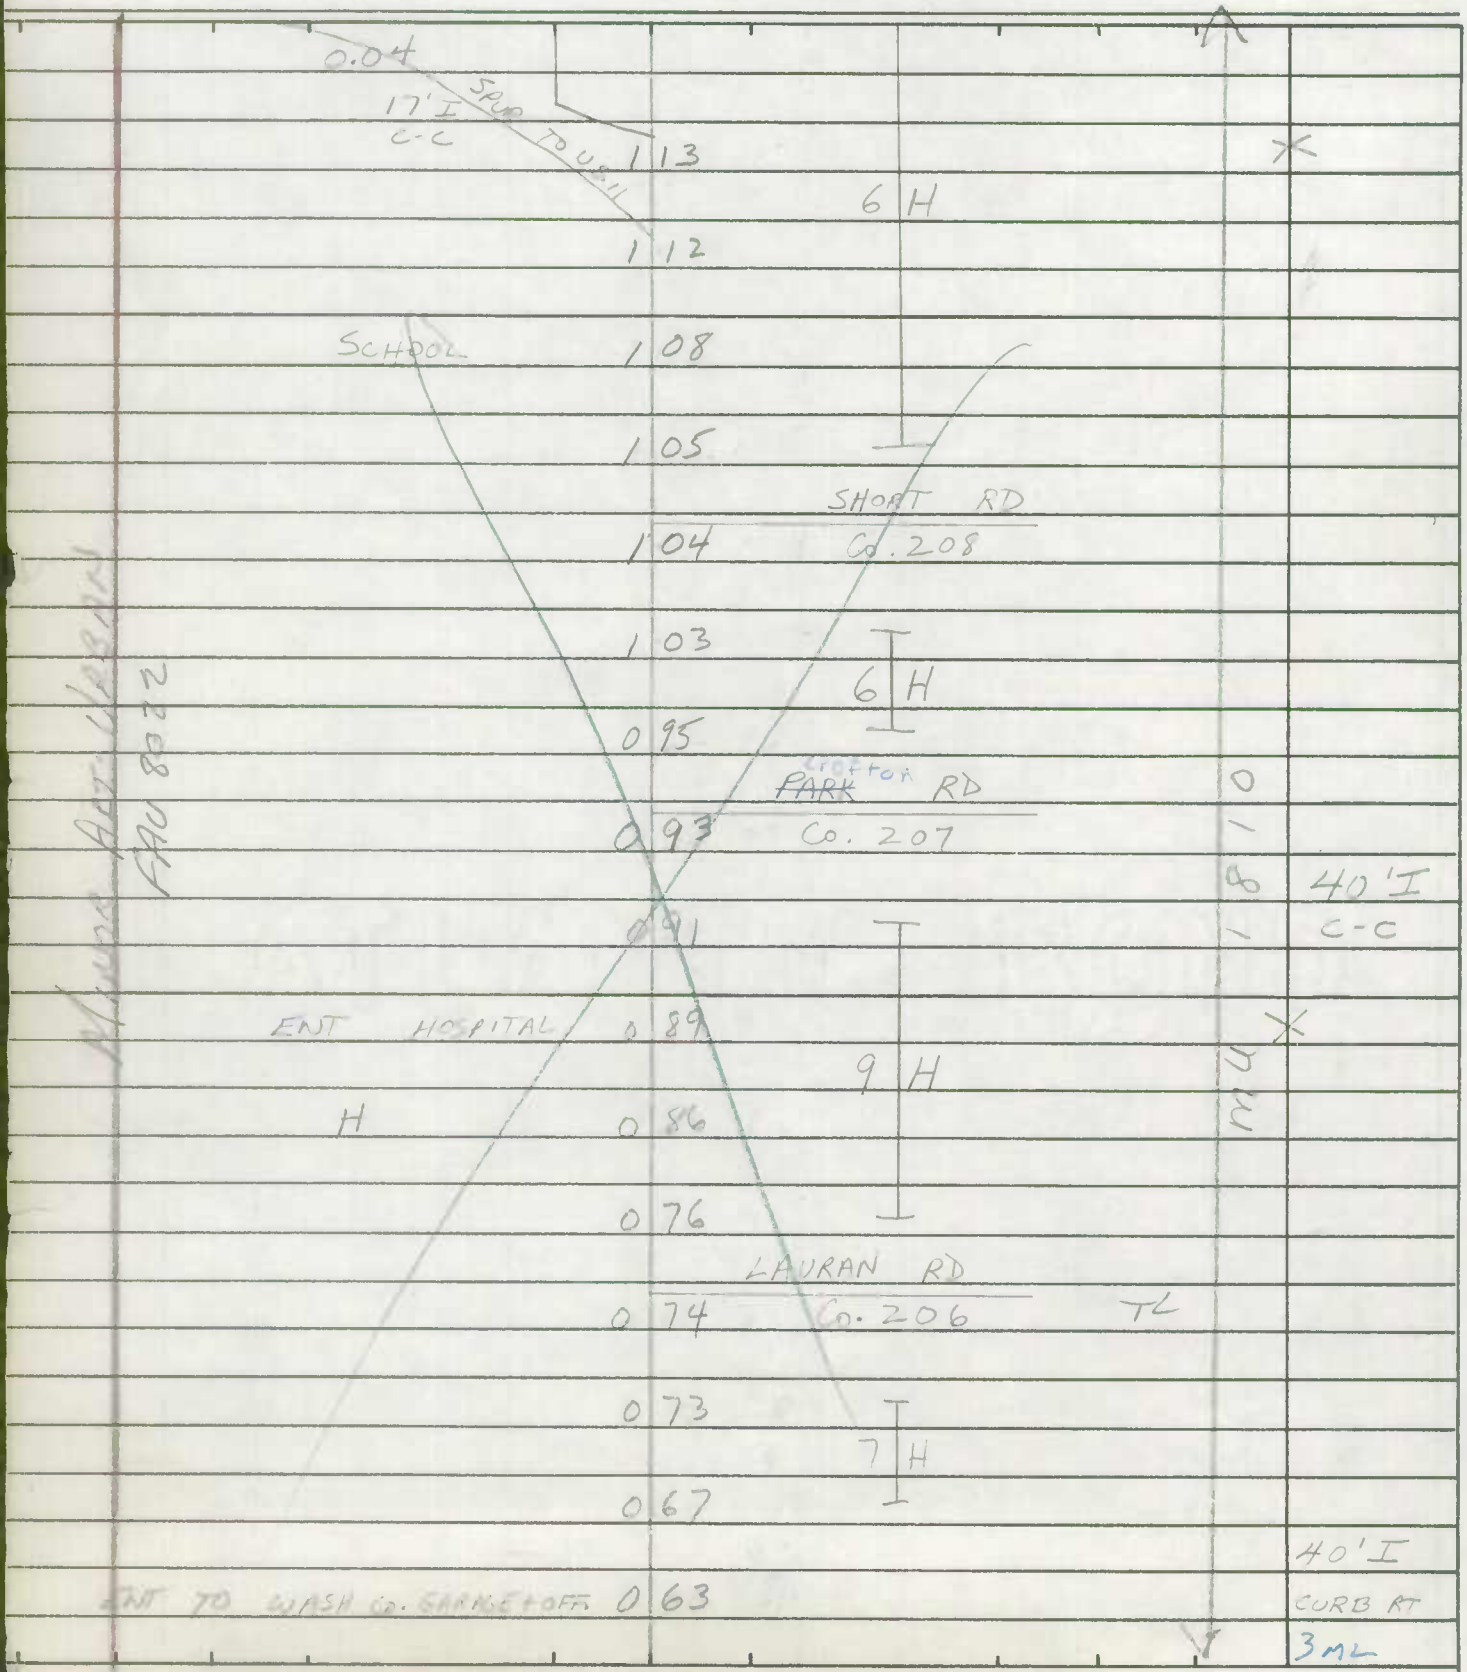

SHA 51.3-8
11-15-72

STATE HIGHWAY ADMINISTRATION OF MARYLAND

V

ROAD INVENTORY SHEET

MU 1810

Party Chief _____
Recorder _____
Helper _____

A-8
Map No. 22

Road No. ~~Co. 778~~
Road Name _____
Sheet No. 3 OF 3
Date _____
County WASHINGTON
State Coordinates _____

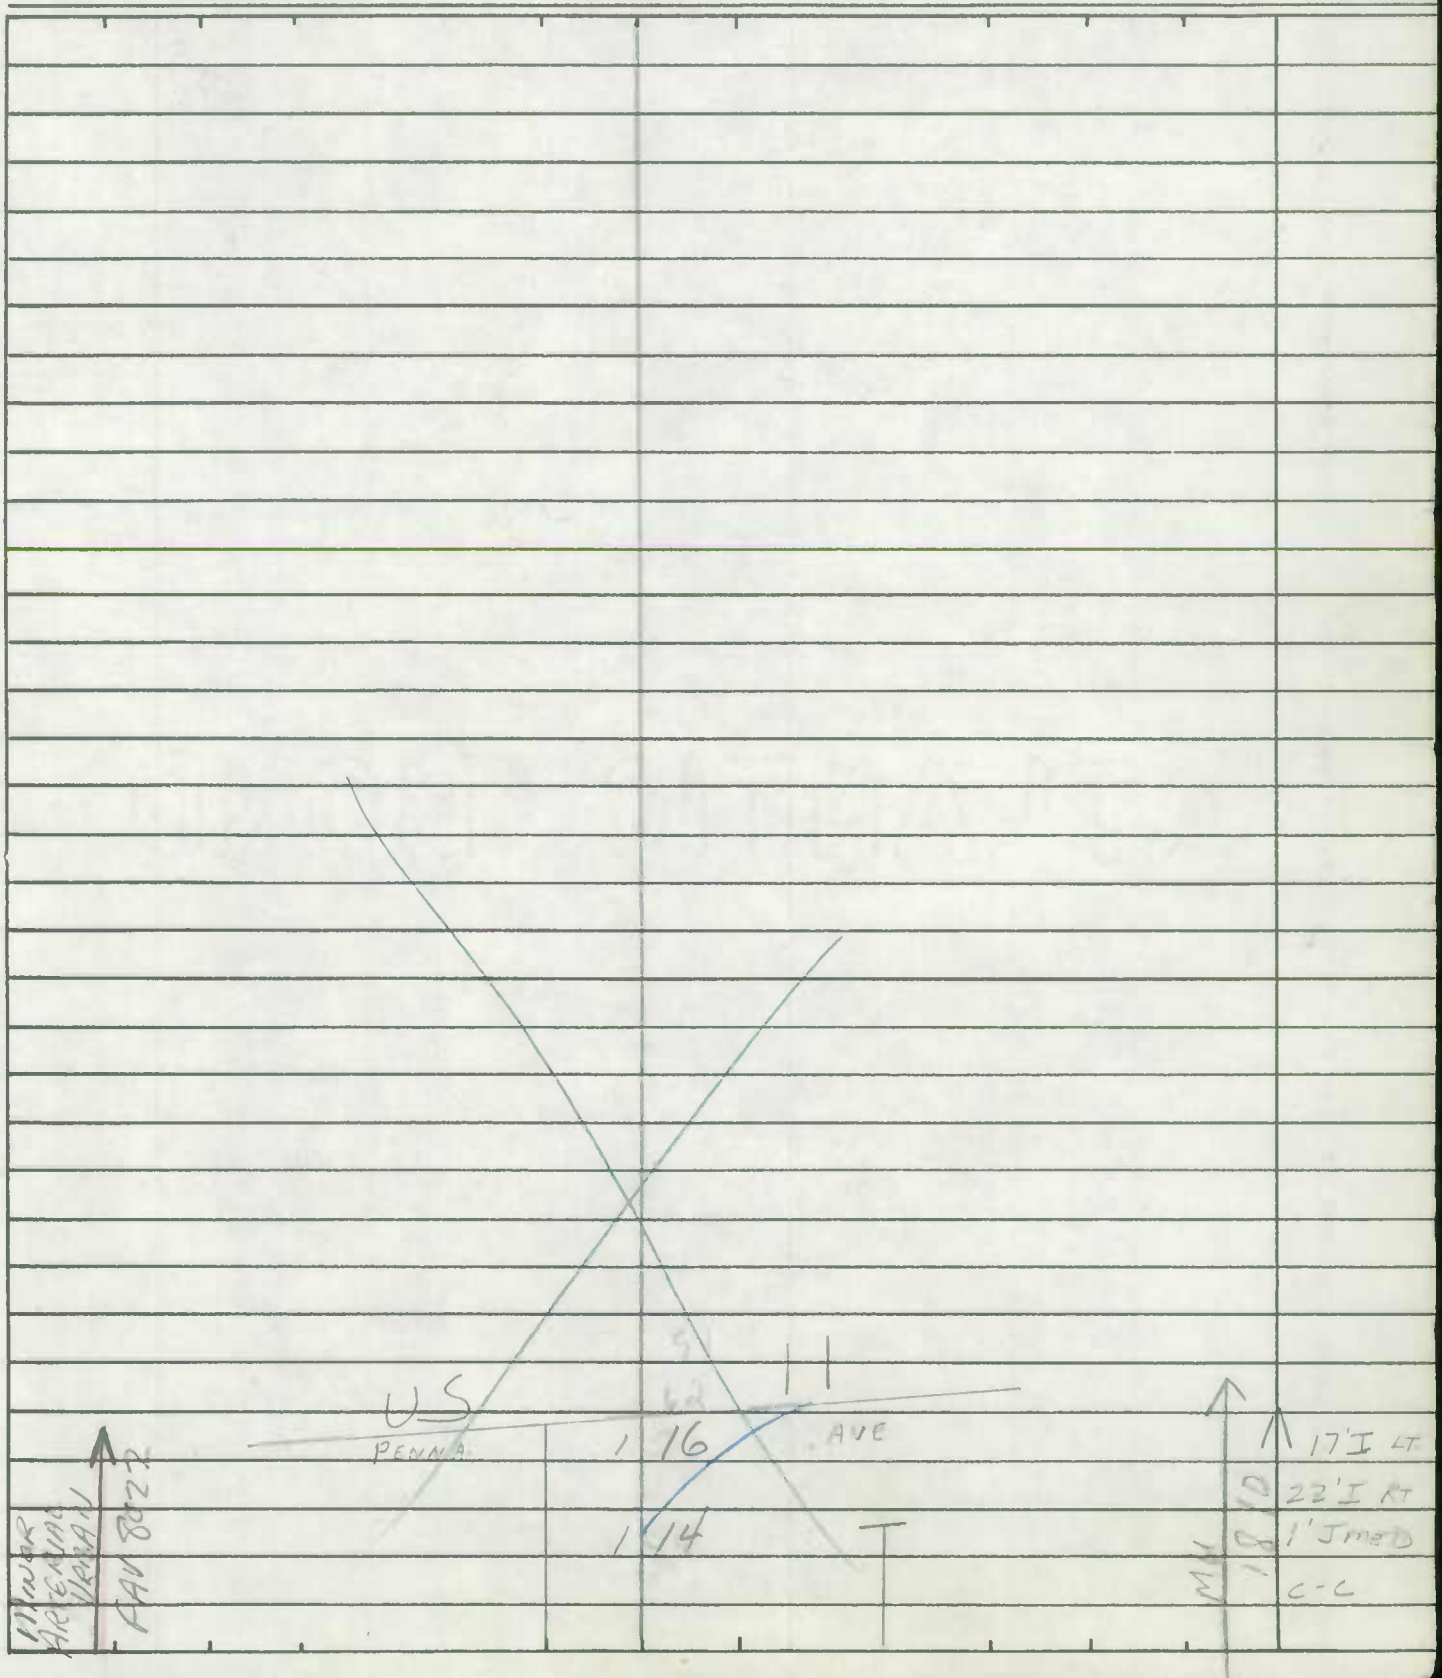

SHA 51.3-8
11-15-72

ROAD INVENTORY SHEET

Road No. _____
Road Name _____
Sheet No. _____
Date _____
County _____
State Coordinates _____

Form 6 HPS (Rev. 1961)

Pg 77

ROAD INVENTORY SHEET

Hun. No. 1810

Party Chief R. Vought
Recorder L. Coffelt, Jr.
Chainman

VERIFIED
6-10-76

Road No. Co. ~~255~~
Name Northern Ave.
Sheet No. 1 of 1
Date 9-16-63
County Wash

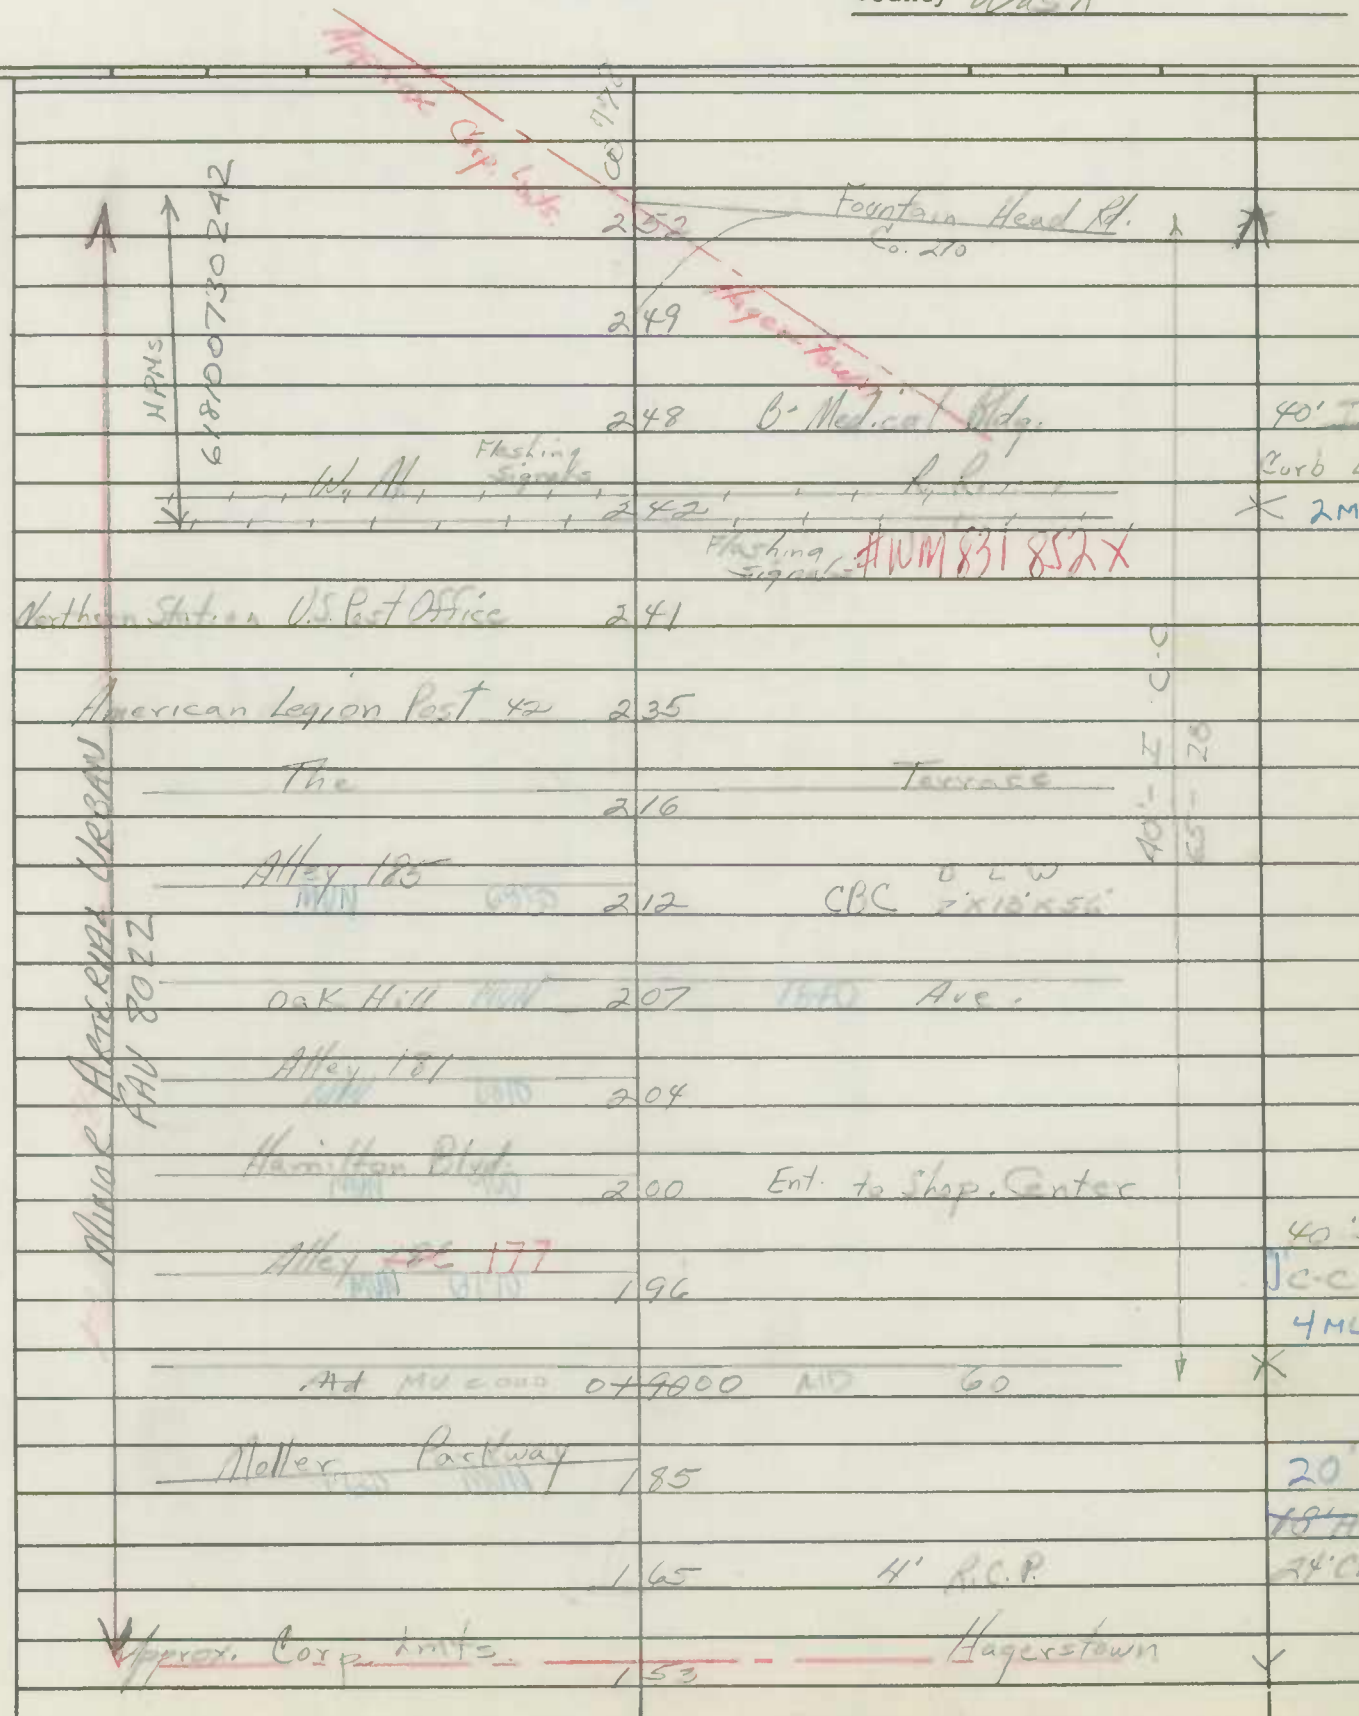

Form 6 HPS (Rev. 1961)

ROAD INVENTORY SHEET

Party Chief R. Vaught
Recorder L. Coffelt Jr.
Chainman

A/T
83-4
4/9/84
VER. DT+NS
7-20-76

Road No. 1830
Name Nottingham Rd.
Sheet No. 1 of 1
Date 10-28-63

E2 5/AT 79-4

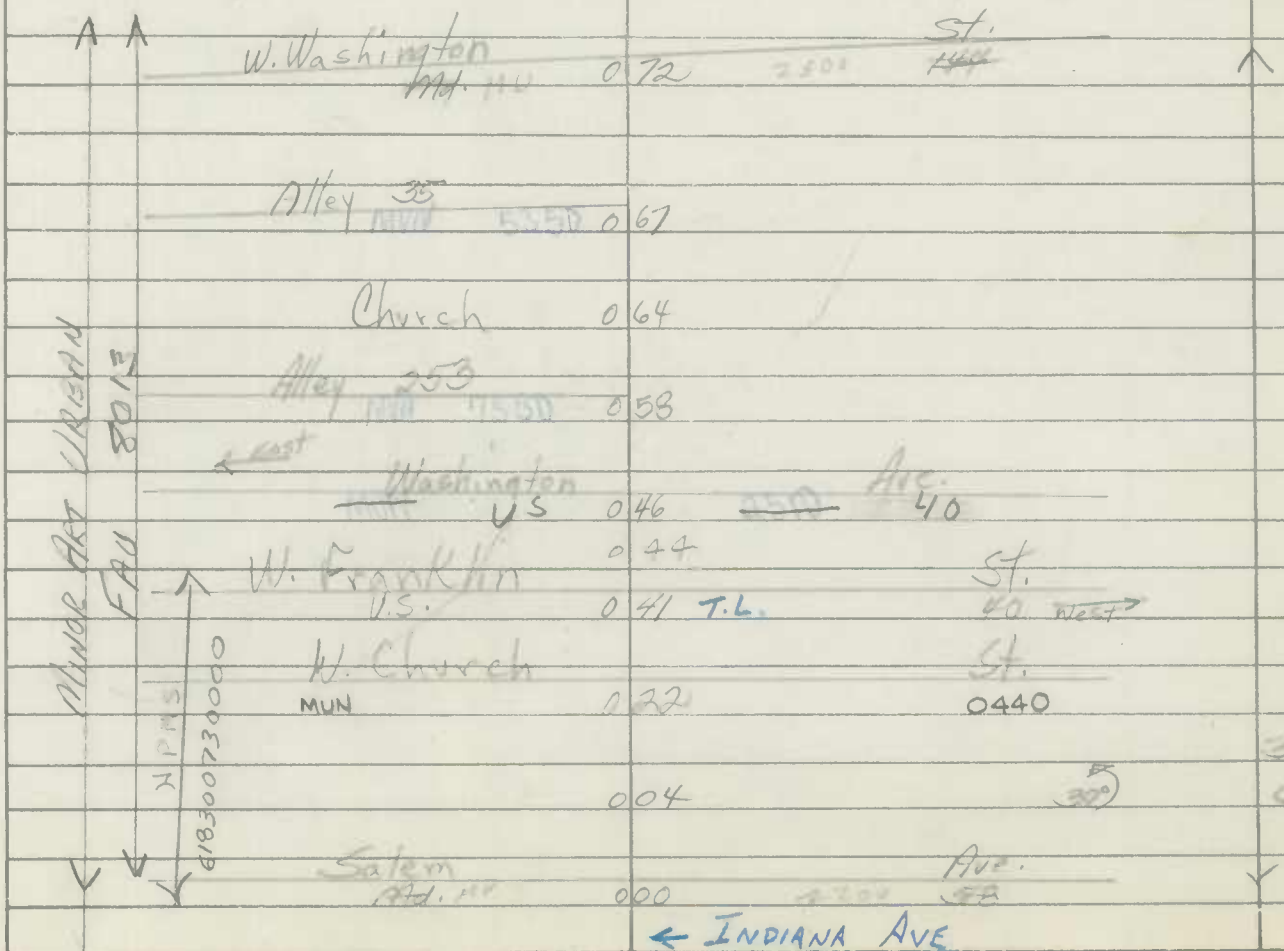
W. Washington
Mid. HW
0 72
St.
Alley
35
0 67
Church
0 64
Alley
253
0 58
Washington
US
0 46
Ave.
40
W. Franklin
U.S.
0 44
0 41 T.L.
St.
W. Church
MUN
0 22
0440
0 04
Salem
Rd.
0 00
Ave.
INDIANA AVE
Middle Rd
Right
Left
NPRS
0
0
0

SHA 51.3-8
11-15-72

STATE HIGHWAY ADMINISTRATION OF MARYLAND

Co 218

ROAD INVENTORY SHEET

Party Chief RV
Recorder LC JR
Helper

Ver 6-10-76
Map No. HAGERSTOWN
Revr 9-4-81

Road No. 1840
Road Name OAK HILL AVE
Sheet No. 1 OF 2
Date 8-30-63
County WASHINGTON
State Coordinates

W MAGNOLIA AVE				
MON MD	0	86		
COUNTRY CLUB RD				
MON	0	73	SD	50' I C-C
NORTHERN AVE				
MON	0	60	MD	X
	0	49	SCHOOL	50' I
APP HAGERSTOWN	0	40	CORP LIM	X 48' I
			CATHEDRAL AVE	JC-LT
ENT TO SHOPPING CENTER	0	35	Co 217	X 50' CU
	0	33	APT HOUSE	40' I JC-C
US DEPT COMMERCE BUR. PUBLIC ROADS REGION 2	0	27		
LONGMEADOW DR				
Co	0	22	T 220	X
H	0	10	5 H	
	0	08		
			THE TERRACE	20' I
	0	01	Co 219	30' CU
	0	00		
ROAD		END		

S

SHA 51.3-8
11-15-72

ROAD INVENTORY SHEET

Road No. 1840
Road Name Dac Hi Ave
Sheet No.
Date
County
State Coordinates

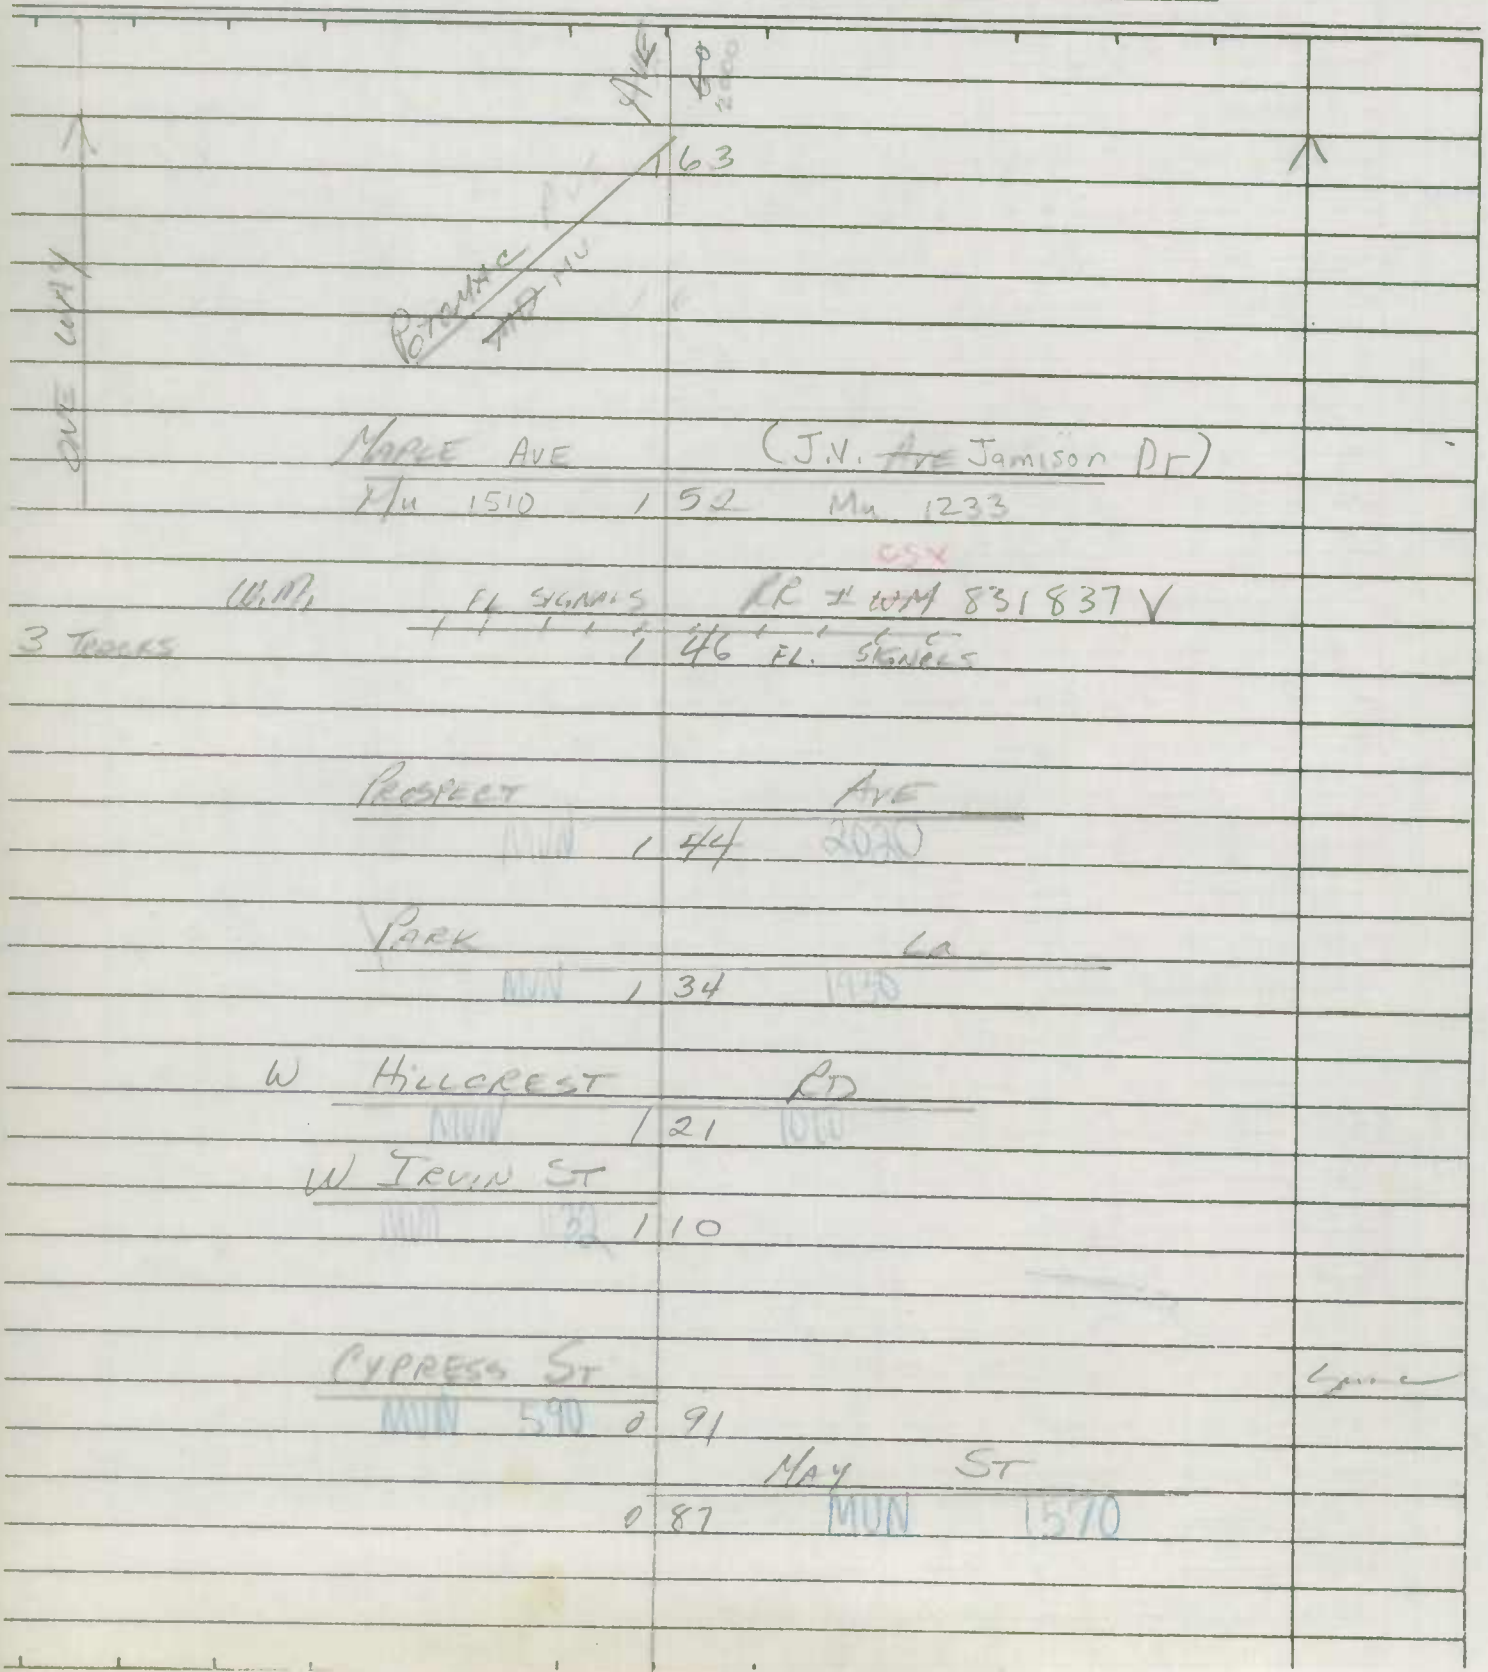

P9-77

MACS

Form 6 HPS (Rev. 1961)

Mun. No. 1840

ROAD INVENTORY SHEET

Party Chief R. VAUGHT
Recorder L. CAFFELT JR
Chainman

COPY 12/6/63 AC DES ENG.

VERIFIED 6-10-76

Road No. CO 218
Name OAK HILL Ave.
Sheet No. 1 OF 2
Date 8-30-63
County WASHINGTON

MAY ST
MUN
083 087
W. MAGNOLIA AVE
MUN.
082 086
COUNTRY CLUB ROAD
079 073
NORTHERN AVE
MUN CO
066 060
255 MUN
055 049
SCHOOL
046 040
CORP LIMITS
CATHERAL AVE
041 035
CO 217
APT HOUSE
033
H
023 027
UNITED STATES DEPT OF COMMERCE
BUREAU OF PUBLIC RDS
REGION 2
LONG MEADOW
CO
028 022
DR
220
H
016 010
5 H
004
THE TERRACE
CO 219
001
000
CATHERAL AVE
CO 217 JCT STATE
HAGERSTOWN
MUN
50' I
CC
40' H
CC
40' H
CC
20' I
30' ON
16' E

Form 6 HPS (Rev. 1961)

4

ROAD INVENTORY SHEET

Party Chief R. VOUGHT
Recorder L. CAFFOLT-HR
Chainman

COPY
12/4/63
M. PEE. E.S.S.

Road No. CO 218
Name
Sheet No. 2 OF 2
Date 8-30-63
County WASHINGTON

S.U.D

WASHINGTON AVE

1 63

POTOMAC AVE

ONE-WAY

MAPLE AVE

MUN

152

HWM 831 837V R.R.

W. MAIN

FLASHING SIGN

FLASHING SIGNALS

3 TRACKS

146

PROSPECT AVE

144

PARK LA

MUN

137

MUN


MUN

121

MUN

W. IRVIN ST

MUN

110

CYPRESS ST

MUN

091

HAGERSTOWN

MUN

SAME

SHA 51.3-8
11-15-72

STATE HIGHWAY ADMINISTRATION OF MARYLAND

URBAN

ROAD INVENTORY SHEET

Co 941

Party Chief M. BAKER OFF. INV.
Recorder
Helper

Map No. A18 80-218

HAGERSTOWN

Road No. MD 1892
Road Name OUTER DR
Sheet No. 1 OF 1
Date 7-14-76 REV 8-4-76
County WASH
State Coordinates 597-669

			34'I
CARROLL HGTS. BLVD.			"J"C-C
MUN.	0 48		X
MUN. 0215		MUN. 0210	
BRAMLY DR	0 44	BRAMLY CT	
	0 39	PT	
		50°	
		(OUTER COURT)	
	0 32	MUN. 1893 PC	38'I
			J"C-C
	0 28		X
130°	0 27	#2	
		MD 1893	39'I
	0 19	30°	~~24'E~~
			~~34'C~~
			X
MD 1892	0 12	H	
H	0 09		39'I
			"J"C-C
	0 08		X
			~~18'H~~
	0 06		~~22'E SP~~
HAVEN RD Co 682			~~26'CW~~
CORP. LIMITS	0 00	OF HAGERSTOWN	

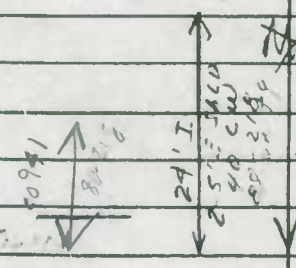

SHA 51.5-6
11-15-72

ROAD INVENTORY SHEET

Co 941

Road No. MU 1890
Road Name
Sheet No. 2 OF 2
Date
County WASH
State Coordinates

HAGERSTOWN

GLENWOOD	AVE.	
MU 0	75 0930	↑
0	69	30° ↑
	OUTER CIR	
0	52 MUN 1 FO	
		SAME

Form 6 HPS (Rev. 1961)

P9-71

AT 4

OFFICE

ROAD INVENTORY SHEET

Party Chief
Recorder DAB
Chainman

VER
7-13-76

70-2

Road No. 1895
Name OXFORD CIRCLE
Sheet No. 1 OF 1
Date 3-12-71
County WASHINGTON

SEE NEW INV

90 MUN LK = 3

GD / TM

3/13/91

ANGLE
WAKEFIELD 004 2460 RD

38'I
C-C

ANGLE 000 RD 0070

SHA 51.3-8
11-15-72

STATE HIGHWAY ADMINISTRATION OF MARYLAND

91-17 Ex #2
BB/SP
3-19-92

ROAD INVENTORY SHEET

Party Chief W DOMBROSKI
Recorder M ZALENSKI
Helper

Map No.
REWRIT - 11-23-81 JTSC
VERIFIED 7-14-76 LJDEMT

Road No. 1900
Road Name PANGBORN BLVD
Sheet No. 1 of 4
Date 9-17-63
County WASHINGTON
State Coordinates 604-659

91-27

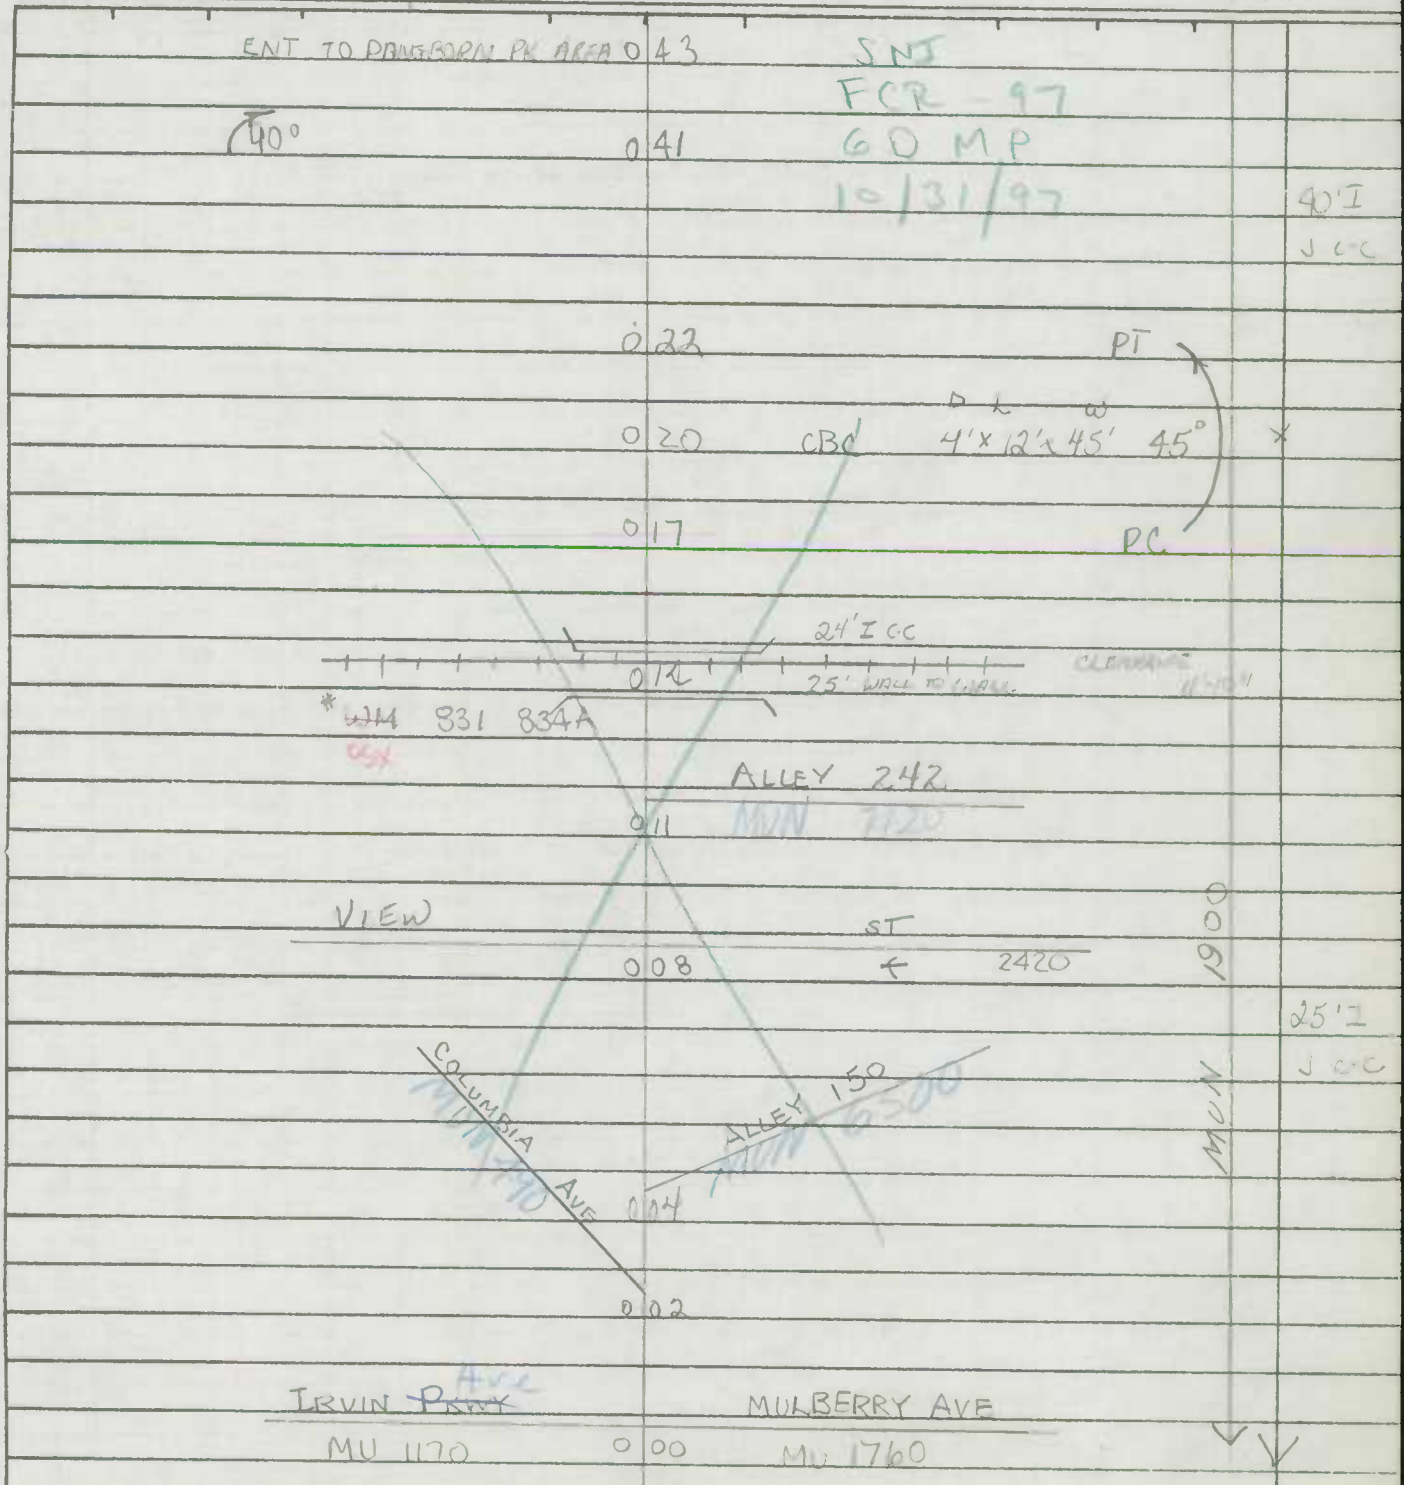

SHA 51.3-8
11-15-72

ROAD INVENTORY SHEET

Road No. 1900
Road Name PANGBORN BLVD
Sheet No. 2 of 4
Date 9-17-63
County WASHINGTON
State Coordinates

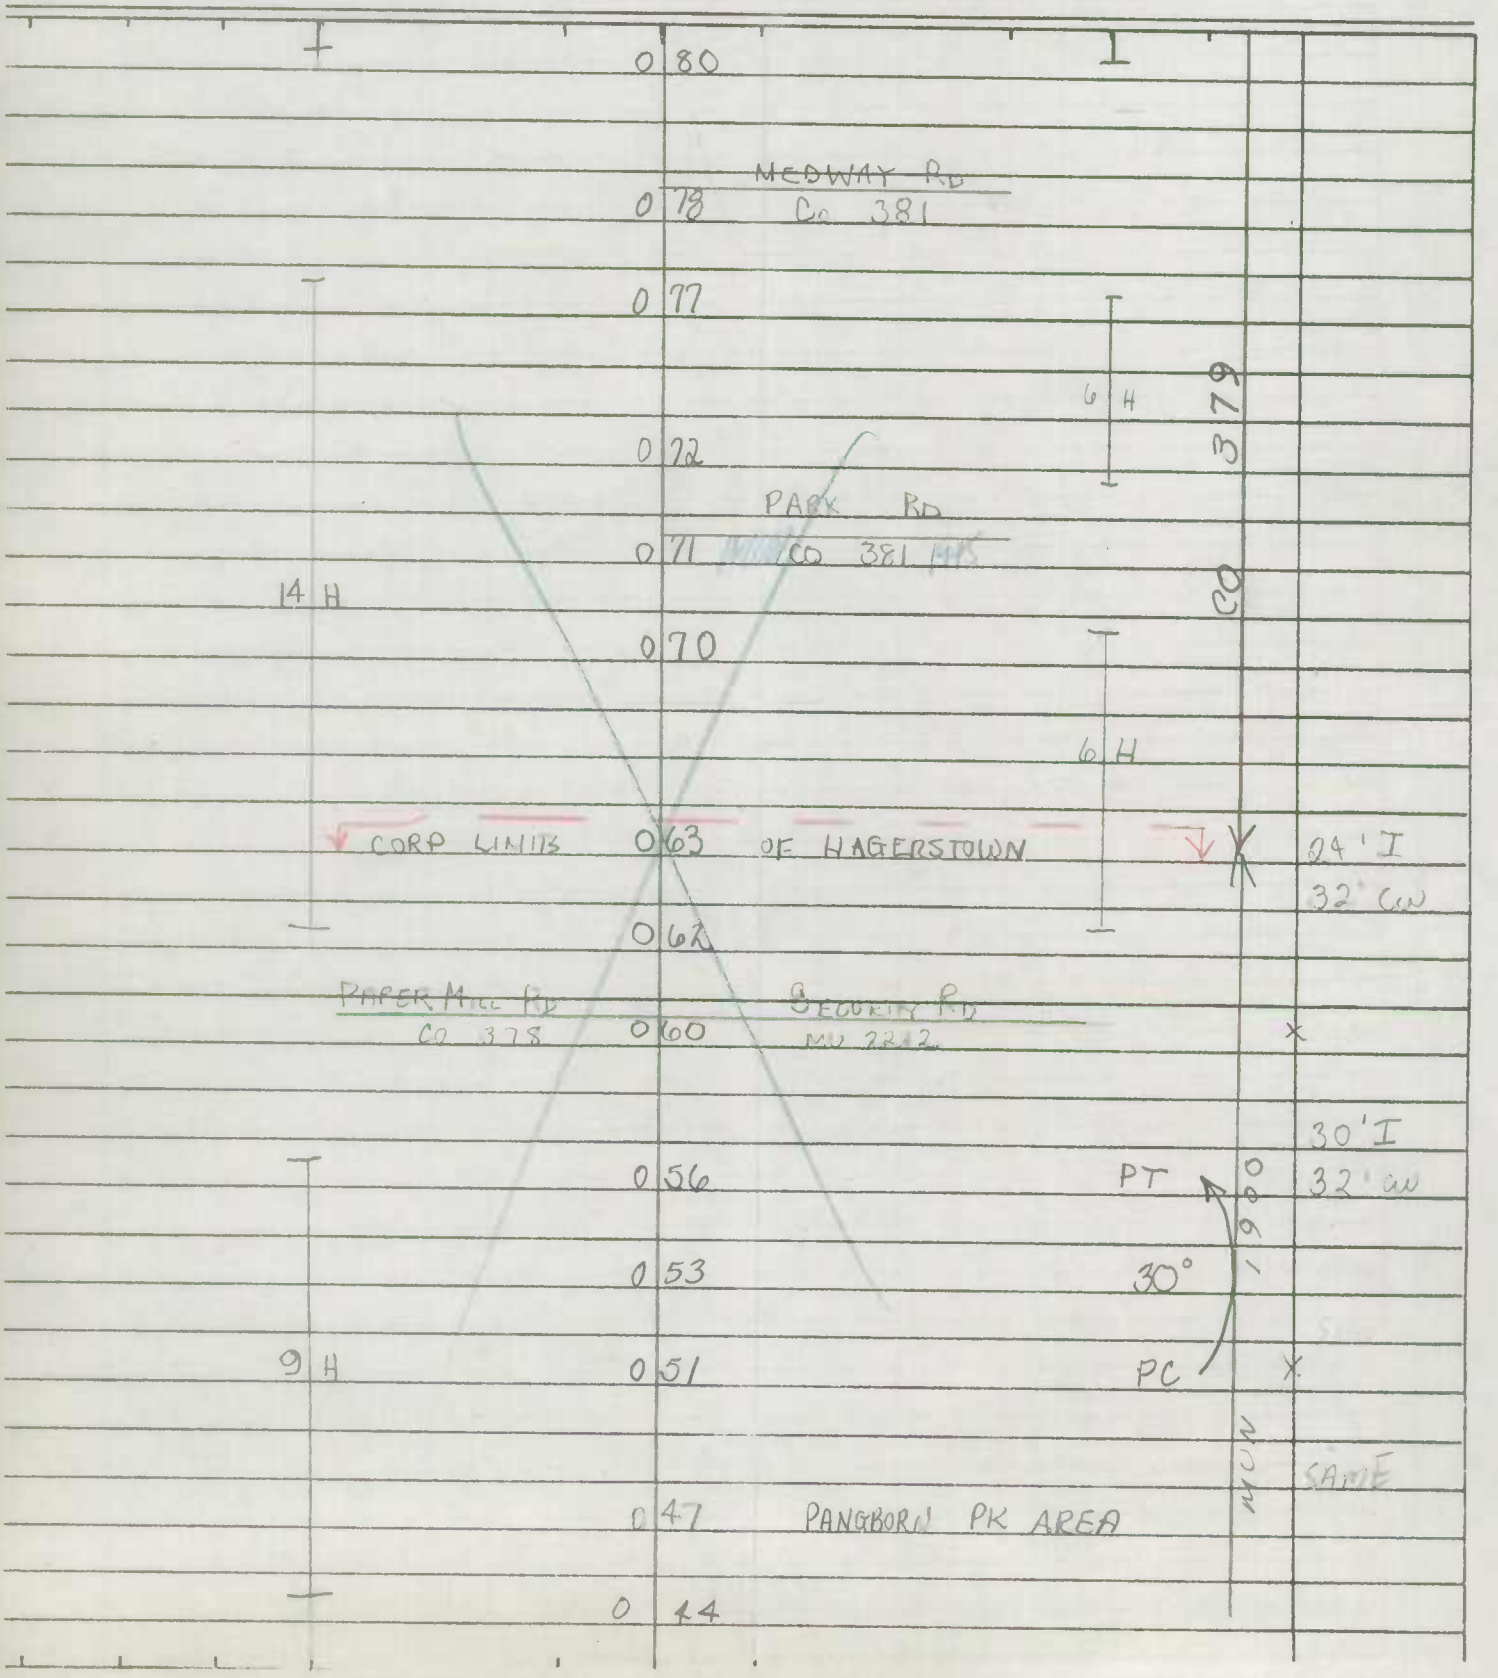

SHA 51.3-8
11-15-72

STATE HIGHWAY ADMINISTRATION OF MARYLAND

ROAD INVENTORY SHEET

Party Chief W DOMERSKI
Recorder M ZAIENSKI
Helper _____

Map No. _____

Road No. MU 1902
Road Name PANGBORN BLVD
Sheet No. 3 of 4
Date 9-17-63
County WASHINGTON
State Coordinates _____

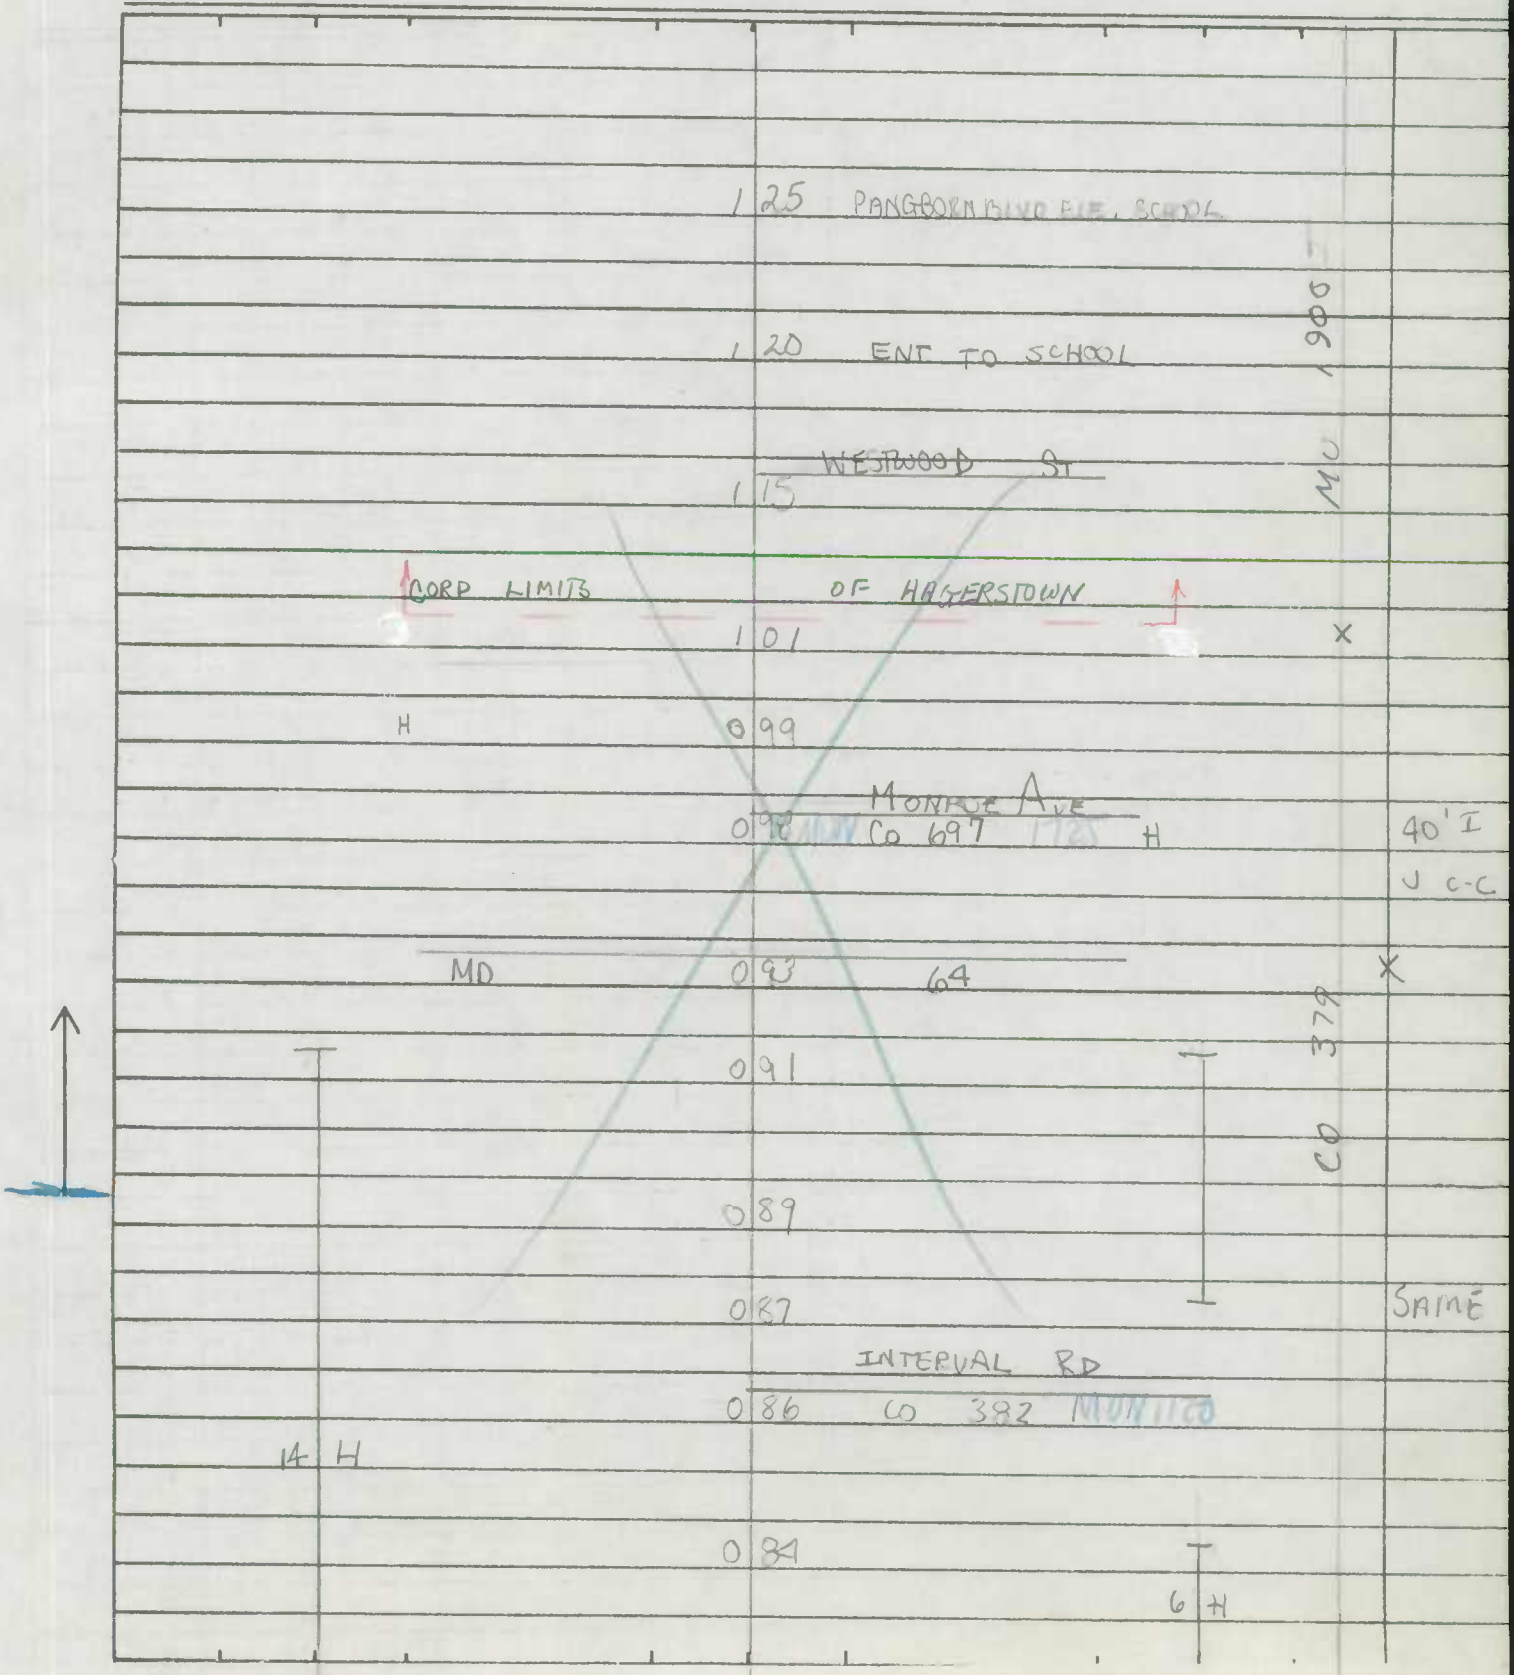

SHA 51.3-8
11-15-72

ROAD INVENTORY SHEET

Road No. 1900
Road Name PAUGHORN BLVD
Sheet No. 4 of 4
Date 9-17-63
County WASHINGTON
State Coordinates

PROP.

ROAD 150 END

MANOR
MU OP 145 DE 200

1900 MU SAME

SHA 51.3-8
11-15-72

STATE HIGHWAY ADMINISTRATION OF MARYLAND

ROAD INVENTORY SHEET

MU 1900
CO 379

Party Chief W. DOMPROWSKI
Recorder M. ZALEWSKI
Helper

Road No.
Road Name TASSEL (OLD)
Sheet No. 1 OF 3
Date 9-17-63
County WASHINGTON
State Coordinates 604 659

Map No. VERIFIED 7-14-76 W.D.E. M.Z.

1941

051 30°
047 PAVEMENT FOR ALLEY
044
043 ENT TO PAVEMENT FOR ALLEY
041 90°
032
020 CBC
017
014 W.M. R.R. #WM 831 834 A
011 ALLEY
008 VIEW ST
004 COLUMBIA ALLEY
002 IRVIN PKWY MUL 1120
000 MULBERRY AVE 1760

30'I 32'CW
40'I JC-C
2-I JC-C

SHA 51.3-8
11-15-72

4

ROAD INVENTORY SHEET

MU 1900

Road No. ~~C~~ 379
Road Name
Sheet No. 2 OF 3
Date 9-17-63
County WASHINGTON
State Coordinates

0 91
0 89 6 H
0 87
14 H INTERVAL RD
0 86 Co 382
0 84
2 H
0 80
MEDWAY RD
0 78 Co 381
0 77
6 H
0 72
PARK RD
0 71 Co 380
14 H
0 70
CORP LIMITS 0 63 OF 6 H HAGERSTOWN
0 62 24'I 32'CW
PAPER MILL RD SECURITY RD
Co 378 0 60 MU 2212 328
0 56 PT
0 53

SHA 51.3-8
11-15-72

STATE HIGHWAY ADMINISTRATION OF MARYLAND

4

ROAD INVENTORY SHEET

MV. 1900

Party Chief W. DOMBROSKI
Recorder M. ZALENSKI
Helper

Map No.

Road No. ~~C 279~~
Road Name
Sheet No. 3 OF 3
Date 9-17-63
County WASHINGTON
State Coordinates

prop

ROAD 1 50 END

~~MANOR~~ DR.
~~MANOR~~ 1 45 200

~~ROAD~~ ~~END~~

~~1 40~~

BANGBORN BLVD.
1 25 ELE SCHOOL

1 20 ENT TO SCHOOL

WESTWOOD ST
1 15

CORP LIMITS ... HAGERSTOWN
1 01

H 0 99

MONROE AVE
0 98 Co 697 H

MD 0 93 64

MUN HAGERSTOWN #1900

24 I
32 CW

40 I
J C-C

SAME

Form 6 HPS (Rev. 1961)

93-4
3-10-93
AL/TM

ROAD INVENTORY SHEET

Party Chief R. VOUGHT
Recorder L. COFFELT JR.
Chainman

HAGERSTOWN

VER
7-15-76

Road No. 1920
Name CITY PARK DRIVE
Sheet No. 1 OF 1
Date 11-8-63
County WASHINGTON

VIRGINIA Ave

Mu 0 15 + 2430

ALLEY #114

Mu 0 11

(HIGHLAND Ave) (HIGHLAND WAY)

1035 000 Mu 1040

20 AI

CURB LT

24 CW

SHA 51.3-8
11-15-72

STATE HIGHWAY ADMINISTRATION OF MARYLAND

ROAD INVENTORY SHEET

Party Chief M BAXTER - OFF. INV
Recorder
Helper

Map No.

HAGERSTOWN

Road No. MU. 1930
Road Name PARK LA
Sheet No. 1 OF 2
Date 7-15-76 REV 8-5-76
County WASH
State Coordinates

SNI
FCR -97
GD, MP 14/13/97

			MU. 0130	
BELVIEW	0	48	AVE	
			6580	
ALLEY	0	44	#158	
WOODLAND	0	39	WAY	
PT 45° PC	0	38		
FORREST	0	33	DR #2	
	0	31	PT 90° PC	
	0	25		
			2360	
THE	0	23	TERRACE	
ALLEY	0	19	#162	
30°	0	17		
OAK HILL	0	14	AVE	
ALLEY	0	10	#161	
HAMILTON	0	05	BLVD	
	0	01	ALLEY #186	30'I "J" C-C
POTOMAC			AVE	
MUN	0	00	2000	

SHA 51.3-8
11-15-72

ROAD INVENTORY SHEET

Road No. MU 1930
Road Name PARK LA
Sheet No. 2 OF 2
Date 7-15-76 REV 8-5-76
County WASHINGTON
State Coordinates

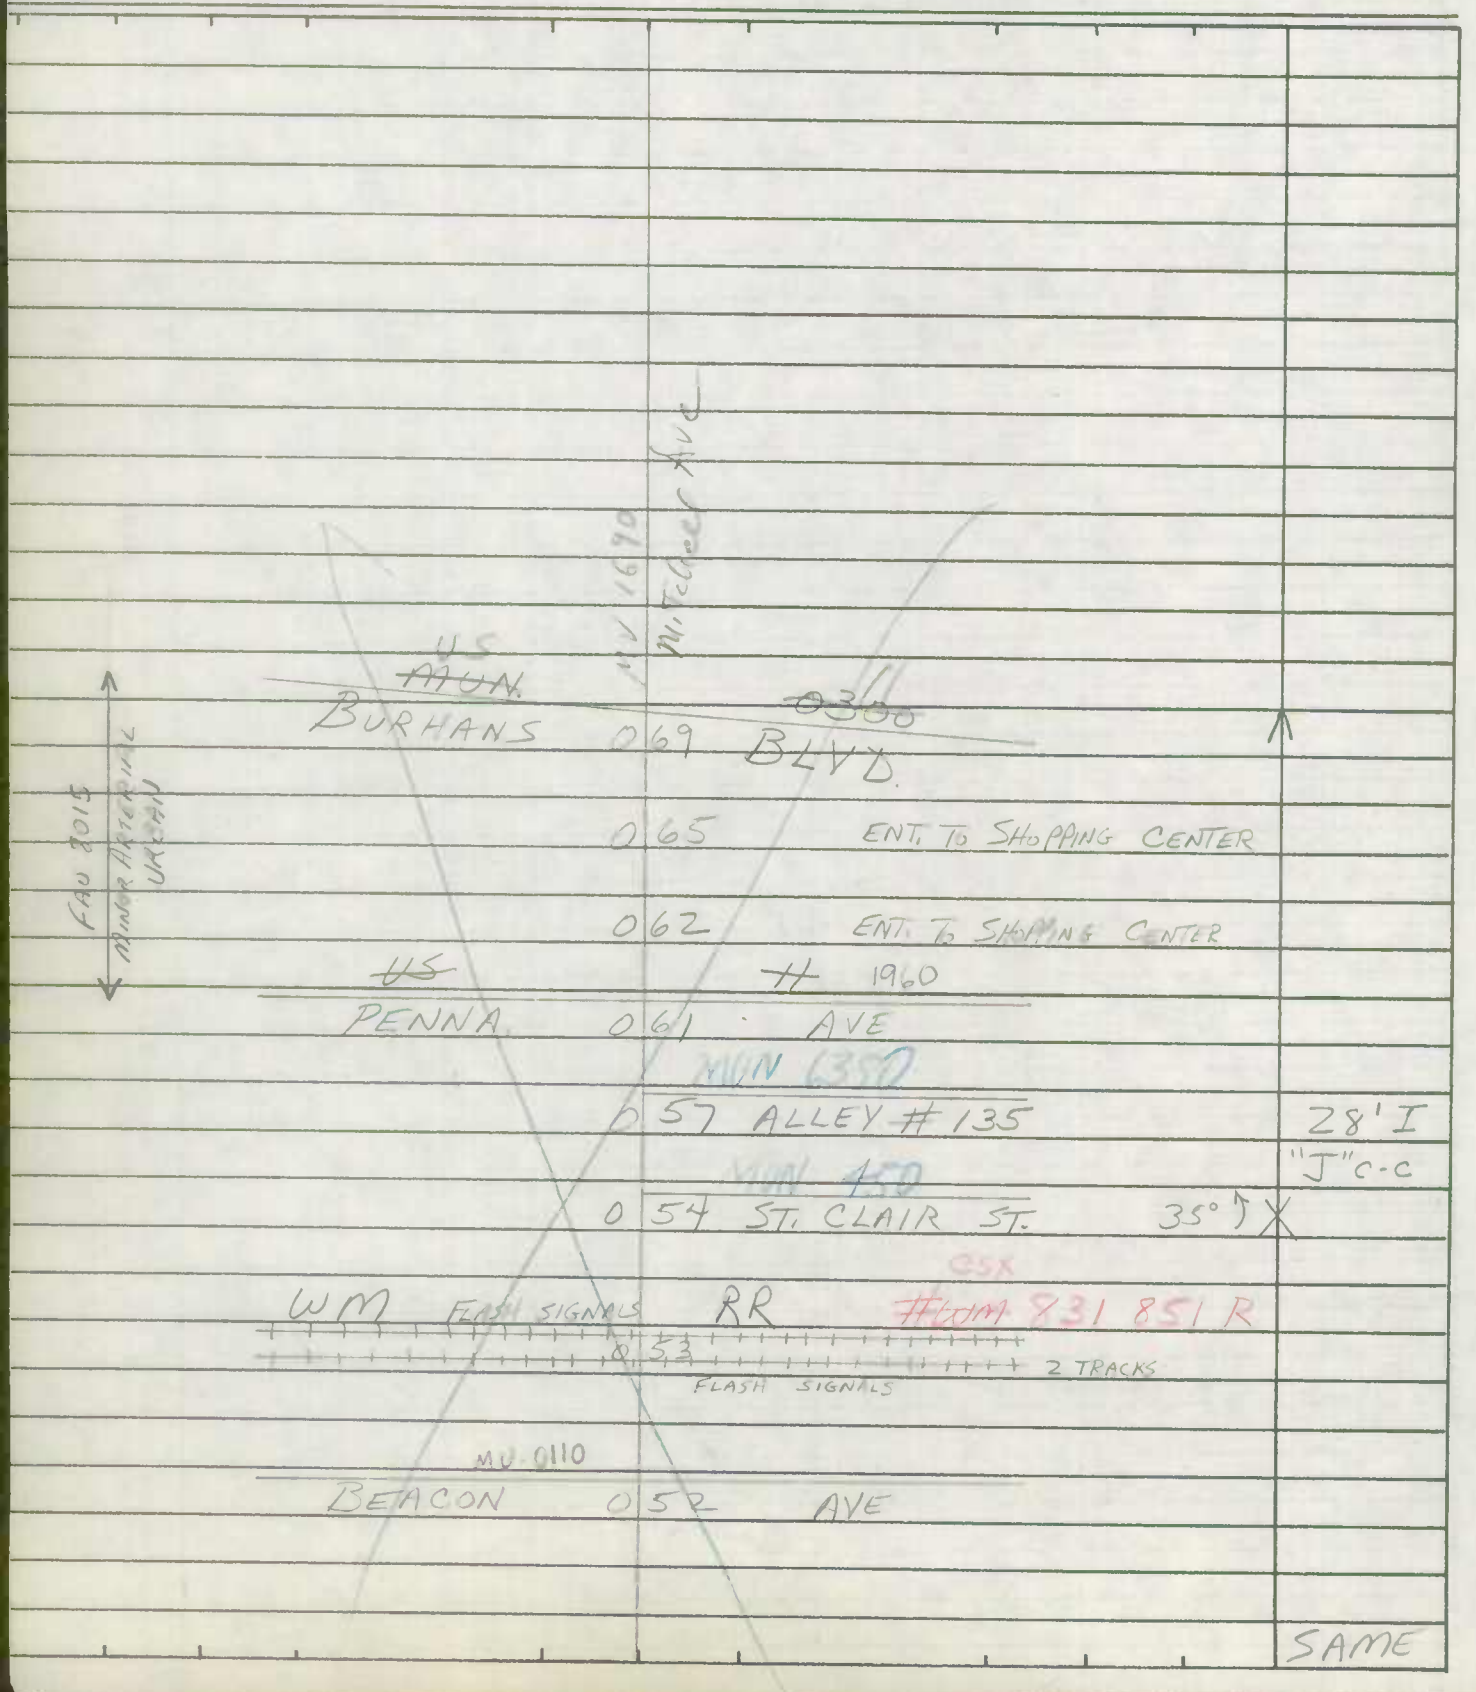

SHA 51.3 - 8 Revised
4.83

MARYLAND STATE HIGHWAY ADMINISTRATION

90-6
3-12-91
GD/TM
A/T

ROAD INVENTORY SHEET (OLD US 11)

Hagerstown

Party Chief CB
Recorder AL
Assistant
Map No./Dir. A-8 / N
State Coordinates 396-661

Road No. MUN. 1960
Road Name PENNSYLVANIA AVE
County WASHINGTON
Date 4-22-87
Sheet No. 1 OF 2

91-12 A/T

TRAFFIC CODES
TRAFFIC CONTROLS: STOP SIGN=SS, TRAFFIC LIGHT=T.L., FLASHING RED BALL=F.R.

TRAFFIC CODES
PARKING RESTRICTIONS: A.M. PEAK, P.M. PEAK, A.M./P.M. PEAK, NO PARKING ANYTIME=N.P., COMM/IND. ACCESS=E

SYSTEM				TRAFFIC		LINE DIAGRAM	TRAFFIC			PAVEMENT DATA
FED. AID.	FUNCT CLASS.	HWY. SYS.	HPMS SAMPLE	PRKG. REST.	COM/IND. ACCESS		CONTROL	COM/IND. ACCESS	PRKG. REST.	
	FAU 8001 URBAN OTHER PRINCIPAL ARTERIAL				I	SNI FCR-93 GD MP 11/11/87 0 25 3 2 REC RR FL 0 24.5 3 TRACKS N PROSPECT ST 2030 ALLEY 178 6780 0 20 23 0 19 21 PENN MAR AVE. 1150 0 178 CHURCH 0 1K3 ALLEY #180 6800 0 10 CLARKSON AVE 0490 0 CA9 CHARLES ST 0410 0 C84 FOREST ST. 0510 0 C0 SOUTH ST 1230	FL TL		34'I J C-C 2 ML 34'I J C-C 1 ML 34'I J C-C 2 ML

LINE DIAGRAM

SYSTEM: FED. AID. | FUNCT. CLASS. | HWY. SYS. | HPMS SAMPLE

FAU 8001 URBAN OTHER PRINCIPAL ARTERIAL HPMS 100110000279 4 V

TRAFFIC: PRKG. REST. | COM/IND ACCESS

TRAFFIC: CONTROL | COM/IND ACCESS | PRKG. REST.

PAVEMENT DATA

US 11

HILLCREST AVE. 1050 TL

BURHANS BLVD. US 11

PARK LA. 1930 TL

WAY

R.R.

FL

BEACON AVE 0110

ORR

BELVIEW AVE. 0130

PROSPECT AVE 2020 TL

50' I
J" C-C
2ML

34' I
J C-C
2 ML

Form 6 HPS (Rev. 1961)

ROAD INVENTORY SHEET

Party Chief R. VOUGHT
Recorder L. COFFELT JR.
Chainman

HAGERSTOWN

VER 7-20-76

Road No. 1960
Name PENN. AVE
Sheet No. 1 OF 2
Date 11-13-63
County WASHINGTON

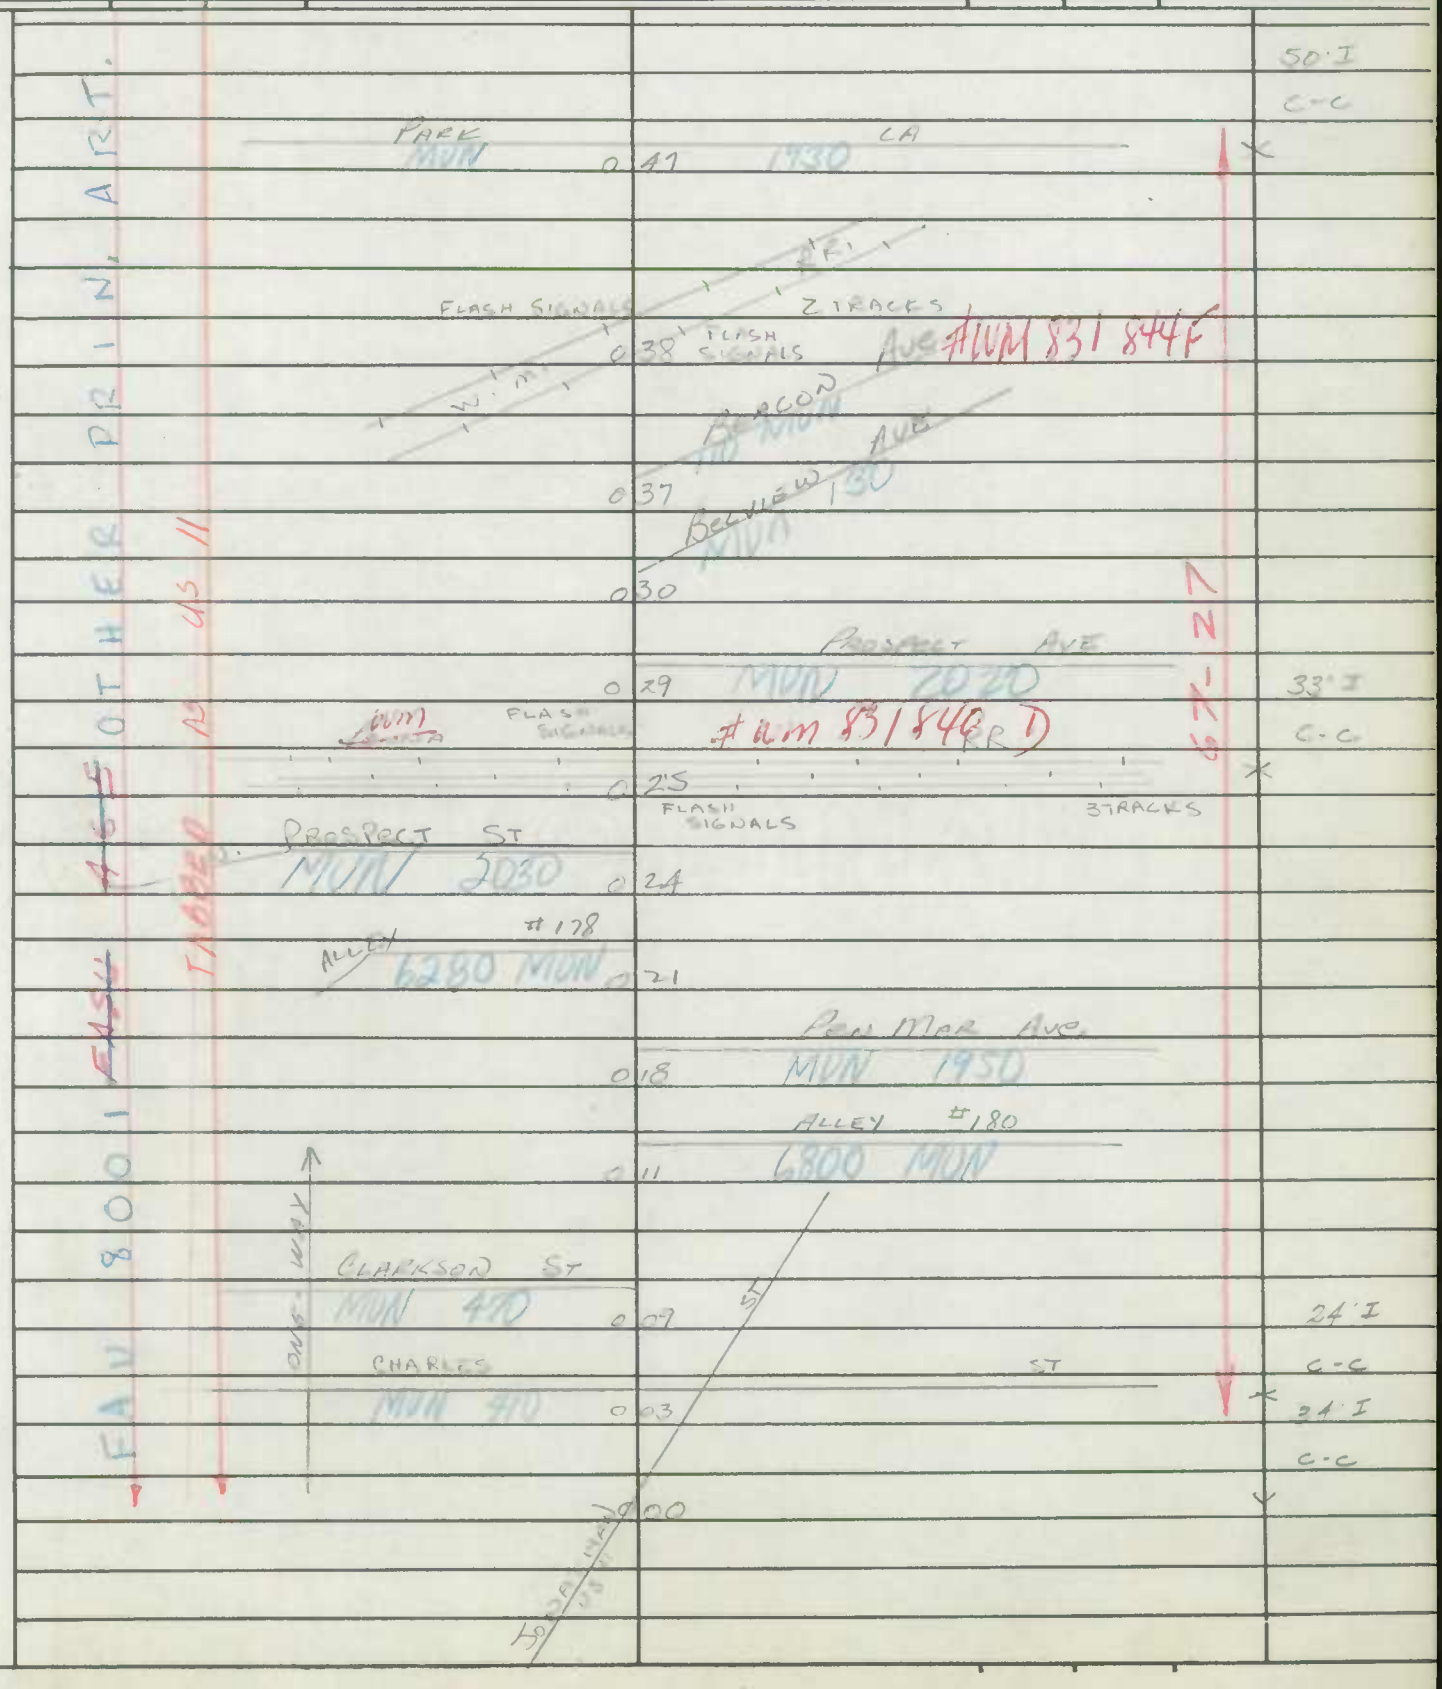

Form 6 HPS (Rev. 1961)

ROAD INVENTORY SHEET

Party Chief ~~R. VOUGHT~~
Recorder
Chainman ~~L. COFFELT~~ J.

HAGERSTOWN

Road No.
Name PENNA. AVE
Sheet No. 2 OF 4
Date 11-13-63
County WASHINGTON

HAVEN RD
MUN 1000

119

113 Begin SRC Maint

FAIRVIEW RD.
MUN 790

110 WESTERN MD. STATE HOSPITAL

099 CORFMAN Medical Center Rd "H"

097 (PVT)

Beechwood Dr.
MUN 720

096

089 NORTH HAGERSTOWN HIGH SCHOOL

W. IRVIN AVE
MUN 1130

072

063

HILL CREST BLVD
MUN PVT

060 . 1066

55' I
C-C

60 I
C-C

Same

FAIRVIEW
TABLER RD
FAIRVIEW

Form 6 HPS (Rev. 1961)

P4-77

ROAD INVENTORY SHEET

Party Chief R. Vought
Recorder L. Coffelt, Jr.
Chainman

VER. 7-14-76

Road No. 1970
Name Pine St.
Sheet No. 1 of 1
Date 11-8-63
County Wash.

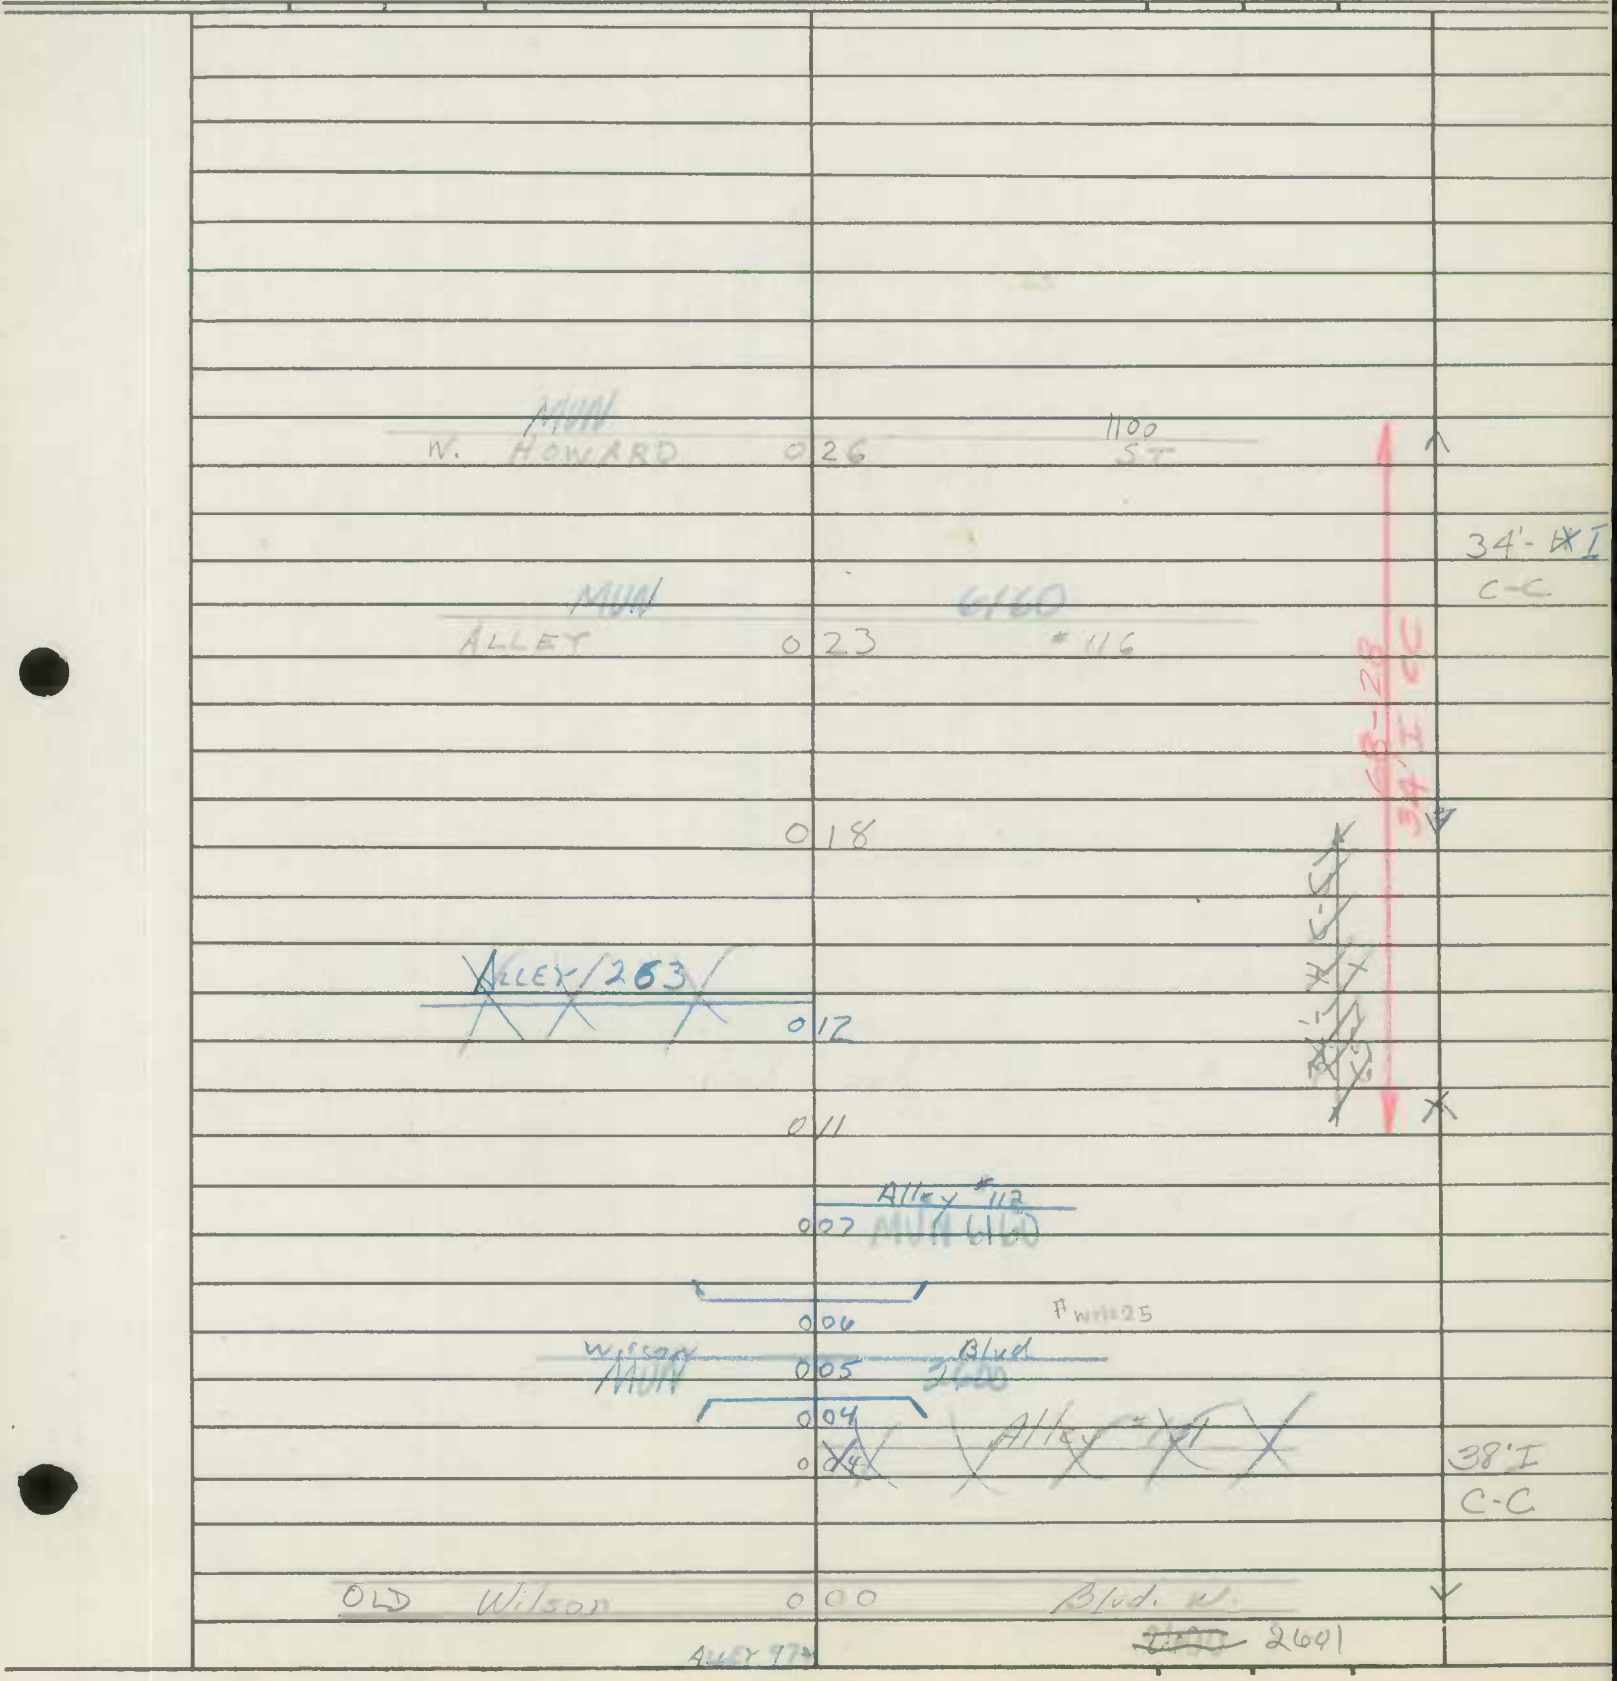

HAGERSTOWN FCR-97

SHA 51.3 - 8 Revised 4.83

MARYLAND STATE HIGHWAY ADMINISTRATION

ROAD INVENTORY SHEET

Party Chief GD
Recorder MP
Assistant
Map No./Dir. 1
State Coordinates

Road No. Mu 2000
Road Name Potomac Ave
County WASHINGTON
Date 11/12/97
Sheet No. 5 OF 7

TRAFFIC CODES
TRAFFIC CONTROLS: STOP SIGN=SS, TRAFFIC LIGHT=T.L., FLASHING RED BALI=F.R.

TRAFFIC CODES
PARKING RESTRICTIONS: A.M. PEAK, P.M. PEAK, A.M./P.M. PEAK, NO PARKING ANYTIME=N.P., COMM/IND. ACCESS=E

SYSTEM: FUNCT CLASS	SYSTEM: HWY SYS	SYSTEM: HPMS SAMPLE	TRAFFIC: PREG. REST.	TRAFFIC: COM/IND ACCESS	LINE DIAGRAM	TRAFFIC: CONTROL	TRAFFIC: COM/IND ACCESS	TRAFFIC: PREG. REST.	PAVEMENT DATA
					E. Lee St. — W. Lee St.				32'I
					Mun 2 15 1360	TL		X	J C-C
					WAY				1 UML
					Alley #5				
					2 07 Mu 5050				
					ONE				
					E Baltimore St. — W. Baltimore St				
					US 40 Alt. 1 99 Mu 0090	TL			
					Alley #7				
					1 95 Mu 5070				
					CH 1 94 35°				
					1 90 CH				
					E Antietam St				
					Mu 1 85 0030				38'I
					Alley #8				J C-C
					Mu 5080 1 81				2 ML
					WAY				
					CH 1 77			X	
					~~W~~. Washington St.				
					EBL U.S. ← 1 75 40 ←				34'I
					LTJ				J C-C
					73				2 ML
					ONE				
Urban Other Principle Arterial									

COUNTY WASHINGTON ROAD NO. Mu 2000 PAGE 6 OF 7

SYSTEM: FUNCT CLASS — Urban Other Principle Arterial; HWY SYS; HPMS SAMPLE

TRAFFIC: PREG REST; COM/IND ACCESS

LINE DIAGRAM

TRAFFIC: OTHER; COM/IND ACCESS; PREG. REST.

PAVEMENT DATA

E. Howard Spur — Mu — 2 79

1090 St — Alley 120

2 77 Mu 6200

Garlinger Ave.

2 61 Mu. 0890

E to CEM — 2 58

2 52

LTL

E Memorial Blvd — W. Memorial Blvd

Mu — 2 48 — 1650 — TL

RTL

LTL 10'I

2 44

38'I
J C-C
2 ML

Bester E.S. — 2 41

Alley #2

2 38 Mu 5020 — X

32'I
J C-C
2 ML

Alley Mu 14 5140 — 2 34

St. — 2 29 — X

S. Locust 1430 — Spur — Mu

Alley #4

2 28 Mun 5040

32'I
J C-C
1 UML

Sycamore St.

2 25 Mu 2340

END

HAGERSTOWN FCR-97

SHA 51.3 - 8 Revised 4.83

MARYLAND STATE HIGHWAY ADMINISTRATION

ROAD INVENTORY SHEET

Party Chief GD
Recorder MP
Assistant
Map No./Dir. /
State Coordinates

Road No. Mu 2000
Road Name Potomac Ave
County WASHINGTON
Date 11/12/97
Sheet No. 7 OF 7

TRAFFIC CODES
TRAFFIC CONTROLS: STOP SIGN-SS, TRAFFIC LIGHT=T.L., FLASHING RED BALL=F.R.

TRAFFIC CODES
PARKING RESTRICTIONS: A.M. PEAK, P.M. PEAK, A.M./P.M. PEAK, NO PARKING ANYTIME=N.P., COMM/IND. ACCESS=E

SYSTEM: FUNCT CLASS | HWY SYS | HPMS SAMPLE
TRAFFIC: PEDG. REST. | COM/IND ACCESS

Urban — Other Principle Arterial

LINE DIAGRAM

	65	
	A	
	M	Corp Limits Hagerstown
3	23	Sign: Begin ST MAINT
		Md 67 Downsville Mu
3	14	
	LT	Wilson Blvd
3	10	
	LT	Mun 2600
3	07	
		Alley 101
3	06	Mu 0010
		W. First St.
2	96	Mu 0810
		W. Howard St.
2	83	Mu 1100
		R.R.
2	80	CSX 140 616 J Track

TRAFFIC: CONTROL | COM/IND ACCESS | PEDG. REST.
TL
TL

PAVEMENT DATA
24'I
2-10'I SHLD
2 ML
38'I
J C-C
2 ML

COUNTY WASHINGTON ROAD NO. _____ PAGE ___ OF ___

SYSTEM				TRAFFIC		LINE DIAGRAM	TRAFFIC				PAVEMENT DATA
FUNCT CLASS	HWY SYS	HPMS SAMPLE		PREG REST	COM/IND ACCESS		CHANNELIZ	COM/IND ACCESS	PREG REST		

Form 6 HPS (Rev. 1961)

SNI
FCR-97
6D MP 11/12/97

CS V
Pg-77

ROAD INVENTORY SHEET

Party Chief R. VOUGHT
Recorder L. COFFELT JR.
Chainman

VCR 7-14-76

HAGERSTOWN

Road No. 2000
Name Potomac Ave
Sheet No. 1 OF 5
Date 10-31-63
County WASHINGTON

88-6 88-11-12 A/T

A/T 81-10

82-11 NS CR1

76-24 91-31 A/T 76-1 82-13 AT

		Manila Ave	Prospect Ave
		MUN 1500	MUN 2020
	088		
			Park La
	080	MUN	1930
		W. Hill Crest	Rd.
	071	MUN	1050
		McKee Ave	
	065	MUN 1600	
		W. IRVIN	Ave #2
	058	MU	1132
	049	PKWY	
			Laurel St
	046		MUN 1350
		PKWY	
	044	1620	
	040	School	
			Cypress St
	037		MUN 570
		W. MAGNOLIA	S. Ave
	031		
		Culvert Fair	
	021		Church
			Country Club Rd.
	017		MUN 560
		Mower Pkwy	
	009	MUN 1620	
		MUN 1810	Northern Ave
	000	END SPL PRIMT CO	MUN 1810
		EASTERN BLVD	

ART UPRIN
FAP 881
MEARS MU
PRIMI
OTHER

48'I
C-C

50'I
C-C

Form 6 HPS (Rev. 1961)

ROAD INVENTORY SHEET

Party Chief R. VOUGHT
Recorder L. [illegible] JEFFELT JR.
Chainman

HAGERSTOWN

Road No. MV 2040
Name Potomac Ave.
Sheet No. 2 OF 5
Date 10-31-63
County WASHINGTON

91-14

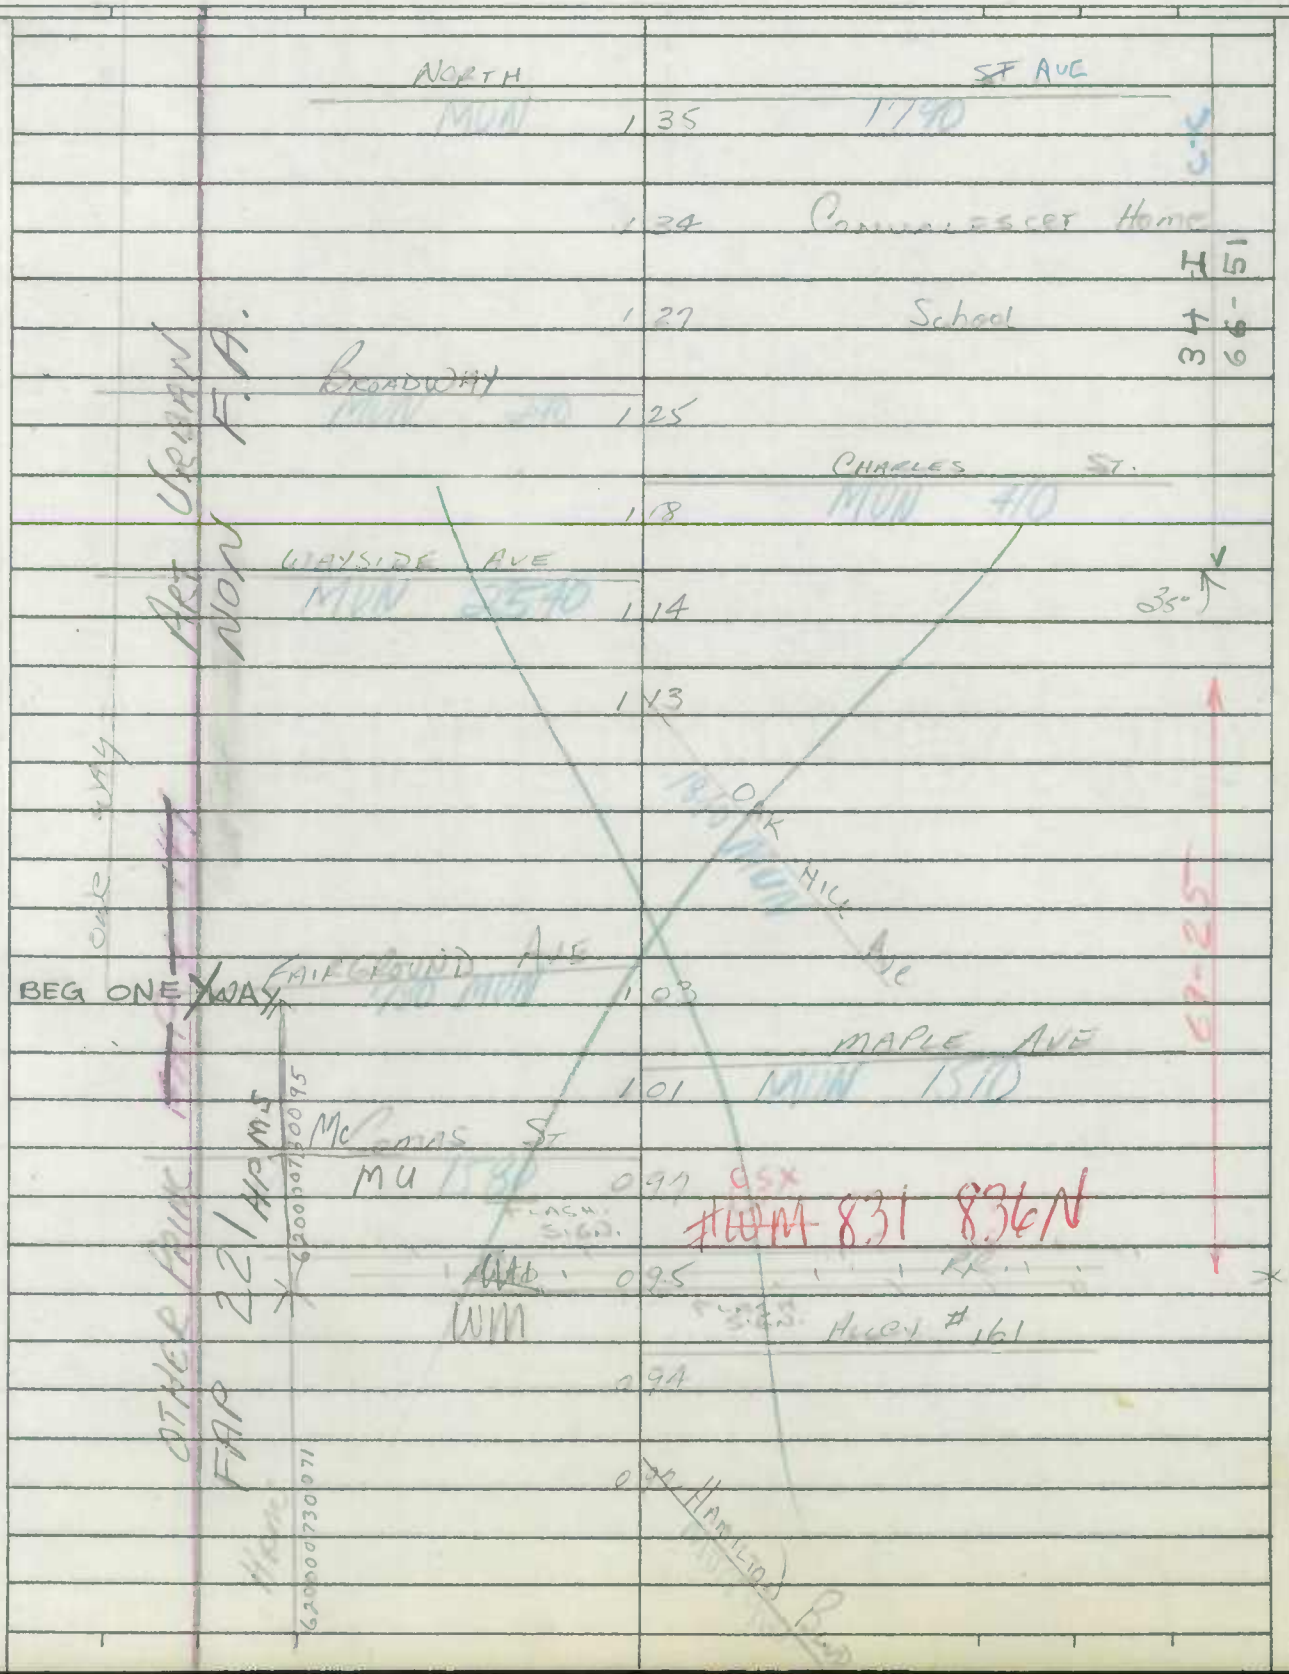

Form 6 HPS (Rev. 1961)

ROAD INVENTORY SHEET

Party Chief R. VOUGHT
Recorder L. COFFELT JR.
Chainman

HAGERSTOWN

Road No. MV 2050
Name POTOMAC LINE
Sheet No. 3 OF 5
Date
County WASHINGTON

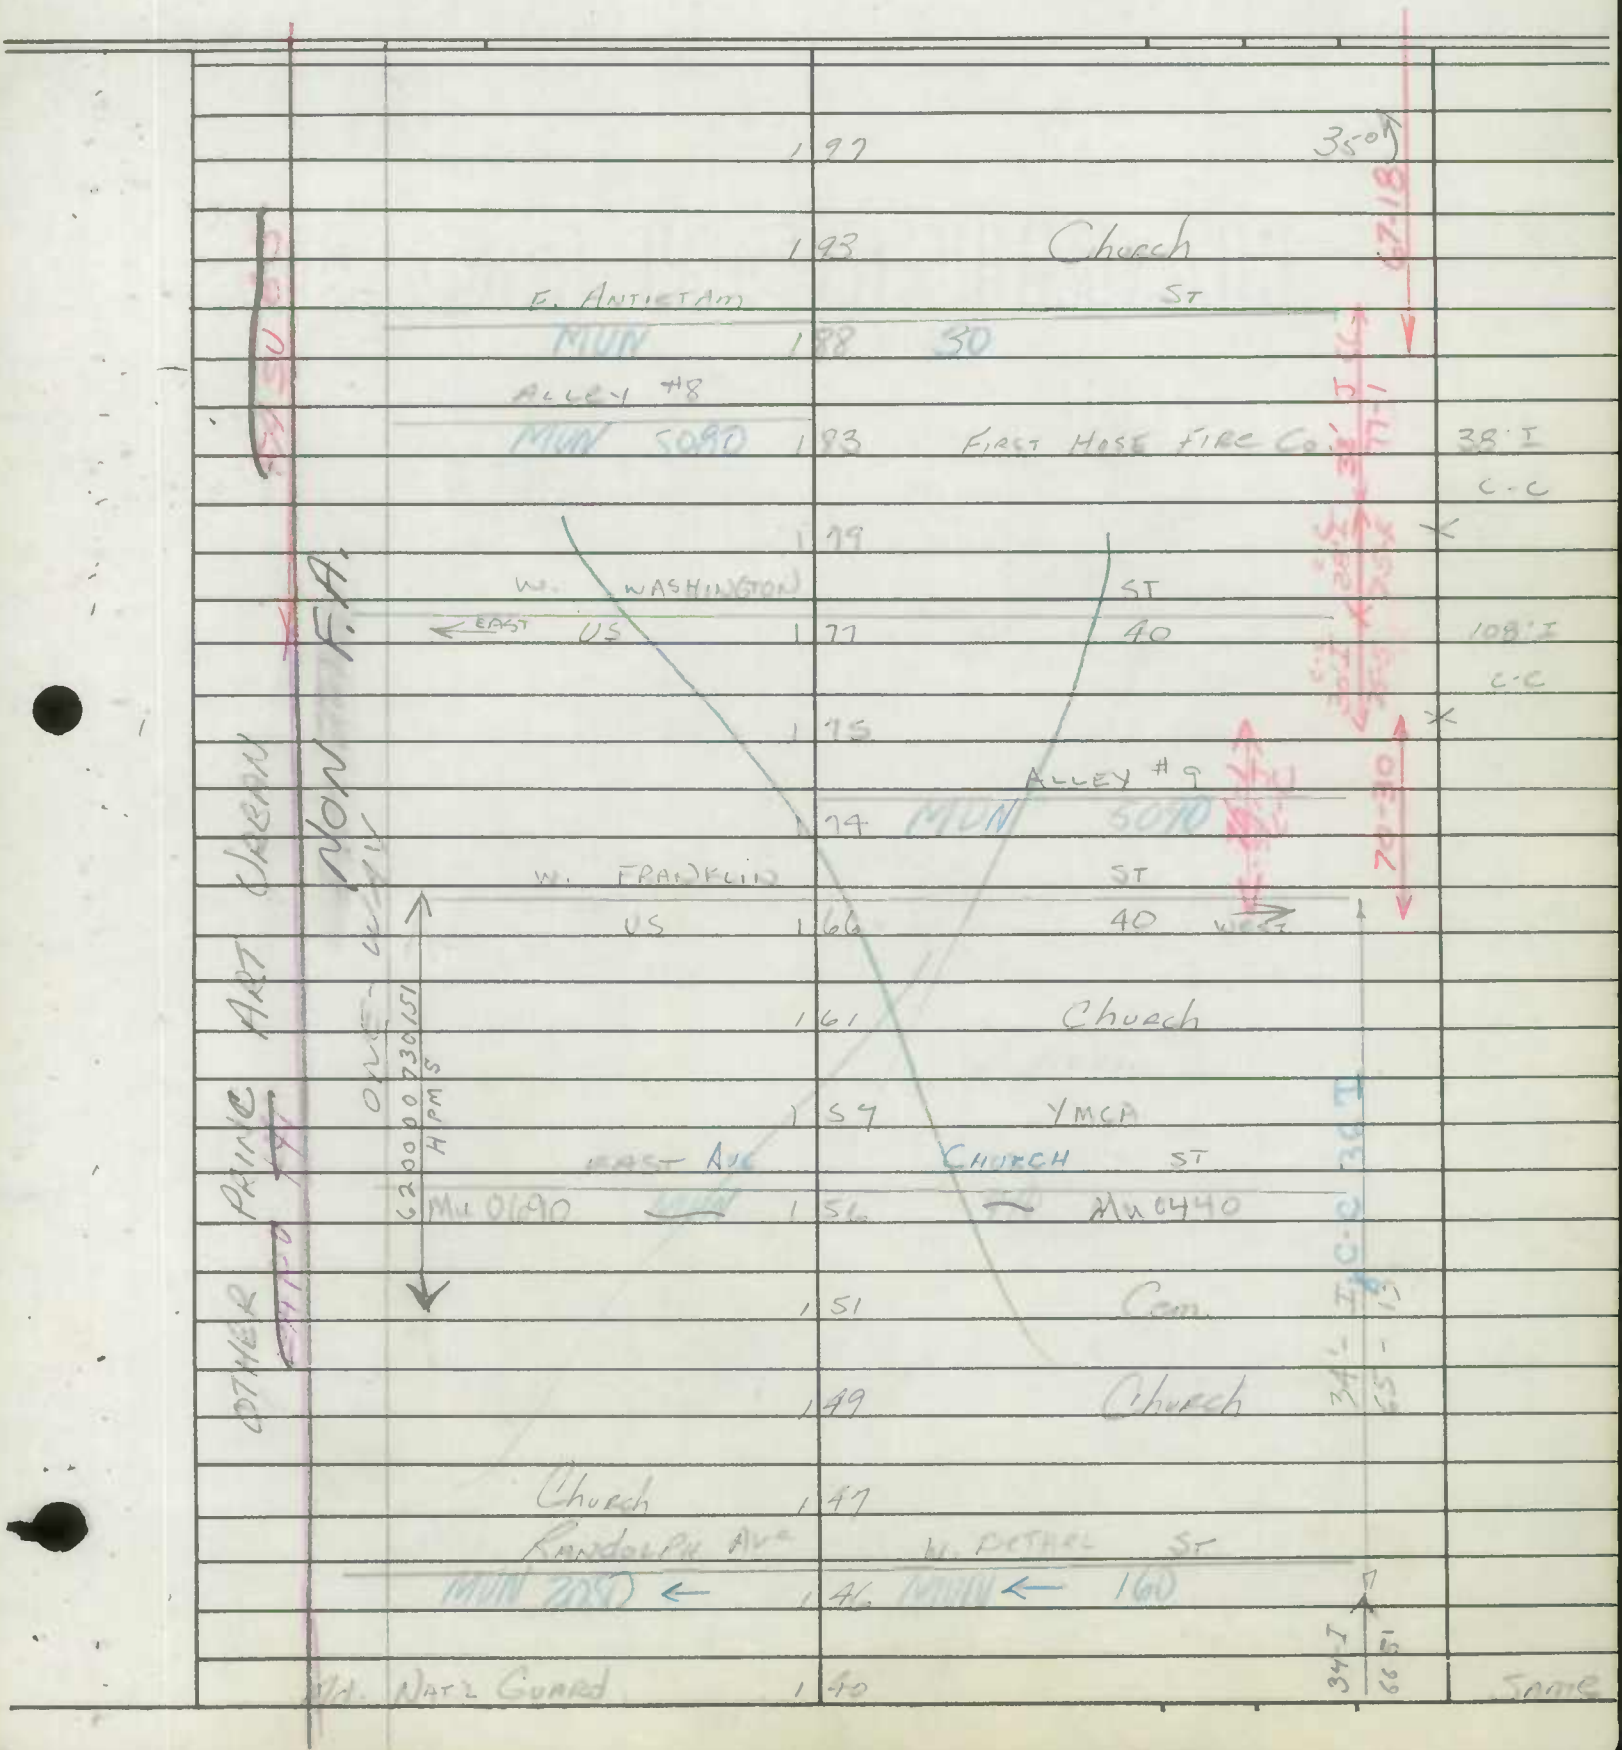

Form 6 HPS (Rev. 1961)

91-29
BB/SP
3-17-92

ROAD INVENTORY SHEET

Party Chief R. VOUGHT
Recorder L. COFFELT JR.
Chainman

87-5-6
PL/KS
3-28-87

HAGERSTOWN

Road No. MV2000
Name POTOMAC AVE
Sheet No. 4 OF 5
Date
County WASHINGTON

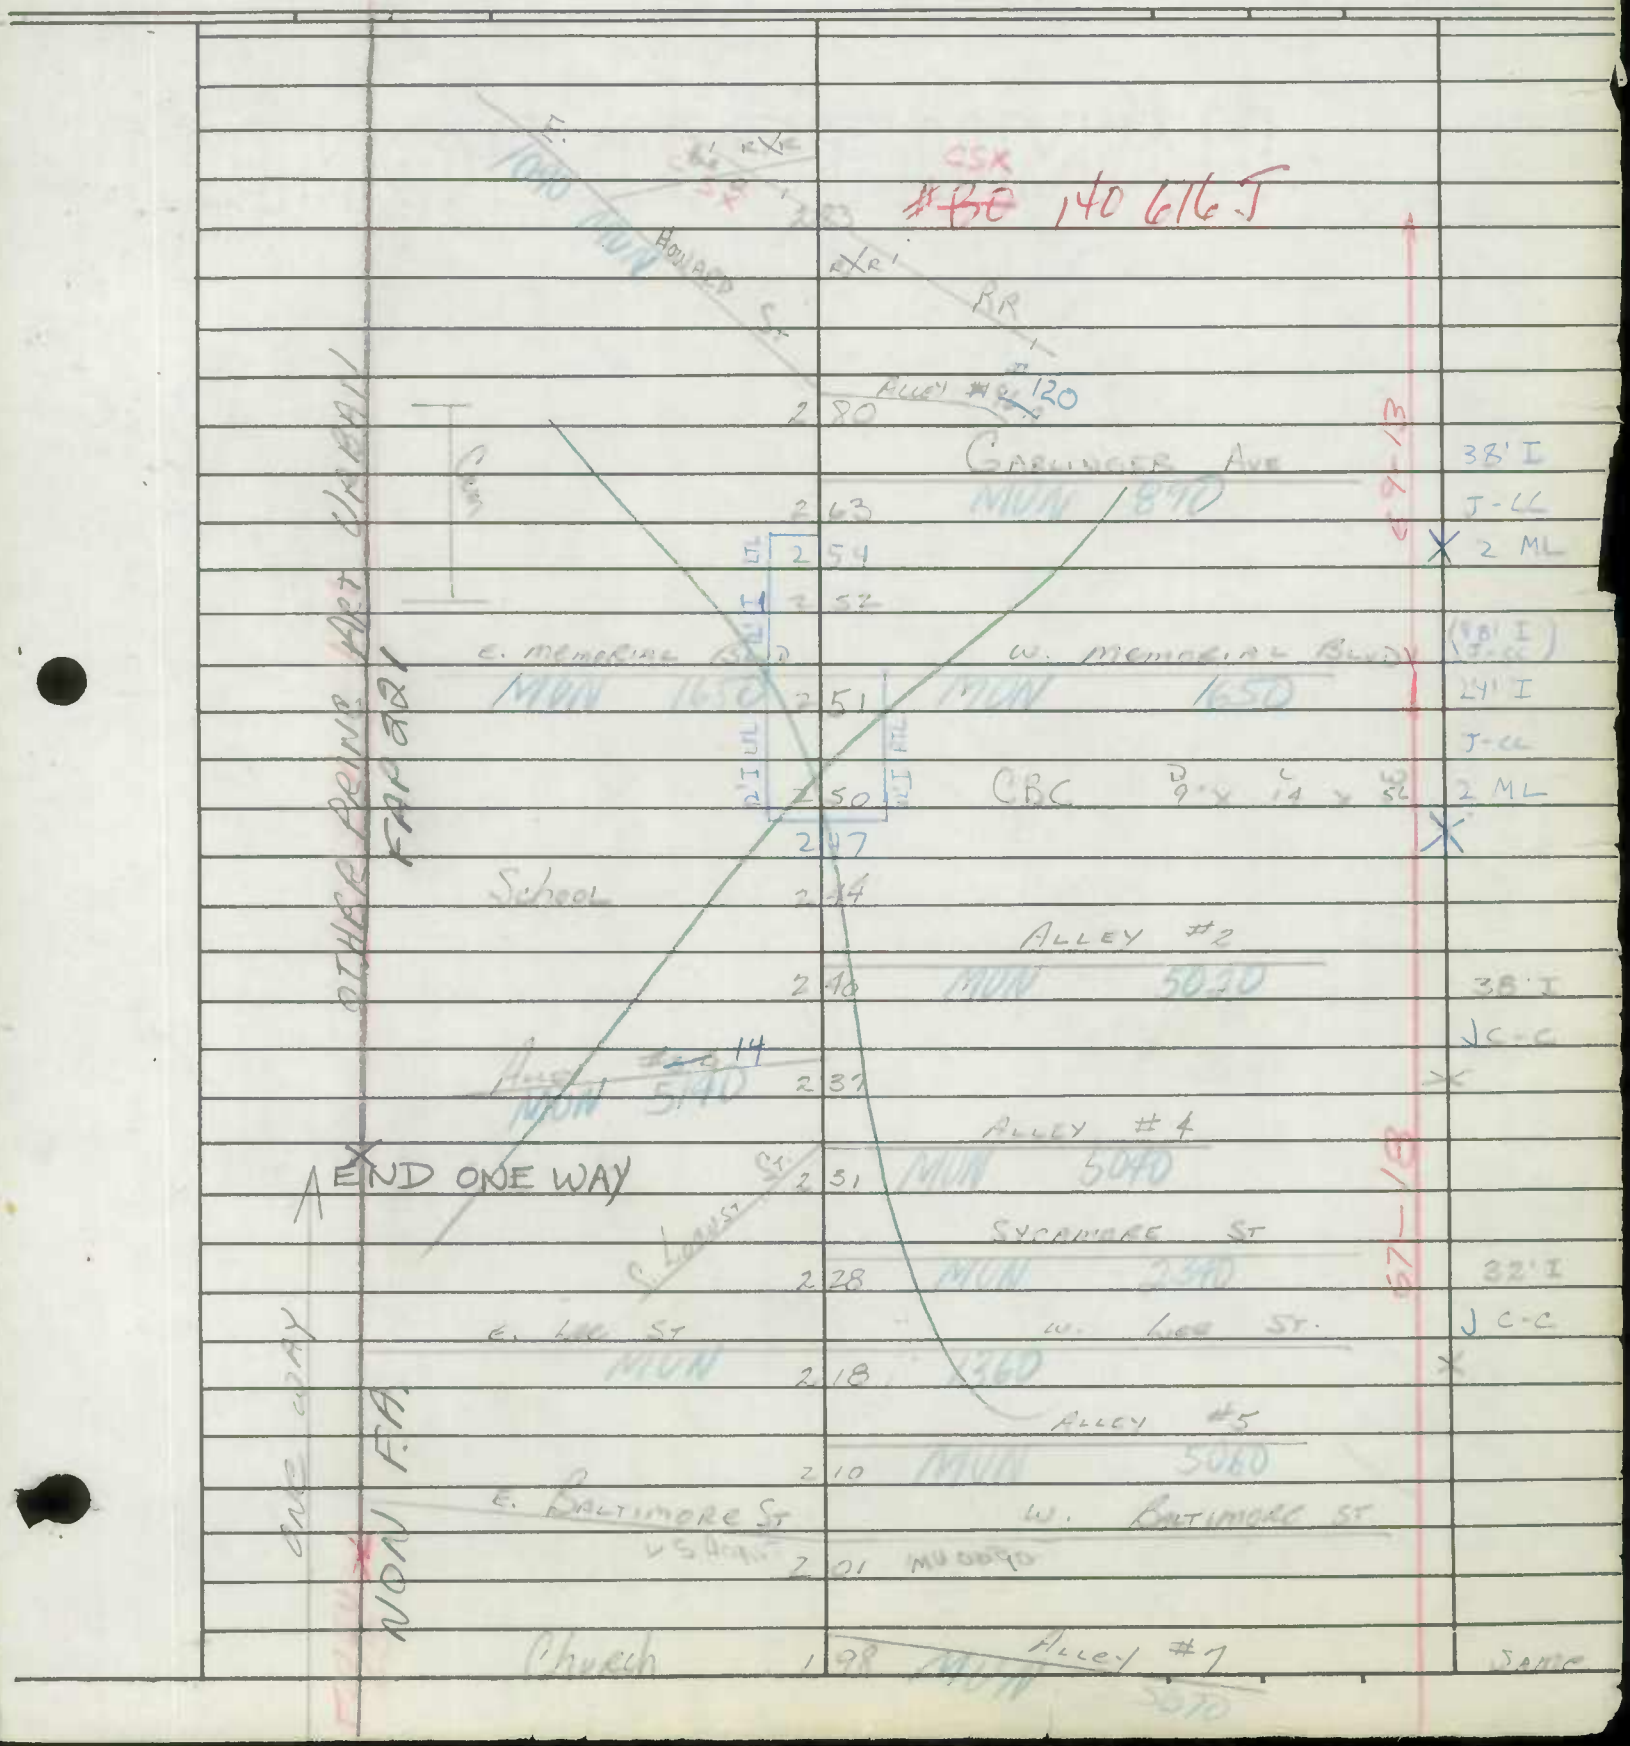

Form 6 HPS (Rev. 1961)

ROAD INVENTORY SHEET

Party Chief R. VOUGHT
Recorder L. COFFELT JR.
Chainman

(92-20) DCMAHA-7-93

HAGERSTOWN

Road No. MV 2000
Name POTOMAC AVE
Sheet No. 5 OF 5
Date
County WASHINGTON

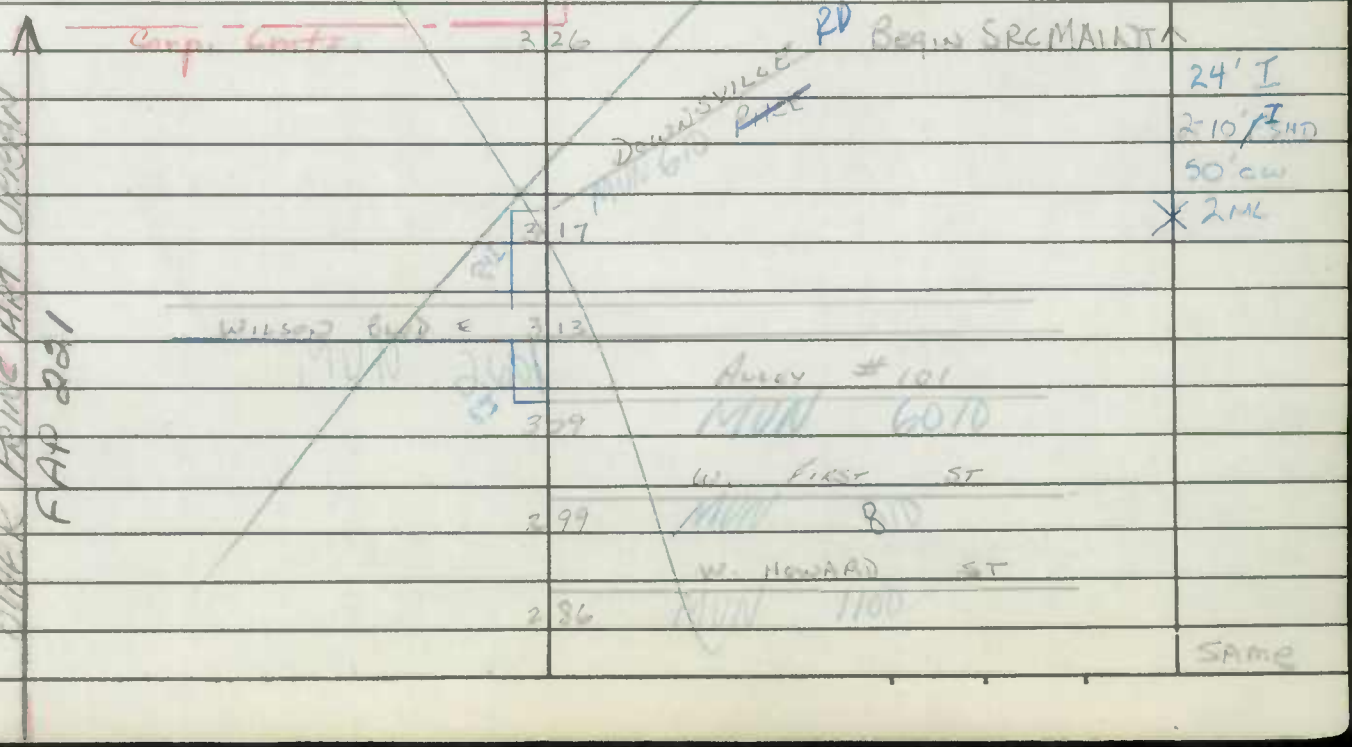

Form 6 HPS (Rev. 1961)

ROAD INVENTORY SHEET

Party Chief R. Vought
Recorder L. Coffelt, Jr.
Chainman

VER
7-14-76

Road No. 2010
Name Potomac Heights
Sheet No. 1 of 1
Date 10-30-63
County Wash.

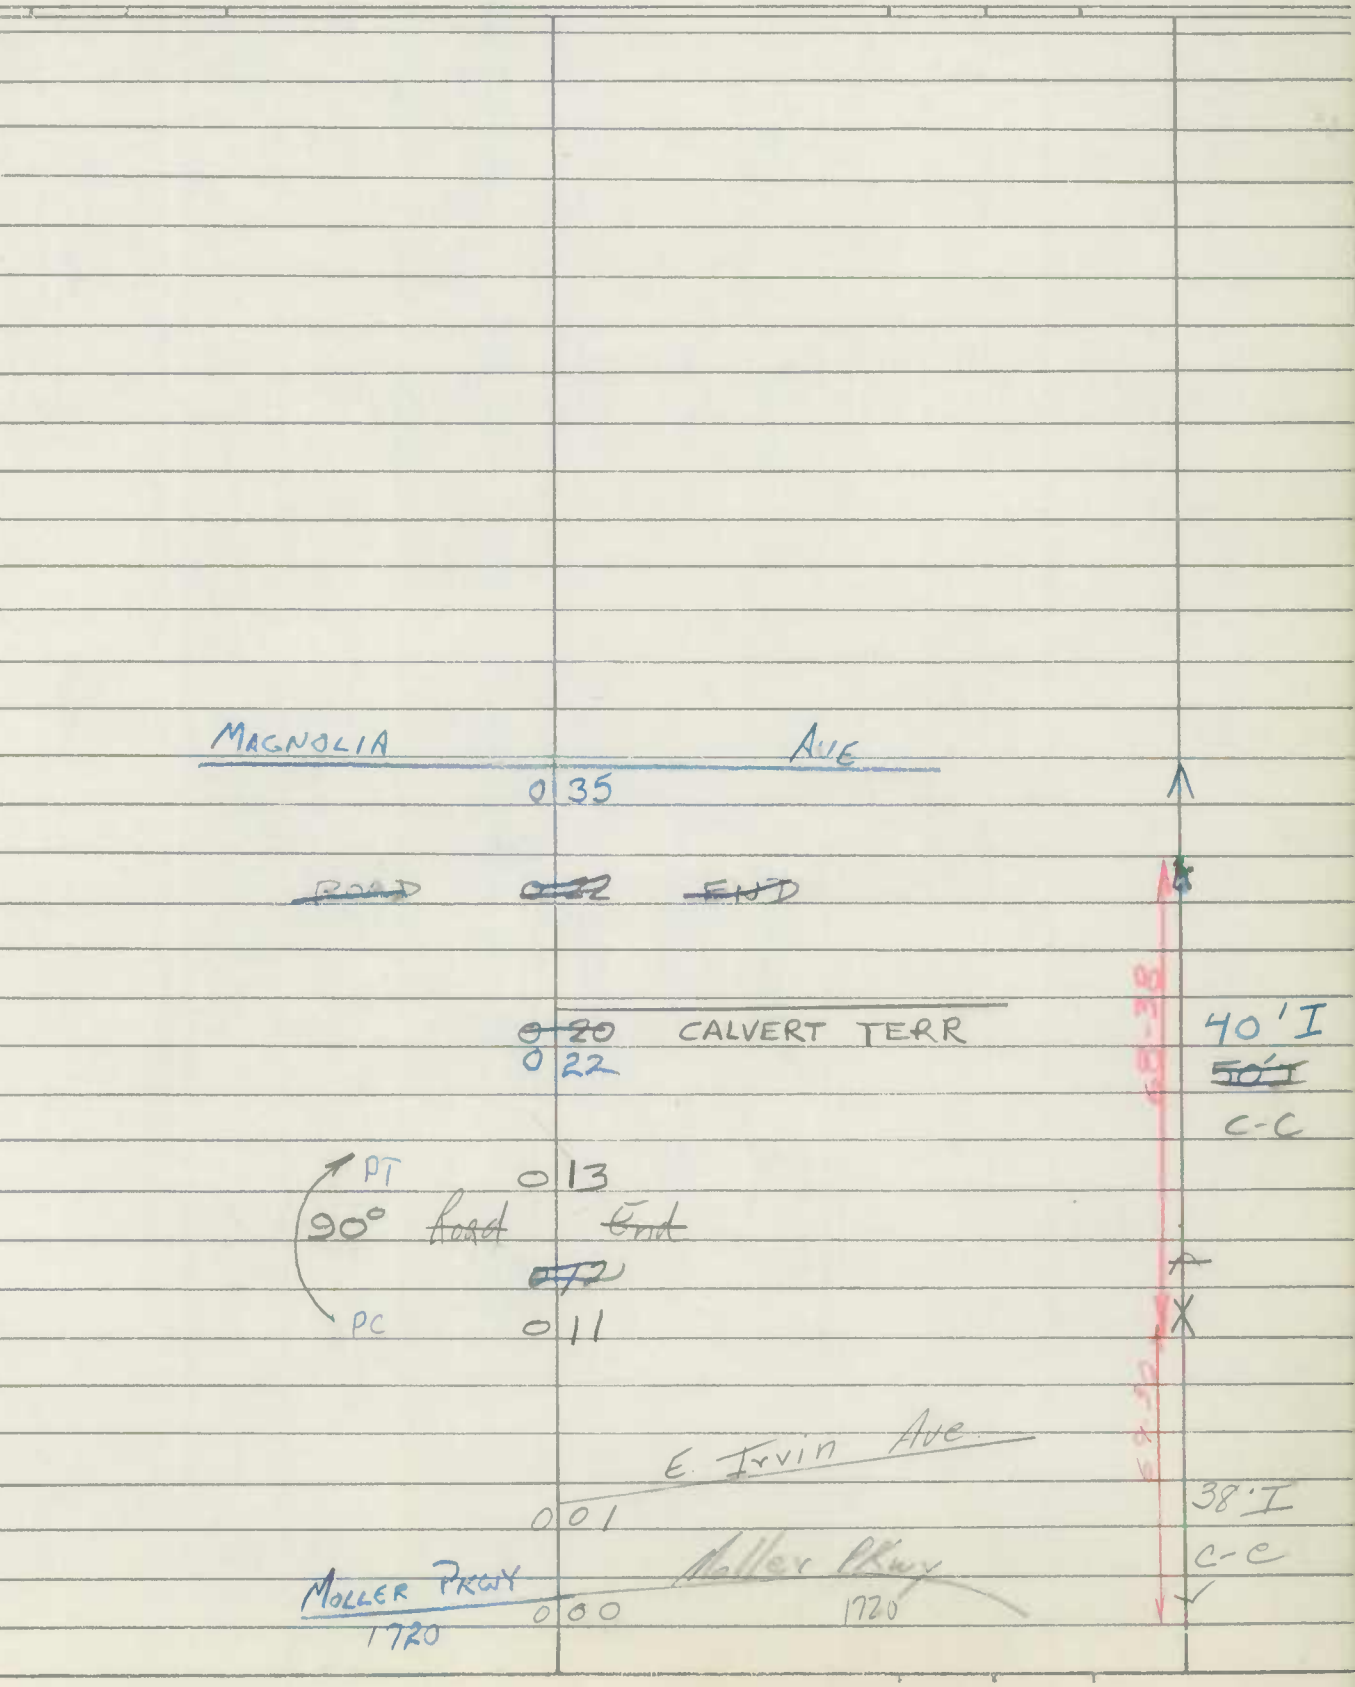

Form 6 HPS (Rev. 1961)

BB 84-9 At
RM 4-26 85

P9-71
CS

4

ROAD INVENTORY SHEET

Party Chief R. Vaught
Recorder L. Coffelt, Jr.
Chainman

VER
7-20-76

Road No. 2020
Name Prospect Ave.
Sheet No. 1 of 1
Date 10-30-63
County Wash.

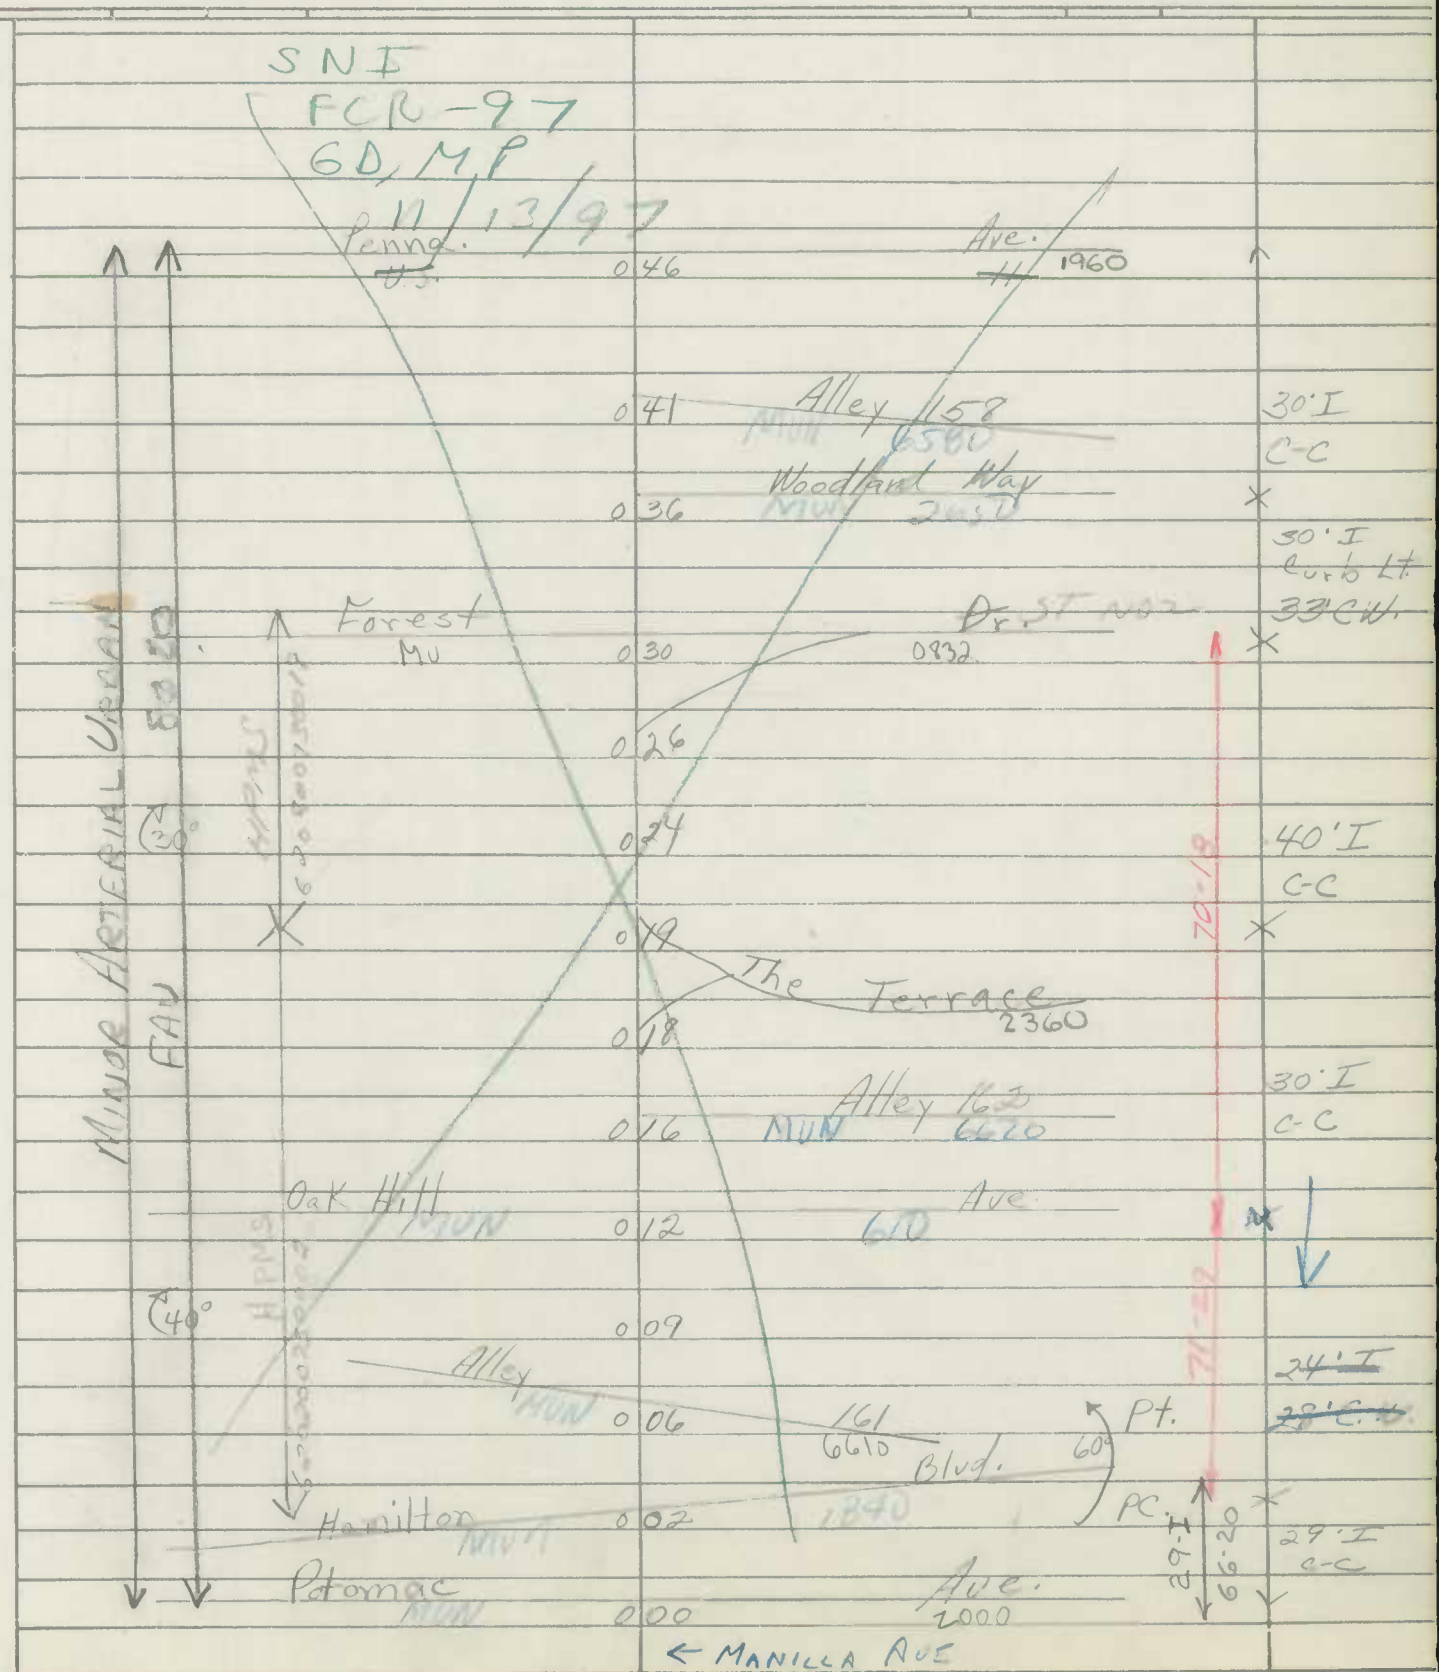

Form 6 HPS (Rev. 1961)

89-3
12/19/89
CG,GD

ROAD INVENTORY SHEET

Party Chief R. VOUGHT
Recorder L. COFFELT JR.
Chainman

HAGERSTOWN VER 7-15-76

Road No. 2030
Name N PROSPECT ST
Sheet No. 1 OF 2
Date 11-4-63
County WASHINGTON

91-9,-10 A/T

SNI 11/21/97
FCR-97
GD MP
LIBRARY ALLEY
MUN 9160
Church
W. WASHINGTON
US
(WAREHAM
MUN
W. FRANKLIN
US
(WELLS Ave
MUN 9160
Church
HAGERTOWN WILLIAMS
MUN 1585
W. BETHEL ST
MUN 160
BLOOMS ALLEY #
MUN 9160
NORTH ST 1170
PENNA AVE
MD US
ALLEY #175
MUN 6750
ST
40
PL)
2492
ST
40
ST
ST
1960
OTHER FWD ROAD
ONE WAY
33' I C-C
34' I C-C
25' I C-C
33' I C-C
38' I
JCC
2 UHL
16' I RT
14' I LT
4 J MED
2 I SAP CONTR
JCC IN

Form 6 HPS (Rev. 1961)

ROAD INVENTORY SHEET

Party Chief R. VOUGHT
Recorder L. COFFELT JR.
Chainman

91-1 A/T
BB/SP
3-19-92

HAGERSTOWN

Road No. 2030
Name N&S PROSPECT ST
Sheet No. 2 OF 2
Date 11-4-63
County WASHINGTON

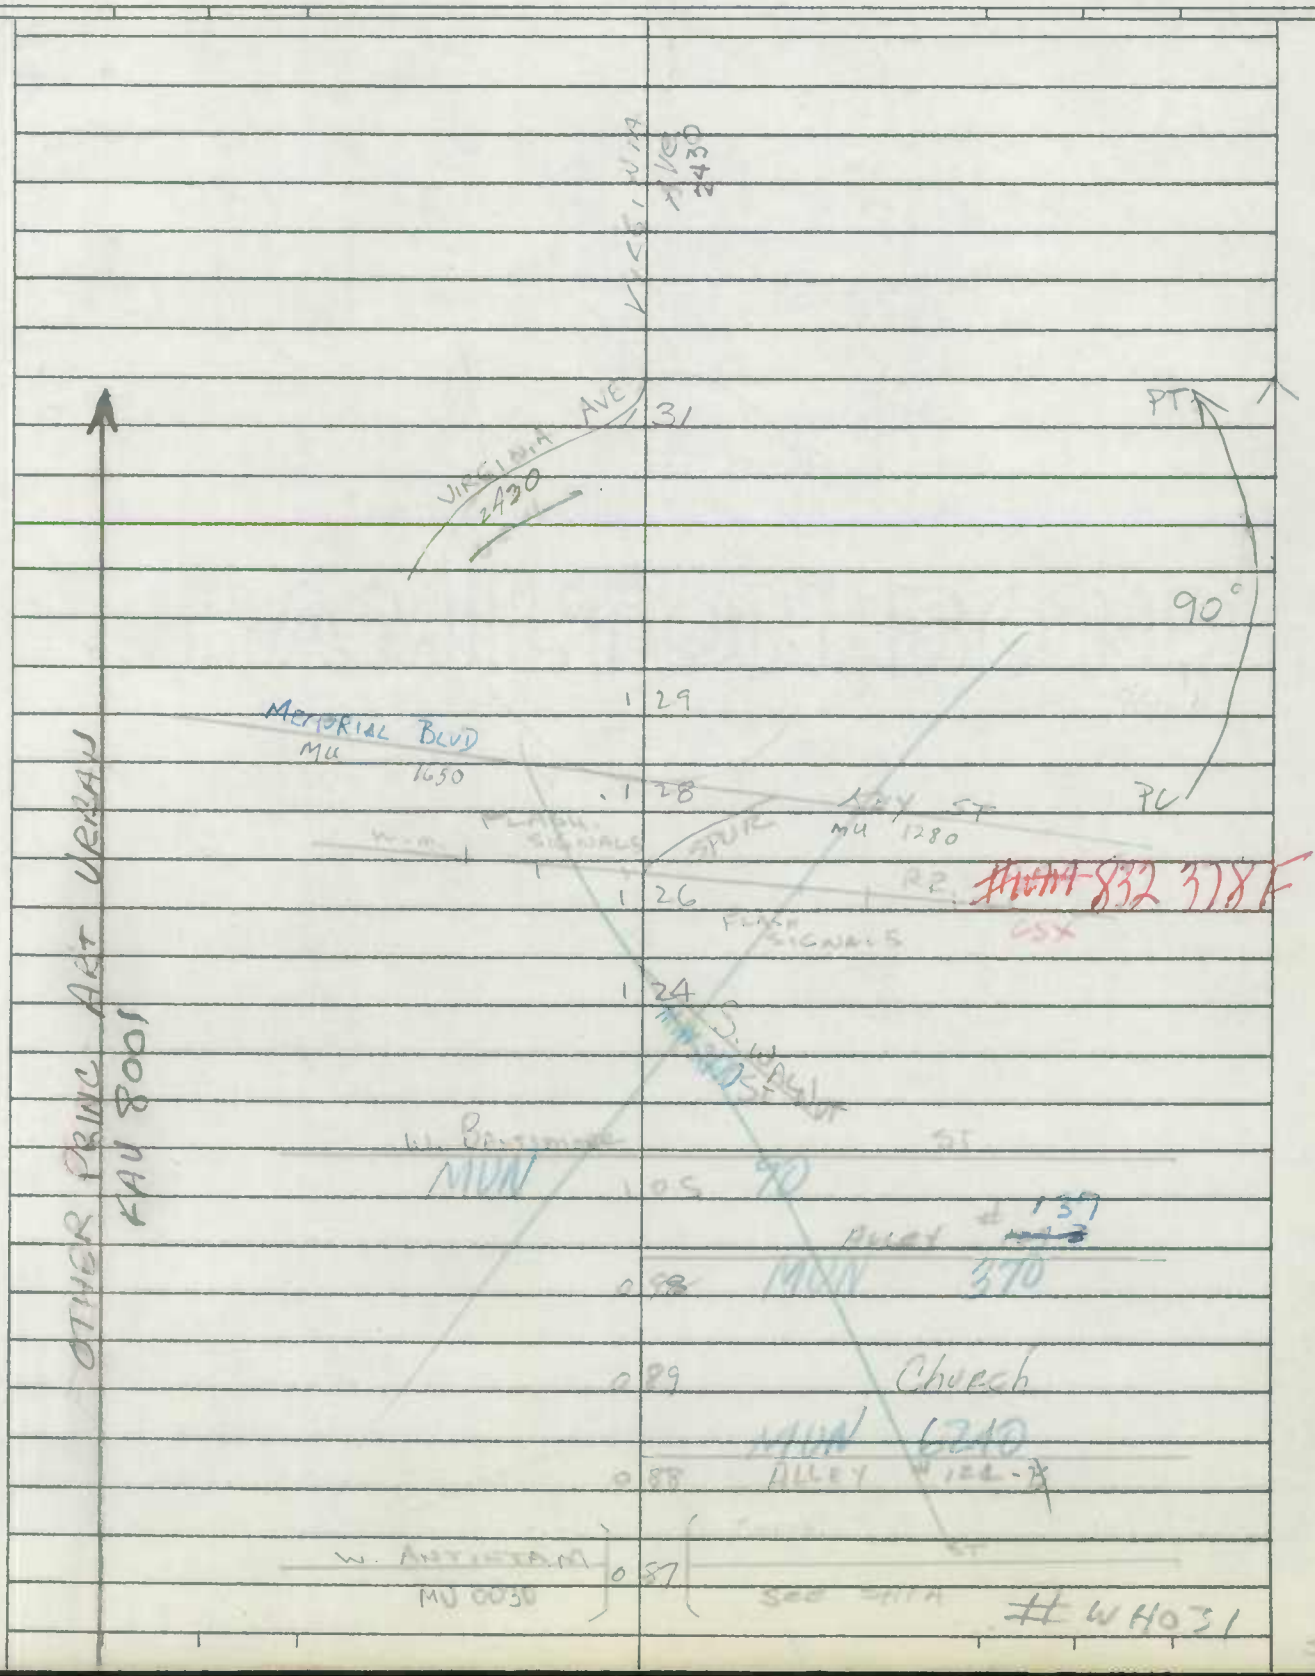

Form 6 HPS (Rev. 1961)

cs ✓ 9-77

ROAD INVENTORY SHEET

Party Chief R. VOUGHT
Recorder L. COFFELT JR.
Chainman

VER. 7-13-76

HAGERSTOWN

Road No. 2100
Name RHODE ISLAND AVE
Sheet No. 1 OF 1
Date 10-28-63
County ~~WASHINGTON~~

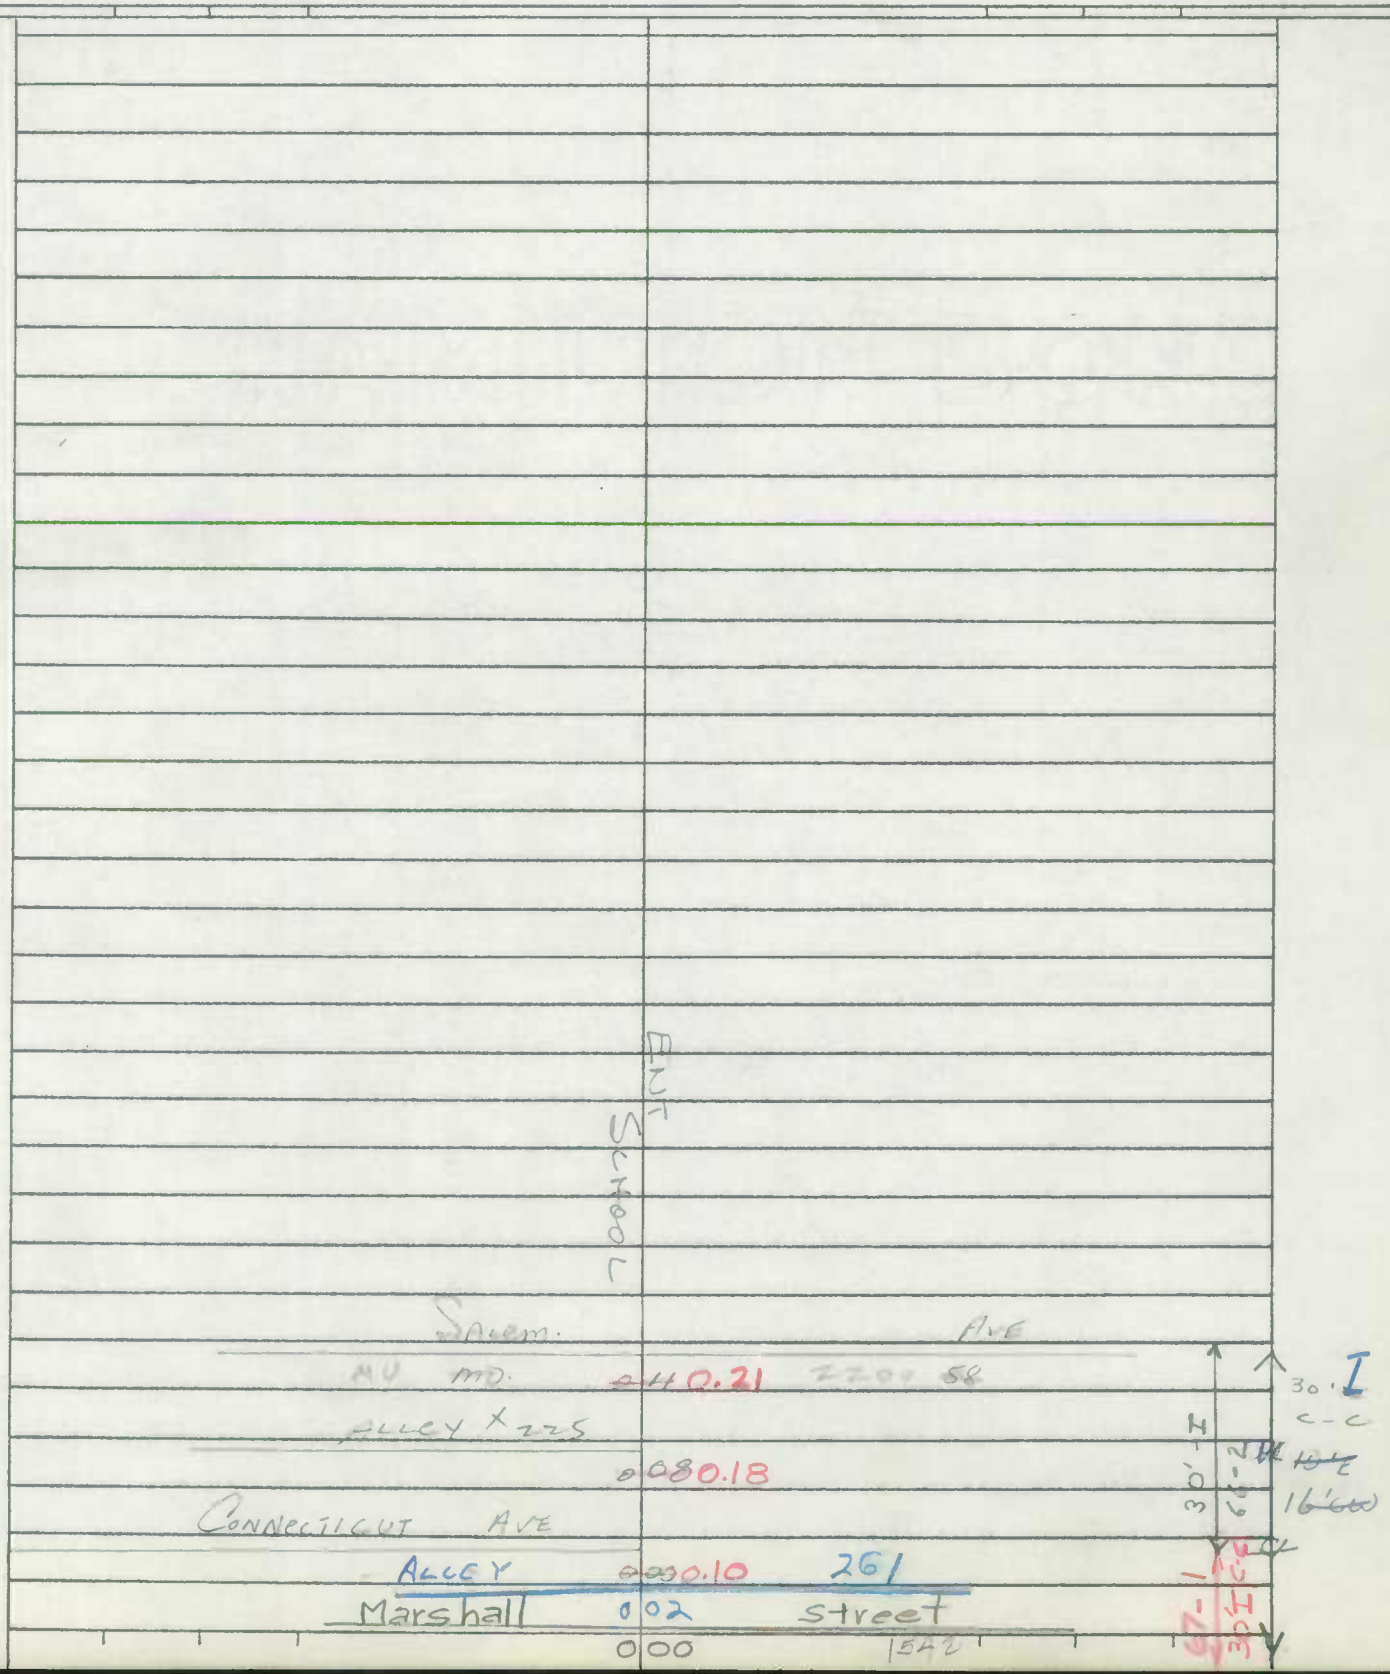

Form 6 HPS (Rev. 1961)

90-30
GD/TM
3/8/91

89-EX #2
PT/CG
2/1/90

P9-77

4

ROAD INVENTORY SHEET

Party Chief R. VOUGHT
Recorder L. DEFELT JR.
Chainman

VER
7-14-76

HAGERSTOWN

Road No. 2120
Name Ridge AVE
Sheet No. 1 OF 1
Date 10-29-63
County WASHINGTON

See New Inventory
written 5-23-02
GPS-02
GD/EF

WESEL BLVD
0.35
MU
2547 (90-30)

~~(ABAN)~~ MEISTER
~~ROAD~~ X X X

Form 6 HPS (Rev. 1961)

P9-77

4 AT

ROAD INVENTORY SHEET

Party Chief R. VOUGHT
Recorder L. JEFFELT JR.
Chainman

HAGERSTOWN

ER
)-15-76

Road No. 2140
Name ROCK WILLOW AVE LA
Sheet No. 1 OF 1
Date 10-28-63
County WASHINGTON

ABAN. 5/4/83 NS CM

NOW DELAWARE

SEE NEW

INV.

MUN 0625

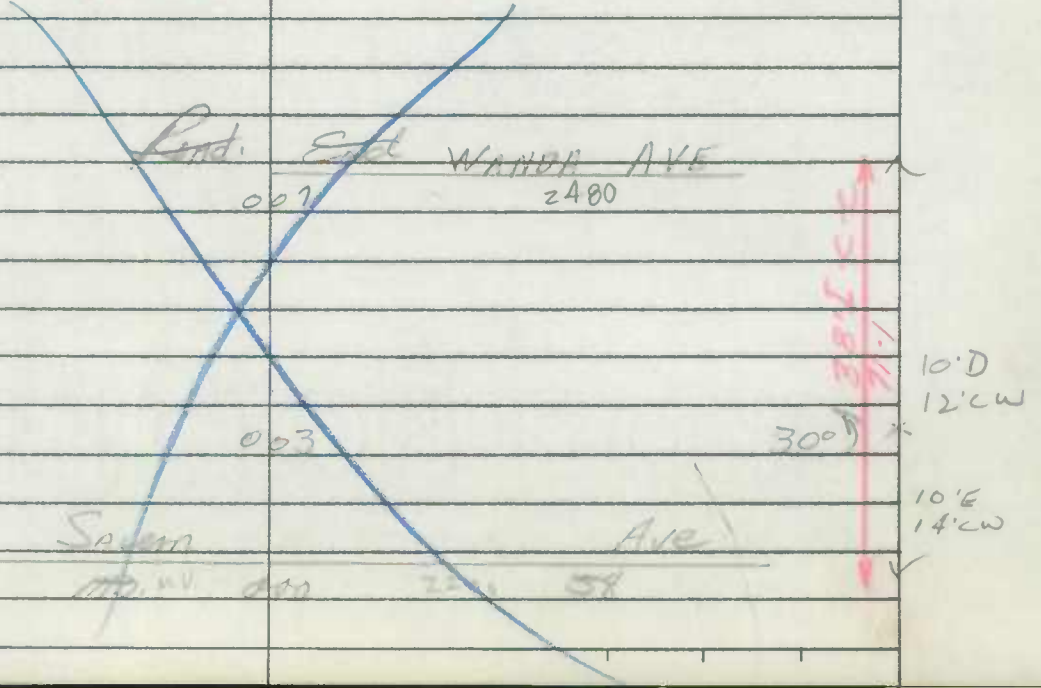

Form 6 HPS (Rev. 1961)

ROAD INVENTORY SHEET

Mun. No. 2200

Party Chief R. Vaught
Recorder L. Coffelt, Jr.
Chainman

Road No. Md. 58
Name Salem Ave.
Sheet No. 5 of 7
Date 10-23-63
County Wash.

68 REV FR 11-9-82

VER. 9-20-76

81-2

| | | |

Form 6 HPS (Rev. 1961)

ROAD INVENTORY SHEET

Mun 2200

Party Chief
Recorder
Chairman

Road No. ~~411~~
Name Salem Ave.
Sheet No. 6 of 7
Date 10-23-63
County Wash.

Form 6 HPS (Rev. 1961)

ROAD INVENTORY SHEET

Mun 2200

Party Chief
Recorder
Chainman

87-13
AL/KJ
3-29-88

Road No. ~~Alt 29~~
Name Salem Ave.
Sheet No. 7 of 7
Date 10-23-63
County Wash.

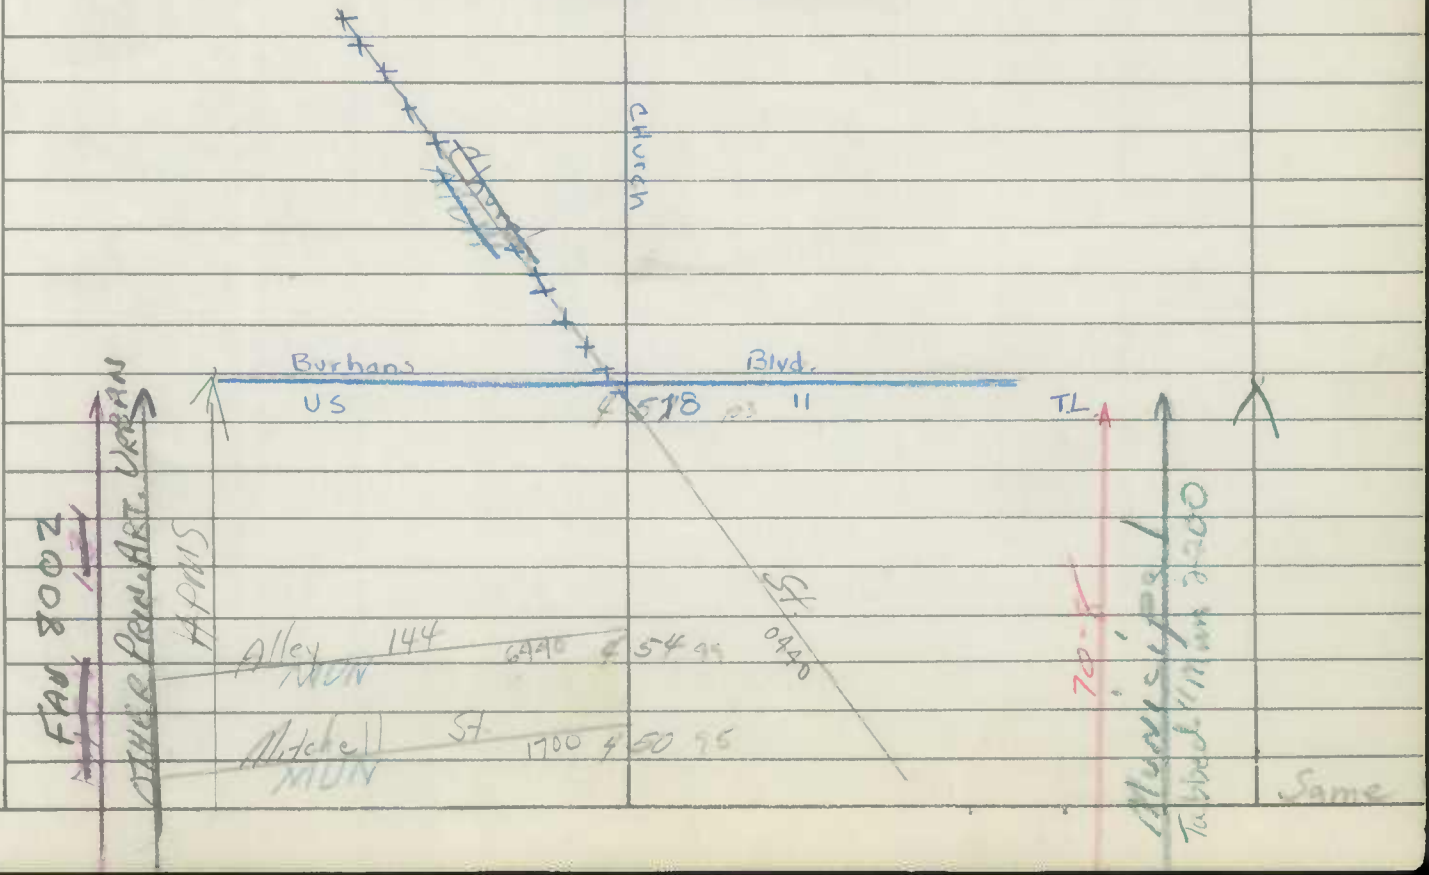

Form 6 HPS (Rev. 1961)

ROAD INVENTORY SHEET

Party Chief R. Vaught
Recorder L. Coffelt
Chainman

VER. 7-14-76

Road No. 2210
Name Security Rd.
Sheet No. 1 of 1
Date 9-17-63
County Wash.

SNJ
FCR-97
GR MP
10/31/97

NOW CONTAINS MUN 2212

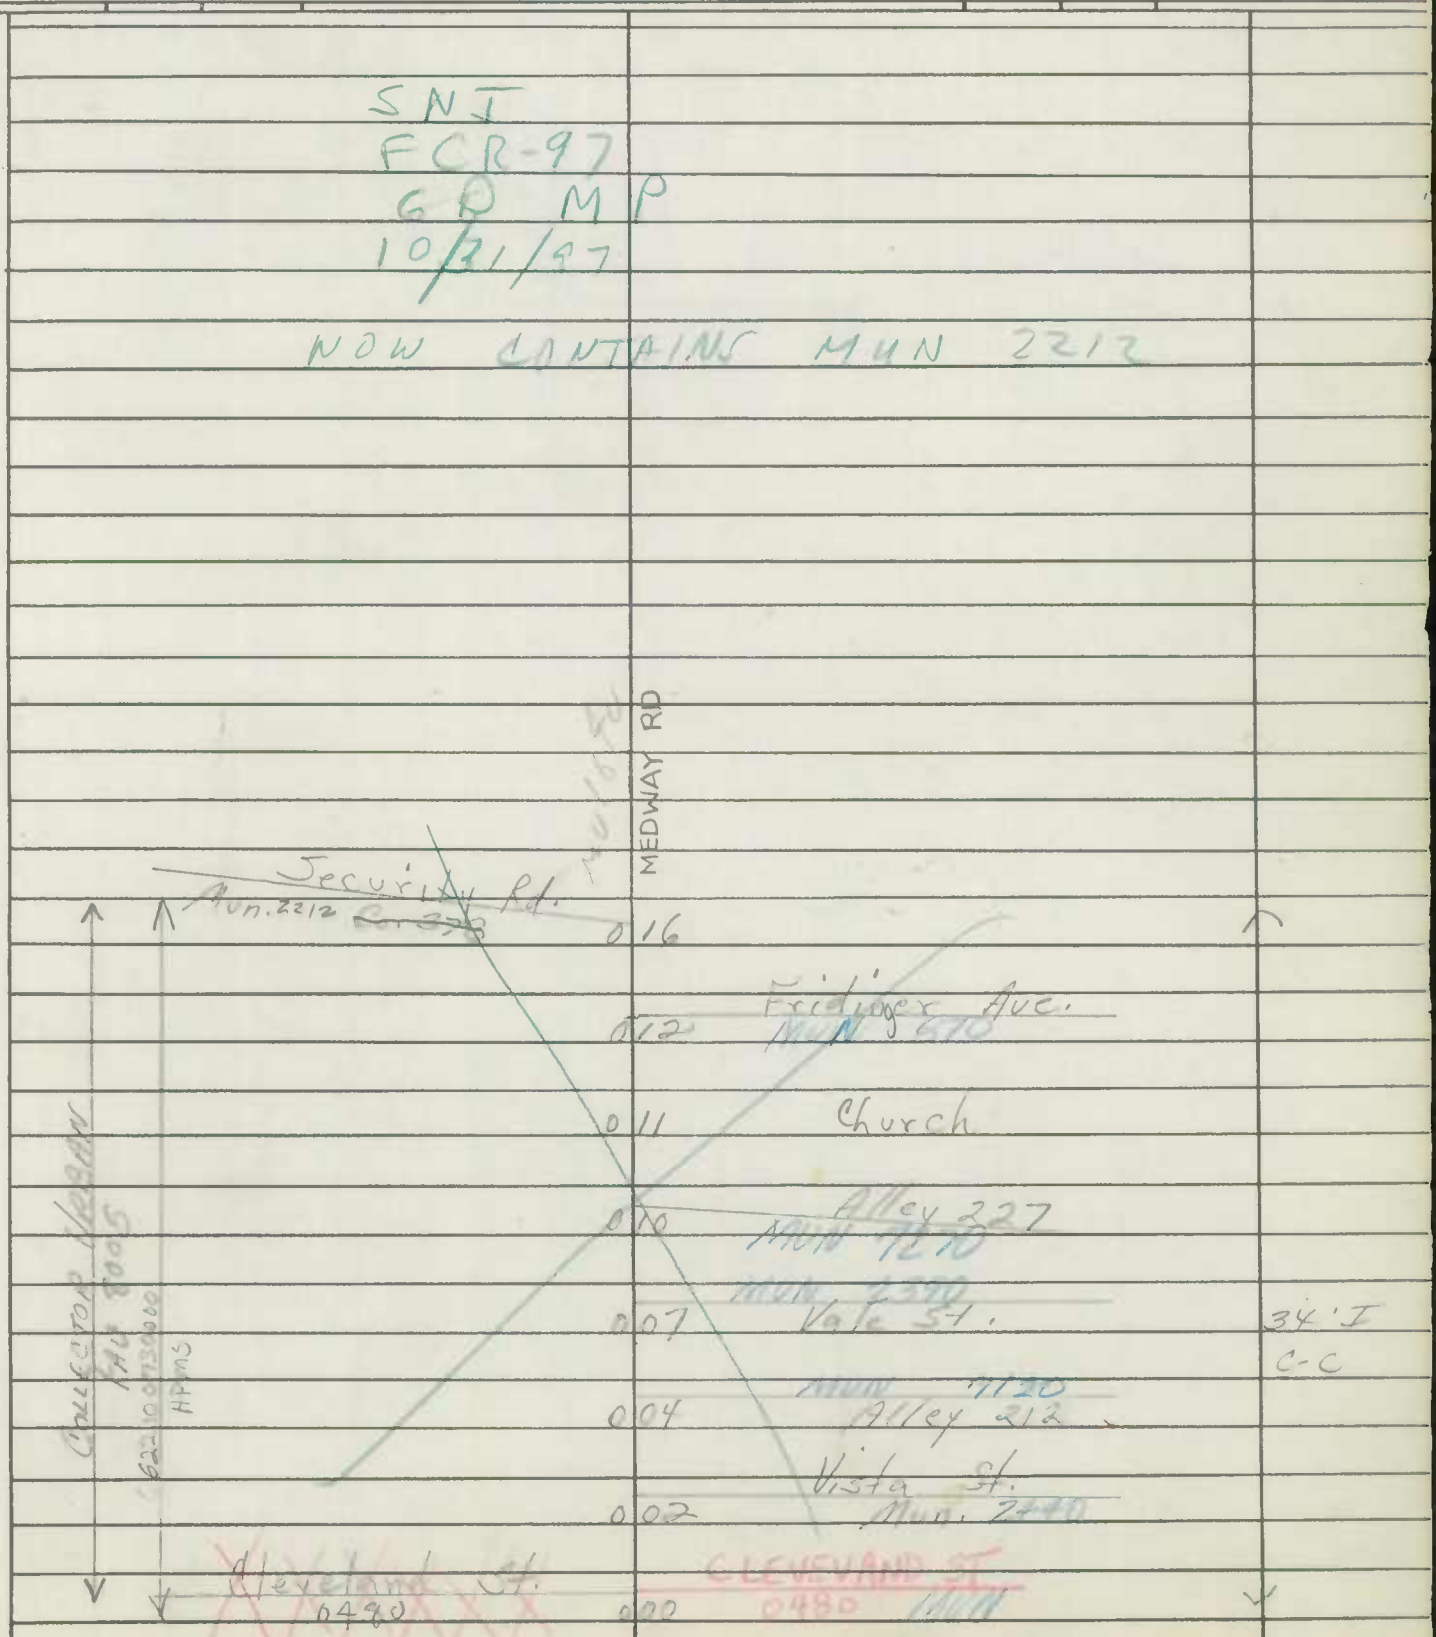

Form 6 HPS (Rev. 1961)

90-31
3-8-91
GD/TM

PI-77
CS

M.N. No. 2220

ROAD INVENTORY SHEET

Party Chief B.V. A/T
Recorder L.C. 83-5
Chainman 4/9/84 VER
COPY 12/10/63 DT-NS 7.15.70
AS PER E.T.C.

Road No. CO 416
Name Sherman Ave.
Sheet No. 2 OF 2
Date 9-19-63
County WASHINGTON

A/T 84-3

SNI FCR-97
GD MP 11/4/97

BURHANS BLVD
US
0 01 T.L.
(SWEENEY DR)
MU 2335 10-31
0 95
0 94
0 78
NOLAND
0 75
DR 1780 SS
0 73
P.T. 40° P.C.
0 70
MARION CO
0 67 S.S.
ST 412 1520
ARMSTRONG CO
0 52
ROAD 414 0250
HAGERSTOWN
0 48
B GROCERY
APP CORP LIMITS
0 46
ELMWOOD RD. CO 415
0 41
0 40
0 37
0 33
COLLECTOR
URBAN
AV 6,220 @ 7300 ± 80
4 H
5 H

34'I JC-C 24'CW
~~16'E 24'CW~~
30-T CC 5 66-
~~30'S 34'CW~~
34'I C-C
18'~~A~~ I 26'CW
18'H CURB RT. 24'C.W.
SAME

Form 6 HPS (Rev. 1961)

ROAD INVENTORY SHEET

Party Chief R. VOUGHT
Recorder L. COFFELT JR.
Chairman

HAGERSTOWN

Road No. 2300
Name Summit Ave
Sheet No. 2 OF 3
Date 11-4-63
County WASHINGTON

79-8

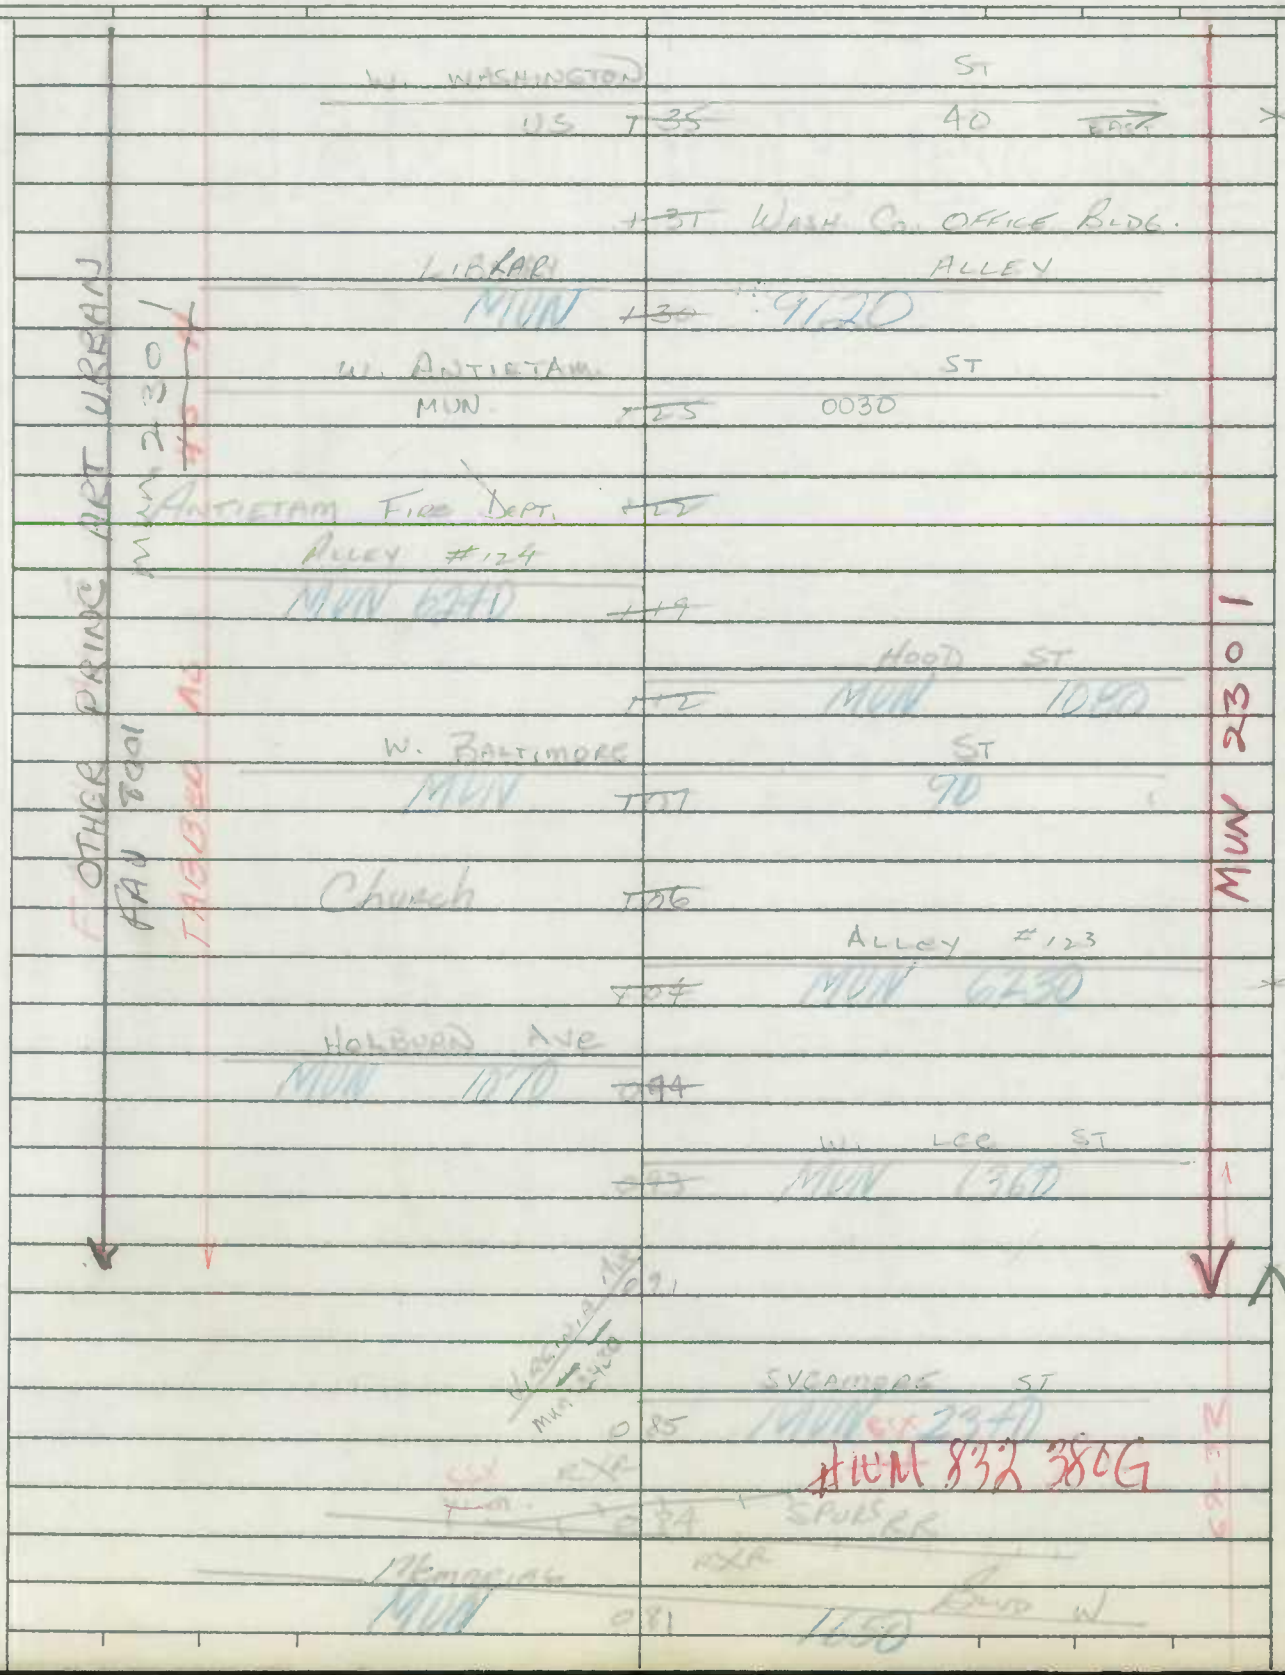

Form 6 HPS (Rev. 1961)

ROAD INVENTORY SHEET

Party Chief R. Vought
Recorder L. Coffelt, Jr.
Chainman

Road No. 2300
Name Summit Ave.
Sheet No. 3 of 3
Date 11-4-63
County Wash.

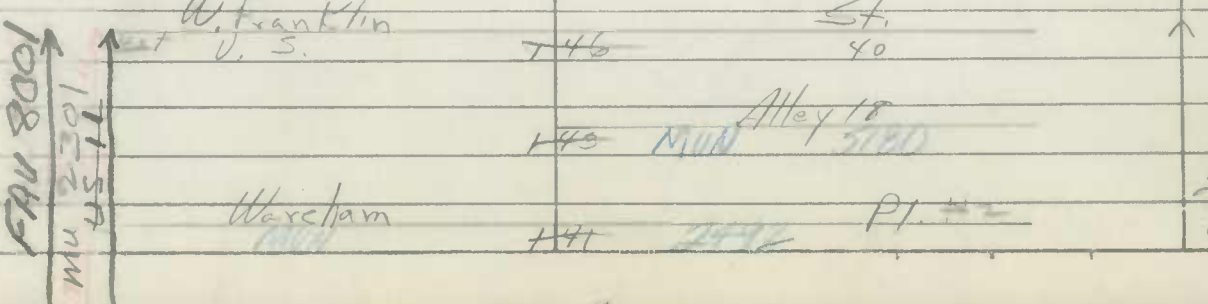

SHA 51.3 - 8 Revised
4.83

MARYLAND STATE HIGHWAY ADMINISTRATION

90-8
3-8-91
GD/TM

ROAD INVENTORY SHEET

(OLD US 11)

Hagerstown

Party Chief CB
Recorder AL
Assistant
Map No./Dir. A-8 / N
State Coordinates 555 - 658

Road No. MUN 2301
Road Name SUMMIT AVE.
County WASHINGTON
Date 4-22-87
Sheet No. 1 OF 2

TRAFFIC CODES
TRAFFIC CONTROLS: STOP SIGN=SS, TRAFFIC LIGHT=T.L., FLASHING RED BALL=F.R.

TRAFFIC CODES
PARKING RESTRICTIONS: A.M. PEAK, P.M. PEAK, A.M./P.M. PEAK, NO PARKING ANYTIME=N.P., COMM/IND. ACCESS=E

SYSTEM				TRAFFIC		LINE DIAGRAM	TRAFFIC			PAVEMENT DATA
FED. AID.	FUNCT CLASS.	HWY. SYS.	HPMS SAMPLE	PRKG. REST.	COM/IND. ACCESS		CONTROL	COM/IND. ACCESS	PRKG. REST.	
						SNI				
				NP		W. ANTIETAM ST. 0030			PKG	
						0 24	TL	X	X	
						ANTIETAM F.D. 0 31				
						0 30		E		
						ALLEY 124 6240 0 29				
						0 26		E		
						(HOOD ST) 1080				
						0 22			NO PKG	
						W. BALTIMORE ST. 0090				25' I.
						0 17	TL			J' C.C
						ALLEY # 123 6230				2 ML
						0 13				
						(HOLBURN AVE) 1070				3 I
						0 1				J C.C
						SWIFFT 1360				1 ML
						0 03			V	
						0 1		E		34' I
						0 60				J C.C
						25'				2 ML
						SUMMIT AVE 2300				
						SNI				

FALL ZONE
URBAN OTHER PRINCIPAL ARTERIAL
HPMS 100/1000/660
PKG
V
V V

LINE DIAGRAM

SYSTEM: FED. AID. | FUNCT. CLASS. | HWY. SYS. | HPMS SAMPLE

TRAFFIC: PRKG. REST. | COM/IND ACCESS

TRAFFIC: CONTROL | COM/IND ACCESS | PRKG. REST.

PAVEMENT DATA

SNI
FCR-97

JONATHAN M. ST.

W. FRANKLIN
US
0 56 40 WEST
ST.

ALLEY #10
5180
0 52

WARREN
PL. H 2
2497
0 50

WASHINGTON
US
0 45 40 EAST →
ST.

0 41 WASH CO OFFICE BLDG.

(LIBRARY ALLEY)
9120

0 40

FAU 8001
URBAN OTHER PRINCIPAL ARTERIAL
HPMS
NO PKG
PKG

Form 6 HPS (Rev. 1961)

AT P9-77

4

ROAD INVENTORY SHEET

Party Chief R. VOUGHT
Recorder L. COFFELT JR.
Chainman

VER. 7-14-76
Hagerstown

Road No. 2390
Name VALE ST
Sheet No. 1 OF 1
Date 11-5-63
County WASHINGTON

SECURITY		RD	
MUN TWP	012	2210	
		ALLEY # 227	
	003	MUN 7700	
ALLEY # 209			
MUN 7090	003		
			25'I
JEFFERSON		ST	C-C
MD	090	64	

SHA 51.3 - 8 Revised
4.83

MARYLAND STATE HIGHWAY ADMINISTRATION

Hagerstown

ROAD INVENTORY SHEET

5 NI
FCR-97
GD MP
11/10/97

Party Chief: CB
Recorder: AL
Assistant: Rewritten 10-22-87 KVP
Map No./Dir.: A-8 / N
State Coordinates: 592-654

Road No.: MUN. 2430
Road Name: Virginia Ave
County: Washington
Date: 4-22-87
Sheet No.: 1 OF 3

TRAFFIC CODES
TRAFFIC CONTROLS: STOP SIGN=SS, TRAFFIC LIGHT=T.L., FLASHING RED BALL=F.R.

TRAFFIC CODES
PARKING RESTRICTIONS: A.M. PEAK, P.M. PEAK, A.M./P.M. PEAK, NO PARKING ANYTIME=N.P., COMM/IND. ACCESS=E

SYSTEM				TRAFFIC		LINE DIAGRAM	TRAFFIC			PAVEMENT DATA
FED. AID.	FUNCT CLASS.	HWY. SYS.	HPMS SAMPLE	PRKG. REST.	COM/IND. ACCESS		CONTROL	COM/IND. ACCESS	PRKG. REST.	
FAU 8001	URBAN OTHER Principal Arterial	MUN. (Non-T-Transfer Agreement T-8/14-87) US 11-B	1 001 1 000 0 250			0 25		E		
						0 23				40' I J c-c 2 ML
						W. Howard ST.				
						0 20 MUN. 1100	TL		X	
						0 19				2-24' I J cbs. on T 10' Paint. med
						0 14		E		3 ML
						0 13			X	
						0 11				
						0 08				2-24' I "J" c-c 4' J med. 4 ML
						Wilson BLVD.				
						US 11 0 00 MUN. 2600	TL			
						Virginia Ave. US 11				

93-4
3-1094 AL/TM

79 2

LINE DIAGRAM

SYSTEM				TRAFFIC			TRAFFIC				PAVEMENT DATA
FED. AID.	FUNCT. CLASS.	HWY. SYS.	HPMS SAMPLE	PRKG. REST.	COM/IND ACCESS		CONTROL	COM/IND ACCESS	PRKG. REST.		
			(2) X	E				E		X	31'I "J" C-C 2ML
						0.59					
						Reynolds Ave. 0.54 Mun. 2090					
						Alley 106 Pedestrian ENT. To Hagerstown Mun. Park 0.50 Mun. 6060					
						0.45 School		E			
						Dunn Irvin Dr. 0.40 Mun. 0680					
						Park Drive Mun. 1920 0.39					
						Alley 114 Mun. 6140 0.37					
						0.35		E			
						Sunset Ave Mun. 2320 0.34					
						Alley 108 Brown Ave Mun. 6080 0.31 Mun. 0270					

FAU 8001
URBAN OTHER Principal Arterial
120/0002590 D

SHA 51.3 - 8 Revised
4.83

MARYLAND STATE HIGHWAY ADMINISTRATION

ROAD INVENTORY SHEET

Party Chief: CB
Recorder: AL
Assistant: Rewritten 4-22-87
Map No./Dir.: A-8 / N
State Coordinates:

Road No.: Mun. 2430
Road Name: Virginia Ave
County: Washington
Date: 4-22-87
Sheet No.: 3 OF 3

TRAFFIC CODES
TRAFFIC CONTROLS: STOP SIGN=SS, TRAFFIC LIGHT=T.L., FLASHING RED BALL=F.R.

TRAFFIC CODES
PARKING RESTRICTIONS: A.M. PEAK, P.M. PEAK, A.M./P.M. PEAK, NO PARKING ANYTIME=N.P., COMM/IND. ACCESS=E

SYSTEM				TRAFFIC		LINE DIAGRAM	TRAFFIC			PAVEMENT DATA
FED. AID.	FUNCT CLASS.	HWY. SYS.	HPMS SAMPLE	PRKG. REST.	COM/IND. ACCESS		CONTROL	COM/IND. ACCESS	PRKG. REST.	

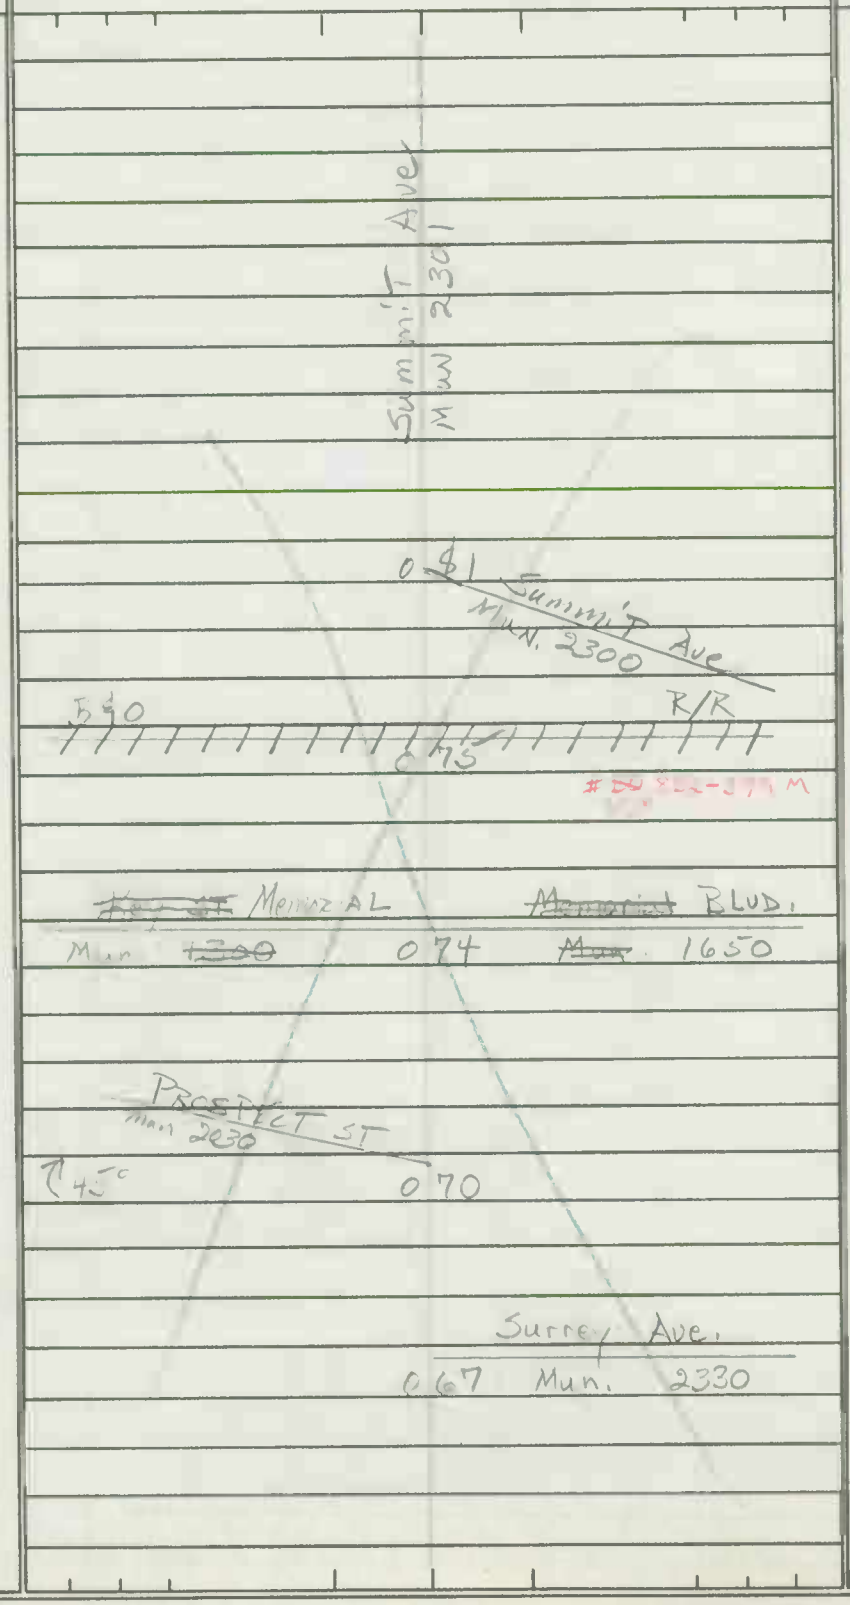

34' I
J-c-c
2 ML
50' I
J-c-c
Same

SYSTEM				TRAFFIC		LINE DIAGRAM	TRAFFIC				PAVEMENT DATA
FED. AID.	FUNCT. CLASS.	HWY. SYS.	HPMS SAMPLE	PRK.G. REST.	COM/IND ACCESS		CONTROL	COM/IND ACCESS	PRK.G. REST.		

SHA 51.3 - 8 Revised
4.83

MARYLAND STATE HIGHWAY ADMINISTRATION

ROAD INVENTORY SHEET (OLD US 11)

Hagerstown

Party Chief CB
Recorder AL
Assistant
Map No./Dir. A-8 / N
State Coordinates 592-654

Road No. MUN 2430
Road Name VIRGINIA AVE
County WASHINGTON
Date 4-22-87
Sheet No. 1 OF 2

TRAFFIC CODES
TRAFFIC CONTROLS: STOP SIGN=SS, TRAFFIC LIGHT=T.L., FLASHING RED BALL=F.R.

TRAFFIC CODES
PARKING RESTRICTIONS: A.M. PEAK, P.M. PEAK, A.M./P.M. PEAK, NO PARKING ANYTIME=N.P., COMM/IND. ACCESS=E

SYSTEM				TRAFFIC		LINE DIAGRAM	TRAFFIC			PAVEMENT DATA
FED. AID.	FUNCT CLASS.	HWY. SYS.	HPMS SAMPLE	PRKG. REST.	COM/IND. ACCESS		CONTROL	COM/IND. ACCESS	PRKG. REST.	
						REYNOLDS AVE. 2090				
						0 24				
						ALLEY 106 6060				
						FED INT. TO HAGERSTOWN MUNI PARK 0 30				
						0 25 SCHOOL		E		
						DUNN IRVIN DR. 0680				
						0 20				
						PARK DRIVEWAY 1920				
						0 19				
						ALLEY 114 6140				
						0 17				
						0 15		E		
						SUNSET AVE 2320				
						0 14				
						ALLEY 108 6080				
						BROWN AVE 0270				
						0 11				
						0 05		E		
						0 03				40' I
						H 10'				"J" c-c
						W. HOWARD ST. 1100				2 ML
V	V		V							

FAIL 8001
URBAN OTHER PRINCIPAL ARTERIAL
HPMS 1011 0390

LINE DIAGRAM

SYSTEM: FED. AID. | FUNCT. CLASS. | HWY. SYS. | HPMS SAMPLE

TRAFFIC: PRKG. REST. | COM/IND ACCESS

TRAFFIC: CONTROL | COM/IND ACCESS | PRKG. REST.

PAVEMENT DATA

FAU 8001

URBAN OTHER PRINCIPAL ARTERIAL

SUMMIT AVE

SUMMIT AVE

0 61

SUMMIT AVE

MUN

@300

B.R. FED 832-379M

B=0

0 55

FL

FL

PROSPECT ST

KEY ST. 1300

MEMORIAL BLVD. 1650

0 54

2030

45°

0 70

SURREY AVE 2330

0 47

0 39

34' I
J" C-C
2ML

50' I
J" C-C

31' I
J" C-C
2ML

Form 6 HPS (Rev. 1961)

pg-n

ROAD INVENTORY SHEET Mun. No. 2430 4

PARTY CHIEF Frederick Settan
RECORDER Thomas Landon
CHAINMAN

ROAD NO. US 11 T
NAME VIRGINIA AVE
SHEET NO. 12 OF 13
DATE 1-5-67
COUNTY WASHINGTON

HAGERSTOWN 72-1

	SUNSET AVE MUN 2320	6	02		
					40'T
	ALLEY #108 MUN 6080	5	99 BROWN AVE MUN 270		C-C
FAS 5U #65		5	88 HOWARD STREET MUN 1100		
	MUN 2330 BRIARWOOD PLACE	5	84		
	MUN 2350 UNION PLACE	5	75		37'T
	R/R				C-C
		5	69 R/R FLASHING LIGHTS		
	MUN 2600 WILSON	5	62 BLVD		
	MUN 7150 ALLEY #215	5	57		
	MUN 2260 SNYDER AVE	5	52		
21-1					
	HOLAND DR MUN 1780	5	49		
			MUN 7170		
FAP 5 C.S.		5	45 ALLEY #217	STATE	
	MUN 7160 ALLEY #214	4	40		
			MELLOTT AVE		
		5	37 CO A13		
	MARION		AVE		54'T
	(MUN)	4	27 CO A12		C-C
			HAGERSTOWN LIMITS		
FAR 5	ROAD T 6 1-1		24 T 6 1-1		C
			18		

Form 6 HPS (Rev. 1961)

ROAD INVENTORY SHEET

PARTY CHIEF Frederick Settan
RECORDER Thomas Landon
CHAINMAN

ROAD NO. U S 11 I
NAME
SHEET NO. 13 OF 13
DATE 1-5-67
COUNTY WASHINGTON

HAGERSTOWN

U S 11 Summit

FAU URBAN - OTHER PRINCIPAL ARTERIAL

	6	29	MEM
PXR FLASHING LIGHTS			#WM 832 379M
	6	44	PXR FLASHING LIGHTS
MUN 1300			MUN 1600
KEY STREET	6	42	MEMORIAL BLVD
MUN 2030			
PROSPECT STREET	6	39	
			MUN 2230
	6	36	SUDDEY AVE
			MUN 2500
	6	22	REYNOLDS AVE
			MUN 2690
ENT. MUN PARK	6	19	ALLEY # 116
	6	13	SCHOOL
			MUN 650
	6	08	DUNN IRVIN DR.
MUN 1920			
PARK DRIVEWAY	6	07	
MUN 640			
ALLEY # 114	6	55	

M. UNCLASS. PRINCIPAL ARTERIAL TRAFFIC NO 13

SAME

Form 6 HPS (Rev. 1961)

3/9/89
DT, GD
(88-9/9)

AT

ROAD INVENTORY SHEET

Party Chief R. VOUGHT
Recorder L. ~~COFFELT~~ JR.
Chainman

VER
7-16-76

HAGERSTOWN

Road No. 2470
Name S & N. WALNUT ST
Sheet No. 1 OF 1
Date 11-4-63
County WASHINGTON

BB-7,8,9,10 11-25-88

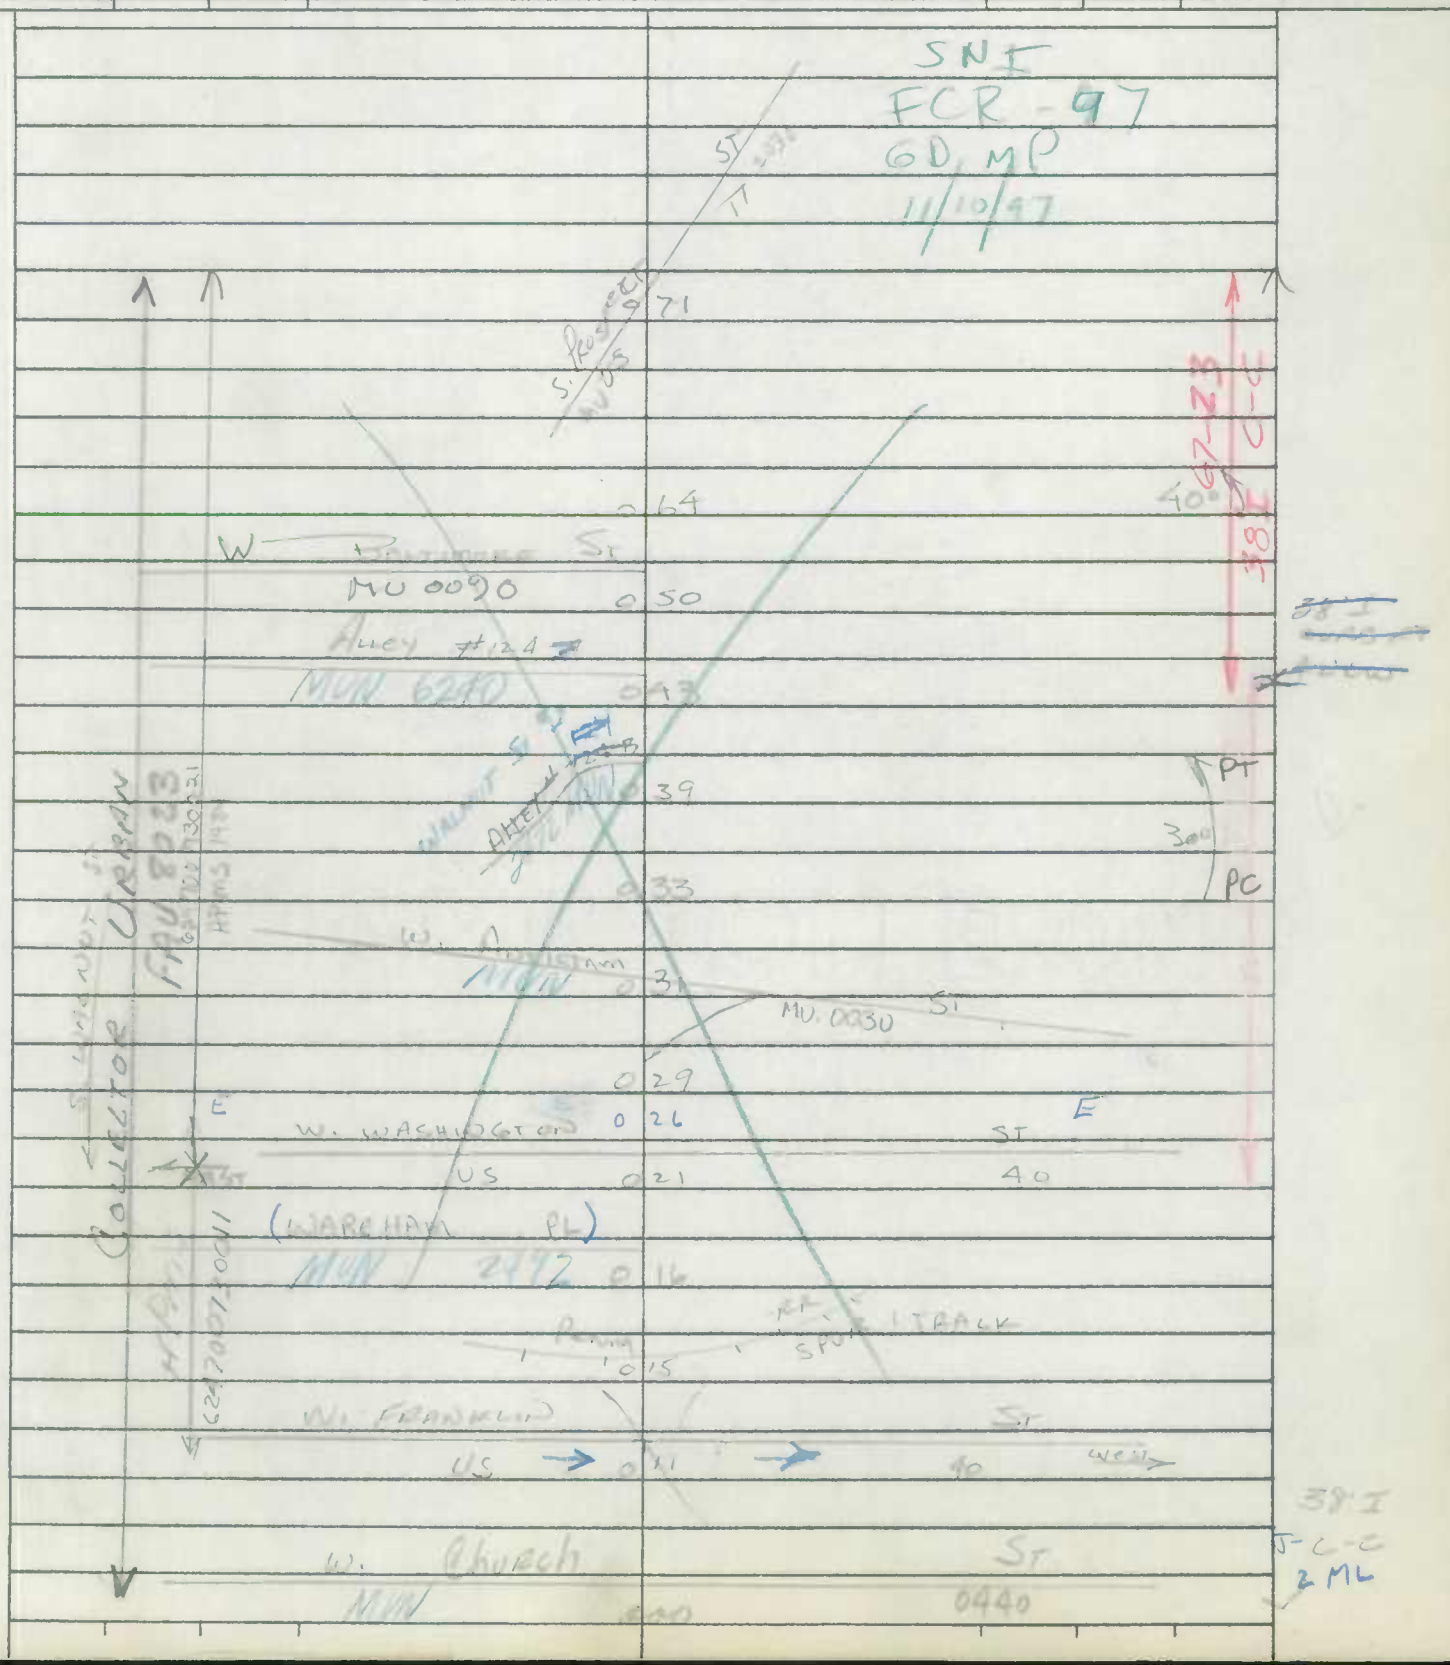

Form 6 HPS (Rev. 1961)

Mun. No. 2500

ROAD INVENTORY SHEET

Party Chief R. Vought
Recorder L. Coffelt, Jr.
Chainman

Hagerstown

VER 7-20-76

Road No. ~~Alt. 144~~
Name Washington St
Sheet No. 3 of 5
Date 11-12-63
County Wash.

81-1

West Place ~~Alley~~ MU 2550

Municipal

Park Ave. ~~Co. 977~~

Hump Rd Co. 479

Note: This section of road was used to detour traffic during Const. of bridge over I-81

38'I C-C

24'I

2-10' S.L.

50' CW

30'I C-C 2-4' J SW

URBAN Non FA

COLLECTOR

B-Market

B-Body Shop

F 1000'

I-81

Form 6 HPS (Rev. 1961)

MU 2500

ROAD INVENTORY SHEET

Party Chief R. Vaught
Recorder L. Coffelt, Jr.
Chairman

Road No. ~~Alt. 11~~ 4
Name
Sheet No. 4 of 5
Date 11-12-63
County Wash

	Alley ~~33~~ 34	253		
	Winter St. MUN 240	252	Cushwa's Alley MUN 4090	
	Alley 13 MUN 5130	250		
X X		247	Elgin Blvd. MUN 700	
	Alley 12 MUN 500	244		
	West Side Ave. MUN 2560	242		
		239	Summer St. MUN 2240	
	Berner ~~Avenue~~ Ave. MU 0140	237		38' L C-C
	Avalon Ave. MUN 60	234		
		229	Key's St. MUN 2160	
	WAKEFIELD RD. MU 2460	226		
	School	222		
	Devonshire Rd. MUN 630	218		
		214	Buena Vista Rd. MUN 220	
X	Wellingham Rd. MUN 1830	213		
		206	~~Alley~~ East Pl MU 0700	
	N. Mont Vista Ave. MUN 1730	205	S. Mont Vista Ave. MUN 1930	
		201		Same

Collector Rd 2013 Feet
Local Road 2500730244
Municipal
Main Co

Form 6 HPS (Rev. 1961)

ROAD INVENTORY SHEET

MU 2500 4

Party Chief R. Vought
Recorder L. Coffelt, Jr.
Chainman

Road No. ~~Md. 144~~
Name
Sheet No. 5 of 5
Date 11-12-63
County Wash.

State + US 40 E.B.

2169

W. Washington U.S.

Antietam St.

2166

2500730244

URBAN

COLLECTOR

FAU 2014

Church

2162

Madison Ave.

Alley

2161

2160

Alley

5750

Municipal

Eighth St.

2156

Same

Form 6 HPS (Rev. 1961)

L 4 AT

ROAD INVENTORY SHEET

Party Chief R. VOUGHT
Recorder L. OFFELT JR.
Chainman

HAGERSTOWN

VER 7-13-76

Road No. 2520
Name WATER ST.
Sheet No. 1 OF 1
Date 10-29-63
County WASHINGTON

N. MONTVALLA AVE

0.10 ALLEY 267 1230

0.07

ALLEY 266

ATHLETIC FIELD 0.03

34' I
C-C

PARK AVE

MUN. 19[illegible] 19[illegible]

SHA 51.3 - 8 Revised
4.83

MARYLAND STATE HIGHWAY ADMINISTRATION

ROAD INVENTORY SHEET

GD FCR-97
MP 11/4/97

90·30

Party Chief GD
Recorder TM
Assistant
Map No./Dir. B-8 / EW
State Coordinates HAGERSTOWN

Road No. MU 2547
Road Name (WESEL BLVD)
County WASHINGTON
Date 3-8-91
Sheet No. 1 OF 3

TRAFFIC CODES
TRAFFIC CONTROLS: STOP SIGN=SS, TRAFFIC LIGHT=T.L., FLASHING RED BALL=F.R.

TRAFFIC CODES
PARKING RESTRICTIONS: A.M. PEAK, P.M. PEAK, A.M./P.M. PEAK, NO PARKING ANYTIME=N.P., COMM/IND. ACCESS=E

SYSTEM				TRAFFIC		LINE DIAGRAM	TRAFFIC			PAVEMENT DATA
FED. AID.	FUNCT CLASS.	HWY. SYS.	HPMS SAMPLE	PRKG. REST.	COM/IND. ACCESS		CONTROL	COM/IND. ACCESS	PRKG. REST.	
										24' I
										~~45' I~~
										~~2 UML~~
						0 31				~~2-18' EW~~
										~~56' ION~~
										TAPER TO 45' I
										~~2 UML~~
						0 17				
										23' I LT
										25' I RT
										15' GR MED W/ CURBS IN
										~~2 UML~~
						0 10				
						ALLEY #79				
						0 09 MU 5790				
						RIDGE AVE				
						0 06 MU 2120				
						ALLEY #78				
						0 03 MU 5780				
										2-25' I
										JC-C
						0 01 0.01/18' I JC-C				4' J MED
						BLVD				42 UML
						BURHANS				
						US 11 @6.39 0 00				

NON FA
URBAN ARTERIAL

SYSTEM: FED. AID. | FUNCT. CLASS. | HWY. SYS. | HPMS SAMPLE

TRAFFIC: PRKG. REST. | COM/IND ACCESS

LINE DIAGRAM

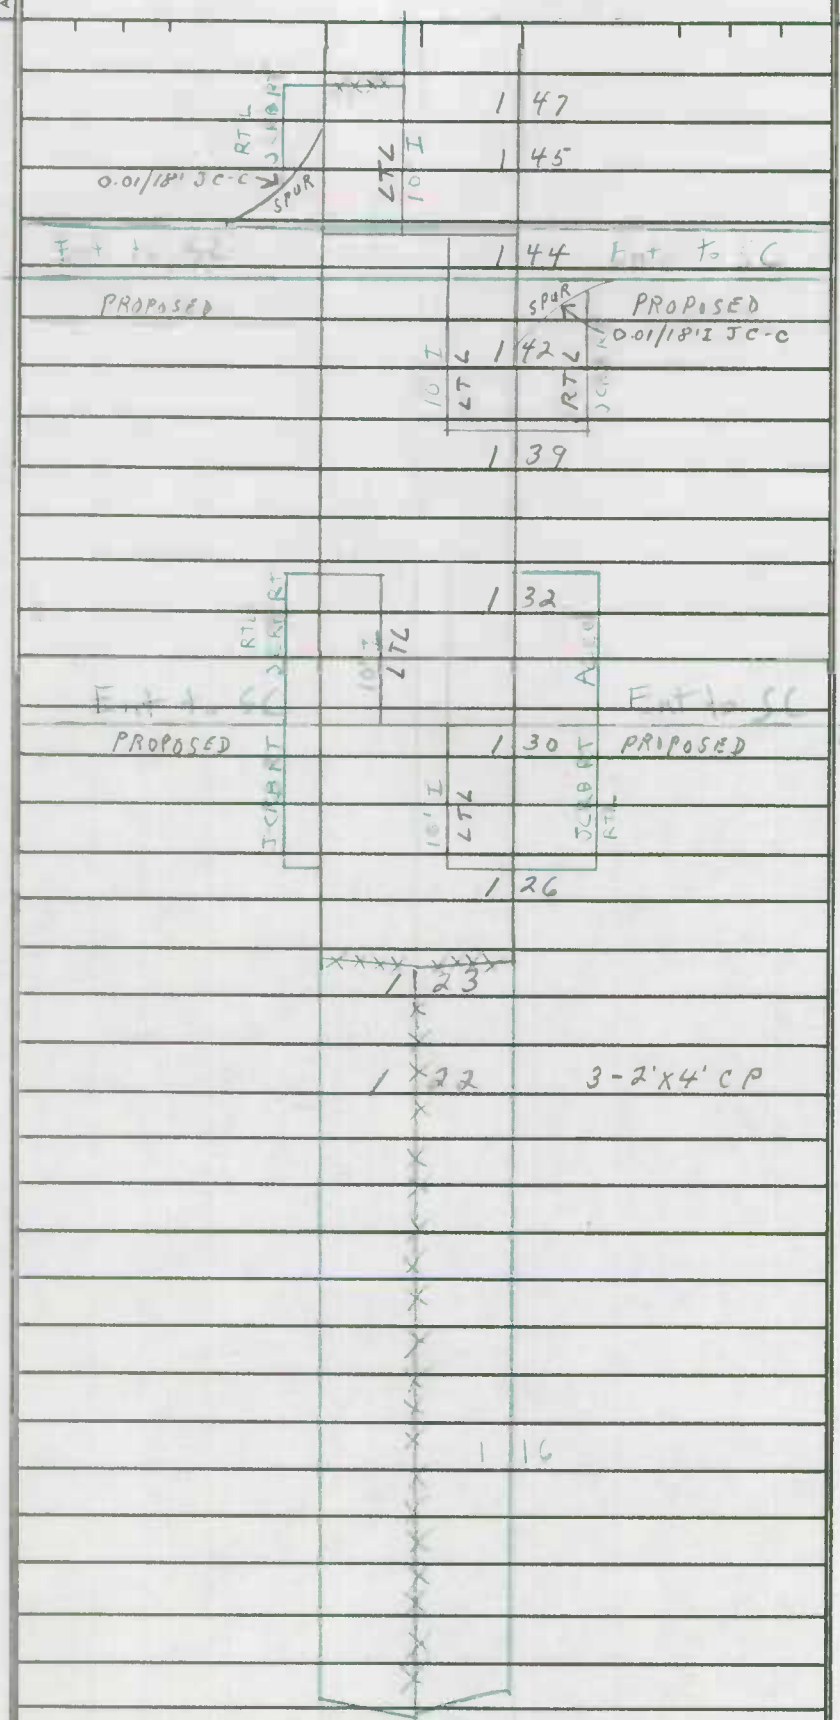

TRAFFIC: CONTROL | COM/IND ACCESS | PRKG. REST.

TL

TL

E

E

PAVEMENT DATA

~~2-35' I~~

~~15' GR MED~~

~~4 J CRBS~~

~~2 X ML~~

2-24' I

2-~~8~~X' I

2 I

15' GR MED

J CRBS IN

4 ~~X~~ ML

12' I RT

24' I LT

2-10' I SHLD OUT

12' I OUT MED

3 ML

~~45 I~~

2 uML

24' I

2-10' I SHLD

NON FA
URBAN ARTERIAL

SHA 51.3 - 8 Revised 4.83

MARYLAND STATE HIGHWAY ADMINISTRATION

ROAD INVENTORY SHEET

Party Chief GD
Recorder TM
Assistant
Map No./Dir. 1
State Coordinates HAGERSTOWN

Road No. MU 2547
Road Name (WESEL BLVD)
County WASHINGTON
Date 3-8-91
Sheet No. 3 OF 3

90-30
91-35
BD/SP
3-11-92

TRAFFIC CODES
TRAFFIC CONTROLS: STOP SIGN=SS, TRAFFIC LIGHT=T.L., FLASHING RED BALL=F.R.

TRAFFIC CODES
PARKING RESTRICTIONS: A.M. PEAK, P.M. PEAK, A.M./P.M. PEAK, NO PARKING ANYTIME=N.P., COMM/IND. ACCESS=E

SYSTEM				TRAFFIC		LINE DIAGRAM	TRAFFIC			PAVEMENT DATA
FED. AID.	FUNCT CLASS.	HWY. SYS.	HPMS SAMPLE	PRKG. REST.	COM/IND. ACCESS		CONTROL	COM/IND. ACCESS	PRKG. REST.	
						MASSEY BLVD				
						1 68 Sign'l Cntrl				
						1 67 RTL				2-~~34~~ I
						1 66 LTL I 10				15' GR MED
						Hagerstown Fair to SC				4-J CRBS
						MU ~~PROPOSED~~ 1015 1 64 PROPOSED I 10 RTL		TL	E	4 @ ML
						I 10 LTL 1 62				
						1 59				
										2-24' I
										2-10' I SHLDR
				F		1 54		E		
										~~2-30' I~~
						1 50				15' GR MED
						I 10 LTL				J CRBS IN
						1 48				42 @ ML

SYSTEM				TRAFFIC		LINE DIAGRAM	TRAFFIC				PAVEMENT DATA
FED. AID.	FUNCT. CLASS.	HWY. SYS.	HPMS SAMPLE	PRKG. REST.	COM/IND ACCESS		CONTROL	COM/IND ACCESS	PRKG. REST.		

Form 6 HPS (Rev. 1961)

MACS

P9-77

ROAD INVENTORY SHEET

Party Chief R. VOUGHT
Recorder L. DEFFELT JR.
Chainman

HAGERSTOWN VER 7-13-76

Road No. 2550
Name West Place
Sheet No. 1 OF 1
Date 10-29-63
County WASHINGTON

W. WASHINGTON ST	
Md. 023	149
	8'6 10'CW
003	MAIN AVE
	1490 X 10'E 12'CW
ROAD 000 END	

SHA 51.3 - 8 Revised
- 4.83

MARYLAND STATE HIGHWAY ADMINISTRATION

ROAD INVENTORY SHEET

3/9/89
JT, GD
(88-14)

Party Chief BB
Recorder RM
Assistant
Map No./Dir. 1
State Coordinates

Road No. MUN 2600
Road Name E. + W. Wilson Blvd
County Washington
Date 4-29-85
Sheet No. 1 OF 3

88-14 11-25-88

TRAFFIC CODES
TRAFFIC CONTROLS: STOP SIGN=SS, TRAFFIC LIGHT=T.L., FLASHING RED BALL=F.R.

TRAFFIC CODES
PARKING RESTRICTIONS: A.M. PEAK, P.M. PEAK, A.M./P.M. PEAK, NO PARKING ANYTIME=N.P., COMM/IND. ACCESS=E

SYSTEM				TRAFFIC		LINE DIAGRAM	TRAFFIC			PAVEMENT DATA
FED. AID.	FUNCT. CLASS.	HWY. SYS.	HPMS SAMPLE	PRK.G. REST.	COM/IND. ACCESS		CONTROL	COM/IND. ACCESS	PRK.G. REST.	
						SNJ				
						FCR-97 6D,MP 1/1/07				
						Chestnut Ave MUN 1430 0.28 Alley 99 MUN 5110				
						Alley 109 MUN 2410 0.24				2-25'I
										18' Gr Pkwy
										J-CC
						Guilford Ave 940 0.21			X	
										2-26'I
										J-CC
						Wilson Blvd (LD = 45') 0.16 Section				10' Gr Pkwy
						Summit MU 0.14 Ave 2300			X	
										10' T Shld IN LT
						PT 300 0.08				2-26'I
										J-CC
										4-mL
						Pine MU 0.05 ST 1970 #WH025			X	4' J mkd
						PC 185 0.04				30' I-JCCRT
										24' I-JCCLT
										4 mL
						Virginia Ave US 11B (MUN) MUN 2430 0.00 US 11	TL			4' J mkd
						Burhans Blvd				

SYSTEM | FED. AID. | FUNCT. CLASS. | HWY. SYS. | HPMS SAMPLE

TRAFFIC | PRKG. REST. | COM/IND ACCESS

LINE DIAGRAM

TRAFFIC | CONTROL | COM/IND ACCESS | PRKG. REST.

PAVEMENT DATA

FAU 6004
WARD MILLING Antenna

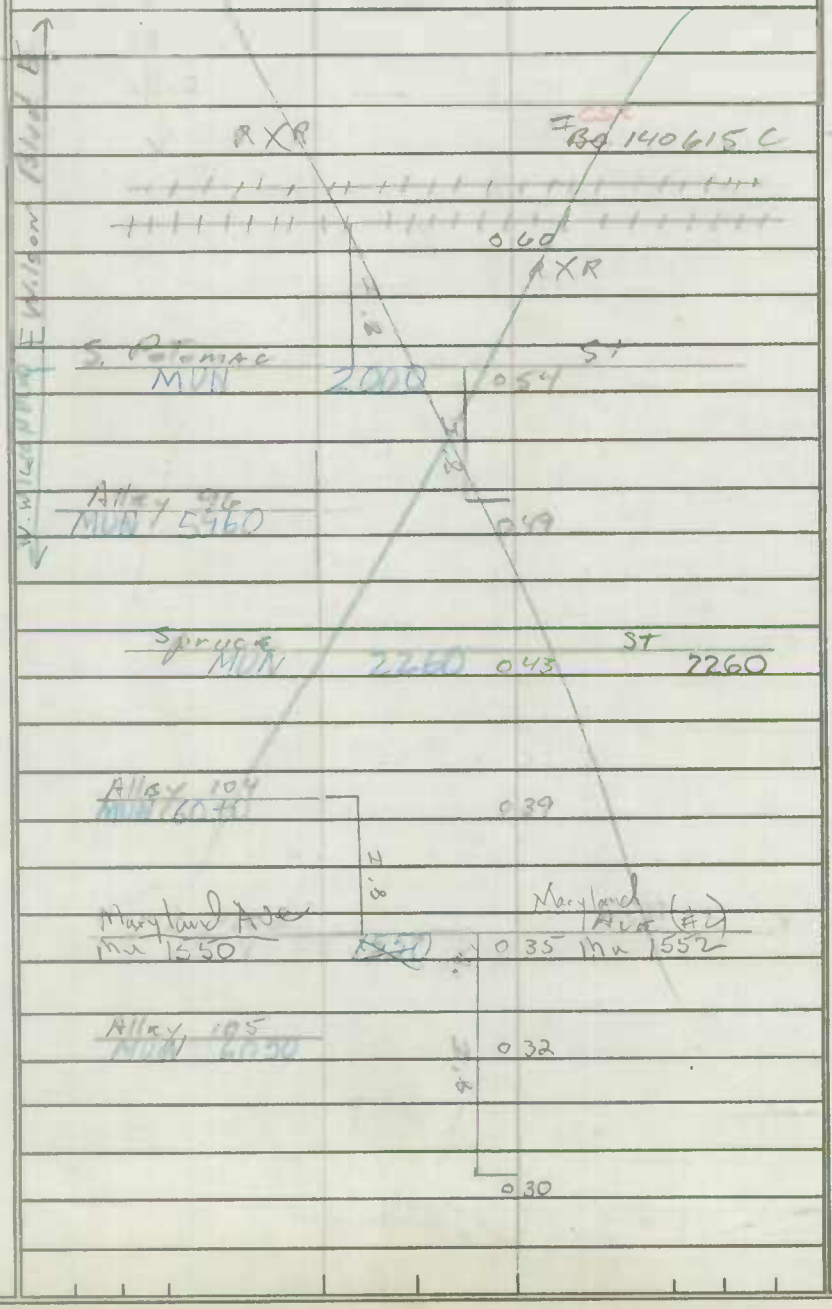

SHA 51.3-8
11-15-72

STATE HIGHWAY ADMINISTRATION OF MARYLAND

ROAD INVENTORY SHEET

Party Chief R. Vought
Recorder L. Coffelt, Jr.
Helper

Map No.

Road No. MUN 2600
Road Name E+W Wilson Blvd
Sheet No. 3 of 3
Date 10-29-63
County WASHINGTON
State Coordinates

Rewrite: 5.9.85 BY CRAIG L MURRAY

	U.S.	136	40 AL
	ALLEY 228 MUN 7720	131	
	Kenly ~~DR~~ MUN 1250	127	DR. op 229
	Kenwood DR MUN 5930	123	BRINKER DR MUN 234
		112	
		107	CHURCH
4	E	~~105~~	
		103	
0			
		099	E
0	OAK MUN 1830 1ST RXR	091 RXR	
8	ALLEY 95 5930 MUN	090	
	KUHN MUN 6320	086	AVE
0	ALLEY 90 MUN 5900	083	
	ROSE MUN	079	HILL AVE 2150
	ALLEY 88 MUN 5880	074	ALLEY 89 MUN 5900
	CORBETT 550	072	ST MUN
0	ALLEY 67 MUN 5670	068	ALLEY 84 MUN 5810
	POPE MUN	064	AVE 1990

2-25'I
18' GRASS
MED
JC-C

SHA 51.3-8
11-15-72

ROAD INVENTORY SHEET

Road No. _____
Road Name _____
Sheet No. _____
Date _____
County _____
State Coordinates _____

Form 6 HPS (Rev. 1961)

ROAD INVENTORY SHEET

Party Chief R. Vought
Recorder L. Coffelt, Jr.
Chainman

Road No. 2600
Name E. & W. Wilson Blvd.
Sheet No. 1 of 2
Date 10-29-63
County Wash.

VER. 7-14-76

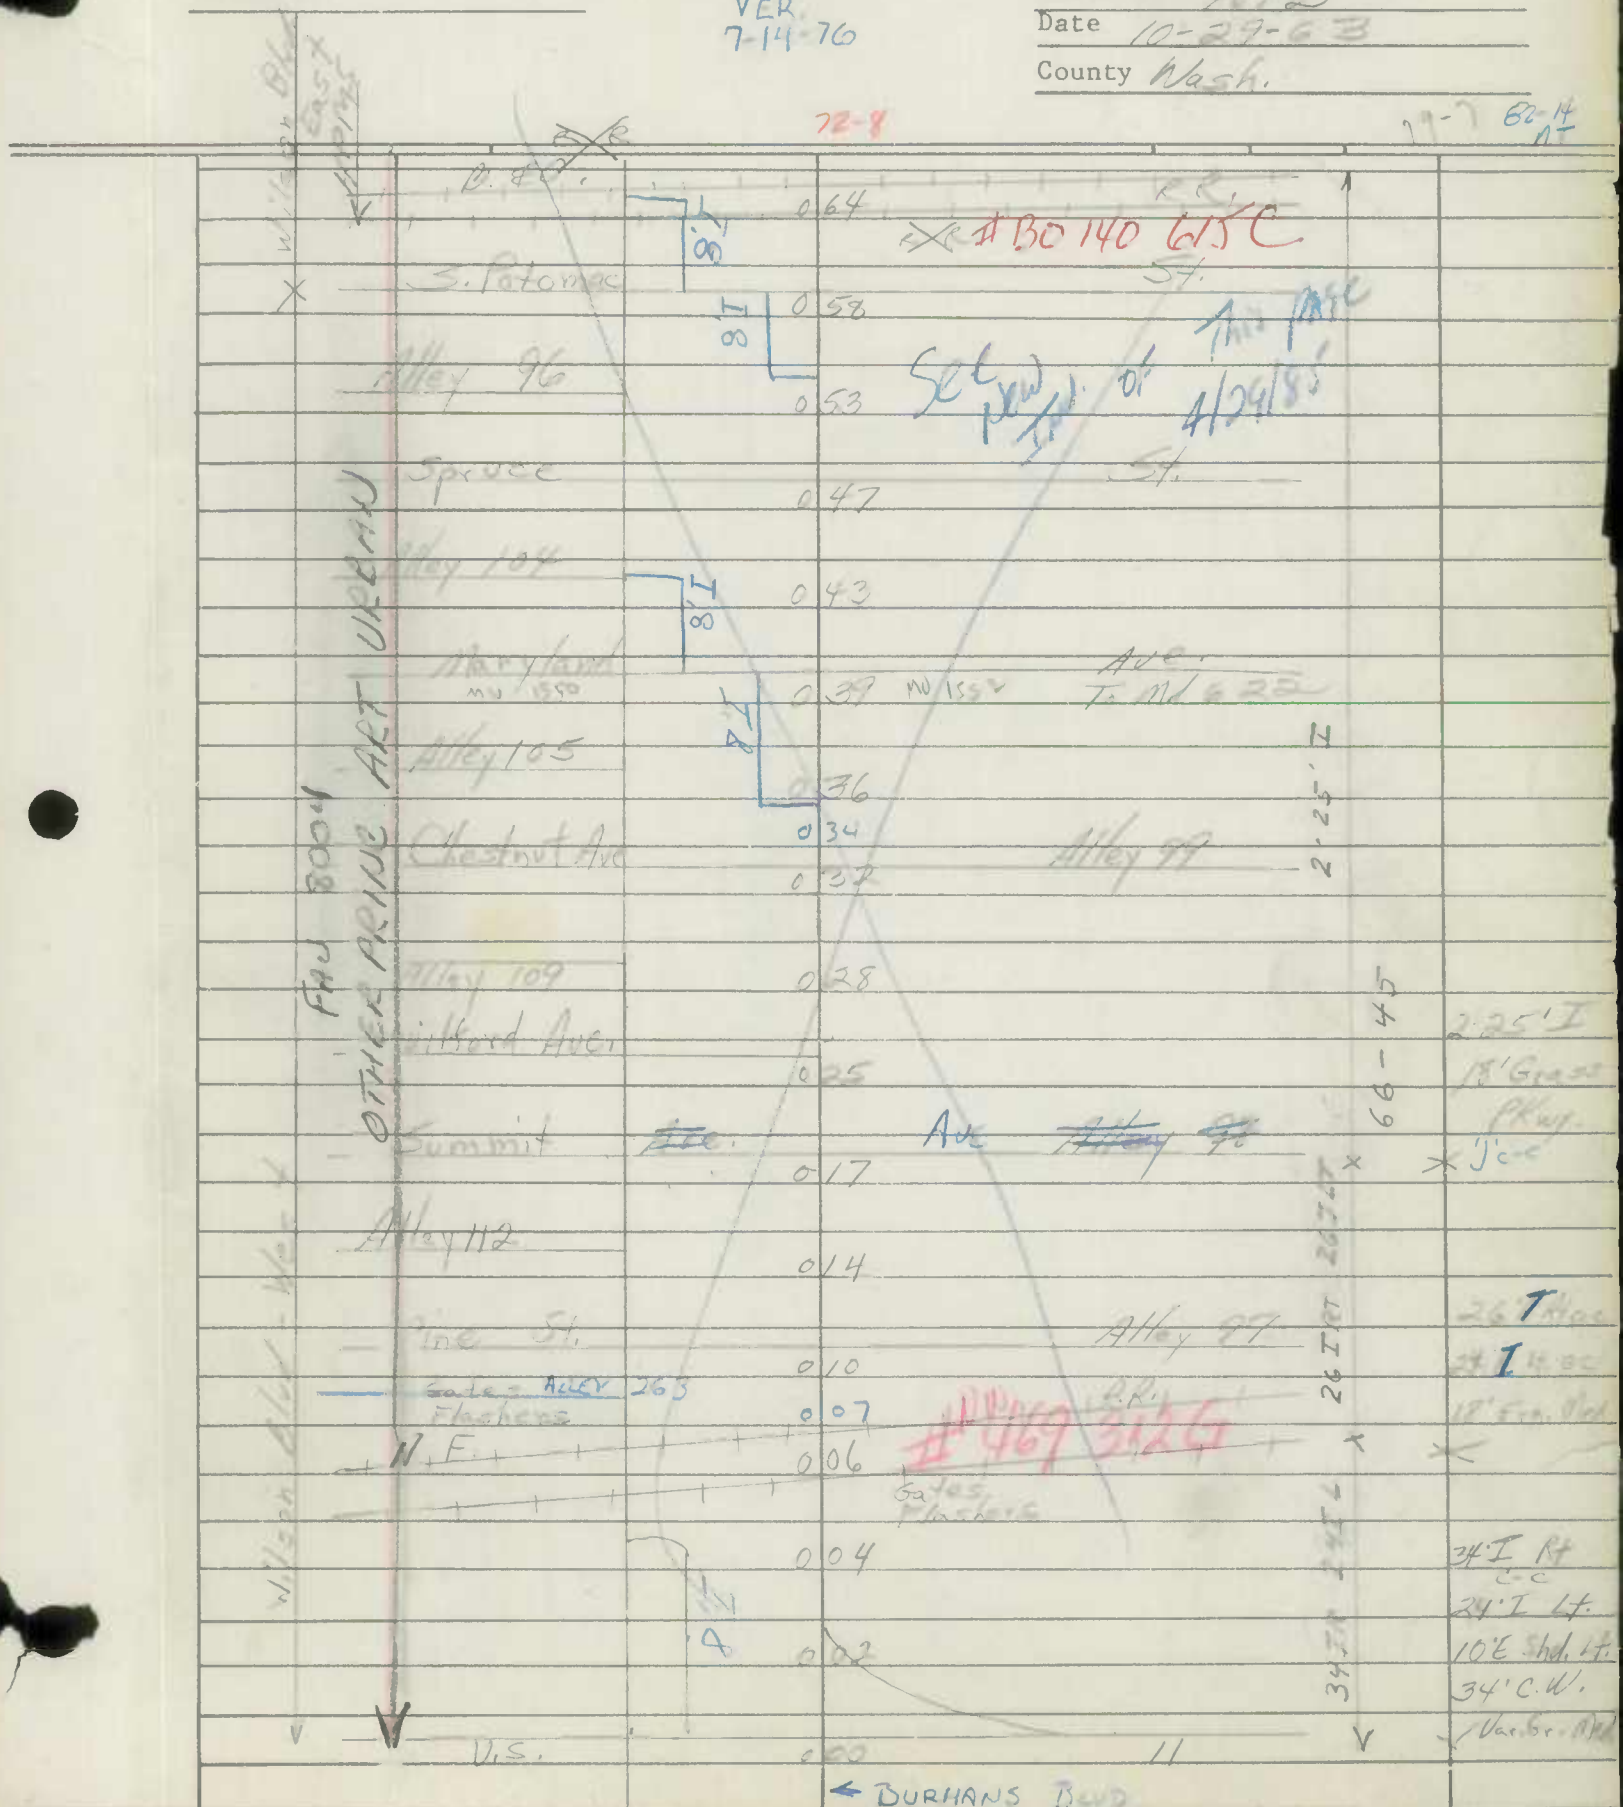

Form 6 HPS (Rev. 1961)

ROAD INVENTORY SHEET

Party Chief R. Vaught
Recorder L. Coffelt, Jr.
Chainman

Road No.
Name E. & W. Wilson Blvd.
Sheet No 3 of 3
Date 10-29-63
County Wash.

79-7

FAU 8004































2-25' I
18' Grass
Med
Isl

0260007300044

SHA 51.3-8
11-15-72

STATE HIGHWAY ADMINISTRATION OF MARYLAND

ROAD INVENTORY SHEET MUN 2630

Party Chief FR
Recorder JE
Helper

Map No. G22
79-63

Road No. ~~C 895~~
Road Name WOODPOINT AVE
Sheet No. 1 of 1
Date 3-27-80
County WASH
State Coordinates 591-665

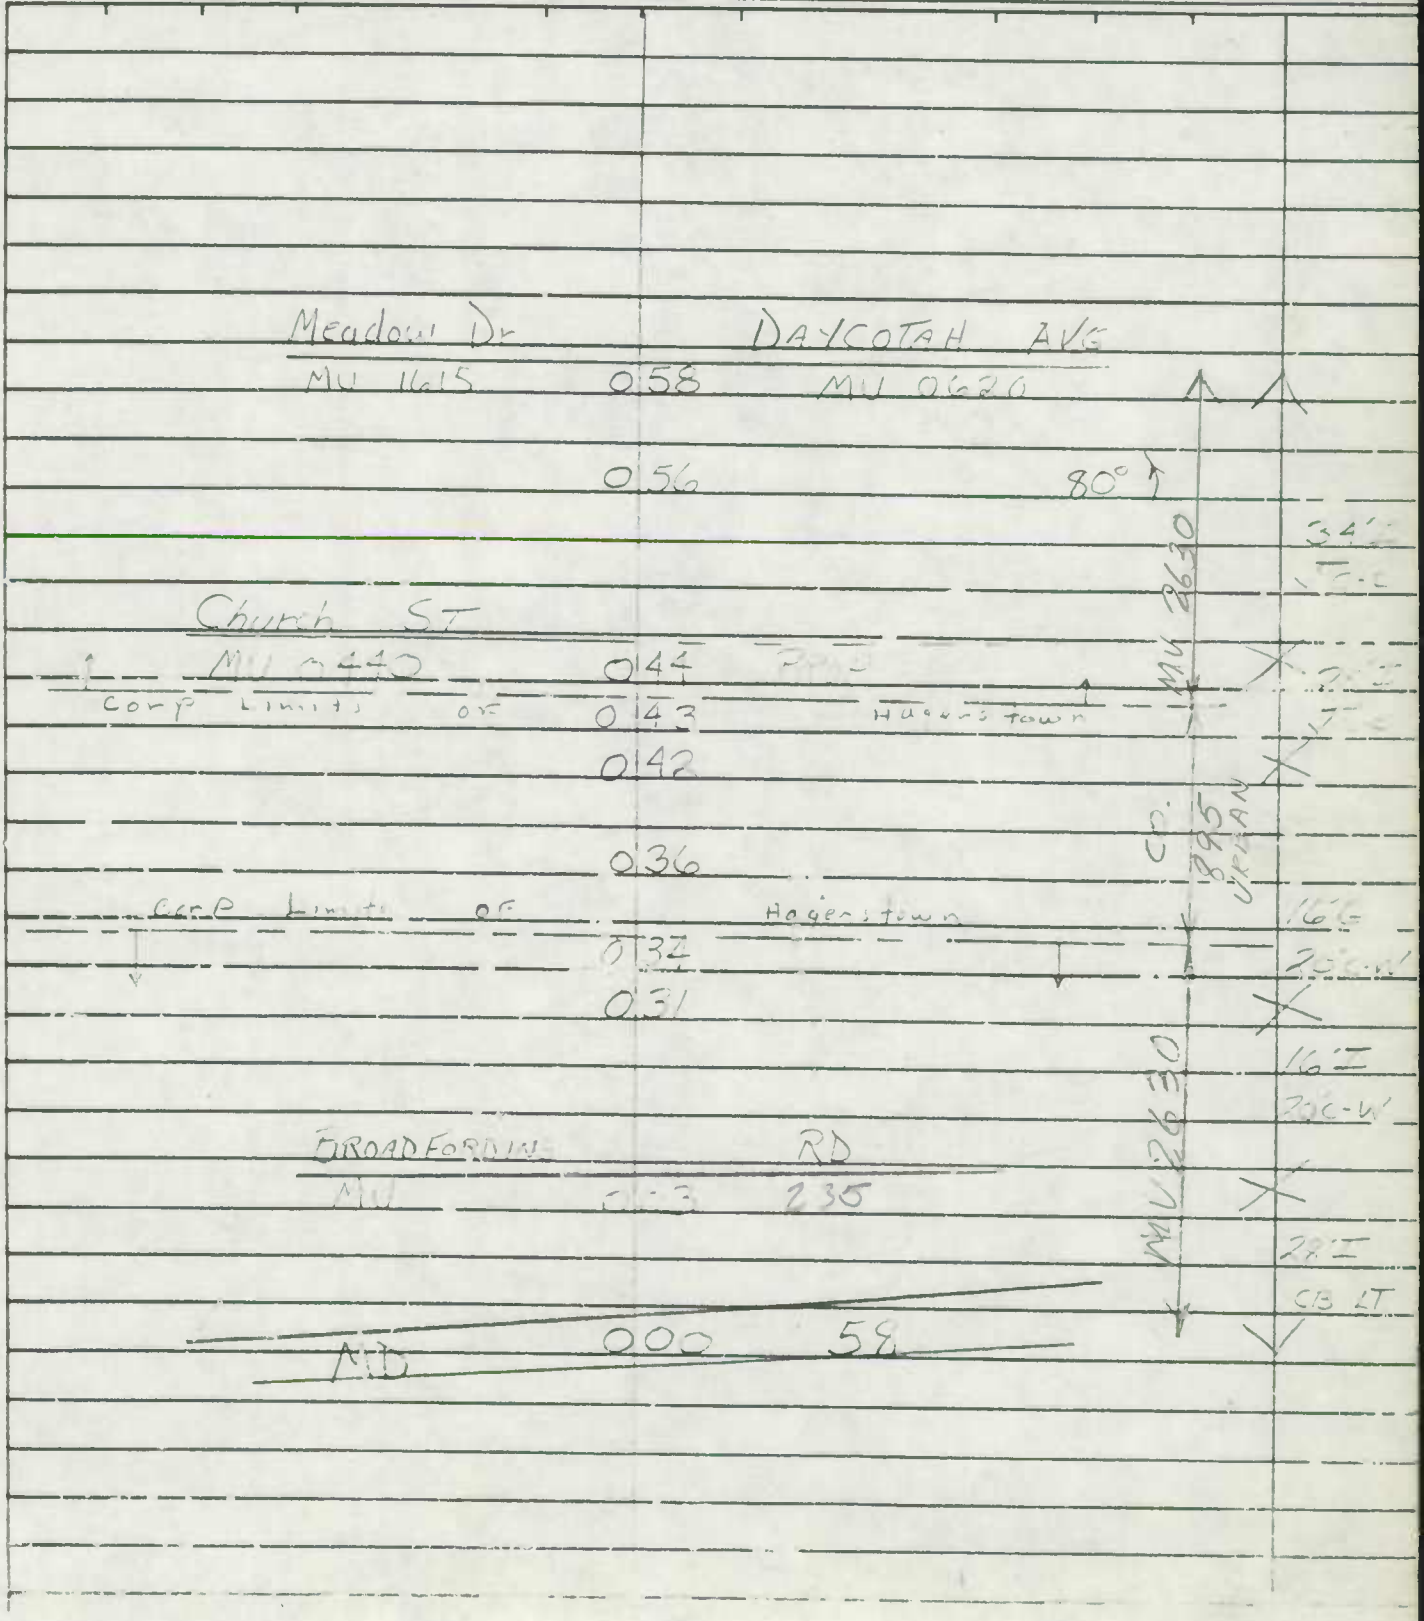

Form 6 HPS (Rev. 1961)

ROAD INVENTORY SHEET

Party Chief R. Vaught
Recorder L. Coffield, Jr.
Chainman

VEC
7-18-76

Road No. 2630
Name Wood Point Ave.
Sheet No. 1 of 1
Date 9-23-63
County Wash.

SEE NEW INV. OF CO. 895

Road End.
0/4

24' X1
C-C

W. Church

W. CHURCH St.
Mun. 044 0

N 0 11

34' I
C-C

MEADOW DR
~~Daycotah Ave.~~
~~0000~~
1615

DAYCOTAH AVE
0 0 0 MI 0620

Form 6 HPS (Rev. 1961)

MUN 2635

WOODPOINT AVE

4

P4-77

ROAD INVENTORY SHEET

Party Chief R. VOUGHT VER 7-15-76

Recorder L. COFFELT JR.

Chainman

HAGERSTOWN
591-665

(Adj-Received 4/66)

Road No. ~~CO 494~~

Name ~~[illegible]~~

Sheet No. 1 OF 1

Date 9-23-63

County WASHINGTON

SEE INV

OF CO 895

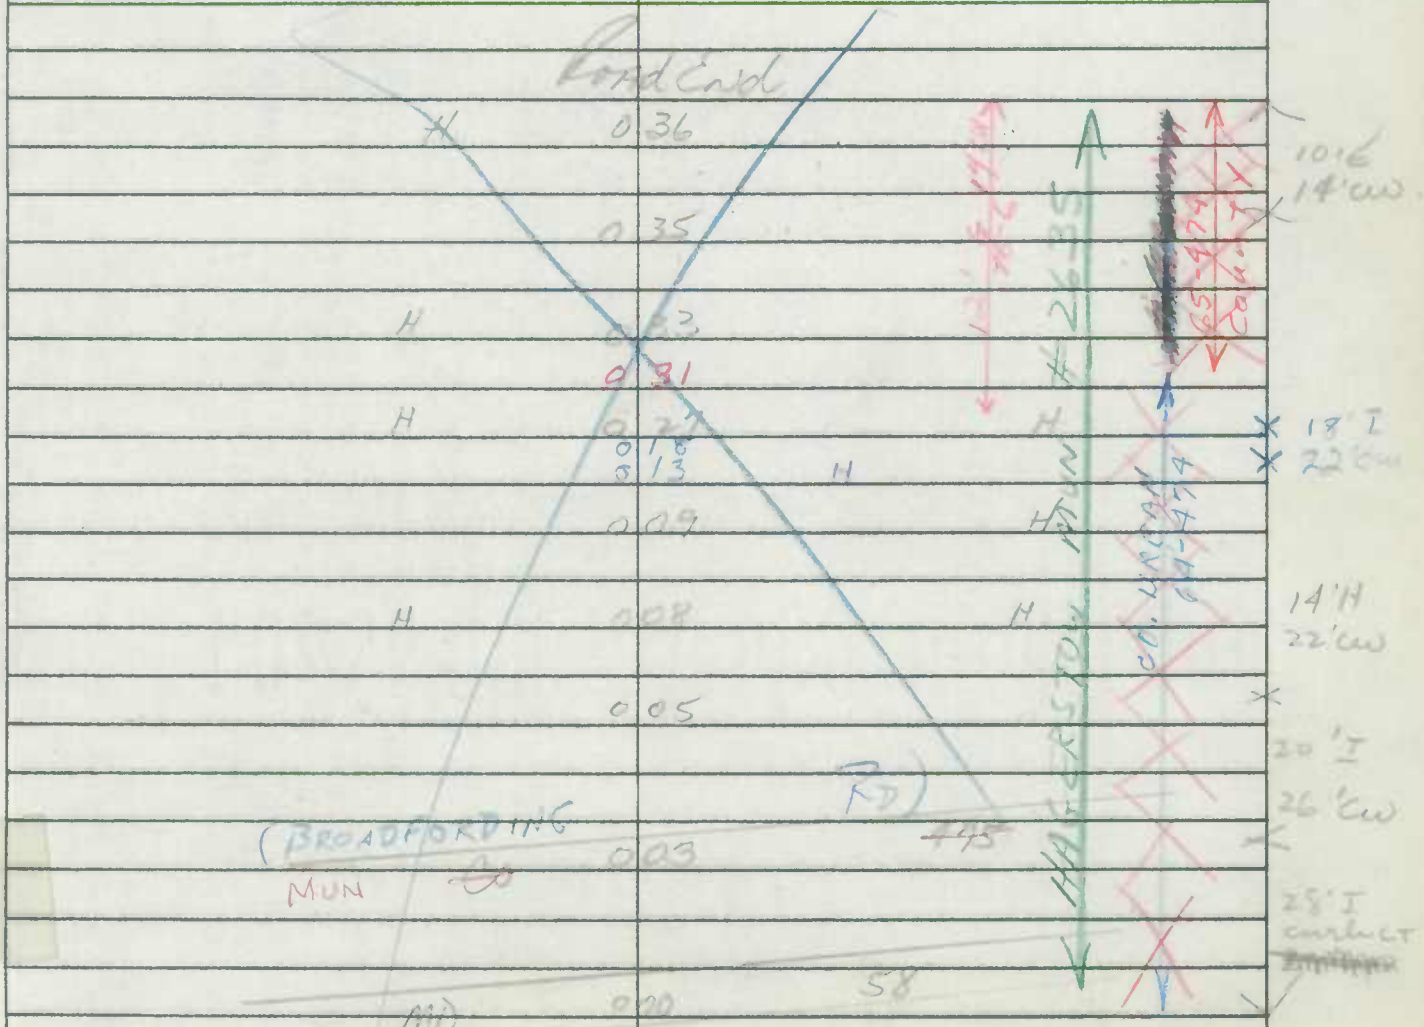

Form 6 HPS (Rev. 1961)

AT ✓

ROAD INVENTORY SHEET

5080

Party Chief R. VOUGHT
Recorder L. COFFELT JR.
Chainman

VER 7-20-76

HAGERSTOWN

Road No. ~~6080~~
Name ALLEY #8
Sheet No. 1 OF 1
Date 11-13-63
County WASHINGTON

Abandoned
GPS-02
6-4-02
GO/85

S. Potomac ST
MAIN 0.06 2005

8'K
8'CW

0.03

10'J
10'CW

ALLEY #20
MAIN 0.00 3200

Form 6 HPS (Rev. 1961)

9/MIKE #1
BB/AH
12-7-99

AT

5170

ROAD INVENTORY SHEET

Party Chief R. VOUGHT
Recorder L. COFFELT JR.
Chainman

HAGERSTOWN

VER
7-20-76

Road No. ~~6170~~
Name ALLEY # 17
Sheet No. 1 OF 1
Date 11-5-63
County WASHINGTON

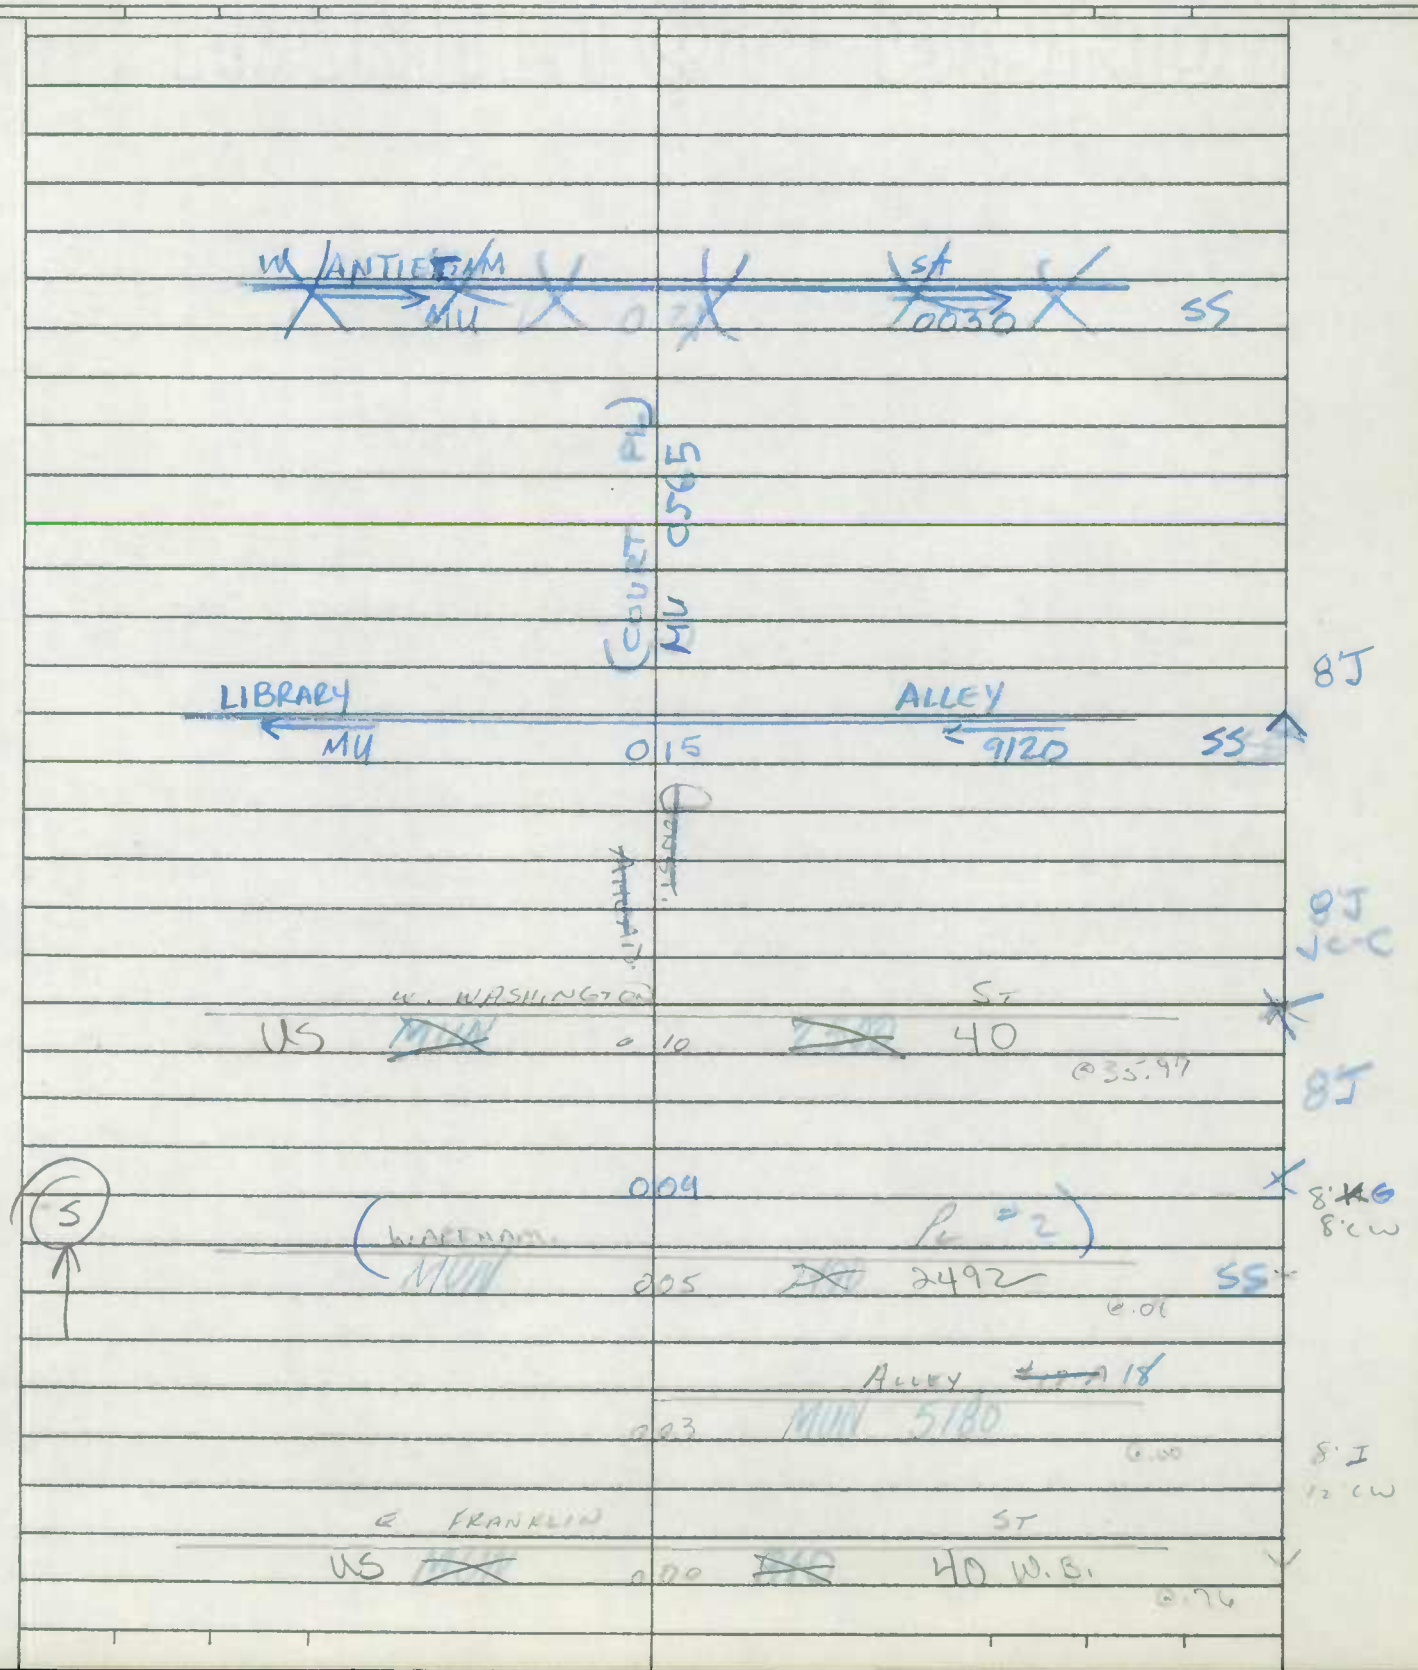

Form 6 HPS (Rev. 1961)

AT

ROAD INVENTORY SHEET

5400

Party Chief R. VOUGHT
Recorder L. COFFELT JR.
Chainman

HAGERSTOWN

VER 7-20-76

Road No. ~~6400~~
Name ALLEY #40
Sheet No. 1 OF 1
Date 10-29-63
County WASHINGTON

ALLEY

00406 12

ALEXANDER

00002 ST

8'J
10'CW

ROAD 000 END

MACS

Form 6 HPS (Rev. 1961)

ROAD INVENTORY SHEET

5630

Party Chief R. VOUGHT
Recorder L. COFFELT JR.
Chainman

VER 1-20-76

HAGERSTOWN

Road No. ~~6630~~
Name ALLEY #63
Sheet No. 1 OF 1
Date 10-29-63
County WASHINGTON

ALLEY #11

Road End 12'

~~0.36~~ 0.35

BUENA VISTA AVE

~~0.18~~ 0.27

ROSS ST

~~0.15~~ 0.14

ALLEY #69

~~0.11~~ 0.08

~~0.08~~ 0.07

ALLEY #72

130

~~0.06~~ 0.05

SUMMER ST

~~0.04~~ 0.03

2290

ALLEY Road End #68

~~0.00~~

50

8'S 12'CW

8'H 12'CW

8'H 79-20

300'

Form 6 HPS (Rev. 1961)

L
AT

ROAD INVENTORY SHEET

Party Chief R. VOUGHT
Recorder L. COFFELT JR.
Chainman

HAGERSTOWN

VER
7-20-76

Road No. 7150
Name ALLEY #215
Sheet No. 1 OF 1
Date 11-8-63
County WASHINGTON

ABAN.

4-29-85

BEG. END

0.15

VIRGINIA AVE

US 0.00 11

8'E
10CLD

Form 6 HPS (Rev. 1961)

PULL

ROAD INVENTORY SHEET

M 7600

Party Chief R. VOUGHT
Recorder L. COFFELT JR.
Chainman

HAGERSTOWN

Road No.
Name ALLEY PVT #2
Sheet No. 1 OF 1
Date 10-28-63
County WASHINGTON

NOW ALLEY # 260

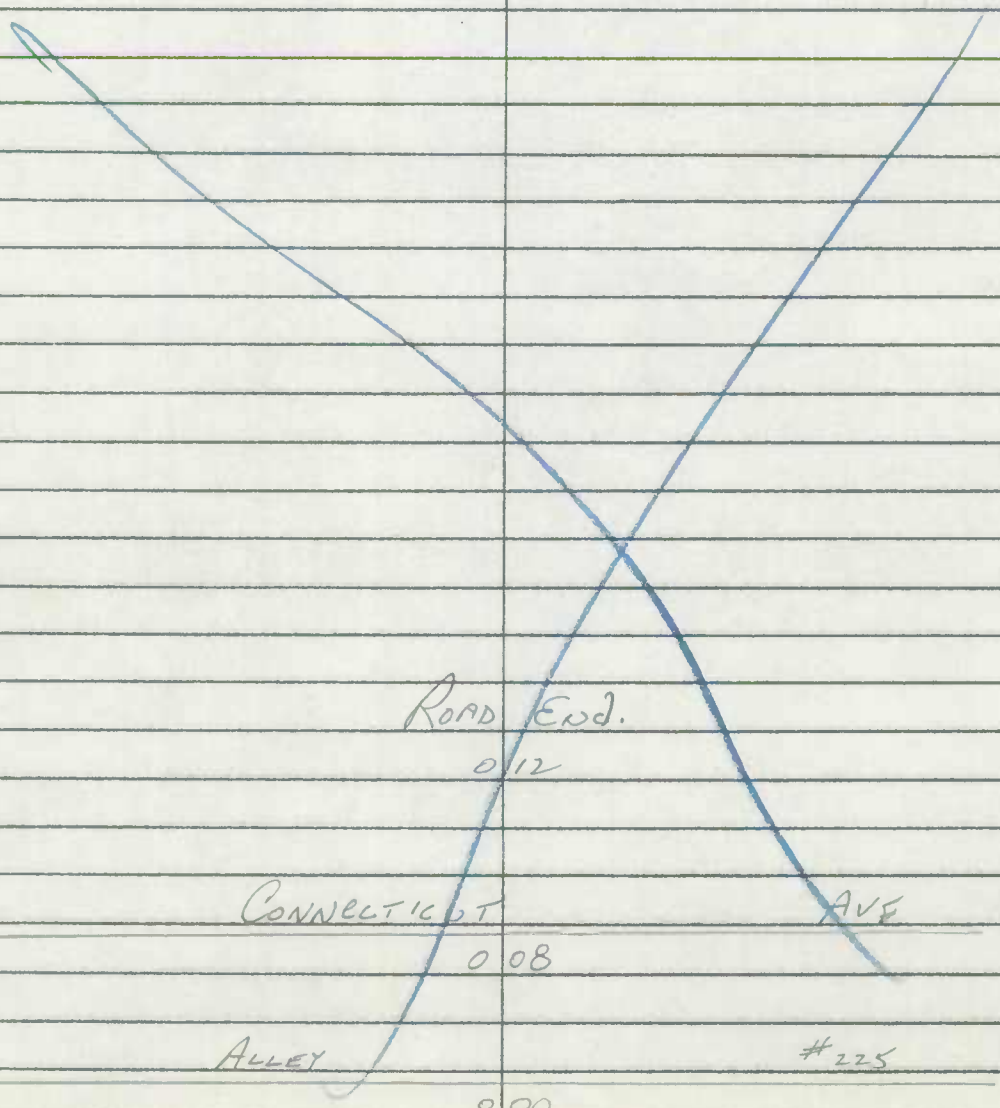

PULL

Form 6 HPS (Rev. 1961)

ROAD INVENTORY SHEET

pw 7620

Party Chief R. VOUGHT
Recorder L. COFFELT JR.
Chainman

HAGERSTOWN

Road No.
Name ALLEY PUT
Sheet No. 1 OF 1
Date 10-28-63
County WASHINGTON

Now Alley # 262

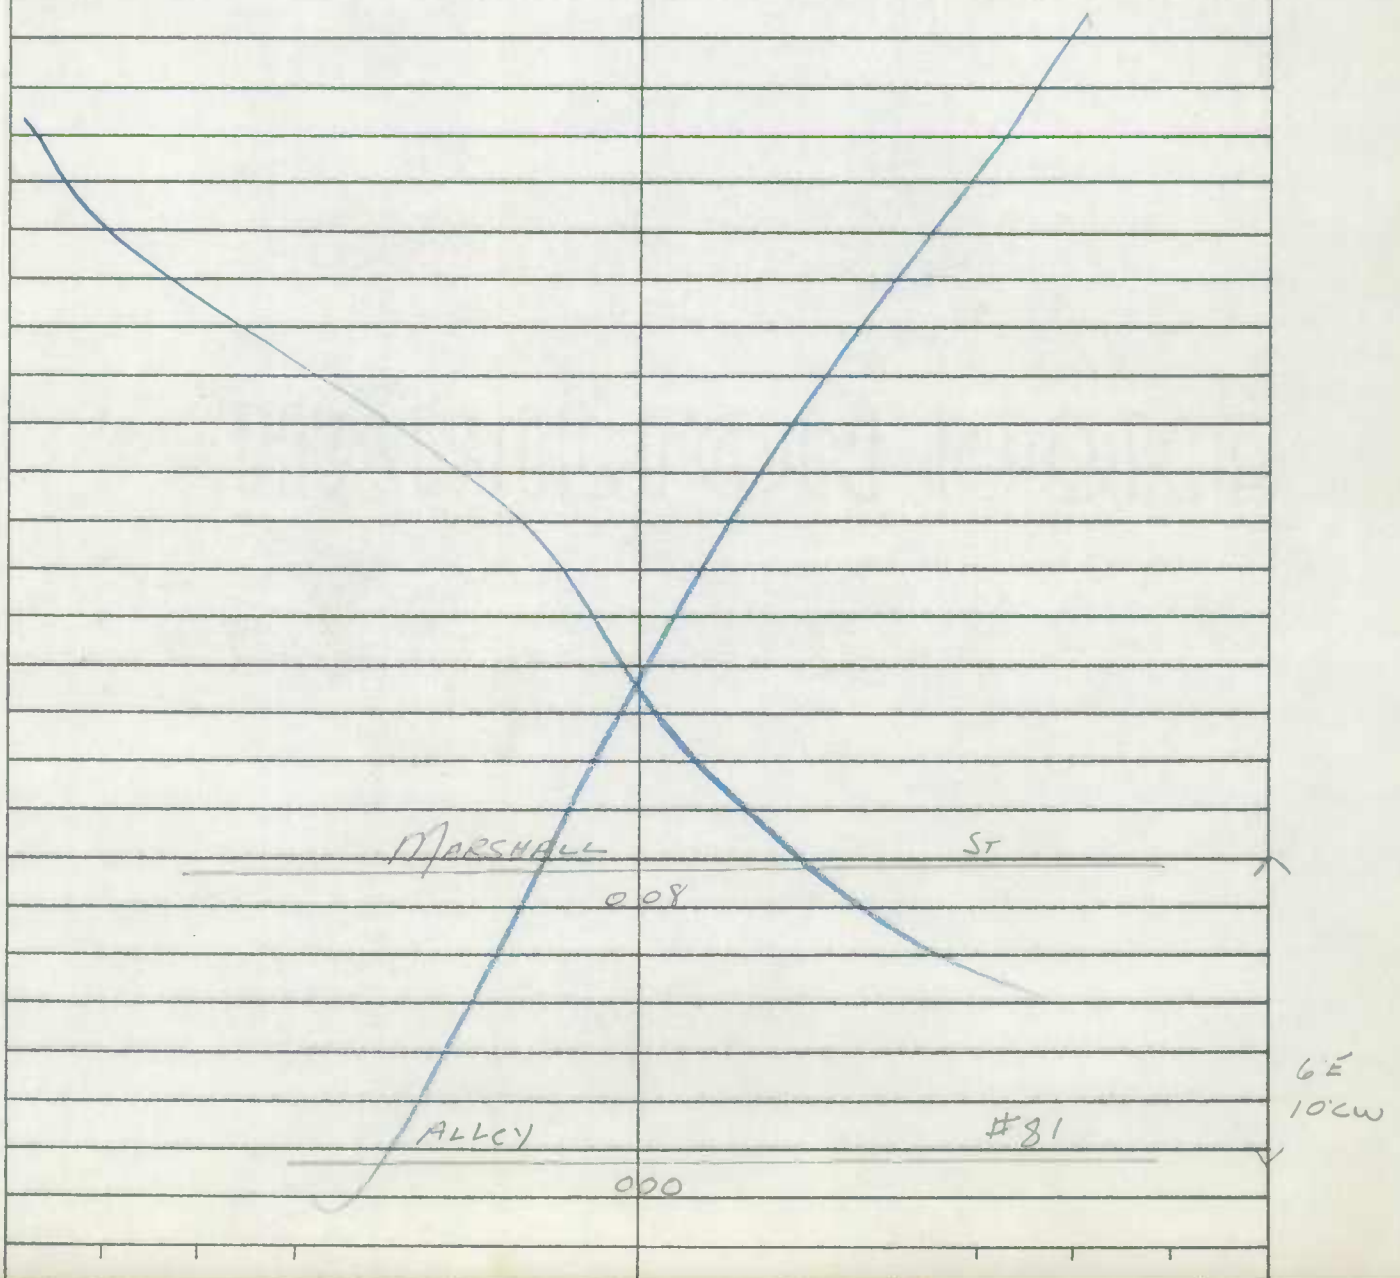

OFFICE

MJ

ROAD INVENTORY SHEET

Party Chief

Recorder Fowler

Chainman

VER
7-19-76

HAGERSTOWN

Road No. 7630

Name Alley 263

Sheet No. 1 of 1

Date 12-1-64

County WASHINGTON

ADM. 4-29-85

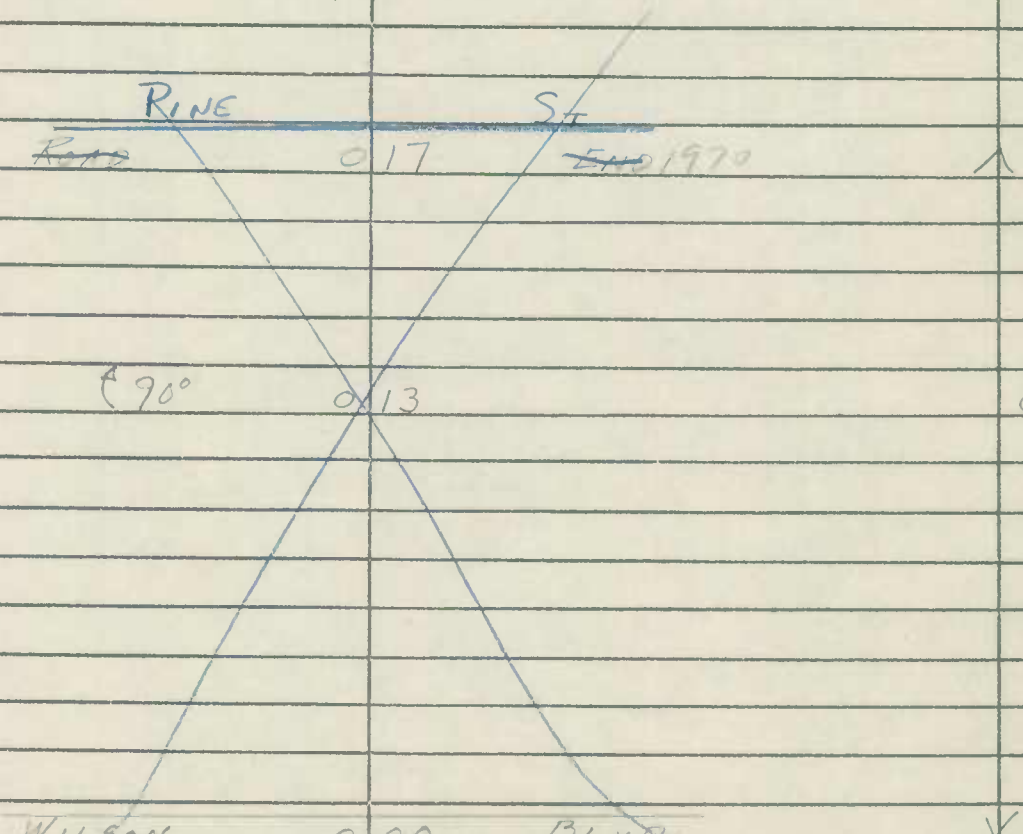

8'-0
64-7

Form 6 HPS (Rev. 1961)

M A C S

ROAD INVENTORY SHEET

Party Chief R. VOUGHT
Recorder L. OFFELT JR. VER
Chainman

7-20-76

HAGERSTOWN

Road No. 9030
Name BLOOMS ALLEY
Sheet No. 1 OF 1
Date 10-31-63
County WASHINGTON

ROAD END
0.07

ALLEY # 196

END TO TOWNHOUSES 0.02

JONATHANS ST

VS 0.00 11

10' J
12' CW

20' CW

CURB RT
10' CW

2' CW

MARKET

Form 6 HPS (Rev. 1961)

ROAD INVENTORY SHEET

PVT

Party Chief R. VOUGHT
Recorder L. OFFELT JR.
Chainman

PVT

HAGERSTOWN

Road No.
Name RD. H
Sheet No. 1 OF 1
Date 10-28-63
County WASHINGTON

Rd.
0 26 H
Pt
30
Rd 0 13
H
0 09
ENT PK. LOT 0 07
ENT PK. LOT 0 23
20'I
26'cW
Penna.
US 000 MD

SHA 51.3 - 8 Revised
4.83

MARYLAND STATE HIGHWAY ADMINISTRATION

ROAD INVENTORY SHEET

Party Chief REWRITTEN SM
Recorder
Assistant
Map No./Dir. /
State Coordinates

Road No. PVT
Road Name RD J
County WASHINGTON
Date 10-19-88
Sheet No. 1 OF 1

TRAFFIC CODES
TRAFFIC CONTROLS: STOP SIGN=SS, TRAFFIC LIGHT=T.L., FLASHING RED BALL=F.R.

TRAFFIC CODES
PARKING RESTRICTIONS: A.M. PEAK, P.M. PEAK, A.M./P.M. PEAK, NO PARKING ANYTIME=N.P., COMM/IND. ACCESS=E

SYSTEM				TRAFFIC		LINE DIAGRAM	TRAFFIC			PAVEMENT DATA
FED. AID.	FUNCT CLASS.	HWY. SYS.	HPMS SAMPLE	PRKG. REST.	COM/IND. ACCESS	HAGERSTOWN	CONTROL	COM/IND. ACCESS	PRKG. REST.	
						0 51				
						40' WALL TO WALL SLL WM P/R BLVD BURHANS 0 43 SLL				
						0 41 35°				
										14'H 18'CW
						WM P/R 50.12 90° 0 05				
						VIRGINIA AVE US 0 00 11				

SYSTEM				TRAFFIC		LINE DIAGRAM	TRAFFIC			PAVEMENT DATA
FED. AID.	FUNCT. CLASS.	HWY. SYS.	HPMS SAMPLE	PRKG. REST.	COM/IND ACCESS		CONTROL	COM/IND ACCESS	PRKG. REST.	

Form 6 HPS (Rev. 1961)

ROAD INVENTORY SHEET

PVT

Party Chief R. VOUGHT
Recorder L. COFFELT JR.
Chainman

PVT

HAGERSTOWN

Road No.
Name Rt. 5
Sheet No. 1 OF 1
Date 11-8-63
County WASHINGTON

PENNA. RR YARD

PARKING LOT

051

40' WALL TO WALL

RR

BLVD

BURHANS

43

35°

090

RR SPUR

005

14'4

VIRGINIA

AVE

18'6"

US 000 11

Form 6 HPS (Rev. 1961)

N #5 MAIN STREET
N. WEST SIDE AVE
W&E BALTIMORE STREET
FREDERICK STREET

ROAD INVENTORY SHEET

Party Chief R. VOUGHT
Recorder L. COFFELT JR.
Chairman

A-8

VERIFIED
6-18-75
W.D. & M.Z.

Road No. ALT US 40
Name FREDERICK ST
Sheet No. 1 OF 15
Date 10-21-63
County WASHINGTON

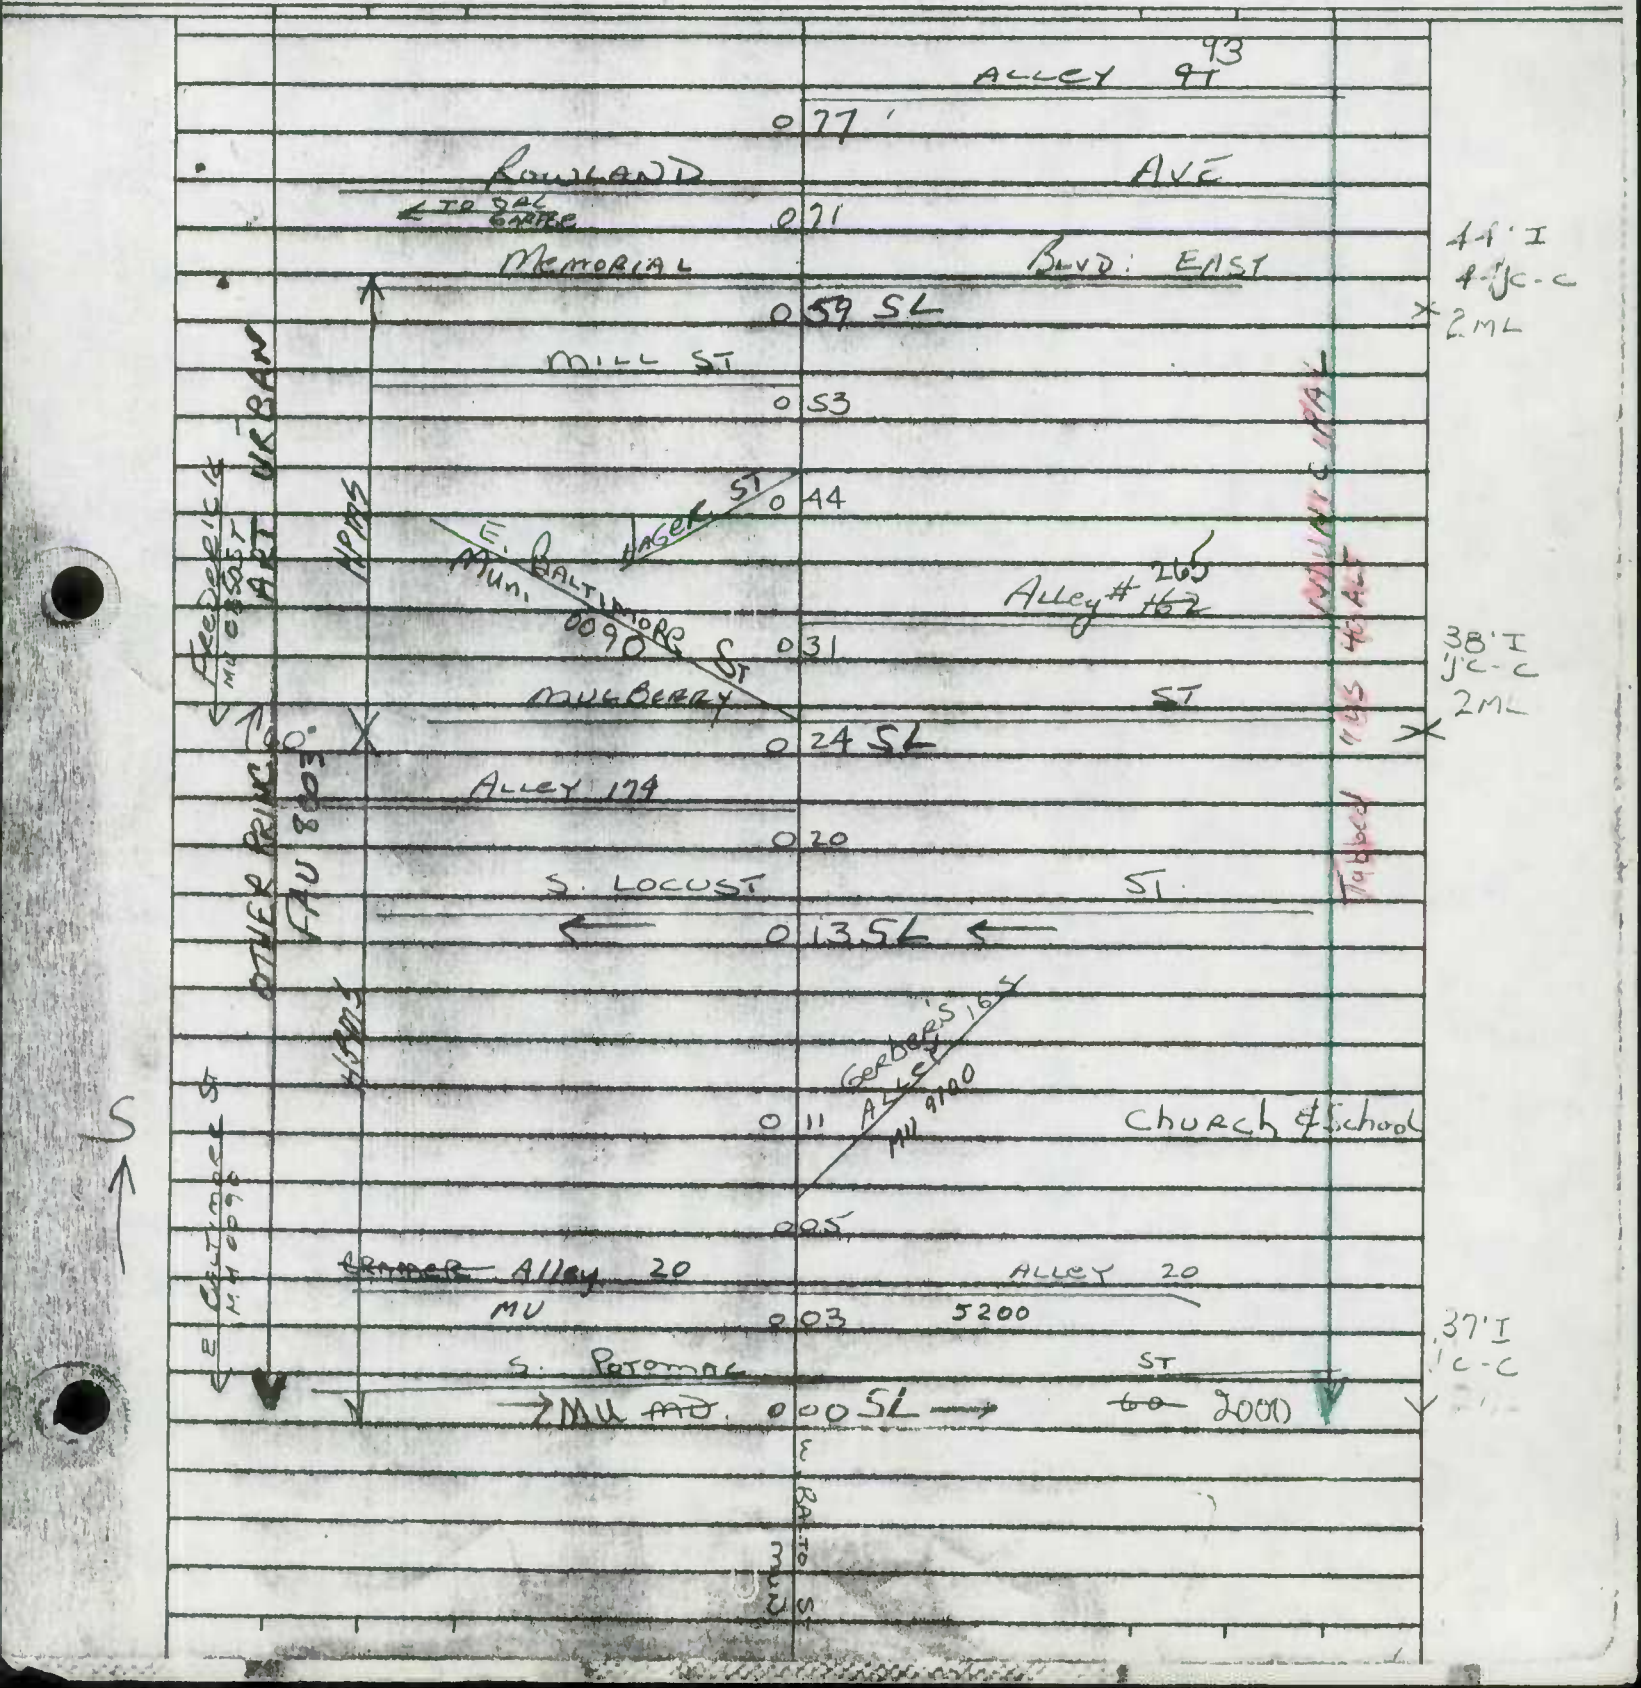

SHA 51.3-8
11-15-72

STATE HIGHWAY ADMINISTRATION OF MARYLAND

ROAD INVENTORY SHEET

Party Chief R.V
Recorder L.C
Helper

Road No. ALT. U.S. 40
Road Name FREDERICK ST
Sheet No. 2 OF 15
Date 10-21-63
County WASH
State Coordinates

Map No. A-8 — CORP LIMITS

172
HIST. SIGN
169
167
KENLY AVE
161 BEGIN DED. S.H.A. MAINT — HAGERSTOWN
156
(RD. 'C')
155
BOWMAN AVE
149
MU 0200 SPUR
147
138 E. WILSON BLVD
WILLOW CIRCLE
127
RAVENSWOOD DR
124
E. FIRST ST
107 MU 0800
COMMONWEALTH AVE
099
HAGERSTOWN MUN. SWIM. POOL 095 R X R
093 R X R
EASTERN BLVD 090 R X R
MU 0705 TL 086
TAYLOR AVE
080

HPMS
OTHER PRINCIPAL ARTERIAL
FAU 8203
HPMS

24'I
6'I SHLD LT
4'I SHLD RT
4'C.L.
2ML
48'I
SCC
2ML
30'
16'I
38'C.L.
2ML
35'I SCC LT
6'C.L.I RT
45'C.L. 2ML
Same

BO 134 1964
A.T.L.M.C. PLANT
Tabbed FAU 40 ALT

SHA 51.3 - 8 Revised
4.83

MARYLAND STATE HIGHWAY ADMINISTRATION

ROAD INVENTORY SHEET Co 940

Party Chief Rewritten TM
Recorder
Assistant
Map No./Dir. 1 E
State Coordinates

Road No. MU 0030
Road Name CANAL Rd
County WASHINGTON
Date 10-4-88
Sheet No. 1 OF 2

TRAFFIC CODES
TRAFFIC CONTROLS: STOP SIGN=SS, TRAFFIC LIGHT=T.L., FLASHING RED BALL=F.R.

TRAFFIC CODES
PARKING RESTRICTIONS: A.M. PEAK, P.M. PEAK, A.M./P.M. PEAK, NO PARKING ANYTIME=N.P., COMM/IND. ACCESS=E

SYSTEM				TRAFFIC		LINE DIAGRAM	TRAFFIC			PAVEMENT DATA
FED. AID.	FUNCT CLASS.	HWY. SYS.	HPMS SAMPLE	PRKG. REST.	COM/IND. ACCESS	HANCOCK	CONTROL	COM/IND. ACCESS	PRKG. REST.	
	CO. URBAN					1 49				
						CORP Limits HANCOCK				
						1 26				
						0 62 45°				
						30° 0 58				
						0 03				15' I +4' E 20' CW
						LOCKER Rd 0 00 CO 31				
						32 CO				

Hancock

SYSTEM				TRAFFIC		LINE DIAGRAM	TRAFFIC				PAVEMENT DATA
FED. AID.	FUNCT. CLASS.	HWY. SYS.	HPMS SAMPLE	PRKG. REST.	COM/IND ACCESS		CONTROL	COM/IND ACCESS	PRKG. REST.		
						ROAD 2 28 EWT					
											14'E
											18'CW
						TANEY ST					
						MU 0337 2 17				X	
						WILLIAMS ST					14'G
						MU 0400 2 11					
						PENNA AVE					
						2 05				X	
						2 02 C&O HISTORICAL PARK		E			
						45 1 78 522					

SHA 51.3 - 8 Revised
4.83

MARYLAND STATE HIGHWAY ADMINISTRATION

ROAD INVENTORY SHEET Co 940

Party Chief Remsnitzer TM
Recorder
Assistant
Map No./Dir. 1 E
State Coordinates

Road No. MU 0030
Road Name CANAL Rd
County WASHINGTON
Date 10-4-88
Sheet No. 1 OF 2

TRAFFIC CODES
TRAFFIC CONTROLS: STOP SIGN=SS, TRAFFIC LIGHT=T.L., FLASHING RED BALL=F.R.

TRAFFIC CODES
PARKING RESTRICTIONS: A.M. PEAK, P.M. PEAK, A.M./P.M. PEAK, NO PARKING ANYTIME=N.P., COMM/IND. ACCESS=E

SYSTEM				TRAFFIC		LINE DIAGRAM	TRAFFIC			PAVEMENT DATA
FED. AID.	FUNCT CLASS.	HWY. SYS.	HPMS SAMPLE	PK.G. REST.	COM/IND. ACCESS	HANCOCK	CONTROL	COM/IND. ACCESS	PK.G. REST.	
	14 (CO. URBAN)					1 49				
						CORP Limits — HANCOCK				
						1 26				
						0 62 45°				
						30° 0 58				
						0 03				15' I
										+4' B
										20' CW
						LOCKER Rd				
						0 00 CO 31				
						N S				
						0				

SYSTEM				TRAFFIC		LINE DIAGRAM	TRAFFIC			PAVEMENT DATA
FED. AID.	FUNCT. CLASS.	HWY. SYS.	HPMS SAMPLE	PRKG. REST.	COM/IND ACCESS		CONTROL	COM/IND ACCESS	PRKG. REST.	
						ROAD 2 28 EWD				14'E 18'CW
						TANEY ST MU 0332 2 17				
						WILLIAMS ST MU 0400 2 11				14'G
						PENNA AVE 2 05				
						2 02 C&O HISTORICAL PARK		E		
						45 1 78 522				

SHA 51.3-8
11-15-72

STATE HIGHWAY ADMINISTRATION OF MARYLAND

ROAD INVENTORY SHEET MU 0030

Party Chief BB
Recorder ER
Helper

Map No. G 22

81-107

Road No. CO. 940
Road Name CANAL RD
Sheet No. 1 OF 1
Date 10-28-82
County WASH
State Coordinates 459 - 675

ROAD	2	2428	END
TANEY ST. MU. 132	2	1417	
WILLIAMS ST. MU. 400 →	2	0811	
PENNA. AVE. MU. 280	2	0205	
	2	0002	ENT. C+O CANAL HISTORICAL PARK LITTLE TONNELWAY
US	1	7578	
			522
CHURCH + CEM.	1	5659	
CORP LIMITS	1	4649	HANCOCK
	1	2326	
	0	5962	
	0	5555	
LOCKER RD CO 32	0	0031	LOCKER RD

HANCOCK MU. 30

14'E
18'CW
14'G
20'CW
45°
30°
E
N
W
S

SHA 51.3 - 8 Revised
4.83

MARYLAND STATE HIGHWAY ADMINISTRATION

ROAD INVENTORY SHEET CO 940

90-9 3-18-91
GD/TM

Party Chief B.B
Recorder F.R
Assistant Rewritten JEL 11-19-90
Map No./Dir. 1 E
State Coordinates 459-675

Road No. MU 0030
Road Name ~~Gen'l~~ ~~Rt~~ BERM RD
County Washington
Date 10-4-88
Sheet No. 1 OF 4

TRAFFIC CODES
TRAFFIC CONTROLS: STOP SIGN=SS, TRAFFIC LIGHT=T.L., FLASHING RED BALL=F.R.

TRAFFIC CODES
PARKING RESTRICTIONS: A.M. PEAK, P.M. PEAK, A.M./P.M. PEAK, NO PARKING ANYTIME=N.P., COMM/IND. ACCESS=E

SYSTEM				TRAFFIC		LINE DIAGRAM	TRAFFIC			PAVEMENT DATA
FED. AID.	FUNCT CLASS.	HWY. SYS.	HPMS SAMPLE	PRKG. REST.	COM/IND. ACCESS		CONTROL	COM/IND. ACCESS	PRKG. REST.	
						HANCOCK				
						SEE ROAD INVENTORY OF CO 940				
						CO 940				15' I
										20' CW
NON-FIA										
LOCAL Urban										
						0.03 90°				
						#CSX832435S				
						Locker Rd				
						CO 31				
K	K									
						Locker Rd CO 31				

SYSTEM: FED. AID. | FUNCT. CLASS. | HWY. SYS. | HPMS SAMPLE

TRAFFIC: PRKG. REST. | COM/IND ACCESS

LINE DIAGRAM

TRAFFIC: CONTROL | COM/IND ACCESS | PRKG. REST.

PAVEMENT DATA

30

MU

1 49 site of old Corp. Limits X

County urban

↑ Corp Lmts — HANCOCK →

1 216

15' I

20' (W)

940

CO

0 162 45° ↑

↑ 30°

0 158

NON FA
Local Option

SHA 51.3 - 8 Revised
4.83

MARYLAND STATE HIGHWAY ADMINISTRATION

ROAD INVENTORY SHEET MU0030

Party Chief Rewritten JEL
Recorder
Assistant
Map No./Dir. 1 E
State Coordinates

Road No. CO940
Road Name ~~Canal Rd~~ BERM RD
County Washington
Date 10-4-88
Sheet No. 3 OF 4

TRAFFIC CODES
TRAFFIC CONTROLS: STOP SIGN=SS, TRAFFIC LIGHT=T.L., FLASHING RED BALL=F.R.

TRAFFIC CODES
PARKING RESTRICTIONS: A.M. PEAK, P.M. PEAK, A.M./P.M. PEAK, NO PARKING ANYTIME=N.P., COMM/IND. ACCESS=E

SYSTEM				TRAFFIC		LINE DIAGRAM	TRAFFIC			PAVEMENT DATA
FED. AID.	FUNCT CLASS	HWY. SYS.	HPMS SAMPLE	PRKG. REST.	COM/IND. ACCESS		CONTROL	COM/IND. ACCESS	PRKG. REST.	
						HANCOCK				
						Williams St.				
						MU 0400 2 11				
						PENNSYLVANNIA ~~AVE~~				
						MU 0280 2 05				
						2 02 Ent C & O CANAL H. Stor. al PARK - LITTLE TONOLOWAY				
						30				
						MU				
						Hurfordsburg Rd				15' I
						US 40 78				20' (4L)
						522 0.41				
						NON FA Local Urban				

LINE DIAGRAM

SYSTEM				TRAFFIC		TRAFFIC			PAVEMENT DATA
FED. AID.	FUNCT. CLASS.	HWY. SYS.	HPMS SAMPLE	PRKG. REST.	COM/IND ACCESS	CONTROL	COM/IND ACCESS	PRKG. REST.	
NON F/A									
Local Urban									
									14' E
									18' CW
								X	
									15' I
									20' CW

Road 2128 End

Taney St
MU 0330 2117

30

MU

Form 6 HPS (Rev. 1961)

CP 4

ROAD INVENTORY SHEET

Mun. No. 0030

Party Chief R. VAUGHT
Recorder L. COFFELT JR
Chainman

VERIFIED 6-22-76

Road No. Co 32
Name Canal St
Sheet No. 2 of 2
Date 8-7-63
County WASHINGTON

COPY 12/6/63 NS Dec. E.T.S.

RE-Written SEE NEW 78-11

Inventory

	ROAD	END	
		378	
TANEY ST			14'E
MUN 330		368	18'CW
WILLIAMS ST			14'H
MUN		362	~~16'E~~
PENN AVE			16'CW
MUN		356	
30°		354	
US			16'H
			20'CW
		349	~~14'E~~
			~~20'C.W.~~
APP Corp Limits		~~378~~ 300	CE HANCOCK
~~CORP~~ Limits		~~222~~	Hancock 522
CHURCH & CEM	2	12	
	2	27	DRAIN
H	2	20	
H H	2	19	
H	2	18	
H	2	17	
H	2	15	
	2	13	45° DR SAME

HANCOCK MUN.

SHA 51.3-8
11-15-72

ROAD INVENTORY SHEET

MUN 0090

Road No. ~~Co. 749~~
Road Name Creek Rd.
Sheet No. 2 OF 3
Date
County WASHINGTON
State Coordinates

	1971 ANNEX		
	2 18	INTERSECT	PT
H	2 12		80°
	2 09		PC
PT	2 04		
40° H-100' H	2 00		
PC	1 97		
~~PVT RD~~	KIRK Fkem RD		
F ~~9'D~~	1 74 MU 0197 H		
	1 64		PT
H	1 61		30°
H	1 58		PC
	1 55		24" CMP
US	48		
PT US	1 45 ~~40~~		E EAST
	1 46 48		
	1 43 40		E WEST
			SAME
30°	1 42		
			20' I
			30' CW
			2 mi.

SHA 51.3-8
11-15-72

STATE HIGHWAY ADMINISTRATION OF MARYLAND

ROAD INVENTORY SHEET

MUN 0090

Party Chief E. SCHUYLER
Recorder C. FORREST
Helper M. BAXTER - OFF. INV.

Map No. 22

Road No. ~~CO. 749~~
Road Name Creek Rd.
Sheet No. 3 OF 3
Date
County WASHINGTON
State Coordinates

REVISED 4-25-74 Round Top Rd to #2

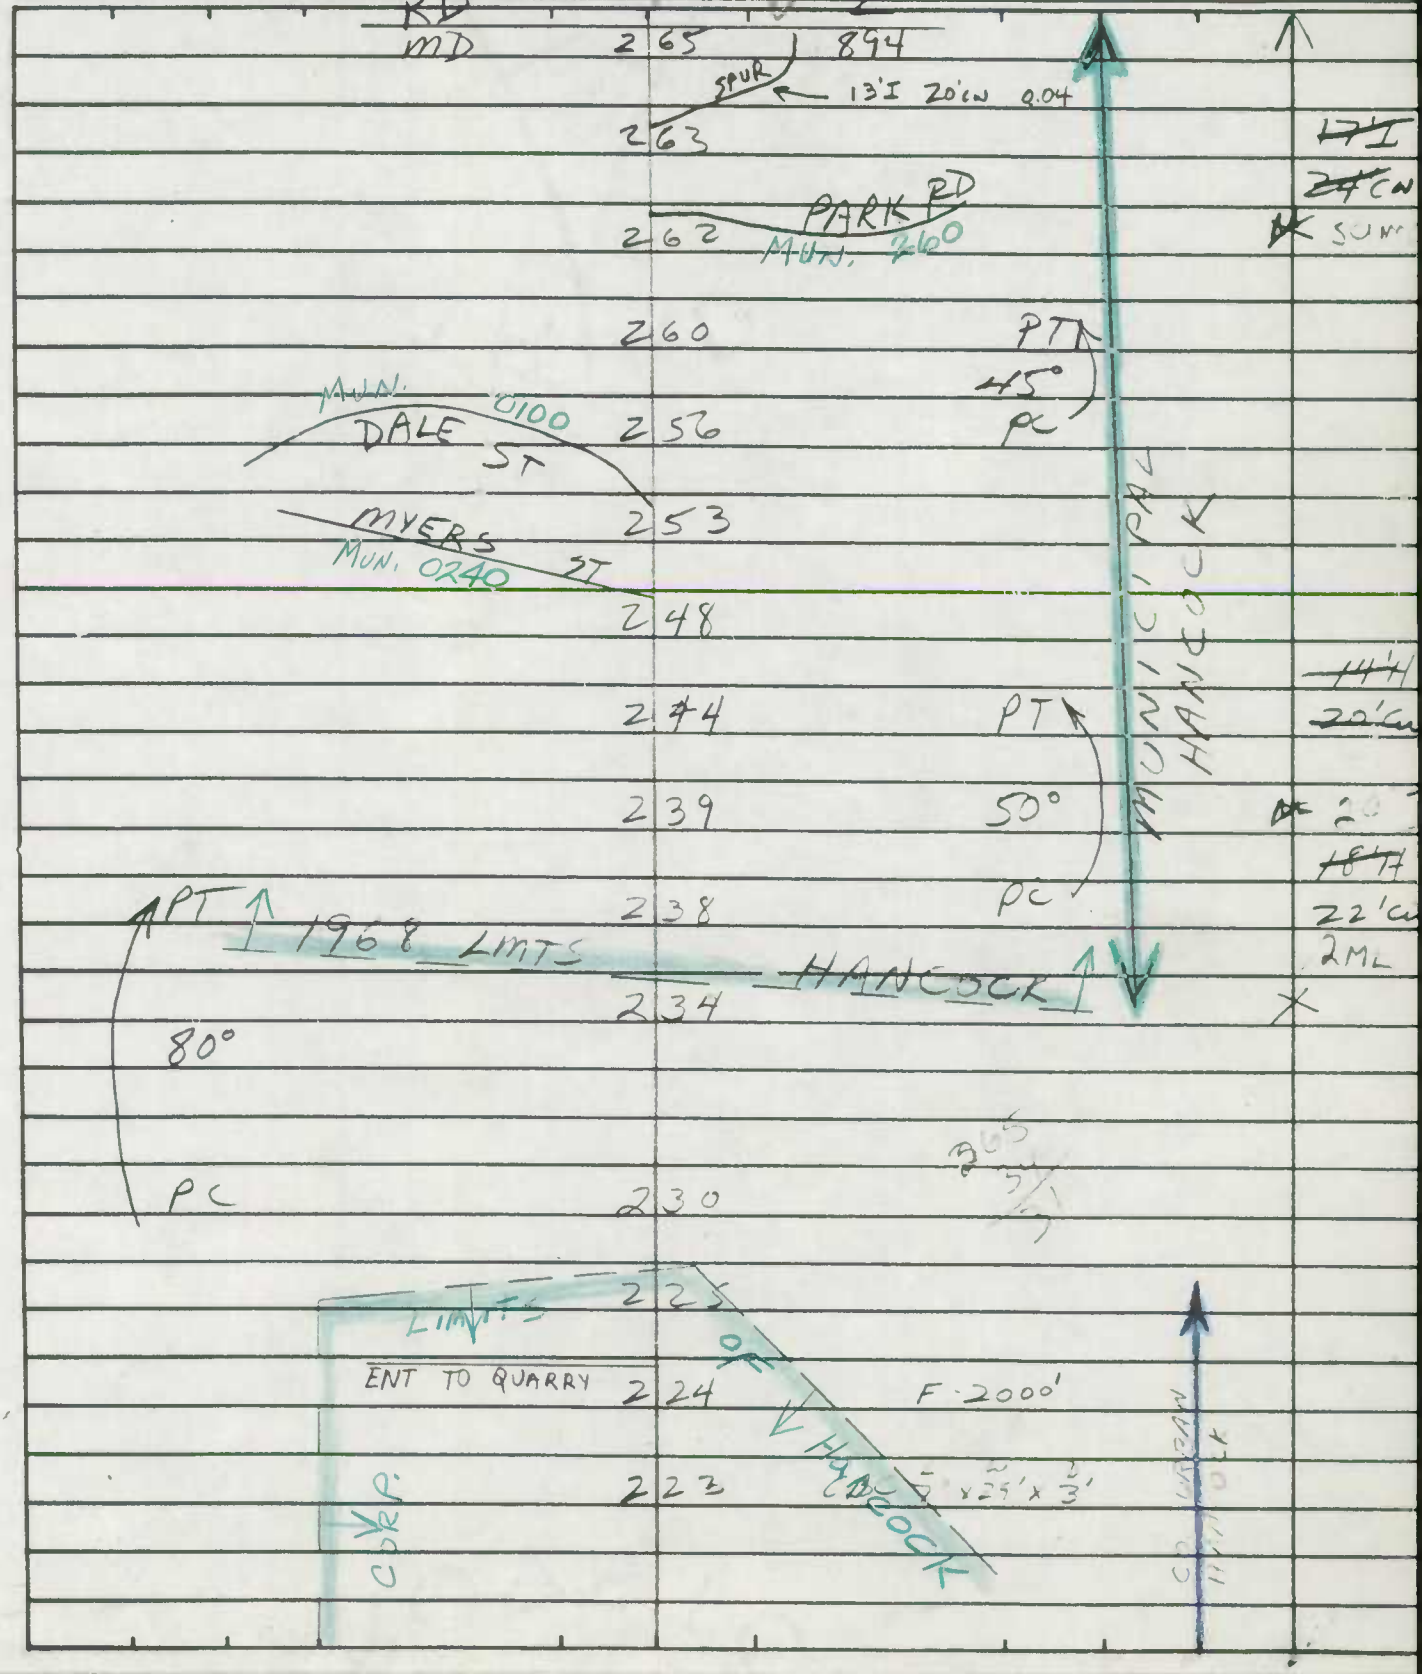

Form 6 HPS (Rev. 1961)

ROAD INVENTORY SHEET

R. VOUGHT

Party Chief L. COFFELT JR.

Recorder

Chainman

HANCOCK

VER. 7-13-76

Road No. 0140

Name FULTON ST

Sheet No. 1 OF 1

Date 8-8-63

County WASHINGTON

74-4

Penna.			Ave.	
MUN.	0	41	280	25'I J-CURB LT 28'CW 22'SG 28'CW
	0	38	90	28'XI J-C-C
	0	35		28'XI CURB LT 32'CW
ROGER ST.			HILLSIDE RD	
	0	28		20'I 22'CW 25'I J-CURB 28'CW
	0	19		
WABASH ST				
	0	14		
ALLEY 1				
	0	11		25'I J-C-C
HIGH			ST	
	0	07		
MUN. PARKING	0	06		17'XI CURB RT
	0	04		17'XI CURB RT
	0	03		17'XI C-C
MAIN			ST	
~~HS~~	0	00	40	
Md.			144-RWB	

SHA 51.3-8
11-15-72

STATE HIGHWAY ADMINISTRATION OF MARYLAND

Hancock

ROAD INVENTORY SHEET

Party Chief W. DANIELOSKI
Recorder M. ZALENSKI
Helper

Map No. G22

Road No. Co. 751
Road Name HESS RD
Sheet No. 1 OF 1
Date 6-22-76
County WASH.
State Coordinates 472-687

	COUNTY LANDFILL			
	0.75 END			
	0.73			
	ROAD END			
190°	GATE 0.64	ENT TO LANDFILL		
	0.60		20°	
120°	H 0.47			
	0.33		15°	
PT 25° PC	0.27			
	CORP Limits 0.21 of Hancock			
	0.13			
	0.12	H	PT 35° PC	
	0.09	H		
H	0.07			22 I
H	0.05			2 ML
	FENCE			
ROBINSON RD CO 76	0.00 CO 25 909			

E

SHA 51.3-8
11-15-72

STATE HIGHWAY ADMINISTRATION OF MARYLAND

ROAD INVENTORY SHEET

Party Chief E. SCHLOSSER
Recorder C. FORREST
Helper M. BAXTER - OFF. INV.

Map No. _____

REVISED 4-25-74

Road No. CO. 751
Road Name SENSEL RD.
Sheet No. 1 OF 2
Date 12-9-65
County WASHINGTON
State Coordinates 475 - 635

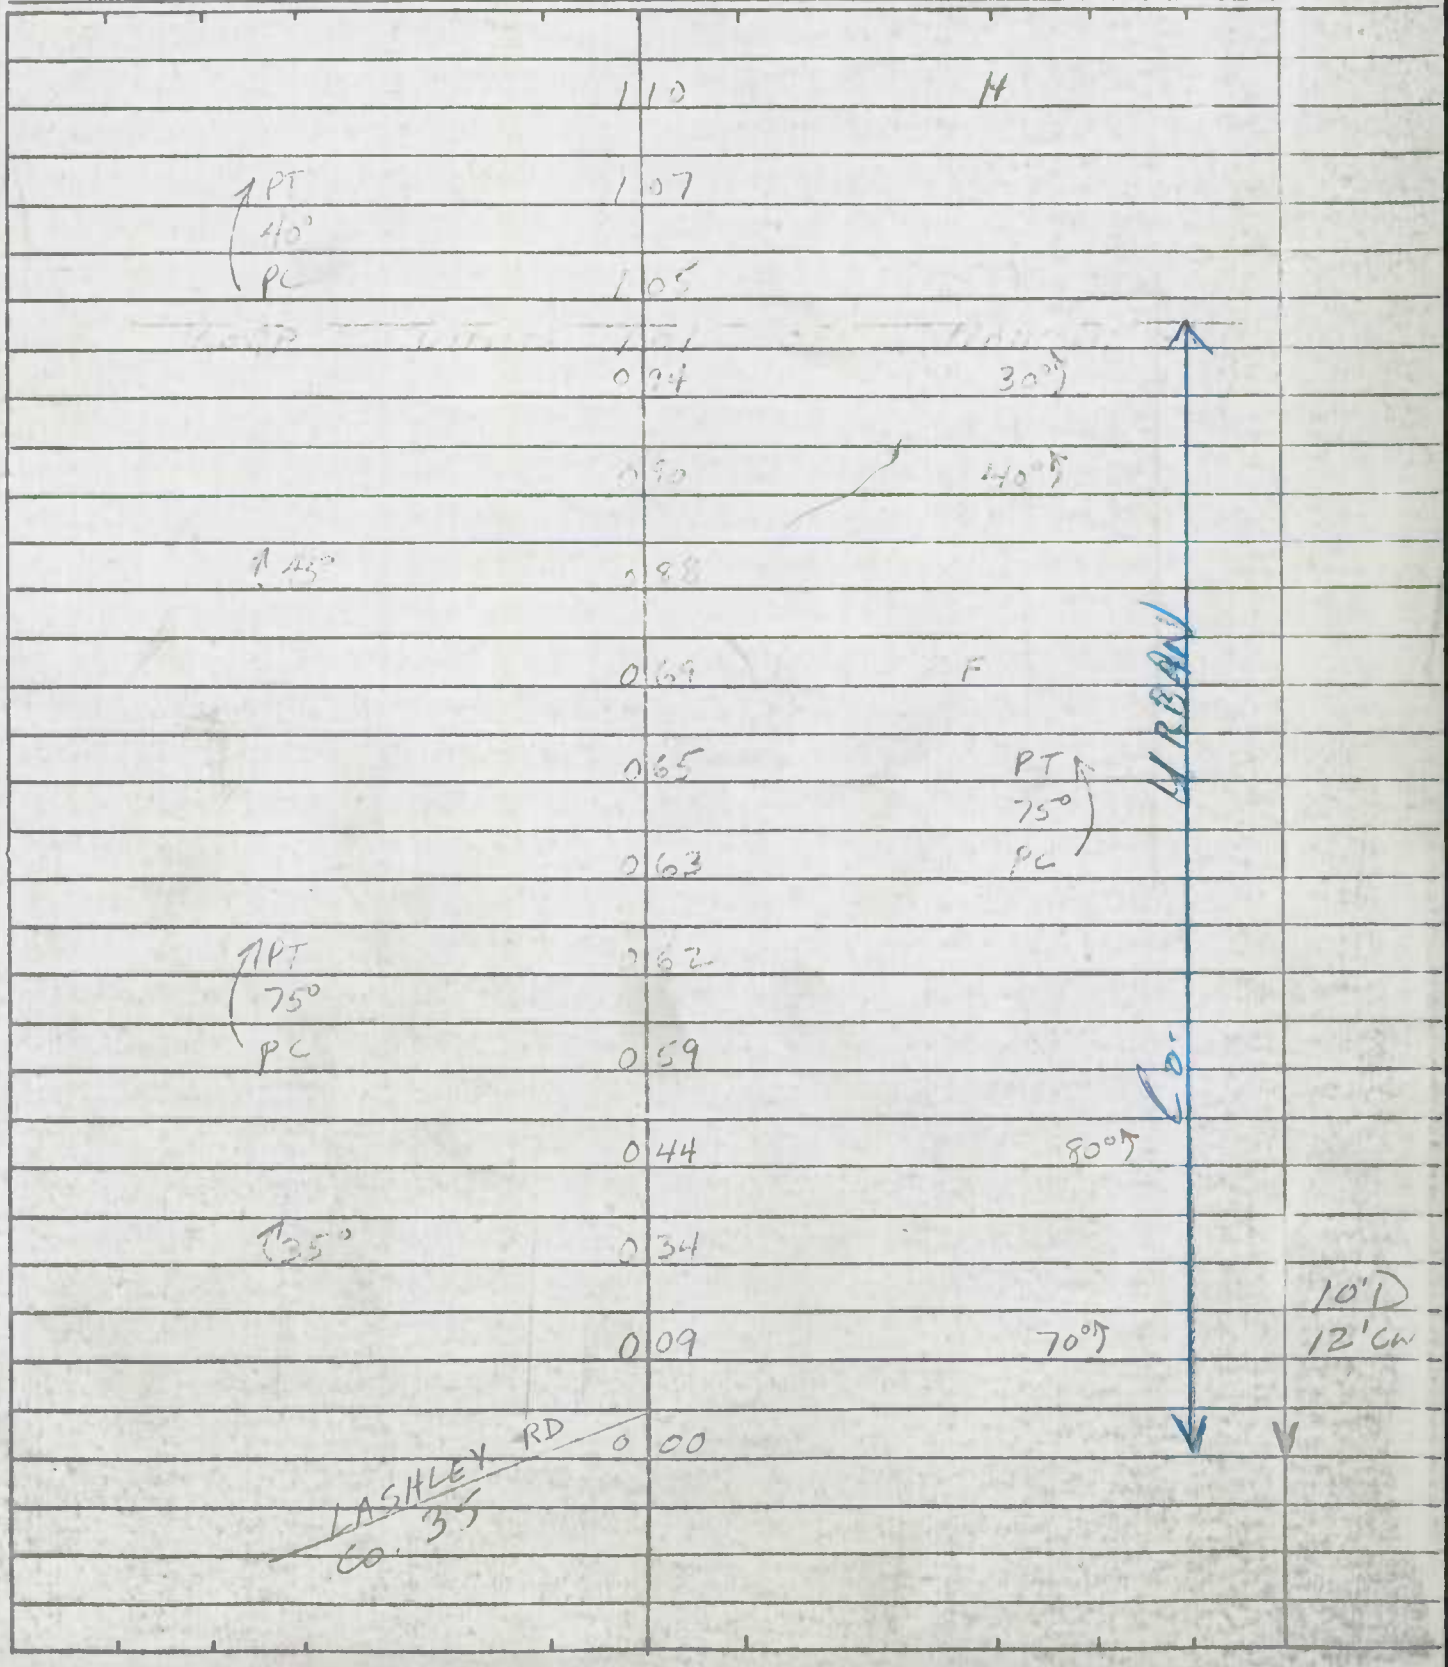

Form 6 HPS (Rev. 1961)

93 MU. EX. #8
3-15-94
AL/TM

ROAD INVENTORY SHEET

MUN. No. 0170

Party Chief R. VOUGHT
Recorder L. COFFELT JR
Chainman

VER. 6-11-75

Rev. 6/9/94 D. Bochenek HANCOCK

Road No. ~~DAD 735~~
Name HIGH ST.
Sheet No. 1 OF 1
Date 8-8-63
County WASHINGTON

US 522

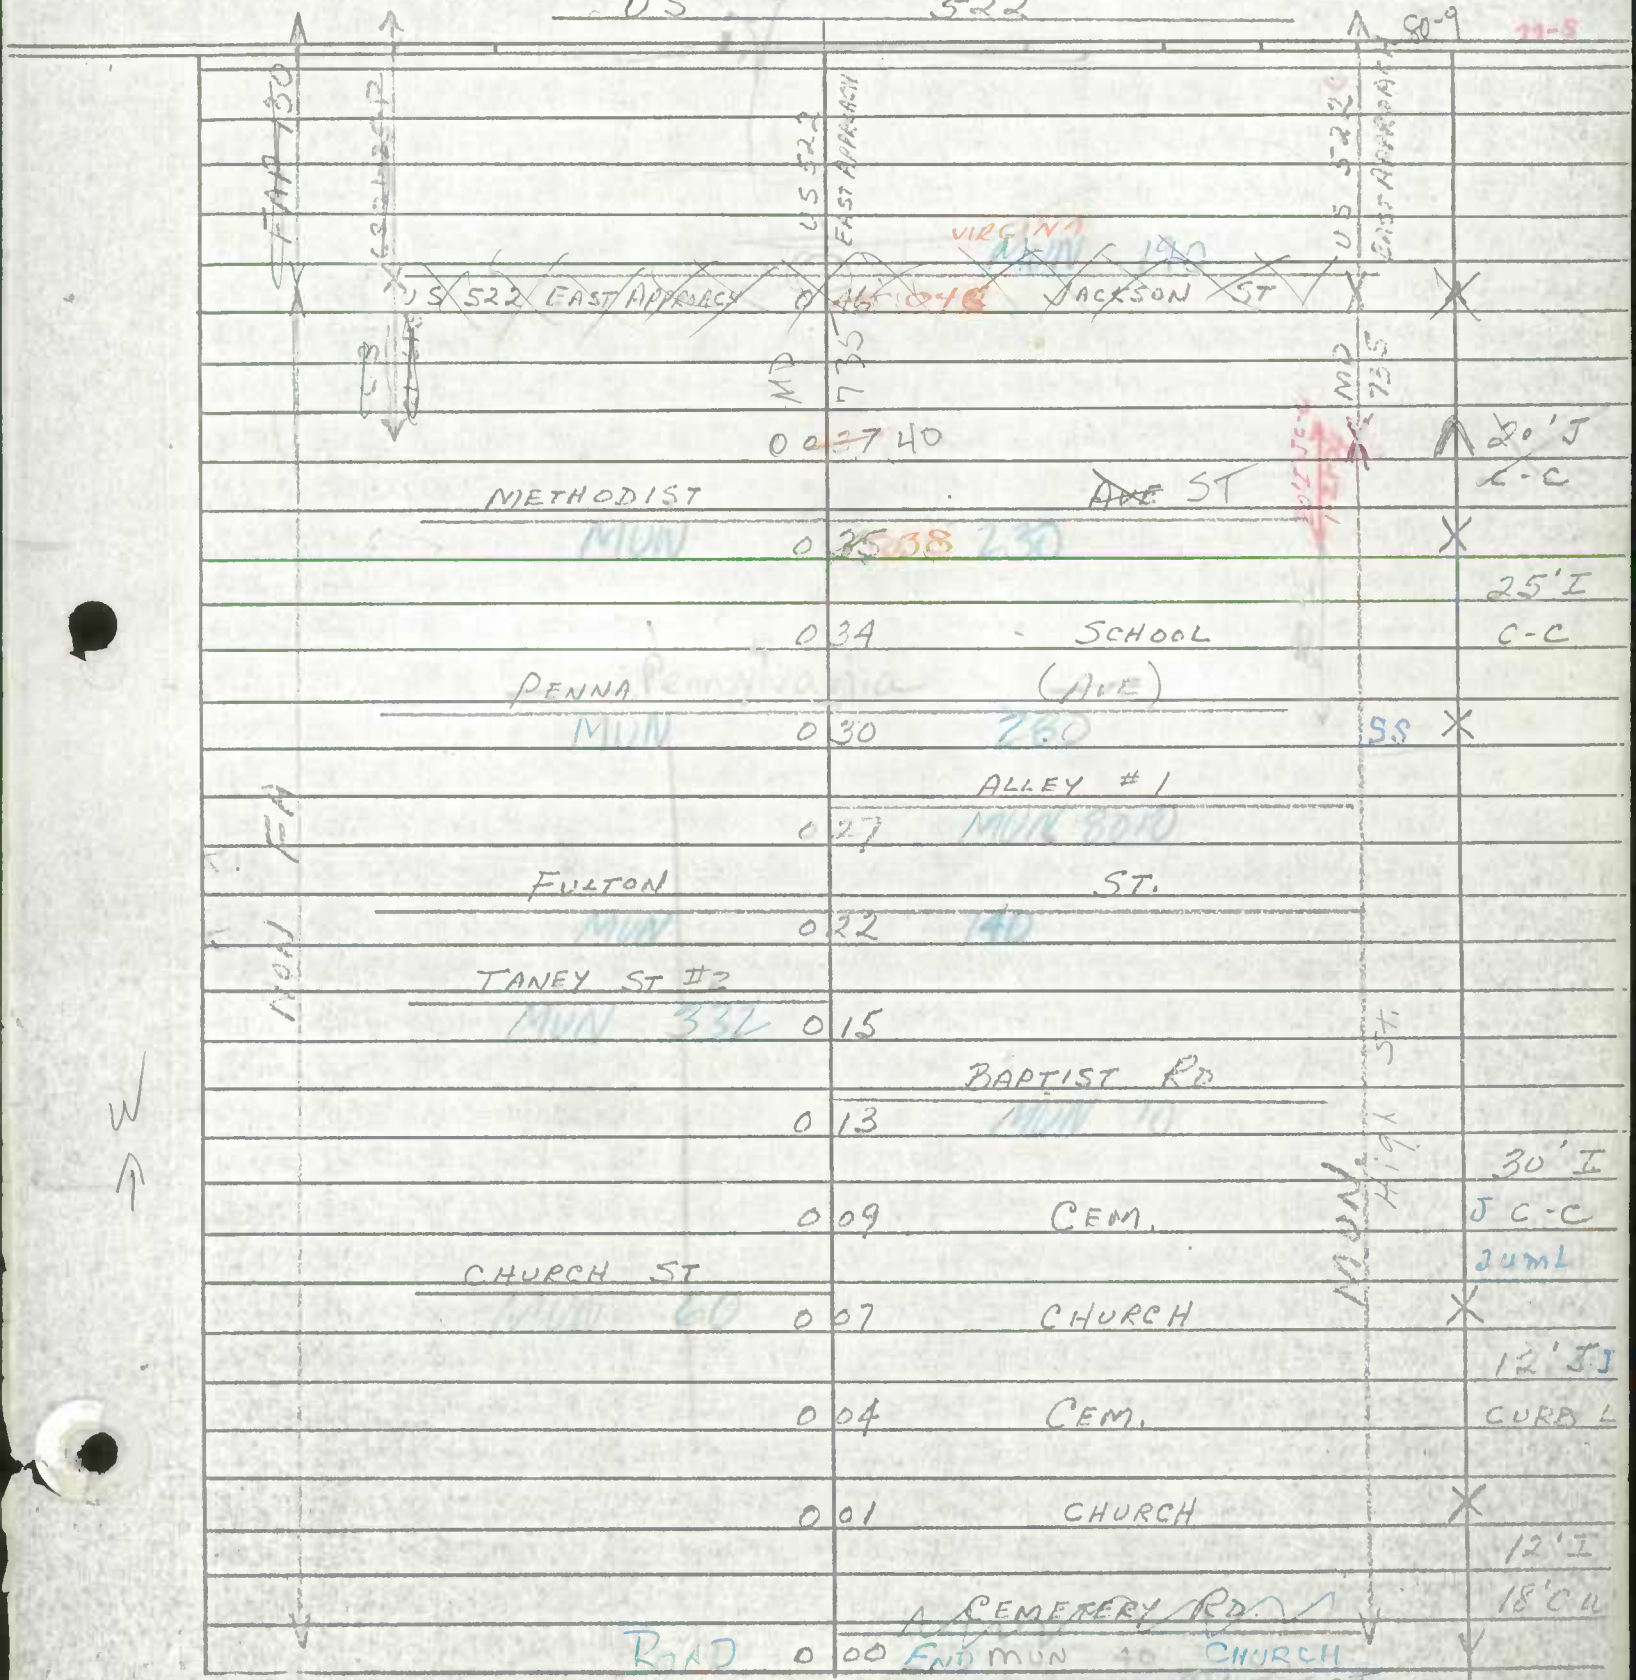

Form 6 HPS (Rev. 1961)

ROAD INVENTORY SHEET

Party Chief R. Vought
Recorder L. Coffelt, Jr
Chainman

VER 7-13-76

Road No. 0190
Name Jackson St.
Sheet No. 1 of 1
Date 8-8-63
County Wash.

SEE NEW INVENTORY
90-5 3-12-91 GD/TM

Road End
0+13

VIRGINIA
MU

0+80

90°

SHA 51.3-8
11-15-72

STATE HIGHWAY ADMINISTRATION OF MARYLAND

PC-79
93 Co. Ex. #17
3-15-94
AL/TM

ROAD INVENTORY SHEET

Party Chief DT
Recorder ER.
Helper

Map No. GH 22

78-9
HANCOCK

Road No. MUN. 0225
Road Name (McKINLEY DR.)
Sheet No. 1 OF 1
Date 4-17-79
County WASH.
State Coordinates

91-2 XT

VOID

SEE NEW INVENTORY
3-15-94

	ROAD 0	42 END	
PT (180° ~~160°~~ OP	0	37	
	0	36	
PC ENT Trailer Park 93 MH. Ex. #5	0	34	
	0	27	45° ↑
OP of 93 MH. Ex. #5A	0	22	
	0	20	PT 90° PC
	0	17	
(TERRACE HGTS. DR) MUN. 0335 78-10	0	12	
PT 30° PC	0	09	
	0	05	
	0	02	40° ↑ 20'I 26'CW
~~TOLLGATE TIMER~~ RD. ~~CO.~~	0	00 38	55

N ↑

SHA 51.3-8
11-15-72

ROAD INVENTORY SHEET

Road No. _____
Road Name _____
Sheet No. _____
Date _____
County _____
State Coordinates _____

Form 6 HPS (Rev. 1961)

ROAD INVENTORY SHEET

MUN. No. 0280

Party Chief R. VOUGHT
Recorder L. COFFELT JR.
Chainman

VERIFIED 6-22-76

Road No. CO 33
Name PENN AVE
Sheet No. 1 OF 4
Date 8-8-63
County WASHINGTON

COPY 12/6/63 AS PER E.T.S

80-11 78-12 77-1 77-3,4

FULTON ST.

0 45 MU 0140

NOTE

22'H
30'CW

0 42

OPEN

0 40 HANCOCK POST OFFICE

0 35 ROGER ST HANCOCK SUB-STATION 37' I

0 34 MU 0240 1c-c

MU 00 COVER ST.

0 33 28' I SAME RIGHT

MU 30

FRANKLIN ST 0 30 same

ALLEY MUN. 3 9030 MU 27

WASHINGTON ST 0 24 MUN 380

WABASH 0 21 ST

MUN 170

HIGH 0 14 ST 22' I CURB LEFT

0 12 22' I 1c-c

0 10 NOTE 22'H 1c-c

EAST MAIN ST.

D. S. MO 0 07 40 144 WB 22'H 30' CW

FLASHING SIGNALS

W. M. 0 03 R.R. 3 TRACKS FLASHING SIGNALS

EQUAL BCRM MUN 832 ST. 431 RD 20'H 30'CW

40 0 00 30 32

MA-TOE COLLECTOR FAS 1039

RURAL

URBAN

Form 6 HPS (Rev. 1961)

ROAD INVENTORY SHEET

Party Chief E. Schuyler
Recorder C. Forrest
Chainman

Road No. C033
Name
Sheet No. 2 OF 4
Date 12-8-65
County Ashe

CORD LATH

HANCOCK

0 97
0 88 B-Clothing Factory
0 86
0 82 NO NAME 18'E FLEMING TRAILER CRT
0 81 HANCOCK

24'I
~~21'I~~
~~20'H~~ 28'CW
18'H 21'CW
~~20'H~~ 30'CW
~~20'I~~ 30'CW
31'I 30'C-C

UD URBAN

F
~~ARP Lots~~

0 74
0 66
0 65
0 61

OLD BAPTIST RD #3

RESLEY ST
~~U.S. 221-II~~ Co. 712
~~and 421~~

MAJOR COLLECTOR RURAL 1039

I
0 58 TO ~~EAST~~ WEST
SCHOOL HWY
25'+ OVER 40' PILLAR TO PILLAR

D.D.
0 57

I
0 56 TO ~~WEST~~ EAST
25'+ OVER
40' PILLAR TO PILLAR

0 55

0 53 BAPTIST RD
MU 0010

MU 0110
DOUGLAS ST 0 49

MUN. HANCOCK

SAME

Form 6 HPS (Rev. 1961)

ROAD INVENTORY SHEET

Party Chief E. Schuyler
Recorder C. Forrest
Chainman

Road No. Co 33
Name
Sheet No. 3 of 4
Date 12-8-65
County WASH

	H	1 75	
		1 73	DR
		1 71	F
		Corp Limits 1 62 of Hancock	
		1 56	DR.
		1 47	F
		1 37	DR.
		1 26	DR
		Corp Limits of Hancock	
		1 25	H
		1 18	H
		1 16	DR
		1 15	H
		1 08	
		1 04	
		1 01	H H
		1 00	H
		0 99	6" Cmp

Water Collector Route
FAS 1039

County Urban

PC
6"
3%
PT
30°
PC

18'H
22'Cw

Form 6 HPS (Rev. 1961)

ROAD INVENTORY SHEET

Party Chief E. Schuyler
Recorder C. Forbes
Chainman

Road No. C033
Name
Sheet No. 4 of 4
Date 12-8-65
County WASH

PA MD

STATE LINE STATE LINE

SAME SAME

E-300' H

SAME

Form 6 HPS (Rev. 1961) Hancock MUN. NO. 0350

ROAD INVENTORY SHEET

Party Chief R. VAUGHT
Recorder L. CAPPELLI Jr
Chainman

VER 6-23-76 MP 4.60

Road No. CO 38
Name Timbex Ridge Rd
Sheet No. 1 OF 2
Date 8-9-63
County WASHINGTON

80-6

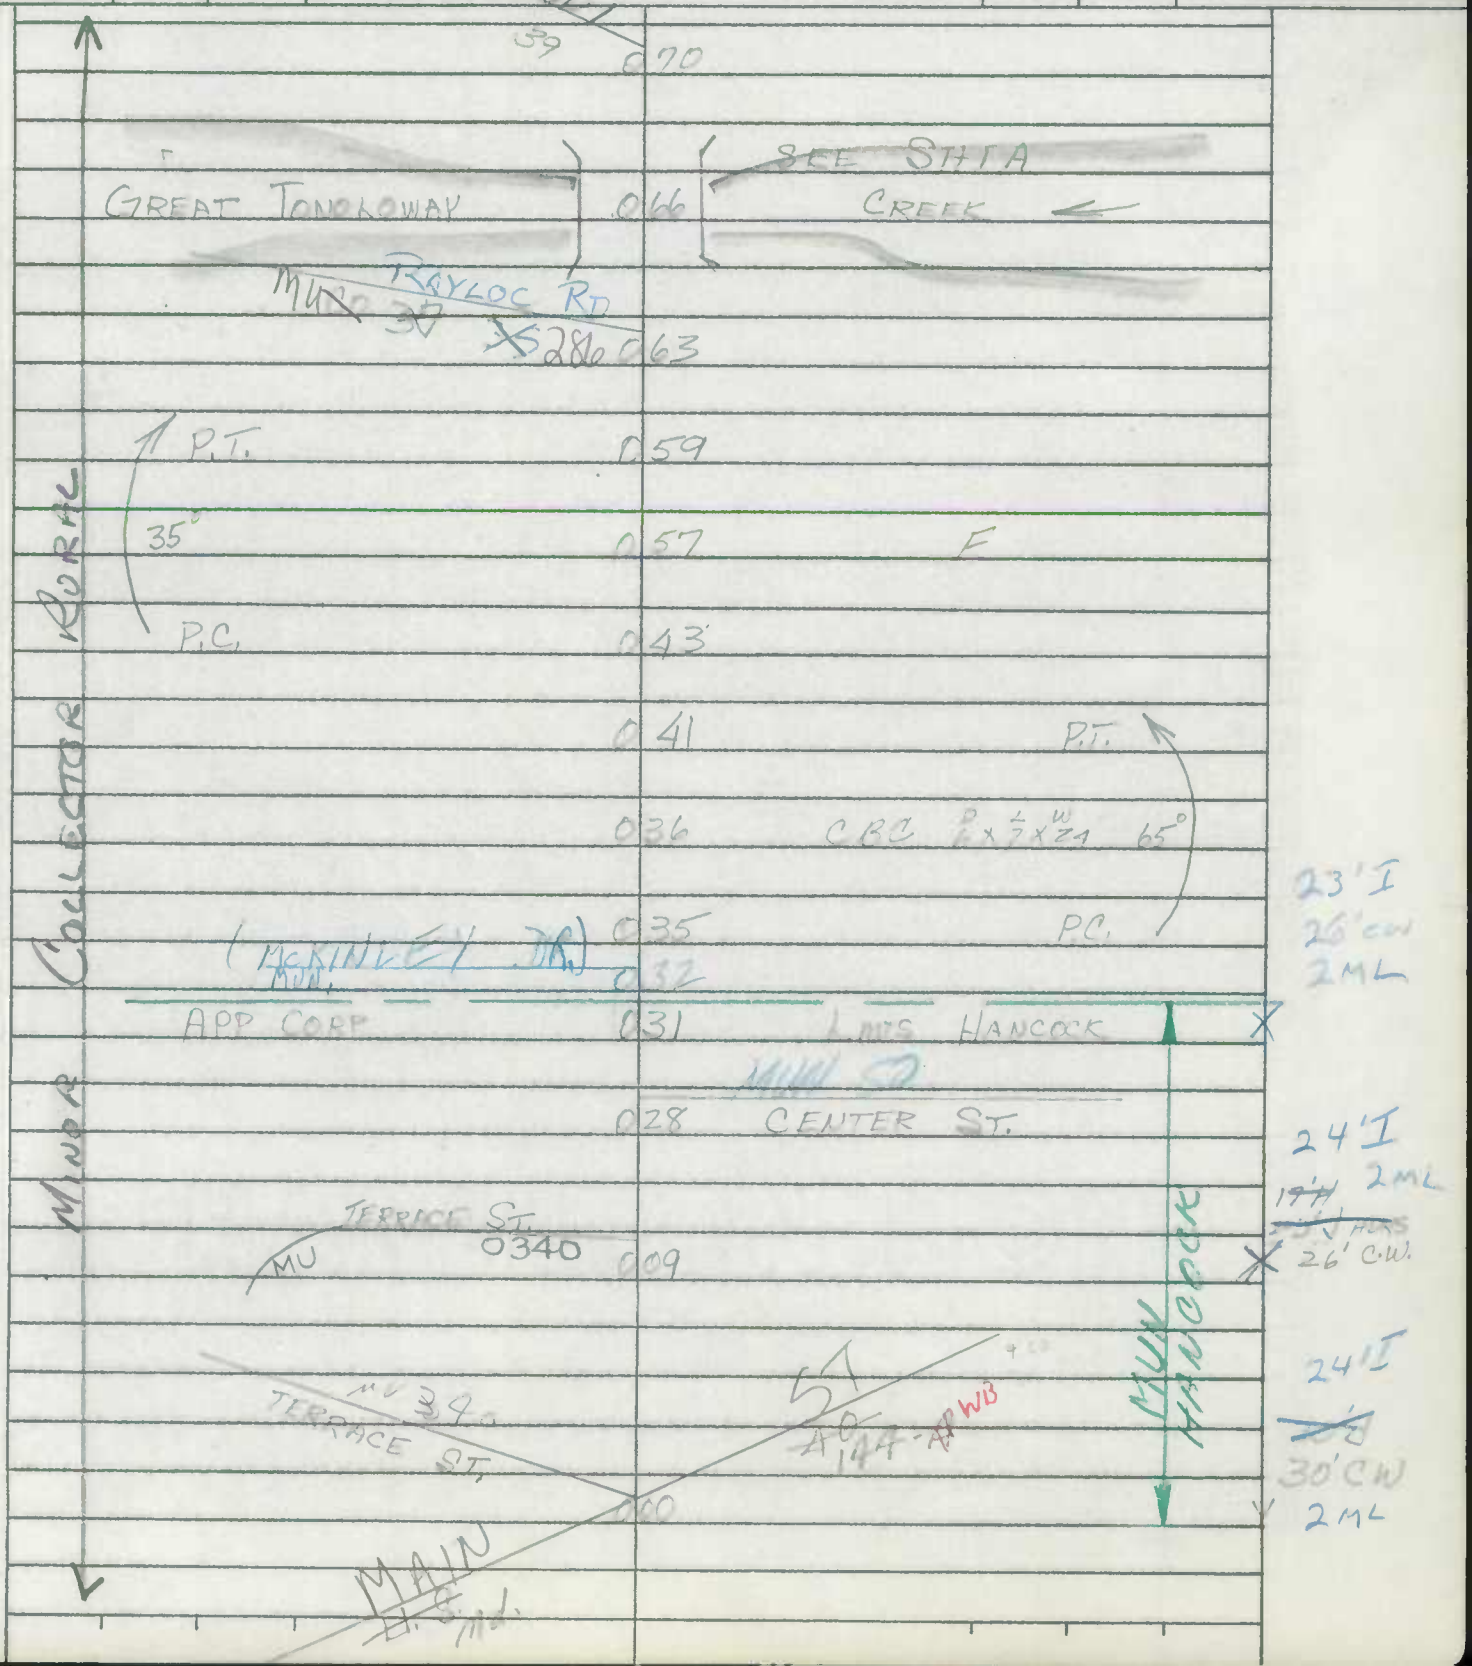

23'I
26'CW
2ML

24'I
2ML
26' C.W.

24'I
30'CW
2ML

SHA 51.3 - 8 Revised
4.83

Hancock

MARYLAND STATE HIGHWAY ADMINISTRATION

ROAD INVENTORY SHEET

MU 8090

Party Chief _____
Recorder _____
Assistant _____
Map No./Dir. /
State Coordinates _____

Road No. OP 39
Road Name ~~Alley A~~ Century La
County Washington
Date _____
Sheet No. _____ OF _____

SYSTEM				TRAFFIC		LINE DIAGRAM	TRAFFIC			PAVEMENT DATA
FED. AID.	FUNCT CLASS.	HWY. SYS.	HPMS SAMPLE	PRKG. REST.	COM/IND. ACCESS		CONTROL	COM/IND. ACCESS	PRKG. REST.	

SEE INVENTORY OF

MU ~~8090~~

~~Alley "A"~~ Century La

Hancock (96 mm ex #5)

* Route number "OP 39" Reassigned 3-2-71 by GJG - previous OP 39 now Co 691 (68-55)

TRAFFIC CODES

TRAFFIC CONTROLS: STOP SIGN=SS, TRAFFIC LIGHT=T.L., FLASHING RED BALL=F.R.

TRAFFIC CODES

PARKING RESTRICTIONS: A.M. PEAK, P.M. PEAK, A.M./P.M. PEAK, NO PARKING ANYTIME=N.P., COMM/IND. ACCESS=E

SYSTEM				TRAFFIC		LINE DIAGRAM	TRAFFIC			PAVEMENT DATA
FED. AID.	FUNCT. CLASS.	HWY. SYS.	HPMS SAMPLE	PRKG. REST.	COM/IND ACCESS		CONTROL	COM/IND ACCESS	PRKG. REST.	

Form 6 HPS (Rev. 1961)

90-3,4
3-6-91
GD/TM

MUN. No. 0030 - ~~0049~~

ROAD INVENTORY SHEET

Party Chief R. VOUGHT
Recorder L. COFFELT JR.
Chainman

VERIFIED
7-1-76

MP 6.84

Road No. Co 637
Name COFFMAN LANE (COFFMAN RD.
Sheet No. 1 OF 1
Date 10-9-63
County WASHINGTON

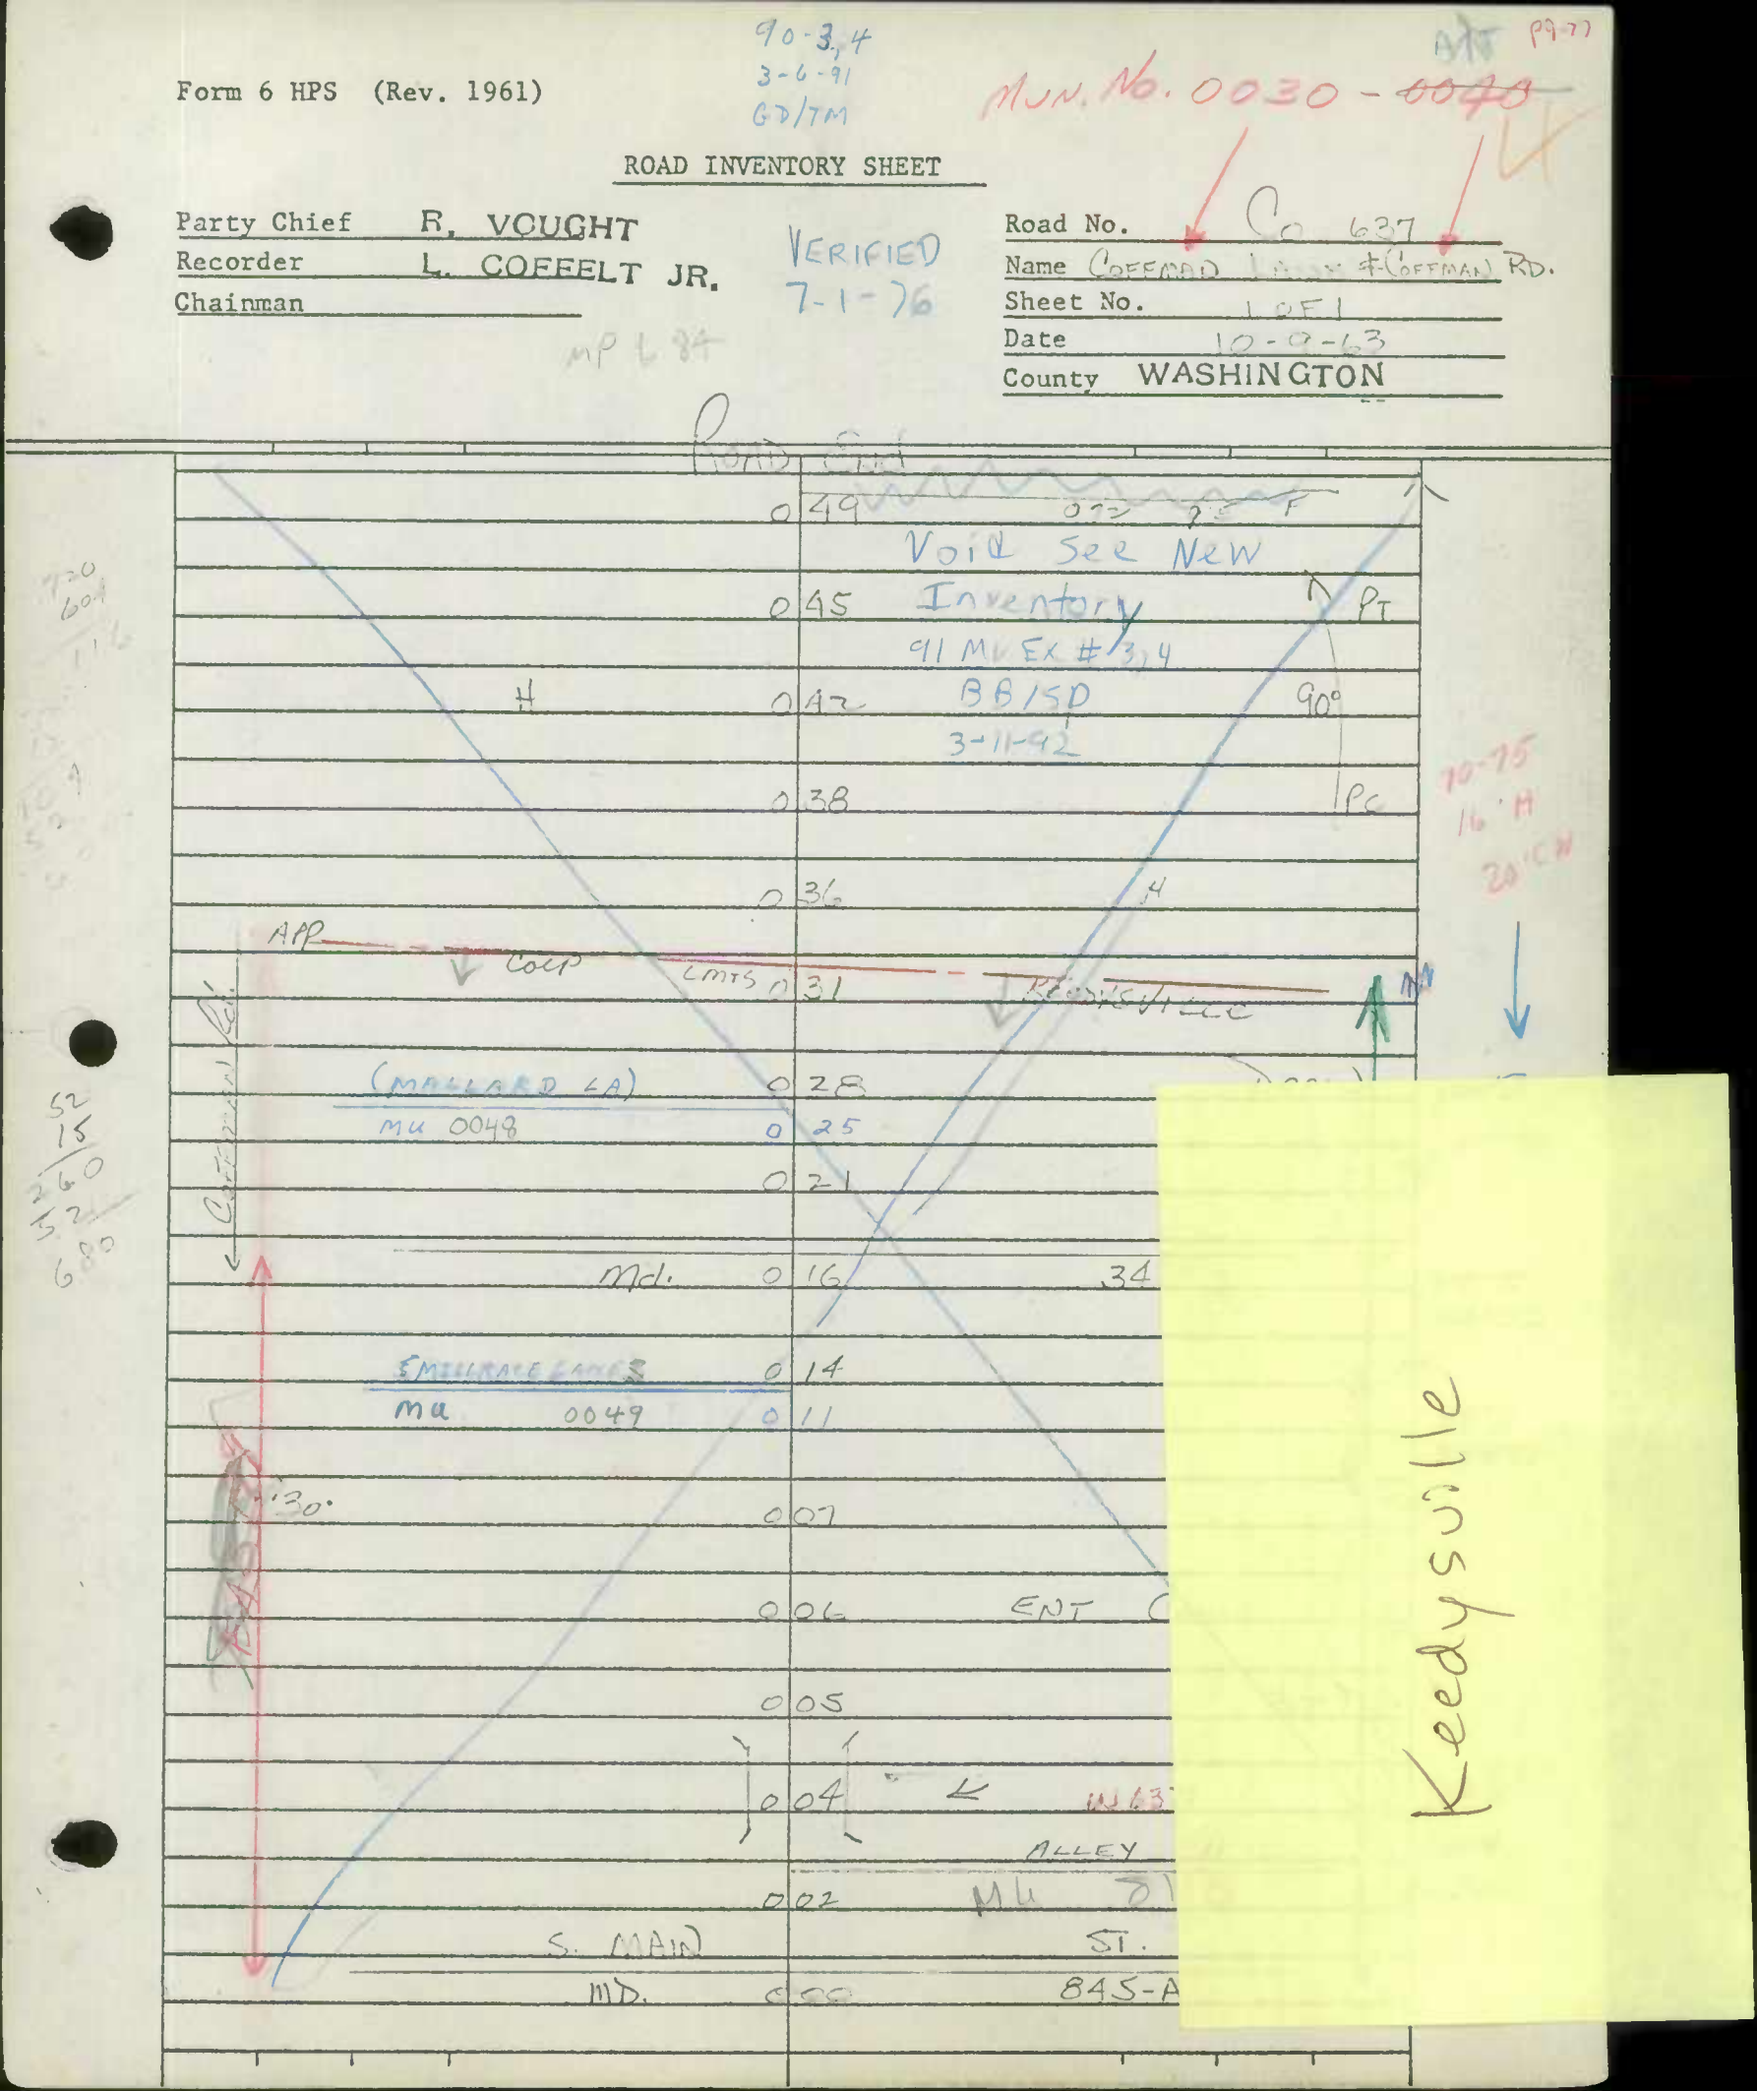

Form 6 HPS (Rev. 1961)

90-3,4
3-6-91
GD/TM

MUN. No. 0030 - ~~0048~~

ROAD INVENTORY SHEET

Party Chief R. VOUGHT
Recorder L. COFFELT JR.
Chainman

VERIFIED 7-1-76

MP 6.84

Road No. Co 637
Name COFFMAN [illegible] & COFFMAN RD.
Sheet No. 1 OF 1
Date 10-2-63
County WASHINGTON

Road End

0 49 Void See New Inventory 91 MU Ex #3,4 BB/SD 3-1-92
0 45 PT
0 42 90°
0 38 PC
0 36
0 31 APP Corp Limits
0 28 (MALLARD LA) MU 0048 DRAIN
0 25
0 21
0 16 Md. 34
0 14 EMERALD LANE MU 0049
0 11
0 07 30°
0 06 ENT Corp.
0 05 20'M
0 04 MU 6371 ALLEY 11 MU 2110
0 02 S. MAIN ST.
0 00 MD. 845-A

10-75 16'H 20'CW
20'I 24'CW
18'H 22'CW
20'I 30'CW 14'H 18'CW

SHA 51.3 - 8 Revised
4.83

MARYLAND STATE HIGHWAY ADMINISTRATION KEEDYSVILLE

ROAD INVENTORY SHEET

Party Chief _____
Recorder _____
Assistant Rewritten 5-20-92 T.M.
Map No./Dir. B-8 / S
State Coordinates 602-601

Road No. MU 0050
Road Name DOG STREET Rd
County WASHINGTON
Date 10-3-63
Sheet No. _____ OF _____

SYSTEM				TRAFFIC		LINE DIAGRAM	TRAFFIC			PAVEMENT DATA
FED. AID.	FUNCT CLASS.	HWY. SYS.	HPMS SAMPLE	PRKG. REST.	COM/IND. ACCESS		CONTROL	COM/IND. ACCESS	PRKG. REST.	
						SEE INUENTORY				
						CO 805				
						Imp. 91 Mu. Ex. #5				
						SNI				
						FC2 97				
						GD MP				
						11/3/97				

TRAFFIC CODES
TRAFFIC CONTROLS: STOP SIGN=SS, TRAFFIC LIGHT=T.L., FLASHING RED BALL=F.R.

TRAFFIC CODES
PARKING RESTRICTIONS: A.M. PEAK, P.M. PEAK, A.M./P.M. PEAK, NO PARKING ANYTIME=N.P., COMM/IND. ACCESS=E

SYSTEM				TRAFFIC		LINE DIAGRAM	TRAFFIC			PAVEMENT DATA
FED. AID.	FUNCT. CLASS.	HWY. SYS.	HPMS SAMPLE	PRK.G. REST.	COM/IND ACCESS		CONTROL	COM/IND ACCESS	PRK.G. REST.	

SHA 51.3 - 8 Revised
4.83

MARYLAND STATE HIGHWAY ADMINISTRATION

ROAD INVENTORY SHEET MU 0050

Party Chief M BAKER OFF INV
Recorder Rewritten: JEL/11/4/91
Assistant
Map No./Dir. B-8 / S
State Coordinates 602-601

Road No. CO 855
Road Name MT BRIER RD
County WASHINGTON
Date 10-3-63 REV 8-12-14
Sheet No. 1 OF 2

TRAFFIC CODES
TRAFFIC CONTROLS: STOP SIGN=SS, TRAFFIC LIGHT=T.L., FLASHING RED BALL=F.R.

TRAFFIC CODES
PARKING RESTRICTIONS: A.M. PEAK, P.M. PEAK, A.M./P.M. PEAK, NO PARKING ANYTIME=N.P., COMM/IND. ACCESS=E

SYSTEM				TRAFFIC		KEEDYSVILLE LINE DIAGRAM	TRAFFIC			PAVEMENT DATA
FED. AID.	FUNCT CLASS.	HWY. SYS.	HPMS SAMPLE	PRKG. REST.	COM/IND. ACCESS		CONTROL	COM/IND. ACCESS	PRKG. REST.	
		KCo Urban				CORP LMTS OF KEEDYSVILLE				
						0.37				
						0.32 * site of old Corp. Limits				
						0.26 30°				
						0.18				
		NON FED AID MINOR COLLECTOR RURAL				MT VERNON DR MU 0070 0.05				
						MT VERNON LA MU 0080 0.03				18' I 24' W
						South MAIN ST MD 0.00 845-A				

KEEDYSVILLE MU 0050

LINE DIAGRAM

SYSTEM: FED. AID. | FUNCT. CLASS. | HWY. SYS. | HPMS SAMPLE

TRAFFIC: PRKG. REST. | COM/IND ACCESS

TRAFFIC: CONTROL | COM/IND ACCESS | PRKG. REST.

PAVEMENT DATA

NOD ELA
MINOR COLLECTOR RURAL

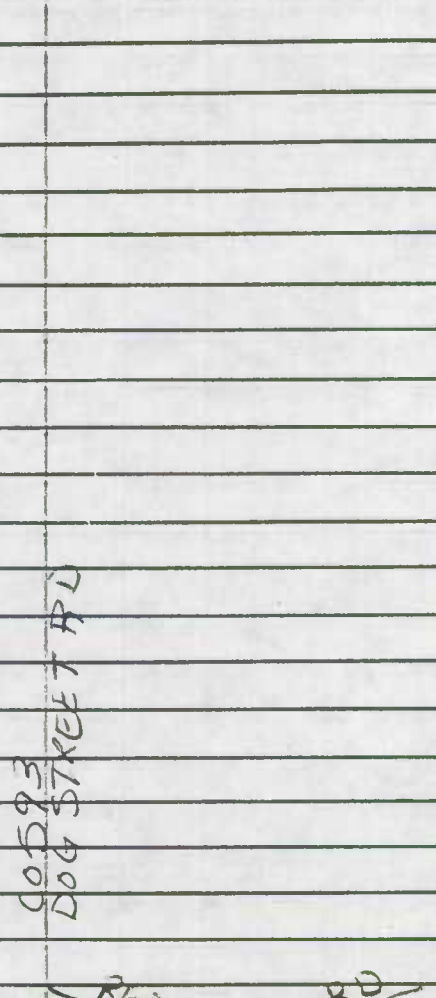

20' I
30' CW

18' I
24' CW

SHA 51.3-8
11-15-72

STATE HIGHWAY ADMINISTRATION OF MARYLAND

PS-77

4

ROAD INVENTORY SHEET

MU 0050

Party Chief M. BAXTER - OFF. INV.
Recorder
Helper

B-8 (5) VERIFIED 7-1-76

Map No. 22

Road No. Co. 805
Road Name MT. BRIAR RD
Sheet No. 1 OF 1
Date 10-3-63 REV. 8-12-74
County WASHINGTON
State Coordinates 602 - 601

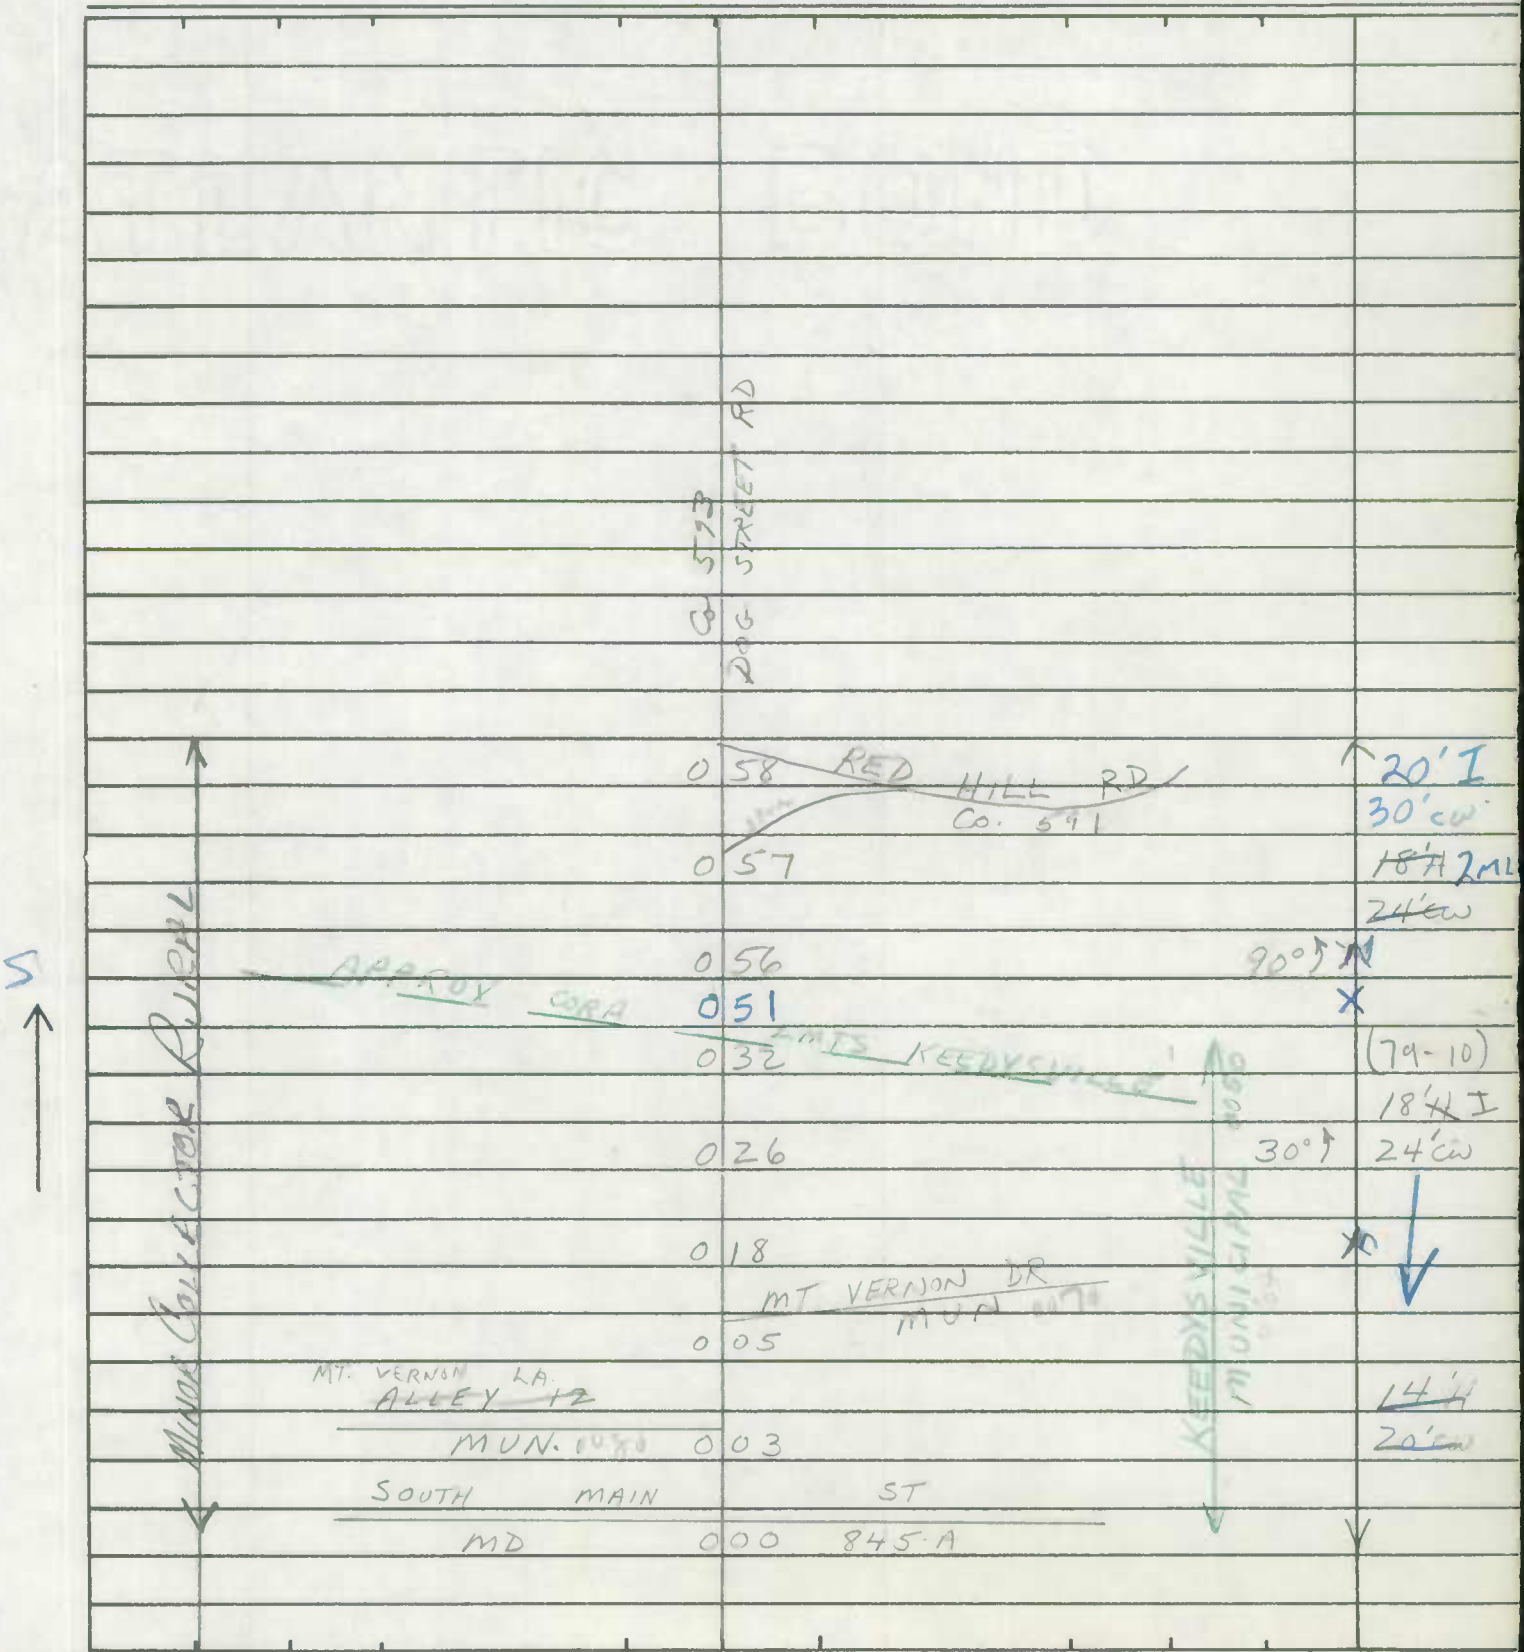

SHA 51.3-8
11-15-72

ROAD INVENTORY SHEET

Road No. _____
Road Name _____
Sheet No. _____
Date _____
County _____
State Coordinates _____

Form 6 HPS (Rev. 1961)

Co. 592 Dog Street Rd. P7-77

ROAD INVENTORY SHEET

Party Chief R. Vought
Recorder L. Coffelt, Jr.
Chainman

Mun. No. 0050.

VERIFIED 7-1-76

Road No. Co. ~~592~~ 805
Name Mt. Briar Rd.
Sheet No. 1 of 3
Date 10-3-63
County Wash.

Mt. Hebron Rd. Co. 595
See Sh 1A
Little Antietam
Creek
R.R.
P.O.
Eakles Mill Rd. Co. 594
Dog Street
Red Hill Rd. Co. ~~592~~ 591
Keedysville
Approx Corp Limits
Minor Collector Rural
Mt. Vernon Dr. Mun-0070
Mt. Vernon La
Alley 12
South Main St.
Sh. 845-A

18'H
22'CW
12'H
16'CW
20'I
30'CW
2ML
CO IMP 79-10
I
18'H
20'CW

Form 6 HPS (Rev. 1961)

ROAD INVENTORY SHEET

Party Chief R. Vought
Recorder L. Coffee H, Jr.
Chainman

Keedysville

Revised 1-29-74 W.D.P.

VLR 7-8-76

Road No. 0100
Name Park Co.
Sheet No. 1 of 1
Date 10-9-63
County Wash.

Alley #3 Mu 80 30

N. Main St.
Md. 0-38 42 MD-A

10'H
12'CW.

0-28 33 90°

0-26 36 Athletic Field

16'I
18'CW

Alley 2 Mun 60 20

0-22 32

0-13 23

0-12 23 Columbine Dr. (73-1) Mu 0045

0-04 14 (45°

Alley 1 Mun 60 20

16'I
20'C.W.

Taylor La. Mun 130

0-20 10

← TAYLOR DR
Mu 120

Form 6 HPS (Rev. 1961)

A/N

P9-77

4

ROAD INVENTORY SHEET

Party Chief R. Vought
Recorder L. Coffelt, Jr.
Chainman

VER
7-8-76

Road No. 0120
Name Taylor Dr.
Sheet No. 1 of 1
Date 10-9-63
County Wash.

Form 6 HPS (Rev. 1961)

87-EX
PART AGAIN.
as per Phone call of MAYOR TAYLOR 1-4-88 JE

SC MU EX #5
GD/KS
2-7-97

ROAD INVENTORY SHEET

Party Chief R. VOUGHT
Recorder L. COFFELT JR.
Chainman

VER
7-8-76

Keedysville

Road No. 8090
Name ~~ALLEY 2~~ INVENTORY NAME
Sheet No. 1 OF 1
Date 10-9-63
County WASHINGTON

SEE NEW INVENTORY
ERRONEOUSLY MISTAKEN AS A
HANCOCK ALLEY MU 8090

MK 3/12/97

Road 0.05 End

10'E

(METHODIST ST)
MU 0.00 0.230

~~S. MAIN~~ ST
~~MD~~ 0.00 ~~0.45-A~~

12'E
1 LANE

PVT DR
0.03

10'H
12'CW

S. MAIN ST
MD 0.00 0.95-A

Form 6 HPS (Rev. 1961)

ROAD INVENTORY SHEET

Party Chief R. VOUGHT
Recorder L. COFFELT JR.
Chainman

VER 7-8-76

TL REVISED F.R. 3/23/76

Road No. ~~0000~~ - 0010
Name W. ANTIETAM ST & E. ANTIETAM ST
Sheet No. 1 OF 1
Date 10-9-63
County WASHINGTON

82-3 SM NE

Sharpsburg

	16	
ALLEY ~~14~~ ABAND. MUN. ~~8160~~ 8025	059	~~END~~
	057	
S Church Co	052	ST 385
	051	CBC 4
ALLEY 4 MUN.	044	8040
	041	
S. Mechanic MUN	037	ST 100
ALLEY MUN	030	6 8060
S. HALL MUN	022	ST 50
ALLEY MUN	013	7 8070
S. Potomac St MUN 110	005	GENERAL STUART Ct Co 95
	001	ATHLETIC FIELD
ALLEY 9 MUN 8090		

E ANTIETAM ST

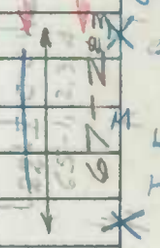

Form 6 HPS (Rev. 1961)

ROAD INVENTORY SHEET

Party Chief R. VOUGHT
Recorder L. COFFELT JR.
Chainman

VER 7-8-76

TL REVISED F.R. 3/23/76

82-3 CM NE

Road No. ~~0000~~ - 0010
Name W. ANTIETAM ST & E. ANTIETAM ST
Sheet No. 1 OF 1
Date 10-9-63
County WASHINGTON

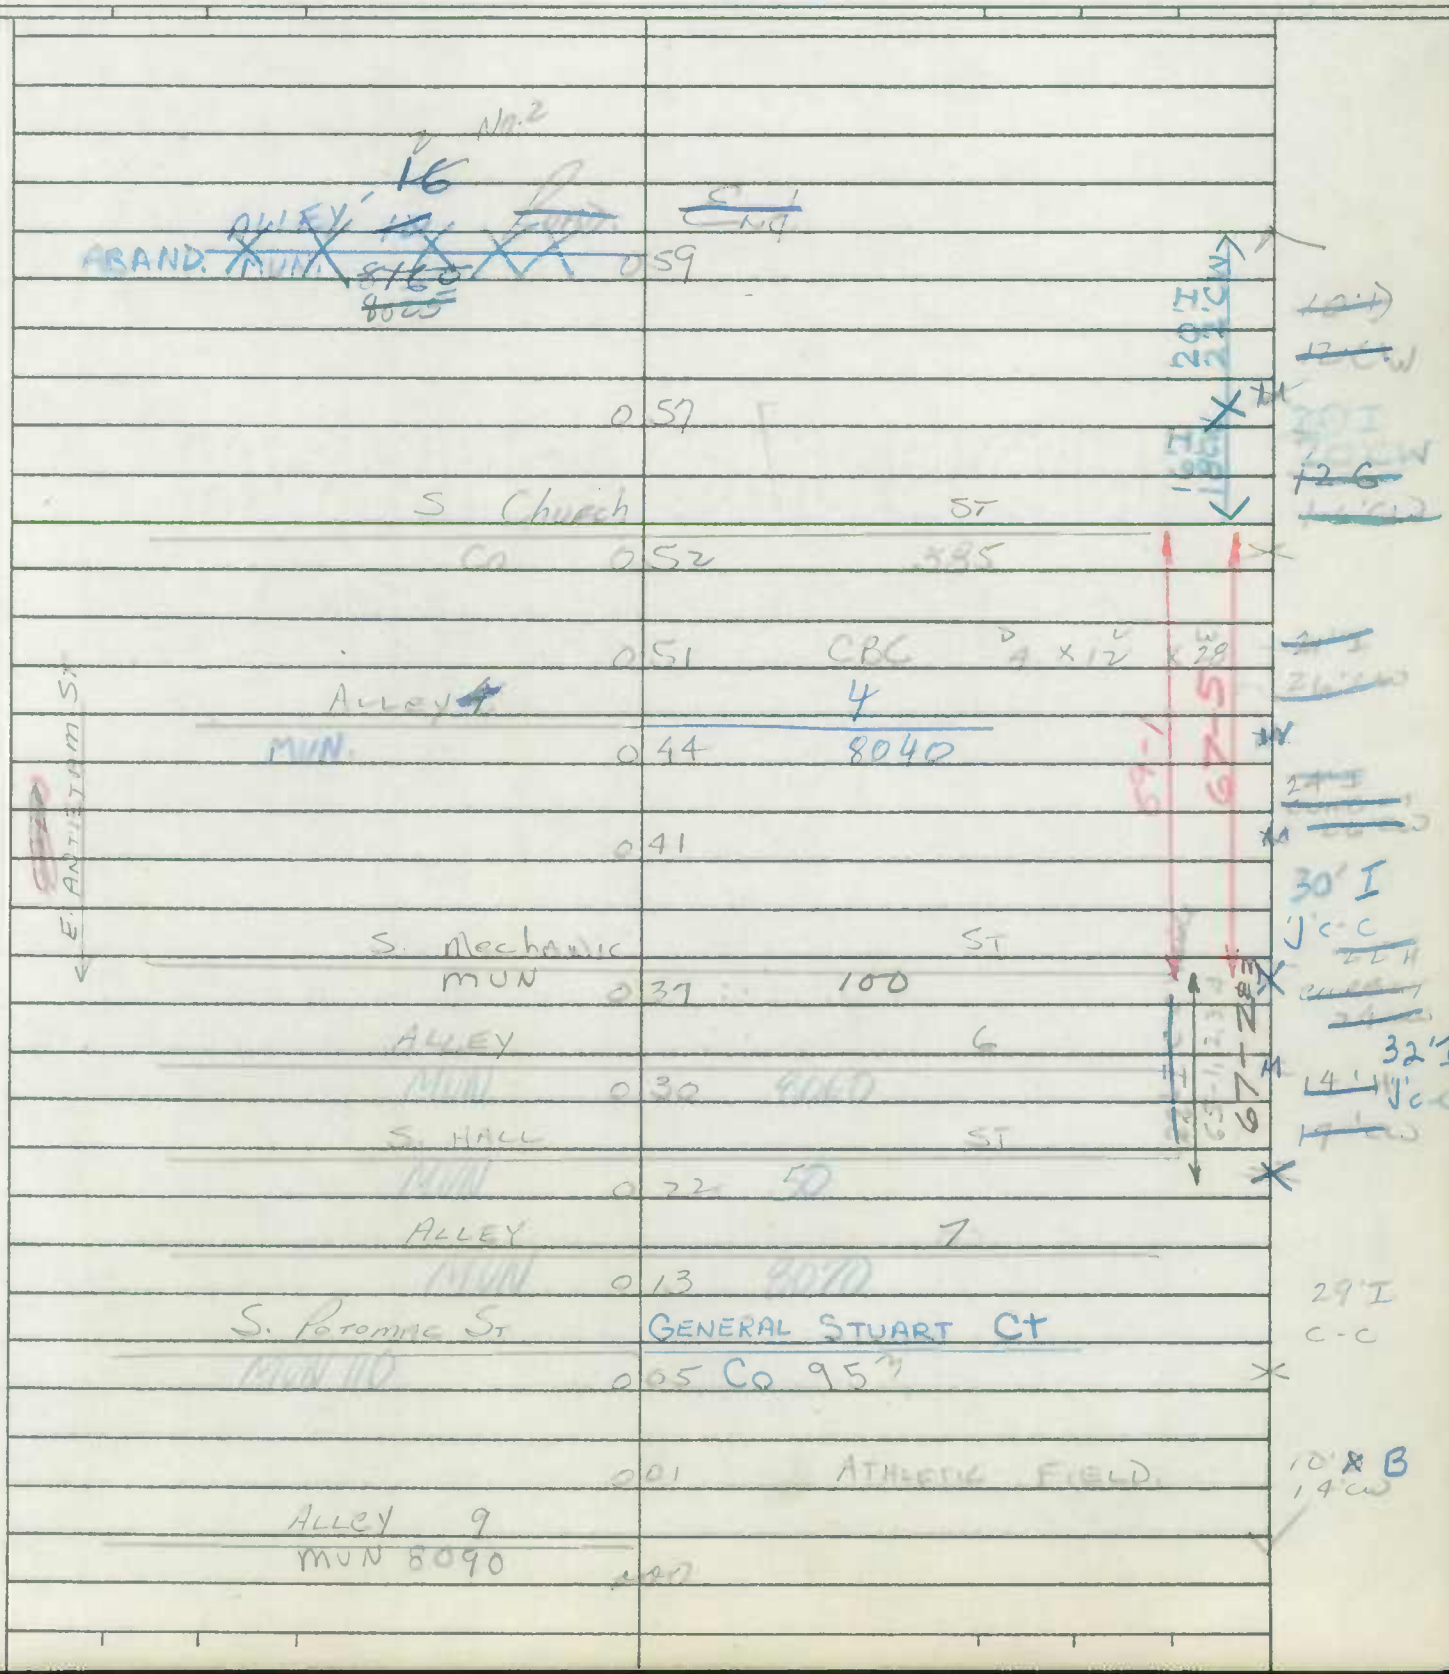

SHA 51.3 - 8 Revised
4.83

MARYLAND STATE HIGHWAY ADMINISTRATION

ROAD INVENTORY SHEET

Party Chief Rowsitter TM
Recorder
Assistant
Map No./Dir. 1
State Coordinates

Road No. MU 0070
Road Name W. HIGH ST
County WASHINGTON
Date 10-5-88
Sheet No. ____ OF ____

SYSTEM: FED. AID. | FUNCT CLASS. | HWY. SYS. | HPMS SAMPLE
TRAFFIC: PRKG. REST. | COM/IND. ACCESS

LINE DIAGRAM

SHARPSBURG

				TRAFFIC: CONTROL	TRAFFIC: COM/IND. ACCESS	TRAFFIC: PRKG. REST.	PAVEMENT DATA
ALLEY 4							
MU 8040	0	31					
							12'I
							16'CW
S MECHANIC ST		HARPERS FERRY Rd					
MU 0100	0	24	CO 580			X	
							13'I
							20'CW
	0	19				X	
ALLEY 6							
MU 8060	0	17					
							11' I
							14'CW
	0	11				X	
S. HALL ST							
MU 0050	0	09					
	0	03	(A)				24'I
							"J" C-4
							6'F SHLDRT
ALLEY 7							
MU 8070	0	00				✓	

TRAFFIC CODES
TRAFFIC CONTROLS: STOP SIGN=SS, TRAFFIC LIGHT=T.L., FLASHING RED BALL=F.R.

TRAFFIC CODES
PARKING RESTRICTIONS: A.M. PEAK, P.M. PEAK, A.M./P.M. PEAK, NO PARKING ANYTIME=N.P., COMM/IND. ACCESS=E

LINE DIAGRAM

SYSTEM: FED. AID. | FUNCT. CLASS. | HWY. SYS. | HPMS SAMPLE

TRAFFIC: PRKG. REST. | COM/IND ACCESS

TRAFFIC: CONTROL | COM/IND ACCESS | PRKG. REST.

PAVEMENT DATA

community Pond

Road 0 47 END

20° 0 45 72" cmp

S CHURCH ST 0030 0 41 CO

BURNSIDE Bridge Rd 585

12'E
14'CW

18'I
20'CW

SAME

P9-77

SHA 51.3-8
11-15-72

STATE HIGHWAY ADMINISTRATION OF MARYLAND

ROAD INVENTORY SHEET

E HIGH ST. 0070

4

Party Chief T. LANDON
Recorder F. RHODES
Helper

VER 7-8-76

Map No. SHARPSBURG

BB REV. FR. 4-14-81

Road No. MUN. 0080
Road Name W. HIGH ST.
Sheet No. 1 OF 1
Date 3/23/76
County WASH.
State Coordinates 78-12

86-1 CA/L 4-13-87

		ROAD END	
	0	53	12'E 14'CW
	0	51	PT 120° PC
	0	49	10'E 12'CW
	0	47 BARRICADE	
ROAD	0	47 END COMMUNITY POND	
↑ 20°	0	45	12'E 14'CW
S. CHURCH ST. MUN. 0030	0	41 BURNSIDE BRIDGE RD. 72" CMP CO. 585	16'CW
	0	34	80-1
ALLEY 4 MUN. 8040	0	31	12' I 16'CW
S. MECHANIC ST. MUN. 0100	0	24 HARPERS FERRY RD CO. 580	13' I 20'CW
ALLEY 6 MUN. 8060	0	19	11' I 14'CW
	0	17	
	0	11 WATER TANK	24' I
S. HALL ST. MUN. 50	0	09	10'E 14'CW
ALLEY 7 MUN. 8070	0	03 SHARPSBURG COMMUNITY PARK	36'CW
	0	00	

E

SHA 51.3-8
11-15-72

ROAD INVENTORY SHEET

Road No. _____
Road Name _____
Sheet No. _____
Date _____
County _____
State Coordinates _____

SHA 51.3 - 8 Revised
4.83

SHARPSBURG 83-2,90-22A

MARYLAND STATE HIGHWAY ADMINISTRATION

ROAD INVENTORY SHEET

Party Chief B. Vought
Recorder L. Coffelt Jr
Assistant Rewritten (JEL) 5-14-91
Map No./Dir. C-8 / S
State Coordinates Sharpsburg

Road No. MU 0100
Road Name S. Mechanic St
County Washington
Date 10-2-63
Sheet No. 1 OF 1

TRAFFIC CODES
TRAFFIC CONTROLS: STOP SIGN=SS, TRAFFIC LIGHT=T.L., FLASHING RED BALL=F.R.

TRAFFIC CODES
PARKING RESTRICTIONS: A.M. PEAK, P.M. PEAK, A.M./P.M. PEAK, NO PARKING ANYTIME=N.P., COMM/IND. ACCESS=E

SYSTEM: FED. AID.	SYSTEM: FUNCT CLASS.	SYSTEM: HWY. SYS.	SYSTEM: HPMS SAMPLE	TRAFFIC: PRKG. REST.	TRAFFIC: COM/IND. ACCESS	LINE DIAGRAM	TRAFFIC: CONTROL	TRAFFIC: COM/IND. ACCESS	TRAFFIC: PRKG. REST.	PAVEMENT DATA
						E. High St. — W. High St.				
						MU — 0 — 19 — 0070				
						CORP LMTS — Sharpsburg				32' I C-C
						Alley — 3				
						MU — 0 14 8030				
						SNI FCR-97 G.D. MP 11/5/97				40' I C-C
						E. Antietam St. — W. Antietam St.				
						MU — 0 10 0010				
										39' I C-C
						Alley — 10				
						MU — 0 05 8100				
										34' I C-C
						E. Main St. — W. Main St.				
						MD — 0 00 34				
						N. Mechanic St. MU 0090				

FAS 1057 Major Collector - Rural

SYSTEM				TRAFFIC		LINE DIAGRAM	TRAFFIC				PAVEMENT DATA
FED. AID.	FUNCT. CLASS.	HWY. SYS.	HPMS SAMPLE	PRKG. REST.	COM/IND ACCESS		CONTROL	COM/IND ACCESS	PRKG. REST.		

SHA 51.3-8
11-15-72

STATE HIGHWAY ADMINISTRATION OF MARYLAND

ROAD INVENTORY SHEET

9025

Party Chief J. LANDON
Recorder E. RHODES
Helper

Road No. MUN. 9160
Road Name ALLEY 16 2 No. 2
Sheet No. 1 OF 1
VER. 7-8-76 Date 3/ 176
Map No. SHARPSBURG F County WASH.
State Coordinates

C E M.

N

ROAD END
0 04

REF ↑ Boonsboro

E. ANTIETAM ST.
MUN 0010 0 00

8'C
12'CW

Form 6 HPS (Rev. 1961)

91-3 AT

4

GPS-02
4-10-02
GD/EF

SHARPSBURG

ROAD INVENTORY SHEET

Party Chief R. VOUGHT
Recorder L. COFFELT JR.
Chainman

91-3 MU
BB/SP
VER. 3-10-92
7-8-76

TL REVISED
F.R. 3/23/76

Road No. 8060
Name ALLEY 6
Sheet No. 1 OF 1
Date 10/1-63
County WASHINGTON

See New
Inventory
Written 4-10-02
GPS-02
GD/EF

~~ALLEY~~ ~~Rud~~ ~~End~~ ~~12~~

~~W. Chapline~~ ~~Mun~~ ~~0 32~~ ~~ST~~

~~Snyder~~ MUN 023 40

~~Street Split Comm. Line~~ ~~025~~

~~Alley~~

~~Mun~~ 023 ~~ST~~

~~Mun~~ ~~ST~~

~~Mun~~ ~~019~~ 34

ROAD 017 END

ALLEY 10

MUN 014 8060

W. ANTIETAM ST

MUN 009 10

ALLEY 3

MUN 004 8030

W HIGH ST

MUN 000 80 70

N

~~10'F~~ ~~12'W~~

10'C
11'CW

86
10CW

8
10'CW

Form 6 HPS (Rev. 1961)

Urban

ROAD INVENTORY SHEET

Party Chief R. VOUGHT
Recorder L. ~~GOFFELT~~ JR.
Chainman

VER 7-9-70

SMITHSBURG

Road No. ~~8070~~ BARKDOLL LA 0002
Name ~~Alley #7~~
Sheet No. 1 OF
Date 9 - 10 - 63
County WASHINGTON

Smithsburg

RAILROAD ~~ALLEY~~ #11 LH
MUN 008 ~~040~~ 0070

NEWMAN ~~ALLEY~~ #5 LA
MUN ~~0050~~ 004 0047

8'H 12'CW
12'H 16'CW

Md 000

~~67~~ 66

Form 6 HPS (Rev. 1961)

Urban

ROAD INVENTORY SHEET

Party Chief R. VOUGHT

Recorder L. GOFFELT JR.

Chainman

SMITHSBURG

VER 7-9-70

Road No. ~~8070~~ BARKDOLL LA 0002

Name ~~Foley #7~~

Sheet No. 1 OF

Date 9-10-63

County WASHINGTON

RAILROAD ~~FOLEY~~

MUN 008

~~#11~~ LA

~~8070~~ 0070

NEWMAN ~~FOLEY #5~~ LA

MUN ~~8070~~ 004

0047

8'A
12'CW

12'H
16CW

3 LANE LOOP

2 LANE

mtd 000

#7
66

Form 6 HPS (Rev. 1961)

Urban ~~MACS~~

ROAD INVENTORY SHEET

Party Chief R. Voight
Recorder L. Coffelt Jr.
Chainman

VERIFIED
7-7-76

Road No. ~~0150~~ 0004 Bishop La
Name ~~Alley 75~~
Sheet No. 1 of 1
Date 9-12-63
County Wash.

	ROAD	END
~~CLOPPER~~ ~~ALLEY~~ AVE ~~13~~	0	06
MUN ~~BLVD~~ ~~0012~~	0	05
~~Road~~		~~End~~
	0	04
S. Main MUN	0	00

URBAN Locals
NON FA

H 1

~~22' W E~~
~~Curb RT.~~
26' CW.

Ct.

← Co. 241

SHA 51.3-8
11-15-72

STATE HIGHWAY ADMINISTRATION OF MARYLAND

urban

ROAD INVENTORY SHEET

Party Chief R Vought
Recorder L Cofelt Jr
Helper

Map No. _____ VER 7-9-76

Road No. ~~8120~~ Bowling LA 0007
Road Name ~~Alley 12~~
Sheet No. 1 of 1
Date 9-10-63
County WASH
State Coordinates

Pearrit & Co SJVTC SMITHSBURG

SEE NEW INVENTORY

NOW COMBINED

WITH

MU 9060

3-3-88

BISHOP 016 LA 21

HENRRIETTA MIN 007 ST 10

ROAD 000 IND

URBAN INCR

NON LA

10'I

A'cw

SHA 51.3-8
11-15-72

ROAD INVENTORY SHEET

Road No. _____
Road Name _____
Sheet No. _____
Date _____
County _____
State Coordinates _____

Form 6 HPS (Rev. 1961)

Urban

4

Bowman LA

ROAD INVENTORY SHEET

Party Chief R. VOUGHT

Recorder L. DEFELT JR.

Chainman

VER 7-9-76

T. LANDON
F. RHODES

SMITHSBURG

2/2017 REVISED
3/28/78

Road No. ~~3140~~ 0009

Name ~~ALLEY #14~~

Sheet No. 1 OF 1

Date 9-10-63

County WASHINGTON

MAPLE AVE ST.
MUN 018 40

KELLER AVE
MUN 014 MUN 003 90°

12'I
14'CW

HENRIETTA ST
MUN 10 008

003 90°

10'H
12'CW

MAPLE AVE
MUN 000 40

URBAN LOCAL
NON FA

Form 6 HPS (Rev. 1961)

wlbam 06-9 AL/CB 4/15/87

ROAD INVENTORY SHEET

Party Chief R. VOUGHT L. COFFELT JR.

Recorder

Chainman

SMITHSBURG

VER 7-9-76

Road No. 0010

Name HENRIETTA ST

Sheet No. 1 OF 1

Date 9 - 10 - 63

County WASHINGTON

AI 84-5

		F		
		Road End		
	032	CBC D 4 X L 4 X W 21		
CLOPPER		AVE		10'X I
~~ALLEY~~ #13		~~ALLEY~~ #13		14'CW
MUN	022	~~SFD~~ 0012		
S. MAIN		ST		10'H
MUN ~~CO~~	016	~~SFD~~ 0020 MUN		14'CW
BOWLING ~~ALLEY~~		~~#12~~ LA		
MUN	010	~~BOWLING ALLEY~~ LA 0007		
	007	MU ~~ALLEY~~ 0006		16'I
MAPLE		ST		20'CW
MUN	004	AD		
~~BOWLING~~ ALLEY #14		~~ALLEY~~ 14 LA		10'I
MUN ~~SFD~~	000	0009		12'CW

Form 6 HPS (Rev. 1961)

urban NT

ROAD INVENTORY SHEET

C+P LA

Party Chief R. VOUGHT
Recorder L. ~~COF~~FELT J..
Chainman

VER. 7-9-76

SMITHSBURG

Road No. ~~8040~~ 0013
Name ~~Alley #4~~
Sheet No. 1 OF 1
Date 9-10-63
County WASHINGTON

81-4 80-3

RAILROAD ~~ALLEY~~
MUN 0 18 ~~8120~~ 0071 ~~LA~~
MOOSE ~~ALLEY #3~~ LA 0 15 C&P TELEPHONE CO
~~MUN 8120~~ 0048 0 14
NEWMAN ~~ALLEY~~ LA #6
0 12 MUN 0048
W. WATER ST
MD. 0 07 ~~LA~~ C&E
FIRE CO. LA ~~ALLEY #5~~
0 02 MUN 8120 0016
FIRE CO LA ~~ALLEY #2~~
~~MUN 8120~~ 0014 0 00

8'H 16'CW
10'H 16'CW
8'H 14'CW

URBAN LOCAL
NON FA
ALLEY

Form 6 HPS (Rev. 1961)

Urban A

4

ROAD INVENTORY SHEET

FIRE COMPANY LA

Party Chief R. VOUGHT
Recorder L. COFFELT J.
Chainman

SMITHSBURG

VER 7-9-76

Road No. ~~8020~~ 0014
Name ~~Alley #2~~
Sheet No. 1 OF 1
Date 9-10-63
County WASHINGTON

80-2

C+P ~~RECD~~ LA
~~MUN~~ ~~0013~~
0012

PVT. RD TO T.H. 12'E
THIS SIDE LAWN ABAND.

8'H 14'CW

N MAIN
~~CO~~ mud 0026

ST
229 mud 0020

10' I 16'CW

URBAN LOCAL
NON

SCHOOL ALLEY
MUN

LA
~~TC~~

~~CO~~ 0093

Form 6 HPS (Rev. 1961)

85-12 BT DC 3-12-86

urban AIT

ROAD INVENTORY SHEET

FIRE Company LA

Party Chief R. VOUGHT

Recorder L. COFFELT JR.

Chainman

SMITHSBURG

VER 7-9-76

Road No. ~~B160~~ 0016

Name ~~ALLEY #16~~

Sheet No. 1 OF 1

Date 9-10-63

County WASHINGTON

A/T 84-2

ROAD 018 END

12'E 14'CW

~~ROAD END~~

013

X

84 I

12'CW

MIN 10.0' MIN 14.0'

C&P ALLEY

~~F~~ LA

MIN and ~~RIGHT~~ 0013

Smithsburg

SHA 51.3 - 8 Revised
4.83

MARYLAND STATE HIGHWAY ADMINISTRATION

MU0020
N. MAIN ST
S. MAIN ST

ROAD INVENTORY SHEET

Party Chief _____
Recorder _____
Assistant _____
Map No./Dir. 1
State Coordinates _____

Road No. CO 229
Road Name _____
County WASHINGTON
Date _____
Sheet No. 3 OF 5

TRAFFIC CODES
TRAFFIC CONTROLS: STOP SIGN=SS, TRAFFIC LIGHT=T.L., FLASHING RED BALL=F.R.

TRAFFIC CODES
PARKING RESTRICTIONS: A.M. PEAK, P.M. PEAK, A.M./P.M. PEAK, NO PARKING ANYTIME=N.P., COMM/IND. ACCESS=E

SYSTEM				TRAFFIC		LINE DIAGRAM	TRAFFIC			PAVEMENT DATA
FED. AID.	FUNCT CLASS.	HWY. SYS.	HPMS SAMPLE	PRKG. REST.	COM/IND. ACCESS		CONTROL	COM/IND. ACCESS	PRKG. REST.	
						B-PACKING HOUSE 2 05				
						UNGER RD				
						1 81 CO 236				
										77-22
										20'I
										24'C-W
						DURBERRY RD				
						CO 237 1 45				X
						1 32 STONE ARCH D 5'x L 7'x W 19'				
						ENT BROCK to Hosp				
						1 31 SR 4				
						UNGER RD				
						1 14 CO 236				
										SAME

FAS 1060 RURAL
MAJOR COLLECTOR

LINE DIAGRAM

SYSTEM: FED. AID.	SYSTEM: FUNCT. CLASS.	SYSTEM: HWY. SYS.	SYSTEM: HPMS SAMPLE	TRAFFIC: PKG. REST.	TRAFFIC: COM/IND ACCESS				TRAFFIC: CONTROL	TRAFFIC: COM/IND ACCESS	TRAFFIC: PKG. REST.	PAVEMENT DATA
								W. WATER ST				46'I
						MD	3	97 166				JC-C
						Church	3	91				
						FIRE		COMPANY LA=2				
						MU	3	90 14				
						SCHOOL		LA				
						MU	3	80 92				48 I
												JC-C
							3	70				2MU
							3	66 SCHOOL				42'I
												JCB RT
						CORP LMTS	3	65 SMITHSBURG				
						GRAVE CREEK CIR OP CO 231	3	53 Geiser Way (SP228)				
							3	47				
						CORP LMTS	3	23 SMITHSBURG				
						STEVENSON RD						
						CO 240	3	15				22'I
								D L W				28'C-W
							3	12 CBC · 4' x 11' x 28'				
							3	07 SEWAGE TREAT PLANT				
						ROWE		RD				
						CO	2	72 239				
												20'I
												24'C-W
												SAME

FAU 8032
URBAN MINOR ARTERIAL

FAS 1060
MAJOR COLLECTOR - RURAL

SHA 51.3-8
11-15-72

STATE HIGHWAY ADMINISTRATION OF MARYLAND

ROAD INVENTORY SHEET

Party Chief _____
Recorder _____
Helper _____

Map No. A-9

Road No. Co. 229 MD 20
Road Name _____
Sheet No. 5 OF 5
Date _____
County WASHINGTON
State Coordinates _____

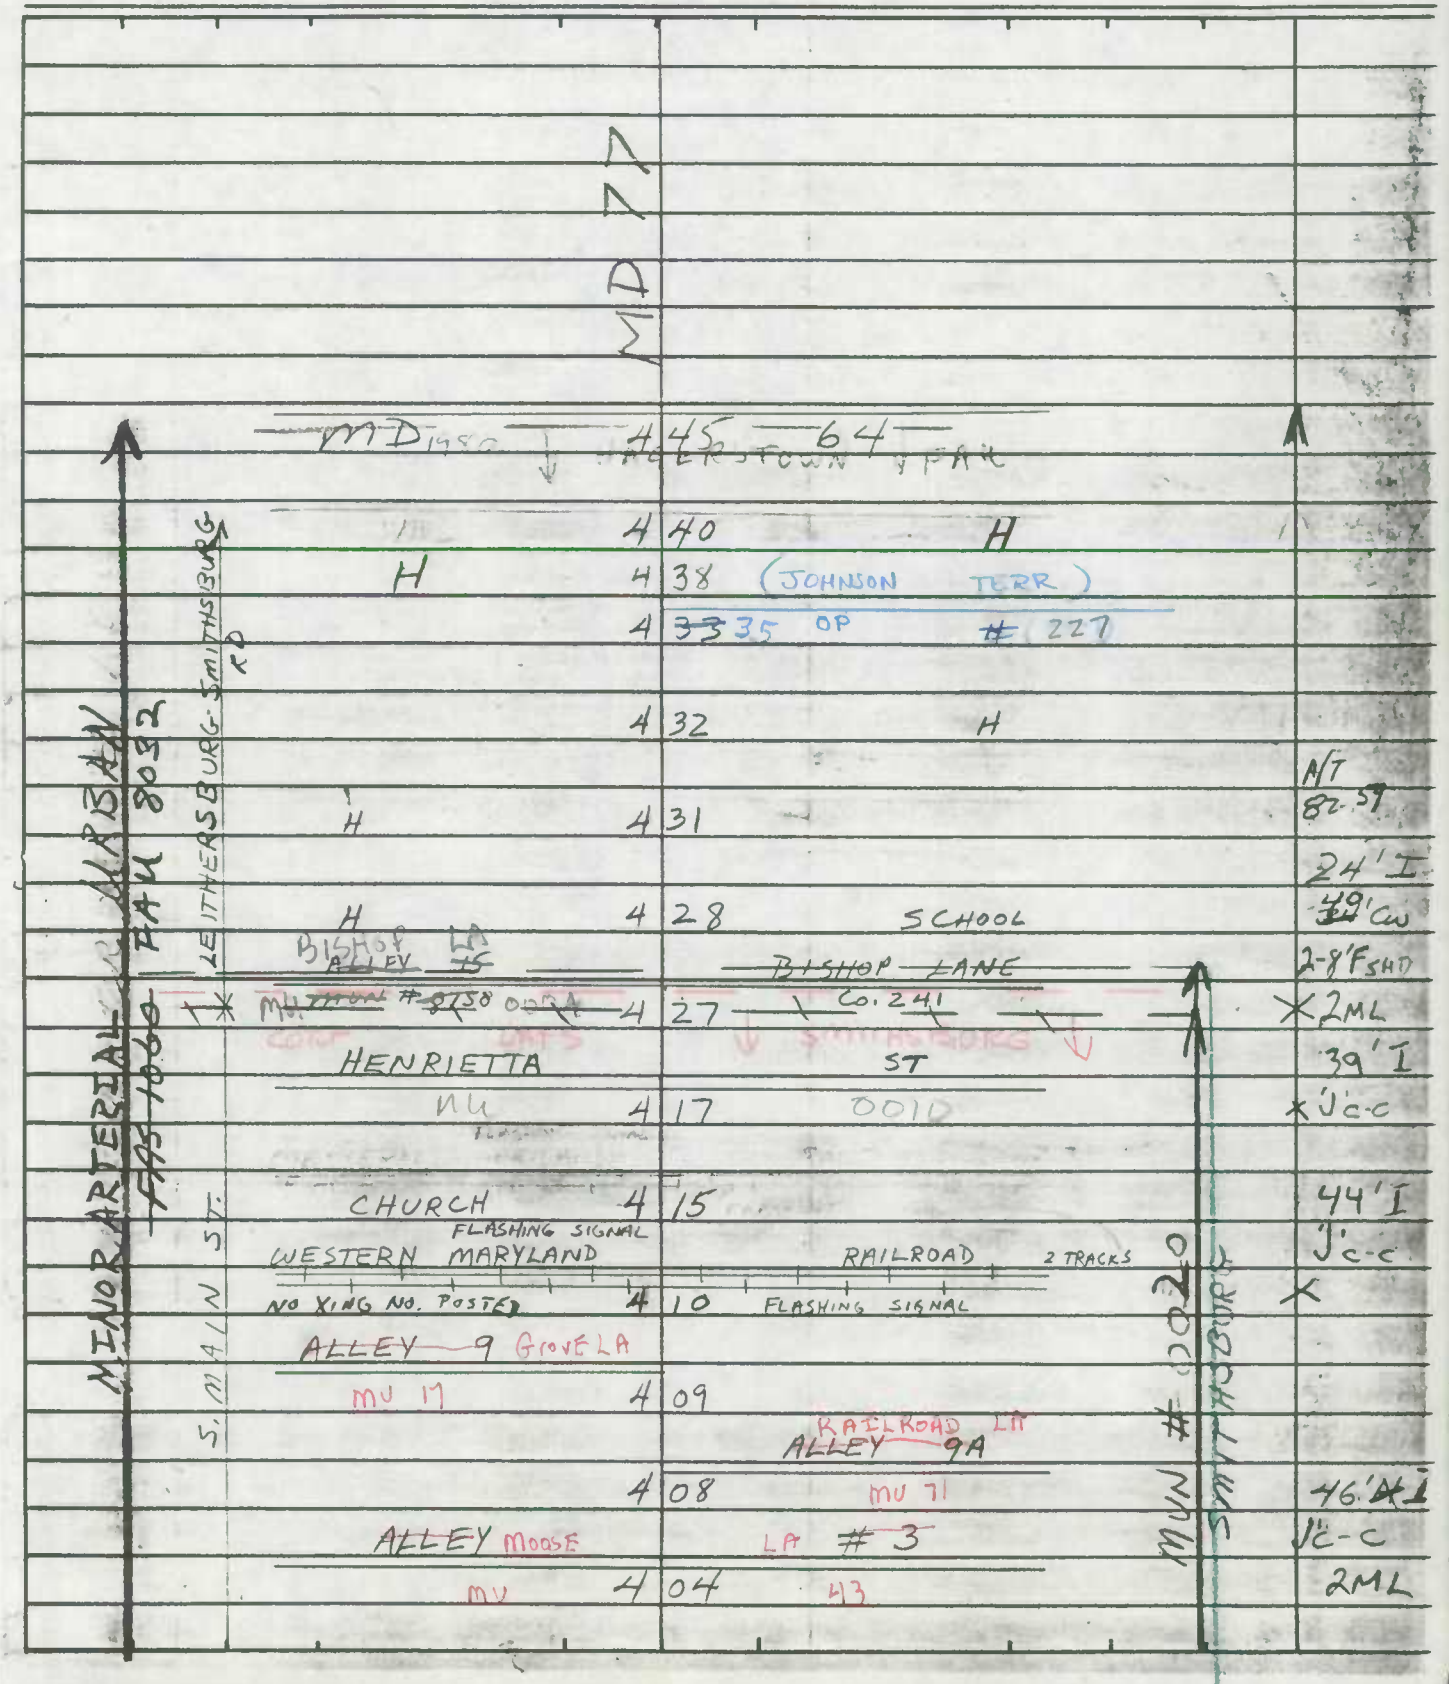

SHA 51.3-8
11-15-72

STATE HIGHWAY ADMINISTRATION OF MARYLAND

ROAD INVENTORY SHEET

Party Chief R Vaught
Recorder L Offutt Jr
Helper

Map No. _____ VER-6-30-76

Road No. A0
Road Name MAPLE ST
Sheet No. 1 of 1
Date 9-10-63
County WASH
State Coordinates

Round 8-86-81 JTSC SMITHSBURG

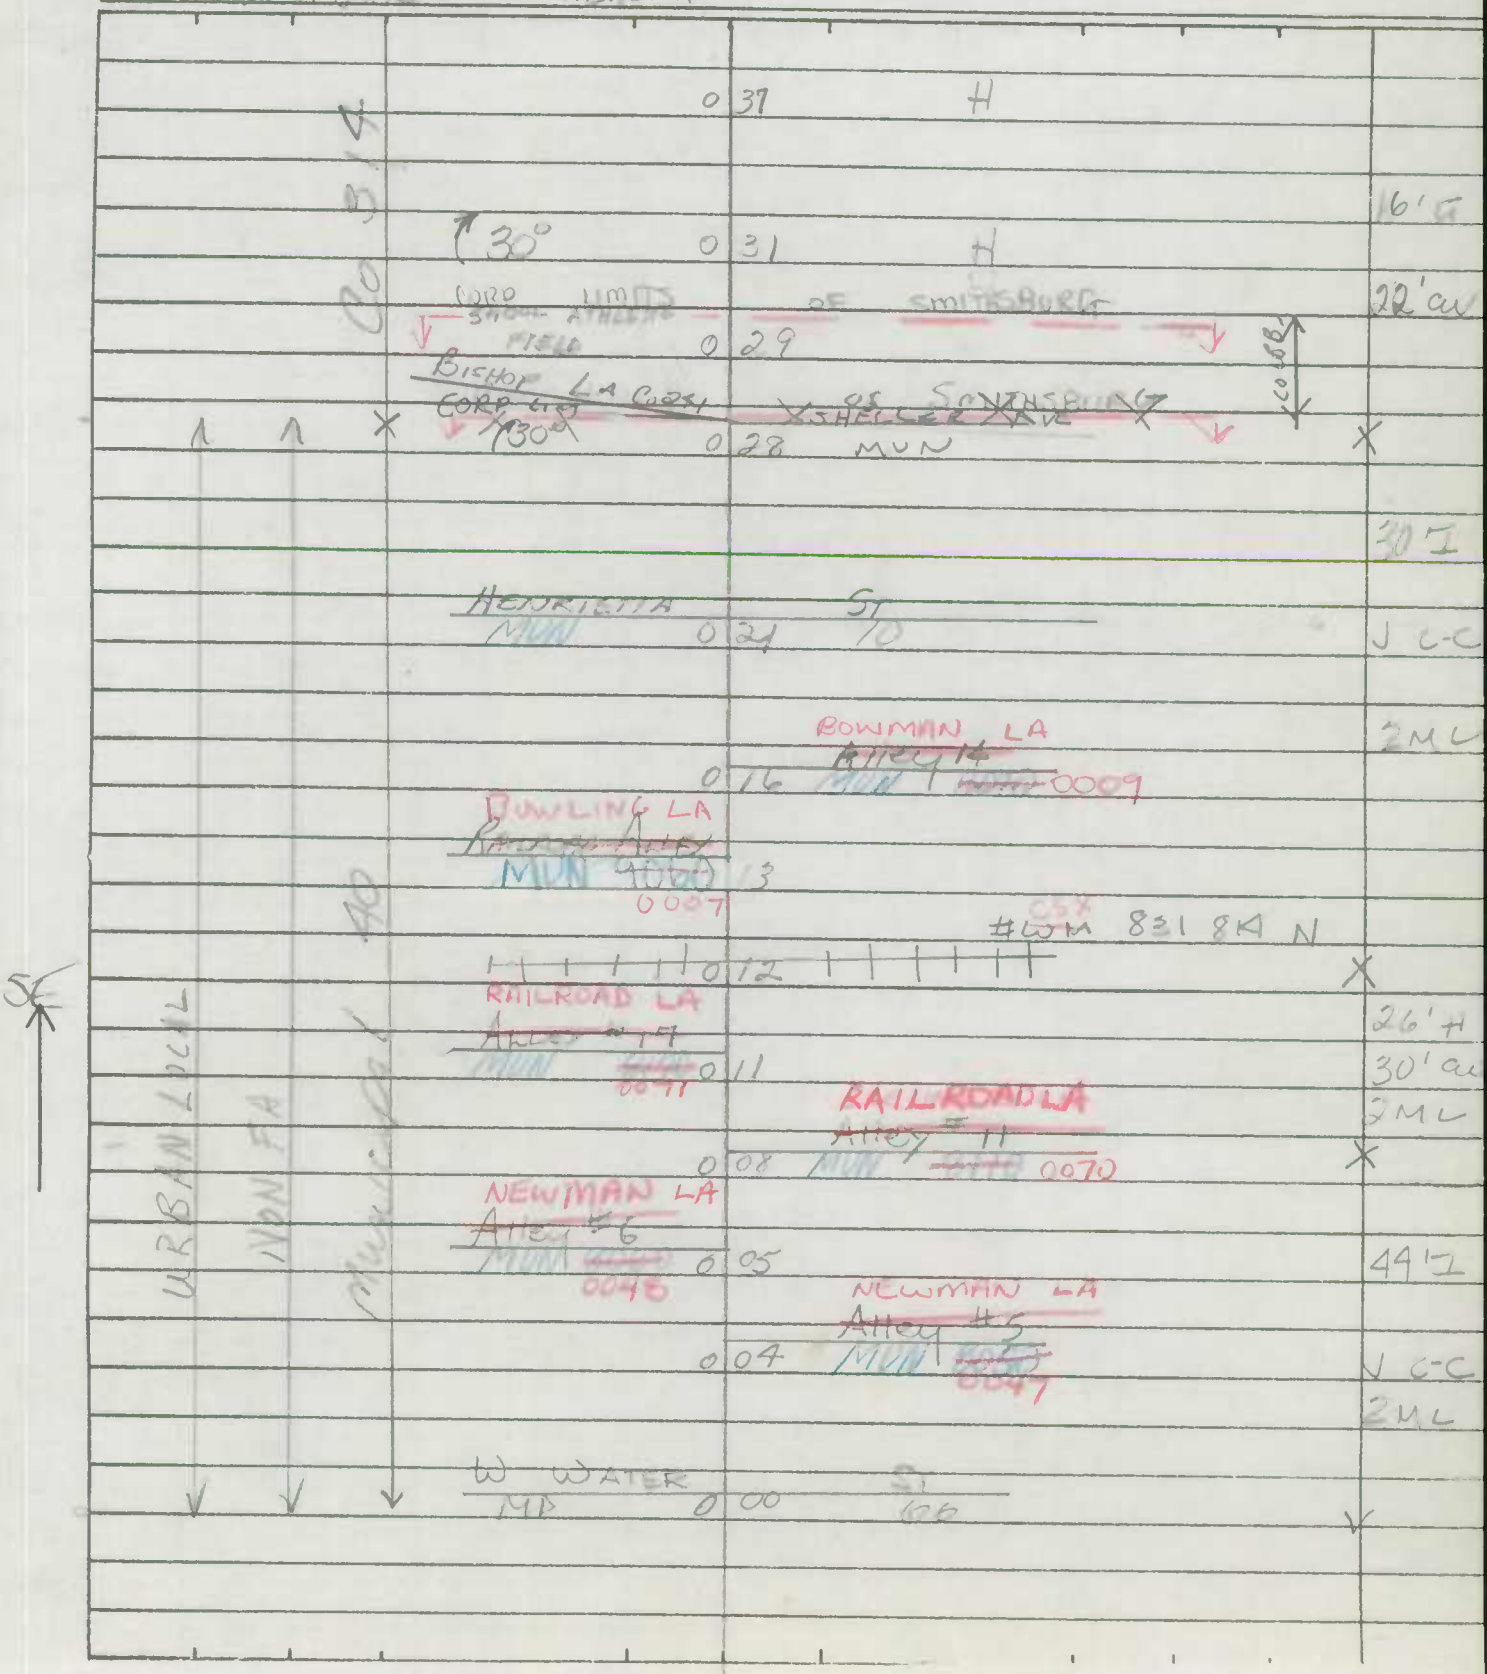

SHA 51.3-8
11-15-72

ROAD INVENTORY SHEET

Road No. _____
Road Name _____
Sheet No. _____
Date _____
County _____
State Coordinates _____

Form 6 HPS (Rev. 1961)

ROAD INVENTORY SHEET

MUN. No. 0040

Party Chief R. Vaught
Recorder L. Coffelt Jr.
Chainman

VER 6-30-76

Road No. Co. ~~305~~ 314
Name Maple St. & Mt. Lenn Rd. & ~~Route 4~~
Sheet No. 1 of 10
Date 9-10-63
County Wash

→	0	44	See Sh 1A	12'H 16'CW.
B. Cider Mill	0	42		X
A	0	38		
Mt. Lenn Rd.	0	37		
Co	0	31	H	
School Athletic Field	0	29		16'G 22'CW.
Bishop La.	0	28	SHELLER AVE MUN	X
Maple St.	0	~~22~~	~~ALLEY~~	
Henrietta	0	21		
			ALLEY 14	
	0	16		
RAILROAD ALLEY				
	0	13	#MUN 831 814N	30'I JC-C
W. H.	0	12		X 2ML
Alley #7	0	11		26'H
Alley #H	0	09		30'CW X 2ML
Alley #6	0	05		
Alley #5	0	04		44'I JC-C
W. Water St.	0	00	St. Sole	X 2ML

Form 6 HPS (Rev. 1961)

Urban

ROAD INVENTORY SHEET

Party Chief R. VOUGHT
Recorder L. COFFELT J.R.
Chainman

SMITHSBURG

VER 7-9-76

Road No. ~~8830~~ 0043 MOOSE LANE
Name ~~Alley #3~~
Sheet No. 1 OF 1
Date 9-10-63
County WASHINGTON

91-3

GROVE ~~Alley~~ MUN 012

~~#9~~ LA ~~000~~ 0017

S. MAIN mun Co. 006

ST 229 MUN 0020

CLARE ALLEY ~~MUN~~ 000

~~#1~~ LA ~~ROAD~~ 0013

8'H 12'CW

Form 6 HPS (Rev. 1961)

Mun. No. 0060 PENNSYLVANIA AVE &

ROAD INVENTORY SHEET 0080 WATER ST.

Party Chief R. Vaught
Recorder L. Coffelt, Jr.
Chainman

Road No. Md. 66
Name
Sheet No. 3 of 15
Date 10-22-63
County Wash.

VER 7-9-76

URBAN
RURAL
Commercial
New
Municipal
Transferred
7-5-66

		1 72	Cem.	
	Alley 7	1 52		
	Maple Ave.	1 46		I
	Alley	1 40	4	
	S. Main St. Mun. Co.	1 34	N. Main St. 329 Mun.	
		1 30	Alley 8	48' I
	Alley 9	1 28		
		1 23		
	E. Water St. Mun.	1 19		
				26' I
			10	
	Alley	1 14	8100	20' I
			Smithsburg	23 CW
		1 09		
3 H		1 06	3 H	18' H
		1 04		23' CW.
		1 02	Church	

Form 6 HPS (Rev. 1961)

4

ROAD INVENTORY SHEET

Party Chief R. Vought
Recorder L. Coffelt, Jr.
Chainman

Road No. Md. 66
Name
Sheet No. 4 of 15
Date 10-22-63
County Wash.

H 209

H 207

R R R R 206

CB

202

Auto Signal Lights

199 Auto Signal Lights

5 H

Pvt. Ent. 198 (300)

194 R R R R

195

Cave Hill Rd. Co. 251

191

190 Ht.

H 183 Ht.

182 P.E. Sub Station. Elect.

H 181

Collector Rural

NON FA

179 Smithsburg 18'H 23'C.W.

178

old Mill Rd. (Mun.) 177

MUN

same

174 ± Maint Stake

URBAN Collector

Form 6 HPS (Rev. 1961)

Mun. No. 0060 PENNSYLVANIA AVE & WATER ST

ROAD INVENTORY SHEET (0070)

4

Party Chief R. Vaught
Recorder C. Cotterill, Jr.
Chairman

Road No. Md. 66
Name
Sheet No. 3 of 15
Date 10-22-63
County Wash.

SEE PA. AVE INV PRECEDING PG.

		1	72	Cem.	
	Alley I	1	52		
	Maple Ave.	1	46		24'I
					2-2'I Hdrs
	Alley	1	40	4	2-7'H Shds
					48'C-C
	S. Main St.			N. Main St.	
	N. Mun. Co.	1	34	329 Mun.	X
		1	30	Alley 8	
X	Alley 7	1	28		
					20'I
					2-3'I Hdrs
		1	23		3-11'H Shds
					48'C-C
X	E. Water St.	1	19		X
					14'I
					3-I Hdrs LT
					7'I Hdrs RT
					Curb LT.
	Alley			10	27'CW.
		1	14		X 14'I
					2-3'I Hdrs
V	N. Main	1	09	Smithsburg (30°)	X 20'C
	3 H	1	06	3 H	18'H
					23'CW.
		1	03	Church	

TRANSFERRED

SHA 51.3-8
11-15-72

STATE HIGHWAY ADMINISTRATION OF MARYLAND

Wr ban NT 4

VER 7-9-76

ROAD INVENTORY SHEET

Schaller Ave.

Party Chief I. LANDON REV.
Recorder E. RHODES 3/28/78
Helper _____

Map No. _____ SMITHSBURG 74-2

Road No. MUN. 0090
Road Name (~~SHELLER AVE.~~)
Sheet No. 1 OF 1
Date 2/20/75
County WASHINGTON
State Coordinates _____

(DOUGLAS CT.)
MUN. 0 18 0008

20'I
2-5'F
SHLD.

(CHIPS CT)
MUN. 0005 0 13

PT
90°
PC

X 36'CW

0 09

~~ROAD END~~
~~005~~

BOWMAN LA
ALLEY 14
0 04 MUN. ~~8440~~ 0009

24'I
IC. RT.
30'CW

~~12'I~~
~~15'CW~~

MAPLE
MUN.

~~14~~ AVE.
~~CUL~~
0040

0 00

BISHOP AVE.
MUN.

URBAN-LOCAL
RURAL-MINOR COLL.

N

SHA 51.3-8
11-15-72

ROAD INVENTORY SHEET

Road No. _____
Road Name _____
Sheet No. _____
Date _____
County _____
State Coordinates _____

Form 6 HPS (Rev. 1961)

urban

ROAD INVENTORY SHEET

Party Chief R. VOUGHT

Recorder ~~L. GOFFELT JR.~~

Chainman

SMITHSBURG

VER 7-9-76

School La.

Road No. ~~8010~~ 0092

Name ~~ALLEY #4~~

Sheet No. 1 OF 1

Date 9 - 10 - 63

County WASHINGTON

WASHINGTON CT

~~ALLEY #4~~

MUN

0012

0008

URBAN LOCAL

NON FA

MUN

CO.

0006

ST

~~E19~~ MUN

~~ALLEY #10~~

MUN

~~0092~~ 0090

~~K'G~~

~~H D~~

~~H CO~~

16'I

JC-C

12'I

16'CW

SHA 51.3 - 8 Revised
4.83

MARYLAND STATE HIGHWAY ADMINISTRATION

URBAN

ROAD INVENTORY SHEET SCHOOL LA

Party Chief OFFICE-INV
Recorder J. SMITH
Assistant
Map No./Dir. 1 S
State Coordinates

Road No. 0093
Road Name ~~ALLEY 10 A~~
County WASH
Date 12-15-87
Sheet No. 1 OF 1

SYSTEM				TRAFFIC		LINE DIAGRAM	TRAFFIC			PAVEMENT DATA
FED. AID.	FUNCT CLASS.	HWY. SYS.	HPMS SAMPLE	PRKG. REST.	COM/IND. ACCESS		CONTROL	COM/IND. ACCESS	PRKG. REST.	

TRAFFIC CODES
TRAFFIC CONTROLS: STOP SIGN=SS, TRAFFIC LIGHT=T.L., FLASHING RED BALL=F.R.

TRAFFIC CODES
PARKING RESTRICTIONS: A.M. PEAK, P.M. PEAK, A.M./P.M. PEAK, NO PARKING ANYTIME=N.P., COMM/IND. ACCESS=E

NON EA
URBAN LOCAL

FIRE COMPA LA
0015
MUN

FIRE COMPANY LA
~~ALLEY #2~~
10 MUN 8020
0014

~~ALLEY #19~~
~~MUN 8190~~
0017

SCHOOL # LA
~~ALLEY #1~~
0100 MUN 8010 0092

10' I
16' CW

SYSTEM				TRAFFIC		LINE DIAGRAM	TRAFFIC			PAVEMENT DATA
FED. AID.	FUNCT. CLASS.	HWY. SYS.	HPMS SAMPLE	PRK.G. REST.	COM/IND ACCESS		CONTROL	COM/IND ACCESS	PRK.G. REST.	

Form 6 HPS (Rev. 1961)

urban

ROAD INVENTORY SHEET

Party Chief R. VOUGHT
Recorder L. COFFELT JR.
Chainman

SMITHSBURG

VER 7-9-76 Sra

A/T 83-3

Road No. 8100
Name ALLEY #10
Sheet No. 1 OF 1
Date 9-10-63
County WASHINGTON

86-2

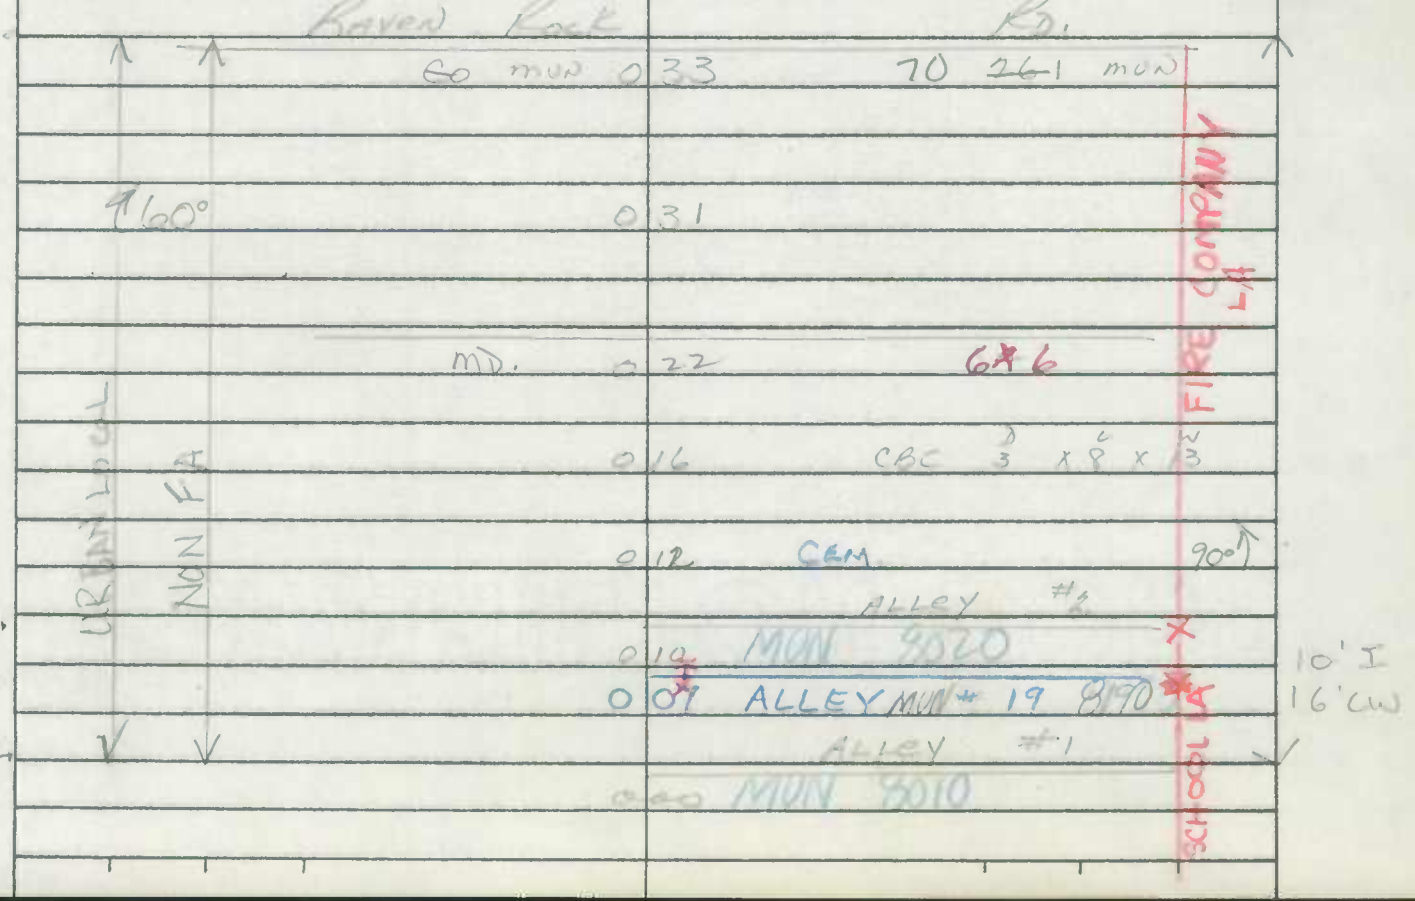

Form 6 HPS (Rev. 1961)

4

ROAD INVENTORY SHEET

Party Chief R. VOUGHT
Recorder ~~L. JEFFELT JR.~~
Chainman
SMITHSBURG VED 7-9-76

Road No. 8120
Name ALLEY 12
Sheet No. 1 OF 1
Date 9 - 10 - 63
County WASHINGTON

BISHOP	LA
0.16	
HENRIETTA	ST
0.07	
0.00	
MUN	ST
0.40	

10' I
14' W
2 W

SHA 51.3-8
11-15-72

STATE HIGHWAY ADMINISTRATION OF MARYLAND

urban

ROAD INVENTORY SHEET

Party Chief BB
Recorder NS
Helper

Map No.

SMITHSBURG

Road No. MUN 8190
Road Name ALLEY # 19
Sheet No. 1 OF 1
Date 3/23/84
County WASHINGTON
State Coordinates

AT 84-7

ABAN.

SEE LETTER DATED DEC 3, 1987

SW

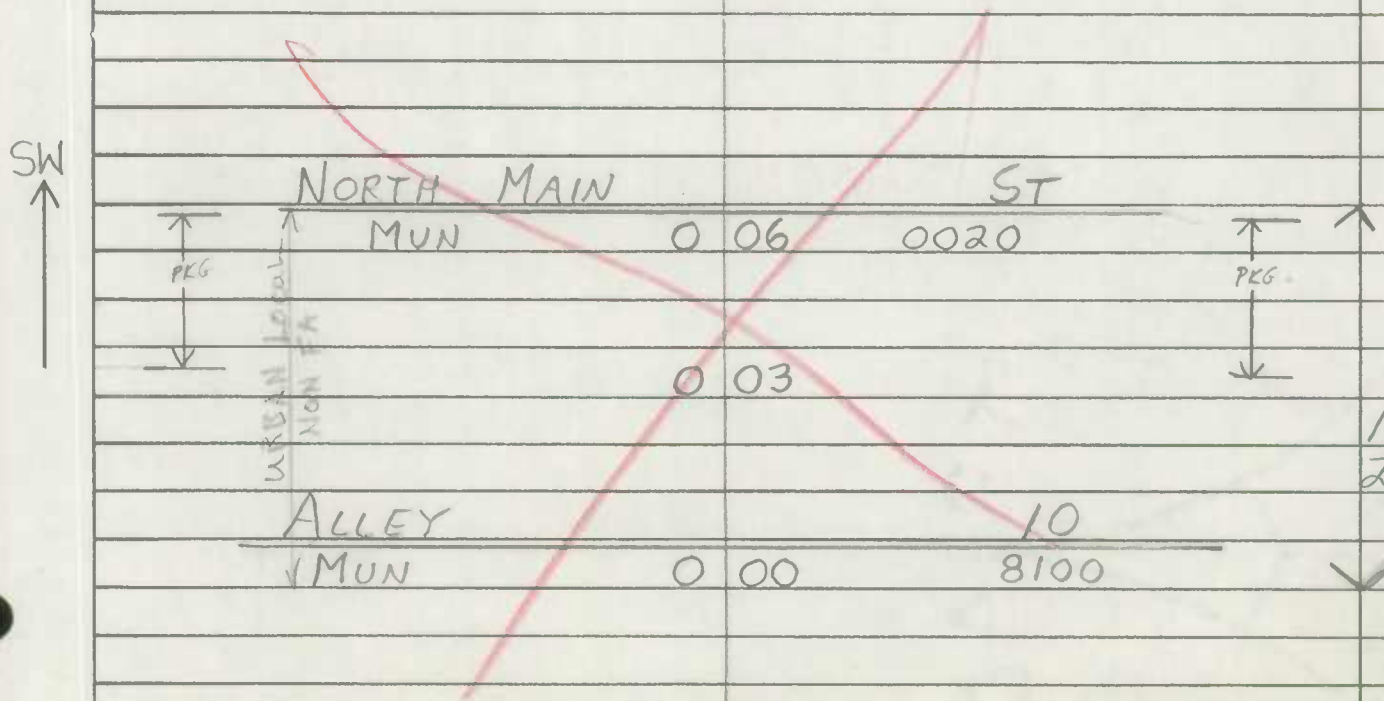

SHA 51.3-8
11-15-72

ROAD INVENTORY SHEET

Road No. _____
Road Name _____
Sheet No. _____
Date _____
County _____
State Coordinates _____

Form 6 HPS (Rev. 1961)

3/8/91 DTED (88-EXTRA) P9-11

OFFICE COPY

ROAD INVENTORY SHEET

Party Chief
Recorder
Chainman

91-2, 88/SP 3-9-92

VER 6-17-75

BBREV FR 10-28-82

Road No. 0010 - 0020
Name N & S ARTIZAN ST
Sheet No. 1 of 2
Date 10-16-63
County WASHINGTON

76-1 91-3 A/T 75-7 A2 Travel

N. ARTIZAN ST

WILLIAMSPORT SANITARIUM 7 95

30° ALLEY 4

MON 7 80 0010

E POTOMAC ST

U.S. 11 7 75 US 11 @ 8.04

E SALISBURY 7 72 CBC 6'x 2' x 1'6" ±

MON 7 66 190

E CHURCH ST

MON 40 7 57

E. FREDERICK ST

MON 30 7 48

ALLEY 13

MON 5130 7 43

E. SUNSET

7 39

210 AVE MD. 6

CHURCH 7 38

7 36

WILLIAMS P

7 18 CO. 507 HILL

H 7 17

7 16

CORP LMTS

7 13

6 H

7 06

7 03

S. ARTIZAN ST

LOCAL NB GRAV

MUNICIPAL EXTENSION OF STATE RD 0010

Williamsport

Form 6 HPS (Rev. 1961)

OERICK CORY

ROAD INVENTORY SHEET

Party Chief
Recorder
Chainman

91-2, 88/SP 3-9-92

VER 6-17-75

BBREV FR 10-28-82

Road No. 0010 - 0020
Name N & S ARTIZAN ST
Sheet No. 1 of 2
Date 10-16-63
County WASHINGTON

91-3 A/P 75-7 A: TRAVERSE

MUNICIPAL EXTENSION OF STATE RD

N. ARTIZAN ST

	WILLIAMSPORT SANITARIUM	7 95	33'I
	(30° ALLEY	4	J-CC 2ML
	MUN	7 80 0010	~~32'I~~
	E POTOMAC ST		~~C-C~~
	U.S. 11	7 75 US 11 @ 8.04	
	E SALISBURY ST	7 72 CBC 6'x 2' x 90° ±	
	MUN	7 66 190	
	E CHURCH ST		
	MUN	7 57	
	E. FREDERICK ST		
	MUN 30	7 48	
S. ARTIZAN ST	ALLEY 13		
	MUN 9130	7 43	
	E. SUNSET		
	MUN	7 39 210 AVE MD. 68	40'I
	CHURCH	7 38	~~39'I~~
			JC-C
		7 36	2 ML
		WILLIAMSPORT (1962)	
		7 18 CO. 507 HILLCREST AVE	
	H	7 17	
		7 16	
	CORP LMTS		
	6 H	7 13	10 H 18'H
			24'CW
		7 06	
		7 03	

LOCAL VERIFY

Form 6 HPS (Rev. 1961)

ROAD INVENTORY SHEET

~~MD 63-H~~

Party Chief
Recorder
Chainman

Road No.
Name N & S ARTIZAN ST
Sheet No. 2 of 2
Date
County WASHINGTON

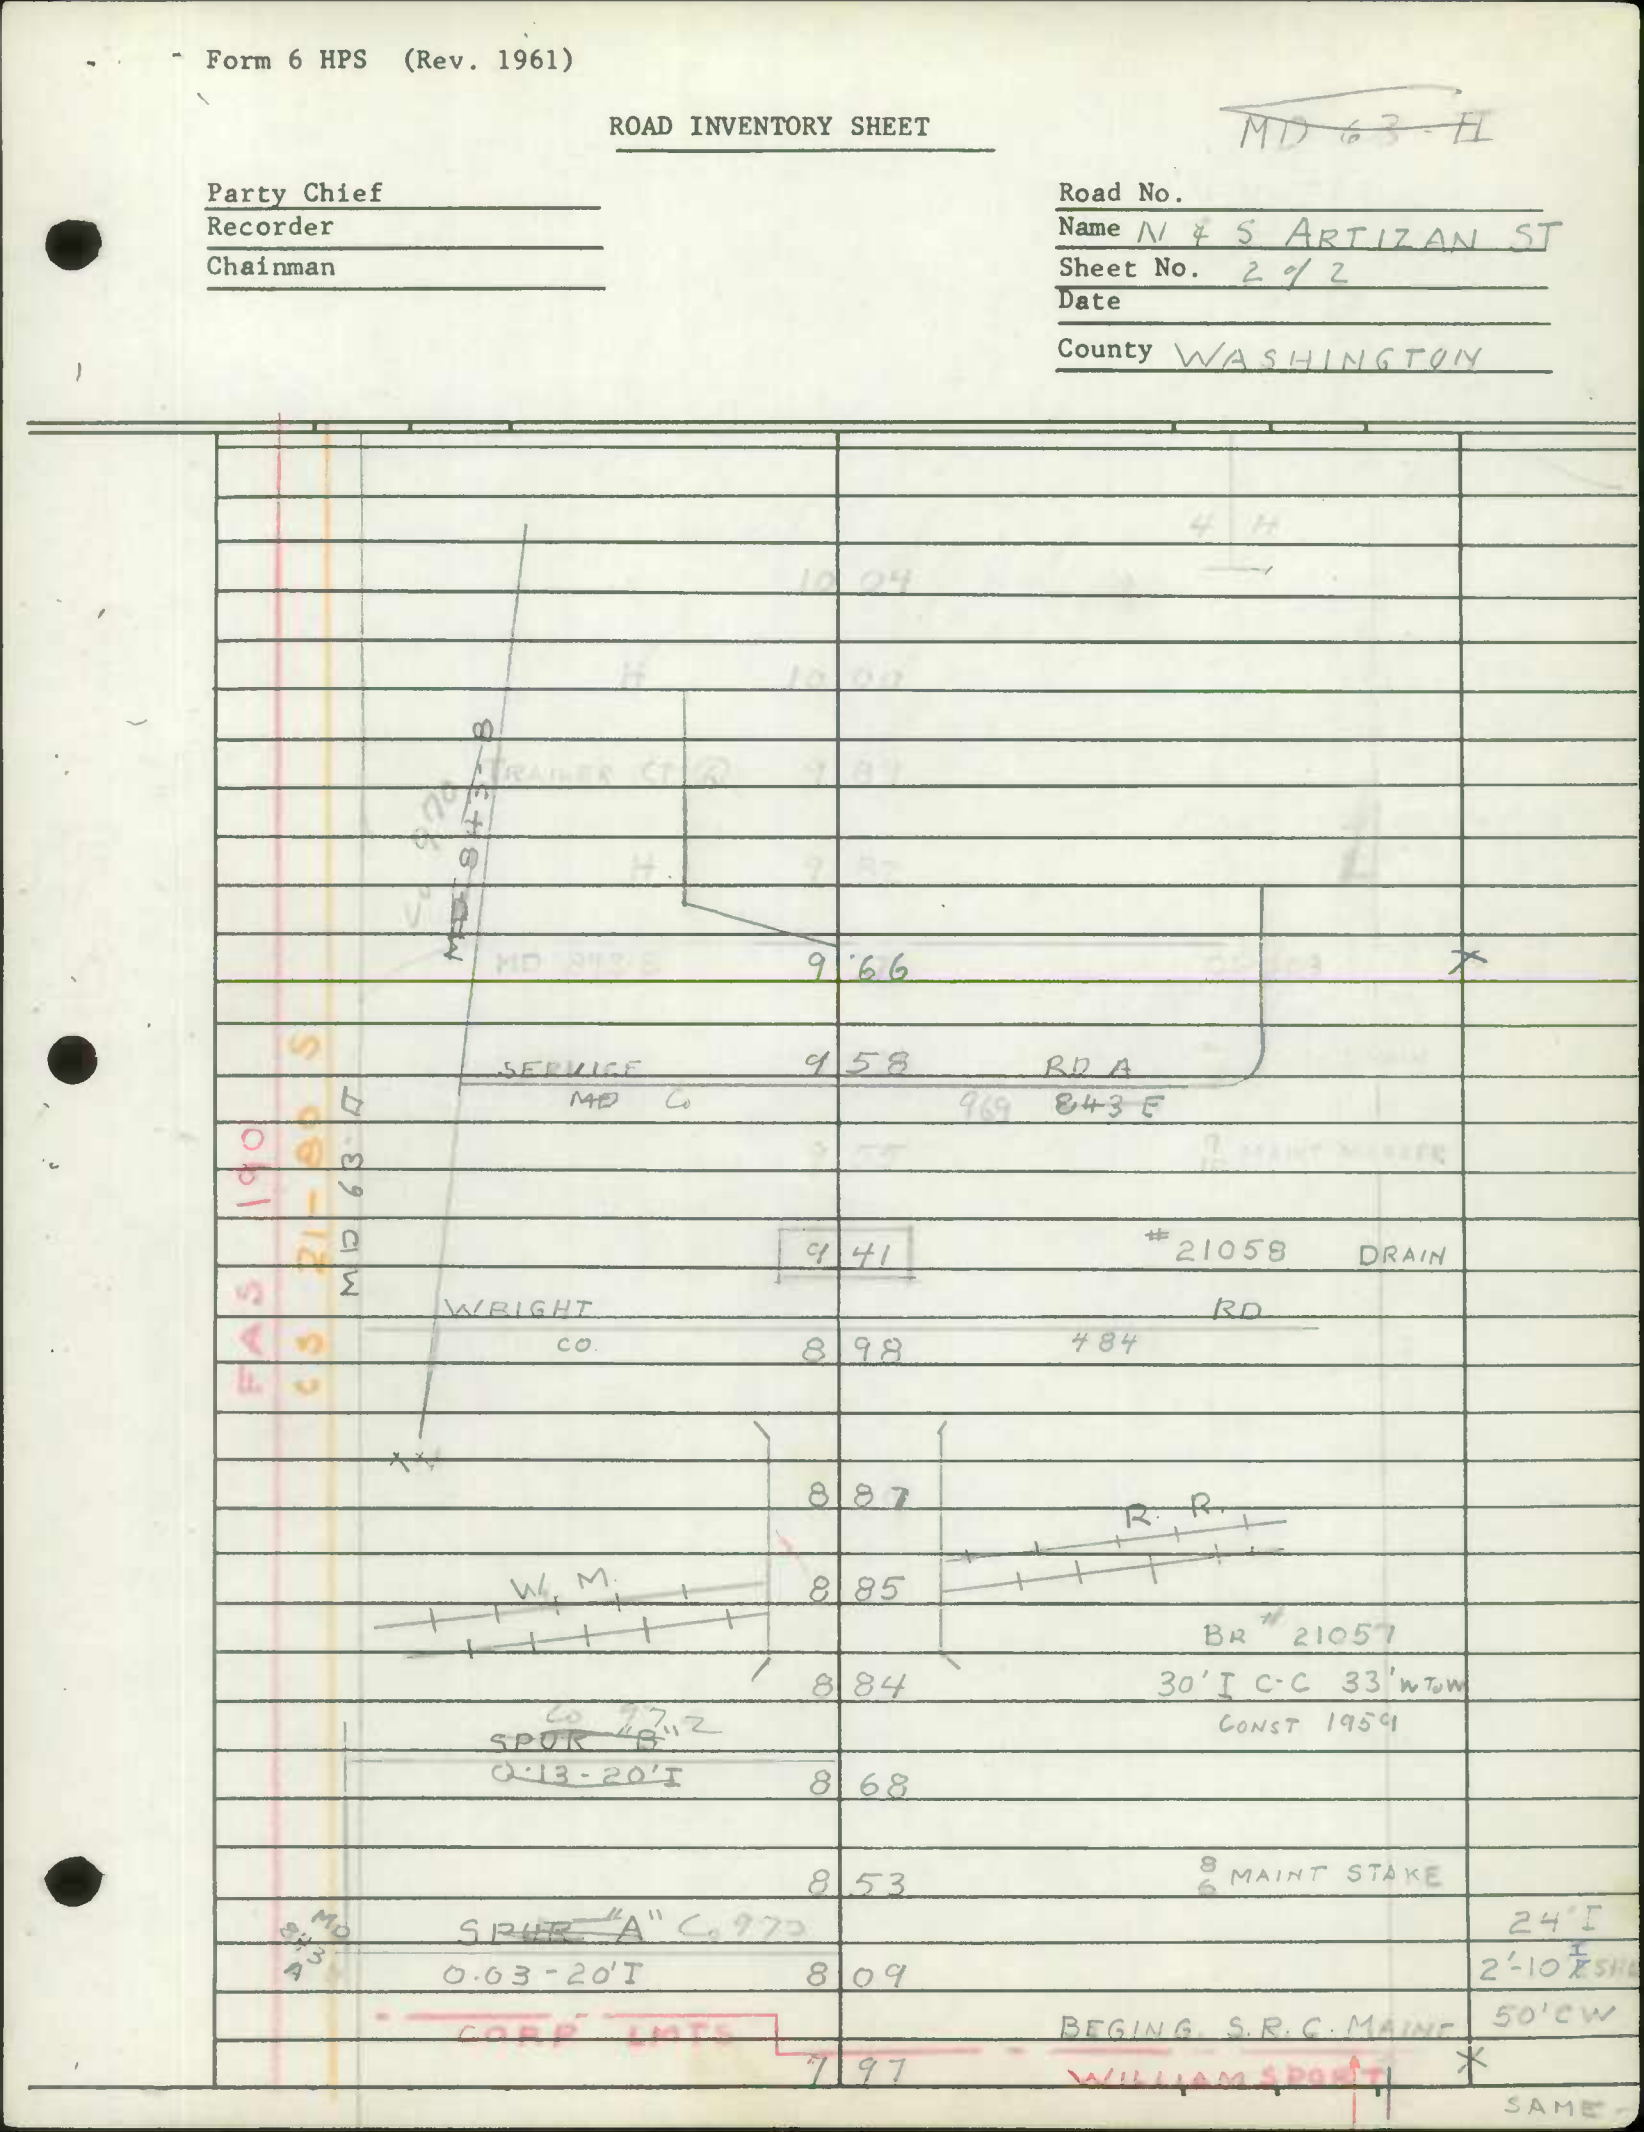

Form 6 HPS (Rev. 1961)

89-1,2
DT/CG
1/31/90

ROAD INVENTORY SHEET

Party Chief R. Vought
Recorder L. Coffelt Jr.
Chainman
Williamsport

VER 7-12-76

86-2
CB/AL
4-19-87
AT

Road No. 0040
Name E & W. Church St.
Sheet No. 1 of 1
Date 9-30-63
County Wash.

SEE NEW INV
FCR-97
GD MP
11/7/97

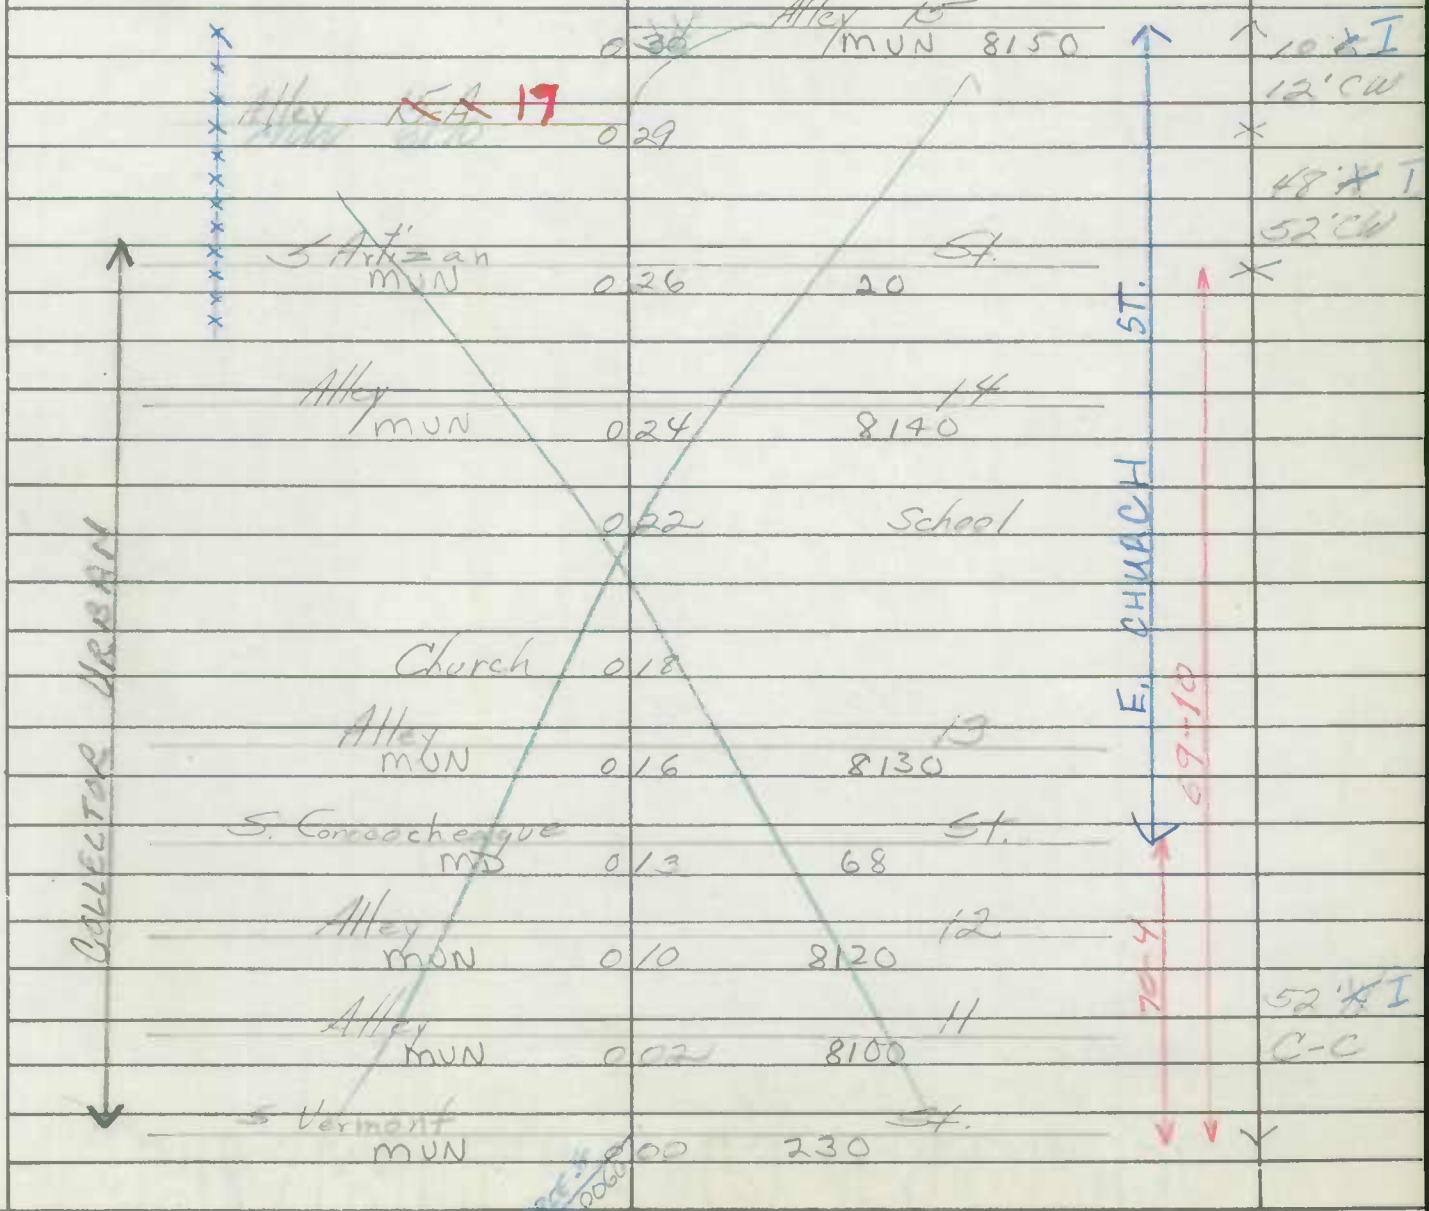

Form 6 HPS (Rev. 1961)

AL/GS
8-7-3
3-24-88
ALT

MD A9-77

4

ROAD INVENTORY SHEET

Pear Tree LA

Party Chief R. VOUGHT
Recorder L. COFFELT JR.
Chainman

91MVEx#1
91FIDEx#1

VER 7-12-76
BB/SP 3-9-92

Road No. 0050
Name ~~N. CLIFTON DR~~
Sheet No. 1 OF 1
Date 10-1-63
County WASHINGTON

Williamsport

REVISED 4-27-71 DAB

~~SCHOOL~~

~~ROAD 028 END SCHOOL~~

N CLIFTON DR

~~EXT TO SHEET 2~~

~~MAPLEHURST AVE~~
~~MON 130~~

~~045~~

L POTOMAC
U.S. 007 ST 11

ALLEY 18 MON 6 IRO

003

~~20'H~~
~~20'CW~~
~~40'I~~
30'I
36'CW
2 ML
20'I
~~30'I~~
30'CW

PEAR TREE LA
050

Clover + RD
~~CHEVY~~
Co

LA

000 50'I

Form 6 HPS (Rev. 1961) * Depiction of intersections @ m.p. 0.18 is incorrect - KSP

pg-17

ROAD INVENTORY SHEET

93 MM. EK #10
3-14-94
AC/TM

VER
7-12-76

Party Chief R. Vought
Recorder L. Coffelt, Jr.
Chainman
Williamsport

Road No. 0060
Name Commerce St
Sheet No. 1 of 1
Date 9-30-63
County Wash.

77-1 76-2

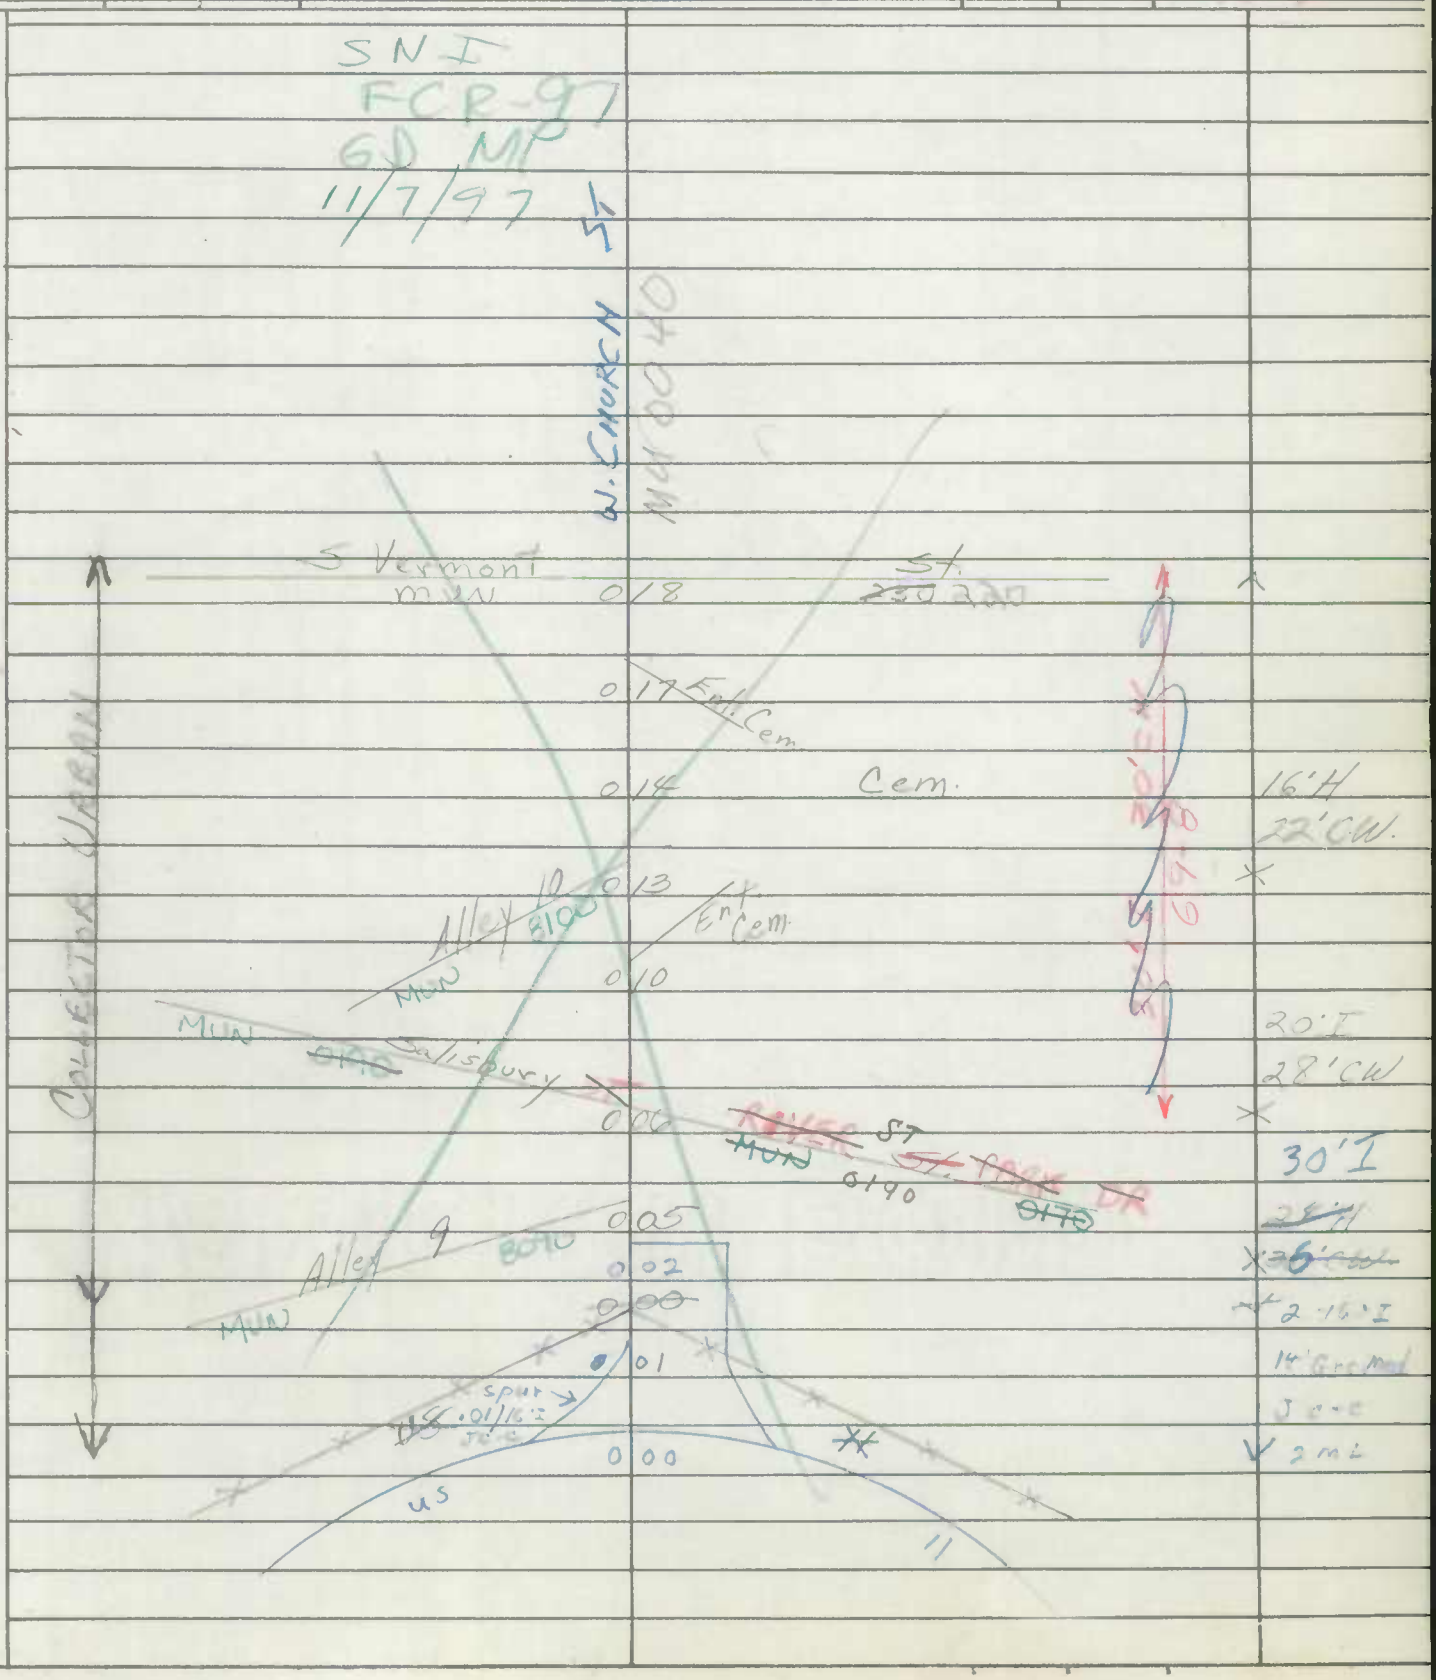

Form 6 HPS (Rev. 1961)

89-1,2
DT/CG
1/31/90

P3-77

ROAD INVENTORY SHEET

MUN No. 0070

Party Chief SETTAN
Recorder LANDON
Chainman

Road No. ~~MD. 68~~
Name Conococheague St.
Sheet No. 9 of 18
Date 1-4-67
County WASH.

8 03

7 98 — 2-24' I, 2-10' F SHLD, 16' GR. MED. CURB RT.

7 96 — 48' I, 1-10' F SHLD

7 92

7 82 — J-CURB LT.

BRANDY DR. ENT TO T-H

7 74 E. SUNSET AVE — (WATER AM. LEGION HALL PARK DR.) MU 0230

MUN 210

7 66

E. FREDERICK ST — W. FREDERICK STREET

MUN — 7 57 — 80

CHURCH — 7 53

E. CHURCH ST. — W. CHURCH STREET

MUN — 7 48 — 40

E. SALISBURY — STREET

MUN — 7 39 — 190

(EAST) POTOMAC — STREET (WEST)

US — 7 30 — 11

ALLEY — FOUR

MUN — 7 26 — 3040

RR — 2 TRACKS

W M — 7 17 — #WM (32 396 l)

60°

7 14

(END CORP LMTS) — 7 12 — (SRC MAINT.) WILLIAMSPORT

PENNSYLVANIA RD

1 CONOCOCHEAGUE — 7 10 — CREEK

BR. NO. #21036 — 7 07 — 22'I C-C 5'J&V LT — 42' H C-C

Form 6 HPS (Rev. 1961)

ROAD INVENTORY SHEET

Party Chief SETTAN
Recorder LANDON
Chairman

Road No. MD 68
Name
Sheet No. 10 of 18
Date 1-4-67
County WASH.

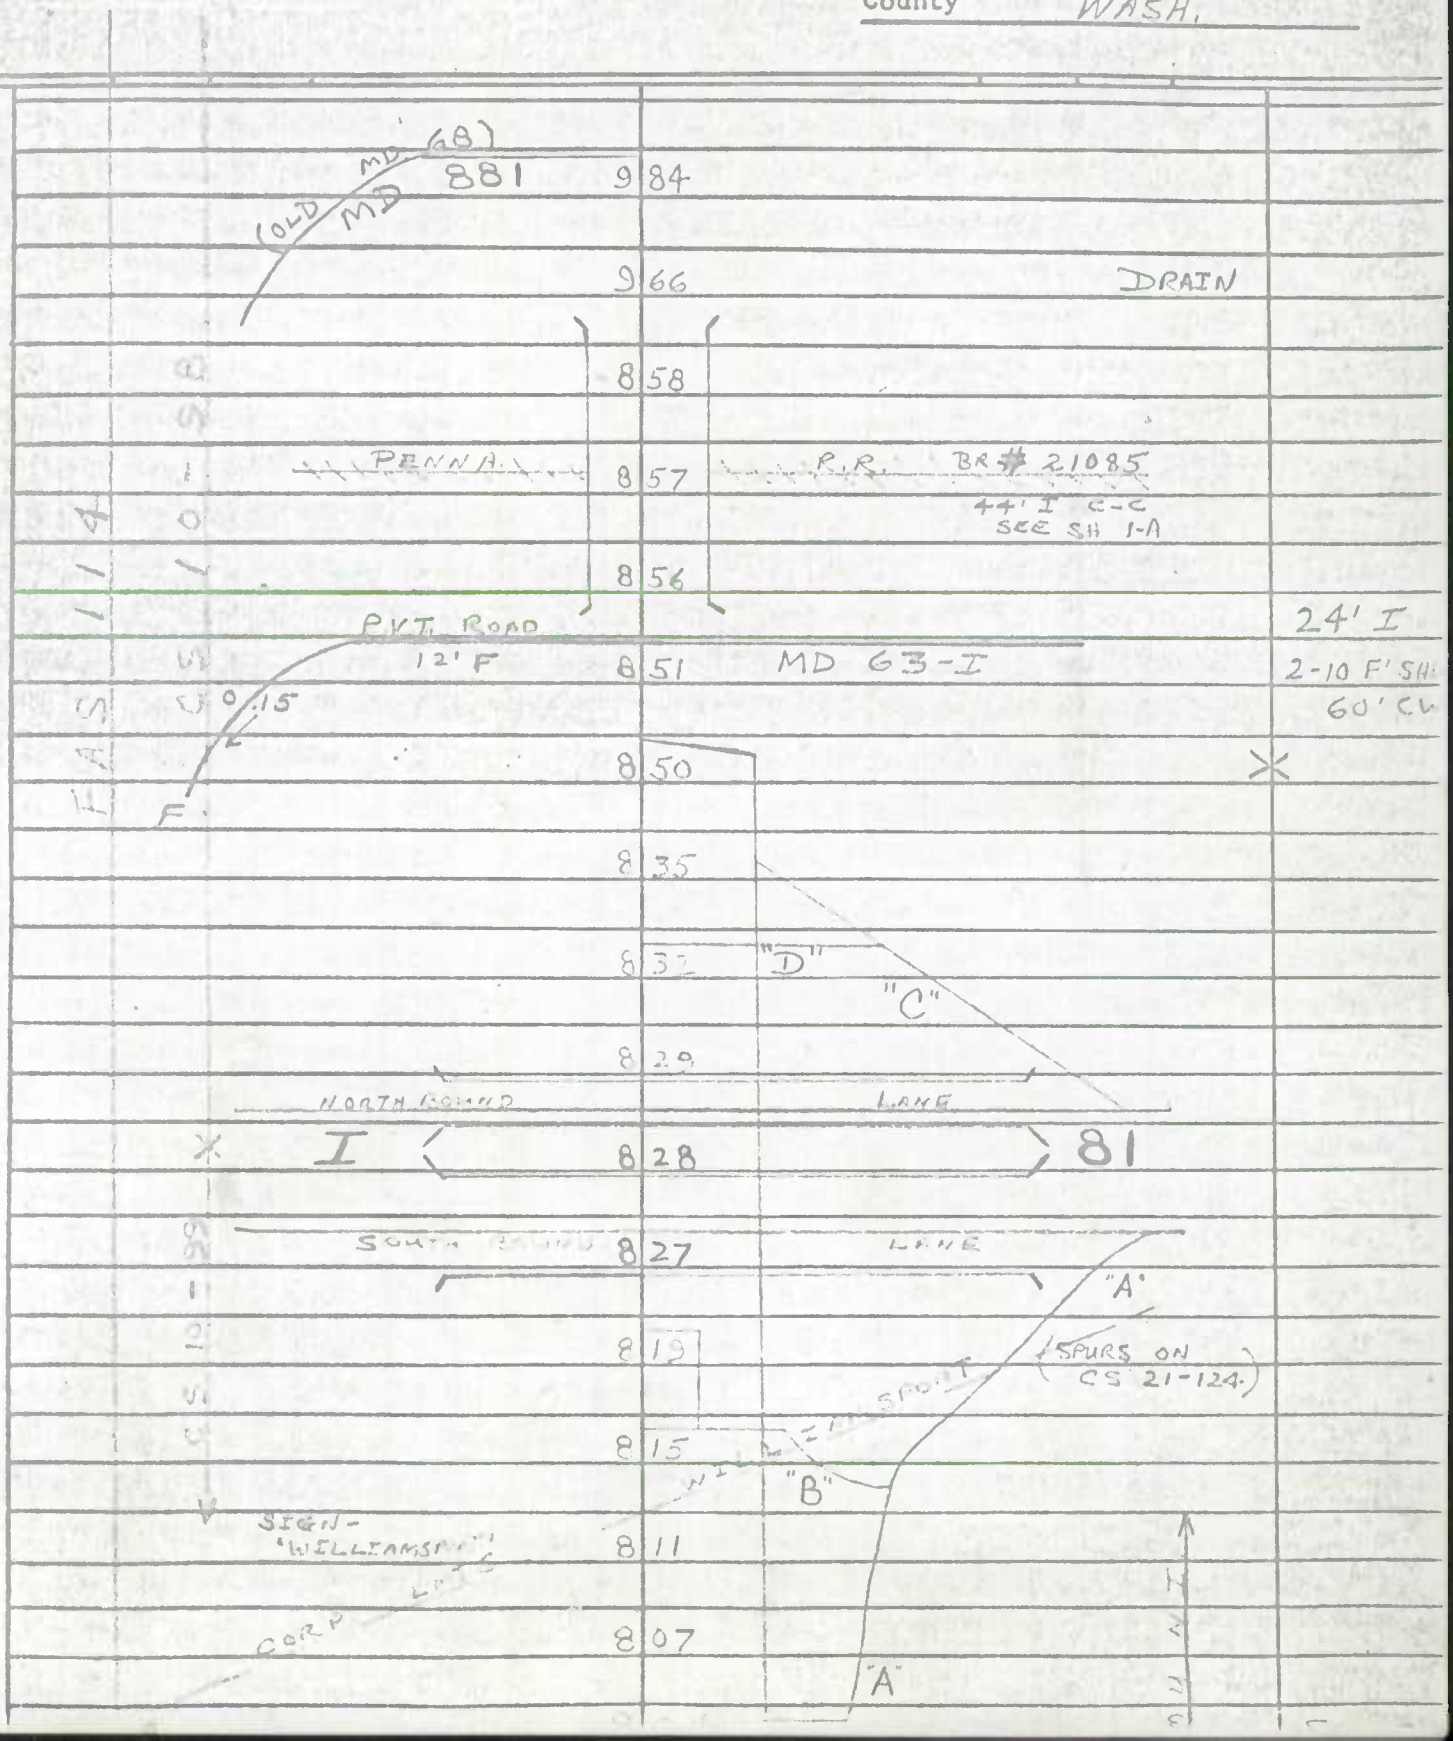

Form 6 HPS (Rev. 1961)

~~Mun. No. 0112~~ - Lockwood Rd. (pg 11)
Mun. No. 0110 - Lockwood Rd.

ROAD INVENTORY SHEET

VER 7-8-76

PARTY CHIEF Frederick Settan
RECORDER Thomas Landon
CHAINMAN

SEWAGE TREATMENT PLANT

ROAD NO. [redacted] 510
NAME LOCKWOOD RD
SHEET NO. 1 OF 1
DATE 1 - 4 - 67
COUNTY WASHINGTON

	DATE	ROAD				
		0	66 END			
PT 90° PC		0	59			
H		0	56			16'I 22'CW
CORP LMTS				Williamsport		
		0	55			
H		0	54	H		
		0	52	H		
		0	45	H	510	
		0	43	H		
		0	42	H	COUNTY	12'E 12'CW
		0	32			
PT 110° PC		0	29			
CORP LIMITS		0	24	WILLIAMSPORT		
		0	13			
		0	04	PT 80° PC		18'E 40'CW
		0	00	St		
Condoc Chearge MD				68		

SHA 51.3 - 8 Revised
4.83

Hagerstown Urban
93 MD EX 62
A/T 3-14-94
AL/TM

MARYLAND STATE HIGHWAY ADMINISTRATION

Williamsport

ROAD INVENTORY SHEET

Co 1116

Party Chief D. Taylor
Recorder F. Rhodes
Assistant Rewritten 11-8-91 KJP
Map No./Dir. 1 N
State Coordinates

Road No. MUN 0138
Road Name Milestone Terr
County Washington
Date 4-18-79
Sheet No. 1 OF 1

89-3 (mun)
DT/CG
1-31-90

TRAFFIC CODES
TRAFFIC CONTROLS: STOP SIGN=SS, TRAFFIC LIGHT=T.L., FLASHING RED BALL=F.R.

TRAFFIC CODES
PARKING RESTRICTIONS: A.M. PEAK, P.M. PEAK, A.M./P.M. PEAK, NO PARKING ANYTIME=N.P., COMM/IND. ACCESS=E

SYSTEM				TRAFFIC		LINE DIAGRAM	TRAFFIC			PAVEMENT DATA
FED. AID.	FUNCT CLASS.	HWY. SYS.	HPMS SAMPLE	PKG. REST.	COM/IND. ACCESS		CONTROL	COM/IND. ACCESS	PKG. REST.	
						SNI FCR - 97 GD MP 11/7/97				
						(Oak Tree La.) MUN 0 18 0133				
				E		Tri-State Indoor Racquet Club 0 15 Apts.		E		
						0 13 Apts.		E		42' I
						MUN 0138				J C-C
						Hopewell Rd				
						Relocated 64 to 473 and 473 to 64 — 0 10 Co 473				
						0 08 Co 1116				
						* Site of old Corp. Limits * 0 05 County Urban				36' I
										J C-C
						E. Potomac ST. MUN 0138				3 ML
						US 0 00 11 @ 1.33				

NON F/A
Urban Local
Urban Collector
was part of Co 473 Hopewell Rd
was Md 60 Hopewell Rd

SYSTEM				TRAFFIC		LINE DIAGRAM	TRAFFIC				PAVEMENT DATA
FED. AID.	FUNCT. CLASS.	HWY. SYS.	HPMS SAMPLE	PRKG. REST.	COM/IND ACCESS		CONTROL	COM/IND ACCESS	PRKG. REST.		

SHA 51.3-8
11-15-72

STATE HIGHWAY ADMINISTRATION OF MARYLAND

89-3
DT/CG
1/31/90

ROAD INVENTORY SHEET

Party Chief DT
Recorder ER.
Helper

Map No. GH22 78-2

Road No. MUN. 0138
Road Name (MILESTONE TERR.)
Sheet No. 1 OF 1
Date 4-18-79
County WASH.
State Coordinates

WILLIAMSPORT

N

(OAK TREE MUN. 0 X 18 0 L.A.)

TRI-STATE INDOOR RACQUET CLUB 0 X 15 ENT. APTS

0 X 13 ENT. APTS.

42 I
J-C-C

HOFFMAN RD
MD CO 423

E. POTOMAC ST.

US 0 X 00 11

36' I
J-C-C
3 ML

SHA 51.3-8
11-15-72

ROAD INVENTORY SHEET

Road No. _____
Road Name _____
Sheet No. _____
Date _____
County _____
State Coordinates _____

Form 6 HPS (Rev. 1961)

ROAD INVENTORY SHEET

M.N.No. 0160 - Potomac St. W.
" " 0150 - Potomac St. E.

89-3 DT/CG 11/31/70 I

PARTY CHIEF Frederick Settan
RECORDER Thomas Landon
CHAINMAN

VCQ 6-19-75

ROAD NO. ~~U.S. 11~~
NAME E & W Potomac Street
SHEET NO. 1 OF 13
DATE 1-5-67
COUNTY WASHINGTON

WILLIAMSPORT

	CONOCOCHEAGUE		STREET	
	MD 68	0 63	MD 63 & 68	
	ALLEY MUN	0 61	8120 #12	
			MUN 9110	
		0 53	ALLEY #11	
	CHURCH	0 52		
			MUN 220	
		0 50	VERMONT STREET	
			MUN 8100	
		0 48	ALLEY #10	
			MUN 8090	52' H
		0 42	ALLEY #9	C-C
	(MUN) 140			
190°	POTOMAC ST.	0 40		24' H
			MUN 60	32' CW
		0 35	COMMERCE STREET 90°	
				26' H
				C-C
		0 33		
	N.M.	0 32	RR.	
	POTOMAC	0 31	RIVER	
	CORP LIMITS	0 13	WILLIAMSPORT	19' T
	MARYLAND		BR' 2100'	C-C
	WEST VIRGINIA	0 00	STATE LINE STATE LINE	19' T C-C
			059	
			WEST VIRGINIA DD	

MUNICIPAL EXTENSION OF STATE RD
W. POTOMAC
FAP B
MUNICIPAL
TABLE

Form 6 HPS (Rev. 1961)

ROAD INVENTORY SHEET

PARTY CHIEF Frederick Settan
RECORDER Thomas Landon
CHAINMAN

ROAD NO. ~~U.S. 11~~ I
NAME ~~E. POTOMAC ST~~
SHEET NO. 20 OF 13
DATE 1-5-67
COUNTY WASHINGTON

WILLIAMSPORT

AS TABLED 75-6

MILESTONE TERR.

MU Co 473 0138 (89-3) 1 35

B-TELEPHONE Co. 1 33

B-DRIVE IN THEATER

1 31 B-GAS

1 29

CLIFTON DR (MUN) SO

APPLETREE LANE Co 500 1 28

1 12 SPRINGFIELD LANE (MUN)

SPUR 1 09

PEACHTREE LANE Co 504 0 93

PARK RD 0 90 ENT MUN PARK

MUN ALLEY 0 79 8170 #17

ARTESIAN MD 63 ☐ C 76 STREET (MUN)

MUN 8170 ALLEY 0 74 #14

0 73 ALLEY

C 71 C. HUECH

MUN 8130 ALLEY 0 66 13

FAP

MUNICIPAL

5.6'I

~~STAPLE I-9~~

~~60'I~~

2-11'HSHD

J-C-C

3 ML

X

TANGENT AS 2-11

N 6° E

26'I

2-10'HSHD

50'CW

2 ML

X

50'I

54'CW

X 2 ML

~~4.6'I~~

38'CW

Form 6 HPS (Rev. 1961)

ROAD INVENTORY SHEET

PARTY CHIEF Frederick Settan
RECORDER Thomas Landon
CHAINMAN

ROAD NO. ~~U.S. 11~~ I
NAME POTOMAC ST
SHEET NO. 30 OF 13
DATE 1-5-67
COUNTY WASHINGTON

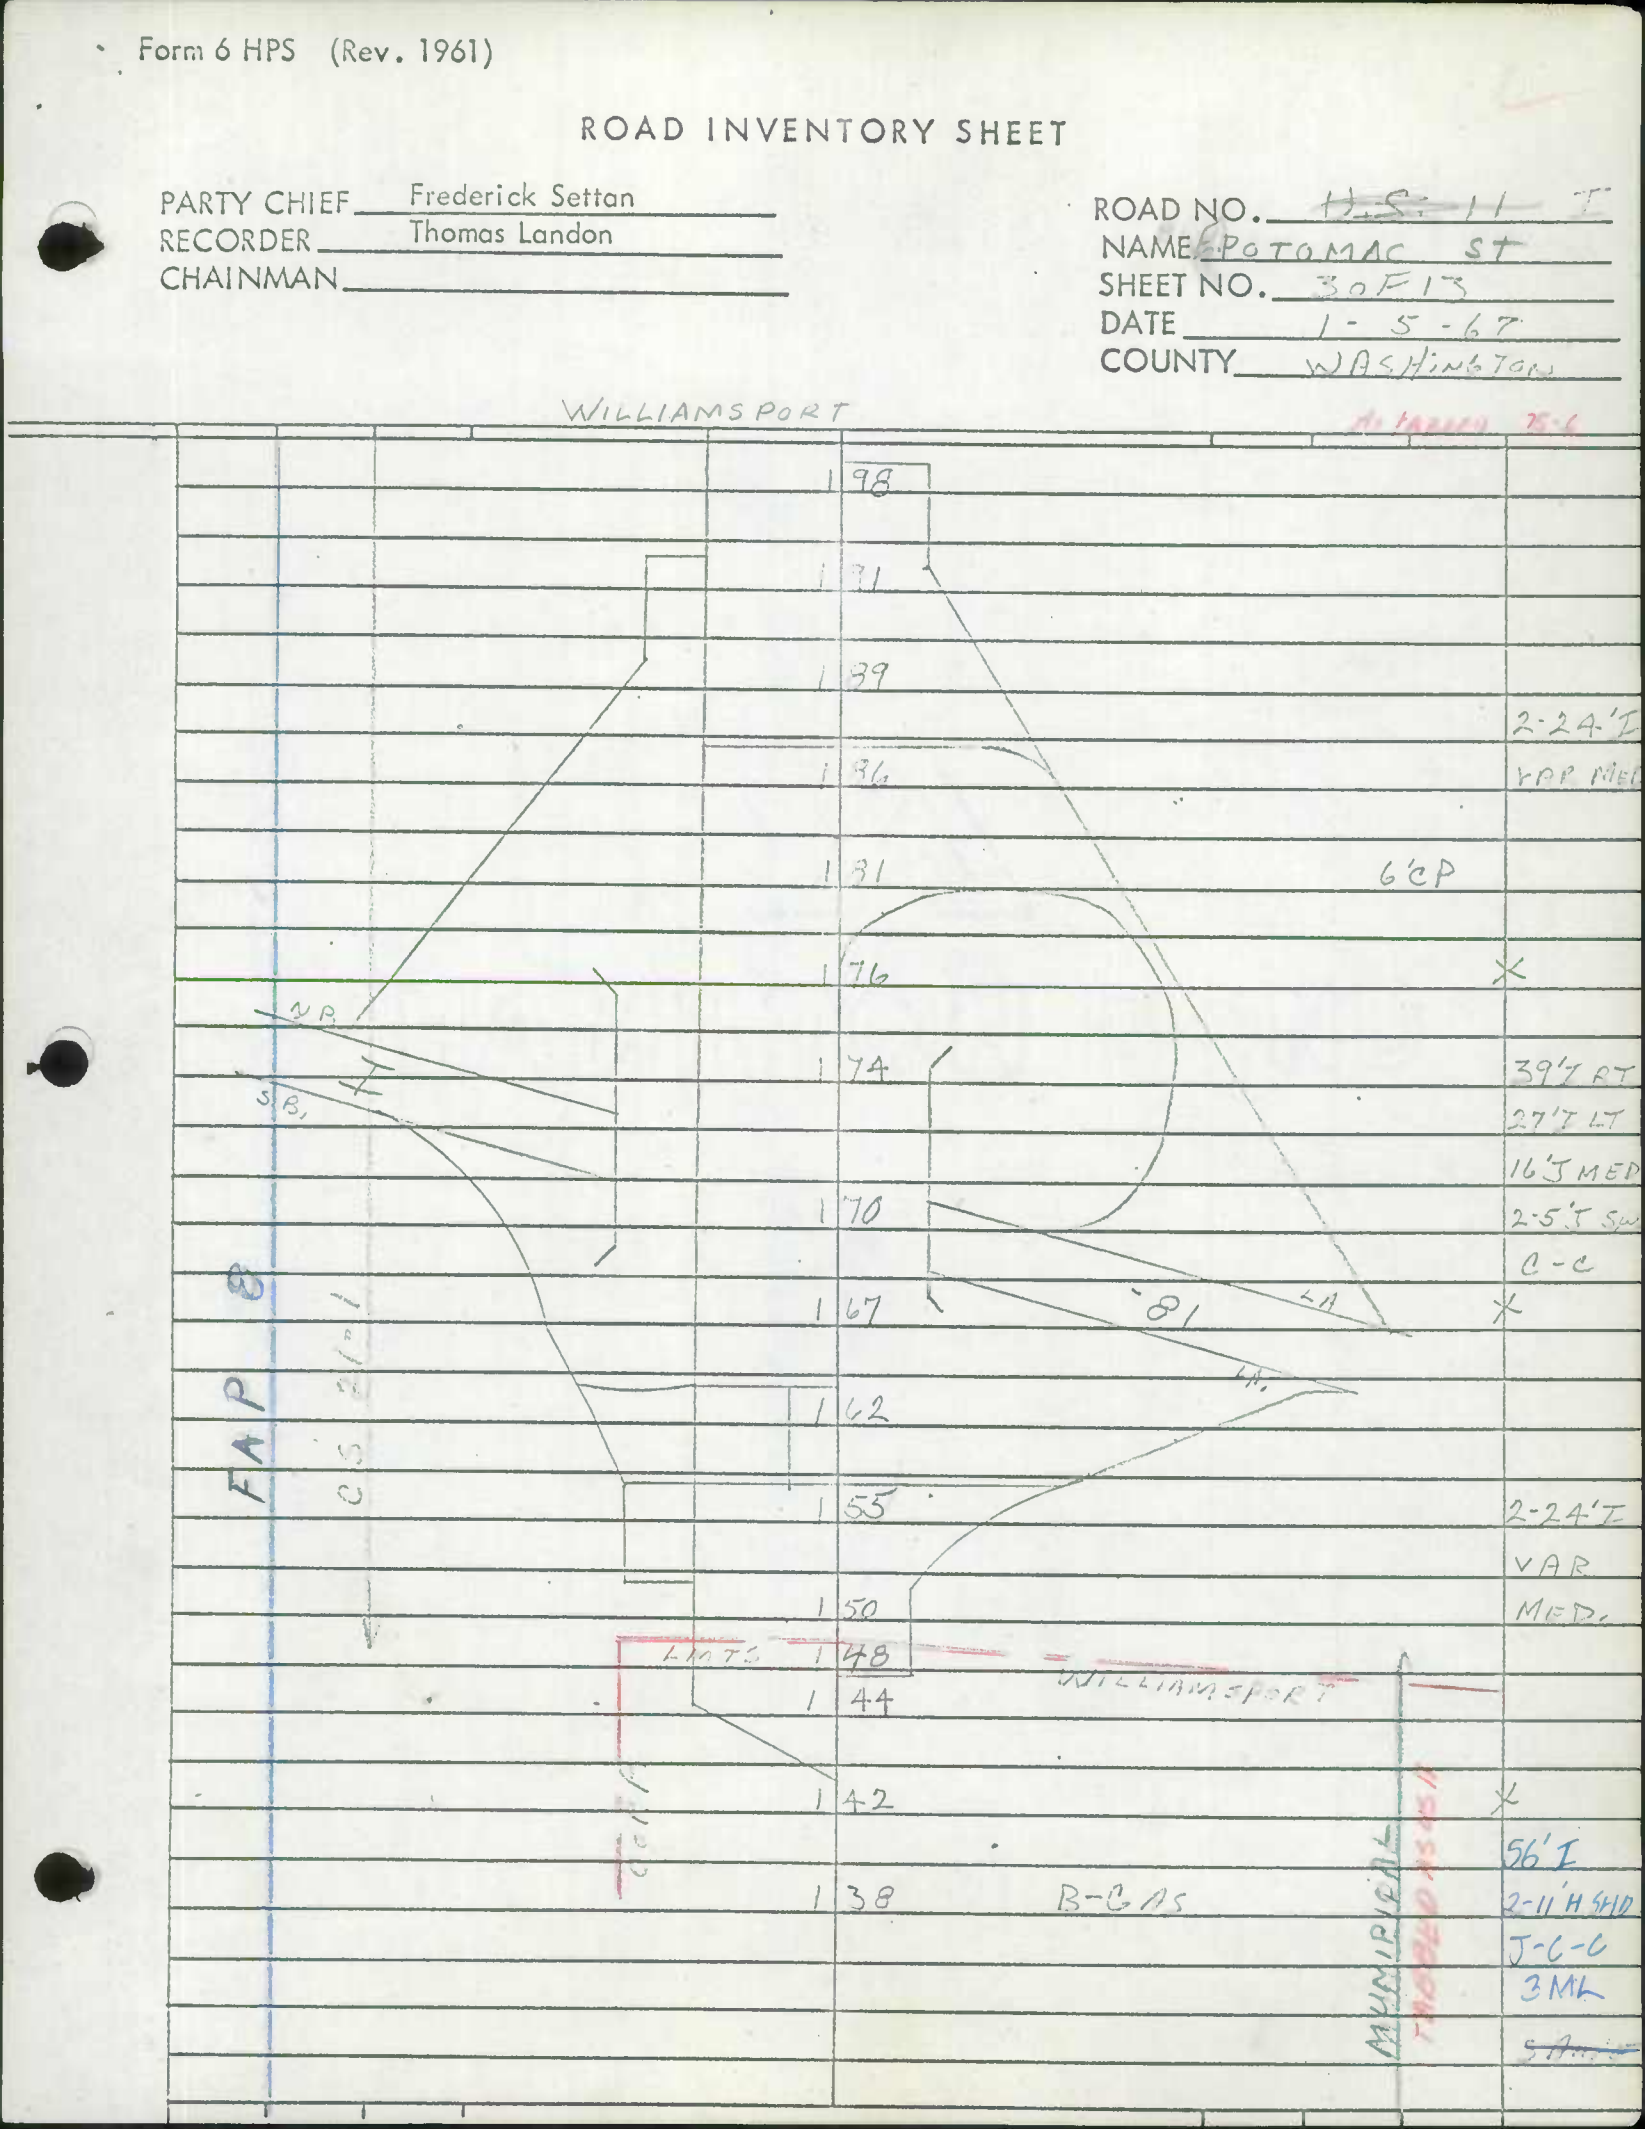

Form 6 HPS (Rev. 1961)

ROAD INVENTORY SHEET

Party Chief R. Vought
Recorder L. Coffelt, Jr.
Chainman
Williamsport

VER 7-12-76

Road No. 0170
Name River Park Dr.
Sheet No. 1 of 1
Date 9-30-63
County Wash.

72-2

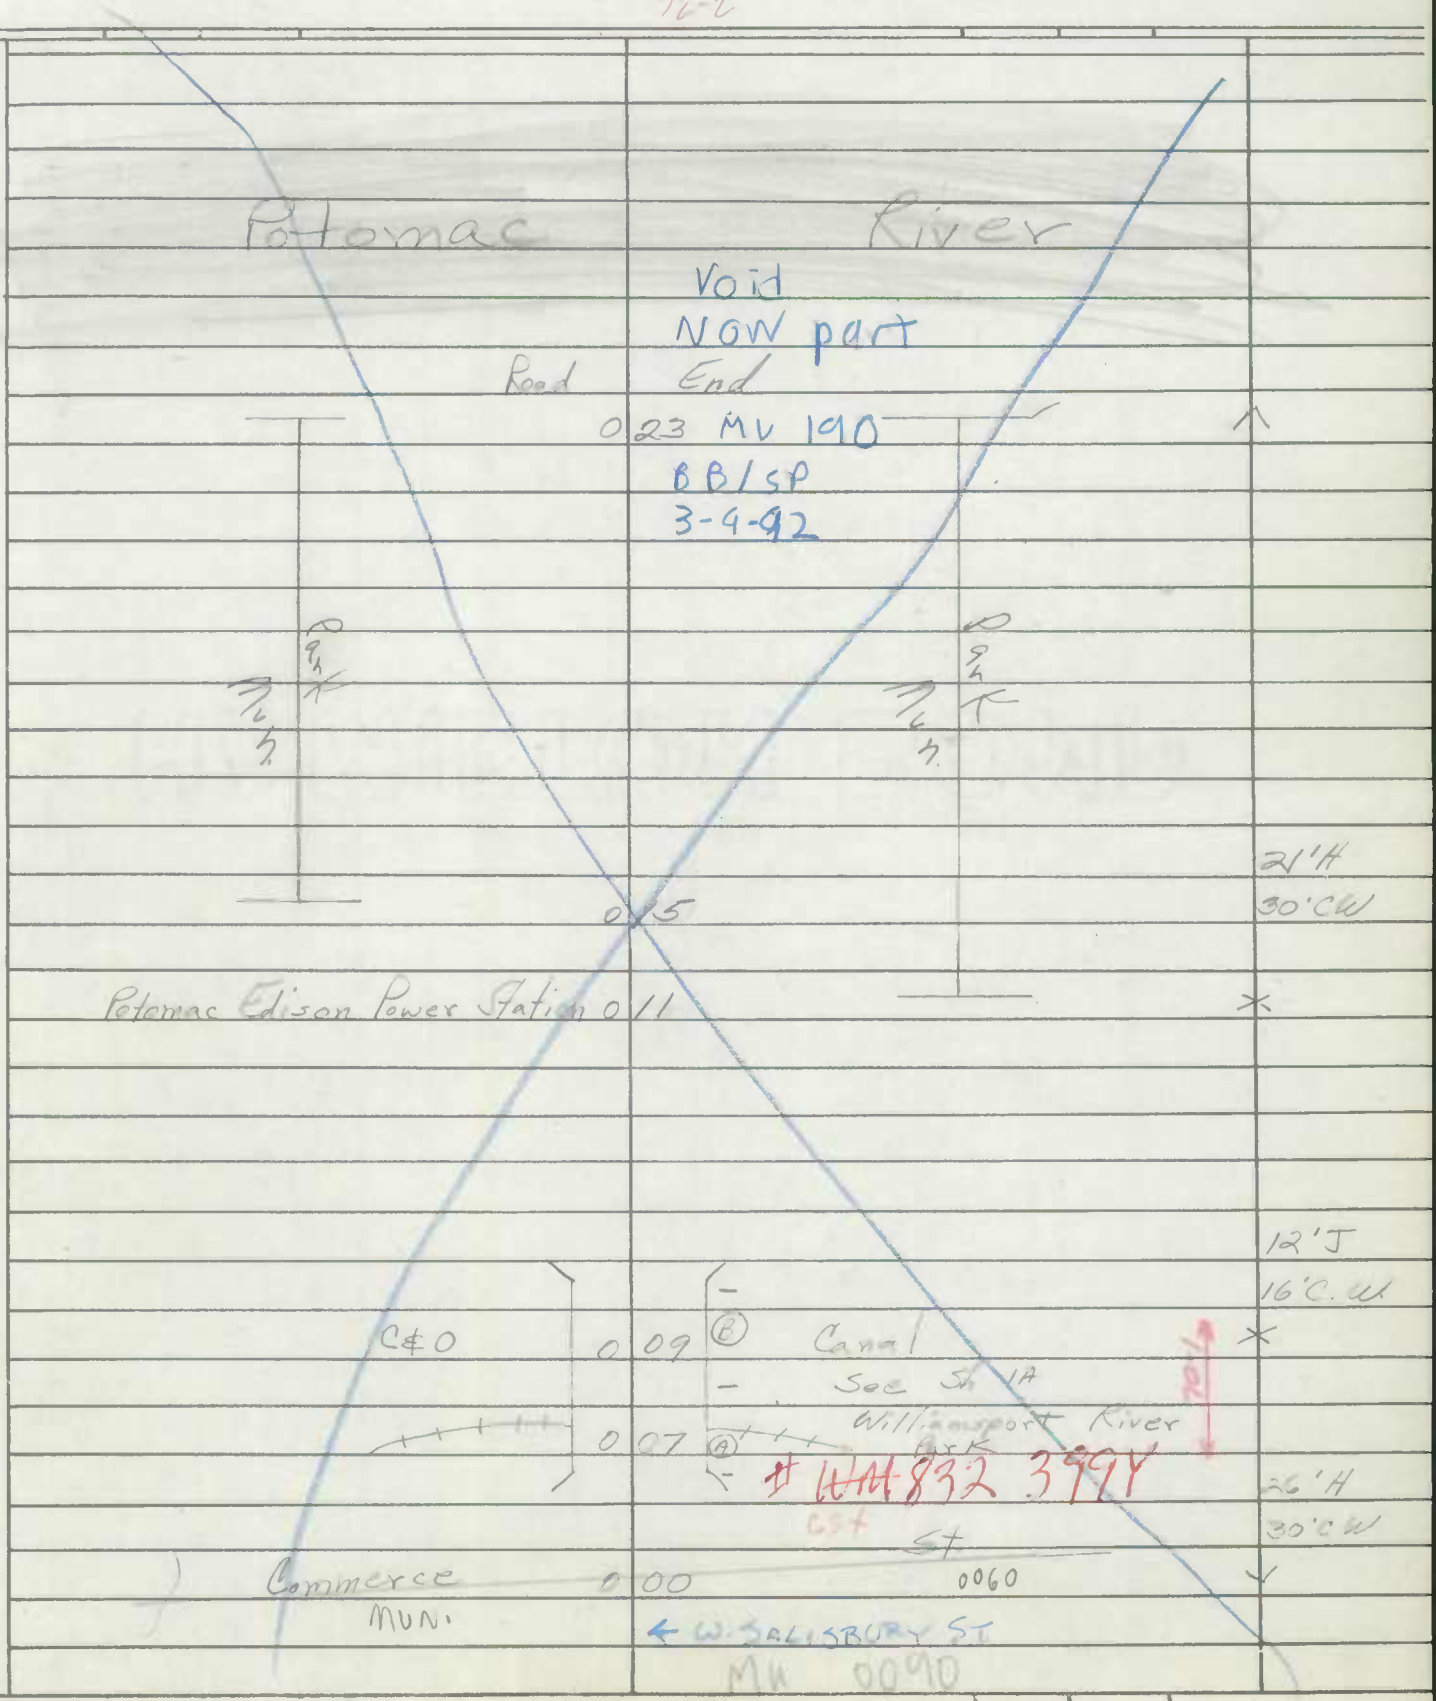

Form 6 HPS (Rev. 1961)

91-1 MU
BBISP
3-9-92

Pg 11

ROAD INVENTORY SHEET

85-02
BC 3-15-86

Party Chief R. Vought
Recorder L. Coffelt Jr.
Chainman
Williamsport

YER
7-12-76

Road No ~~180~~ -0190
Name E. & W. Salisbury St
Sheet No. 1 of 2
Date 9-30-63
County Wash.

26-465

As Tauca 7-5

					42' I on tapers to 17' I
			St		
Commerce	MUN	0	35	60	55 2 UML
Alley	MUN	0	31	8100	10
S Vermont St	MUN	0	28	N Vermont St 220	
Alley	MUN	0	36	8140	11
U.S. Post Office Williamsport		0	21		54' 66-2
Alley	MUN	0	18	8120	12
		0	17	Williamsport V.F.D.	
S Conecheague St	MB	0	15	N Conecheague St 63	
Alley	MUN	0	13	8130	13
Church		0	07		
Alley	MUN	0	05	8110	14
S Artisan St	MUN	0	02	N Artisan St 60	5x' I 11 c-c 2 ML
Alley	MUN	0	00	8170	17

OTHR HOLLAND RD. NUM 0137

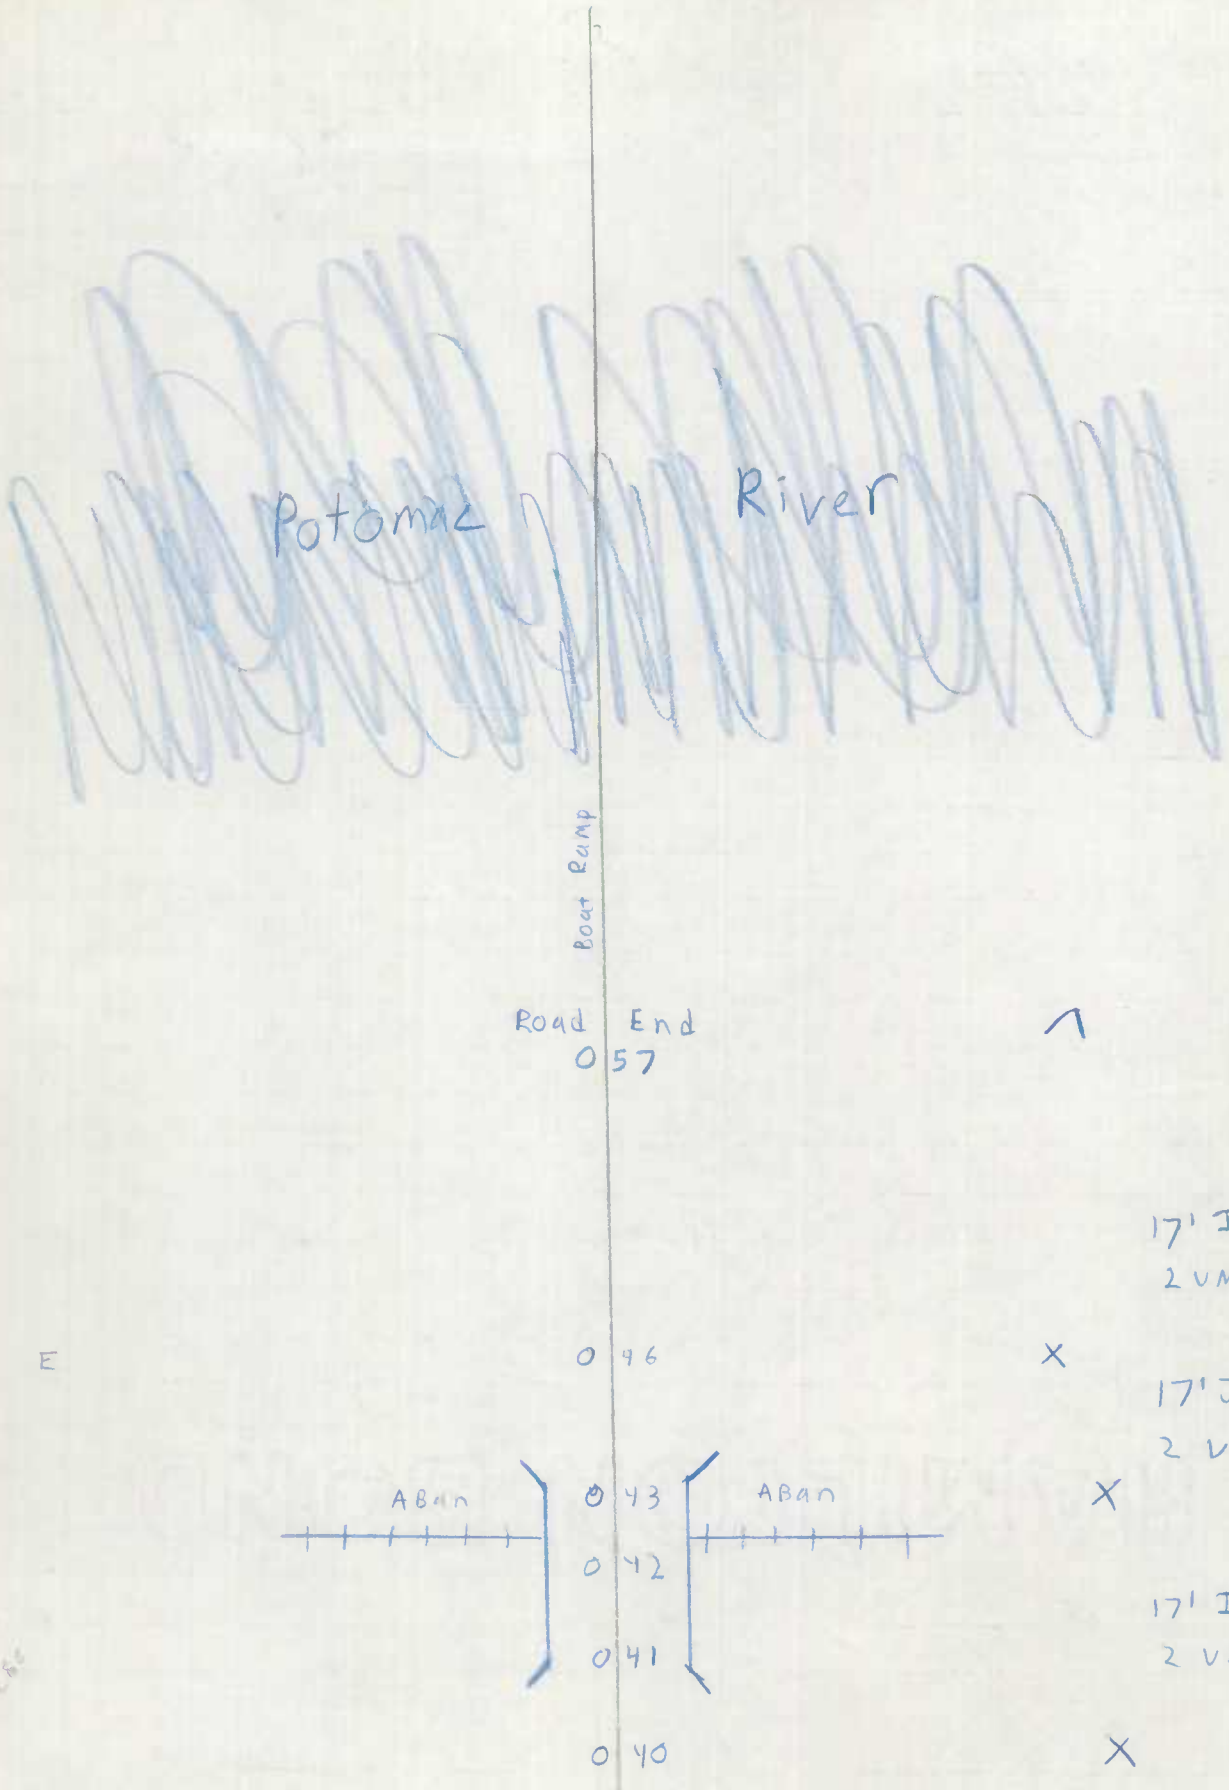
Potomac River
Boat Ramp
Road End
057
17' I
2 VML
E
046
17' J
2 VML
ABan
043
ABan
042
17' I
2 VML
041
040

SHA 51.3-8
11-15-72

STATE HIGHWAY ADMINISTRATION OF MARYLAND

ROAD INVENTORY SHEET

Party Chief DT
Recorder FR.
Helper

Map No. GH 22 78-2
WILLIAMSPORT

Road No. MUN. 0195
Road Name (SHAWNEE TER.)
Sheet No. 1 OF 1
Date 4- -79
County WASH
State Coordinates

N ↑

(OAKTREE LA.)
MUN. 0133 0 0 8

ENT. APTS. 0 0 4 42'I

(HOPEWELL RD.)
CO 0 0 0 473

SHA 51.3-8
11-15-72

ROAD INVENTORY SHEET

Road No. _____
Road Name _____
Sheet No. _____
Date _____
County _____
State Coordinates _____

Form 6 HPS (Rev. 1961)

ROAD INVENTORY SHEET

MUN No. 0210 CA 4 pg-77

PARTY CHIEF Frederick Settan
RECORDER Thomas Landon
CHAINMAN

AL|KJ
87-2 3-24-68
VER.
7-12-76

ROAD NO. ~~MD 861~~ A
NAME SUNSET AVE
SHEET NO. 1 OF 1
DATE 1-4-67
COUNTY WASHINGTON

I- 81 272 26-3

S.B.		↑ 200' LA.	
		XXXXXX ↓	
ROAD	0	59 END	EX
ENT school	0	58	20'I
	0	56 END CEM	12'I
E	0	48	35'CW
	0	44 BEG CEM	
	0	43 H	
	0	42 H	
		BRITNER AVE	
	0	41 Co 508	
	0	37	
		3 H	
	0	35	
		~~GROVE~~ AVE	
H	0	32 Co 506	
H	0	21	23'I
MUN 9150			20' H
ALLEY #15	0	17 ~~BEG SEC MAIN~~	40'CW
ARTIZAN		STREET	~~2 24 CW~~
MUN 70	0	13 ~~MD 843~~ MUN	6'I
MUN 9170			
ALLEY #14	0	11	40'I
CONOCOCHEAUGE		ST	C-C
MD	0	00 68	

Transferred to Williamsport 10-5-76 SRC Agreement

MUN

N

WATER PARK

2

3

E

Form 6 HPS (Rev. 1961)

4

ROAD INVENTORY SHEET

Party Chief R. VOUGHT
Recorder L. COFFELT JR.
Chainman

VER. 7-12-76

WILLIAMSPORT

Road No. 8040
Name ALLEY 4
Sheet No. 1 OF 1
Date 9-30-63
County WASHINGTON

Road End
0 37
0 33

8'H
7'K
10'CW

ALLEY 12
0 31
0 30

CONOCOCHEAGUE ST
MD. 0 28 68
0 27

7'J
9'CW

ALLEY 13
0 26
0 25

8'I
15'CW

ALLEY 14 #2
0 22

7'J
9'CW

0 17
ARTISAN ST
Md 0 14 63
0 18

ALLEY 15 17
0 15
0 13
0 12

9 30°

0 08
0 09
ALLEY MUN 16
8160

7'E
10'CW

0 00
ROAD End 50'

8'I
10'CW

CO 0 00 504