Anne Arundel County

Private Roads

Form 6 HPS (Rev. 1961) BMATS FAU-BALTO. PRIVATE RD

ROAD INVENTORY SHEET

MAP #2

Party Chief E. SCHUYLER
Recorder J. CAREY
Helper

Road No. PVT. 1
Road Name HELEN AVE.
Sheet No. 1 OF 1
Date 7-23-71
County A.A.

893-506

ROAD END
0.07

5

10' F
16' CL

W. NURSERY ROAD.
Co. 0.00 6

Form 6 HPS (Rev. 1961)

ROAD INVENTORY SHEET

Road No. _____
Road Name _____
Sheet No. _____
Date _____
County _____

Form 6 HPS (Rev. 1961)

BMATS
FAU-BALTO.

ROAD INVENTORY SHEET

MAP 22

Party Chief E. SCHUYLER.
Recorder J. COLLEY
Helper

Road No. PVT. 2
Road Name [HORSE FARM RD]
Sheet No. 1 OF 1
Date 7-27-71
County A. A.

895-497

ROAD END.

0 23

0 19 36" RCP

S

0 10 STABLES

16' E
OPEN FROM 8 A.M.-7 P.M. 20' CW
(SIGN)

Co ANDOVER RD 0 00 10

OLD ROBERTS RD

Form 6 HPS (Rev. 1961)

ROAD INVENTORY SHEET

Road No. _____
Road Name _____
Sheet No. _____
Date _____
County _____

BMATS
FAU-BALTO.

Form 6 HPS (Rev. 1961)

ROAD INVENTORY SHEET

Party Chief E. Schuyler
Recorder A. Forish
Helper

MAP 29

Road No. PVT 3
Road Name PVT. ROAD
Sheet No. 1 of 1
Date 10-4-71
County Anne Arundel

0.05 9/8-490

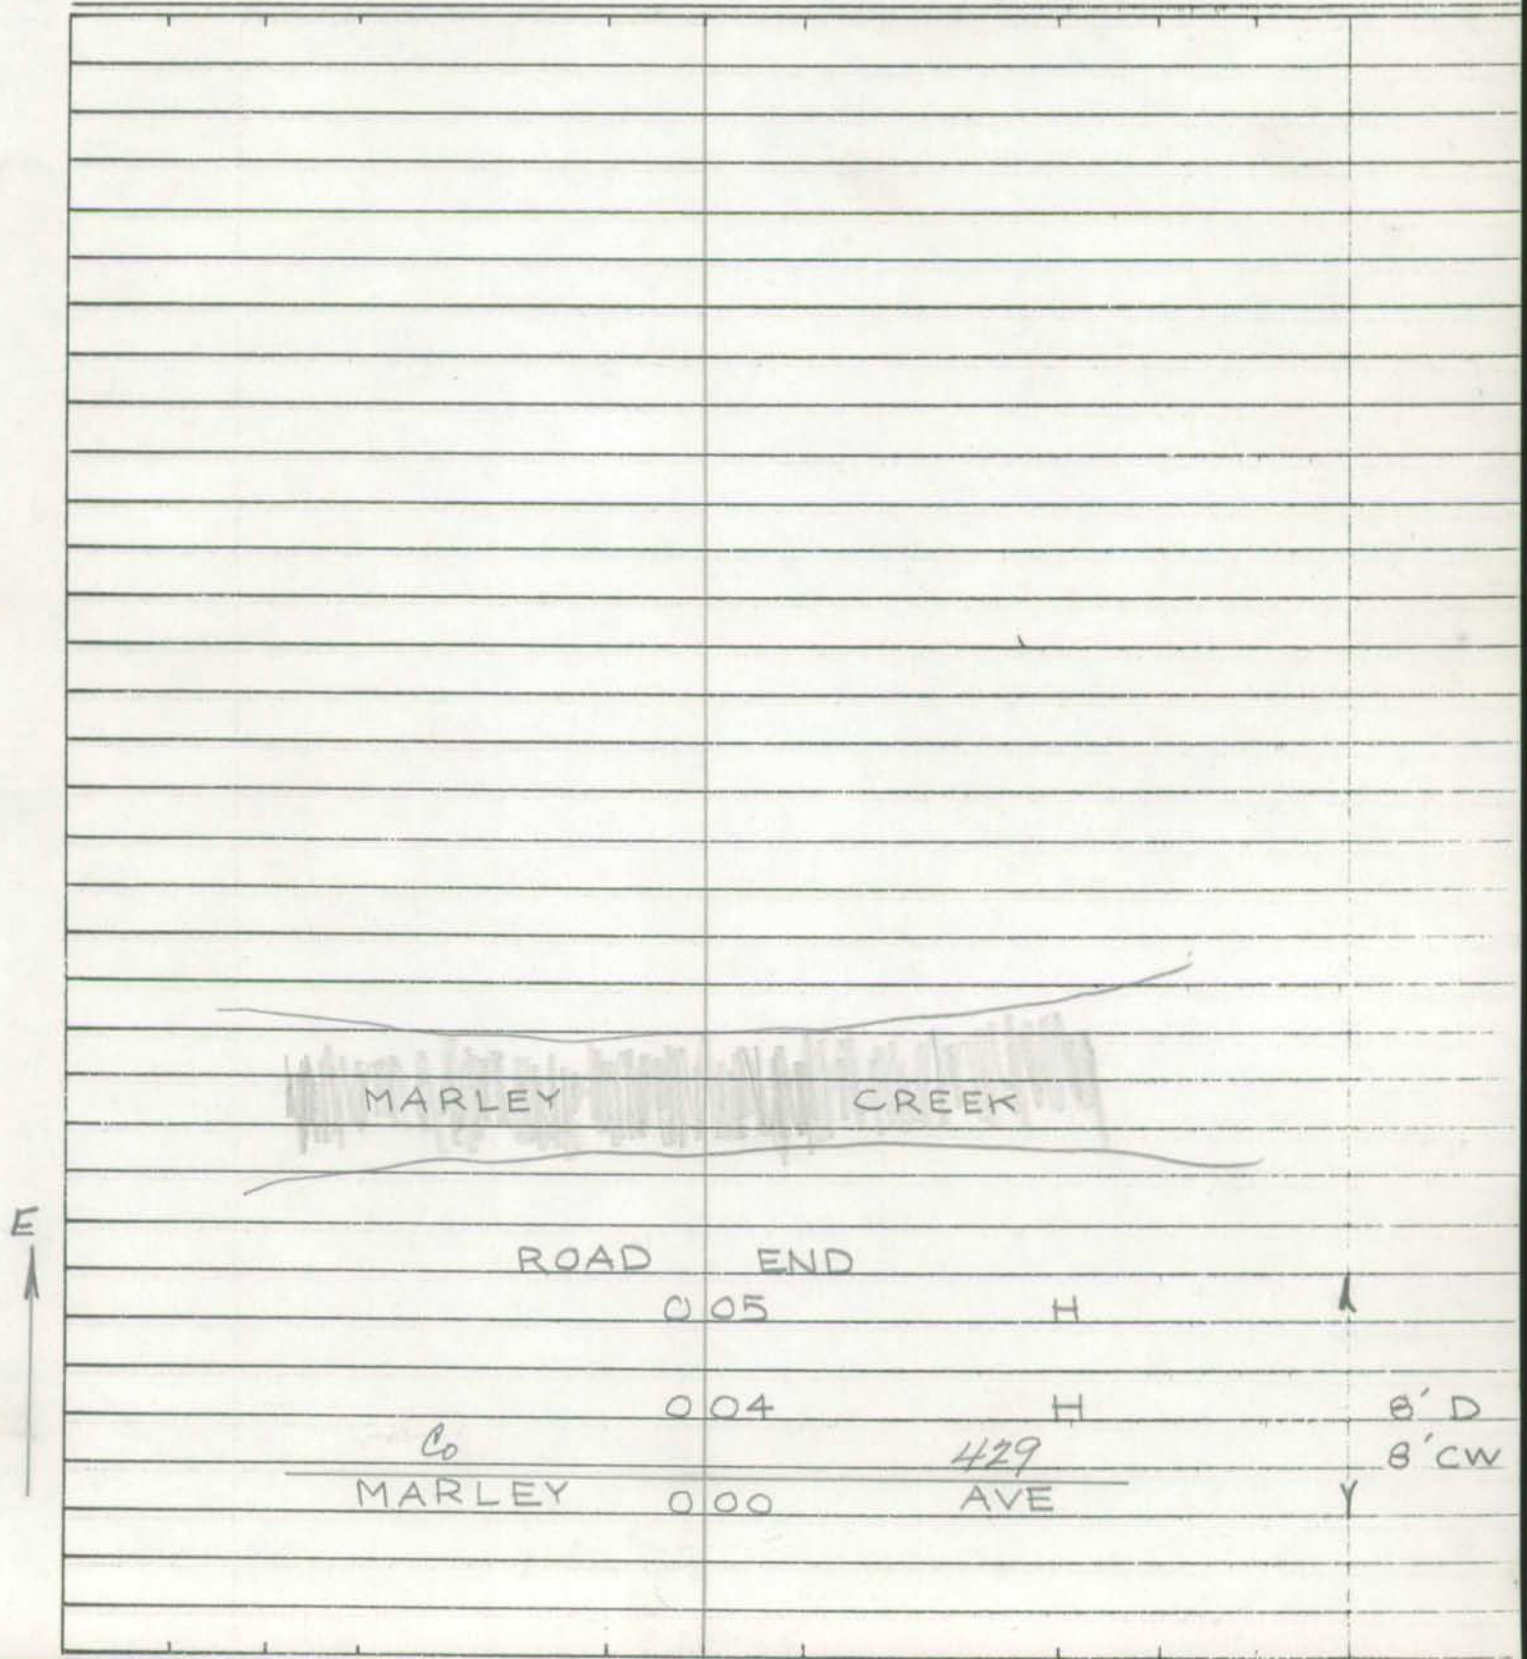

Form 6 HPS (Rev. 1961)

ROAD INVENTORY SHEET

Road No. _____
Road Name _____
Sheet No. _____
Date _____
County _____

BMATS
FAU - BALTO.

Form 6 HPS (Rev. 1961)

ROAD INVENTORY SHEET

Party Chief E. Schuyler
Recorder A. Forish
Helper

MAP 29

Road No. PVT 4
Road Name PVT. ROAD
Sheet No. 1 of 1
Date 10-4-71
County Anne Arundel
0.10 918-490

MARLEY CREEK

E

H H H
ROAD END
0 04

H 0 03 10' E
Co 429 10' CW
MARLEY 0 00 AVE.

Form 6 HPS (Rev. 1961)

ROAD INVENTORY SHEET

Road No. _____
Road Name _____
Sheet No. _____
Date _____
County _____

Form 6 HPS (Rev. 1961)

ROAD INVENTORY SHEET

Party Chief E. Schuyler
Recorder A. Forish
Helper

MAP 29

Road No. PVT 5
Road Name PVT ROAD
Sheet No. 1 of 1
Date 10-4-71
County Anne Arundel
0.16 918-491

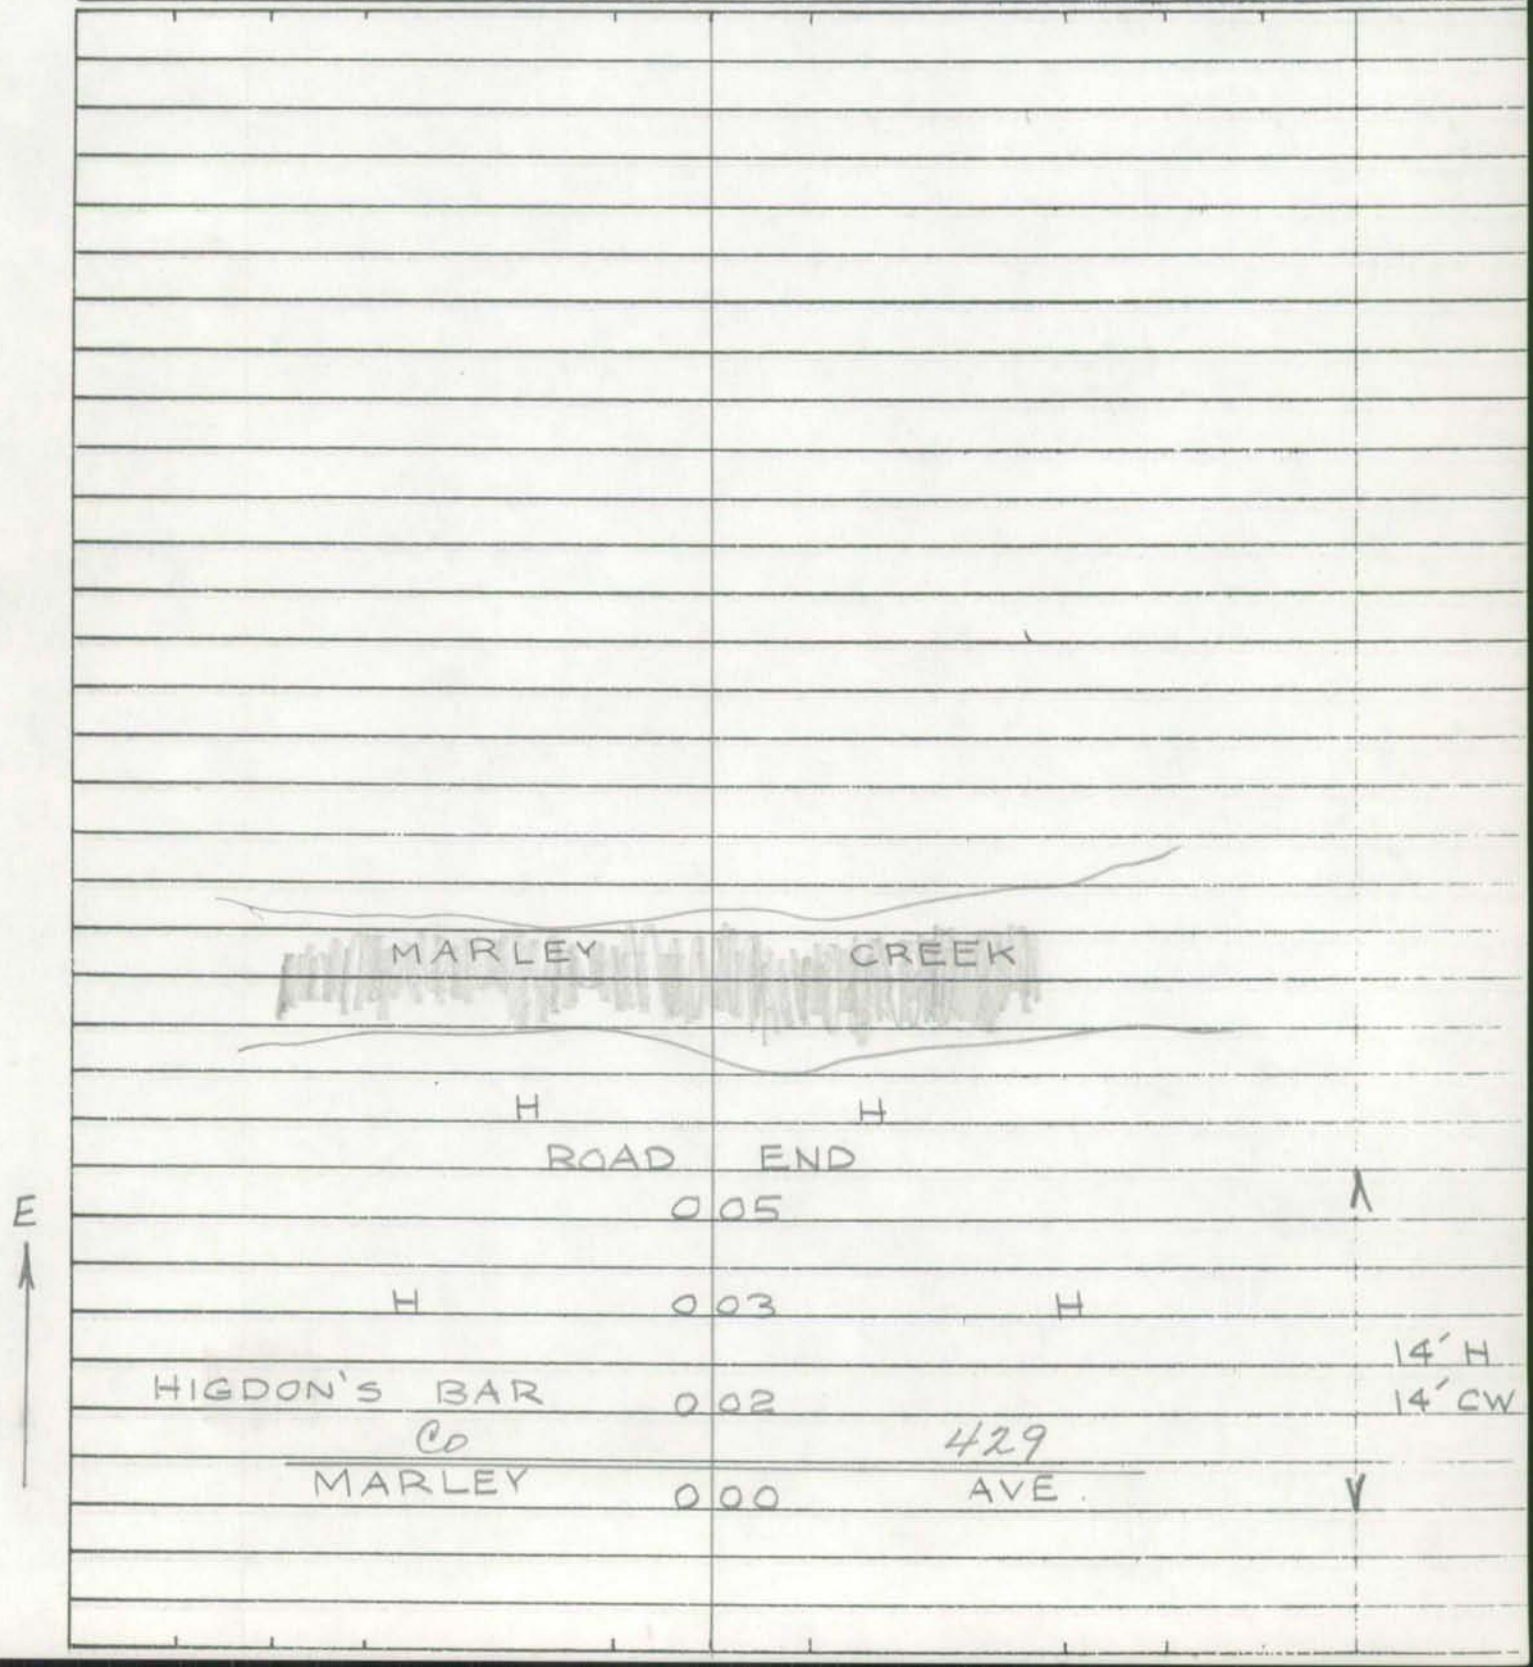

Form 6 HPS (Rev. 1961)

ROAD INVENTORY SHEET

Road No. _____
Road Name _____
Sheet No. _____
Date _____
County _____

BMATS
FAU-BALTO

Form 6 HPS (Rev. 1961)

ROAD INVENTORY SHEET

Party Chief E. Schuyler
Recorder A. Forish
Helper

MAP 29

Road No. PVT 6
Road Name PVT. ROAD
Sheet No. 1 of 1
Date 10-4-71
County Anne Arundel
0.29 918-491

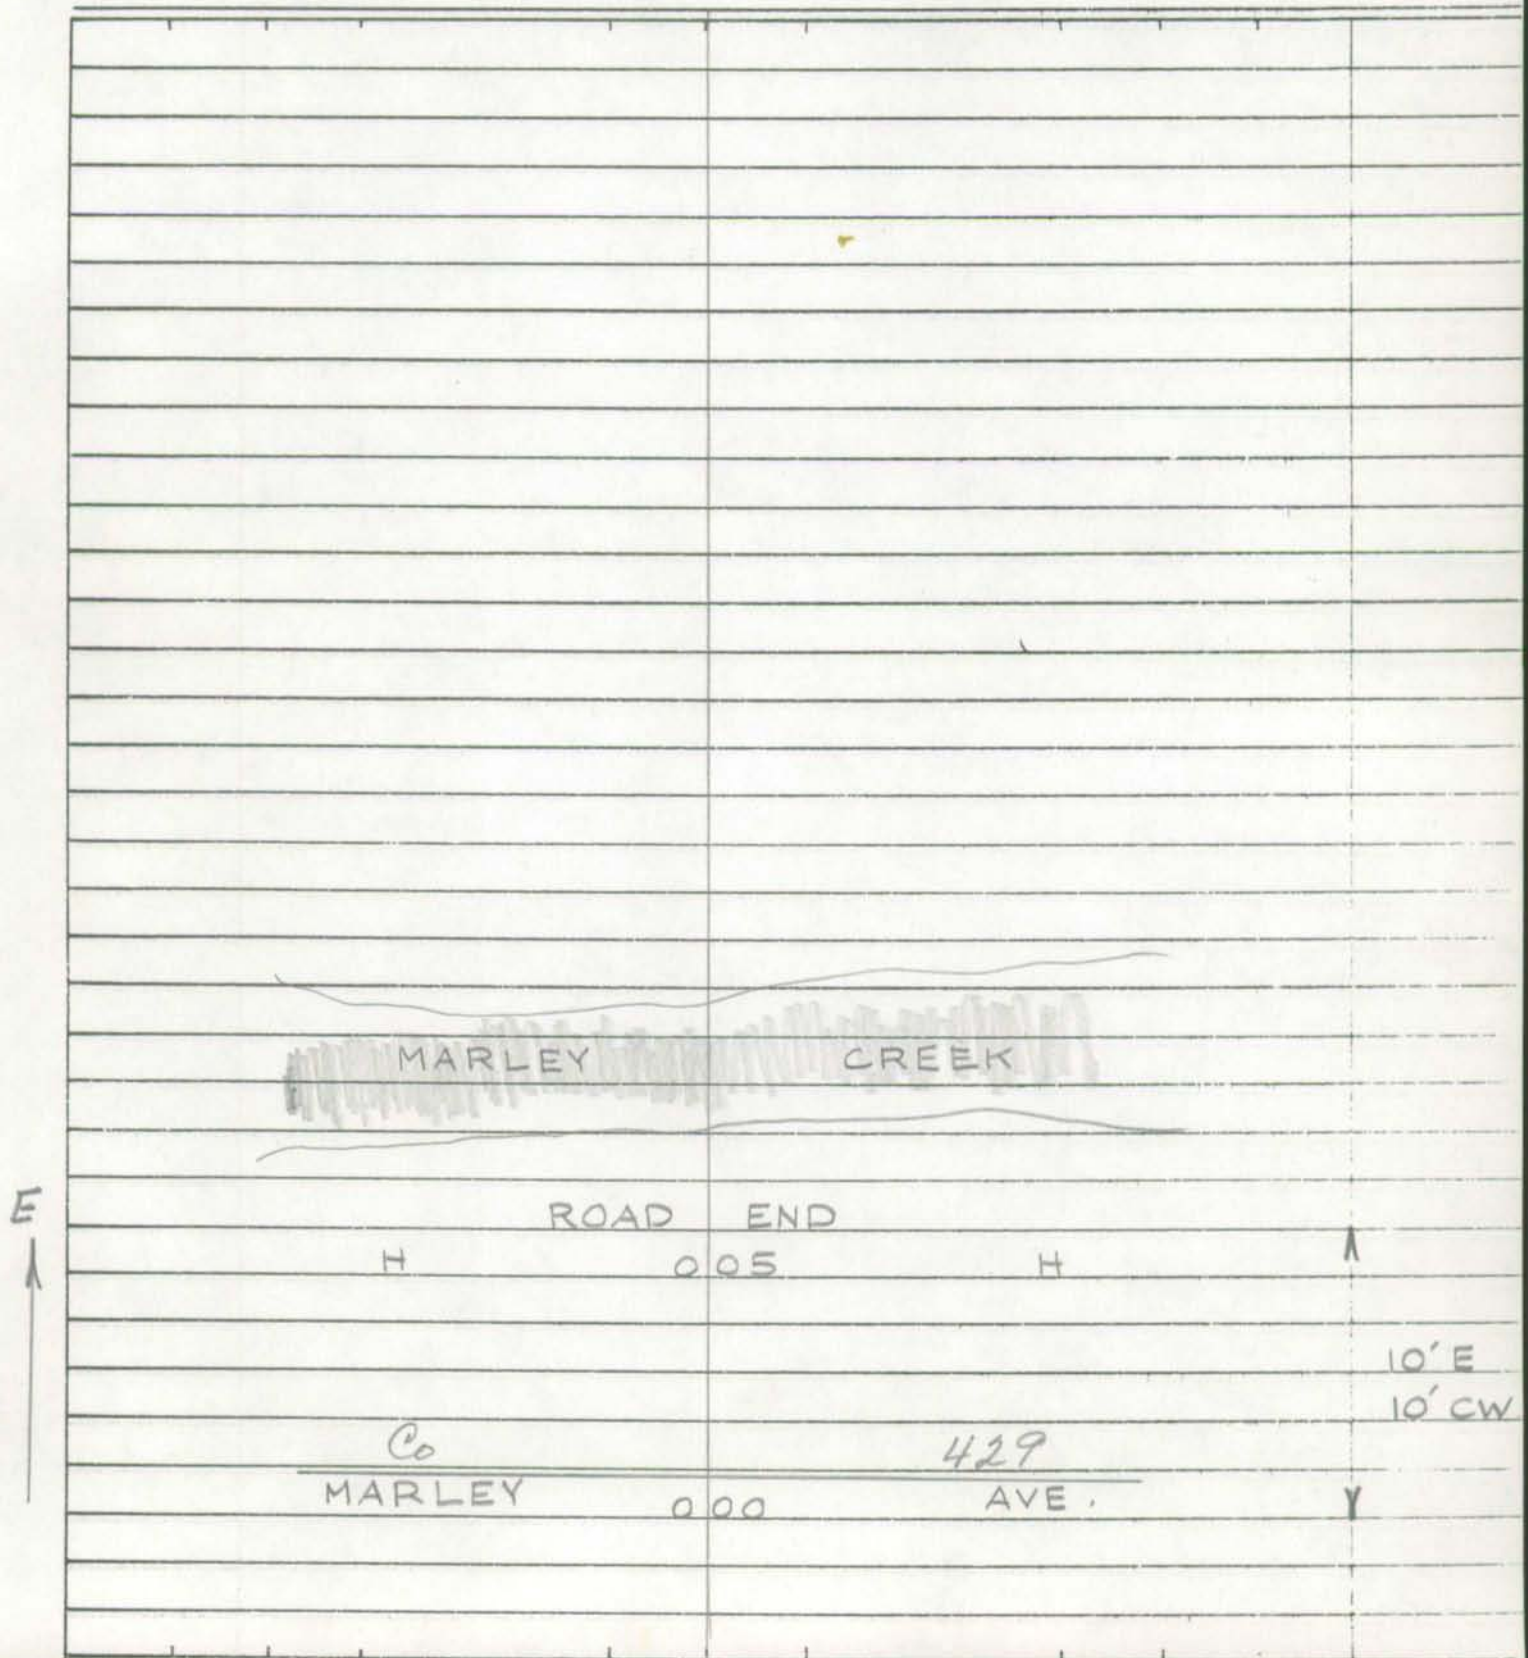

Form 6 HPS (Rev. 1961)

ROAD INVENTORY SHEET

Road No. _____
Road Name _____
Sheet No. _____
Date _____
County _____

Form 6 HPS (Rev. 1961)

BHATS
FAU-BALTO.

ROAD INVENTORY SHEET

Party Chief E. Schuyler
Recorder A. Forish
Helper

MAP 29

Road No. PVT. 7
Road Name PVT. ROAD
Sheet No. 1 of 1
Date 10-4-71
County Anne Arundel
0.38
918-492

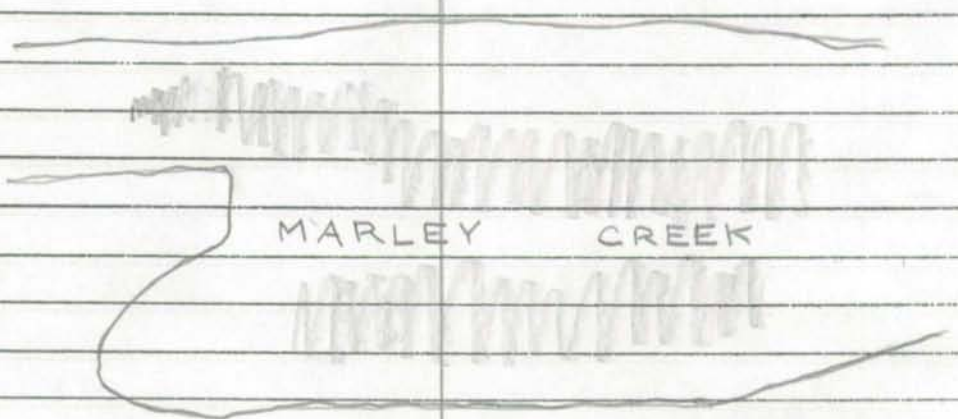

E

ROAD END

H 0 03 H

10'E

0 01 H

10'CW

Co 429

MARLEY 0 00 AVE.

Form 6 HPS (Rev. 1961)

ROAD INVENTORY SHEET

Road No. _____
Road Name _____
Sheet No. _____
Date _____
County _____

Form 6 HPS (Rev. 1961)

BMATS
FAU-BALTO

ROAD INVENTORY SHEET

Party Chief E. SCHUYLER
Recorder J. COLLEY
Helper

Road No. PRIVATE 8
Road Name (ENT. TO PITTSBURG STEEL CO.)
Sheet No. 1 OF 1
Date 8-12-71
County A A.

MAP 23

924-496

S

GATE
005

004 90° ↰ 20' H
30' CW

PITTMAN
Co. 000 ROAD 419

Form 6 HPS (Rev. 1961)

ROAD INVENTORY SHEET

Road No. _____
Road Name _____
Sheet No. _____
Date _____
County _____

Form 6 HPS (Rev. 1961) BMATS

ROAD INVENTORY SHEET

Party Chief T. LANDON
Recorder W. WARFIELD
Helper

Map No. 28

Road No. PRIVATE 9
Road Name
Sheet No. 1 of 1
Date 5-25-72
County Anne Arundel - District 2
State Coordinates 846-462

WHISKEY BOTTOM RD.

Co. 0 85 995

0 75 HORSE STABLES PT 25° PC

0 55

0 47 15° 21'I 23'cw

0 33

0 30 LAUREL RACE TRACK

0 18 H

N

0 15° 0 10 ENT: PARKING LOT

PT 30° PC 0 07 RD.

SPUR 0 03

0 02 RACE TRACK 10 36'I "I" C-C

SPUR (ABAN.) 0 00

LAUREL PRIVATE

Form 6 HPS (Rev. 1961)

ROAD INVENTORY SHEET

Road No. _____
Road Name _____
Sheet No. _____
Date _____
County Anne Arundel - District
State Coordinates _____

Form 6 HPS (Rev. 1961)

ROAD INVENTORY SHEET

Party Chief T. LANDON
Recorder W. WARFIELD
Helper

Map No. 28

Road No. PRIVATE 10
Road Name LAUREL RACE TRACK RD.
Sheet No. 1 OF 1
Date 5-25-72
County Anne Arundel - District
State Coordinates 847-460

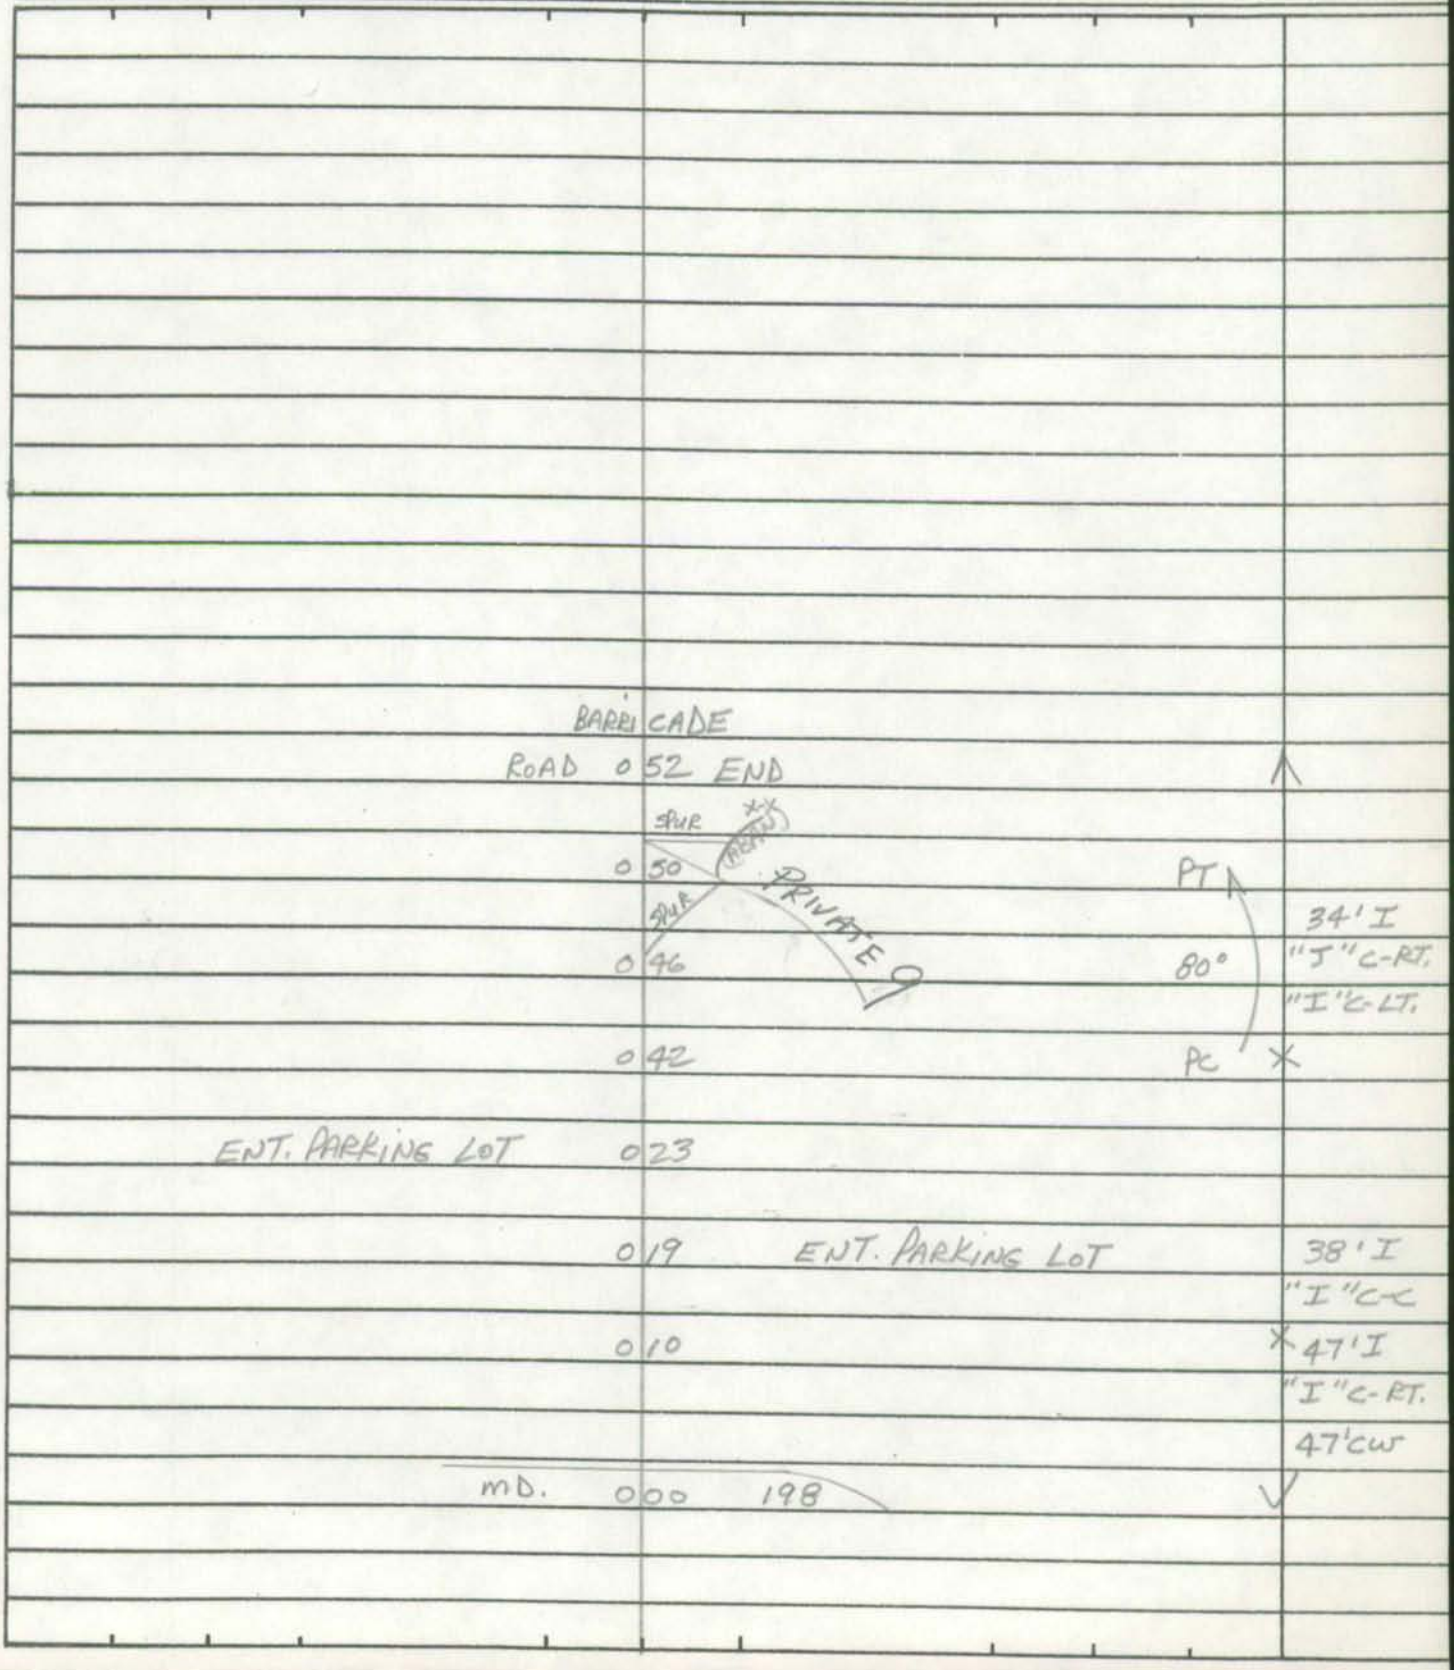

Form 6 HPS (Rev. 1961)

ROAD INVENTORY SHEET

Road No. _____
Road Name _____
Sheet No. _____
Date _____
County Anne Arundel - District
State Coordinates _____

BMATS
FAU-BALTO.

Form 6 HPS (Rev. 1961)

ROAD INVENTORY SHEET

Party Chief E Schuyler
Recorder A. Forish
Helper

MAP 29

Road No. PVT. 11
Road Name WAGNER STATION RD.
Sheet No. 1 of 1
Date 10-13-71
County Anne Arundel - DIST. 1

931-489

2.08

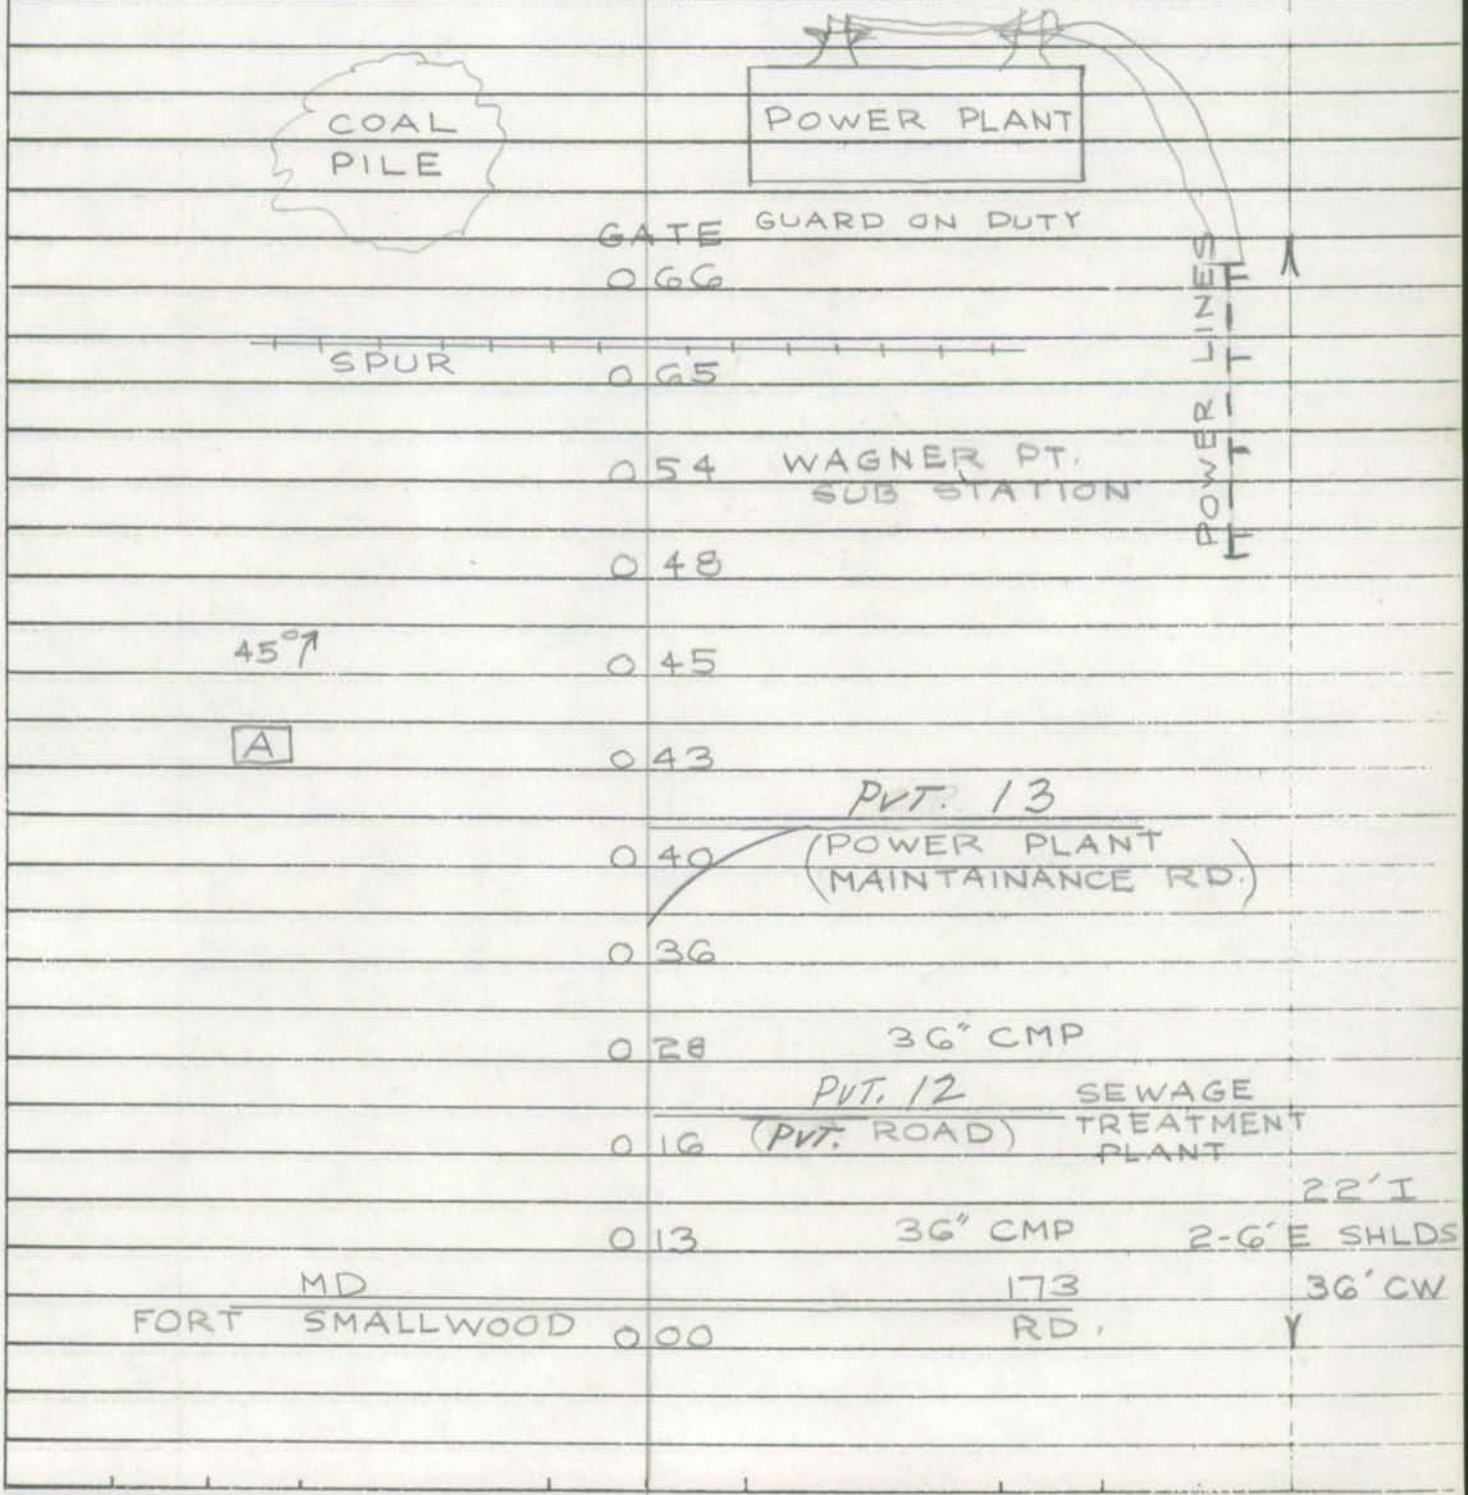

Form 6 HPS (Rev. 1961)

ROAD INVENTORY SHEET

Road No. _____
Road Name _____
Sheet No. _____
Date _____
County _____

Form 6 HPS (Rev. 1961)

BMATS
FAU - BALTO.

ROAD INVENTORY SHEET

Party Chief E. Schuyler
Recorder A. Forish
Helper

MAP 29

Road No. PVT 12
Road Name
Sheet No. 1 of 1
Date 10-13-71
County Anne Arundel - DIST. 1

0.16

932-489

GATE
0 09

POWER LINES

(POWER LINES 0 07 MAINTAINANCE RD.)

22' I
2-8' E SHLDS
40' CW

PVT. 11
WAGNER STATION 0 00 RD.

S

Form 6 HPS (Rev. 1961)

ROAD INVENTORY SHEET

Road No. _____
Road Name _____
Sheet No. _____
Date _____
County _____

Form 6 HPS (Rev. 1961)

BMATS
FAU-BALTO.

ROAD INVENTORY SHEET

Party Chief E. Schuyler
Recorder A. Forish
Helper

MAP 29

Road No. PVT. 13
Road Name (POWER PLANT MAINTAINANCE RD.)
Sheet No. 1 of 1
Date 10-13-71
County Anne Arundel - DIST. 1

0.40

933-490

0.00

GATE

0 27

0 22 PARKING LOT

0 17 P.T. 90

0 14 P.C.

POWER LINES

T-T-T-T-T-T-T-T-T-T-T-T

0 08

0 04 22'I
2-8'E SHLDS
38'CW

PVT
WAGNER STATION 0 00 11 RD.

S

Form 6 HPS (Rev. 1961)

ROAD INVENTORY SHEET

Road No. _____
Road Name _____
Sheet No. _____
Date _____
County _____

Form 6 HPS (Rev. 1961)

BMATS
FAU-BALTO.

ROAD INVENTORY SHEET

Party Chief E. Schuyler
Recorder A. Forish
Helper

Road No. PVT. 14
Road Name PVT. ROAD
Sheet No. 1 of 1
Date 10-13-71
County Anne Arundel - DIST. 1

245

MAP 29

932-487

E

FARM
ROAD END
017

10' E
20' CW

MD.
FT. SMALLWOOD 000
173
RD.

CARVEL BEACH RD. Co. 1579

Form 6 HPS (Rev. 1961)

ROAD INVENTORY SHEET

Road No. _____
Road Name _____
Sheet No. _____
Date _____
County _____

BMATS

Form 6 HPS (Rev. 1961)

ROAD INVENTORY SHEET

Party Chief E. SCHUYLER
Recorder W. DOMBROSKI
Helper

MAP 29

Road No. P.V.T. 15
Road Name (WATER TOWER RD)
Sheet No. 1 OF 1
Date 10-20-71
County ANNE ARUNDEL DIST. 1

935-479

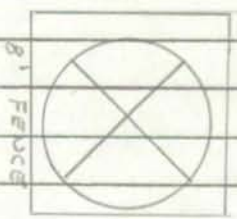

WATER TOWER

ROAD 018 END

W

10'C
10'CW

MD 173

FT. SMALLWOOD 000 ROAD

FARMVIEW RD Co. 696

Form 6 HPS (Rev. 1961)

ROAD INVENTORY SHEET

Road No. _____
Road Name _____
Sheet No. _____
Date _____
County _____

BMATS

Form 6 HPS (Rev. 1961)

ROAD INVENTORY SHEET

Party Chief E. SCHUYLER
Recorder W. DOMAROSKI
Helper

MAP 29

Road No. PRIVATE 16
Road Name (ENT TO MARINA)
Sheet No. 1 OF 1
Date 11-1-71
County ANNE ARUNDEL - DIST. 1

938-478

0.83

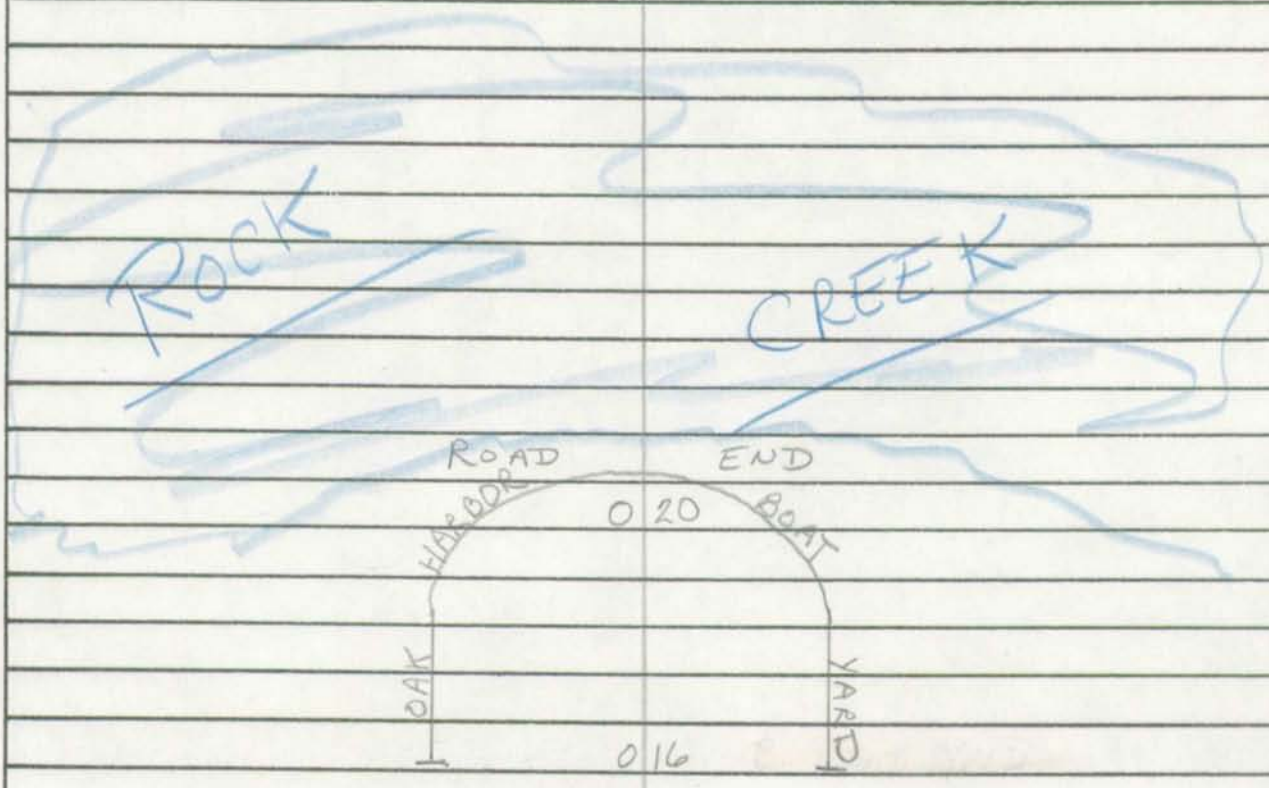

W

12' E
12' CW

CO. OPEN GATES 1847
WATER OAKS PT) 0 00 (ROAD)

Form 6 HPS (Rev. 1961)

ROAD INVENTORY SHEET

Road No. _____
Road Name _____
Sheet No. _____
Date _____
County _____

BMATS

Form 6 HPS (Rev. 1961)

ROAD INVENTORY SHEET

Party Chief E. SCHUYLER
Recorder W. DOMBROSKI
Helper

MAP 29

Road No. PVT. 17
Road Name (ROD + GUN CLUB RD)
Sheet No. 1 OF 1
Date 11-2-71
County ANNE ARUNDEL - DIST. 1

944-476

7.19

	ROAD	END	
RIFLE RANGE	0	50	H + CLUB
15°	0	3R	
10°	0	20	
FARM PVT. RD			18'E
MD FT. SMALLWOOD RD	0	00	173 18'CW

S

Form 6 HPS (Rev. 1961)

ROAD INVENTORY SHEET

Road No. _____
Road Name _____
Sheet No. _____
Date _____
County _____

BM ATS

Form 6 HPS (Rev. 1961)

ROAD INVENTORY SHEET

Party Chief E. SCHUYLER
Recorder W. DOMBROSKI
Helper

MAP 29
E13A

Road No. PVT. 18
Road Name (SOUTH AVE)
Sheet No. 1 OF 1
Date 11-2-71
County ANNE ARUNDEL - DIST. 1
947-480

LOGS ACROSS ROAD

ROAD 0 06 END

E

18'E
18'W

MD
FT SMALLWOOD 0 00 ED 173

Form 6 HPS (Rev. 1961)

ROAD INVENTORY SHEET

Road No. _____
Road Name _____
Sheet No. _____
Date _____
County _____

BMATS

Form 6 HPS (Rev. 1961)

ROAD INVENTORY SHEET

Party Chief E. SCHUYLER
Recorder W. DOMBROSKI
Helper

Road No. PVT 19
Road Name GIBSON ISLAND CAUSEWAY
Sheet No. 1 OF 1
Date 11-11-71
County ANNE ARUNDEL

MAP 29

GIBSON ISLAND

964-457

ALL SPURS ARE 25' OR LESS IN LENGTH

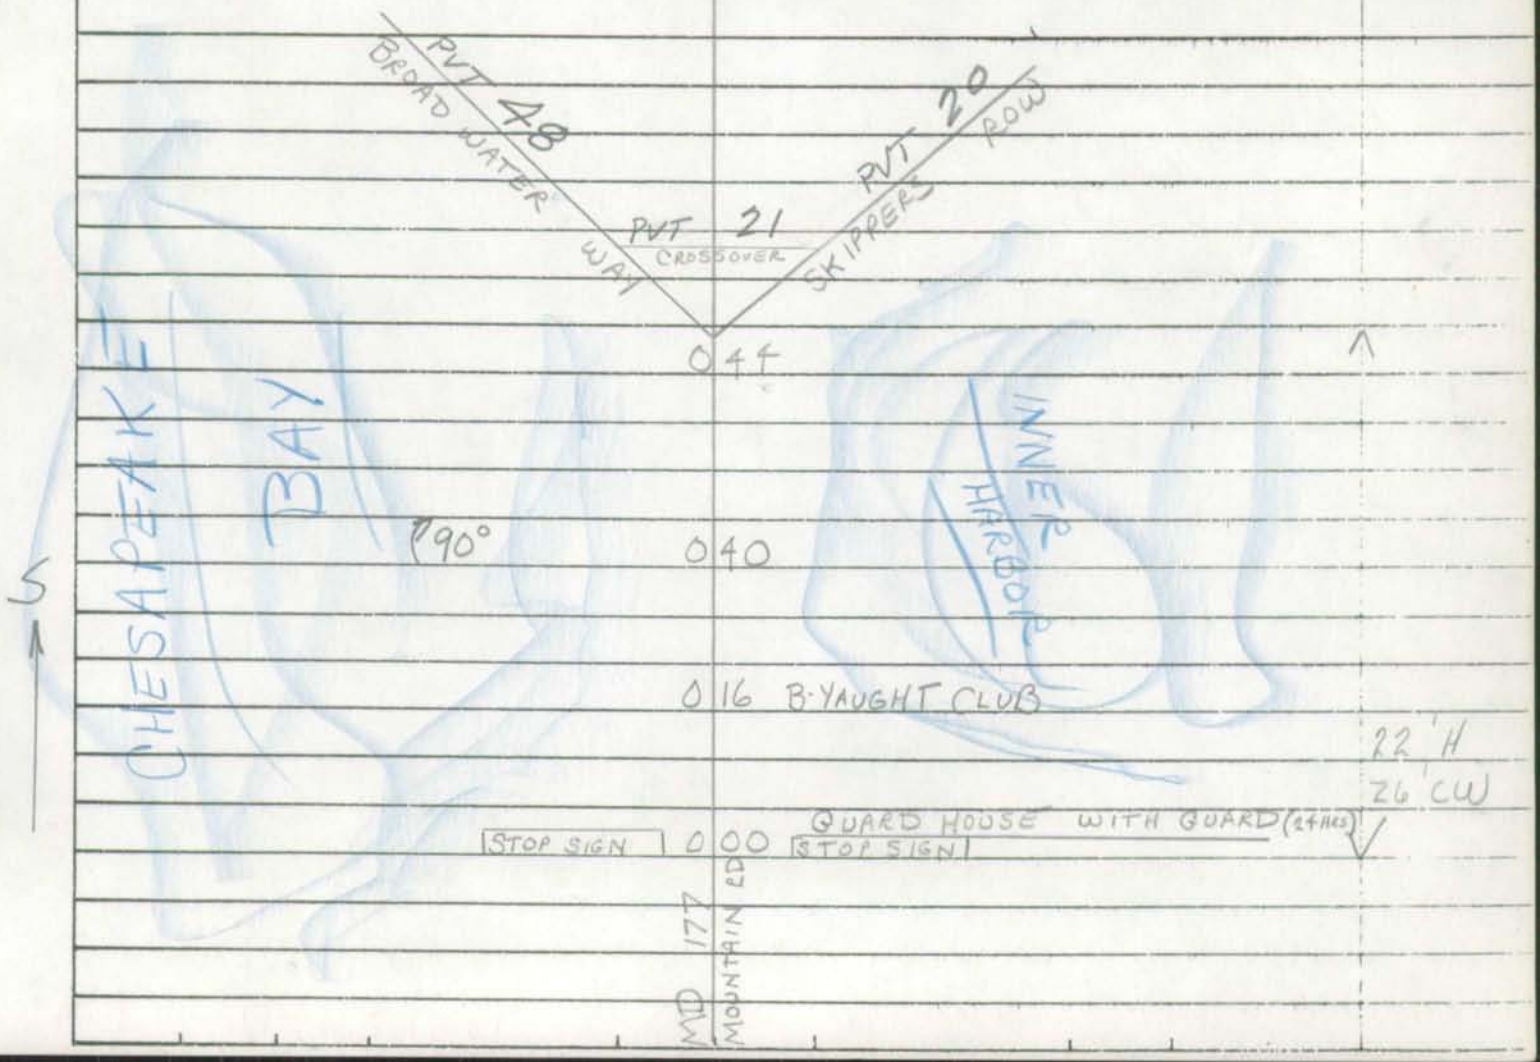

Form 6 HPS (Rev. 1961)

ROAD INVENTORY SHEET

Road No. _____
Road Name _____
Sheet No. _____
Date _____
County _____

BMATS

Form 6 HPS (Rev. 1961)

ROAD INVENTORY SHEET

Party Chief E. SCHUYLER
Recorder W. DOMAROSKI
Helper

MAP 29

Road No. PVT 20
Road Name SKIPPERS ROW
Sheet No. 1 OF 2
Date 11-11-71
County ANNE ARUNDEL

GIBSON ISLAND 964-455

LIGHT HOUSE	0	54	
GIBSON ISLAND YAUGHT YARD	0	50	H
T 30° SPUR	0	48	
PVT SPUR			
ABERFOYLE 24	0	45	
RD	0	42	H
PVT 23			
(ALLEY)	0	41	H
(Water Plant RD) 8' F			
H 300'	0	36	
	0	32	15" CMP
8' F			
H 500'	0	27	
			T H
	0	09	
PVT BANDBURY 22			
RD	0	04	60°
PVT 21			
(CROSSOVER)	0	02	
T 45° PVT 48			
BROAD WATER WAY			20' I
	0	00	20' CW
			V
PVT			
GIBSON ISLAND 19			
CAUSE			

W

Form 6 HPS (Rev. 1961)

ROAD INVENTORY SHEET

Road No. PVT 20
Road Name SKIPPERS ROW
Sheet No. 2 OF 2
Date 11-11-71
County ANNE ARUNDEL

MAP 29

GIBSON ISLAND

BMAT5

Form 6 HPS (Rev. 1961)

ROAD INVENTORY SHEET

Party Chief E. SCHUYLER
Recorder W. DOMBROSKI
Helper

MAP 29

Road No. PVT 21
Road Name (CROSSOVER)
Sheet No. 1 OF 1
Date 11-11-71
County ANNE ARUNDEL

GIBSON ISLAND 964-455

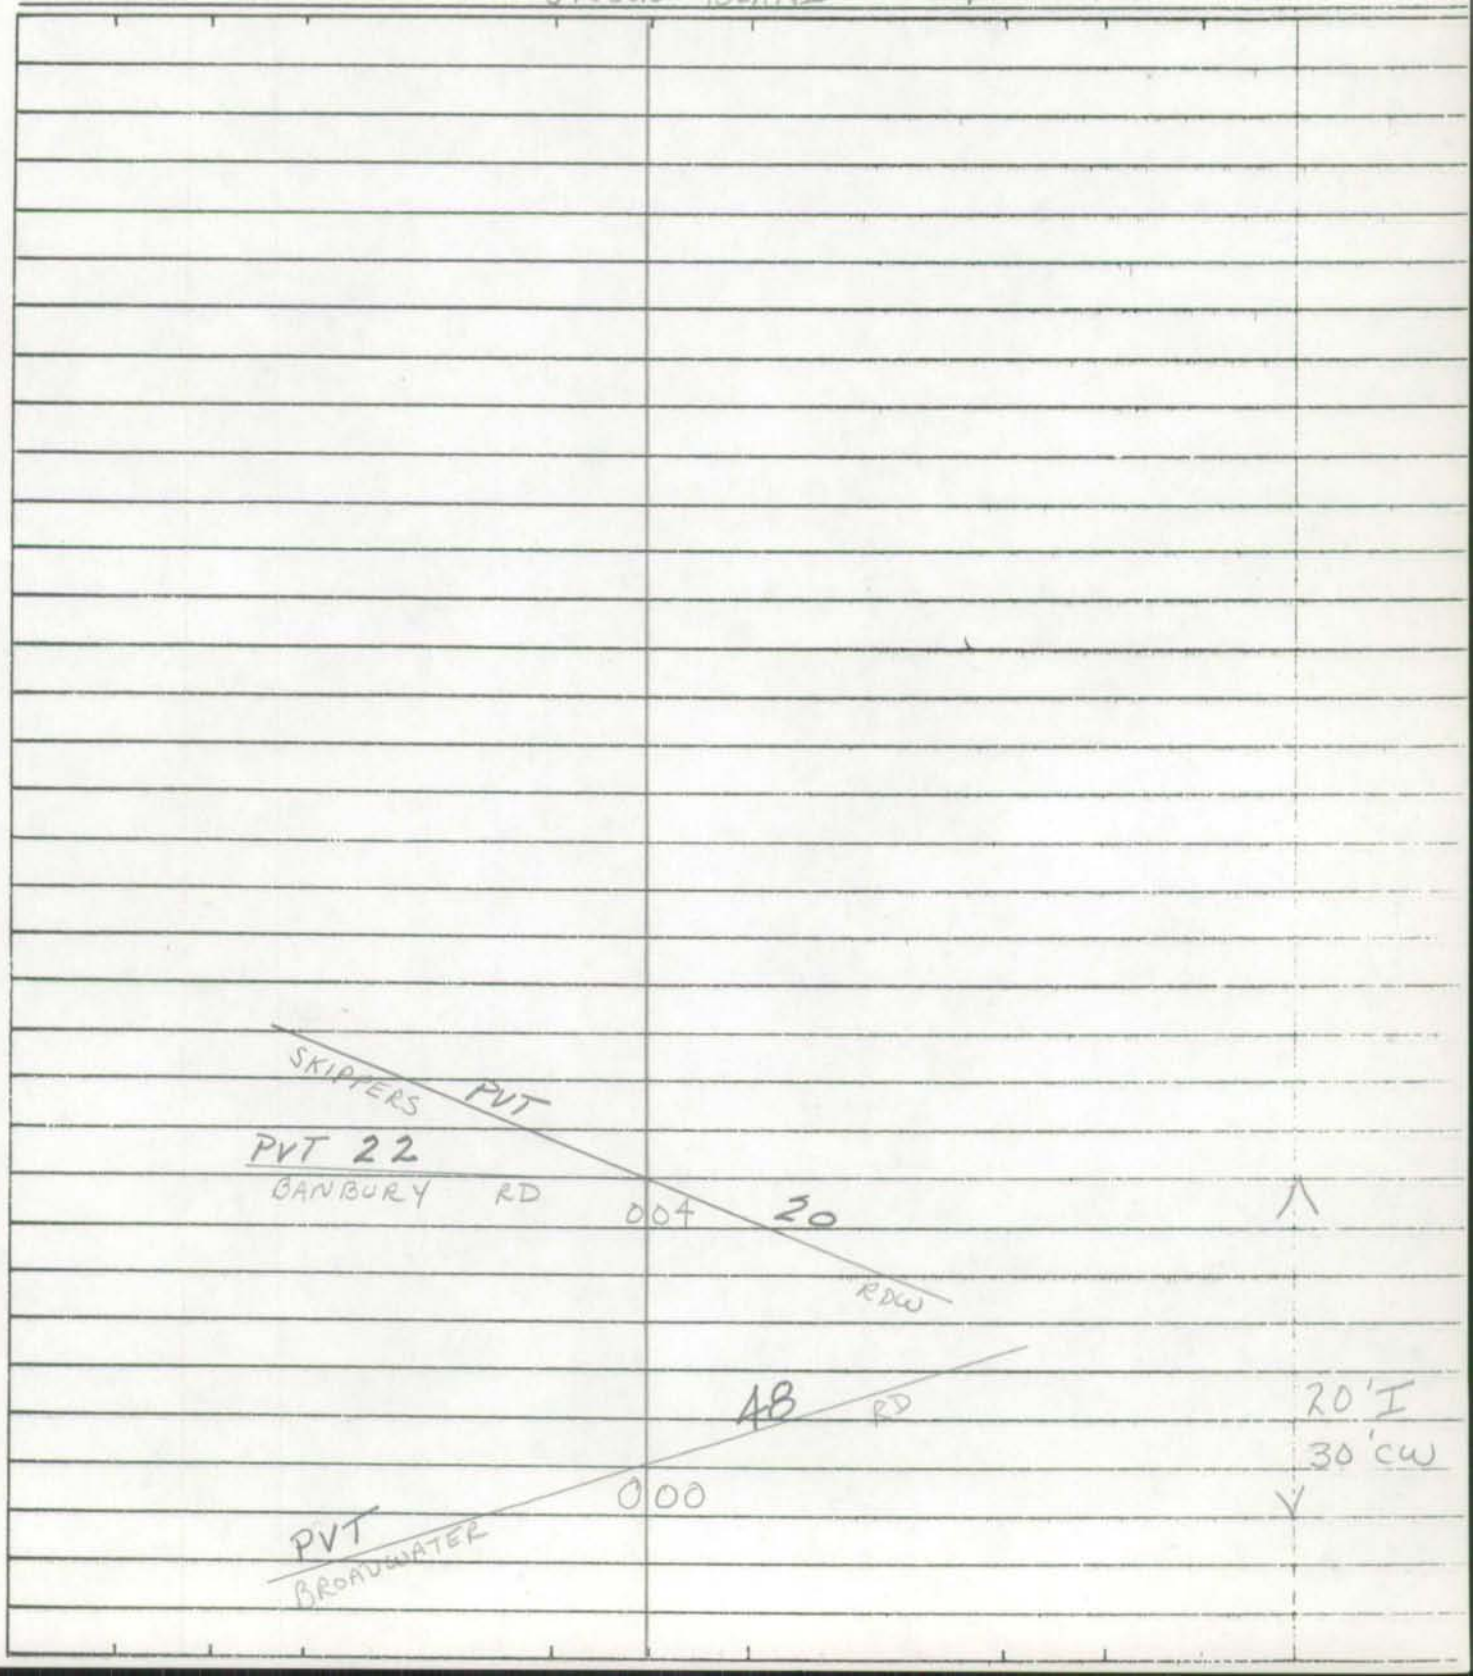

Form 6 HPS (Rev. 1961)

ROAD INVENTORY SHEET

Road No. _____
Road Name _____
Sheet No. _____
Date _____
County _____

BMATS

Form 6 HPS (Rev. 1961)

ROAD INVENTORY SHEET

Party Chief E. SCHUYLER
Recorder W. DOMBROSKI
Helper

MAP 29

Road No. PVT 22
Road Name BANBURY RD
Sheet No. 1 OF 2
Date 11-11-71
County ANNE ARUNDEL

GIBSON ISLAND 963-455

0096 15" TERR. PIPE 30'
0077 PVT. 25 36" RCP
0070 10'
0062 36" R.C.P.
PVT 37
0047 PIECE OF GOLF COURSE
0046 SPUR PVT 24
0045 ABERFOYLE RD
8' D
0032 400' H
0023 H
H
PIECE OF GOLF COURSE
0020 8'E 300'
0013 H 30'
W
H 0012
10° H 0009 H 20 ROW
18' H
26' CW
PVT 21
(CROSSOVER)
0000 PIECE OF GOLF COURSE 5 HOLE
PVT. SKIPPERS

Form 6 HPS (Rev. 1961)

ROAD INVENTORY SHEET

Road No. PVT. 22
Road Name BANBURY RD
Sheet No. 2 OF 2
Date 11-11-71
County ANNE ARUNDEL

MAP 29

GIBSON ISLAND

PVT.
MAGOTHY

28

104

RD

SAME

103

BMATS

Form 6 HPS (Rev. 1961)

ROAD INVENTORY SHEET

Party Chief E. SCHUYLER
Recorder W. DOMBROSKI
Helper

MAP 29

Road No. PVT 23
Road Name (ALLEY)
Sheet No. 1 OF 1
Date 11-11-71
County ANNE ARUNDEL

GIBSON ISLAND 962-455

PVT
ABERFOYLE

0 20 24 RD
SPUR
0 19
0 17
0 00 20 ROW

S
T 45°

PVT
SKIPPERS

PVT
ABERFOYLE RD

12' E
12' CW

Form 6 HPS (Rev. 1961)

ROAD INVENTORY SHEET

Road No. _____
Road Name _____
Sheet No. _____
Date _____
County _____

BMATS

Form 6 HPS (Rev. 1961)

ROAD INVENTORY SHEET

Party Chief E. SCHUYLER
Recorder W. DOMBROSKI
Helper

MAP 29

Road No. PVT. 24
Road Name ABERFOYLE RD
Sheet No. 1 OF 1
Date 11-11-71
County ANNE ARUNDEL

GIBSON ISLAND 962-455

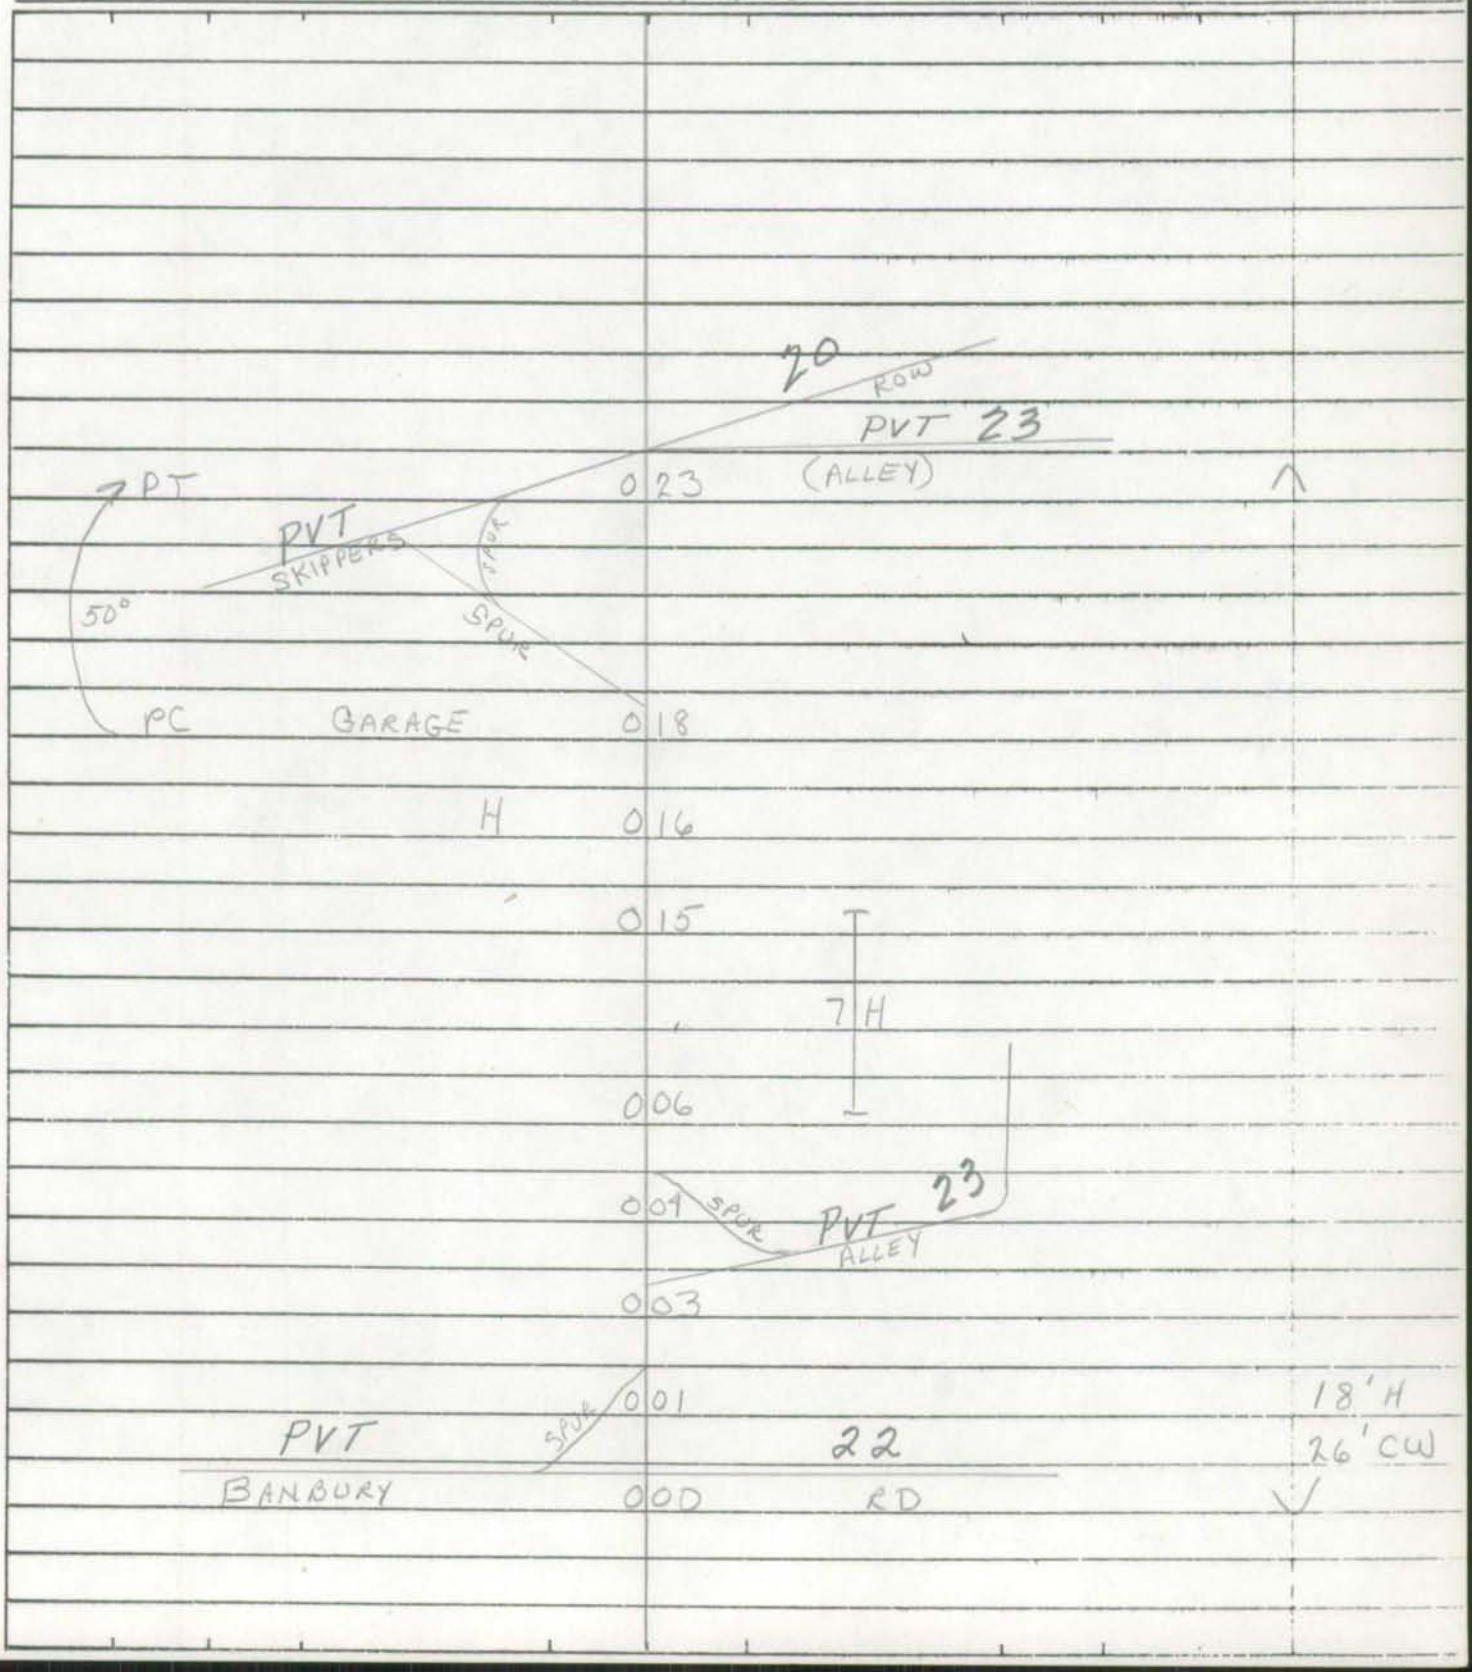

Form 6 HPS (Rev. 1961)

ROAD INVENTORY SHEET

Road No. _____
Road Name _____
Sheet No. _____
Date _____
County _____

BMATS

Form 6 HPS (Rev. 1961)

ROAD INVENTORY SHEET

Party Chief E. SCHUYLER
Recorder W. DOMBROSKI
Helper

MAP 29

Road No. PVT 25
Road Name
Sheet No. 1 OF 1
Date 11-11-71
County ANNE ARUNDEL

0.70 (BANBURY RD) GIBSON ISLAND 960-456

PVT (BANBURY)

0 36 9Q (RD)

0 29 15" RCP

S

PROPOSED 0 05

PVT 26 (SS MIDDLE NY RD)

0 00

8'D
8'CW

Form 6 HPS (Rev. 1961)

ROAD INVENTORY SHEET

Road No. _____
Road Name _____
Sheet No. _____
Date _____
County _____

BMATS

Form 6 HPS (Rev. 1961)

ROAD INVENTORY SHEET

Party Chief E. SCHUYLER
Recorder W. DOMBROSKI
Helper

MAP 29

Road No. PVT 26
Road Name (PURDY PT. Rd.)
Sheet No. 1 OF 1
Date 11-11-71
County ANNE ARUNDEL

1.03 GIBSON ISLAND 959-456

DE
CUL 0|64 SAC
0|59 20°
20° 0|41
0|30 PT 20°
PROPOSED
0|28 PC
(0.70 BANBURY RD)
0|12 PVT 25
20° 0|07
(1.04 MAGOTHY RD)
PVT 27 0|01
E
PVT (MAGOTHY) 0|00 28 (RD)
8'D
8'CW

Form 6 HPS (Rev. 1961)

ROAD INVENTORY SHEET

Road No. _____
Road Name _____
Sheet No. _____
Date _____
County _____

BMATS

Form 6 HPS (Rev. 1961)

ROAD INVENTORY SHEET

Party Chief E. SCHUYLER
Recorder W. DOMGROSKI
Helper

MAP 29

Road No. PVT 27
Road Name
Sheet No. 1 OF 1
Date 11-11-71
County ANNE ARUNDEL

1.04 (MAGOTHY RD) GIBSON ISLAND 959-456

ROAD 007 END

W

PVT
(MAGOTHY)
001
28
(RD)
30°
26
000
PVT
8'D
8'CW

Form 6 HPS (Rev. 1961)

ROAD INVENTORY SHEET

Road No. _____
Road Name _____
Sheet No. _____
Date _____
County _____

Form 6 HPS (Rev. 1961)

BMATS

ROAD INVENTORY SHEET

Party Chief E. SCHUYLER
Recorder W. DOMBROSKI
Helper

Road No. PVT 28
Road Name MAGOTHY RD
Sheet No. 1 OF 2
Date 11-11-71
County ANNE ARUNDEL

MAP 29

GIBSON ISLAND 960-452

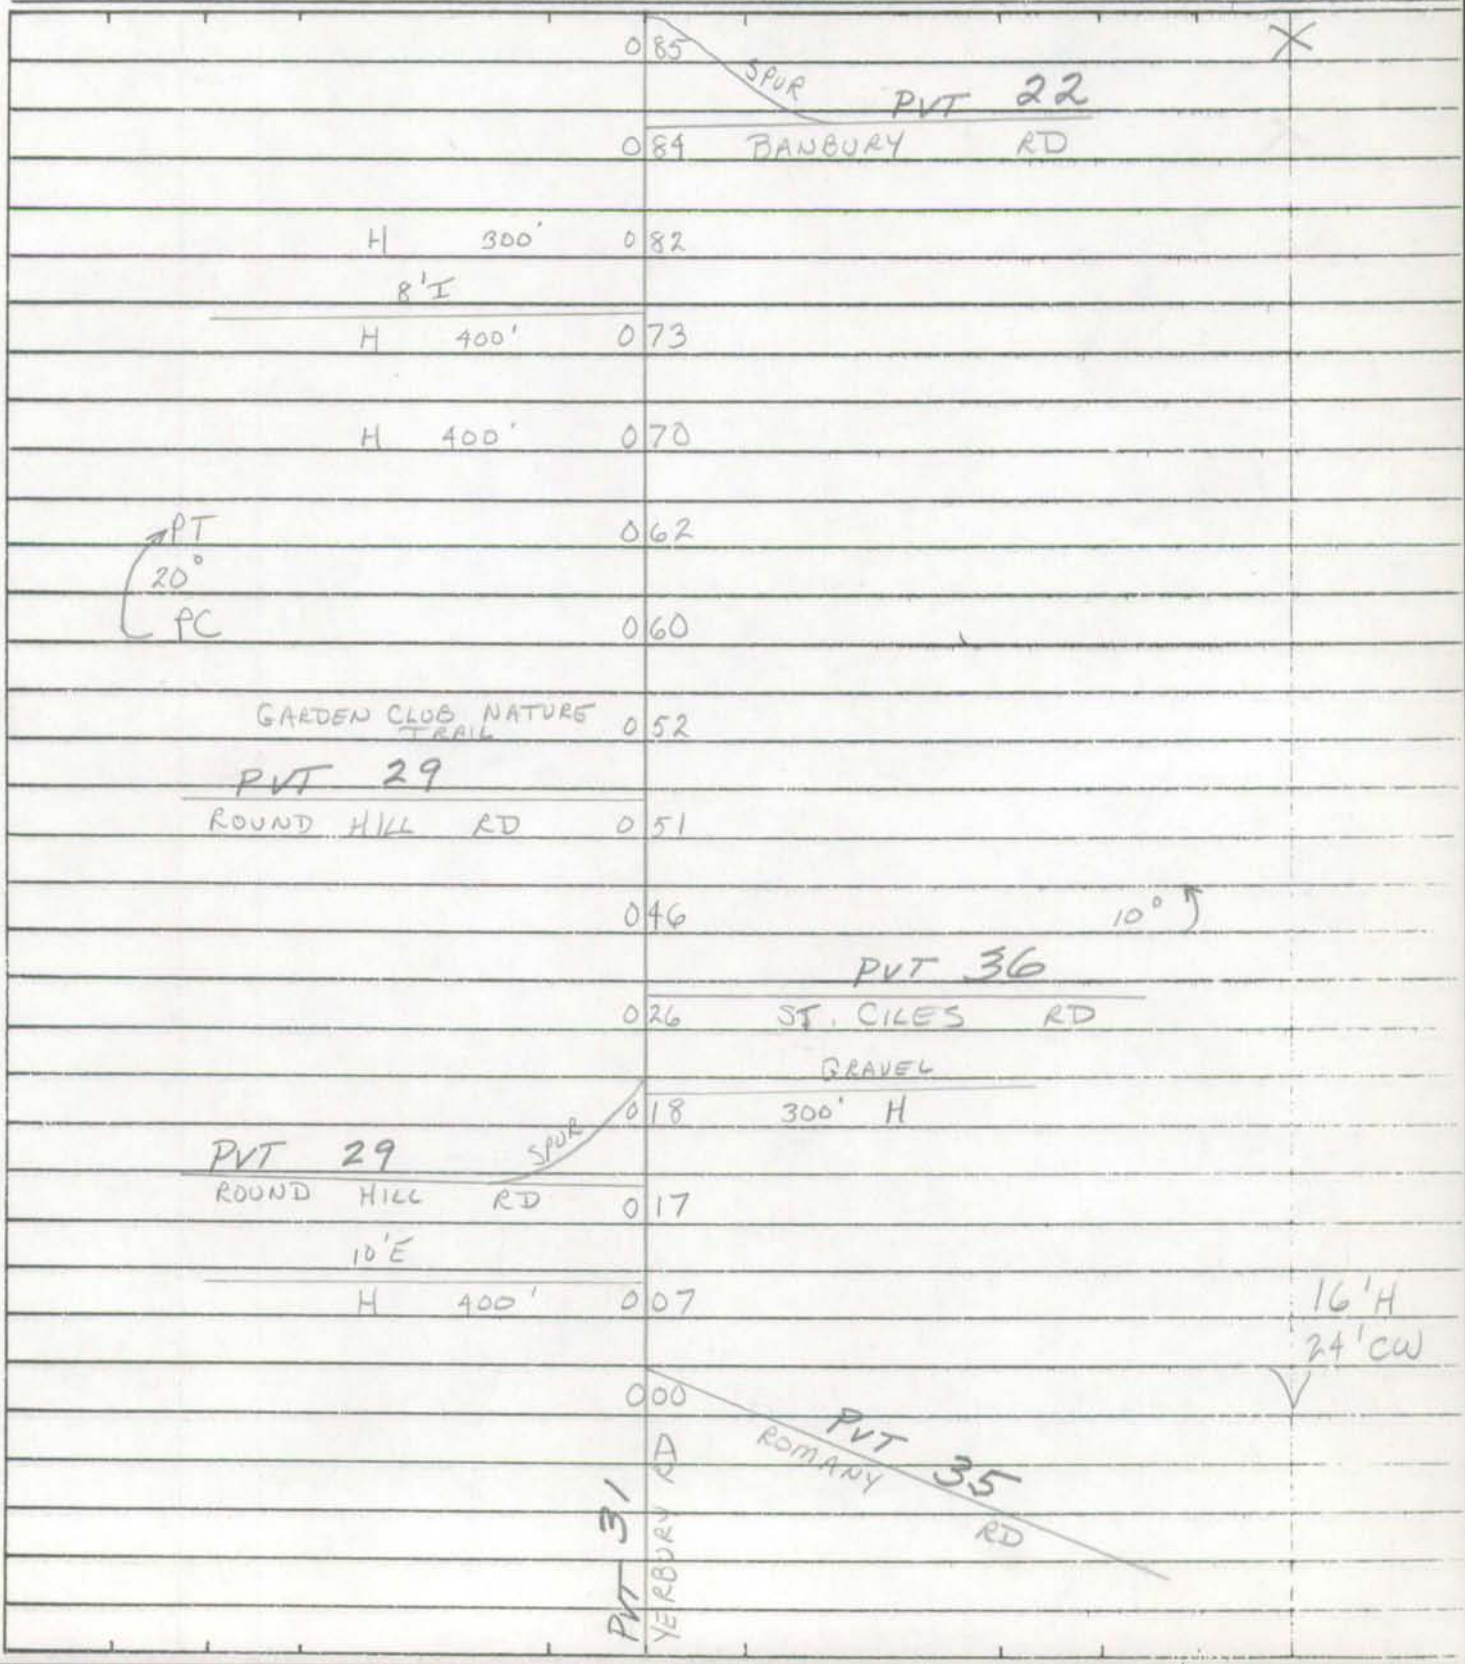

Form 6 HPS (Rev. 1961)

ROAD INVENTORY SHEET

Road No. PVT 28
Road Name MAGOTHY RD
Sheet No. 2 OF 2
Date 11-11-71
County ANNE ARUNDEL

MAP 29

GIBSON ISLAND

D E

COL 1 46 SAC

1 45 80° ↑

↑ 45° 1 40

1 37 35° ↑

↑ 15° 1 32

1 15 RIFLE RANGE

PVT 27 1 10 PVT 26 10° ↑

1 04

1 03 16' E 22' CW

BMATS

Form 6 HPS (Rev. 1961)

ROAD INVENTORY SHEET

Party Chief E. SCHUYLER
Recorder W. DOMBROSKI
Helper

MAP 29

Road No. PVT 29
Road Name ROUND HILL RD
Sheet No. 1 OF 2
Date 11-11-71
County ANNE ARUNDEL

GIBSON ISLAND 959-453

PC	0 58	
	0 49	PT
	0 48	300' H
		85°
	0 47	H
	0 44	PC
	0 38	H
	0 34	H
	0 29	H 25°
	0 26	PT
	PVT 30	
	0 25 COOLEYS POND RD	35°
	0 23	PC
PT 15° PC	0 13	
	0 10	
	0 03	20° 17'H
PVT	28	24'CW
MAGOTHY	0 00 RD	

W

Form 6 HPS (Rev. 1961)

ROAD INVENTORY SHEET

Road No. PVT 29
Road Name ROUND HILL RD
Sheet No. 2 OF 2
Date 11-11-71
County ANNE ARUNDEL

MAP 29

GIBSON ISLAND

28
RD

PVT
MAGATHY
SPUR

0.69

0.67

PT

0.65

SAME

20°

BMATS

Form 6 HPS (Rev. 1961)

ROAD INVENTORY SHEET

Party Chief E. SCHUYLER
Recorder W. DOMBROSKI
Helper

MAP 29

Road No. PVT 30
Road Name COOLEYS POND RD
Sheet No. 1 OF 1
Date 11-11-71
County ANNE ARUNDEL

GIBSON ISLAND 958-453

	ROAD	END	
	H	0 14	^
	H	0 12	
	H	0 07	
PT		0 06	
30°	H	0 05	
PC	H	0 02	29 RD
PVT ROUND HILL		0 00	17' H 24' CW V

N

Form 6 HPS (Rev. 1961)

ROAD INVENTORY SHEET

Road No. _____
Road Name _____
Sheet No. _____
Date _____
County _____

BMATS

Form 6 HPS (Rev. 1961)

ROAD INVENTORY SHEET

Party Chief E. SCHUYLER
Recorder W. DOMBROSKI
Helper

MAP 29

Road No. PVT 31
Road Name YERBURY RD
Sheet No. 1 OF 1
Date 11-11-71
County ANNE ARUNDEL

GIBSON ISLAND 960-451

PVT. 28 MAGOTHY RD

019 PVT 35 SPUR ROMANY RD

017

012 PT 90° PRC

005 PRC 75° PC

001 18' H 24' CW

PVT SKYWATER

000 32 RD

N

Form 6 HPS (Rev. 1961)

ROAD INVENTORY SHEET

Road No. _____
Road Name _____
Sheet No. _____
Date _____
County _____

BMATS

Form 6 HPS (Rev. 1961)

ROAD INVENTORY SHEET

Party Chief E. SCHUYLER
Recorder W. DOMBROSKI
Helper

MAP 29

Road No. PVT 32
Road Name SKYWATER RD
Sheet No. 1 OF 2
Date 11-11-71
County ANNE ARUNDEL

GIBSON ISLAND 962-449

0043 H

PT
80°
PRC

0039

H 0034

PRC
75°
PC

0031 H

0029

H 0026 H

PT
80°
PC

0023

H 0019 H

H 0017

H 0014 H

8" P
300'
H

0011

H 0009

SPUR PVT 33 RD
RACHHAM

0007

W

H 0005 H

H 0003 H

20'I
26'CW

PVT 48
BROAD WATER 0000 RD

Form 6 HPS (Rev. 1961)

ROAD INVENTORY SHEET

Road No. PVT 32
Road Name SKYWATER RD
Sheet No. 2 OF 2
Date 11-11-71
County ANNE ARUNDEL

MAP 29

GIBSON ISLAND

	DE H	
CUL	0 60 SAC	↑
	0 56	
↑80°	0 54	8' F
	PVT 31	10' CW
	0 50 YERBURY RD	X
H	0 47	
	0 45 H	
	0 41 10° ↑	SAME

BMATS

Form 6 HPS (Rev. 1961)

ROAD INVENTORY SHEET

Party Chief E. SCHUYLER
Recorder W. DOMEROSKI
Helper

MAP 29

Road No. PVT 33
Road Name RACHHAM RD
Sheet No. 1 OF 1
Date 11-11-71
County ANNE ARUNDEL

GIBSON ISLAND

961-449

N

D E
H CUL 0 15 SAC
0 14 H
90° 0 06
PVT SKYWATER SOUR 0 02 H
0 00
32 RD
10' H
16' CW

Form 6 HPS (Rev. 1961)

ROAD INVENTORY SHEET

Road No. _____
Road Name _____
Sheet No. _____
Date _____
County _____

BMATS

Form 6 HPS (Rev. 1961)

ROAD INVENTORY SHEET

Party Chief E. SCHUYLER
Recorder W. DOMBROSKI
Helper

MAP 29

Road No. PVT 34
Road Name BYWATER RD
Sheet No. 1 OF 1
Date 11-11-71
County ANNE ARUNDEL

962-449

		DE		
CUL	0	18	SAC	^
	0	16	H	
H	0	10	H	
	0	08	H	
H	0	06	H	PT
	0	03	H	85°
	0	02		PC 16' H
PVT.		48		20' CW
BROAD WATER	0	00	RD	v

E ↑

Form 6 HPS (Rev. 1961)

ROAD INVENTORY SHEET

Road No. _____
Road Name _____
Sheet No. _____
Date _____
County _____

BMATS

Form 6 HPS (Rev. 1961)

ROAD INVENTORY SHEET

Party Chief E. SCHUYLER
Recorder W. DOMBROSKI
Helper

MAP 29

Road No. PVT 35
Road Name ROMANY RD
Sheet No. 1 OF 1
Date 11-11-71
County ANNE ARUNDEL

GIBSON HWY 962-450

PVT 28 MAGOTHY RD

PVT 31 YERBURY RD

SPUR

0 42

T 10°

0 40

0 28

10° ↑

W

T 35°

H

0 06

0 04

SPUR

12' E
20' CW

PVT BROAD WATER

0 00

48 WAY

Form 6 HPS (Rev. 1961)

ROAD INVENTORY SHEET

Road No. _____
Road Name _____
Sheet No. _____
Date _____
County _____

BMATS

Form 6 HPS (Rev. 1961)

ROAD INVENTORY SHEET

Party Chief E. SCHUYLER
Recorder W. DOMBROSKI
Helper

Road No. PVT 36
Road Name ST GILES RD
Sheet No. 1 OF 2
Date 11-11-71
County ANNE ARUNDEL

960-453

MAP 29

GIBSON ISLAND PVT 38

0+42 STILL WATER RD
SPUR
0+40
PVT 37
0+35
SPUR
0+34
T 45°
0+31
0+24 300' H
0+23 PT
0+21 250' H 45°
0+19 300' H PC
0+17 15" RCP
0+16 H
0+11 H
E
0+09 36" RCP
0+04 H
0+02 15" RCP 16' F
28 24' CW
PVT MAGOTHY 0+00 RD
V

Form 6 HPS (Rev. 1961)

ROAD INVENTORY SHEET

Road No. PVT 36
Road Name ST CILES RD
Sheet No. 2 OF 2
Date 11-11-71
County ANNE ARUNDEL

MAP 29

GIBSON ISLAND

PVT BROADWATER

0.74 PVT 46 BEACON RD

0.70 KERRY WAY 48

0.61 H

0.58 PVT 39 COTTERILL RD 25'

0.49 H SAME

BMATS

Form 6 HPS (Rev. 1961)

ROAD INVENTORY SHEET

Party Chief E. SCHUYLER
Recorder W. DOMBROSKI
Helper

MAP 29

Road No. PVT 37
Road Name
Sheet No. 1 OF 1
Date 11-11-71
County ANNE ARUNDEL

0.47 GIBSON ISLAND 961-454

ROAD 0 35 END

PVT ST GILES 0 23 — 36 RD

SPUR 0 22

30° 0 19

0 16 10°

0 08 45°

S 25° 0 05

TRAIL FOR 0 02 GOLF CARTS

8'D
8'CW

PVT BANBURY 0 00 — 22 RD

Form 6 HPS (Rev. 1961)

ROAD INVENTORY SHEET

Road No. _____
Road Name _____
Sheet No. _____
Date _____
County _____

BMATS

Form 6 HPS (Rev. 1961)

ROAD INVENTORY SHEET

Party Chief E. SCHUYLER
Recorder W. DOMBROSKI
Helper

MAP 29

Road No. PVT 38
Road Name STILL WATER RD
Sheet No. 1 OF 1
Date 11-11-71
County ANNE ARUNDEL

961-453

GIBSON ISLAND 48

PVT BROAD WATER WAY

0 58

0 57 PT 30°

0 52 3 H PC

3 H

0 47

PVT 43

OXBURY RD

0 44 H

H 0 41 H

H 0 38 H

0 29 H

H 0 24 H 35°

0 22 H

PVT 40

JORRICK RD

0 20

SPUR

0 19 H

H 0 12

0 09 H

0 01 35° 16'H 18'CW

SPUR 36

PVT ST CILES 0 00 RD

S

Form 6 HPS (Rev. 1961)

ROAD INVENTORY SHEET

Road No. _____
Road Name _____
Sheet No. _____
Date _____
County _____

BMATS

Form 6 HPS (Rev. 1961)

ROAD INVENTORY SHEET

Party Chief E. SCHUYLER
Recorder W. DOMBROSKI
Helper

MAP 29

Road No. PVT 39
Road Name COTTERILL RD
Sheet No. 1 OF 1
Date 11-11-71
County ANNE ARUNDEL

GIBSON ISLAND 962-453

ROAD 011 END PT

009 H 90°

H 005 H PC

H 003

36 RD

PVT ST. CHES 000

17'H
24'CW

S

Form 6 HPS (Rev. 1961)

ROAD INVENTORY SHEET

Road No. _____
Road Name _____
Sheet No. _____
Date _____
County _____

BMATS

Form 6 HPS (Rev. 1961)

ROAD INVENTORY SHEET

Party Chief E. SCHUYLER
Recorder W. DOMBROSKI
Helper

MAP 29

Road No. PVT 40
Road Name JORRICK RD
Sheet No. 1 OF 1
Date 11-11-71
County ANNE ARUNDEL

GIBSON ISLAND 962-452

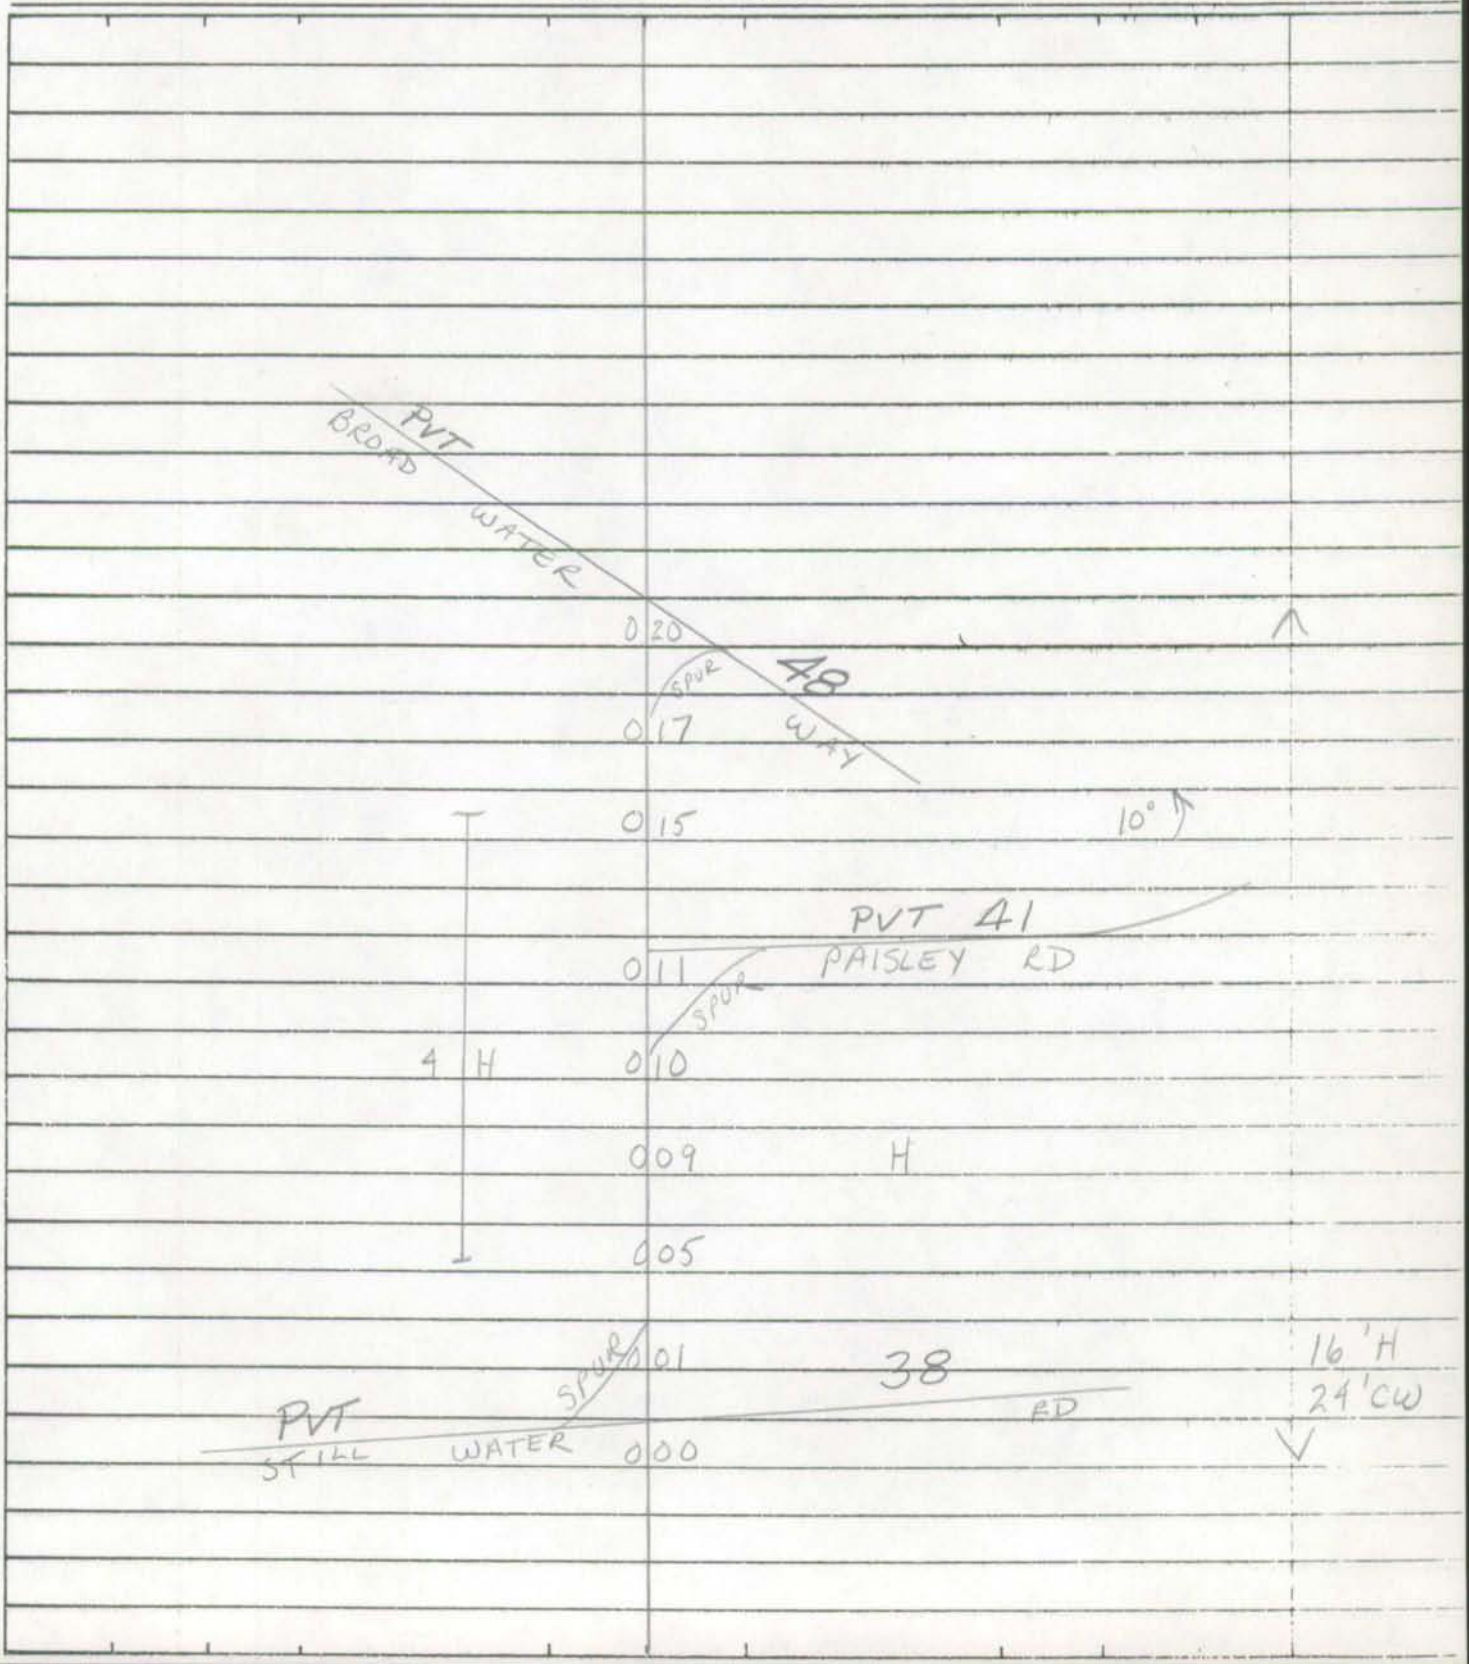

Form 6 HPS (Rev. 1961)

ROAD INVENTORY SHEET

Road No. _____
Road Name _____
Sheet No. _____
Date _____
County _____

BMATS

Form 6 HPS (Rev. 1961)

ROAD INVENTORY SHEET

Party Chief E. SCHUYLER
Recorder W. DOMBROSKI
Helper

MAP 29

Road No. PVT 41
Road Name PAISLEY RD
Sheet No. 1 OF 1
Date 11-11-71
County ANNE ARUNDEL

GIBSON ISLAND 962-452

D E
CUL 0 10 SAC

T 10° 0 06

0 04 H

0 01 35° 16' H
SPUR 40 26' CW
PVT RD
JORRICK 0 00

S

Form 6 HPS (Rev. 1961)

ROAD INVENTORY SHEET

Road No. _____
Road Name _____
Sheet No. _____
Date _____
County _____

BMATS

Form 6 HPS (Rev. 1961)

ROAD INVENTORY SHEET

Party Chief E. SCHUYLER
Recorder W. DOMBROSKI
Helper

MAP 29

Road No. PVT 42
Road Name MEADOW LA
Sheet No. 1 OF 1
Date 1-11-71
County ANNE ARUNDEL

GIBSON ISLAND 963-451

E

DE
CUL 006 SAC H

005 H

10'F
14'CW

PVT 48
(BROAD WATER) 000 (ROAD)

Form 6 HPS (Rev. 1961)

ROAD INVENTORY SHEET

Road No. _____
Road Name _____
Sheet No. _____
Date _____
County _____

Form 6 HPS (Rev. 1961)

BMATS

ROAD INVENTORY SHEET

Party Chief E. SCHUYLER
Recorder W. DOMOROSKI
Helper

MAP 29

Road No. PVT 43
Road Name OXBURY RD
Sheet No. 1 OF 1
Date 11-11-71
County ANNE ARUNDEL

GIBSON ISLAND

962-451

PVT
STILL WATER 0 0 8

38
RD

H 0 0 6 H 30° ↱

H 0 0 3

16' H
24' CW

PVT
BROAD WATER 0 0 0

48
RD

PVT 44
AYRLIE WATER RD

W

Form 6 HPS (Rev. 1961)

ROAD INVENTORY SHEET

Road No. _____

Road Name _____

Sheet No. _____

Date _____

County _____

BMATS

Form 6 HPS (Rev. 1961)

ROAD INVENTORY SHEET

Party Chief E. SCHUYLER
Recorder W. DOMBROSKI
Helper

MAP 29

Road No. PVT 44
Road Name AYRLIEWATER RD
Sheet No. 1 OF 1
Date 11-11-71
County ANNE ARUNDEL

GIBSON ISLAND 48 WAY 963-451

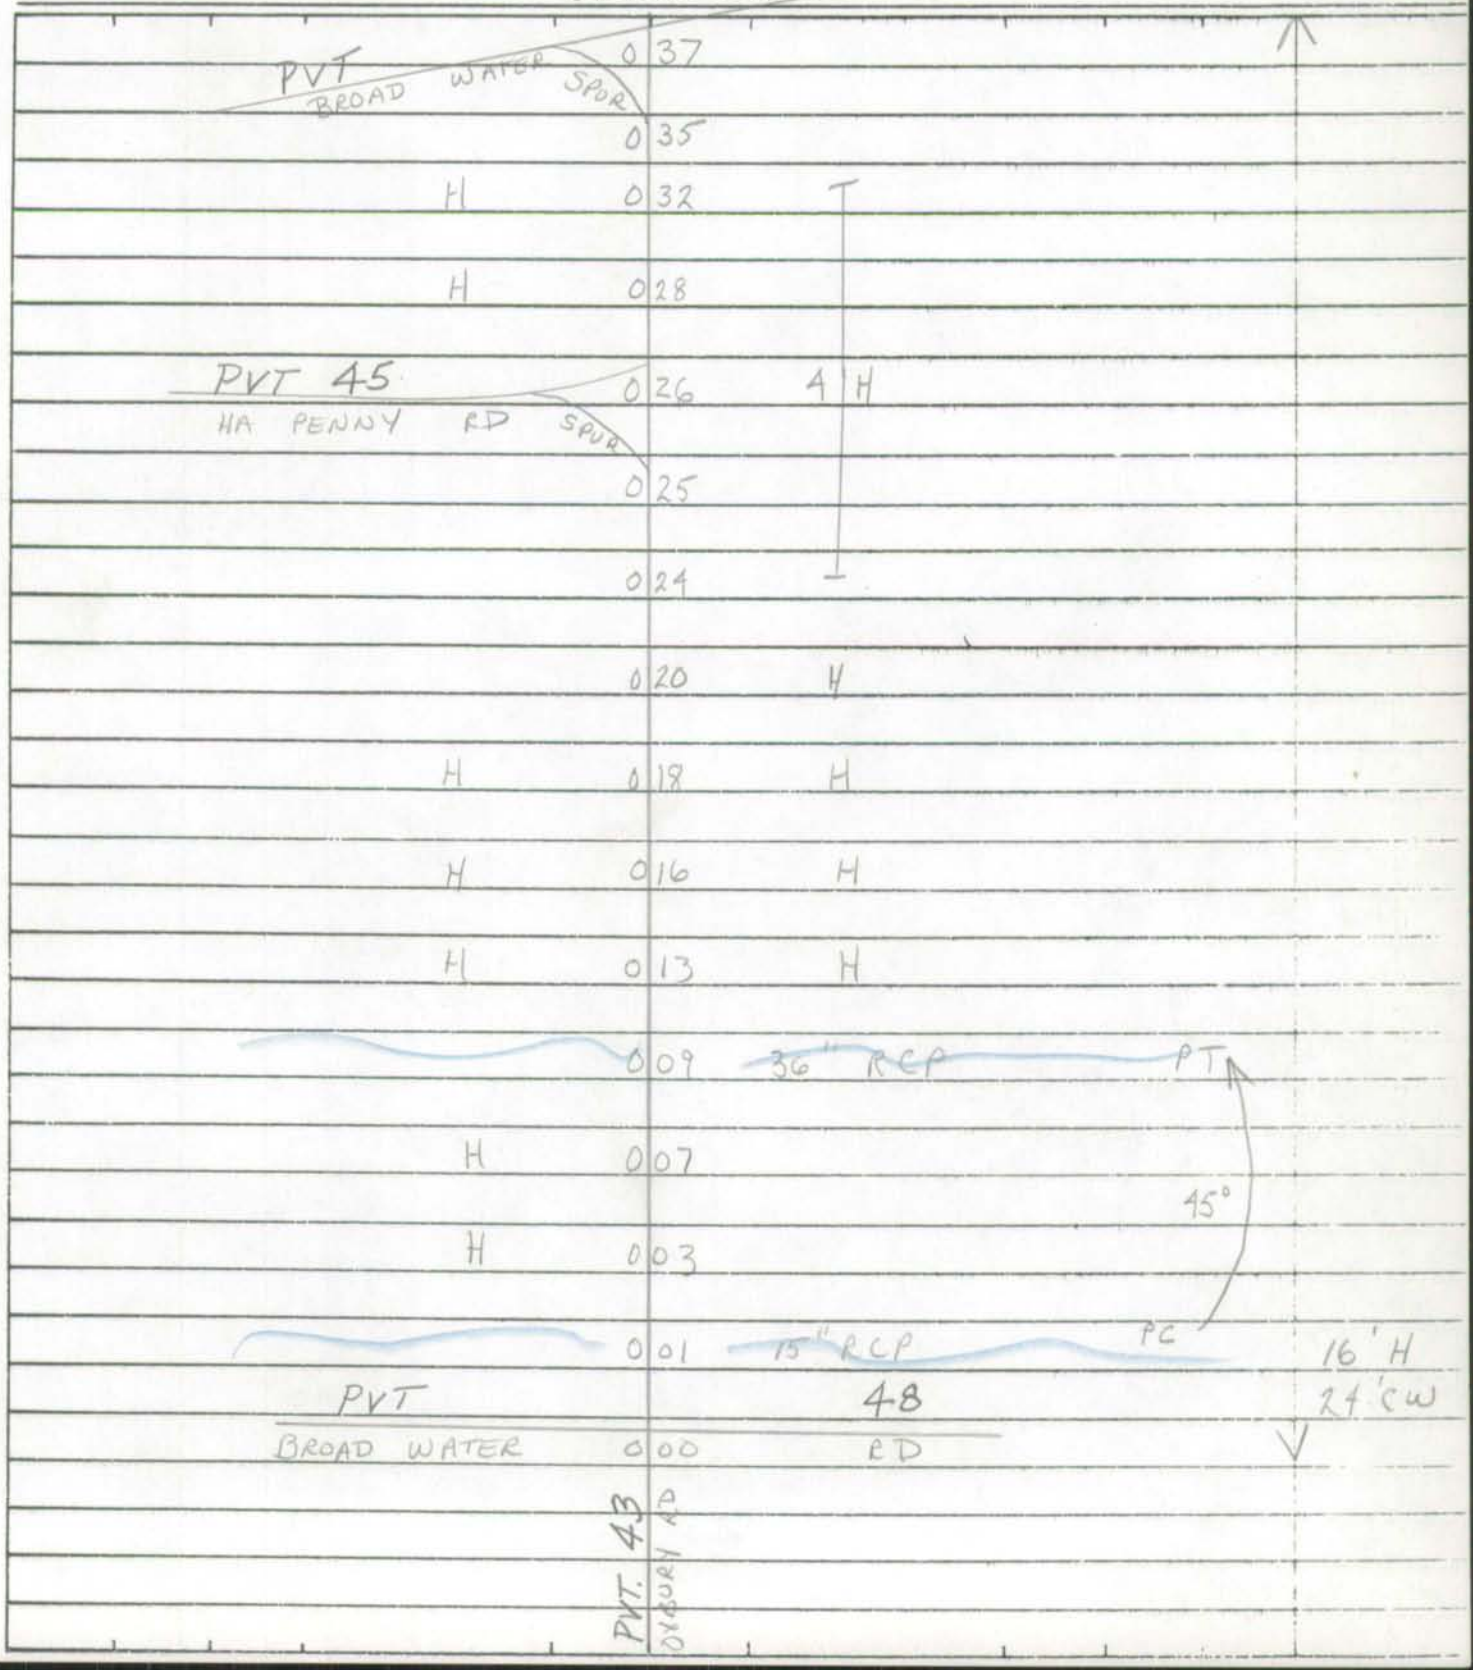

Form 6 HPS (Rev. 1961)

ROAD INVENTORY SHEET

Road No. _____
Road Name _____
Sheet No. _____
Date _____
County _____

BMATS

Form 6 HPS (Rev. 1961)

ROAD INVENTORY SHEET

Party Chief E. SCHUYLER
Recorder W. DOMBROSKI
Helper

MAP 29

Road No. PVT. 45
Road Name HA PENNY RD
Sheet No. 1 OF 1
Date 11-11-71
County ANNE ARUNDEL

GIBSON ISLAND 963-452

W

PVT 46 (KERRY BACON RD)
0 11
10' H
24' CW
0 07
H 0 06
40°
0 02
16' F
24' CW
PVT SPUR 44
(AYRLIEWATER) 0 00 (RD)

Form 6 HPS (Rev. 1961)

ROAD INVENTORY SHEET

Road No. _____
Road Name _____
Sheet No. _____
Date _____
County _____

BMATS

Form 6 HPS (Rev. 1961)

ROAD INVENTORY SHEET

Party Chief E. SCHUYLER
Recorder W. DOMBROSKI
Helper

MAP 29

Road No. PVT 46
Road Name KERRY BACON RD
Sheet No. 1 OF 1
Date 11-11-71
County ANNE ARUNDEL

GIBSON ISLAND 963-452

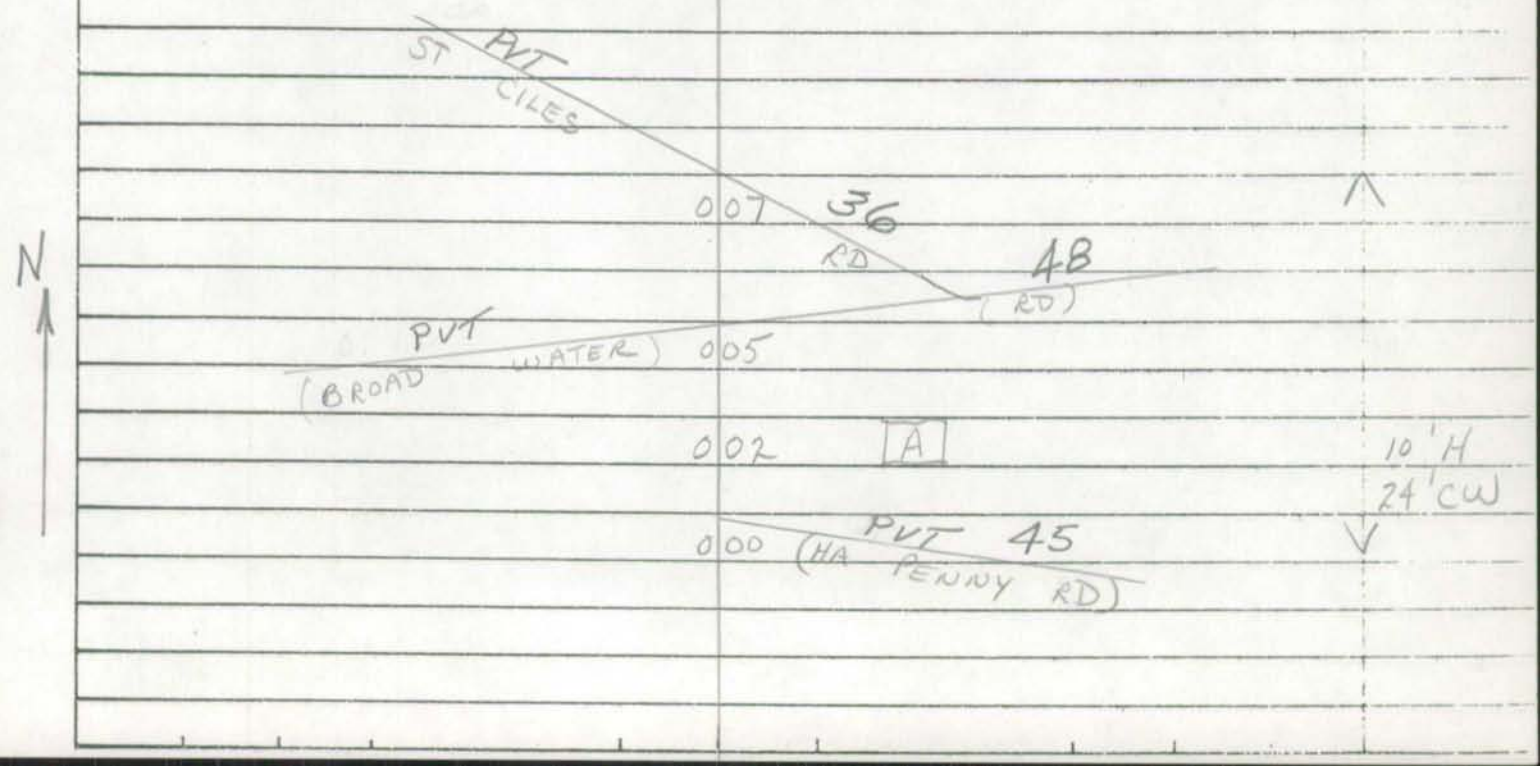

Form 6 HPS (Rev. 1961)

ROAD INVENTORY SHEET

Road No. _____
Road Name _____
Sheet No. _____
Date _____
County _____

BMATS

Form 6 HPS (Rev. 1961)

ROAD INVENTORY SHEET

Party Chief E. SCHUYLER
Recorder W. DOMARASKI
Helper

MAP 29

Road No. PVT 47
Road Name
Sheet No. 1 OF 1
Date 11-11-71
County ANNE ARUNDEL

0.26 GIBSON ISAND 964-454

ROAD 0	10	END
		8'C
		8'CW
ENT TO GOLF + TENNIS SHOP	0	03
PVT BROADWATER		20'H
		30'CW
0	00	48 RD

W

Form 6 HPS (Rev. 1961)

ROAD INVENTORY SHEET

Road No. _____
Road Name _____
Sheet No. _____
Date _____
County _____

BMATS

Form 6 HPS (Rev. 1961)

ROAD INVENTORY SHEET

Party Chief E. SCHUYLER
Recorder W. DOMBROSKI
Helper

MAP 29

Road No. PVT 48
Road Name BROAD WATER RD
Sheet No. 1 OF 3
Date 11-11-71
County ANNE ARUNDEL

GIBSON ISLAND 964-455

PVT. 44 ARLIE WATER RD
PT
80°
PC
0 45
0 37
0 36
SWIMING POOL 0 33 TENNIS COURTS
0 30 GIBSON ISLAND POST OFFICE
COUNTRY CLUB 0 29 PVT. 47
0 26
4 H
0 14
H 0 11
CHURCH 0 08
0 04
PT
(CROSSOVER) PVT 21
0 03
15°
PVT 20 ROW
0 01
PC
PVT. SKIPPERS
21 'I
30 CW
0 00
PVT. 19 GIBSON ISLAND CRUSEWAY
S

Form 6 HPS (Rev. 1961)

ROAD INVENTORY SHEET

Road No. PVT. 48
Road Name BROAD WATER RD
Sheet No. 2 OF 3
Date 11-11-71
County ANNE ARUNDEL

MAP 29

GIBSON ISLAND

PT	1 05		
			OTTER
50°	0 98	15" RCP	
			POND
PC	0 97		
5 H	0 93	STILLWATER RD PVT 38	
	0 88		
PVT 42 MEADOW LA	0 83	H	
PVT 44 AYRLIEWATER RD	0 79	PVT 43 OXBURY RD	
	0 77	H	
H	0 74	H	
H	0 69		
H	0 66	H	
H	0 62	SPUR PVT 40 RD JORRICK	
	0 60		
PVT. 46 KERRY BEACON	0 55		PT
	16 RD 0 52	36 RD	45°
	PVT. ST. CILES 0 48		PC SAME

Form 6 HPS (Rev. 1961)

ROAD INVENTORY SHEET

Party Chief E. SCHUYLER
Recorder W. DOMAROSKI
Helper

Road No. PVT 48
Road Name BROAD WATER RD
Sheet No. 3 OF 3
Date 11-11-71
County ANNE ARUNDEL

MAP 29

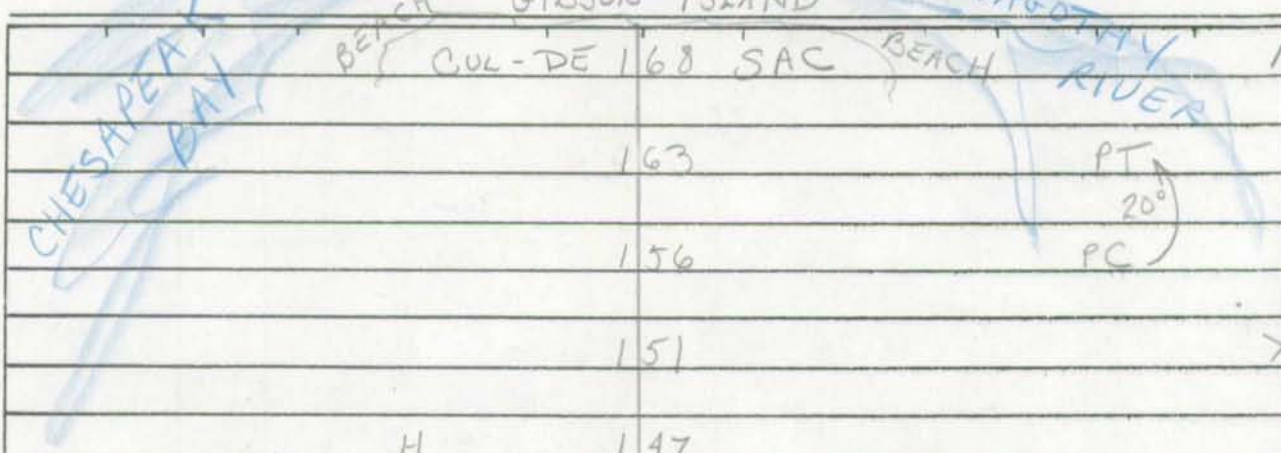

	163		PT 20°	
	156		PC	18'H 20'CW
	151			X
H	147			
H	144	H		
H	141			
H	139	H		
PVT 34 BYWATER RD	135	H		20'H 30'CW
		PVT 32 SKY WATER RD		X
H	130			
H	127	H		
	125	H		
	122	H		
	118	H PVT 35 RD	PT	
3H	114	SPUR ROMANY	50°	
	111		PC	SAME

Form 6 HPS (Rev. 1961)

ROAD INVENTORY SHEET

Road No. _____
Road Name _____
Sheet No. _____
Date _____
County _____

Form 6 HPS (Rev. 1961) BMATS

ROAD INVENTORY SHEET

Party Chief ~~E. SCHUYLER~~
Recorder ~~W. DOMBROSKI~~
Helper

MAP 29

Road No. PVT. Rd. 49
Road Name (ENT TO WHIPOORWIRL GIRL SCOUT CAMP)
Sheet No. ~~OF~~ 1
Date 11-18-71
County ~~ANNE ARUNDEL~~ DIST. 1
936-457

2.53

H
CLUB HOUSE
ROAD 021 END
3 H

018
PT
85°
016
PC
ENT TO CAMP
GATE
015

W
PARKING FOR CAMP 013

008 H

H 004

1986
000 SHORE DR

8'E
8'CW

LAKE

Form 6 HPS (Rev. 1961)

ROAD INVENTORY SHEET

Road No. _____

Road Name _____

Sheet No. _____

Date _____

County _____

Form 6 HPS (Rev. 1961)

BMATS

ROAD INVENTORY SHEET

Party Chief E. SCHUYLER
Recorder W. DOMBROSKI
Helper

MAP 29

Road No. PVT. 50
Road Name (ENT TO BOAT RAMPS)
Sheet No. 1 OF 1
Date 11-30-71
County ANNE ARUNDEL - DIST. 1

928-457

SIGN POLE
003 SEE PICTURE
002
000

S

12'I
2-JCURBS
28'I
2-JCURBS

Co (BERRYWOOD)
2136 (DR)

E. SCHUYLER
W. DOMBROSKI

11-30-71

OP
(ENT TO BOAT RAMPS) OFF OF BERRYWOOD DR.

PICTURE TAKEN AT 0.03 SHOWING SIGN POLE IN MIDDLE OF ROADWAY

MAP 29 - 928-457

Form 6 HPS (Rev. 1961)

ROAD INVENTORY SHEET

Road No. _____

Road Name _____

Sheet No. _____

Date _____

County _____

Form 6 HPS (Rev. 1961) BMATS

ROAD INVENTORY SHEET

Party Chief E. SCHUYLER
Recorder W. DOMBROSKI
Helper

Road No. PVT. 51
Road Name (ENT TO YACHT CLUB)
Sheet No. 1 OF 1
Date 12-9-71
County ANNE ARUNDEL DIST. 2

MAP 29
0.29
920-452

H
H
ROAD 0 12 END
0 11 15°
0 09 H
E
0 07 BAR & CLUB HOUSE 10°
T 30°
0 06
0 04 BOAT WAREHOUSE (DRY STOREAGE) 10'F
10'CW
(RD)
0 00
(0 21 16)
(SEVERN)

Form 6 HPS (Rev. 1961)

ROAD INVENTORY SHEET

Road No. _____
Road Name _____
Sheet No. _____
Date _____
County _____

Form 6 HPS (Rev. 1961)

BMATS

ROAD INVENTORY SHEET

Party Chief E. SCHUYLER
Recorder W. DOMBROSKI
Helper

Road No. PRIVATE 52
Road Name (ENT TO PRIVATE BEACH)
Sheet No. 1 OF 1
Date 12-13-71
County ANNE ARUNDEL - DIST. 2

D, 22 MAP 29 LINSTEAD ON THE SEVERN 926-449

SEVERN RIVER

PRIVATE BEACH

DE

CUL 005 SAC

GATE (OPEN) 001

CO 2223

(BOONE) 000 (TRAIL)

20' I
20' CW

S

Form 6 HPS (Rev. 1961)

ROAD INVENTORY SHEET

Road No. _____
Road Name _____
Sheet No. _____
Date _____
County _____

Form 6 HPS (Rev. 1961)

ROAD INVENTORY SHEET

Party Chief E. SCHUYLER
Recorder W. DOMBROSKI
Helper

Map No. 33

Road No. PVT. 53
Road Name NOTTINGHAM
Sheet No. 1 OF 1
Date 5-8-72
County Anne Arundel - District
State Coordinates 929-435

1.70 SHERWOOD FOREST

D E

CUL 0 27 SAC

0 25 RT 90° PC 8' F 10' Cu

0 23 PVT. 54 (NOTTINGHAM WAY CIR)

T 45° 0 19

0 11 H

H 0 10

H 0 06

0 05 PVT. 55 (COUNTRY CLUB RD)

N H 0 03

H 0 01 16' H 20' Cu

2753

SHERWOOD FOREST 0 00 RD

Form 6 HPS (Rev. 1961)

ROAD INVENTORY SHEET

Road No. _____
Road Name _____
Sheet No. _____
Date _____
County Anne Arundel - District
State Coordinates _____

Form 6 HPS (Rev. 1961)

ROAD INVENTORY SHEET

Party Chief E. SCHUYLER
Recorder W. DOMBROSKI
Helper

Map No. 33
SHERWOOD FOREST

Road No. PVT. 54
Road Name (NOTTINGHAM CIR.)
Sheet No. 1 OF 1
Date 5-6-72
County Anne Arundel - District
State Coordinates 928-436

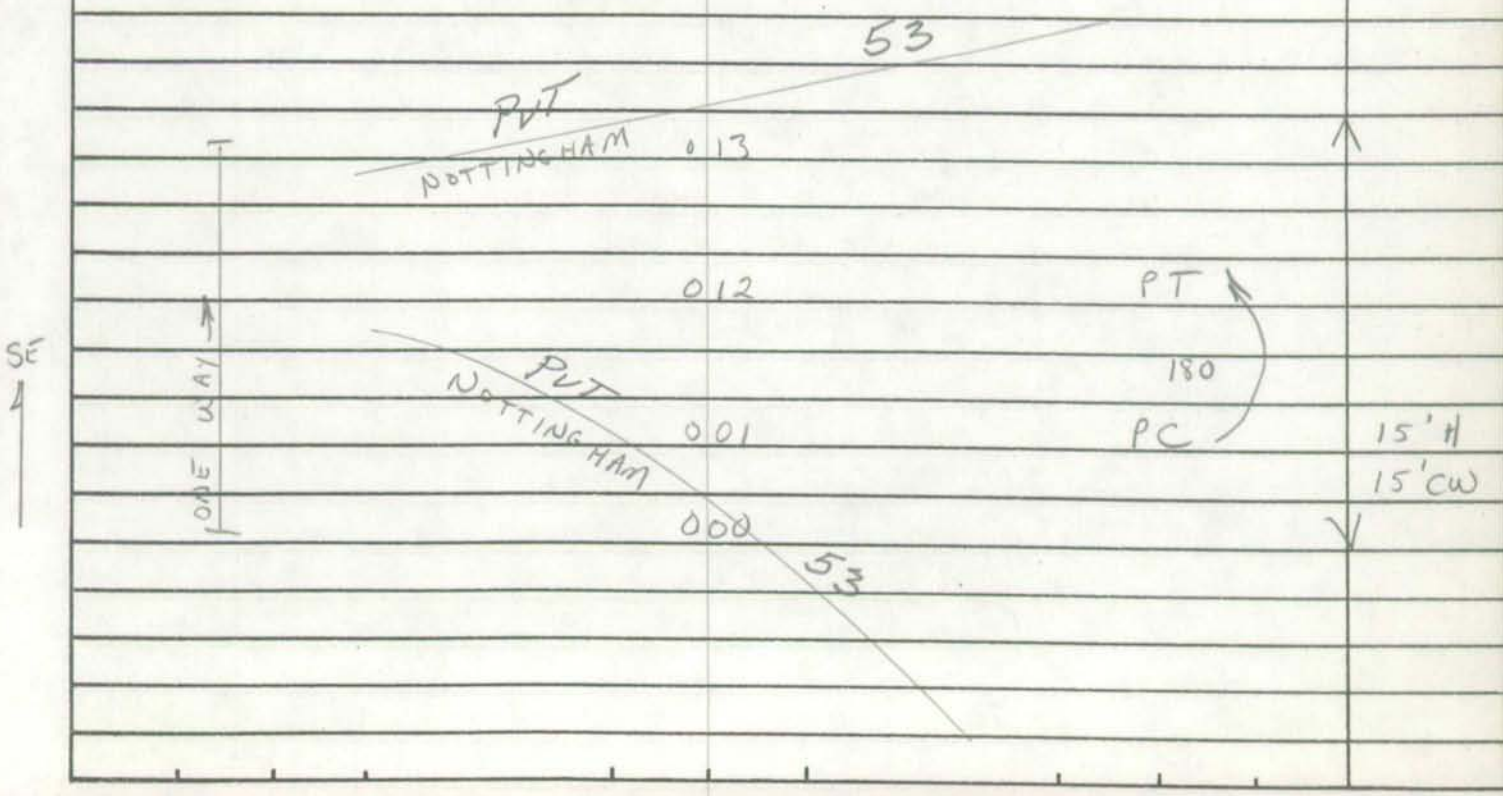

Form 6 HPS (Rev. 1961)

ROAD INVENTORY SHEET

Road No. _____
Road Name _____
Sheet No. _____
Date _____
County Anne Arundel - District
State Coordinates _____

Form 6 HPS (Rev. 1961)

ROAD INVENTORY SHEET

Party Chief E. SCHUYLER
Recorder W. DOMBROSKI
Helper

Map No. 33
SHERWOOD FOREST

Road No. PVT. 55
Road Name COUNTRY CLUB RD
Sheet No. 1 OF 2
Date 5-8-72
County Anne Arundel - District
State Coordinates 929-435

0.05

0.63 PT 50° PC
0.61
0.47 PT 90° PC
BREWER CK 0.45 36" CMP
0.41
PT 75° PC 0.38
0.34
0.23 PT 45° PC
0.21
30° 0.16
2753 RD
SHERWOOD FORES 0.08
PVT. 57 ONE WAY → (FRIAR TUCK RD) 0.05
E PVT 56 (BEACH RD) 0.04
90° 0.02 16'H 20'CW
PVT 53
NOTTINGHAM 0.00

Form 6 HPS (Rev. 1961)

ROAD INVENTORY SHEET

Road No. _____
Road Name (COUNTRY CLUB RD)
Sheet No. 2 OF 2
Date 5-8-72
County Anne Arundel - District
State Coordinates _____

ROAD	END	
	1 03	↑
	0 99 COUNTRY CLUB	
	0 93	45° ↗
↑ 45°	0 89	
↑ 50°	0 83	
	0 79	85° ↗
↑ 60°	0 73	
	0 67	30° ↗ SAME

Form 6 HPS (Rev. 1961)

ROAD INVENTORY SHEET

Party Chief E. SCHUYLER
Recorder W. DOMBROSKI
Helper

Map No. 33
SHERWOOD FOREST

Road No. PVT. 56
Road Name (BEACH RD)
Sheet No. 1 OF 2
Date 5-8-72
County Anne Arundel - District
State Coordinates 929-435

↑ 45°	143	
	131	35° ↑
↑ 80°	126	
↑ 45°	115	
↑ PT (70° PC)	108	
	104	
	099	20° ↑
SEVERN	089 (ALLAN-A-DALE)	
RIVER	075 — 12" CMP	
	064 — 12" CMP	16' H 16' CW
↑ PT (100° PC)	030	X
	022	
E ↑	006	
	003	PT ↑ (90° PC) 20' H 20' CW
PVT (COUNTRY CLUB)	55 000 (RD)	√

Form 6 HPS (Rev. 1961)

ROAD INVENTORY SHEET

Road No. PVT 56
Road Name (BEACH RD)
Sheet No. 2 OF 2
Date 5-8-72
County Anne Arundel - District
State Coordinates

	1 78		↑
PT.	1 77		
100°			
PC	1 67		8' H
			10' CW
↱ 90°	1 56		X
	1 48	45° ↴	SAME

Form 6 HPS (Rev. 1961)

ROAD INVENTORY SHEET

Party Chief E. SCHUYLER
Recorder W. DOMBROSKI
Helper

Map No. 33
SHERWOOD FOREST

Road No. PVT. 57
Road Name (FRIAR TUCK RD)
Sheet No. 1 OF 1
Date 5-8-72
County Anne Arundel - District
State Coordinates 930-435

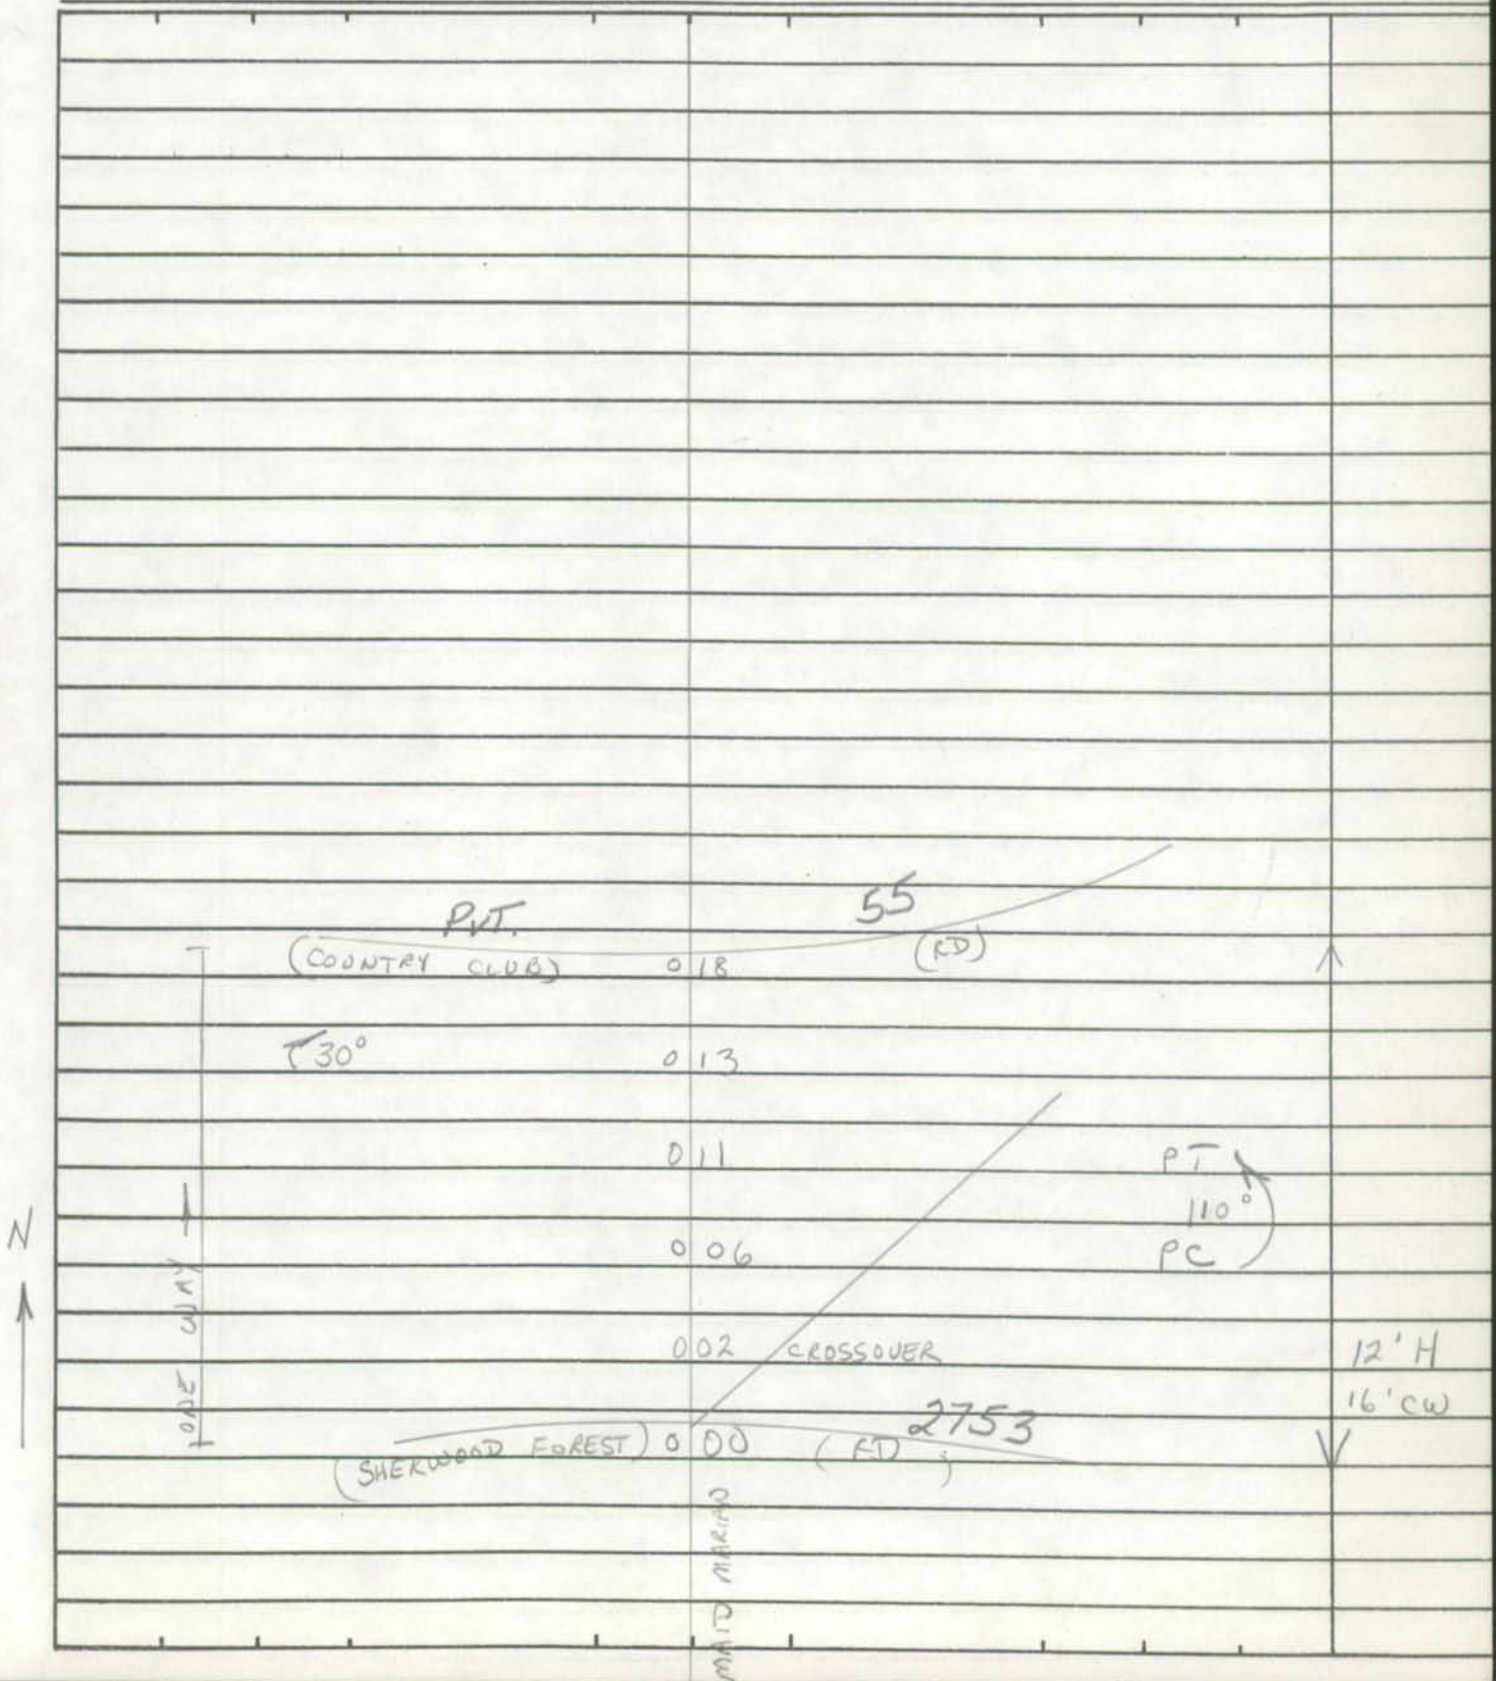

Form 6 HPS (Rev. 1961)

ROAD INVENTORY SHEET

Road No. _____
Road Name _____
Sheet No. _____
Date _____
County Anne Arundel - District
State Coordinates _____

Form 6 HPS (Rev. 1961)

ROAD INVENTORY SHEET

Party Chief E. SCHUYLER
Recorder W. DOMBROSKI
Helper

Map No. 33
SHERWOOD FOREST

Road No.
Road Name MAID MARIAN
Sheet No. 1 OF
Date 5-8-72
County Anne Arundel - District
State Coordinates 930-435

STOPPED AT THIS POINT BY CLUB MANAGER. SEE NOTE

2753

SHERWOOD FOREST 000 RD

FRIAR TUCK RD

Form 6 HPS (Rev. 1961)

ROAD INVENTORY SHEET

Road No. _____
Road Name _____
Sheet No. _____
Date _____
County Anne Arundel - District
State Coordinates _____

Sherwood Forest

8 MAY 72

To whom it MAY Concern

We do NOT wish our roads surveyed or mapped by any public agency

C F Rowe
Club Manager

Form 6 HPS (Rev. 1961)

ROAD INVENTORY SHEET

Party Chief _____
Recorder _____
Helper _____

Map No. _____

Road No. PVT. 420
Road Name _____
Sheet No. _____
Date _____
County Anne Arundel - District
State Coordinates _____

SEE CO. 420 EXTENSION

Form 6 HPS (Rev. 1961)

ROAD INVENTORY SHEET

Road No. _____
Road Name _____
Sheet No. _____
Date _____
County Anne Arundel - District
State Coordinates _____

Form 6 HPS (Rev. 1961)

ROAD INVENTORY SHEET

Party Chief _____
Recorder _____
Helper _____

Map No. _____

Road No. PVT 426
Road Name _____
Sheet No. _____
Date _____
County Anne Arundel - District
State Coordinates _____

SEE CO 426 EXTENSION

Form 6 HPS (Rev. 1961)

ROAD INVENTORY SHEET

Road No. _____
Road Name _____
Sheet No. _____
Date _____
County Anne Arundel - District
State Coordinates _____

Form 6 HPS (Rev. 1961)

ROAD INVENTORY SHEET

Party Chief _____
Recorder _____
Helper _____

Map No. _____

SEE CO. 780 EXTENSION

Road No. PVT. 780
Road Name _____
Sheet No. _____
Date _____
County Anne Arundel - District
State Coordinates _____

Form 6 HPS (Rev. 1961)

ROAD INVENTORY SHEET

Road No. _____
Road Name _____
Sheet No. _____
Date _____
County Anne Arundel - District
State Coordinates _____

Form 6 HPS (Rev. 1961)

ROAD INVENTORY SHEET

Party Chief _____
Recorder _____
Helper _____

Map No. _____

Road No. PVT. 1334
Road Name _____
Sheet No. _____
Date _____
County Anne Arundel - District
State Coordinates _____

SEE CO. 1334 EXTENSION

Form 6 HPS (Rev. 1961)

ROAD INVENTORY SHEET

Road No. _____
Road Name _____
Sheet No. _____
Date _____
County Anne Arundel - District
State Coordinates _____

Form 6 HPS (Rev. 1961)

ROAD INVENTORY SHEET

Party Chief _____
Recorder _____
Helper _____

Map No. _____
SEE Co 1806 EXTENSION

Road No. PVT. 1806
Road Name _____
Sheet No. _____
Date _____
County Anne Arundel - District
State Coordinates _____

Form 6 HPS (Rev. 1961)

ROAD INVENTORY SHEET

Road No. _____
Road Name _____
Sheet No. _____
Date _____
County Anne Arundel - District
State Coordinates _____

Form 6 HPS (Rev. 1961)

ROAD INVENTORY SHEET

Party Chief _____
Recorder _____
Helper _____

Map No. _____
SEE CO 2176 EXTENSION

Road No. PVT 2176
Road Name _____
Sheet No. _____
Date _____
County Anne Arundel - District
State Coordinates _____

Form 6 HPS (Rev. 1961)

ROAD INVENTORY SHEET

Road No. _____
Road Name _____
Sheet No. _____
Date _____
County Anne Arundel - District
State Coordinates _____

Form 6 HPS (Rev. 1961)

ROAD INVENTORY SHEET

Party Chief _____
Recorder _____
Helper _____

Map No. _____

SEE Co 2190 EXTENSION

Road No. PVT 2190
Road Name _____
Sheet No. _____
Date _____
County Anne Arundel - District
State Coordinates _____

Form 6 HPS (Rev. 1961)

ROAD INVENTORY SHEET

Road No. _____
Road Name _____
Sheet No. _____
Date _____
County Anne Arundel - District
State Coordinates _____

Form 6 HPS (Rev. 1961)

ROAD INVENTORY SHEET

Party Chief _____
Recorder _____
Helper _____

Map No. _____

Road No. PVT. 2266
Road Name _____
Sheet No. _____
Date _____
County Anne Arundel - District
State Coordinates _____

SEE Co 2266 EXTENSION

Form 6 HPS (Rev. 1961)

ROAD INVENTORY SHEET

Road No. _____
Road Name _____
Sheet No. _____
Date _____
County Anne Arundel - District
State Coordinates _____

Form 6 HPS (Rev. 1961)

ROAD INVENTORY SHEET

Party Chief _____
Recorder _____
Helper _____

Map No. _____

Road No. PVT. 2753
Road Name _____
Sheet No. _____
Date _____
County Anne Arundel - District
State Coordinates _____

SEE Co 2753 EXTENSION

Form 6 HPS (Rev. 1961)

ROAD INVENTORY SHEET

Road No. _____
Road Name _____
Sheet No. _____
Date _____
County Anne Arundel - District
State Coordinates _____