CALVERT COUNTY
OTHER PUBLIC ROADS
1 to 250

SHA 51.3-8
11-15-72

STATE HIGHWAY ADMINISTRATION OF MARYLAND

ROAD INVENTORY SHEET

Party Chief _____
Recorder _____
Helper _____

Map No. _____

Road No. Palisades Dr.
Road Name _____
Sheet No. _____
Date _____
County _____
State Coordinates _____

OP 1 NOW CO 289

HPS-39 6-28-75

SHA 51.3-8
11-15-72

ROAD INVENTORY SHEET

Road No. _____
Road Name _____
Sheet No. _____
Date _____
County _____
State Coordinates _____

Form 6 HPS (Rev. 1961)

ROAD INVENTORY SHEET

Party Chief T. LANDON
Recorder W. WARFIELD
Chainman R. DENTON

Road No. MP 2
Name
Sheet No. 1 OF 1
Date 5-20-69
County CALVERT

896.5-331

NOW CO. 470

3-3-81

SEE HPS-39

PROPOSED

ROAD 0 15 END

5 H

0 66

18'E
24'CUT

S.B. SOUTHERN MARYLAND BLVD. LA.

MD 0 00 4 LA.

N.B.

OP 3 TO OP 5

UNASSIGNED

SHA 51.3 - 8 Revised
4.83

MARYLAND STATE HIGHWAY ADMINISTRATION

ROAD INVENTORY SHEET

Party Chief _____
Recorder _____
Assistant _____
Map No./Dir. 1
State Coordinates _____

Road No. OP 6
Road Name _____
County CALVERT
Date _____
Sheet No. _____ OF _____

SYSTEM				TRAFFIC		LINE DIAGRAM	TRAFFIC			PAVEMENT DATA
FED. AID.	FUNCT CLASS.	HWY. SYS.	HPMS SAMPLE	PRK.G. REST.	COM/IND. ACCESS		CONTROL	COM/IND. ACCESS	PRK.G. REST.	
						UNASSIGNED Now Go 677 85-60				

TRAFFIC CODES

TRAFFIC CONTROLS: STOP SIGN=SS,
TRAFFIC LIGHT=T.L.,
FLASHING RED BALL=F.R.

TRAFFIC CODES

PARKING RESTRICTIONS: A.M. PEAK,
P.M. PEAK, A.M./P.M. PEAK, NO PARKING
ANYTIME=N.P., COMM/IND. ACCESS=E

SYSTEM				TRAFFIC		LINE DIAGRAM	TRAFFIC				PAVEMENT DATA
FED. AID.	FUNCT. CLASS.	HWY. SYS.	HPMS SAMPLE	PRK.G. REST.	COM/IND ACCESS		CONTROL	COM/IND ACCESS	PRK.G. REST.		

Form 6 HPS (Rev. 1961)

ROAD INVENTORY SHEET

Party Chief T. LANDON
Recorder W. WARFIELD
Chainman R. DENTON

H-12
908-318

Road No. OP 7
Name
Sheet No. 1 OF 1
Date 5-21-69
County CALVERT

W
1

H H H
200'
ROAD 004 END

RD
PARS 133

MT. HARMONY — 000
CO.

10'0
14'CW

Form 6 HPS (Rev. 1961)

ROAD INVENTORY SHEET

Party Chief T. LANDON
Recorder W. WARFIELD
Chainman R. DENTON

H-17

9155-306

Road No. OP 8
Name
Sheet No. 1 OF 1
Date 5-22-69
County CALVERT

S

H
100'
H

H

H ROAD 0 14 END

H 0 11

PT H-400' 0 10
50°
PRC H 0 06 PRC

0 04 H 30°

0 02 H PC 9'C
12'CW

PUSHAW STATION 0 00
CO. 21 RD.

SHA 51.3 - 8 Revised
4.83

MARYLAND STATE HIGHWAY ADMINISTRATION

ROAD INVENTORY SHEET

Party Chief _____ Road No. 01 9
Recorder _____ Road Name _____
Assistant _____ County _____
Map No./Dir. 1 Date _____
State Coordinates _____ Sheet No. _____ OF _____

SYSTEM				TRAFFIC		LINE DIAGRAM	TRAFFIC			PAVEMENT DATA
FED. AID.	FUNCT CLASS.	HWY. SYS.	HPMS SAMPLE	PRKG. REST.	COM/IND. ACCESS		CONTROL	COM/IND. ACCESS	PRKG. REST.	

UNASSIGNED

NO CO 818 + CO 819

90-16
90-17

TRAFFIC CODES

TRAFFIC CONTROLS: STOP SIGN=SS, TRAFFIC LIGHT=T.L., FLASHING RED BALL=F.R.

TRAFFIC CODES

PARKING RESTRICTIONS: A.M. PEAK, P.M. PEAK, A.M./P.M. PEAK, NO PARKING ANYTIME=N.P., COMM/IND. ACCESS=E

SYSTEM				TRAFFIC		LINE DIAGRAM	TRAFFIC			PAVEMENT DATA
FED. AID.	FUNCT. CLASS.	HWY. SYS.	HPMS SAMPLE	PRK.G. REST.	COM/IND ACCESS		CONTROL	COM/IND ACCESS	PRK.G. REST.	

Form 6 HPS (Rev. 1961)

ROAD INVENTORY SHEET

Party Chief T. LANDON
Recorder W. WARFIELD
Chainman R. DENTON

RANDLE CLIFF BEACH

H13
934-3035

Road No. OP 10
Name
Sheet No. 1 OF 1
Date 5-27-69
County CALVERT

E					
			H		
	ROAD	010	END	H	
		009		H	
		007		H	
		006		H	8'D 12'CMP
		004			X
		002	CHURCH	90°	16'E 20'CW
	WILLOWS		RD		
	MD	000	261		

BAY

CHESAPEAKE

Form 6 HPS (Rev. 1961)

ROAD INVENTORY SHEET

Party Chief T. LANDON
Recorder W. WARFIELD
Chainman R. DENTON

LOCUST GROVE BEACH

H 13
939-299

Road No. OP 11
Name Locust Grove Rd
Sheet No. 1 OF 1
Date 5-27-69
County CALVERT

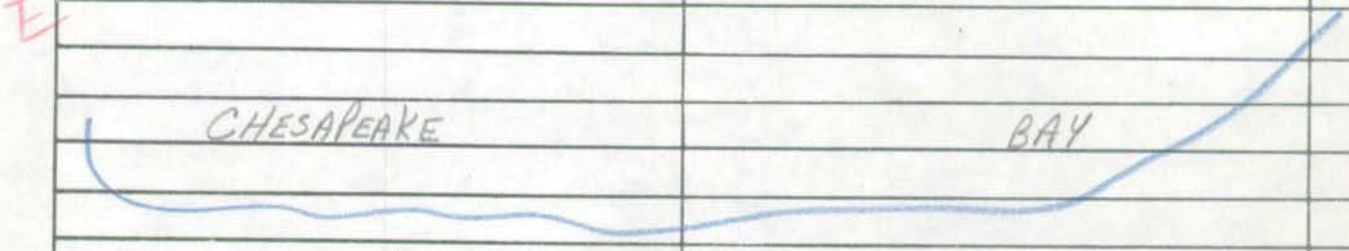

H ROAD 0 14 END H H-200'

PT
3 H
15°
PC

0 11
0 09
IRMA AVE
OP 13 0 08
LESTER AVE
OP 12 0 05 10'E
WILLOWS RD. 14'CW
MD 0 00 261

Form 6 HPS (Rev. 1961)

ROAD INVENTORY SHEET

Party Chief T. LANDON
Recorder W. WAREFIELD
Chainman R. DENTON

LOCUST GROVE BEACH
17-13
994-999

Road No. OP 12
Name LESTER AVE.
Sheet No. 1 OF 1
Date 5-27-69
County CALVERT

N

	LOAD	006	END
3 H			
		002	
			12'E
		001	H 16'CW
Locust Grove		Rd	
OP		000	11

Form 6 HPS (Rev. 1961)

ROAD INVENTORY SHEET

Party Chief T. LANDON
Recorder W. WARFIELD
Chainman R. DENTON

LOCUST GROVE BEACH

H 13
934-299

Road No. OP 13
Name IRMA AVE
Sheet No. 1 OF 1
Date 5-27-69
County CALVERT

N

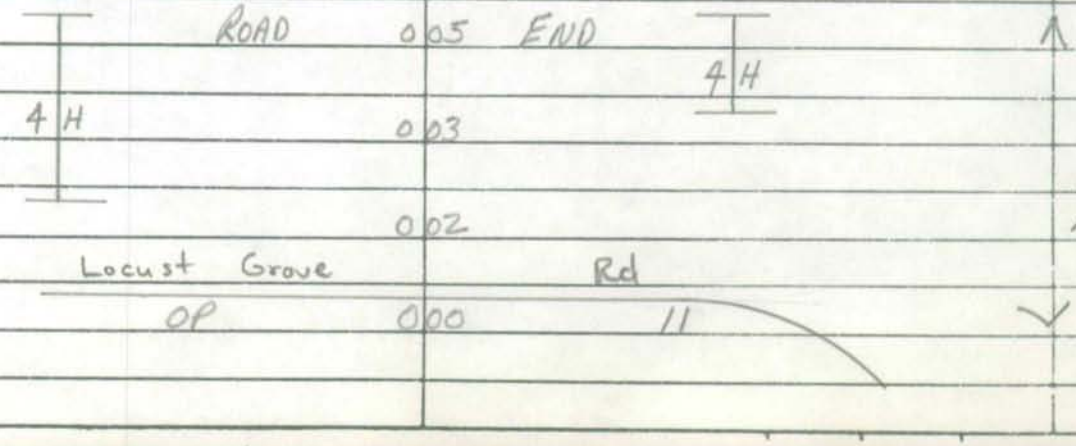

Rewritten (10-26-90) by JEL

SHA 51.3 - 8 Revised
4.83

MARYLAND STATE HIGHWAY ADMINISTRATION

ROAD INVENTORY SHEET

Party Chief T. LANDON
Recorder W. Warfield
Assistant R. Denton
Map No./Dir. H-13 / E
State Coordinates 936 - 297

Road No. OP 14
Road Name Beach Dr
County Calvert
Date 5-27-69
Sheet No. 1 OF 1

TRAFFIC CONTROLS: STOP SIGN=SS, TRAFFIC LIGHT=T.L., FLASHING RED BALL=F.R.

TRAFFIC CODES

PARKING RESTRICTIONS: A.M. PEAK, P.M. PEAK, A.M./P.M. PEAK, NO PARKING ANYTIME=N.P., COMM/IND. ACCESS=E

TRAFFIC CODES

SYSTEM				TRAFFIC		LINE DIAGRAM	TRAFFIC			PAVEMENT DATA
FED. AID.	FUNCT CLASS.	HWY. SYS.	HPMS SAMPLE	PRK.G. REST.	COM/IND. ACCESS		CONTROL	COM/IND. ACCESS	PRK.G. REST.	
						Larchmont Dr				
						0 17 OP 671				
						PT 75° PRC				
						0 15 PRC 40°				12' G
						0 13 H PRC				14' CW
						PRC 35° PC				
						0 11				
						0 10				
										12' E
										14' CW
						0 01 H				
						Willows Rd @ 2.84				
						MD 0 00 261				

NON F/A RURAL LOCAL

SYSTEM				TRAFFIC		LINE DIAGRAM	TRAFFIC			PAVEMENT DATA
FED. AID.	FUNCT. CLASS.	HWY. SYS.	HPMS SAMPLE	PRK'G. REST.	COM/IND ACCESS		CONTROL	COM/IND ACCESS	PRK'G. REST.	

Form 6 HPS (Rev. 1961)

ROAD INVENTORY SHEET

Party Chief T. LANDON
Recorder W. WARFIELD
Chainman R. DENTON

HOLIDAY BEACH

H13
93415-29715

Road No. OP 15
Name HOLIDAY RD
Sheet No. 1 OF 1
Date 5-27-69
County CALVERT

E

LARCHMONT		DR	
OP	009	# 671	
LENOIR		DR	
OP	004	16	
H	003		12'E
			16'CW
OP	000	17	

Form 6 HPS (Rev. 1961)

ROAD INVENTORY SHEET

Party Chief T. LANDON
Recorder W. WARFIELD
Chainman R. DENTON

HOLIDAY BEACH

H13

934.5-297.5

Road No. OP 16
Name LENOIR DR.
Sheet No. 1 OF 1
Date 5-27-69
County CALVERT

H	ROAD	008	END
HOLIDAY			DR.
OP		004	15
H		001	10'E
CALVERT			DR. 14'CW
OP		000	~~74~~ 670

Form 6 HPS (Rev. 1961)

ROAD INVENTORY SHEET

Party Chief T. LANDON
Recorder W. WARFIELD
Chainman R. DENTON

HOLIDAY BEACH
H-13
939.5-297.5

Road No. OP 17
Name
Sheet No. 1 OF 1
Date 5-27-69
County CALVERT

ROAD	007	END H	
H	006	H	
		HOLIDAY DR	
	004	OP 15	
H	003		
H	001		10'F 14'CW
CALVERT		DR	
OP	000	~~14~~ 670	

Form 6 HPS (Rev. 1961)

3/28/83 VDT/GD (87-48)

ROAD INVENTORY SHEET

Party Chief T. LANDON
Recorder W. WARFIELD
Chainman R. DENTON

WILLOWS BEACH

H 13
937-290

Road No. OP 18
Name BAY VIEW DR.
Sheet No. 1 OF 1
Date 5-28-69
County CALVERT

N

HUTCHINS RD.
0 14 CO 740 (87-48)

N

~~ROAD~~ 0 06 ~~END~~

3 H

10°

0 04

0 03 H

12 F
16' CW

0 01 of section H
CO WILLOWS 113 RD. CALVERT DR.

~~CO.~~ 0 00 OP ~~113~~ 520

SHA 51.3 - 8 Revised
4.83

MARYLAND STATE HIGHWAY ADMINISTRATION

ROAD INVENTORY SHEET

Party Chief _____
Recorder _____
Assistant _____
Map No./Dir. 1
State Coordinates _____

Road No. OP19
Road Name _____
County _____
Date _____
Sheet No. _____ OF _____

SYSTEM				TRAFFIC		LINE DIAGRAM	TRAFFIC			PAVEMENT DATA
FED. AID.	FUNCT CLASS.	HWY. SYS.	HPMS SAMPLE	PRK.G. REST.	COM/IND. ACCESS		CONTROL	COM/IND. ACCESS	PRK.G. REST.	
						UNASSIGNED NOW 00 701 87-45				

TRAFFIC CODES

TRAFFIC CONTROLS: STOP SIGN=SS, TRAFFIC LIGHT=T.L., FLASHING RED BALL=F.R.

TRAFFIC CODES

PARKING RESTRICTIONS: A.M. PEAK, P.M. PEAK, A.M./P.M. PEAK, NO PARKING ANYTIME=N.P., COMM/IND. ACCESS=E

SYSTEM				TRAFFIC		LINE DIAGRAM	TRAFFIC			PAVEMENT DATA
FED. AID.	FUNCT. CLASS.	HWY. SYS.	HPMS SAMPLE	PRKG. REST.	COM/IND ACCESS		CONTROL	COM/IND ACCESS	PRKG. REST.	

SHA 51.3 - 8 Revised
4.83

MARYLAND STATE HIGHWAY ADMINISTRATION

ROAD INVENTORY SHEET

Party Chief _____
Recorder _____
Assistant _____
Map No./Dir. 1
State Coordinates _____

Road No. OP-20
Road Name _____
County _____
Date _____
Sheet No. _____ OF _____

SYSTEM				TRAFFIC		LINE DIAGRAM	TRAFFIC			PAVEMENT DATA
FED. AID.	FUNCT CLASS.	HWY. SYS.	HPMS SAMPLE	PRK.G. REST.	COM/IND. ACCESS		CONTROL	COM/IND. ACCESS	PRK.G. REST.	
						UNASSIGNED NOW CO-702 87-47				

TRAFFIC CODES

TRAFFIC CONTROLS: STOP SIGN=SS, TRAFFIC LIGHT=T.L., FLASHING RED BALL=F.R.

TRAFFIC CODES

PARKING RESTRICTIONS: A.M. PEAK, P.M. PEAK, A.M./P.M. PEAK, NO PARKING ANYTIME=N.P., COMM/IND. ACCESS=E

SYSTEM				TRAFFIC		LINE DIAGRAM	TRAFFIC			PAVEMENT DATA
FED. AID.	FUNCT. CLASS.	HWY. SYS.	HPMS SAMPLE	PRK.G. REST.	COM/IND ACCESS		CONTROL	COM/IND ACCESS	PRK.G. REST.	

Form 6 HPS (Rev. 1961)

ROAD INVENTORY SHEET

Party Chief T. LANDON
Recorder W. WARFIELD
Chainman R. DENTON

Willows Beach
H-13
938-289.5

Road No. OP 21
Name FOREST DR
Sheet No. 1 OF 1
Date 5-28-69
County CALVERT

N

SECTION DR.
520
BAY
CHES. BEAKE
OP
CALVERT
~~CO.~~ OP
T13
010
008
005
003
001
000
4 H
PT
45°
PC
10'D
14'CW
(Bayview Dr)
~~OP~~
CO
~~19~~
701

Form 6 HPS (Rev. 1961)

ROAD INVENTORY SHEET

Party Chief T. LANDON
Recorder W. WARFIELD
Chainman R. DENTON

WILLOWS BEACH
H-13
937.5-290.5

Road No. OP 22
Name VALLEY DR.
Sheet No. 1 OF 1
Date 5-28-69
County CALVERT

E

OP
CALVERT
~~Co.~~ OP 006

H 004

H 002
DOGWOOD
OP CO 000

SECTION
520 DR.
~~1/2~~
RD
~~20~~ 702

10'F
14'CW

SHA 51.3 - 8 Revised
4.83

MARYLAND STATE HIGHWAY ADMINISTRATION

ROAD INVENTORY SHEET

Party Chief _____
Recorder _____
Assistant _____
Map No./Dir. 1
State Coordinates _____

Road No. OP23
Road Name _____
County _____
Date _____
Sheet No. _____ OF _____

SYSTEM				TRAFFIC		LINE DIAGRAM	TRAFFIC			PAVEMENT DATA
FED. AID.	FUNCT CLASS.	HWY. SYS.	HPMS SAMPLE	PRK.G. REST.	COM/IND. ACCESS		CONTROL	COM/IND. ACCESS	PRK.G. REST.	
						UNASSIGNED NOW CO-700 87-44				

TRAFFIC CODES

TRAFFIC CONTROLS: STOP SIGN=SS, TRAFFIC LIGHT=T.L., FLASHING RED BALL=F.R.

TRAFFIC CODES

PARKING RESTRICTIONS: A.M. PEAK, P.M. PEAK, A.M./P.M. PEAK, NO PARKING ANYTIME=N.P., COMM/IND. ACCESS=E

SYSTEM				TRAFFIC		LINE DIAGRAM	TRAFFIC				PAVEMENT DATA
FED. AID.	FUNCT. CLASS.	HWY. SYS.	HPMS SAMPLE	PRK.G. REST.	COM/IND ACCESS		CONTROL	COM/IND ACCESS	PRK.G. REST.		

SHA 51.3 - 8 Revised
4.83

MARYLAND STATE HIGHWAY ADMINISTRATION

ROAD INVENTORY SHEET

Party Chief _____
Recorder _____
Assistant _____
Map No./Dir. 1
State Coordinates _____

Road No. OP 24
Road Name _____
County _____
Date _____
Sheet No. _____ OF _____

SYSTEM				TRAFFIC		LINE DIAGRAM	TRAFFIC			PAVEMENT DATA
FED. AID.	FUNCT. CLASS.	HWY. SYS.	HPMS SAMPLE	PRK'G. REST.	COM/IND. ACCESS		CONTROL	COM/IND. ACCESS	PRK'G. REST.	
						UNASSIGNED NOW CO 699 87-49 ex 1				

TRAFFIC CODES

TRAFFIC CONTROLS: STOP SIGN=S.S., TRAFFIC LIGHT=T.L., FLASHING RED BALL=F.R.

TRAFFIC CODES

PARKING RESTRICTIONS: A.M. PEAK, P.M. PEAK, A.M./P.M. PEAK, NO PARKING ANYTIME=N.P., COMM/IND. ACCESS=E

SYSTEM				TRAFFIC		LINE DIAGRAM	TRAFFIC				PAVEMENT DATA
FED. AID.	FUNCT. CLASS.	HWY. SYS.	HPMS SAMPLE	PRK.G. REST.	COM/IND ACCESS		CONTROL	COM/IND ACCESS	PRK.G. REST.		

SHA 51.3-8
11-15-72

STATE HIGHWAY ADMINISTRATION OF MARYLAND

ROAD INVENTORY SHEET

Party Chief _____
Recorder _____
Helper _____

Map No. _____

Road No. _____
Road Name _____
Sheet No. _____
Date _____
County _____
State Coordinates _____

OP 25 Now Co 327
HILLSIDE PLACE
HPS-39 1-6-77

SHA 51.3-8
11-15-72

ROAD INVENTORY SHEET

Road No. _____
Road Name _____
Sheet No. _____
Date _____
County _____
State Coordinates _____

SHA 51.3-8
11-15-72

STATE HIGHWAY ADMINISTRATION OF MARYLAND

ROAD INVENTORY SHEET

Party Chief _____
Recorder _____
Helper _____

Map No. _____

Road No. _____
Road Name _____
Sheet No. _____
Date _____
County _____
State Coordinates _____

OP 26
Unassigned

Now Co 296 & 302
and 303

SHA 51.3-8
11-15-72

ROAD INVENTORY SHEET

Road No. _____
Road Name _____
Sheet No. _____
Date _____
County _____
State Coordinates _____

Form 6 HPS (Rev. 1961)

ROAD INVENTORY SHEET

Co 301

Party Chief T. HANSON
Recorder W. WARFIELD
Chainman L. DENTON

BREEZY POINT BEACH

937.5-281.5

Road No. ~~OP 27~~
Name WILLOWS ST
Sheet No. 1 OF 1
Date 5-28-69
County CALVERT

OP 27 Unassigned

Now Co 301

ROAD 007 END

H 006 H

005 H

CO 293

Ridge ~~OP~~ 004 ~~29~~ 10'F

16'CWS

003 H

BREEZY 10'F

H CO. 002 H 14'CWS

000

POINT

31 RD

Form 6 HPS (Rev. 1961)

ROAD INVENTORY SHEET

Party Chief T. LANDON
Recorder W. WARFIELD
Chainman R. DENTON

BREEZY POINT BEACH

938-4875

Road No. OP 28
Name
Sheet No. 1 OF 1
Date 5-28-69
County CALVERT

Unassigned

See Co 299 + 300

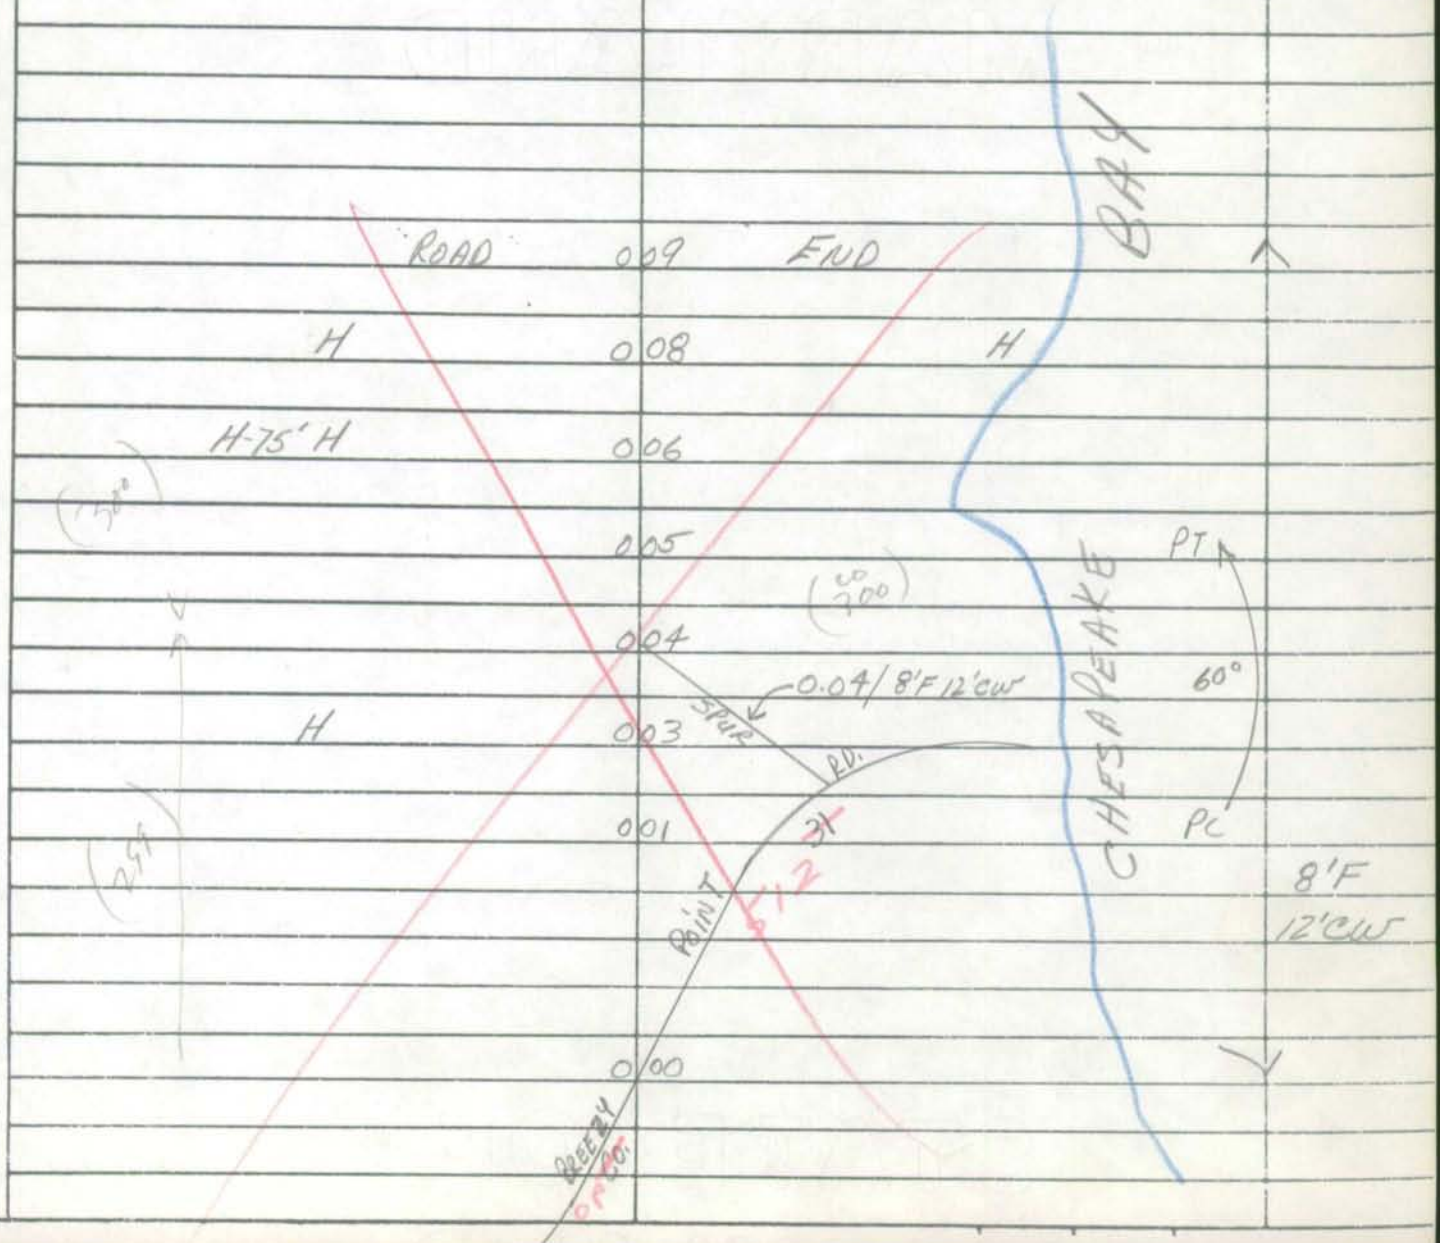

OP 29

Calvert County

UNASSIGNED

NOW

CO 298

RIDGE RD

00-08 CO

4-16-2001

SHA 51.3-8
11-15-72

STATE HIGHWAY ADMINISTRATION OF MARYLAND

ROAD INVENTORY SHEET

Party Chief _____
Recorder _____
Helper _____

Map No. _____

Road No. _____
Road Name _____
Sheet No. _____
Date _____
County _____
State Coordinates _____

OP 30 NOW Co 326

HPS 39 1-6-77

SHA 51.3-8
11-15-72

ROAD INVENTORY SHEET

Road No. _____
Road Name _____
Sheet No. _____
Date _____
County _____
State Coordinates _____

Form 6 HPS (Rev. 1961)

"SCOTTS ST"

Co 297

ROAD INVENTORY SHEET

Party Chief T. LANDON
Recorder W. WARFIELD
Chairman R. DENTON

BREEZY POINT BEACH

H-13
937-286.5

Road No. OP 31
Name ~~TALLANT'S CORNER~~ RD
Sheet No. 1 OF 1
Date 5-28-69
County CALVERT

BAYVIEW ~~MEADOWS~~
CO. ~~OP~~

0 27 ~~26~~ 303

0 25

3 H

0 23

8'D
12'CW

SHERWOOD
~~OP~~ CO.

AVE ~~24~~

0 21 330

0 19

10°

0 13 H

0 12 H PT

75°

0 08 PC

16'I
20'CW

RECKER RD
OP 33

0 06 PT

15°

BURGESS RD
CO. 328 ~~OP~~ ~~32~~

0 03 PC

~~8'F~~
~~12'CW~~

HARBOR ~~MEADOW~~ DR.
CO. OP ~ 302

0 00 ~~296~~ CO. 296

LANE 26

OP 31

CO 297 ~~MEADOW~~ LANE

SHA 51.3 - 8 Revised
4.83

MARYLAND STATE HIGHWAY ADMINISTRATION

ROAD INVENTORY SHEET

Party Chief _____
Recorder _____
Assistant _____
Map No./Dir. 1
State Coordinates _____

Road No. op 32
Road Name Burgess RD
County _____
Date _____
Sheet No. _____ OF _____

SYSTEM				TRAFFIC		LINE DIAGRAM	TRAFFIC			PAVEMENT DATA
FED. AID.	FUNCT. CLASS.	HWY. SYS.	HPMS SAMPLE	PRK.G. REST.	COM/IND. ACCESS		CONTROL	COM/IND. ACCESS	PRK.G. REST.	
						SEE CO 328 90-15				

TRAFFIC CODES

TRAFFIC CONTROLS: STOP SIGN=SS,
TRAFFIC LIGHT=T.L.,
FLASHING RED BALL=F.R.

TRAFFIC CODES

PARKING RESTRICTIONS: A.M. PEAK,
P.M. PEAK, A.M./P.M. PEAK, NO PARKING
ANYTIME=N.P., COMM/IND. ACCESS=E

SYSTEM				TRAFFIC		LINE DIAGRAM	TRAFFIC				PAVEMENT DATA
FED. AID.	FUNCT. CLASS.	HWY. SYS.	HPMS SAMPLE	PRK.G. REST.	COM/IND ACCESS		CONTROL	COM/IND ACCESS	PRK.G. REST.		

Form 6 HPS (Rev. 1961)

ROAD INVENTORY SHEET

Party Chief T. LANDON
Recorder N. WARFIELD
Chainman R. DENTON

T/L REV. F.R. 2/12/77

BREEZY POINT BEACH H-13

937-287

Road No. OP 33
Name RECKER RD.
Sheet No. 1 of 1
Date 5-29-69
County CALVERT

Abandoned

91-41 (extra)

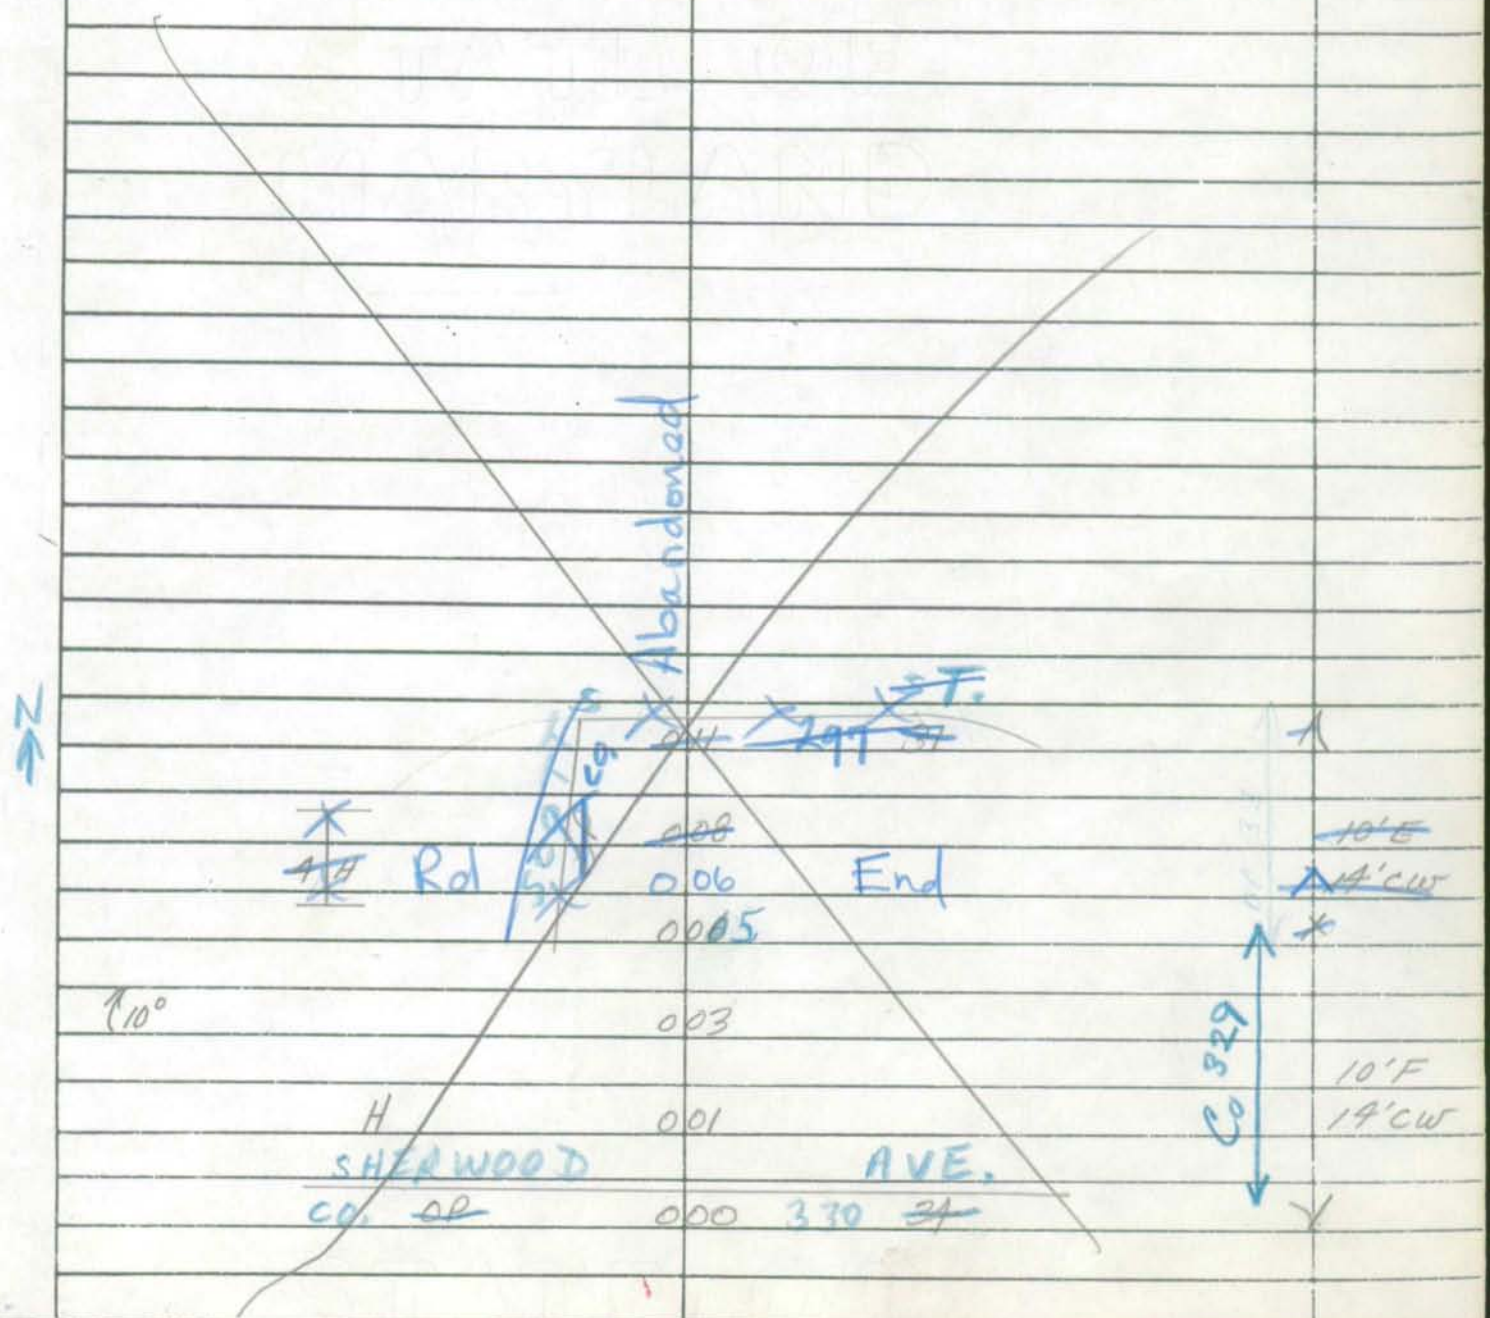

SHA 51.3-8
11-15-72

STATE HIGHWAY ADMINISTRATION OF MARYLAND

ROAD INVENTORY SHEET

86-26
CB/AL
3-3-87

Party Chief T. LANDON
Recorder F. RHODES
Helper

Map No. ~~H~~ 13

Road No. OP 34
Road Name HIGHVIEW RD.
Sheet No. 1 OF 1
Date 2/2/77
County CALVERT
State Coordinates 937-287

S

H ROAD 0 ~~18~~ 22 END

H 0 14 10 F 8' ~~F~~ 12' CW

BAYVIEW AVE.
CO. 303 0 06

0 03 H 33 8 ~~8~~ F ~~12' CW~~

SHERWOOD AVE
CO. 330 0 00

SHA 51.3-8
11-15-72

ROAD INVENTORY SHEET

Road No. _____
Road Name _____
Sheet No. _____
Date _____
County _____
State Coordinates _____

Form 6 HPS (Rev. 1961)

ROAD INVENTORY SHEET

Party Chief THAYER
Recorder W. WARFIELD
Chainman L. DENTON

NEELD ESTATES

SHA MIN 9-15-71

939-285

Road No. OP 35
Name SHORE DR
Sheet No. 1 OF 1
Date 5-28-69
County CALVERT

UNASSIGNED
NOW CO 242
71-10

H ROAD 015 END

H 014

011 PT

H 009

008 36°

007 PC

5 SC

H 003

H 002 B/F 12 EW

BM4 OP SECTION BLOB

CO. 006 139

Form 6 HPS (Rev. 1961)

ROAD INVENTORY SHEET

Party Chief TILLMAN
Recorder WARFIELD
Chainman R. CRAITON

NEELD ESTATES

939-284.5

Road No. OP 36
Name KNOLL RD
Sheet No. 1 OF 1
Date 5-28-69
County CALVERT

UNASSIGNED

NOW CO-243

71-10

BAY
Co.

0 20

PLUD
139

H

0 19

H

0 17

PT
45°
PC

0 16

H

0 15

0 14

H

LOOKOUT TRAIL

6 H

PT
135°
PC

0 09

0 08

0 07

KNOLL RD

0 06

H

H

0 04

H

0 02

H

8'F
12'CW

BAY
Co.

PLUD
139

0 00

Form 6 HPS (Rev. 1961)

ROAD INVENTORY SHEET

Party Chief T. LANDON
Recorder W. WARFIELD
Chainman R. DENTON

NEELD ESTATES

I-13
938.5-263

Road No. OP 37
Name
Sheet No. 1 OF 1
Date 5-28-69
County CALVERT

N

xxxx
ROAD 012 END

011 OP 38

008 OP 38 PT

40°

003 POINT RD. 263 PC 8'D 12'CW

000

PLUM MD

Form 6 HPS (Rev. 1961)

ROAD INVENTORY SHEET

Party Chief T. LANDON
Recorder W. WARFIELD
Chainman R. DENTON

NEELD ESTATES

1-13
938.5-283

Road No. OP 38
Name
Sheet No. 1 OF 1
Date 5-28-69
County CALVERT

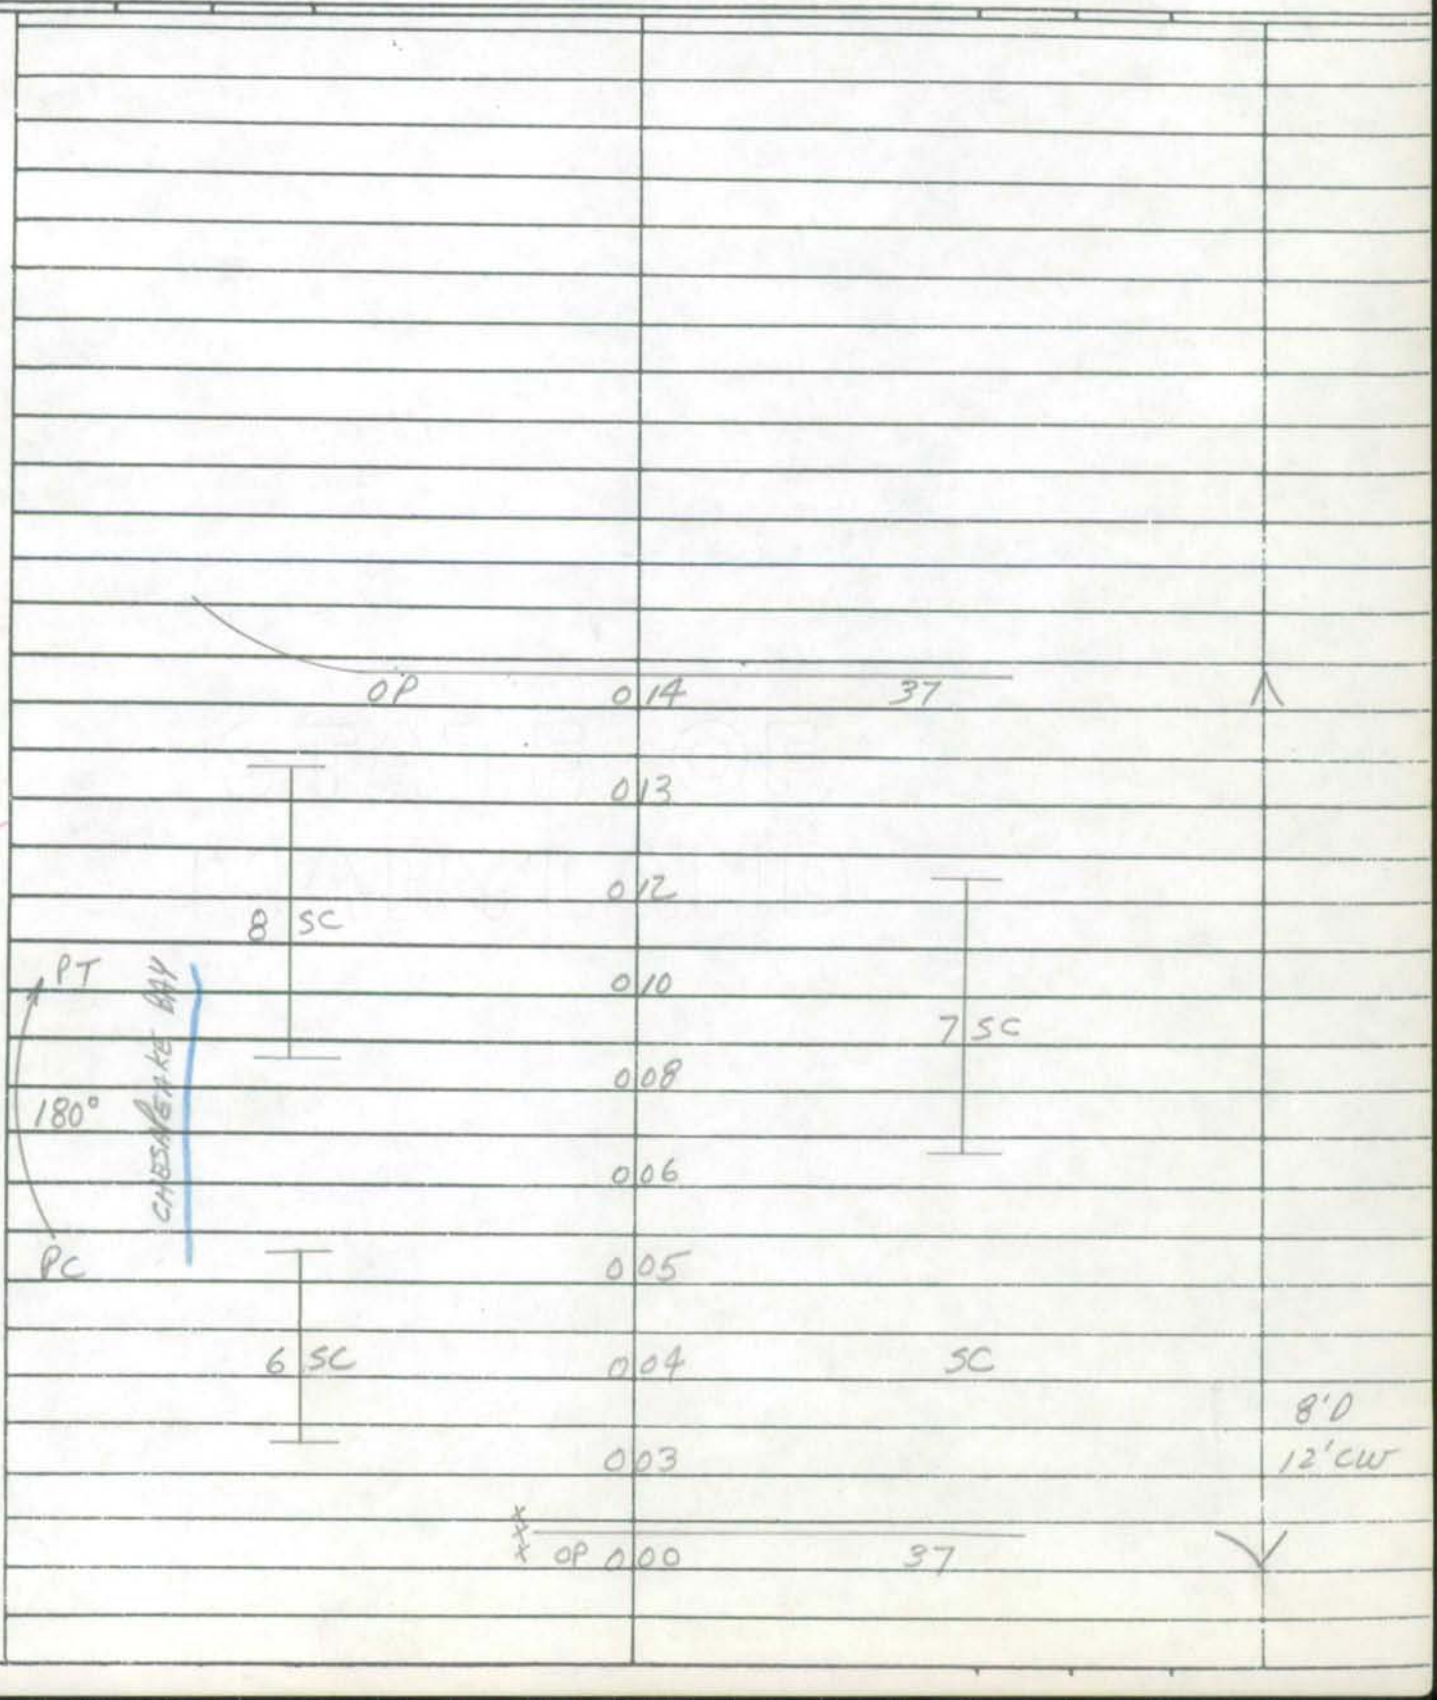

Form 6 HPS (Rev. 1961)

ROAD INVENTORY SHEET

Party Chief T. LANDON
Recorder W WARFIELD
Chainman R. DENTON

CARPENTER BEACH

I-13
938.5-282

Road No. OP 39
Name
Sheet No. 1 OF 1
Date 5-28-69
County CALVERT

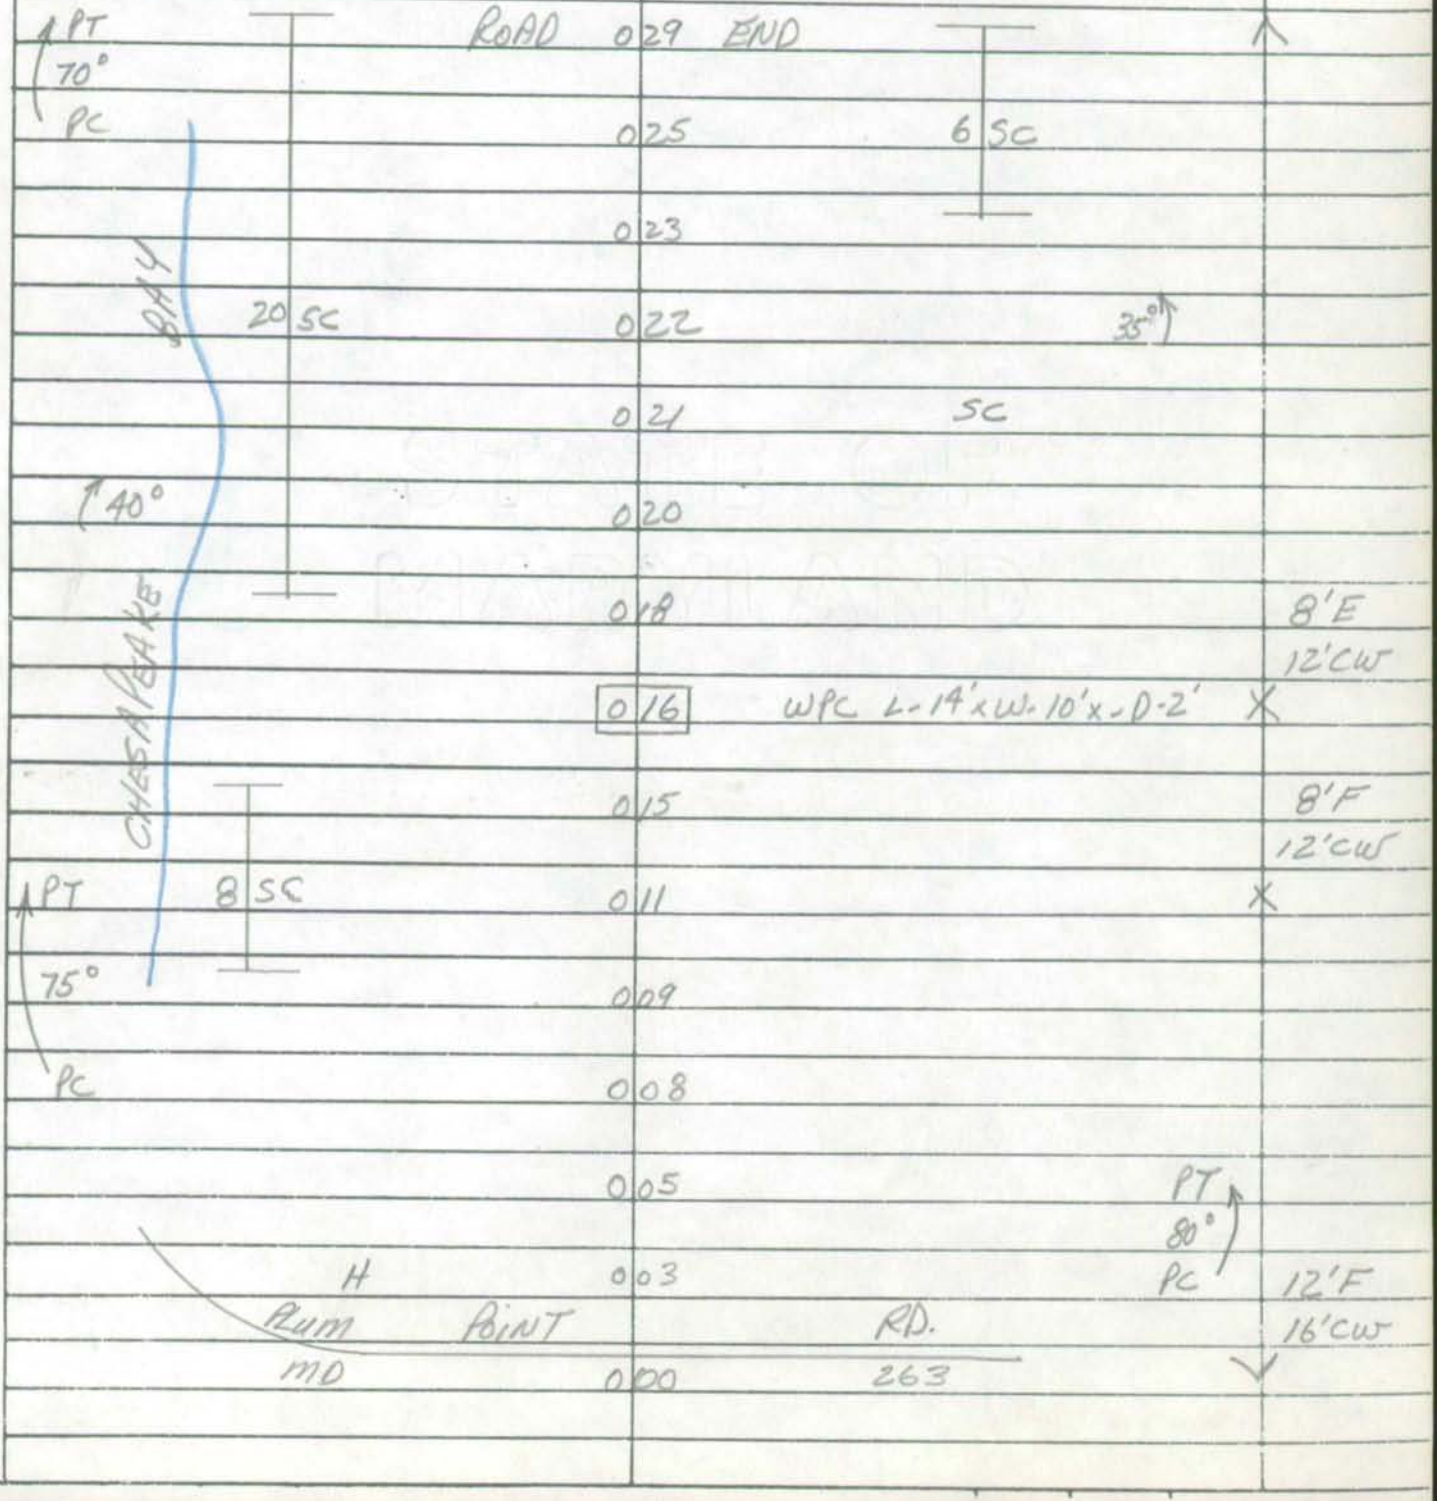

Form 6 HPS (Rev. 1961)

ROAD INVENTORY SHEET

Party Chief T. LANDON
Recorder W. WARFIELD
Chainman R. DENTON

H-13

922.5-291

Road No. OP 40
Name BUCKLEY RD
Sheet No. 1 OF 1
Date 6-2-69
County CALVERT

W

	H ROAD	031	END	
PT 50°	H	027		
PC	H	022		
				12'E
PT 30°		018		16'CW
PC		015		X
		006	12"CMP	
		004	PT 35°	
		002	PC	14'E
			RD. 22	20'CW
HARDESTY CO.		000		

SHA 51.3-8
11-15-72

STATE HIGHWAY ADMINISTRATION OF MARYLAND

99EXT #1
GD-EF
1-14-00

ROAD INVENTORY SHEET

Party Chief G. SIMS
Recorder K. Hess
Helper

Map No. 40

81-74
EXT-A H12

Road No. UP41
Road Name MACARTHER DR.
Sheet No. 1 of 1
Date 10-19-82
County CALVERT
State Coordinates 912-289

2

ROAD 005 END H

12'G
16'CW

570
SD HARVEY 000 RD

SHA 51.3-8
11-15-72

ROAD INVENTORY SHEET

Road No. _____
Road Name _____
Sheet No. _____
Date _____
County _____
State Coordinates _____

Form 6 HPS (Rev. 1961)

ROAD INVENTORY SHEET

Party Chief T. LANDON
Recorder W. WARFIELD
Chainman R. DENTON

H-12
907-287

Road No. OP 42
Name
Sheet No. 1 OF 1
Date 6-2-69
County CALVERT

PT 75° PC	F ROAD	0 43	END	
		0 38		
N				
		0 34		PT 60° PRC
PRC 30° PRC		0 30		
		0 27		PRC 30° PC
		0 17	H	
PT 65° PC		0 14		
		0 11	H	
	HUNTINGTOWN Co.	0 09	H	8'D 12'CW
		0 00		
			10 RD	

Form 6 HPS (Rev. 1961)

ROAD INVENTORY SHEET

Party Chief T. LANDON
Recorder W. WARFIELD
Chainman R. DENTON

H-12
905-291

Road No. OP 43
Name
Sheet No. 1 OF 1
Date 6-2-69
County CALVERT

E			
	F ROAD	018 END	↑
↑ PT		011	
40°			
PC		009	
		005 H	
		004 H	
		003 OP 44 90°)	8'D
		RD.	12'CW
HUNTING TOWN		000 10	↓
CO.			

Form 6 HPS (Rev. 1961)

ROAD INVENTORY SHEET

Party Chief T. LANDON
Recorder W. WARFIELD
Chainman R. DENTON

H-12

705-290

Road No. OP 44
Name
Sheet No. 1 OF 1
Date 6-2-69
County CALVERT

OP 45 & OP 46

UNASSIGNED

Form 6 HPS (Rev. 1961)

ROAD INVENTORY SHEET

Party Chief T. LANDON
Recorder W. WARFIELD
Chainman R. DENTON

I-13
CHESAPEAKE BEACH
936.5-281

Road No. OP 47
Name
Sheet No. 1 OF 1
Date 6-4-69
County CALVERT

E

CHESAPEAKE BAY

5-SC ROAD 046 END

H 024
H RD 022
PVT 10'E
021 30°
010 F 10'E
RD 14'CW
WILSON CO. 000 36

Form 6 HPS (Rev. 1961)

ROAD INVENTORY SHEET

Party Chief T. LANDON
Recorder W. WARFIELD
Chainman R. DENTON

938-279
1-13
PARES BEACH

Road No. OP 48
Name
Sheet No. 1 OF 1
Date 6-4-69
County CALVERT

S

CHESAPEAKE BAY

ROAD 020 END

017 TRAILER CT. PT
(35 TRAILERS)

011 90° PC

H-600' 007 12'E
OP 16'CW
PAUL PD
SECTION
CO. 000 HANKE 154
O.P. 529

Form 6 HPS (Rev. 1961)

ROAD INVENTORY SHEET

Party Chief T. LANDON
Recorder W. WARFIELD
Chainman R. DENTON

936-276
2-13

DARES BEACH

Road No. OP 49
Name
Sheet No. 1 OF 1
Date 6-4-69
County CALVERT

		CHESAPEAKE BAY	
		7-SC's	
	ROAD	0 59 END	
↑25°		0 53	
		0 47 30°↑	
E		0 40 PT ↑ 90°	
PRC ↑125°		0 36 PRC	
PC		0 28	
		0 24 15°↑	
↑15°		0 21	
		0 11 20°↑	
		0 06 12"CMP	
↑15°		0 03	B'D 12'CWS
	WILSON Co.	0 00 36 ED.	

Form 6 HPS (Rev. 1961)

ROAD INVENTORY SHEET

Party Chief T. LANDON
Recorder W. WARFIELD
Chainman R. DENTON

7-13
DARES BEACH
935-274

Road No. OP 50
Name
Sheet No. 1 OF 1
Date 6-4-69
County CALVERT

	CHESAPEAKE	BAY	
H ROAD	0 65	END	
	0 60	H	
	0 58	H	
	0 55	45° ↑	
	0 48	90° ↑	
↑ 90°	0 35		
	0 32	F	10' E 14' CW
WILSON CO.	0 00	RD 36	

SHA 51.3-8
11-15-72

STATE HIGHWAY ADMINISTRATION OF MARYLAND

ROAD INVENTORY SHEET

Party Chief _____
Recorder _____
Helper _____

Map No. _____

Road No. OP 51
Road Name _____
Sheet No. _____
Date _____
County CALVERT
State Coordinates _____

UNASSIGNED

NOW Co 522

HPMS 9

10-81

SHA 51.3-8
11-15-72

ROAD INVENTORY SHEET

Road No. _____
Road Name _____
Sheet No. _____
Date _____
County _____
State Coordinates _____

SHA 51.3-8
11-15-72

STATE HIGHWAY ADMINISTRATION OF MARYLAND

ROAD INVENTORY SHEET

Party Chief _____
Recorder _____
Helper _____

Map No. _____

Road No. OP 52
Road Name _____
Sheet No. _____
Date _____
County CALVERT
State Coordinates _____

UNASSIGNED

Now Co 521

HPS-39
10-81

SHA 51.3-8
11-15-72

ROAD INVENTORY SHEET

Road No. _____
Road Name _____
Sheet No. _____
Date _____
County _____
State Coordinates _____

Form 6 HPS (Rev. 1961)

ROAD INVENTORY SHEET

Party Chief T. LANDON
Recorder W. WARFIELD
Chainman B. HOOPER

CHESAPEAKE HEIGHTS
1-13
932-265

Road No. OP 53
Name
Sheet No. 1 OF 1
Date 6-9-69
County CALVERT

E

ROAD 0 03 END

2-20' I.
18' GRASS MED.

CASSELL BLVD
OP CO 0 00
521

OP 54

CALVERT COUNTY

UNASSIGNED

NOW

CO 1169

SOUTH SHORE TER

01- 22 CO

Form 6 HPS (Rev. 1961)

ROAD INVENTORY SHEET

Party Chief T. LANDON
Recorder W. WARFIELD
Chainman B. HOOPER

CHESAPEAKE HEIGHTS
I-13
932.5-266.5

Road No. OP 55
Name
Sheet No. 1 OF 1
Date 6-9-69
County CALVERT

N

PROPOSED

ROAD 006 END

20'I
2-3'ESHLD
32'CW

CASSELL BLVD

OP CO 003 521 X

2-20'I
14'GRASS MED
2-3'ESHLD.

ROAD 000 END

OP 56

CALVERT COUNTY

SEE INVENTORY OF

CO 949, SOUTH SHORE TERR. #7.

95-25

SHA 51.3-8
11-15-72

STATE HIGHWAY ADMINISTRATION OF MARYLAND

ROAD INVENTORY SHEET

Party Chief _____
Recorder _____
Helper _____

Map No. _____

Road No. OP 57
Road Name _____
Sheet No. _____
Date _____
County CALVERT
State Coordinates _____

UNASSIGNED
NOW 6523
APR 79
10-81

SHA 51.3-8
11-15-72

ROAD INVENTORY SHEET

Road No. _____
Road Name _____
Sheet No. _____
Date _____
County _____
State Coordinates _____

OP 58

Calvert County

UNASSIGNED

NOW

CO 1115

PARK TERRACE #4

00-29 CO

4-10-2001

SHA 51.3-8
11-15-72

STATE HIGHWAY ADMINISTRATION OF MARYLAND

ROAD INVENTORY SHEET

Party Chief _____
Recorder _____
Helper _____

Map No. _____

Road No. OF 59
Road Name _____
Sheet No. _____
Date _____
County CALVERT
State Coordinates _____

UNASSIGNED

Now Co 524

HP3-59
10-81

SHA 51.3-8
11-15-72

ROAD INVENTORY SHEET

Road No. _____
Road Name _____
Sheet No. _____
Date _____
County _____
State Coordinates _____

OP 60

Calvert County

UNASSIGNED

NOW

CO 1147

South Shore Ter 4

00-28 CO

4-17-2001

SHA 51.3-8
11-15-72

STATE HIGHWAY ADMINISTRATION OF MARYLAND

ROAD INVENTORY SHEET

Party Chief _____
Recorder _____
Helper _____

Map No. _____ E-13

Road No. OP 61
Road Name _____
Sheet No. _____
Date _____
County CALVERT
State Coordinates 935-268

See Inventory of Co. 528

N

SHA 51.3-8
11-15-72

ROAD INVENTORY SHEET

Road No. _____
Road Name _____
Sheet No. _____
Date _____
County _____
State Coordinates _____

SHA 51.3-8
11-15-72

STATE HIGHWAY ADMINISTRATION OF MARYLAND

ROAD INVENTORY SHEET

Party Chief _____
Recorder _____
Helper _____

Map No. _____

Road No. OP 62
Road Name _____
Sheet No. _____
Date _____
County CALVERT
State Coordinates _____

UNASSIGNED

Now Co 532

APS-39
10-21

SHA 51.3-8
11-15-72

ROAD INVENTORY SHEET

Road No. _____
Road Name _____
Sheet No. _____
Date _____
County _____
State Coordinates _____

Form 6 HPS (Rev. 1961)

ROAD INVENTORY SHEET

Party Chief T. LANDON
Recorder W. WARFIELD
Chainman B. HOOPER

CHESAPEAKE HEIGHTS
I-13
936-169

Road No. OP 63
Name
Sheet No. 1 OF 1
Date 6-9-69
County CALVERT

SW

DE
CUL 004 SAC

10'I
(NOT YET COMPLETE)
30'CW

CASSELL
~~OP~~ CO 000 DLKD 521

SHA 51.3-8
11-15-72

STATE HIGHWAY ADMINISTRATION OF MARYLAND

ROAD INVENTORY SHEET

Party Chief _____
Recorder _____
Helper _____

Map No. _____

Road No. OP 64
Road Name _____
Sheet No. _____
Date _____
County CALVERT
State Coordinates _____

UNASSIGNED NOW

G 530

APS-39
10-81

SHA 51.3-8
11-15-72

ROAD INVENTORY SHEET

Road No. _____
Road Name _____
Sheet No. _____
Date _____
County _____
State Coordinates _____

SHA 51.3-8
11-15-72

STATE HIGHWAY ADMINISTRATION OF MARYLAND

ROAD INVENTORY SHEET

Party Chief _____
Recorder _____
Helper _____

Map No. _____

Road No. OP 65
Road Name _____
Sheet No. _____
Date _____
County CALVERT
State Coordinates _____

UNASSIGNED

Now Co. 525 to Co 527

HPS-79
10-81

SHA 51.3-8
11-15-72

ROAD INVENTORY SHEET

Road No. _____
Road Name _____
Sheet No. _____
Date _____
County _____
State Coordinates _____

SHA 51.3-8
11-15-72

STATE HIGHWAY ADMINISTRATION OF MARYLAND

ROAD INVENTORY SHEET

Party Chief _____
Recorder _____
Helper _____

Map No. _____

Road No. OP66
Road Name _____
Sheet No. _____
Date _____
County CALVERT
State Coordinates _____

UNASSIGNED

Now Co 534

HPS-39
10-81

SHA 51.3-8
11-15-72

ROAD INVENTORY SHEET

Road No. _____
Road Name _____
Sheet No. _____
Date _____
County _____
State Coordinates _____

Form 6 HPS (Rev. 1961)

ROAD INVENTORY SHEET

Party Chief T. LANDON
Recorder W. WARFIELD
Chainman B. HOOPER

CHESAPEAKE HEIGHTS

I-13

937.5-269.5

Road No. 01 67
Name
Sheet No. 1 OF 1
Date 6-9-69
County CALVERT

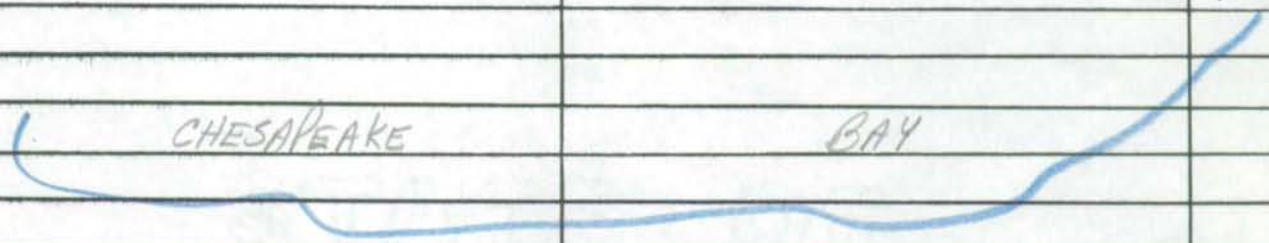

SALES OFFICE

ROAD 0|3 END

E

0|0 PT

008 PUMPING STATION 35°

002 PC 20'I
30'CW

DEANE
CO 000 AVE
527 ~~525~~

SHA 51.3-8
11-15-72

STATE HIGHWAY ADMINISTRATION OF MARYLAND

ROAD INVENTORY SHEET

Party Chief _____
Recorder _____
Helper _____

Map No. _____

Road No. OP 68
Road Name _____
Sheet No. _____
Date _____
County CALVERT
State Coordinates _____

UNASSIGNED

Now Co 526

HPS-39
10/81

SHA 51.3-8
11-15-72

ROAD INVENTORY SHEET

Road No. _____
Road Name _____
Sheet No. _____
Date _____
County _____
State Coordinates _____

SHA 51.3-8
11-15-72

STATE HIGHWAY ADMINISTRATION OF MARYLAND

ROAD INVENTORY SHEET

Party Chief _____
Recorder _____
Helper _____

Map No. _____

Road No. OP69
Road Name _____
Sheet No. _____
Date _____
County CALVERT
State Coordinates _____

UNASSIGNED

NOW C 533
APS-39
10-87

SHA 51.3-8
11-15-72

ROAD INVENTORY SHEET

Road No. _____
Road Name _____
Sheet No. _____
Date _____
County _____
State Coordinates _____

SHA 51.3-8
11-15-72

STATE HIGHWAY ADMINISTRATION OF MARYLAND

ROAD INVENTORY SHEET

Party Chief _____
Recorder _____
Helper _____

Map No. _____

Road No. OP 70
Road Name _____
Sheet No. _____
Date _____
County CALVERT
State Coordinates _____

UNASSIGNED

Now C0 528

HPS-39
10-81

SHA 51.3-8
11-15-72

ROAD INVENTORY SHEET

Road No. _____
Road Name _____
Sheet No. _____
Date _____
County _____
State Coordinates _____

Form 6 HPS (Rev. 1961)

ROAD INVENTORY SHEET

Party Chief T. LANDON
Recorder W. WARFIELD
Chainman B. HOOPER

CHESAPEAKE HEIGHTS

Road No. CP 71
Name
Sheet No. 1 OF 1
Date 6-9-69
County CALVERT

939-2695

NW

ROAD 002 END

2-20' I
20' GRASS MED.

FLORA AVE

~~GR~~ CO 000 530 64

Form 6 HPS (Rev. 1961)

ROAD INVENTORY SHEET

Party Chief T. LANDON
Recorder W. WARFIELD
Chainman B. HOOPER

CHESAPEAKE HEIGHTS

939.5-269.5

Road No. OP 72
Name
Sheet No. 1 OF 1
Date 6-9-69
County CALVERT

NW

ROAD 002 END

2-20' I
18' GRASS
MED

FLORA 00 00 530 64 AVE

Form 6 HPS (Rev. 1961)

ROAD INVENTORY SHEET

Party Chief T. LANDON
Recorder W. WARFIELD
Chainman B. HOOPER

CHESAPEAKE HEIGHTS

939-270

Road No. OP 73
Name
Sheet No. 1 OF 1
Date 6-9-69
County CALVERT

NW

ROAD 002 END

2-20' I
20' GRASS
MED.

FURA ~~CE~~ D 000 AVE 530 ~~64~~

SHA 51.3-8
11-15-72

STATE HIGHWAY ADMINISTRATION OF MARYLAND

ROAD INVENTORY SHEET

Party Chief _____
Recorder _____
Helper _____

Map No. _____

Road No. OP 74
Road Name _____
Sheet No. _____
Date _____
County CALVERT
State Coordinates _____

VVASSIFIED

NW Co 537

HPS-39
10-81

SHA 51.3-8
11-15-72

ROAD INVENTORY SHEET

Road No. _____
Road Name _____
Sheet No. _____
Date _____
County _____
State Coordinates _____

Form 6 HPS (Rev. 1961)

94-1 ST
GO/TM
11-17-94

ROAD INVENTORY SHEET

Party Chief T. LANDON
Recorder W. WARFIELD
Chainman B. HOOPER

7-13
DARES BEACH
935-2645

Road No. OP 75
Name BROOKS VILLAGE
Sheet No. 1 OF 1
Date 6-9-69
County CALVERT

H	ROAD	010	END
		009	H
H		007	
		005	H
		004	H-200'
DARES		BEACH	RD
MD		000	402

Form 6 HPS (Rev. 1961)

ROAD INVENTORY SHEET

Party Chief T. LANDON
Recorder W. WARFIELD
Chainman B HOOPER

I-13
DARES BEACH
937-2615

Road No. OP 76
Name
Sheet No. 1 OF 1
Date 6-9-69
County CALVERT

			BAY	
ROAD	0	50	END	N
	0	48	H	
SC	0	44	CHESAPEAKE	
SC	0	42		
	0	37	20° ↑	
	0	34	12" CMP	
↑ 30°	0	33		
	0	30	12" CMP 90° ↑	
↑ 40°	0	24		
SC	0	20	20° ↑	
			101 RD.	10' D
				14' CW
GOLD STEIN				
CO.	0	00		

SHA 51.3 - 8 Revised
4.83

MARYLAND STATE HIGHWAY ADMINISTRATION

ROAD INVENTORY SHEET

Party Chief _____
Recorder _____
Assistant _____
Map No./Dir. 1
State Coordinates _____

Road No. OP 77
Road Name _____
County CALVERT
Date _____
Sheet No. _____ OF _____

SYSTEM				TRAFFIC		LINE DIAGRAM	TRAFFIC			PAVEMENT DATA
FED. AID.	FUNCT CLASS.	HWY. SYS.	HPMS SAMPLE	PRKG. REST.	COM/IND. ACCESS		CONTROL	COM/IND. ACCESS	PRKG. REST.	
						See INV. of 6633 85-1				

TRAFFIC CODES

TRAFFIC CONTROLS: STOP SIGN=SS, TRAFFIC LIGHT=T.L., FLASHING RED BALL=F.R.

TRAFFIC CODES

PARKING RESTRICTIONS: A.M. PEAK, P.M. PEAK, A.M./P.M. PEAK, NO PARKING ANYTIME=N.P., COMM/IND. ACCESS=E

SYSTEM				TRAFFIC		LINE DIAGRAM	TRAFFIC				PAVEMENT DATA
FED. AID.	FUNCT. CLASS.	HWY. SYS.	HPMS SAMPLE	PRK.G. REST.	COM/IND ACCESS		CONTROL	COM/IND ACCESS	PRK.G. REST.		

Form 6 HPS (Rev. 1961)

ROAD INVENTORY SHEET

Party Chief
Recorder
Chainman

Road No. OP 78
Name
Sheet No. 1-51
Date 6/21

921-2625

Now Co 269

Form 6 HPS (Rev. 1961)

ROAD INVENTORY SHEET

Party Chief T. [illegible]


PRIMARY REFERENCE
921-263

Road Co 270

H ROAD 0.18 END

H 0.25

16'D
32'W

OP 0.00 73

Form 6 HPS (Rev. 1961)

ROAD INVENTORY SHEET

AL/RL 4-22-97 ST RI

Party Chief T. LANDON
Recorder W. WARFIELD
Chainman B. HOOPER

PRINCE FREDERICK
I-13
920-257

Road No. OP 80
Name VIANNEY LANE
Sheet No. 1 of 1
Date 6-10-69
County CALVERT

N

	H		
ROAD	0 07	END	
4 H			
	0 04		12'0
~~SEC~~ MAIN SECTION	ST ~~MD~~ 2		16'CW
MP	0 00	765-A	

SHA 51.3 - 8 Revised
4.83

MARYLAND STATE HIGHWAY ADMINISTRATION

ROAD INVENTORY SHEET

Party Chief _____
Recorder _____
Assistant _____
Map No./Dir. 1
State Coordinates _____

Road No. OP 81
Road Name _____
County CALVERT
Date _____
Sheet No. _____ OF _____

SYSTEM				TRAFFIC		LINE DIAGRAM	TRAFFIC			PAVEMENT DATA
FED. AID.	FUNCT CLASS.	HWY. SYS.	HPMS SAMPLE	PRK.G. REST.	COM/IND. ACCESS		CONTROL	COM/IND. ACCESS	PRK.G. REST.	
						UNASSIGNED Now Co 639 85-49				

TRAFFIC CODES

TRAFFIC CONTROLS: STOP SIGN=SS, TRAFFIC LIGHT=T.L., FLASHING RED BALL=F.R.

TRAFFIC CODES

PARKING RESTRICTIONS: A.M. PEAK, P.M. PEAK, A.M./P.M. PEAK, NO PARKING ANYTIME=N.P., COMM/IND. ACCESS=E

SYSTEM				TRAFFIC		LINE DIAGRAM	TRAFFIC			PAVEMENT DATA
FED. AID.	FUNCT. CLASS.	HWY. SYS.	HPMS SAMPLE	PRK'G. REST.	COM/IND ACCESS		CONTROL	COM/IND ACCESS	PRK'G. REST.	

Form 6 HPS (Rev. 1961)

ROAD INVENTORY SHEET

Party Chief T. LANDON
Recorder W. WARFIELD
Chainman B. HOOPER

I-12
PRINCE FREDERICK
914-266.5

Road No. OP 82
Name (Avery Rd)
Sheet No. 1 OF 4
Date 6-5-69
County CALVERT

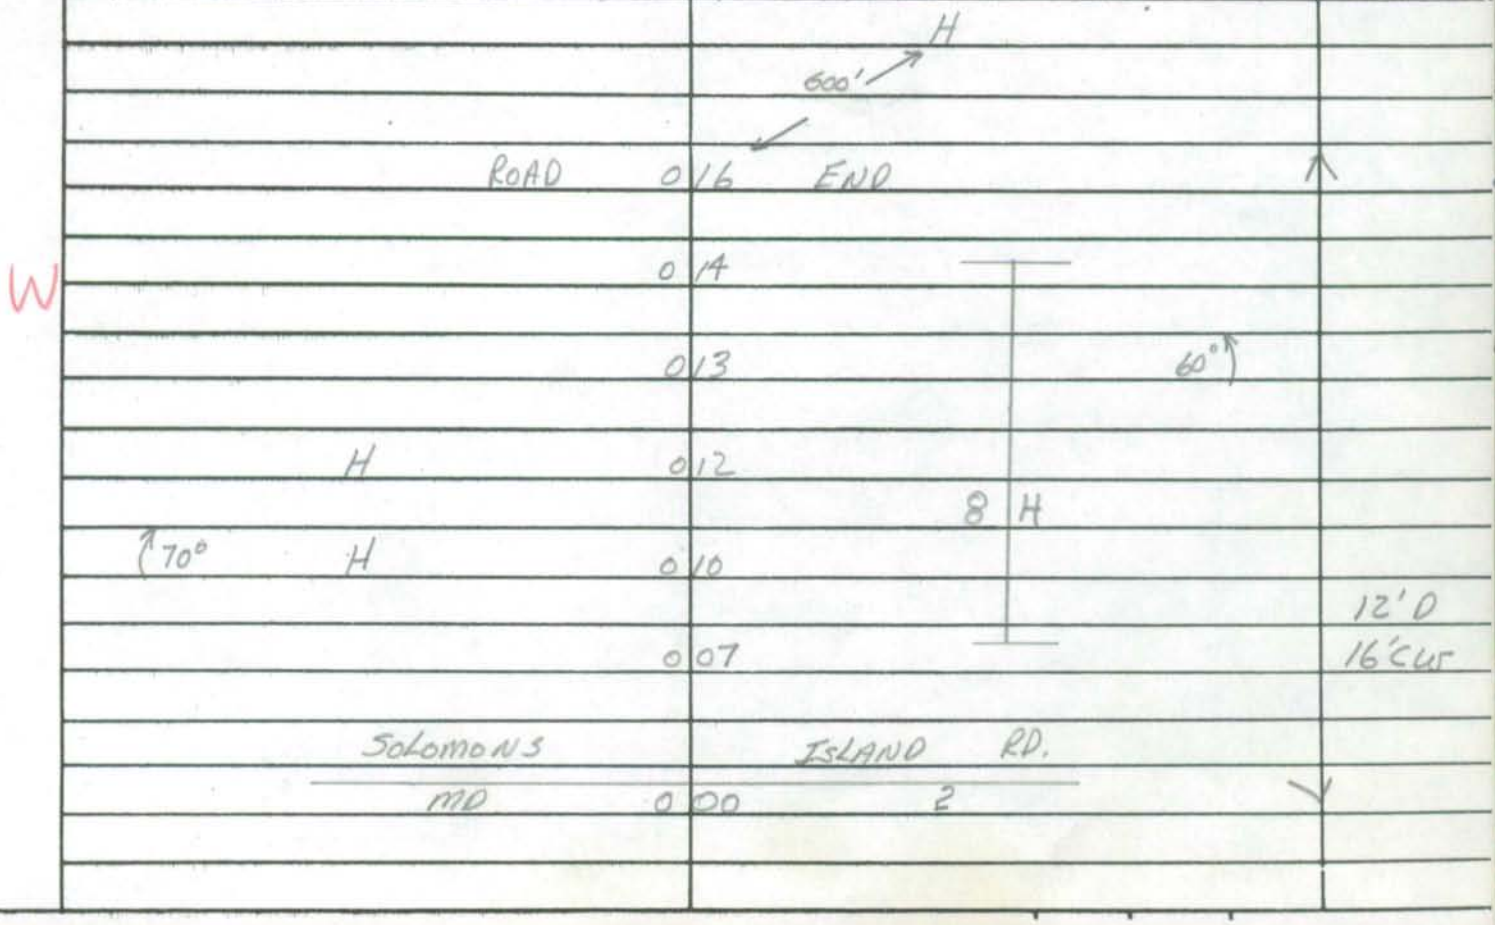

Form 6 HPS (Rev. 1961)

ROAD INVENTORY SHEET

Party Chief T. LANDON
Recorder W. WARFIELD
Chainman B. HOOPER

Z-12

899.5-264

Road No. OP 83
Name
Sheet No. 1 OF 1
Date 6-10-69
County CALVERT

OP 84

ST. MARY'S COUNTY

UNASSIGNED - NOW

CO 1033, HERON LANDING WAY.

97-22

Form 6 HPS (Rev. 1961)

ROAD INVENTORY SHEET

Party Chief T. LANDON
Recorder W. WARFIELD
Chainman B. HOOPER

Road No. OP 85
Name
Sheet No. 1 of 1
Date 6-11-69
County CALVERT

I-12 901 -246

S

		H ↑ 300 ↓	
H	ROAD	0 30	END
F-400'		0 26	
		0 22	H
		0 17	12" CMP 10'E
HALLOWING			PT. RD. 14'CW
MD		0 00	231

SHA 51.3 - 8 Revised
4.83

MARYLAND STATE HIGHWAY ADMINISTRATION

ROAD INVENTORY SHEET

Party Chief _____
Recorder _____
Assistant _____
Map No./Dir. 1
State Coordinates _____

Road No. OP 86
Road Name (Sea Gull Beach RD)
County _____
Date _____
Sheet No. _____ OF _____

SYSTEM				TRAFFIC		LINE DIAGRAM	TRAFFIC			PAVEMENT DATA
FED. AID.	FUNCT CLASS.	HWY. SYS.	HPMS SAMPLE	PRKG. REST.	COM/IND. ACCESS		CONTROL	COM/IND. ACCESS	PRKG. REST.	
						SEE CO 813 90-14				

TRAFFIC CODES

TRAFFIC CONTROLS: STOP SIGN=SS, TRAFFIC LIGHT=T.L., FLASHING RED BALL=F.R.

TRAFFIC CODES

PARKING RESTRICTIONS: A.M. PEAK, P.M. PEAK, A.M./P.M. PEAK, NO PARKING ANYTIME=N.P., COMM/IND. ACCESS=E

SYSTEM				TRAFFIC		LINE DIAGRAM	TRAFFIC				PAVEMENT DATA
FED. AID.	FUNCT. CLASS.	HWY. SYS.	HPMS SAMPLE	PRKG. REST.	COM/IND ACCESS		CONTROL	COM/IND ACCESS	PRKG. REST.		

SHA 51.3-8
11-15-72

STATE HIGHWAY ADMINISTRATION OF MARYLAND

ROAD INVENTORY SHEET

Party Chief T. LANDON
Recorder W. WARFIELD
Helper R. HOOPER

Map No. I-12
897-246-5

Road No. O.P. 87
Road Name
Sheet No. 1 of 1
Date 6-11-69
County CALVERT
State Coordinates

S

ROAD END

H 0 22
H 0 20 H
0 14 H
H 0 13 H
0 09 H

MD 131
752

PATUXENT RIVER

12'E
16'CW

0 00

OLD SECTION MD

SHA 51.3-8
11-15-72

ROAD INVENTORY SHEET

Road No. _____
Road Name _____
Sheet No. _____
Date _____
County _____
State Coordinates _____

Form 6 HPS (Rev. 1961)

ROAD INVENTORY SHEET

Party Chief T. LANDON
Recorder W. WARFIELD
Chainman B. HOOPER

J-12

Road No. OP 88
Name MORSELLS RD.
Sheet No. 1 OF 1
Date 6-11-69
County CALVERT

908.5-238

	F ROAD	083 END	
W	PT (35° PC	072	
		062	H-(UAC.)
		055	PT (40°)
		049	H-(ABAN.) 200' PC
		037	20°
		016	15°
	H	004	12'E
	ADELINA	RD.	16'CCW
	Co.	000 57	

Form 6 HPS (Rev. 1961)

ROAD INVENTORY SHEET

Party Chief T. LANDON
Recorder W. WARFIELD
Chainman B. HOOPER

I-12

908.5-235.5

Road No. OP 89
Name
Sheet No. 1 OF 1
Date 6-12-69
County CALVERT

ROAD	011	END	
15°	006		
	005	H	
	004	40°	
			8'C
H.	002		12'CW
ADELINA			
CO.	000	57 RD	

Form 6 HPS (Rev. 1961)

ROAD INVENTORY SHEET

Party Chief T. LANDON
Recorder W. WARFIELD
Chainman B. HOOPER

J-13

923.5-2245

Road No. OP 90
Name
Sheet No. 1 OF 1
Date 6-16-69
County CALVERT

		H		
	ROAD	054	END	
	H-(ABAN.)	042	H-(ABAN.)	8'C 12'CW
(35°		035		
		031	H	10'D 14'CW
			PVT. RD	
		018	8'D	95°
			02 I	14'D 20'CW
		017	H	
	WILLIAMS	WHARF	RD.	
	60	000	61	

Form 6 HPS (Rev. 1961)

ROAD INVENTORY SHEET

Party Chief T. LANIGAN
Recorder W. WAREFIELD
Chainman B. HOOPER

BROOMES ISLAND
1-13
930-212.5

Road No. OP 91
Name
Sheet No. 1 OF 1
Date 6-17-69
County CALVERT

S

ROAD	0	08	END	H	↑
CHURCH CO.	0	05		H	
					10'E
B-GROCERY	0	01		H	15° ↑ 14'CW
	0	00			↓
TR			RD		

Form 6 HPS (Rev. 1961)

ROAD INVENTORY SHEET

Party Chief T. LANDON
Recorder W. WARFIELD
Chainman B. HOOPER

BROOMES ISLAND
7-13
930-213

Road No. OP 92
Name GLEN RD
Sheet No. 1 OF 1
Date 6-17-69
County CALVERT

ABANDONED
SR 93
GD, GW
7-8-93

I-

ISLAND CREEK

H ROAD 0 13 END

0 12 H H-50' 12'D 16'CW

0 07 H

BROOMES ISLAND RD

MD 0 00 26+

Form 6 HPS (Rev. 1961)

ROAD INVENTORY SHEET

Party Chief T. LANDON
Recorder W. WARFIELD
Chainman B. HOOPER

BROOMES ISLAND
J-13
930-212.5

Road No. OP 93
Name
Sheet No. 1 OF 1
Date 6-17-69
County CALVERT

N

PATUXENT RIVER

			H	
3 H	ROAD	0 25	END	4 H
		0 19		
BROOMES			ISLAND RD	
MD		0 13	264	
		0 05	H	90° CREEK 10'D 14'CW
	ROAD	0 00	END B-CRAB HOUSE	ISLAND
			H	

Form 6 HPS (Rev. 1961)

ROAD INVENTORY SHEET

Party Chief T. LANDON
Recorder W. WARFIELD
Chainman B. HOOPER

3-13

938-222.5

Road No. OP 94
Name
Sheet No. 1 OF 1
Date 6-17-69
County CALVERT

	F		
ROAD	100	END	↑
↑15°	094		
	091		PT ↑ 45°)
	087		PC
	065	H-200'	10° ↑
H-200'	063		
	052	H-300'	
	045	H	
	035		15° ↑
↑30°	028		10'D 14'CW
	000		↓

N

MACKALL CO. 209 RD

Form 6 HPS (Rev. 1961)

2001 CO EX #3
2-20-02
GD/EF

ROAD INVENTORY SHEET

Party Chief T. LANDON
Recorder W. WARFIELD
Chainman B. HOOVER

3-13
937-224

Road No. OP 95
Name MARSHALL RD.
Sheet No. 1 OF 2
Date 6-17-69
County CALVERT

(40°		0	93		
		0	88	PT	
				65)	
PRC		0	82	PRC	
(20°					
PRC		0	79	PRC	
				30°	
		0	75	PC	
PT	H-500'	0	69		
50°	H-300'	0	66		
N					
PRC		0	64	PRC	
		0	57	H 55°	
		0	55	PC	
↑ 45°		0	48	CHIMNEY LA	
		0	34	PVT	
PT		0	24		
(30°					
PRC		0	20	PRC	
				70°)	
		0	15	PC	
		0	08	15° ↑	8'D
					12'CW
		0	00		

Form 6 HPS (Rev. 1961)

ROAD INVENTORY SHEET

Party Chief T. LANDON
Recorder W. WARFIELD
Chainman B. HOOKER

J-13

Road No. OP 95
Name MARSHALL RD
Sheet No. 2 OF 2
Date 6-17-69
County CALVERT

H

	ROAD	189	END
			PT 50°
		181	PC
PT 70°		176	
PC		172	
		161	15" CMP
		157	H
		146	12" CMP
			PT 40°
		141	PC
		136	10°
PT 45°		133	
PC		130	
		126	PT 55°
PRC 145°		122	PRC
PRC		114	PRC 60°
	H (ABAN.)	111	PC
		098	10°
			SAME

W

Form 6 HPS (Rev. 1961)

ROAD INVENTORY SHEET

Party Chief T. LANDON
Recorder W. WARFIELD
Chainman B. HOOPER

J-13

945-213

Road No. OP 96
Name
Sheet No. 1 OF 1
Date 6-18-69
County CALVERT

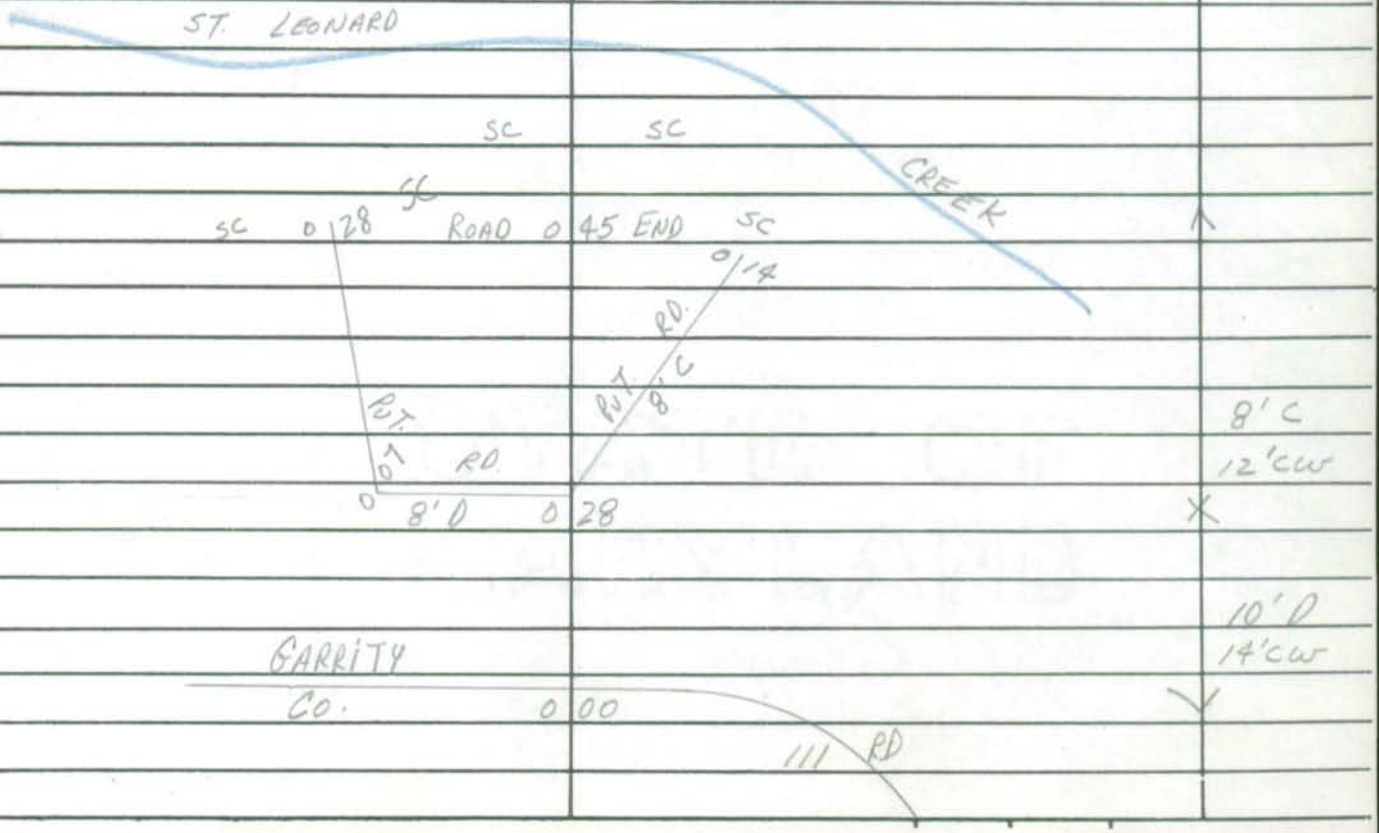

Form 6 HPS (Rev. 1961)

ROAD INVENTORY SHEET

Party Chief T. LANDON
Recorder W. WARFIELD
Chainman B. HOOPER

CAPE LEONARD

Road No. OP 97
Name
Sheet No. 1 OF 2
Date 6-18-69
County CALVERT

942.5-209

		79 SPUR ← 0.01/10'E		12'E
H-400'	0		OP	16'CW
PVT 9'O RD	0	78	98	X
	0	75		
"SLAVE HOUSE" (1812)	0	70	H	PT 55° PC
	0	67		
SC-400'	0	62		
SC-400'	0	60		
PT 80° PC	0	56		
H	0	52		
		PVT RD 9'E	0 0	
	0	46		PT 25° PC
	0	42		
20°	0	40		
	0	36		PT 100° PRC
PRC 20°	0	30	RD 209	
PC	0	24		14'E 20'CW
	0	00		
		MACKALL CO.		

Now Co. 213

Form 6 HPS (Rev. 1961)

ROAD INVENTORY SHEET

Party Chief T. LANDON
Recorder W. WARFIELD
Chainman G HOOPER

Road No. OP 97
Name
Sheet No. 2 OF 2
Date 6-18-69
County CALVERT

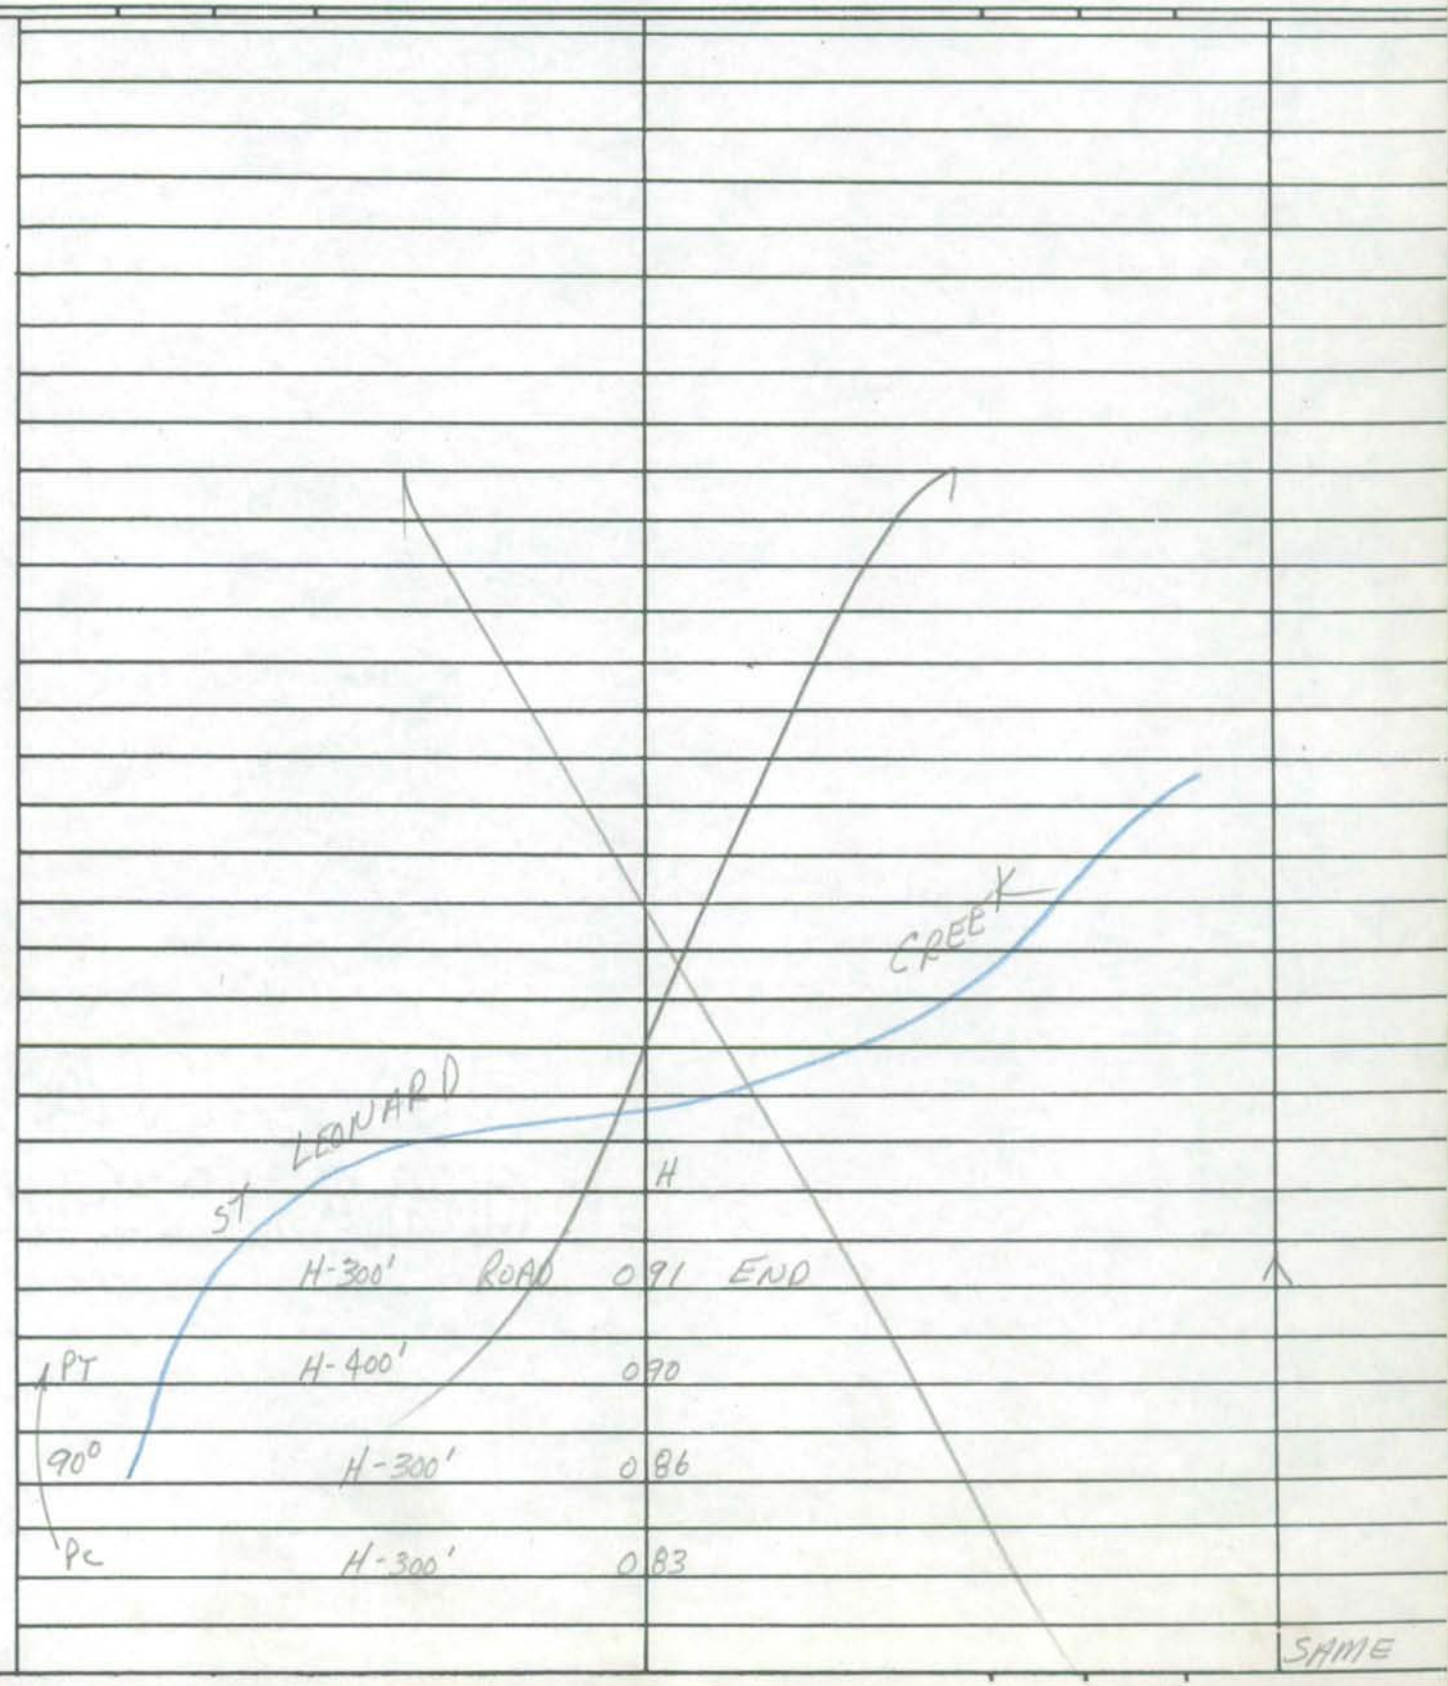

Form 6 HPS (Rev. 1961)

ROAD INVENTORY SHEET

Party Chief T. LANDON
Recorder W. WARFIELD
Chainman B. HOOPER

CAPE LEONARD

Road No. OP 98
Name
Sheet No. 1 OF 2
Date 6-18-69
County CALVERT

945-248

	0 51	H-400'	ST. LEONARD CREEK
	0 43		PT
	0 40	6 H	150'
	0 35		
	0 33	H-300'	PC
OP 98	0 27	H-300'	
	0 22	H-400'	10'E 14'CW
	0 20		PT 80° PC
	0 15		
ST. LEONARD CREEK	0 07	H-300'	
PT	0 05	H-200'	
	0 03	H-400'	
110°			
	0 02	CLUB HOUSE-300' OP	
		0.01/10'E →	12'E
PC	0 01	STOP	12"CMP 16'CW
	0 00		
		97	

CO. 311 CO. 313 NOW 76-4×7

Form 6 HPS (Rev. 1961)

ROAD INVENTORY SHEET

Party Chief T. LANDON
Recorder W. WARFIELD
Chainman R. HOOPER

Road No. OP 98
Name
Sheet No. 2 OF 2
Date 6-18-69
County CALVERT

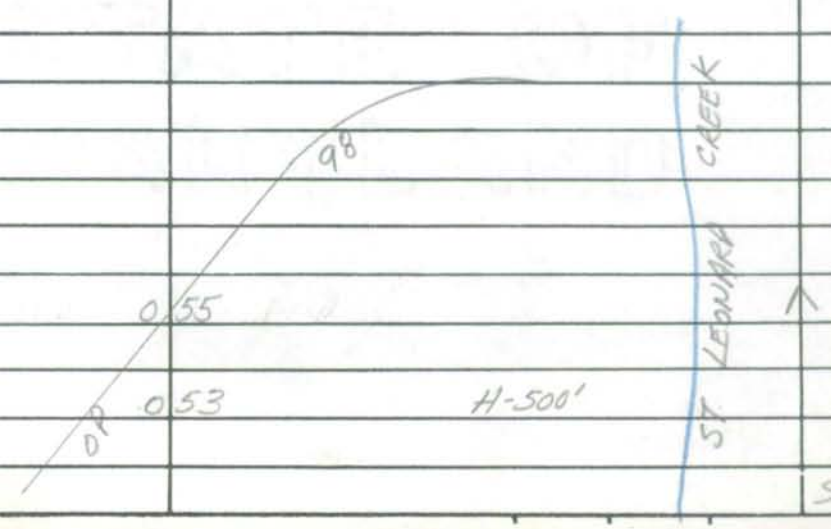

Form 6 HPS (Rev. 1961)

ROAD INVENTORY SHEET

Party Chief T. LANDON
Recorder W. WARFIELD
Chainman B. HOOPER

SCIENTIST CLIFFS
I-13

938-2515

Road No. OP 99
Name Elder Rd
Sheet No. 1 OF 1
Date 6-18-69
County CALVERT

UNASSIGNED

NOW PVT 88-EX

JE

E-

Elm
OP 018 Rd
101

S.C. 016

015 SC 8'G

Evergreen RD 12'CW
OP 100 011

010 10°

10° 003 10'EF

SCIENTIST CLIFFS 14'CW
CO. 000

69 RD.

Form 6 HPS (Rev. 1961)

ROAD INVENTORY SHEET

PVT 88-EX ✓

Party Chief T. LANDON
Recorder W.W. WARFIELD
Chainman B. HOOPER

SCIENTIST CLIFFS
I-13

938-252

Road No. ~~OF~~ ~~100~~
Name Evergreen Rd
Sheet No. 1 OF 1
Date 6-18-69
County CALVERT

UNASSIGNED - NOW PVT 88-EX JE

N

CHESAPEAKE BAY

SC

S.C. ROAD	0 13	END	
	0 11	30° ↑	
↑ 85°	0 09		
	0 06	S.C.	
		Easterbell Rd.	10'E
	0 05	~~OF~~ ~~101~~ PVT 88-EX	14'CW
PVT ~~OF~~ Elder		Rd	
	0 00	~~99~~ PVT 88-EX	✓

Form 6 HPS (Rev. 1961)

ROAD INVENTORY SHEET

PVT

Party Chief T. LANHAM
Recorder W. WARFIELD
Chainman B. HOOPER

SCIENTIST CLIFFS

Z-13

938-252

Road No. ~~of~~ ~~101~~
Name Easterbell Rd
Sheet No. 1 OF 1
Date 6-18-69
County CALVERT

UNASSIGNED

NOW PVT 88-EX

E

CHESAPEAKE BAY

~~#~~

~~SC~~ ~~ROAD~~ ~~016~~ ~~END~~ ~~#~~

~~014~~ ~~SC~~

~~Folder Rd.~~

~~017~~ ~~of~~ ~~99~~

~~3 S.C.~~

~~PT~~

~~009~~

Elm Rd

SC 200' 008 PVT

~~40°~~

SC 300' 007

~~PC~~ 006

SC. 003 10' E

Evergreen 14' CW

Rd

~~of~~ PVT 000 ~~100~~ PVT

SHA 51.3 - 8 Revised
4.83

MARYLAND STATE HIGHWAY ADMINISTRATION

ROAD INVENTORY SHEET

Was Part of OP 101

Party Chief BB
Recorder AL
Assistant
Map No./Dir. J-13 / S
State Coordinates 938-252

Road No. PVT
Road Name Elm Rd.
County Calvert
Date 4-12-89
Sheet No. 1 OF 1

SYSTEM: FED. AID. | FUNCT. CLASS. | HWY. SYS. | HPMS SAMPLE
TRAFFIC: PRK.G. REST. | COM/IND. ACCESS

LINE DIAGRAM

TRAFFIC: CONTROL | COM/IND. ACCESS | PRK.G. REST.

PAVEMENT DATA

Road
0 08 End

10' F
14' CW

Elder Rd
0 03 ~~OP 99~~ PVT

Easterbell Rd.
0 00 ~~OP 101~~ PVT

TRAFFIC CODES
TRAFFIC CONTROLS: STOP SIGN=SS, TRAFFIC LIGHT=T.L., FLASHING RED BALL=F.R.

TRAFFIC CODES
PARKING RESTRICTIONS: A.M. PEAK, P.M. PEAK, A.M./P.M. PEAK, NO PARKING ANYTIME=N.P., COMM/IND. ACCESS=E

SYSTEM				TRAFFIC		LINE DIAGRAM	TRAFFIC				PAVEMENT DATA
FED. AID.	FUNCT. CLASS.	HWY. SYS.	HPMS SAMPLE	PRK'G. REST.	COM/IND ACCESS		CONTROL	COM/IND ACCESS	PRK'G. REST.		

Form 6 HPS (Rev. 1961)

ROAD INVENTORY SHEET

Party Chief T. LANDON
Recorder W. WARFIELD
Chainman B. HOOPER

SCIENTIST CLIFFS

I-13

938-251

Road No. Of 102
Name Dahlia Rd
Sheet No. 1 OF 1
Date 6-18-69
County CALVERT

BAY

~~ROAD~~ ~~0 27~~ ~~END~~

~~0 25~~ ~~SC~~ ~~70°~~

~~0 24~~ ~~SC~~

Dock Rd

0 23 ~~SP~~ ~~104~~ PVT

CHESAPEAKE

5 S.C.

0 21 S.C.

T=

PT

0 20

75°

SC

0 19

PC

0 18 S.C.

Date Rd

S.C.

0 15 ~~SP~~ ~~104~~ PVT

0 14 S.C.

PVT Dogwood Rd ~~SP~~ ~~103~~

0 11 Daffodil Rd.

SCIENTIST CO.

0 10 PVT

10°

0 03 S.C.

10'@ 14'CW

0 00

69

CLIFFS RD

SHA 51.3 - 8 Revised
4.83

MARYLAND STATE HIGHWAY ADMINISTRATION

ROAD INVENTORY SHEET

Party Chief BB
Recorder AL
Assistant
Map No./Dir. I-13 / S
State Coordinates 939-251

Road No. PVT
Road Name Daffodil Rd
County Calvert
Date 4-12-89
Sheet No. 1 OF 1

SYSTEM				TRAFFIC		LINE DIAGRAM	TRAFFIC			PAVEMENT DATA
FED. AID.	FUNCT CLASS.	HWY. SYS.	HPMS SAMPLE	PRK.G. REST.	COM/IND. ACCESS		CONTROL	COM/IND ACCESS	PRK.G. REST.	
						Road 0.05 End				8' F
						Dahlia Rd OP 0.00 to2 PVT				

TRAFFIC CODES
TRAFFIC CONTROLS: STOP SIGN=SS, TRAFFIC LIGHT=T.L., FLASHING RED BALL=F.R.

TRAFFIC CODES
PARKING RESTRICTIONS: A.M. PEAK, P.M. PEAK, A.M./P.M. PEAK, NO PARKING ANYTIME=N.P., COMM/IND. ACCESS=E

SYSTEM				TRAFFIC		LINE DIAGRAM	TRAFFIC			PAVEMENT DATA
FED. AID.	FUNCT. CLASS.	HWY. SYS.	HPMS SAMPLE	PRK.G. REST.	COM/IND ACCESS		CONTROL	COM/IND ACCESS	PRK.G. REST.	

Form 6 HPS (Rev. 1961)

ROAD INVENTORY SHEET

PVT

Party Chief T.LANDON
Recorder W.WARFIELD
Chainman B.HOOPER

SCIENTIST CLIFFS

1-13

939-251

Road No. ~~OF~~ 103
Name Dogwood Rd
Sheet No. 1 OF 1
Date 6-18-69
County CALVERT

UNASSIGNED

NOW PVT 88-EX

N

CHESAPEAKE BAY

	SC	ROAD 009	END	
	SC	008		
		007	SC	
PT	SC	006		
90°	SC	005	SC	
PC		002		8'F 12'CW
	Dahlia		Rd	
	~~OF~~ PVT	000	~~102~~ PVT 88-EX	

Form 6 HPS (Rev. 1961)

ROAD INVENTORY SHEET

PVT

Party Chief T. LANDON
Recorder W. WARFIELD
Chainman B. HOOPER

SCIENTIST CLIFFS

Z-13

939-251

Road No. ~~OF 104~~
Name Dock Rd
Sheet No. 1 OF 1
Date 6-18-69
County CALVERT

W

~~OF~~ ~~008~~ ~~702~~

~~SC~~ ~~006~~ ~~SC~~

~~SC~~ ~~005~~

Dock Rd

~~190°~~ S.C. 50' S.C. 004 PVT

003 SC 8'F 12'CW

Rd

Dahlia 000 ~~182~~

~~OF~~ PVT

SHA 51.3 - 8 Revised
4.83

MARYLAND STATE HIGHWAY ADMINISTRATION

ROAD INVENTORY SHEET

Was part of OP 104

Party Chief BB
Recorder AL
Assistant
Map No./Dir. I-13 / W
State Coordinates 939-251

Road No. PVT
Road Name Date Rd
County Calvert
Date 4-12-89
Sheet No. 1 OF 1

SYSTEM				TRAFFIC		LINE DIAGRAM	TRAFFIC			PAVEMENT DATA
FED. AID.	FUNCT CLASS.	HWY. SYS.	HPMS SAMPLE	PRK.G. REST.	COM/IND. ACCESS		CONTROL	COM/IND. ACCESS	PRK.G. REST.	
						Dahlia Rd.				
						OP 0 04 102				8' F
										12' CW
						Dock Rd				
						000 OP 104				

TRAFFIC CODES

TRAFFIC CONTROLS: STOP SIGN=SS, TRAFFIC LIGHT=T.L., FLASHING RED BALL=F.R.

TRAFFIC CODES

PARKING RESTRICTIONS: A.M. PEAK, P.M. PEAK, A.M./P.M. PEAK, NO PARKING ANYTIME=N.P., COMM/IND. ACCESS=E

SYSTEM				TRAFFIC		LINE DIAGRAM	TRAFFIC			PAVEMENT DATA
FED. AID.	FUNCT. CLASS.	HWY. SYS.	HPMS SAMPLE	PRKG. REST.	COM/IND ACCESS		CONTROL	COM/IND ACCESS	PRKG. REST.	

Form 6 HPS (Rev. 1961)

ROAD INVENTORY SHEET

PVT

Party Chief T. LANDON
Recorder W. WARFIELD
Chainman B. HOOPER

SCIENTIST CLIFFS

I-13

938-250

Road No. ~~OP~~ ~~105~~
Name Cedar Rd
Sheet No. 1 OF 2
Date 6-19-69
County CALVERT

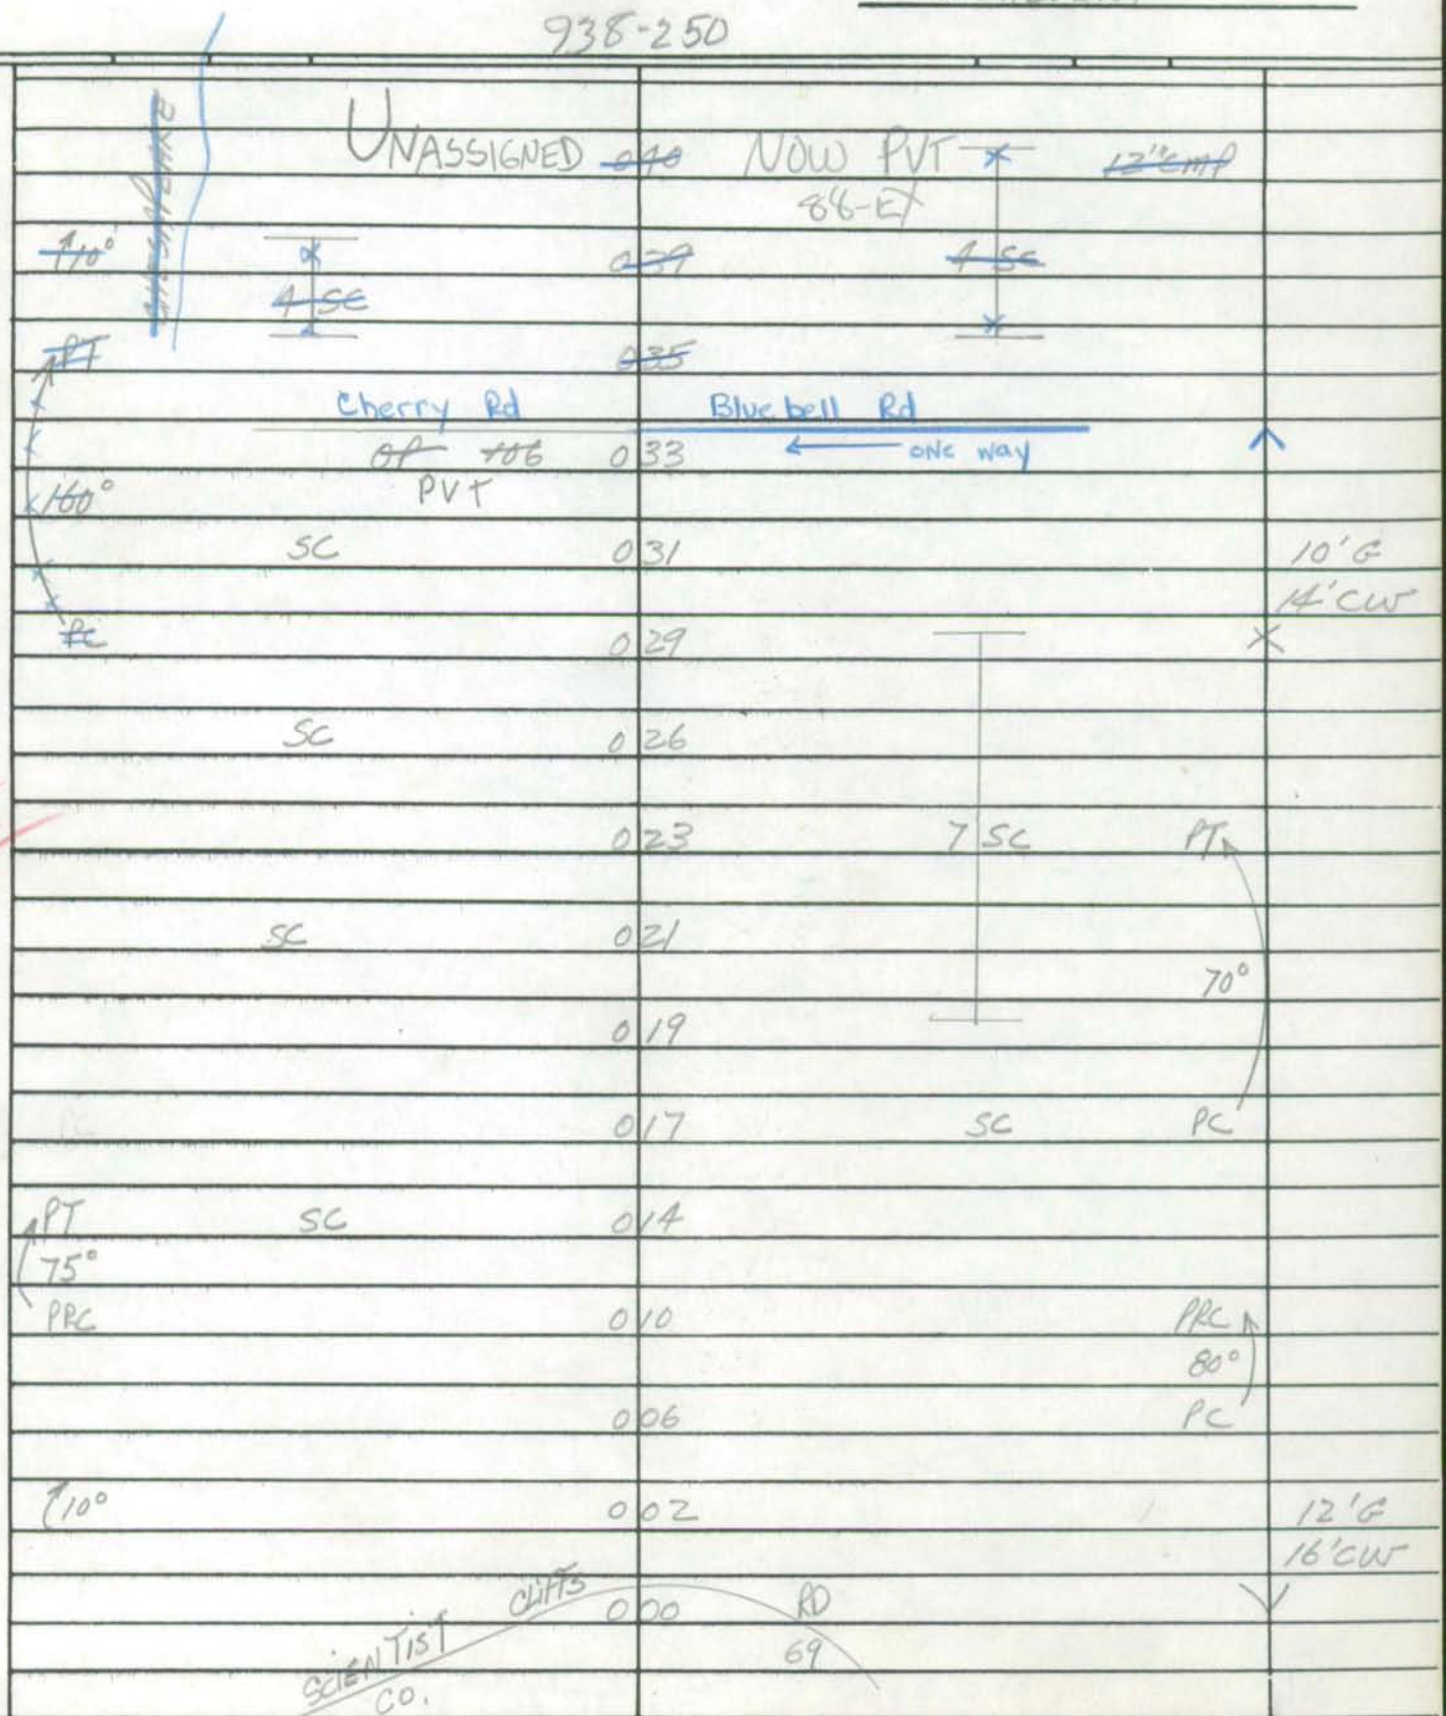

Form 6 HPS (Rev. 1961)

PVT

ROAD INVENTORY SHEET

Party Chief T. LANDON
Recorder W. WARFIELD
Chainman B. HOOPER

Road No. ~~OP 105~~
Name Cedar Rd
Sheet No. 2 OF 2
Date 6-19-69
County CALVERT

UNASSIGNED

NOW PVT

88 - EX

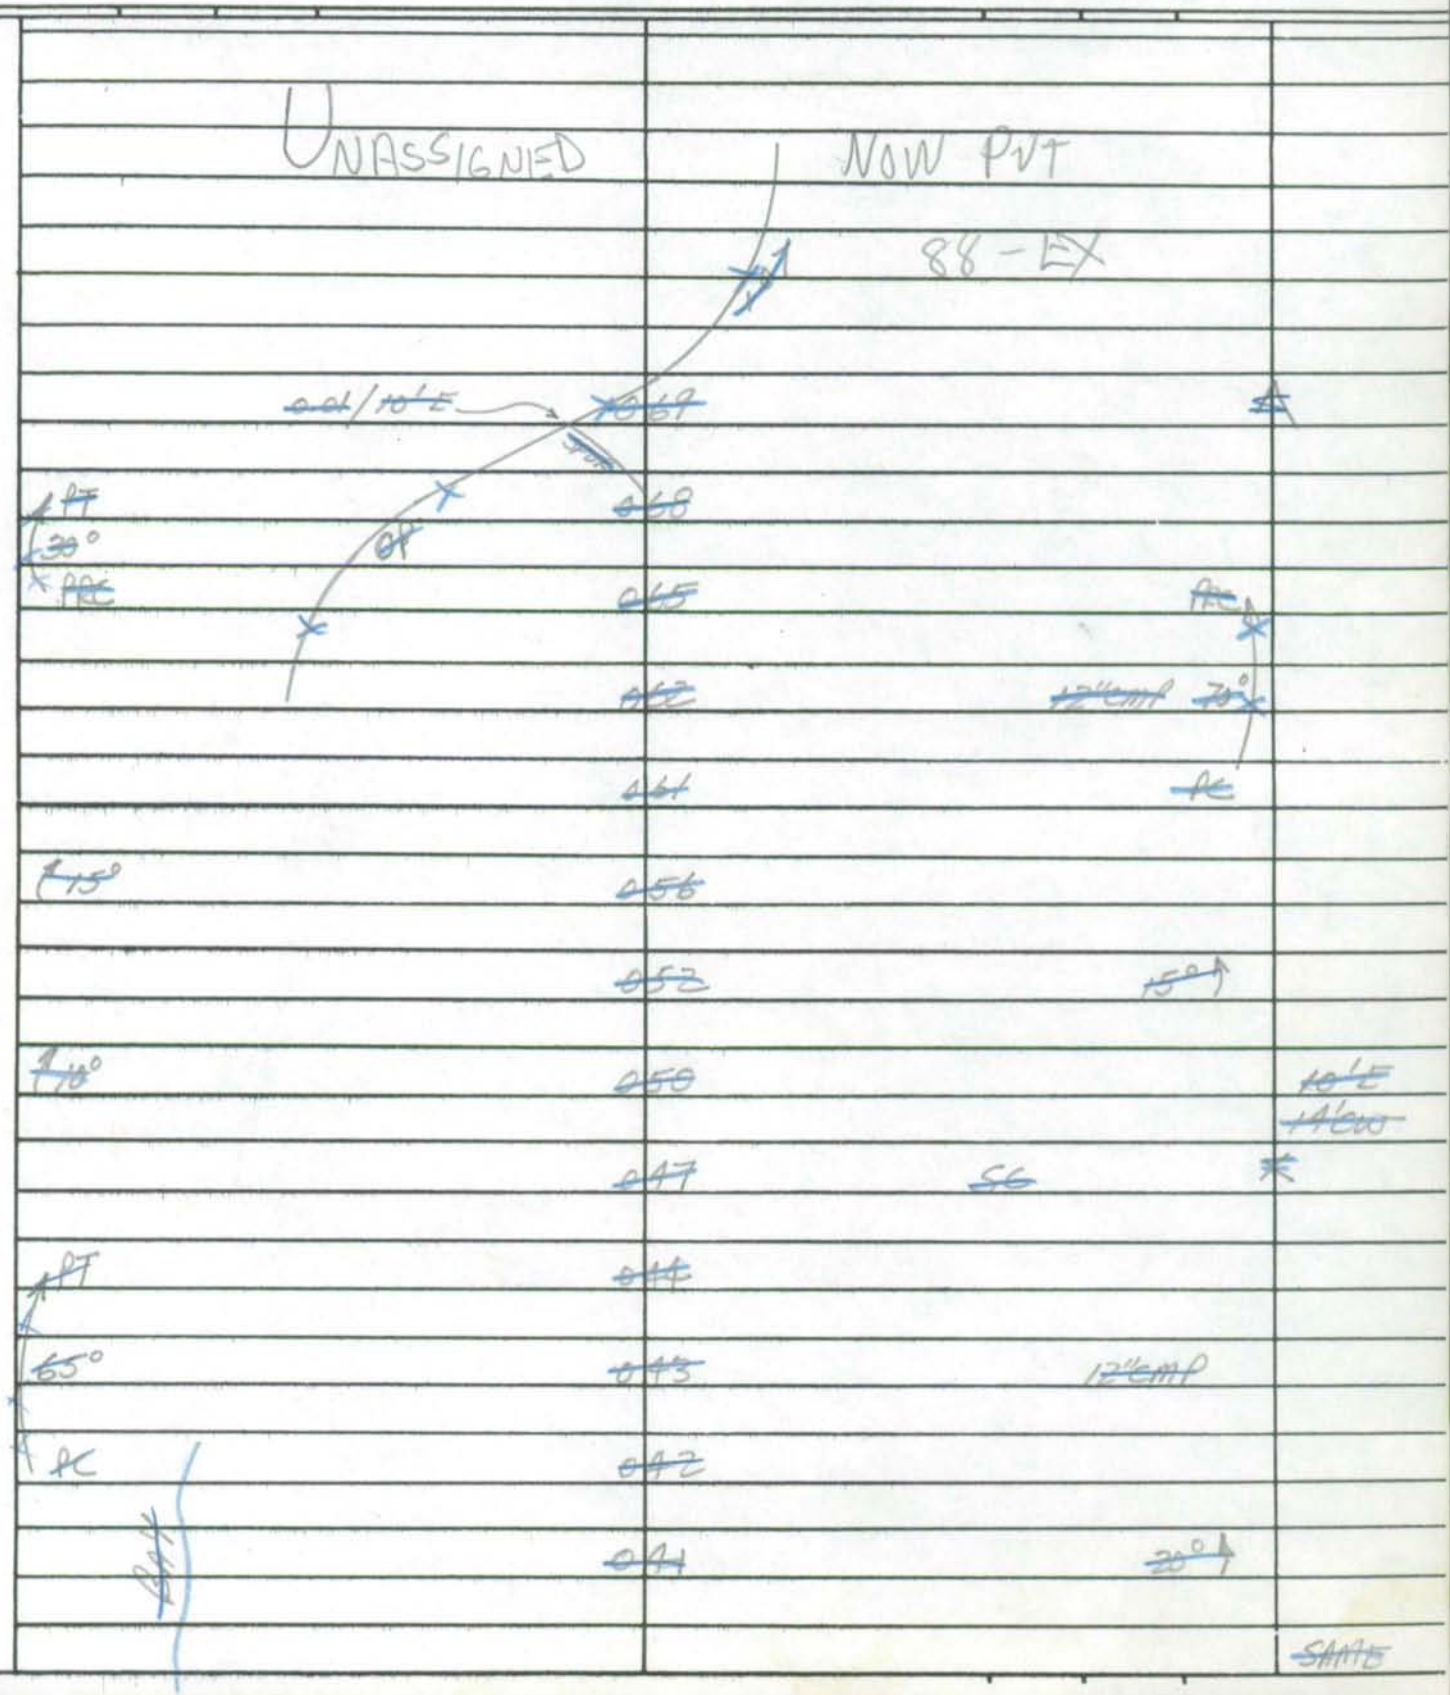

SHA 51.3 - 8 Revised
4.83

MARYLAND STATE HIGHWAY ADMINISTRATION

ROAD INVENTORY SHEET

Was part of op 105

Party Chief BB
Recorder AL
Assistant
Map No./Dir. I-13 / N
State Coordinates 938-250

Road No. PVT
Road Name Bluebell Rd
County Calvert
Date 4-12-89
Sheet No. 1 OF 1

TRAFFIC CODES
TRAFFIC CONTROLS: STOP SIGN=SS, TRAFFIC LIGHT=T.L., FLASHING RED BALL=F.R.

TRAFFIC CODES
PARKING RESTRICTIONS: A.M. PEAK, P.M. PEAK, A.M./P.M. PEAK, NO PARKING ANYTIME=N.P., COMM/IND. ACCESS=E

SYSTEM				TRAFFIC		LINE DIAGRAM	TRAFFIC			PAVEMENT DATA
FED. AID.	FUNCT. CLASS.	HWY. SYS.	HPMS SAMPLE	PRKG. REST.	COM/IND. ACCESS		CONTROL	COM/IND. ACCESS	PRKG. REST.	
						Cherry Rd off the PVT				
						Cedar Rd ~~OP 105~~ PVT 0 35				
						0 34 35°				
						0 26 45°				
						TWO WAY PT 0 09 300				
						PC 0 06				
						ONE 0 01 spur				10' F
						Birch Rd. ~~OP~~ PVT 0 00 ~~10~~ T				

SYSTEM				TRAFFIC		LINE DIAGRAM	TRAFFIC			PAVEMENT DATA
FED. AID.	FUNCT. CLASS.	HWY. SYS.	HPMS SAMPLE	PRKG. REST.	COM/IND ACCESS		CONTROL	COM/IND ACCESS	PRKG. REST.	

Form 6 HPS (Rev. 1961)

ROAD INVENTORY SHEET

Party Chief T. LANDON
Recorder W. WARFIELD
Chainman B. HOOPER

SCIENTIST CLIFFS
7-13
939-251

PVT
Road No. ~~OP~~ ~~106~~
Name Cherry Rd
Sheet No. 1 OF 1
Date 6-19-69
County CALVERT

UNASSIGNED
NOW PVT 88-EX

BAY
CHESAPEAKE

SC
ROAD 003 END

SC 002 SC

001 SC 12'E 16'CW

000

OP PVT 105

Form 6 HPS (Rev. 1961)

PVT

ROAD INVENTORY SHEET

Party Chief T. LANDON — SCIENTIST CLIFFS
Recorder W. WARFIELD
Chainman B. HOOPER

I-13

938-249

Road No. ~~of~~ ~~107~~
Name Birch Rd
Sheet No. 1 OF 1
Date 6-19-69
County CALVERT

UNASSIGNED
NOW PVT
68-EX

SC

ROAD 0 35 END SC

CHESAPEAKE BAY

0 33

0 31 SC PT 60° PC

0 29 SC

0 28 SC

0 26 SC

PT 40° PC

0 24

Balsam Rd PVT 109

0 22 SC PT 25° PC 10'G 14'CW

Bay Rd PVT 108

0 21

0.01/10'E

Bluebell Rd PVT 105

0 13 15°

PT 20° PC

0 09

0 08

SCIENTIST CO.

0 06 12'G 16'CW

0 00

CLIFFS 69

Form 6 HPS (Rev. 1961)

ROAD INVENTORY SHEET

PVT

Party Chief T. LANDON
Recorder W. WARFIELD
Chainman R. HOOPER

SCIENTIST CLIFFS

2-13

939-249

Road No. ~~of 108~~
Name Bay Rd
Sheet No. 1 OF 1
Date 6-19-69
County CALVERT

UNASSIGNED

NOW PVT 88-EX

CHESAPEAKE BAY

	SC ROAD	0 14	END	
20°	SC	0 11		
		0 07	15°	
	~~of~~ Birch PVT	0 06	12" CMP	8' G 12' CW
		0 00		
			~~Birch~~ Rd	

Form 6 HPS (Rev. 1961)

ROAD INVENTORY SHEET

Party Chief T. LANDON
Recorder W. WARFIELD
Chainman B. HOOPER

SCIENTIST CLIFFS
I-13
939-249

PVT
Road No. ~~of 109~~
Name Balsam Rd
Sheet No. 1 OF 1
Date 6-19-69
County CALVERT

UNASSIGNED

NOW PVT 86-EX

BAY

CHESAPEAKE

ROAD 011 END

6 SC

006 100°

SC ~~SP~~ Birch 005

SC PVT 003 SC 10'G 14'CW

000

Rd.

Form 6 HPS (Rev. 1961)

ROAD INVENTORY SHEET

PVT

Party Chief T. LANDON
Recorder W. WARFIELD
Chainman B. HOOPER

SCIENTIST CLIFFS

7-13
938-248

Road No. ~~of~~ 110
Name Apple Rd
Sheet No. 1 OF 1
Date 6-19-69
County CALVERT

UNASSIGNED

NOW PVT 88-EX

S

Aspen Rd
~~of~~ PVT 0.16
~~plus~~ -0.04/10'F ~~H~~
H 0.14
B- MAINT. SHOP 0.13
RD 109 CLIFFS
PROPOSED RD 0.09
0.00
14'F
20'CW

Form 6 HPS (Rev. 1961)

ROAD INVENTORY SHEET

Party Chief T. LANDON
Recorder W. WARFIELD
Chainman B. HOOKER

SCIENTIST CLIFFS
I-13
938-248

Road No. OP 111
Name Aspen Rd
Sheet No. 1 OF 2
Date 6-19-69
County CALVERT

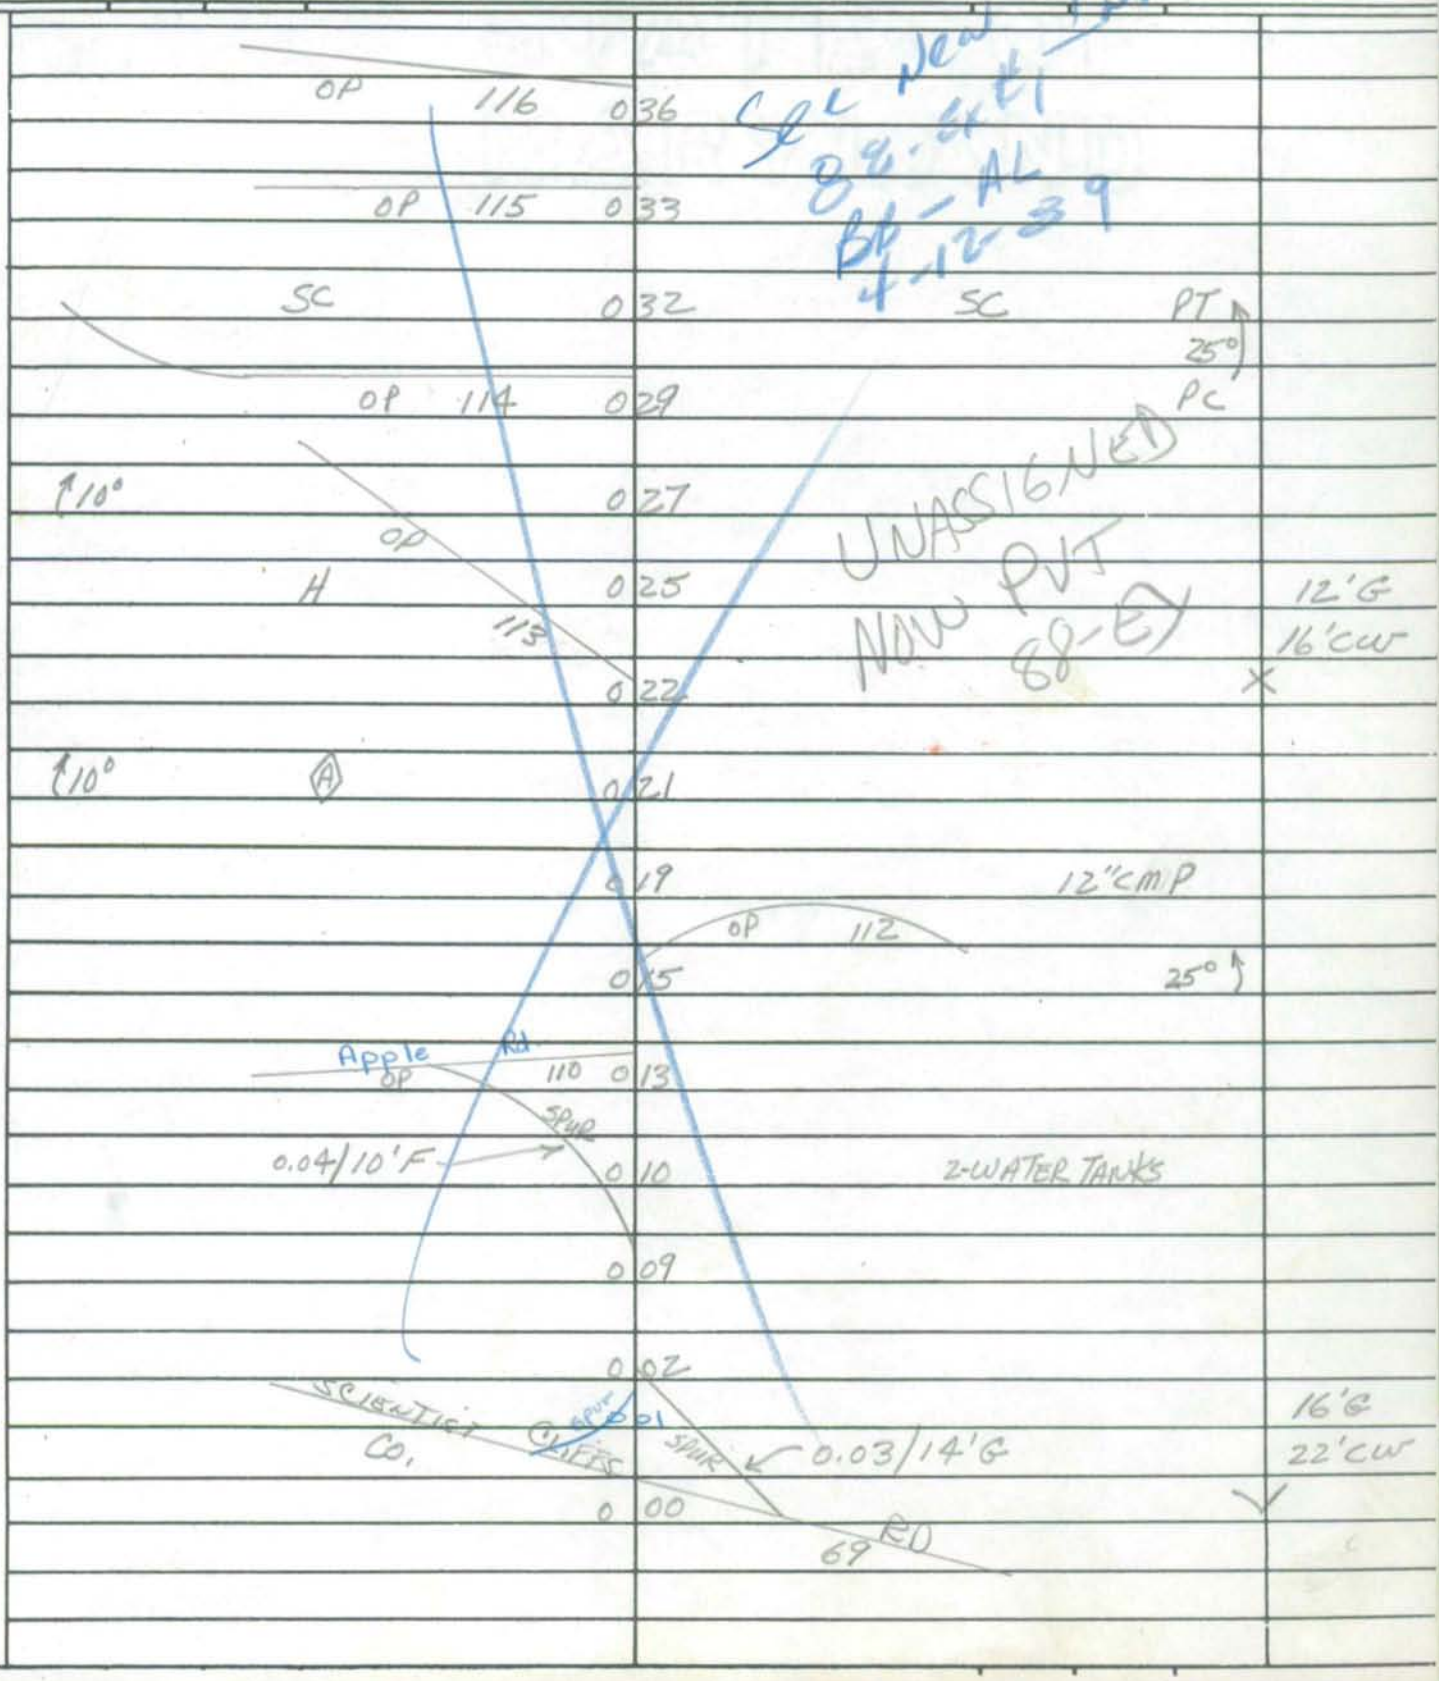

Form 6 HPS (Rev. 1961)

ROAD INVENTORY SHEET

Party Chief T. LANDON
Recorder W. WARFIELD
Chainman B. Hooper

Road No. OP 111
Name
Sheet No. 2 OF 2
Date 6-19-69
County CALVERT

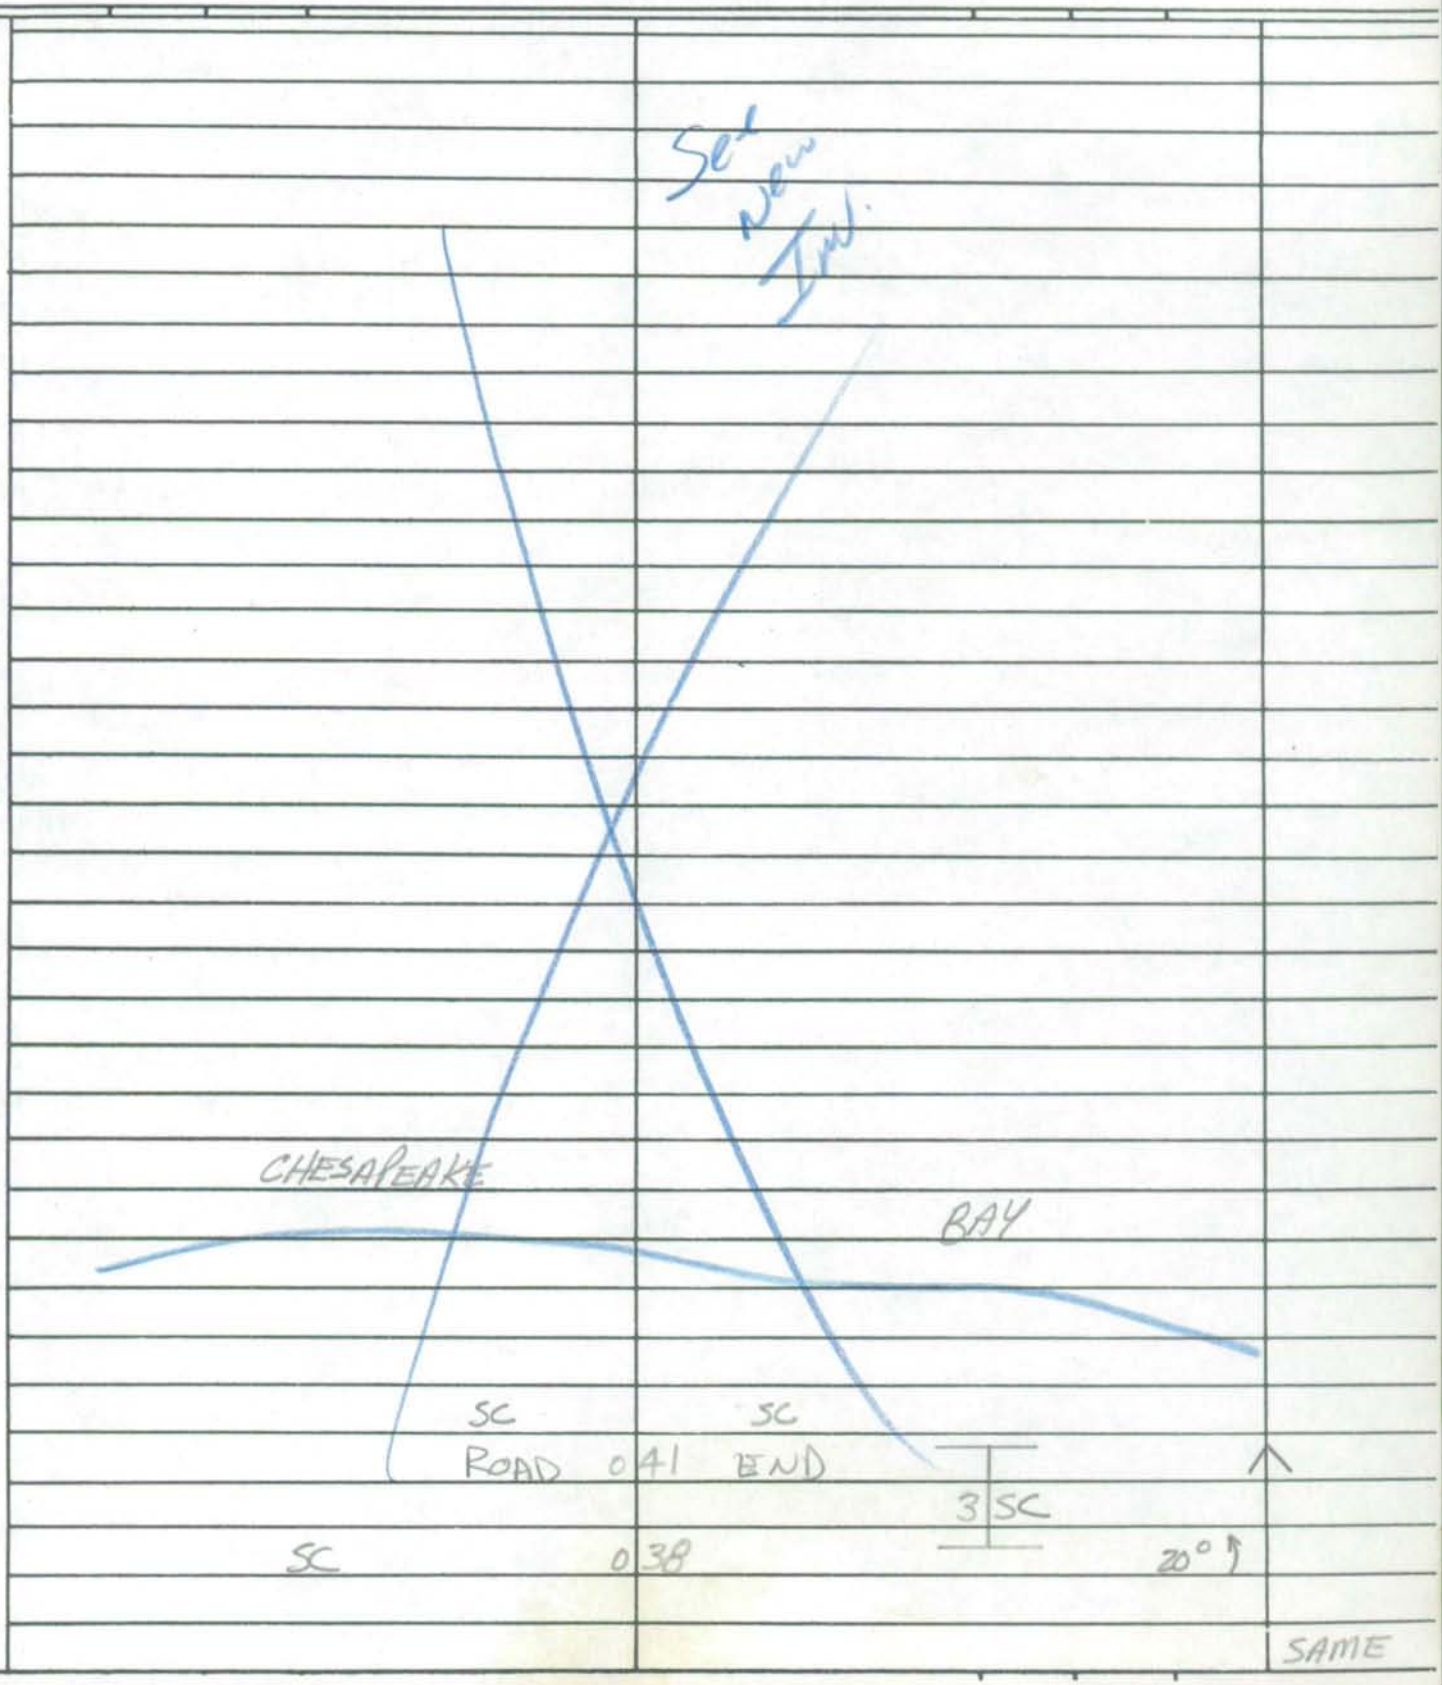

SHA 51.3 - 8 Revised
4.83

MARYLAND STATE HIGHWAY ADMINISTRATION

ROAD INVENTORY SHEET

PVT

Party Chief BB
Recorder AL
Assistant
Map No./Dir. I-13 / E
State Coordinates 938-248

Road No. ~~OP~~ MT
Road Name Aspen Rd
County Calvert
Date 4-12-89
Sheet No. 1 OF 3

TRAFFIC CODES
TRAFFIC CONTROLS: STOP SIGN=SS, TRAFFIC LIGHT=T.L., FLASHING RED BALL=F.R.

TRAFFIC CODES
PARKING RESTRICTIONS: A.M. PEAK, P.M. PEAK, A.M./P.M. PEAK, NO PARKING ANYTIME=N.P., COMM/IND. ACCESS=E

SYSTEM				TRAFFIC		LINE DIAGRAM	TRAFFIC			PAVEMENT DATA
FED. AID.	FUNCT. CLASS.	HWY. SYS.	HPMS SAMPLE	PRK.G. REST.	COM/IND. ACCESS		CONTROL	COM/IND. ACCESS	PRK.G. REST.	
						PC 0 40 0 33 PT 55° 0 21 PC Alder ~~OP~~ PVT Rd. 60° 0 15 Apple Rd. ~~OP~~ PVT ~~110~~ 0 13 SPUR 0.04/10' F 0 10 2-Water Tanks 0 09 0 02 SPUR 0.03/14' G Scientists SPUR CO 0 00 Cliffs Rd 69				16' G 22' CW

SYSTEM: FED. AID. | FUNCT. CLASS. | HWY. SYS. | HPMS SAMPLE

TRAFFIC: PRKG. REST. | COM/IND ACCESS

LINE DIAGRAM

TRAFFIC: CONTROL | COM/IND ACCESS | PRKG. REST.

PAVEMENT DATA

Allspice Rd.
PVT
0 82

0 74
PT
35°
PRC

PRC 0 71

South Beach Rd
45° ~~OP 114~~ one way 0 70
PVT

PC 0 67

Aster Rd
~~OP~~ 120
PVT
0 62

Ash Rd.
~~OP 121~~
PVT
0 45

PT 0 43

Abelia Rd
~~OP 122~~
75° PVT
0 41

8' C

14' F
20' cw

16' G
22' cw

SHA 51.3 - 8 Revised
4.83

MARYLAND STATE HIGHWAY ADMINISTRATION

ROAD INVENTORY SHEET

Party Chief BB
Recorder AL
Assistant
Map No./Dir. I-13 / E
State Coordinates 938-248

Road No. OP-11 PVT
Road Name Aspen Rd
County Calvert
Date 4-12-89
Sheet No. 3 OF 3

SYSTEM: FED. AID. | FUNCT. CLASS. | HWY. SYS. | HPMS SAMPLE
TRAFFIC: PRK.G. REST. | COM/IND. ACCESS

LINE DIAGRAM

Allspice Rd.
PVT

1+10
1+08
1+06
1+01

PT
90°
PC

TRAFFIC: CONTROL | COM/IND. ACCESS | PRK.G. REST.

PAVEMENT DATA

12' F

8' C

TRAFFIC CODES

TRAFFIC CONTROLS: STOP SIGN=SS, TRAFFIC LIGHT=T.L., FLASHING RED BALL=F.R.

TRAFFIC CODES

PARKING RESTRICTIONS: A.M. PEAK, P.M. PEAK, A.M./P.M. PEAK, NO PARKING ANYTIME=N.P., COMM/IND. ACCESS=E

SYSTEM				TRAFFIC		LINE DIAGRAM	TRAFFIC			PAVEMENT DATA
FED. AID.	FUNCT. CLASS.	HWY. SYS.	HPMS SAMPLE	PRKG. REST.	COM/IND ACCESS		CONTROL	COM/IND ACCESS	PRKG. REST.	

Form 6 HPS (Rev. 1961)

PVT

ROAD INVENTORY SHEET

Party Chief T. LANDON
Recorder W. WARFIELD
Chainman B. HOOPER

SCIENTIST CLIFFS
2-13
938.5-247.5

Road No. ~~OP 112~~
Name
Sheet No. 1 OF 3
Date 6-19-69
County CALVERT

	047	
120 OP	043	UNASSIGNED NOW PVT 84.63 New Inv
	041	15° →
SC	037	See 88-EXH 1 BB/AL 4-11-69
SC	033	
SC	032	
OP 121	031	
PT SC	027	
75° OP 122	025	
PC	024	
	022	SC
SC	020	
	017	PT
SC-300'	011	55°
	005	PC 16'G 22'CW
OP	000	
		111

Form 6 HPS (Rev. 1961)

ROAD INVENTORY SHEET

Party Chief T. LANDON
Recorder W. WARFIELD
Chainman B. HOOPER

Road No. OP 112
Name
Sheet No. 2 OF 3
Date 6-19-69
County CALVERT

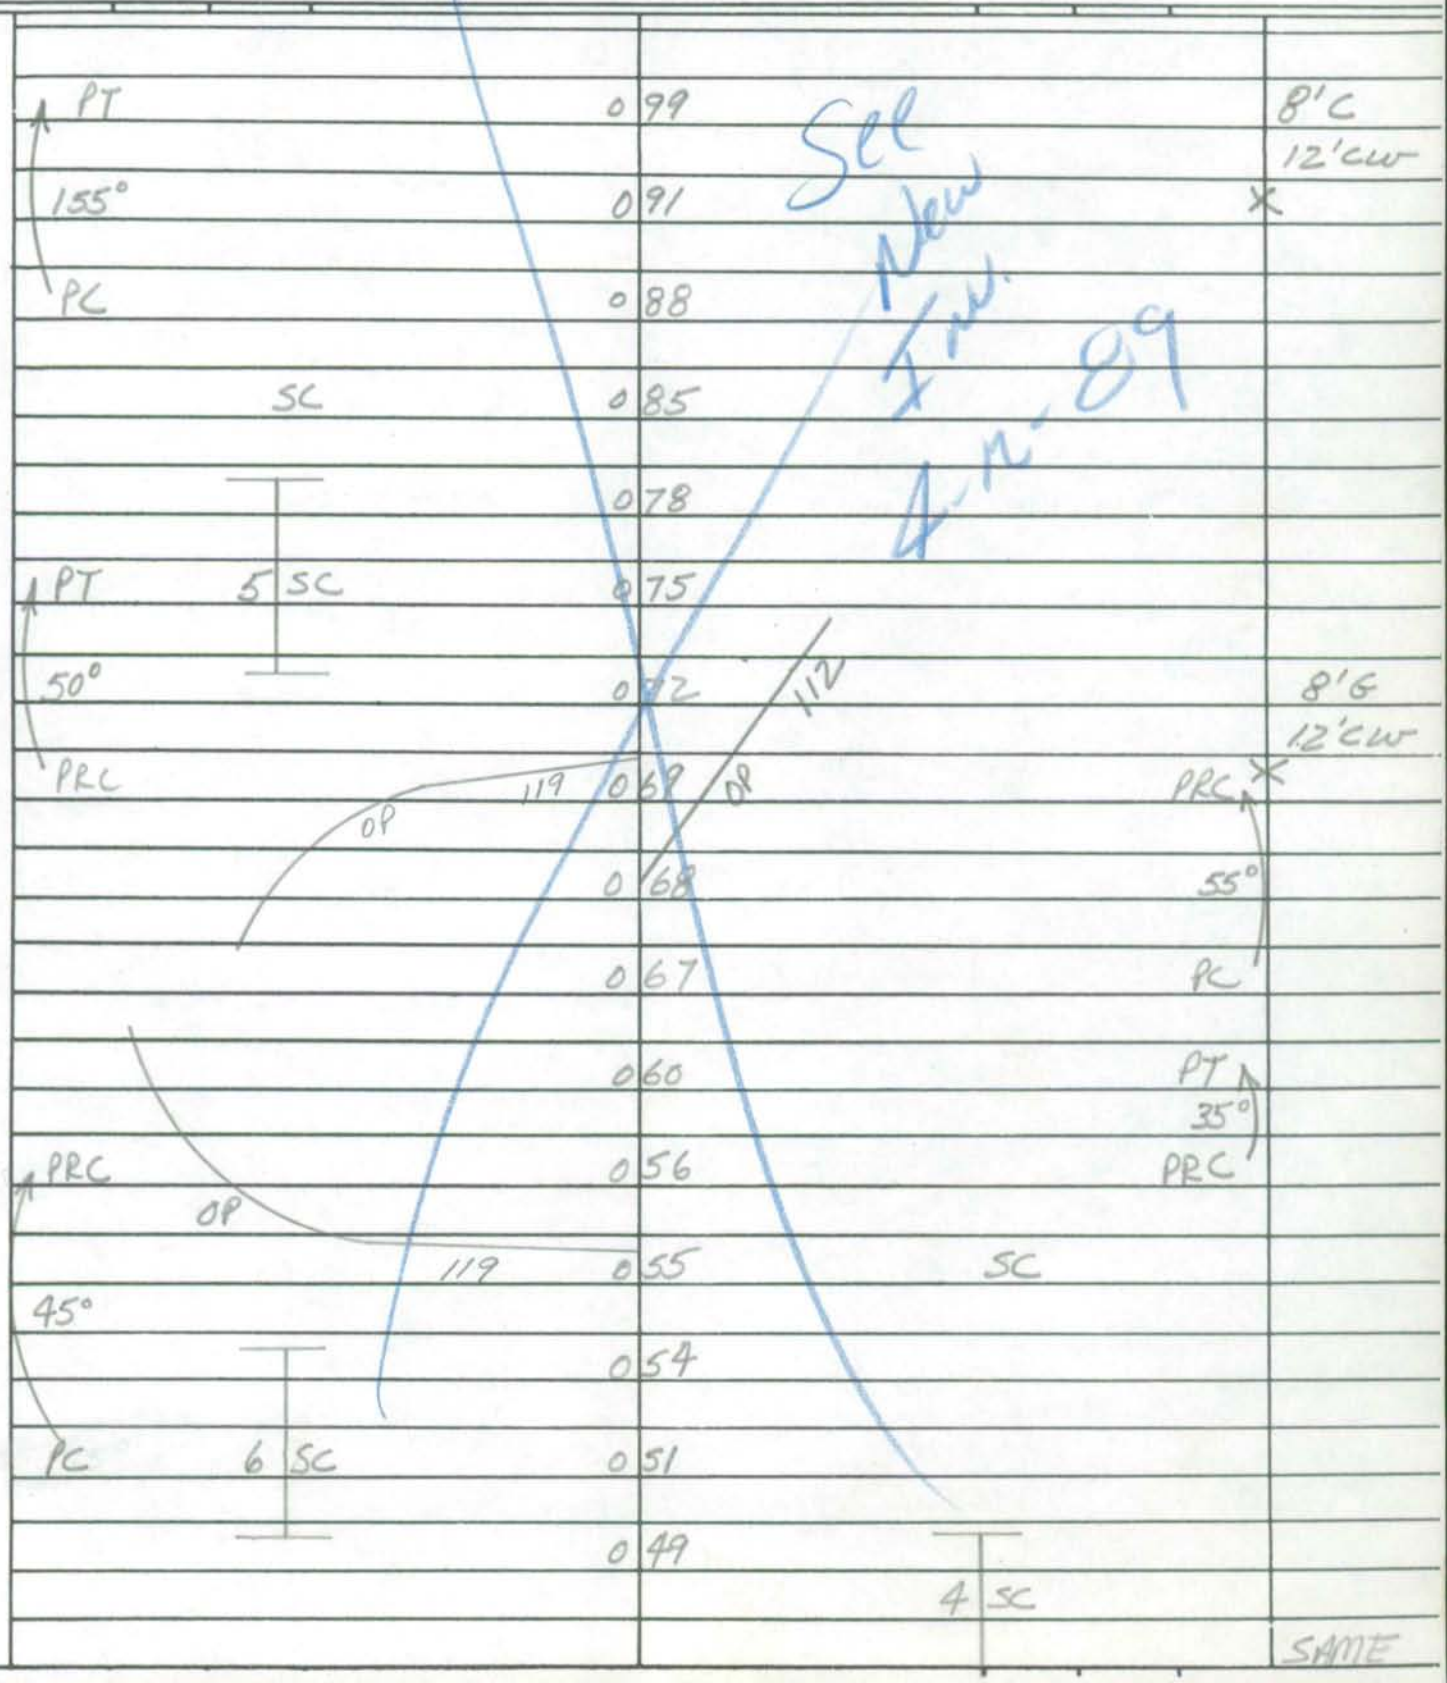

Form 6 HPS (Rev. 1961)

ROAD INVENTORY SHEET

PVT

Party Chief T. LANDON
Recorder W. WARFIELD
Chainman B. HOOPER

Road No. ~~OR~~ 112
Name
Sheet No. 3 OF 3
Date 6-9-69
County CALVERT

UNASSIGNED
NOW PVT

88-EY

Set new Inv. 4-12-69

~~OR~~ PVT 118

112

112

10°

SAME

SHA 51.3 - 8 Revised
4.83

MARYLAND STATE HIGHWAY ADMINISTRATION

ROAD INVENTORY SHEET

Party Chief BB
Recorder AL
Assistant
Map No./Dir. I-13 / E
State Coordinates 938-248

Road No. ~~OP 112~~ PVT
Road Name Alder Rd
County Calvert
Date 4-12-89
Sheet No. 1 OF 1

SYSTEM: FED. AID. | FUNCT. CLASS. | HWY. SYS. | HPMS SAMPLE
TRAFFIC: PRKG. REST. | COM/IND. ACCESS

LINE DIAGRAM

Road 0 25 End

Angelica Rd
~~OP 116~~ PVT 0 20

Althea Rd
~~OP 115~~ PVT 0 17

Azalea Rd
~~OP 114~~ PVT 0 13

Acacia Rd
~~OP 113~~ PVT 0 06

Rd 114 PVT

0 00

Aspen Rd PVT

TRAFFIC: CONTROL | COM/IND. ACCESS | PRKG. REST.

PAVEMENT DATA

10' F

12' G

16' G

TRAFFIC CODES

TRAFFIC CONTROLS: STOP SIGN=SS, TRAFFIC LIGHT=T.L., FLASHING RED BALL=F.R.

TRAFFIC CODES

PARKING RESTRICTIONS: A.M. PEAK, P.M. PEAK, A.M./P.M. PEAK, NO PARKING ANYTIME=N.P., COMM/IND. ACCESS=E

SYSTEM				TRAFFIC		LINE DIAGRAM	TRAFFIC			PAVEMENT DATA
FED. AID.	FUNCT. CLASS.	HWY. SYS.	HPMS SAMPLE	PRK.G. REST.	COM/IND ACCESS		CONTROL	COM/IND ACCESS	PRK.G. REST.	

SHA 51.3 - 8 Revised
4.83

MARYLAND STATE HIGHWAY ADMINISTRATION

ROAD INVENTORY SHEET

was part of OP 112 which is now OP 111

Party Chief BB
Recorder AL
Assistant
Map No./Dir. I-13 / N
State Coordinates 938 - 248

Road No. PVT
Road Name Allspice Rd
County Calvert
Date 4-12-89
Sheet No. 1 OF 1

SYSTEM: FED. AID. | FUNCT. CLASS. | HWY. SYS. | HPMS SAMPLE
TRAFFIC: PRK.G. REST. | COM/IND. ACCESS

LINE DIAGRAM

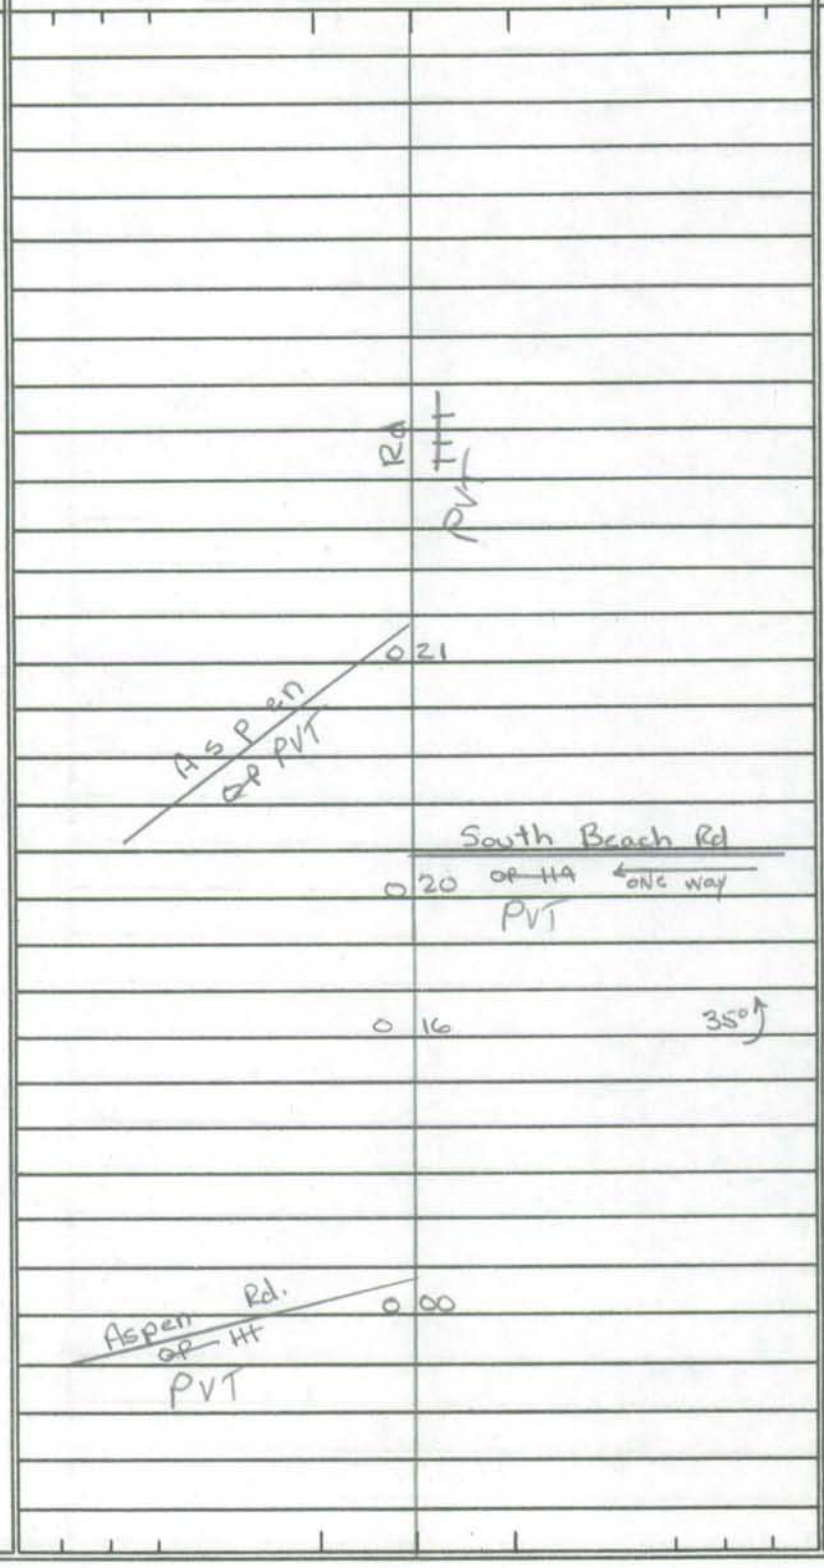

TRAFFIC: CONTROL | COM/IND. ACCESS | PRK.G. REST.

PAVEMENT DATA
10' F
12' CW

TRAFFIC CODES
TRAFFIC CONTROLS: STOP SIGN=SS, TRAFFIC LIGHT=T.L., FLASHING RED BALL=F.R.

TRAFFIC CODES
PARKING RESTRICTIONS: A.M. PEAK, P.M. PEAK, A.M./P.M. PEAK, NO PARKING ANYTIME=N.P., COMM/IND. ACCESS=E

SYSTEM				TRAFFIC		LINE DIAGRAM	TRAFFIC				PAVEMENT DATA
FED. AID.	FUNCT. CLASS.	HWY. SYS.	HPMS SAMPLE	PRK.G. REST.	COM/IND ACCESS		CONTROL	COM/IND ACCESS	PRK.G. REST.		

Form 6 HPS (Rev. 1961)

ROAD INVENTORY SHEET

UNASSIGNED PVT

Party Chief T. LANDON
Recorder W.U. WARFIELD
Chainman B. HOOPER

SCIENTIST CLIFFS

I-13

939-248

Road No. ~~OP~~ 113
Name Acacia Rd
Sheet No. 1 OF 1
Date 6-19-69
County CALVERT

CHESAPEAKE BAY					
	ROAD	0	33	END	
	4 SC	0	32	SC	
PT		0	30	12" CMP	
115° PC	SC	0	28	SC	
15°	SC	0	26		
	SC	0	25	Ambrosia Rd HT SC	
	SC	0	23	~~OP~~ PVT SC	
10°	SC-200'	0	21		
	SC	0	20	Avocado Rd ~~HB~~ SC	
		0	18	~~OP~~ PVT SC	
		0	15	30°	10'G 14'CW
		0	09		
20°		0	06	Rd. ~~HH~~ 12	12'G 16'CW
		0	00	Alder ~~OP~~ PVT	

Form 6 HPS (Rev. 1961)

ROAD INVENTORY SHEET

PVT

Party Chief T. LANDON
Recorder W. WARFIELD — SCIENTIST CLIFFS
Chainman B. HOOPER

I-13
939-249

Road No. ~~OP~~ 114
Name Azalea Rd
Sheet No. 1 OF 1
Date 6-19-69
County CALVERT

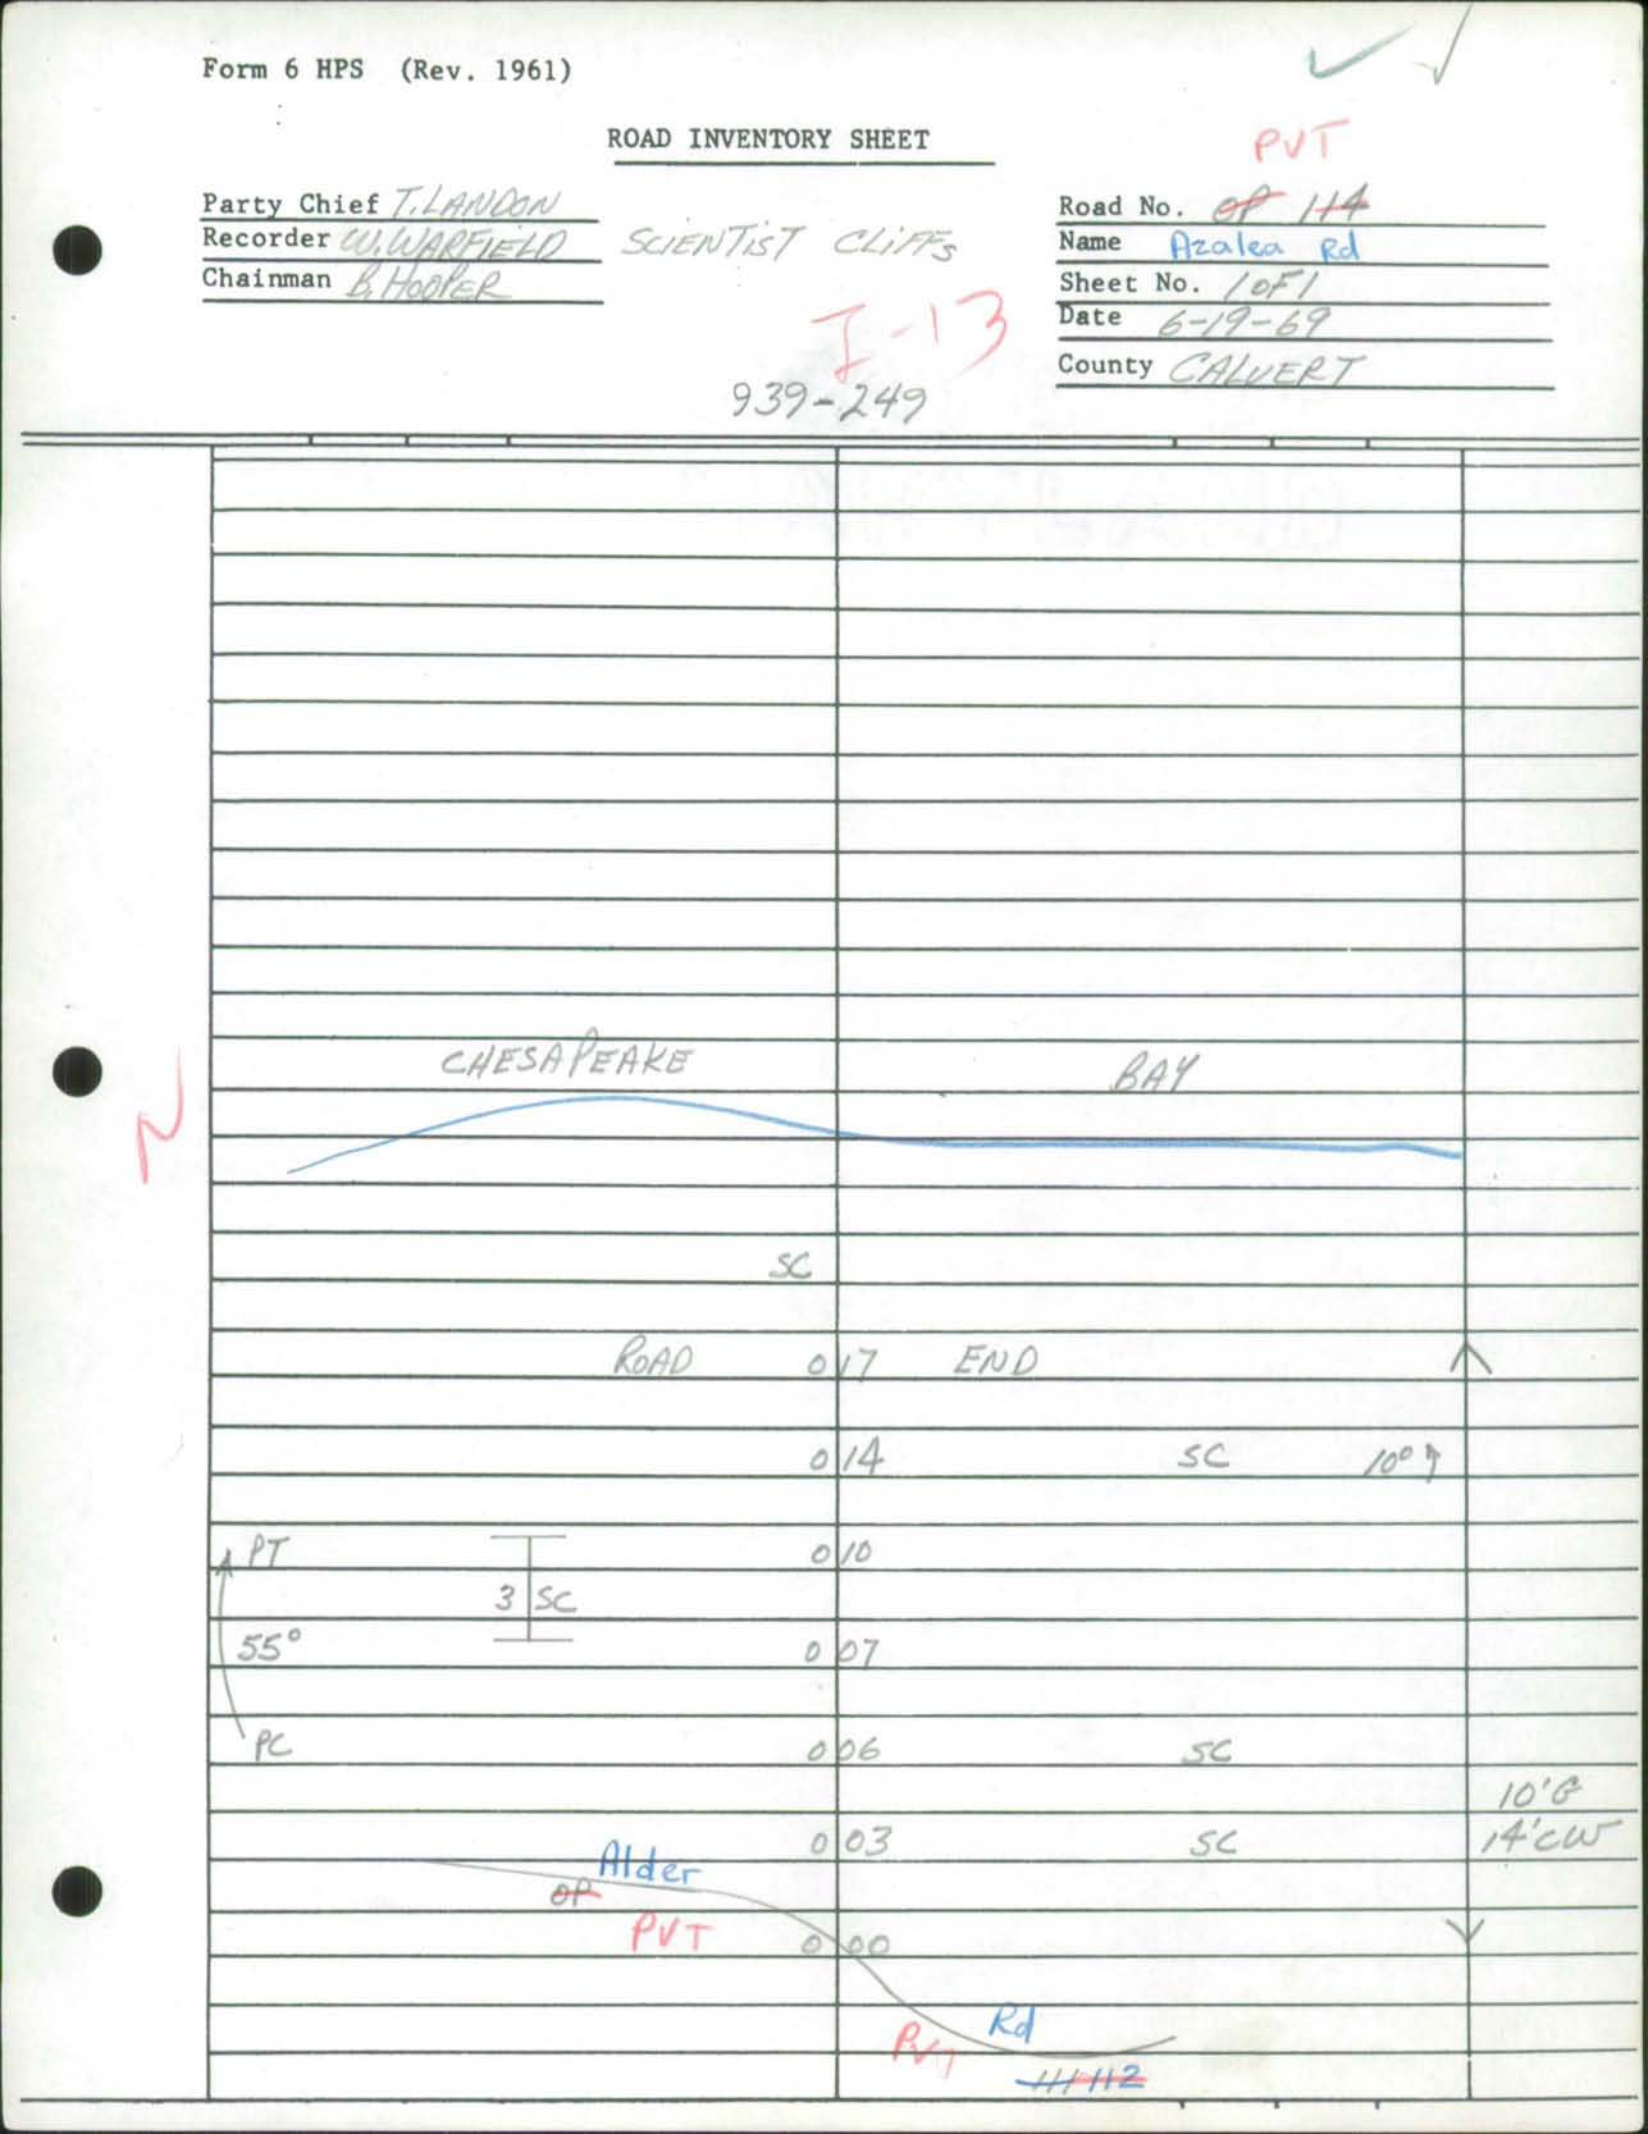

Form 6 HPS (Rev. 1961)

ROAD INVENTORY SHEET

Party Chief T. LANDON
Recorder CU WARFIELD
Chainman R. HOOPER

SCIENTIST CLIFFS
I-13
939.5-248

PVT
Road No. ~~of 113~~
Name Althea Rd
Sheet No. 1 OF 1
Date 6-19-69
County CALVERT

UNASSIGNED
NOW PVT
88-EX

CHESAPEAKE BAY

	SC		SC	
SC	ROAD	012	END	SC
SC		009		
PT		007	3	SC
55°	SC	005		
PC		003	SC	10'G 14'CW
	Alder		Rd	
	~~OP~~	000	~~HH 112~~ PVT	

Form 6 HPS (Rev. 1961)

ROAD INVENTORY SHEET

PVT

Party Chief T. LANDON
Recorder W. WARFIELD
Chainman B. HOOPER

SCIENTIST CLIFFS

I-13

9395-248

Road No. ~~CP~~ 116
Name Angelica Rd
Sheet No. 1 OF 1
Date 6-19-69
County CALVERT

UNASSIGNED
NOW PVT
88-EX

N

ROAD	0	08 END	SC
SC	0	04	SC
SC	0	01	10'G 14'CW
Alder	0	00	

Rd HH HZ

PVT

Form 6 HPS (Rev. 1961)

ROAD INVENTORY SHEET

Party Chief T. LANDON
Recorder W. WARFIELD
Chainman B. HOOPER

SCIENTIST CLIFFS

2-13

939-249

Road No. ~~OP~~ PVT 111
Name Ambrosia Rd
Sheet No. 1 OF 1
Date 6-19-69
County CALVERT

UNASSIGNED NOW PVT 88-EX

SC

PT 30° PC ROAD 006 END SC

Avocado

003 ~~OP~~ PVT Rt

Acacia

~~OP~~ PVT 002 SC 8'F 12'CW

000 Rt

~~PVT~~

Form 6 HPS (Rev. 1961)

ROAD INVENTORY SHEET

Party Chief T. LANDON
Recorder W. WARFIELD
Chainman B. HOOPER

SCIENTIST CLIFFS

I-13

939.5-249

Road No. ~~OP~~ PVT 118
Name Avocado Rd
Sheet No. 10F1
Date 6-19-69
County CALVERT

UNASSIGNED

NOW PVT 88-EX

S

Acacia

~~OP~~ PVT 006 Rd

~~H3~~

PT SC 003 8'F 12'CW

90° 002

PC 001 10'E 14'CW

Ambrosia Rd

~~OP~~ 000 ~~H7~~ PVT

Form 6 HPS (Rev. 1961)

ROAD INVENTORY SHEET

Party Chief T. LANDON
Recorder W. WARFIELD
Chainman B. HOOPER

SCIENTIST CLIFFS

I-13
940.5 - 245.5

PJT
Road No. ~~OP~~ 177
Name South Beach Rd
Sheet No. 1 OF 1
Date 6-19-69
County CALVERT

UNASSIGNED
NOW PVT 88-EX

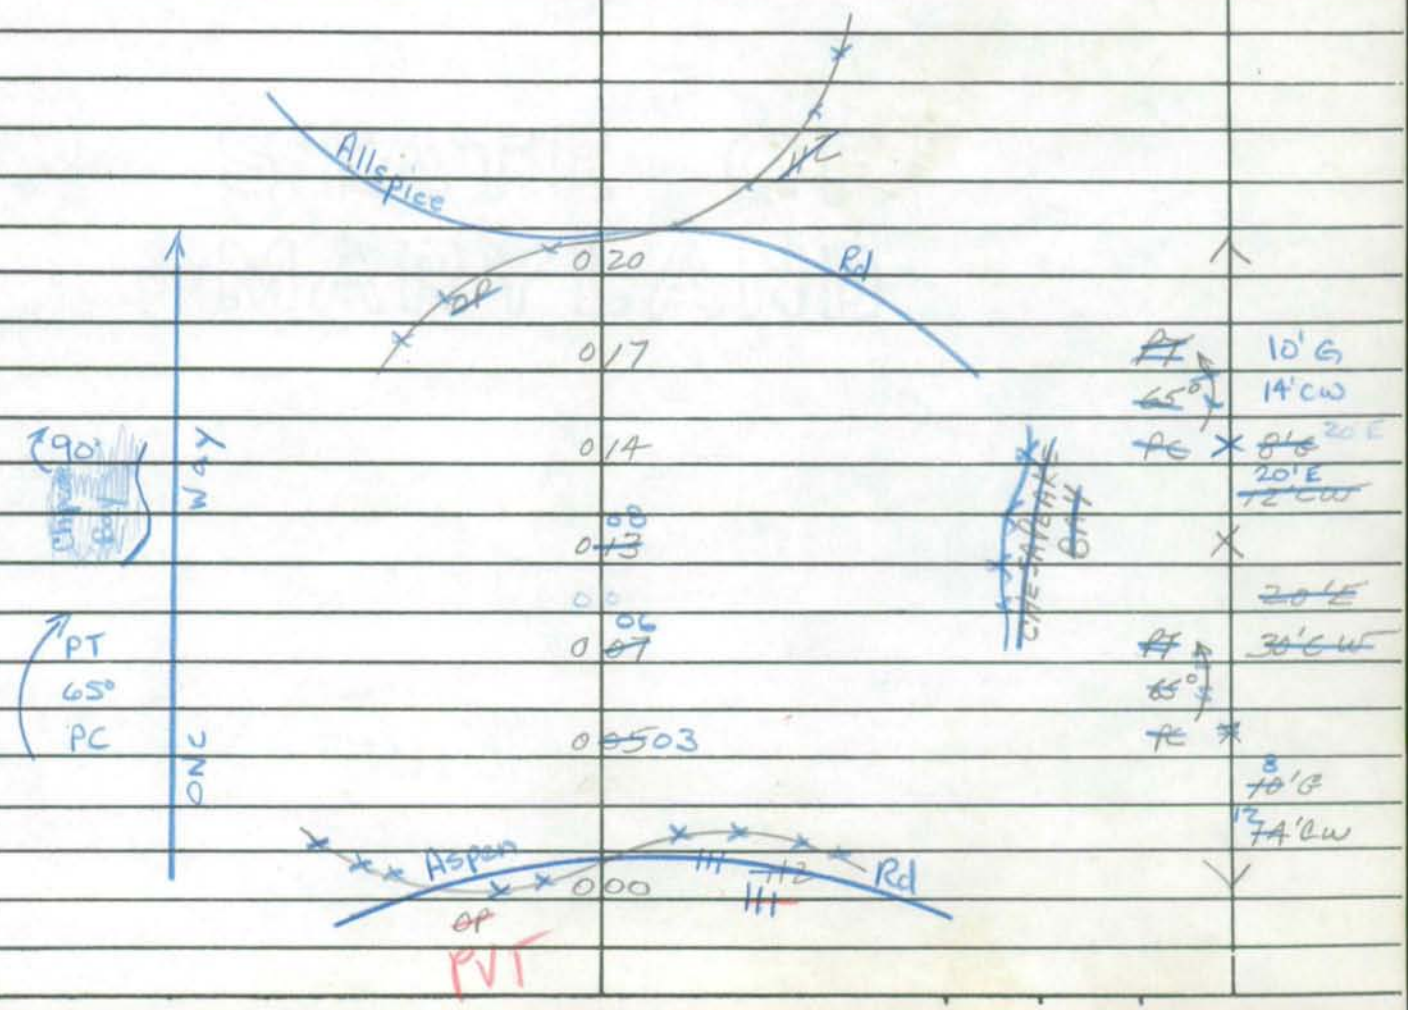

Form 6 HPS (Rev. 1961)

ROAD INVENTORY SHEET

Party Chief T. LANDON
Recorder W. WARFIELD
Chainman B HOOPER

SCIENTIST CLIFFS
1-13
940-246

PVT
Road No. ~~OP~~ 120
Name Aster Rd
Sheet No. 1 OF 1
Date 6-19-69
County CALVERT

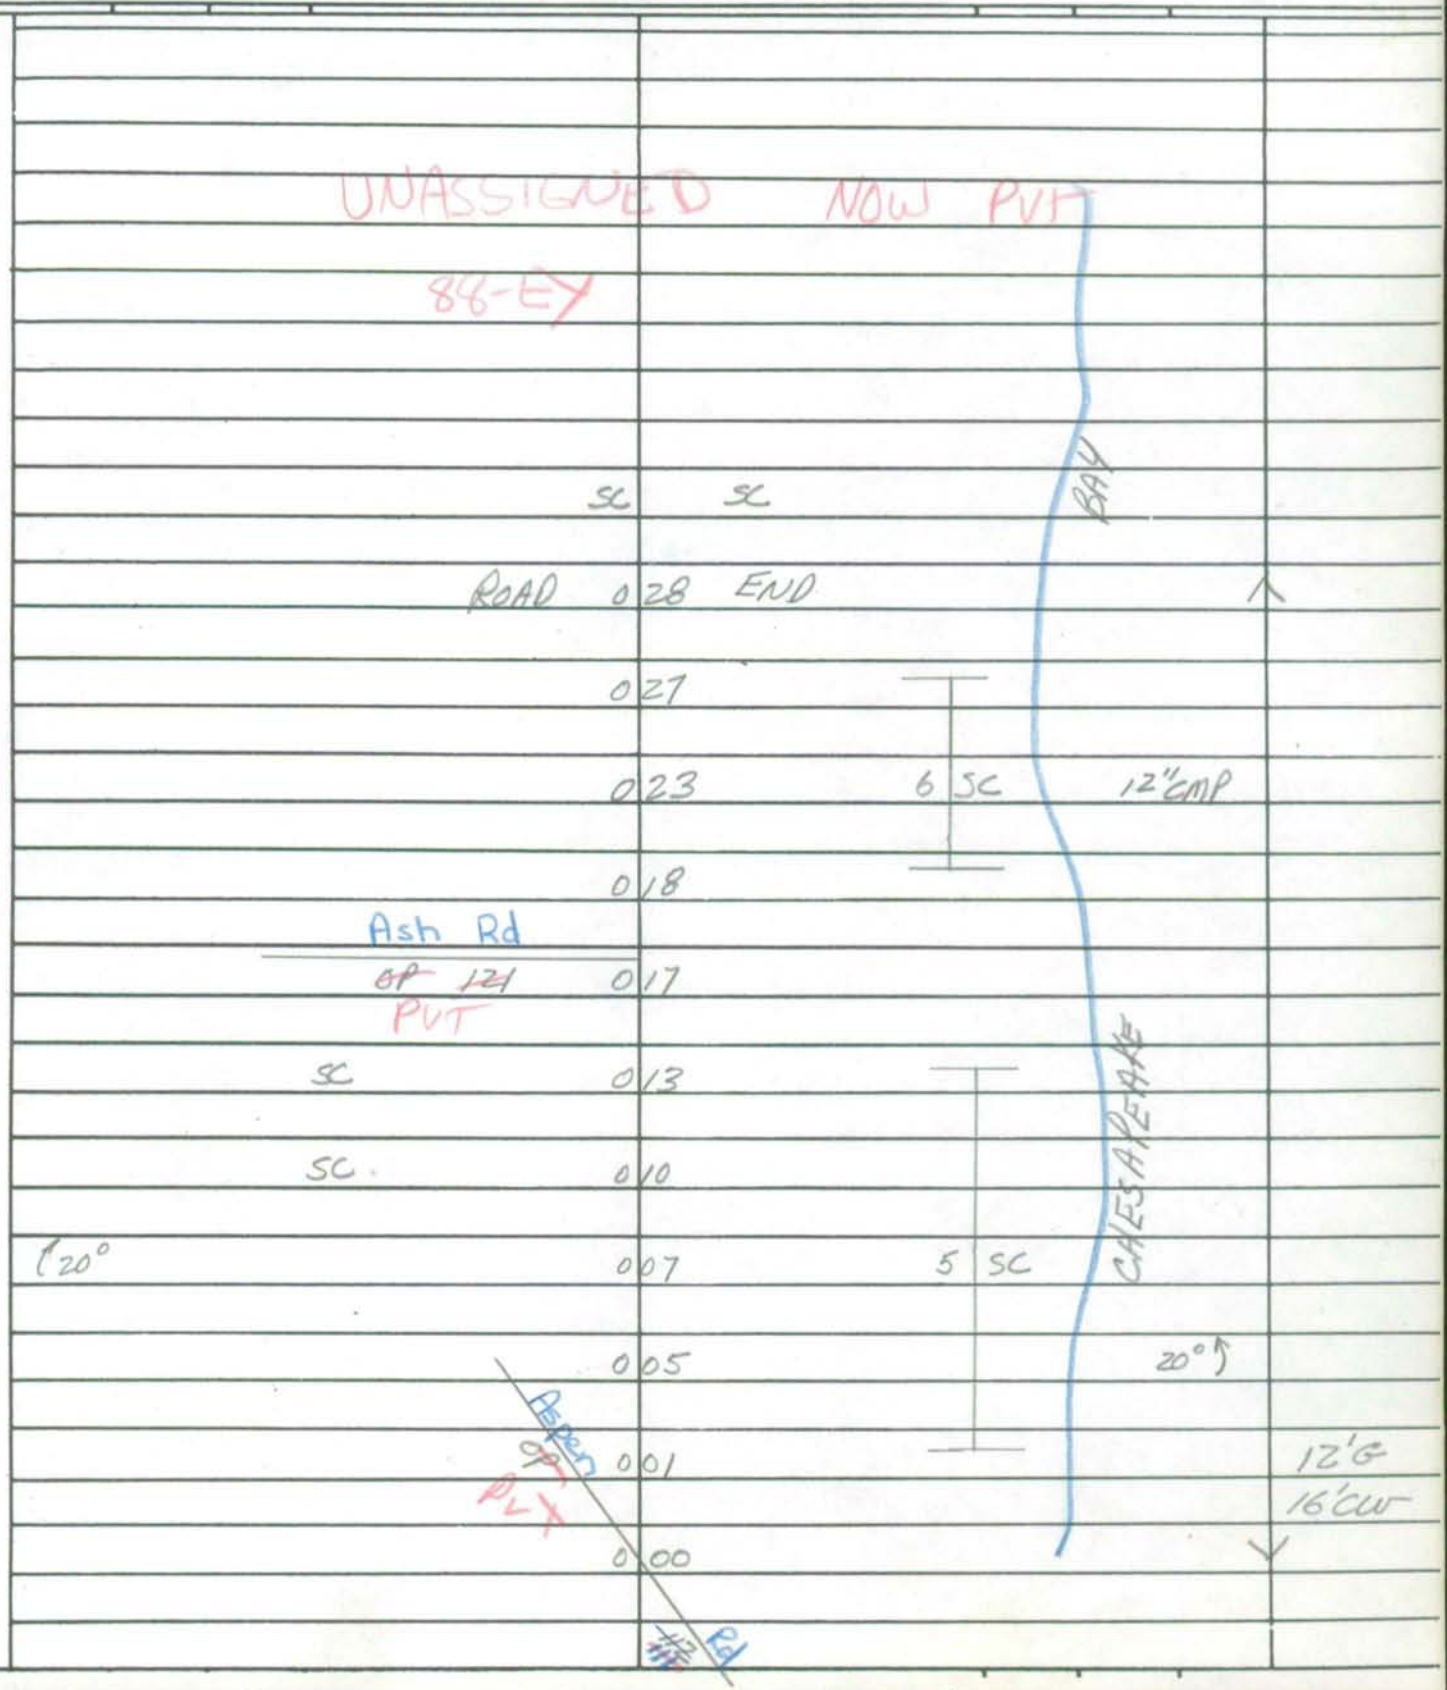

Form 6 HPS (Rev. 1961)

ROAD INVENTORY SHEET

PVT

Party Chief T. LANDON
Recorder W. WARFIELD
Chainman B. HOOPER

SCIENTIST CLIFFS

Z-13

940-247

Road No. ~~OP 121~~
Name Ash Rd
Sheet No. 1 OF 1
Date 6-19-69
County CALVERT

UNASSIGNED - NOW PVT

88-EX

W

Aspen		Rd		
PVT ~~OP~~	0	04	~~112~~ 111	
	0	02	SC	16'6
Aster		Rd		22'CW
PVT ~~OP~~	0	00	~~120~~	

Form 6 HPS (Rev. 1961)

ROAD INVENTORY SHEET

PUT

Party Chief T. LANDON
Recorder W. WARFIELD
Chainman B. HOOPER

SCIENTIST CLIFFS

I-13

939-247

Road No. ~~OP 132~~
Name Abelia Rd
Sheet No. 1 OF 1
Date 6-19-69
County CALVERT

UNASSIGNED

NOW PUT - ~~88-EX~~

N

N

ROAD 005 END SC

004 50°

SC 001 12' G 16' CW

Aspen

~~OP~~ PVT 000 Rd

~~11~~ 12

Form 6 HPS (Rev. 1961)

ROAD INVENTORY SHEET

Party Chief T. LANDON
Recorder W. WARFIELD
Chainman B. HOOPER

KENWOOD BEACH

I-13

942-243

Road No. OP 123
Name
Sheet No. 1 OF 1
Date 6-19-69
County CALVERT

	ROAD	0	06 END	
			6 SC	
		0	03	110°
				12'D
55°	(Government	0	01 RUN	16'CW
	KENWOOD		BEACH RD.)	
	MD	0	00 509	

BAY

CHESAPEAKE

Form 6 HPS (Rev. 1961)

ROAD INVENTORY SHEET

Party Chief T. LANDON
Recorder W. WARFIELD
Chainman B. HOOPER

KENWOOD BEACH

Road No. OP 124
Name
Sheet No. 1 OF 1
Date 6-19-69
County CALVERT

941.5-243

UNASSIGNED NOW PULL

CO 656

S 5-44 (NORTH AVE)

SC	ROAD	018	END	SC
SC		017		SC
		015		SC
		013		SC
SC		011		
SC-200' SC		010		
↑20°	OP	008	126	
		007		
5 SC	KENWOOD CO.	001	3 SC	12'E 16'CW
		000	BEACH RD	

Form 6 HPS (Rev. 1961)

ROAD INVENTORY SHEET

Party Chief T. LANDON
Recorder W. WARFIELD
Chainman B. HOOPER

KENWOOD BEACH

Road No. OP 125
Name
Sheet No. 1 of 1
Date 6-19-69
County CALVERT

942 - 242.5

UNASSIGNED

~~ROLL~~

NOW CO 658 ST

(~~NORTH AVE~~ BAYVIEW)

(85 ~~LN~~ 37)

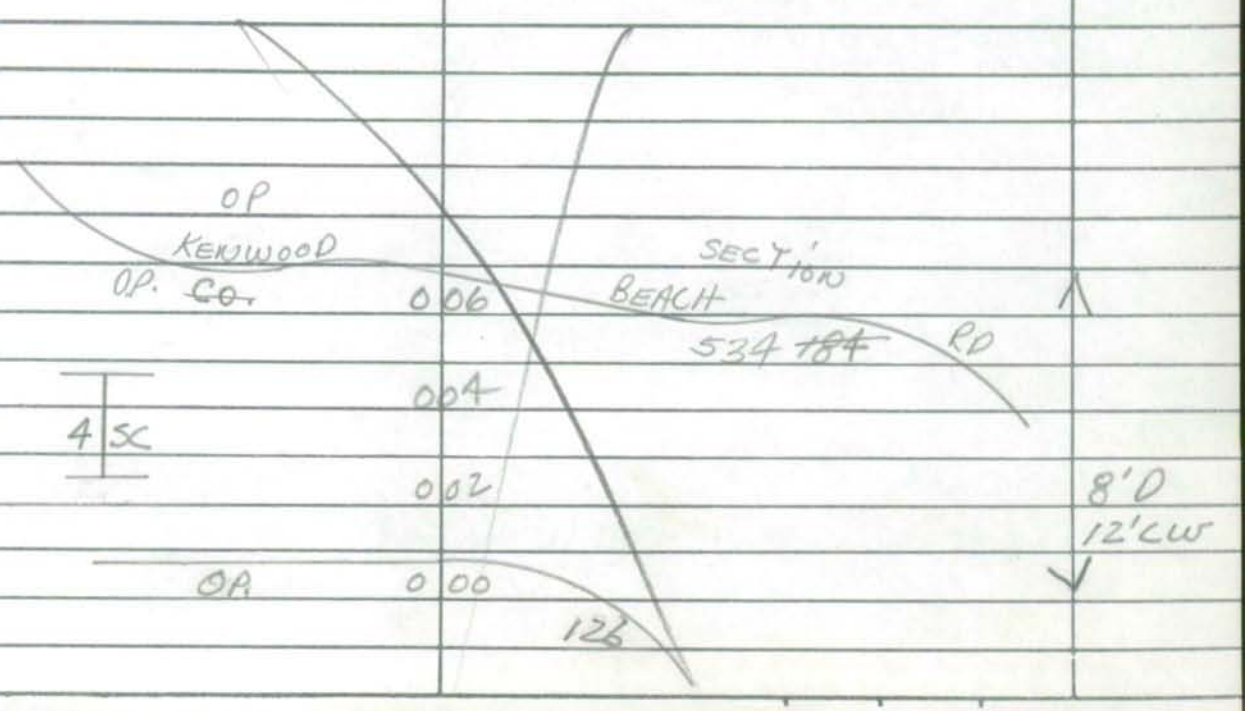

SHA 51.3 - 8 Revised
4.83

MARYLAND STATE HIGHWAY ADMINISTRATION

ROAD INVENTORY SHEET

Party Chief _____
Recorder _____
Assistant _____
Map No./Dir. 1
State Coordinates _____

Road No. OP 126
Road Name _____
County CALVERT
Date _____
Sheet No. _____ OF _____

SYSTEM				TRAFFIC		LINE DIAGRAM	TRAFFIC			PAVEMENT DATA
FED. AID.	FUNCT CLASS.	HWY. SYS.	HPMS SAMPLE	PRK.G. REST.	COM/IND. ACCESS		CONTROL	COM/IND. ACCESS	PRK.G. REST.	
						See T.N. of G 657 85-46				

TRAFFIC CODES

TRAFFIC CONTROLS: STOP SIGN=SS,
TRAFFIC LIGHT=T.L.,
FLASHING RED BALL=F.R.

TRAFFIC CODES

PARKING RESTRICTIONS: A.M. PEAK,
P.M. PEAK, A.M./P.M. PEAK, NO PARKING
ANYTIME=N.P., COMM/IND. ACCESS=E

SYSTEM				TRAFFIC		LINE DIAGRAM	TRAFFIC				PAVEMENT DATA
FED. AID.	FUNCT. CLASS.	HWY. SYS.	HPMS SAMPLE	PRK.G. REST.	COM/IND ACCESS		CONTROL	COM/IND ACCESS	PRK.G. REST.		

SHA 51.3 - 8 Revised
4.83

MARYLAND STATE HIGHWAY ADMINISTRATION

ROAD INVENTORY SHEET

Party Chief _____
Recorder _____
Assistant _____
Map No./Dir. 1
State Coordinates _____

Road No. OP 127
Road Name _____
County CALVERT
Date _____
Sheet No. _____ OF _____

SYSTEM				TRAFFIC		LINE DIAGRAM	TRAFFIC			PAVEMENT DATA
FED. AID.	FUNCT. CLASS.	HWY. SYS.	HPMS SAMPLE	PRKG. REST.	COM/IND. ACCESS		CONTROL	COM/IND. ACCESS	PRKG. REST.	
						See INV. OF C664 85-43				

TRAFFIC CODES

TRAFFIC CONTROLS: STOP SIGN=SS,
TRAFFIC LIGHT=T.L.,
FLASHING RED BALL=F.R.

TRAFFIC CODES

PARKING RESTRICTIONS: A.M. PEAK,
P.M. PEAK, A.M./P.M. PEAK, NO PARKING
ANYTIME=N.P., COMM/IND. ACCESS=E

SYSTEM				TRAFFIC		LINE DIAGRAM	TRAFFIC			PAVEMENT DATA
FED. AID.	FUNCT. CLASS.	HWY. SYS.	HPMS SAMPLE	PRK.G. REST.	COM/IND ACCESS		CONTROL	COM/IND ACCESS	PRK.G. REST.	

Form 6 HPS (Rev. 1961)

ROAD INVENTORY SHEET

Party Chief T. LANDON
Recorder W. WARFIELD
Chainman B. HOOPER

KENWOOD BEACH

Road No. OP 128
Name
Sheet No. 1 OF 1
Date 6-19-69
County CALVERT

942-242

UNASSIGNED
NOW PART
OF 658
857

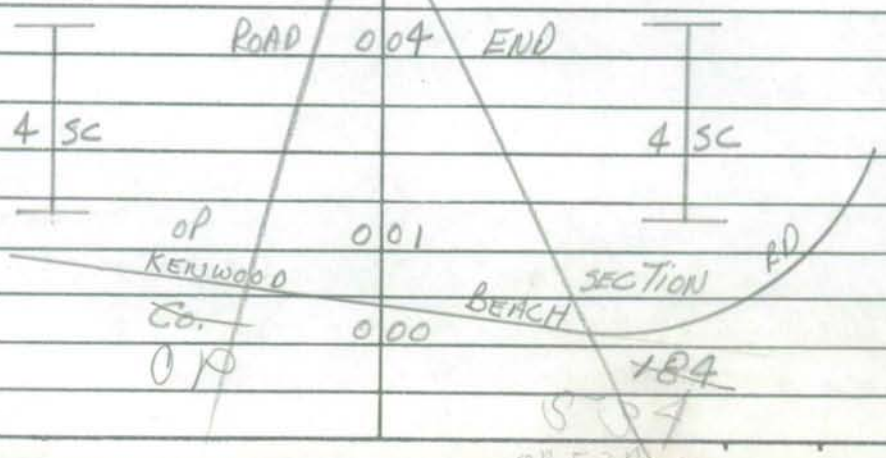

SHA 51.3-8
11-15-72

STATE HIGHWAY ADMINISTRATION OF MARYLAND

ROAD INVENTORY SHEET

Party Chief: T. Landen
Recorder: F. Rhodes
Helper: Copied by P.B from Co 282 Inv.

Map No. G-05

Road No. OP 129
Road Name Western Shore Blvd.
Sheet No. 1 of 1
Date 3-10-76
County Calvert
State Coordinates 939-240

NOW CO. 501

80-39

H Road 140 END 15" CMP

P.T.
85°
P.C.

133
130
Dogwood DR.
125 OP 130
123
90°
118
116
12' E
16' CW
H 114 14 SC-50'
107
3 SC
103 Berry Lane
OP ~~130~~ 516

E

N
N

SHA 51.3-8
11-15-72

ROAD INVENTORY SHEET

Road No. _____
Road Name _____
Sheet No. _____
Date _____
County _____
State Coordinates _____

SHA 51.3-8
11-15-72

STATE HIGHWAY ADMINISTRATION OF MARYLAND

ROAD INVENTORY SHEET

BERRY LANE

Party Chief: T. London
Recorder: E. Rhodes
Helper:

Road No.: O.P. 130
Road Name: Dogwood Drive
Sheet No.: 1 of 1
Date: 3-10-76
County: Calvert
State Coordinates: 944.5 - 237

Map No. 605
Western Shore Estates

SEE NEW INV.
80-42+43

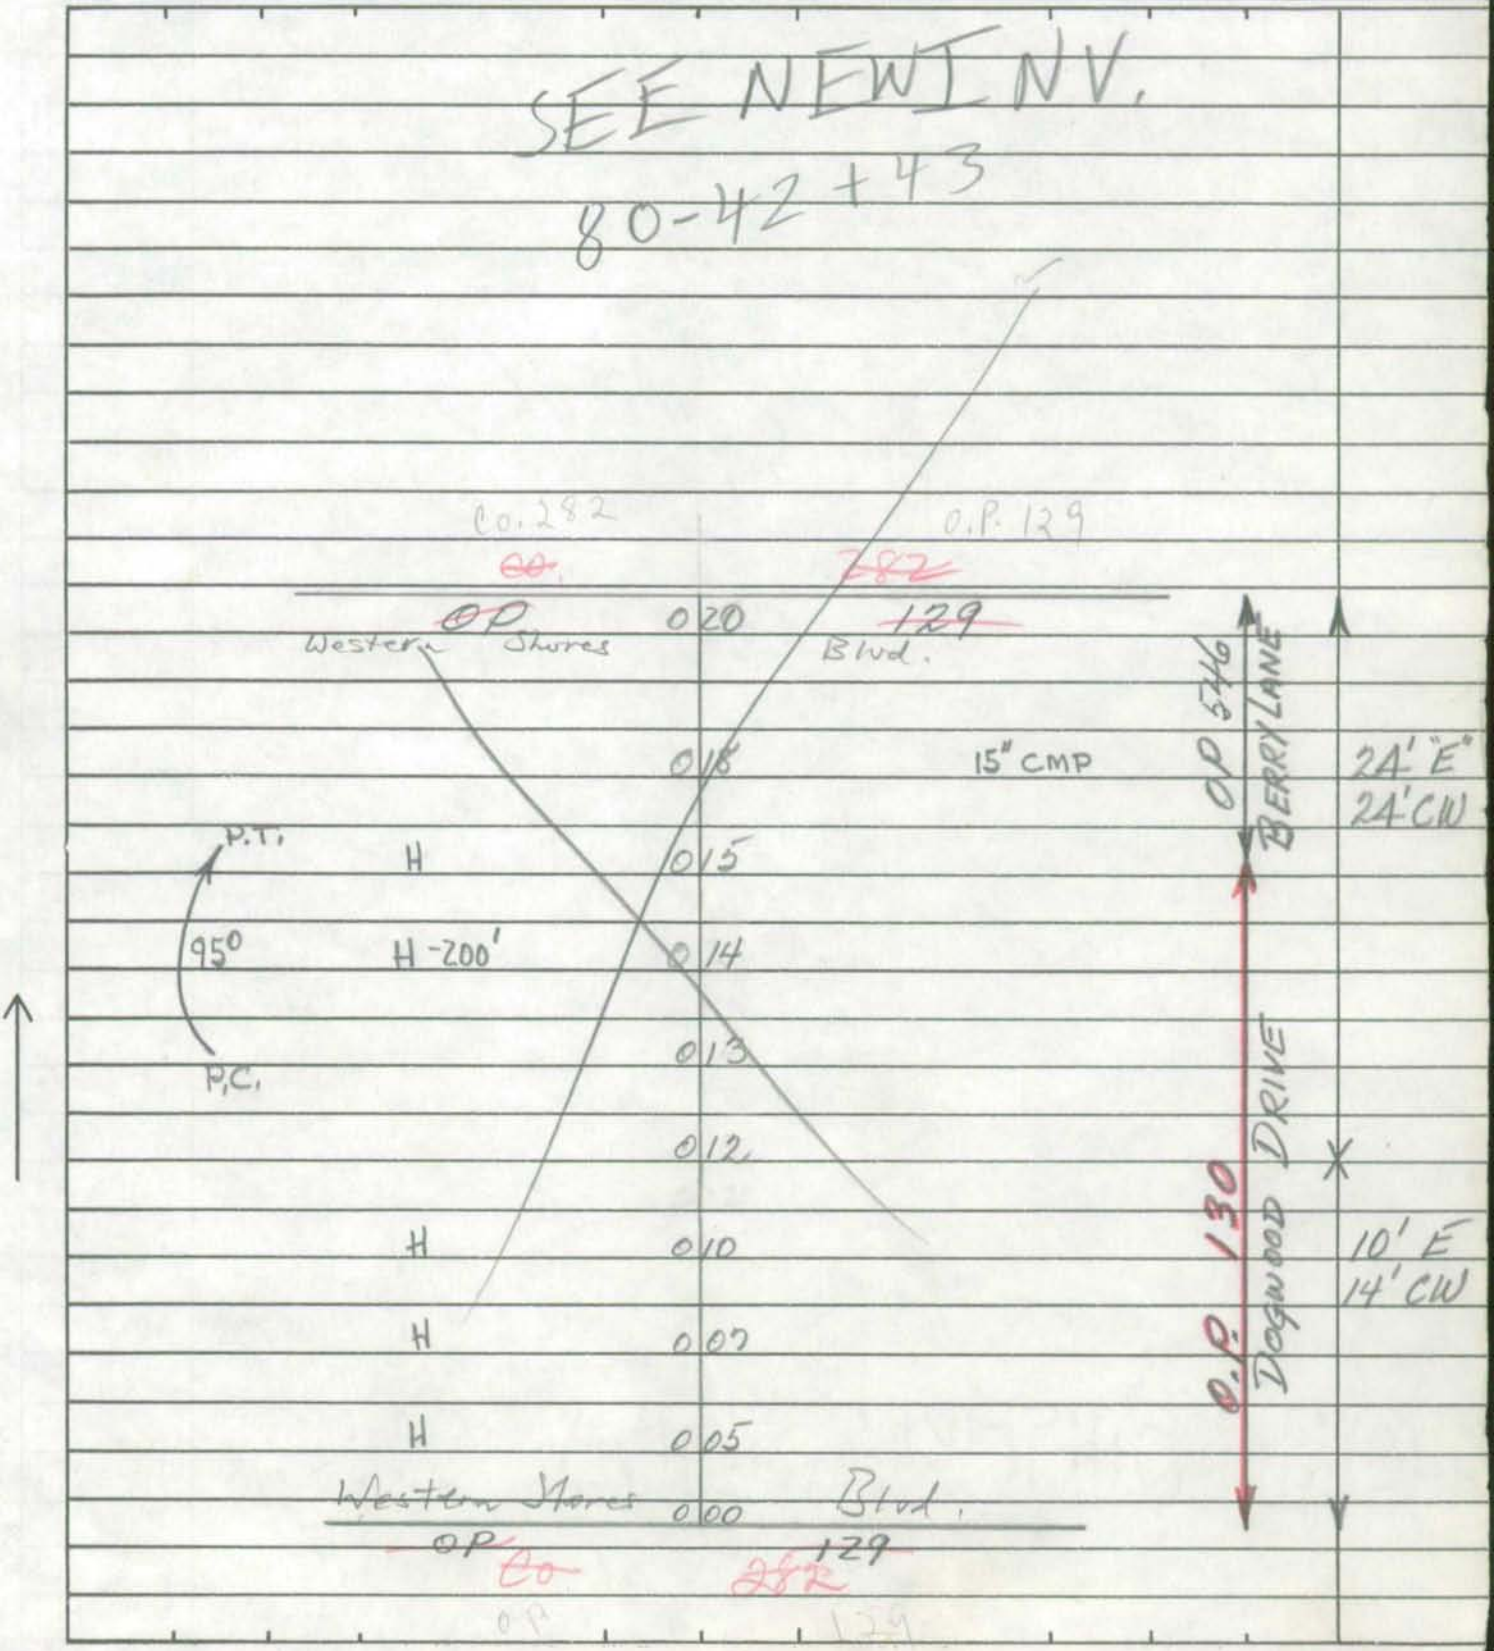

SHA 51.3-8
11-15-72

ROAD INVENTORY SHEET

Road No. _____
Road Name _____
Sheet No. _____
Date _____
County _____
State Coordinates _____

Form 6 HPS (Rev. 1961)

ROAD INVENTORY SHEET

Party Chief T. LANDON
Recorder W. WARFIELD
Chainman B. HOOPER

Z-13
941-236.5

Road No. OP 131
Name
Sheet No. 1 OF 1
Date 6-19-69
County CALVERT

E

F-400' (MEAN) H ROAD	0 28 END	
	0 13 H	
	ISLAND RD. 965 ±	10'E 14'CW
SOLOMONS MD	0 00	

Form 6 HPS (Rev. 1961)

ROAD INVENTORY SHEET

Party Chief T. LANDON
Recorder W. WARFIELD
Chainman B. HOOPER

I-13
943-233

Road No. OP 132
Name
Sheet No. 1 OF 1
Date 6-24-69
County CALVERT

		F	
TH ROAD	0	83. END	^
↑90°	0	61	10'D 14'CW
H	0	47	X
	0	41	10° ↑
↑30°	0	36	
		PVT. RD 0	
	0	25 8'D 38	H
	0	19	85° ↑
H	0	10 RD 70	14'E 20'CW
CALVERT BEACH CO.	0	00	v

Form 6 HPS (Rev. 1961)

ROAD INVENTORY SHEET

Party Chief T. LANDON
Recorder W. WARFIELD
Chainman B. HOOPER

I-13

945.5-233

Road No. OP 133
Name
Sheet No. 1 OF 1
Date 6-19-69
County CALVERT

SHA 51.3-8
11-15-72

STATE HIGHWAY ADMINISTRATION OF MARYLAND

ROAD INVENTORY SHEET

Party Chief _____
Recorder _____
Helper _____

Map No. _____

Road No. OP 134
Road Name _____
Sheet No. _____
Date _____
County CALVERT
State Coordinates _____

See Inventory

OC Co 576

82-24

SHA 51.3-8
11-15-72

ROAD INVENTORY SHEET

Road No. _____
Road Name _____
Sheet No. _____
Date _____
County _____
State Coordinates _____

SHA 51.3-8
11-15-72

STATE HIGHWAY ADMINISTRATION OF MARYLAND

ROAD INVENTORY SHEET

Party Chief _____
Recorder _____
Helper _____

Map No. _____

Road No. OP135
Road Name _____
Sheet No. _____
Date _____
County CALVERT
State Coordinates _____

UNASSIGNED

Now Co. 577

82-23

SHA 51.3-8
11-15-72

ROAD INVENTORY SHEET

Road No. _____
Road Name _____
Sheet No. _____
Date _____
County _____
State Coordinates _____

SHA 51.3-8
11-15-72

STATE HIGHWAY ADMINISTRATION OF MARYLAND

ROAD INVENTORY SHEET

Party Chief _____
Recorder _____
Helper _____

Map No. _____

Road No. OP136
Road Name _____
Sheet No. _____
Date _____
County CALVERT
State Coordinates _____

UNASSIGNED

Now Co. 578

82-23

SHA 51.3-8
11-15-72

ROAD INVENTORY SHEET

Road No. _____
Road Name _____
Sheet No. _____
Date _____
County _____
State Coordinates _____

CALVERT COUNTY

OP 137

SEE INVENTORY

OF

CO 1174

BEACH DR

01-02 CO (0.00-0.12)

SHA 51.3-8
11-15-72

STATE HIGHWAY ADMINISTRATION OF MARYLAND

ROAD INVENTORY SHEET

Party Chief _____
Recorder _____
Helper _____

Map No. _____

Road No. OP 138
Road Name _____
Sheet No. _____
Date _____
County _____
State Coordinates _____

UNASSIGNED

NOW CO. 439

79-56

SHA 51.3-8
11-15-72

ROAD INVENTORY SHEET

Road No. _____
Road Name _____
Sheet No. _____
Date _____
County _____
State Coordinates _____

SHA 51.3-8
11-15-72

STATE HIGHWAY ADMINISTRATION OF MARYLAND

ROAD INVENTORY SHEET

Party Chief _____
Recorder _____
Helper _____

Map No. _____

Road No. OP 139
Road Name _____
Sheet No. _____
Date _____
County _____
State Coordinates _____

UNASSIGNED

NOW CO. 438

79-55

SHA 51.3-8
11-15-72

ROAD INVENTORY SHEET

Road No. _____
Road Name _____
Sheet No. _____
Date _____
County _____
State Coordinates _____

SHA 51.3-8
11-15-72

STATE HIGHWAY ADMINISTRATION OF MARYLAND

ROAD INVENTORY SHEET

Party Chief _____
Recorder _____
Helper _____

Map No. _____

Road No. OP 140
Road Name _____
Sheet No. _____
Date _____
County _____
State Coordinates _____

NOW
CO. 437

79-60

SHA 51.3-8
11-15-72

ROAD INVENTORY SHEET

Road No. _____
Road Name _____
Sheet No. _____
Date _____
County _____
State Coordinates _____

SHA 51.3-8
11-15-72

STATE HIGHWAY ADMINISTRATION OF MARYLAND

ROAD INVENTORY SHEET

Party Chief _____
Recorder _____
Helper _____

Map No. _____

Road No. OP 141
Road Name _____
Sheet No. _____
Date _____
County _____
State Coordinates _____

NOW PART CO.
444 + PART CO.
445
79-EXTRA #7

SHA 51.3-8
11-15-72

ROAD INVENTORY SHEET

Road No. _____
Road Name _____
Sheet No. _____
Date _____
County _____
State Coordinates _____

SHA 51.3-8
11-15-72

STATE HIGHWAY ADMINISTRATION OF MARYLAND

ROAD INVENTORY SHEET

Party Chief _____
Recorder _____
Helper _____

Map No. _____

Road No. OP 142
Road Name _____
Sheet No. _____
Date _____
County _____
State Coordinates _____

NOW CO. 444

79 EXTRA #7

SHA 51.3-8
11-15-72

ROAD INVENTORY SHEET

Road No. _____
Road Name _____
Sheet No. _____
Date _____
County _____
State Coordinates _____

Form 6 HPS (Rev. 1961)

ROAD INVENTORY SHEET

Party Chief T. LANDON
Recorder W. WARFIELD
Chainman B. HOOPER

LONG BEACH

J-13
950.5-231

Road No. OP 143
Name
Sheet No. 1 OF 1
Date 6-24-69
County CALVERT

ABANDONED
GPS-02
7-11-02
GO/RI

CHESAPEAKE BAY

N

		D	E		
H	CUL	0	04	SAC	
H		0	02	H	
~~OP~~ CO.		0	01	H	14'G 18'CWS
		0	00		

SHA 51.3-8
11-15-72

STATE HIGHWAY ADMINISTRATION OF MARYLAND

ROAD INVENTORY SHEET

Party Chief _____
Recorder _____
Helper _____

Map No. _____

Road No. OP 144
Road Name _____
Sheet No. _____
Date _____
County _____
State Coordinates _____

NOW CO. 436

79-62

SHA 51.3-8
11-15-72

ROAD INVENTORY SHEET

Road No. _____
Road Name _____
Sheet No. _____
Date _____
County _____
State Coordinates _____

SHA 51.3-8
11-15-72

STATE HIGHWAY ADMINISTRATION OF MARYLAND

ROAD INVENTORY SHEET

Party Chief _____
Recorder _____
Helper _____

Map No. _____

Road No. OP 145
Road Name _____
Sheet No. _____
Date _____
County _____
State Coordinates _____

NOW CO. 435

79-66

SHA 51.3-8
11-15-72

ROAD INVENTORY SHEET

Road No. _____
Road Name _____
Sheet No. _____
Date _____
County _____
State Coordinates _____

SHA 51.3-8
11-15-72

STATE HIGHWAY ADMINISTRATION OF MARYLAND

ROAD INVENTORY SHEET

Party Chief _____
Recorder _____
Helper _____

Map No. _____

Road No. OP 146
Road Name _____
Sheet No. _____
Date _____
County _____
State Coordinates _____

NOW CO. 434

7965

SHA 51.3-8
11-15-72

ROAD INVENTORY SHEET

Road No. _____
Road Name _____
Sheet No. _____
Date _____
County _____
State Coordinates _____

OP 147

Calvert County

UNASSIGNED

NOW

CO 1125

FOREST RD

00-45 CO

4-11-2001

Form 6 HPS (Rev. 1961)

2000 COEX #4
03-14-01
SS/AG

ROAD INVENTORY SHEET

Party Chief T. LANDON
Recorder W. WARFIELD
Chainman B. HOOPER

LONG BEACH

J-13

950.5-228

Road No. OP 148
Name POPLAR RD
Sheet No. 1 OF 1
Date 6-25-69
County CALVERT

SE	ROAD	019	END	
		017	SC - (VAC.)	
	H	014		
		009	H	
	H	006		
		003	SC	
	H of LONG BEACH	001		9'D
	Co. ~~OP~~	CO. 000	~~SECTION~~ DR. ~~71~~ 1166 ~~71~~ (2000 COEX #4)	12'CW

Form 6 HPS (Rev. 1961)

2000.00 Ex = 4
03-14-0
SSMR

ROAD INVENTORY SHEET

Party Chief T. LANDON
Recorder W. WARFIELD
Chainman B. HOOPER

LONG BEACH

J-13

950.5-228.5

Road No. OP 149
Name FIR RD
Sheet No. 1 OF 1
Date 6-25-69
County CALVERT

	ROAD	023	END	
		021		
H		020	3 H	
H		019		
H		017		
H		013		
		008	H	
		005	H	
		003	H	
			SECTION	PR. 12'0
			BEACH 1166	~~71~~ 16'CW
		000	~~71~~ ~~516~~	(2000.00 Ex = 4)

SE

OP LONG Co. ~~OP~~

OP 150

Calvert County

UNASSIGNED

NOW

CO 1121

LOCUST RD

00-41 CO

4-11-2001

SHA 6 HES (Rev. 1961)

ROAD INVENTORY SHEET

Party Chief J. HANNON
Recorder W. WARFIELD
Chainman R. HOFER

LONG BEACH

3-13

951-828.5

Road No. OP 151
Name SOUTH HARBOR DR
Sheet No. 1 OF 1
Date 6-25-61
County CALVERT

HARBOR

BOAT

ROAD 0|27 END

0|25 H

0|24 H-500'

PROPOSED RD

15 0|23 LILAC CR.

0|20 H

PT 45° PC 0|18 16'G 22'CW

0|14 X 15'I 20'C-U

ELM OP 437 0|11 OP RD. 155

PT 45° PC 0|09 22'I 22'C-U

LONG BEACH OP COL OP 0|04 14'G 18'CW

0|00

SECTION DR 71-71

OP 152

Calvert County

UNASSIGNED

NOW

CO 1123

Hill Rd

00-43 CO

4-30-2001

CALVERT COUNTY

OP 153

SEE INVENTORY

OF

CO 1124

HICKORY RD

00-44 CO

04-11-2001

Form 6 HPS (Rev. 1961)

2000 CO EX 44
08-14-01
SS/AG

ROAD INVENTORY SHEET

Party Chief T. LANDON
Recorder W. WARFIELD
Chainman B. HOOPER

LONG BEACH

S-13
952-228

Road No. OP 154
Name BAYVIEW RD
Sheet No. 1 OF 1
Date 6-25-69
County CALVERT

OP				
LONG BEACH			SECTION	
CO OP CO.	0	22	1166 OR. 5-71 (2000 CO EX 44)	
H	0	18	H	20° ↱
PINE RD				
OP 158	0	17		
H	0	16	H	
	0	14		15° ↱
	0	12	H	
	0	11	H	
H	0	10	H	
	0	07	H	
↰15° H	0	06		
	0	04	H	
				12'G
OP HILL	0	03		85° ↱ 14'CW
CO				
	0	00	RD	
			1123 @.16	

E

OP 155

CALVERT COUNTY

SEE INVENTORY OF

CO 433

ELM RD

Rewritten (10/26/90) by JEL

SHA 51.3 - 8 Revised
4.83

MARYLAND STATE HIGHWAY ADMINISTRATION

ROAD INVENTORY SHEET

Party Chief: I Landon
Recorder: W Warfield
Assistant: B. Hooper
Map No./Dir.: J-13/SW
State Coordinates: 952 - 229

Road No.: OP 156
Road Name: Dogwood Rd
County: Calvert County
Date: 10-24-89
Sheet No.: 1 OF 1

TRAFFIC CODES
TRAFFIC CONTROLS: STOP SIGN=SS, TRAFFIC LIGHT=T.L., FLASHING RED BALL=F.R.

TRAFFIC CODES
PARKING RESTRICTIONS: A.M. PEAK, P.M. PEAK, A.M./P.M. PEAK, NO PARKING ANYTIME=N.P., COMM/IND. ACCESS=E

SYSTEM				TRAFFIC		LINE DIAGRAM	TRAFFIC			PAVEMENT DATA
FED. AID.	FUNCT CLASS.	HWY. SYS.	HPMS SAMPLE	PRKG. REST.	COM/IND. ACCESS		CONTROL	COM/IND. ACCESS	PRKG. REST.	
						Chesapeake Pkwy				
						H OP 1672 013				
						H 012				
						011 H				
						Hickory Rd				
						Co ~~OP~~ 008 ~~1123~~ 1124 @.18				12' G 14' CW
						007				
						3 H 004 5 H				
						003				
						Bayside Rd				
						Co ~~OP~~ 000 ~~1121~~ 1122 @.08				

NOT F/R BALL LOCAL

SYSTEM				TRAFFIC		LINE DIAGRAM	TRAFFIC				PAVEMENT DATA
FED. AID.	FUNCT. CLASS.	HWY. SYS.	HPMS SAMPLE	PRK'G. REST.	COM/IND ACCESS		CONTROL	COM/IND ACCESS	PRK'G. REST.		

Form 6 HPS (Rev. 1961)

ROAD INVENTORY SHEET

Party Chief T. LANDON
Recorder W. WARFIELD
Chainman B. HOOPER

LONG BEACH
J-13
951.5 - 229.5

Road No. OP 157
Name LILAC RD
Sheet No. 1 OF 1
Date 6-19-69
County CALVERT

SW			
		Proposed	
HICKORY		RD.	
CO ~~X~~	008	1124 e.14 ~~183~~	
H	007		
	006	H	
	005	H	
H	003	H	12'6
BAYSIDE		RD	14'CW
CO ~~X~~	000	~~155~~ ~~548~~ 1122 @.13	

Form 6 HPS (Rev. 1961)

ROAD INVENTORY SHEET

Party Chief T. LANDON
Recorder W. WARFIELD
Chainman B. HOOPER

LONG BEACH
5-13

9515-2285

Road No. OP 158
Name PINE RD
Sheet No. 1 OF 1
Date 6-25-69
County CALVERT

BAYVIEW
OP
0 09
154 RD
0 07 SC
H 0 06 H
0 04 H
H 0 02
HILL 0 01 RD 1123 H 12'G 14'CW
CO SR 152
0 00

Form 6 HPS (Rev. 1961)

ROAD INVENTORY SHEET

Party Chief T. LANDON
Recorder W. WARFIELD
Chainman B. HOOPER

LONG BEACH
5-13
952-228

Road No. OP 159
Name LAUREL RD
Sheet No. 1 OF 1
Date 6-25-69
County CALVERT

N				
		ROAD	008 END	^
	H		007	
			006 H	
			005 H	
PT	H		004	
105°	H		003	
PC			002 H	
	H		001	12'a
	HILL		RD	14'cw
	~~PT~~ CO		000 ~~PT~~ 1123	v

Rewritten (10-26-90) JEL

2000 CO EX #4
03-14-01
SS/AQ

SHA 51.3 - 8 Revised
4.83

MARYLAND STATE HIGHWAY ADMINISTRATION

ROAD INVENTORY SHEET

Party Chief: T. LANDON
Recorder: W. Warfield
Assistant: B. Hooter
Map No./Dir.: J-13 / SW
State Coordinates: 953-2285

Road No.: OP 160
Road Name: Cypress Rd
County: Calvert County
Date: 6-25-69
Sheet No.: 1 OF 1

TRAFFIC CODES
TRAFFIC CONTROLS: STOP SIGN=SS, TRAFFIC LIGHT=T.L., FLASHING RED BALL=F.R.

TRAFFIC CODES
PARKING RESTRICTIONS: A.M. PEAK, P.M. PEAK, A.M./P.M. PEAK, NO PARKING ANYTIME=N.P., COMM/IND. ACCESS=E

SYSTEM				TRAFFIC		LINE DIAGRAM	TRAFFIC			PAVEMENT DATA
FED. AID.	FUNCT CLASS.	HWY. SYS.	HPMS SAMPLE	PKG. REST.	COM/IND. ACCESS		CONTROL	COM/IND. ACCESS	PKG. REST.	
						0.00 Cedar Rd / OP 673				
						0.10				
						NON F/A RURAL LOCAL				
						0.06 PT				10' E
						60°				14' CW
						0.03 PC				
						Long Beach DR Q245				
						~~OP~~ ~~SS~~ OP 0.00 ~~EX~~ ~~#~~ (2000 CO EX #4) 516 ~~1166~~				

SYSTEM				TRAFFIC		LINE DIAGRAM	TRAFFIC			PAVEMENT DATA
FED. AID.	FUNCT. CLASS.	HWY. SYS.	HPMS SAMPLE	PRKG. REST.	COM/IND ACCESS		CONTROL	COM/IND ACCESS	PRKG. REST.	

Rewritten (10-26-90) JEL

2000 COEX #4
03-14-01
SS/AQ

SHA 51.3 - 8 Revised
4.83

MARYLAND STATE HIGHWAY ADMINISTRATION

ROAD INVENTORY SHEET

Party Chief J. Landon
Recorder W. Warfield
Assistant B. Hooper
Map No./Dir. J-13/SW
State Coordinates 953-228.5

Road No. OP 161
Road Name Walnut Rd
County Calvert County
Date 6-25-69
Sheet No. 1 OF 1

TRAFFIC CODES

TRAFFIC CONTROLS: STOP SIGN=SS, TRAFFIC LIGHT=T.L., FLASHING RED BALL=F.R.

TRAFFIC CODES

PARKING RESTRICTIONS: A.M. PEAK, P.M. PEAK, A.M./P.M. PEAK, NO PARKING ANYTIME=N.P., COMM/IND. ACCESS=E

SYSTEM				TRAFFIC		LINE DIAGRAM	TRAFFIC			PAVEMENT DATA
FED. AID.	FUNCT CLASS.	HWY. SYS.	HPMS SAMPLE	PRK.G. REST.	COM/IND. ACCESS		CONTROL	COM/IND. ACCESS	PRK.G. REST.	
						0.14				
						Beach Rd 0.8° OP 674				8' D
										12' CW
						0.10 PT				
						75°				
						0.08 PC			X	
										12' E
										14' CW
						Long Beach DR 0253				
						OP 0.00 516 (2000 COEX #4)			Y	

NON RURAL LOCAL

SYSTEM				TRAFFIC		LINE DIAGRAM	TRAFFIC				PAVEMENT DATA
FED. AID.	FUNCT. CLASS.	HWY. SYS.	HPMS SAMPLE	PRKG. REST.	COM/IND ACCESS		CONTROL	COM/IND ACCESS	PRKG. REST.		

Form 6 HPS (Rev. 1961)

2000 COEX #4
03-14-201
SHQ

ROAD INVENTORY SHEET

Party Chief T. LANDON
Recorder W. WARFIELD
Chainman B. HOOPER

LONG BEACH
J-13
953-228

Road No. OP 162
Name BAYBERRY RD
Sheet No. 1 OF 1
Date 6-25-69
County CALVERT

ROAD	0 05 END	
	0 04 H	
	0 03 H	
H	0 02	
OP	SECTION	12'E
LONG	BEACH DR	16'CW
CO.	0 00 71 (2000 COEX #4)	
OP	56	

Form 6 HPS (Rev. 1961)

ROAD INVENTORY SHEET

Party Chief T. LANDON
Recorder W. WARFIELD
Chainman B. HOOPER

WHITE SANDS

J-13
954-216.5

Road No. OP 163
Name
Sheet No. 1 OF 3
Date 6-25-69
County CALVERT

UNASSIGNED NOW 6670

PT 30° PC		059	
		056	
		052	PT
	167	046	H 55°
	2 0	044	H
H		042	PC
20°	OP 168	039	
H		037	
H		031	PT 30° PC
		028	
PT 70° PC		023	
		019	H
		012	PT 45° PC
		008	
15°	0.04/16'G → SOLOMONS MD	003	16'G 22'CW
	SPUR	000	ISLAND RD 2

Form 6 HPS (Rev. 1961)

ROAD INVENTORY SHEET

Party Chief T. LANDON
Recorder W. WARFIELD
Chainman B. HOOPER

Road No. OP 163
Name
Sheet No. 2 OF 3
Date 6-25-69
County CALVERT

PRC 40° PRC	OP 164	141	PRC 12'I 16'CW
		139	PRC 60° X
		135	PC 14'G 20'C W
		130	X
		125 OP 165	20°
10°	H	115	
		113 OP 166	
		110	PT 55°
		105	PC
		101	H-200' PT 40°
PRC 45°		094	PRC
PC		083	
10°		078	
	PVT. RD		
	9' E	076	
		073	15"CMP 15°
20°		066	
			SAME

Form 6 HPS (Rev. 1961)

ROAD INVENTORY SHEET

Party Chief T. LANDON
Recorder W. WARFIELD
Chainman B. HOOPER

Road No. OP 163
Name
Sheet No. 3 OF 3
Date 6-25-69
County CALVERT

PT
30°
PRC
ONE-WAY
OP ← 151
148
164
H
PRC
130°
12'C
16'CW

Form 6 HPS (Rev. 1961)

ROAD INVENTORY SHEET

Party Chief T. LANDON
Recorder W. WARFIELD
Chainman B. HOOPER

WHITE SANDS

Road No. OP 164
Name
Sheet No. 1 OF 2
Date 6-25-69
County CALVERT

958.5 - 215.5

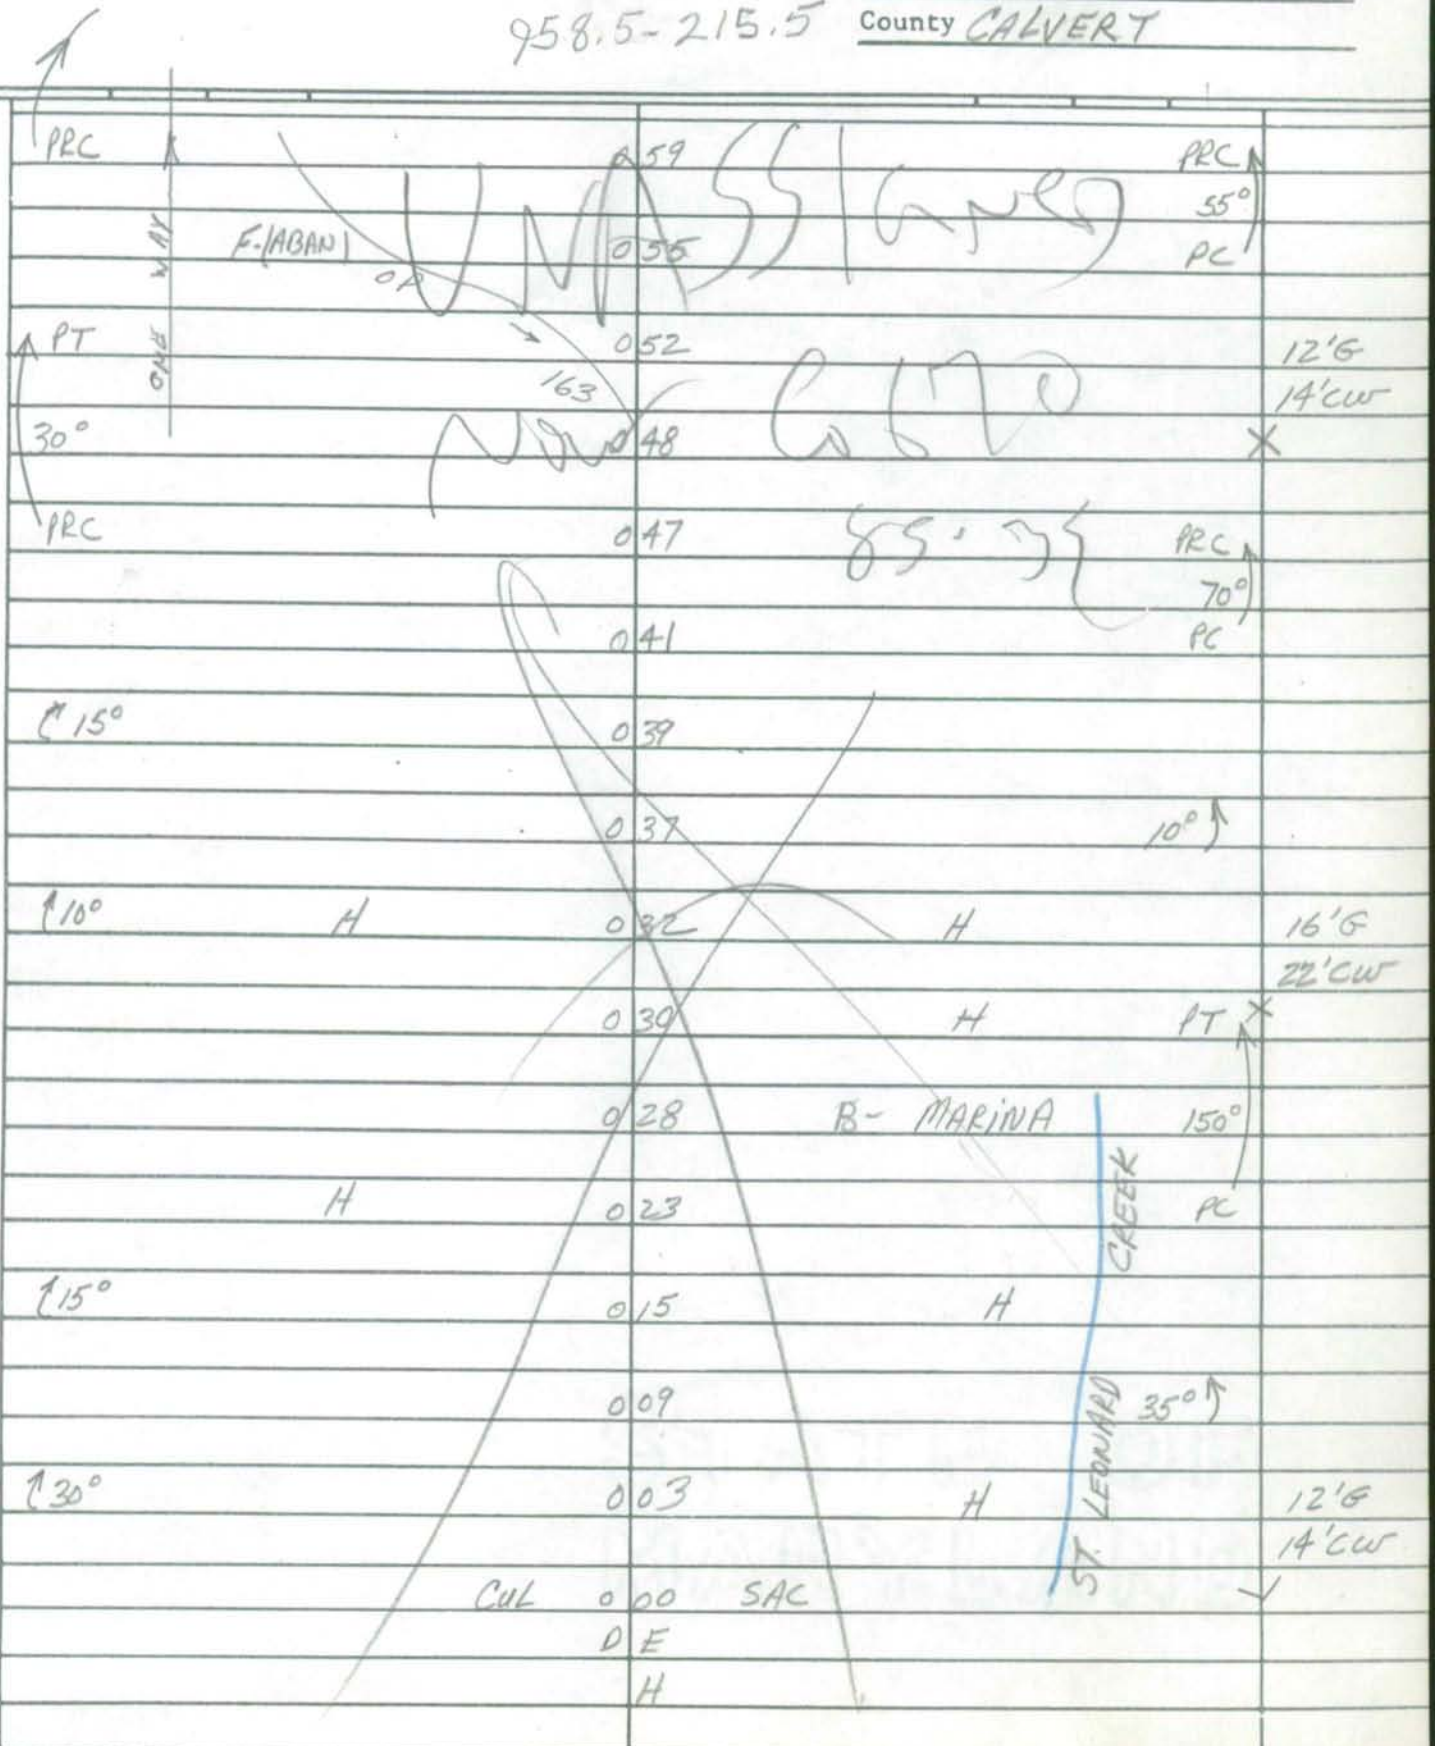

Form 6 HPS (Rev. 1961)

ROAD INVENTORY SHEET

Party Chief T. LANDON
Recorder W. WARFIELD
Chainman B. HOOPER

Road No. OP 164
Name
Sheet No. 2 OF 2
Date 6-25-69
County CALVERT

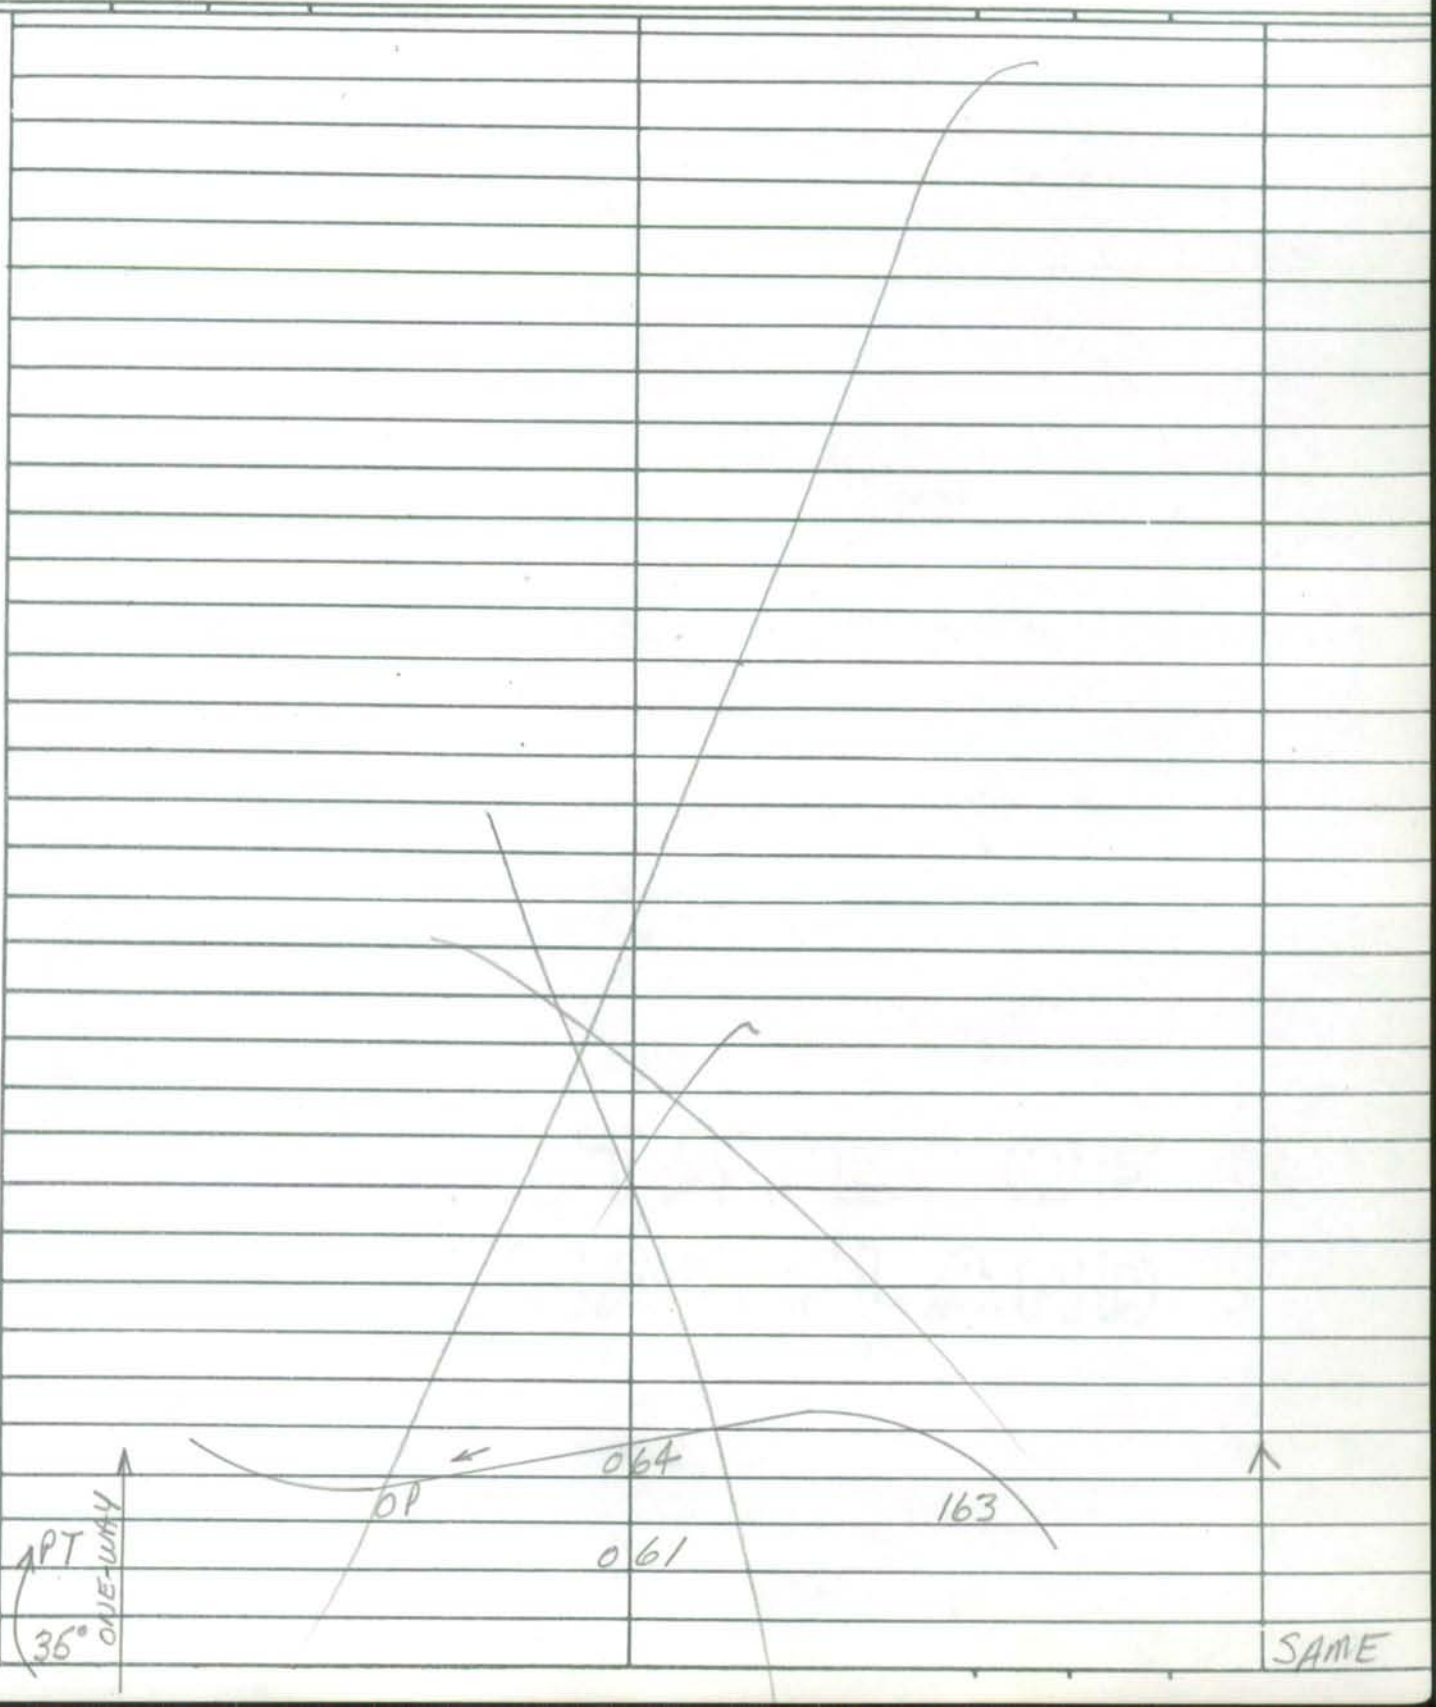

Form 6 HPS (Rev. 1961)

3-5-86 JE MB

ROAD INVENTORY SHEET

Party Chief TILANDON
Recorder W. WARFIELD
Chainman R. HOOPER

WHITE SANDS
J-13
949-216
~~949~~-216.5

Road No. OP 165
Name STABLE LANE
Sheet No. 1 OF 1
Date 6-25-69
County CALVERT

ROAD	0	29	END	H	
	0	25		H	
	0	23		SC-200'	
	0	20		PT	8'D
				135°	12'CW
	0	17		PC	
	0	14		PT	10'E
				20°	14'CW
PRC	0	11		PRC	
50°					
PC	0	06			12'E
					14'CW
WHITE SANDS DRIVE					
CO	0	00	670		

CREEK

ST. LEONARDS

SHA 51.3 - 8 Revised
4.83

MARYLAND STATE HIGHWAY ADMINISTRATION

ROAD INVENTORY SHEET

Party Chief _____
Recorder _____
Assistant _____
Map No./Dir. 1
State Coordinates _____

Road No. OP166
Road Name _____
County CALVERT
Date _____
Sheet No. _____ OF _____

SYSTEM				TRAFFIC		LINE DIAGRAM	TRAFFIC			PAVEMENT DATA
FED. AID.	FUNCT CLASS.	HWY. SYS.	HPMS SAMPLE	PRKG. REST.	COM/IND. ACCESS		CONTROL	COM/IND. ACCESS	PRKG. REST.	
						UNASSIGNED NON CO 672 85-86				

TRAFFIC CODES

TRAFFIC CONTROLS: STOP SIGN=SS, TRAFFIC LIGHT=T.L., FLASHING RED BALL=F.R.

TRAFFIC CODES

PARKING RESTRICTIONS: A.M. PEAK, P.M. PEAK, A.M./P.M. PEAK, NO PARKING ANYTIME=N.P., COMM/IND. ACCESS=E

SYSTEM				TRAFFIC		LINE DIAGRAM	TRAFFIC				PAVEMENT DATA
FED. AID.	FUNCT. CLASS.	HWY. SYS.	HPMS SAMPLE	PRK.G. REST.	COM/IND ACCESS		CONTROL	COM/IND ACCESS	PRK.G. REST.		

OP 167

CALVERT COUNTY

UNASSIGNED

NOW

CO 982, LAUREL DR

OP 168

CALVERT COUNTY

UNASSIGNED

NOW

CO 952, POPLAR RD.

95-51

Form 6 HPS (Rev. 1961)

ROAD INVENTORY SHEET

Party Chief T. LANDON
Recorder W. WARFIELD
Chainman B. HOOVER

Road No. OP 169
Name
Sheet No. 1 OF 1
Date 6-26-69
County CALVERT

973-212

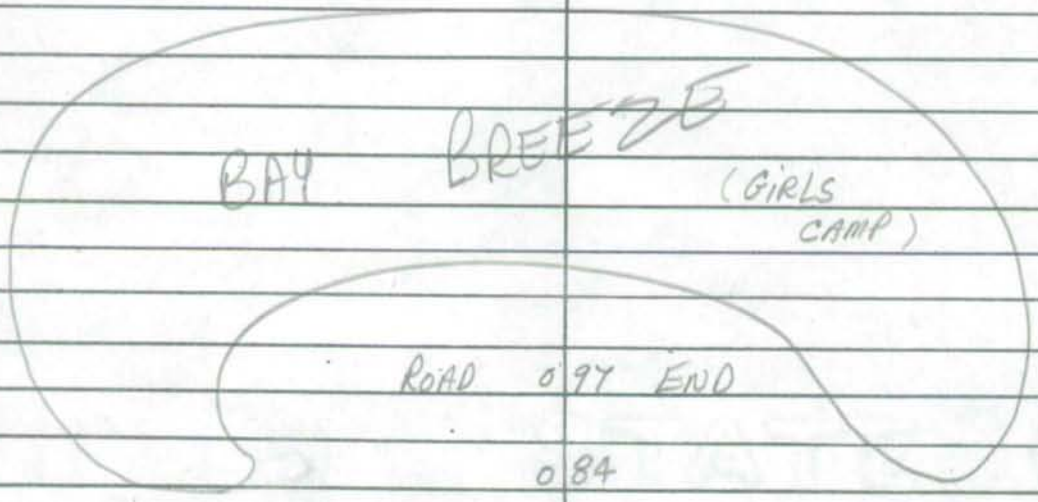

	ROAD	0 97	END	
I		0 84	40° ↑	
		0 77	20° ↑	
↑15°		0 72		
		0 61	25° ↑	
↑20°		0 51		
		0 47	30° ↑	
↑20°	H 41 31 PVT. RD 0 0 8'D	0 27		
	H-700 (ACAM.) CAMP	0 25	30° ↑	12'E 16'CW
	Co.	0 00	CONOY RD	
			72	

Form 6 HPS (Rev. 1961)

ROAD INVENTORY SHEET

Party Chief TLANDON
Recorder W. WARFIELD
Chainman B. HOOPER

Road No. OP 170
Name
Sheet No. 1 OF 1
Date 6-26-69
County CALVERT

J-13
955-206

		H	
ROAD	0	14 END H	
	0	12 H	
		PVT. RD	0
SOLLERS CO.	0	10 8'D	1.8
			8'D
			12'CW
	0	00 BRIDGE	
		112 RD	

Form 6 HPS (Rev. 1961)

93 Co. Ex. #9, #10
3-7-94
ALITM

ROAD INVENTORY SHEET

Party Chief T. LANDON
Recorder W. WARFIELD
Chainman R. HOOPER

J-13

946-202.5

Road No. OP 171
Name MEARS CREEK RD
Sheet No. 1 OF 1
Date 6-26-69
County CALVERT

			H	
5	ROAD	0	53 END	
	H	0	49	
		0	47	80° →
	↑ 50°	0	42	
		0	36	90° → 10'D 14'CW
	OP 172	0	33	H H-200'
		0	31	H-600'
			Martha's Way	
		0	28 PVT DRIVE	H-900'
		0	21	DR 18'D ~~DE~~ 16'CW
	(SOLLERS		Wharf RD)	
	CO.	0	00	
			112	

RIVER
PATUXENT

Form 6 HPS (Rev. 1961)

93 CO-EX-#9
3-7-94
AL/TM

ROAD INVENTORY SHEET

Party Chief T. LANDON
Recorder W. WARFIELD
Chainman B. HOOPER

J-13

945.5-201.5

Road No. OP 172
Name
Sheet No. 1 OF 1
Date 6-26-69
County CALVERT

S

PATUXENT. RIVER

H

ROAD	0	20	END
H	0	17	
	0	13	40°
	0	09	H
	0	07	H
MEARS CREEK		RD	
OP	0	00	

12'E
16'CW

Form 6 HPS (Rev. 1961)

ROAD INVENTORY SHEET

Party Chief T. LANDON
Recorder W. WARFIELD
Chairman B. HOOPER

COVE POINT

3-13
974.5-199

Road No. OP 173
Name PARK DR
Sheet No. 1 OF 1
Date 7-1-69
County CALVERT

H	ROAD 012	END	
H	010		
LIGHTHOUSE		BLVD.	
CO.	006	118	
		CALVERT BLVD #2	
	003	OP 184	
H	001	H	12'E 16'CW
	ROAD 000	END	
	XXX		
CHESAPEAKE		BAY	

Form 6 HPS (Rev. 1961)

ROAD INVENTORY SHEET

Party Chief T. LANDON
Recorder W. WARFIELD
Chainman B. HOOPER

COVE POINT
J-13
975-199

Road No. OP 174
Name BEACH DR.
Sheet No. 1 OF 1
Date 7-1-69
County CALVERT

ROAD	0	16	END SC	
H	0	14	H	
H	0	12	H	
	0	08	H	
LIGHT HOUSE CO.	0	07	BLVD 118	
CALVERT OP	0	03	BLVD #2 184	
				12'E
	0	01	H	16'CW
ROAD	0	00	END	
	X	XX		
CHESAPEAKE			BAY	

Form 6 HPS (Rev. 1961)

ROAD INVENTORY SHEET

Party Chief T. LANDON
Recorder W. WARFIELD
Chainman B. HOOPER

COVE POINT
J-13
975-199.5

Road No. OP 175
Name CHESAPEAKE DR
Sheet No. 1 OF 1
Date 7-1-69
County CALVERT

N	H-200'	ROAD	0 16	END H
	H		0 15	
	H		0 14	
	H		0 11	
			0 07	H
	LIGHTHOUSE			BLVD
	CO		0 06	118
	CALVERT			BLVD #2
	OP		0 03	184
		ROAD	0 00	END
			XXX	
	CHESAPEAKE			BAY

Form 6 HPS (Rev. 1961)

ROAD INVENTORY SHEET

Party Chief T. LANDON
Recorder W. WARFIELD
Chainman B. HOOPER

COVE POINT

J-13

975-200

Road No. OP 176
Name WEBSTER DR
Sheet No. 1 OF 1
Date 7-1-69
County CALVERT

ROAD	0	20	END H	
	0	15		
H	0	13	4 H	
	0	10		
LIGHT HOUSE			BLVD	
CO	0	07	118	
NW	0	05	H	
CALVERT BLVD #2				
OP 184	0	03		
			CALVERT BLVD #1	
	0	02	OP 183	
				12'E
	0	01	H	16'CW
ROAD	0	00	END	
		XXX		
CHESAPEAKE			BAY	

Form 6 HPS (Rev. 1961)

ROAD INVENTORY SHEET

Party Chief T. LANDON
Recorder W. WARFIELD
Chairman B. HOOPER

COVE POINT
J-13
9755-2005

Road No. OP 177
Name HOLLY DR
Sheet No. 1 OF 1
Date 7-1-69
County CALVERT

	ROAD.	017	END H	
		015		
		014	H	
4 H				
		011	H	
		009	H	
	LIGHT HOUSE		BLVD	
	CO.	006	118	
H		003		
	CALVERT		BLVD #1	12'E
	OP	002	183	16'CW
	ROAD	000	END	
		XXX		
	CHESAPEAKE		BAY	

Form 6 HPS (Rev. 1961)

ROAD INVENTORY SHEET

Party Chief T. LANDON
Recorder W. WARFIELD
Chainman B. HOOPER

COVE POINT
J-13
976-200.5

Road No. OP 178
Name CEDAR DR
Sheet No. 1 OF 1
Date 7-1-69
County CALVERT

H	ROAD	021	END H	
H		018	H	
H		016		
		014	12" CMP	
H		013		
		011	H	
		010	H	
LIGHTHOUSE			BLVD.	
CO.		007	118	
H		004		
CALVERT				12'E
OP		002	BLVD #1	16'CW
			183	
ROAD		000	END H	
		XXX		
CHESAPEAKE			BAY	

Form 6 HPS (Rev. 1961)

ROAD INVENTORY SHEET

Party Chief T. LANDON
Recorder W. WARFIELD
Chainman B. HOOPER

COVE POINT

J-13

976-201

Road No. OP 179
Name ELM DR.
Sheet No. 1 OF 1
Date 7-1-69
County CALVERT

H ROAD.	021	END	
	020	H	
SC	018	H	10'E 14'CW
	012	H	X
H	011	H	
LIGHTHOUSE CO.	007	BLVD. 118	
	005	H	
CALVERT OP	002	BLVD #1 183	12'E 16'CW
ROAD	000	END	
	XXX		
CHESAPEAKE		BAY	

Form 6 HPS (Rev. 1961)

ROAD INVENTORY SHEET

Party Chief T. LANDON
Recorder W. WARFIELD
Chainman B HOOPER

COVE POINT

5-13

976.5-201

Road No. OP 180
Name POPLAR DR
Sheet No. 1 OF 1
Date 7-1-69
County CALVERT

	ROAD 022	END
6 H		
	013	
LIGHTHOUSE		BLVD
CO.	008	118
CALVERT BLVD #1		
OP 183	002	
		CALVERT BLVD
H	001	OP 182
	ROAD 000	END
	XXX	
CHESAPEAKE		BAY

12'E
16'CW

Form 6 HPS (Rev. 1961)

ROAD INVENTORY SHEET

Party Chief T. LANDON
Recorder W. WARFIELD
Chainman B. HOOPER

COVE POINT
J-13
977-201.5

Road No. OP 181
Name HEMLOCK DR
Sheet No. 1 OF 1
Date 7-1-69
County CALVERT

	XXX		
ROAD	008	END	
	004	H.	
CALVERT BLVD			
OP ~~181~~ 182	003		
	002	H	
			12'E
	001	H	16'CW
ROAD	000	END	
	XXX		
CHESAPEAKE		BAY	

180
#1
176
#2

Form 6 HPS (Rev. 1961)

ROAD INVENTORY SHEET

Party Chief T. LANDON
Recorder W. WARFIELD
Chainman B. HOOPER

COVE POINT
J-13
976.5-201.5

Road No. OP 182
Name CALVERT BLVD
Sheet No. 1 OF 1
Date 7-1-69
County CALVERT

N

BAY

CHESAPEAKE

HEMLOCK			DR	X	
OP	0	11	181	X	↑
	0	09		H	
↱10°	0	06		H	
					12'E
H	0	03		H	16'CW
POPLAR			DR	X	
OP	0	00	180	X	↓

Form 6 HPS (Rev. 1961)

ROAD INVENTORY SHEET

Party Chief T. LANDON
Recorder W. WARFIELD
Chainman B. HOOKER

Road No. OP 183
Name CALVERT BLVD. #1
Sheet No. 1 OF 1
Date 7-1-69
County CALVERT

5-13
976.5-207

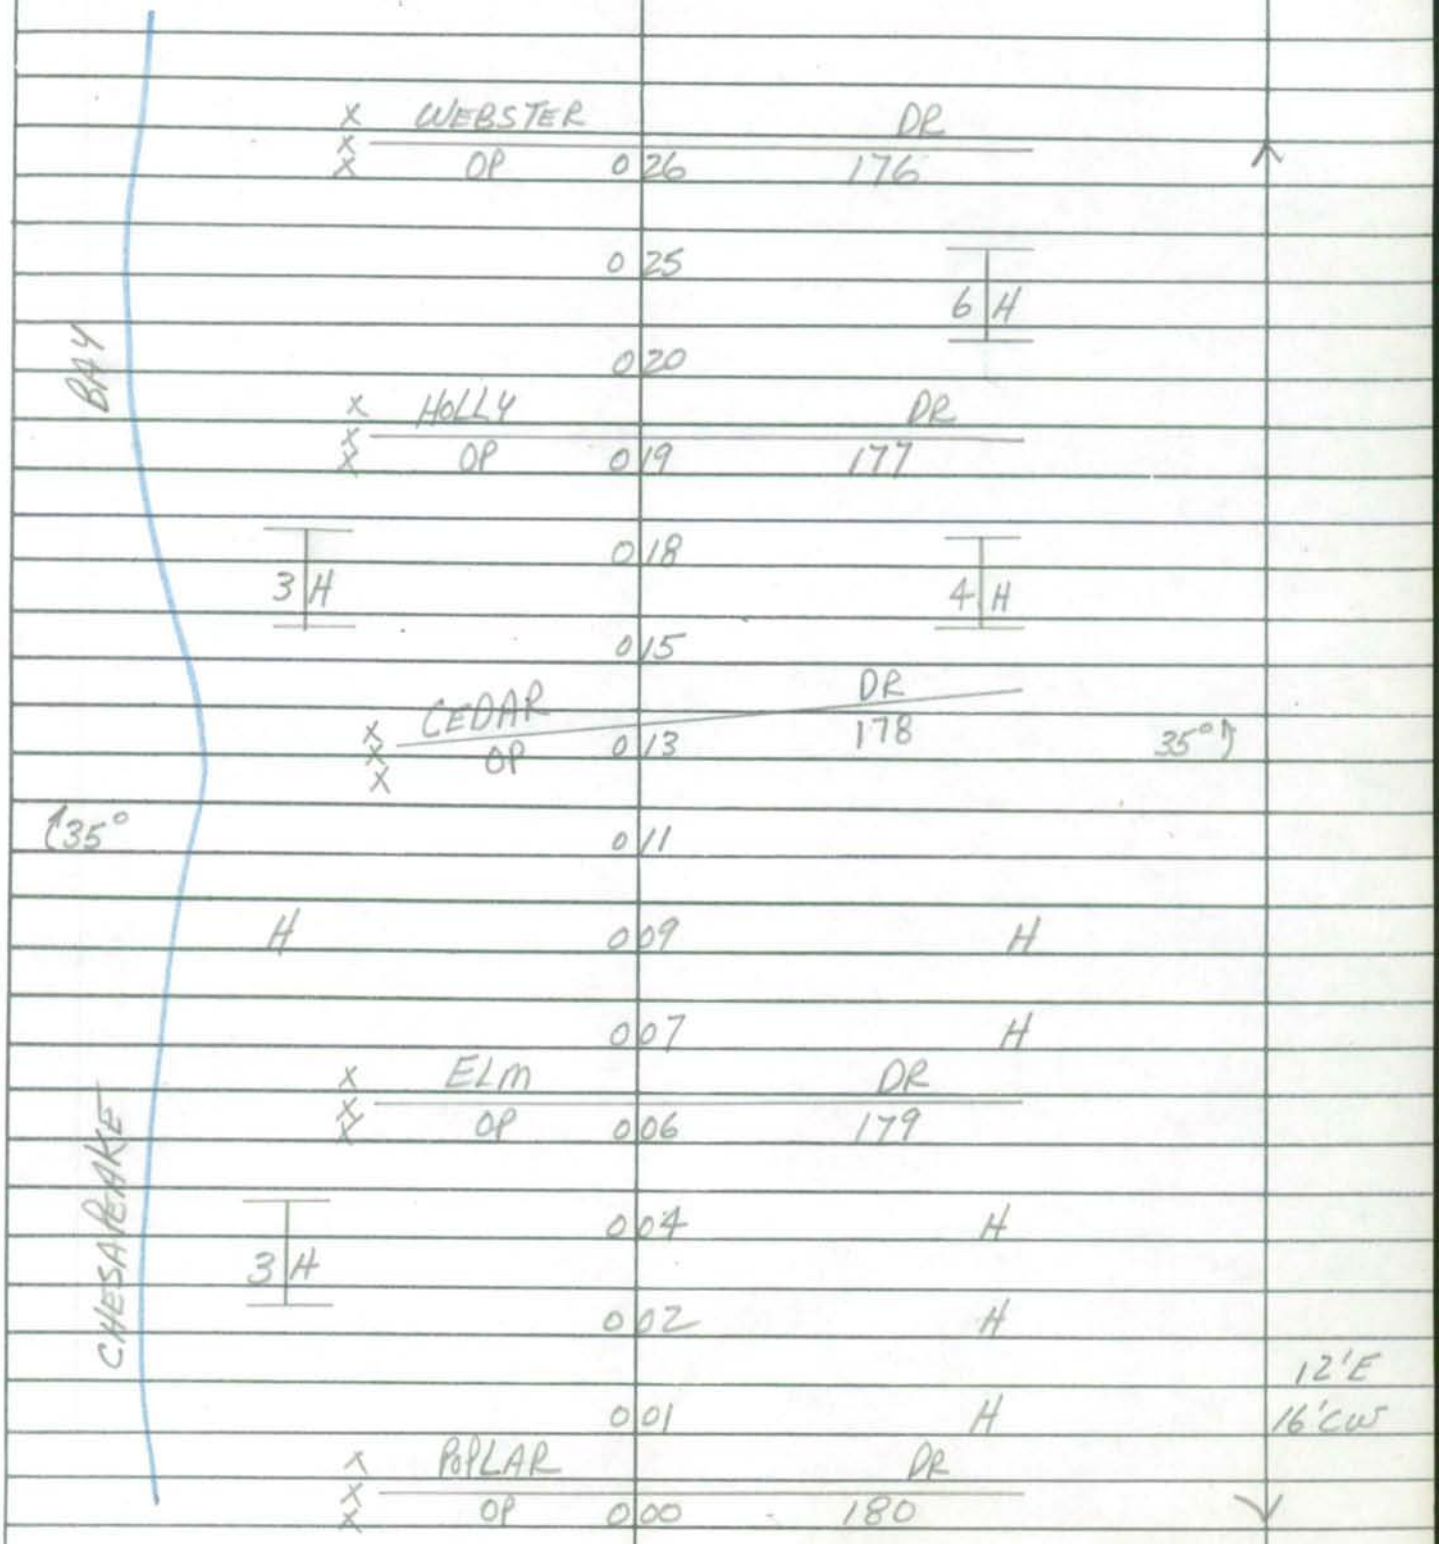

Form 6 HPS (Rev. 1961)

ROAD INVENTORY SHEET

Party Chief T. LANDON
Recorder W. WARFIELD
Chainman B. HOOPER

COVE POINT

5-13

975-200

Road No. Of 184
Name CALVERT BLVD. #2
Sheet No. 1 OF 1
Date 7-1-69
County CALVERT

	X PARK			DR	
	X OP	0	18	173	
BAY		0	15	H	
		0	14	H	
	H	0	13		
	X BEACH			DR	
	X OP	0	12	174	
		0	11		
		0	10	H	
	4 H				
		0	08	H	
		0	07	H	
CHESAPEAKE	X CHESAPEAKE			DR	
	X OP	0	06	175	
		0	04	H	
		0	03		
	3 H				12'E
		0	01	H	16'CW
	^ WEBSTER			DR	
	^ OP	0	00	176	

Form 6 HPS (Rev. 1961)

ROAD INVENTORY SHEET

Party Chief T. LANDON
Recorder W. WARFIELD
Chairman B. HOOPER

J-13
COVE POINT
950-197.5

Road No. OP 185
Name
Sheet No. 1 OF 1
Date 7-1-69
County CALVERT

S

HELLEN CREEK
URBAN LOCAL

	ROAD	0	52	END
	H	0	48	
	H	0	44	
	H	0	38	18"CMP 20°
155°		0	25	
				14'E
		0	21	18"CMP 20'CW
	TURNER			RD
	CO.	0	00	74

SHA 51.3 - 8 Revised
4.83

MARYLAND STATE HIGHWAY ADMINISTRATION

ROAD INVENTORY SHEET

Party Chief _____
Recorder _____
Assistant _____
Map No./Dir. 1
State Coordinates _____

Road No. OP186
Road Name _____
County CALVERT
Date _____
Sheet No. _____ OF _____

SYSTEM				TRAFFIC		LINE DIAGRAM	TRAFFIC			PAVEMENT DATA
FED. AID.	FUNCT CLASS.	HWY. SYS.	HPMS SAMPLE	PRKG. REST.	COM/IND. ACCESS		CONTROL	COM/IND. ACCESS	PRKG. REST.	
						See INV Of Co 680 85-74				

TRAFFIC CODES

TRAFFIC CONTROLS: STOP SIGN=S, TRAFFIC LIGHT=T, L., FLASHING RED BALL=F, R.

TRAFFIC CODES

PARKING RESTRICTIONS: A.M. PEAK, P.M. PEAK, A.M./P.M. PEAK, NO PARKING ANYTIME=N, P., COMM/IND. ACCESS=E

SYSTEM				TRAFFIC		LINE DIAGRAM	TRAFFIC				PAVEMENT DATA
FED. AID.	FUNCT. CLASS.	HWY. SYS.	HPMS SAMPLE	PRKG. REST.	COM/IND ACCESS		CONTROL	COM/IND ACCESS	PRKG. REST.		

OP 187

UNASSIGNED

SHA 51.3-8
11-15-72

STATE HIGHWAY ADMINISTRATION OF MARYLAND

ROAD INVENTORY SHEET

Party Chief _____
Recorder _____
Helper _____

Map No. _____

Road No. OP 188
Road Name _____
Sheet No. _____
Date _____
County CALVERT
State Coordinates _____

UNASSIGNED

NOW 6509

HPS-39

HILLTOP RD - CA

79-80

SHA 51.3-8
11-15-72

ROAD INVENTORY SHEET

Road No. _____
Road Name _____
Sheet No. _____
Date _____
County _____
State Coordinates _____

Form 6 HPS (Rev. 1961)

ROAD INVENTORY SHEET

Party Chief T. LANDON
Recorder W. WARFIELD
Chainman B. HOOPER

J-13
COVE POINT
957-183.5

Road No. OP 189
Name
Sheet No. 1 OF 1
Date 7-1-69
County CALVERT

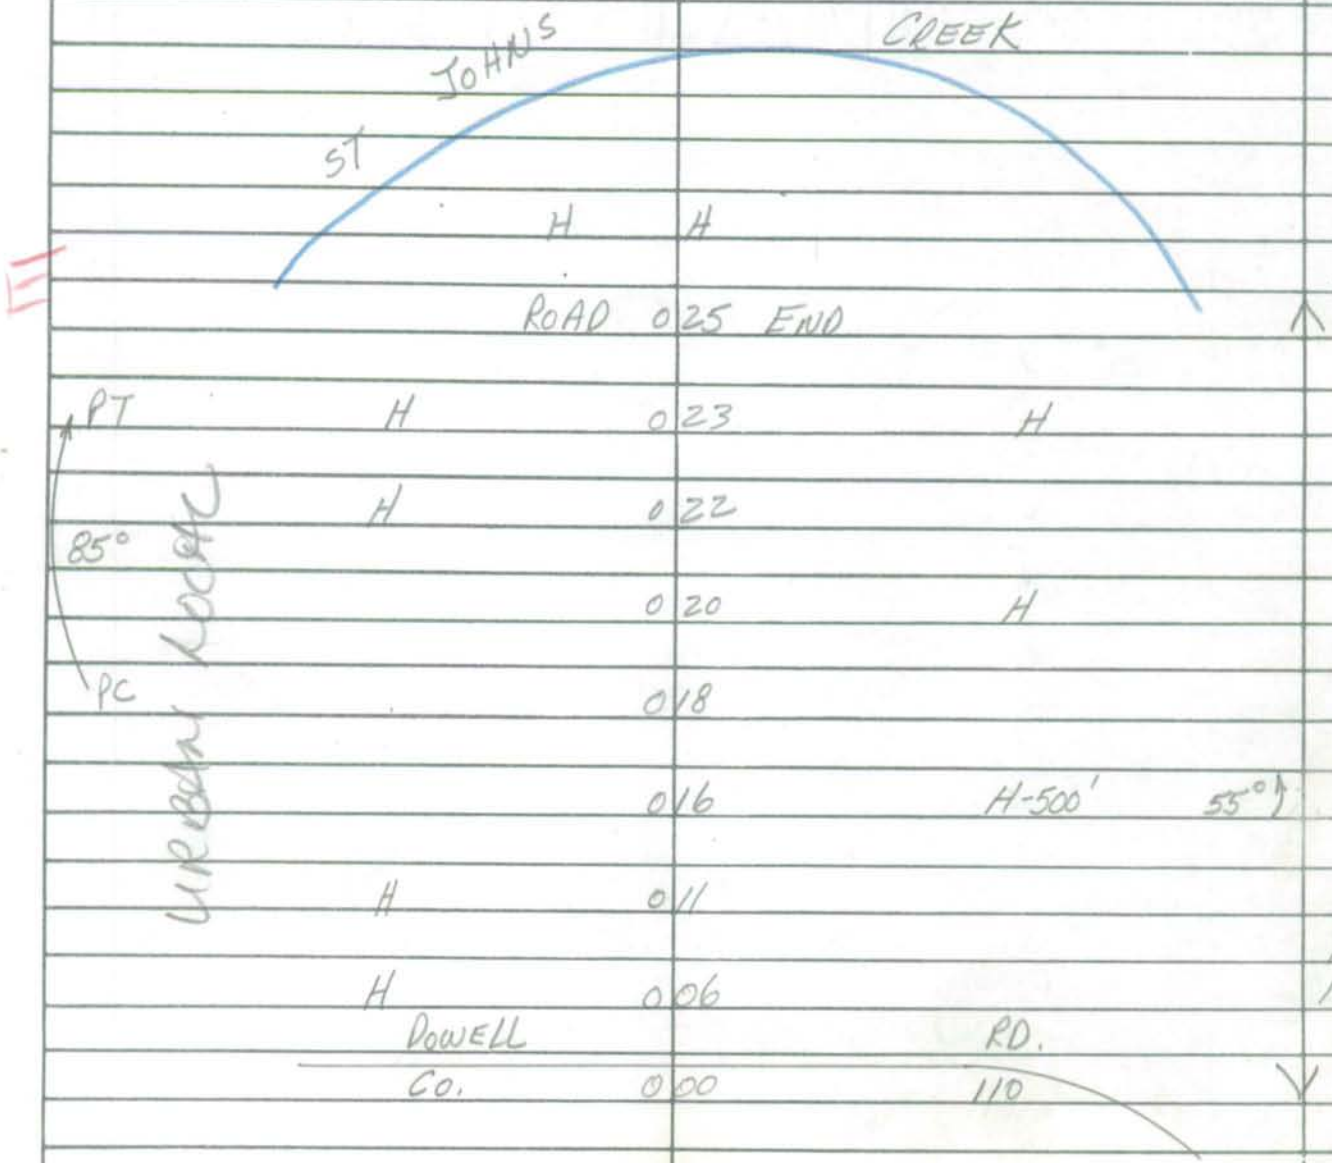

Form 6 HPS (Rev. 1961)

ROAD INVENTORY SHEET

Party Chief T. LANDON
Recorder W. WARFIELD
Chainman B. HOOPER

J-13
COVE POINT
957 - 184.5

Road No. OP 190
Name
Sheet No. 1 OF 1
Date 7-1-69
County CALVERT

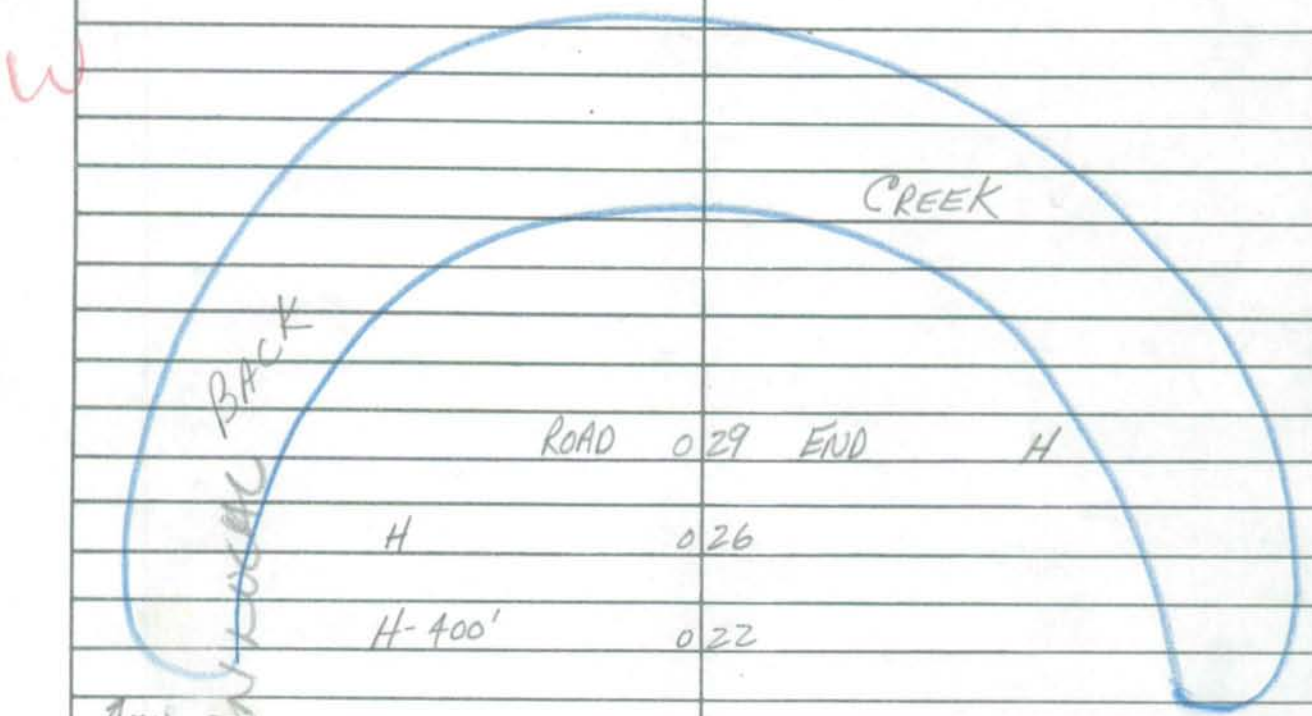

ROAD	0	29	END	H	
H	0	26			
H-400'	0	22			
70°	0	15			
	0	05	H	45°	8'D 12'CW
DOWELL CO.	0	00	RD. 110		

Form 6 HPS (Rev. 1961)

ROAD INVENTORY SHEET

Party Chief T. LANDON
Recorder W. WARFIELD
Chainman B. HOOPER

J-13
COVE POINT
956.5-185

Road No. OP 191
Name (Back Creek Rd)
Sheet No. 1 OF 1
Date 7-1-69
County CALVERT

BACK

H CREEK

H ROAD 010 END

H 006

H 003 12'E

DOWELL RD 16'CW

Co. 000 110

URBAN NO PARK

Form 6 HPS (Rev. 1961)

ROAD INVENTORY SHEET

Party Chief T. LANIGAN
Recorder W. WARFIELD
Chainman B. HOOPER

Co 248
Road No. ~~OR 192~~
Name
Sheet No. 1 OF 1
Date 7-1-69
County CALVERT

9565-185

72-11
NOW CO 248

ST. JOHNS	CREEK		
	H	H	
ROAD	0 16	END	
	0 14	H	H-50'
	0 11	H	
	0 09	H	
	0 06	H	
	0 02 RD 110	H	14'E 18'CW
DOWELL CO.	0 00		

Form 6 HPS (Rev. 1961)

ROAD INVENTORY SHEET

Party Chief T. LANDON
Recorder W. WARFIELD
Chairman B. HOOPER

S-13
COVE POINT
956.5 - 185.5

Road No. OP 193
Name
Sheet No. 1 OF 1
Date 7-1-69
County CALVERT

ST. JOHNS CREEK

H H

ROAD 0 30 END

0 28 H

H 0 24

15° 0 22

URBAN HIGH

0 16 H

0 13 H 12'E 16'CW

DOWELL CO. RD 110

0 00

Form 6 HPS (Rev. 1961)

00-EXIST
SS/AP
3-14-01

ROAD INVENTORY SHEET

Party Chief T. LANDON
Recorder W. WARFIELD
Chainman B. HOOKER

COVE POINT
J-13
953.5 - 189.5

Road No. OP 194
Name
Sheet No. 1 OF 1
Date 7-2-69
County CALVERT

S
D

		H	
ROAD	012	END	
	011	H	
POINT	006	H	
(SWAGGERS ~~PT.~~ RD)			
CO. 229(00-EXIST)	005	H-300'	
	002	H	
	001	H	8'D 12'CW
ROAD	000	END	
H	H		
		H	
HUNGERFORD			

CREEK

Form 6 HPS (Rev. 1961)

ROAD INVENTORY SHEET

Party Chief T. LANDON
Recorder W. WARFIELD
Chairman B. HOOPER

Road No. OP 195
Name Strathmore LN
Sheet No. 1 OF 1
Date 7-2-69
County CALVERT

COUNTY ROUTE 13

953.5-181

		H		
ROAD	0	22	END	
	0	19	H	
	0	18	PT	10'G 14'CW
	0	16	4 SC 95°	
	0	15		12'I
	0	14	PC	16'CW
	0	10		12'G
SOLOMONS		ISLAND	RD S.	16'CW
~~AD~~ CO	0	00	= 1090	

RIVER

PATUXENT

CHESAPEAKE BEACH

Form 6 HPS (Rev. 1961)

ROAD INVENTORY SHEET

Party Chief T. LANDON
Recorder W. WARFIELD
Chainman B. HOOPER

K-13
COVE POINT
956.5 - 178

Road No. OP 196
Name MALTBY ST
Sheet No. 1 OF 1
Date 7-2-69
County CALVERT

		H	
CHRONAL LOCATN	S. ↑ ROAD 007 END		∧
	H-(ABAN.) CHARLES ~~SOLOMONS~~	005 ST ~~ISLAND~~ H	PP
	~~AND~~ CO	002 1089	8'D 12'CW
	ROAD 000 END	B-MARINA CREEK	∨
	BACK		

5

Form 6 HPS (Rev. 1961)

93 CO EX #1
3-7-94
AL/TM

ROAD INVENTORY SHEET

Party Chief T. LANDON
Recorder W. WARFIELD
Chainman B HOOPER

K-13
COVE POINT

955-179.5

Road No. OP 197
Name
Sheet No. 1 OF 1
Date 7-2-69
County CALVERT

Form 6 HPS (Rev. 1961)

93 CO EX #1
3-7-94
AL/TM

ROAD INVENTORY SHEET

Party Chief T. LANDON
Recorder W. WARFIELD
Chainman B. HOOPER

K-13
COVE POINT

Road No. OP 198
Name
Sheet No. 1 OF 1
Date 7-2-69
County CALVERT

955-180

N

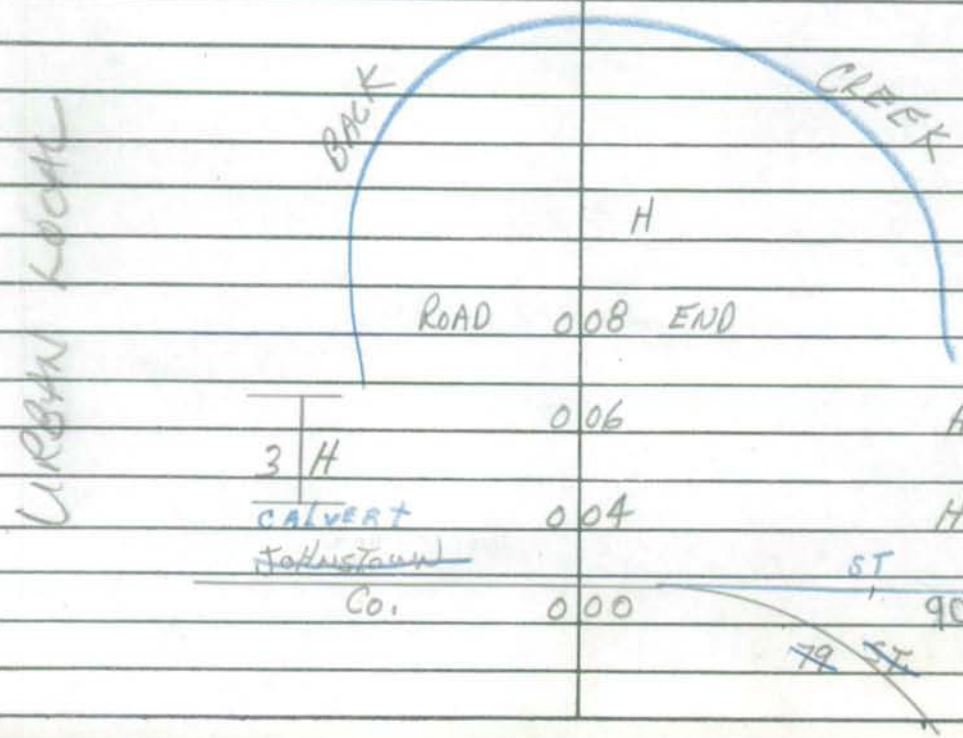

Form 6 HPS (Rev. 1961)

ROAD INVENTORY SHEET

Party Chief T. LANDON
Recorder W. WARFIELD
Chainman B. HOOPER

Road No. OP 199
Name
Sheet No. 1 OF 1
Date 7-2-69
County CALVERT

5-13

COVE POINT

959.5 - 184

W

ST. JOHNS CREEK

CHESAPEAKE BEACH

H		H	
ROAD	0	08 END	
H	0	06 H	
OLIVET		RD	10'E 14'CWS
Co	0	00 123	

Form 6 HPS (Rev. 1961)

ROAD INVENTORY SHEET

Party Chief T. LANDON
Recorder W. WARFIELD
Chainman B. HOOPER

5-13

COVE POINT
959-185

Road No. OP 200
Name
Sheet No. 1 OF 1
Date 7-2-69
County CALVERT

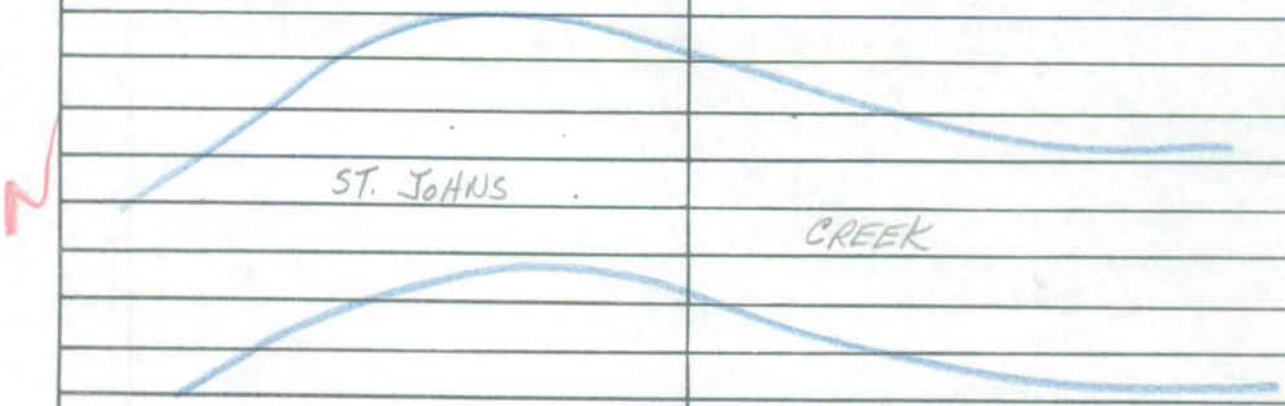

H
↑
600'
↓

ROAD 0 17 END H ↑

0 07 OP 201

0 04 70° ↑

E.
CO. JOY

0 00 ↓

10'E
14'CW

RD 119

URBAN ROCK

Form 6 HPS (Rev. 1961)

ROAD INVENTORY SHEET

Party Chief T. LANDON
Recorder W. WARFIELD
Chainman B. HOOPER

J-13
COVE POINT

Road No. OP 201
Name
Sheet No. 1 OF 1
Date 7-2-69
County CALVERT

83-16 JE NS 2-15-84 959-185.5

OLIVET

~~0.0~~

~~0.44~~ ~~1.0~~ ~~1.28~~

PT 65° ST JOHNS CREEK RD

~~0.83~~

~~0.82~~ 0.32 618

PC

0.30

H-500'

0.12

10°

H-600'

0.08

10'E
14'CW

OP 0.00

200

URBANNA

urban local

GPS-02
6-21-02
GD/RI

SHA 51.3 - 8 Revised 4.83

MARYLAND STATE HIGHWAY ADMINISTRATION

ROAD INVENTORY SHEET

Party Chief JE
Recorder NS
Assistant Rewritten 9-12-02
Map No./Dir. J-13 / W
State Coordinates 960-187

Road No. OP 202
Road Name Big Rd
County Calvert
Date 2-15-84
Sheet No. 1 OF

SYSTEM: FUNCT CLASS | HWY SYS | HPMS SAMPLE
TRAFFIC: PREG. REST. | COM/IND ACCESS

LINE DIAGRAM

Road
0 31 End
0 20
PT
65°
PC
0 18
0 00
St. Johns Creek Rd
0 0 18

TRAFFIC: CONTROL | COM/IND ACCESS | PREG. REST.

PAVEMENT DATA
10' E

TRAFFIC CODES
TRAFFIC CONTROLS: STOP SIGN-SS, TRAFFIC LIGHT-T.L., FLASHING RED BALL-F.R.

TRAFFIC CODES
PARKING RESTRICTIONS: A.M. PEAK, P.M. PEAK, A.M./P.M. PEAK, NO PARKING ANYTIME-N.P., COMM/IND. ACCESS-I

COUNTY _____ ROAD NO. _____ PAGE ___ OF ___

SYSTEM				TRAFFIC		LINE DIAGRAM	TRAFFIC				PAVEMENT DATA
FUNCT CLASS	HWY SYS	NHS	STATE	PREG	ADT	COM/IND ACCESS			COM/IND ACCESS	PREG. ADT	

SHA 51.3-8
11-15-72

STATE HIGHWAY ADMINISTRATION OF MARYLAND

ROAD INVENTORY SHEET

Party Chief _____
Recorder _____
Helper _____

Map No. _____

Road No. OP202
Road Name _____
Sheet No. _____
Date _____
County CALVERT
State Coordinates _____

See Inventory
OC 6618
83-16

Urban
Local

SHA 51.3-8
11-15-72

ROAD INVENTORY SHEET

Road No. _____
Road Name _____
Sheet No. _____
Date _____
County _____
State Coordinates _____

Form 6 HPS (Rev. 1961)

ROAD INVENTORY SHEET

Party Chief T. LANDON
Recorder W. WARFIELD
Chainman B. HOOPER

COVE J-13 Point
959.5-187

Road No. OP 203
Name
Sheet No. 1 OF 1
Date 7-2-69
County CALVERT

	ROAD	0	31	END H	
	H	0	29	H	
		0	23	H	
		0	21		20°
	H	0	17		
PT 25° PC		0	09		
	ST JOHNS CRK OP	0	04		10'E 14'CW
		0	00	CREEK RD 618	

URBAN RECORD

Form 6 HPS (Rev. 1961)

ROAD INVENTORY SHEET

Party Chief T. LANDON
Recorder W. WARFIELD
Chainman B. HOOPER

Road No. OP 204
Name
Sheet No. 1 OF 1
Date 7-2-69
County CALVERT

COVE POINT J-13

960.5-189

Form 6 HPS (Rev. 1961)

ROAD INVENTORY SHEET

Party Chief T. LANDON
Recorder W. WARFIELD
Chainman

Cove B-13
969-186

Road No. OP 205
Name (VALERIE LANE)
Sheet No. 1 OF 1
Date 7-9-69
County CALVERT

W

MILL CREEK

H ROAD 0 09 END

0 06 PT 10'E 14'CW

0 04 50°

0 02 PC 16'G 22'CW

0 00

URBANA NECK

HALL RD 76°

Rock Hill RD

SHA 51.3 - 8 Revised
4.83

MARYLAND STATE HIGHWAY ADMINISTRATION

ROAD INVENTORY SHEET

Party Chief: I. LANDON
Recorder: W. Warfield
Assistant: Rewritten (10/26/90) JEL
Map No./Dir.: 7-13 / (W)
State Coordinates: 964.5 - 184

Road No.: OP 206
Road Name: Anchor Dr
County: Calvert
Date: 7-9-64
Sheet No.: 1 OF 2

SYSTEM: FED. AID. | FUNCT. CLASS. | HWY. SYS. | HPMS SAMPLE
TRAFFIC: PRKG. REST. | COM/IND. ACCESS

LINE DIAGRAM

0 28 — PRC — 35° — PRC
0 25 — PRC — 120° — PC
0 20
0 18 — 18" CMP
0 14 — PT — 60° — PRC
0 12 — PRC — 45° — PC
0 07 — 18" CMP
OP 208 0 06
Bowsby Hall Rd
MD 0 00 760 @ 1.59

TRAFFIC: CONTROL | COM/IND. ACCESS | PRKG. REST.

PAVEMENT DATA
14' G
20' CW

Non FIA
K K Urban Rural Local

TRAFFIC CODES
TRAFFIC CONTROLS: STOP SIGN=SS, TRAFFIC LIGHT=T.L., FLASHING RED BALL=F.R.

TRAFFIC CODES
PARKING RESTRICTIONS: A.M. PEAK, P.M. PEAK, A.M./P.M. PEAK, NO PARKING ANYTIME=N.P., COMM/IND. ACCESS=E

SYSTEM				TRAFFIC		LINE DIAGRAM	TRAFFIC			PAVEMENT DATA
FED. AID.	FUNCT. CLASS.	HWY. SYS.	HPMS SAMPLE	PRK.G. REST.	COM/IND ACCESS		CONTROL	COM/IND ACCESS	PRK.G. REST.	
Non F/A	Local	Urban				0.34 Mill Creek Dr 676				14' G 20' CW

Form 6 HPS (Rev. 1961)

ROAD INVENTORY SHEET

Party Chief T. LANDON
Recorder W. WARFIELD
Chainman

Solomons
Blow-up
J-13
963.5-186

Road No. OP 207
Name
Sheet No. 1 OF 1
Date 7-9-69
County CALVERT

MILL CREEK

H

D E

CUL 005 SAC

003 10°

12'
16' CW

CALVERT DR OP 000 MILL CREEK 206 DR.

URBANNA LOOP

Form 6 HPS (Rev. 1961)

ROAD INVENTORY SHEET

Party Chief T. LANDON
Recorder W. WARFIELD
Chainman

Solomons Blow-UP

J-23

964-183.5

Road No. OP 208
Name
Sheet No. 1 OF 1
Date 7-9-69
County CALVERT

S

ROUSBY HALL RD.

MP	013	760	
	011		PT 65° PRC
PRC 20° PRC	008		
	006		PRC 40° PC
	003		10'E 14'CW
ANCHOR OP	000	OR. 206	

URBAN MOCK

Form 6 HPS (Rev. 1961)

V 1

ROAD INVENTORY SHEET

Party Chief T. LANDON
Recorder W. WARFIELD
Chainman

Solomons
Blow-UP
5-13
9645-182.5

Road No. OP 209
Name
Sheet No. 1 OF 1
Date 7-9-69
County CALVERT

LEASON — COVE DR
OP 0 34 210

PT H-400' 0 31

H-200' 0 30

75° H 0 29 14'G 20'CW

0 28 X

PC 0 25

URBANNA ROAD

10° 0 16

0 13 15"CMP

0 01 35° 10'E 14'CW

ROUSBY — HALL RD
MD 0 00 760

Form 6 HPS (Rev. 1961)

ROAD INVENTORY SHEET

Party Chief T. LANDON
Recorder W. WARFIELD
Chainman

Solomons
Blow UP
5-13
962.5-183

Road No. OP 210
Name LEASON COVE DR.
Sheet No. 1 OF 2
Date 7-9-69
County CALVERT

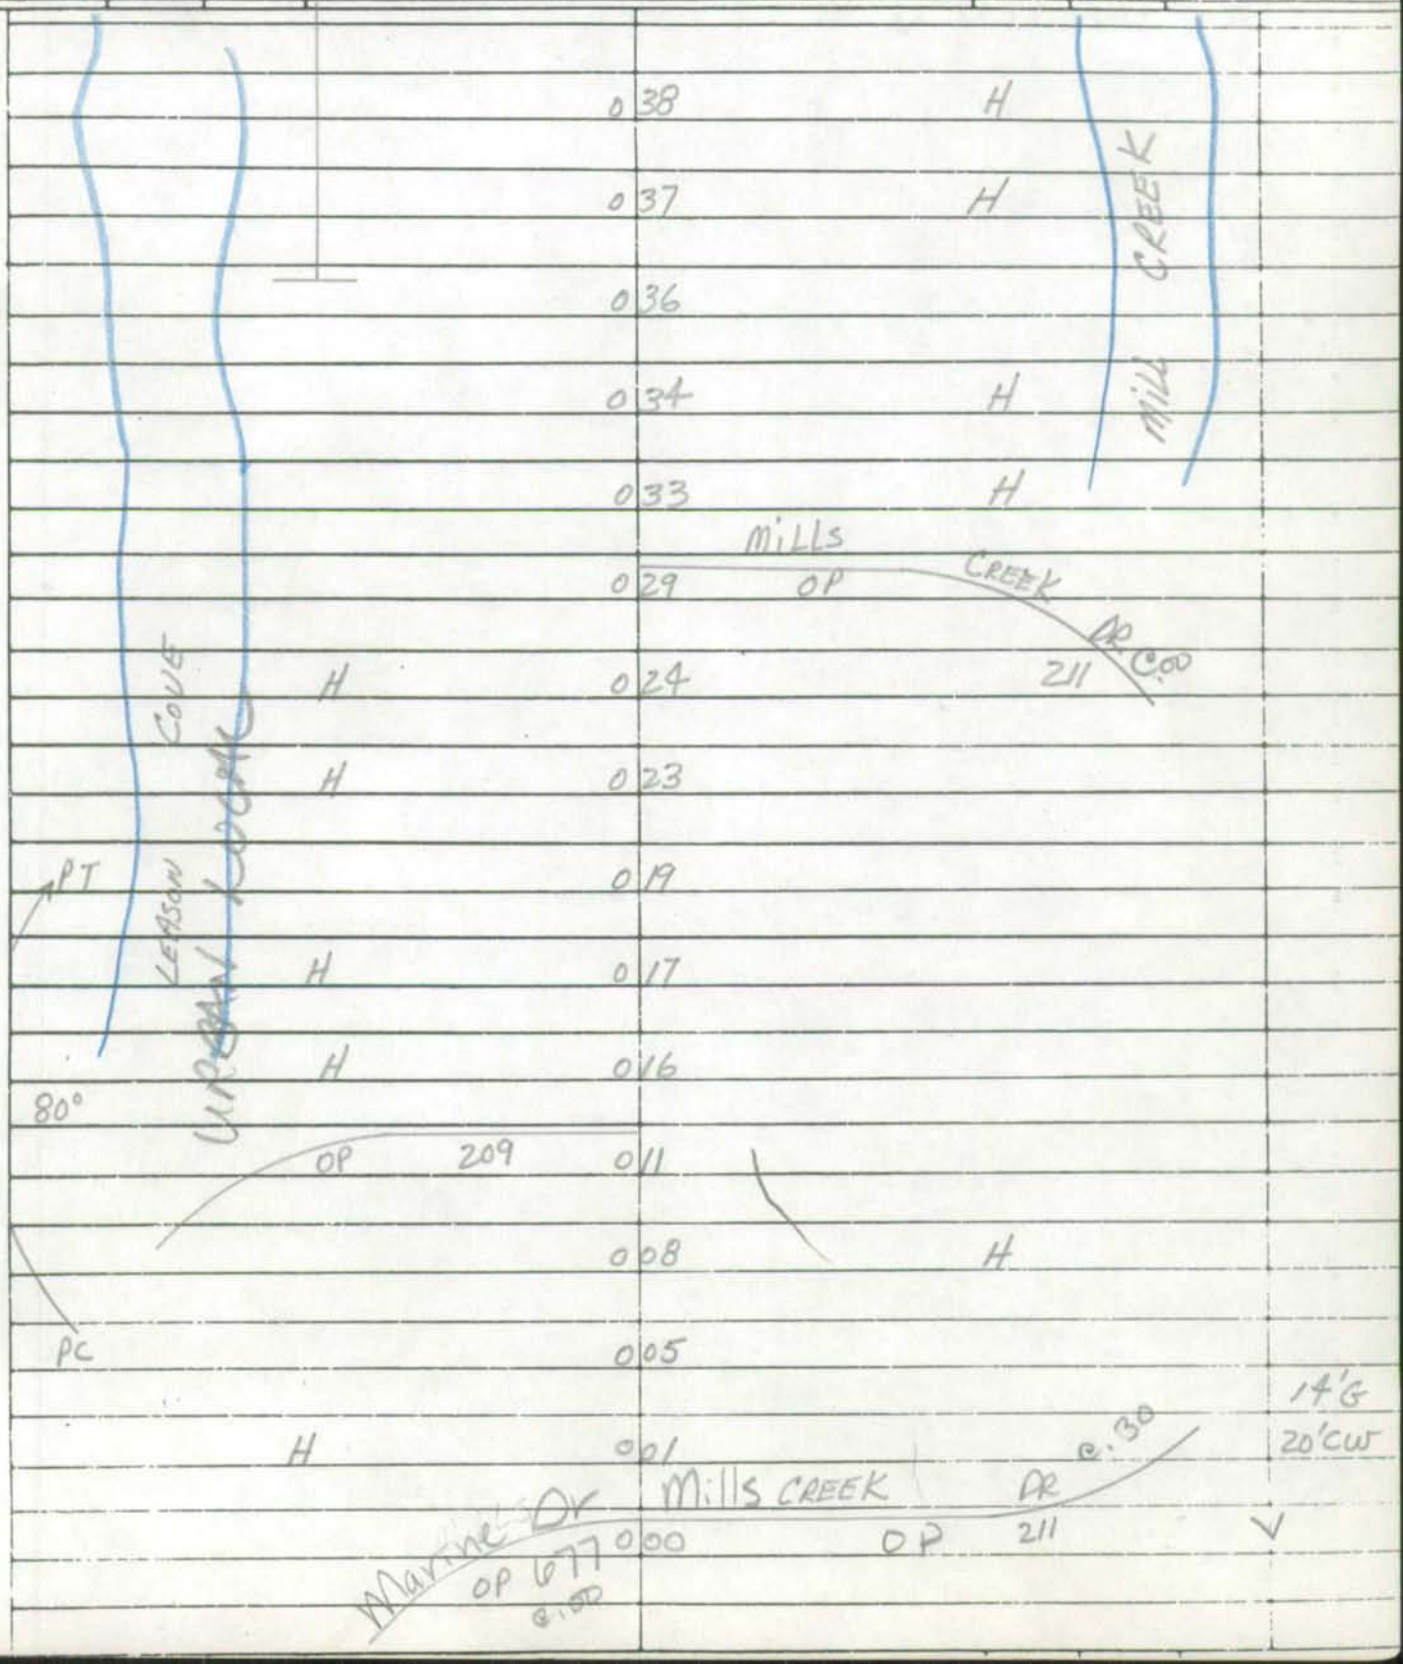

Form 6 HPS (Rev. 1961)

ROAD INVENTORY SHEET

Party Chief T. LANDON
Recorder W. WARFIELD
Chainman

Road No. OP 210
Name LEASON COVE RD
Sheet No. 2 OF 2
Date 7-9-69
County CALVERT

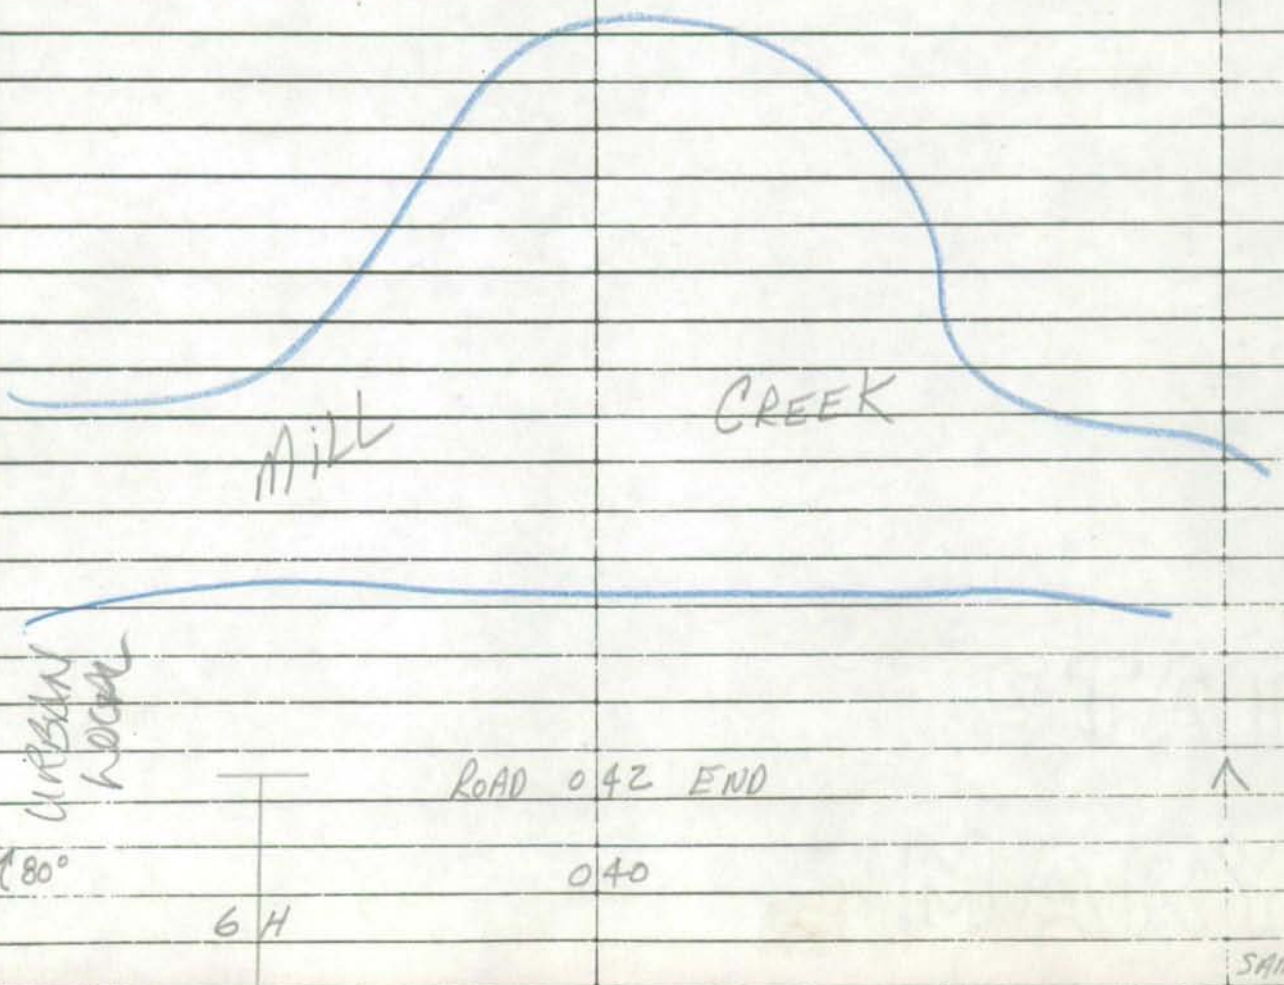

SHA 51.3 - 8 Revised
4.83

MARYLAND STATE HIGHWAY ADMINISTRATION

ROAD INVENTORY SHEET

Party Chief J. Landon
Recorder W. Warfield
Assistant Rewritten (10/29/70) JEL
Map No./Dir. J-13 / N
State Coordinates 961 - 182.5

Road No. OP 211
Road Name Mills Creek Dr
County Calvert County
Date 7-9-69
Sheet No. 1 OF 1

TRAFFIC CODES
TRAFFIC CONTROLS: STOP SIGN=SS, TRAFFIC LIGHT=T.L., FLASHING RED BALL=F.R.

TRAFFIC CODES
PARKING RESTRICTIONS: A.M. PEAK, P.M. PEAK, A.M./P.M. PEAK, NO PARKING ANYTIME=N.P., COMM/IND. ACCESS=E

SYSTEM				TRAFFIC		LINE DIAGRAM	TRAFFIC			PAVEMENT DATA
FED. AID.	FUNCT CLASS.	HWY. SYS.	HPMS SAMPLE	PRKG. REST.	COM/IND. ACCESS		CONTROL	COM/IND. ACCESS	PRKG. REST.	
						Maxine Dr @ 0.00				
						LEASON COVE DR @ 0.00				
						0.30 OP 210				16' G
										22' CW
						PT 0.26				
						100°				
						PRC 0.22 Mill Creek				
						PRC				14' G
						0.09				20' CW
						95°				
						PC 0.02				
						LEASON COVE DR @ 0.21				
						OP 0.00 210				

NON F/A
Rural Local

SYSTEM				TRAFFIC		LINE DIAGRAM	TRAFFIC			PAVEMENT DATA
FED. AID.	FUNCT. CLASS.	HWY. SYS.	HPMS SAMPLE	PRKG. REST.	COM/IND ACCESS		CONTROL	COM/IND ACCESS	PRKG. REST.	

Form 6 HPS (Rev. 1961)

ROAD INVENTORY SHEET

Party Chief T. LANDON
Recorder W. WARFIELD
Chainman

Solomons
Blow-UP
J-13
963-183.5

Road No. OP 212
Name SHIPS WAY
Sheet No. 1 OF 1
Date 7-9-69
County CALVERT

W

HARBOR
OP
0.07
0.31
680
DR.
225

H
0.04

HARBOR
OP
0.00
0.19
680
DR.
285

16'G
22'CW

Form 6 HPS (Rev. 1961)

ROAD INVENTORY SHEET

Party Chief T. LANDON
Recorder W. WARFIELD
Chainman

Solomons Blow-Up

961 - 180.5

Road No. OP 213
Name HARBOR LANE
Sheet No. 1 OF 1
Date 7-9-69
County CALVERT

N

LANE / 213

0 24

HARBOR / OP

HARBOR LANE / 213

OP 0 23

0 20

0 19

COVE

LEASON

PT
235°
PC

URBAN Locate

9'E
12°CW

ROUSBY — HALL RD

MD 0 00 760

Form 6 HPS (Rev. 1961)

ROAD INVENTORY SHEET

Party Chief T. LANDON
Recorder W. WARFIELD
Chainman

Solomons
Blow-up

J-13
961-180

Road No. OP 214
Name JOHNSON DR
Sheet No. 1 OF 1
Date 7-9-69
County CALVERT

N

DEER
OP
DR.
215
0 35
0 33
0 30
0 29
0 24
JOHNSON CT.
PROPOSED RD
0 23
0 21
ROUSBY
HALL RD
MD
0 00
760
H
H
LEASON COVE
PT
30°
PC
15"CMP
PT
60°
PC
15'G
20'CW
UPBACH LOCAL

Form 6 HPS (Rev. 1961)

ROAD INVENTORY SHEET

Party Chief T. LANDON
Recorder W. WARFIELD
Chainman

Solomons Blow-up

Road No. OP 215
Name DEER DR.
Sheet No. 1 OF 1
Date 7-9-69
County CALVERT

959-182

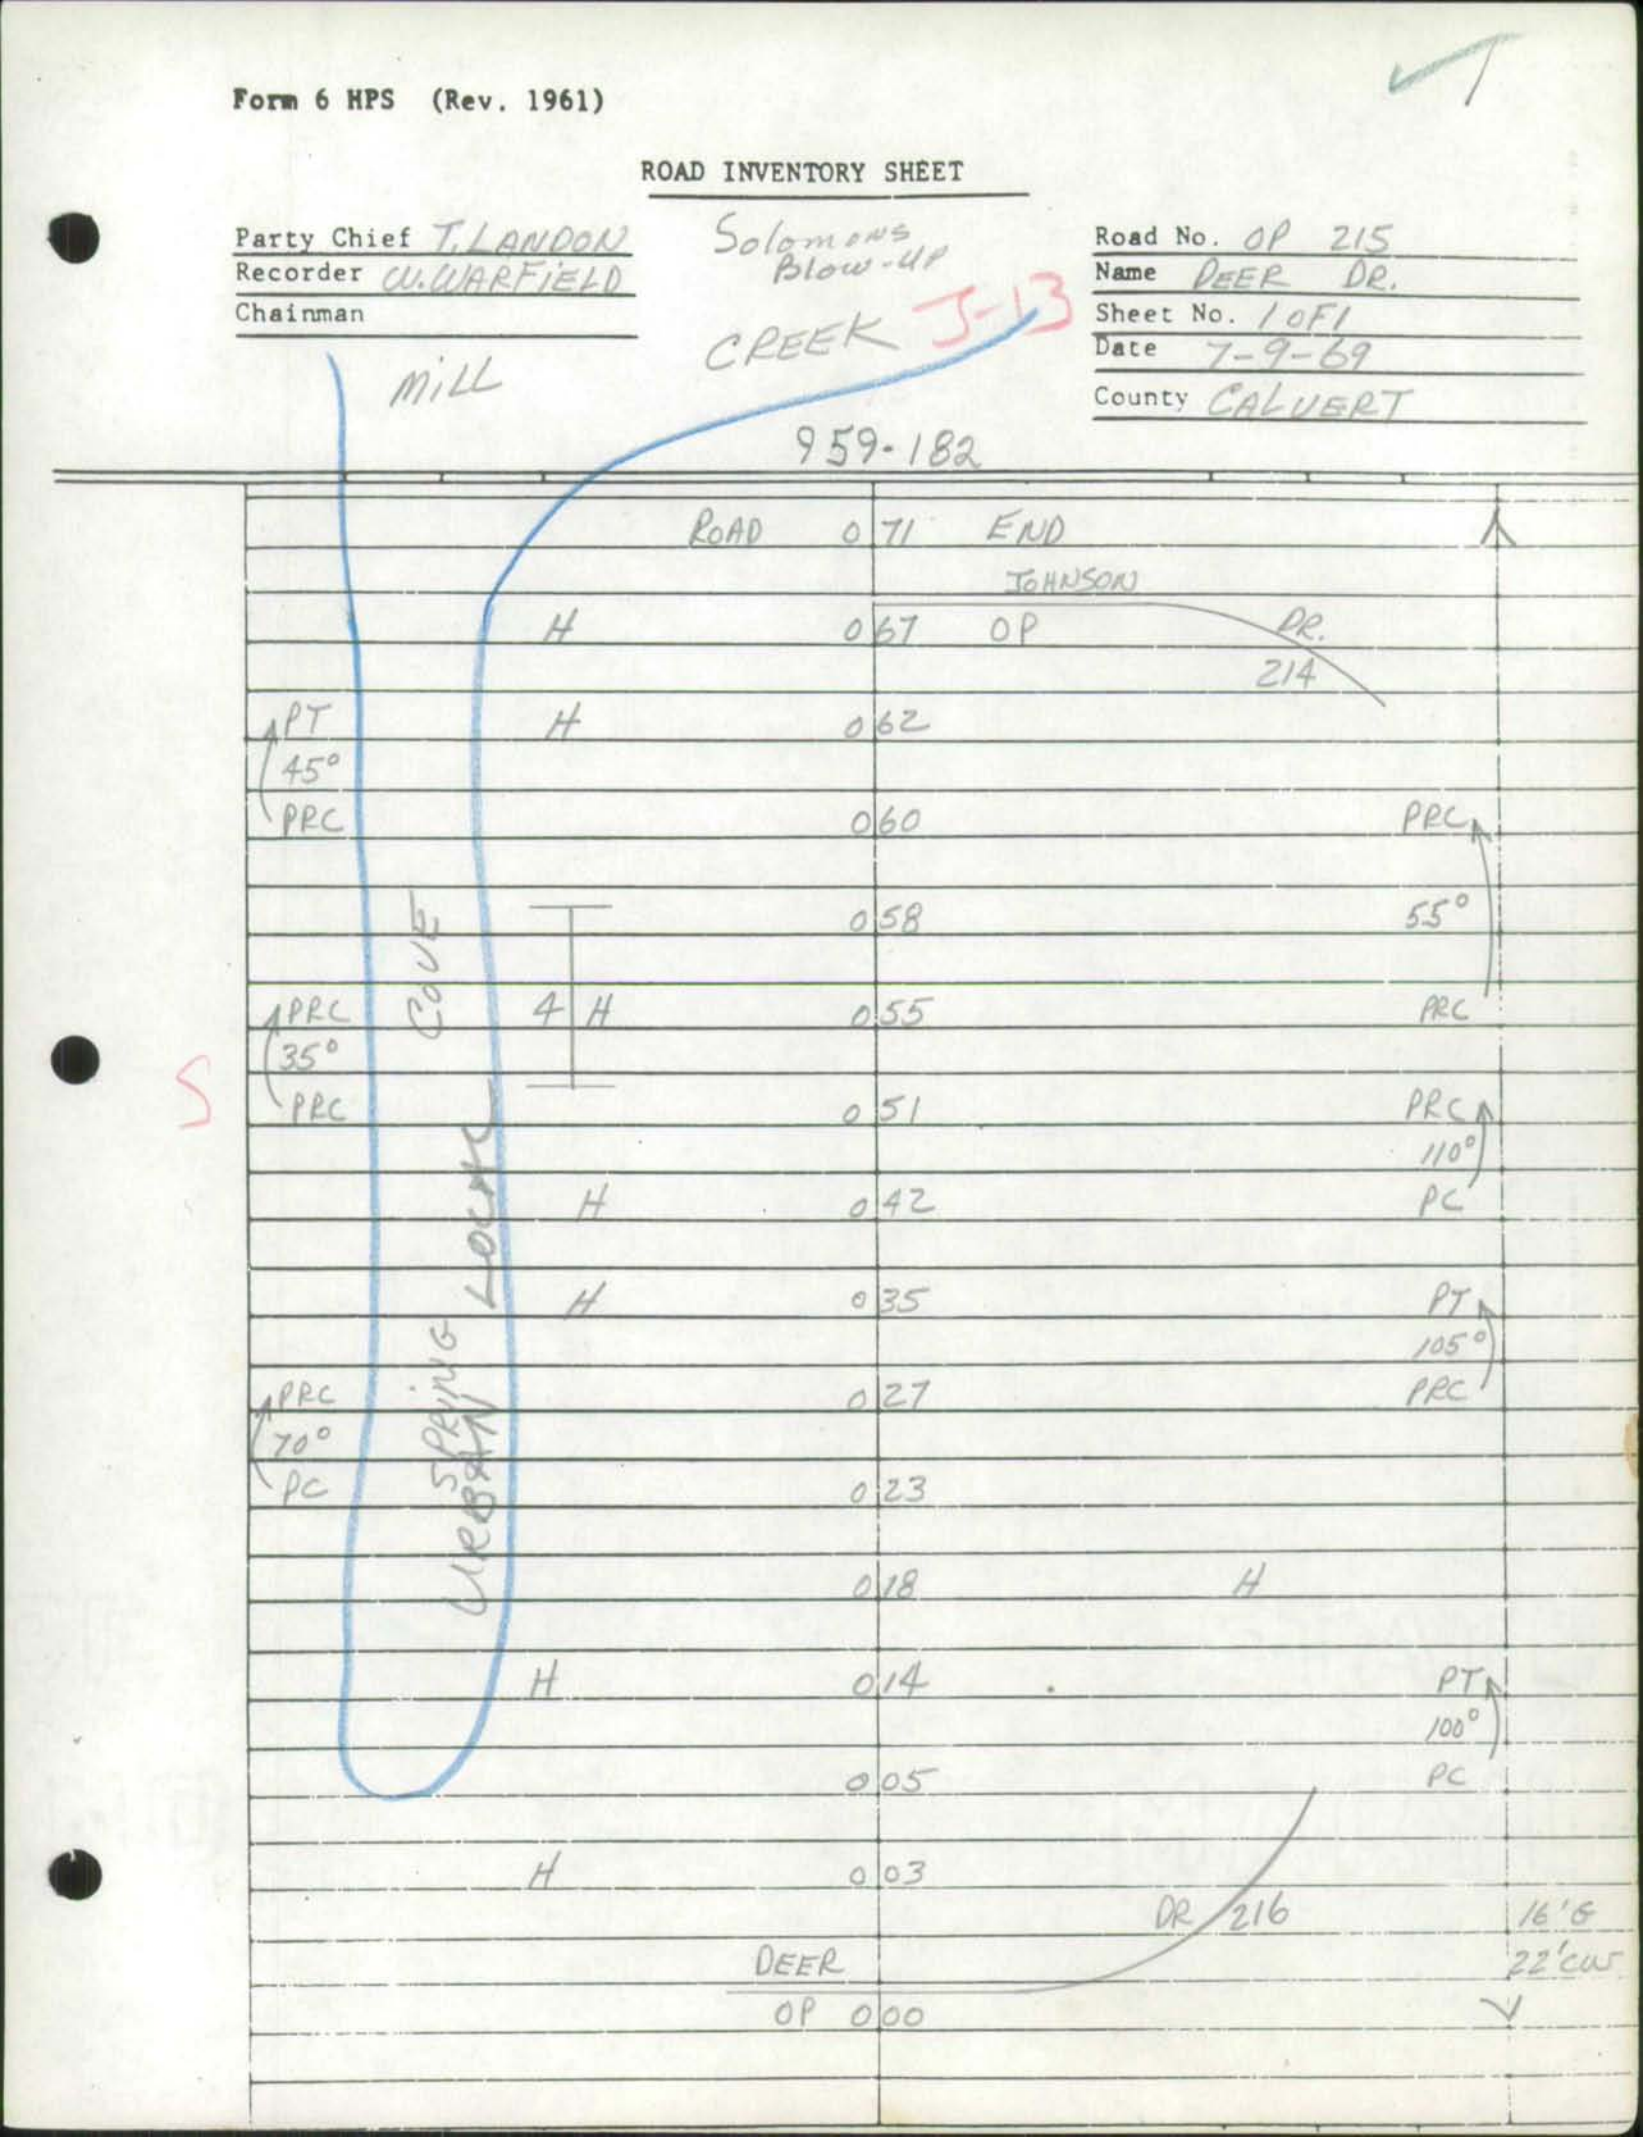

Form 6 HPS (Rev. 1961)

ROAD INVENTORY SHEET

Party Chief T. LANDON
Recorder W. WARFIELD
Chainman

Solomons Blow-up
959-180

Road No. OP 216
Name DEER DR
Sheet No. 1 OF 1
Date 7-9-69
County CALVERT

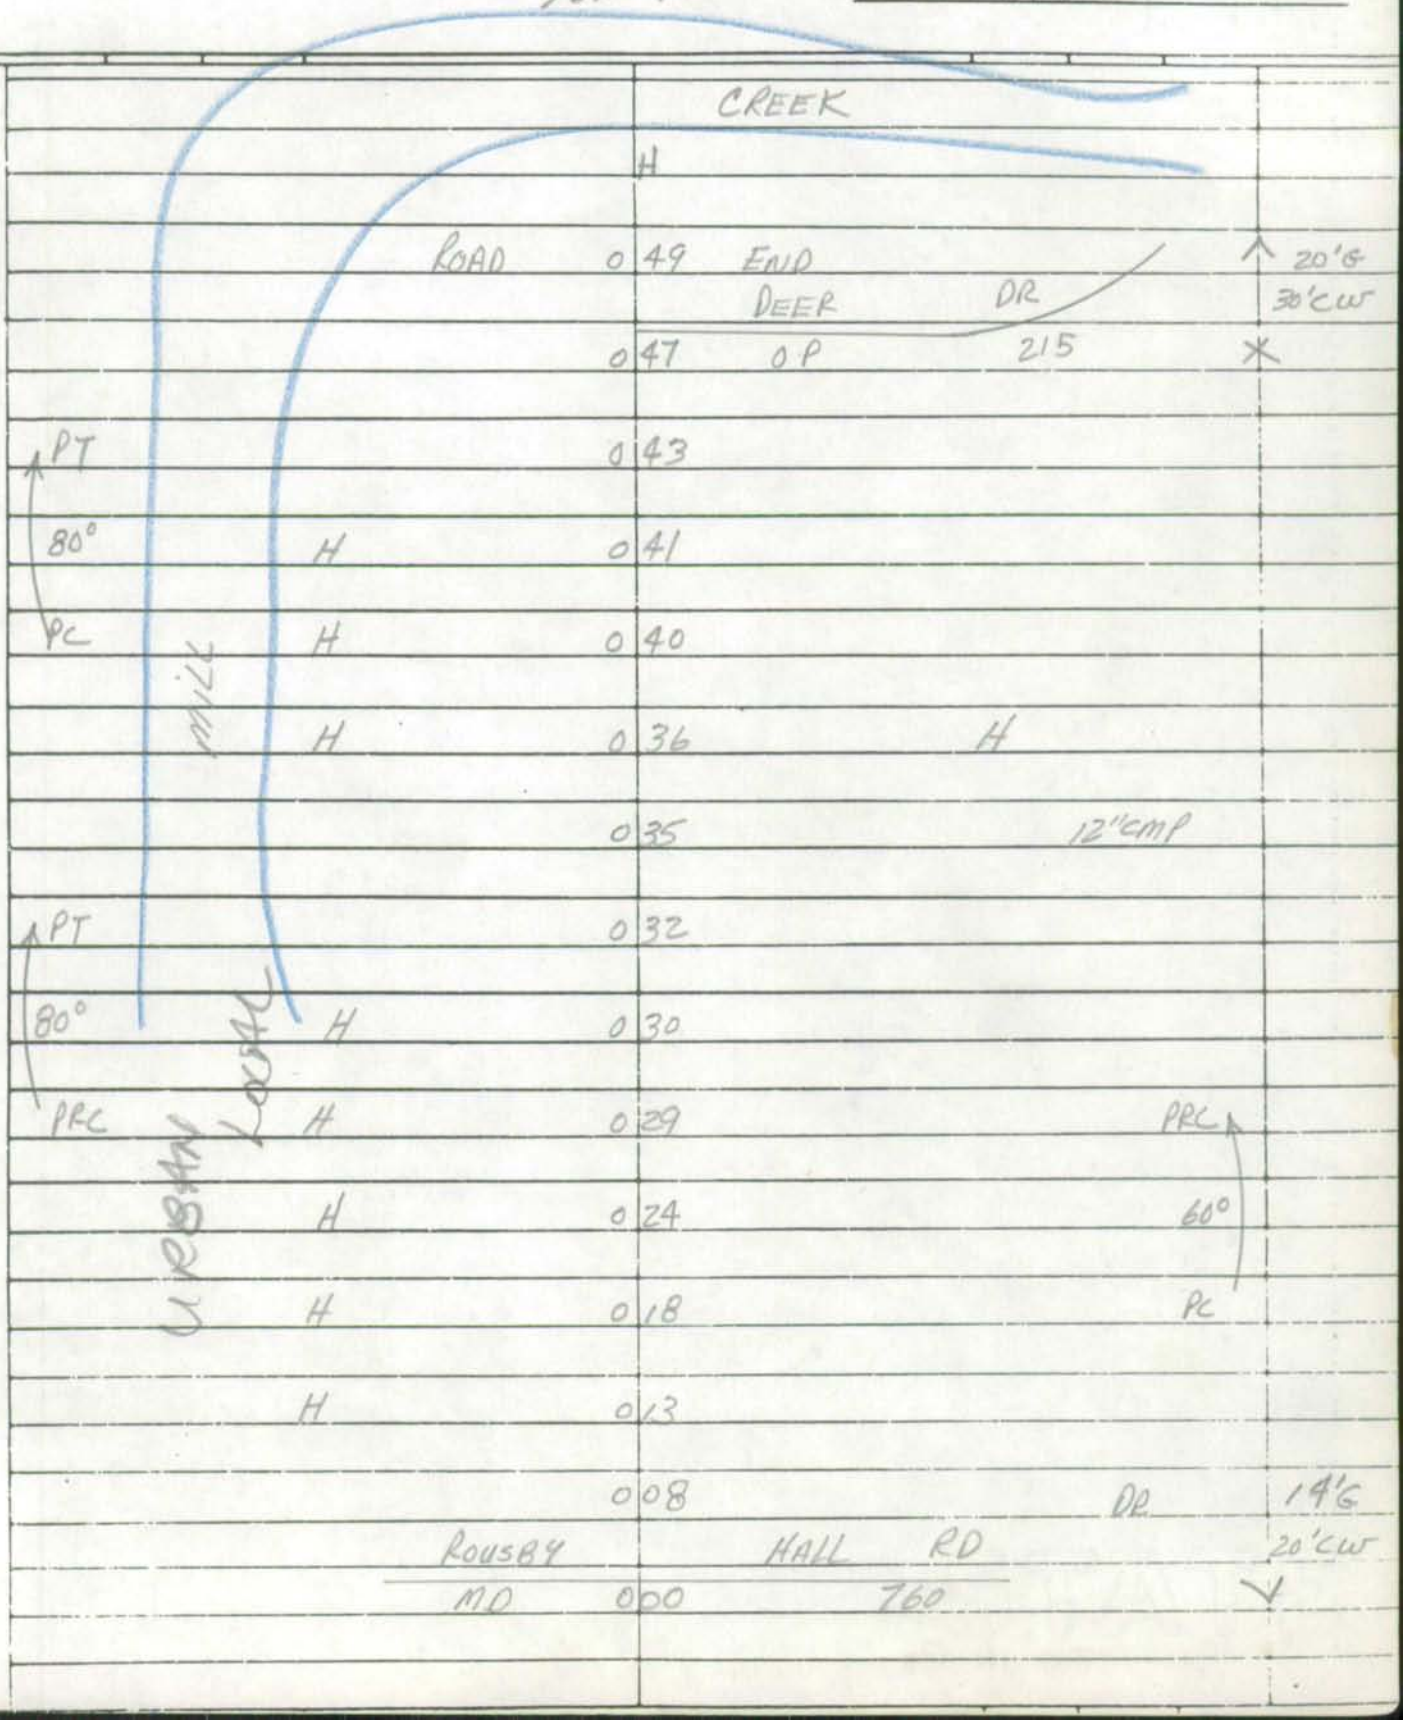

OP
217
VNASSIFIED

SHA 51.3 - 8 Revised
4.83

MARYLAND STATE HIGHWAY ADMINISTRATION

ROAD INVENTORY SHEET

Party Chief _____
Recorder _____
Assistant _____
Map No./Dir. 1
State Coordinates _____

Road No. OP 217
Road Name ROUSBY RD
County CALVERT
Date _____
Sheet No. _____ OF _____

SYSTEM				TRAFFIC		LINE DIAGRAM	TRAFFIC			PAVEMENT DATA
FED. AID.	FUNCT CLASS.	HWY. SYS.	HPMS SAMPLE	PRK.G. REST.	COM/IND. ACCESS		CONTROL	COM/IND. ACCESS	PRK.G. REST.	
						UNASSIGNED				
						NOW CO 342				
						68				

TRAFFIC CODES

TRAFFIC CONTROLS: STOP SIGN=SS,
TRAFFIC LIGHT=T.L.,
FLASHING RED BALL=F.R.

TRAFFIC CODES

PARKING RESTRICTIONS: A.M. PEAK,
P.M. PEAK, A.M./P.M. PEAK, NO PARKING
ANYTIME=N.P., COMM/IND. ACCESS=E

SYSTEM				TRAFFIC		LINE DIAGRAM	TRAFFIC			PAVEMENT DATA
FED. AID.	FUNCT. CLASS.	HWY. SYS.	HPMS SAMPLE	PRK.G. REST.	COM/IND ACCESS		CONTROL	COM/IND ACCESS	PRK.G. REST.	

SR93
6D, GW
6-29-93

Form 6 HPS (Rev. 1961)

ROAD INVENTORY SHEET

Party Chief T. LANDON
Recorder W. WARFIELD
Chainman

Solomons
Blow-Up

J-13
960-180.5

Road No. OP 218
Name HANCE AVE
Sheet No. 1 OF 1
Date 7-9-69
County CALVERT

Form 6 HPS (Rev. 1961)

ROAD INVENTORY SHEET

Party Chief T. LANDON
Recorder W. WARFIELD
Chainman

Solomons
Blow-up

J-13

961-181

Road No. OP 219
Name STARBOARD LANE
Sheet No. 1 OF 1
Date 7-9-69
County CALVERT

S

ROAD 0 16 END

3 H

0 14

PT 90° PC

0 12

12'E
16'CW

URBAN LOCAL

ROUSBY HALL RD

MD 0 00 760

SHA 51.3 - 8 Revised
4.83

MARYLAND STATE HIGHWAY ADMINISTRATION

ROAD INVENTORY SHEET

Party Chief: T. Landon
Recorder: W. Warfield
Assistant: Bowers, Hen (10/29/90) JEL
Map No./Dir.: J-13 / S
State Coordinates: 962.5 - 181

Road No.: MD 220
Road Name: River View Dr.
County: Calvert County
Date: 7-9-69
Sheet No.: 1 OF 2

TRAFFIC CODES
TRAFFIC CONTROLS: STOP SIGN=SS, TRAFFIC LIGHT=T.L., FLASHING RED BALL=F.R.

PARKING RESTRICTIONS: A.M. PEAK, P.M. PEAK, A.M./P.M. PEAK, NO PARKING ANYTIME=N.P., COMM/IND. ACCESS=E

SYSTEM				TRAFFIC		LINE DIAGRAM	TRAFFIC			PAVEMENT DATA
FED. AID.	FUNCT CLASS.	HWY. SYS.	HPMS SAMPLE	PRKG. REST.	COM/IND. ACCESS		CONTROL	COM/IND. ACCESS	PRKG. REST.	
	URBAN					0 37 PRC 45° PC				
						0 35				
						0 32 PT 75°				
						0 30 PRC 85° PRC				
						0 27 PRC 85°				
						0 24 PC				15' G 20' CW
						(Form GRA-100) (Vista LA) @ 0.00 MD 221 0 18				
						RD END LESSIN DR 12'P 0.04 0 06 PVT RD NOT CO MAINT USE AT YOUR OWN RISK				
K	K					Boushy Hall Rd MD 0.00 7.60	35			

ADD FIA Route Local

SYSTEM				TRAFFIC		LINE DIAGRAM	TRAFFIC			PAVEMENT DATA
FED. AID.	FUNCT. CLASS.	HWY. SYS.	HPMS SAMPLE	PRK.G. REST.	COM/IND ACCESS		CONTROL	COM/IND ACCESS	PRK.G. REST.	

Form 6 HPS (Rev. 1961)

ROAD INVENTORY SHEET

Party Chief T. LANDON
Recorder W. WARFIELD
Chainman

Solomons Blow-up J-13

962.5 - 180

Road No. OP 221
Name (Vista LA)
Sheet No. 1 OF 1
Date 7-9-69
County CALVERT

N

OVERLOOK DR @.50

OP 678 024

@.18 DR

RIVER VIEW 220

OP

H 022

020 H PT

019 DR 14'G

35° 20'CW

PRC 017 PRC

SAGNER DRIVE PVT

016

130° 012 DR

IC URBAN LOCAL

005 10'E 14'CW

RIVER VIEW

OP 000 PR @.41

220

SHA 51.3 - 8 Revised
4.83

MARYLAND STATE HIGHWAY ADMINISTRATION

ROAD INVENTORY SHEET

Party Chief: T. Landon
Recorder: W. Warfield
Assistant: Rewritten (10/29/90) JEL
Map No./Dir.: J-13 / NJ
State Coordinates: 963-179

Road No.: OP 222
Road Name: Iroquois Way
County: Calvert County
Date: 7-9-69
Sheet No.: 1 OF 1

SYSTEM: FED. AID. | FUNCT CLASS. | HWY. SYS. | HPMS SAMPLE
TRAFFIC: PRK'G. REST. | COM/IND. ACCESS

LINE DIAGRAM

TRAFFIC: CONTROL | COM/IND. ACCESS | PRK'G. REST.

PAVEMENT DATA

TRAFFIC CODES
TRAFFIC CONTROLS: STOP SIGN=SS, TRAFFIC LIGHT=T.L., FLASHING RED BALI=F.R.

TRAFFIC CODES
PARKING RESTRICTIONS: A.M. PEAK, P.M. PEAK, A.M./P.M. PEAK, NO PARKING ANYTIME=N.P., COMM/IND. ACCESS=E

Non F/A Rural Local

Gray DR 0.00
012 OP 679

10' E
14' CW

007 OP 224 0.14

14' G
20' CW

Overlook
OP

DR 0.11
000 678

SYSTEM				TRAFFIC		LINE DIAGRAM	TRAFFIC			PAVEMENT DATA
FED. AID.	FUNCT. CLASS.	HWY. SYS.	HPMS SAMPLE	PRK'G. REST.	COM/IND ACCESS		CONTROL	COM/IND ACCESS	PRK'G. REST.	

Form 6 HPS (Rev. 1961)

ROAD INVENTORY SHEET

Party Chief T. LANDON
Recorder W. WARFIELD
Chainman

DRUM POINT

Road No. OP 223
Name
Sheet No. 1 OF 1
Date 7-9-69
County CALVERT

964.5-179

OVERLOOK
OP 0 10 DR.
220 to 18
0 09 SPUR ← 002/15'G PT
0 08 12"CMP 100°
0 03 PC
0 02 15'G
002/12'G → SPUR 20'CLV
URBAN LOCAL
BARREDA BLVD. @.25
~~OP~~ CO 0 00 ~~225~~ 1189

Form 6 HPS (Rev. 1961)

ROAD INVENTORY SHEET

Party Chief T. LANDON
Recorder W. WARFIELD
Chainman

DRUM POINT
K-13
964.5-180

Road No. OP 224
Name
Sheet No. 1 OF 1
Date 7-9-69
County CALVERT

	IROQUOIS		WAY @ .07	
	OP	0.14	222	
				14'E
		0.10	H	20'CWS
	BARREDA		BLVD @ .29	
	~~OP~~ CO	0.00	~~225~~ 1189	

URBAN ROCHE

CALVERT COUNTY

OP 225

SEE INVENTORY

OF

CO 1189

BARREDA BLVD

02-23

Form 6 HPS (Rev. 1961)

ROAD INVENTORY SHEET

Party Chief T. LANDON
Recorder W. WARFIELD
Chainman

DRUM POINT

J-13
9645-180.5

Road No. OP 226
Name
Sheet No. 1 OF 1
Date 7-9-69
County CALVERT

D E
CUL 0 16 SAC
H 0 14
URBAN LOCAL
[15 0 0 4 12'G 16'CW
BARREDA BLVD. @ 43
CO ~~OP~~ 0 00 ~~225~~ 1189

Form 6 HPS (Rev. 1961)

ROAD INVENTORY SHEET

Party Chief T. LANDON
Recorder W. WARFIELD
Chainman

DRUM POINT
J-13
964.5-181

Road No. OP 227
Name GROVER LANE
Sheet No. 1 OF 1
Date 7-9-69
County CALVERT

W

			H	
URBAN NODAL	ROAD	012	END	^
	H	011	H	
	BARREDA		BLVD. C.S!	10'E 14'CW
	CO ~~OP~~	000	~~225~~ 1189	V

Form 6 HPS (Rev. 1961)

ROAD INVENTORY SHEET

Party Chief T. LANDON
Recorder W. WARFIELD
Chainman

DRUM POINT

J-13
964.5-181

Road No. OP 228
Name
Sheet No. 1 OF 1
Date 7-9-69
County CALVERT

E

URBAN Local	HURON OP	0 15	DR @ 16 235
		0 09	15" CMP
		0 05	10°9 10'E 14'CW
	BARREDA CO ~~OP~~	0 00	BLVD. C.55 ~~225~~ 1189

Form 6 HPS (Rev. 1961)

ROAD INVENTORY SHEET

Party Chief T. LANDON
Recorder W. WARFIELD
Chainman

DRUM POINT

J-13
9645-181

Road No. OP 229
Name
Sheet No. 1 OF 1
Date 7-9-69
County CALVERT

	ROAD 0.12 END			↑
	H	0.07		
URBANA ROAD	H	0.06	H	10'E
	BARREDA		BLUD. 0.58	14'CW
	CO ~~OF~~	0.00	~~225~~ 1189	↓

Form 6 HPS (Rev. 1961)

ROAD INVENTORY SHEET

Party Chief T. LANDON
Recorder W. WARFIELD
Chainman

DRUM POINT
J-13
965-181

Road No. OP 230
Name
Sheet No. 1 OF 1
Date 7-9-69
County CALVERT

	BARREDA		BLVD. C.L.		
	OP	0	15	225	
(15° Urban Lecard)		0	09		
		0	06	15" CMP	10'E 14'W
	HURON		PR		
	~~AP~~ CO	0	00 1189	~~235~~ 0.11	

CALVERT COUNTY

OP 231

SEE INVENTORY

OF

CO 1191

CHESTNUT DR

02-25

Form 6 HPS (Rev. 1961)

ROAD INVENTORY SHEET

Party Chief T. LANDON
Recorder W. WARFIELD
Chainman

DRUM POINT
J-13
964.5 - 161.5

Road No. OP 232
Name
Sheet No. 1 OF 1
Date 7-9-69
County CALVERT

E

(PROPOSED)

HURON			DR.	
OP	0	14	235	
	0	07		DR
	0	05		10°)
BARREDA			BLVD. C.L.	
CO ~~OP~~	0	00	1189 ~~225~~	

10'E
14'CW

URBAN
LOCAL

SHA 51.3 - 8 Revised
4.83

MARYLAND STATE HIGHWAY ADMINISTRATION

ROAD INVENTORY SHEET

Party Chief: T. Landon
Recorder: W. Warfield
Assistant: Rewritten (11-1-90) JEL
Map No./Dir.: 5-13 / E
State Coordinates: 165 - 181.5

Road No.: OP 233
Road Name: Lake Dr
County: Calvert County
Date: 7/10/89
Sheet No.: 1 OF 2

TRAFFIC CODES
TRAFFIC CONTROLS: STOP SIGN=SS, TRAFFIC LIGHT=T.L., FLASHING RED BALL=F.R.

TRAFFIC CODES
PARKING RESTRICTIONS: A.M. PEAK, P.M. PEAK, A.M./P.M. PEAK, NO PARKING ANYTIME=N.P., COMM/IND. ACCESS=E

SYSTEM				TRAFFIC		LINE DIAGRAM	TRAFFIC			PAVEMENT DATA
FED. AID.	FUNCT CLASS.	HWY. SYS.	HPMS SAMPLE	PRKG. REST.	COM/IND. ACCESS		CONTROL	COM/IND. ACCESS	PRKG. REST.	
						(Laurel Way) 0.00				
						OP 241 0.25				
						PT 0.23				
						35°				
						PC 0.19				
										18' G
										24' CW
						Huron Dr 0.00				
						0.13 OP 235				
						0.03 10°				
						Barreda Blvd. 0.71				
						~~OP~~ CO 0.00 ~~225~~ 1189				

NON FIA
~~RURAL~~ URBAN
Local

SYSTEM: FED. AID. | FUNCT. CLASS. | HWY. SYS. | HPMS SAMPLE
TRAFFIC: PRKG. REST. | COM/IND ACCESS

LINE DIAGRAM

TRAFFIC: CONTROL | COM/IND ACCESS | PRKG. REST.
PAVEMENT DATA

NON F/A
URBAN Rural Local

PT

Pine La @ 0.00
0 70 OP 681

16' G
22' CW

Chesapeake Bay

80°

0 160

Bay Rd. @ 0.00
OP 242 0 55

PC 0 52

18' G
24' CW

PT 0 47

20°

Pine La. @ 0.19
PC 0 43 ~~OP 223~~
OP 681

Dogwood DR. @ 0.00
OP 234 0 35

CALVERT COUNTY

OP 234

SEE INVENTORY

OF

CO 1190

DOGWOOD DR

02-24

SHA 51.3 - 8 Revised
4.83

MARYLAND STATE HIGHWAY ADMINISTRATION

ROAD INVENTORY SHEET

Party Chief: J Landon
Recorder: W. Warfield
Assistant: Rewritten (11-1-90) JEL
Map No./Dir.: J-13 / S
State Coordinates: 965 - 181.5

Road No.: OP 235
Road Name: Huron DR
County: Calvert County
Date: 7/10/69
Sheet No.: 1 OF 1

TRAFFIC CODES
TRAFFIC CONTROLS: STOP SIGN=SS, TRAFFIC LIGHT=T.L., FLASHING RED BALL=F.R.

TRAFFIC CODES
PARKING RESTRICTIONS: A.M. PEAK, P.M. PEAK, A.M./P.M. PEAK, NO PARKING ANYTIME=N.P., COMM/IND. ACCESS=E

SYSTEM				TRAFFIC		LINE DIAGRAM	TRAFFIC			PAVEMENT DATA
FED. AID.	FUNCT CLASS.	HWY. SYS.	HPMS SAMPLE	PRKG. REST.	COM/IND. ACCESS		CONTROL	COM/IND. ACCESS	PRKG. REST.	
						Holly DR @.00				
						OP 682 0 29 15" CMP				
						@.15				
						PT 0 16 OP 228				
						Buckler DR				
						OP 236 0 15 @.28				16' G
						20°				22' CW
						PC 0 14				
						(Iris LA) @.00				
						0 11 OP 230				
						Proposed @.14				
						OP 0 05 232				
										18' G
										24' CW
						Lake DR @.13				
						OP 0 00 233				

F/A
NON URBAN Rural local

SYSTEM				TRAFFIC		LINE DIAGRAM	TRAFFIC			PAVEMENT DATA
FED. AID.	FUNCT. CLASS.	HWY. SYS.	HPMS SAMPLE	PRK.G. REST.	COM/IND ACCESS		CONTROL	COM/IND ACCESS	PRK.G. REST.	

Form 6 HPS (Rev. 1961)

ROAD INVENTORY SHEET

Party Chief T. LANDON
Recorder W. WARFIELD
Chairman

DRUM POINT
K-13
966-179.5

Road No. OP 236
Name BUCKLER DR.
Sheet No. 1 OF 1
Date 7-10-69
County CALVERT

N

	HURON OP	0 28	DR. 0.15 235	
	OTTAWA DR. OP 237	0 22		
	H	0 21		
URBANNA		0 16	12" CMP	PT 85° PC
		0 13		
	H	0 09		
	H	0 06		
		0 02	DR 238 18" CMP 20°	16'G 22'CW
	NONAWK OP	0 00		

Form 6 HPS (Rev. 1961)

ROAD INVENTORY SHEET

Party Chief T. LANDON
Recorder W. WARFIELD
Chainman

DRUM POINT
J-13
965-180

Road No. OP 237
Name OTTAWA DR
Sheet No. 1 OF 1
Date 7-10-69
County CALVERT

N

	BUCKLER		DR	
URBAN / LOCAL	OP	0 15	236	↑
		0 03		30° ↑ 12 6
	HOLLY			16 CW
	OP	0 00	DR 0.05	↓
			~~235~~	
			682	

Form 6 HPS (Rev. 1961)

ROAD INVENTORY SHEET

Party Chief T. LANDON
Recorder W. WARFIELD
Chainman

Drum Point

K-13
966-179

Road No. OP 238
Name MOHAWK DR
Sheet No. 1 OF 2
Date 7-10-69
County CALVERT

				BUCKLER DR 236	
H		0	34	OP	
H					
		0	33	H	PC
H		0	30		
				CREE DR	
H		0	27	OP 239	
		0	24		15° ↑
W H		0	23	H	
				MOHAWK DR	
			238		
		0	21	OP	
		0	20	H	
		0	17	H	PT
		0	13	H	
				DR	170°
		0	12	240 H	
				BEACH	
		0	10	OP	PC
H		0	09		
		0	08		PT
					125°
		0	03		PC 14'G
	MOHAWK			DR	20'CW
	OP	0	00	238	

URBANA ROAD

Form 6 HPS (Rev. 1961)

ROAD INVENTORY SHEET

Party Chief T. LANDON
Recorder W. WARFIELD
Chainman

K-13

Road No. OP 238
Name MOHAWK DR
Sheet No. 2 OF 2
Date 7-10-69
County CALVERT

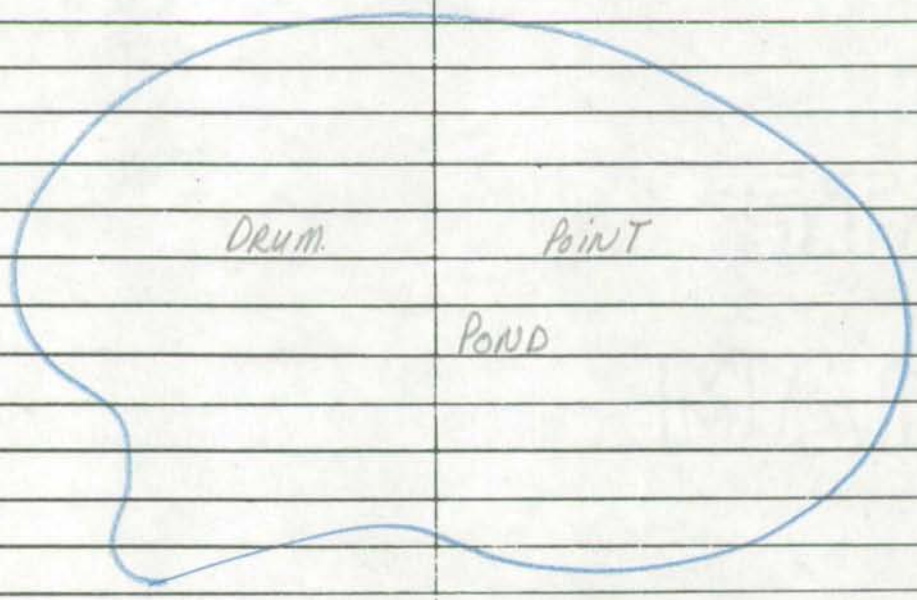

H H H
DE
CUL 047 SAC
SC 045
043 H PT
H 040 HOLLY 0.12
OP DR 120°
235 682 SAME

Form 6 HPS (Rev. 1961)

ROAD INVENTORY SHEET

Party Chief T. LANDON
Recorder W. WARFIELD
Chainman

DRUM POINT

K-13
966-179.5

Road No. OP 239
Name CREE DR.
Sheet No. 1 OF 1
Date 7-10-69
County CALVERT

E

ROAD	0 13	END	
	0 08	H	
	0 04	H	12'G 16'CW
MOHAWK OP	0 00	DR 238	

LIKELY NOT

Form 6 HPS (Rev. 1961)

ROAD INVENTORY SHEET

Party Chief T. LANDON
Recorder W. WARFIELD
Chainman

DRUM POINT

K-13

966.5-179

Road No. OP 240
Name BENCH DR
Sheet No. 1 of 1
Date 7-10-69
County CALVERT

5

CHESAPEAKE BAY

URBAN ROAD

0 E

CUL 0 05 SAC

0 01 20° 14'6 20' CUT

MOHAWK OP 0 00 DR 238

Form 6 HPS (Rev. 1961)

ROAD INVENTORY SHEET

Party Chief T. LANDON
Recorder W. WARFIELD
Chainman

DRUM POINT

J→13
966-181

Road No. OP 241
Name (Laurel Way)
Sheet No. 1 OF 1
Date 7-14-69
County CALVERT

	ROAD @ 0.11	038	END		
PT (40° PRC)	OP 248	036			
		030		PRC (60° PC)	
N	OP 248 @ 0.00	026			
		021	OP 247		
	LITTLE	016	FRESH CREEK	18' CMP SQUASH	
Rock		011	H		
		010	OP 246		
	OP 245	009			18'G
J	DOGWOOD		DR.		24'CW
PT (25° PCR)	CO ~~OF~~ 1190	006	OP 234		X
		003			
		001	H		14'G
	LAKE		DR 0.25		20'CW
	OP	000	233		Y

SHA 51.3 - 8 Revised
4.83

MARYLAND STATE HIGHWAY ADMINISTRATION

ROAD INVENTORY SHEET

Party Chief: J. Landon
Recorder: W. Warfield
Assistant: Rewritten (11-1-90) JEL
Map No./Dir.: J-13 / N
State Coordinates: 967-180

Road No.: OP 242
Road Name: Bay Rd.
County: Calvert Co.
Date: 7/10/89
Sheet No.: 1 OF 2

TRAFFIC CODES
TRAFFIC CONTROLS: STOP SIGN=SS, TRAFFIC LIGHT=T.L., FLASHING RED BALL=F.R.

TRAFFIC CODES
PARKING RESTRICTIONS: A.M. PEAK, P.M. PEAK, A.M./P.M. PEAK, NO PARKING ANYTIME=N.P., COMM/IND. ACCESS=E

SYSTEM				TRAFFIC		LINE DIAGRAM	TRAFFIC			PAVEMENT DATA
FED. AID.	FUNCT CLASS.	HWY. SYS.	HPMS SAMPLE	PRK.G. REST.	COM/IND. ACCESS		CONTROL	COM/IND. ACCESS	PRK.G. REST.	
						0.21 20°				
						20° 0.20 BAY				
						0.16 30°				
						Little				
						Fresh				16' G
						0.12 18" CMP				22' CW
						Creek				
						Chesapeake				
						0.09 PT				
						120°				
						0.05 PRC				
						PRC				
						85°				
						0.02				
						PC				
						Lake DR @ 0.55				
						OP 0.00 233				
K	K	URBAN	F/A Local							

SYSTEM: FED. AID. | FUNCT. CLASS. | HWY. SYS. | HPMS SAMPLE
TRAFFIC: PRKG. REST. | COM/IND ACCESS

LINE DIAGRAM

TRAFFIC: CONTROL | COM/IND ACCESS | PRKG. REST.

PAVEMENT DATA

Non FIA
Urban ~~Rural~~ local

Lake View @ 1.10
DP 243 0 51

Bay View @ 1.00
DP 243 0 31

0 28

0 25

0 23

PRC
115°
PC

PT
75°
PRC

Chesapeake Bay

14' G
20' CW

16' G
22' CW

Form 6 HPS (Rev. 1961)

ROAD INVENTORY SHEET

Party Chief T. LANDON
Recorder W. WARFIELD
Chainman

DRUM POINT
J-13
968-181.5

Road No. OP 243
Name BAY VIEW
Sheet No. 1 OF 1
Date 7-10-69
County CALVERT

LITTLE FRESH CREEK

H
D E
CUL 0 26 SAC
0 25 H 15°
0 21 OP
PT 120°
0 18 15" CMP PC
URBAN ROAD
H 0 09
OP 244 0 07
LAKE VIEW @.18
0 05 OP ~~242~~ 683 15° 14'6 20'CW
BAY RD @.31
OP 0 00 242

Form 6 HPS (Rev. 1961)

ROAD INVENTORY SHEET

Party Chief T. LANDON
Recorder W. WARFIELD
Chainman

DRUM POINT

J-13 966-182

Road No. OP 244
Name
Sheet No. 1 OF 1
Date 7-10-69
County CALVERT

S

D E
CUL 0 07 SAC

URBAN Road

0 05 45°

12'6
16'CW

BAY VIEW
OP 0 00 243

Form 6 HPS (Rev. 1961)

ROAD INVENTORY SHEET

Party Chief T. LANDON
Recorder W. WARFIELD
Chainman

DRUM POINT

J-13
966.5-181.5

Road No. OP 245
Name
Sheet No. 1 OF 1
Date 7-14-69
County CALVERT

W

ROAD 009 END

007 35°

003 OP 250

16'6
22'CW

OP 000 241

VIRGINIA ROCKS

Form 6 HPS (Rev. 1961)

ROAD INVENTORY SHEET

Party Chief T. LANDON
Recorder W. WARFIELD
Chainman

DRUM POINT

J-13
966.5-182

Road No. OP 246
Name
Sheet No. 1 OF 1
Date 7-14-69
County CALVERT

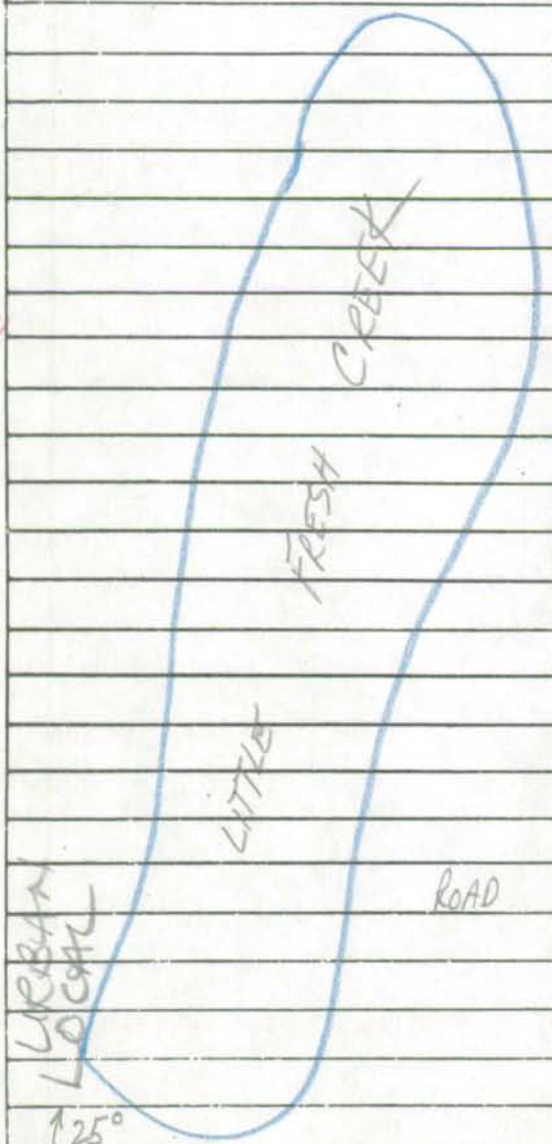

	ROAD	0 06	END
URBAN DOWN			
125°		0 02	16'E
			22'CW
	OP	0 00	241

Form 6 HPS (Rev. 1961)

ROAD INVENTORY SHEET

Party Chief T. LANDON
Recorder W. WARFIELD
Chainman

DRUM POINT

J-13
966.5-182.5

Road No. OP 247
Name
Sheet No. 1 OF 1
Date 7-14-69
County CALVERT

E

OP RAY

019

OP 251 018 VIEWS 243

015

120°

LITTLE 011 FRESH CREEK 18'CMP SQUASH 18'6 24'CW

006

PROPOSED RD

004 16'6 22'CW

OP 000 241

URBAN LOCAL

Form 6 HPS (Rev. 1961)

ROAD INVENTORY SHEET

Party Chief T. LANDON
Recorder W. WARFIELD
Chainman

DRUM POINT
5-13
9665-182.5

Road No. OP 248
Name
Sheet No. 1 OF 1
Date 7-14-69
County CALVERT

	OP	021	241
		018	15"CMP
		016	OP 249
URBANA LOOP		013	12"CMP PT
		010	15"CMP 145°
		007	PC 16'G 22'CW
	OP	000	241

Form 6 HPS (Rev. 1961)

ROAD INVENTORY SHEET

Party Chief T. LANDON
Recorder W. WARFIELD
Chainman

DRUM POINT

J-13
9665-183

Road No. OP 249
Name
Sheet No. 1 OF 1
Date 7-14-69
County CALVERT

5

LITTLE FRESH
CREEK

DE
CUL 002 SAC

URBAN AREA

16'G
22'CW

OP 000
248

Form 6 HPS (Rev. 1961)

ROAD INVENTORY SHEET

Party Chief T.LANDON
Recorder W.WARFIELD
Chainman

DRUM POINT
S-13
966-182

Road No. OP 250
Name
Sheet No. 1 OF 1
Date 7-14-69
County CALVERT

N

ROAD 003 END

135° LIKELY ROCKS

002

14'G
20'CW

OP 000 245