DORCHESTER COUNTY
OTHER PUBLIC ROADS
to
SR / GV ROADS

SHA 51.3-8
11-15-72

STATE HIGHWAY ADMINISTRATION OF MARYLAND

ROAD INVENTORY SHEET

Party Chief T. LANDON
Recorder F. RHODES
Helper

Map No.

Road No. OP 1
Road Name
Sheet No. 1 OF 1
Date 9/3/74
County DORCHESTER
State Coordinates 1010 - 282

	ROAD	END	
	1	35 PVT. CEM.	↑
	1	31 F	90°↑
↑30°	1	07	
	0	99 GATE	
↑20°	0	75	
	0	71 H	
↑20°	0	52	
	0	27	15°↑
	0	15 GATE	
↑30° H	0	09	10'D 14'CW
	0	06	20°↑
	0	00 COOK PT. RD. CO. Rt 15	↓

COOKSPOINT RD. CO. Rt 15

SHA 51.3-8
11-15-72

ROAD INVENTORY SHEET

Road No. _____
Road Name _____
Sheet No. _____
Date _____
County _____
State Coordinates _____

Form 6 HPS (Rev. 1961) 279-1028

ROAD INVENTORY SHEET

Party Chief F SETTAN
Recorder
Chainman C FOREST

T. LANDON
F. RHODES
9/3/74 VERIFIED

Road No. OP2
Name
Sheet No. 1 OF 1
Date 4-20-65
County DORCHESTER
1026-279

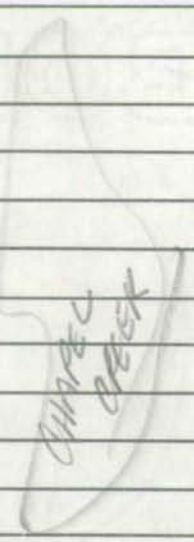

	H		
N	ROAD	END	
	025		
	010	H	
MD	005	H	10'D
	003	H	14'CW
	000		
	343		

200-1443

ROAD INVENTORY SHEET

Co. 378

ty Chief F SETTAN
corder C FORREST
ainman

7-6
REVISED 1-31-72 T. LANDON W. WARFIELD

Road No. OP3
Name
Sheet No. 1 OF 1
Date 4-21-65
County DORCHESTER
1028-260

BEING DEVELOPED

POSTED PRIVATE

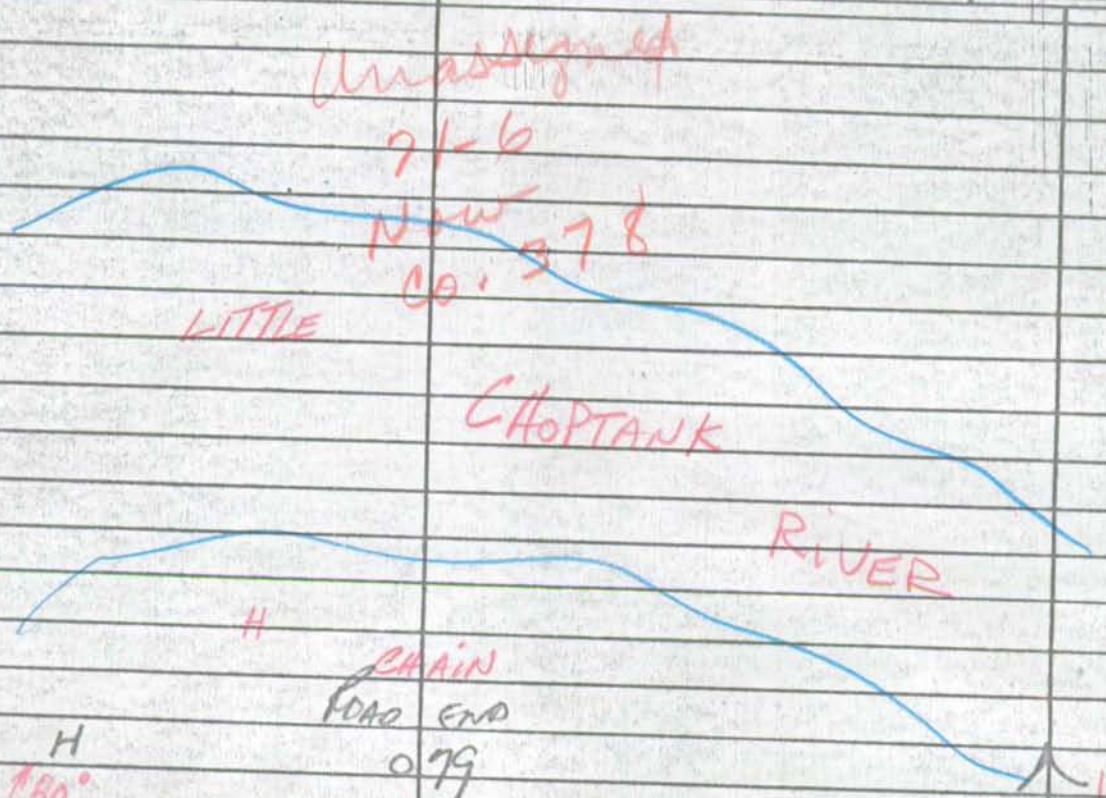

ROAD	CHAIN END	
H	079	
180°	076	12'E 14'CW
	062	90° 90°
	057	12" CP
PT 30° PC	055	
	048	
H	044	80°
90° H	034	
	030	12" CP
	012	90° 14'E 20'CW
	Found PT Rd. Co 62 000	

Form 6 HPS (Rev. 1961)

151-1071

ROAD INVENTORY SHEET

Party Chief F SETTAN
Recorder C FORREST
Chainman T.L.

T. LANDON
F. RHODES
9/71 74 VERIFIED

Road No. OP4
Name
Sheet No. 10F1
Date 8-6-65
County DORCHESTER

SW

H ROAD ENO
0 05

H 0 03 H
DENNIKAS 0 01 ROAD H
Co 0 00 156

10'EF
12'Cw

Ross Thumb Rd
OP5

Now CO 349

TRANSFERRED
TO
COUNTY
12-31-66

65.32

SHA 51.3-8
11-15-72

STATE HIGHWAY ADMINISTRATION OF MARYLAND

ROAD INVENTORY SHEET

Party Chief T. LANDON
Recorder F. RHODES
Helper

Map No.

Road No. OP-6
Road Name Knauer Rd
Sheet No. 1 OF 1
Date 9/23/74
County DORCHESTER
State Coordinates 1082-240

UNASSIGNED

SIGNED PVT Rd

FCRI-95

ROAD END

E

0 91 F

H 0 76 H

0 67 20°↑

0 42 F

12'E

↑20° 0 31 14'CW

0 25 20°↑

0 19 H

BUCKTOWN CO. 0 00 R.D. 168

SHA 51 .3-8
11-15-72

ROAD INVENTORY SHEET

Road No. _____
Road Name _____
Sheet No. _____
Date _____
County _____
State Coordinates _____

Form 6 HPS (Rev. 1961)

ROAD INVENTORY SHEET

Party Chief
Recorder
Chainman

Road No. OP 7
Name
Sheet No.
Date
County

68-21

NOW UNASSIGNED

NOW CO 363

Form 6 HPS (Rev. 1961)

250-1093

CO 420

ROAD INVENTORY SHEET

73-31

Party Chief F. SETTAN
Recorder T. LANDON
Chainman C. FORREST

Road No. ~~OP 8~~
Name HEIGHT Rd.
Sheet No. 1 OF 1
Date 5-14-65
County DORCHESTER

OP 8 UNASSIGNED —

NOW CO 420

ROAD		END
	0 32	
H	0 31	
	0 21	H
H	0 10	
DRAWBRIDGE		ROAD
CO	0 00	177

9' ℄ E
12' CW

175-1089
(Blow up)

Form 6 HPS (Rev. 1961)

ROAD INVENTORY SHEET

Party Chief F.S.
Recorder C.F.
Chainman T.L.

T.L AND ON
F.R HODES
9/20/74 VERIFIED

Road No. OP9
Name
Sheet No. 1 OF 1
Date 5-13-65
County DOR.

H (NAC)

		Road	GND
↑		0	28
	H	0	26
↑40°	H	0	14
		0	07 ↑50°

Elliotts Island Rd.

Co 000 192

9'C
12'C

Form 6 HPS (Rev. 1961)

195-1087

(Bl. 4 up)

~~Co 381~~

ROAD INVENTORY SHEET

NOTE: IS STILL OP 10

Party Chief F.S.
Recorder C.F
Chainman T.L

T.L ANDON
F. RHODES
9/20/74 VERIFIED H-10

1297

Road No. ~~OP 10~~
Name ~~BAYOU RD~~
Sheet No. 1 OF 1
Date 5-13-65
County DOR.

1087-176

		H-ABAN	
H		ROAD END	
	0	38	
	0	31	H (ABAN)
H	0	26	H-ABAN
	0	20	H
← OP 9 Elliotts Co	0	16 Island 6193 → Rd. 192	
S CEM.	0	09	
	0	07	H
	0	05	H
H	0	00	H
		ROAD END	

8'D
~~20'C~~
~~30'CW~~
V 16'CW

Form 6 HPS (Rev. 1961) 185-1085

ROAD INVENTORY SHEET

Party Chief F SETTAN
Recorder C FORREST
Chainman T.L.
T.LANDON
F.RHODES
9/20/74 VERIFIED

Road No. OF 12
Name
Sheet No. 10F1
Date 5-13-65
County DORCHESTER
1084-174

	H		
		PUT. COM	
	ROAD END		
	0 19		
S ↑	0 18	H	) 90°
	0 17	H	
↑ 20°	0 09		25° ↑
	0 04	H- ~~AGAIN~~.	10' E
	Elliotts	Island Rd.	14' W
	Co 0 00	192	

Form 6 HPS (Rev. 1961)

284-1098

ROAD INVENTORY SHEET

Party Chief F. SETTAN
Recorder T. LANDON
Chainman C. FORREST
T. LANDON
F. RHODES
9/25/74 VERIFIED

Road No. OP13
Name
Sheet No. 1 OF 1
Date 5-19-65
County DORCHESTER

WARWICK		RIVER	
H			
ROAD		END	
	0	12	
N ↑ H	0	04	10'E 16'CW
H	0	02	
SUNNYSIDE ~~SHADY~~		RD. ~~Drive~~	
CO	0	01	232

Form 6 HPS (Rev. 1961)

280-1109 (Blow up)

ROAD INVENTORY SHEET

Party Chief F. SETJAN
Recorder J. LANDON
Chainman C. FORREST
T. LANDON
F. RHODES
9/27/74 VERIFIED

Road No. OP 14
Name
Sheet No. 1 OF 1
Date 5-19-65
County DORCHESTER

E MD 005 392

H 001 H

22'E
22'W

NO NAME
OP 000 15

Form 6 HPS (Rev. 1961)

280-1109
(blow up)

ROAD INVENTORY SHEET

Party Chief F. SETTAN
Recorder T. LANDON
Chainman C. FORREST
T. LANDON
F. RHODES
9/27/74 VERIFIED

Road No. OP15
Name
Sheet No. 1 OF 1
Date 5-19-65
County DORCHESTER

H

ROAD END

H 0 09

H (ABAN) 0 06

0 04 9'C 12'CW

3A H NO NAME

N 0 03 OP14

0 01 H 14'E 18'CW

0 00

ROAD END

H

SHA 51.3-8
11-15-72

STATE HIGHWAY ADMINISTRATION OF MARYLAND

ROAD INVENTORY SHEET

Party Chief T. LANDON
Recorder F. RHODES
Helper

Map No. WAS Co 388

Road No. OP 16
Road Name
Sheet No. 1 OF 1
Date 10/1/74
County DORCHESTER
State Coordinates 1129-287

E

H (VAC)

	ROAD	END
H	0	10
H	0	06
	0	00

4 H

VILLAGE RD. 308

JONES CO.

10'E
12'CW

SHA 51.3-8
11-15-72

ROAD INVENTORY SHEET

Road No. _____
Road Name _____
Sheet No. _____
Date _____
County _____
State Coordinates _____

Form 6 HPS (Rev. 1961)

283-1113

ROAD INVENTORY SHEET

Party Chief F. SETTAN T.L. REVISED F.R. 1/8/76
Recorder T. LANDON
Chainman C. FORREST
T. LANDON
F. RHODES
9/27/74 VERIFIED

Road No. OP~~18~~ 17
Name
Sheet No. 1 OF 1
Date 5-27-65
County DORCHESTER

RAILROAD ~~BUZZARD~~ CO	C 19	~~HILL~~ RD. RD. 321
	O 15	60° ~~40°~~ ↑ H-300'
	O 10	H (VAC)
↑80°	O 09	
~~H ABAN~~	~~O 08~~	
H	O 06	H 60° ↑
W ↑	O 05	H
	O 02	H
(DOBSON ~~NO~~ ~~OP~~ CO.	O 00	RD.) ~~NAME~~ 439 ~~18~~

10'D
16'W

297-1107

Form 6 HPS (Rev. 1961)

ROAD INVENTORY SHEET

Party Chief F. SETTON
Recorder T. LANDON
Chainman C. FORREST
T. LANDON
F. RHODES
9/25/74 VERIFIED

Road No. OP19
Name
Sheet No. 1 OF 1
Date 5-22-65
County DORCHESTER
1105-297

F

ROAD END
055

040 H(VAC) 12'E 18'CW

N

038 H

004 12" CP

(SECRETARY SVICIDE BRIDGE RD.)

00 000 323

SHA 51.3 - 8 Revised
4.83

MARYLAND STATE HIGHWAY ADMINISTRATION

ROAD INVENTORY SHEET

Party Chief _____
Recorder _____
Assistant _____
Map No./Dir. 1
State Coordinates _____

Road No. OP 20
Road Name No Name
County Dorchester Co.
Date _____
Sheet No. _____ OF _____

SYSTEM				TRAFFIC		LINE DIAGRAM	TRAFFIC			PAVEMENT DATA
FED. AID.	FUNCT CLASS.	HWY. SYS.	HPMS SAMPLE	PRKG. REST.	COM/IND. ACCESS		CONTROL	COM/IND. ACCESS	PRKG. REST.	

UNASSIGNED

Now Routes

(Private DR)

Co-328, Quail Run 93-CO #3

~~Co 328, Quail Run~~ and Co 529, Pheasant Dr

~~92-9, 11~~

TRAFFIC CODES

TRAFFIC CONTROLS: STOP SIGN=SS, TRAFFIC LIGHT=T.L., FLASHING RED BALL=F.R.

TRAFFIC CODES

PARKING RESTRICTIONS: A.M. PEAK, P.M. PEAK, A.M./P.M. PEAK, NO PARKING ANYTIME=N.P., COMM/IND. ACCESS=E

SYSTEM				TRAFFIC		LINE DIAGRAM	TRAFFIC			PAVEMENT DATA
FED. AID.	FUNCT. CLASS.	HWY. SYS.	HPMS SAMPLE	PRKG. REST.	COM/IND ACCESS		CONTROL	COM/IND ACCESS	PRKG. REST.	

Form 6 HPS (Rev. 1961)

303-1122

ROAD INVENTORY SHEET

Party Chief F. SETTAN
Recorder T. LANDON
Chainman
T. LANDON
F. RHODES
9/27/74 VERIFIED

Road No. OP21
Name
Sheet No. 1 OF 1
Date 6-2-65
County DORCHESTER
1123-303

BOBTOWN RD.
CO 012 335

N

003

4 H

000
ROAD END

10'C
16'CW

303-1122

Form 6 HPS (Rev. 1961)

ROAD INVENTORY SHEET

Party Chief F. SETTAN
Recorder J. LANDON
Chainman
T. LANDON
F. RHODES
9/27/74 VERIFIED

Road No. OP22
Name
Sheet No. 1 OF 1
Date 6-2-63
County DORCHESTER
1124-303

BOBTOWN	ROAD	
CO	007	335
	003	PT
	004	H (VAC) 90°
N	003	H PC
	002	H
	000	H
ROAD	END	

12'D
16'CW

Form 6 HPS (Rev. 1961)

278-1012

ROAD INVENTORY SHEET

Party Chief F SETTAN
Recorder C FOREST
Chainman

T. LANDON
F. RHODES
9/5/74 VERIFIED

Road No. ~~Co 11~~ OP 26
Name (HUDSON School Rd)
Sheet No. 10F1
Date 4-14-65
County DORCHESTER

1009-277

		Cooks Co	Pt Rd 14
	1	36	
PT 30° PC	1	32	
	1	30	
H	0	97	16'D 20'CW
		NO NAME Co 13	
	0	92	
	0	90	NO NAME Co 12
		Hudson School Rd Co 10	
	0	81	
H	0	78	
H	0	76	
H	0	72	14'F 20'CW
E	0	69	80°
	0	24	F 50° 90°
			0 P
~~40°~~ 80°	0	18	26 10'~~F~~ I 14'CW
	0	00	
	ROAD	END	
H	H	F	

Form 6 HPS (Rev. 1961) 279-1015

ROAD INVENTORY SHEET

Party Chief F SETTAN
Recorder C FORREST FAR
Chainman

T. LANDON
F. RHODES
9/5/74 VERIFIED

65-20

Road No. ~~C018~~ OP 27
Name ~~BALDWIN RD~~ INDIAN QUARTER RD.
Sheet No. 1 OF 1
Date 4-15-65
County DORCHESTER
1015-278

H

H H

ROAD END

0 71

0 52 E 70°

0 28 12" CMP

0 17 PT

0 16 H (VAC) 85°

0 15 PC

E ↑

0 12 H

F-400'

0 02

30°

0 01

MD

0 00

343

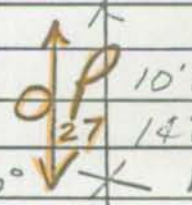

65-20
20'F
30 CW
2-3 F Slag

26 E
30 CW

Form 6 HPS (Rev. 1961) 275-1035

ROAD INVENTORY SHEET

OP 29

Party Chief ~~F SETTAN~~
Recorder
Chainman ~~C FORREST~~

T. LANDON
F. RHODES
9/3/74 VERIFIED

Road No. ~~625~~
Name RICHARDSON RD
Sheet No. 1 OF 1
Date 4-20-65
County ~~DORCHESTER~~
1035-279

	H		
	ROAD END		
	0 99		
H	0 97	PVT. CEM.	
H	0 93	0 P	
		29	10'D
(90°	0 91		14'CW
	0 82	15°	
MARINA	0 71	H	
	0 63	H	
	0 37	H	
	0 29	H	
	0 11	12" CP	2-3'ESHLD
			16'F
			24'CW
Cambridge-Hudson Rd MD	0 00		
	343		

N

Form 6 HPS (Rev. 1961)

278-1037

ROAD INVENTORY SHEET

GARDEN OF EDAN RD

Party Chief F SETTAN
Recorder C FORREST
Chainman

REVISED 2.1.67

65-19

Road No. ~~Co26~~ OP 30
Name TRAVERS WHARF Rd
Sheet No. 1 OF 1
Date 4-20-65
County DORCHESTER

G8 - 4

CODE UNASSIGNED

NOW Co 26

ROAD	END	
1	08	H
0	95	H 90°
0	91	
0	81	H 90°
0	52	
0	45	
		TRAVERS WHARF RD Co27
0	23	
0	04	
0	00	

343

90° GARDEN OF EDAN RD

40°

H-ABAN.

TRAVERS WHARF RD 27

MD

90° 30 20CW

H 90° 15-30

0 P 10'E 14'CW

30

14'E 20'CW

12' CMP 5'E

20'F 28CW 36CW

20'F 24'CW

20'I 26'CW

SHA 51.3-8
11-15-72

STATE HIGHWAY ADMINISTRATION OF MARYLAND

OP 32

ROAD INVENTORY SHEET

Party Chief T. LANDON
Recorder E. RHODES
Helper

9/10/74 VERIFIED

Map No. G10

Road No. Co 418
Road Name (OYSTER COVE RD)
Sheet No. 1 OF 1
Date 1-22-74
County DORCHESTER
State Coordinates 992-235

W

F 0 22

H 0 20

PT 0 16 8'D
85° 10'CW
PC 0 14

OP 32

0 11

0 07 H

10'D
12'CW

BAY SHORE RD
CO 106 0 00

BAY SHORE
CO 107

Form 6 HPS (Rev. 1961)

172-1065

OP 33

ROAD INVENTORY SHEET

Party Chief F. SETTAN
Recorder T. LANDON
Chainman C. FORREST

T. LANDON
F. RHODES
9/17/74 VERIFIED

Road No. ~~CO~~ 162
Name TODDVILLE BACK ST
Sheet No. 1 OF 1
Date 5-10-65
County DORCHESTER

	H		
ROAD		END	
	0 32		
	0 24	H	
	0 23		
	0 20	H	
H	0 16	H	
	0 14	H	
H	0 11	H	
	0 04	H	
	FARM CREEK RD.		
CO	000	150	

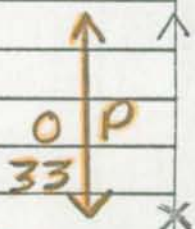

10' E
16' CW

12' E
16' CW

Form 6 HPS (Rev. 1961) 165-1062 (Blow up)

ROAD INVENTORY SHEET

~~OF 34~~

Party Chief ~~F SETTAN~~
Recorder
Chainman ~~C FOREST~~ T.L.

Road No. ~~CO 165~~
Name POWLEY RD
Sheet No. 1 OF 1
Date 5-11-65
County DORCHESTER

POWLEY

Unassigned
71-1
Now Co 372
ADAMS RD.

HEATENS COVE

H

ROAD END

0 23

0 20 H

34 ← Co 150 — Co 149 → 34

Co 0 15 138

WINGATE BISHOPS HEAD RD.

0 02 48" CMP. 11'E 15'W

0 00

ROAD END

PUT. CEM. H

Form 6 HPS (Rev. 1961) 250-1096

ROAD INVENTORY SHEET

OP 35

Party Chief F. SETTAN
Recorder T. LANDON
Chainman C. FORREST

T. LANDON
F. RHODES
9/23/74 VERIFIED

Road No. ~~C0184~~
Name HIGGINS Mill Pond Rd
Sheet No. 1 OF 1
Date 5-14-65
County DORCHESTER

	ROAD	END	
E ↑ F	0	64	
H -400'	0	51	12'E 16'CW
H	0	46	
F ↑90°	0	44	
H	0	35	18'E 24'CW
	0	23	H-ABAN.
DRAWBRIDGE		ROAD	
CO	000	177	

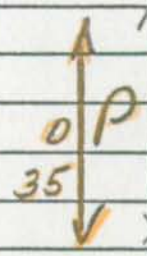

235-1095

Form 6 HPS (Rev. 1961)

OP 36

ROAD INVENTORY SHEET

Party Chief F. SETTAN
Recorder T. LANDON
Chainman C. FORREST

T. LANDON
F. RHODES
9/24/74 VERIFIED

GH-10

Road No. ~~Co 233~~
Name FORK NECK RD.
Sheet No. 1 OF 1
Date 5-14-65
County DORCHESTER

DE Coursey Bridge Rd.

CO	174	169
	124	90° ↑
	123	=
PT. 7 90°	099.	OP 12'D
PC.	096	36 18'CW
	089	DR.
	069	
	029	12" CP
	007	= - 1800'
Fork Neck Road	179	12'F
CO	000	18'CW

SHA 51.3-8
11-15-72

STATE HIGHWAY ADMINISTRATION OF MARYLAND

ROAD INVENTORY SHEET

O.P. 90

Party Chief: T. Lardon
Recorder: F. Rhodes
Helper:

Map No.:

Road No.: Co. 328
Road Name: Snug Harbor Rd.
Sheet No.: 1051
Date: 9-25-74
County: Dorchester
State Coordinates: 1099 - 290

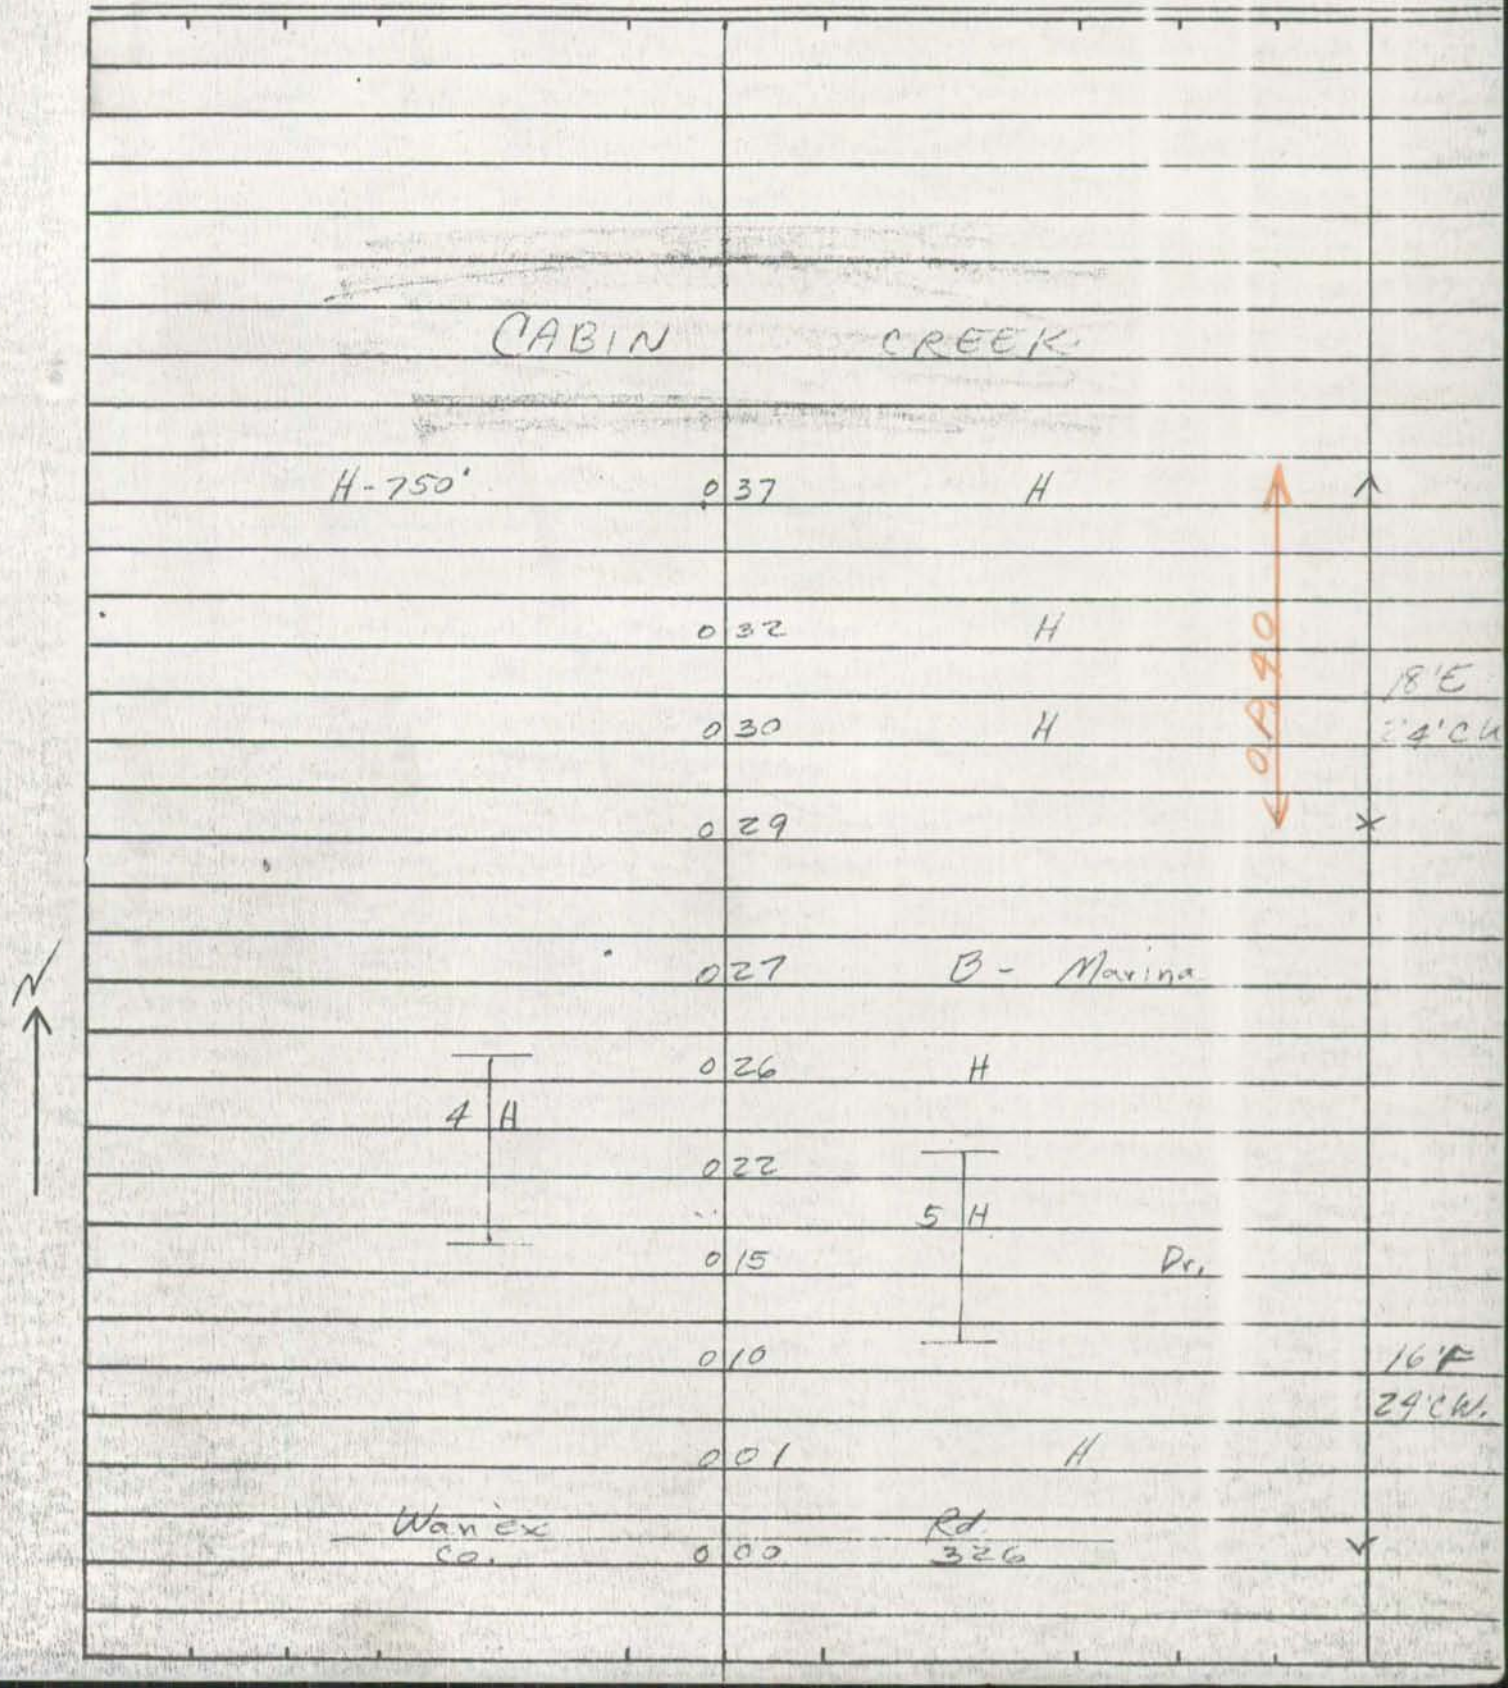

Form 6 HPS (Rev. 1961)

1023-247

~~OPH~~

~~[illegible]~~

ROAD INVENTORY SHEET

Party Chief T. LANDON
Recorder W. WARFIELD
Helper

T. LANDON
F. RHODES 71-5
9/10 74 VERIFIED

Road No. Co 373
Road Name (PENNSYLVANIA AVE.)
Sheet No. 1 of 1
Date 1-31-72
County DORCHESTER

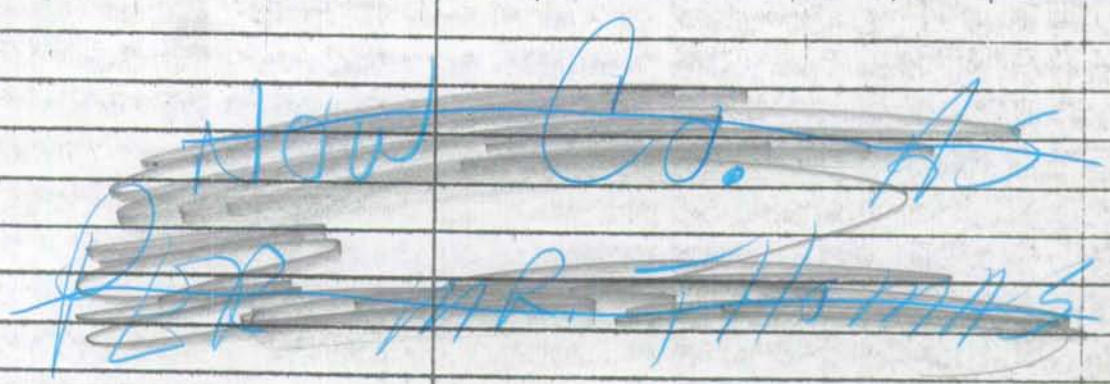

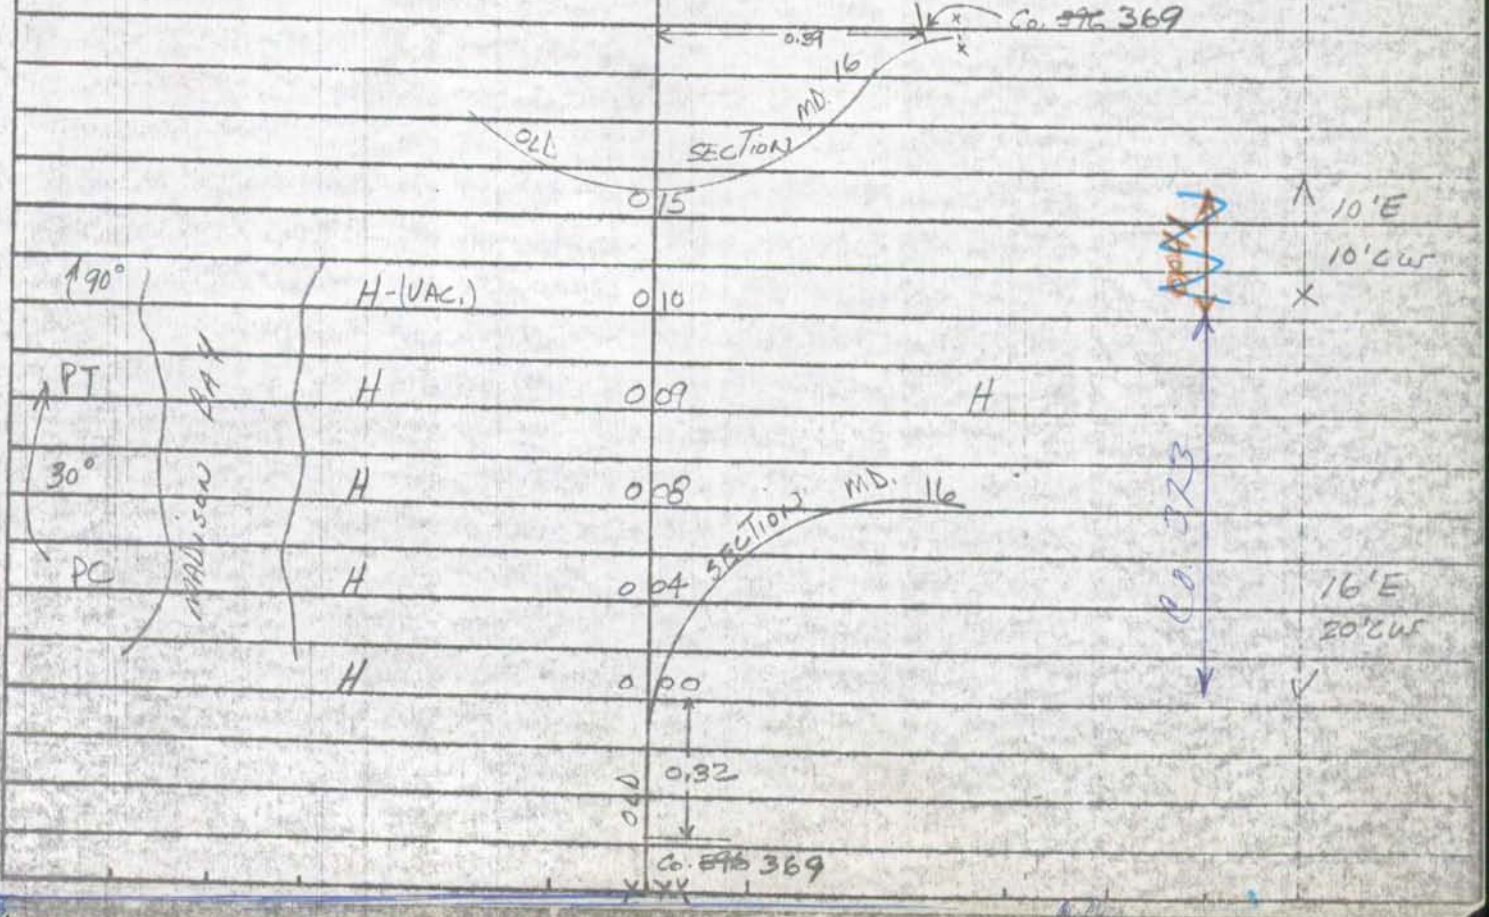

Form 6 HPS (Rev. 1961) 1067-268

ROAD INVENTORY SHEET

OP 44

Party Chief T. LANDON
Recorder W. WARFIELD
Helper

Road No. ~~#0480~~
Road Name FLETCHER AVE.
Sheet No. 1 OF 1
Date 2-1-72
County DORCHESTER

70-15 - CAMBRIDGE

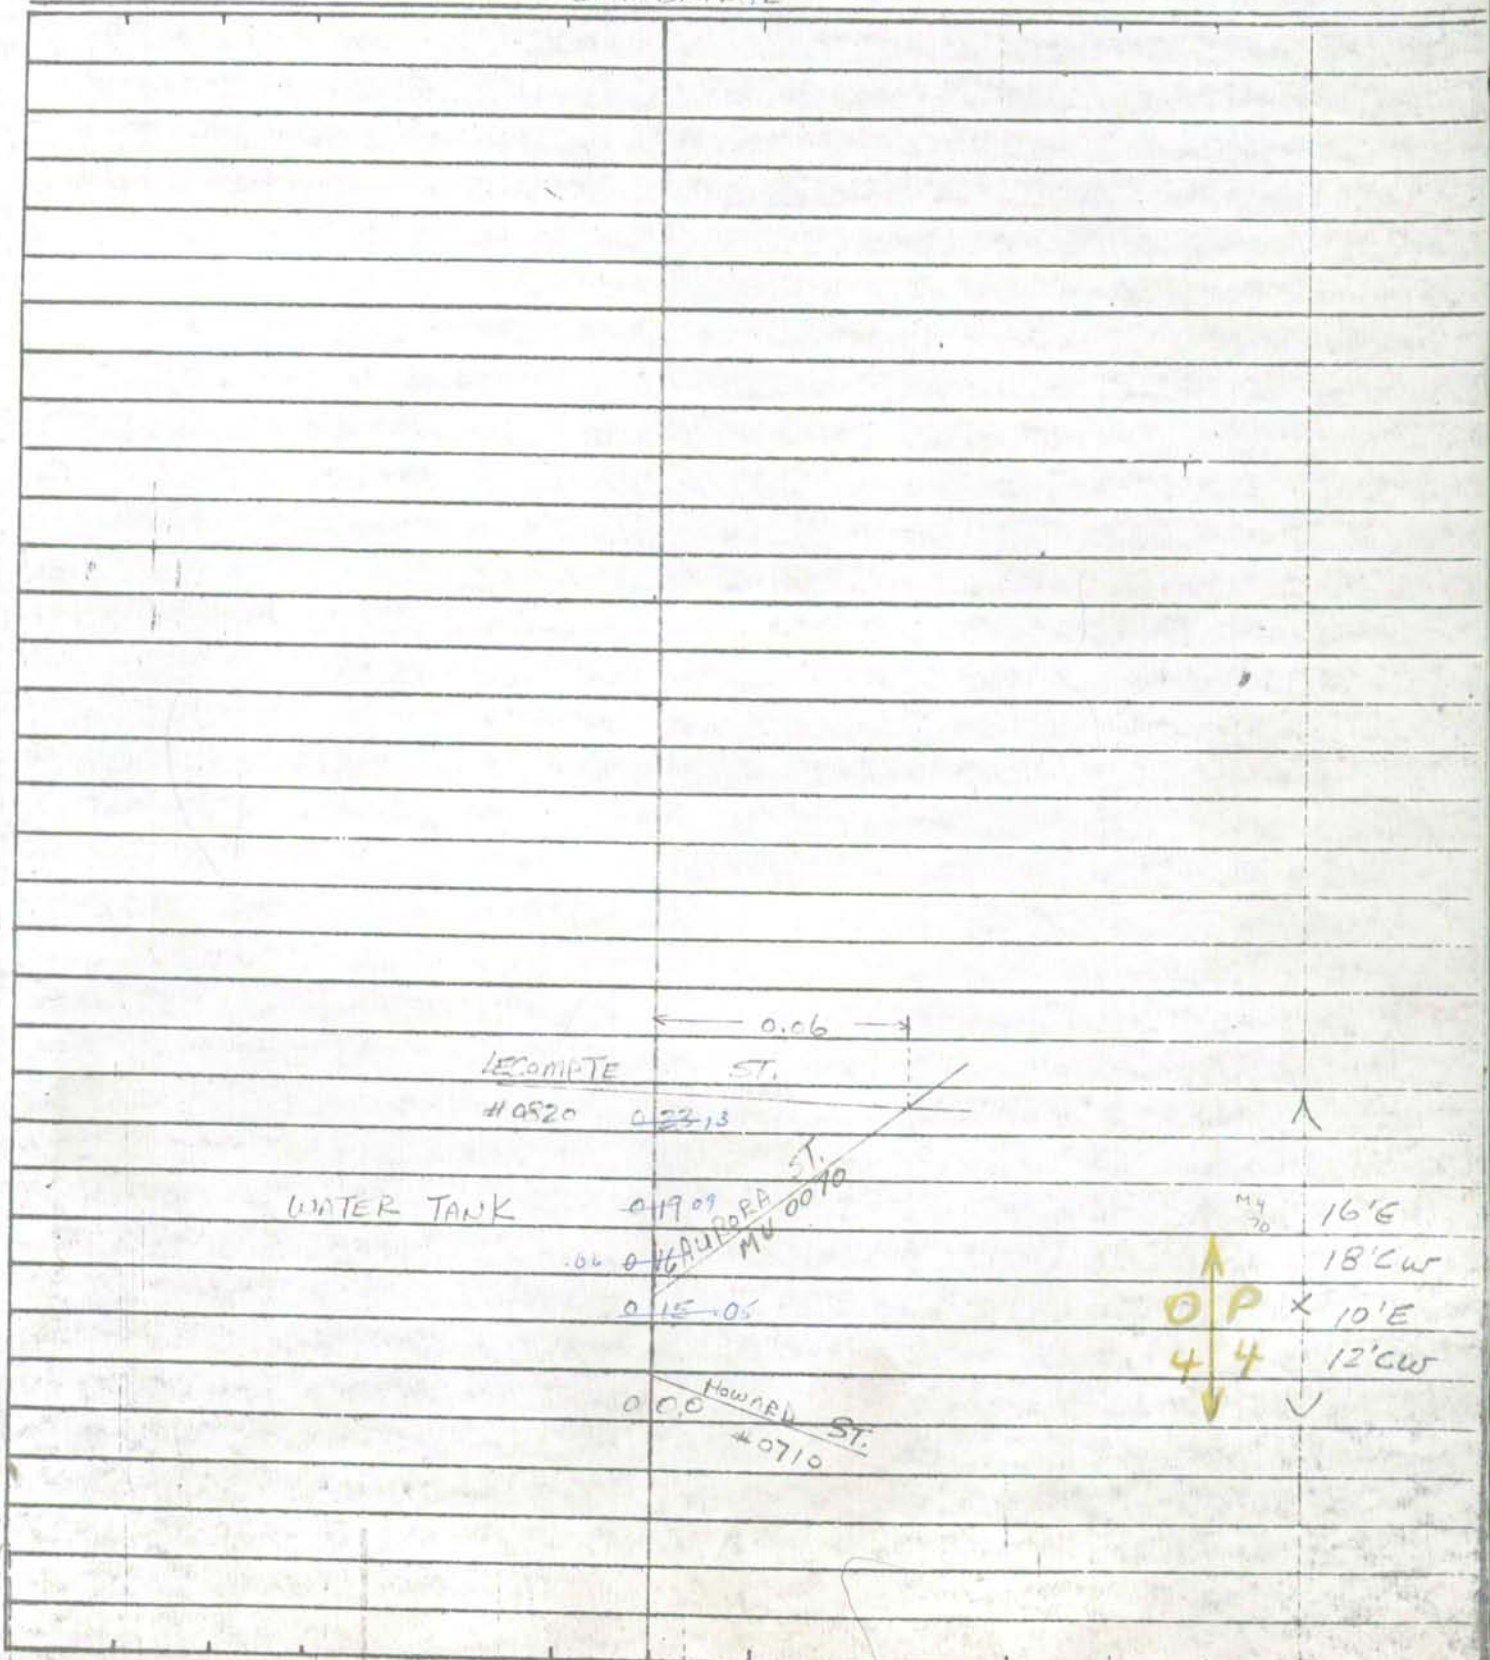

1068-268

Form 6 HPS (Rev. 1961)

ROAD INVENTORY SHEET

OP 45

Party Chief T. LANDON
Recorder W. WARFIELD
Helper

Road No. ~~# 0710~~
Road Name HOWARD ST.
Sheet No. 1 OF 1
Date 2-1-72
County DORCHESTER

66-86 CAMBRIDGE

FLETCHER AVE. ~~# 0850~~ #14 OP

0.10

0.04

ST. DORCHESTER AVE.

~~# 0410~~ 0.00

CEDAR 0.07

OP 4 OP 5

10'E
12'Cu
20'G
24'Cu

Form 6 HPS (Rev. 1961)

ROAD INVENTORY SHEET

OP46

Party Chief T. LAMSON
Recorder W.S. WAKEFIELD
Helper

Road No. #1035
Road Name PENNSYLVANIA AVE.
Sheet No. 1 OF 1
Date 2-1-72
County DORCHESTER

70-56 CAMBRIDGE 1063-264

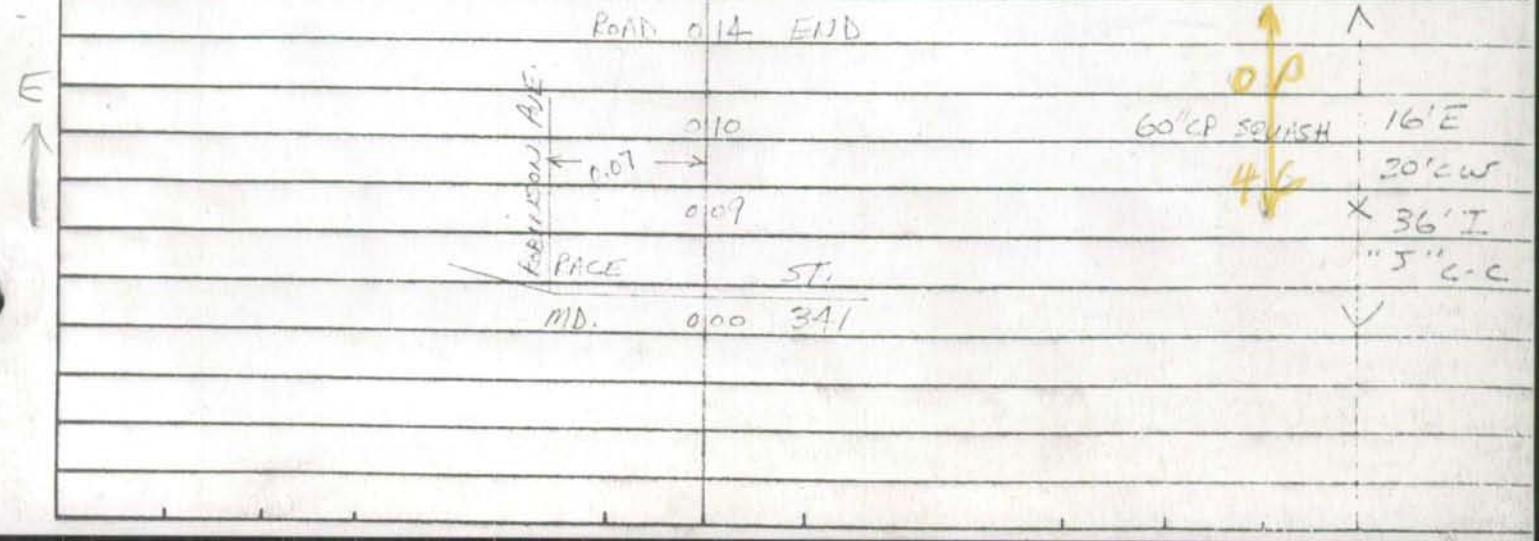

Form 6 HPS (Rev. 1961)

1124-295

ROAD INVENTORY SHEET

OP 47

Party Chief T. LANDON
Recorder W. WARFIELD
Helper

HURLOCK
70-1

Road No. (MUN.) 0112
Road Name HURLOCK AVE.
Sheet No. 1 of 1
Date 1-27-72
County DORCHESTER

Now Mun 0112

Unassigned

WRIGHTS (MUN.) 0111 AVE. 0320

HEIGHTS AVE (MUN.) ELM 0001 ST. 3rd ST.

(MUN.) 0000 0095 2nd ST. POPLAR

OP 47

24' E
30' CW

SHA 51.3-8
11-15-72

STATE HIGHWAY ADMINISTRATION OF MARYLAND

ROAD INVENTORY SHEET MUN 330

Party Chief T. LANDON
Recorder F. RHODES
Helper

Map No. G 10 PROSPECT HILLS HURLOCK

Road No. OP 48
Road Name (GOLD RUSH LANE)
Sheet No. 1 OF 1
Date 10/1/74
County DORCHESTER
State Coordinates 1128 - 292

UNASSIGNED
NOW
MU0330
HURLOCK
89-21

W

ROAD END

H 0 03 H

↑10° 0 01 H

GOLD RUSH LA
~~MUN 1A~~ MU 0103 104 0 00

GOLD RUSH LA
~~MUN 1A~~ MU 0103
104

24'G
2-3'ESAL
30'CW

SHA 51.3-8
11-15-72

ROAD INVENTORY SHEET

Road No. _____
Road Name _____
Sheet No. _____
Date _____
County _____
State Coordinates _____

SHA 51.3-8
11-15-72

STATE HIGHWAY ADMINISTRATION OF MARYLAND

ROAD INVENTORY SHEET

Party Chief _____
Recorder _____
Helper _____

Map No. _____

Road No. _____
Road Name _____
Sheet No. _____
Date _____
County _____
State Coordinates _____

OP 49
UNASSIGNED
NOW HURLOCK MUN

"GOLD RUSH LA"
MU 74-6

SHA 51.3-8
11-15-72

ROAD INVENTORY SHEET

Road No. _____
Road Name _____
Sheet No. _____
Date _____
County _____
State Coordinates _____

SHA 51.3-8
11-15-72

STATE HIGHWAY ADMINISTRATION OF MARYLAND

ROAD INVENTORY SHEET

Party Chief _____
Recorder _____
Helper _____

Map No. _____

Road No. _____
Road Name _____
Sheet No. _____
Date _____
County _____
State Coordinates _____

OP 50
UNASSIGNED
NOW HURLOCK MUN
"DOUGLAS DRIVE"
MU~~7-4-6~~ 74-1

SHA 51.3-8
11-15-72

ROAD INVENTORY SHEET

Road No. _____
Road Name _____
Sheet No. _____
Date _____
County _____
State Coordinates _____

SHA 51.3-8
11-15-72

STATE HIGHWAY ADMINISTRATION OF MARYLAND

ROAD INVENTORY SHEET

Party Chief _____
Recorder _____
Helper _____

Map No. _____

Road No. _____
Road Name _____
Sheet No. _____
Date _____
County _____
State Coordinates _____

OP 51
UNASSIGNED
NOW HURLOCK MUN

"LLOYD C/R"
MU ~~74-6~~ 74-8

SHA 51.3-8
11-15-72

ROAD INVENTORY SHEET

Road No. _____
Road Name _____
Sheet No. _____
Date _____
County _____
State Coordinates _____

OP 52

DORCHESTER COUNTY

UNASSIGNED

NOW

MU 0190

SUGAR DRIVE

99-1 MU

FILE: OP to CO.doc
HISD - SHA

Tuesday, January 04, 2000

SHA 51.3-8
11-15-72

STATE HIGHWAY ADMINISTRATION OF MARYLAND

ROAD INVENTORY SHEET

Party Chief _____
Recorder _____
Helper _____

Map No. _____

Road No. OP 52
Road Name _____
Sheet No. _____
Date _____
County _____
State Coordinates _____

UNASSIGNED

NOW 20 472
78-21

SHA 51.3-8
11-15-72

ROAD INVENTORY SHEET

Road No. _____
Road Name _____
Sheet No. _____
Date _____
County _____
State Coordinates _____

OP 55

UNASSIGNED

SEE CO. 435

(74-105)

SHA 51.3-8
11-15-72

STATE HIGHWAY ADMINISTRATION OF MARYLAND

ROAD INVENTORY SHEET

Party Chief T. LANDON
Recorder E. RHODES
Helper

Map No.

Road No. OP 57
Road Name
Sheet No. 1 OF 1
Date 9/10/74
County DORCHESTER
State Coordinates 1005-234

	ROAD	END	
H	0	25	
H	0	22	
↑15° H	0	19	
	0	11	50°↑
↑30° H	0	09	12'E 16'CW
B-MARINA	0	03	
	0	00	

N ↑

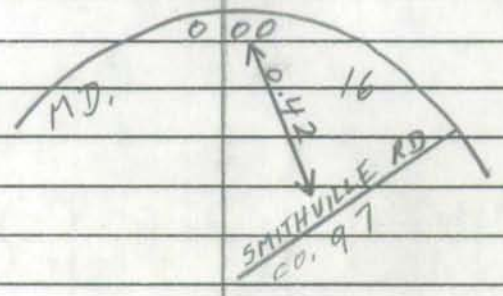

SHA 51.3-8
11-15-72

ROAD INVENTORY SHEET

Road No. _____
Road Name _____
Sheet No. _____
Date _____
County _____
State Coordinates _____

SHA 51.3-8
11-15-72

STATE HIGHWAY ADMINISTRATION OF MARYLAND

ROAD INVENTORY SHEET

Party Chief _____
Recorder _____
Helper _____

Map No. _____

Road No. OP 58
Road Name _____
Sheet No. _____
Date _____
County DORCHESTER
State Coordinates _____

(UNASSIGNED)

NOW CO 482

81-15

SHA 51.3-8
11-15-72

ROAD INVENTORY SHEET

Road No. _____
Road Name _____
Sheet No. _____
Date _____
County _____
State Coordinates _____

SHA 51.3-8
11-15-72

STATE HIGHWAY ADMINISTRATION OF MARYLAND

ROAD INVENTORY SHEET O.P. 59

Party Chief T. Landon
Recorder F. Rhodes
Helper

Map No.

Road No. ~~Co. 226~~
Road Name Belle Aire Rd.
Sheet No. 1 of 1
Date 9-25-74
County Worcester
State Coordinates 1089-274

CHOPTANK RIVER

H	0	H 70	
	0	69 H	
	0	61 (15°)	
H	0	55	10' E
			14' C. L.
	0	52	
H	0	50	
H	0	44	
(15°	0	37 F	
H. 500	0	27	
H	0	19	
H	0	17	
			13' F
F T	0	01 T T	18' C. L.
MD	0	00 16	

O.P. 59

N

SHA 51.3-8
11-15-72

STATE HIGHWAY ADMINISTRATION OF MARYLAND

ROAD INVENTORY SHEET

O.P. 60 Next Page

Party Chief T. Landon
Recorder F. Rhodes
Helper

Map No. _____

Road No. ~~Co. 232~~
Road Name Sunnyside Rd.
Sheet No. 1 of 2
Date 9-25-74
County Dorchester
State Coordinates 1097 -284

H	0 56		
(90°	0 43		
H (Vac.)	0 39		
H	0 26	H-1000'	
	0 23		
3 H	0 19	H 10.5	
	0 17		
B-Barber	0 16		
H	0 12	H-600'	
H	0 09	H-800'	
			15' E
	0 06	O.P. 13	19' C.W.
H	0 03	H-500'	
	0 02	H-500' 20.5	
			20' E
	0 01	24" C.P.	32' C.W.
	0 00		

W

MD 17 I

SHA 51.3-8
11-15-72

ROAD INVENTORY SHEET

O.P. 60
~~Co. 232~~

Road No. _____
Road Name _____
Sheet No. 2 of 2
Date _____
County _____
State Coordinates _____

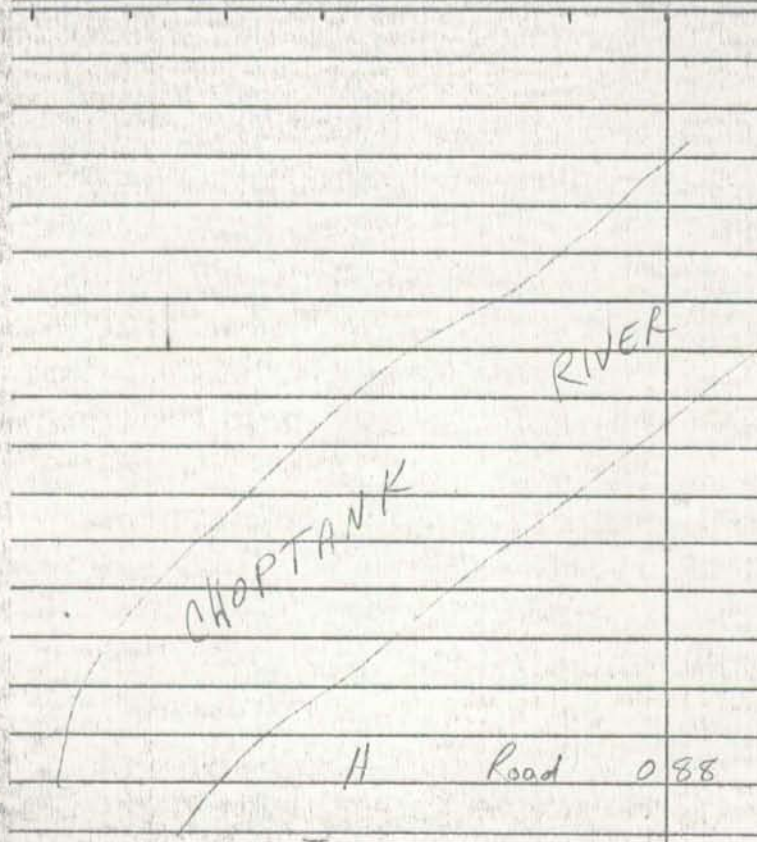

H	Road	0 88	End	
(90°		0 86		
		0 82	H	
		0 79	H-400' 90°)	10'E 12'C.W.
(90°		0 68		
		0 63	F-600'	
		0 59	90°)	Same

SHA 51.3-8
11-15-72

STATE HIGHWAY ADMINISTRATION OF MARYLAND

ROAD INVENTORY SHEET

OP. 61 Next Page

Party Chief T. Landon
Recorder F. Rhodes
Helper

Map No. _____

Road No. ~~Co. 246~~
Road Name (Conway Rd.)
Sheet No. 1 of 2
Date 9-26-74
County Dorchester
State Coordinates 1109-279

(30°	0	20	H
H	0	19	H
H	0	16	
H	0	15	
H	0	14	
(10° (Richardson Co.	0	12	(Rd. 245
H	0	09	H
	0	08	H
H	0	05	No Name Co. 247
	0	02	(30° 14'6 16'CW.
(Depot Co.	0	00	(Rd. 244

E ↑

SHA 51.3-8
11-15-72

ROAD INVENTORY SHEET

O.P. 61

Road No. ~~Co. 246~~
Road Name
Sheet No. 2 of 2
Date
County
State Coordinates

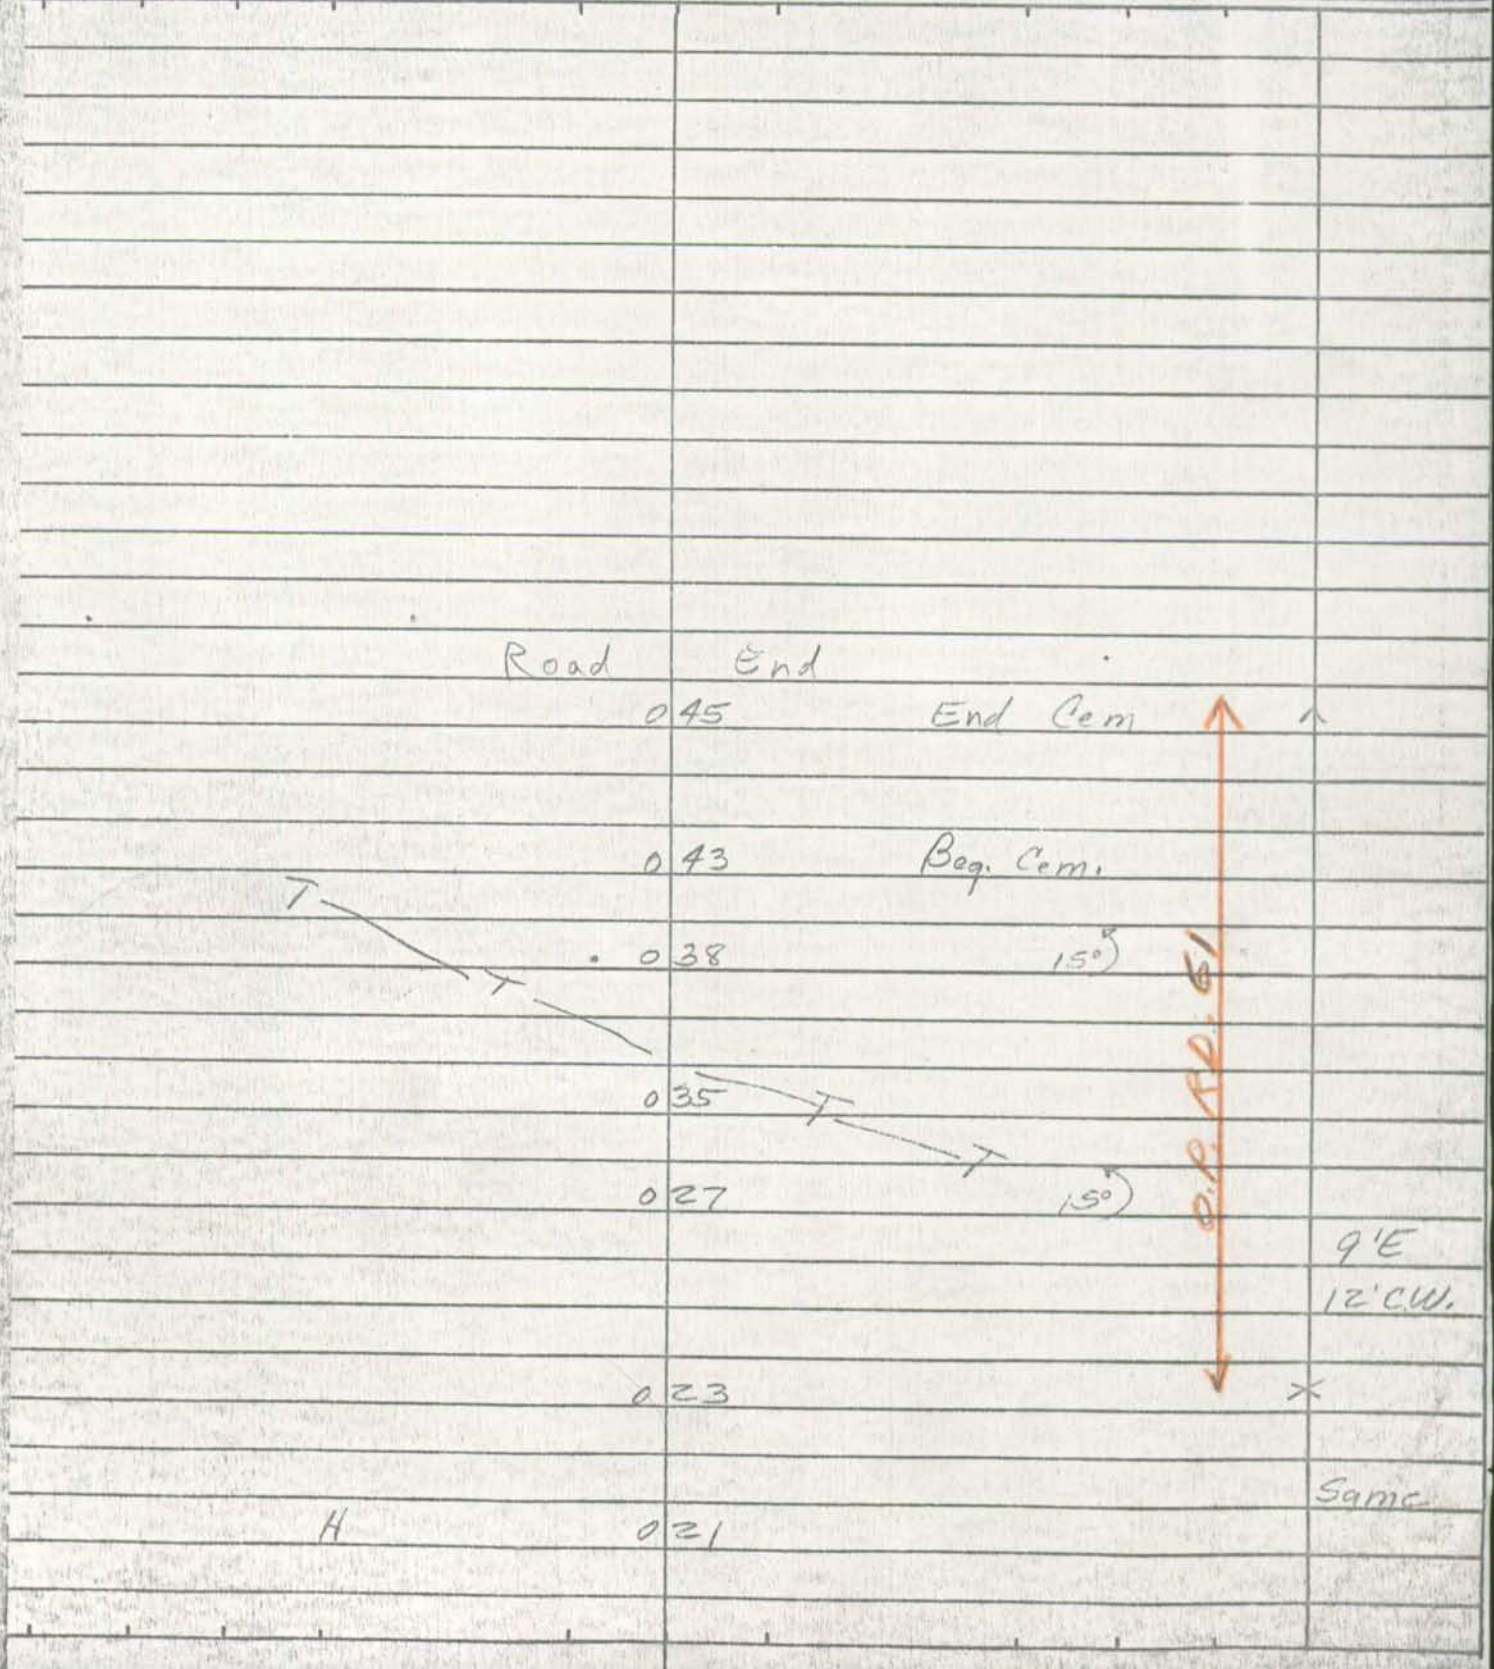

SHA 51.3 - 8 Revised
4.83

MARYLAND STATE HIGHWAY ADMINISTRATION

ROAD INVENTORY SHEET

Party Chief _____
Recorder _____
Assistant _____
Map No./Dir. 1
State Coordinates _____

Road No. OP62
Road Name JONES VILLAGE RD
County DORCHESTER
Date _____
Sheet No. _____ OF _____

SYSTEM				TRAFFIC		LINE DIAGRAM	TRAFFIC			PAVEMENT DATA
FED. AID.	FUNCT CLASS.	HWY. SYS.	HPMS SAMPLE	PRKG. REST.	COM/IND. ACCESS		CONTROL	COM/IND. ACCESS	PRKG. REST.	
						SEE INVENTORY OF CO 308				

TRAFFIC CODES

TRAFFIC CONTROLS: STOP SIGN=SS,
TRAFFIC LIGHT=T.L.,
FLASHING RED BALL=F.R.

TRAFFIC CODES

PARKING RESTRICTIONS: A.M. PEAK, P.M. PEAK, A.M./P.M. PEAK, NO PARKING ANYTIME=N.P., COMM/IND. ACCESS=E

SYSTEM				TRAFFIC		LINE DIAGRAM	TRAFFIC				PAVEMENT DATA
FED. AID.	FUNCT. CLASS.	HWY. SYS.	HPMS SAMPLE	PRK.G. REST.	COM/IND ACCESS		CONTROL	COM/IND ACCESS	PRK.G. REST.		

SHA 51.3-8
11-15-72

STATE HIGHWAY ADMINISTRATION OF MARYLAND

73-3

ROAD INVENTORY SHEET

op 63

Party Chief W. Dombroski
Recorder D. Taylor
Helper

Map No. _____

Hurlock

Road No. MU 0120
Road Name James St
Sheet No. 1 of 1
Date 1-22-74
County Dorchester
State Coordinates 1124-294

F. ANNUALS VERIFIED 75

MUN

MUN

op 0 2.1 46

20'F
20'W

Road End
019

E

(Penn St)
MUN. 73-1 016 op

Commerce St
MUN 013 0060'

26' F
30' W

Noble St
MUN 007 0210

26' G
30' W

N. Main St
~~001~~ ~~317~~ MU 140

SHA 51.3 - 8 Revised
4.83

MARYLAND STATE HIGHWAY ADMINISTRATION HurLook

ROAD INVENTORY SHEET

Party Chief _____
Recorder _____
Assistant _____
Map No./Dir. 1
State Coordinates _____

Road No. OP 64
Road Name Mapleton ST
County DORCHESTER
Date _____
Sheet No. _____ OF _____

SYSTEM				TRAFFIC		LINE DIAGRAM	TRAFFIC			PAVEMENT DATA
FED. AID.	FUNCT CLASS.	HWY. SYS.	HPMS SAMPLE	PRKG. REST.	COM/IND. ACCESS		CONTROL	COM/IND. ACCESS	PRKG. REST.	
						SEE INVENTORY OF				
						MU 0150 2-11-93 T. Massicot				

TRAFFIC CODES

TRAFFIC CONTROLS: STOP SIGN=SS, TRAFFIC LIGHT=T.L., FLASHING RED BALL=F.R.

TRAFFIC CODES

PARKING RESTRICTIONS: A.M. PEAK, P.M. PEAK, A.M./P.M. PEAK, NO PARKING ANYTIME=N.P., COMM/IND. ACCESS=E

SYSTEM				TRAFFIC		LINE DIAGRAM	TRAFFIC			PAVEMENT DATA
FED. AID.	FUNCT. CLASS.	HWY. SYS.	HPMS SAMPLE	PRK.G. REST.	COM/IND ACCESS		CONTROL	COM/IND ACCESS	PRK.G. REST.	

SHA 51.3 - 8 Revised
4.83

MARYLAND STATE HIGHWAY ADMINISTRATION Hurlock

ROAD INVENTORY SHEET MU0235

Party Chief _____
Recorder _____
Assistant _____
Map No./Dir. 1
State Coordinates _____

Road No. OP65
Road Name PENN ST
County Dorchester
Date 3-4-92
Sheet No. 1 OF 1

SYSTEM				TRAFFIC		LINE DIAGRAM	TRAFFIC			PAVEMENT DATA
FED. AID.	FUNCT CLASS.	HWY. SYS.	HPMS SAMPLE	PRKG. REST.	COM/IND. ACCESS		CONTROL	COM/IND. ACCESS	PRKG. REST.	
						UNASSIGNED				
						NOW MU 0235				
						Imp. Report 77-2 3/4/92 T.M.				

TRAFFIC CODES

TRAFFIC CONTROLS: STOP SIGN=SSy
TRAFFIC LIGHT=T.L.,
FLASHING RED BALL=F.R.

TRAFFIC CODES

PARKING RESTRICTIONS: A.M. PEAK,
P.M. PEAK, A.M./P.M. PEAK, NO PARKING
ANYTIME=N.P., COMM/IND. ACCESS=E

SYSTEM				TRAFFIC		LINE DIAGRAM	TRAFFIC			PAVEMENT DATA
FED. AID.	FUNCT. CLASS.	HWY. SYS.	HPMS SAMPLE	PRK.G. REST.	COM/IND ACCESS		CONTROL	COM/IND ACCESS	PRK.G. REST.	

SHA 51.3-8
11-15-72

STATE HIGHWAY ADMINISTRATION OF MARYLAND

(92 MU EX #1)
GO/A. HATTEN
1/29/93

ROAD INVENTORY SHEET

Party Chief T. LANDON
Recorder E. RHODES
Helper

Map No. URBAN

Road No. OP 66
Road Name MD. 16 ST.
Sheet No. 1 OF 1
Date 10/15/75
County DORCHESTER
State Coordinates 1125-296

HURLOCK

ABANDONED

RAILROAD AVE
POPLAR ST.
MUN. 0.240 0.260

S

BROAD ST.
MD. 0 19 307

0 10 JAMES ST.
OP 63 SECTION
MP 120

MARLETON ST.
OP 64 0 00 MUN 0.150

12'E
16'CW

SHA 51.3-8
11-15-72

ROAD INVENTORY SHEET

Road No. _____
Road Name _____
Sheet No. _____
Date _____
County _____
State Coordinates _____

Form 6 HPS (Rev. 1961)

ROAD INVENTORY SHEET

OP 67

Party Chief F. SETTAN
Recorder T. LANDON
Chainman C. FORREST

T. LANDON
F. RHODES
VERIFIED
10/14/75
HURLOCK

Road No. ~~0209~~
Name (WRIGHT ST)
Sheet No. 1 OF 1
Date 5-27-75
County DORCHESTER

WRIGHT PLANT

008

E ↑

24'C
~~20'E~~
26'CW

0200

NEALSON 000 ST ↓

SHA 51.3-8
11-15-72

STATE HIGHWAY ADMINISTRATION OF MARYLAND

ROAD INVENTORY SHEET

Party Chief FR
Recorder JE
Helper

Map No. G10

79-Extra 79-10:15

Road No. OP 68
Road Name
Sheet No. 1 of 1
Date 2-12-80
County Dorchester
State Coordinates 1083-265

S

De
Cul 0 28 Sac

0 11 H

0 10 H

Cannon Rd
Co 471 @ON 0 07

22'F
30'C-41

Cul 0 00 Sac
De

SHA 51.3-8
11-15-72

ROAD INVENTORY SHEET

Road No. _____
Road Name _____
Sheet No. _____
Date _____
County _____
State Coordinates _____

SHA 51.3 - 8 Revised
4.83

MARYLAND STATE HIGHWAY ADMINISTRATION

ROAD INVENTORY SHEET

Party Chief _____
Recorder _____
Assistant _____
Map No./Dir. 1
State Coordinates _____

Road No. OP 69
Road Name (Belfiore RD)
County Dorchester
Date _____
Sheet No. _____ OF _____

SYSTEM				TRAFFIC		LINE DIAGRAM	TRAFFIC			PAVEMENT DATA
FED. AID.	FUNCT CLASS.	HWY. SYS.	HPMS SAMPLE	PRKG. REST.	COM/IND. ACCESS		CONTROL	COM/IND. ACCESS	PRKG. REST.	
						Unassigned Now MD Co 532 93-13 Co				

TRAFFIC CODES

TRAFFIC CONTROLS: STOP SIGN=SS, TRAFFIC LIGHT=T.L., FLASHING RED BALL=F.R.

TRAFFIC CODES

PARKING RESTRICTIONS: A.M. PEAK, P.M. PEAK, A.M./P.M. PEAK, NO PARKING ANYTIME=N.P., COMM/IND. ACCESS=E

SYSTEM				TRAFFIC		LINE DIAGRAM	TRAFFIC			PAVEMENT DATA
FED. AID.	FUNCT. CLASS.	HWY. SYS.	HPMS SAMPLE	PRKG. REST.	COM/IND ACCESS		CONTROL	COM/IND ACCESS	PRKG. REST.	

SHA 51.3 - 8 Revised
4.83

MARYLAND STATE HIGHWAY ADMINISTRATION

ROAD INVENTORY SHEET

Party Chief _____
Recorder _____
Assistant _____
Map No./Dir. 1
State Coordinates _____

Road No. OP 70
Road Name _____
County Dorchester
Date _____
Sheet No. _____ OF _____

SYSTEM				TRAFFIC		LINE DIAGRAM	TRAFFIC			PAVEMENT DATA
FUNCT CLASS	HWY. SYS.	HPMS SAMPLE		PREG. REST.	COM/IND ACCESS		CONTROL	COM/IND ACCESS	PREG. REST.	

Unassigned

Now

CO 547

97-11 CO.

TRAFFIC CODES

TRAFFIC CONTROLS: STOP SIGN-SS, TRAFFIC LIGHT=T.L., FLASHING RED BALI=F.R.

TRAFFIC CODES

PARKING RESTRICTIONS: A.M. PEAK, P.M. PEAK, A.M./P.M. PEAK, NO PARKING ANYTIME=N.P., COMM/IND. ACCESS=E

COUNTY _____ ROAD NO. _____ PAGE ___ OF ____

SYSTEM				TRAFFIC		LINE DIAGRAM	TRAFFIC				PAVEMENT DATA
FUNCT. CLASS	HWY SYS	HPMS SAMPLE		PKG. REST.	CONTROL ACCESS		CONTROL	COMMND ACCESS	PKG. REST.		

SHA 51.3-8 **STATE HIGHWAY ADMINISTRATION OF MARYLAND**

11-15-72

73-30

ROAD INVENTORY SHEET

OP 419

Party Chief W. Dombroski
Recorder D. Taylor
Helper

Road No. ~~Co~~ 419
Road Name (Blue Water DR)
Sheet No. 1 of 1
Date 1-22-74
County Dorchester
State Coordinates 1033-285

Map No. G10

N/T 2-12-90 FR JE

CHAPTAIN RIVER

H ROAD 1.05 END

0.82
1.79
0.82
0.65
0.59
0.49
0.32
0.30 Proposed
0.16
0.00

(Castle Haven Rd)

W

SHA 51.3-8
11-15-72

STATE HIGHWAY ADMINISTRATION OF MARYLAND

ROAD INVENTORY SHEET

Party Chief _____
Recorder _____
Helper _____

Map No. G 10

Road No. OP 420
Road Name Springdale Rd.
Sheet No. 1
Date _____
County Dorchester
State Coordinates 1094-273

See Inventory
of
Co 228
85-19

SHA 51.3-8
11-15-72

ROAD INVENTORY SHEET

Road No. _____
Road Name _____
Sheet No. _____
Date _____
County _____
State Coordinates _____

SHA 51.3-8
11-15-72

STATE HIGHWAY ADMINISTRATION OF MARYLAND

ROAD INVENTORY SHEET

Party Chief _____
Recorder _____
Helper _____

Map No. G10

Road No. OP 421
Road Name Taylor Ave
Sheet No. _____
Date _____
County Dorchester
State Coordinates 1128-292

See Inventory

of

~~001~~ ~~316~~ MU 0290-HURLOCK

85-24

SHA 51.3-8
11-15-72

ROAD INVENTORY SHEET

Road No. _____
Road Name _____
Sheet No. _____
Date _____
County _____
State Coordinates _____

SHA 51.3 - 8 Revised
4.83

MARYLAND STATE HIGHWAY ADMINISTRATION

ROAD INVENTORY SHEET

89-12 (EY)

Party Chief C.G
Recorder BTB
Assistant
Map No./Dir. GH 10 / S
State Coordinates 1022 - 175

Road No. OP- 422
Road Name (NO NAME)
County DORCHESTER
Date 1/19/90
Sheet No. 1 OF 1

TRAFFIC CODES
TRAFFIC CONTROLS: STOP SIGN=SS, TRAFFIC LIGHT=T.L., FLASHING RED BALL=F.R.

TRAFFIC CODES
PARKING RESTRICTIONS: A.M. PEAK, P.M. PEAK, A.M./P.M. PEAK, NO PARKING ANYTIME=N.P., COMM/IND. ACCESS=E

SYSTEM				TRAFFIC		LINE DIAGRAM	TRAFFIC			PAVEMENT DATA
FED. AID.	FUNCT CLASS.	HWY. SYS.	HPMS SAMPLE	PRKG. REST.	COM/IND. ACCESS		CONTROL	COM/IND. ACCESS	PRKG. REST.	
						ROAD 0.08 END				
M	VOW FA RURAL LOCAL									14'F
K						HORSE Pt Rd.				
						Co 0.00 128				

SYSTEM				TRAFFIC		LINE DIAGRAM	TRAFFIC				PAVEMENT DATA
FED. AID.	FUNCT. CLASS.	HWY. SYS.	HPMS SAMPLE	PRKG. REST.	COM/IND ACCESS		CONTROL	COM/IND ACCESS	PRKG. REST.		

SHA 51.3 - 8 Revised
4.83

89-15
(SEE MU 1000)

MARYLAND STATE HIGHWAY ADMINISTRATION

ROAD INVENTORY SHEET

Party Chief C.G
Recorder B.B
Assistant
Map No./Dir. I-15 / NE
State Coordinates

Road No. OP 423
Road Name EARL ST
County DORCHESTER
Date 12/28/89
Sheet No. 1 OF 1

TRAFFIC CODES
TRAFFIC CONTROLS: STOP SIGN=SS, TRAFFIC LIGHT=T.L., FLASHING RED BALL=F.R.

TRAFFIC CODES
PARKING RESTRICTIONS: A.M. PEAK, P.M. PEAK, A.M./P.M. PEAK, NO PARKING ANYTIME=N.P., COMM/IND. ACCESS=E

SYSTEM				TRAFFIC		CAMBRIDGE LINE DIAGRAM	TRAFFIC			PAVEMENT DATA
FED. AID.	FUNCT. CLASS.	HWY. SYS.	HPMS SAMPLE	PRK.G. REST.	COM/IND. ACCESS		CONTROL	COM/IND. ACCESS	PRK.G. REST.	

SYSTEM				TRAFFIC		LINE DIAGRAM	TRAFFIC				PAVEMENT DATA
FED. AID.	FUNCT. CLASS.	HWY. SYS.	HPMS SAMPLE	PRKG. REST.	COM/IND ACCESS		CONTROL	COM/IND ACCESS	PRKG. REST.		

SHA 51.3 - 8 Revised
4.83

MARYLAND STATE HIGHWAY ADMINISTRATION

ROAD INVENTORY SHEET

Party Chief _____
Recorder _____
Assistant _____
Map No./Dir. GH 10 / E
State Coordinates 1065 - 263

Road No. OP 424
Road Name Fieldcrest Rd
County Dorchester
Date _____
Sheet No. _____ OF _____

SYSTEM				TRAFFIC		LINE DIAGRAM	TRAFFIC			PAVEMENT DATA
FED. AID.	FUNCT CLASS.	HWY. SYS.	HPMS SAMPLE	PRK.G. REST.	COM/IND. ACCESS		CONTROL	COM/IND. ACCESS	PRK.G. REST.	

UNASSIGNED

NOW

CO 525

92-13

TRAFFIC CODES

TRAFFIC CONTROLS: STOP SIGN=SS, TRAFFIC LIGHT=T.L., FLASHING RED BALL=F.R.

TRAFFIC CODES

PARKING RESTRICTIONS: A.M. PEAK, P.M. PEAK, A.M./P.M. PEAK, NO PARKING ANYTIME=N.P., COMM/IND. ACCESS=E

SYSTEM				TRAFFIC		LINE DIAGRAM	TRAFFIC			PAVEMENT DATA
FED. AID.	FUNCT. CLASS.	HWY. SYS.	HPMS SAMPLE	PRK.G. REST.	COM/IND ACCESS		CONTROL	COM/IND ACCESS	PRK.G. REST.	

SHA 51.3 - 8 Revised
4.83

MARYLAND STATE HIGHWAY ADMINISTRATION

ROAD INVENTORY SHEET

Party Chief _____
Recorder _____
Assistant _____
Map No./Dir. 1
State Coordinates _____

Road No. OP 425
Road Name _____
County Dorchester
Date _____
Sheet No. _____ OF _____

SYSTEM				TRAFFIC		LINE DIAGRAM	TRAFFIC			PAVEMENT DATA
FED. AID.	FUNCT CLASS.	HWY. SYS.	HPMS SAMPLE	PRKG. REST.	COM/IND. ACCESS		CONTROL	COM/IND. ACCESS	PRKG. REST.	

See Env. of MU 0140
(CAMBRIDGE)

TRAFFIC CODES

TRAFFIC CONTROLS: STOP SIGN=SS, TRAFFIC LIGHT=T.L., FLASHING RED BALL=F.R.

TRAFFIC CODES

PARKING RESTRICTIONS: A.M. PEAK, P.M. PEAK, A.M./P.M. PEAK, NO PARKING ANYTIME=N.P., COMM/IND. ACCESS=E

SYSTEM				TRAFFIC		LINE DIAGRAM	TRAFFIC			PAVEMENT DATA
FED. AID.	FUNCT. CLASS.	HWY. SYS.	HPMS SAMPLE	PRKG. REST.	COM/IND ACCESS		CONTROL	COM/IND ACCESS	PRKG. REST.	

Form 6 HPS (Rev. 1961)

282-1158

(92-14)
G. DAVIS / A. HATTEN
2/2/93
OP 426

ROAD INVENTORY SHEET

Party Chief F. SETTAN
Recorder T. LANDON
Chainman C. FORREST
T. LANDON
F. RHODES
10/7/74 VERIFIED

Road No. ~~280~~ ~~281~~
Name (OAK RD)
Sheet No. 1 OF 1
Date 5-23-65
County DARLINGTON

(LOWE Co	PINE RD.) 280
0.66	(1.80 (R))
(COKESBURY Co	ROAD) 279
0.10	(2.89 (L))

S ↑

↑ 18' ED
24' CW

Form 6 HPS (Rev. 1961)

151-1073

93-20 A/T
2-16-94
BB/TM

ROAD INVENTORY SHEET

OP 427

Party Chief F SETTAN
Recorder C FORKE
Chainman T.L.

Road No. 8158
Name (CROCHEROW WHARF RD)
Sheet No. 1 OF 1
Date 5-6-65
County ~~DORCHESTER~~

TEDIOUS CREEK

ROAD END
005

14'E F
20'CW

NE

(CROCHEROW 000 RD.)
Co 133

SHA 51.3 - 8 Revised
4.83

MARYLAND STATE HIGHWAY ADMINISTRATION

ROAD INVENTORY SHEET

Party Chief _____
Recorder _____
Assistant _____
Map No./Dir. I
State Coordinates _____

Road No. OP 428
Road Name _____
County Dorchester
Date _____
Sheet No. _____ OF _____

SYSTEM				TRAFFIC		LINE DIAGRAM	TRAFFIC			PAVEMENT DATA
FUNCT CLASS	HWY. SYS.	HPMS SAMPLE		PREG. REST.	COM/IND ACCESS		CONTROL	COM/IND ACCESS	PREG. REST.	
						SEE INV. OF CO 321 97-18 CO.				

TRAFFIC CODES

TRAFFIC CONTROLS: STOP SIGN-SS, TRAFFIC LIGHT=T.L., FLASHING RED BALI=F.R.

TRAFFIC CODES

PARKING RESTRICTIONS: A.M. PEAK, P.M. PEAK, A.M./P.M. PEAK, NO PARKING ANYTIME=N.P., COMM/IND. ACCESS=E

COUNTY _____ ROAD NO. _____ PAGE ___ OF ____

SYSTEM				TRAFFIC		LINE DIAGRAM	TRAFFIC				PAVEMENT DATA
FUNCT. CLASS	HWY SYS	HPMS SAMPLE		PREG. REST.	COM/IND ACCESS		CONFIG	COM/IND ACCESS	PREG. REST.		

SR & GV Rds

Form 6 HPS (Rev. 1961)

0001

ROAD INVENTORY SHEET

GV-1
~~2X-1~~

Party Chief F. SETTAN
Recorder T. LANDON
Chainman

1060-220
G 10

Road No. ~~COUNTY 1~~
Name (REFUGE RD)
Sheet No. 1 OF 2
Date 6-24-65
County DORCHESTER

BLACKWATER NATIONAL WILDLIFE REFUGE

SEA PLANE HANGER C	31	
		GATE
	30	30' ↑
	17	WPC 24' W X 14' L X 5' D
H	15	
H	12	12' E, 20' CW
	10	MAINTENANCE GARAGE X
		16' E 20' CW
KEY	WALLACE DR	
Co	00	111

Form 6 HPS (Rev. 1961)

0001

ROAD INVENTORY SHEET

~~2X-1~~ GV-1

Party Chief F. SETTON

Recorder T. LANDAN

Chainman

Road No. ~~GOOT.~~ #1

Name

Sheet No. 2 OF 2

Date 6-24-65

County DORCHESTER

BLACKWATER NATIONAL WILDLIFE REFUGE

	FIRE TOWER	
ROAD		END
	0+67	↑
	0+62	PT ↑
		50°
	0+59	PC)
PICNIC AREA	0+47	
PARKING AREA	0+44	
↑30°	0+38	

SAME

Form 6 HPS (Rev. 1961)

~~1X-2~~ SR-2 0002

LINKWOOD WILDLIFE MGT. AREA
MD. DEPT. GAME & INLAND

ROAD INVENTORY SHEET

Party Chief F. SETTAN
Recorder T. LANDON
Chainman

1104-257

G10

Road No. FISH
Name ~~G. S. #1~~
Sheet No. 1 OF 1
Date 6-17-65
County DORCHESTER

NOTE: NO CULTURE

ROAD		END
	055	
↑ 40°	015	36" CMP
	012	60° ↑
US	000	50

10'E
16'CW

SR 3

Farm Dr

Dorchester County

UNASSIGNED

Now

PRIVATE ROAD

Transfer of Title

Memorandum

2-5-99

SR 4

Farm Rd "A"

Dorchester County

UNASSIGNED

Now

PRIVATE ROAD

Transfer of Title

Memorandum

2-5-99

SR 5

Park Dr

Dorchester County

UNASSIGNED

Now

PRIVATE ROAD

Transfer of Title

Memorandum

2-5-99

SR 6

Linden Rd

Dorchester County

UNASSIGNED

Now

PRIVATE ROAD

Transfer of Title

Memorandum

2-5-99

SR 7

Point Dr

Dorchester County

UNASSIGNED

Now

PRIVATE ROAD

Transfer of Title

Memorandum

2-5-99

SR 8

E. Shore Dr

Dorchester County

UNASSIGNED

Now

PRIVATE ROAD

Transfer of Title

Memorandum

2-5-99

SR 9

Short Rd

Dorchester County

UNASSIGNED

Now

PRIVATE ROAD

Transfer of Title

Memorandum

2-5-99

SR 10

Oak Dr

Dorchester County

UNASSIGNED

Now

PRIVATE ROAD

Transfer of Title

Memorandum

2-5-99

Form 6 HPS (Rev. 1961)

SR 0011

PVT

~~6X-20~~

ROAD INVENTORY SHEET

Party Chief F. SETTAN
Recorder T. LANDON
Chainman C. FORREST

1076-267

G10

Road No. CO 203
Name MOOSE LODGE Rd
Sheet No. 1 OF 2
Date 5-18-65
County DORCHESTER

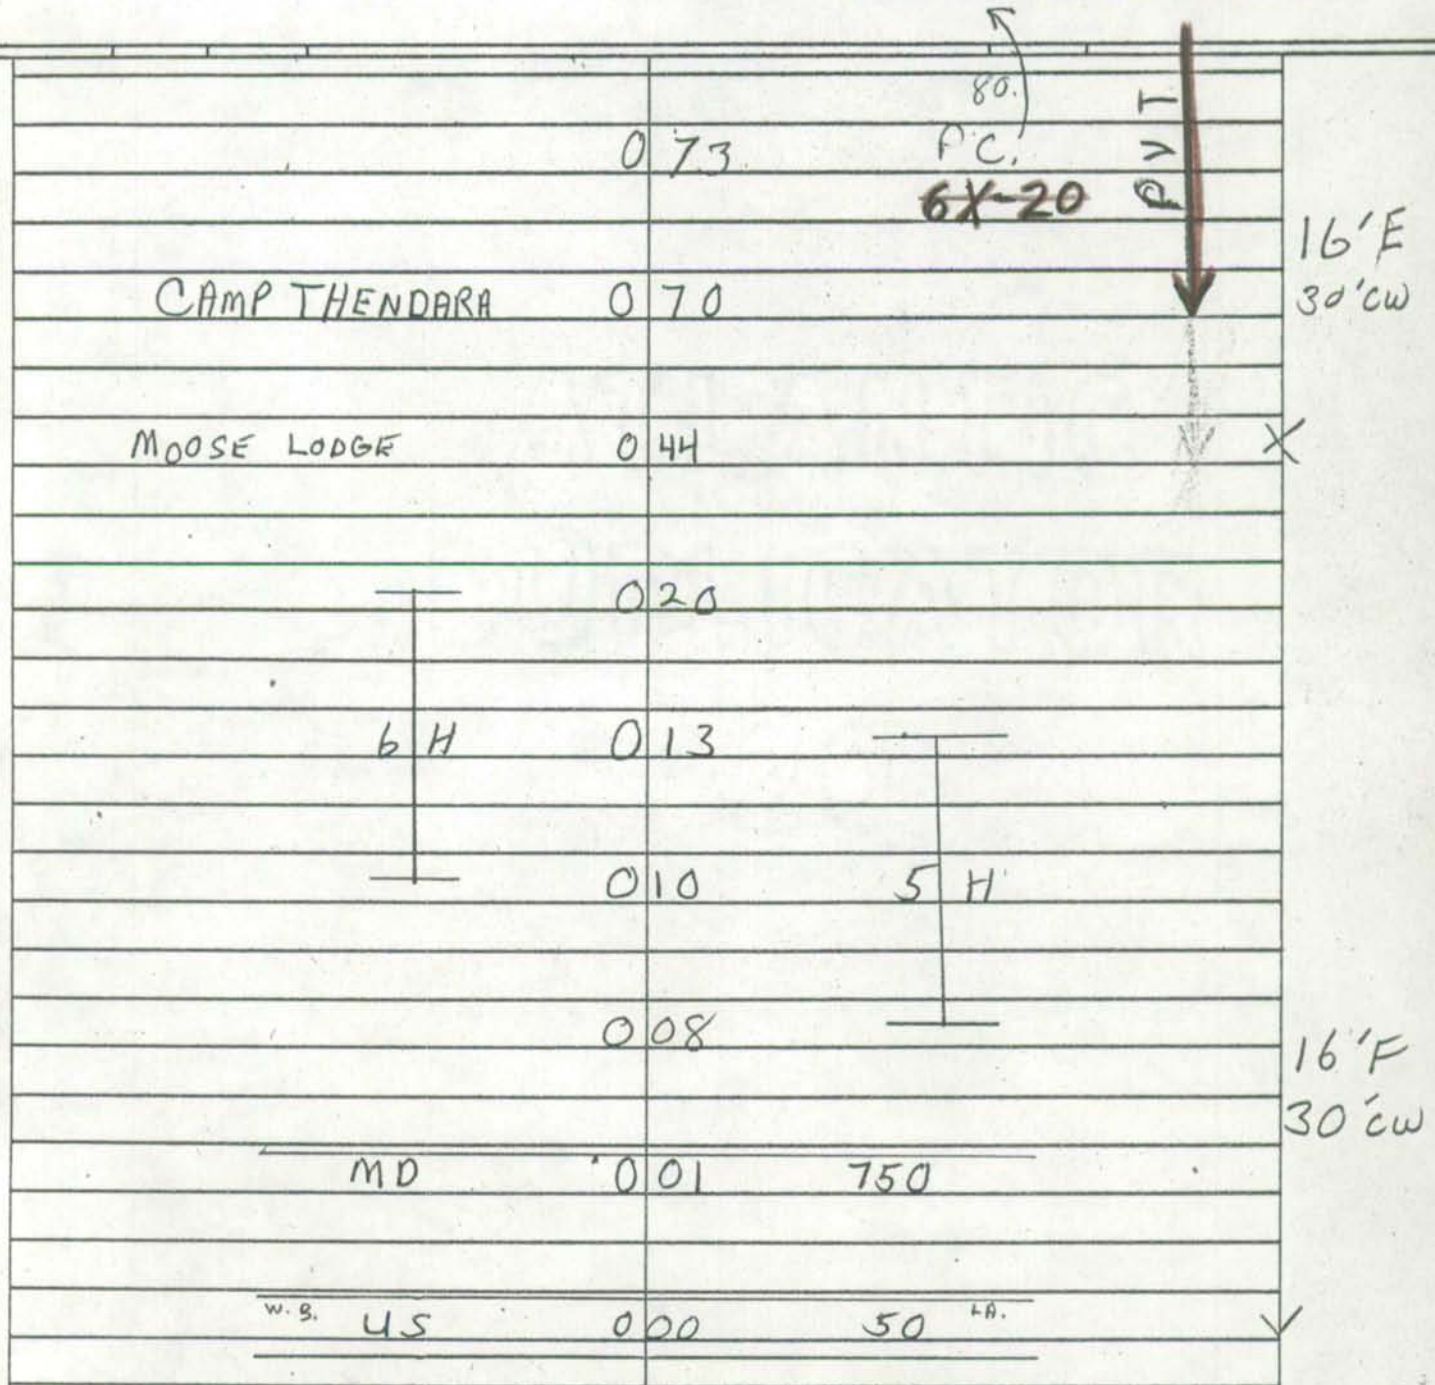

Form 6 HPS (Rev. 1961)

~~SR 0011~~
PVT
~~6X-20~~

ROAD INVENTORY SHEET

Party Chief F. SETTAN
Recorder J. LANDON
Chainman C. FORREST

Road No. C0203
Name
Sheet No. 2 OF 2
Date 5-18-65
County DORCHESTER

CHOPTANK RIVER

ROAD END
0 81

8X-20
PVT.

0 78 PT.
80'

SAME

Form 6 HPS (Rev. 1961)

PVT ~~0012~~
~~6X-22~~

ROAD INVENTORY SHEET

Party Chief F. SETTAN 1080-266
Recorder T. LANDON
Chainman C. FORREST

G10
HURTS · CR.

Road No. CO 211
Name ELKS LODGE RD.
Sheet No. 1 OF 2
Date 5-18-65
County DORCHESTER

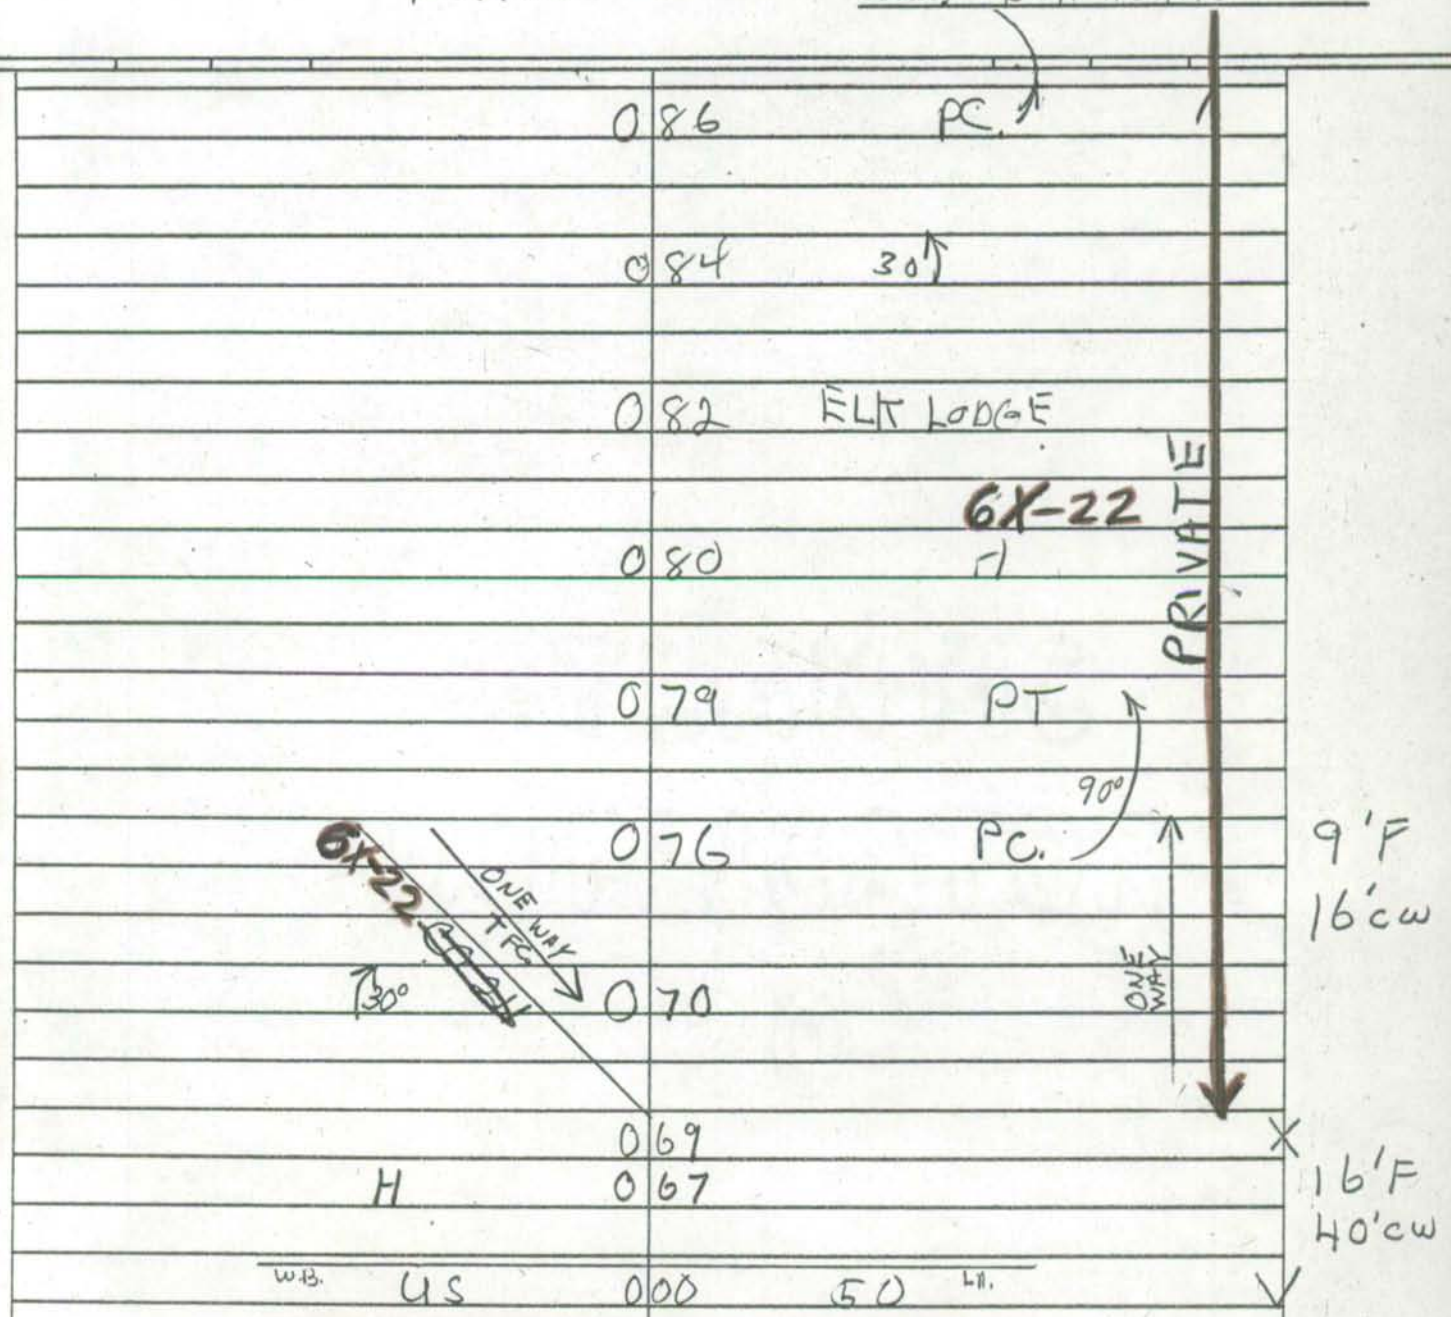

Form 6 HPS (Rev. 1961)

~~0012~~ PVT

~~6X-22~~

ROAD INVENTORY SHEET

Party Chief F. SETTAN
Recorder T. LANDON
Chainman C. FORREST

Road No. CO 211
Name ELKLODGE RD.
Sheet No. 2 OF 2
Date 5-18-65
County DORCHESTER

~~6X-22~~ 0.93 ~~0.44~~

6X-22 0.90 PT 60° ℄

SAME

Form 6 HPS (Rev. 1961)

~~GD13~~

PVT

~~6X-25~~

ROAD INVENTORY SHEET

Party Chief F.S.
Recorder C.F.
Chainman T.L.

1156-262
G10

Road No. Co 268
Name RATHELL Rd
Sheet No. 1 OF 2
Date 5-24-65
County DoR

	178	PC
	175	12" CMP
	170	PT 85°
	165	PC
PT 35° PC	161	6X-25 PVT
	155	
	152	2-24" CMP
PT 50° PC	137	
	131	20'E 26'CW
	123	
	106	SCOUT GARAGE (MAINT SHOP)
	100	H
	071	18" CMP
H	042	F
	008	F 16'E 24'CW
MD	000	313

Form 6 HPS (Rev. 1961)

0013

~~6X-25~~ PVT

ROAD INVENTORY SHEET

Party Chief K. S.
Recorder C. F.
Chainman T. L.

Road No. C0268
Name
Sheet No. 2 OF 2
Date 5-24-65
County DOR.

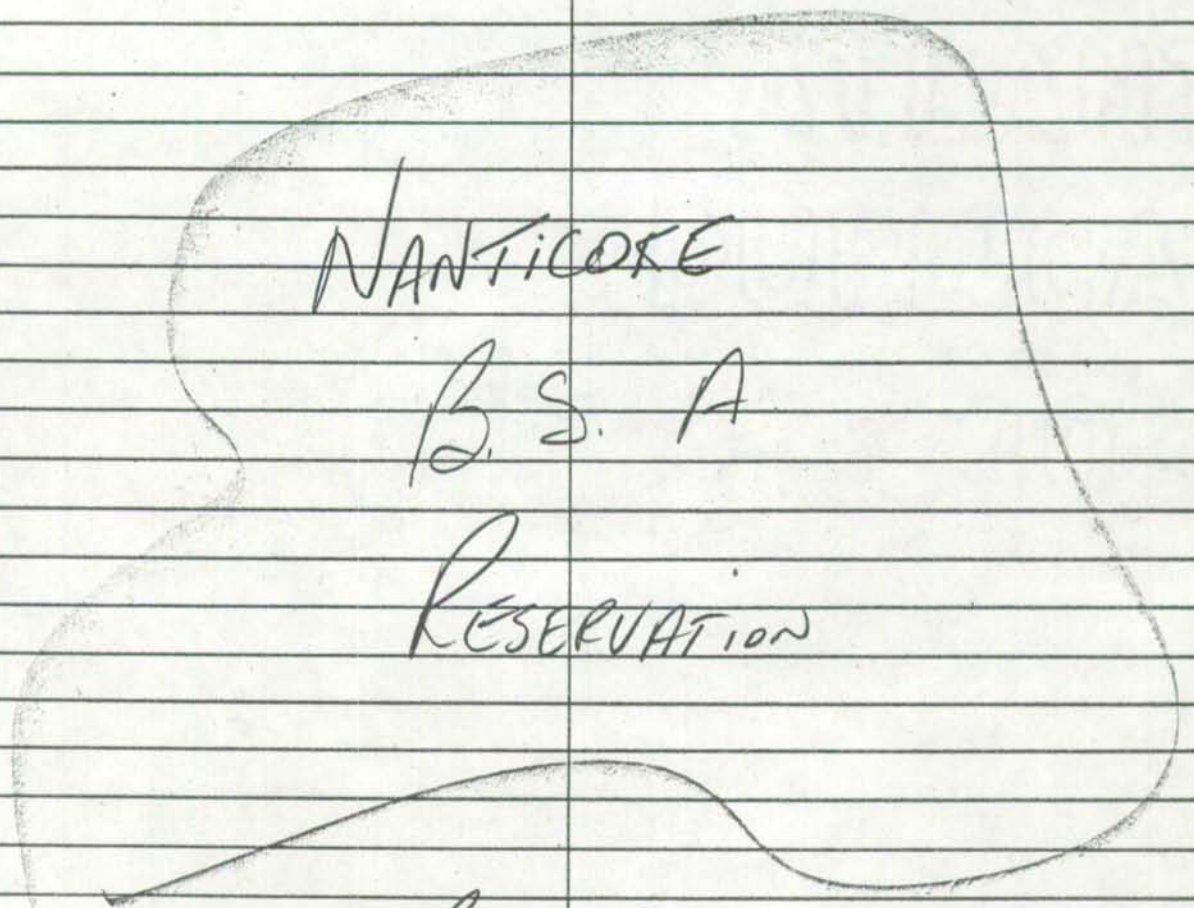

ROAD END

SWIMMING POOL 190 WATER TOWER

6X-25

181 PT

3"

EP RVT

Stone

SHA 51.3-8
11-15-72

STATE HIGHWAY ADMINISTRATION OF MARYLAND

ROAD INVENTORY SHEET

Party Chief T. LANDON
Recorder F. RHODES
Helper

Map No.

Road No. 2X-1
Road Name
Sheet No. 1 OF 1
Date 9/16/74
County DORCHESTER
State Coordinates 1060 - 224

BLACKWATER GAME REFUGE

		OBSERVATION TOWER	
		ROAD END	
	0	69	
	0	61	50°↑
↑PT 30° PC	0	56	
	0	48	
↑50° PICNIC AREA	0	45	
	0	39	25°↑
↑20°	0	35	
	0	30 WILDLIFE DRIVE	30°↑
H	0	15	
	0	11 MAINT. SHOP	
			16'G
H	0	05	2-3'ESHLD
			26'CW
KEY WALLACE CO.	0	00 11TH DR.	

S ↑

SHA 51.3-8
11-15-72

ROAD INVENTORY SHEET

Road No. _____
Road Name _____
Sheet No. _____
Date _____
County _____
State Coordinates _____

SHA 51.3-8
11-15-72

STATE HIGHWAY ADMINISTRATION OF MARYLAND

ROAD INVENTORY SHEET

Party Chief _____
Recorder _____
Helper _____

Map No. _____

Road No. _____
Road Name _____
Sheet No. _____
Date _____
County _____
State Coordinates _____

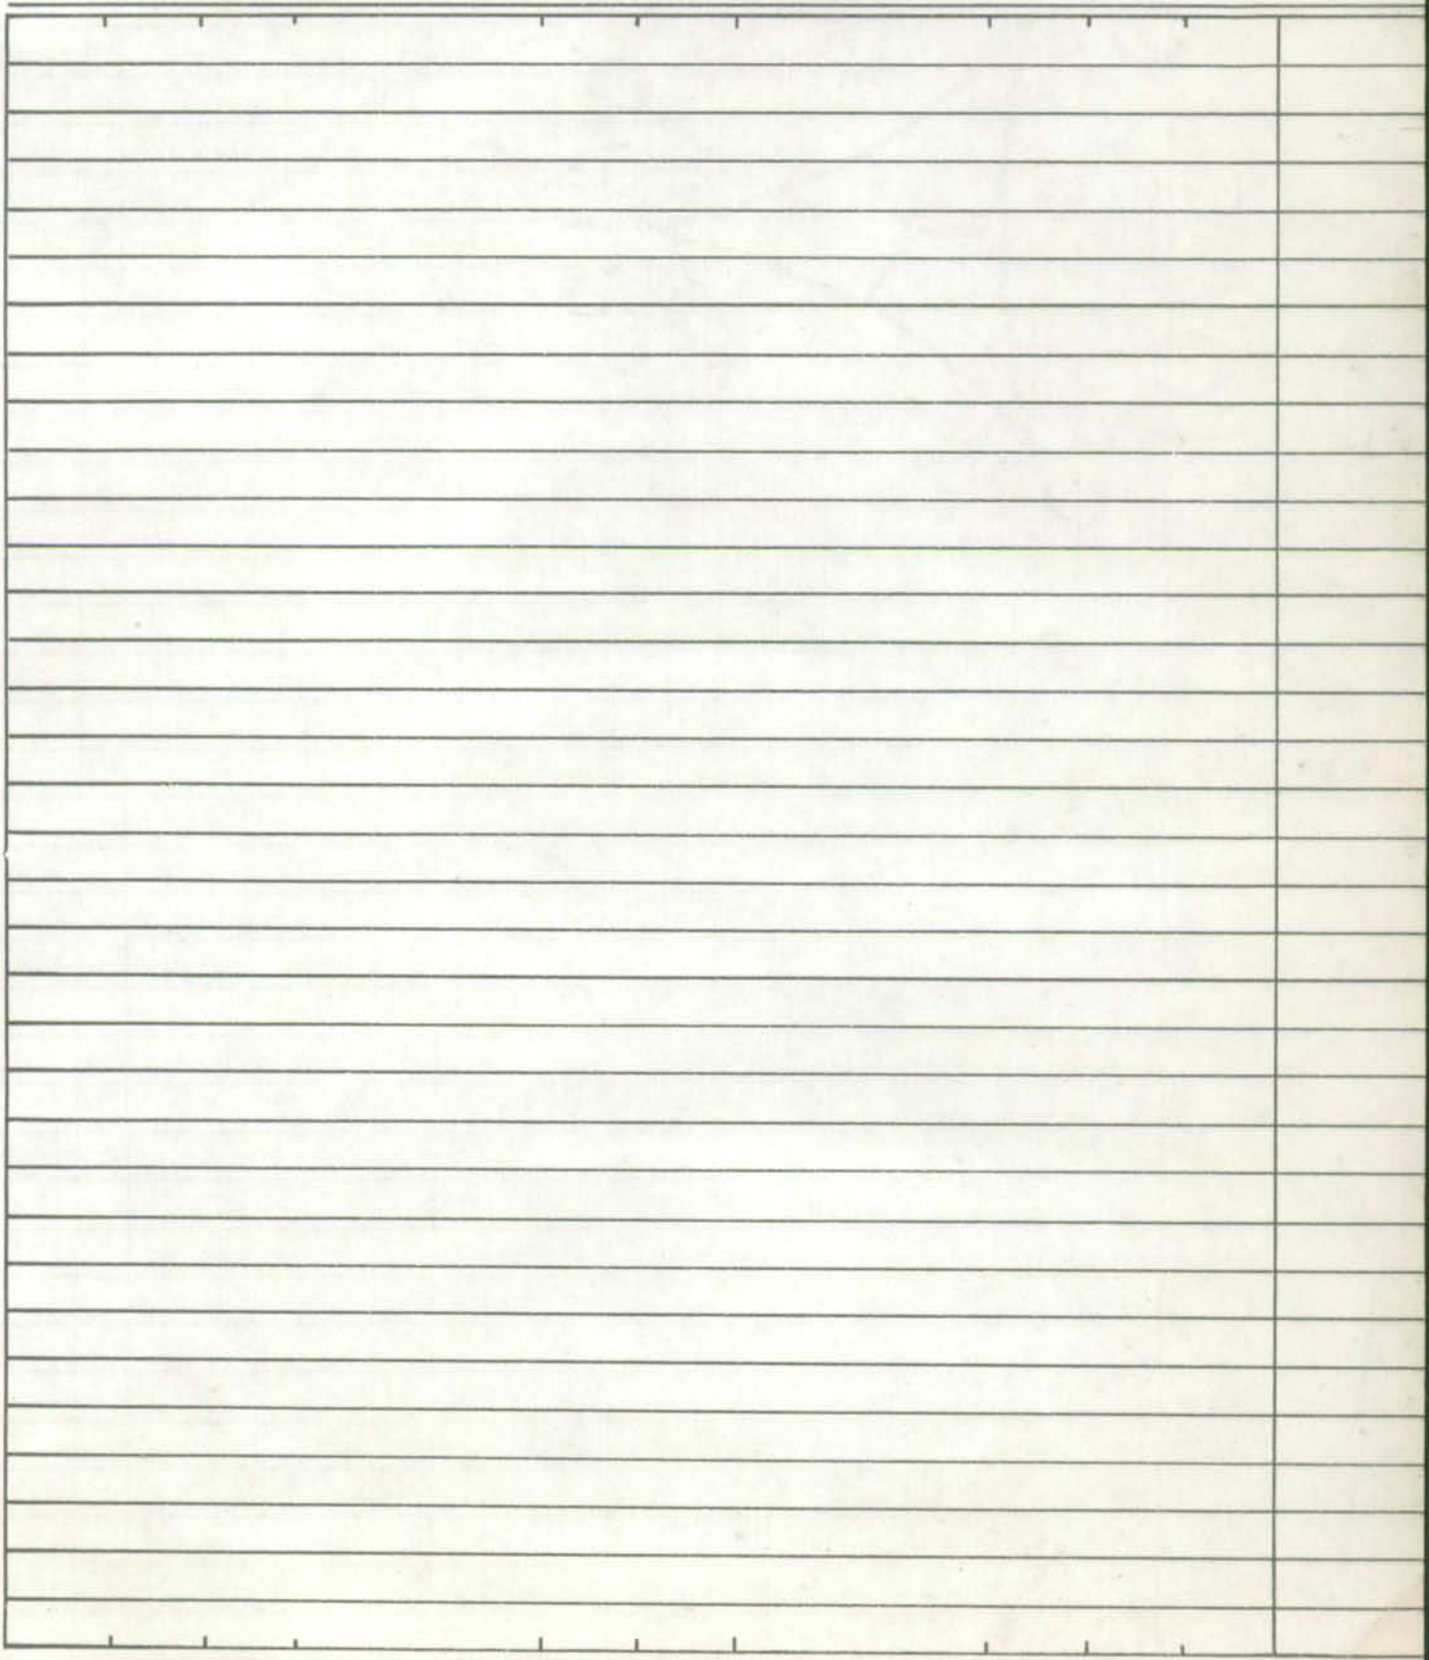

SHA 51.3-8
11-15-72

ROAD INVENTORY SHEET

Road No. _____
Road Name _____
Sheet No. _____
Date _____
County _____
State Coordinates _____