HOWARD COUNTY

COUNTY ROADS

3151 to END

SHA 51.3 - 8 Revised
4.83

Balto Urban

MARYLAND STATE HIGHWAY ADMINISTRATION

90-00 CO
SS/AQ
01-10-01

ROAD INVENTORY SHEET

Party Chief S. SNYDER
Recorder A QUATTROCHI
Assistant
Map No./Dir. E12A / N
State Coordinates 850-489

Road No. CO 3151
Road Name NATURES ROAD
County HOWARD
Date 01-10-01
Sheet No. 1 OF 1

TRAFFIC CODES

TRAFFIC CONTROLS: STOP SIGN-SS, TRAFFIC LIGHT=T.L., FLASHING RED BALL=F.R.

PARKING RESTRICTIONS: A.M. PEAK, P.M. PEAK, A.M./P.M. PEAK, NO PARKING ANYTIME=N.P., COMM/IND. ACCESS=E

SYSTEM				TRAFFIC		LINE DIAGRAM	TRAFFIC			PAVEMENT DATA
	FUNCT CLASS	HWY SYS	HPMS SAMPLE	PREG. REST.	COM/IND ACCESS		CONTROL	COM/IND ACCESS	PREG. REST.	
	Urban	local				(NATURES ROAD) CO 3151 0 21	SS			
						0 20				
						0 19 PT				
						260°				
						0 14 PC				
						(NATURES ROAD) 0 11 PT				
						CO 3151 0 10				
						70°				
						0 06 PC				
						0 05				
						CONSTANT COURSE RAILWAY DEW WAY Ext to T.L.				
						PT CO 3152 0 04				
						35°				
						PC 002				24' I
										Jc-c
										2 lane
						WALK 0.14				
						SOLAR CO 0 00 3884	SS			
						WALK				
						MORNING PROP				

COUNTY _____ ROAD NO. _____ PAGE ___ OF ____

SYSTEM				TRAFFIC		LINE DIAGRAM	TRAFFIC				PAVEMENT DATA
FUNCT CLASS	HWY SYS	NHS	SAMPLE	PROJ EST	COM/IND ACCESS		SCHOOL	COM/IND ACCESS	PROJ. EST.		

SHA 51.3 - 8 Revised
4.83

Balto Urban

MARYLAND STATE HIGHWAY ADMINISTRATION

91-0060
SS/AQ
1-10-01

ROAD INVENTORY SHEET

Party Chief S.SNYDER
Recorder A Quattrochi
Assistant
Map No./Dir. E12A / W
State Coordinates 850-489

Road No. CO 3152
Road Name CONSTANT COURSE
County HOWARD
Date 1-10-01
Sheet No. 1 OF 1

TRAFFIC CODES

TRAFFIC CONTROLS: STOP SIGN-SS,
TRAFFIC LIGHT=T.L.,
FLASHING RED BALI=F.R.

TRAFFIC CODES

PARKING RESTRICTIONS: A.M. PEAK,
P.M. PEAK, A.M./P.M. PEAK, NO PARKING
ANYTIME=N.P., COMM/IND. ACCESS=E

SYSTEM				TRAFFIC		LINE DIAGRAM	TRAFFIC			PAVEMENT DATA
	FUNCT CLASS	HWY. SYS	HPMS SAMPLE	PKG. REST.	COM/IND ACCESS		CONTROL	COM/IND ACCESS	PKG. REST.	
						(CONSTANT COURSE) CO 017 3152	SS			
						016 HEAD-IN P K G				
						014 PT 1200 PC HEAD-IN P K G				
						011 PC HEAD-IN PKG				
						010 PT				
						009				
						(CONSTANT COURSE) CO 3152 007 1200 PC				
						006				
	K	urban	local			(NATURES ROAD 3151) CO 000	SS			24' I JC-C 2UML
						BALMY DEW WAY ENT TO T.H.				

COUNTY _____ ROAD NO. _____ PAGE ___ OF ___

SYSTEM				TRAFFIC		LINE DIAGRAM	TRAFFIC				PAVEMENT DATA
FUNCT CLASS	HWY SYS	HPMS SAMPLE		PREG. REST	COM/IND ACCESS		L. OH BRG	COM/IND ACCESS	PREG. REST.		

85-0000
SS/19
1-9-01

SHA 51.3 - 8 Revised
4.83

Balto Urban

MARYLAND STATE HIGHWAY ADMINISTRATION

ROAD INVENTORY SHEET

Party Chief S. Snyder
Recorder A. QUATTROCHI
Assistant
Map No./Dir. D12C / E
State Coordinates 874-498

Road No. CO 3153
Road Name WARRENS WAY
County HOWARD
Date 1-9-01
Sheet No. 1 OF 1

TRAFFIC CODES
TRAFFIC CONTROLS: STOP SIGN-SS, TRAFFIC LIGHT=T.L., FLASHING RED BALL=F.R.

TRAFFIC CODES
PARKING RESTRICTIONS: A.M. PEAK, P.M. PEAK, A.M./P.M. PEAK, NO PARKING ANYTIME=N.P., COMM/IND. ACCESS=E

SYSTEM				TRAFFIC		LINE DIAGRAM	TRAFFIC			PAVEMENT DATA
	FUNCT CLASS	HWY SYS	HPMS SAMPLE	PREG. REST.	COMM/IND ACCESS		CONTROL	COMM/IND ACCESS	PREG. REST.	
	Urban	local				ROAD END 0 04				24' I JC-C 2UML
						HUNT ROAD @11				
						GOSHEN CO 0 00 2707 (84-0000)	SS			
						LOWES LANE 0 31 54 CO				

COUNTY _____ ROAD NO. _____ PAGE ___ OF ___

SYSTEM				TRAFFIC		LINE DIAGRAM	TRAFFIC				PAVEMENT DATA
	FUNCT CLASS	HWY SYS	HPMS SAMPLE	PRES. REST.	CONTROL ACCESS		CONTROL	CONTROL ACCESS	PRES. REST.		

SHA 51.3 - 8 Revised
4.83

Balto urban

86-00CO
SS/AP
1-9-01

MARYLAND STATE HIGHWAY ADMINISTRATION

ROAD INVENTORY SHEET

Party Chief S. Snyder
Recorder A. QUATTROCHI
Assistant
Map No./Dir. D12C / W
State Coordinates 874-498

Road No. CO 3154
Road Name LOWES LANE
County HOWARD
Date 1-9-01
Sheet No. 1 OF 1

TRAFFIC CODES
TRAFFIC CONTROLS: STOP SIGN-SS, TRAFFIC LIGHT=T.L., FLASHING RED BALI=F.R.

TRAFFIC CODES
PARKING RESTRICTIONS: A.M. PEAK, P.M. PEAK, A.M./P.M. PEAK, NO PARKING ANYTIME=N.P., COMM/IND. ACCESS=E

SYSTEM: FUNCT CLASS	SYSTEM: HWY. SYS.	SYSTEM: HPMS SAMPLE	TRAFFIC: PKG. REST.	TRAFFIC: COMM/IND ACCESS	LINE DIAGRAM	TRAFFIC: CONTROL	TRAFFIC: COMM/IND ACCESS	TRAFFIC: PKG. REST.	PAVEMENT DATA
					D E				
					CUL 0 07 SAC				
					0 04 PT 800				
					0 02 PC				24'I
					HUNT ROAD 2707 (84-002) @.11				JC-C
					GOSHEN				2UML
K urban local K					CO 0 00	SS			
					WARRENS WAY 31 53 CO				

COUNTY _____ ROAD NO. _____ PAGE ___ OF ___

SYSTEM				TRAFFIC		LINE DIAGRAM	TRAFFIC				PAVEMENT DATA
FUNCT CLASS	HWY SYS	HPMS SAMPLE		PREG. REST	COM/IND ACCESS		% GH/RV	COM/IND ACCESS	PREG. REST.		

SHA 51.3 - 8 Revised
4.83

Balto urban

MARYLAND STATE HIGHWAY ADMINISTRATION

97-00 CO
1-9-01
SS/AQ

ROAD INVENTORY SHEET

Party Chief S. Snyder
Recorder A. QUATTROCHI
Assistant
Map No./Dir. E11B / N
State Coordinates 830-482

Road No. CO 3155
Road Name MONTPELIER ROAD
County HOWARD
Date 1-9-01
Sheet No. 1 OF 1

TRAFFIC CODES
TRAFFIC CONTROLS: STOP SIGN=SS, TRAFFIC LIGHT=T.L., FLASHING RED BALL=F.R.

TRAFFIC CODES
PARKING RESTRICTIONS: A.M. PEAK, P.M. PEAK, A.M./P.M. PEAK, NO PARKING ANYTIME=N.P., COMM/IND. ACCESS=E

SYSTEM: FED. AID. | FUNCT. CLASS. | HWY. SYS. | HPMS SAMPLE
TRAFFIC: PRKG. REST. | COM/IND. ACCESS

LINE DIAGRAM

ROAD
0 36 END
0 27 PT
0 21 45°
0 19 PC
16'
0 16 PT
0 14
90°
0 12
PC
0 07
0 05
5'
3'
0 02
Johns Hopkins Rd
CO 0 00 109 @ 11 SS

TRAFFIC: CONTROL | COM/IND. ACCESS | PRKG. REST.
E
E
E

PAVEMENT DATA

2-16'I
12'I pat med clt
JC-C out
2ML
24'I LT
12'I RT
12'I Pat med clt
JC-C out
3ML
2-24'I
15'I PAT MED CLT
JC-C OUT
4ML
30'I RT
14'I LT
10'GRS MED
JC-C in/OUT
3ML

SYSTEM				TRAFFIC		LINE DIAGRAM	TRAFFIC				PAVEMENT DATA
FED. AID.	FUNCT. CLASS.	HWY. SYS.	HPMS SAMPLE	PRK.G. REST.	COM/IND ACCESS		CONTROL	COM/IND ACCESS	PRK.G. REST.		

Balto Urban

95-0000
SS/AP

SHA 51.3 - 8 Revised
4.83

MARYLAND STATE HIGHWAY ADMINISTRATION

ROAD INVENTORY SHEET

Party Chief S. Snyder
Recorder A. QUATTROCHI
Assistant
Map No./Dir. E11 B / W
State Coordinates 845 - 462

Road No. CO 3156
Road Name PATUXENT LANE
County HOWARD
Date 1-9-01
Sheet No. 1 OF 1

TRAFFIC CODES

TRAFFIC CONTROLS: STOP SIGN-SS, TRAFFIC LIGHT=T.L., FLASHING RED BALL=F.R.

TRAFFIC CODES

PARKING RESTRICTIONS: A.M. PEAK, P.M. PEAK, A.M./P.M. PEAK, NO PARKING ANYTIME=N.P., COMM/IND. ACCESS=E

SYSTEM				TRAFFIC		LINE DIAGRAM	TRAFFIC			PAVEMENT DATA
	FUNCT CLASS	HWY. SYS	HPMS SAMPLE	PREG. REST.	COMM/IND ACCESS		CONTROL	COMM/IND ACCESS	PREG. REST.	
						ROAD END				
						0.05				
						STREAM VIEW LANE				
						0.04 PVT RD				
	urban local									24' I
										JC-C
						SEWALL AVENUE @.25				2UML
						CO 0.00 1883 (93-0000)	SS			
						PVT DRIVE				

COUNTY _____ ROAD NO. _____ PAGE ___ OF ___

SYSTEM				TRAFFIC		LINE DIAGRAM	TRAFFIC				PAVEMENT DATA
FUNCT CLASS	HWY SYS	HPMS SAMPLE		PRES. REST.	COM/IND ACCESS		CHANNEL	COM/IND ACCESS	PRES. REST.		

94-0060
SS/AQ
1-9-01

SHA 51.3 - 8 Revised
4.83

Balto Urban

MARYLAND STATE HIGHWAY ADMINISTRATION

ROAD INVENTORY SHEET

Party Chief S. Snyder
Recorder A. QUATTROCHI
Assistant
Map No./Dir. E11B / E
State Coordinates 845-462

Road No. CO 3157
Road Name SPRATLEY AVENUE
County HOWARD
Date 1-9-01
Sheet No. 1 OF 1

TRAFFIC CODES
TRAFFIC CONTROLS: STOP SIGN-SS, TRAFFIC LIGHT=T.L., FLASHING RED BALL=F.R.

TRAFFIC CODES
PARKING RESTRICTIONS: A.M. PEAK, P.M. PEAK, A.M./P.M. PEAK, NO PARKING ANYTIME=N.P., COMM/IND. ACCESS=E

SYSTEM: FUNCT CLASS	SYSTEM: HWY. SYS.	SYSTEM: HPMS SAMPLE	TRAFFIC: PREG. REST.	TRAFFIC: COM/IND ACCESS	LINE DIAGRAM	TRAFFIC: CONTROL	TRAFFIC: COM/IND ACCESS	TRAFFIC: PREG. REST.	PAVEMENT DATA
					ROAD END				
					0 14				
local					SEWALL AVENUE @.35				
					CO 0 04 1883 (93-0060)	SS			
					STREAM VIEW LANE				24'I
					PVT 0 01 RD				JC-C
									2JML
					0 00				
					ROAD END				
urban									

COUNTY _____ ROAD NO. _____ PAGE ___ OF ___

SYSTEM				TRAFFIC		LINE DIAGRAM	TRAFFIC				PAVEMENT DATA
FUNCT CLASS	HWY SYS	HPMS SAMPLE		PREG. REST.	COM/IND ACCESS		CONNECT	COM/IND ACCESS	PREG. REST.		

SHA 51.3 - 8 Revised
4.83

MARYLAND STATE HIGHWAY ADMINISTRATION

* inventory of CO 158 split due to name change 8-30-01

ROAD INVENTORY SHEET

Party Chief: Office Inventory
Recorder: WS
Assistant:
Map No./Dir.: D12D / N
State Coordinates: 892-503

Road No.: CO 3158
Road Name: RIVER RD
County:
Date: 8-30-01
Sheet No.: 1 OF 1

SYSTEM: FED. AID. | FUNCT. CLASS. | HWY. SYS. | HPMS SAMPLE
TRAFFIC: PRKG. REST. | COM/IND. ACCESS

LINE DIAGRAM

XXXV GATE
0.44
ROCKBURN HILL RD
CO 432
0.43
H @ 00060 See Br Sh 1A
ROCKBURN BRANCH
0.42
BOWDOIN RD
OP 292
0.37
3243
0.35
IS 95
0.34
0.33
50' P-P
55' V.C.
LAWYERS HILL RD
CO 154
LEVERING RD
CO 158
PATAPSCO STATE PARK

TRAFFIC: CONTROL | COM/IND. ACCESS | PRKG. REST.

PAVEMENT DATA
20' I
2-2' Shds
2 UML

TRAFFIC CODES
TRAFFIC CONTROLS: STOP SIGN=SS, TRAFFIC LIGHT=T.L., FLASHING RED BALL=F.R.

TRAFFIC CODES
PARKING RESTRICTIONS: A.M. PEAK, P.M. PEAK, A.M./P.M. PEAK, NO PARKING ANYTIME=N.P., COMM/IND. ACCESS=E

URBAN LOCAL

SYSTEM				TRAFFIC		LINE DIAGRAM	TRAFFIC				PAVEMENT DATA
FED. AID.	FUNCT. CLASS.	HWY. SYS.	HPMS SAMPLE	PRK.G. REST.	COM/IND ACCESS		CONTROL	COM/IND ACCESS	PRK.G. REST.		

SHA 51.3 - 8 Revised
4.83

Inventory of CO 177 split due to name change 8-30-01

CO GPS 2001
6-22-01
SS/WP

MARYLAND STATE HIGHWAY ADMINISTRATION

ROAD INVENTORY SHEET

Party Chief: Office Inventory
Recorder: WS
Assistant:
Map No./Dir.: D12A / W
State Coordinates: 857-523

Road No.: CO 3159
Road Name: MERRYMAN ST
County: HOWARD
Date: 8-30-01
Sheet No.: 1 OF 1

TRAFFIC CONTROLS: STOP SIGN=SS, TRAFFIC LIGHT=T.L., FLASHING RED BALL=F.R.

PARKING RESTRICTIONS: A.M. PEAK, P.M. PEAK, A.M./P.M. PEAK, NO PARKING ANYTIME=N.P., COMM/IND. ACCESS=E

SYSTEM				TRAFFIC		LINE DIAGRAM	TRAFFIC			PAVEMENT DATA
FED. AID.	FUNCT CLASS.	HWY. SYS.	HPMS SAMPLE	PRKG. REST.	COM/IND. ACCESS		CONTROL	COM/IND. ACCESS	PRKG. REST.	
						HILL ST CO 177				
	URBAN LOCAL					PT 0 13 25° PC 0 12				12'G 14'CW
						0 10 WPC L 12' x W 24' x D 4'				
						0 07 CBC L 10' x W 14' x D 10' (steel Rails)				14' H JC-Lt 18' CW
						MAIN ST CO 0 00 1077				

SYSTEM				TRAFFIC		LINE DIAGRAM	TRAFFIC				PAVEMENT DATA
FED. AID.	FUNCT. CLASS.	HWY. SYS.	HPMS SAMPLE	PRK.G. REST.	COM/IND ACCESS		CONTROL	COM/IND ACCESS	PRK.G. REST.		

SHA 51.3 - 8 Revised
4.83

Inventory of CO181 split due to name change 8-30-01

MARYLAND STATE HIGHWAY ADMINISTRATION

ROAD INVENTORY SHEET

Party Chief: Office Inventory
Recorder: LWS
Assistant:
Map No./Dir.: D12A / N
State Coordinates: 857 - 523

Road No.: CO 3160
Road Name: FORREST ST
County: HOWARD
Date: 8-30-01
Sheet No.: 1 OF 1

TRAFFIC CODES

TRAFFIC CONTROLS: STOP SIGN=SS, TRAFFIC LIGHT=T.L., FLASHING RED BALL=F.R.

TRAFFIC CODES

PARKING RESTRICTIONS: A.M. PEAK, P.M. PEAK, A.M./P.M. PEAK, NO PARKING ANYTIME=N.P., COMM/IND. ACCESS=E

SYSTEM				TRAFFIC		LINE DIAGRAM	TRAFFIC			PAVEMENT DATA
FED. AID.	FUNCT CLASS.	HWY. SYS.	HPMS SAMPLE	PRKG. REST.	COM/IND. ACCESS		CONTROL	COM/IND. ACCESS	PRKG. REST.	
	KUEBAN LOCAL					MAIN ST CO 005 1077 PT 003 90° PC 000 ONE WAY HAMILTON ST CO 181				20' I JC-C 1 UML

SYSTEM				TRAFFIC		LINE DIAGRAM	TRAFFIC			PAVEMENT DATA
FED. AID.	FUNCT. CLASS.	HWY. SYS.	HPMS SAMPLE	PRKG. REST.	COM/IND ACCESS		CONTROL	COM/IND ACCESS	PRKG. REST.	

SHA 51.3 - 8 Revised
4.83

MARYLAND STATE HIGHWAY ADMINISTRATION

CO GPS 2001
6-6-01
SS/WP

ROAD INVENTORY SHEET

Party Chief: S SNYDER
Recorder: W PLEW
Assistant: WS 9-5-01
Map No./Dir.: D 12A / E
State Coordinates: 849-522

Road No.: CO 3161
Road Name: MEADOWVALE CT
County: HOWARD
Date: 6-6-01
Sheet No.: 1 OF 1

TRAFFIC CODES
TRAFFIC CONTROLS: STOP SIGN=SS, TRAFFIC LIGHT=T.L., FLASHING RED BALL=F.R.

TRAFFIC CODES
PARKING RESTRICTIONS: A.M. PEAK, P.M. PEAK, A.M./P.M. PEAK, NO PARKING ANYTIME=N.P., COMM/IND. ACCESS=E

SYSTEM				TRAFFIC		LINE DIAGRAM	TRAFFIC			PAVEMENT DATA
FED. AID.	FUNCT. CLASS.	HWY. SYS.	HPMS SAMPLE	PRKG. REST.	COM/IND. ACCESS		CONTROL	COM/IND. ACCESS	PRKG. REST.	
	URBAN LOCAL					D E CUL 0005 SAC DUNLOGGIN RD CO 0100 281 MEADOWVALE RD CO 326				24' I I C-C 2 UNL

SYSTEM				TRAFFIC		LINE DIAGRAM	TRAFFIC				PAVEMENT DATA
FED. AID.	FUNCT. CLASS.	HWY. SYS.	HPMS SAMPLE	PRK.G. REST.	COM/IND ACCESS		CONTROL	COM/IND ACCESS	PRK.G. REST.		

SHA 51.3 - 8 Revised
4.83

Was M.P. 0.09 - 0.18 of CO 350 until split by name chg

CO GPS 2001
6-8-01
SS/WP

MARYLAND STATE HIGHWAY ADMINISTRATION

ROAD INVENTORY SHEET

Party Chief: Office Inventory
Recorder: WS
Assistant:
Map No./Dir.: D 11 D / E
State Coordinates: 844-508

Road No.: CO 3162
Road Name: PEPPLE CT
County: HOWARD
Date: 9-6-01
Sheet No.: 1 OF 1

TRAFFIC CODES

TRAFFIC CONTROLS: STOP SIGN=SS, TRAFFIC LIGHT=T.L., FLASHING RED BALL=F.R.

TRAFFIC CODES

PARKING RESTRICTIONS: A.M. PEAK, P.M. PEAK, A.M./P.M. PEAK, NO PARKING ANYTIME=N.P., COMM/IND. ACCESS=E

SYSTEM				TRAFFIC		LINE DIAGRAM	TRAFFIC			PAVEMENT DATA
FED. AID.	FUNCT. CLASS.	HWY. SYS.	HPMS SAMPLE	PRKG. REST.	COM/IND. ACCESS		CONTROL	COM/IND. ACCESS	PRKG. REST.	
						D E				
						CUL 0.09 SAC				
										28' I
										C-C
										2 UNL
	URBAN LOCAL					WEST PENNFIELD RD / CO 1079 — MELLENBROOK RD / CO 352				
						PEPPLE DR / CO 350				

SYSTEM				TRAFFIC			LINE DIAGRAM	TRAFFIC				PAVEMENT DATA
FED. AID.	FUNCT. CLASS.	HWY. SYS.	HPMS SAMPLE	PRK.G. REST.	COM/IND ACCESS			CONTROL	COM/IND ACCESS	PRK.G. REST.		

SHA 51.3 - 8 Revised
4.83

MARYLAND STATE HIGHWAY ADMINISTRATION

ROAD INVENTORY SHEET

Party Chief: Office Inventory
Recorder: WS
Assistant:
Map No./Dir.: D11D / W
State Coordinates: 837-509

Road No.: CO 3163
Road Name: LAKE CIRCLE WEST
County: HOWARD
Date: 9-6-01
Sheet No.: 1 OF 2

TRAFFIC CODES

TRAFFIC CONTROLS: STOP SIGN=SS, TRAFFIC LIGHT=T.L., FLASHING RED BALL=F.R.

TRAFFIC CODES

PARKING RESTRICTIONS: A.M. PEAK, P.M. PEAK, A.M./P.M. PEAK, NO PARKING ANYTIME=N.P., COMM/IND. ACCESS=E

SYSTEM				TRAFFIC		LINE DIAGRAM	TRAFFIC			PAVEMENT DATA
FED. AID.	FUNCT CLASS.	HWY. SYS.	HPMS SAMPLE	PRKG. REST.	COM/IND. ACCESS		CONTROL	COM/IND. ACCESS	PRKG. REST.	
						0 33 15°				
						CASTLE MOOR DR				28' I
						CO 0 30 1088				I C-C
						0 27			X	
						0 24 PT 80°				
						0 18 PC				
						LAKE CIRCLE CT				
						0 17 CO 556				
	URBAN	LOCAL								
						0 13 PT 35°				
						0 07 PC				
						0 03 50°				24' H
										I C-C
						BEAVERBROOK RD				
						CO 0 00 1064				
						LAKE CIRCLE CO 354				

HOWARD CO 3163 2 of 2

SYSTEM				TRAFFIC		LINE DIAGRAM	TRAFFIC			PAVEMENT DATA
FED. AID.	FUNCT. CLASS.	HWY. SYS.	HPMS SAMPLE	PRK.G. REST.	COM/IND ACCESS		CONTROL	COM/IND ACCESS	PRK.G. REST.	
	URBAN LOCAL					W DURHAM RD CO 053 355				
						PT 049 60° PC 041				28' I I C-C

SHA 51.3 - 8 Revised
4.83

85-01
01-17-02
SS/WP

MARYLAND STATE HIGHWAY ADMINISTRATION

ROAD INVENTORY SHEET

Party Chief J. Snyder
Recorder W. PIEW
Assistant
Map No./Dir. D12C / N
State Coordinates 872-496

Road No. CO 3164
Road Name TROY HILL DR
County HOWARD
Date 01-17-02
Sheet No. 1 OF 4

49-99
96-195T

TRAFFIC CODES
TRAFFIC CONTROLS: STOP SIGN-SS, TRAFFIC LIGHT=T.L., FLASHING RED BALL-F.R.

TRAFFIC CODES
PARKING RESTRICTIONS: A.M. PEAK, P.M. PEAK, A.M./P.M. PEAK, NO PARKING ANYTIME-N.P., COMM/IND. ACCESS=E

SYSTEM				TRAFFIC		LINE DIAGRAM	TRAFFIC			PAVEMENT DATA
	FUNCT CLASS	HWY SYS	HPMS SAMPLE	PREG. REST.	COMM/IND ACCESS		CONTROL	COMM/IND ACCESS	PREG. REST.	
					E	0 26		E		
				E		0 23				48'I
				E		0 20		E		JC-C
										4mL
						0 18 PT				X
	Urban Local			E		0 14 35°				
						0 10 PC				
						0 08				68'I on TAPER TO 48'I
						10'± GTR				JC-C
										2umL
						0 06				X
										2-26'I
										M'GRS med
										JC-C
										2umL
K						US 0 00 1 @ 8.24	SS			Y

COUNTY Howard ROAD NO. CO 3164 PAGE 2 OF 4

LINE DIAGRAM

SYSTEM: FUNCT CLASS; HWY SYS; HPMS SAMPLE

TRAFFIC: PREG. RESTR.; COM/IND ACCESS

TRAFFIC: X-SECTION; COM/IND ACCESS; PREG. RESTR.

PAVEMENT DATA

Urban Local

0+66 — 180° — PC

0+59

E

0+55

0+51 — PT

35°

PC

E

0+43

E

PT

0+39

0+36

45°

PC

0+29

E

E

E

48'I

JC-C

4mL

SHA 51.3 - 8 Revised
4.83

MARYLAND STATE HIGHWAY ADMINISTRATION

ROAD INVENTORY SHEET

Party Chief S Snyder
Recorder W. Pleas
Assistant
Map No./Dir. /
State Coordinates

Road No. CO 3164
Road Name TROY HILL DR
County HOWARD
Date 01-17-02
Sheet No. 3 OF 4

TRAFFIC CODES
TRAFFIC CONTROLS: STOP SIGN-SS, TRAFFIC LIGHT=T.L., FLASHING RED BALL-F.R.

TRAFFIC CODES
PARKING RESTRICTIONS: A.M. PEAK, P.M. PEAK, A.M./P.M. PEAK, NO PARKING ANYTIME-N.P., COMM/IND. ACCESS=E

SYSTEM: FUNCT CLASS	SYSTEM: HWY SYS	SYSTEM: HPMS SAMPLE	TRAFFIC: PREG. REST.	TRAFFIC: COM/IND ACCESS	LINE DIAGRAM	TRAFFIC: CONTROL	TRAFFIC: COM/IND ACCESS	TRAFFIC: PREG. REST.	PAVEMENT DATA
					X-over 30°				
				E	110 PC		E		2-24'I
									4' GRS MED ON TAPER TO 15' GRS MED
									JC-C
									4ML
					107			X	
					097 PT				
Urban Local				E	094				
					084 180°		E		
					079		E		
				E	076				
					073		E		48'I
									JC-C
									4ML

COUNTY Howard ROAD NO. CO 3164 PAGE 4 OF 4

SYSTEM | TRAFFIC | LINE DIAGRAM | TRAFFIC | PAVEMENT DATA

FUNCT CLASS | HWY SYS | NHPN SAMPLE | PREG REST | CONTRL ACCESS | CONTRL | CONTRL ACCESS | PREG. REST.

Urban Local

US 1 46 1 @ 8.04

SS

12' RT

1 38

X-OVER

E

1 36

PT

1 35

1 33

10' LT

E

1 32

40°

1 28

10' LT

X-OVER

E

1 27

PC

1 21

1 19

PT

E

X-OVER

30°

1 15

E

2-24' I

4' GRS med on TAPER TO 15' GRS med

JC-C

4 MG

Rural

14-98COX2
1/7/99
SS/RB

29-01

SHA 51.3 - 8 Revised
4.83

MARYLAND STATE HIGHWAY ADMINISTRATION

ROAD INVENTORY SHEET

CO 3165

Party Chief: SNYDER
Recorder: BOOTH
Assistant:
Map No./Dir.: D11A / N
State Coordinates: 806-527

Road No.: ~~02~~ 1054
Road Name: GREAT VALLEY DRIVE
County: HOWARD
Date: 1/7/99
Sheet No.: 1 OF 1

TRAFFIC CODES

TRAFFIC CONTROLS: STOP SIGN-SS, TRAFFIC LIGHT=T.L., FLASHING RED BALI=F.R.

TRAFFIC CODES

PARKING RESTRICTIONS: A.M. PEAK, P.M. PEAK, A.M./P.M. PEAK, NO PARKING ANYTIME=N.P., COMM/IND. ACCESS=E

SYSTEM				TRAFFIC		LINE DIAGRAM	TRAFFIC			PAVEMENT DATA
	FUNCT CLASS	HWY. SYS.	HPMS SAMPLE	PREG. REST.	COM/IND ACCESS		CONTROL	COM/IND. ACCESS	PREG. REST.	
						D E				
						CUL O 11 SAC				
						FOX VALLEY DRIVE				20'I
						OP O 00 1037 @.95				2UML

COUNTY _____ ROAD NO. _____ PAGE ___ OF ____

SYSTEM				TRAFFIC		LINE DIAGRAM	TRAFFIC				PAVEMENT DATA
FUNCT. CLASS	HWY SYS	HPMS SAMPLE		PKG. REST.	COM/IND ACCESS		COM/IND	COM/IND ACCESS	PKG. REST.		

Rural

14-98CO X1
1/7/99
SS/RB

31-01

SHA 51.3 - 8 Revised
4.83

MARYLAND STATE HIGHWAY ADMINISTRATION

ROAD INVENTORY SHEET

CO 3166

Party Chief SNYDER
Recorder BOOTH
Assistant
Map No./Dir. D11 / N
State Coordinates 806-527

Road No. ~~RT~~ 7083
Road Name VELVET VALLEY DRIVE
County HOWARD
Date 1/7/99
Sheet No. 1 OF 1

TRAFFIC CODES

TRAFFIC CONTROLS: STOP SIGN-SS, TRAFFIC LIGHT=T.L., FLASHING RED BALL=F.R.

TRAFFIC CODES

PARKING RESTRICTIONS: A.M. PEAK, P.M. PEAK, A.M./P.M. PEAK, NO PARKING ANYTIME=N.P., COMM/IND. ACCESS=E

SYSTEM				TRAFFIC		LINE DIAGRAM	TRAFFIC			PAVEMENT DATA
	FUNCT CLASS	HWY. SYS.	HPMS SAMPLE	PREG. REST.	COM/IND. ACCESS		CONTROL	COM/IND. ACCESS	PREG. REST.	
						D E				
						CUL 0 20 SAC				
						PT 0 11				
						30°				
						PC 0 06				
										20'I
						FOX VALLEY DRIVE				2UML
						OP 0 00 1037 @.81				

COUNTY _____ ROAD NO. _____ PAGE ___ OF ____

SYSTEM				TRAFFIC		LINE DIAGRAM	TRAFFIC				PAVEMENT DATA
FUNCT. CLASS	HWY SYS	HPMS SAMPLE		PREG. REST.	COM/IND ACCESS		COM/IND ACCESS	PREG. REST.			

20-01

SHA 51.3 - 8 Revised
4.83

MARYLAND STATE HIGHWAY ADMINISTRATION

97-5-ST

ROAD INVENTORY SHEET

CO 3167

Party Chief AL
Recorder AP
Assistant —
Map No./Dir. D-11B / S
State Coordinates 840 - 533

Road No. ~~OR~~ 1040
Road Name (Rose Trail)
County HOWARD
Date 12-23-97
Sheet No. 1 OF 1

TRAFFIC CODES

TRAFFIC CONTROLS: STOP SIGN-SS, TRAFFIC LIGHT=T.L., FLASHING RED BALL=F.R.

TRAFFIC CODES

PARKING RESTRICTIONS: A.M. PEAK, P.M. PEAK, A.M./P.M. PEAK, NO PARKING ANYTIME=N.P., COMM/IND. ACCESS=E

SYSTEM				TRAFFIC		LINE DIAGRAM	TRAFFIC			PAVEMENT DATA
	FUNCT CLASS	HWY. SYS	HPMS SAMPLE	PREG. REST.	COM/IND ACCESS		CONTROL	COM/IND ACCESS	PREG. REST.	
						DE CUL 0 08 SAC				↑
						MD 0 00 99				28' I I C-C 2 UML ↓

COUNTY _____ ROAD NO. _____ PAGE ___ OF _____

SYSTEM				TRAFFIC		TRAFFIC				
FUNCT CLASS	HWY SYS	NHS	SAMPLE	PREG	REST	CRITICAL	COMMUNITY	ACCESS	PREG. REST.	PAVEMENT DATA

LINE DIAGRAM

Baltourban

14-99CO#1
SS/AB
2-23-00
79-01

SHA 51.3 - 8 Revised 4.83

MARYLAND STATE HIGHWAY ADMINISTRATION

ROAD INVENTORY SHEET

Party Chief S. Snyder
Recorder A. Barbour
Assistant
Map No./Dir. D-11D / N
State Coordinates 816-502

Road No. ~~OF 1040~~ CO 3168
Road Name LITTLE BELLS ROW
County HOWARD
Date 2-23-00
Sheet No. 1 OF 1

SYSTEM				TRAFFIC		LINE DIAGRAM	TRAFFIC			PAVEMENT DATA
	FUNCT CLASS	HWY. SYS	HPMS SAMPLE	PREG. REST.	COM/IND ACCESS		CONTROL	COM/IND ACCESS	PREG. REST.	
						DE				
						CUL 0 04 SAC				
										24'6
										JC-C
						LINTHICUM LANE .14				2UNL
						LINDEN CO 0 00 2507	SS			

TRAFFIC CODES

TRAFFIC CONTROLS: STOP SIGN-SS, TRAFFIC LIGHT=T.L., FLASHING RED BALL=F.R.

TRAFFIC CODES

PARKING RESTRICTIONS: A.M. PEAK, P.M. PEAK, A.M./P.M. PEAK, NO PARKING ANYTIME=N.P., COMM/IND. ACCESS=E

COUNTY _____ ROAD NO. _____ PAGE ___ OF ___

SYSTEM				TRAFFIC		LINE DIAGRAM	TRAFFIC				PAVEMENT DATA
	FUNCT CLASS	HWY SYS	NHS	PREG	COM/IND ACCESS		OTHER	COM/IND ACCESS	PREG. REST.		

Balto Urban 14-99C0#2
SS/AB
2-23-00
80-01

SHA 51.3 - 8 Revised 4.83

MARYLAND STATE HIGHWAY ADMINISTRATION

ROAD INVENTORY SHEET

CO 3169

Party Chief S. Snyder
Recorder A. Barbour
Assistant
Map No./Dir. D-11D / N
State Coordinates 816-502

Road No. ~~OP~~ 1891
Road Name WHISTLING WINDS WALK
County Howard
Date 2-23-00
Sheet No. 1 OF

TRAFFIC CODES
TRAFFIC CONTROLS: STOP SIGN-SS, TRAFFIC LIGHT=T.L., FLASHING RED BALL=F.R.

TRAFFIC CODES
PARKING RESTRICTIONS: A.M. PEAK, P.M. PEAK, A.M./P.M. PEAK, NO PARKING ANYTIME=N.P., CONN/IND. ACCESS=E

SYSTEM				TRAFFIC		LINE DIAGRAM	TRAFFIC			PAVEMENT DATA
	FUNCT CLASS	HWY. SYS	HPMS SAMPLE	PREG. REST.	COM/IND ACCESS		CONTROL	COM/IND ACCESS	PREG. REST.	
						D E				
						CUL 0 20 SAC				
						0 18 PT				
						40°				
						0 13 PC				
						PT 0 10				
						70°				
						PC 0 05				
						LINDEN CO ~~SR~~ LINTHICUM LANE 0 00 1089 2569 .14	SS			24'6 JC-C 2UNL
						WILD ORANGE CT ~~ST~~ CO 3170				

COUNTY _____ ROAD NO. _____ PAGE ___ OF ___

SYSTEM				TRAFFIC		LINE DIAGRAM	TRAFFIC				PAVEMENT DATA
FUNCT CLASS	HWY SYS.	NHS	SAMPLE	PRES BEST	% OWNRD ACCESS		% CHRGD	% OWNRD ACCESS	PRES. BEST.		

Balto Urban

14-9901#3
SS/AB
2-23-00
82-01

SHA 51.3 - 8 Revised 4.83

MARYLAND STATE HIGHWAY ADMINISTRATION

ROAD INVENTORY SHEET

CO 3170

Party Chief S Snyder
Recorder A. Barbour
Assistant
Map No./Dir. D11D / S
State Coordinates 816-502

Road No. ~~MR 99~~ ~~MD 99~~
Road Name WILD ORANGE GATE
County HOWARD
Date 2-23-00
Sheet No. 1 OF 1

SYSTEM: FUNCT CLASS | HWY. SYS | HPMS SAMPLE
TRAFFIC: PREG. REST. | COM/IND ACCESS

LINE DIAGRAM

TRAFFIC: CONTROL | COM/IND ACCESS | PREG. REST.

PAVEMENT DATA

TRAFFIC CODES

TRAFFIC CONTROLS: STOP SIGN-SS, TRAFFIC LIGHT=T.L., FLASHING RED BALL=F.R.

TRAFFIC CODES

PARKING RESTRICTIONS: A.M. PEAK, P.M. PEAK, A.M./P.M. PEAK, NO PARKING ANYTIME=N.P., COMM/IND. ACCESS=E

D E
CUL o 17 SAC
o 16
PT
30°
PC
o 10
HIDDEN WATERS WAY
~~MD 99~~ MR 99
o 08
~~MD~~ CO 3171
LINDEN ~~MD~~ CO
o 00
LITHICUM LANE
~~MD 99~~ MR 99
2567
SS
WHISTLING WINDS ~~MD~~ CO 3169
WALK ~~MD~~ CO 1091

24'6
JC-C
2 UNL

COUNTY _____ ROAD NO. _____ PAGE ___ OF ___

SYSTEM				TRAFFIC		LINE DIAGRAM	TRAFFIC				PAVEMENT DATA
	FUNCT CLASS	HWY SYS	HPMS SAMPLE	PRES EST	OW/HH ACCESS		% OTHER	% OW/HH	ACCESS	PRES. EST.	

Balto Urban 14-9900#4

81-01

SHA 51.3 - 8 Revised 4.83

MARYLAND STATE HIGHWAY ADMINISTRATION

ROAD INVENTORY SHEET CO 3171

Party Chief S. Snyder
Recorder A. Barbour
Assistant
Map No./Dir. 5 11D / E
State Coordinates 816-502

Road No. ~~OR 1093~~
Road Name HIDDEN WATERS WAY
County HOWARD
Date 2-23-00
Sheet No. 1 OF 1

TRAFFIC CODES
TRAFFIC CONTROLS: STOP SIGN-SS, TRAFFIC LIGHT=T.L., FLASHING RED BALL=F.R.

TRAFFIC CODES
PARKING RESTRICTIONS: A.M. PEAK, P.M. PEAK, A.M./P.M. PEAK, NO PARKING ANYTIME=N.P., COMM/IND. ACCESS=E

SYSTEM: FUNCT CLASS	SYSTEM: HWY. SYS	SYSTEM: HPMS SAMPLE	TRAFFIC: PREG. REST.	TRAFFIC: COM/IND ACCESS	LINE DIAGRAM	TRAFFIC: CONTROL	TRAFFIC: COM/IND ACCESS	TRAFFIC: PREG. REST.	PAVEMENT DATA
					Δ E				
					CUL O 08 SAC				
					O 04 70°				
									24'6
									JC-C
					WILD ORANGE GATE				2UML
					~~OR~~ CO O 00 3170 ~~1093~~	SS			

COUNTY _____ ROAD NO. _____ PAGE ___ OF ___

SYSTEM				TRAFFIC		LINE DIAGRAM	TRAFFIC				PAVEMENT DATA
FUNCT CLASS	HWY SYS	NHS	STRAHNET	PRES	COM/IND ACCESS		CONFIG	COM/IND ACCESS	PRES. REST.		

Balto Urban

17-00COEX1
SS/AQ
33-01

SHA 51.3 - 8 Revised
4.83

MARYLAND STATE HIGHWAY ADMINISTRATION

ROAD INVENTORY SHEET

CO 3172

Party Chief S. SNYDER
Recorder A. Quattrochi
Assistant
Map No./Dir. D12A / N
State Coordinates 852-528

Road No. ~~MD~~ ~~1002~~ CO 3172
Road Name HOLLOW COURT
County HOWARD
Date 1-12-01
Sheet No. 1 OF 2

TRAFFIC CODES
TRAFFIC CONTROLS: STOP SIGN-SS, TRAFFIC LIGHT=T.L., FLASHING RED BALL=F.R.

TRAFFIC CODES
PARKING RESTRICTIONS: A.M. PEAK, P.M. PEAK, A.M./P.M. PEAK, NO PARKING ANYTIME=N.P., COMM/IND. ACCESS=E

SYSTEM				TRAFFIC		LINE DIAGRAM	TRAFFIC			PAVEMENT DATA
	FUNCT CLASS	HWY SYS	HPMS SAMPLE	PREG. REST.	COM/IND ACCESS		CONTROL	COM/IND ACCESS	PREG. REST.	
	urban local					HOLLOW COURT 0010 ~~MD~~ ~~1002~~ CO 3172 0008 PT 0006 80° 0005 HEADING 12 X 6 0004 PC HEADING 4 X 6 0003 0001 HAMLET COURT CO 3138 0000 HIBISCUS COURT 31 39 CO				24'I JC-C 2UML

CO 3172

COUNTY HOWARD ROAD NO. ~~CR 1107~~ PAGE 2 OF 2

SYSTEM				TRAFFIC			LINE DIAGRAM	TRAFFIC				PAVEMENT DATA
	FUNCT CLASS	HWY SYS	HPMS SAMPLE	PREG. REST.	CONV/INC ACCESS			CONTRG	CONVNG ACCESS	PREG. REST.		
urban local							HOLLOW COURT OR CO 0 16 ~~1109~~ 3172	SS				
							0 15				HEAD-IN P X G	
							↱90° 0 14					
							↱90° 0 13					
							0 12				HEAD-IN P X G	24'I JC-C
							↱90° 0 11					2UML

SHA 51.3 - 8 Revised
4.83

MARYLAND STATE HIGHWAY ADMINISTRATION

95-10 ST
43-01

ROAD INVENTORY SHEET CO 3173

Party Chief DT
Recorder AL
Assistant
Map No./Dir. D-12 / SE
State Coordinates 857-530

Road No. ~~CO~~ 994
Road Name Governors Run
County Howard
Date 3-5-96
Sheet No. 1 OF 2

SYSTEM				TRAFFIC		LINE DIAGRAM	TRAFFIC			PAVEMENT DATA
FUNCT CLASS	HWY. SYS.	HPMS SAMPLE		PERC. REST.	COM/IND ACCESS		CONTROL	COM/IND ACCESS	PERC. REST.	
										30'I
										"J" c-c
						GOVERNOR RIDGELY LANE				2UML
						o 43 CO 3212 (42-01) 0.00			X	
						Edgewood Road				36'I
						OP 42 o 15				'J' c-c
										2UML
						o 11			X	
										62'I ON TAPER
										to 36'I
										'J' c-c
										2UML
						o 07			X	
										2-24'I
										16' GRS MED
										'J' c-c IN/OUT
										4UML
						US o 00 40			√	

TRAFFIC CODES

TRAFFIC CONTROLS: STOP SIGN-SS, TRAFFIC LIGHT=T.L., FLASHING RED BALI=F.R.

TRAFFIC CODES

PARKING RESTRICTIONS: A.M. PEAK, P.M. PEAK, A.M./P.M. PEAK, NO PARKING ANYTIME=N.P., COMM/IND. ACCESS=E

COUNTY Howard ROAD NO. CO 3173 95-10 ST PAGE 2 OF 2

SYSTEM				TRAFFIC			LINE DIAGRAM	TRAFFIC				PAVEMENT DATA
	FUNCT. CLASS	HWY SYS	HPMS SAMPLE	PKG. REST.	COM/IND ACCESS			SCHOOL	COM/IND ACCESS	PKG. REST.		

D E

CUL O 74 SAC

O 70 PT

45°

O 65 PC

30' I

J' c-c

2UNL

@0.10 GOVERNOR GRAYSON WAY

CO 3210 (40-0.20 60

BALTO URBAN

SHA 51.3 - 8 Revised
4.83

MARYLAND STATE HIGHWAY ADMINISTRATION

ROAD INVENTORY SHEET

CO 3174

21-95 ex #2
71-01

Party Chief DT
Recorder AL
Assistant BW
Map No./Dir. D-12C / S
State Coordinates 862-505

Road No. ~~OR~~ ~~SAT~~
Road Name Sunny Field Court
County Howard
Date 3-12-96
Sheet No. 1 OF 1

TRAFFIC CODES
TRAFFIC CONTROLS: STOP SIGN-SS, TRAFFIC LIGHT=T.L., FLASHING RED BALL=F.R.

TRAFFIC CODES
PARKING RESTRICTIONS: A.M. PEAK, P.M. PEAK, A.M./P.M. PEAK, NO PARKING ANYTIME=N.P., COMM/IND. ACCESS=E

SYSTEM				TRAFFIC		LINE DIAGRAM	TRAFFIC			PAVEMENT DATA
FUNCT CLASS	HWY. SYS.	HPMS SAMPLE		PKG. REST.	COM/IND ACCESS		CONTROL	COM/IND ACCESS	PKG. REST.	
						D E				
						CUL O 35 SAC				
						PT O 27 900 PC Pumping Station O 24 PC				
						O 23 3-60" CMP				
						BRIAR OAK COURT ~~OR~~ O 09 ~~988~~ CO 2750				
						Kerger Road O 00 CO 189				30' I J-CC 2UML
						Kerger Road CO 189				

COUNTY _____ ROAD NO. _____ PAGE __ OF ____

SYSTEM				TRAFFIC		LINE DIAGRAM	TRAFFIC				PAVEMENT DATA
FUNCT. CLASS	HWY SYS	HPMS SAMPLE		PREG. REST.	COM/IND ACCESS		CONTROL	COM/IND ACCESS	PREG. REST.		

SHA 51.3 - 8 Revised 4.83

1-01
1/15/02
ss/WP

MARYLAND STATE HIGHWAY ADMINISTRATION

ROAD INVENTORY SHEET

Party Chief S. Snyder
Recorder W. Pleid
Assistant
Map No./Dir. C11/D11B / W
State Coordinates 828-546

Road No. CO 3175
Road Name Barley Field Way
County Howard
Date 1/15/02
Sheet No. 1 OF 1

TRAFFIC CODES
TRAFFIC CONTROLS: STOP SIGN-SS, TRAFFIC LIGHT=T.L., FLASHING RED BALL-F.R.

TRAFFIC CODES
PARKING RESTRICTIONS: A.M. PEAK, P.M. PEAK, A.M./P.M. PEAK, NO PARKING ANYTIME-N.P., COMM/IND. ACCESS=I

SYSTEM				TRAFFIC		LINE DIAGRAM	TRAFFIC			PAVEMENT DATA
	FUNCT CLASS	HWY SYS	HPMS SAMPLE	PREG. REST.	COMM/IND ACCESS		CONTROL	COMM/IND ACCESS	PREG. REST.	
	K					D E CUL 0 84 SAC 0 81 PT 70° 0 73 PC 0 56 PT 180° 0 37 PC PT 0 32 90° PC 0 22 MARRIOTTSVILLE ROAD ©2.81 CO 0 00 70				22'I 24ML
	K						SS			

Rural Local

COUNTY _____ ROAD NO. _____ PAGE ___ OF ___

SYSTEM			TRAFFIC		LINE DIAGRAM	TRAFFIC			PAVEMENT DATA
FUNCT CLASS	HWY SYS	NHS/STRAHNET	PRES	CONTROL ACCESS		% CHRG	CONTROL ACCESS	PRES. REST.	

SHA 51.3 - 8 Revised
4.83

4-01
01/15/02
SS/WP

MARYLAND STATE HIGHWAY ADMINISTRATION

ROAD INVENTORY SHEET

Party Chief S Snyder
Recorder W Plew
Assistant
Map No./Dir. D11A / W
State Coordinates 780-528

Road No. CO 3176
Road Name FIELDS END COURT
County HOWARD
Date 01/15/02
Sheet No. 1 OF 1

TRAFFIC CODES
TRAFFIC CONTROLS: STOP SIGN-SS, TRAFFIC LIGHT-T.L., FLASHING RED BALL-F.R.

TRAFFIC CODES
PARKING RESTRICTIONS: A.M. PEAK, P.M. PEAK, A.M./P.M. PEAK, NO PARKING ANYTIME-N.P., COMM/IND. ACCESS=I

SYSTEM				TRAFFIC		LINE DIAGRAM	TRAFFIC			PAVEMENT DATA
	FUNCT CLASS	HWY SYS	HPMS SAMPLE	PREG. REST.	COM/IND ACCESS		CONTROL	COM/IND ACCESS	PREG. REST.	
						D 6				
						CUL 0 30 SOC				
						PT 0 28				
						45°				
						PC 0 21				
						@ 0.00 SPRING HOUSE COURT				
						CO 3177 (5-01) 0 20				
						PT 0 09				
						35°				
						PC 0 05				24'I
										2UML
						0 03				
										2-M'I
										10' GRASS TRANS TO 31 2ML
						@ 3.58 DAISY ROAD				
						CO 0 00 24 (3-01)	SS			

Rural Local

COUNTY _____ ROAD NO. _____ PAGE ___ OF ___

SYSTEM				TRAFFIC		LINE DIAGRAM	TRAFFIC			PAVEMENT DATA
FUNCT CLASS	HWY SYS	NPMS SAMPLE		PREG REST	COM/IND ACCESS		X-OVER/SIGN	COM/IND ACCESS	PREG. REST.	

SHA 51.3 - 8 Revised
4.83

5-01
01/15/01
SS/WP

MARYLAND STATE HIGHWAY ADMINISTRATION

ROAD INVENTORY SHEET

Party Chief S Snyder
Recorder W. Plews
Assistant
Map No./Dir. D11A / S
State Coordinates 779-528

Road No. CO 3177
Road Name SPRING HOUSE COURT
County HOWARD
Date 01/15/01
Sheet No. 1 OF 1

TRAFFIC CODES
TRAFFIC CONTROLS: STOP SIGN-SS, TRAFFIC LIGHT-T.L., FLASHING RED BALL-F.R.

TRAFFIC CODES
PARKING RESTRICTIONS: A.M. PEAK, P.M. PEAK, A.M./P.M. PEAK, NO PARKING ANYTIME-N.P., COMM/IND. ACCESS-I

SYSTEM				TRAFFIC		LINE DIAGRAM	TRAFFIC			PAVEMENT DATA
	FUNCT CLASS	HWY SYS	HPMS SAMPLE	PEAK REST.	COM/IND ACCESS		CONTROL	COM/IND ACCESS	PEAK REST.	
						D E				
						CUL 0 12 SAC				
						30° 0 06				22'I
	K									2UMC
	Rural Local									
	K					FIELDS END				
						CO 0 08 3176 COURT @.30 (4-01)	55			

COUNTY _____ ROAD NO. _____ PAGE ___ OF ___

SYSTEM				TRAFFIC		LINE DIAGRAM	TRAFFIC			PAVEMENT DATA
FUNCT CLASS	HWY SYS	NHS	STATE	PRES.	COM/IND ACCESS		PRES.	COM/IND ACCESS		

6-01
01/15/02
ss/wp

SHA 51.3 - 8 Revised
4.83

MARYLAND STATE HIGHWAY ADMINISTRATION

ROAD INVENTORY SHEET

Party Chief S. Snyder
Recorder W. Plew
Assistant
Map No./Dir. 21A / S
State Coordinates 787-537

Road No. CO 3178
Road Name Ridge Hunt DRIVE
County Howard
Date 01/15/02
Sheet No. 1 OF 2

TRAFFIC CODES
TRAFFIC CONTROLS: STOP SIGN-SS, TRAFFIC LIGHT-T.L., FLASHING RED BALL-F.R.

TRAFFIC CODES
PARKING RESTRICTIONS: A.M. PEAK, P.M. PEAK, A.M./P.M. PEAK, NO PARKING ANYTIME-N.P., COMM/IND. ACCESS-I

SYSTEM				TRAFFIC		LINE DIAGRAM	TRAFFIC			PAVEMENT DATA
	FUNCT CLASS	HWY SYS	HPMS SAMPLE	PREG. REST.	COMM/IND ACCESS		CONTROL	COMM/IND ACCESS	PREG. REST.	
						FARM VIEW COURT @0.00				
						028 CO 3179 (7-01)				
						PT 024				
						30°				
						PC 020				
						PT 016				
						45°				
						PC 009				
						007 PT				
						45°				
						002 PC				22'I
										24ML
						MILL RD @2.18				
						CARRS CO 000 26	SS			
		Rural Local								
	K									Y

COUNTY Howard ROAD NO. CO 3178 PAGE 2 OF 2

SYSTEM			TRAFFIC		LINE DIAGRAM	TRAFFIC			PAVEMENT DATA
FUNCT CLASS	HWY SYS NHS STATE		PROG REST	COMMUNITY ACCESS		GROWTH	COMMUNITY ACCESS	PROG. REST.	
Rural Local					D 6 CUL 0 48 SAC 0 43 PT 50° 0 31 PC				22' I 2 LANE

SHA 51.3 - 8 Revised
4.83

7-01
01/15/02
SS/WP

MARYLAND STATE HIGHWAY ADMINISTRATION

ROAD INVENTORY SHEET

Party Chief S. Snyder
Recorder W. Plew
Assistant
Map No./Dir. D11A / W
State Coordinates 787-536

Road No. CO 3179
Road Name Farm View CT
County Howard
Date 01/15/02
Sheet No. 1 OF 1

TRAFFIC CODES
TRAFFIC CONTROLS: STOP SIGN-SS, TRAFFIC LIGHT=T.L., FLASHING RED BALL-F.R.

TRAFFIC CODES
PARKING RESTRICTIONS: A.M. PEAK, P.M. PEAK, A.M./P.M. PEAK, NO PARKING ANYTIME-N.P., COMM/IND. ACCESS=I

SYSTEM				TRAFFIC		LINE DIAGRAM	TRAFFIC			PAVEMENT DATA
	FUNCT CLASS	HWY SYS	HPMS SAMPLE	PREG. REST.	COM/IND ACCESS		CONTROL	COM/IND ACCESS	PREG. REST.	
	Rural Local					D E CUL 0 14 SAC 0 10 PT 60° 0 06 PC RIDGE HUNT DRIVE CO 0 00 3178 (6-01) 0.05	SS			22'I 2UML

COUNTY _____ ROAD NO. _____ PAGE ___ OF ___

SYSTEM				TRAFFIC		LINE DIAGRAM	TRAFFIC			PAVEMENT DATA
FUNCT CLASS	HWY SYS	NHS	SAMPLE	PRES.	COMM/IND ACCESS		% OTHER	COMM/IND ACCESS	PRES.	

SHA 51.3 - 8 Revised
4.83

10-01
1/15/02
SS/WP

MARYLAND STATE HIGHWAY ADMINISTRATION

ROAD INVENTORY SHEET

Party Chief S Snyder
Recorder W Plew
Assistant
Map No./Dir. D11A / S
State Coordinates 800-539

Road No. CO 3180
Road Name WEEPING CHERRY DR
County HOWARD
Date 1/15/02
Sheet No. 1 OF 1

TRAFFIC CODES
TRAFFIC CONTROLS: STOP SIGN-SS, TRAFFIC LIGHT=T.L., FLASHING RED BALL=F.R.

TRAFFIC CODES
PARKING RESTRICTIONS: A.M. PEAK, P.M. PEAK, A.M./P.M. PEAK, NO PARKING ANYTIME=N.P., COMM/IND. ACCESS=I

SYSTEM				TRAFFIC		LINE DIAGRAM	TRAFFIC			PAVEMENT DATA
	FUNCT CLASS	HWY. SYS	HPMS SAMPLE	REG. REST.	COMM/IND ACCESS		CONTROL	COMM/IND ACCESS	REG. REST.	
						D E				
						CUL 0 26 SAC				
						90° 0 22				
						0 17 TRAFFIC CLAMING DEVICE				
						0 15 PT				
						0 14 36" CP 80°				
						0 13 PC				
	Rural Local					0 09 TEARFEM CLAMING DEVICE				
						30° 0 02				18'I 2UNL
						MCKENDREE RD @1.69				
						CO 0 00 38	SS			

COUNTY _____ ROAD NO. _____ PAGE ___ OF ___

SYSTEM				TRAFFIC		LINE DIAGRAM	TRAFFIC				PAVEMENT DATA
FUNCT CLASS	HWY SYS	NHS	STATE SAMPLE	PREG BEST	CONTRL ACCESS		CONTRL	CONTRL ACCESS	PREG. BEST.		

8-01
1/15/02
SS/WP

SHA 51.3 - 8 Revised
4.83

MARYLAND STATE HIGHWAY ADMINISTRATION

ROAD INVENTORY SHEET

Party Chief S. Snyder
Recorder W. Plews
Assistant
Map No./Dir. D11B / E
State Coordinates 817-539

Road No. CO 3181
Road Name WHITMAN WAY
County HOWARD
Date 1/15/02
Sheet No. 1 OF 1

TRAFFIC CODES
TRAFFIC CONTROLS: STOP SIGN-SS, TRAFFIC LIGHT=T.L., FLASHING RED BALL-F.R.

TRAFFIC CODES
PARKING RESTRICTIONS: A.M. PEAK, P.M. PEAK, A.M./P.M. PEAK, NO PARKING ANYTIME-N.P., COMM/RESID. ACCESS=E

SYSTEM				TRAFFIC		LINE DIAGRAM	TRAFFIC			PAVEMENT DATA
	FUNCT CLASS	HWY SYS	HPMS SAMPLE	PREG. REST.	COM/IND ACCESS		CONTROL	COM/IND ACCESS	PREG. REST.	
						D E				
						CUL 0 17 SAC				
	Rural Local									
						PT 0 08				
						45°				
						PC 0 03				22'I
										2UML
						ST. JAMES ROAD @.41				
						CO 0 00 1653	SS			

COUNTY _____ ROAD NO. _____ PAGE ___ OF _____

SYSTEM				TRAFFIC		LINE DIAGRAM	TRAFFIC				PAVEMENT DATA
FUNCT CLASS	HWY SYS	NHS	STATE	PRES	COM/IND ACCESS		CHRG	COM/IND ACCESS	PRES.		

Balto Urban 12-01 01-15-02

SHA 51.3 - 8 Revised 4.83

MARYLAND STATE HIGHWAY ADMINISTRATION

ROAD INVENTORY SHEET

Party Chief S. Snyder
Recorder W Plews
Assistant
Map No./Dir. D11B / E
State Coordinates 838-538

Road No. CO 3182
Road Name WARWICK WAY
County HOWARD
Date 01-15-02
Sheet No. 1 OF 2

TRAFFIC CODES
TRAFFIC CONTROLS: STOP SIGN-SS, TRAFFIC LIGHT-T.L., FLASHING RED BALL-F.R.

TRAFFIC CODES
PARKING RESTRICTIONS: A.M. PEAK, P.M. PEAK, A.M./P.M. PEAK, NO PARKING ANYTIME-N.P., COMM/IND. ACCESS=E

SYSTEM: FUNCT CLASS	SYSTEM: HWY SYS	SYSTEM: HPMS SAMPLE	TRAFFIC: PKG. REST.	TRAFFIC: COMM/IND ACCESS	LINE DIAGRAM	TRAFFIC: CONTROL	TRAFFIC: COMM/IND ACCESS	TRAFFIC: PKG. REST.	PAVEMENT DATA
					032		E		
			E		031				
					45°				
					018 PC				36'I
									TC-C
									2UML
Urban Local					PT 013			X	
					WAVERLY MANSION DR				
					PVT 011				
					40°				40'I
									TC-C
									2UML
					PC 005			X	
									2-16'I
									6'GRSMED
									TC-C
									2UML
					HARRIOTTSVILLE ROAD				
K					CO 000 70 (11-01) @1.49	TL SS		V	

COUNTY Howard ROAD NO. CO 3182 PAGE 2 OF 2

SYSTEM			TRAFFIC		LINE DIAGRAM	TRAFFIC			PAVEMENT DATA
FUNCT CLASS	HWY SYS	NHS	PRES BEST	COM/IND ACCESS		SCHOOL	COM/IND ACCESS	PRES. BEST.	
					BIRMINGHAM WAY				
					CO D 51 3183 (13-01)	ES			
			E		D 44		E		
									36'I
									JC-C
					PT D 37				2UNL
					45°				

Urban Local

SHA 51.3 - 8 Revised
4.83

13-01
1/15/02
SS/WP

MARYLAND STATE HIGHWAY ADMINISTRATION

ROAD INVENTORY SHEET

Party Chief S Snyder
Recorder W. Plew
Assistant
Map No./Dir. D11B / S
State Coordinates 831-537

Road No. CO 3183
Road Name Birmingham Way
County HOWARD
Date 1/15/02
Sheet No. 1 OF 1

TRAFFIC CODES

TRAFFIC CONTROLS: STOP SIGN-SS, TRAFFIC LIGHT-T.L., FLASHING RED BALL-F.R.

TRAFFIC CODES

PARKING RESTRICTIONS: A.M. PEAK, P.M. PEAK, A.M./P.M. PEAK, NO PARKING ANYTIME-N.P., COMM/HVD. ACCESS=E

SYSTEM				TRAFFIC		LINE DIAGRAM	TRAFFIC			PAVEMENT DATA
	FUNCT CLASS	HWY SYS	HPMS SAMPLE	PKG. REST.	COM/IND ACCESS		CONTROL	COM/IND ACCESS	PKG. REST.	
						PRIVATE RD				
						0 18				
						0 17 TO APTS		E		
						0 13 S.C.		E		
	Urban Local					0 05				
						WARWICK WAY @.51				44'I
						0 02 CO 3182 (12-01)				Jc-c
										20ML
						0 00				
						ROAD END				

COUNTY _____ ROAD NO. _____ PAGE ___ OF ___

SYSTEM				TRAFFIC		LINE DIAGRAM	TRAFFIC			PAVEMENT DATA
FUNCT CLASS	HWY SYS	NHS	SAMPLE	PREG REST	CONTRG ACCESS		CONTRG	CONTRG ACCESS	PREG. REST.	

SHA 51.3 - 8 Revised
4.83

15-01
01-15-02

MARYLAND STATE HIGHWAY ADMINISTRATION

ROAD INVENTORY SHEET

Party Chief S. Snyder
Recorder M. Plews
Assistant
Map No./Dir. D 11G / S
State Coordinates 829-528

Road No. CO 3184
Road Name GROTTO WALK
County Howard
Date 1/15/02
Sheet No. 1 OF 1

TRAFFIC CODES
TRAFFIC CONTROLS: STOP SIGN-SS, TRAFFIC LIGHT=T.L., FLASHING RED BALL-F.R.

TRAFFIC CODES
PARKING RESTRICTIONS: A.M. PEAK, P.M. PEAK, A.M./P.M. PEAK, NO PARKING ANYTIME-N.P., COMM/IND. ACCESS=I

SYSTEM: FUNCT CLASS.	SYSTEM: HWY. SYS	SYSTEM: HPMS SAMPLE	TRAFFIC: PREG. REST.	TRAFFIC: COMM/IND ACCESS
Urban Local				

LINE DIAGRAM

GROTTO WALK CO 3184 (15-01) @0.00

SAINT CHARLES PLACE @0.00
CO 3185 (18-01) 0 20

0 15 PT
180°
0 12 PC

SAINT CHARLES PLACE @0.07
CO 3185 (18-01)

0 05 PT
180°
0 02 PC

SAINT CHARLES PLACE @0.00
CO 3185 (18-01) 0 00

GROTTO WALK CO 3184 (15-01) @0.00

TRAFFIC: CONTROL	TRAFFIC: COMM/IND ACCESS	TRAFFIC: PREG. REST.	PAVEMENT DATA
			20' I
			Jc-c
			2UML

COUNTY _____ ROAD NO. _____ PAGE ___ OF ___

SYSTEM			TRAFFIC		LINE DIAGRAM	TRAFFIC			PAVEMENT DATA
FUNCT CLASS	HWY SYS	HPMS SAMPLE	PREG REST	DRIVING ACCESS		% OVERSIZE	COMMERCIAL ACCESS	PREG. REST.	

SHA 51.3 - 8 Revised
4.83

18-01
01-15-02
SS/WP

MARYLAND STATE HIGHWAY ADMINISTRATION

ROAD INVENTORY SHEET

Party Chief S. Snyder
Recorder W. Plew
Assistant
Map No./Dir. D11B / E
State Coordinates 830-528

Road No. CO 3185
Road Name SAINT CHARLES PLACE
County HOWARD
Date 1/15/02
Sheet No. 1 OF 2

TRAFFIC CODES
TRAFFIC CONTROLS: STOP SIGN-SS, TRAFFIC LIGHT=T.L., FLASHING RED BALL-F.R.

TRAFFIC CODES
PARKING RESTRICTIONS: A.M. PEAK, P.M. PEAK, A.M./P.M. PEAK, NO PARKING ANYTIME-N.P., COMM/IND. ACCESS=F

SYSTEM: FUNCT CLASS	SYSTEM: HWY SYS	SYSTEM: HPMS SAMPLE	TRAFFIC: PREG. REST.	TRAFFIC: COMM/IND ACCESS	LINE DIAGRAM	TRAFFIC: CONTROL	TRAFFIC: COMM/IND ACCESS	TRAFFIC: PREG. REST.	PAVEMENT DATA
					TERRA MARIA WAY @.17				
					CO 025 3188 (19-01)				
					0 19 PT				
					90°				
					JOSEPHINE WALK @.09				
					0 16 CO 3186 (16-01) PC				
					@.05 TERRA MARIA WAY				
					CO 3188 (19-01) 0 12				
					0 09				
					↑ 5% GRADE				
					0 05				
					GROTTO WAY @.01				24'I
					CO 0 02 3184 (15-01)	SS			Ic-c
									2UML
					GROTTO WAY @.00				
					CO 0 00 3184 (15-01)	SS			
	Urban local								

COUNTY Howard ROAD NO. Co 3185 PAGE 2 OF 2

SYSTEM				TRAFFIC		TRAFFIC			PAVEMENT DATA
FUNCT CLASS	HWY SYS	NHS	STRAHNET	PREG REST	COM/IND ACCESS	CHRG	COM/IND ACCESS	PREG. REST.	
Urban Local									

LINE DIAGRAM

Saint Charles Place @ .39

CO 3185 (18-01) 0.40 — 55

90° 0.38

Terra Maria Way @ .32

CO 3188 (19-01) 0.36

90° 0.34

90° 0.33

0.32

16' TAPER

0.30

Saint Charles Place @ .40

0.29 CO 3185 (18-01)

24' I
JC-C
2 UNL

16-01
1-15-02
SS/WP

SHA 51.3 - 8 Revised
4.83

MARYLAND STATE HIGHWAY ADMINISTRATION

ROAD INVENTORY SHEET

Party Chief S Snyder
Recorder W. Plew
Assistant
Map No./Dir. D11B / E
State Coordinates 831-528

Road No. CO 3186
Road Name JOSEPHINE WALK
County HOWARD
Date 01-15-02
Sheet No. 1 OF 1

TRAFFIC CODES
TRAFFIC CONTROLS: STOP SIGN-SS, TRAFFIC LIGHT=T.L., FLASHING RED BALL-F.R.

TRAFFIC CODES
PARKING RESTRICTIONS: A.M. PEAK, P.M. PEAK, A.M./P.M. PEAK, NO PARKING ANYTIME-N.P., COMM/IND. ACCESS=E

SYSTEM				TRAFFIC		LINE DIAGRAM	TRAFFIC			PAVEMENT DATA
	FUNCT CLASS	HWY SYS	HPMS SAMPLE	PKG. REST.	COMM/IND ACCESS		CONTROL	COMM/IND ACCESS	PKG. REST.	
						SAINT CHARLES PLACE @.10 L18-01				
						CO 009 3185				
						006 ENT. COMM CTR		E		
						45° 003				
	Urban Local									24' I
										Jc-c
										2UNL
						KATHERINE PLACE @.02				
						CO 000 3187	SS			
						PLACE 17-01				
						KATHERINE CO 3187 @.03				

COUNTY _____ ROAD NO. _____ PAGE ___ OF ___

SYSTEM			TRAFFIC		LINE DIAGRAM	TRAFFIC			PAVEMENT DATA
FUNCT CLASS	HWY SYS	NHS	PREG REST	COM/IND ACCESS		CHILDCA	COM/IND ACCESS	PREG. REST.	

SHA 51.3 - 8 Revised
4.83

17-01
01-15-02
SSNP

MARYLAND STATE HIGHWAY ADMINISTRATION

ROAD INVENTORY SHEET

Party Chief S Snyder
Recorder W Plew
Assistant
Map No./Dir. D110 / N
State Coordinates 831-528

Road No. CO 3187
Road Name KATHERINE PLACE
County HOWARD
Date 1/15/02
Sheet No. 1 OF 2

TRAFFIC CODES
TRAFFIC CONTROLS: STOP SIGN-SS, TRAFFIC LIGHT-T.L., FLASHING RED BALL-F.R.

TRAFFIC CODES
PARKING RESTRICTIONS: A.M. PEAK, P.M. PEAK, A.M./P.M. PEAK, NO PARKING ANYTIME-N.P., COMM/IND. ACCESS-I

SYSTEM				TRAFFIC		LINE DIAGRAM	TRAFFIC			PAVEMENT DATA
	FUNCT CLASS	HWY SYS	NHS SAMPLE	PREG. REST.	COMM/IND ACCESS		CONTROL	COMM/IND ACCESS	PREG. REST.	
						0 24				
						↑ 4% GRADE				
						0 21				
						60° 0 20				
						PT 0 14				
	Urban Local					180°				
						PC 0 11				
						60° 0 06				
						JOSEPHINE WALK @.00 — KATHERINE PLACE @.05				24'I
						CO 3186 (16-01) 0 02 CO 3187 (17-01)				JC-C
										2UML
						FREDERICK RD				
						MD 0 00 144-A @14.54	SS			

COUNTY Howard ROAD NO. CO 3187 PAGE 2 OF 2

SYSTEM			TRAFFIC		LINE DIAGRAM	TRAFFIC			PAVEMENT DATA
FUNCT CLASS	HWY SYS	HPMS SAMPLE	PROJ REST	OWN/IND ACCESS		SIGNING	OWN/IND ACCESS	PROJ. REST.	
Urban Local					Josephine Black (16-10) 3186 (8.10) CO KATHERINE PRACE CO 0 25 3187 (17-01) 2.07				24' I Jc-c 2-UNL

SHA 51.3 - 8 Revised 4.83

MARYLAND STATE HIGHWAY ADMINISTRATION

96-15 St
19-01
1/15/02
ss/wp

ROAD INVENTORY SHEET

CO 3188

Party Chief BB
Recorder MG
Assistant
Map No./Dir. D-11 / N
State Coordinates 830-527

Road No. ~~Op 1015~~
Road Name Terra Maria Way
County Howard
Date 2-14-97
Sheet No. 1 OF 2

TRAFFIC CODES
TRAFFIC CONTROLS: STOP SIGN-SS, TRAFFIC LIGHT=T.L., FLASHING RED BALI=F.R.

PARKING RESTRICTIONS: A.M. PEAK., P.M. PEAK, A.M./P.M. PEAK., NO PARKING ANYTIME=N.P., COMM/IND. ACCESS=E

SYSTEM: FUNCT CLASS	SYSTEM: HWY. SYS	SYSTEM: HPMS SAMPLE	TRAFFIC: PREG. REST.	TRAFFIC: COM/IND ACCESS	LINE DIAGRAM	TRAFFIC: CONTROL	TRAFFIC: COM/IND ACCESS	TRAFFIC: PREG. REST.	PAVEMENT DATA
					0 22 PC				
					0 20 DRIVE ~~Proposed~~ WAY		E		
					SAINT CHARLES PLACE @.25				
					CO ~~proposed~~ 0 17 3185 ~~proposed~~ (18-01)	SS			
				E	DRIVEWAY 0 15 ~~Proposed~~ DRIVEWAY		E		
					℄ 90° 0 12				24'I
									JC-C
					0 10 ~~proposed~~				20ML
									32'I
									JC-C
					Saint Charles Place				20ML
					CO ~~proposed~~ 0 05 3185 ~~proposed~~ (18-01) @.12				
									24'I
									JC-C
									20ML
					Frederick Rd				
					MD 0 00 144A	SS			
					@ 14.42				

K URBAN LOCAL

CO 3188

COUNTY Howard ROAD NO. ~~00~~ PAGE 2 OF 2

SYSTEM				TRAFFIC		LINE DIAGRAM	TRAFFIC				PAVEMENT DATA
	FUNCT CLASS	HWY SYS	NHS	PREG REST	COM/IND ACCESS		% CH TRUCKS	% COM/IND ACCESS	PREG. REST.		
						Saint Charles Place @ 36					
						CO ~~proposed~~ 0+36 3185 ~~proposed~~ (180')					
						0+33 PT					
						90°					
						0+29 PC					
						0+27 PT					24'I
						90°					JC-C
											2UML
	Urban Local										

SHA 51.3 - 8 Revised
4.83

MARYLAND STATE HIGHWAY ADMINISTRATION

ROAD INVENTORY SHEET

30-95 ck #1
2-01
11/15/02
SS/WP

Party Chief DT
Recorder AL
Assistant
Map No./Dir. D-11 / E
State Coordinates 837-527

Road No. ~~OP 986~~ C03189
Road Name Martin Meadows Court
County Howard
Date 3-5-96
Sheet No. 1 OF 1

TRAFFIC CODES
TRAFFIC CONTROLS: STOP SIGN-SS, TRAFFIC LIGHT=T.L., FLASHING RED BALI=F.R.

TRAFFIC CODES
PARKING RESTRICTIONS: A.M. PEAK, P.M. PEAK, A.M./P.M. PEAK, NO PARKING ANYTIME=N.P., COMM/IND. ACCESS=E

SYSTEM				TRAFFIC		LINE DIAGRAM	TRAFFIC			PAVEMENT DATA
	FUNCT CLASS	HWY. SYS.	HPMS SAMPLE	PEKG. REST.	COM/IND. ACCESS		CONTROL	COM/IND. ACCESS	PEKG. REST.	
		K Urban Local				D E CUL O 05 SAC Boones Co O 00 Ln. 224 Dr Raton 211 Ct 9 Bl	SS			24' I "J" c-c 2UML

COUNTY _____ ROAD NO. _____ PAGE ___ OF ____

SYSTEM				TRAFFIC		LINE DIAGRAM	TRAFFIC				PAVEMENT DATA
	FUNCT. CLASS	HWY SYS	HPMS SAMPLE	PRES. REST.	COM/IND ACCESS		CONFIG	COM/IND ACCESS	PRES. REST.		

27-01, 26-01
1/16/02
SS/WP

SHA 51.3 - 8 Revised
4.83

MARYLAND STATE HIGHWAY ADMINISTRATION

ROAD INVENTORY SHEET

Party Chief S. Snyder
Recorder W. Plews
Assistant
Map No./Dir. D11D / W
State Coordinates 841-534

Road No. CO 3190
Road Name Hidden Haven Court
County Howard
Date 1/16/02
Sheet No. 1 OF 1

TRAFFIC CODES
TRAFFIC CONTROLS: STOP SIGN-SS, TRAFFIC LIGHT-T.L., FLASHING RED BALL-F.R.

TRAFFIC CODES
PARKING RESTRICTIONS: A.M. PEAK, P.M. PEAK, A.M./P.M. PEAK, NO PARKING ANYTIME-N.P., COMM/IND. ACCESS-E

SYSTEM				TRAFFIC		LINE DIAGRAM	TRAFFIC			PAVEMENT DATA
	FUNCT CLASS	HWY SYS	HPMS SAMPLE	PKG. REST.	COMM/IND ACCESS		CONTROL	COMM/IND ACCESS	PKG. REST.	
	Urban Local					D E CUL 013 SAC PT 004 45° PC 001 OLD MILL ROAD @.37 CO 000 2377 (2601)				18' I I C-C 2 UML

COUNTY _____ ROAD NO. _____ PAGE ___ OF _____

SYSTEM			TRAFFIC		LINE DIAGRAM	TRAFFIC			PAVEMENT DATA
FUNCT CLASS	HWY SYS	HPMS SAMPLE	PREG REST	COM/IND ACCESS		X-CHNG	COM/IND ACCESS	PREG. REST.	

SHA 51.3 - 8 Revised
4.83

25-01
1/16/02
SS/WP

MARYLAND STATE HIGHWAY ADMINISTRATION

ROAD INVENTORY SHEET

Party Chief S. Snyder
Recorder W. Plews
Assistant
Map No./Dir. D11B / E
State Coordinates 844 - 537

Road No. CO 3191 / OP 1137
Road Name GREENHAVEN COURT
County HOWARD
Date 1/16/02
Sheet No. 1 OF 2

TRAFFIC CODES

TRAFFIC CONTROLS: STOP SIGN-SS, TRAFFIC LIGHT=T.L., FLASHING RED BALL-F.R.

TRAFFIC CODES

PARKING RESTRICTIONS: A.M. PEAK, P.M. PEAK, A.M./P.M. PEAK, NO PARKING ANYTIME-N.P., COMM/IND. ACCESS=F

SYSTEM				TRAFFIC		LINE DIAGRAM	TRAFFIC			PAVEMENT DATA
	FUNCT CLASS	HWY SYS	HPMS SAMPLE	PREG. REST.	COMM/IND ACCESS		CONTROL	COMM/IND ACCESS	PREG. REST.	
	Urban Local					0+27 PT 45° 0+22 PC 11 37 R 0+18 0 PT 0+15 90° 0+10 PC 0+06 PT 30° 0+02 PC ROAD @ 77 0+00 1724 TADENTOOK CO				30'I IC-C 2 UNL

COUNTY HOWARD ROAD NO. Co 3191/0P1137 PAGE 2 OF 2

SYSTEM			TRAFFIC		LINE DIAGRAM	TRAFFIC			PAVEMENT DATA
FUNCT CLASS	HWY SYS	HPMS SAMPLE	PRES RESI	COM/IND ACCESS		CRITICAL	COM/IND ACCESS	PRES. RESI.	
Urban Local					D E CUL D HI SAC 37 11 P O				30'I I c-c 2UNL

72-01
3/11/02
SS/WP

SHA 51.3 - 8 Revised
4.83

MARYLAND STATE HIGHWAY ADMINISTRATION

ROAD INVENTORY SHEET

Party Chief S.Snyder
Recorder W. Plew
Assistant
Map No./Dir. D11D / N
State Coordinates 817-408

Road No. CO 3192
Road Name Langford CT
County HOWARD
Date 01/11/02
Sheet No. 1 OF 1

TRAFFIC CODES

TRAFFIC CONTROLS: STOP SIGN-SS, TRAFFIC LIGHT-T.L., FLASHING RED BALL-F.R.

TRAFFIC CODES

PARKING RESTRICTIONS: A.M. PEAK, P.M. PEAK, A.M./P.M. PEAK, NO PARKING ANYTIME-N.P., COMM/IND. ACCESS-I

SYSTEM				TRAFFIC		LINE DIAGRAM	TRAFFIC			PAVEMENT DATA
	FUNCT CLASS	HWY SYS	HPMS SAMPLE	PREG REST	COM/IND ACCESS		CONTROL	COM/IND ACCESS	PREG REST	
						D E				
						CUL 009 SAC				
	Rural Local									
										24'I
										I c-c
										2 UNL
						GALWAY DR				
						CO 000 3094 0.05	SS			

COUNTY _____ ROAD NO. _____ PAGE ___ OF _____

SYSTEM			TRAFFIC		LINE DIAGRAM	TRAFFIC			PAVEMENT DATA
FUNCT CLASS	HWY SYS	HPMS SAMPLE	PREG REST	COM/IND ACCESS		ORIGIN	COM/IND ACCESS	PREG. REST.	

SHA 51.3 - 8 Revised
4.83

76-01
01/11/02
ES/08

MARYLAND STATE HIGHWAY ADMINISTRATION

ROAD INVENTORY SHEET

Party Chief S. Snyder
Recorder W. Plew
Assistant
Map No./Dir. D11D / S
State Coordinates 817-503

Road No. CO 3193
Road Name GENTLE CALL
County HOWARD
Date 01/11/02
Sheet No. 1 OF 1

TRAFFIC CODES
TRAFFIC CONTROLS: STOP SIGN-SS, TRAFFIC LIGHT=T.L., FLASHING RED BALL=F.R.

TRAFFIC CODES
PARKING RESTRICTIONS: A.M. PEAK, P.M. PEAK, A.M./P.M. PEAK, NO PARKING ANYTIME=N.P., COMM/IND. ACCESS=E

SYSTEM			TRAFFIC		LINE DIAGRAM	TRAFFIC			PAVEMENT DATA
FUNCT CLASS	HWY SYS	NHS SAMPLE	PREG. REST.	COM/IND ACCESS		CONTROL	COM/IND ACCESS	PREG. REST.	
					GENTLE CALL				
					CO 0 19 3193	SS			
					0 17 90°				
					0 15 90°				
					0 12 90°				
					GENTLE CALL CO 3193 0 09				
					0 06 PT				
					90°				
					0 03 PC				
Urban Loca									24'I
									I-C-C
									2UML
					0 01				
									1-12'I
									8'-GRSMD
									I-C-C
					GREAT STAR DR @ DR				2 ML
					CO 0 00 2892	SS			
					FOLD				

COUNTY _____ ROAD NO. _____ PAGE ___ OF ___

SYSTEM				TRAFFIC		LINE DIAGRAM	TRAFFIC			PAVEMENT DATA
FUNCT CLASS	HWY SYS	NHS	SAMPLE	PRES	COM/IND ACCESS		SCHOOL	COM/IND ACCESS	PRES. REST.	

74-01
01/11/02
SS/WP

SHA 51.3 - 8 Revised
4.83

MARYLAND STATE HIGHWAY ADMINISTRATION

ROAD INVENTORY SHEET

Party Chief S. Snyder
Recorder W. Plew
Assistant
Map No./Dir. D11D / J
State Coordinates 818-502

Road No. CO 3194
Road Name Blue Point CT
County HOWARD
Date 01/11/02
Sheet No. 1 OF 1

TRAFFIC CODES
TRAFFIC CONTROLS: STOP SIGN-SS, TRAFFIC LIGHT=T.L., FLASHING RED BALL-F.R.

TRAFFIC CODES
PARKING RESTRICTIONS: A.M. PEAK, P.M. PEAK, A.M./P.M. PEAK, NO PARKING ANYTIME-N.P., COMM/IND. ACCESS=E

SYSTEM: FUNCT CLASS	SYSTEM: HWY SYS	SYSTEM: HPMS SAMPLE	TRAFFIC: PREG. REST.	TRAFFIC: COMM/IND ACCESS	LINE DIAGRAM	TRAFFIC: CONTROL	TRAFFIC: COMM/IND ACCESS	TRAFFIC: PREG. REST.	PAVEMENT DATA
					Blue Point Ct				
↑					CO 0 15 3194 (74-01)	SS			↑
					↱ 90° 0 12				
					↱ 85° 0 10				
					↱ 90° 0 08				
					Blue Point Ct				
					0 06 CO 3194 (74-01)				
Urban Local					@0.00 White Marble Court				
					PT CO 3195 (75-01) 0 04				
					35°				
					PC 0 02				24'I
									Ic-c
									2UNL
					SIDR DR @.39				
↓					GREAT CO 0 00 2892	SS			↓
					Moonsails Lane				
					CO 3111 @.00				

COUNTY _____ ROAD NO. _____ PAGE ___ OF ___

SYSTEM			TRAFFIC		LINE DIAGRAM	TRAFFIC			PAVEMENT DATA
FUNCT CLASS	HWY SYS	HPMS SAMPLE	PREG REST	COM/IND ACCESS		% GROWTH	COM/IND ACCESS	PREG. REST.	

SHA 51.3 - 8 Revised
4.83

MARYLAND STATE HIGHWAY ADMINISTRATION

ROAD INVENTORY SHEET

75-01
74-01
1/11/02
SS/WP

Party Chief S. Snyder
Recorder W. Plew
Assistant
Map No./Dir. D18 / S
State Coordinates 818-502

Road No. CO 3195
Road Name WHITE MARBLE CT
County HOWARD
Date 1/11/02
Sheet No. 1 OF 1

TRAFFIC CODES
TRAFFIC CONTROLS: STOP SIGN-SS, TRAFFIC LIGHT=T.L., FLASHING RED BALL-F.R.

TRAFFIC CODES
PARKING RESTRICTIONS: A.M. PEAK, P.M. PEAK, A.M./P.M. PEAK, NO PARKING ANYTIME-N.P., COMM/IND. ACCESS=I

SYSTEM				TRAFFIC		LINE DIAGRAM	TRAFFIC			PAVEMENT DATA
	FUNCT CLASS	HWY SYS	HPMS SAMPLE	PREG. REST.	COM/IND ACCESS		CONTROL	COM/IND ACCESS	PREG. REST.	
	K	Urban Local				D E CUL 005 SAC				
						002 30°				24'I I-CL 24ML
	K					000 BLUE CO POINT 3194 CT (74-01)	SS			

COUNTY _____ ROAD NO. _____ PAGE ___ OF ___

SYSTEM				TRAFFIC		LINE DIAGRAM	TRAFFIC				PAVEMENT DATA
FUNCT CLASS	HWY SYS	NHS	STATE	PRES	COM/IND ACCESS		CHANGE	COM/IND ACCESS	PRES.		

84-01
01-11-02

SHA 51.3 - 8 Revised
4.83

MARYLAND STATE HIGHWAY ADMINISTRATION

ROAD INVENTORY SHEET

Party Chief S. Snyder
Recorder W. Plews
Assistant
Map No./Dir. 5110 / N
State Coordinates 819-502

Road No. CO 3196
Road Name Western Sea Run
County Howard
Date 01-11-02
Sheet No. 1 OF 1

TRAFFIC CODES
TRAFFIC CONTROLS: STOP SIGN-SS, TRAFFIC LIGHT-T.L., FLASHING RED BALL-F.R.

TRAFFIC CODES
PARKING RESTRICTIONS: A.M. PEAK, P.M. PEAK, A.M./P.M. PEAK, NO PARKING ANYTIME-N.P., COMM/IND. ACCESS-I

SYSTEM				TRAFFIC		LINE DIAGRAM	TRAFFIC			PAVEMENT DATA
	FUNCT CLASS	HWY SYS	HPMS SAMPLE	PREG. REST.	COMM/IND ACCESS		CONTROL	COMM/IND ACCESS	PREG. REST.	
	Urban Local					DE CUL DE SAC 0.11 TT 0.07 80° PC 0.02 24'I Jc-c 2 UNL 0.32 LINDEN LINTHICUM LANE CO 0.00 2567 WHITE PINE PATH CO 31 97 Road	5			

COUNTY _____ ROAD NO. _____ PAGE ___ OF _____

SYSTEM				TRAFFIC		LINE DIAGRAM	TRAFFIC				PAVEMENT DATA
FUNCT CLASS	HWY SYS	NHS	STATE	PRES EST	COM/IND ACCESS		S. CH/FEDL	COM/IND ACCESS	PRES. EST.		

SHA 51.3 - 8 Revised
4.83

78-01
01/11/01
SS/WP

MARYLAND STATE HIGHWAY ADMINISTRATION

ROAD INVENTORY SHEET

Party Chief S. Snyder
Recorder W Plew
Assistant
Map No./Dir. D11D / S
State Coordinates 819-502

Road No. CO 3197
Road Name WHITE PEBBLE PATH
County HOWARD
Date 01/11/01
Sheet No. 1 OF 1

TRAFFIC CODES
TRAFFIC CONTROLS: STOP SIGN-SS, TRAFFIC LIGHT-T.L., FLASHING RED BALL-F.R.

TRAFFIC CODES
PARKING RESTRICTIONS: A.M. PEAK, P.M. PEAK, A.M./P.M. PEAK, NO PARKING ANYTIME-N.P., COMM/HND. ACCESS=C

SYSTEM				TRAFFIC		LINE DIAGRAM	TRAFFIC			PAVEMENT DATA
	FUNCT CLASS	HWY SYS	HPMS SAMPLE	PREG. REST.	COMM/IND ACCESS		CONTROL	COMM/IND ACCESS	PREG. REST.	
						TG				
						CUL 0 09 SAC				
						0 07 PT				
						80°				
						0 04 PC				24'I
										Tc-c
										2UML
	K	Urban Local				LINDEN LINTHICUM LANE @ 22				
						CO 0 00 2567	SS			
						RUN				
						SEA				
						WEBSTER 96				
						@ CO 31				

COUNTY _____ ROAD NO. _____ PAGE ___ OF ___

SYSTEM			TRAFFIC		LINE DIAGRAM	TRAFFIC				PAVEMENT DATA
FUNCT CLASS	HWY SYS	HPMS SAMPLE	PREG REST.	COM/IND ACCESS		X CHNG	COM/IND ACCESS	PREG. REST.		

SHA 51.3 - 8 Revised
4.83

77-01
01/11/02
SS/WP

MARYLAND STATE HIGHWAY ADMINISTRATION

ROAD INVENTORY SHEET

Party Chief S. Snyder
Recorder W. Plews
Assistant
Map No./Dir. D11D / S
State Coordinates 820-502

Road No. CO 3198 / OP 1138
Road Name INDIAN SUMMER DRIVE
County HOWARD
Date 01/11/02
Sheet No. 1 OF 2

TRAFFIC CODES
TRAFFIC CONTROLS: STOP SIGN-SS, TRAFFIC LIGHT=T.L., FLASHING RED BALL=F.R.

TRAFFIC CODES
PARKING RESTRICTIONS: A.M. PEAK, P.M. PEAK, A.M./P.M. PEAK, NO PARKING ANYTIME=N.P., COMM/IND. ACCESS=I

SYSTEM: FUNCT CLASS	SYSTEM: HWY SYS	SYSTEM: HPMS SAMPLE	TRAFFIC: PREG. REST.	TRAFFIC: COM/IND ACCESS	LINE DIAGRAM	TRAFFIC: CONTROL	TRAFFIC: COM/IND ACCESS	TRAFFIC: PREG. REST.	PAVEMENT DATA
					FLOATING CLOUDS PATH — FLOWING WATER TRAIL				
					0 31				
					DISTANT THUNDER TRAIL — SUNLIT WATER WAY				
					0 19				
					0 18				
					PT				
					30°				
					PC				
					0 13				
					0 09				
					SUMMER SKY PATH				
					0 06				22'I
									Jc-c
									2UML
					LINDEN — LINTHICUM LANE @HO				
					CO 0 00 2567	55			

Urban Local

COUNTY HOWARD ROAD NO. CO 3198/OP 1138 PAGE 2 OF 2

SYSTEM			TRAFFIC		LINE DIAGRAM	TRAFFIC			PAVEMENT DATA
FUNCT CLASS	HWY SYS	NFMS SAMPLE	PREG REST	COM/IND ACCESS		CH/TRGN	COM/IND ACCESS	PREG. REST.	
					D E				
					CUL 0 53 SAC				
					FALL MOON RIDE				
					0 46				

SHA 51.3 - 8 Revised
4.83

59-01
01-11-02
SS/WP

MARYLAND STATE HIGHWAY ADMINISTRATION

ROAD INVENTORY SHEET

Party Chief S. Snyder
Recorder W. Plews
Assistant
Map No./Dir. D11D / E
State Coordinates 830-512

Road No. CO 3199
Road Name WINTER THICKET RD
County HOWARD
Date 01/11/02
Sheet No. 1 OF 1

TRAFFIC CODES
TRAFFIC CONTROLS: STOP SIGN-SS, TRAFFIC LIGHT-T.L., FLASHING RED BALL-F.R.

TRAFFIC CODES
PARKING RESTRICTIONS: A.M. PEAK, P.M. PEAK, A.M./P.M. PEAK, NO PARKING ANYTIME-N.P., COMM/IND. ACCESS=I

SYSTEM: FUNCT CLASS	SYSTEM: HWY SYS	SYSTEM: HPMS SAMPLE	TRAFFIC: PREG. REST.	TRAFFIC: COMM/IND ACCESS
Rural Local				

LINE DIAGRAM

TRAFFIC: CONTROL	TRAFFIC: COMM/IND ACCESS	TRAFFIC: PREG. REST.
SS		

PAVEMENT DATA
22'I
2UML

ROAD END

0 22

PT 0 19

115° 0 14 36" D.O.F. 41' CP SQUASH

PC 0 07

DORSCH FARM RD @.21

CO 0.00 1907

COUNTY _____ ROAD NO. _____ PAGE ___ OF ___

SYSTEM				TRAFFIC			LINE DIAGRAM	TRAFFIC				PAVEMENT DATA
	FUNCT CLASS	HWY SYS	NHS	PREG	REST	COM/IND ACCESS						

SHA 51.3 - 8 Revised
4.83

57-01
01/11/02
ES/WP

MARYLAND STATE HIGHWAY ADMINISTRATION

ROAD INVENTORY SHEET

Party Chief S. Snyder
Recorder W. Plew
Assistant
Map No./Dir. D11D / E
State Coordinates 830-513

Road No. CO 3200
Road Name Hidden Fox CT
County Howard
Date 01/11/02
Sheet No. 1 OF 1

TRAFFIC CODES
TRAFFIC CONTROLS: STOP SIGN-SS, TRAFFIC LIGHT=T.L., FLASHING RED BALL=F.R.

TRAFFIC CODES
PARKING RESTRICTIONS: A.M. PEAK, P.M. PEAK, A.M./P.M. PEAK, NO PARKING ANYTIME-N.P., COMM/IND. ACCESS=E

SYSTEM				TRAFFIC		LINE DIAGRAM	TRAFFIC			PAVEMENT DATA
	FUNCT CLASS	HWY. SYS	HPMS SAMPLE	PK.HR. REST.	COM/IND ACCESS		CONTROL	COM/IND ACCESS	PK.HR. REST.	
						D E				
						CUL 0.15 SAC				
						PT 0.13				
						60°				
						PC 0.07				22'I
										2UNL
						DORSCH FARM RD 0.39				
						CO 0.00 1907	SS			

Rural Local

COUNTY _____ ROAD NO. _____ PAGE ___ OF _____

SYSTEM			TRAFFIC		LINE DIAGRAM	TRAFFIC			PAVEMENT DATA
FUNCT CLASS	HWY SYS	NHS	PREG REST	COM/IND ACCESS		% CH HCV	COM/IND ACCESS	PREG. REST.	

55-01
01-11-02
55/WP

SHA 51.3 - 8 Revised
4.83

MARYLAND STATE HIGHWAY ADMINISTRATION

ROAD INVENTORY SHEET

Party Chief S. Snyder
Recorder W. Plews
Assistant
Map No./Dir. D11D / W
State Coordinates 830-514

Road No. CO 3201
Road Name HUNTERS VIEW RD
County HOWARD
Date 1/11/02
Sheet No. 1 OF 1

TRAFFIC CODES
TRAFFIC CONTROLS: STOP SIGN-SS, TRAFFIC LIGHT-T.L., FLASHING RED BALL-F.R.

TRAFFIC CODES
PARKING RESTRICTIONS: A.M. PEAK, P.M. PEAK, A.M./P.M. PEAK, NO PARKING ANYTIME-N.P., COMM/IND. ACCESS-I

SYSTEM				TRAFFIC		LINE DIAGRAM	TRAFFIC			PAVEMENT DATA
	FUNCT CLASS	HWY SYS	HPMS SAMPLE	PKG. REST.	COMM/IND ACCESS		CONTROL	COMM/IND ACCESS	PKG. REST.	
						ROAD END				
						0 12				
	Rural Local									22'I
										2UML
						DORSCH FARM RD				
						CO 0 00 1907 @.46	55			

COUNTY _____ ROAD NO. _____ PAGE ___ OF ___

SYSTEM				TRAFFIC		LINE DIAGRAM	TRAFFIC			PAVEMENT DATA
FUNCT CLASS	HWY SYS	NHS	SAMPLE	PRES	COM/IND ACCESS		CONFIG	COM/IND ACCESS	PRES. REST.	

56-01
1/11/02
SS/WP

SHA 51.3 - 8 Revised
4.83

MARYLAND STATE HIGHWAY ADMINISTRATION

ROAD INVENTORY SHEET

Party Chief S Snyder
Recorder W. Plew
Assistant
Map No./Dir. D11D / E
State Coordinates 83-514

Road No. CO 3202
Road Name STEEPLECHASE CT
County HOWARD
Date 01/11/02
Sheet No. 1 OF 1

TRAFFIC CODES
TRAFFIC CONTROLS: STOP SIGN-SS, TRAFFIC LIGHT=T.L., FLASHING RED BALL-F.R.

TRAFFIC CODES
PARKING RESTRICTIONS: A.M. PEAK, P.M. PEAK, A.M./P.M. PEAK, NO PARKING ANYTIME-N.P., COMM/IND. ACCESS=E

SYSTEM				TRAFFIC		LINE DIAGRAM	TRAFFIC			PAVEMENT DATA
	FUNCT CLASS	HWY SYS	HPMS SAMPLE	FREQ. REST.	COMM/IND ACCESS		CONTROL	COMM/IND ACCESS	FREQ. REST.	
						D E				
						CUL D 10 SAC				
	7									
	Rural Local									22'I
										2UNL
						DORSCH FORM TED 3.61				
	K					CO 0 00 1907	SS			

COUNTY _____ ROAD NO. _____ PAGE ___ OF ___

SYSTEM				TRAFFIC		LINE DIAGRAM	TRAFFIC			PAVEMENT DATA
FUNCT CLASS	HWY SYS	NHS	STATE	PRES	COM/IND ACCESS		CONFIG	COM/IND ACCESS	PRES. REST.	

SHA 51.3 - 8 Revised
4.83

32-01
01-135T
1/16/02
SS/WP

MARYLAND STATE HIGHWAY ADMINISTRATION

ROAD INVENTORY SHEET

Party Chief S. Snyder
Recorder W. Plew
Assistant
Map No./Dir. D12A / E
State Coordinates 852-527

Road No. CO 3203 / OP 1139
Road Name EXECUTIVE CENTER ROAD
County HOWARD
Date 1/16/02
Sheet No. 1 OF 1

TRAFFIC CODES
TRAFFIC CONTROLS: STOP SIGN-SS, TRAFFIC LIGHT=T.L., FLASHING RED BALL=F.R.

TRAFFIC CODES
PARKING RESTRICTIONS: A.M. PEAK, P.M. PEAK, A.M./P.M. PEAK, NO PARKING ANYTIME-N.P., COMM/IND. ACCESS=I

SYSTEM: FUNCT CLASS	SYSTEM: HWY. SYS	SYSTEM: HPMS SAMPLE	TRAFFIC: PREG. REST.	TRAFFIC: COM/IND ACCESS	LINE DIAGRAM	TRAFFIC: CONTROL	TRAFFIC: COM/IND ACCESS	TRAFFIC: PREG. REST.	PAVEMENT DATA
					@15.30				
					US 0 26 40 (01-1357)				2-20'I
									4' GRSMED ON TAPER TO 20GTS MED
									I c-c
									2 ML
					0 25				
			E		PT 0 21				
					0 17				
					120° 0 14				
					HALCYON COURT 0 12				
					PC 0 11		E		
					HAWTHORNE COURT ENT TO APTS 0 07				
					0 04		E		38'I
									I c-c
									2 UML
					@13 NORTH RIDGE ROAD CO 0 00 2929	SS			
Urban Local									

COUNTY _____ ROAD NO. _____ PAGE ___ OF ___

SYSTEM			TRAFFIC		LINE DIAGRAM	TRAFFIC			PAVEMENT DATA
FUNCT CLASS	HWY SYS	NHS SAMPLE	PRES BEST	COM/IND ACCESS		CONTROL	COM/IND ACCESS	PRES BEST	

SHA 51.3 - 8 Revised
4.83

51-01
48-01
01/16/02
SS/WP

MARYLAND STATE HIGHWAY ADMINISTRATION

ROAD INVENTORY SHEET

Party Chief S-Snyder
Recorder W. Plew
Assistant
Map No./Dir. D12A / E
State Coordinates 855-526

Road No. Co 3204
Road Name MARTHA BUSH DRIVE
County HOWARD
Date 01-16-02
Sheet No. 1 OF 1

TRAFFIC CODES
TRAFFIC CONTROLS: STOP SIGN-SS, TRAFFIC LIGHT-T.L., FLASHING RED BALL-F.R.

TRAFFIC CODES
PARKING RESTRICTIONS: A.M. PEAK, P.M. PEAK, A.M./P.M. PEAK, NO PARKING ANYTIME-N.P., COMM/HHD. ACCESS=E

SYSTEM			TRAFFIC		LINE DIAGRAM	TRAFFIC			PAVEMENT DATA
FUNCT CLASS	HWY SYS	HPMS SAMPLE	PREG. REST.	COMM/IND ACCESS		CONTROL	COMM/IND ACCESS	PREG. REST.	
					GOVERNOR Howard DRIVE Co 32 0.05 @ 0.00				
					0 19 PT				
					45°				
					0 15 PC				30'I
									JC-C
									2UML
					0 13 DISTRICT COURT MULTI-SERVICE CENTER		E	X	
					0 08 30°				
					PT 0 06				
					40°				
					PC 0 03				24'I
									JC-C
					COURT HOUSE DR @ 13				2UML
					Co 0 00 437	SS		V	
					ENT TO County Complex				

Urban Local

COUNTY _____ ROAD NO. _____ PAGE ___ OF ___

SYSTEM				TRAFFIC		LINE DIAGRAM	TRAFFIC				PAVEMENT DATA
FUNCT CLASS	HWY SYS	HPMS SAMPLE		PREG REST	COM/IND ACCESS		CONTROL	COM/IND ACCESS	PREG REST		

SHA 51.3 - 8 Revised
4.83

48-01, 51-01
49-01, 46-01
50-01
01-16-02
SS/WP

MARYLAND STATE HIGHWAY ADMINISTRATION

ROAD INVENTORY SHEET

Party Chief S. Snyder
Recorder W. Plew
Assistant
Map No./Dir. D12A / N
State Coordinates 857-526

Road No. CO 3205
Road Name GOVERNOR HOWARD DR
County HOWARD
Date 01-16-02
Sheet No. 1 OF 2

TRAFFIC CODES
TRAFFIC CONTROLS: STOP SIGN-S, TRAFFIC LIGHT-T.L., FLASHING RED BALL-F.R.

TRAFFIC CODES
PARKING RESTRICTIONS: A.M. PEAK, P.M. PEAK, A.M./P.M. PEAK, NO PARKING ANYTIME-N.P., COMM/IND. ACCESS=I

SYSTEM				TRAFFIC		LINE DIAGRAM	TRAFFIC			PAVEMENT DATA
	FUNCT CLASS	HWY SYS	HPMS SAMPLE	PREG. REST.	COM/IND ACCESS		CONTROL	COM/IND ACCESS	PREG. REST.	
	Urban Local					0.24				SEE NEXT PG
						X-OVER				2-16'I
						0.22				30' VAR GRS med
										JC-C
										2UNL
						0.21				
						GOVERNOR CARROLL COURT CO 3208 (47-01) 0.00 — GOVERNOR JOHNSON COURT CO 3209 (46-01) 0.00				
						0.19				
						PT				
						0.06				
						35°				
						PC				30'I
						0.03				JC-C
										2UNL
	K					0.00				
						MARTHA BUSH DRIVE CO 3204 (51-01) 0.17				

COUNTY Howard ROAD NO. co 3205 PAGE 2 OF 2

LINE DIAGRAM

SYSTEM: FUNCT CLASS | HWY SYS | HPMS SAMPLE

TRAFFIC: PREG REST | CONV/RAMP ACCESS

TRAFFIC: CONTROL | CONV/RAMP ACCESS | PREG. REST.

PAVEMENT DATA

Urban Local

D 6

CUL 0 36 SAC

30° 0 33

Governor Henry Court

@0.00 CO 3206 (49-01) 0 32

30' I
JC-C
2uml

0 30

2-11' I
30' VAR GRS med

X-over

JC-C
2ml

0 28

0 27

Governor Martin Ct

0 25 CO 3207 @0.00

30' I
JC-C
2uml

49-01
51-01
1/16/02
SS/WP

SHA 51.3 - 8 Revised
4.83

MARYLAND STATE HIGHWAY ADMINISTRATION

ROAD INVENTORY SHEET

Party Chief S. Snyder
Recorder W. Plew
Assistant
Map No./Dir. D12A / N
State Coordinates 858-527

Road No. CO 3206
Road Name GOVERNOR HENRY COURT
County HOWARD
Date 1/16/02
Sheet No. 1 OF 1

TRAFFIC CODES
TRAFFIC CONTROLS: STOP SIGN-SS, TRAFFIC LIGHT-T.L., FLASHING RED BALL-F.R.

TRAFFIC CODES
PARKING RESTRICTIONS: A.M. PEAK, P.M. PEAK, A.M./P.M. PEAK, NO PARKING ANYTIME-N.P., COMMA/HYPHEN, ACCESS=E

SYSTEM				TRAFFIC		LINE DIAGRAM	TRAFFIC			PAVEMENT DATA
	FUNCT CLASS	HWY SYS	HPMS SAMPLE	PREG. REST.	COMMND ACCESS		CONTROL	COMMND ACCESS	PREG. REST.	
	K	Urban Local				D E				
						CUL 0 09 SAC				
						PT 0 03 ↑ 45°				
						PC 0 02				24'I
										IC-C
										2 NML
						GOVERNOR HOWARD DRIVE 0.32				
	K					CO 0 00 3205 (48-01)	SS			

COUNTY _____ ROAD NO. _____ PAGE ___ OF ___

SYSTEM				TRAFFIC		LINE DIAGRAM	TRAFFIC				PAVEMENT DATA
FUNCT CLASS	HWY SYS	NHS	SAMPLE	PREG. REST	COM/IND ACCESS		OTHER	COM/IND ACCESS	PREG. REST.		

SHA 51.3 - 8 Revised
4.83

50-01
48-01
1/16/02
SS/WP

MARYLAND STATE HIGHWAY ADMINISTRATION

ROAD INVENTORY SHEET

Party Chief S. Snyder
Recorder W. Pierce
Assistant
Map No./Dir. 12A / E
State Coordinates 857-527

Road No. CO 3207
Road Name GOVERNOR MARTIN COURT
County HOWARD
Date 1/16/02
Sheet No. 1 OF 1

TRAFFIC CODES

TRAFFIC CONTROLS: STOP SIGN-SS, TRAFFIC LIGHT-T.L., FLASHING RED BALL-F.R.

PARKING RESTRICTIONS: A.M. PEAK, P.M. PEAK, A.M./P.M. PEAK, NO PARKING ANYTIME-N.P., COMM/HHD. ACCESS-E

SYSTEM				TRAFFIC		LINE DIAGRAM	TRAFFIC			PAVEMENT DATA
	FUNCT CLASS	HWY SYS	HPMS SAMPLE	PKG. REST.	COMM/IND ACCESS		CONTROL	COMM/IND ACCESS	PKG. REST.	
	K	Urban Local				D E CUL 0 17 SAC				24' I Ja-c 2 UNL
	K					GOVERNOR HOWARD DRIVE @.25 CO 0 00 3205 (48-01)	SS			

COUNTY _____ ROAD NO. _____ PAGE ___ OF ___

SYSTEM				TRAFFIC		LINE DIAGRAM	TRAFFIC				PAVEMENT DATA
FUNCT CLASS	HWY SYS	HPMS SAMPLE		PAVG. REST.	COM/IND ACCESS		S. CHARGE	COM/IND ACCESS	PAVG. REST.		

SHA 51.3 - 8 Revised
4.83

47-01
48-01
1/16/02
SS/WT

MARYLAND STATE HIGHWAY ADMINISTRATION

ROAD INVENTORY SHEET

Party Chief S. Snyder
Recorder W. Plews
Assistant
Map No./Dir. D12A / N
State Coordinates 857-526

Road No. CO 3208
Road Name GOVERNOR CARROLL COURT
County HOWARD
Date 1/16/02
Sheet No. 1 OF 1

TRAFFIC CODES
TRAFFIC CONTROLS: STOP SIGN-SS, TRAFFIC LIGHT-T.L., FLASHING RED BALL-F.R.

TRAFFIC CODES
PARKING RESTRICTIONS: A.M. PEAK, P.M. PEAK, A.M./P.M. PEAK, NO PARKING ANYTIME-N.P., COMM/IND. ACCESS=I

SYSTEM				TRAFFIC		LINE DIAGRAM	TRAFFIC			PAVEMENT DATA
	FUNCT CLASS	HWY. SYS	NHS & SAMPLE	PREG. REST.	COM/IND ACCESS		CONTROL	COM/IND ACCESS	PREG. REST.	
	Urban Local					D E CUL D 11 SAC HOWARD DRIVE @.19 GOVERNOR CO 0 00 3205 (48-01) Governor Johnson Ct 3209 Co @.20	SS			24'I Jc-c 2UML

COUNTY _____ ROAD NO. _____ PAGE ___ OF ___

SYSTEM				TRAFFIC		LINE DIAGRAM	TRAFFIC				PAVEMENT DATA
FUNCT CLASS	HWY SYS	HPMS SAMPLE		PREG REST	COM/IND ACCESS		CONSTR	COM/IND ACCESS	PREG REST		

47-01 46-01
48-01
1/16/02
SS/WP

SHA 51.3 - 8 Revised
4.83

MARYLAND STATE HIGHWAY ADMINISTRATION

ROAD INVENTORY SHEET

Party Chief S. Snyder
Recorder W. Plew
Assistant
Map No./Dir. 012A / S
State Coordinates 857-526

Road No. CO 3209
Road Name GOVERNOR JOHNSON COURT
County HOWARD
Date 1/16/02
Sheet No. 1 OF 1

TRAFFIC CODES
TRAFFIC CONTROLS: STOP SIGN-SS, TRAFFIC LIGHT-T.L., FLASHING RED BALL-F.R.

TRAFFIC CODES
PARKING RESTRICTIONS: A.M. PEAK, P.M. PEAK, A.M./P.M. PEAK, NO PARKING ANYTIME-N.P., COMM/IND. ACCESS-I

SYSTEM				TRAFFIC		LINE DIAGRAM	TRAFFIC			PAVEMENT DATA
	FUNCT CLASS	HWY SYS	HPMS SAMPLE	PREG. REST.	COMM/IND ACCESS		CONTROL	COMM/IND ACCESS	PREG. REST.	
	K Urban Local					D E CUL O OB SAC GOVERNOR HOWARD DRIVE (48-01) @.19 CO O 00 3205 GOVERNOR CONTROL COURT (47-01) Co 3208 @ 0.08	SS			24' I I C-C 20ML

COUNTY _____ ROAD NO. _____ PAGE ___ OF ___

SYSTEM			TRAFFIC		LINE DIAGRAM	TRAFFIC			PAVEMENT DATA
FUNCT CLASS	HWY SYS	NHS SAMPLE	PREG REST	COM/IND ACCESS		OTHER	COM/IND ACCESS	PREG. REST.	

SHA 51.3 - 8 Revised
4.83

40-01
41-01
1/16/02
SS/WP

MARYLAND STATE HIGHWAY ADMINISTRATION

ROAD INVENTORY SHEET

Party Chief S.Snyder
Recorder W.Plew
Assistant
Map No./Dir. D12A / E
State Coordinates 858-527

Road No. CO 3210
Road Name Governor Grayson WAY
County HOWARD
Date 1/16/02
Sheet No. 1 OF 1

TRAFFIC CODES
TRAFFIC CONTROLS: STOP SIGN-SS, TRAFFIC LIGHT-T.L., FLASHING RED BALL-F.R.

TRAFFIC CODES
PARKING RESTRICTIONS: A.M. PEAK, P.M. PEAK, A.M./P.M. PEAK, NO PARKING ANYTIME-N.P., COMM/IND. ACCESS-I

SYSTEM				TRAFFIC		LINE DIAGRAM	TRAFFIC			PAVEMENT DATA
	FUNCT CLASS	HWY SYS	HPMS SAMPLE	PRES. REST.	COM/IND ACCESS		CONTROL	COM/IND ACCESS	PRES. REST.	
						D E				
						CUL O 29 SAC				
						O 20 PT				
						140°				
						O 08 PC				
	Urban Local					@0.00 GOVERNOR BRADFORD LANE				
						GOVERNOR 3211 (41-01) O 06 CO				
						PT O 05				
						35°				
						PC O 02				28'I
										I-C
										ZUML
						GOVERNORS RUN				
						CO O 00 3173 @.60	SS			

COUNTY _____ ROAD NO. _____ PAGE ___ OF ___

SYSTEM				TRAFFIC		LINE DIAGRAM	TRAFFIC			PAVEMENT DATA
FUNCT CLASS	HWY SYS	HPMS SAMPLE		PREG REST	COMM/IND ACCESS		CHARGE	COMM/IND ACCESS	PREG REST	

SHA S1.3 - 8 Revised
4.83

MARYLAND STATE HIGHWAY ADMINISTRATION

41-01
40-01
1/16/02
55/WP

ROAD INVENTORY SHEET

Party Chief S. Snyder
Recorder W. Plew
Assistant
Map No./Dir. D12A / N
State Coordinates 858-527

Road No. CO 3211
Road Name GOVERNOR BRADFORD LANE
County HOWARD
Date 1/16/02
Sheet No. 1 OF 1

TRAFFIC CODES
TRAFFIC CONTROLS: STOP SIGN-SS, TRAFFIC LIGHT-T.L., FLASHING RED BALL-F.R.

TRAFFIC CODES
PARKING RESTRICTIONS: A.M. PEAK, P.M. PEAK, A.M./P.M. PEAK, NO PARKING ANYTIME-N.P., COMM/IND. ACCESS-E

SYSTEM			TRAFFIC		LINE DIAGRAM	TRAFFIC			PAVEMENT DATA
FUNCT CLASS	HWY SYS	NHS SAMPLE	PREG REST.	COM/IND ACCESS		CONTROL	COM/IND ACCESS	PREG. REST.	
K					D E				
					CUL 009 SAC				

COUNTY _____ ROAD NO. _____ PAGE ___ OF ___

SYSTEM				TRAFFIC		LINE DIAGRAM	TRAFFIC				PAVEMENT DATA
FUNCT CLASS	HWY SYS	HPMS SAMPLE		PREG. REST.	COM/IND ACCESS		CONTROL	COM/IND ACCESS	PREG. REST.		

SHA 51.3 - 8 Revised
4.83

MARYLAND STATE HIGHWAY ADMINISTRATION

4/2-01
95-01
1/16/02
SS/WP

ROAD INVENTORY SHEET

Party Chief S. Snyder
Recorder W. Plew
Assistant
Map No./Dir. 21A / W
State Coordinates 858-528

Road No. CO 3212
Road Name GOVERNOR Ridgely LANE
County HOWARD
Date 1/16/02
Sheet No. 1 OF 1

TRAFFIC CODES
TRAFFIC CONTROLS: STOP SIGN-SS, TRAFFIC LIGHT-T.L., FLASHING RED BALL-F.R.

TRAFFIC CODES
PARKING RESTRICTIONS: A.M. PEAK, P.M. PEAK, A.M./P.M. PEAK, NO PARKING ANYTIME-N.P., COMM/IND. ACCESS=I

SYSTEM				TRAFFIC		LINE DIAGRAM	TRAFFIC			PAVEMENT DATA
	FUNCT CLASS	HWY SYS	HPMS SAMPLE	PREG. REST.	COM/IND ACCESS		CONTROL	COM/IND ACCESS	PREG. REST.	
						D E				
	↑					CUL 0 16 SAC				↑
						GOVERNOR KENT TERRACE / GOVERNOR THOMAS LANE				
						CO 3214 (45-01) 0 11 CO 3213 (45-01)				
						0 10 PT				
						35°				
						0 07 PC				
	Urban Local									30'I
										IC-C
										2UNL
						GOVERNORS / RUN				
	↓					CO 0 00 3173 0.43	SS			↓

COUNTY _____ ROAD NO. _____ PAGE ___ OF ___

SYSTEM				TRAFFIC		LINE DIAGRAM	TRAFFIC				PAVEMENT DATA
FUNCT CLASS	HWY SYS	HPMS SAMPLE		PVMG. REST.	CONN/IND ACCESS		CONTROL	CONN/IND ACCESS	PVMG. REST.		

SHA 51.3 - 8 Revised
4.83

MARYLAND STATE HIGHWAY ADMINISTRATION

44-01
42-01
1/16/02
SS/WP

ROAD INVENTORY SHEET

Party Chief S. Snyder
Recorder W. Plew
Assistant
Map No./Dir. D12A / N
State Coordinates 857-528

Road No. CO 3213
Road Name GOVERNOR THOMAS LANE
County HOWARD
Date 1/16/02
Sheet No. 1 OF 1

TRAFFIC CODES
TRAFFIC CONTROLS: STOP SIGN-SS, TRAFFIC LIGHT-T.L., FLASHING RED BALL-F.R.

TRAFFIC CODES
PARKING RESTRICTIONS: A.M. PEAK, P.M. PEAK, A.M./P.M. PEAK, NO PARKING ANYTIME-N.P., COMM/IND. ACCESS-I

SYSTEM				TRAFFIC		LINE DIAGRAM	TRAFFIC			PAVEMENT DATA
	FUNCT CLASS	HWY SYS	HPMS SAMPLE	PREG. REST	COMM/IND ACCESS		CONTROL	COMM/IND ACCESS	PREG. REST	
						D E				
						C4L 0 09 SAC				
	Urban Local									
										28'I
										Ice
										2UML
						GOVERNOR				
						CO 0 00 3212 RIDGELY LANE (42-01)				
						GOVERNOR KENT TERRACE 3214 (45-01) 30	55			

COUNTY _____ ROAD NO. _____ PAGE ___ OF ___

SYSTEM			TRAFFIC		LINE DIAGRAM	TRAFFIC			PAVEMENT DATA
FUNCT CLASS	HWY SYS	HPMS SAMPLE	PREG. REST.	COM/IND ACCESS		CONFIG.	COM/IND ACCESS	PREG. REST.	

SHA 51.3 - 8 Revised
4.83

45-01
44-01
42-01
1/16/02
SS/WT

MARYLAND STATE HIGHWAY ADMINISTRATION

ROAD INVENTORY SHEET

Party Chief S. Snyder
Recorder W. Plew
Assistant
Map No./Dir. D12A / S
State Coordinates 857-528

Road No. CO 3214
Road Name GOVERNOR KENT TERRACE
County HOWARD
Date 1/16/02
Sheet No. 1 OF 1

TRAFFIC CODES
TRAFFIC CONTROLS: STOP SIGN-SS, TRAFFIC LIGHT-T.L., FLASHING RED BALL-F.R.

TRAFFIC CODES
PARKING RESTRICTIONS: A.M. PEAK, P.M. PEAK, A.M./P.M. PEAK, NO PARKING ANYTIME-N.P., CONVA/HND. ACCESS-E

SYSTEM			TRAFFIC		LINE DIAGRAM	TRAFFIC			PAVEMENT DATA
FUNCT CLASS	HWY SYS	HPMS SAMPLE	PREG REST.	COM/IND ACCESS		CONTROL	COM/IND ACCESS	PREG. REST.	
Urban Local					7 E CUL 0 10 SAC 35° 0 05 GOVERNOR CO RIDGELY LANE 0.11 0 00 3212 (42-01) GOVERNOR THOMAS LANE CO 3213 (44-01) 0.10	SS			28' I I C-C 2 UNL

COUNTY _____ ROAD NO. _____ PAGE ___ OF ___

SYSTEM				TRAFFIC		LINE DIAGRAM	TRAFFIC				PAVEMENT DATA
FUNCT CLASS	HWY SYS	HPMS SAMPLE		PREG. RESI.	COM/IND ACCESS		CONTROL	COM/IND ACCESS	PREG. RESI.		

SHA 51.3 - 8 Revised
4.83

MARYLAND STATE HIGHWAY ADMINISTRATION

ROAD INVENTORY SHEET

Party Chief S. Snyder
Recorder W. Plew
Assistant
Map No./Dir. D12A / N
State Coordinates 853-524

Road No. CO 3215
Road Name PAPILLION DRIVE
County HOWARD
Date 1/18/02
Sheet No. 1 OF 2

TRAFFIC CODES
TRAFFIC CONTROLS: STOP SIGN-SS, TRAFFIC LIGHT-T.L., FLASHING RED BALL-F.R.

TRAFFIC CODES
PARKING RESTRICTIONS: A.M. PEAK, P.M. PEAK, A.M./P.M. PEAK, NO PARKING ANYTIME-N.P., COMM/IND. ACCESS-I

SYSTEM: FUNCT CLASS	SYSTEM: HWY SYS	SYSTEM: HPMS SAMPLE	TRAFFIC: PREG. REST.	TRAFFIC: COM/IND ACCESS
Urban Local				

LINE DIAGRAM

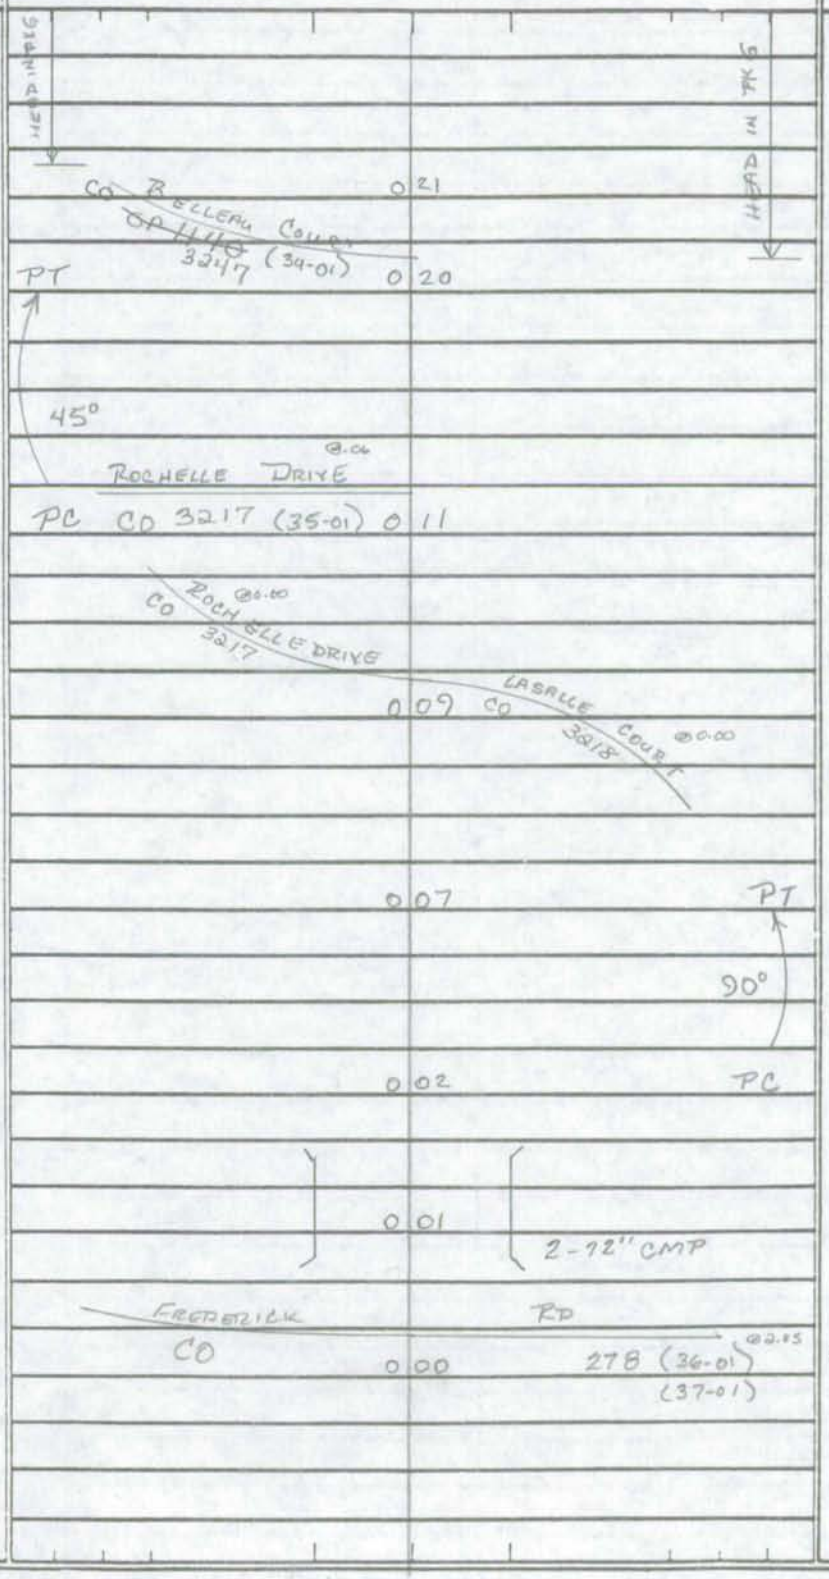

TRAFFIC: CONTROL	TRAFFIC: COM/IND ACCESS	TRAFFIC: PREG. REST.
SS		

PAVEMENT DATA
24'I
I-C
2UML

COUNTY HOWARD ROAD NO. CO 3215 PAGE 2 OF 2

SYSTEM: FUNCT CLASS | HWY SYS | HPMS SAMPLE
TRAFFIC: PREG REST | CONTROL ACCESS

LINE DIAGRAM

TRAFFIC: CONTROL | CONTROL ACCESS | PREG. REST.

PAVEMENT DATA

Urban Local

HEAD IN PARKING

D E

CUL D 32 SAC

D 30

PT

30°

HEAD IN PARKING

D 26

PC

24' I
I-C-C
2 UNL

CO 3216

HOWARD COUNTY

UNASSIGNED

NOW OP 1140

BELLEAU CT

34-01

35-01
39-01
1/18/02
SS/WP

SHA 51.3 - 8 Revised
4.83

MARYLAND STATE HIGHWAY ADMINISTRATION

ROAD INVENTORY SHEET

Party Chief S. Snyder
Recorder W. Plew
Assistant
Map No./Dir. D12A / S
State Coordinates 853-524

Road No. CO 3217
Road Name Rochelle DRIVE
County Howard
Date 1/18/02
Sheet No. 1 OF 1

TRAFFIC CODES

TRAFFIC CONTROLS: STOP SIGN-SS, TRAFFIC LIGHT=T.L., FLASHING RED BALL-F.R.

TRAFFIC CODES

PARKING RESTRICTIONS: A.M. PEAK, P.M. PEAK, A.M./P.M. PEAK, NO PARKING ANYTIME-N.P., COMM/IND. ACCESS=I

SYSTEM				TRAFFIC		LINE DIAGRAM	TRAFFIC			PAVEMENT DATA
	FUNCT CLASS	HWY SYS	HPMS SAMPLE	PREG. REST.	COM/IND ACCESS		CONTROL	COM/IND ACCESS	PREG. REST.	
	K	Urban Local				PAPILLION CO DRIVE @.11 0 06 3215 (39-01) 0 04 PT 0 03 HEAD IN PKG 170° HEAD IN PKG 0 01 PC PAPILLION CO DRIVE @.09 0 00 3215 (39-01) SS LASALLE COURT (3218 (39-01) 00 @.8				24'I I-C 2UML

COUNTY _____ ROAD NO. _____ PAGE ___ OF ___

SYSTEM				TRAFFIC		LINE DIAGRAM	TRAFFIC				PAVEMENT DATA
	FUNCT CLASS	HWY SYS	HPMS SAMPLE	PKG BEST	COM/IND ACCESS		CONTROL	COM/IND ACCESS	PKG. BEST.		

SHA 51.3 - 8 Revised
4.83

38-01
1/18/02
⇒ SLWP
39-01

MARYLAND STATE HIGHWAY ADMINISTRATION

ROAD INVENTORY SHEET

Party Chief S. Snyder
Recorder W. Plew
Assistant
Map No./Dir. D12A / N
State Coordinates 853-524

Road No. CO 3218
Road Name LASALLE COURT
County HOWARD
Date 1/18/02
Sheet No. 1 OF 1

TRAFFIC CODES

TRAFFIC CONTROLS: STOP SIGN-SS, TRAFFIC LIGHT-T.L., FLASHING RED BALL-F.R.

PARKING RESTRICTIONS: A.M. PEAK, P.M. PEAK, A.M./P.M. PEAK, NO PARKING ANYTIME-N.P., COMM/HVD, ACCESS=E

TRAFFIC CODES

SYSTEM				TRAFFIC		LINE DIAGRAM	TRAFFIC			PAVEMENT DATA
	FUNCT CLASS	HWY SYS	HPMS SAMPLE	PKG. REST.	COM/IND ACCESS		CONTROL	COM/IND ACCESS	PKG. REST.	
	K									

Urban Local

D E
CUL 0 05 SAC
NO PARKING
PT 0 03
HEAD IN PARKING
30°
PC 0 01
PAPILLON
CO 0 00 3215
DRIVE 0.09
(39-01)
TO BOWLEY'S LANE CO 3217 (35-01) 0.8

24' I
I c-c
2 UNL

COUNTY _____ ROAD NO. _____ PAGE ___ OF ___

SYSTEM				TRAFFIC		LINE DIAGRAM	TRAFFIC				PAVEMENT DATA
FUNCT CLASS	HWY SYS	HPMS SAMPLE		PREG. RESP.	COM/IND ACCESS		CHANGE	COM/IND ACCESS	PREG. RESP.		

SHA 51.3 - 8 Revised
4.83

62-01
01-17-02
SS/WP

MARYLAND STATE HIGHWAY ADMINISTRATION

ROAD INVENTORY SHEET

Party Chief S. Snyder
Recorder W. Plew
Assistant
Map No./Dir. D12C / S
State Coordinates 860-513

Road No. CO 3219
Road Name ISSAC DRIVE
County HOWARD
Date 01-17-02
Sheet No. 1 OF 1

TRAFFIC CODES
TRAFFIC CONTROLS: STOP SIGN-SS, TRAFFIC LIGHT-T.L., FLASHING RED BALL-F.R.

TRAFFIC CODES
PARKING RESTRICTIONS: A.M. PEAK, P.M. PEAK, A.M./P.M. PEAK, NO PARKING ANYTIME-N.P., COMM/IND. ACCESS-I

SYSTEM				TRAFFIC		LINE DIAGRAM	TRAFFIC			PAVEMENT DATA
	FUNCT CLASS	HWY SYS	HPMS SAMPLE	PREG. REST.	COM/IND ACCESS		CONTROL	COM/IND ACCESS	PREG. REST.	
	K Urban Local					DE CUL 0 04 SAC				20'I 2UNL
						HUNTLEY DRIVE @0.08 CO 0 00 644	SS			

COUNTY _____ ROAD NO. _____ PAGE ___ OF ___

SYSTEM			TRAFFIC		LINE DIAGRAM	TRAFFIC			PAVEMENT DATA
FUNCT CLASS	HWY SYS	HPMS SAMPLE	PREG. REST.	COM/IND ACCESS		CONSTR.	COM/IND ACCESS	PREG. REST.	

SHA 51.3 - 8 Revised
4.83

63-01
01-17-02
SSIWP

MARYLAND STATE HIGHWAY ADMINISTRATION

ROAD INVENTORY SHEET

Party Chief S. Snyder
Recorder W. Plew
Assistant
Map No./Dir. D12C / S
State Coordinates 860-513

Road No. CO 3220
Road Name TERRY DRIVE
County HOWARD
Date 01-17-02
Sheet No. 1 OF 1

TRAFFIC CODES

TRAFFIC CONTROLS: STOP SIGN-SS, TRAFFIC LIGHT=T.L., FLASHING RED BALL-F.R.

TRAFFIC CODES

PARKING RESTRICTIONS: A.M. PEAK, P.M. PEAK, A.M./P.M. PEAK, NO PARKING ANYTIME-N.P., COMM/IND. ACCESS=I

SYSTEM				TRAFFIC		LINE DIAGRAM	TRAFFIC			PAVEMENT DATA
	FUNCT CLASS	HWY SYS	HPMS SAMPLE	PREG. REST.	COM/IND ACCESS		CONTROL	COM/IND ACCESS	PREG. REST.	
	Urban Local					D E CUL 0 06 SAC				
						HUNTLEY DRIVE @.15 CO 0 00 644	55			20'I 2UML

COUNTY _____ ROAD NO. _____ PAGE ___ OF ___

SYSTEM				TRAFFIC		LINE DIAGRAM	TRAFFIC			PAVEMENT DATA
FUNCT CLASS	HWY SYS	NHS	SAMPLE	PREG REST	COM/IND ACCESS		OTHER	COM/IND ACCESS	PREG. REST.	

SHA 51.3 - 8 Revised
4.83

MARYLAND STATE HIGHWAY ADMINISTRATION

ROAD INVENTORY SHEET

67-01
01/17/02
SS/WP
(66-01)
64-01
65-01

Party Chief S. Snyder
Recorder W. Plew
Assistant
Map No./Dir. D12C / S
State Coordinates 863-512

Road No. CO 3221
Road Name BRITTON LANE
County HOWARD
Date 01/17/02
Sheet No. 1 OF 2

TRAFFIC CODES
TRAFFIC CONTROLS: STOP SIGN-SS, SIGNAL-S
TRAFFIC LIGHT-T.L.,
FLASHING RED BALL-F.R.

TRAFFIC CODES
PARKING RESTRICTIONS: A.M. PEAK, P.M. PEAK, A.M./P.M. PEAK, NO PARKING ANYTIME-N.P., COMM/IND. ACCESS=I

SYSTEM				TRAFFIC		LINE DIAGRAM	TRAFFIC			PAVEMENT DATA
	FUNCT CLASS	HWY SYS	NHS/STRAHNET	PREG. REST.	COMM/IND ACCESS		CONTROL	COMM/IND ACCESS	PREG. REST.	
						@ 1.00 BRADY COURT				
						0 25 CO 3222 (64-01)				
						BORDEAUX COVE				
						0 19				
						PT 0 17				
	Urban Local					60°				
						PC 0 11				
						(30° 0 04				26'I
										I-CC
										2 UNL
						@ 0.05 WHARFF LANE				
	K					CO 0 00 344 (66-01)	65			Y

COUNTY Howard ROAD NO. 3221 PAGE 2 OF 2

SYSTEM				TRAFFIC		LINE DIAGRAM	TRAFFIC				PAVEMENT DATA
FUNCT CLASS	HWY SYS	NHS	STRAHNET	PREG RESI	COM/IND ACCESS		CONSTR	COM/IND ACCESS	PREG RESI		

SHA 51.3 - 8 Revised
4.83

64-01
67-01
1/17/02
SS/WP

MARYLAND STATE HIGHWAY ADMINISTRATION

ROAD INVENTORY SHEET

Party Chief S. Snyder
Recorder W Plew
Assistant
Map No./Dir. D12C / N
State Coordinates 863-512

Road No. CO 3222
Road Name BRADY COURT
County HOWARD
Date 1/17/02
Sheet No. 1 OF 1

TRAFFIC CODES

TRAFFIC CONTROLS: STOP SIGN-SS, TRAFFIC LIGHT-T.L., FLASHING RED BALL-F.R.

TRAFFIC CODES

PARKING RESTRICTIONS: A.M. PEAK, P.M. PEAK, A.M./P.M. PEAK, NO PARKING ANYTIME-N.P., COMM/RESID. ACCESS-E

SYSTEM				TRAFFIC		LINE DIAGRAM	TRAFFIC			PAVEMENT DATA
	FUNCT CLASS	HWY SYS	HPMS SAMPLE	PREG. REST.	COMM/IND ACCESS		CONTROL	COMM/IND ACCESS	PREG. REST.	
	Urban Local					D E CUL 0 07 SAC				24'I Ic-c 2UML
						BRITTEN CO LANE 0 00 3221 (67-01) BAS	55			

COUNTY _____ ROAD NO. _____ PAGE ___ OF ___

SYSTEM				TRAFFIC		LINE DIAGRAM	TRAFFIC				PAVEMENT DATA
	FUNCT CLASS	HWY SYS	NHS SAMPLE	PRES. RESI	COM/IND ACCESS		X-TRFFC	COM/IND ACCESS	PRES. RESI.		

SHA 51.3 - 8 Revised
4.83

65-01
67-01
68-01
6 9-01
1/17/02
SS/WP

MARYLAND STATE HIGHWAY ADMINISTRATION

ROAD INVENTORY SHEET

Party Chief S.Snyder
Recorder W. Plews
Assistant
Map No./Dir. D12C / N
State Coordinates 862-512

Road No. CO 3223
Road Name CRESTWOOD LANE
County HOWARD
Date 1/17/02
Sheet No. 1 OF 1

TRAFFIC CODES
TRAFFIC CONTROLS: STOP SIGN-SS, TRAFFIC LIGHT-T.L., FLASHING RED BALL-F.R.

TRAFFIC CODES
PARKING RESTRICTIONS: A.M. PEAK, P.M. PEAK, A.M./P.M. PEAK, NO PARKING ANYTIME-N.P., COMM/IND. ACCESS=I

SYSTEM				TRAFFIC		LINE DIAGRAM	TRAFFIC			PAVEMENT DATA
	FUNCT CLASS	HWY SYS	HPMS SAMPLE	PREG. REST.	COM/IND ACCESS		CONTROL	COM/IND ACCESS	PREG. REST.	
						BRITTEN LANE @.35				
						CO 043 3221 (67-01)				
						PT 025				
	Urban Local					60°				
						PC 017				
						008 30°				
										26'I
										IC-C
										2 UML
						ROCHESTER ROAD CO 000 273 @.75 (68-01, 69-01)	SS			

COUNTY _____ ROAD NO. _____ PAGE ___ OF _____

SYSTEM				TRAFFIC		LINE DIAGRAM	TRAFFIC			PAVEMENT DATA
FUNCT CLASS	HWY SYS	NHS	STATE HWY	PRES	COM/IND ACCESS		CONFIG	COM/IND ACCESS	PRES. REST.	

52-01
53-01

SHA 51.3 - 8 Revised
4.83

MARYLAND STATE HIGHWAY ADMINISTRATION

ROAD INVENTORY SHEET

Party Chief S. Snyder
Recorder W. Plew
Assistant
Map No./Dir. D12C / N
State Coordinates 867-503

Road No. CO 3224
Road Name PARKVIEW COURT
County HOWARD
Date 1/18/02
Sheet No. 1 OF 1

TRAFFIC CODES
TRAFFIC CONTROLS: STOP SIGN-SS, TRAFFIC LIGHT=T.L., FLASHING RED BALL-F.R.

TRAFFIC CODES
PARKING RESTRICTIONS: A.M. PEAK, P.M. PEAK, A.M./P.M. PEAK, NO PARKING ANYTIME-N.P., COMM/IND. ACCESS=I

SYSTEM				TRAFFIC		LINE DIAGRAM	TRAFFIC			PAVEMENT DATA
	FUNCT CLASS	HWY SYS	NHS/S SAMPLE	PREG. REST.	COM/IND ACCESS		CONTROL	COM/IND ACCESS	PREG. REST.	
						D E				
	Urban Local					CUL 0 16 SAC				24'T
										IC-C
										2UML
						CO MONTGOMERY RD @1.18				
						0 00 136 (53-01)	53			

COUNTY _____ ROAD NO. _____ PAGE ___ OF ___

SYSTEM				TRAFFIC		LINE DIAGRAM	TRAFFIC				PAVEMENT DATA
FUNCT CLASS	HWY SYS	NHS	STATE HIGHWAY	PRES EST	COM/IND ACCESS		CHURCH	COM/IND ACCESS	PRES. EST.		

SHA 51.3 - 8 Revised
4.83

87-01
1/17/02
SS/WP

MARYLAND STATE HIGHWAY ADMINISTRATION

ROAD INVENTORY SHEET

Party Chief S. Snyder
Recorder W. Plew
Assistant
Map No./Dir. D12C / W
State Coordinates 875-499

Road No. CO 3225
Road Name ELDERBERRY COURT
County HOWARD
Date 1/17/02
Sheet No. 1 OF 1

TRAFFIC CODES

TRAFFIC CONTROLS: STOP SIGN-SS, TRAFFIC LIGHT-T.L., FLASHING RED BALL-F.R.

TRAFFIC CODES

PARKING RESTRICTIONS: A.M. PEAK, P.M. PEAK, A.M./P.M. PEAK, NO PARKING ANYTIME-N.P., COMM/IND. ACCESS=I

SYSTEM				TRAFFIC		LINE DIAGRAM	TRAFFIC			PAVEMENT DATA
	FUNCT CLASS	HWY. SYS	NHS SAMPLE	PREG. REST.	COM/IND ACCESS		CONTROL	COM/IND ACCESS	PREG. REST.	
						D E				
						CUL O 14 SAC				
						PT O 11				
						30°				
						PC O 09				
						PT O 07				
						35°				24'I
						PC O 02				IC-C
										2UML
						ROWANBERRY DRIVE @.69				
						CO O 00 2188	SS			

Urban Local

COUNTY _____ ROAD NO. _____ PAGE ___ OF ___

SYSTEM				TRAFFIC		LINE DIAGRAM	TRAFFIC				PAVEMENT DATA
FUNCT CLASS	HWY SYS	NHS	STATE	PRES	COM/IND ACCESS		% CHG	COM/IND ACCESS	PRES.		

SHA 51.3 - 8 Revised
4.83

88-01
01/11/02
SS/WP

MARYLAND STATE HIGHWAY ADMINISTRATION

ROAD INVENTORY SHEET

Party Chief S. Snyder
Recorder W. Plews
Assistant
Map No./Dir. E11B / W
State Coordinates 824-487

Road No. CO 3226
Road Name Janney CT
County Howard
Date 01/11/02
Sheet No. 1 OF 1

TRAFFIC CODES

TRAFFIC CONTROLS: STOP SIGN-SS, TRAFFIC LIGHT=T.L., FLASHING RED BALL-F.R.

PARKING RESTRICTIONS: A.M. PEAK, P.M. PEAK, A.M./P.M. PEAK, NO PARKING ANYTIME-N.P., COMM/IND. ACCESS=I

SYSTEM				TRAFFIC		LINE DIAGRAM	TRAFFIC			PAVEMENT DATA
	FUNCT CLASS	HWY SYS	NHS SAMPLE	PREG. REST.	COM/IND ACCESS		CONTROL	COM/IND ACCESS	PREG. REST.	
	Rural Local					D E CUL 0 20 SAC 0 18 TT 90° 0 10 PC PINDELL SCHOOL RD @1.50 CO 0 00 93 TOWNS HOPKINS RD CO 1 09 @4.23	SS			19'I 2UML

COUNTY _____ ROAD NO. _____ PAGE ___ OF ___

SYSTEM				TRAFFIC		LINE DIAGRAM	TRAFFIC				PAVEMENT DATA
FUNCT CLASS	HWY SYS	HPMS SAMPLE		PREG REST	COMMND ACCESS		CHARG	COMMND ACCESS	PREG REST		

SHA 51.3 - 8 Revised
4.83

96-01
95-01
01-11-02
SS/WP

MARYLAND STATE HIGHWAY ADMINISTRATION

ROAD INVENTORY SHEET

Party Chief S. Snyder
Recorder W. Pew
Assistant
Map No./Dir. E11B / N
State Coordinates 820-478

Road No. ~~OR 16~~ CO 3227
Road Name HUNTERBROOKE LANE
County HOWARD
Date 01-11-02
Sheet No. 1 OF 2

TRAFFIC CODES
TRAFFIC CONTROLS: STOP SIGN-SS, TRAFFIC LIGHT-T.L., FLASHING RED BALL-F.R.

TRAFFIC CODES
PARKING RESTRICTIONS: A.M. PEAK, P.M. PEAK, A.M./P.M. PEAK, NO PARKING ANYTIME-N.P., COMM/IND. ACCESS=I

SYSTEM				TRAFFIC		LINE DIAGRAM	TRAFFIC			PAVEMENT DATA
	FUNCT CLASS	HWY SYS	HPMS SAMPLE	PREG. REST.	COM/IND ACCESS		CONTROL	COM/IND ACCESS	PREG. REST.	
						PT 0 39				
						HUNTFIELD DRIVE				
						CO 3228 (95-01) 0 34				
						35°				
						PRC 0 29 PRC				20'I
										2UML
						0 27			X	
						45°				
						0 24 PC				
										20'I
										IC-RT
										2UML
						0 18			X	
										22'I
						Lime Kiln RD				2UML
K						CO 0 00 88 @225			Y	

RURAL LOCAL

COUNTY HOWARD ROAD NO. ~~OPTS~~ CO 3227 PAGE 2 OF 2

SYSTEM			TRAFFIC		LINE DIAGRAM	TRAFFIC			PAVEMENT DATA
FUNCT CLASS	HWY SYS	HPMS SAMPLE	PREG REST	CNTRL ACCESS		X-CNTRLD	COM/IND ACCESS	PREG. REST.	
Rural Local					BARRICADE 043				20'-I 2 LANE

SHA 51.3 - 8 Revised
4.83

95-01
01/11/02
53/107

MARYLAND STATE HIGHWAY ADMINISTRATION

ROAD INVENTORY SHEET

Party Chief S. Snyder
Recorder W. Aeu
Assistant
Map No./Dir. E11B / E
State Coordinates 820-478

Road No. CO 3228
Road Name HUNTFIELD DRIVE
County HOWARD
Date 01/11/02
Sheet No. 1 OF 1

TRAFFIC CODES
TRAFFIC CONTROLS: STOP SIGN-SS, TRAFFIC LIGHT=T.L., FLASHING RED BALL-F.R.

TRAFFIC CODES
PARKING RESTRICTIONS: A.M. PEAK, P.M. PEAK, A.M./P.M. PEAK, NO PARKING ANYTIME-N.P., COMM/IND. ACCESS=I

SYSTEM			TRAFFIC		LINE DIAGRAM	TRAFFIC			PAVEMENT DATA
FUNCT CLASS	HWY SYS	HPMS SAMPLE	PKG. REST.	COM/IND ACCESS		CONTROL	COM/IND ACCESS	PKG. REST.	
					BARRI CADE XX XX				
					0 28				
					PT 0 21				
Rural Local					80°				
					PC 0 11				22'I 2UML
					HUNTERBROOKE LANE CO 0 0 0 3209 (96-01) @-34	SS			

COUNTY _____ ROAD NO. _____ PAGE ___ OF ___

SYSTEM				TRAFFIC		LINE DIAGRAM	TRAFFIC			PAVEMENT DATA
FUNCT CLASS	HWY SYS	HPMS SAMPLE		PRES. REST	CONF/UNC ACCESS		CONTROL	CONF/UNC ACCESS	PRES. REST.	

99-01
78-01
1/17/02
SS/WP

SHA 51.3 - 8 Revised
4.83

MARYLAND STATE HIGHWAY ADMINISTRATION

ROAD INVENTORY SHEET

Party Chief S-Snyder
Recorder W. Plew
Assistant
Map No./Dir. E-11B / W
State Coordinates 844-472

Road No. CO 3229
Road Name OVERTON DRIVE
County HOWARD
Date 1/17/02
Sheet No. 1 OF 1

TRAFFIC CODES
TRAFFIC CONTROLS: STOP SIGN-SS, TRAFFIC LIGHT=T.L., FLASHING RED BALL-F.R.

TRAFFIC CODES
PARKING RESTRICTIONS: A.M. PEAK, P.M. PEAK, A.M./P.M. PEAK, NO PARKING ANYTIME-N.P., COMM/IND. ACCESS=I

SYSTEM: FUNCT CLASS	SYSTEM: HWY SYS	SYSTEM: HPMS SAMPLE	TRAFFIC: PREG. REST.	TRAFFIC: COMM/IND ACCESS	LINE DIAGRAM	TRAFFIC: CONTROL	TRAFFIC: COMM/IND ACCESS	TRAFFIC: PREG. REST.	PAVEMENT DATA
					D E				
					CUL O 13 SAC				
					ODELTON @0.00 COURT				
					CO 3230 (98-01) O 05				24'I
									JC-C
									2UML
					CHATON ROAD @0.09				
K					CO O 00 2782	SS			
K	Urban Local								

COUNTY _____ ROAD NO. _____ PAGE ___ OF ___

SYSTEM				TRAFFIC		LINE DIAGRAM	TRAFFIC				PAVEMENT DATA
FUNCT CLASS	HWY SYS	HPMS SAMPLE		PKG REST	OWNING ACCESS		% OTHER	OWNING ACCESS	PKG. REST.		

SHA 51.3 - 8 Revised
4.83

98-01
99-01
1/17/02
55/WT

MARYLAND STATE HIGHWAY ADMINISTRATION

ROAD INVENTORY SHEET

Party Chief J. Snyder
Recorder W. Plew
Assistant
Map No./Dir. 61B / S
State Coordinates 843-472

Road No. CO 3230
Road Name OBERTON COURT
County HOWARD
Date 1/17/02
Sheet No. 1 OF 1

TRAFFIC CODES

TRAFFIC CONTROLS: STOP SIGN-SS, TRAFFIC LIGHT-T.L., FLASHING RED BALL-F.R.

TRAFFIC CODES

PARKING RESTRICTIONS: A.M. PEAK, P.M. PEAK, A.M./P.M. PEAK, NO PARKING ANYTIME-N.P., COMM/IND. ACCESS-I

SYSTEM			TRAFFIC		LINE DIAGRAM	TRAFFIC			PAVEMENT DATA
FUNCT CLASS	HWY SYS	HPMS SAMPLE	PREG. REST.	COM/IND ACCESS		CONTROL	COM/IND ACCESS	PREG. REST.	
					D E				
					CUL 0 05 SAC				
									24'I
									I-C
									2UNL
K Urban Local					OBERTON DRIVE @.05				
					CO 0 00 3229 (99-01)	55			

COUNTY _____ ROAD NO. _____ PAGE ___ OF ___

SYSTEM				TRAFFIC		LINE DIAGRAM	TRAFFIC			PAVEMENT DATA
FUNCT CLASS	HWY SYS	NHS	STATE	PREG RESI	COM/IND ACCESS		CONTROL	COM/IND ACCESS	PREG RESI	

SHA 51.3 - 8 Revised
4.83

100-01
1/17/02
SS/WP

MARYLAND STATE HIGHWAY ADMINISTRATION

ROAD INVENTORY SHEET

Party Chief S. Snyder
Recorder W. Plew
Assistant
Map No./Dir. E11B / E
State Coordinates 844-472

Road No. CO 3231
Road Name ULSTER DRIVE
County HOWARD
Date 1/17/02
Sheet No. 1 OF 1

TRAFFIC CODES

TRAFFIC CONTROLS: STOP SIGN-SS, TRAFFIC LIGHT-T.L., FLASHING RED BALL-F.R.

TRAFFIC CODES

PARKING RESTRICTIONS: A.M. PEAK, P.M. PEAK, A.M./P.M. PEAK, NO PARKING ANYTIME-N.P., COMM/IND. ACCESS=I

SYSTEM				TRAFFIC		LINE DIAGRAM	TRAFFIC			PAVEMENT DATA
	FUNCT CLASS	HWY SYS	HPMS SAMPLE	PREG. REST.	COM/IND ACCESS		CONTROL	COM/IND ACCESS	PREG. REST.	
	K Urban Local					ROAD END 006				24'I IC-C 2UNL
						CHATON ROAD 0.19 CO 000 2782	55			

COUNTY _____ ROAD NO. _____ PAGE ___ OF ___

SYSTEM			TRAFFIC		LINE DIAGRAM	TRAFFIC				PAVEMENT DATA
FUNCT CLASS	HWY SYS	HPMS SAMPLE	PKG DEST	COM/IND ACCESS		CONTROL	COM/IND ACCESS	PKG. DEST.		

SHA 51.3 - 8 Revised
4.83

91-01
1/18/02
SS/WP

MARYLAND STATE HIGHWAY ADMINISTRATION

ROAD INVENTORY SHEET

Party Chief S. Snyder
Recorder W. Plew
Assistant
Map No./Dir. E12A / S
State Coordinates 852-488

Road No. CO 3232
Road Name LEE DEFOREST DRIVE
County HOWARD
Date 1/18/02
Sheet No. 1 OF 1

TRAFFIC CODES
TRAFFIC CONTROLS: STOP SIGN-SS, TRAFFIC LIGHT=T.L., FLASHING RED BALL-F.R.

TRAFFIC CODES
PARKING RESTRICTIONS: A.M. PEAK, P.M. PEAK, A.M./P.M. PEAK, NO PARKING ANYTIME-N.P., COMM/IND. ACCESS=E

SYSTEM			TRAFFIC		LINE DIAGRAM	TRAFFIC			PAVEMENT DATA
FUNCT CLASS	HWY SYS	HPMS SAMPLE	PEEG. RESI.	COM/IND ACCESS		CONTROL	COM/IND ACCESS	PEEG. RESI.	
					BARRICADE				
					0 16				
					ELIAS HOWE DRIVE				
					PVT 0 15				
					PROP 0 09				
Urban Local									38'I
									I c-c
									2 UNL
					FULTON DRIVE @.50				
					ROBERT CO 0 00 2129	55			

COUNTY _____ ROAD NO. _____ PAGE ___ OF ____

SYSTEM				TRAFFIC		LINE DIAGRAM	TRAFFIC				PAVEMENT DATA
	FUNCT CLASS	HWY SYS	NHS YN/PTS	PKG. REST.	COM/IND ACCESS			COM/IND ACCESS	PKG. REST.		

H0-629-509-770
* Conveyed by Deed May 3, 2000.
Transfer Confirmed by Stephen Clarke, ORE 12/9/2002

SR-96

DPSSR-98
BB/SS
4.13.98

SHA 51.3 - 8 Revised 4.83

MARYLAND STATE HIGHWAY ADMINISTRATION

ROAD INVENTORY SHEET Co 3233

Party Chief Lijewski
Recorder Balzanelo
Assistant
Map No./Dir. D12C / NW
State Coordinates 852-515

Road No. ~~MD~~ ~~US~~ ~~X~~
Road Name MEADOWRIDGE LA
County HOWARD
Date 11-21-96
Sheet No. 1 OF 2

ST TO INV 4/19/01 SS/WT

132-02 ST TO Co. Transfer

TRAFFIC CODES
TRAFFIC CONTROLS: STOP SIGN-SS, TRAFFIC LIGHT=T.L., FLASHING RED BALI=F.R.

TRAFFIC CODES
PARKING RESTRICTIONS: A.M. PEAK, P.M. PEAK, A.M./P.M. PEAK, NO PARKING ANYTIME=N.P., COMM/IND. ACCESS=E

SYSTEM: FUNCT CLASS	SYSTEM: HWY. SYS.	SYSTEM: HPMS SAMPLE	TRAFFIC: PREG. REST.	TRAFFIC: COM/IND ACCESS	LINE DIAGRAM	TRAFFIC: CONTROL	TRAFFIC: COM/IND ACCESS	TRAFFIC: PREG. REST.	PAVEMENT DATA
					021 CBC 2 cells 15' DEEP 70' LENGTH 20' WIDTH				24'I
									10' ISHD LT
									3' ISHD RT 2ML
					019 30MPH			X	
					017 PT SIGN: END STATE MAINT.				24'I 4' ISHD RT 10' I SHD LT
					016 SPUR TO Park & Ride 80°				2ML
					014			X	
			E		TO Park & Ride 009 PC				
					007 PT 10' H LT LA.				
					005 60°				
					002 PC				24'I
									2-10'I SHDS
									2ML
					Exit Ft. Park & Ride — LONG GATE PKWY				
					000	55		V	
					MD 100 J e.43				
					Ramp #5 Ramp #6 Ramp #3				

Co 3233

COUNTY Howard ROAD NO. ~~MD 100K~~ PAGE 2 OF 2

SYSTEM			TRAFFIC		LINE DIAGRAM	TRAFFIC				PAVEMENT DATA
FUNCT. CLASS	HWY SYS.	HPMS SAMPLE	PREG. REST.	COM/IND ACCESS		F. CONFIG	COM/IND ACCESS	PREG. REST.		
					SYBERT DRIVE					
					Co 103 40 @.29	SS				
					086 PT					
					076 CBC 1cell 10' DEEP 80' Length 14' width					
					180°					
					028 PC					24'I 10'I SHD LT 3'I SHD RT 2ML

Howard County

HO-6211-96

SHA 51.3 - 8 Revised 4.83

MARYLAND STATE HIGHWAY ADMINISTRATION

ROAD INVENTORY SHEET CO 3234

97-3
97-4 ST.

Party Chief AL
Recorder AP
Assistant
Map No./Dir. D11B / S
State Coordinates 835 - 539

Road No. ~~OF 1039~~
Road Name DORCHESTER WAY
County HOWARD
Date 12-23-97
Sheet No. 1 OF 1

18-02

TRAFFIC CODES
TRAFFIC CONTROLS: STOP SIGN-SS, TRAFFIC LIGHT=T.L., FLASHING RED BALL=F.R.

TRAFFIC CODES
PARKING RESTRICTIONS: A.M. PEAK, P.M. PEAK, A.M./P.M. PEAK, NO PARKING ANYTIME=N.P., COMM/IND. ACCESS=E

SYSTEM				TRAFFIC		LINE DIAGRAM	TRAFFIC			PAVEMENT DATA
FUNCT CLASS	HWY. SYS	HPMS SAMPLE		PREG. REST.	COM/IND ACCESS		CONTROL	COM/IND ACCESS	PREG. REST.	
						PROP.				
						BIRMINGHAM WAY				
						PT 0 59				
						35°				
						PC 0 48				
						0 47				
						PETERSBORO ROAD				
						0 41				
						PT 0 36				
						120°				
						PC 0 18				
						0 15				
						PT 30° PC				
						0 10				
						CHESHAM WAY				36' I
						0 08				J C-C
										2 UNL
						⊙4.29				
						MD 0 00 99				

COUNTY _____ ROAD NO. _____ PAGE ___ OF ___

SYSTEM				TRAFFIC			LINE DIAGRAM	TRAFFIC				PAVEMENT DATA
	FUNCT CLASS	HWY SYS	NHS SAMPLE	PREG	RESTR	OWNERSHIP ACCESS		% OVERSIZE	% OWNERSHIP	ACCESS	PREG. RESTR.	

SHA 51.3 - 8 Revised
4.83

MARYLAND STATE HIGHWAY ADMINISTRATION

ROAD INVENTORY SHEET

97-8 ST

Party Chief AL
Recorder AP
Assistant —
Map No./Dir. D 11 D / N
State Coordinates 822 - 493

Road No. ~~OP / 1041~~ CO 3235
Road Name BERRY WOOD COURT
County HOWARD
Date 12-29-97
Sheet No. 1 OF 1

66 02

TRAFFIC CODES

TRAFFIC CONTROLS: STOP SIGN-SS, TRAFFIC LIGHT=T.L., FLASHING RED BALL=F.R.

TRAFFIC CODES

PARKING RESTRICTIONS: A.M. PEAK, P.M. PEAK, A.M./P.M. PEAK, NO PARKING ANYTIME=N.P., COMM/IND. ACCESS=E

SYSTEM				TRAFFIC		LINE DIAGRAM	TRAFFIC			PAVEMENT DATA
FUNCT CLASS	HWY. SYS	HPMS SAMPLE	PEAK REST.	COM/IND ACCESS			CONTROL	COM/IND ACCESS	PEAK REST.	
						ROAD END.				
					0 09					
					0 05	PT				
						MYSTIC WOODS WAY				
					0 04	90°				
										20'T
										JC-C
					0 02	PC				2 UNL
						GUILFORD				
					0 00	~~RD~~ ROAD. ~~RD~~ 2964				
						~~RD~~ CO				

COUNTY _____ ROAD NO. _____ PAGE ___ OF ___

SYSTEM				TRAFFIC					TRAFFIC				PAVEMENT DATA
	FUNCT. CLASS	HWY SYS	HPMS SAMPLE		PREG	RESI	COM/IND	ACCESS	% CH'BRGN	% COM/IND	ACCESS	PREG. RESI.	

LINE DIAGRAM

SHA 51.3 - 8 Revised
4.83

Balto Urban

MARYLAND STATE HIGHWAY ADMINISTRATION

6-00C010
SS/19
1-3-01

ROAD INVENTORY SHEET

Party Chief S. SNYDER
Recorder A. Quattrochi
Assistant
Map No./Dir. D12A / N
State Coordinates 852 - 534

Road No. ~~OP~~ ~~1105~~ CO 3236
Road Name GAITHER HOLLOW COURT
County HOWARD
Date 1-3-01
Sheet No. 1 OF 1

38-02

TRAFFIC CODES

TRAFFIC CONTROLS: STOP SIGN=SSy
TRAFFIC LIGHT=T.L.,
FLASHING RED BALL=F.R.

TRAFFIC CODES

PARKING RESTRICTIONS: A.M. PEAK,
P.M. PEAK, A.M./P.M. PEAK, NO PARKING
ANYTIME=N.P., COMM/IND. ACCESS=E

SYSTEM				TRAFFIC		LINE DIAGRAM	TRAFFIC			PAVEMENT DATA
FED. AID.	FUNCT CLASS.	HWY. SYS.	HPMS SAMPLE	PRK.G. REST.	COM/IND. ACCESS		CONTROL	COM/IND. ACCESS	PRK.G. REST.	
						DE				
	^					CUL 005 SAC			^	
	local									
	urban									24' & I
										JC-C
										2UML
						MILLERS WAY DRIVE @ 0.0				
	v					~~OP~~ CO ~~1104~~ 3238 0 00			v	
						STONEHOUSE DRIVE @ 0.0 CO ~~1095~~ 37 ~~1095~~ 31 CO				

SYSTEM				TRAFFIC		LINE DIAGRAM	TRAFFIC				PAVEMENT DATA
FED. AID.	FUNCT. CLASS.	HWY. SYS.	HPMS SAMPLE	PRK.G. REST.	COM/IND ACCESS		CONTROL	COM/IND ACCESS	PRK.G. REST.		

SHA 51.3 - 8 Revised
4.83

Balto Urban

MARYLAND STATE HIGHWAY ADMINISTRATION

6-00C08
SS/AQ
1-3-01

ROAD INVENTORY SHEET

Party Chief S. SNYDER
Recorder A. Quattrochi
Assistant
Map No./Dir. D12A/N
State Coordinates 852-534

Road No. ~~OP~~ ~~1103~~ CO 3237
Road Name HOWARD RUN DRIVE
County HOWARD
Date 1-3-01
Sheet No. 1 OF

32-02

SYSTEM				TRAFFIC		LINE DIAGRAM	TRAFFIC			PAVEMENT DATA
FED. AID.	FUNCT. CLASS.	HWY. SYS.	HPMS SAMPLE	PRKG. REST.	COM/IND. ACCESS		CONTROL	COM/IND. ACCESS	PRKG. REST.	
						STONEHOUSE DRIVE				
						~~OP~~ CO 005 3137 ~~1095~~ @.05	SS			
	1									24'I
										JC-C
										2UML
	K	urban	local			OLD FREDERICK ROAD 271 @.20				
						CO 000	SS			

TRAFFIC CODES

TRAFFIC CONTROLS: STOP SIGN=SS, TRAFFIC LIGHT=T.L., FLASHING RED BALL=F.R.

TRAFFIC CODES

PARKING RESTRICTIONS: A.M. PEAK, P.M. PEAK, A.M./P.M. PEAK, NO PARKING ANYTIME=N.P., COMM/IND. ACCESS=E

SYSTEM				TRAFFIC		LINE DIAGRAM	TRAFFIC				PAVEMENT DATA
FED. AID.	FUNCT. CLASS.	HWY. SYS.	HPMS SAMPLE	PRK.G. REST.	COM/IND ACCESS		CONTROL	COM/IND ACCESS	PRK.G. REST.		

SHA 51.3 - 8 Revised
4.83

Balto Urban

MARYLAND STATE HIGHWAY ADMINISTRATION

6-00009
SS/AG
1-3-01

ROAD INVENTORY SHEET

Party Chief S. SNYDER
Recorder A. Quattrochi
Assistant
Map No./Dir. D12A / W
State Coordinates 852 - 534

Road No. ~~OP~~ CO ~~1104~~ 3238
Road Name MILLERS WAY DRIVE
County HOWARD
Date 1-3-01
Sheet No. 1 OF 2

39-02

TRAFFIC CODES

TRAFFIC CONTROLS: STOP SIGN=SS, TRAFFIC LIGHT=T.L., FLASHING RED BALL=F.R.

TRAFFIC CODES

PARKING RESTRICTIONS: A.M. PEAK, P.M. PEAK, A.M./P.M. PEAK, NO PARKING ANYTIME=N.P., COMM/IND. ACCESS=E

SYSTEM: FED. AID.	SYSTEM: FUNCT. CLASS.	SYSTEM: HWY. SYS.	SYSTEM: HPMS SAMPLE	TRAFFIC: PRK.G. REST.	TRAFFIC: COM/IND. ACCESS	LINE DIAGRAM	TRAFFIC: CONTROL	TRAFFIC: COM/IND. ACCESS	TRAFFIC: PRK.G. REST.	PAVEMENT DATA
						DORSEY SPRING COURT				
						CO ~~OP~~ 3239 ~~1106~~ 0 36				
						PT 0 34				
						130°				
						PC 0 25				
						0 19 PT				
						45°				
						0 15 PC				
	Urban local									
						PT 0 05				
						40°				
						PC 0 01				24' & I
										JC-C
										2UML
						@0.00 STONEHOUSE DRIVE GAITHER HOLLOW COURT				
V						~~OP~~ CO ~~1095~~ 3137 0 00 ~~OP~~ CO ~~1105~~ 3236 @0.00	SS		V	

~~OP1104~~ 2 of 2

SYSTEM				TRAFFIC		LINE DIAGRAM	TRAFFIC			PAVEMENT DATA
FED. AID.	FUNCT. CLASS.	HWY. SYS.	HPMS SAMPLE	PRK.G. REST.	COM/IND ACCESS		CONTROL	COM/IND ACCESS	PRK.G. REST.	
	Urban local					ROAD END 049				24' G JC-C 2UML

SHA 51.3 - 8 Revised
4.83

Balto Urban

MARYLAND STATE HIGHWAY ADMINISTRATION

6-00011
SS/AQ
1-3-01

ROAD INVENTORY SHEET

Party Chief S. SNYDER
Recorder A Quattrochi
Assistant
Map No./Dir. D12 A / S
State Coordinates 852-534

Road No. ~~OP 11010~~ CO 3239
Road Name DORSEY SPRING COURT
County HOWARD
Date 1-3-01
Sheet No. 1 OF 1

40-02

TRAFFIC CODES
TRAFFIC CONTROLS: STOP SIGN=SS, TRAFFIC LIGHT=T.L., FLASHING RED BALL=F.R.

TRAFFIC CODES
PARKING RESTRICTIONS: A.M. PEAK, P.M. PEAK, A.M./P.M. PEAK, NO PARKING ANYTIME=N.P., COMM/IND. ACCESS=E

SYSTEM				TRAFFIC		LINE DIAGRAM	TRAFFIC			PAVEMENT DATA
FED. AID.	FUNCT. CLASS.	HWY. SYS.	HPMS SAMPLE	PRKG. REST.	COM/IND. ACCESS		CONTROL	COM/IND. ACCESS	PRKG. REST.	
						D E				
						CUL 005 SAC				
	urban local									24' I
										J C-C
										2 UML
						MILLERS WAY DRIVE				
						~~OP~~ CO 000 ~~1104~~ 3238	SS			

SYSTEM				TRAFFIC		LINE DIAGRAM	TRAFFIC				PAVEMENT DATA
FED. AID.	FUNCT. CLASS.	HWY. SYS.	HPMS SAMPLE	PRK.G. REST.	COM/IND ACCESS		CONTROL	COM/IND ACCESS	PRK.G. REST.		

SHA 51.3 - 8 Revised
4.83

Balto Urban

MARYLAND STATE HIGHWAY ADMINISTRATION

6-00C07
SS/AQ
1-3-01

ROAD INVENTORY SHEET

Party Chief S. SNYDER
Recorder A. Quattrochi
Assistant
Map No./Dir. D12A / W
State Coordinates 852-534

Road No. ~~OP~~ ~~1102~~ C03240
Road Name STONE HOLLOW COURT
County HOWARD
Date 1-3-01
Sheet No. 1 OF 1

35-02

SYSTEM				TRAFFIC		LINE DIAGRAM	TRAFFIC			PAVEMENT DATA
FED. AID.	FUNCT CLASS.	HWY. SYS.	HPMS SAMPLE	PRKG. REST.	COM/IND. ACCESS		CONTROL	COM/IND. ACCESS	PRKG. REST.	

SYSTEM				TRAFFIC		LINE DIAGRAM	TRAFFIC			PAVEMENT DATA
FED. AID.	FUNCT. CLASS.	HWY. SYS.	HPMS SAMPLE	PRK.G. REST.	COM/IND ACCESS		CONTROL	COM/IND ACCESS	PRK.G. REST.	

SHA 51.3 - 8 Revised 4.83

Balto Urban

MARYLAND STATE HIGHWAY ADMINISTRATION

6-00C01
55/10
1-3-01

ROAD INVENTORY SHEET

Party Chief S. SNYDER
Recorder A. Quattrochi
Assistant
Map No./Dir. D12A / S
State Coordinates 852-534

Road No. ~~OP~~ CO ~~1096~~ 3241
Road Name WATER WHEEL COURT
County HOWARD
Date 1-3-01
Sheet No. 1 OF 1

29-02

TRAFFIC CODES

TRAFFIC CONTROLS: STOP SIGN-SS, TRAFFIC LIGHT=T.L., FLASHING RED BALL=F.R.

TRAFFIC CODES

PARKING RESTRICTIONS: A.M. PEAK, P.M. PEAK, A.M./P.M. PEAK, NO PARKING ANYTIME=N.P., COMM/IND. ACCESS=E

SYSTEM				TRAFFIC		LINE DIAGRAM	TRAFFIC			PAVEMENT DATA
	FUNCT CLASS	HWY. SYS.	HPMS SAMPLE	PKG. REST.	COM/IND ACCESS		CONTROL	COM/IND ACCESS	PKG. REST.	
						D E				
						CUL 007 SAC				
						PT 004				
						35°				
						PC 002				
										24' I
										JC-C
										2UML
						STONEHOUSE DRIVE @.23				
						~~OP~~ CO 000 ~~1095~~ 3137	SS			
						CARROL WIND DRIVE OP CO 32 42 ~~70 97~~ 2.00				

COUNTY _____ ROAD NO. _____ PAGE ___ OF ___

SYSTEM				TRAFFIC			LINE DIAGRAM	TRAFFIC			PAVEMENT DATA
FUNCT. CLASS	HWY SYS	HPMS SAMPLE		PAVG. RESF.	COM/IND ACCESS			CONFIG	COM/IND ACCESS	PAVG. RESF.	

SHA 51.3 - 8 Revised 4.83

Balto Urban

6-0002
SS/AQ
1-3-01

MARYLAND STATE HIGHWAY ADMINISTRATION

ROAD INVENTORY SHEET

Party Chief S. SNYDER
Recorder A. Quattrochi
Assistant
Map No./Dir. D12 A/ N
State Coordinates 852 - 534

Road No. ~~OP~~ CO ~~1097~~ 3242
Road Name CARROLL WIND DRIVE
County HOWARD
Date 1-3-01
Sheet No. 1 OF 2

30-02

TRAFFIC CODES
TRAFFIC CONTROLS: STOP SIGN=SS, TRAFFIC LIGHT=T.L., FLASHING RED BALL=F.R.

TRAFFIC CODES
PARKING RESTRICTIONS: A.M. PEAK, P.M. PEAK, A.M./P.M. PEAK, NO PARKING ANYTIME=N.P., COMM/IND. ACCESS=E

SYSTEM				TRAFFIC		LINE DIAGRAM	TRAFFIC			PAVEMENT DATA
	FUNCT CLASS	HWY. SYS.	HPMS SAMPLE	PKG. REST.	COM/IND ACCESS		CONTROL	COM/IND ACCESS	PKG. REST.	
						PT 0 19				
						MILLDAM COURT				
						50° 0 18 ~~OP~~ CO ~~1107~~ 3246				
						PC 0 15				
						LAWRENCE MILL COURT				
						~~OP~~ CO 3245 ~~1100~~ 0 13				
						PT 0 12				
						WATKINS RUN COURT UNION MILLS COURT				
						CO ~~OP~~ 3244 ~~1098~~ 0 08 CO ~~OP~~ 3243 ~~1099~~				
						80°				
						PC 0 06				
	Urban local									24' I
										Jc-c
						STONEHOUSE DRIVE				2UML
K						~~OP~~ CO 0 00 ~~1095~~ 3137	SS			V
						WATER WHEEL COURT				
						~~OP~~ CO ~~1096~~ 3241				

COUNTY HOWARD ROAD NO. OP 1097 PAGE 2 OF 3

SYSTEM				TRAFFIC		LINE DIAGRAM	TRAFFIC			PAVEMENT DATA
	FUNCT. CLASS	HWY SYS	HPMS SAMPLE	PAVG. REST.	CONF/INTL ACCESS		CONFIG	CONF/INTL ACCESS	PAVG. REST.	
urban local						D E CUL 0 22 SAC				24I JC-C 2UML

SHA 51.3 - 8 Revised
4.83

Balto Urban

MARYLAND STATE HIGHWAY ADMINISTRATION

6-00 C04
SS/AQ
1-3-01

ROAD INVENTORY SHEET

Party Chief S. SNYDER
Recorder A Quattrochi
Assistant
Map No./Dir. D12A / E
State Coordinates 852 - 534

Road No. ~~OP 1099~~ CO 3243
Road Name UNION MILLS COURT
County HOWARD
Date 1-3-01
Sheet No. 1 OF 1

34-02

SYSTEM				TRAFFIC		LINE DIAGRAM	TRAFFIC			PAVEMENT DATA
FED. AID.	FUNCT. CLASS.	HWY. SYS.	HPMS SAMPLE	PRKG. REST.	COM/IND. ACCESS		CONTROL	COM/IND. ACCESS	PRKG. REST.	
	7									

SYSTEM				TRAFFIC		LINE DIAGRAM	TRAFFIC				PAVEMENT DATA
FED. AID.	FUNCT. CLASS.	HWY. SYS.	HPMS SAMPLE	PRK.G. REST.	COM/IND ACCESS		CONTROL	COM/IND ACCESS	PRK.G. REST.		

SHA 51.3 - 8 Revised
4.83

Balto Urban

MARYLAND STATE HIGHWAY ADMINISTRATION

6-00C03
SS/AQ
1-3-01

ROAD INVENTORY SHEET

Party Chief S. SNYDER
Recorder A. Quattrochi
Assistant
Map No./Dir. D12A / N
State Coordinates 852 - 534

Road No. ~~CO~~ ~~1098~~ CO 3244
Road Name WATKINS RUN COURT
County HOWARD
Date 1-3-01
Sheet No. 1 OF 1

31.02

TRAFFIC CODES

TRAFFIC CONTROLS: STOP SIGN=SS, TRAFFIC LIGHT=T.L., FLASHING RED BALL=F.R.

TRAFFIC CODES

PARKING RESTRICTIONS: A.M. PEAK, P.M. PEAK, A.M./P.M. PEAK, NO PARKING ANYTIME=N.P., COMM/IND. ACCESS=E

SYSTEM				TRAFFIC		LINE DIAGRAM	TRAFFIC			PAVEMENT DATA
FED. AID.	FUNCT CLASS.	HWY. SYS.	HPMS SAMPLE	PRKG. REST.	COM/IND. ACCESS		CONTROL	COM/IND. ACCESS	PRKG. REST.	
	K urban local					D E CUL 006 SAC PT 003 35° PC 001 CARROLL WIND 000 3242 1097 DRIVE OF CO UNION MILLS COURT 43 30 1097 OF CO	SS			24' D JC-C 2UML

SYSTEM				TRAFFIC		LINE DIAGRAM	TRAFFIC			PAVEMENT DATA
FED. AID.	FUNCT. CLASS.	HWY. SYS.	HPMS SAMPLE	PRK.G. REST.	COM/IND ACCESS		CONTROL	COM/IND ACCESS	PRK.G. REST.	

SHA 51.3 - 8 Revised
4.83

Balto Urban

MARYLAND STATE HIGHWAY ADMINISTRATION

6-00505
SS/AQ
1-3-01

ROAD INVENTORY SHEET

Party Chief S. SNYDER
Recorder A. Quattrochi
Assistant
Map No./Dir. D12A / W
State Coordinates 852 - 534

Road No. ~~OP H00~~ CO 3245
Road Name LAWRENCE MILL COURT
County HOWARD
Date 1-3-01
Sheet No. 1 OF 1

37 02

TRAFFIC CODES

TRAFFIC CONTROLS: STOP SIGN=SS, TRAFFIC LIGHT=T.L., FLASHING RED BALL=F.R.

TRAFFIC CODES

PARKING RESTRICTIONS: A.M. PEAK, P.M. PEAK, A.M./P.M. PEAK, NO PARKING ANYTIME=N.P., COMM/IND. ACCESS=E

SYSTEM				TRAFFIC		LINE DIAGRAM	TRAFFIC			PAVEMENT DATA
FED. AID.	FUNCT CLASS.	HWY. SYS.	HPMS SAMPLE	PRKG. REST.	COM/IND. ACCESS		CONTROL	COM/IND. ACCESS	PRKG. REST.	
	↑								↑	
						D E				
						CUL 005 SAC				
										24'I
										JC-C
										2UML
						WIND DRIVE 1097 3242				
						CARROLL CO 000	SS			
	↓								↓	
	Urban local									

SYSTEM				TRAFFIC		LINE DIAGRAM	TRAFFIC				PAVEMENT DATA
FED. AID.	FUNCT. CLASS.	HWY. SYS.	HPMS SAMPLE	PRK.G. REST.	COM/IND ACCESS		CONTROL	COM/IND ACCESS	PRK.G. REST.		

SHA 51.3 - 8 Revised
4.83

Balto Urban

MARYLAND STATE HIGHWAY ADMINISTRATION

6-00C06
SS/1Q
1-3-01

ROAD INVENTORY SHEET

Party Chief S. SNYDER
Recorder A Quattrochi
Assistant
Map No./Dir. D12A/ E
State Coordinates 852-534

Road No. ~~OP~~ ~~1101~~ CO 3246
Road Name MILLDAM COURT
County HOWARD
Date 1-3-01
Sheet No. 1 OF 1

36-02

TRAFFIC CODES

TRAFFIC CONTROLS: STOP SIGN=SS, TRAFFIC LIGHT=T.L., FLASHING RED BALL=F.R.

TRAFFIC CODES

PARKING RESTRICTIONS: A.M. PEAK, P.M. PEAK, A.M./P.M. PEAK, NO PARKING ANYTIME=N.P., COMM/IND. ACCESS=E

SYSTEM				TRAFFIC		LINE DIAGRAM	TRAFFIC			PAVEMENT DATA
FED. AID.	FUNCT CLASS.	HWY. SYS.	HPMS SAMPLE	PRKG. REST.	COM/IND. ACCESS		CONTROL	COM/IND. ACCESS	PRKG. REST.	
						D E				
						CUL 007 SAC				
	urban local					PT 004				
						45°				24' I
						PC 001				JC-C
										2UML
						CARROLL OR CO 000 WIND 4097 3240 DRIVE ©0118	SS			

SYSTEM				TRAFFIC		LINE DIAGRAM	TRAFFIC				PAVEMENT DATA
FED. AID.	FUNCT. CLASS.	HWY. SYS.	HPMS SAMPLE	PRKG. REST.	COM/IND ACCESS		CONTROL	COM/IND ACCESS	PRKG. REST.		

SHA 51.3 - 8 Revised
4.83

34-01
1/18/02
SS/WP

MARYLAND STATE HIGHWAY ADMINISTRATION

ROAD INVENTORY SHEET

Party Chief S Snyder
Recorder W. Plews
Assistant
Map No./Dir. D12A / W
State Coordinates 853-525

Road No. ~~OP 1140~~ CO 3247
Road Name Belleau COURT
County HOWARD
Date 1/18/02
Sheet No. 1 OF 1

131-02

SYSTEM: FUNCT CLASS | HWY SYS | HPMS SAMPLE
TRAFFIC: PREG. REST. | COMMND ACCESS

LINE DIAGRAM

TRAFFIC: CONTROL | COMMND ACCESS | PREG. REST.
PAVEMENT DATA

TRAFFIC CODES

TRAFFIC CONTROLS: STOP SIGN-SS, TRAFFIC LIGHT=T.L., FLASHING RED BALL-F.R.

PARKING RESTRICTIONS: A.M. PEAK, P.M. PEAK, A.M./P.M. PEAK, NO PARKING ANYTIME-N.P., COMM/IND. ACCESS=E

Urban Local

ROAD END
0 04
HEAD IN PARKING
PT
0 03
30°
HEAD IN PARKING
24'I
PC
0 01
I-C
2-UML
DRIVE @ 20
PAPILLON CO
0 00 3215 (39-0.1)
SS

COUNTY _____ ROAD NO. _____ PAGE ___ OF ___

SYSTEM				TRAFFIC		LINE DIAGRAM	TRAFFIC			PAVEMENT DATA
FUNCT CLASS	HWY SYS	HPMS SAMPLE		PRES. RESP.	CONTROL ACCESS		CONTROL	CONTROL ACCESS	PRES. RESP.	

Baltourban

41-99C0#1
SS/AB
2-25-00

SHA 51.3 - 8 Revised 4.83

MARYLAND STATE HIGHWAY ADMINISTRATION

ROAD INVENTORY SHEET

Party Chief S. Snyder
Recorder A. Barbour
Assistant
Map No./Dir. D-12C / E
State Coordinates 824 - 501

Road No. ~~CP 1086~~ CO 3248
Road Name Sandy Ridge
County Howard
Date 2-25-00
Sheet No. 1 OF 2

81-02

TRAFFIC CODES
TRAFFIC CONTROLS: STOP SIGN-SS, TRAFFIC LIGHT=T.L., FLASHING RED BALL=F.R.

TRAFFIC CODES
PARKING RESTRICTIONS: A.M. PEAK, P.M. PEAK, A.M./P.M. PEAK, NO PARKING ANYTIME=N.P., COMM/IND. ACCESS=E

SYSTEM				TRAFFIC		LINE DIAGRAM	TRAFFIC			PAVEMENT DATA
	FUNCT CLASS	HWY. SYS	HPMS SAMPLE	PREG. REST.	COM/IND ACCESS		CONTROL	COM/IND ACCESS	PREG. REST.	
						BEE COURT				
						o 27 ~~CP~~ CO 3250 ~~1087~~				
						SPRING LEAF COURT ~~1088~~				
						o 19 ~~CP~~ CO 3249				
						PT o 14				
						110°				
						PC o 02				24I
										JC-C
						AVALON DRIVE 52				2UNL
						~~CP~~ CO o 00 3037 ~~1087~~ (41-99C(1))	SS			

COUNTY Howard ROAD NO. OP 1086 PAGE 2 OF 2

SYSTEM				TRAFFIC		LINE DIAGRAM	TRAFFIC				PAVEMENT DATA
	FUNCT CLASS	HWY SYS NHS STATE		PREG REST	COM/IND ACCESS		% OTHER	% COM/IND	ACCESS	PREG REST	

Baltourban 41-99C0112
SS/AB
2-25-00

SHA 51.3 - 8 Revised
4.83

MARYLAND STATE HIGHWAY ADMINISTRATION

ROAD INVENTORY SHEET

Party Chief S. Snyder
Recorder A. Barbour
Assistant
Map No./Dir. D-12 C / S
State Coordinates 804-501

Road No. ~~OP~~ ~~1088~~ CO 3249
Road Name SPRING LEAF COURT
County Howard
Date 2-25-00
Sheet No. 1 OF 1

82-02

TRAFFIC CODES
TRAFFIC CONTROLS: STOP SIGN-SS, TRAFFIC LIGHT=T.L., FLASHING RED BALL=F.R.

TRAFFIC CODES
PARKING RESTRICTIONS: A.M. PEAK, P.M. PEAK, A.M./P.M. PEAK, NO PARKING ANYTIME=N.P., COMM/IND. ACCESS=E

SYSTEM				TRAFFIC		LINE DIAGRAM	TRAFFIC			PAVEMENT DATA
FUNCT CLASS	HWY. SYS	HPMS SAMPLE		PREG. REST.	COM/IND ACCESS		CONTROL	COM/IND ACCESS	PREG. REST.	
						D E				
						CUL O 09 SAC				
						O 05 AT 35°				
						O 02 PC				
						SANDY ~~OP~~ CO RIDGE .19 O 00 3248 ~~1080~~	SS			24'I JC-C 2UML

COUNTY _____ ROAD NO. _____ PAGE ___ OF ___

SYSTEM				TRAFFIC		LINE DIAGRAM	TRAFFIC				PAVEMENT DATA
	FUNCT CLASS	HWY SYS	NHS	PRES	ADT		% OTHER	% COMM'L	ACCESS	PRES.	

Baltimore Urban AII-99CO#3
SS/AB
2-25-00

SHA 51.3 - 8 Revised 4.83

MARYLAND STATE HIGHWAY ADMINISTRATION

ROAD INVENTORY SHEET

Party Chief S. Snyder
Recorder A. Barbour
Assistant
Map No./Dir. D-12C / S
State Coordinates 864 - 501

Road No. ~~OP~~ ~~1087~~ CO3250
Road Name BEE CT
County Howard
Date 2-25-00
Sheet No. 1 OF 1

83-02

SYSTEM				TRAFFIC		LINE DIAGRAM	TRAFFIC			PAVEMENT DATA
FUNCT CLASS	HWY. SYS	NHS & SAMPLE	PEAK REST.	COM/IND ACCESS			CONTROL	COM/IND ACCESS	PEAK REST.	
						D E				
						CUL O 03 SAC				24 'I
										JS-C
						SANDY RIDGE .M				2umL
						~~OP~~ CO O 00 3248 ~~1086~~	SS			

TRAFFIC CODES
TRAFFIC CONTROLS: STOP SIGN-SS, TRAFFIC LIGHT=T.L., FLASHING RED BALL=F.R.

TRAFFIC CODES
PARKING RESTRICTIONS: A.M. PEAK, P.M. PEAK, A.M./P.M. PEAK, NO PARKING ANYTIME=N.P., COMM/IND. ACCESS=E

COUNTY _____ ROAD NO. _____ PAGE ___ OF ___

SYSTEM				TRAFFIC		LINE DIAGRAM	TRAFFIC				PAVEMENT DATA
FUNCT CLASS	HWY SYS	HPMS SAMPLE		PREG. REST	COM/IND ACCESS		% GR TRUCKS	COM/IND ACCESS	PREG. REST.		

SHA 51.3 - 8 Revised
4.83

MARYLAND STATE HIGHWAY ADMINISTRATION

ROAD INVENTORY SHEET

21-95 ex #1

Party Chief DT
Recorder AL
Assistant
Map No./Dir. D-12C / W
State Coordinates 862-505

Road No. ~~OP~~ ~~995~~ CO 3251
Road Name Dunteachin Drive
County Howard
Date 3- -96
Sheet No. 1 OF 1

52-02

SYSTEM				TRAFFIC		LINE DIAGRAM	TRAFFIC			PAVEMENT DATA
	FUNCT CLASS	HWY. SYS.	HPMS SAMPLE	PREG. REST.	COM/IND ACCESS		CONTROL	COM/IND ACCESS	PREG. REST.	
						D F				
						CUL 0 40 SAC				
						0 30 PT				
						Tim's court				
						0 22 ~~OP 996~~ CO 3253 80°				
						(Meadow Pond Drive)				
						~~OP 997~~ CO 2895 0 17 PC				
						0.22				
						PT 0 09				
						Honey Court				
						CO ~~OP 995~~ 3252 0 05				
						70°				
										30' I
						PC 0 02				J CC
										2 uml
						Kerger Road				
						CO 0 00 189				

TRAFFIC CODES

TRAFFIC CONTROLS: STOP SIGN-SS, TRAFFIC LIGHT=T.L., FLASHING RED BALL=F.R.

TRAFFIC CODES

PARKING RESTRICTIONS: A.M. PEAK, P.M. PEAK, A.M./P.M. PEAK, NO PARKING ANYTIME=N.P., COMM/IND. ACCESS=E

COUNTY _____ ROAD NO. _____ PAGE ___ OF ___

SYSTEM				TRAFFIC			LINE DIAGRAM	TRAFFIC				PAVEMENT DATA
	FUNCT. CLASS	HWY SYS	HPMS SAMPLE	PKG. REST.	CONF/IND ACCESS			CONFIRG.	CONF/IND ACCESS	PKG. REST.		

SHA 51.3 - 8 Revised
4.83

MARYLAND STATE HIGHWAY ADMINISTRATION

21-95 ex #6

ROAD INVENTORY SHEET

Party Chief DT
Recorder AL
Assistant
Map No./Dir. D-12C / S
State Coordinates 862-505

Road No. ~~OP 995~~ C03252
Road Name Honey Court
County Howard
Date 3-14-96
Sheet No. 1 OF 1

53-02

SYSTEM				TRAFFIC		LINE DIAGRAM	TRAFFIC			PAVEMENT DATA
	FUNCT CLASS	HWY. SYS	HPMS SAMPLE	PKG. REST.	COM/IND ACCESS		CONTROL	COM/IND ACCESS	PKG. REST.	

D E
CUL 0 08 SAC

PT 0 05
80°
PC 0 01

Dunkeachin 0 00 994 Drive
OPEN 3251

30'I
J"C-C
2UNC

TRAFFIC CODES

TRAFFIC CONTROLS: STOP SIGN-SS, TRAFFIC LIGHT=T.L., FLASHING RED BALL=F.R.

TRAFFIC CODES

PARKING RESTRICTIONS: A.M. PEAK, P.M. PEAK, A.M./P.M. PEAK, NO PARKING ANYTIME=N.P., COM/IND. ACCESS=E

COUNTY _____ ROAD NO. _____ PAGE ___ OF ___

SYSTEM				TRAFFIC		LINE DIAGRAM	TRAFFIC				PAVEMENT DATA
FUNCT. CLASS	HWY SYS	HPMS SAMPLE		PREG.	COM/IND ACCESS		CONTROL	COM/IND ACCESS	PREG.		

BALTI URBAN

SHA 51.3 - 8 Revised
4.83

MARYLAND STATE HIGHWAY ADMINISTRATION

21-95 ex #5

ROAD INVENTORY SHEET

Party Chief BT
Recorder AL
Assistant
Map No./Dir. D-12C / N
State Coordinates 862-505

Road No. ~~CP~~ 996 CO 3253
Road Name Tim's Court
County Howard
Date 3-14-96
Sheet No. 1 OF 1

55-02

SYSTEM				TRAFFIC		LINE DIAGRAM	TRAFFIC			PAVEMENT DATA
FUNCT CLASS	HWY. SYS.	HPMS SAMPLE		PREG. REST.	COM/IND. ACCESS		CONTROL	COM/IND. ACCESS	PREG. REST.	
						D | E				
						CUL O 07 SAC				
										30' I
										"J" c-c
										2 UNL
						Drive				
						Dirt access O 00 996 3251 of CO				

TRAFFIC CODES

TRAFFIC CONTROLS: STOP SIGN-SS, TRAFFIC LIGHT=T.L., FLASHING RED BALI=F.R.

TRAFFIC CODES

PARKING RESTRICTIONS: A.M. PEAK, P.M. PEAK, A.M./P.M. PEAK, NO PARKING ANYTIME=N.P., COMM/IND. ACCESS=E

COUNTY _____ ROAD NO. _____ PAGE ___ OF ____

SYSTEM				TRAFFIC		LINE DIAGRAM	TRAFFIC				PAVEMENT DATA
	FUNCT. CLASS	HWY SYS	HPMS SAMPLE	PKG. REST.	COM/IND ACCESS		CONTROL	COM/IND ACCESS	PKG. REST.		

Balto Urban

93-0000Ex1
SS/AQ
1-9-01

SHA 51.3 - 8 Revised 4.83

MARYLAND STATE HIGHWAY ADMINISTRATION

ROAD INVENTORY SHEET

Party Chief S. Snyder
Recorder A QUATTROCHI
Assistant
Map No./Dir. E11B / E
State Coordinates 845 - 462

Road No. ~~OP~~ ~~1109~~ CO3254
Road Name HALSTEAD AVENUE
County HOWARD
Date 1-9-01
Sheet No. 1 OF 1

110-02

TRAFFIC CODES
TRAFFIC CONTROLS: STOP SIGN-SS, TRAFFIC LIGHT=T.L., FLASHING RED BALL=F.R.

TRAFFIC CODES
PARKING RESTRICTIONS: A.M. PEAK, P.M. PEAK, A.M./P.M. PEAK, NO PARKING ANYTIME=N.P., COMM/IND. ACCESS=E

SYSTEM				TRAFFIC		LINE DIAGRAM	TRAFFIC			PAVEMENT DATA
	FUNCT CLASS	HWY SYS	HPMS SAMPLE	PREG. REST.	COM/IND ACCESS		CONTROL	COM/IND ACCESS	PREG. REST.	
						ROAD END				
						016				
						SEWALL AVENUE @.42				
	local					~~OP~~ CO 005 ~~1108~~ 1883 (93-0000)	55			
						STREAM VIEW LANE				24' & I
						001 PVT				JC-C
										2UML
	urban					000				
						ROAD END				

COUNTY _____ ROAD NO. _____ PAGE ___ OF ___

SYSTEM			TRAFFIC		LINE DIAGRAM	TRAFFIC			PAVEMENT DATA
FUNCT. CLASS	HWY SYS	HPMS SAMPLE	PKG. RESTR.	COMMERCIAL ACCESS		OTHER	COMMERCIAL ACCESS	PKG. RESTR.	

PROPOSED

SHA 51.3 - 8 Revised
4.83

MARYLAND STATE HIGHWAY ADMINISTRATION

ROAD INVENTORY SHEET

Party Chief _____
Recorder _____
Assistant _____
Map No./Dir. 1 N
State Coordinates _____

Road No. Co 9000
Road Name GUILFORD RD EXT
County HOWARD
Date 12-10-92
Sheet No. 1 OF 1

SYSTEM: FED. AID. | FUNCT CLASS. | HWY. SYS. | HPMS SAMPLE
TRAFFIC: PRKG. REST. | COM/IND. ACCESS

LINE DIAGRAM

WIDE SHOULDER
FROM Co 93 (PINDELL SCHOOL RD)
(0.00) @ 0.35 ~~0.35~~
TO MD 32 W
(0.~~35~~) @ 2.78
0.25
TOTAL MILEAGE 0.~~25~~ ±
RURAL MINOR COLLECTOR
UNASSIGNED
NO OUTLET
OF MD 32 W
96-2+5 STAGE

TRAFFIC: CONTROL | COM/IND. ACCESS | PRKG. REST.

PAVEMENT DATA

TRAFFIC CODES
TRAFFIC CONTROLS: STOP SIGN=SS, TRAFFIC LIGHT=T.L., FLASHING RED BALL=F.R.

TRAFFIC CODES
PARKING RESTRICTIONS: A.M. PEAK, P.M. PEAK, A.M./P.M. PEAK, NO PARKING ANYTIME=N.P., COMM/IND. ACCESS=E

SYSTEM				TRAFFIC		LINE DIAGRAM	TRAFFIC			PAVEMENT DATA
FED. AID.	FUNCT. CLASS.	HWY. SYS.	HPMS SAMPLE	PRKG. REST.	COM/IND ACCESS		CONTROL	COM/IND ACCESS	PRKG. REST.	

SHA 51.3 - 8 Revised
4.83

MARYLAND STATE HIGHWAY ADMINISTRATION

ROAD INVENTORY SHEET

Party Chief _____
Recorder _____
Assistant _____
Map No./Dir. 15
State Coordinates _____

Road No. Co 9001
Road Name BANNEKER RD ext
County HOWARD
Date 12-10-92
Sheet No. 1 OF 1

SYSTEM				TRAFFIC		LINE DIAGRAM	TRAFFIC			PAVEMENT DATA
FED. AID.	FUNCT CLASS.	HWY. SYS.	HPMS SAMPLE	PRKG. REST.	COM/IND. ACCESS		CONTROL	COM/IND. ACCESS	PRKG. REST.	
						FROM Co 887 (BANNEKER RD)				
						(0.00) C 0.14				
						TO Co 1161 (BROKEN LAND PKWY)				
						(L30) (.35) C ~~0.00~~ 0.55				
						TOTAL MILEAGE ~~0.00~~ 0.35				
						URBAN MINOR ARTERIAL				

TRAFFIC CODES

TRAFFIC CONTROLS: STOP SIGN=SS,
TRAFFIC LIGHT=T.L.,
FLASHING RED BALL=F.R.

TRAFFIC CODES

PARKING RESTRICTIONS: A.M. PEAK,
P.M. PEAK, A.M./P.M. PEAK, NO PARKING
ANYTIME=N.P., COMM/IND. ACCESS=E

SYSTEM				TRAFFIC		LINE DIAGRAM	TRAFFIC			PAVEMENT DATA
FED. AID.	FUNCT. CLASS.	HWY. SYS.	HPMS SAMPLE	PRK.G. REST.	COM/IND ACCESS		CONTROL	COM/IND ACCESS	PRK.G. REST.	

SHA 51.3 - 8 Revised
4.83

MARYLAND STATE HIGHWAY ADMINISTRATION

ROAD INVENTORY SHEET

Party Chief _____
Recorder _____
Assistant _____
Map No./Dir. 1 E
State Coordinates _____

Road No. Co 9002
Road Name BRIGHTFIELD RD EXT
County HOWARD
Date 12-10-92
Sheet No. 1 OF 1

SYSTEM				TRAFFIC		LINE DIAGRAM	TRAFFIC			PAVEMENT DATA
FED. AID.	FUNCT CLASS.	HWY. SYS.	HPMS SAMPLE	PRK.G. REST.	COM/IND. ACCESS		CONTROL	COM/IND. ACCESS	PRK.G. REST.	
						(C2483)				
						FROM OP 912 (BRIGHTFIELD RD)				
						0.00 C 0.23 0.42				
						TO MD 103 (MONTPELIER RD)				
						(20).03 C 240.				
						TOTAL MILEAGE 0.20				
						UNDER CONSTRUCTION				
						UNASSIGNED				
						NEW				
						EXISTING				

TRAFFIC CODES
TRAFFIC CONTROLS: STOP SIGN=SS, TRAFFIC LIGHT=T.L., FLASHING RED BALL=F.R.

TRAFFIC CODES
PARKING RESTRICTIONS: A.M. PEAK, P.M. PEAK, A.M./P.M. PEAK, NO PARKING ANYTIME=N.P., COMM/IND. ACCESS=E

SYSTEM				TRAFFIC		LINE DIAGRAM	TRAFFIC			PAVEMENT DATA
FED. AID.	FUNCT. CLASS.	HWY. SYS.	HPMS SAMPLE	PRK.G. REST.	COM/IND ACCESS		CONTROL	COM/IND ACCESS	PRK.G. REST.	

SHA 51.3 - 8 Revised
4.83

53-93
1-24-94
BG/TM

MARYLAND STATE HIGHWAY ADMINISTRATION

ROAD INVENTORY SHEET

Party Chief _____
Recorder _____
Assistant _____
Map No./Dir. 15
State Coordinates _____

Road No. Co 9003
Road Name LONG GATE PKWY
County HOWARD
Date 12-10-93
Sheet No. 1 OF 1

SYSTEM				TRAFFIC		LINE DIAGRAM	TRAFFIC			PAVEMENT DATA
FED. AID.	FUNCT. CLASS.	HWY. SYS.	HPMS SAMPLE	PRKG. REST.	COM/IND. ACCESS		CONTROL	COM/IND. ACCESS	PRKG. REST.	

UNASSIGNED

FROM MD 103 (MONTGOMERY RD) @ 5.63
(0.00)

TO MD 100 @ 6.75
(0.25)

TOTAL MILEAGE 0.25.

URBAN MINOR ARTERIAL

FROM: MD 103 (Montgomery Rd @ 5.63
(.00)

TO: MD 100 (Proposed) @ 6.75
(.25)

Total proposed mileage 0.11 mile
URBAN Minor ARTERIAL

*(.00-.14-it now Co 2650=93-53Co)

TRAFFIC CODES

TRAFFIC CONTROLS: STOP SIGN=SS, TRAFFIC LIGHT=T.L., FLASHING RED BALL=F.R.

TRAFFIC CODES

PARKING RESTRICTIONS: A.M. PEAK, P.M. PEAK, A.M./P.M. PEAK, NO PARKING ANYTIME=N.P., COMM/IND. ACCESS=E

SYSTEM				TRAFFIC		LINE DIAGRAM	TRAFFIC			PAVEMENT DATA
FED. AID.	FUNCT. CLASS.	HWY. SYS.	HPMS SAMPLE	PRK.G. REST.	COM/IND ACCESS		CONTROL	COM/IND ACCESS	PRK.G. REST.	

SHA 51.3 - 8 Revised
4.83

MARYLAND STATE HIGHWAY ADMINISTRATION

ROAD INVENTORY SHEET

Party Chief _____
Recorder _____
Assistant _____
Map No./Dir. 1 / N
State Coordinates _____

Road No. Co 9004
Road Name DORSEY RUN RD EXT
County HOWARD
Date 12-11-92
Sheet No. 1 OF 1

SYSTEM				TRAFFIC		LINE DIAGRAM	TRAFFIC			PAVEMENT DATA
FED. AID.	FUNCT CLASS.	HWY. SYS.	HPMS SAMPLE	PRKG. REST.	COM/IND. ACCESS		CONTROL	COM/IND. ACCESS	PRKG. REST.	
						102891				
						FROM ~~MD 732~~ R (GUILFORD RD) @ 0.39 (0.00)				
						TO Co 121 (DORSEY RUN RD) @ 1.39 (0.60)				
						TOTAL MILEAGE 0.60				
						URBAN COLLECTOR				

TRAFFIC CODES

TRAFFIC CONTROLS: STOP SIGN=SS, TRAFFIC LIGHT=T.L., FLASHING RED BALL=F.R.

TRAFFIC CODES

PARKING RESTRICTIONS: A.M. PEAK, P.M. PEAK, A.M./P.M. PEAK, NO PARKING ANYTIME=N.P., COMM/IND. ACCESS=E

SYSTEM				TRAFFIC		LINE DIAGRAM	TRAFFIC			PAVEMENT DATA
FED. AID.	FUNCT. CLASS.	HWY. SYS.	HPMS SAMPLE	PRKG. REST.	COM/IND ACCESS		CONTROL	COM/IND ACCESS	PRKG. REST.	

SHA 51.3 - 8 Revised
4.83

MARYLAND STATE HIGHWAY ADMINISTRATION

ROAD INVENTORY SHEET

Party Chief _____
Recorder _____
Assistant _____
Map No./Dir. 1 E
State Coordinates _____

Road No. MD 9005
Road Name S HANOVER RD EXT
County HOWARD
Date 12-11-92
Sheet No. 1 OF 1

SYSTEM				TRAFFIC		LINE DIAGRAM	TRAFFIC			PAVEMENT DATA
FED. AID.	FUNCT CLASS.	HWY. SYS.	HPMS SAMPLE	PRKG. REST.	COM/IND. ACCESS		CONTROL	COM/IND. ACCESS	PRKG. REST.	
						FROM MD 559 (S. HANOVER ST) (0.00) @ 0.57				
						TO MD 1068 (ANDERSON AVE) (0.10) @ 0.32				
						TOTAL MILEAGE 0.10				
						CROSS MINOR ARTERIAL				

TRAFFIC CODES

TRAFFIC CONTROLS: STOP SIGN=SS, TRAFFIC LIGHT=T.L., FLASHING RED BALL=F.R.

TRAFFIC CODES

PARKING RESTRICTIONS: A.M. PEAK, P.M. PEAK, A.M./P.M. PEAK, NO PARKING ANYTIME=N.P., COMM/IND. ACCESS=E

SYSTEM				TRAFFIC		LINE DIAGRAM	TRAFFIC			PAVEMENT DATA
FED. AID.	FUNCT. CLASS.	HWY. SYS.	HPMS SAMPLE	PRK.G. REST.	COM/IND ACCESS		CONTROL	COM/IND ACCESS	PRK.G. REST.	

SHA 51.3 - 8 Revised
4.83

MARYLAND STATE HIGHWAY ADMINISTRATION

ROAD INVENTORY SHEET

Party Chief _____
Recorder _____
Assistant _____
Map No./Dir. 15
State Coordinates _____

Road No. CO 9006
Road Name SNOWDEN RIVER PKWY EXT
County HOWARD
Date 12-11-90
Sheet No. 1 OF 2

SYSTEM				TRAFFIC		LINE DIAGRAM	TRAFFIC			PAVEMENT DATA
FED. AID.	FUNCT CLASS.	HWY. SYS.	HPMS SAMPLE	PRKG. REST.	COM/IND. ACCESS		CONTROL	COM/IND. ACCESS	PRKG. REST.	

FROM (MP 5.5 (Howard))
(0.00) @ 13.15

TO CO1140 (SNOWDEN RIVER PKWY)
(1.80) @ 0.00

TOTAL MILEAGE 1.80

URBAN MINOR ARTERIAL

FROM CO1991, Tamar DR
(.00) @ .79

TO MD 108 (Waterloo RD)
(.50) @ 13.15

Total mileage: .50

URBAN MINOR ARTERIAL

UNASSIGNED NOW ~~CO432~~
SNOWDEN RIVER PKWY
NOW CO1140

TRAFFIC CODES

TRAFFIC CONTROLS: STOP SIGN=SS, TRAFFIC LIGHT=T.L., FLASHING RED BALL=F.R.

TRAFFIC CODES

PARKING RESTRICTIONS: A.M. PEAK, P.M. PEAK, A.M./P.M. PEAK, NO PARKING ANYTIME=N.P., COMM/IND. ACCESS=E

SYSTEM				TRAFFIC		LINE DIAGRAM	TRAFFIC			PAVEMENT DATA
FED. AID.	FUNCT. CLASS.	HWY. SYS.	HPMS SAMPLE	PRK.G. REST.	COM/IND ACCESS		CONTROL	COM/IND ACCESS	PRK.G. REST.	