PRINCE GEORGES COUNTY
COUNTY ROADS
101 to 200

SHA 51.3-8
11-15-72

STATE HIGHWAY ADMINISTRATION OF MARYLAND

97-194
3-24-98
BC/AP

ROAD INVENTORY SHEET

Party Chief ES
Recorder WD
Helper REWRITTEN BY ER 11-7-79

Map No. M 36 G12

Road No. CO. 101
Road Name OAK GROVE RD.
Sheet No. 1 OF 2
Date 7-9-68
County P.G.
State Coordinates 862-380

	30°	1	54		
	H	1	49	30°↑	
	CEM	1	22	CHURCH + CEM.	18'H 30'CW
	CHURCH RD. CO. 59	1	17	SCHOOL-OFFICE	*
		1	15	H	
		1	13	QUEEN ANNE SCHOOL	
	F-1000'	0	97	F-1000'	
		0	94	30°↑	
		0	67	F-1000'	
	PT	0	64		
	F-1200'	0	62		
	80°				
	F-7500'	0	55		
	PC	0	54		
		0	51	F-7500'	
		0	44	KOBEY RD. 30°↑	18'E
	@ 14.47	0	08	CO 5852	2-3E 3W 30CW
	MD 193	0	00	6.16	2ML

SHA 51.3-8
11-15-72

ROAD INVENTORY SHEET

Road No. CO. 101
Road Name OAK GROVE R.D.
Sheet No. 2 OF 2
Date 7-9-68
County P.G.
State Coordinates

#PC529572S
XXX SIGN: WATCH FOR TRAINS
184
183 (RXR)
H 182
179 LEELAND RD. S. CO. 103 SAME

CROSSING
018

COUNTY # 101
LEELAND ~~RD NORTH~~

TURN PICTURES OVER

1

2

3

4

RAILROAD CROSSING
STOP
LOOK AND LISTEN

PRINCE GEORGES Co 10/30/69

PICTURE TAKEN FACING SOUTH
ON Co 101 LEELAND RD NORTH

J926501

1

PRINCE GEORGES Co 10/30/69

PICTURE TAKEN FACING NORTH
ON Co 101 LEELAND RD NORTH.

J926501

2

PRINCE GEORGES Co 10/30/69

PICTURE TAKEN FACING WEST
ON Co 101 LEELAND RD NORTH

J926501

3

PRINCE GEORGES Co 10/30/69

PICTURE TAKEN FACING EAST
ON Co 101 LEELAND RD NORTH

J926501

4

P & P 104

RAILROAD GRADE CROSSING SHEET

State Roads Commission of Maryland
Planning and Programming Division

1. GENERAL

Crossing No. 018

Mile Pole Number (R.R. Co.) ... NONE

Coordinates ..... x 872 y 379

System Classification
(Check One)

State Primary ..... ☐

State Secondary ..... ☐

State Road Only ..... ☐

County ..... ☑

Local ..... ☐
(Specify)

County and/or Municipality .. PRINCE GEORGES

U.S. Route Number .....

State Route Number .....

Road Number/Name ..... CO 101 LEECAND RD NORTH

Station .....

Surface Type ..... 14' H

Name of Railroad ..... PENN CENTRAL

Number of Main Tracks 1

Number of Other Tracks ..... NONE

2. TRAIN MOVEMENTS

Time Period	Pass	Freight	Train Speed at Grade Pass	Train Speed at Grade Freight	Spur	Remarks (Other than daily) Pass	Remarks (Other than daily) Freight
Day 6 A.M. to 6 P.M.							
Night 6 P.M. to 6 A.M.							
24 Hour Total							

3. TYPE OF PROTECTION

a. 3 Warning Signs - Reflectorized, (Non-reflectorized)

b. 1 Crossing Signs - Reflectorized, (Non-reflectorized)

c. — Road Marking

d. — Lights - Flashing, Stationary

e. — Traffic Control (Stop and Go) Signals

f. — Automatic Gate

g. — Watchman - Gate, Flag...hours

h. — Others

* By numerals 1 or 2 indicate whether installation is on one or both sides of track.

4. ALIGNMENT FACTOR

P. 416'

N. 260'

Average Daily Trains ...

Train Speed .....

Highway ADT.....

Highway Speed Limit ... 25 M.P.H

Average Vehicle Speed . 30 MPH

Max. Approach Grade .. N -2.0 P +3.0

Restricted Sight Distance . No
(On Highway)

5. QUADRANT ... SIGHT DISTANCE

	@300'	@10'
A 70°	0	1000'
B 110°	0	1000'
C 110°	0	1000'
D 70°	0	1000'

6. ACCIDENT RECORD
(Vehicles & Trains)

Year	No. of Accidents	No. of Fatalities
1961		
1962		
1963		
1964		
1965		
Total		

7. CROSSING RATING

A

B

C

D

Total

State Roads Commission of Maryland
Planning and Programming Division

Party _____
Date 10/30/69

DIAGRAM FOR RAILROAD GRADE CROSSING

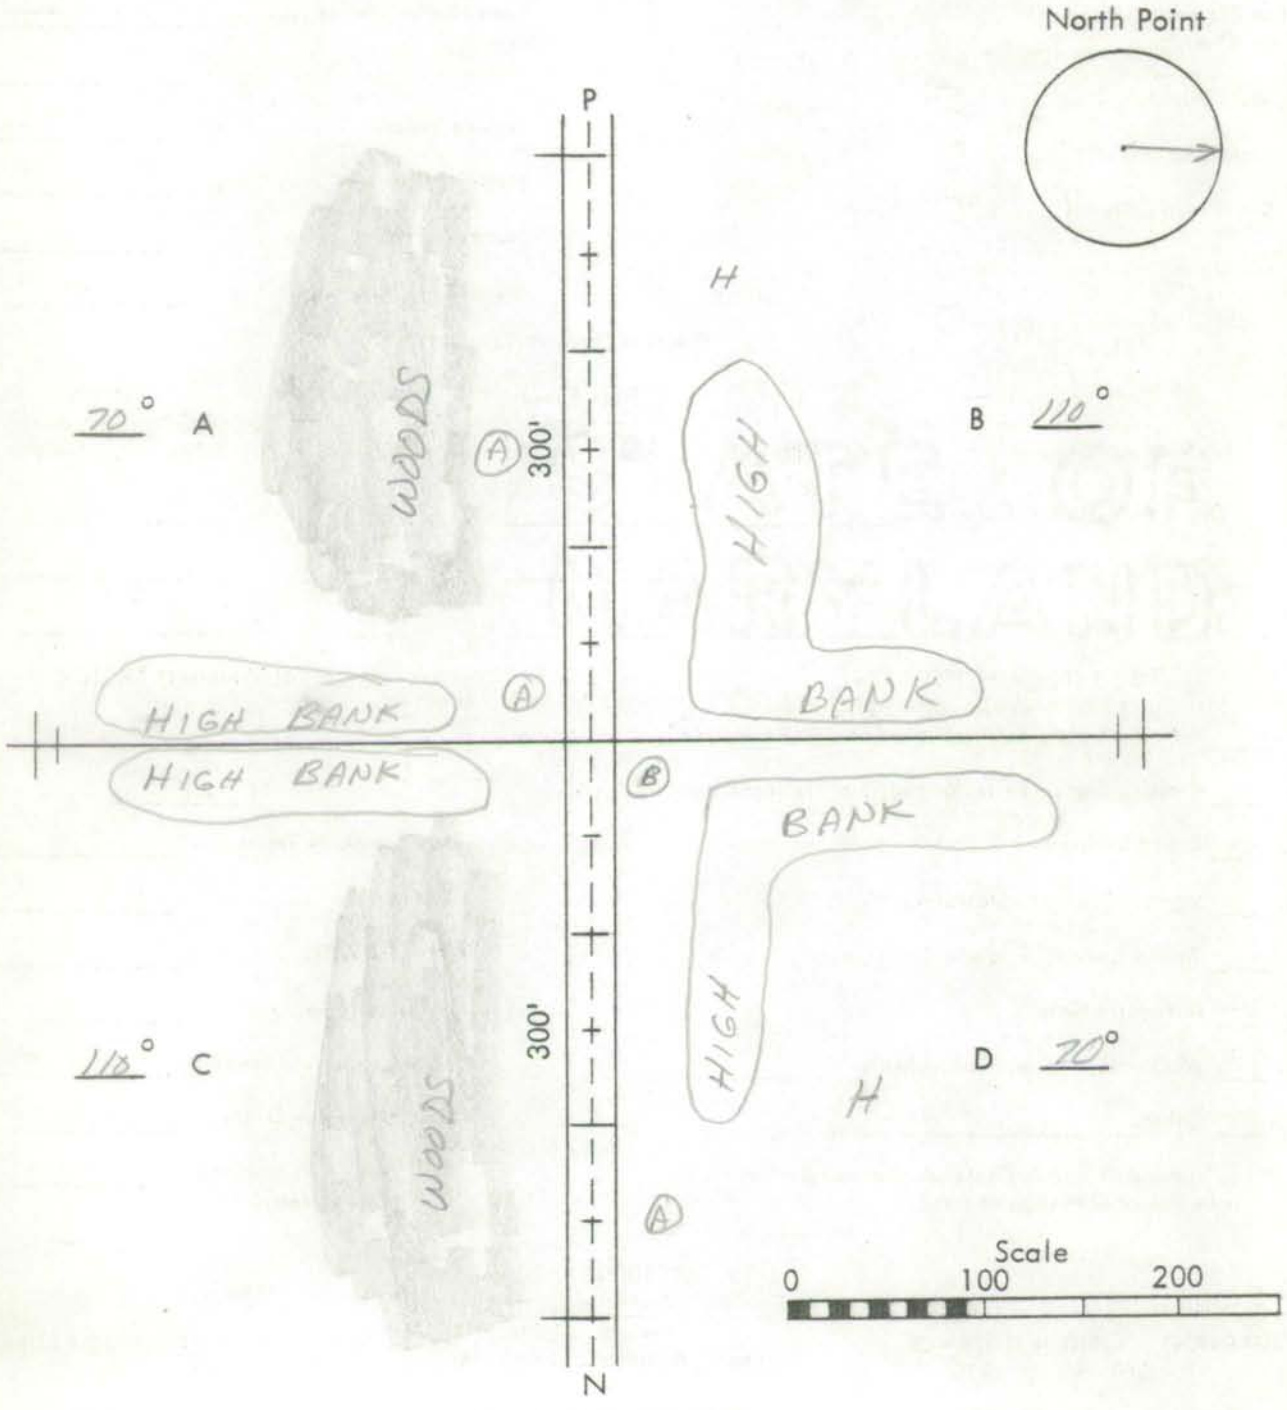

Survey Direction

Remarks: _____

Form 5-HPS (Revised 1961)

MARYLAND STATE ROADS COMMISSION
PLANNING AND PROGRAMMING DIVISION

S26130

IN COOPERATION WITH
U. S. BUREAU OF PUBLIC ROADS

BRIDGE SHEET

ROAD NO. CO 101
SHEET NO. 1A
PARTY NO. _____
DATE 7-9-68
COUNTY PRINCE GEO

RATED CAPACITY H 20

FOR ALL STRUCTURES HAVING A TOTAL OPENING OF MORE THAN 20 FEET AS DEFINED IN NOTE 1.

ODOMETER READING 203 NAME OF STREAM, RAILROAD OR HIGHWAY CROSSED BLACK BRANCH STREAM

NUMBER OF RAILROAD TRACKS _____
KIND OF CROSSING (NOTE 2) _____

UNDERPASS-SIMPLE UNDERPASS-COMBINED (NOTE 3) OVERPASS BRIDGE OVER SYSTEM

DESCRIPTION

NUMBER OF SPANS	LENGTH EACH SPAN (NOTE 4)	TYPE (NOTE 5)
1	22'	I BEAM

TOTAL LENGTH-ON LINE OF ROAD OVER-ALL (NOTE 6) 26'

MATERIAL
SUBSTRUCTURE IRON SUPERSTRUCTURE _____
FLOOR C.M. COVERED WITH BIT MIX

CLEARANCES
ROADWAY (NOTE 7) 15' SIDEWALK WIDTHS: —RIGHT —LEFT

SURFACE OF ROAD TO STREAM BED 8' FOR OVERPASSES, SHOW DISTANCES TO TOP OF RAIL OR SURFACE OF LOWER ROAD. (NOTE 8)
SURFACE OF ROAD TO BOTTOM PORTAL _____ (MINIMUM OVERHEAD CLEARANCE
CLEAR DISTANCE OF OPENING ABOVE STREAM BED 6' (WATERWAYS ONLY)
POSTED LOAD LIMITS 20,000 LB. BRIDGE NO. — CONSTRUCTION DATE —

GENERAL CONDITION OF BRIDGE: CHECK IF GOOD, FAIR, OR POOR, DESCRIBE DEFECTS IF SERIOUS.

	GOOD	FAIR	POOR
SUPERSTRUCTURE	✓		
FLOOR		✓	
SUBSTRUCTURE		✓	
PAINT		✓	

BADLY CORRODED OR RUSTED

TYPE OF PROTECTION FOR DRAWBRIDGES (NOTE 9) _____

(NOTES ON REVERSE SIDE)

S26130

Notes:

1. In agreement with Federal-aid standards, a bridge is defined as a structure including supports erected over a depression or an obstruction, as water, highway, or railway, and having a track or passageway for carrying traffic or other moving loads, and having a length measured along the center of roadway of more than 20 feet between undercoping of abutments or spring lines of arches, or extreme ends of openings for multiple boxes and pipes, where the clear distance between openings is less than half of the smaller contiguous opening.

2. Show kind of crossing by checking descriptive item applicable. For multiple-span bridges give complete information on each span including approach spans. Indicate on leg sheet the odometer reading, position, and angle of skew of structure with respect to center line of road and by arrow the direction of stream flow.

3. Give information on the span over the highway only.

4. For span length use center to center of bearings, otherwise the clear opening. Skew bridges will be measured along center line of road. See Note 1.

5. Show general type such as: Trestle, Truss, Girder, I-Beam, Rigid Frame, Arch, Slab, Suspension, or Covered Bridge. See illustrations attached. Describe draw spans by classifications listed in Article X, Section 2 of Manual.

6. The length of a bridge structure is the over-all length measured along the line of survey stationing back to back of back-walls of abutments, if present, otherwise end to end of bridge floor, but in no case less than the total clear opening of the structure.

7. Give minimum lateral clearance. Where traffic lanes are separated by bridge numbers, show clearance width of each lane separately. Special conditions should be explained by notes.

8. In case of overhead bracing or arch construction, measurement shall be made to the lowest point above the road surface.

9. Use classification listed on RR crossing sheet. Form 4 HPS.

Remarks: _____

_____

A rearrangement of the form similar to that shown on the attachment may be used to provide space for coding.

Form 6 HPS (Rev. 1961) ~~FAU~~ MAP 8 95-137 BB 1/11 3/26/96 1-074 Rural 78

ROAD INVENTORY SHEET

Party Chief E.S.
Recorder W.D.
Chainman

61-142

Gen Hwy
VER 7-19-77
880-380 M36

Road No. CO 102
Name CLAGETT LANDING RD
Sheet No. 1 OF 2
Date 7-10-68
County PRINCE GEO

	H	094	
	H	093	~~12'F~~ ~~2-3'E SHO~~
	H	086	~~H~~
12'E FARM 0.50		085	
	H	073	
	H	042	
		029	PT 40°
		026	PC
		016	PT 45°
		013	P.C.
	H	012	
PT 45° PC	FARM 10'E (CLAGETT LNDG RD SOUTH) CO 2003	008	
		006	
	~~25~~	003	20'G 2-3'E SHO
NB	US	000	301

Form 6 HPS (Rev. 1961)

78

ROAD INVENTORY SHEET

Party Chief E.S.
Recorder W.D.
Chainman

Road No. CO 102
Name CLAGETT LANDING RD
Sheet No. 2 OF 2
Date 7-10-68
County PRINCE GEO

ROAD 255 END

	254	H	
	250	DR.	
H	249		
	246	H	16'E 16'CW
	235	85° ☐ END COUNTY SIGN MAIN	X
H 85°	227		
	217	PT 50°	
	214	P.C	
	196	FARM	
P.T 35°	186		
P.C.	182		
	181	FARM	
30°	172		12'F 20'W
	156	90°	X
FARM	136		
		9'E	
	119	0.60 FARM	~~SAME~~ 20'G
		Heritage Hills Dr	
	111	58-116 CO 4948	

0.P 577'

Form 6 HPS (Rev. 1961)

FAU ~~MAP 7~~ 5-144B

Gr. Upper Marlboro

C

85-196 BD/AL 3-12-86

ROAD INVENTORY SHEET

Party Chief E.S.
Recorder W.D.
Chainman

Gen. Hwy 97-32ST 2-8-00 GD EF

VER 7-15-77

871-379 ~~M~~ G12

Road No. Co 103
Name LEELAND RD S
Sheet No. 1 OF 2
Date 7-9-68
County PRINCE GEO

		1	~~2~~ T 16 H	
	H	1	~~14~~ 11	
	H	1	~~12~~ 09	
	C.B.C	1	00 H 16'L, 20'W, 8'D	
		0	01 ~~85~~ H	
		0	72 ~~74~~ H	18'I 20'CW
		0	61	X
		0	55 H	
		0	54 PT	
		0	~~52~~ X PT	
			X 45° CO 103	
		0	43 ~~48~~ P.C	
			#RD596	
	COLLINGTON	0	39 ~~40~~ BRANCH (SEE 1A)	24'I 2-10' D SHD
		0	25	X
	R/R	C	18	
E	R/R		#PC J79, J69 J	20'I 30'CW
		0	15 (STOP, LOOK, LIST) 1 TRACK	X
		0	11 R/R	
		0	01 H	
	CO		101	18'I ~~24'E SHD~~
	~~LEELAND RD~~	000	OAK GROVE RD	

NON FA COLLECTOR - ~~MINOR~~ ARTERIAL JUNCTION

Form 6 HPS (Rev. 1961)

78

ROAD INVENTORY SHEET

Party Chief E.S.
Recorder W.D.
Chainman

Road No. CO 103
Name LEELAND RD. S.
Sheet No. 2 OF 2
Date 7-9-68
County PRINCE GEO

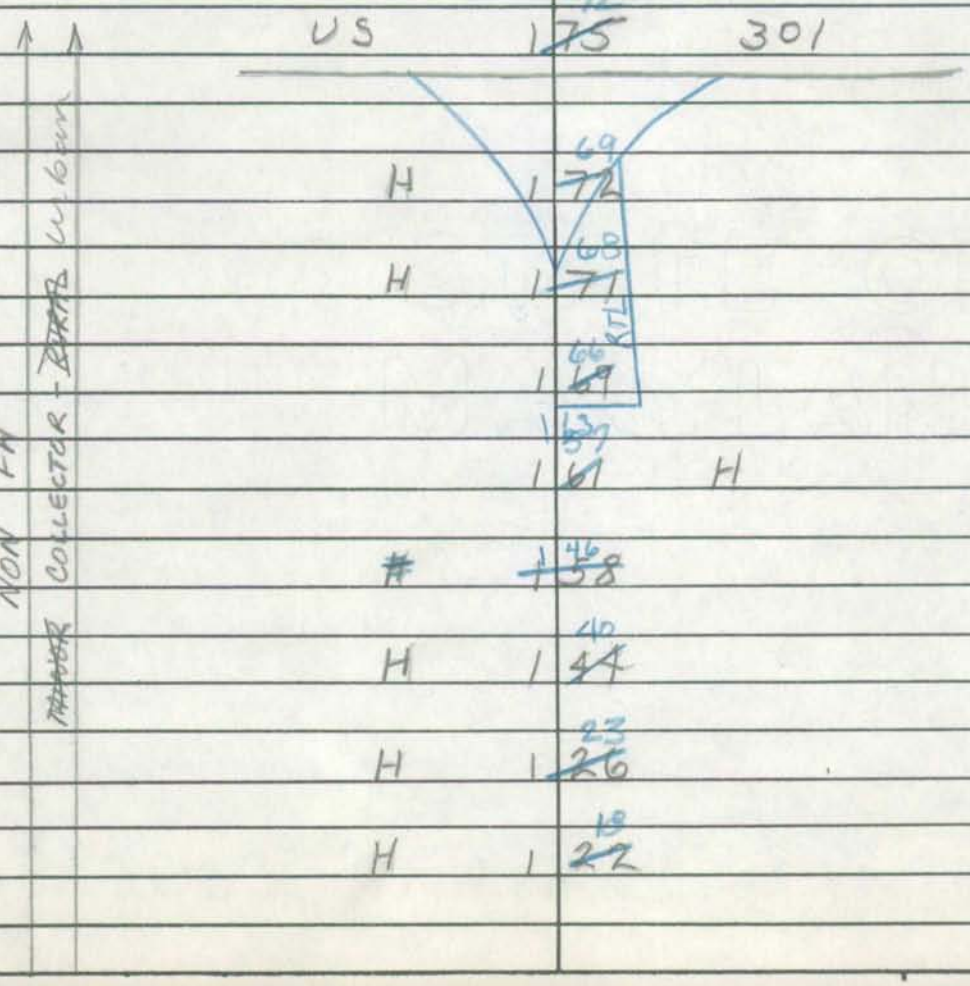

Form HPS 5

STATE HIGHWAY ADMINISTRATION OF MARYLAND

LEELAND ROAD BRIDGE

IN COOPERATION WITH
FEDERAL HIGHWAY ADMINISTRATION

3103

BRIDGE SHEET

ROAD NO. ~~5-6146~~

SHEET NO. _____

PARTY NO. _____

DATE 12/19/85

COUNTY Prince George's

RATED CAPACITY HS-20

FOR ALL STRUCTURES HAVING A TOTAL OPENING OF MORE THAN 20 FEET AS DEFINED IN NOTE 1.

ODOMETER READING 0.38 NAME OF STREAM, RAILROAD OR HIGHWAY CROSSED COLLINGTON BRANCH

NUMBER OF RAILROAD TRACKS N/A

KIND OF CROSSING (NOTE 2) Stream

UNDERPASS-SIMPLE UNDERPASS-COMBINED (NOTE 3) OVERPASS BRIDGE OVER SYSTEM

DESCRIPTION

NUMBER OF SPANS	LENGTH EACH SPAN (NOTE 4)	TYPE (NOTE 5)
1	61.67'	I-Beam

TOTAL LENGTH-ON LINE OF ROAD OVER-ALL (NOTE 6) 66'

MATERIAL

SUBSTRUCTURE CONCRETE SUPERSTRUCTURE COMPOSITE STEEL/CONCRETE

FLOOR Concrete

CLEARANCES

ROADWAY (NOTE 7) SIDEWALK WIDTHS: RIGHT N/A LEFT N/A

SURFACE OF ROAD TO STREAM BED 17' FOR OVERPASSES, SHOW DISTANCES TO TOP OF RAIL OR SURFACE OF LOWER ROAD. N/A (NOTE 8)

SURFACE OF ROAD TO BOTTOM PORTAL N/A (MINIMUM OVERHEAD CLEARANCE CLEAR DISTANCE OF OPENING ABOVE STREAM BED 12.5' (WATERWAYS ONLY)

POSTED LOAD LIMITS N/A BRIDGE NO. P 0596 CONSTRUCTION DATE 1985

GENERAL CONDITION OF BRIDGE: CHECK IF GOOD, FAIR, OR POOR, DESCRIBE DEFECTS IF SERIOUS.

	GOOD	FAIR	POOR
SUPERSTRUCTURE	GOOD		
FLOOR	GOOD		
SUBSTRUCTURE	GOOD		

PAINT N/A BADLY CORRODED OR RUSTED

TYPE OF PROTECTION FOR DRAWBRIDGES N/A

SHA 51.3 - 22
10-1-73

(NOTES ON REVERSE SIDE)

Notes:

1. In agreement with Federal-aid standards, a bridge is defined as a structure including supports erected over a depression or an obstruction, as water, highway, or railway, and having a track or passageway for carrying traffic or other moving loads, and having a length measured along the center of roadway of more than 20 feet between undercoping of abutments or spring lines of arches, or extreme ends of openings for multiple boxes and pipes, where the clear distance between openings is less than half of the smaller contiguous opening.

2. Show kind of crossing by checking descriptive item applicable. For multiple-span bridges give complete information on each span including approach spans. Indicate on leg sheet the odometer reading, position, and angle of skew of structure with respect to center line of road and by arrow the direction of stream flow.

3. Give information on the span over the highway only.

4. For span length use center to center of bearings, otherwise the clear opening. Skew bridges will be measured along center line of road. (See note 1.)

5. Show general type such as: Trestle, Truss, Girder, I-Beam, Rigid Frame, Arch, Slab, Suspension, or Covered Bridge.

6. The length of a bridge structure is the over-all length measured along the line of survey stationing back to back of back-walls of abutments, if present, otherwise end to end of bridge floor, but in no case less than the total clear opening of the structure.

7. Give minimum lateral clearance. Where traffic lanes are separated by bridge members, show clearance width of each lane separately. Special conditions should be explained by notes.

8. In case of overhead bracing or arch construction, measurement shall be made to the lowest point above the road surface.

Remarks: _____

_____

P & P 104

RAILROAD GRADE CROSSING SHEET

State Roads Commission of Maryland
Planning and Programming Division

1. GENERAL

Crossing No. 017

Mile Pole Number (R.R. Co.) ... 10

Coordinates ..... x 872 y 378

System Classification (Check One)

- State Primary ..... ☐
- State Secondary ..... ☐
- State Road Only ..... ☐
- County ..... ☑
- Local ..... ☐ (Specify)

County and/or Municipality .. PRINCE GEORGES

U.S. Route Number .....

State Route Number .....

Road Number/Name ..... CO. 103 LEELAND RD SOUTH

Station .....

Surface Type ..... 16' H

Name of Railroad ..... PENN CENTRAL

Number of Main Tracks 1

Number of Other Tracks ..... NONE

2. TRAIN MOVEMENTS

Time Period	Pass	Freight	Train Speed at Grade: Pass	Train Speed at Grade: Freight	Spur	Remarks (Other than daily): Pass	Remarks (Other than daily): Freight
Day 6 A.M. to 6 P.M.							
Night 6 P.M. to 6 A.M.							
24 Hour Total							

3. TYPE OF PROTECTION

a. 3 Warning Signs - Reflectorized, (Non-reflectorized)

b. 1 Crossing Signs - Reflectorized, (Non-reflectorized)

c. — Road Marking

d. — Lights - Flashing, Stationary

e. — Traffic Control (Stop and Go) Signals

f. — Automatic Gate

g. — Watchman - Gate, Flag...hours

h. — Others

* By numerals 1 or 2 indicate whether installation is on one or both sides of track.

4. ALIGNMENT FACTOR

P. 528'

N. 572'

Average Daily Trains ...

Train Speed .....

Highway ADT.....

Highway Speed Limit ... 30 M.P.H

Average Vehicle Speed . 30 M.P.H

Max. Approach Grade .. N.-0.2 P-5.1

Restricted Sight Distance . NO (On Highway)

5. QUADRANT ... SIGHT DISTANCE

	@300'	@10'
A 140°	0	1000'
B 90°	0	1000'
C 90°	0	1000'
D 140°	0	1000'

6. ACCIDENT RECORD (Vehicles & Trains)

Year	No. of Accidents	No. of Fatalities
1961		
1962		
1963		
1964		
1965		
Total		

7. CROSSING RATING

A

B

C

D

Total

State Roads Commission of Maryland
Planning and Programming Division

Party _____
Date 10/30/69

DIAGRAM FOR RAILROAD GRADE CROSSING

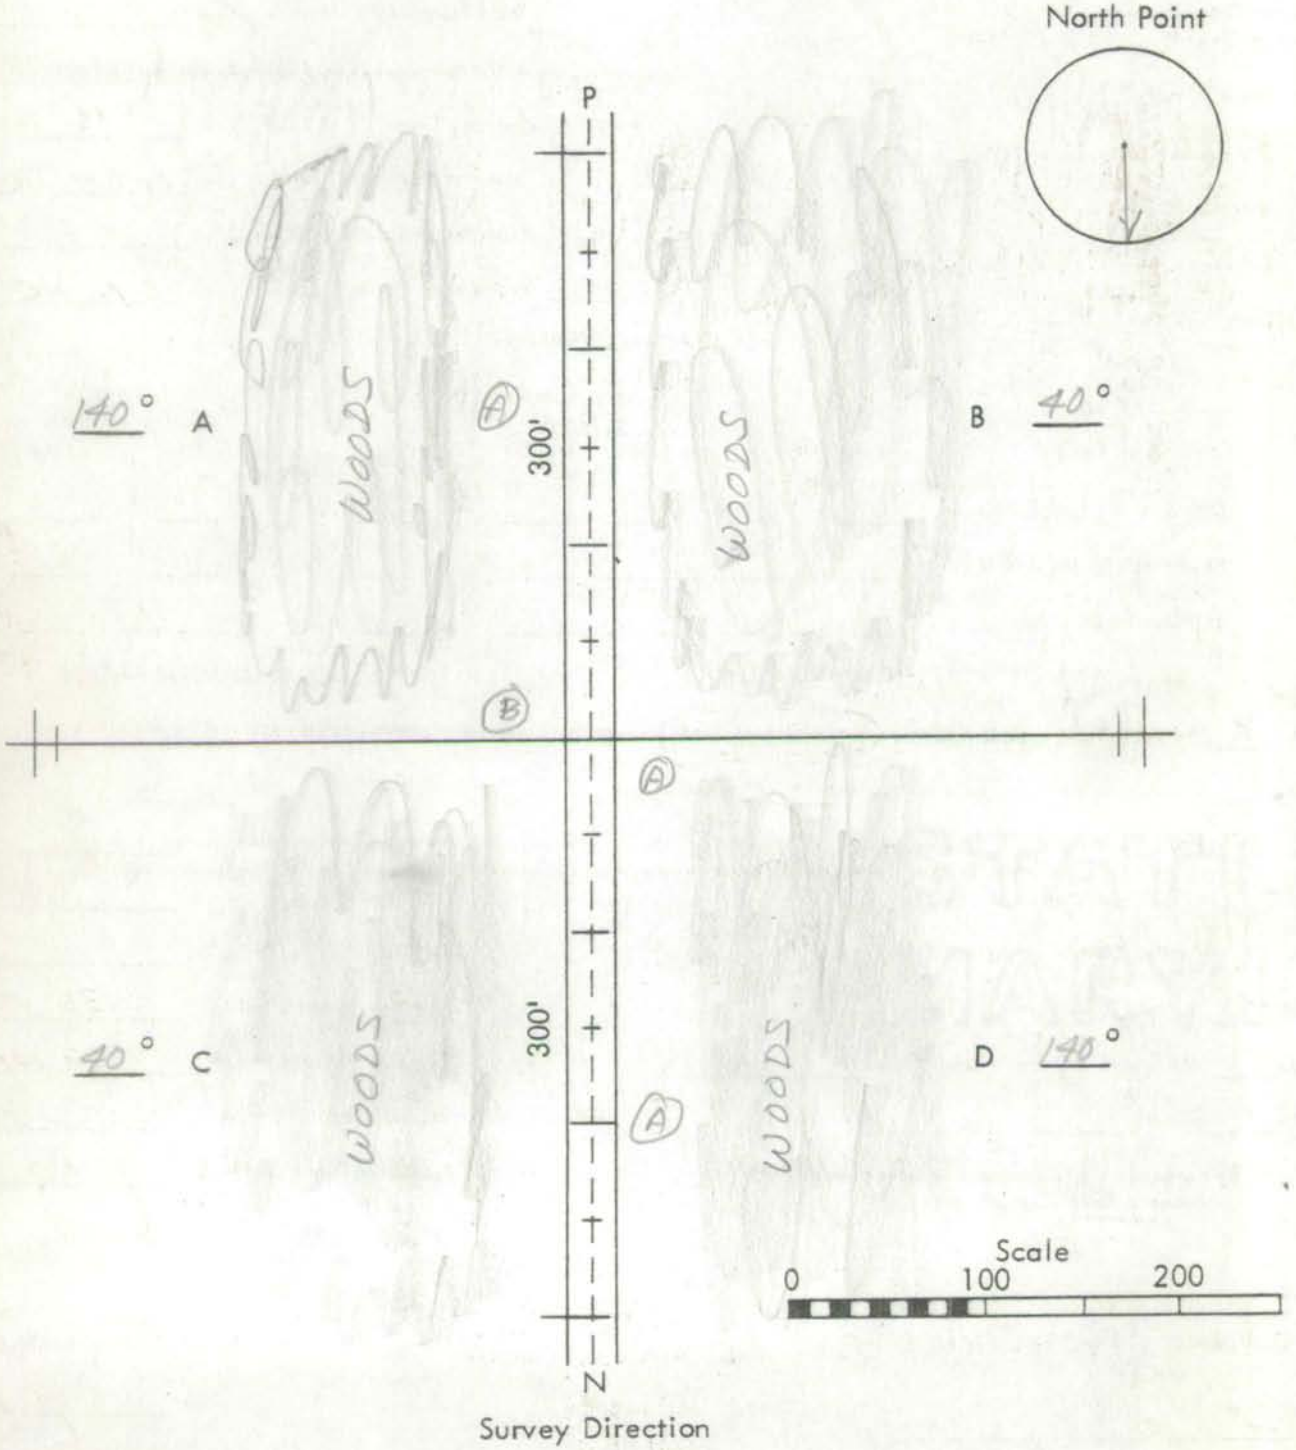

Remarks: _____

CROSSING
017

COUNTY # 103
LEELAND RD. SOUTH.

TURN PICTURES OVER

1

2

3

4

PRINCE GEORGES Co 10/30/69

PICTURE TAKEN FACING SOUTH
ON Co 103 LEELAND RD.

H9324481

1

PRINCE GEORGES Co 10/30/69

PICTURE TAKEN FACING NORTH
ON Co 103 LEELAND RD

J9265501

2

PRINCE GEORGES Co 10/30/69

PICTURE TAKEN FACING WEST
ON Co 103 LEELAND RD

J9265501

3

PRINCE GEORGES Co 10/30/69

PICTURE TAKEN FACING EAST
ON Co 103 LEELAND RD

J9265501

4

Form 5-HPS
(Revised 1961)

MARYLAND STATE ROADS COMMISSION
PLANNING AND PROGRAMMING DIVISION

S26130

IN COOPERATION WITH
U. S. BUREAU OF PUBLIC ROADS

ROAD NO. CO 103

BRIDGE SHEET

SHEET NO. 1A

PARTY NO.

DATE 7-9-68

COUNTY PRINCE GEO

RATED CAPACITY

FOR ALL STRUCTURES HAVING A TOTAL OPENING OF MORE THAN 20 FEET AS DEFINED IN NOTE 1.

ODOMETER READING 0.40 NAME OF STREAM, RAILROAD OR HIGHWAY CROSSED COLLINGTON BRANCH STREAM

NUMBER OF RAILROAD TRACKS
KIND OF CROSSING (NOTE 2)

UNDERPASS-SIMPLE UNDERPASS-COMBINED (NOTE 3) OVERPASS BRIDGE OVER SYSTEM

DESCRIPTION

NUMBER OF SPANS	LENGTH EACH SPAN (NOTE 4)	TYPE (NOTE 5)
1	28'	PONY TRUS

TOTAL LENGTH-ON LINE OF ROAD OVER-ALL (NOTE 6)

MATERIAL
SUBSTRUCTURE IRON SUPERSTRUCTURE
FLOOR IRON, BIT MIX COVER

CLEARANCES
ROADWAY (NOTE 7) SIDEWALK WIDTHS: RIGHT LEFT

SURFACE OF ROAD TO STREAM BED 8' FOR OVERPASSES, SHOW DISTANCES TO TOP OF RAIL OR SURFACE OF LOWER ROAD. (NOTE 8)
SURFACE OF ROAD TO BOTTOM PORTAL (MINIMUM OVERHEAD CLEARANCE
CLEAR DISTANCE OF OPENING ABOVE STREAM BED 5' (WATERWAYS ONLY)
POSTED LOAD LIMITS 16,000 BRIDGE NO. CONSTRUCTION DATE

GENERAL CONDITION OF BRIDGE: CHECK IF GOOD, FAIR, OR POOR, DESCRIBE DEFECTS IF SERIOUS.

	GOOD	FAIR	POOR
SUPERSTRUCTURE		✓	
FLOOR		✓	
SUBSTRUCTURE		✓	
PAINT		BADLY CORRODED OR RUSTED	

TYPE OF PROTECTION FOR DRAWBRIDGES (NOTE 9)

(NOTES ON REVERSE SIDE)

S26130

Notes:

1. In agreement with Federal-aid standards, a bridge is defined as a structure including supports erected over a depression or an obstruction, as water, highway, or railway, and having a track or passageway for carrying traffic or other moving loads, and having a length measured along the center of roadway of more than 20 feet between undercoping of abutments or spring lines of arches, or extreme ends of openings for multiple boxes and pipes, where the clear distance between openings is less than half of the smaller contiguous opening.

2. Show kind of crossing by checking descriptive item applicable. For multiple-span bridges give complete information on each span including approach spans. Indicate on leg sheet the odometer reading, position, and angle of skew of structure with respect to center line of road and by arrow the direction of stream flow.

3. Give information on the span over the highway only.

4. For span length use center to center of bearings, otherwise the clear opening. Skew bridges will be measured along center line of road. See Note 1.

5. Show general type such as: Trestle, Truss, Girder, I-Beam, Rigid Frame, Arch, Slab, Suspension, or Covered Bridge. See illustrations attached. Describe draw spans by classifications listed in Article X, Section 2 of Manual.

6. The length of a bridge structure is the over-all length measured along the line of survey stationing back to back of back-walls of abutments, if present, otherwise end to end of bridge floor, but in no case less than the total clear opening of the structure.

7. Give minimum lateral clearance. Where traffic lanes are separated by bridge numbers, show clearance width of each lane separately. Special conditions should be explained by notes.

8. In case of overhead bracing or arch construction, measurement shall be made to the lowest point above the road surface.

9. Use classification listed on RR crossing sheet. Form 4 HPS.

Remarks: _____

A rearrangement of the form similar to that shown on the attachment may be used to provide space for coding.

SHA 51.3-8
11-15-72

STATE HIGHWAY ADMINISTRATION OF MARYLAND

DT/TT
12-14-94
94-53

ROAD INVENTORY SHEET

Party Chief ES.
Recorder WD.
Helper REWRITTEN BY ER 11-7-79

Map No. M 32

Road No. CO. 104
Road Name MILL BRANCH RD.
Sheet No. 1 OF 1
Date 7-8-68
County P. G.
State Coordinates 881-401

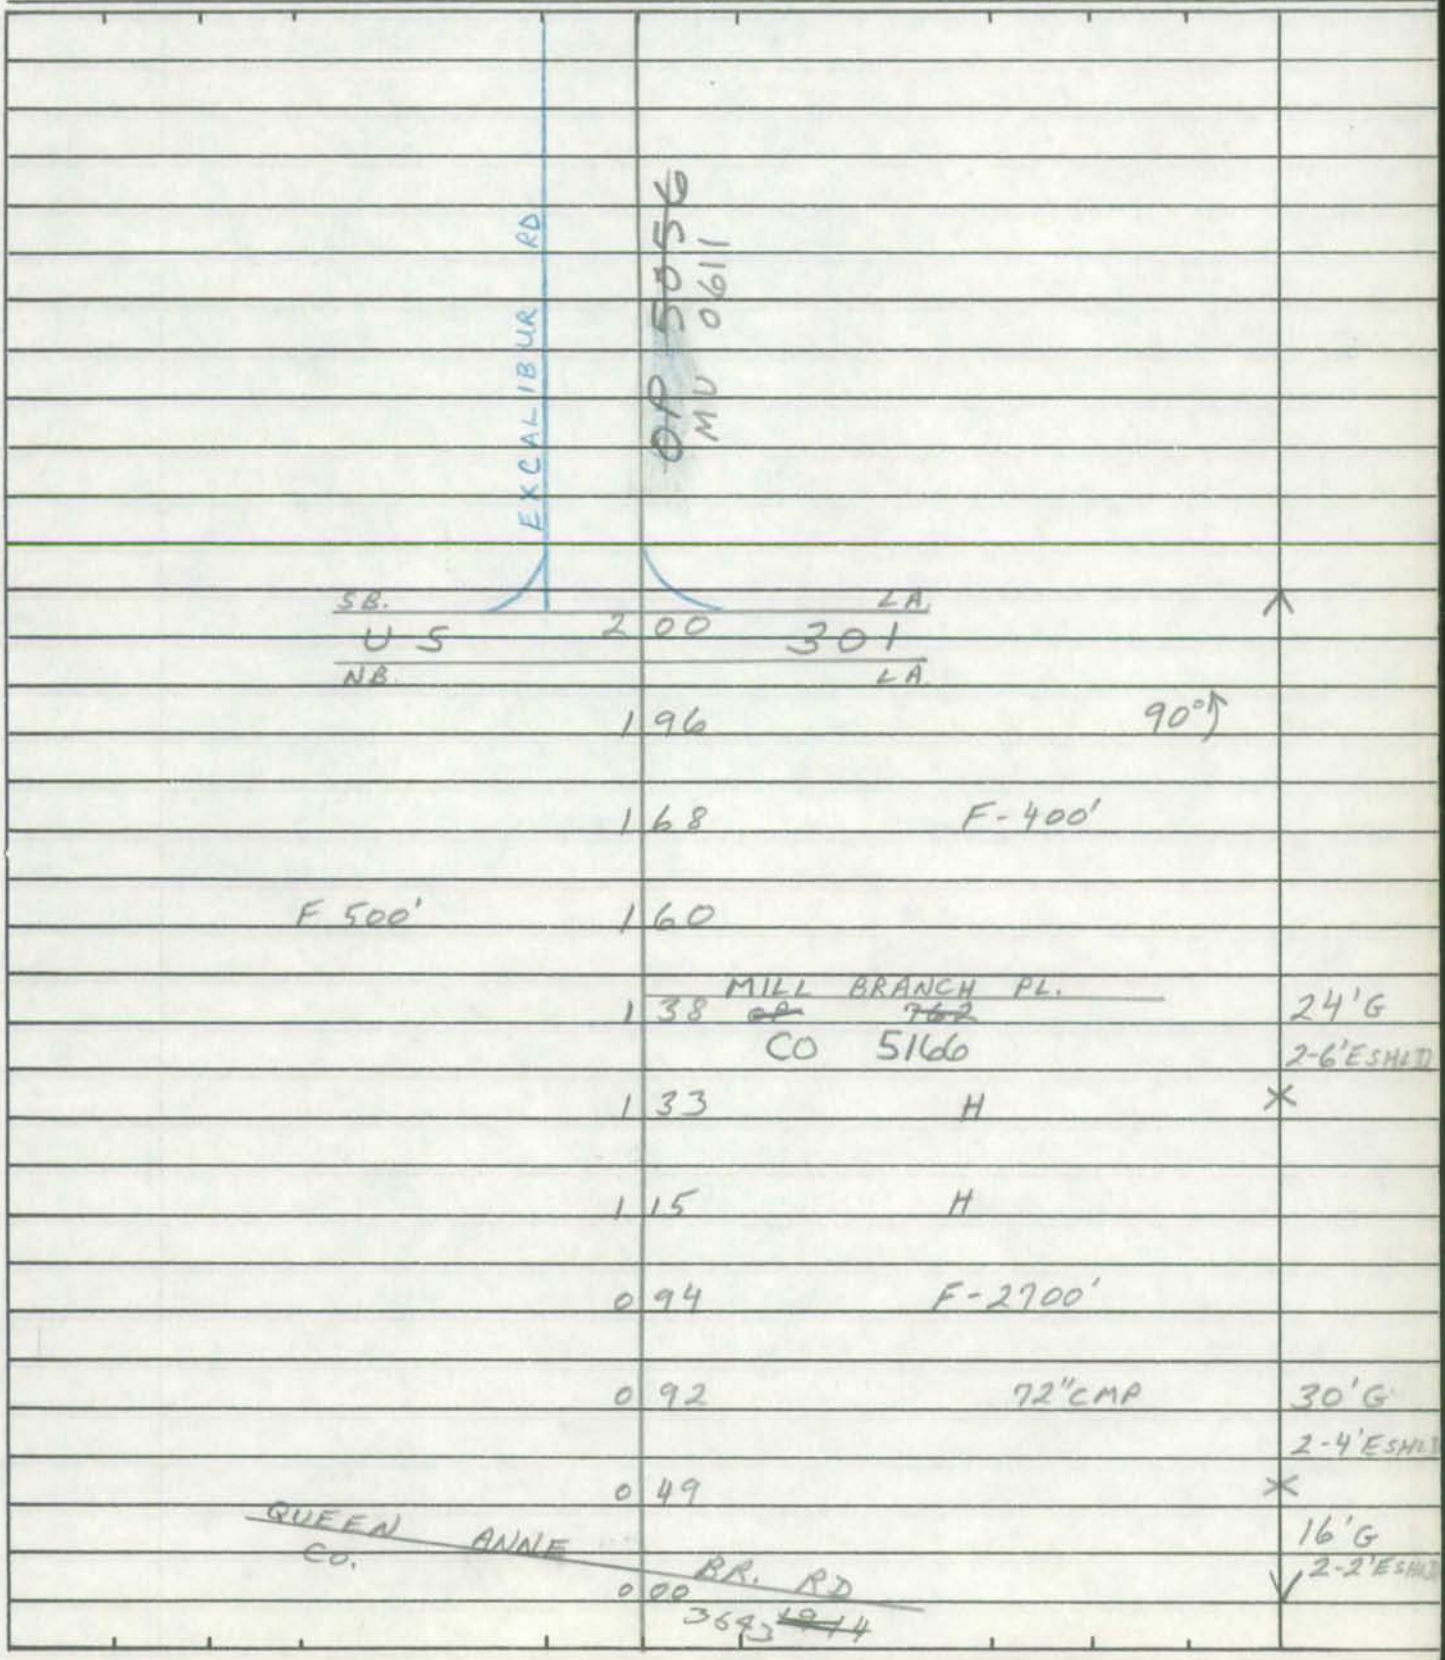

SHA 51.3-8
11-15-72

ROAD INVENTORY SHEET

Road No. _____
Road Name _____
Sheet No. _____
Date _____
County _____
State Coordinates _____

Form 6 HPS (Rev. 1961)

MAP 3

1-033-B
9.7-15
3-11-98
BB/AP

ROAD INVENTORY SHEET

VER 11-16-77

Party Chief E. SCHOYCER
Recorder W. DAMBROSKI
Chainman

809.426
M31

Road No. 67-30 CO 105
Name ADELPHI RD
Sheet No. 1 OF 2
Date 5-6-69
County PRINCE GEORGES

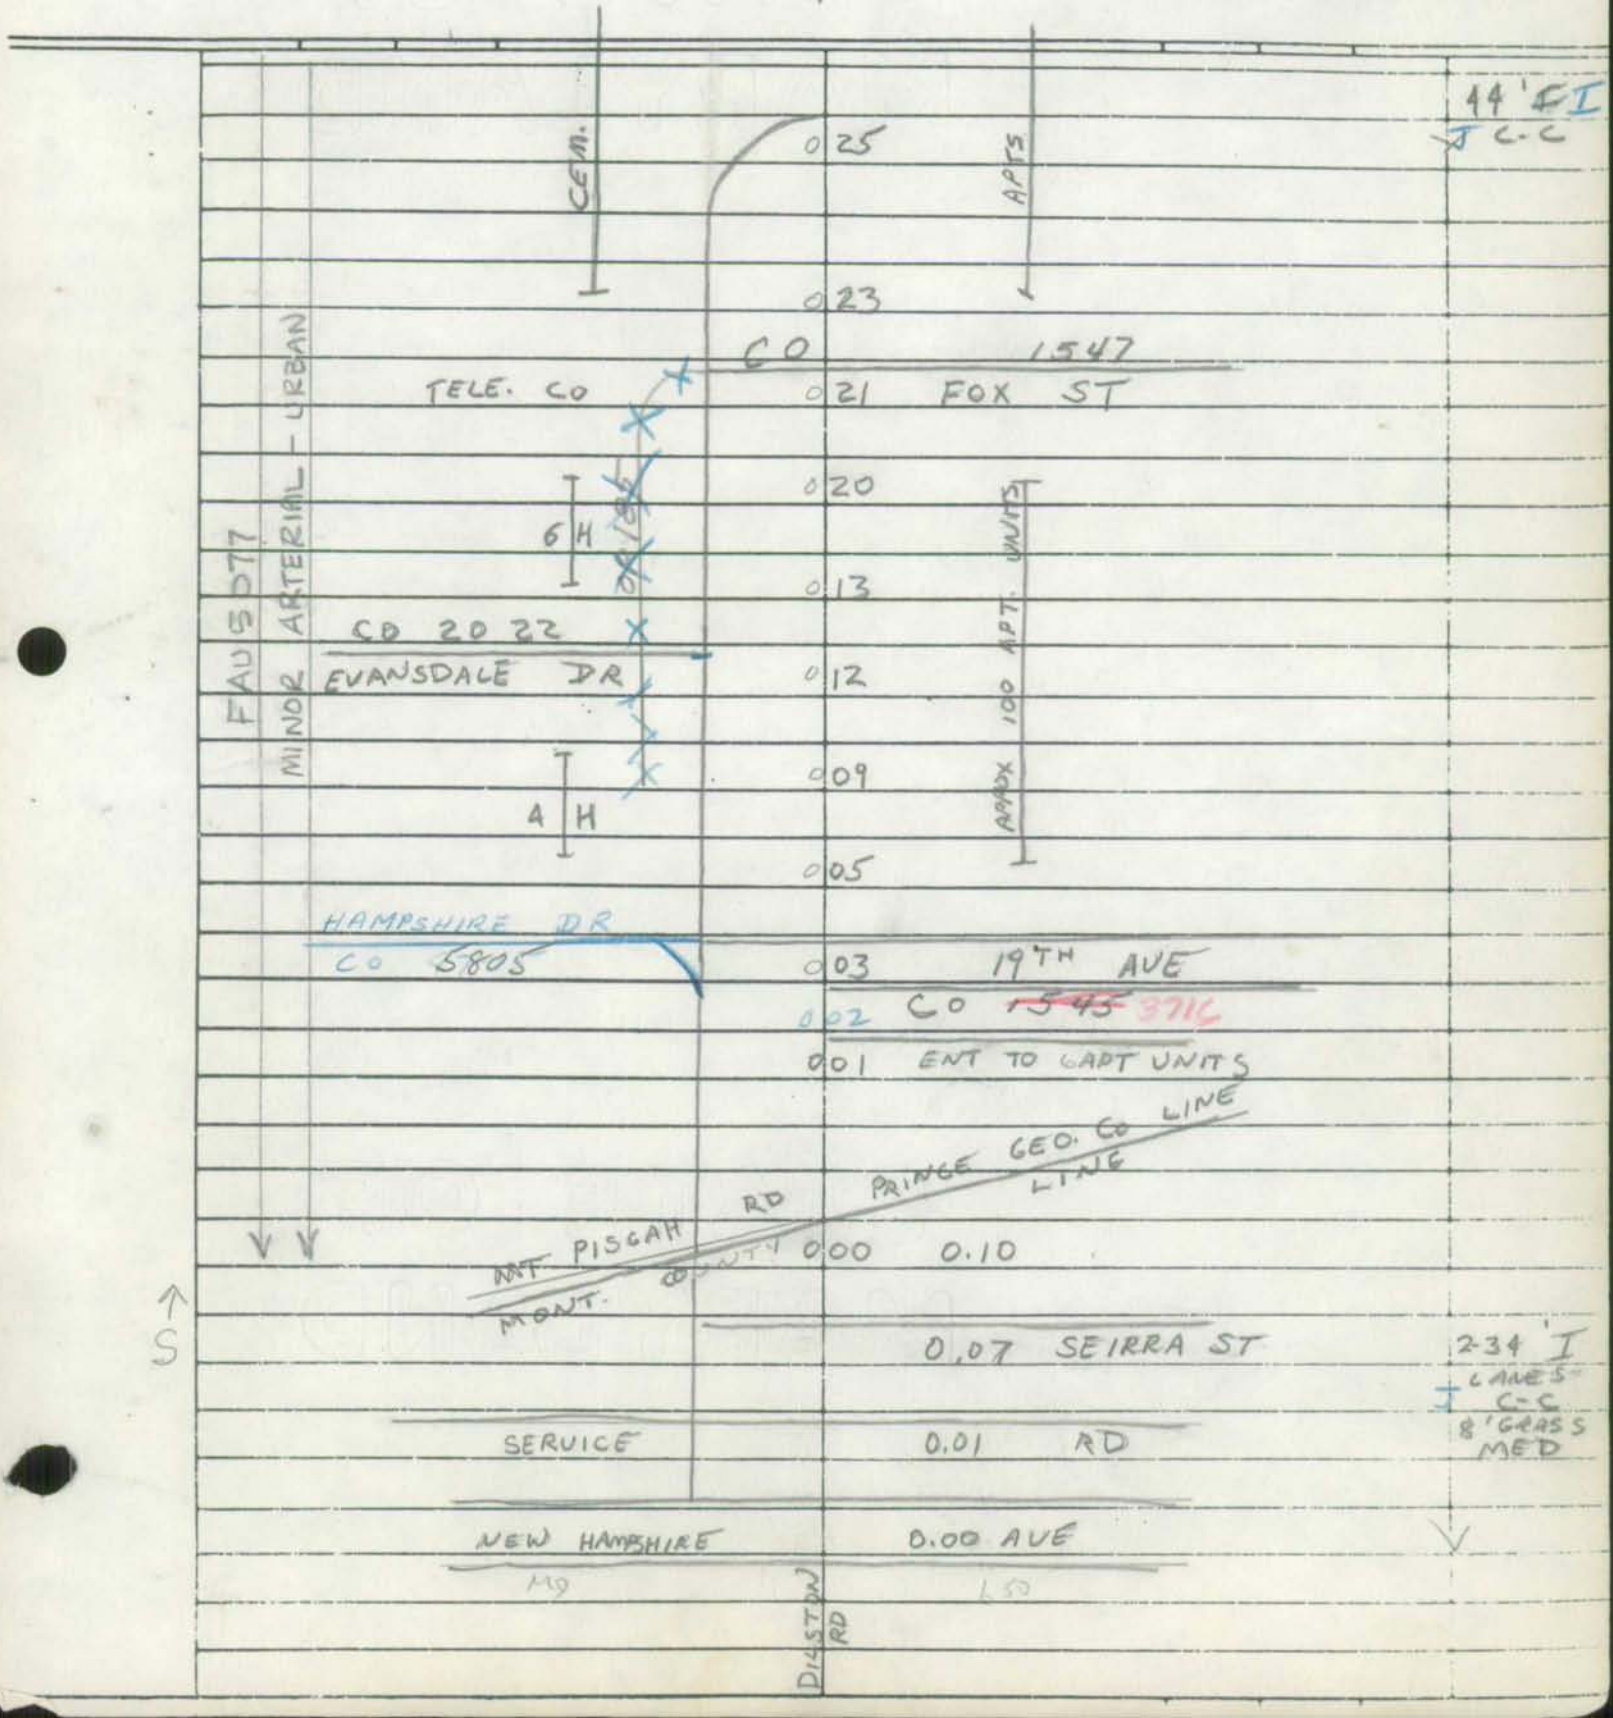

Form 6 HPS (Rev. 1961)

18

ROAD INVENTORY SHEET

(67-30)

Party Chief E. SCHUYLER
Recorder W DOMBROSKI
Chainman

Road No. CO 105
Name ADELPHI RD
Sheet No. 2 OF 2
Date 5-6-69
County PRINCE GEORGES

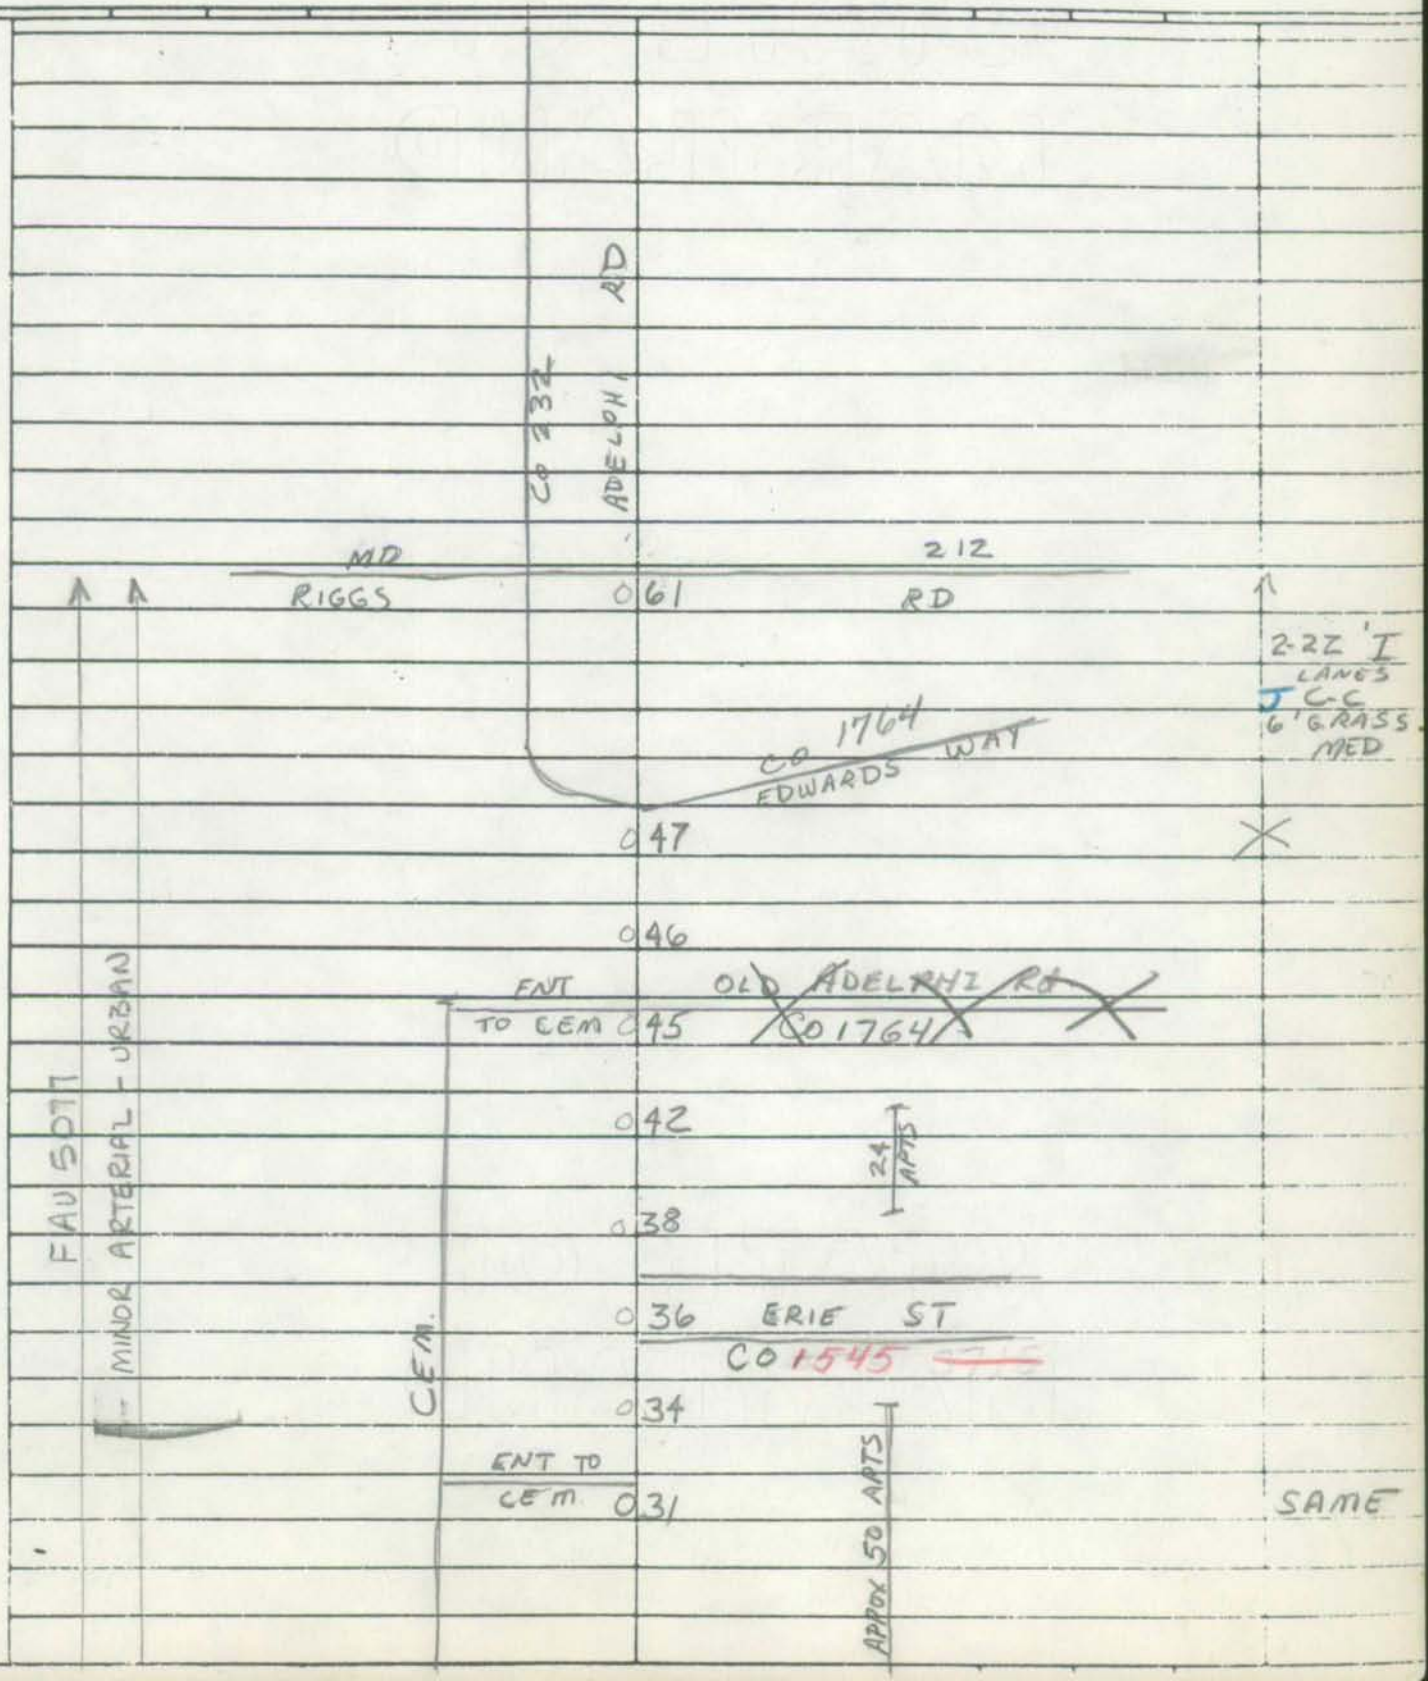

SHA 51.3-8
11-15-72

STATE HIGHWAY ADMINISTRATION OF MARYLAND

ROAD INVENTORY SHEET

Party Chief ES
Recorder FS
Helper REWRITTEN BY FR. 11-7-79

Map No. M31D

Road No. CO. 106
Road Name JEFFERSON ST
Sheet No. 1 OF 1
Date 6-18-68
County P.G.
State Coordinates 841-401

ROAD	0 30 END	
	0 29	20'G
3 H		2-3'ESHLD
	0 22	X 30'CW
BOLD ST. CO. 2450	0 19	
	0 18	
3 H		
	0 15	26'I
		3"-C-LT.
ARDWICK-ARDMORE CO.	0 12 RD. 65	X 28'CW
H	0 05	
		20'I
OLD ARDWICK-ARDMORE RD. CO. 171	0 00	30'CW

SHA 51.3-8
11-15-72

ROAD INVENTORY SHEET

Road No. _____
Road Name _____
Sheet No. _____
Date _____
County _____
State Coordinates _____

Form 6 HPS (Rev. 1961)

FAU MAP 4 MD AN 1-264-A

(92-2)
CO PA H 3-5-93

ROAD INVENTORY SHEET

Party Chief E. SCHUYLER
Recorder T. LANDON
Chainman E. KOENIG

Road No. Co 107
Name MAPLE AVE.
Sheet No. 1 OF 2
Date 4-9-68
County PRINCE GEORGES

VER 18
6-6

BOWIE
863-429 M32

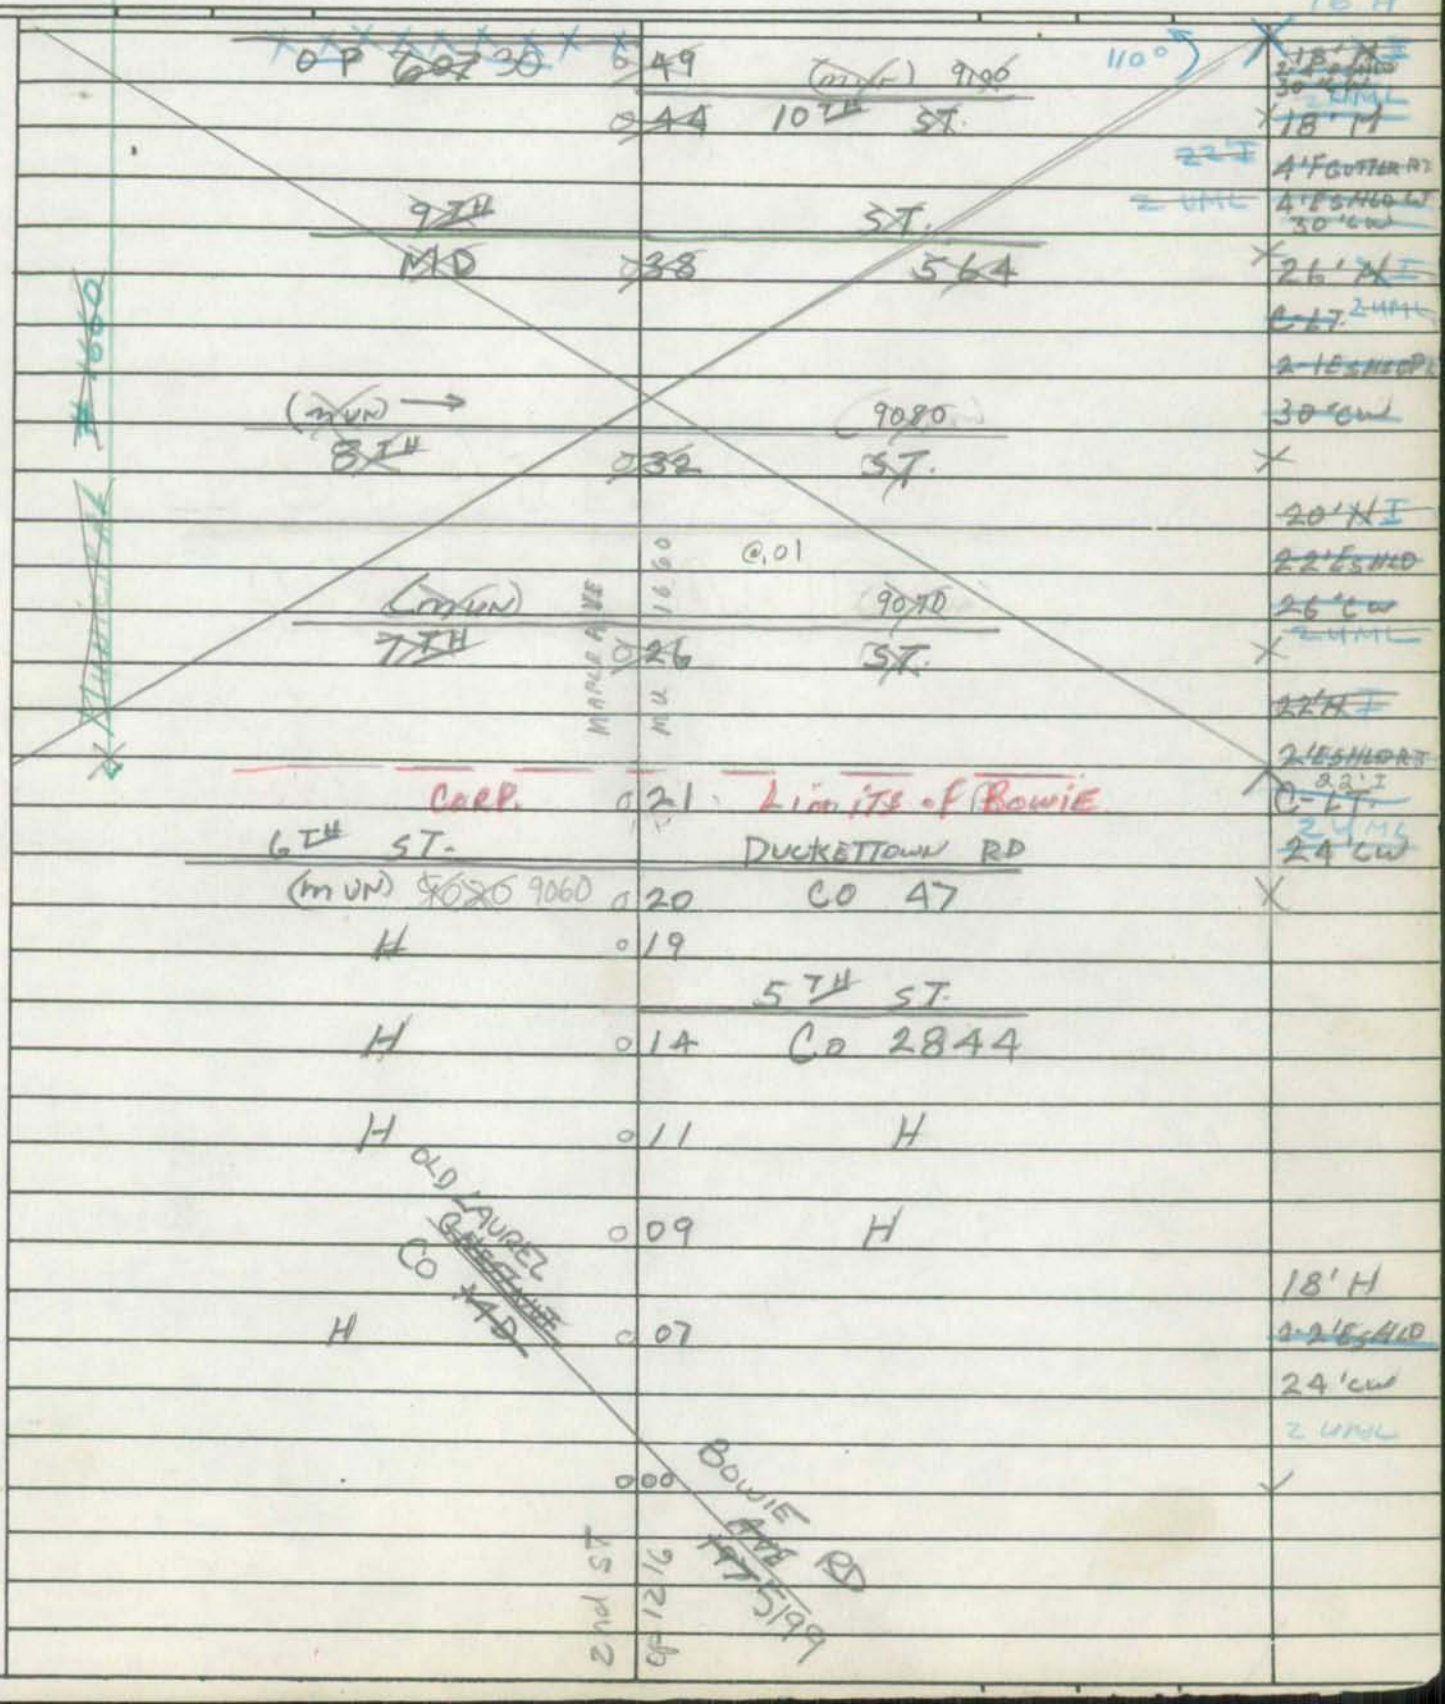

Form 6 HPS (Rev. 1961)

FHA MAP 10 Washington Urban 5-071

ROAD INVENTORY SHEET

PARTY CHIEF Frederick Settan
RECORDER Thomas Landon
CHAINMAN

Gen Hwy D

ROAD NO. Co 108
NAME CROOM STATION RD
SHEET NO. 10 F 3
DATE 8-3-67
COUNTY PRINCE GEORGES

866-355 M36

			F RD 0.35 T.H.
H	120		PVT 0 P.O.T.H. 11'D
	105		
H	098		
US	093	301	
	084	CBC L-10'XW-24'XD-5'	
H	075		
	058	H	
PT 30° PC	055	CHEW RD Co 109	
	048		
F	041		17'F
			2-4'E SHLD
H	034		30'CW
Co 71	033	F	M
LODGE HALL	028		
			24'I
	013	F	2-8'E SHLD
			50'CW
OLD CABIN Co	000	HWY 1212	✓

S

899 FASV

Form 6 HPS (Rev. 1961)

ROAD INVENTORY SHEET

PARTY CHIEF Frederick Settan
RECORDER Thomas Landon
CHAINMAN

ROAD NO. Co 108
NAME
SHEET NO. 2 OF 3
DATE 8-3-67
COUNTY PRINCE GEORGES

45°
RVRSIGN
RVRSIGN
#PE 529 584L
45°
H
RVRSIGN
PT
90°
PC
H
OP 518
~~OP "A"~~
CHARLES
#PE 503
BRANCH
SEE BRS+11-A
24" CMP
H H H
PVT OP RD
PT
30°
PC
OP
H

2 44
2 43
2 41
2 39
2 37
2 35
2 25
2 21
2 19
2 04
1 98
1 80
1 66
1 61
1 41
1 34

399
FAS U

SHEET

Form 6 HPS (Rev. 1961)

ROAD INVENTORY SHEET

PARTY CHIEF Frederick Settan
RECORDER Thomas Landon
CHAINMAN

ROAD NO. Co 108
NAME
SHEET NO. 30F3
DATE 8-3-67
COUNTY PRINCE GEORGES

C Room | RD
MD 255 | 382

H Region 251

SAME

Form 5-HPS
(Revised 1956)

MARYLAND STATE ROADS COMMISSION
TRAFFIC DIVISION

S26130

IN COOPERATION WITH
U. S. BUREAU OF PUBLIC ROADS

ROAD NO. Co 108

BRIDGE SHEET

SHEET NO. 1-A

PARTY NO. _____

DATE 8-3-67

COUNTY PRINCE GEORGES

RATED CAPACITY _____

FOR ALL STRUCTURES HAVING A TOTAL OPENING OF MORE THAN 20 FEET AS DEFINED IN NOTE 1.

ODOMETER READING 2.04 NAME OF STREAM, RAILROAD OR HIGHWAY CROSSED CHARLES BRANCH

NUMBER OF RAILROAD TRACKS _____
KIND OF CROSSING (NOTE 2) _____

UNDERPASS - SIMPLE UNDERPASS - COMBINED (NOTE 3) OVERPASS BRIDGE OVER SYSTEM

DESCRIPTION

NUMBER OF SPANS	LENGTH EACH SPAN (NOTE 4)	TYPE (NOTE 5)
1	20'	CONCRETE
1	19'	"

TOTAL LENGTH - ON LINE OF ROAD OVER-ALL (NOTE 6) 39'

MATERIAL
SUBSTRUCTURE CONCRETE SUPERSTRUCTURE CONCRETE
FLOOR CONCRETE

CLEARANCES
ROADWAY (NOTE 7) 22' SIDEWALK WIDTHS: RIGHT _____ LEFT _____

SURFACE OF ROAD TO STREAM BED 8' FOR OVERPASSES, SHOW DISTANCES TO TOP OF RAIL OR SURFACE OF LOWER ROAD. (NOTE 8)
SURFACE OF ROAD TO BOTTOM PORTAL 2' (MINIMUM OVERHEAD CLEARANCE
CLEAR DISTANCE OF OPENING ABOVE STREAM BED 6' (WATERWAYS ONLY)
POSTED LOAD LIMITS _____ BRIDGE NO. _____ CONSTRUCTION DATE _____

GENERAL CONDITION OF BRIDGE: CHECK IF GOOD, FAIR, OR POOR, DESCRIBE DEFECTS IF SERIOUS.

	GOOD	FAIR	POOR
SUPSTRUCTURE			
FLOOR	✓		
SUBSTRUCTURE	✓		
PAINT			

BADLY CORRODED OR RUSTED

TYPE OF PROTECTION FOR DRAWBRIDGES (NOTE 9) _____

(NOTES ON REVERSE SIDE)

S26130

Notes:

1. In agreement with Federal-aid standards, a bridge is defined as a structure including supports erected over a depression or an obstruction, as water, highway, or railway, and having a track or passageway for carrying traffic or other moving loads, and having a length measured along the center of roadway of more than 20 feet between undercoping of abutments or spring lines of arches, or extreme ends of openings for multiple boxes and pipes, where the clear distance between openings is less than half of the smaller contiguous opening.

2. Show kind of crossing by checking descriptive item applicable. For multiple-span bridges give complete information on each span including approach spans. Indicate on leg sheet the odometer reading, position, and angle of skew of structure with respect to center line of road and by arrow the direction of stream flow.

3. Give information on the span over the highway only.

4. For span length use center to center of bearings, otherwise the clear opening. Skew bridges will be measured along center line of road. See Note 1.

5. Show general type such as: Trestle, Truss, Girder, I-Beam, Rigid Frame, Arch, Slab, Suspension, or Covered Bridge. See illustrations attached. Describe draw spans by classifications listed in Article X, Section 2 of Manual.

6. The length of a bridge structure is the over-all length measured along the line of survey stationing back to back of back-walls of abutments, if present, otherwise end to end of bridge floor, but in no case less than the total clear opening of the structure.

7. Give minimum lateral clearance. Where traffic lanes are separated by bridge numbers, show clearance width of each lane separately. Special conditions should be explained by notes.

8. In case of overhead bracing or arch construction, measurement shall be made to the lowest point above the road surface.

9. Use classification listed on RR crossing sheet. Form 4 HPS.

Remarks: _____

A rearrangement of the form similar to that shown on the attachment may be used to provide space for coding.

P & P 104

RAILROAD GRADE CROSSING SHEET

State Roads Commission of Maryland
Planning and Programming Division

1. GENERAL

Crossing No. .....

Mile Pole Number (R.R. Co.) ... NONE

Coordinates ..... x 866 y 344

System Classification (Check One)

- State Primary ..... ☐
- State Secondary ..... ☐
- State Road Only ..... ☐
- County ..... ☒
- Local ..... ☐ (Specify)

County and/or Municipality .. PRINCE GEORGES

U.S. Route Number .....

State Route Number .....

Road Number/Name ..... Co 108

Station 2.43

Surface Type ..... 15'F

Name of Railroad ..... PENN

Number of Main Tracks 1

Number of Other Tracks ..... NONE

2. TRAIN MOVEMENTS

Time Period	Pass	Freight	Train Speed at Grade: Pass	Train Speed at Grade: Freight	Spur	Remarks (Other than daily): Pass	Remarks (Other than daily): Freight
Day 6 A.M. to 6 P.M.							
Night 6 P.M. to 6 A.M.							
24 Hour Total							

3. TYPE OF PROTECTION

P.a. 4 Warning Signs - Reflectorized, (Non-reflectorized)

b. 0 Crossing Signs - Reflectorized, Non-reflectorized

c. 0 Road Marking

d. 0 Lights - Flashing, Stationary

e. 0 Traffic Control (Stop and Go) Signals

f. 0 Automatic Gate

g. 0 Watchman - Gate, Flag...hours

h. 0 Others

* By numerals 1 or 2 indicate whether installation is on one or both sides of track.

4. ALIGNMENT FACTOR

P. 416'

N. 572'

Average Daily Trains ...

Train Speed .....

Highway ADT.....

Highway Speed Limit ... 40 MPH

Average Vehicle Speed . 30 MPH

Max. Approach Grade .. N+0.2·P.0

Restricted Sight Distance . NO (On Highway)

5. QUADRANT ... SIGHT DISTANCE

		@300'	@10'
A	100°	0	988'
B	80°	0	572'
C	°	0	989'
D	°	571'	572'

6. ACCIDENT RECORD (Vehicles & Trains)

Year	No. of Accidents	No. of Fatalities
1961		
1962		
1963		
1964		
1965		
Total		

7. CROSSING RATING

A

B

C

D

Total

State Roads Commission of Maryland
Planning and Programming Division

Party SETTAVLADON
Date 8-3-67

DIAGRAM FOR RAILROAD GRADE CROSSING

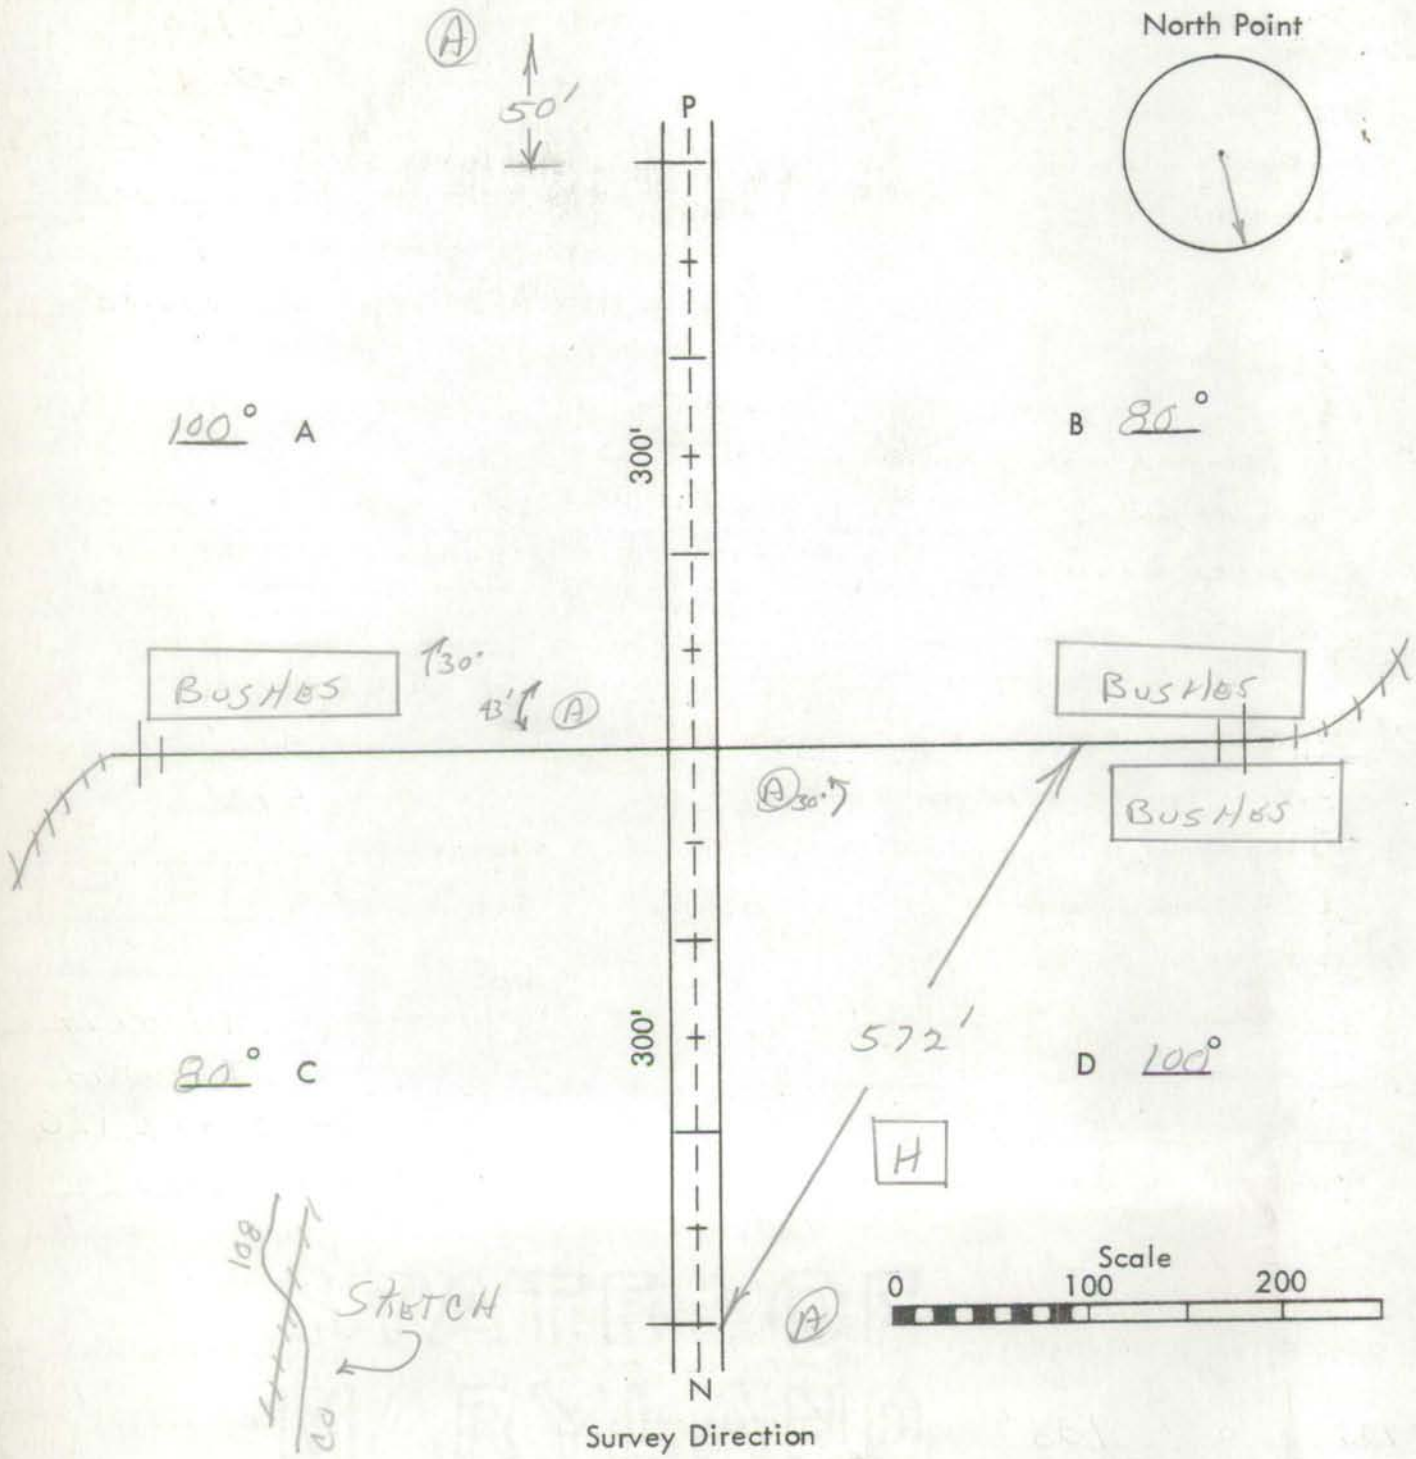

Remarks: NO 300' SIGHT DISTANCE ON ANGLES "B" + "C" BECAUSE THE TRACK PARALELLS THE ROAD

Form 6 HPS (Rev. 1961)

FAU MAP 10

Greater Upper Marlboro Sm. Urban 5-050

ROAD INVENTORY SHEET

91-180 extra 2-12-92 DT/JS

PARTY CHIEF Frederick Settan
RECORDER Thomas Landon
CHAINMAN

Gen Hwy

ROAD NO. Co 109
NAME CHEW RD
SHEET NO. 1 OF 2
DATE 8-3-67
COUNTY PRINCE GEORGES

VER 7-15-77 868-353 M36

OP 577

			9'D
	EXPANSION		14'CW
	144	EXPANSION	X
	140	EXPANSION	
H	136	H	
H	133		
		AT 0° RDD	
	114	9'CS	
		023 T.H.	
	094	CB L-14'X W-24'X D-6'	
		#10590	
	060		
	059	B- TRUCKING	
US	045	301	
	037	H	
			16'H
H	033		
	026		X
	018	H	24'I 2-3'ISLND 2 ML H
F	014		~~16'H~~
WAYNESFORD DR			~~2-3'ISLND~~
H CO 5297	008	H	X 24'CW
		RD 108	16'H
CROOM STATION CO	000		✓

Form 6 HPS (Rev. 1961)

ROAD INVENTORY SHEET

PARTY CHIEF Frederick Settan
RECORDER Thomas Landon
CHAINMAN

ROAD NO. Co 109
NAME
SHEET NO. 2 OF 2
DATE 8-3-67
COUNTY PRINCE GEORGES

H
ROAD END
H 164 H
OP 164
152
151 H

SAME

P & P 104

RAILROAD GRADE CROSSING SHEET

State Roads Commission of Maryland
Planning and Programming Division

1. GENERAL

Crossing No. 1V

Mile Pole Number (R.R. Co.) ... 1C

Coordinates ..... x 823 y 347

System Classification
(Check One)

State Primary ..... ☐

State Secondary ..... ☐

State Road Only ..... ☐

County ..... ☒

Local ..... ☐
(Specify)

County and/or Municipality .. PRINCE GEORGE

U.S. Route Number .....

State Route Number .....

Road Number/Name ..... C0109 CHEW RD

Station 144

Surface Type ..... 12'F

Name of Railroad ..... PENN A

Number of Main Tracks 1

Number of Other Tracks ..... NONE

2. TRAIN MOVEMENTS

Time Period	Pass	Freight	Train Speed at Grade: Pass	Train Speed at Grade: Freight	Spur	Remarks (Other than daily): Pass	Remarks (Other than daily): Freight
Day 6 A.M. to 6 P.M.							
Night 6 P.M. to 6 A.M.							
24 Hour Total							

3. TYPE OF PROTECTION

P a. 3 Warning Signs - Reflectorized, (Non-reflectorized)

b. ____ Crossing Signs - Reflectorized, Non-reflectorized

c. ____ Road Marking

d. ____ Lights - Flashing, Stationary

e. ____ Traffic Control (Stop and Go) Signals

f. ____ Automatic Gate

g. ____ Watchman - Gate, Flag...hours ____

h. ____ Others ____

* By numerals 1 or 2 indicate whether installation is on one or both sides of track.

4. ALIGNMENT FACTOR

P. 210'

N. 315'

Average Daily Trains ... ____

Train Speed ..... ____

Highway ADT..... ____

Highway Speed Limit ... ____

Average Vehicle Speed . 10 MPH

Max. Approach Grade .. N = -0.61+32

Restricted Sight Distance . NO
(On Highway)

5. QUADRANT ... SIGHT DISTANCE

		@300'	@10'
A	110°	0	470'
B	70°	0	440'
C	70°	0	285'
D	110°	0	330'

6. ACCIDENT RECORD
(Vehicles & Trains)

Year	No. of Accidents	No. of Fatalities
1961		
1962		
1963		
1964		
1965		
Total		

7. CROSSING RATING

A ____

B ____

C ____

D ____

Total ____

State Roads Commission of Maryland
Planning and Programming Division

Party SETTANI LANDON
Date 8-3-67

DIAGRAM FOR RAILROAD GRADE CROSSING

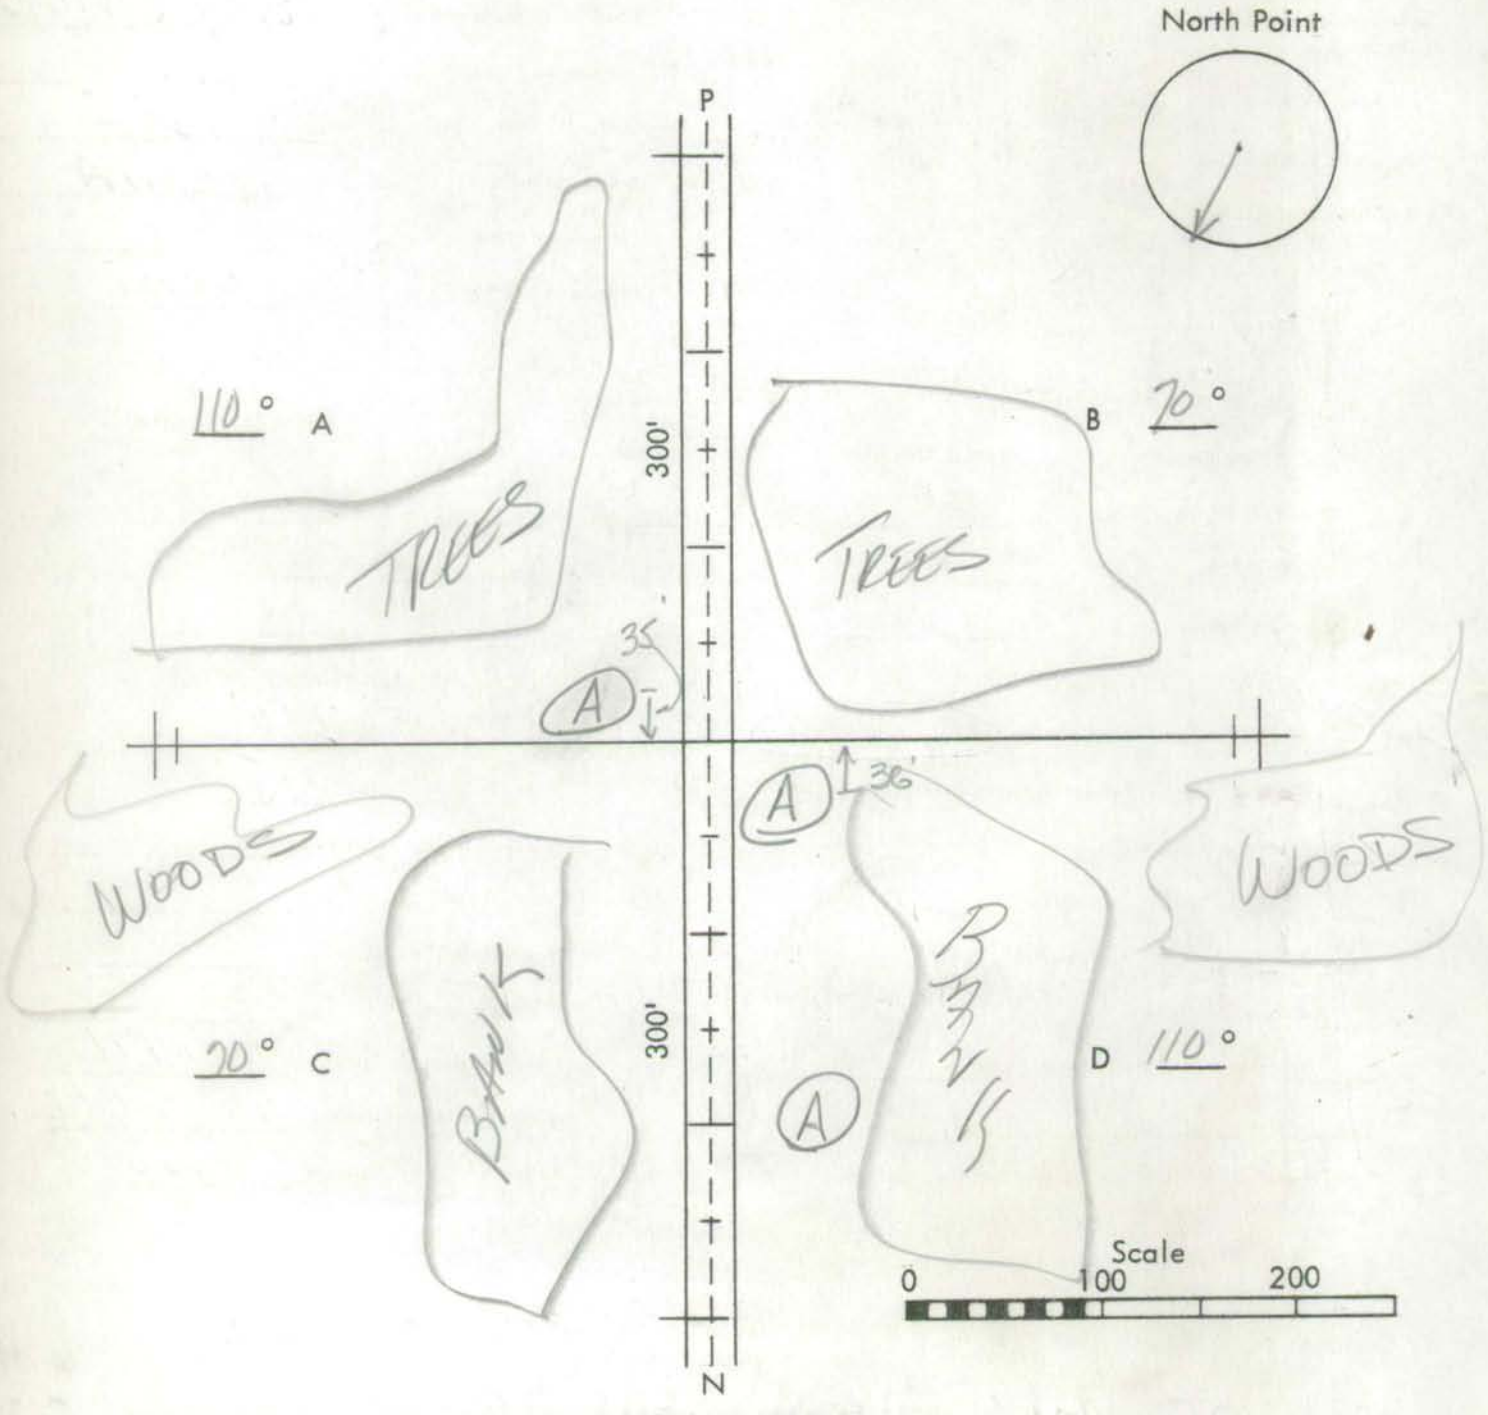

Survey Direction

Remarks: _____

Form 6 HPS (Rev. 1961) FHU MAPC 3-237 78

ROAD INVENTORY SHEET

Party Chief E Schuyler
Recorder T LANDON
Chairman J EMERICK
D Plummer
59-211 VER
8-19-77 810-360 M35

BARNABY OAKS MANOR

Road No. Co 110
Name WHEELER RD
Sheet No. 10F3
Date 12-21-67
County PRINCE GEORGES

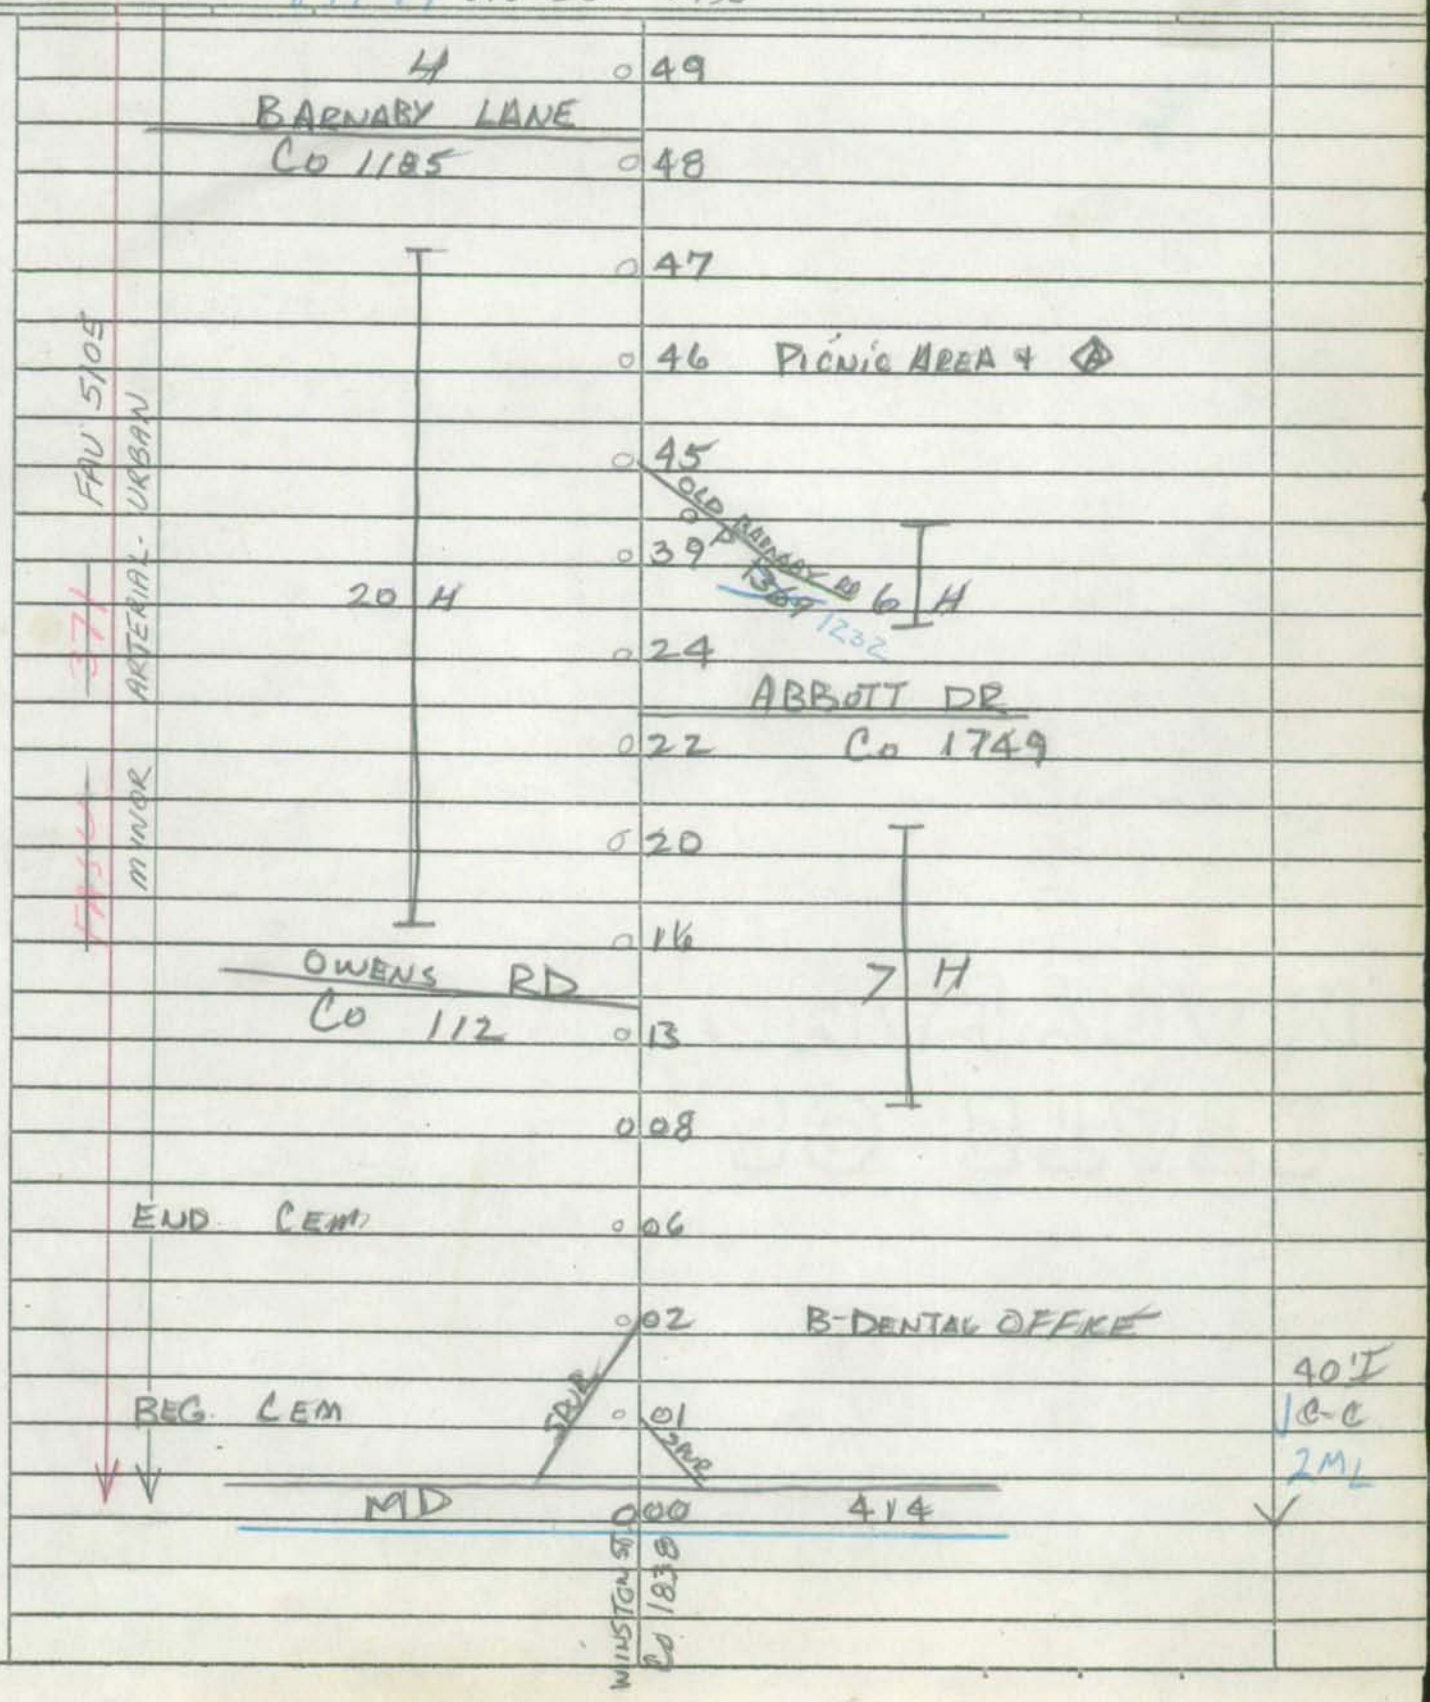

Form 6 HPS (Rev. 1961)

91-96
Z-892
DT/JS

ROAD INVENTORY SHEET

97-155
3-17-98
BB/AP

Party Chief E SCHUETTLER
Recorder I LANDON
Chainman U ENERICK BARNABY
D PLUMMER 83-128 BB JD OAKS
75-94 & 95 MANOR

Road No. Co 110
Name WHEELER RD.
Sheet No. 2 OF 3
Date 12 - 21 - 67
County PRINCE GEORGES

FAU 5105
MINOR ARTERIAL - URBAN
377
ACO

151 X
134 TWIN CBG 1-15'X2-10'D 1-2-100'W #P0304C
CALAIS CT 83-129
CO 4585
126
123 H 12' 34'I
H CO 4584 83-130 117 10'I SHD RT JCLT 2mL
CALAIS ST 116
IVERSON ST 150 24'CP 24'I
CO 1478 WHEELER RD 563
92 95 @1.08 CO 46'I JCLT 2mL
BOWIE FIELD
SPUR 91 H E X 42'I
A15 86 H 32'I CRT
LELAND DR
Co 1476 85 46'I 2mL
83
5 H 77 H
76 PT
MANOR DR
Co 1473 75 30° 40'I
74 JC-C 2mL
10 H 3 H 69 PC
BIRCHTREE LA
68 Co. 3935
IVERSON AVE PL
Co. 1192
57 SAME

Form 6 HPS (Rev. 1961)

78

ROAD INVENTORY SHEET

Party Chief F. SCHUYLER
Recorder T LANDON
Chainman J EMERICK
D PLUMMER

Road No. Co 110
Name WHEELER RD
Sheet No. 30F3
Date 12 - 21 -67
County PRINCE GEORGES

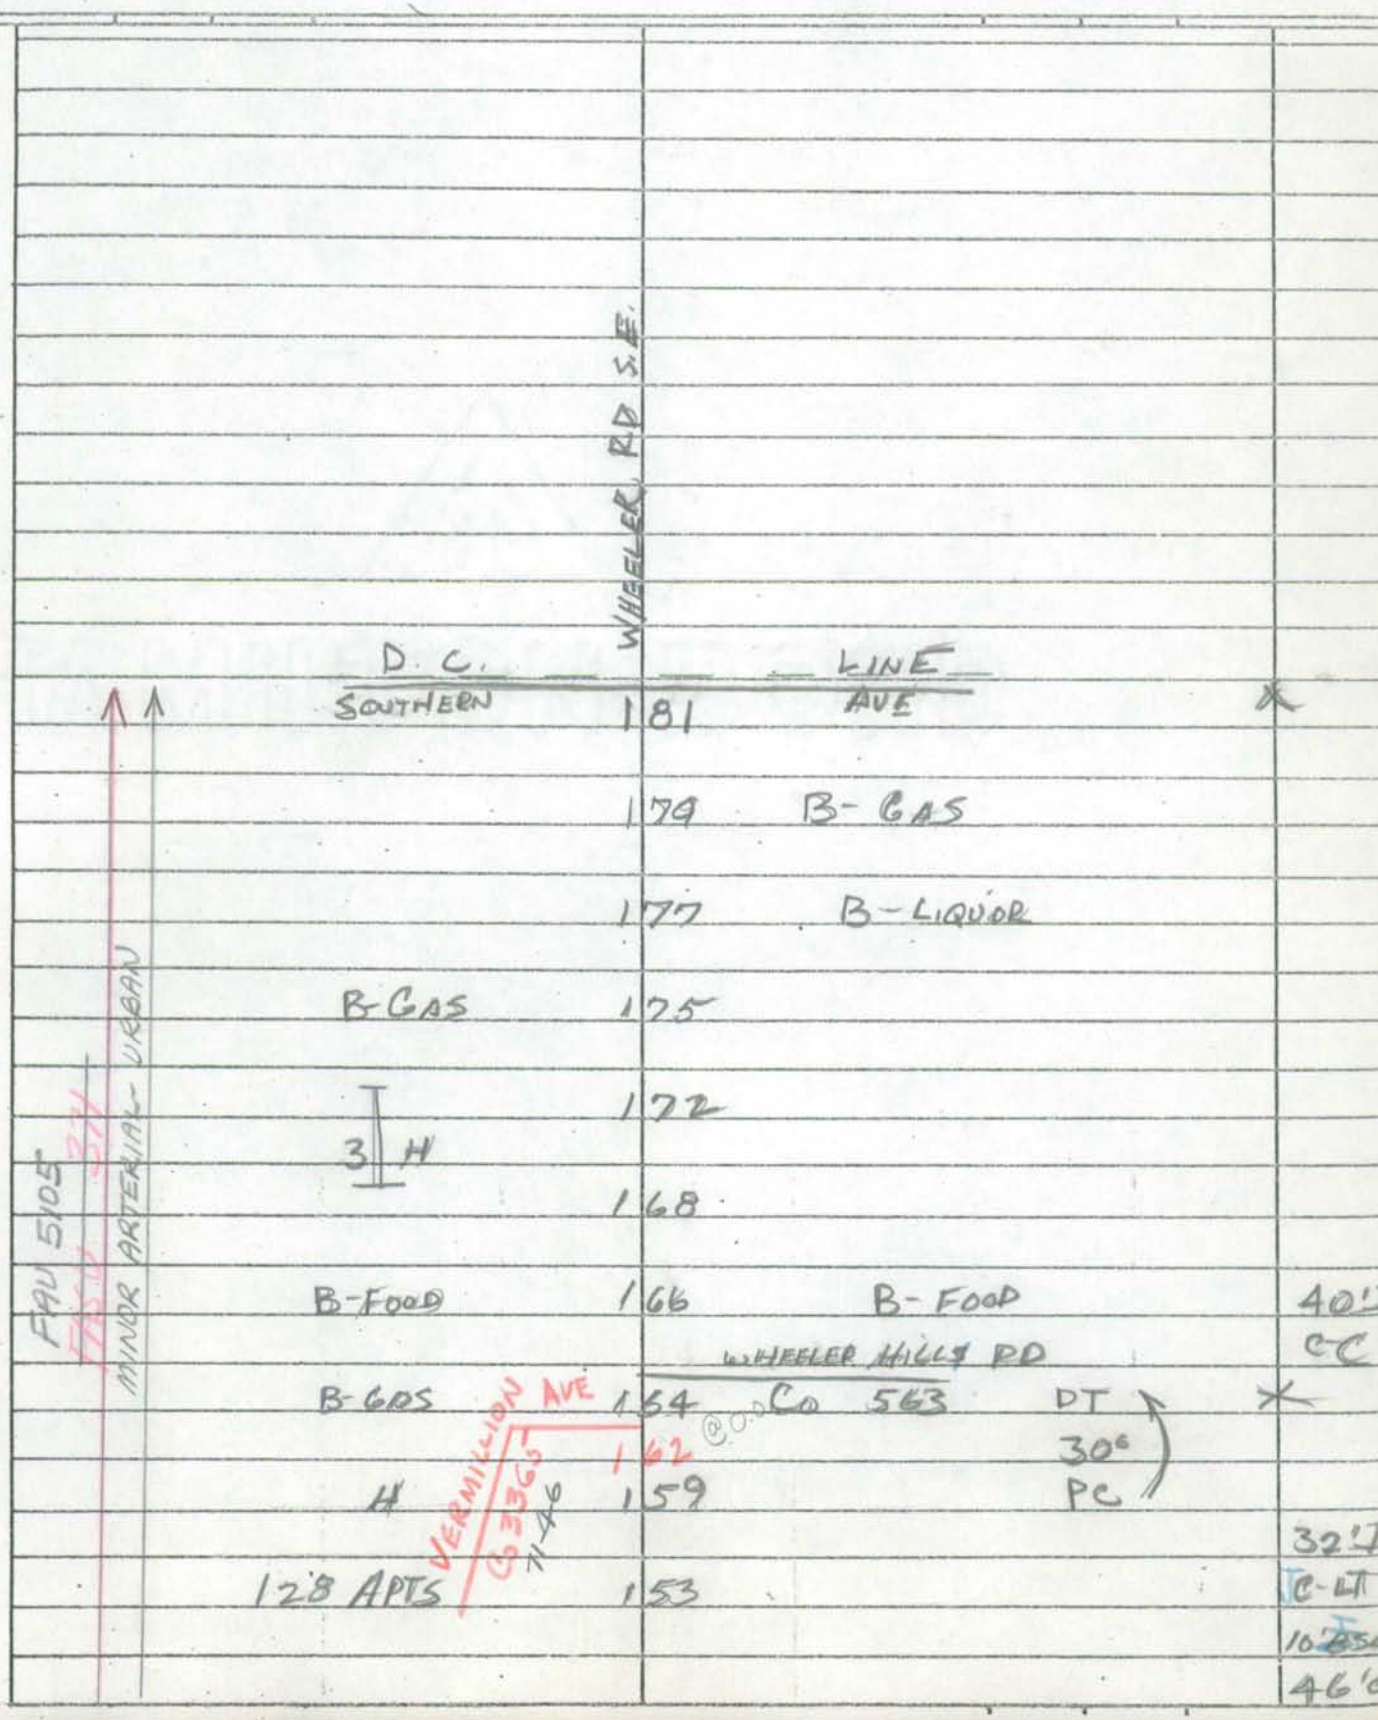

Wash Co Boun

97-117 extra

SHA 51.3 - 8 Revised 4.83

MARYLAND STATE HIGHWAY ADMINISTRATION

ROAD INVENTORY SHEET

Party Chief BB
Recorder AP
Assistant —
Map No./Dir. E-12C / E
State Coordinates 856-393

Road No. CO 111
Road Name WOODMORE RD
County PRINCE GEORGES
Date 3/12/98
Sheet No. 1 OF 3

98-41 A/T
95-82

TRAFFIC CODES
TRAFFIC CONTROLS: STOP SIGN-SS, TRAFFIC LIGHT=T.L., FLASHING RED BALL=F.R.

TRAFFIC CODES
PARKING RESTRICTIONS: A.M. PEAK, P.M. PEAK, A.M./P.M. PEAK, NO PARKING ANYTIME=N.P., COMM/IND. ACCESS=E

SYSTEM				TRAFFIC		LINE DIAGRAM	TRAFFIC			PAVEMENT DATA
FUNCT CLASS	HWY SYS	HPMS SAMPLE		PREG. REST.	COM/IND ACCESS		CONTROL	COM/IND ACCESS	PREG. REST.	
					E	END TO CHURCH 12' I LT 0 38				
						WOODVALE LA				
						12' I RT 0 36 CO 5828 @.38			X	
					E	EXIT FR. CHURCH 12' I LT 0 35				36' I RT
						0 31				14' I - LT JC-C IN
										JC-OUT RT 4' I shld MED
										4' I shld on LT & GRS MED
						0 28			X	4 ML
										36' I RT
										36' I LT on TAPER to 14' I 40' GRS Med
										JCC in & OUT 5 ML
						0 27			X	
Local						PLEASANT PROSPECT RD — CLEARWOOD DR				
						CO 5676 @.00 12' I LT 0 15 OP 5129				2-36' I
										40' GRS MED
						0 10				JCC IN & OUT
										6 ML
						0 06			X	
										36' I RT
						RT 12' I LT				24' I LT
						0 02				JCC IN & OUT
						ENTERPRISE 12' I RD				40' GRS MED 5 ML
						MD 0 00 193	TL		✓	
						LOTTS FORD RD				
						CO 64				

COUNTY PRINCE GEORGE'S ROAD NO. CO 111 PAGE 2 OF 3

SYSTEM				TRAFFIC		LINE DIAGRAM	TRAFFIC				PAVEMENT DATA
FUNCT. CLASS	HWY SYS.	NHS	SAMPLE	PKG. REST.	COM/IND ACCESS		% CHRGS	COM/IND ACCESS	PKG. REST.		
						0 92			X		
						0 89					
						12'I LT					
						12'I RT Acc/89					
						12'I PARKSIDE DR					24'I RT
				E	To school	0 86 ~~CR 5883~~					14'I LT
						CO 5829					40' NAT BAR MED
						12'I LT					J C-C RT
						12'I RT					4'I SHLD IN LT
						12'I					4'I SHLD OUT LT
						12'I					3 ML
						0 80			X		
						0 71					
						12'I LT					
						12'I					
						0 66					36'I RT
											14'I LT
											75' NAT. BAR. MED
											J C-C RT
											4'I SHLD IN LT
						0 56 C.B.C. L=15' W=20' D=25'					4'I SHLD OUT LT
											4 ML
						0 50			X		
											36'I RT
											14'I LT
											15' GRS MED
						0 40					J C-C RT
						12'I LT					4'I SHLD IN LT
						12'I					4'I SHLD OUT LT
											4 ML

97-117

SHA 51.3 - 8 Revised 4.83

MARYLAND STATE HIGHWAY ADMINISTRATION

ROAD INVENTORY SHEET

Party Chief BB
Recorder AP
Assistant —
Map No./Dir. F-12C / E
State Coordinates 856 - 393

Road No. CO 111
Road Name WOODMORE RD
County PRINCE GEORGE'S
Date 3/12/98
Sheet No. 3 OF 3

TRAFFIC CODES
TRAFFIC CONTROLS: STOP SIGN-SS, TRAFFIC LIGHT=T.L., FLASHING RED BALL=F.R.

TRAFFIC CODES
PARKING RESTRICTIONS: A.M. PEAK, P.M. PEAK, A.M./P.M. PEAK, NO PARKING ANYTIME=N.P., COMM/IND. ACCESS=E

SYSTEM: FUNCT CLASS	SYSTEM: HWY. SYS	SYSTEM: NHAS SAMPLE	TRAFFIC: PREG. REST.	TRAFFIC: COM/IND. ACCESS	LINE DIAGRAM	TRAFFIC: CONTROL	TRAFFIC: COM/IND. ACCESS	TRAFFIC: PREG. REST.	PAVEMENT DATA
					CHURCH RD				
					CO 2 46 59	SS			^
									20'I
									2 ML
					1 86			X	
					BERMONDSEY DR CO 5258				26'I
					1 79				2 ML
					1 77			X	20'I
									2 ML
Local					1 04			X	
					PLEASANT PROSPECT RD				2-14'I
					CO 5676 1 02				30'GRS-Med
					61.45				on Taper to 0
					0 94				14'I add out RT
									2-4'I add in
									4'I add out LT
									I C-C RT
									2 ML

COUNTY _____ ROAD NO. _____ PAGE ___ OF ___

SYSTEM				TRAFFIC		LINE DIAGRAM	TRAFFIC				PAVEMENT DATA
FUNCT. CLASS	HWY SYS	HPMS SAMPLE		PREG. REST.	COM/IND ACCESS		CAPACITY	COM/IND ACCESS	PREG. REST.		

Form 6 HPS (Rev. 1961) FAU 3-171

ROAD INVENTORY SHEET

Party Chief E.S.
Recorder W.D.
Chainman

MAPC
GLASSMANOR
811-359 M354 VER 8-19-77

Road No. Co 112
Name OWENS RD
Sheet No. 1 OF 3
Date 1-10-69
County PRINCE GEO

FAU 5238 COLLECTOR - URBAN

→ W

049 45°↑
040
037
CO 1568
NORLINDA AVE 035 10 H
033
9 H
020
CO 1474
WOODLAND 017 3LUD
016
H 015 3 H
ENT TO SCH 012
007 H 20'I 2-3L-3U0
006 ✱
ELE. 48'I J'c-c
SCHOOL 004 H 22'I 2-3E-3U0
CO 110
WHEELER 000 RD.

Form 6 HPS (Rev. 1961)

ROAD INVENTORY SHEET

Party Chief E.S.
Recorder W.D.
Chairman

GLASSMANOR

Road No. Co 112
Name OWENS RD
Sheet No. 2 OF 3
Date 1-10-69
County PRINCE GEO.

	144		
	140	36" RCP	36' I J C-LT
Co 662			10' SHORT
KENNEBEC ST	139		X 2 ML
	137	H	
	134	H	
			24' I
PT 50° PG	129	H	2-10' SHD 50' CL 2 ML
	123		X 36' I J C-LT
	116		10' SHORT
10 H	105	BARNABY RUN DR	X 2 ML
	103	OP 4395	
	093	H	
Co 1961			
WEAVER TERR	091	ENT TO ELEM. SCH.	
	089		
	083	5 H	
	076		
25 H		Co 2139	
	072	MARTIN DR	
	067	5 H	SAME

FAU 5238 COLLECTOR - URBAN

Form 6 HPS (Rev. 1961)

78

ROAD INVENTORY SHEET

Party Chief E.S.
Recorder W.D.
Chainman

GLASS MANOR

Road No. CO 112
Name OWENS RD
Sheet No. 3 OF 3
Date 1-10-69
County PRINCE GEO

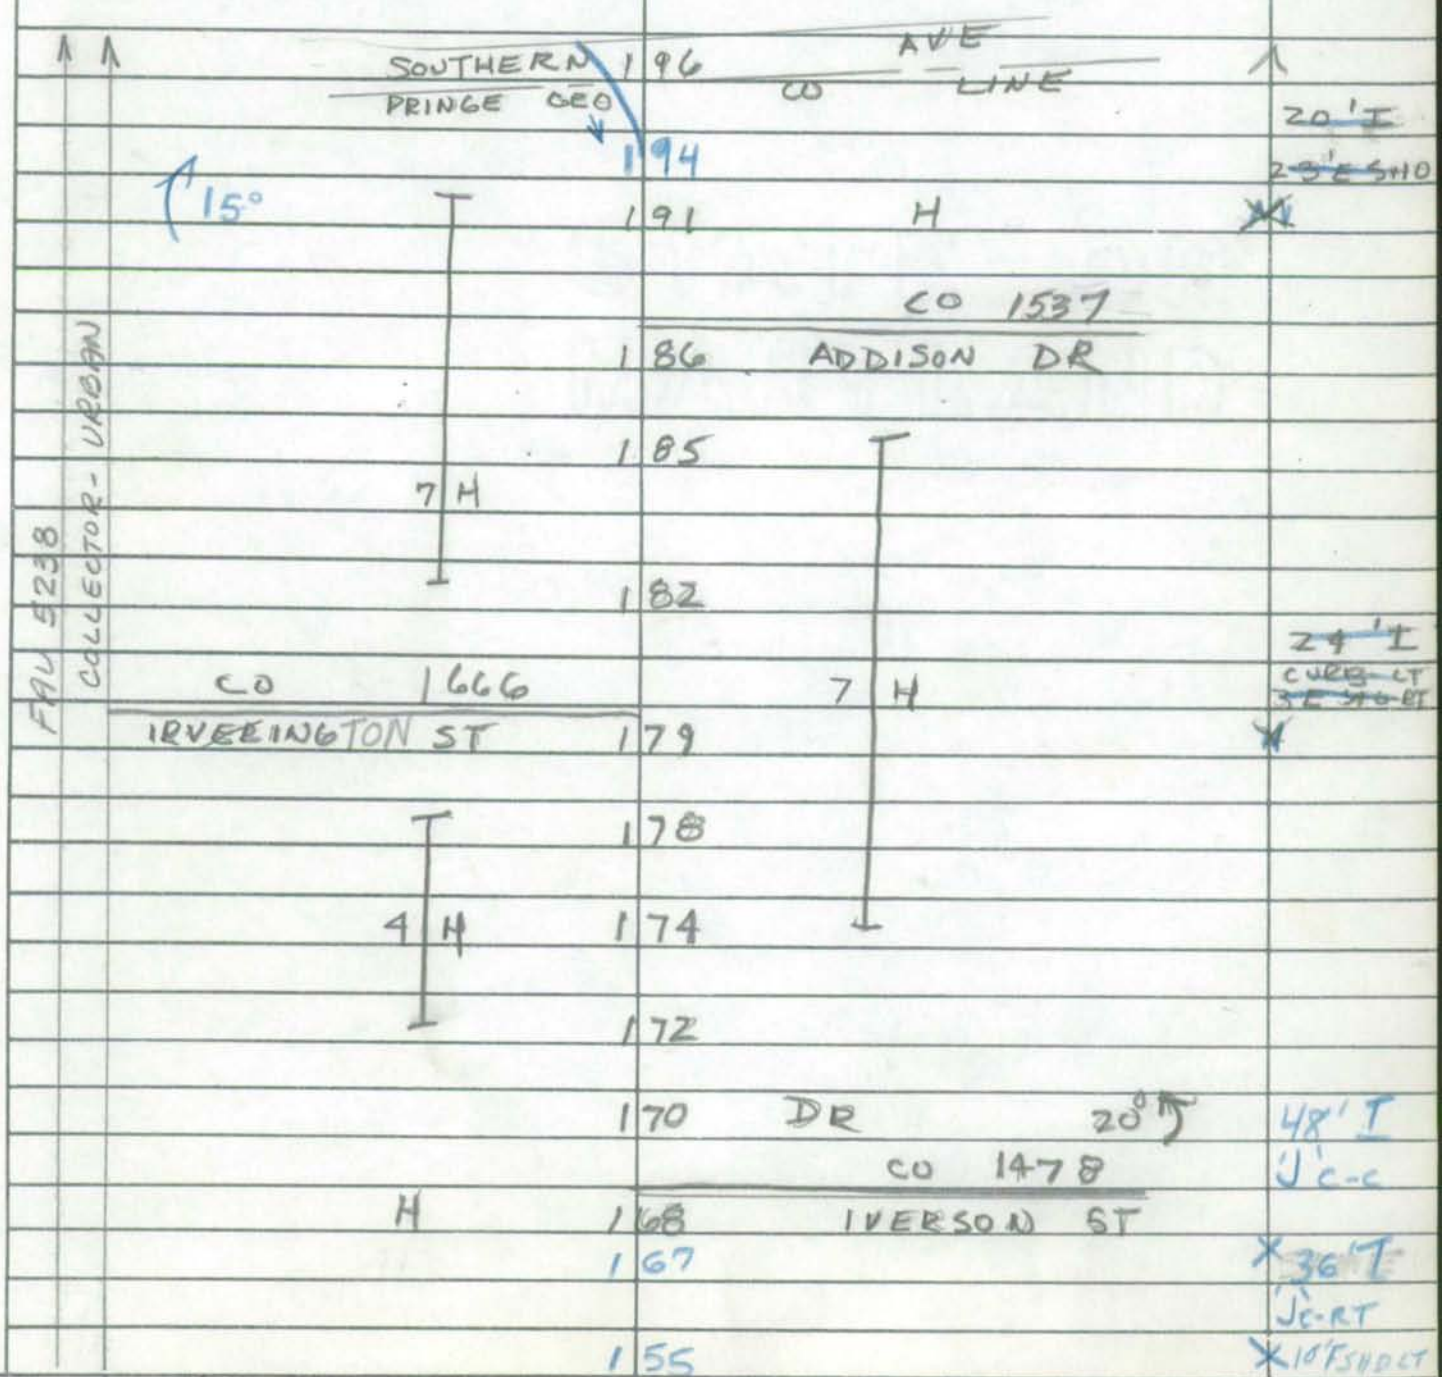

Form 6 HPS (Rev. 1961)

FAU

87-47

1-330

78

ROAD INVENTORY SHEET

Party Chief E.S.
Recorder W.D
Chainman

MAP 4

VER 6-9-78

851.420 M32

Road No. CO 113
Name N. LANSDALE ST
Sheet No. 1 OF 1
Date 7-2-68
County PRINCE GEO

ROAD	H	0	14	END	↑ 12' I
		0	12		X 18' CW,
	H	0	08		X 8' I 20'
					~~12' CW~~
GLENDALE VOL. FIRE DEPT		0	01		~~16'~~
					~~2 4' SHD~~
MD		0	00	~~193~~ 953	✓

93-COEx#543
GD:AR
3-15-94

92-CO Ex # 1
CD AH
3/12/93

90-8
STATE
91-2extra (STATE)

SHA 51.3 - 8 Revised
4.83

MARYLAND STATE HIGHWAY ADMINISTRATION

ROAD INVENTORY SHEET

Party Chief BB
Recorder BB
Assistant
Map No./Dir. G11-C / S
State Coordinates 799-350

Road No. Co 114
Road Name OXON HILL Rd.
County PRINCE GEORGES
Date 3-5-91
Sheet No. 1 OF 9

TRAFFIC CODES
TRAFFIC CONTROLS: STOP SIGN=SS, TRAFFIC LIGHT=T.L., FLASHING RED BALL=F.R.

TRAFFIC CODES
PARKING RESTRICTIONS: A.M. PEAK, P.M. PEAK, A.M./P.M. PEAK, NO PARKING ANYTIME=N.P., COMM/IND. ACCESS=E

SYSTEM				TRAFFIC		LINE DIAGRAM (ROAD TABLE NO)	TRAFFIC			PAVEMENT DATA
FED. AID.	FUNCT CLASS.	HWY. SYS.	HPMS SAMPLE	PRKG. REST.	COM/IND. ACCESS		CONTROL	COM/IND. ACCESS	PRKG. REST.	
						0 18 GV130			X	
						RTL NO SHD				
						0 12 PC				12'I RT 36'I LT JC-C OUT 12'I PDTMED 4ML
						0 10			X	
						RAMP #10 Spur (NOV)				
						0 09 Ramp #6				
FAU 5239	COLLECTOR URBAN			E		S.H.A. SALT BIN 0 07	TL			
						RTL NO SHD				
						2-LTL NO SHD				
						ACCEL/RTL NO SHD				2-24'I
						I-95				JC-C
						SPUR 0 03 SPUR				4'JMED
K	K					INDIAN HEAD HIGHWAY				4ML
						0 00	TL			
						MD 210				
						414				
						ST. BARNABAS Rd				
						MD				

SYSTEM: FED. AID. | FUNCT. CLASS. | HWY. SYS. | HPMS SAMPLE
TRAFFIC: PRKG. REST. | COM/IND ACCESS

LINE DIAGRAM

TRAFFIC: CONTROL | COM/IND ACCESS | PRKG. REST.

PAVEMENT DATA

FAU 5239
Collector Urban

0 45
Under Construction
STILL UNDER CONST. 3/24/93 Construction will not be finished 9 Sept. of #3
0 41
E TOPK + Ride
0 35
TL 21
0 33
0 30
PT
E TOPK + Ride
0 25
I-295 RAMP #7
FR
0 23
0 21
TO
I-295 RAMP #1
0 20
60°
LC-19

22'I
2ML
3' I SHD LT
24'I
2ML
20'I SHD LT
24'I
2ML
2-20'I TO OUT JCT
30'I LT
12'I RT
JC-OUT LT
VAR. I SHD
OUT. RT. (10-20')
JC-OUT RT
10 I PAT MED CLT
3ML

SHA 51.3 - 8 Revised
4.83

MARYLAND STATE HIGHWAY ADMINISTRATION

ROAD INVENTORY SHEET

Party Chief BB
Recorder BB
Assistant
Map No./Dir. 61C / S
State Coordinates 799-350

Road No. Co 114
Road Name OXON HILL Rd
County PRINCE GEORGES
Date 3-5-91
Sheet No. 3 OF 9

TRAFFIC CODES
TRAFFIC CONTROLS: STOP SIGN=SS, TRAFFIC LIGHT=T.L., FLASHING RED BALL=F.R.

TRAFFIC CODES
PARKING RESTRICTIONS: A.M. PEAK, P.M. PEAK, A.M./P.M. PEAK, NO PARKING ANYTIME=N.P., COMM/IND. ACCESS=E

SYSTEM				TRAFFIC		LINE DIAGRAM	TRAFFIC			PAVEMENT DATA
FED. AID.	FUNCT CLASS.	HWY. SYS.	HPMS SAMPLE	PRKG. REST.	COM/IND. ACCESS		CONTROL	COM/IND. ACCESS	PRKG. REST.	
FAU 5239	Collector URBAN			E		0 80 RTL NO SHD		E		
						0 76 48" CMP				
										20'I
										2ML
						0 604			X	
						0 58 11' LT				
				E		0 56 OXON HILL MAJOR (PROPOSED)		E		
						10' LT RTL - NO SHD				
						0 53				22'I
										2ML
										3'I SMLT

SYSTEM				TRAFFIC		LINE DIAGRAM	TRAFFIC			PAVEMENT DATA
FED. AID.	FUNCT. CLASS.	HWY. SYS.	HPMS SAMPLE	PRK'G. REST.	COM/IND ACCESS		CONTROL	COM/IND ACCESS	PRK'G. REST.	
						ABBINGTON Dr.				
				BS		Co 1609 1 26			B	
						1 24			BS	
						LOURETRO LA 4496 1 21				
						CO				
						Apple Tree La.				
						1 02 Prvt Rd				
						Brockton Rd Dr Pipers Glen LA				
						CO. 1802 0 99 Prvt. Rd.			BS	
				BS		0 97				
						BALMORAL DR. E				28'I
						0 92 Co. 1967				JC-LT
										2ML
						0 88			X	
				E		0 83 RTL NO SHD		E		20'I
										2ML

FAU 5239
Collector URBAN

SHA 51.3 - 8 Revised
4.83

MARYLAND STATE HIGHWAY ADMINISTRATION

ROAD INVENTORY SHEET

Party Chief BB
Recorder BB
Assistant
Map No./Dir. 61C / S
State Coordinates 199-350

Road No. Co 114
Road Name Oxon Hill Rd
County Prince Georges
Date 3-5-91
Sheet No. 5 OF 9

TRAFFIC CODES
TRAFFIC CONTROLS: STOP SIGN=SS, TRAFFIC LIGHT=T.L., FLASHING RED BALL=F.R.

TRAFFIC CODES
PARKING RESTRICTIONS: A.M. PEAK, P.M. PEAK, A.M./P.M. PEAK, NO PARKING ANYTIME=N.P., COMM/IND. ACCESS=E

SYSTEM				TRAFFIC		LINE DIAGRAM	TRAFFIC			PAVEMENT DATA
FED. AID.	FUNCT CLASS.	HWY. SYS.	HPMS SAMPLE	PRKG. REST.	COM/IND. ACCESS		CONTROL	COM/IND. ACCESS	PRKG. REST.	
						1 56 PT				
						CLAUDIA DR.				
				BS		Co 3219 1 51 30°			BS	28'I
										JC-LT
										6'FSHDRT
										2ML
						1 47 PC			X	
						CareyBrook LA.				
						Co 1053 1 43 PT				
						VISTA Terr.				
						1 40 Co 1225 30°				
										20'I
										2ML
						PRC Cedar Edge Dr. 1 35 Panorama Dr.				
						Co 3699 1 34 Co 1054 PRC			X	
						50°				
						PC 1 29				
										28'I
										JC-LT
										2ML

FAU 5239 Collector URBAN

SYSTEM				TRAFFIC		LINE DIAGRAM			TRAFFIC			PAVEMENT DATA
FED. AID.	FUNCT. CLASS.	HWY. SYS.	HPMS SAMPLE	PRKG. REST.	COM/IND ACCESS				CONTROL	COM/IND ACCESS	PRKG. REST.	
							2 15			E		
							2 13			E		
						ARTHUR DR E						
							2 11	Co 1723				
						Fort Foote E.S.	1 95					
					E		1 93					
							1 87			E		
						Fort Foote Rd.						42'I
							1 85	Co 88	TL			JC-C
												2ML
							1 83				X	
						Kerby Pkwy						
				BS		Co 2497	1 77				BS	
						Kerby Hill Rd.						
						Co 582	1 70					
												28'I
												JC-LT
												6'FSHDRT
												2ML
FAU 5239												
COLLECTOR URBAN												

SHA 51.3 - 8 Revised
4.83

MARYLAND STATE HIGHWAY ADMINISTRATION

ROAD INVENTORY SHEET

Party Chief BB
Recorder BB
Assistant
Map No./Dir. G11C / 3
State Coordinates 799-350

Road No. Co 114
Road Name OXON HILL Rd
County PRINCE GEORGES
Date 3-5-91
Sheet No. 1 OF 9

TRAFFIC CODES
TRAFFIC CONTROLS: STOP SIGN=SS, TRAFFIC LIGHT=T.L., FLASHING RED BALL=F.R.

TRAFFIC CODES
PARKING RESTRICTIONS: A.M. PEAK, P.M. PEAK, A.M./P.M. PEAK, NO PARKING ANYTIME=N.P., COMM/IND. ACCESS=E

SYSTEM: FED. AID.	SYSTEM: FUNCT CLASS.	SYSTEM: HWY. SYS.	SYSTEM: HPMS SAMPLE	TRAFFIC: PRKG. REST.	TRAFFIC: COM/IND. ACCESS	LINE DIAGRAM	TRAFFIC: CONTROL	TRAFFIC: COM/IND. ACCESS	TRAFFIC: PRKG. REST.	PAVEMENT DATA
						EL CAMINO WAY				
						2 67 Co 4543				
										40'I
						PATES DR.				JC-C
						TOR BRYAN Rd 2 61 Co 565			X	2ML
						Co 2501 2 60				
						OAK LA.				
						2 38 Co. 1722				
						NOTLEY Rd.				
						2 33 Co 1088				
						(PROPOSED) 2 26				
						2 20		E		34'I
										JC-RT
						2 18		ZE		6'FSHDLT
										2ML
						2 17			X	

FAU 5239 Collector (URBAN)

FAU 5239
COLLECTOR URBAN

SYSTEM: FED. AID.	SYSTEM: FUNCT. CLASS.	SYSTEM: HWY. SYS.	SYSTEM: HPMS SAMPLE	TRAFFIC: PRK.G. REST.	TRAFFIC: COM/IND ACCESS	LINE DIAGRAM	TRAFFIC: CONTROL	TRAFFIC: COM/IND ACCESS	TRAFFIC: PRK.G. REST.	PAVEMENT DATA
						3 11 PT				
										24'I
						(proposed) 3 03				2-6'FSHD
										2ML
						3 02			X	
						80'				
						M.'				
						@ 2 98 FORT FOOTE Rd Co. 88	TL			
										44'I
										EC-RT
										JC-LT
										2ML
						2 94			X	
										24'I
						2 90 PC				2-8'FSHD
										2ML
						2 87			X	
										32'I JC-RT
						2 85		E		8'FSHD LT
										2ML
						2 82			X	
						2 81		E		
						2 79		E		
						JOELLYN CT				
						Co 4903 2 77				40'I
										JC-C
										2ML
						2 73			X	
										32'I
										~~JC-LT~~
										~~4'FSHD RT~~
										~~2ML~~
						2 70			X	

SHA 51.3 - 8 Revised
4.83

MARYLAND STATE HIGHWAY ADMINISTRATION

ROAD INVENTORY SHEET

Party Chief BB
Recorder BB
Assistant
Map No./Dir. GHC / S
State Coordinates 199-350

Road No. Co 114
Road Name OXON HILL Rd
County PRINCE GEORGES
Date 3-5-91
Sheet No. 9 OF 9

TRAFFIC CODES
TRAFFIC CONTROLS: STOP SIGN=SS, TRAFFIC LIGHT=T.L., FLASHING RED BALL=F.R.

TRAFFIC CODES
PARKING RESTRICTIONS: A.M. PEAK, P.M. PEAK, A.M./P.M. PEAK, NO PARKING ANYTIME=N.P., COMM/IND. ACCESS=E

SYSTEM				TRAFFIC		LINE DIAGRAM	TRAFFIC			PAVEMENT DATA
FED. AID.	FUNCT CLASS.	HWY. SYS.	HPMS SAMPLE	PKG. REST.	COM/IND. ACCESS		CONTROL	COM/IND. ACCESS	PKG. REST.	
	FAU 5239 / Collector - URBAN			BS		OLD FORT Rd. Co 118				
						Livingston Rd. Co 3 48 4524	SS			
						3 44			BS	
						BROAD CREEK Church Rd Co 3 28 2976				24'I 2-8'FSHD 2ML
						3 19			X	
						BROAD 3 18 CREEK #P0310				24'I 2-6'FSHD 2ML
						3 17				

SYSTEM				TRAFFIC		LINE DIAGRAM	TRAFFIC			PAVEMENT DATA
FED. AID.	FUNCT. CLASS.	HWY. SYS.	HPMS SAMPLE	PRK'G. REST.	COM/IND ACCESS		CONTROL	COM/IND ACCESS	PRK'G. REST.	

Form 5-HPS
(Revised 1961)

MARYLAND STATE ROADS COMMISSION
PLANNING AND PROGRAMMING DIVISION

S26130

IN COOPERATION WITH
U. S. BUREAU OF PUBLIC ROADS

BRIDGE SHEET

ROAD NO. CO 114

SHEET NO. 1A

PARTY NO. _____

DATE 9-19-68

COUNTY PRINCE GEO.

RATED CAPACITY _____

FOR ALL STRUCTURES HAVING A TOTAL OPENING OF MORE THAN 20 FEET AS DEFINED IN NOTE 1.

ODOMETER READING 3.18 NAME OF STREAM, RAILROAD OR HIGHWAY CROSSED BROAD CK.

NUMBER OF RAILROAD TRACKS _____
KIND OF CROSSING (NOTE 2) _____

UNDERPASS-SIMPLE | UNDERPASS-COMBINED (NOTE 3) | OVERPASS | BRIDGE OVER SYSTEM STREAM

DESCRIPTION

NUMBER OF SPANS	LENGTH EACH SPAN (NOTE 4)	TYPE (NOTE 5)
1	40'	CONCRETE BEAM
2	42'	CONCRETE BEAM

TOTAL LENGTH-ON LINE OF ROAD OVER-ALL (NOTE 6) 124'

MATERIAL
SUBSTRUCTURE CONCRETE SUPERSTRUCTURE _____
FLOOR ASPHALT

CLEARANCES
ROADWAY (NOTE 7) 28 SIDEWALK WIDTHS: RIGHT 18" LEFT 4'

SURFACE OF ROAD TO STREAM BED 8' FOR OVERPASSES, SHOW DISTANCES TO TOP OF RAIL OR SURFACE OF LOWER ROAD. (NOTE 8)
SURFACE OF ROAD TO BOTTOM PORTAL _____ (MINIMUM OVERHEAD CLEARANCE
CLEAR DISTANCE OF OPENING ABOVE STREAM BED 6' (WATERWAYS ONLY)
POSTED LOAD LIMITS _____ BRIDGE NO. _____ CONSTRUCTION DATE 1963

GENERAL CONDITION OF BRIDGE: CHECK IF GOOD, FAIR, OR POOR, DESCRIBE DEFECTS IF SERIOUS.

	GOOD	FAIR	POOR
SUPERSTRUCTURE	✓		
FLOOR	✓		
SUBSTRUCTURE	✓		
PAINT		BADLY CORRODED OR RUSTED	

TYPE OF PROTECTION FOR DRAWBRIDGES (NOTE 9) _____

(NOTES ON REVERSE SIDE)

S26130

Notes:

1. In agreement with Federal-aid standards, a bridge is defined as a structure including supports erected over a depression or an obstruction, as water, highway, or railway, and having a track or passageway for carrying traffic or other moving loads, and having a length measured along the center of roadway of more than 20 feet between undercoping of abutments or spring lines of arches, or extreme ends of openings for multiple boxes and pipes, where the clear distance between openings is less than half of the smaller contiguous opening.

2. Show kind of crossing by checking descriptive item applicable. For multiple-span bridges give complete information on each span including approach spans. Indicate on leg sheet the odometer reading, position, and angle of skew of structure with respect to center line of road and by arrow the direction of stream flow.

3. Give information on the span over the highway only.

4. For span length use center to center of bearings, otherwise the clear opening. Skew bridges will be measured along center line of road. See Note 1.

5. Show general type such as: Trestle, Truss, Girder, I-Beam, Rigid Frame, Arch, Slab, Suspension, or Covered Bridge. See illustrations attached. Describe draw spans by classifications listed in Article X, Section 2 of Manual.

6. The length of a bridge structure is the over-all length measured along the line of survey stationing back to back of back-walls of abutments, if present, otherwise end to end of bridge floor, but in no case less than the total clear opening of the structure.

7. Give minimum lateral clearance. Where traffic lanes are separated by bridge numbers, show clearance width of each lane separately. Special conditions should be explained by notes.

8. In case of overhead bracing or arch construction, measurement shall be made to the lowest point above the road surface.

9. Use classification listed on RR crossing sheet. Form 4 HPS.

Remarks: _____

_____

A rearrangement of the form similar to that shown on the attachment may be used to provide space for coding.

Form 6 HPS (Rev. 1961) FAU MAP 748 5-261-A Greater Upper Marlboro Env. Urban

ROAD INVENTORY SHEET

Party Chief E.S.
Recorder W.D.
Chainman

Gen Hwy
VER 7-19-77
878-372 M36

Road No. Co 115
Name SWANSON RD
Sheet No. 1 OF 2
Date 7-10-68
County PRINCE GEO

	0 63	↑35°	
	0 62	H CO 1469 SPUR SWANSON RD	16'E 16'C W
FARM 600'	0 55		X
H 500'	0 46		
35° C	0 42		
	0 31	↑30°	
	0 28	H	
H	0 23		
	0 11	H	16'F 2-3E SHO
	0 10		X
H	0 09		
	0 06	H	
	0 05	ENT. TO CH. 121F	
H	0 04		24'I 2-6E SHO
← NB US	0 00	301	Y

Form 6 HPS (Rev. 1961)

ROAD INVENTORY SHEET

Party Chief E.S.
Recorder W.D.
Chainman

Road No. CO 115
Name SWANSON RD
Sheet No. 2 OF 2
Date 7-10-68
County PRINCE GEO.

H	ROAD	1	29 END 1000' FARM	
	PT H (90° PC)	1	18	
		1	14	
		1	10 PT (35°)	
		1	07 PC	
		0	83 P.T. (40°)	
		0	81 P.C.	
	P.T. (60° PC.)	0	77	
		0	74	SAME

Form 6 HPS (Rev. 1961) FAU 3-406 78

ROAD INVENTORY SHEET

PARTY CHIEF Edward Schuyler
RECORDER Henry Gorman
CHAINMAN J. EMERICK

ROAD NO. CO 116
NAME EASTERN LANE
SHEET NO. 1 OF 1
DATE 11/28/67
COUNTY PRINCE GEORGES

TL REV. F.R. 2/18/77

MAPG VER 8-26-77

822-370 M35

ROAD END

H 025

H 022 H 18'G 24'CW

H 021 ← 200' — 2H.

SUNSET LA.

20 TH 019 *

24I

016 H "J" C-LT. 30'CW

014 H 2

012 * CHAIN. RESIDENTS ONLY NO SOLICITORS

ENTR TO APT PRK LOT

240 UNITS 011 H

009

005 HOT ~~HOUSE~~ 7-11

60 APART UNITS

24'G 2-3'E 3 4 LDS 40 CW

001

SUITLAND RD.

CO. 000 81 V

Form 6 HPS (Rev. 1961)

3-214

78

ROAD INVENTORY SHEET

PARTY CHIEF Edward Schuyler
RECORDER Henry Gorman
CHAINMAN J. EMERICK

MAP

ROAD NO. CO 117
NAME SUNSET LA.
SHEET NO. 1 OF 1
DATE 11/21/67
COUNTY PRINCE GEORGES

VER 8-26-77 823-371

DUPONT HEIGHTS.

M-148

M35

EASTERN EAST AVE. LANE

CO 031 116

030

021

PARK LANE

17 H 011 Co 1497

010

3 H

006

003 H

002

MD 000 458

M-148
30' I
e-c
X J-CURB RT

1816
2-4A
SHLDS
26'

SHA 51.3-8
11-15-72

STATE HIGHWAY ADMINISTRATION OF MARYLAND

95-163 BB/AH 3/27/96
96-147,148 DB/MG 3-21-97

ROAD INVENTORY SHEET

Party Chief ES
Recorder IL.
Helper REWRITTEN BY FR. 11-2-99

Map No. M 39

Road No. CO. 118
Road Name OLD FORT RD.
Sheet No. 1 OF 8
Date 8-21-68
County P.G.
State Coordinates 807-333

		H	1	36		
		H	1	27		
		H	1	22		
			1	21	H	
		PT 45° PC	1	12		
		RHAME CO.	1	10		
		3618 DR.	0	42		
			0	35	PT 30° PC	
			0	32		
		GLASCOW CO. 3902 WAY	0	26		
						18'I
		H	0	21		2 UML
			0	17	WASHINGTON CO. DR. 2280	X 20'I
						2 ML
52 44		H	0	15	WATER TOWER	X 26'I 8'I SHORT JC-RT
FAU	COLLECTOR-URBAN		0	11	40°	X 2 ML
					TREEHOUSE CT	38'I
		H	0	06	CO 5749	JC-RT 6'I SHOLD 2 ML
		H	0	03	RTL	X 42'I JC-RT ~~18'I~~ 2ML ~~24 CW~~
		FT. WASHINGTON CO.	0	00	RD. 416	SS

SHA 51.3-8
11-15-72

90-245
2-27-91
BB/BB

ROAD INVENTORY SHEET

Road No. CO. 118
Road Name OLD FORT RD.
Sheet No. 2 OF 8
Date 8-21-68
County P.G.
State Coordinates

	H	195		
		192		
	3 H	190	3 H	
		187		20'I 2ML
X		WASHINGTON CO. 1557 LA ~~RD~~		X 24'I ~~2-3'ESHLD~~
		~~JACKSON AVE CO. 1556~~ 181		X 2ML
		170 GAS STA.		~~30'I~~ ~~5'C RT. 8'ESHLD LT.~~
		~~168~~ 166 @ 6.81		~~X 40'CW~~ 44'I
		MD. 164 210	TL	JC-C 2ML
		SERVICE RD. MD. 210 E 162		X 20'I 3D'CW 2ML
		CHURCH ~~0.42~~ 46 153		X ~~15'I~~ 21'I ~~11'CW~~ J-C LT. ~~2-3'ESHLD.~~ LT.
		LAMPTON LA. CO H CO 4297 152		X 2ML
		148		
	H	146		
		WARBURTON LA. CO. 1055 144 PISCATAWAY DR. CO. 2924		
	H	142		
		140	H	
	H	138	H	SAME

FAU 5244 COLLECTOR-URBAN

SHA 51.3-8
11-15-72

STATE HIGHWAY ADMINISTRATION OF MARYLAND

93-130
GD. AR
3-15-94

ROAD INVENTORY SHEET

Party Chief E.S.
Recorder W.D.
Helper

Map No.

Road No. CO. 118
Road Name OLD FORT RD.
Sheet No. 3 OF 8
Date 8-21-68
County P.G.
State Coordinates

	2	85	H	~~20'H~~
	~~2~~	~~66~~		~~20'I~~
	2	~~42~~ 08		20'I 2ML TSI-24
	2	59 JOMAR	H DR	37'I
	2	58 CO.	4455	JcbRT
	2	~~50~~ 48 OP	98	
17 H	2	47	5 H	20'I
	2	41		2ML
	2	34	H	
OLD PISCATAWAY RD CO. 3213	2	30	(RICH HILL) RD. OP 88	
	2	27	H	36'I
	2	22		JCbRT
GAS STA.	2	20	7-11 STORE	2ML
LIVINGSTON CO.	2	19	RD. 1202	
	2	17	H	
5 H	2	13	H	
	2	07		
VAN BOREN DR. CO. 1788	2	@0.0 04	3 H	
	2	01		
VAN BUREN CO.	1	@.35 96	DR. 1788	SAME

NON EA COLLECTOR - URBAN

SHA 51.3-8
11-15-72

ROAD INVENTORY SHEET

Road No. CO. 118
Road Name OLD FORT RD
Sheet No. 4 OF 8
Date 8-21-68
County P.G.
State Coordinates

ARAGONA BLVD	3 50	6 H	
~~OF 4857~~ CO 5635	3 49		
	3 43		34' I
			"J" C-AFC PT SHLD RT
H	3 41	TRAFALGER DR. CO. 3654	X 40' CW 2 ML
KERRS ALLEY OP 541	3 40		
	3 37	H	
	3 34	GEN. STORE	
	3 31	H	
	3 27	H	
	3 24	GALLAHAN RD CO. 144	
	3 20	3 H	
	3 16	30' T	
	3 11		
3 H	3 06	CHURCH	
	3 04		
	3 00	CHURCH HALL	20' I 2 mL
	2 95	(A)	
H	2 87		SAME

COLLECTOR-URBAN

SHA 51.3-8
11-15-72

STATE HIGHWAY ADMINISTRATION OF MARYLAND

ROAD INVENTORY SHEET

Party Chief ES
Recorder WD.
Helper

Map No. ____

Road No. CO. 118
Road Name OLD FORT RD.
Sheet No. 5 OF 8
Date 8-21-68
County P.G.
State Coordinates

		F	4	20	
				FRONTIER CT.	
			4	T6 ~~CO 4309~~ CO 4557	
			4	01 CHURCH + CEM	
		4 H	3	98	
			3	89	
		THORNTON ~~THORTON~~ DR. CO. 2509	3	87	
			3	83 POWDER HORN DR. CO 4154 (SEE-171) H	
		7 H	3	77 H	20'I 2ML
			3	6~~5~~	X
		THOMAS RD. CO. 1161	3	63	
				Tall Timber CT	
		H	3	6X1 CO 6025	~~35~~'I ~~45~~ 30'2WL
EA	BROWN	FOLK DR. CO. 620	3	54 VALLEY VIEW DR. CO. 3832	X 2ML
N	ON COLLECTOR	H.	3	51	
					SAME

SHA 51.3-8
11-15-72

ROAD INVENTORY SHEET

Road No. _____
Road Name _____
Sheet No. _____
Date _____
County _____
State Coordinates _____

Form 6 HPS (Rev. 1961)

78

ROAD INVENTORY SHEET

Party Chief E.S.
Recorder W.D.
Chainman

Road No. CO 118
Name OLD FORT RD.
Sheet No. 6 OF 8
Date 8-21-68
County PRINCE GEO.

NON FA
COLLECTOR - URBAN

	4	73	3 H
	4	67	
	4	62	H
			CO 1027
	4	59	GRIFF DR
CO 1716			
THORNE DR	4	58	
H	4	56	4 H
	4	54	
H	4	51	H
H	4	47	H
	4	45	H
GAS STA	4	39	P.T.
			CO 119 OLD FORT RD 45°
	4	35	P.C.
H	4	33	
GAS STA.	4	30	SAME

Form 6 HPS (Rev. 1961)

78

ROAD INVENTORY SHEET

Party Chief E.S.
Recorder W.D.
Chainman

Road No. CO 118
Name OLD FORT RD
Sheet No. 7 OF 8
Date 8-21-68
County PRINCE GEO.

		H	5	42	H	
		H	5	38	H	
			5	34	H	
					CO 161	
			5	32	BROAD VIEW RD.	
		4 H	5	25	H	
			5	18		
FAU 5240	COLLECTOR - URBAN		5	06	H	
			4	97	H	
					CO 297	
			4	94	CALTOR LA.	
			4	91	H	
		H	4	88	H	
		H	4	86		
		H	4	84		
		CO 951			CO 126	
	X	ROLAND LA.	4	81	ALLENTOWN RD.	
NON FA		H	4	78	BAR	SAME

405-99-B

405-99-A

Form 6 HPS (Rev. 1961)

78

ROAD INVENTORY SHEET

Party Chief E.S.
Recorder W.D.
Chainman

Road No. CO 118
Name OLD FORT RD
Sheet No. 8 OF 8
Date 8-21-68
County PRINCE GEO.

CO OXON HILL RD 114

CO ~~1202~~ 4524

LIVING STON 5 88 RD

~~OR 93~~ C04973

BROWN ~~RD~~ 5 80
Kay DOT RD

CO ~~OR 93~~ 4973

BROWN RD. 5 74
Kay DOT RD

H 5 72

LMD 210 CI

SERVICE RD 5 68

567 @ 9.92

MD 5 66 210 I TL

SERVICE ~~CO~~ Md

OLD PALMER 5 63 210 I ~~121~~ Rd X RD.

FAU 5240 COLLECTOR-URBAN

FAU 5239 NHS

29 I
I IC - RT

SAME

Form 6 HPS (Rev. 1961)

FAU URBAN-WASH 4-110

78

ROAD INVENTORY SHEET

83-183

Party Chief E.S.
Recorder W.D.
Chainman

Gen Hwy

~~APP'd~~ VER 7-14-77

FRIENDLY FARMS

Road No. CO 119
Name OLD FORT PLACE
Sheet No. 1 OF 1
Date 8-29-68
County PRINCE GEO.

80-151 AT-82-153
17 MAR 81 75-149
J.E./D.G. REV 3-30-76 807-333 m39

Westerly LA (CO 41 42 61 476)

CO ALLENTOWN RD 126

033 44'I
~~36'I~~ JC-C
025
022 P.T.
30°
020 P.C. ~~43'I~~ TO I JCHEB LT ~~2-3E SHO~~
CO 2943 TONGA DR. CO 2943 TONGA DR. 018 46'I JCC
016 H
H 015 H
CO 2942
H 011 ROSEDELL PL 30'I CURB-RT 3E SHOct
4 008 H 30'I
4 003 32'CW "J" C-RT
OLD FORT RD. EAST
~~20'I~~ ~~2-3E SHO~~
001 ~~OP 4303~~ CO 4551
000 83-183

CO OLD FT RD 118

20'N

FT-P

SHA 51.3-8
11-15-72

STATE HIGHWAY ADMINISTRATION OF MARYLAND

96-36 ST
DB/MG
3-21-97

ROAD INVENTORY SHEET

Party Chief ES
Recorder WD.
Helper REWRITTEN BY FR. 11-7-79

Map No. M 35

Road No. CO. 120
Road Name STEED RD
Sheet No. 1 OF 1
Date 8-28-68 VER. 8-1-77
County PG.
State Coordinates 813-338

	ALLENTOWN RD.		
	CO. 171	126	24'I
			2-6'G SHLD 40'CW
5259	60° 165		X 2 ML
RAA AA A2L	F-500' 154		
COLLECTOR-URBAN	132	H-450'	24 I
		#P0585	2-3'ESHD
	094	SEE BR. SHEET 1A	2 ML
	AIR FIELD 026		X 24'I 2-8'FSHD
	ATT 1.0 # 005		~~2 ML~~
	E TO AIR FIELD 018		~~X 24'I~~ ~~2-8'ESHD~~
	MD. 000	223 TL	~~2 ML~~

SHA 51.3-8
11-15-72

ROAD INVENTORY SHEET

Road No. _____
Road Name _____
Sheet No. _____
Date _____
County _____
State Coordinates _____

Form 5-HPS (Revised 1961)

MARYLAND STATE ROADS COMMISSION
PLANNING AND PROGRAMMING DIVISION

S26130

IN COOPERATION WITH
U. S. BUREAU OF PUBLIC ROADS

BRIDGE SHEET

ROAD NO. Co 120

SHEET NO. 1A

PARTY NO. _____

DATE 8-28-68

COUNTY PRINCE GEO.

RATED CAPACITY _____

FOR ALL STRUCTURES HAVING A TOTAL OPENING OF MORE THAN 20 FEET AS DEFINED IN NOTE 1.

ODOMETER READING 0.94 NAME OF STREAM, RAILROAD OR HIGHWAY CROSSED WATERLOO CREEK

NUMBER OF RAILROAD TRACKS _____
KIND OF CROSSING (NOTE 2) _____

UNDERPASS-SIMPLE | UNDERPASS-COMBINED (NOTE 3) | OVERPASS BRIDGE OVER SYSTEM STREAM

DESCRIPTION

NUMBER OF SPANS	LENGTH EACH SPAN (NOTE 4)	TYPE (NOTE 5)
2	32	CONCRETE BEAM

TOTAL LENGTH-ON LINE OF ROAD OVER-ALL (NOTE 6)

MATERIAL
SUBSTRUCTURE CONCRETE BEAM SUPERSTRUCTURE _____
FLOOR CONCRETE + BIT MIX

CLEARANCES
ROADWAY (NOTE 7) 30' SIDEWALK WIDTHS: RIGHT 24" LEFT 24"

SURFACE OF ROAD TO STREAM BED 8' FOR OVERPASSES, SHOW DISTANCES TO TOP OF RAIL OR SURFACE OF LOWER ROAD. (NOTE 8)
SURFACE OF ROAD TO BOTTOM PORTAL _____ (MINIMUM OVERHEAD CLEARANCE
CLEAR DISTANCE OF OPENING ABOVE STREAM BED 6' (WATERWAYS ONLY)
POSTED LOAD LIMITS _____ BRIDGE NO. _____ CONSTRUCTION DATE _____

GENERAL CONDITION OF BRIDGE: CHECK IF GOOD, FAIR, OR POOR, DESCRIBE DEFECTS IF SERIOUS.

	GOOD	FAIR	POOR
SUPERSTRUCTURE	✓		
FLOOR	✓		
SUBSTRUCTURE	✓		
PAINT			BADLY CORRODED OR RUSTED

TYPE OF PROTECTION FOR DRAWBRIDGES (NOTE 9) _____

(NOTES ON REVERSE SIDE)

S26130

Notes:

1. In agreement with Federal-aid standards, a bridge is defined as a structure including supports erected over a depression or an obstruction, as water, highway, or railway, and having a track or passageway for carrying traffic or other moving loads, and having a length measured along the center of roadway of more than 20 feet between undercoping of abutments or spring lines of arches, or extreme ends of openings for multiple boxes and pipes, where the clear distance between openings is less than half of the smaller contiguous opening.

2. Show kind of crossing by checking descriptive item applicable. For multiple-span bridges give complete information on each span including approach spans. Indicate on leg sheet the odometer reading, position, and angle of skew of structure with respect to center line of road and by arrow the direction of stream flow.

3. Give information on the span over the highway only.

4. For span length use center to center of bearings, otherwise the clear opening. Skew bridges will be measured along center line of road. See Note 1.

5. Show general type such as: Trestle, Truss, Girder, I-Beam, Rigid Frame, Arch, Slab, Suspension, or Covered Bridge. See illustrations attached. Describe draw spans by classifications listed in Article X, Section 2 of Manual.

6. The length of a bridge structure is the over-all length measured along the line of survey stationing back to back of back-walls of abutments, if present, otherwise end to end of bridge floor, but in no case less than the total clear opening of the structure.

7. Give minimum lateral clearance. Where traffic lanes are separated by bridge numbers, show clearance width of each lane separately. Special conditions should be explained by notes.

8. In case of overhead bracing or arch construction, measurement shall be made to the lowest point above the road surface.

9. Use classification listed on RR crossing sheet. Form 4 HPS.

Remarks: _____

_____

A rearrangement of the form similar to that shown on the attachment may be used to provide space for coding.

SHA 51.3-8
11-15-72

STATE HIGHWAY ADMINISTRATION OF MARYLAND

FAU

ROAD INVENTORY SHEET

91-101
2-27-92
DT/JS

Party Chief ES.
Recorder WD.
Helper REWRITTEN BY ER. 11-7-79

Map No. M 35C

Road No. CO. 121
Road Name OLD PALMER RD.
Sheet No. 1 OF 2
Date 9-23-68 VER. 8-5-77
County PG.
State Coordinates 802-339

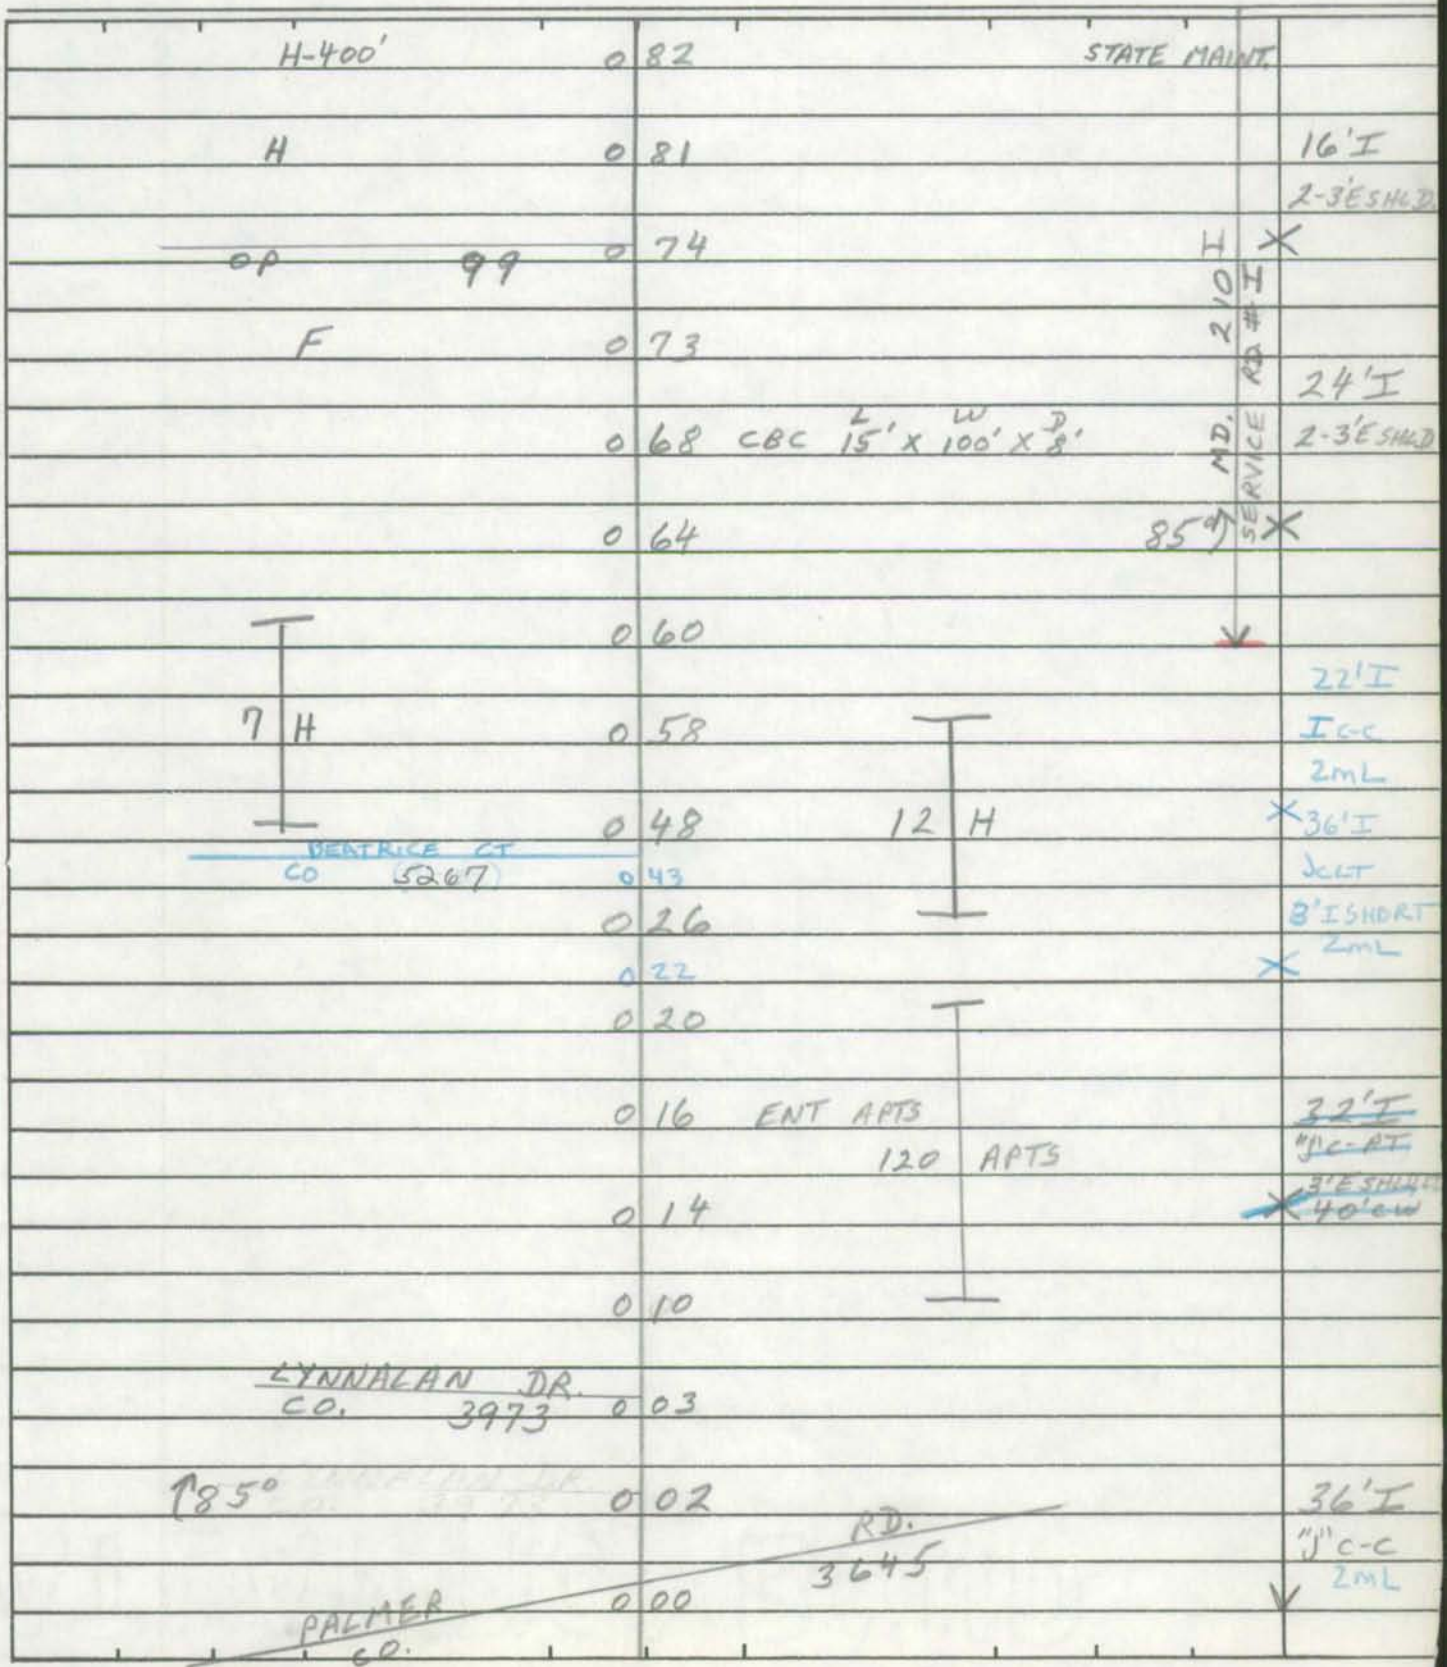

SHA 51.3-8
11-15-72

ROAD INVENTORY SHEET

Road No. CO. 121
Road Name OLD PALMER RD.
Sheet No. 2 OF 2
Date 9-23-68
County PG.
State Coordinates

	ROAD 1	32 END		
H	1	24		
F	1	09		
OLD CO.	1	03 FORT RD. 118		24'I C-C
	0	96	X	
BROAD VIEW RD CO. 161	0	91		24'I 2-3'ESHLD
	0	86	X	

MD. 210 SERVICE RD. #I

SHA 51.3-8
11-15-72

STATE HIGHWAY ADMINISTRATION OF MARYLAND

95-103 BB(AH) 196 ST

92-108/106 GD/AH 3-19-93

ROAD INVENTORY SHEET

Party Chief FR
Recorder JE
Helper

Map No. 35 GIIC

Road No. Co 122
Road Name BRINKLEY RD
Sheet No. 1 of 5
Date 2-24-82
County Prince Georges
State Coordinates 807-354

93 coord'd GD DR 3-18-94

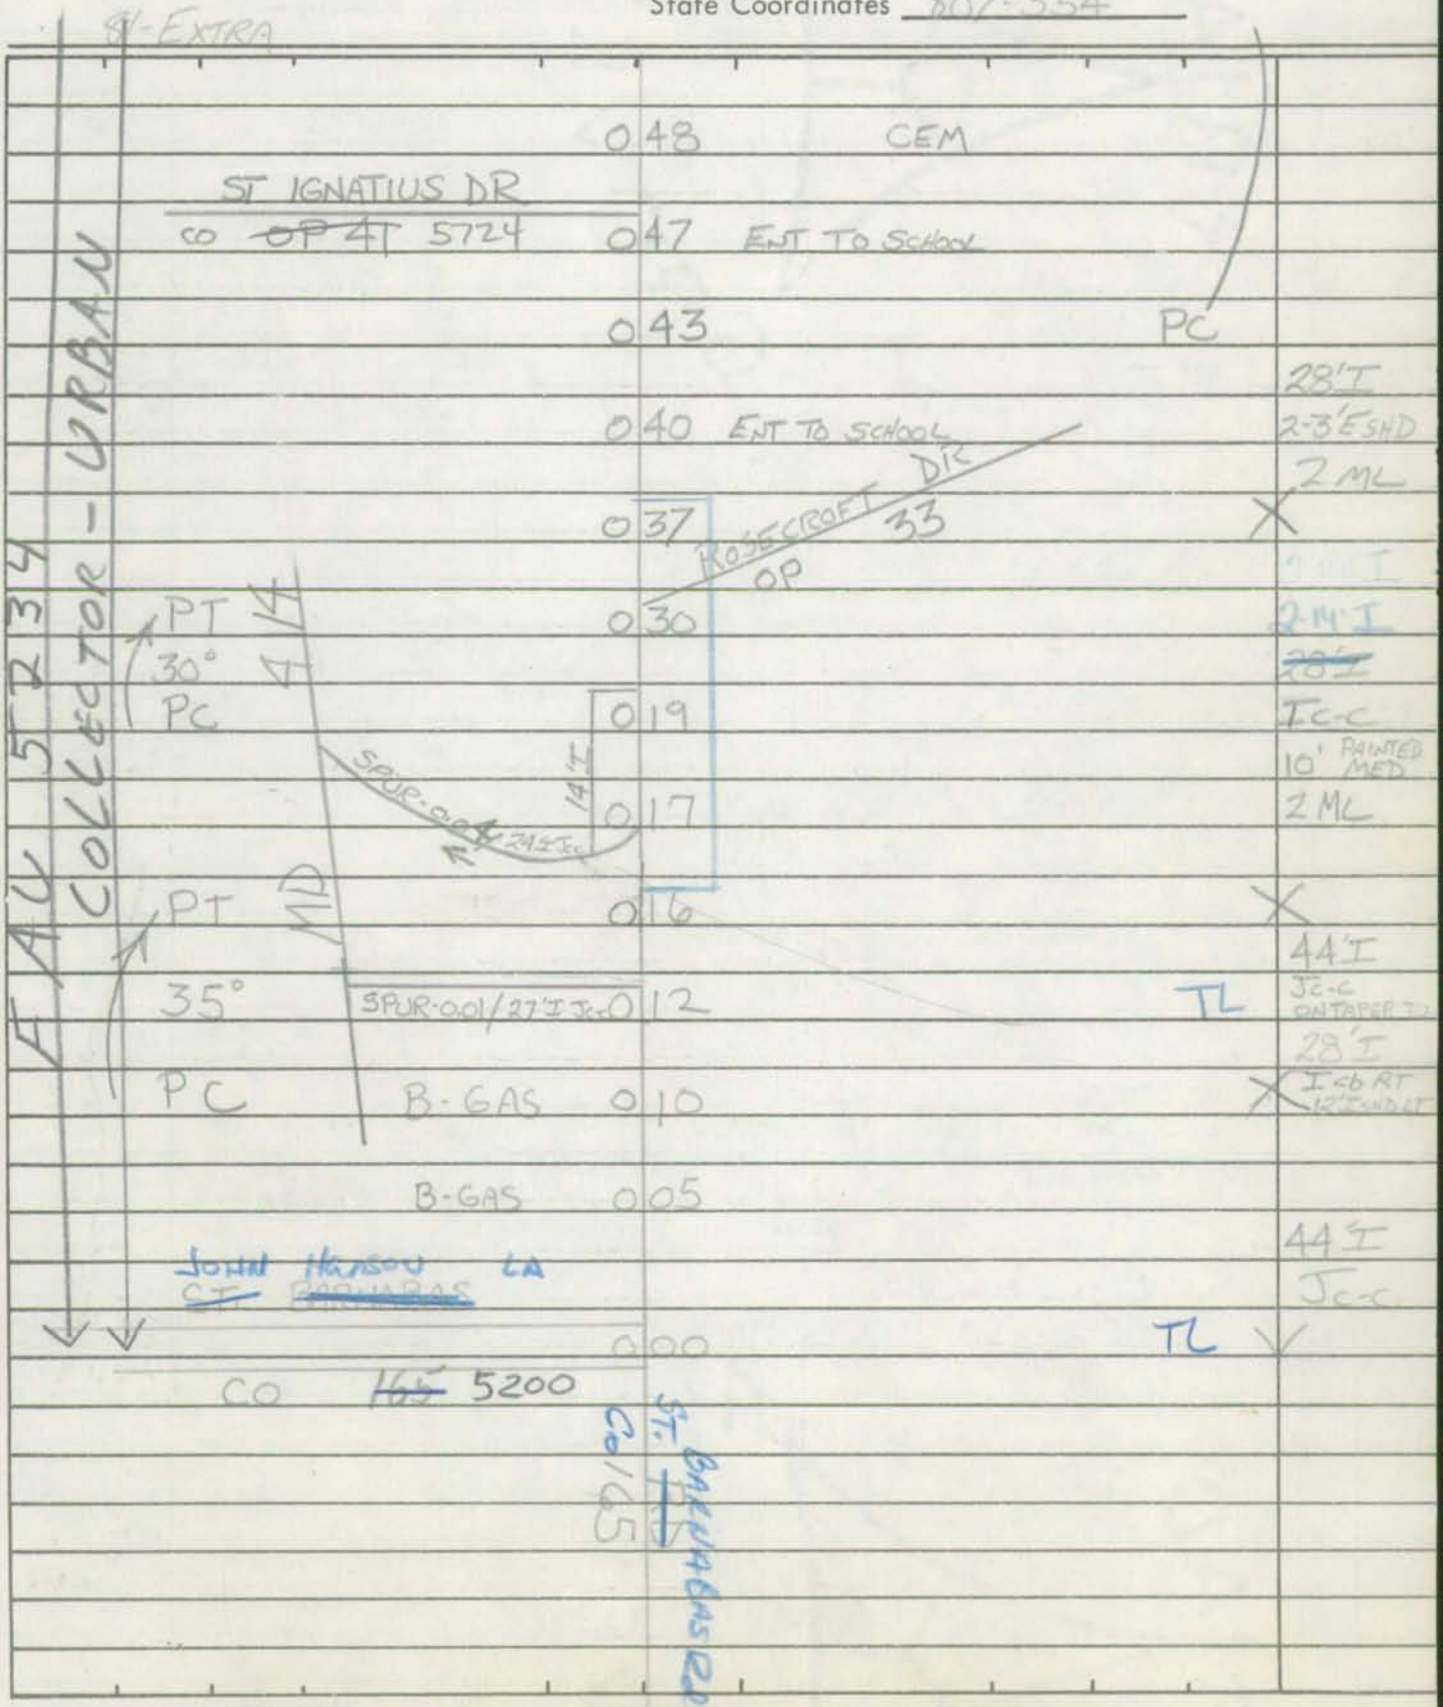

SHA 51.3-8
11-15-72

ROAD INVENTORY SHEET

Road No. Co 122
Road Name BRINKLEY RD
Sheet No. 2 of 5
Date 2-24-82
County Prince Georges
State Coordinates

FAU 5734 + URBAN COLLECTOR

			22'I
	171	#P307	23'E SHD
			30'C-W
			2ML
	158		X
			35'I
ENT TO APTS	148	CHURCH	Jcb LT
			4'E SHD RT
	140		X
PT	134		
30°	132	ENT TO S. CENTER TL	32'I
PC ENT APTS	128		Jcb RT
			X 2ML
	121	ENT APTS	X
			45'I
	108	ENT APTS	Jc-C
			2ML
	107		X
			33'I
	104	30°	5'I SH RT J C-LT
FISHER RD	099		2ML
CO 125	095		
PT 30°	091		X
PC	090		
GLEN ROCK AVE			28'I
CO 1950	069		2-3'E SH
			2ML
	058	PT	
	051	CEM	
		50°	
	049	CHURCH	

SHA 51.3-8
11-15-72

STATE HIGHWAY ADMINISTRATION OF MARYLAND

BB 89-78
RM 3-13-85

78

ROAD INVENTORY SHEET

Party Chief R. Bush
Recorder
Helper

Map No.

Road No. Co 122
Road Name BRINKLEY Rd.
Sheet No. 3 OF 5
Date 12-10-68 REVISED 4-29-74
County PR. GEO.
State Coordinates

FAU 5134 COLLECTOR-URBAN

T40 81.71

93
2 ~~80~~ X

SUMMER HILL Rd
Co 2723

89
1 ~~76~~ 44'I C-C

79
2 ~~66~~ X

2 75 X 34'I Cb Lt
3'F Shld Rt

F 2 ~~70~~ 54 X 50'CW

TEMPLE HILL RD
Co 123

60
2 ~~53~~ X

2 60 LUJEAN LA
2 ~~46~~ 59 Co 3300 70-157 24'I
2-3'F Shld
2 ML

FARMER DR.
Co 946

2 ~~35~~ 48

SOUTHFIELD RD
TRUDE ST. 2 ~~2336~~ CO 4447 X
Co 2404

2 ~~17~~ 30

29
1 ~~26~~ CHURCH

MORTON PL MIDDLEFIELD RD
Co 2054 2 ~~03~~ 16 ~~OP 1242~~ CO 4403

24'I
2 14 61 SHO Lt
3'F SHO Rt
45° 2 ML
2 ~~01~~ ~~98~~ X 40'I
7'E SHO Lt
1 CRT
2 ML
SAME

ROBERTS DR (CHERRYFIELD RD)
Co 2327 1 ~~72~~ 92 ~~X CO X X~~ 4732

REC CIR 1 ~~82~~ ~~77~~ 77
SEC CIR

SHA 51.3-8
11-15-72

ROAD INVENTORY SHEET

28
67
4 of 5

Road No. Co 122
Road Name
Sheet No. 4 OF 5
Date
County
State Coordinates

FAU 5834 · COLLECTOR - URBAN

	51	
CHURCH	3 38	
CLARIDGE Rd.	46	
Co 2517	3 35	
	WHITE OAK ~~DR~~ AVE	
	3 29 42 Co 2518	
	3 37 GIEN OAK DR	
LARWIN DR.	3 33 35 Co 2241	
CO. 3983	3 33	
JOYCE DR.	3 31	
Co 569	3 15 28	
	MAPLES LA	
	3 17 25 OP 37	22'I
		2-3'E Shld
	BUSHEY DR	30'cw
	3 07 20 Co 2728	X
George WASHINGTON DR.	19	
Co 2116	3 06	
	John Adams Dr	
	3 01 14 Co 1990	
(SHOPTON PL)	307	
OP 39 ~~Co 3209~~	3 04	
	305	
	3 02 ENT To School	
MIDDLETON LA		30'I Cb Lt
Co 935	3 87 School	3'E Shld Rt.
	300	

SHA 51.3-8
11-15-72

STATE HIGHWAY ADMINISTRATION OF MARYLAND

78

ROAD INVENTORY SHEET

Party Chief R. Bush (OFFICE)
Recorder
Helper

Map No.

Road No. CO 122
Road Name BRINKLEY Rd
Sheet No. 5 of 5
Date 12-10-68 REVISED 4-29-74
County PR. GEO.
State Coordinates

ALLENTOWN		70	Rd.
CO	3	57	126
BRINKLEY CT			
CO 4199	3	58 45	ANDERSON DR
	3	41 54	Co 2560
(72-133) MARK DR		52	
Co 3496	3	39	

FAU 5234 — B.C. — COLLECTOR - URBAN — FAU

SAME

SHA 51.3-8
11-15-72

ROAD INVENTORY SHEET

Road No. _____
Road Name _____
Sheet No. _____
Date _____
County _____
State Coordinates _____

SHA 51.3 - 8 Revised
4.83

MARYLAND STATE HIGHWAY ADMINISTRATION

ROAD INVENTORY SHEET

93-99
GD. AR
3-16-94

90-277
225-91
BB/BB
91-151
2-20-92
DT/JS

DT/TT
2-16-95
94-97

95-120
BB
AM
3/21/96

89-97,98,94

Party Chief BB
Recorder BB
Assistant
Map No./Dir. G11D / N
State Coordinates 823-336

Road No. Co. 123
Road Name TEMPLE HILL Rd.
County PRINCE GEORGES
Date 2/27/90
Sheet No. 1 OF 7

TRAFFIC CODES
TRAFFIC CONTROLS: STOP SIGN=S.S., TRAFFIC LIGHT=T.L., FLASHING RED BALL=F.R.

TRAFFIC CODES
PARKING RESTRICTIONS: A.M. PEAK, P.M. PEAK, A.M./P.M. PEAK, NO PARKING ANYTIME=N.P., COMM/IND. ACCESS=E

SYSTEM				TRAFFIC		LINE DIAGRAM	TRAFFIC			PAVEMENT DATA
FED. AID.	FUNCT CLASS	HWY. SYS.	HPMS SAMPLE	PRKG. REST.	COM/IND. ACCESS		CONTROL	COM/IND. ACCESS	PRKG. REST.	
										24'I
										30'CW
										2ML
						067 CBC L18'W31'D6'				X
										24'I
										~~5'~~ 3'ISHDRT
						SALIMA ST.				2ML
						049 Co 90-192 5116				X
						12'I JCRT				~~36'I~~ 24'I
										JC-RT
										2ML
						045				X
						OAHU ST				
						Co 4658 042				
						040 CLINTON GROVE E.S.		E		
						036		E		
						BADGER AVE				36'I
						034 Co 3298				24'I JC-LT
										~~10'ISHDLT~~
						029	TY			2ML
						028				X
										24'I 6'ISHD LT
										10'ISHDRT
						018				X 2ML
						003		E		24'I
						(Piscataway RD)				50'CW
V	V					MD 000 223	TL			V 2ML

Fall 5109
Urban Minor Arterial

SYSTEM: FED. AID. | FUNCT. CLASS. | HWY. SYS. | HPMS SAMPLE
TRAFFIC: PRKG. REST. | COM/IND ACCESS

FAU 5109
Urban Minor Arterial

LINE DIAGRAM

TRAFFIC: CONTROL | COM/IND ACCESS | PRKG. REST.

PAVEMENT DATA

KIRBYWOOD ST
172 Co. 5006
168
(GUE ST.)
157 OP 50
140
MEGAN DR.
133 Co. 4269
PT 30°
131
PC
125
121
118
TRAILER CT. RD
OP 49
112
SANTEETLAH Rd
Co. 4656
097 Co. ~~4875~~ 3293
@1.24
PLATA ST
074

PAVEMENT DATA
36'I
JC-RT
X 2ML
24'I
40'CW2ML
X
24'I
10'ISHDLT
5'ISHDLT
JC-RT
X 2ML
36'I JC-RT
~~8'~~ SHDLT
2ML
X
36'I JC-LT
2ML
X
38'I
~~36'I~~ JC-RT
~~10'~~ ISHDLT
2ML
X
52'I
~~48'I~~
JC-C
2ML
X
~~40'I~~
~~JC-RT~~
~~2ML~~
X

SHA 51.3-8
11-15-72

STATE HIGHWAY ADMINISTRATION OF MARYLAND

FAU

ROAD INVENTORY SHEET

86-135 BB 3-27-87 TM 78

Party Chief R. Bush (OFFICE)
Recorder
Helper

Map No. M35 INDEX 9 VER 7-29-77

Road No. C0123
Road Name TEMPLE HILL Rd
Sheet No. 1 OF 6
Date 12-16-68 REVISED 4-29-74
County PR. GEO
State Coordinates 823-336

FAU 5109 FAE MINOR ARTERIAL - URBAN

89-97+98
2-27-90
BB/BB
See New INV

30°

Sand & Gravel ENT 172 KIRBYWOOD ST Co. 89-175 — 34'I JC-RT 2ML
170 — X
PVT ENT 153 — 24'I 40'CW 2ML
GUE ST. — X 24'I
157 OP 50 C042149
133 MEGAN DR — X 10'I Rt Shld
131
125
(TRAILER CT) OP 49 112
100 — 30'I
093 ENT ST Sand & Gravel PIT — 3"C-Rt
SANTEE LAB RD CO4LEE 097 CO 4813 — X
FARM ENTRANCE 095 073
L W D
06 SALIMA ST CBC 18X31X6
PROP
04 — 24'I 30'CW
FARM 045 — X
OAHU ST CO. 4658 042
040 ENT TO ELEM School — 24'I
BAGER AVE
034 Co 3298 70-18 — X
028 — X
018
003 TAVERN — 24'I 2-3'E Shld 50' CW
MD 000 223 — 2ML

N

SHA 51.3-8
11-15-72

ROAD INVENTORY SHEET

Road No. Co 123
Road Name
Sheet No. 23 OF 87
Date
County
State Coordinates

75-109

				50'I
	ALLENTOWN Rd			JC-C
	Co	285	126 TL	X 4ML
	Bus-Carry out	282		
				44'I
↑15°		279		JC-C
		277		X 4ML
		275	Bus. Constr Co.	
	(MANSFIELD ↑ MANOR DR.)			
	Co 2681	264		
		248	ENT	
		244	CHURCH	24'I
				2-3'E Shld
				50'CW
		236		X 2ML
				30'I ob Rt.
	JEAN MARIE DR.			3'E Shld Lt.
	Co 2557	221		X
				24'I
	PVT ENT	214		40'CW
				2ML
		191	# P0504 SEE BR. SH. 1A	
	KIRBY Rd.			
	Co 96	181		X
				~~SAME~~

FAS 1046

FAU 5109 MINOR ARTERIAL - URBAN

SHA 51.3-8
11-15-72

STATE HIGHWAY ADMINISTRATION OF MARYLAND

90-184 78
2-22-91
BB/BB

ROAD INVENTORY SHEET

Party Chief R. Bush (OFFICE)
Recorder
Helper

Map No. M35
INDEX 9

Road No. C0123
Road Name TEMPLE HILL & Rd
Sheet No. 84 OF ~~67~~
Date 12-16-68 Revised 4-29-74
County PR. GEO.
State Coordinates

FAU 5109 #13 1.546 MINOR ARTERIAL - URBAN

LAKEVIEW DR
Co 1965 354

30° 346

BRINKLEY Rd.
Co 343 122

339 PT

HENSON 332 Co CMP CREEK #P0308P 32'I J CURB RT 6'E SHD

TELEPHONE Co. 331 50° ~~24'I~~ ~~2'E Shld~~

326 X

323 PC

CARDWELL DR
313 Co 2727 40'XI JC-C

303 X

TELEPHONE Co. 300

FARMER ~~Rd~~ Dr
Co 946 299 40'I JC-LT

School ENT. 296 EC-RT 4ML

HIGH School 292 ENT TO S.C ~~30'I CB RT~~ ~~3'E Sh LT~~

Gas Sta 287 ~~8'F~~ 50'I JC-C 4ML

SHA 51.3-8
11-15-72

ROAD INVENTORY SHEET

Road No. Co 123
Road Name TEMPLE HILLS Rd.
Sheet No. 5 OF 7
Date
County
State Coordinates

72-131 SUBURBAN C Co 3495	433		
OP1032	429		
	426	OLD TEMPLE HILLS Rd Co 2551	
OLD TEMPLE HILLS Rd. Co 7112	423		
	414	SEE BR. SHEET 1B #P0305C	
		HENDERSON Rd.	
	410	Co 3676	24'I 1-3'E Shld
	403		X 30'I CURB RT 6'E Shld LT.
	391	#P0306	X
WELDON Co	387	DR 2720	
CHURCH	377		
CEDELL Co	370	DR. 1732	32'I CURB RT 6'E Shld LT.
	356		same ↓ X

FAU 5109 MINOR ARTERIAL - URBAN
30°

SHA 51.3-8
11-15-72

STATE HIGHWAY ADMINISTRATION OF MARYLAND

78

ROAD INVENTORY SHEET

Party Chief R. BUSH (OFFICE)
Recorder
Helper

Map No. M35
INDEX 9

Road No. C0123
Road Name TEMPLE HILLS Rd
Sheet No. 65 OF 67
Date 12-16-68 REVISED 5-3-74
County PR. GEO
State Coordinates

78-103

				42'I C-C
	508	CHURCH		
		SPRING ~~DR.~~ TERR.		24'I
NURSEY	502	C01021		2-3'E SHD 50'W
	500		30°	~~44'I~~ ~~2-3'E Shld~~
FISHER Rd.				
80°		Co 571	490	X
PORTAL AVE				
		Co 1567	484	
FAU 5109 MINOR ARTERIAL - URBAN	479		50°	
30°	470			
	466			34'I JQURB LT 3'E Shld RT
LAMBERT DR				
		Co 1572	465	X
	461	CHURCH		
				40'I
	458			2 C-C
	452	ELEM School	65°	X
~~OP 788~~				
	445			
				OLD TEMPLE HILLS Rd.
FARM	442	Co 2551		

SHA 51.3-8
11-15-72

ROAD INVENTORY SHEET

Road No. Co 123
Road Name
Sheet No. ~~7~~ 6 OF ~~8~~ 7
Date
County
State Coordinates

RALEIGH Rd
Co 3733

MD — 561 — 414' — 2-26' I
M 3POR 0.01 / 17' I 1'C-C — 1'C-C
559 — 4' J MED
557 — SHOP CENTER — X

CARLTON AVE
Co 196 — 552

RICKEY AVE
546 — Co 1960

LESLIE AVE
Co 197 — 543

LESLIE ~~PL~~ AVE — 34' I
542 — Co 2841 — 1 CB LT
3'E SHD RT

524 — GAS Stg.
HAGAN Rd. — 523 — X
Co 124 — 522

FAU 5109
MINOR ARTERIAL - URBAN

518

I — 515 — ~~495~~ BR # 16166

513 — SAME

FAS 1046

Form 5-HPS (Revised 1961) MARYLAND STATE ROADS COMMISSION PLANNING AND PROGRAMMING DIVISION S26130

IN COOPERATION WITH
U. S. BUREAU OF PUBLIC ROADS

BRIDGE SHEET

ROAD NO. CO 123

SHEET NO. 1A

PARTY NO.

DATE 12-16-68

COUNTY PRINCE GEO

RATED CAPACITY

FOR ALL STRUCTURES HAVING A TOTAL OPENING OF MORE THAN 20 FEET AS DEFINED IN NOTE 1.

ODOMETER READING 1.91 NAME OF STREAM, RAILROAD OR HIGHWAY CROSSED

NUMBER OF RAILROAD TRACKS

KIND OF CROSSING (NOTE 2)

UNDERPASS-SIMPLE UNDERPASS-COMBINED (NOTE 3) OVERPASS BRIDGE OVER SYSTEM STREAM

DESCRIPTION

NUMBER OF SPANS	LENGTH EACH SPAN (NOTE 4)	TYPE (NOTE 5)
2	20'	CONCRETE SLABS

TOTAL LENGTH-ON LINE OF ROAD OVER-ALL (NOTE 6) 42'

MATERIAL

SUBSTRUCTURE CONCRETE SLAB SUPERSTRUCTURE

FLOOR

CLEARANCES

ROADWAY (NOTE 7) 36' SIDEWALK WIDTHS: RIGHT LEFT 4'J

SURFACE OF ROAD TO STREAM BED 8 FOR OVERPASSES, SHOW DISTANCES TO TOP OF RAIL OR SURFACE OF LOWER ROAD. (NOTE 8)

SURFACE OF ROAD TO BOTTOM PORTAL (MINIMUM OVERHEAD CLEARANCE

CLEAR DISTANCE OF OPENING ABOVE STREAM BED 6' (WATERWAYS ONLY)

POSTED LOAD LIMITS BRIDGE NO. CONSTRUCTION DATE 1963

GENERAL CONDITION OF BRIDGE: CHECK IF GOOD, FAIR, OR POOR, DESCRIBE DEFECTS IF SERIOUS.

	GOOD	FAIR	POOR
SUPERSTRUCTURE	✓		
FLOOR	✓		
SUBSTRUCTURE	✓		
PAINT	✓		BADLY CORRODED OR RUSTED

TYPE OF PROTECTION FOR DRAWBRIDGES (NOTE 9)

(NOTES ON REVERSE SIDE)

S26130

Notes:

1. In agreement with Federal-aid standards, a bridge is defined as a structure including supports erected over a depression or an obstruction, as water, highway, or railway, and having a track or passageway for carrying traffic or other moving loads, and having a length measured along the center of roadway of more than 20 feet between undercoping of abutments or spring lines of arches, or extreme ends of openings for multiple boxes and pipes, where the clear distance between openings is less than half of the smaller contiguous opening.

2. Show kind of crossing by checking descriptive item applicable. For multiple-span bridges give complete information on each span including approach spans. Indicate on leg sheet the odometer reading, position, and angle of skew of structure with respect to center line of road and by arrow the direction of stream flow.

3. Give information on the span over the highway only.

4. For span length use center to center of bearings, otherwise the clear opening. Skew bridges will be measured along center line of road. See Note 1.

5. Show general type such as: Trestle, Truss, Girder, I-Beam, Rigid Frame, Arch, Slab, Suspension, or Covered Bridge. See illustrations attached. Describe draw spans by classifications listed in Article X, Section 2 of Manual.

6. The length of a bridge structure is the over-all length measured along the line of survey stationing back to back of back-walls of abutments, if present, otherwise end to end of bridge floor, but in no case less than the total clear opening of the structure.

7. Give minimum lateral clearance. Where traffic lanes are separated by bridge numbers, show clearance width of each lane separately. Special conditions should be explained by notes.

8. In case of overhead bracing or arch construction, measurement shall be made to the lowest point above the road surface.

9. Use classification listed on RR crossing sheet. Form 4 HPS.

Remarks: _____

_____

A rearrangement of the form similar to that shown on the attachment may be used to provide space for coding.

Form 5-HPS (Revised 1961)

MARYLAND STATE ROADS COMMISSION
PLANNING AND PROGRAMMING DIVISION

S26130

IN COOPERATION WITH
U. S. BUREAU OF PUBLIC ROADS

BRIDGE SHEET

ROAD NO. CO 123
SHEET NO. 1B
PARTY NO.
DATE 12-16-68
COUNTY PRINCE GEO

RATED CAPACITY

FOR ALL STRUCTURES HAVING A TOTAL OPENING OF MORE THAN 20 FEET AS DEFINED IN NOTE 1.

ODOMETER READING 4.14 NAME OF STREAM, RAILROAD OR HIGHWAY CROSSED

NUMBER OF RAILROAD TRACKS
KIND OF CROSSING (NOTE 2)

UNDERPASS-SIMPLE | UNDERPASS-COMBINED (NOTE 3) | OVERPASS BRIDGE OVER SYSTEM STREAM

DESCRIPTION

NUMBER OF SPANS	LENGTH EACH SPAN (NOTE 4)	TYPE (NOTE 5)
2	28'	CONCRETE SLAB

TOTAL LENGTH-ON LINE OF ROAD OVER-ALL (NOTE 6) 56'

MATERIAL
SUBSTRUCTURE CONCRETE SUPERSTRUCTURE
FLOOR BIT. MIX

CLEARANCES
ROADWAY (NOTE 7) 40' SIDEWALK WIDTHS: RIGHT 4' LEFT 4'

SURFACE OF ROAD TO STREAM BED 8 FOR OVERPASSES, SHOW DISTANCES TO TOP OF RAIL OR SURFACE OF LOWER ROAD. (NOTE 8)
SURFACE OF ROAD TO BOTTOM PORTAL (MINIMUM OVERHEAD CLEARANCE
CLEAR DISTANCE OF OPENING ABOVE STREAM BED 6 (WATERWAYS ONLY)
POSTED LOAD LIMITS BRIDGE NO. CONSTRUCTION DATE 1961

GENERAL CONDITION OF BRIDGE: CHECK IF GOOD, FAIR, OR POOR, DESCRIBE DEFECTS IF SERIOUS.

	GOOD	FAIR	POOR
SUPERSTRUCTURE	✓		
FLOOR		✓	
SUBSTRUCTURE		✓	

PAINT ✓ BADLY CORRODED OR RUSTED
TYPE OF PROTECTION FOR DRAWBRIDGES (NOTE 9)

(NOTES ON REVERSE SIDE)

S26130

Notes:

1. In agreement with Federal-aid standards, a bridge is defined as a structure including supports erected over a depression or an obstruction, as water, highway, or railway, and having a track or passageway for carrying traffic or other moving loads, and having a length measured along the center of roadway of more than 20 feet between undercoping of abutments or spring lines of arches, or extreme ends of openings for multiple boxes and pipes, where the clear distance between openings is less than half of the smaller contiguous opening.

2. Show kind of crossing by checking descriptive item applicable. For multiple-span bridges give complete information on each span including approach spans. Indicate on leg sheet the odometer reading, position, and angle of skew of structure with respect to center line of road and by arrow the direction of stream flow.

3. Give information on the span over the highway only.

4. For span length use center to center of bearings, otherwise the clear opening. Skew bridges will be measured along center line of road. See Note 1.

5. Show general type such as: Trestle, Truss, Girder, I-Beam, Rigid Frame, Arch, Slab, Suspension, or Covered Bridge. See illustrations attached. Describe draw spans by classifications listed in Article X, Section 2 of Manual.

6. The length of a bridge structure is the over-all length measured along the line of survey stationing back to back of back-walls of abutments, if present, otherwise end to end of bridge floor, but in no case less than the total clear opening of the structure.

7. Give minimum lateral clearance. Where traffic lanes are separated by bridge numbers, show clearance width of each lane separately. Special conditions should be explained by notes.

8. In case of overhead bracing or arch construction, measurement shall be made to the lowest point above the road surface.

9. Use classification listed on RR crossing sheet. Form 4 HPS.

Remarks: _____

_____

A rearrangement of the form similar to that shown on the attachment may be used to provide space for coding.

Form 6 HPS (Rev. 1961) FAU 3-109

ROAD INVENTORY SHEET

Party Chief E SCHUYLER
Recorder T LANDAN
Chainman JEMERICK
P Plummer

MAP 6

NORTH BARNABY

814.359 M35

Road No. Co 124
Name HAGAN RD
Sheet No. 1 OF 1
Date 12- 20 -67
County PRINCE GEORGES

PD 123

TEMPLE HILLS Co

044
043
040
033
029
023
022
020
018
016
012
009
007
006
002
000

6 H

13 H

3 H

16 H

H

H

B-DOCTOR

LESLIE Co

CARLTON AVE Co 196

MD

PARK

PT 30°

PC

AVE 197

414

DR

10"C
2-3"ESH
28'CW
DK

44' I
J c-c
20'C
2-1"ESWD
30'W

SHA 51.3 - 8 Revised
4.83

MARYLAND STATE HIGHWAY ADMINISTRATION

Wash. Urban (92-107)

ROAD INVENTORY SHEET

Party Chief G. DAVIS
Recorder A. HATTEN
Assistant
Map No./Dir. 6H1D / NE
State Coordinates 812-354

Road No. CO 125
Road Name FISHER RD
County PRINCE GEORGES
Date 3-19-93
Sheet No. 1 OF 2

90-176
81-189

TRAFFIC CODES
TRAFFIC CONTROLS: STOP SIGN=SS, TRAFFIC LIGHT=T.L., FLASHING RED BALL=F.R.

TRAFFIC CODES
PARKING RESTRICTIONS: A.M. PEAK, P.M. PEAK, A.M./P.M. PEAK, NO PARKING ANYTIME=N.P., COMM/IND. ACCESS=E

SYSTEM FED. AID.	SYSTEM FUNCT CLASS.	SYSTEM HWY. SYS.	SYSTEM HPMS SAMPLE	TRAFFIC PRKG. REST.	TRAFFIC COM/IND. ACCESS	LINE DIAGRAM	TRAFFIC CONTROL	TRAFFIC COM/IND. ACCESS	TRAFFIC PRKG. REST.	PAVEMENT DATA
					E	0 23				
										30'I
					E	0 21				VC-LT
										2 ML
						0 20			X	
										30'I
						BRINKLEY STATION DR				JC-RT
						0 16 CO 5113				2 ML
						0 07			X	
						0 06				
					RTL					
						CLOW CT				
						0 04 ENT TO APTS				
										30'I
					H					JC-C
					10'					2 ML
						BRINKLEY RD				
V						CO 0 00 122	TL			

urban collector

SYSTEM				TRAFFIC		LINE DIAGRAM	TRAFFIC			PAVEMENT DATA
FED. AID.	FUNCT. CLASS.	HWY. SYS.	HPMS SAMPLE	PRKG. REST.	COM/IND ACCESS		CONTROL	COM/IND ACCESS	PRKG. REST.	
	Urban Collector					(MYRTLE AVE)				
						0 30 C0 570			↑	
										21'I
										2 ML
						ENT TO APTS				
						OP 515 0 25			X	
										30'I
										JC-LT
										2 ML

SHA 51.3-8
11-15-72

STATE HIGHWAY ADMINISTRATION OF MARYLAND

96-136, 137
BB/MG
3-21-97

18

ROAD INVENTORY SHEET

Party Chief T. LANDON
Recorder F. RHODES
Helper

Map No. 39 + 35
H-11
75-108

VER 8-2-77
75-148 A/T

Road No. CO. 126
Road Name ALLENTOWN RD.
Sheet No. 1 OF 7
Date 2/28/75
County P.G.
State Coordinates 813-344

91-117 A/T
90-185 A/T

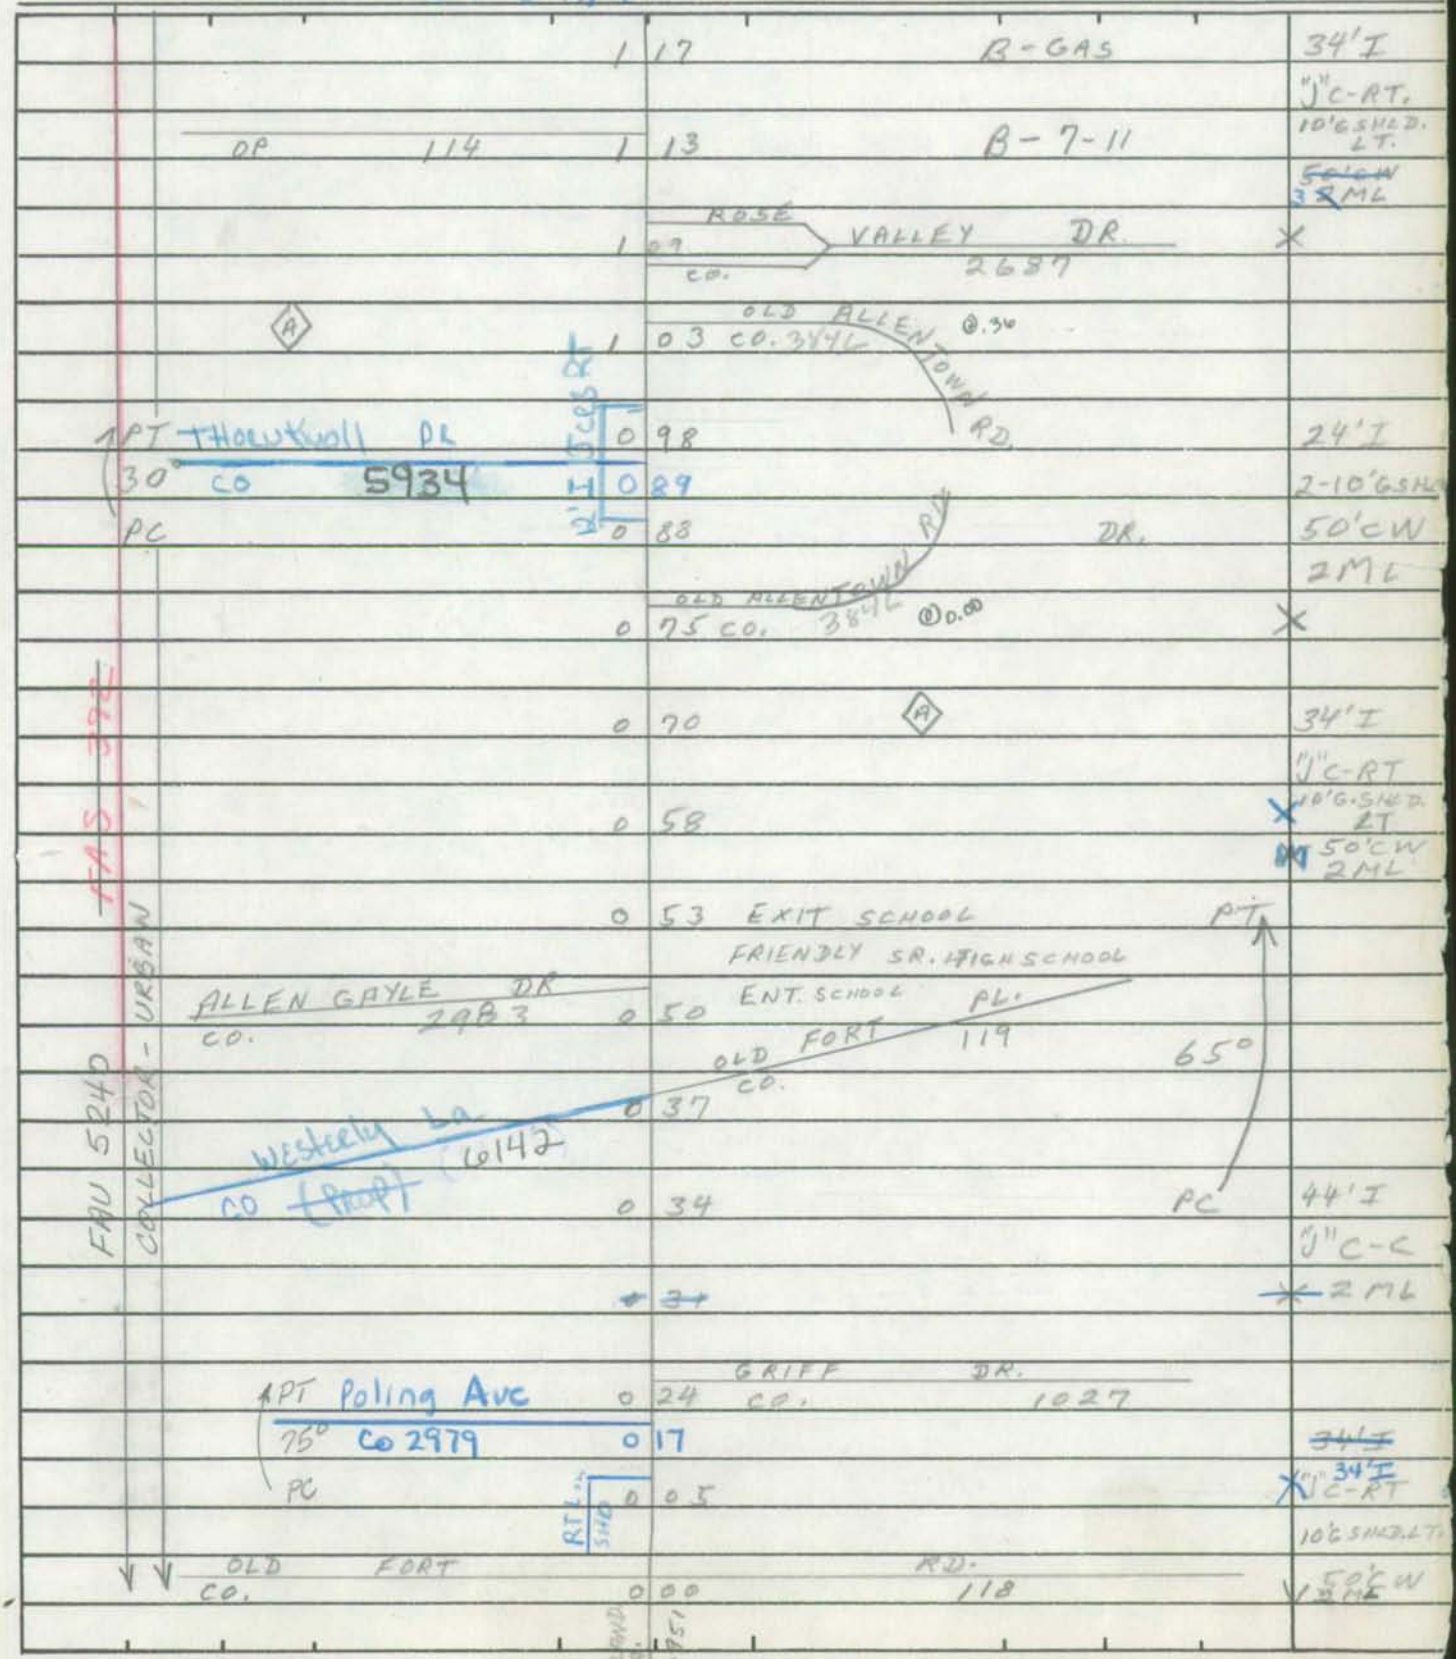

SHA 51.3-8
11-15-72

ROAD INVENTORY SHEET

Road No. CO. 126
Road Name ALLENTOWN RD.
Sheet No. 2 OF 7
Date 2/28/75
County P.G.
State Coordinates

FAU 5240 COLLECTOR - URBAN

	2	23 EXIT SCHOOL	
	2	20 LORD BALTIMORE JR. HIGH	
ALLEN TOWN V.F.D.	2	15 ENT SCHOOL	
ALDERTON AVE. CO. 2685	2	14	
	2	11 STONE BORO RD. CO. 3218	
	2	01	
	1	90 (A)	
AUTO JUNK YARD - 500'	1	83	
	1	77 CALYDON CT. CO. 3821 74-170	
	1	73 RD. 120° PT	
	1	65 STEED CO. 60°	TL
	1	58 STEEDS GRANT WAY PC	
	1	53 CO 5942	
PINE HURST DR. CO. 2353	1	46 15°↑	
CONSTANTINE DR ~~OF~~ CO PROP. ~~T210~~ 4233	T	40 CHURCH	
PT	1	30	
30° DORIS DR. CO. 2214	1	27	44' I 5" c-c
PC	1	24	ML

SHA 51.3-8
11-15-72

STATE HIGHWAY ADMINISTRATION OF MARYLAND

1 8

ROAD INVENTORY SHEET

Party Chief T. LANDON
Recorder F. RHODES
Helper

Map No. 35
G 11 D

Road No. CO. 126
Road Name ALLENTOWN RD
Sheet No. 3 OF 7
Date 2/28/75
County P.G.
State Coordinates

				3	17	VERNON DR. CO. 1032
				3	11	VELTRAJ DR. CO. 2138
		KLOVSTAD CO. 1165		3	05	DR. CO. 2633
FAU 5104	MINOR ARTERIAL-URB.	COMET OP. 105		2	96	DR. CO. 3117
		PRINCE GEORGES DR. CO. 944		2	87	GENNENE LA CO (5276)
		ARUNDEL CO. DR. 3644		2	78	JOSELLE CT CO 5519
				1		
		TUCKER RD. CO. 193		2	68	
		CHURCH		2	48	
FAU 5240	COLLECTOR-URBAN	B-GAS		2	42	OAKLAWN RD. CO. 199
				2	38	R-7-11
				2	36	MARSTON DR. CO 5115
		OAKEWOOD RD. CO. 2350		2	34	
		(DUNLOW LA) CO 5313		2	29	TAYAC ELE SCHOOL
				2	25	

44'I JC-C 4ML

TL 42'I JC-C 3ML

PT 30°

44'I JC-C 4ML SAME

SHA 51.3-8
11-15-72

STATE HIGHWAY ADMINISTRATION OF MARYLAND

ROAD INVENTORY SHEET

Party Chief T. LANDON
Recorder F. RHODES
Helper REWRITTEN BY FR 11-9-79

Map No. 35

Road No. CO. 126
Road Name ALLENTOWN RD.
Sheet No. 4 OF 7
Date 2-28-75 VER. 8-2-77
County PG.
State Coordinates

Lanham OP 5011	4	00	~~LANHAM~~ LA. CO. 1163 @.16
PC	3	95	
PAYNE DR ~~CO~~ ~~A311~~ CO 1164	3	88	PAYNE DR. CO. 1164
WEBSTER CO.	3	76	LA. 568
GAS STA.	3	74	TV. SHOP
BAR & HARDWARE	3	72	
— · — — — — —	3	68	B-HIGHS
	3	66	GAS STA.
	3	59	30° ↑
BURGESS LA. CO. 2162	3	55	
E to CHURCH	3	29	
	3	35	WILLIS LA. ~~CO~~ ~~LOT~~ CO 5180
GAS STA.	3	33	
	3	30	PATS LA. CO. 2161
	3	28	CHURCH
LUMAR DR. CO. 949	3	25	RADFORD ~~RD.~~ DR CO. 3691 TL
B-BARBER SHOP	3	23	
CHURCH	3	19	

4 I
R-C
4ML
~~SAME~~

MINOR ARTERIAL - URBAN
SL 24

SHA 51.3-8
11-15-72

ROAD INVENTORY SHEET

Road No. CO. 126
Road Name ALLENTOWN RD.
Sheet No. 5 OF 7
Date 2-28-75 VER. 8-2-77
County PG.
State Coordinates _____

	5 11	PC	
DODGE LA. CO. 1966	5 08	KINGSTON DR CO. 2124	
MACKSON DR. CO. 2576	5 02		
	4 98	KIDDIMINSTER DR. CO. 2521	
	4 94	CHURCH	
	4 89	KAREN ANNE DR. CO. 2637	
	4 82	LOCH RAVEN RD. CO. 1995	
	4 78	WALDRAN AVE. CO. 2163	
	4 66	PVT. ENTRANCE	
~~CHURCH~~	~~4 62~~		
APT 50' PC	4 53		
	4 49		
TEMPLE HILL CO.	4 44	RD. 123	T2
GAS STA.	4 42	CARRY OUT SHOP	
ENT. TO SCHOOL	4 30		
PLEASANT HILL DR. CO. 2333	4 25		44' I
			5C-C
	4 14	REC. CENTER	4 ML
APT 65'	4 02		~~SAME~~

F AU 5104 MINOR ARTERIAL - URBAN

96-2 ST

SHA 51.3 - 8 Revised 4.83

MARYLAND STATE HIGHWAY ADMINISTRATION

ROAD INVENTORY SHEET

Party Chief BB
Recorder MG
Assistant
Map No./Dir. 1
State Coordinates

Road No. Co 126
Road Name ALLENTOWN Rd
County P.G.
Date 3-27-97
Sheet No. 7 OF 7

TRAFFIC CODES
TRAFFIC CONTROLS: STOP SIGN-SS, TRAFFIC LIGHT=T.L., FLASHING RED BALL=F.R.

TRAFFIC CODES
PARKING RESTRICTIONS: A.M. PEAK, P.M. PEAK, A.M./P.M. PEAK, NO PARKING ANYTIME=N.P., COMM/IND. ACCESS=E

SYSTEM: FUNCT CLASS, HWY. SYS, HPMS SAMPLE
TRAFFIC: PREG. REST., COM/IND ACCESS

LINE DIAGRAM

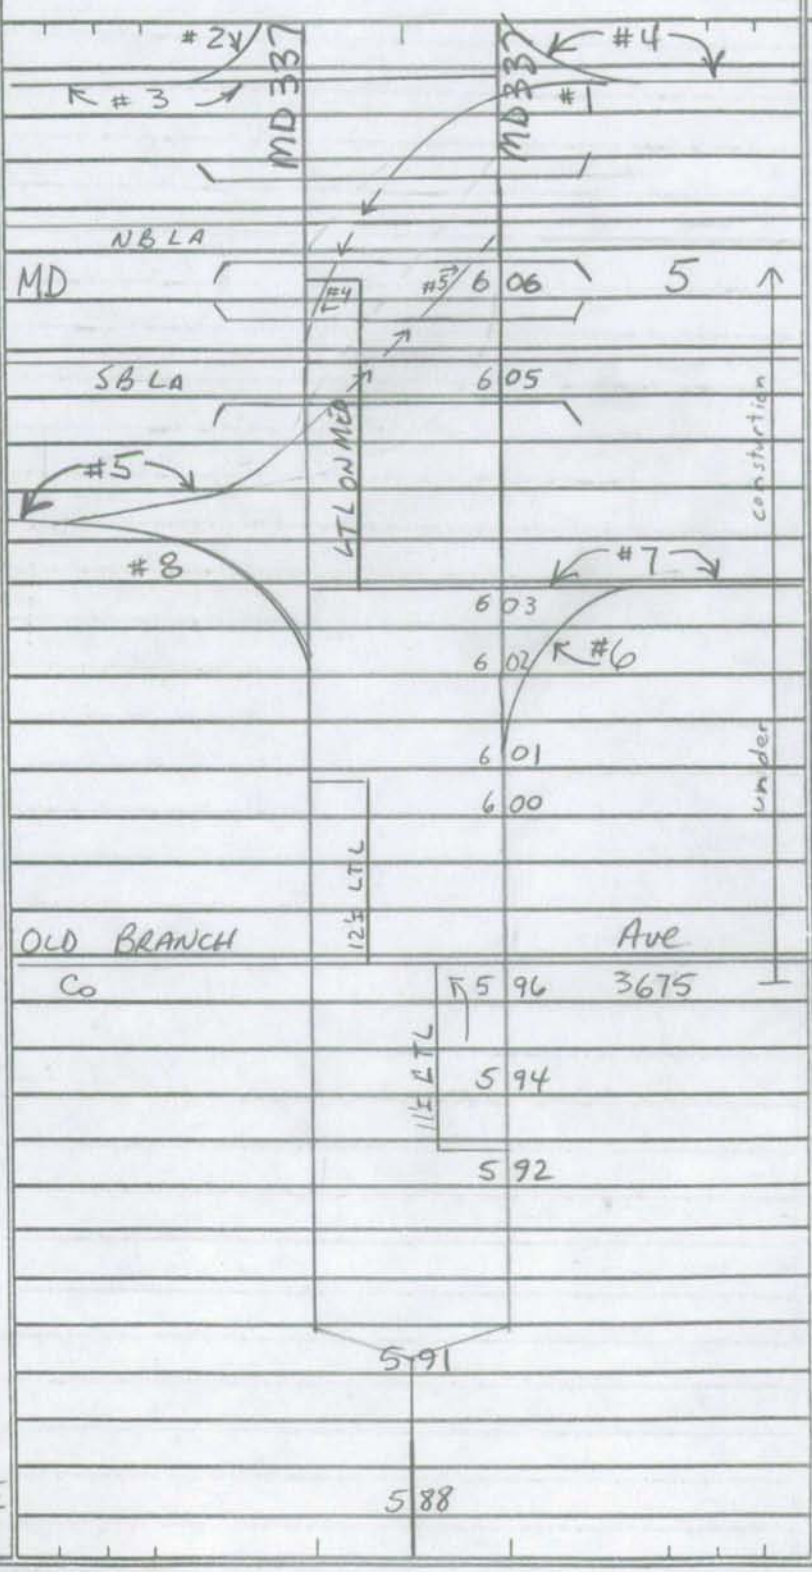

TRAFFIC: CONTROL, COM/IND. ACCESS, PREG. REST.

PAVEMENT DATA

2-36'I
12'I PNT MED.
JC-C OUT
6ML
TL
36'I RT
24'I LT
4'J MED.
JC-C IN/OUT
5ML
TL
2-22'I
14'I PNT. MED
JC-C OUT
4ML
44'I
JC-C
4ML

COUNTY _____ ROAD NO. _____ PAGE ___ OF _____

SYSTEM				TRAFFIC		LINE DIAGRAM	TRAFFIC				PAVEMENT DATA
FUNCT CLASS	HWY SYS	NHS	STATE	PRES	COM/IND ACCESS		% OTHER	COM/IND ACCESS	PRES. REST.		

SHA 51.3-8
11-15-72

STATE HIGHWAY ADMINISTRATION OF MARYLAND

96-2 ST 95-30 ST
BB/MG BB/AH
3-27-97 3/20/96

ROAD INVENTORY SHEET

Party Chief TL
Recorder FR.
Helper REWRITTEN BY FR 11-9-79

Map No. 35

Road No. CO. 126
Road Name ALLENTOWN RD.
Sheet No. 6 OF 7
Date 2-28-75 VER. 8-2-77
County P.G.
State Coordinates

	~~GAS STA.~~	5	~~93~~	~~GAS STA.~~
		5	~~91~~	~~HIGHS STORE~~
	~~7-11 STORE BANK~~	5	~~88~~	
	CAMP SPRINGS AVE. CO. 1991	5	86	GAS STA.
		5	78	ALLENTOWN WAY CO. 3873 TL
		5	75	HIGH SCHOOL
	BRINKLEY RD. CO. 122	5	67	EXIT SCHOOL TL
		5	55	NAPOLI RD. CO. 2240
		5	47	COOLRIDGE ~~COOL RIDGE RD. DR~~ CO. 1425
		5	40	BERKSHIRE DR. CO. 2121
	SCOTT LA. OP 111	5	34	
		5	31	WESTCHESTER CT. CO. 2164
		5	24	WESTCHESTER DR CO. 1433
	TALL OAK DR. CO. 2975	5	21	
FAU 5109 MINOR ARTERIAL - URBAN		5	20	PT 44'I JC-C
		5	17	SHEFFIELD DR CO. 1255 4/ML
		5	14	75° TAYLOR MANOR AVE. ~~OP~~ CO 4975 ~~SAME~~

SHA 51.3-8
11-15-72

ROAD INVENTORY SHEET

Road No. CO. 126
Road Name ALLENTOWN RD.
Sheet No. 7 OF 7
Date 2-28-75 VER. 8-2-77
County A.G.
State Coordinates

VOID SEE NEW Inventory Co 126 96-25T BB/AG 3-27-97

MD. 337

MD 6 06 5

6 00

OLD BRANCH 5 93 AVE. 3675
CO.

UNDER CONST.

SAME

STAU MINIMAL MATERIAL-URBAN

2001 CO EX #1

SHA 51.3 - 8 Revised 4.83

MARYLAND STATE HIGHWAY ADMINISTRATION

ROAD INVENTORY SHEET

Party Chief GD
Recorder EF
Assistant
Map No./Dir. 6 11 D / W
State Coordinates 830 - 356

Road No. CO 127
Road Name AUTH RD
County PG
Date 2-14-02
Sheet No. 1 OF 4

TRAFFIC CODES
TRAFFIC CONTROLS: STOP SIGN-SS, TRAFFIC LIGHT-T.L., FLASHING RED BALL-F.R.

TRAFFIC CODES
PARKING RESTRICTIONS: A.M. PEAK, P.M. PEAK, A.M./P.M. PEAK, NO PARKING ANYTIME-N.P., COMM/IND. ACCESS=I

SYSTEM: FUNCT CLASS	SYSTEM: HWY. SYS	SYSTEM: HPMS SAMPLE	TRAFFIC: PREG. REST.	TRAFFIC: COMM/IND ACCESS	LINE DIAGRAM	TRAFFIC: CONTROL	TRAFFIC: COMM/IND ACCESS	TRAFFIC: PREG. REST.	PAVEMENT DATA
					MAGRUDER AVE				
					CO 1110 0.33				
					CT B				
					0.31 CO 2200				
									38'I
									JC-C
									2ML
					CT C				
					0.26 CO 2201			X	
					MORRIS AVE				28'I
					CO 0.20 1109				JCRb-RT
									6'FSHO-LT
									2ML
					0.18			X	
									24'I
									2-8'E SHOS
									2ML
					0.09			X	
					BROWN AVE				
					CO 1108 0.01				
									38'I
									JC-C
					337				2ML
X					0.00			X	
					MD				
	Urban Collector								

COUNTY PG ROAD NO. CO 127 PAGE 2 OF 4

SYSTEM: FUNCT CLASS; HWY SYS; NHS; SAMPLE

TRAFFIC: PREG REST; COM/IND ACCESS

LINE DIAGRAM

TRAFFIC: CONFIG; COM/IND ACCESS; PREG REST

PAVEMENT DATA

Urban Collector

DUBLIN DR

0.81 CO 1905

CLACTON AVE

ENT to Apts 0.76 — 24'I / 2-6'ISHDS / 2ML

BRAYMER AVE

0.41 CO 1906 30 — X

BARTO AVE

0.65 CO 2146 — 24'I / 2-10'ISHDS / 2ML

#16163

0.59 — X

I

0.56

95

0.53

MEDFORD AVE

CO 1111 0.49

CARSWELL TERR

0.47 CO 2198 — 38'I / J Crb-RT / 6'ISHD-LT / 2ML

CARSWELL AVE

0.41 CO 2197 — X

CT A

0.36 CO 2199 — 38'I / Jc-c / 2ML

* 1.63 - 1.79 reconstructed by SHA Contract PG2175170, Assigned MD 535-A on 4/3/2002.

SHA 51.3 - 8 Revised 4.83

MARYLAND STATE HIGHWAY ADMINISTRATION

ROAD INVENTORY SHEET

Party Chief GD
Recorder EF
Assistant
Map No./Dir. /
State Coordinates

Road No. CO 127 / MD 535-A
Road Name AUTH RD
County PG
Date 2-14-02
Sheet No. 3 OF 4

TRAFFIC CODES
TRAFFIC CONTROLS: STOP SIGN-SS, TRAFFIC LIGHT=T.L., FLASHING RED BALL-F.R.

TRAFFIC CODES
PARKING RESTRICTIONS: A.M. PEAK, P.M. PEAK, A.M./P.M. PEAK, NO PARKING ANYTIME-N.P., CONN/IND. ACCESS=F

SYSTEM				TRAFFIC		LINE DIAGRAM	TRAFFIC			PAVEMENT DATA
	FUNCT CLASS	HWY SYS	HPMS SAMPLE	PEAK REST.	CONN/IND ACCESS		CONTROL	CONN/IND ACCESS	PEAK REST.	
										See Next Page
						129				
						OLD Section of CO 127 ATL				22'I RT
						OLD SOPER RD 18				13'I LT
						127				12'GRS MED
						OLD SOPER RD OP				JC-C IN&OUT
						CAPITAL GATEWAY DR				2ML
						126 CO 5611 905				
						OLD Section of CO 127				
						125				36'I
										JC-C
										2ML
						122				
										31'I
										JCRB-RT
										6'ISHD-LT
										2ML
						HENDERSON WAY				
						CO 2063 112				
						GLORIA DR				
						CO 3980				
						PROCOPIO DR				
						106 CO 4593				
						LEAH CT				
						099 CO 5111				24'I
										2-10'ISHDS
										2ML
						OAKLAND WAY				
						CO 4123 094				
										24'I
										2-6'ISHDS
										2ML
	Urban Collector									

COUNTY PG ROAD NO. CO 127 PAGE 4 OF 4

LINE DIAGRAM

SYSTEM: FUNCT CLASS — Urban Collector; HWY SYS; HPMS SAMPLE

TRAFFIC: PKG REST; COM/IND ACCESS

TRAFFIC: CH/IBGA; COM/IND ACCESS; PKG. REST.

PAVEMENT DATA

#1 RAMP SB

95

94

90

MD 199 5 TL

TL

HL 1 76

12'

171

2-24'I
16'JMeD
JC-C
4ML

169

L 168 L

LT LT

R R

MD 535-A

H 165 H

12' 10'

E

58'I
JC-C
4ML

AUTH PL

Bump #2 163 CO 3585 TL

162

Mercedes BLVD

CO 4451 155

44'I
JC-C
2ML

150

34'I
JCRh-RT
4'ISHD-LT
2ML

142

28'I
2-6'ISHOS
2ML

SHA 51.3-8
11-15-72

STATE HIGHWAY ADMINISTRATION OF MARYLAND

ROAD INVENTORY SHEET

Party Chief E.S.
Recorder H.G.
Helper

Map No. M35

Road No. CO. 128
Road Name KENTUCKY AVE.
Sheet No. 1 OF 1
Date 11-29-67 VER. 9-27-77
County P.G.
State Coordinates 827-370

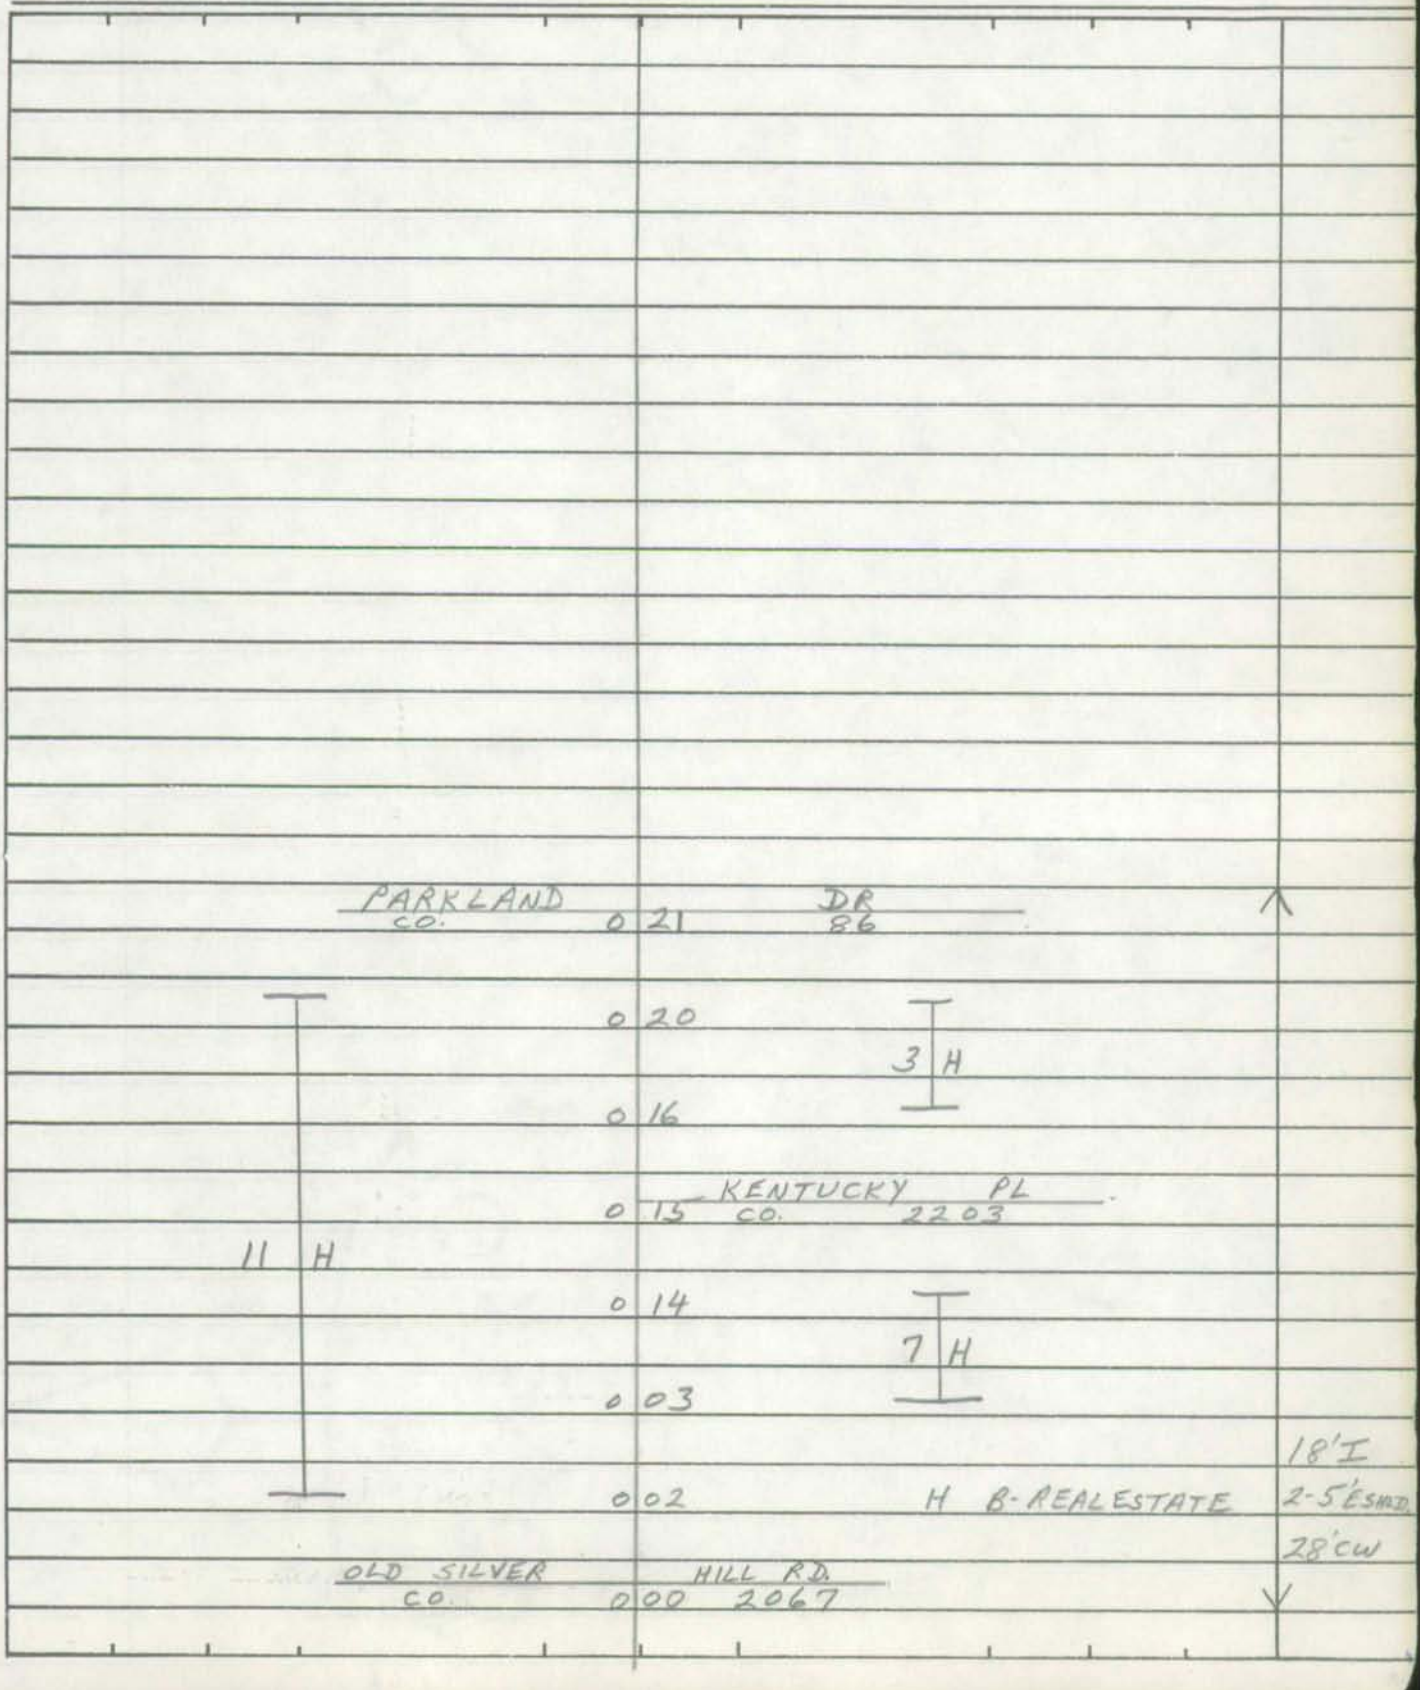

SHA 51.3-8
11-15-72

ROAD INVENTORY SHEET

Road No. _____
Road Name _____
Sheet No. _____
Date _____
County _____
State Coordinates _____

Form 6 HPS (Rev. 1961)

FAU

95-27 PAB/AH 3/20/96

5-008-B

ROAD INVENTORY SHEET

Party Chief E.S.
Recorder W.D.
Chainman T.L.

MAP 7

N. WESTPHALIA
842-363 M35

VER 9-1-77

Road No. CO 129
Name ARMSTRONG LA
Sheet No. 1 OF 1
Date 9-30-68
County PRINCE GEO

	ROAD 059	END	
	057	H	9'E 9'CW
	048		X
	046	H	
	041	H	
H	037		
	035	PACKING H.	16'E 16'CW
CO ~~OP~~ ~~75~~ 5176 RYON RD	034		X
	030	36"CMP	16'I
H	027		X 18'CW
H	019		
		10 H	
H	017		
	005	X CO ~~5160~~ 5684	
10'E AUTO & TRAIN SERVICE 500'	001		20'I I C-C 16'H
CO SERVICE	000	2064 RD	X X X 55

PRESIDENTIAL PKWY

OP 5161

FEDERAL HWY SPUR

SHA 51.3-8
11-15-72

STATE HIGHWAY ADMINISTRATION OF MARYLAND

FAU & R

97-227, 228, 229 27
3/23/98
BB/HH

18

87-176, 177
WB/CC
2-4-88

ROAD INVENTORY SHEET

Party Chief E.S.
Recorder W.D
Helper (M.Z. OFFICE)

Map No. 39

VER 7-1-77

Road No. Co. 130
Road Name SUBRATTS RD.
Sheet No. 1 OF 6
Date 7-26-68
County PR. GEO.
State Coordinates 820-336

91-214
2-18-92
DT/DS

		174 / 201	PT 90° PC	
		169 / 196		
PT 120° PC		150 / 177		24'I 30'CW
		140 / 167		
		133 / 160		
		139 / 127	30°	X
30°		088 / 115		
	NON FA LOCAL - URBAN	086 / 113	400' COTTAGE MASTER'S HOUSE	18'G 2-3'E SHLD
		085 / 112	REAR ENT TO COTTAGES SR44X - 141 ©.90	X
		069 / 096	300' DORMATORY	
W	SEWAGE SYSTEM	064 / 091		
		057 / 084	DR.	
		033 / 080	600' WATER TOWER	
		025 / 052	ENT. TO BOYS VILLAGE SR44X - 142	
	FRANK TIPPETT Co	099 / 126	SR[illegible] FRANK TIPPETT RD CO 132	16'G 90° R-3'E SHLD
		011		24'I 2-10'E SHLD 50'CW
	U.S.	000	301	

SHA 51.3-8
11-15-72

ROAD INVENTORY SHEET

Road No. Co. 130
Road Name SURRATTS RD
Sheet No. 2 OF 6
Date 7-26-68
County PR. GEO.
State Coordinates

PT 80° PC	265 / 292		
	282 / 301		
	280 / 297	HOLLY DR. CO. 94 5192 LA 506	90°
	257 / 284		
	248 / 275	18" CMP	
PT 90° PC	240 / 267		
NON FA LOCAL - URBAN	237 / 264		
H	231 / 258		
	X X O.R. 596 X X X		90°
40°	220 / 247		20' I
	212 / 239		35° 20' CW B'G 2mL
	201 / 228		PT 35° PC X
	192 / 219		
	185 / 212		
PT 75° PC	P 0586 PISCATAWAY 189 / 216	(OR. SEE BR SH. 1A) UNDER CONST.	
	207 / 180		same

SHA 51.3-8
11-15-72

STATE HIGHWAY ADMINISTRATION OF MARYLAND

18

ROAD INVENTORY SHEET

Party Chief E. S.
Recorder W. D.
Helper

Map No.

Road No. Co. 130
Road Name SURRATTS RD.
Sheet No. 3 OF 6
Date 7-26-68
County PR. GEO.
State Coordinates

		307 / 334	
	7 H	299 / 326	H
		292 / 317	
	MOORES LA Co. 1353	291 / 316	
	H	290 / 317	
	H	288 / 315	
NON FA LOCAL-URBAN	H	286 / 313	
	H	284 / 311	H
	H	281 / 308	
	H	280 / 307	
	PROP. RD.	278 / 305	H
		276 / 303	POPLAR HILL DR. ~~CP 299 94~~ CO 5193
	H	274 / 301	
		271 / 298	H
	H	269 / 296	H
		267 / 294	H

20'I 2ml same

SHA 51.3-8
11-15-72

ROAD INVENTORY SHEET

Road No. Co. 130
Road Name SURRATTS RD
Sheet No. 4 OF 6
Date 7-26-75
County PR. GEO.
State Coordinates

FAU 5232 COLLECTOR - URBAN

SUMMIT CREST DR — STUART LA

Co 5880 — 379 — Co 5878

~~5213~~ C&G7 — Co 97-227, 2@.80

48'I

Jc-c

~~4ML~~

~~2-8'E SHLD~~

3 68 / 3 95 — H

3 66 / 3 93 #PO588D — ~~20'I~~

MD — 3 ~~94~~ 57 — 5

3 ~~93~~ 56

3 ~~92~~ 55

~~2-3'E SHLD~~

~~48'I~~

~~4 J C-C~~ ~~2 ML~~

3 ~~49~~ 48 — FOX RUN DR. — OF Co 4869 @1.06 — ~~4605~~

~~4 ML~~

~~1PT~~ E

~~1PT~~ 90°

PC E-SmHc

3 46 / 3 41 — ~~80~~ ~~7823~~

X

~~39'I~~

~~2-8'E SHLD~~

~~1 J" C-LT~~ 2 ML

3 39 / 3 66 — H

X

87-176.177

3 36 / 3 63 — H — 90°

H

3 29 / 3 ~~58~~ — E

3 27 / 3 54 — DANGERFIELD RD Co. 557

X X

H

3 24 / 3 51 — H

NON FA LOCAL-URBAN

3 22 / 3 ~~49~~ — H

3 18 / 3 45 — PT 35° PC

3 15 / 3 ~~42~~

20'I

2 ML

3 11 / 3 ~~37~~ — H

~~same~~

SHA 51.3-8
11-15-72

STATE HIGHWAY ADMINISTRATION OF MARYLAND

96-151A
BB/MG
3-21-97

78

ROAD INVENTORY SHEET

Party Chief E.S
Recorder W.D
Helper

Map No.

Road No. Co. 130
Road Name SURRATTS RD
Sheet No. 5 of 6
Date 7-26-68
County ~~PR~~ GEO
State Coordinates

97 MENT MAP

SURRATTS J.H.S

O.P. 12

SUMMIT CREEK DR

~~5213~~ 5880

HALE DR.
Co. 2533

BEVERLY AVE.
Co. 2537

FAU 5232
COLLECTOR-URBAN

30°

35°

20'I
2-3'ESHD
2MI

Same

97 MENT MAP

SHA 51.3-8
11-15-72

ROAD INVENTORY SHEET

Road No. Co. 130
Road Name SURRATTS RD.
Sheet No. 6 OF 6
Date 7-26-68
County PR. GEO.
State Coordinates

IMPROVEM 19

BRANDYWINE Co.	4.52 4.79	RD 599 TL
	4.45 4.72	H same

FAU 4232 COLLECTOR URBAN

IMPROVEM 19

Form 5-HPS
(Revised 1961)

MARYLAND STATE ROADS COMMISSION
PLANNING AND PROGRAMMING DIVISION

526130

IN COOPERATION WITH
U.S. BUREAU OF PUBLIC ROADS

BRIDGE SHEET

ROAD NO. CO. 130

SHEET NO. 1A

PARTY NO. 7-26-68

DATE 7-26-68

COUNTY P.G.

RATED CAPACITY _____

FOR ALL STRUCTURES HAVING A TOTAL OPENING OF MORE THAN 20 FEET AS DEFINED IN NOTE 1.

ODOMETER READING 2.10 NAME OF STREAM, RAILROAD OR HIGHWAY CROSSED PISCATAWAY CREEK

NUMBER OF RAILROAD TRACKS _____
KIND OF CROSSING (NOTE 2) _____

UNDERPASS-SIMPLE UNDERPASS-COMBINED (NOTE 3) OVERPASS BRIDGE OVER SYSTEM

DESCRIPTION

NUMBER OF SPANS	LENGTH EACH SPAN (NOTE 4)	TYPE (NOTE 5)
1	40'	I BEAM

TOTAL LENGTH-ON LINE OF ROAD OVER-ALL (NOTE 6) 40'

MATERIAL
SUBSTRUCTURE I BEAM SUPERSTRUCTURE _____
FLOOR CORRAGATED BEAM WITH BIT. MIX

CLEARANCES
ROADWAY (NOTE 7) 16' SIDEWALK WIDTHS: RIGHT NONE LEFT
SURFACE OF ROAD TO STREAM BED 8' FOR OVERPASSES, SHOW DISTANCES TO TOP OF RAIL OR SURFACE OF LOWER ROAD. (NOTE 8)
SURFACE OF ROAD TO BOTTOM PORTAL _____ (MINIMUM OVERHEAD CLEARANCE
CLEAR DISTANCE OF OPENING ABOVE STREAM BED 4' (WATERWAYS ONLY)
POSTED LOAD LIMITS 10,000LB. BRIDGE NO. _____ CONSTRUCTION DATE _____

GENERAL CONDITION OF BRIDGE: CHECK IF GOOD, FAIR, OR POOR, DESCRIBE DEFECTS IF SERIOUS.

	GOOD	FAIR	POOR
SUPERSTRUCTURE	✓		
FLOOR	✓		
SUBSTRUCTURE	✓		
PAINT	✓		BADLY CORRODED OR RUSTED

TYPE OF PROTECTION FOR DRAWBRIDGES (NOTE9) _____

(NOTES ON REVERSE SIDE)

S26130

Notes:

1. In agreement with Federal-aid standards, a bridge is defined as a structure including supports erected over a depression or an obstruction, as water, highway, or railway, and having a track or passageway for carrying traffic or other moving loads, and having a length measured along the center of roadway of more than 20 feet between undercoping of abutments or spring lines of arches, or extreme ends of openings for multiple boxes and pipes, where the clear distance between openings is less than half of the smaller contiguous opening.

2. Show kind of crossing by checking descriptive item applicable. For multiple-span bridges give complete information on each span including approach spans. Indicate on leg sheet the odometer reading, position, and angle of skew of structure with respect to center line of road and by arrow the direction of stream flow.

3. Give information on the span over the highway only.

4. For span length use center to center of bearings, otherwise the clear opening. Skew bridges will be measured along center line of road. See Note 1.

5. Show general type such as: Trestle, Truss, Girder, I-Beam, Rigid Frame, Arch, Slab, Suspension, or Covered Bridge. See illustrations attached. Describe draw spans by classifications listed in Article X, Section 2 of Manual.

6. The length of a bridge structure is the over-all length measured along the line of survey stationing back to back of back-walls of abutments, if present, otherwise end to end of bridge floor, but in no case less than the total clear opening of the structure.

7. Give minimum lateral clearance. Where traffic lanes are separated by bridge numbers, show clearance width of each lane separately. Special conditions should be explained by notes.

8. In case of overhead bracing or arch construction, measurement shall be made to the lowest point above the road surface.

9. Use classification listed on RR crossing sheets. Form 4 HPS.

Remarks: _____

A rearrangement of the form similar to that shown on the attachment may be used to provide space for coding.

Washington Urban
DT/TT
3-2-95
94-130

SHA 51.3 - 8 Revised
4.83

MARYLAND STATE HIGHWAY ADMINISTRATION

ROAD INVENTORY SHEET

88-31

Party Chief RB
Recorder DW
Assistant
Map No./Dir. G12 / SE
State Coordinates 845-346

Road No. CO 131
Road Name Rosaryville Rd
County P.G.
Date 3-8-89
Sheet No. 1 OF 4

92-134

TRAFFIC CODES
TRAFFIC CONTROLS: STOP SIGN=SS, TRAFFIC LIGHT=T.L., FLASHING RED BALL=F.R.

TRAFFIC CODES
PARKING RESTRICTIONS: A.M. PEAK, P.M. PEAK, A.M./P.M. PEAK, NO PARKING ANYTIME=N.P., COMM/IND. ACCESS=E

SYSTEM				TRAFFIC		LINE DIAGRAM	TRAFFIC			PAVEMENT DATA
FED. AID.	FUNCT CLASS.	HWY. SYS.	HPMS SAMPLE	PRKG. REST.	COM/IND. ACCESS		CONTROL	COM/IND. ACCESS	PRKG. REST.	
										48'I J-CC
										2 mL
						0 73			X	
						PT 0 68				
						35°				24'I
										2-10' FSHD
										2 mL
						PC 0 62			X	
						0 55		E		44'I
										J-CC 2 mL
						152			X	
						Gambler Dr				
						CO 3299 0 48				
										34'I 10'F
										Short J-c Lt
						0 38			X	2 mL
										24'I 2-10' FSHD 2 mL
						012			X	
						HAISLIP WAY				
						CO 100-10 6089 009				
						004				24'I 2-10'
						000 223	TL			SHD 2 mL
						MD				

LINE DIAGRAM

SYSTEM: FED. AID.	SYSTEM: FUNCT. CLASS.	SYSTEM: HWY. SYS.	SYSTEM: HPMS SAMPLE	TRAFFIC: PRK.G. REST.	TRAFFIC: COM/IND ACCESS	TRAFFIC: CONTROL	TRAFFIC: COM/IND ACCESS	TRAFFIC: PRK.G. REST.	PAVEMENT DATA
									24'I 10'F Shd Rt 2mL 2'I 6'HD Lt
									Brookwood Ave
								X	182 CO 2902
									Mt Airy
									179
									Lake 176 CBC L 5' x W 32' x D 6'
									24'I 30' CW 2mL
								X	160
									24'I 2-10' EShD 2mL
									Frank Tipper ++ Rd
						TL		X	116 CO 132
									150' 24'W
									106
									Churchill Dr
									102 CO 3591
									34'I J-C Rt 2mL 10'F Shd Lt
								X	091
									Williamsburg Rd Dr
									081 CO 3140

FAS 1384 CO 1758 - SK Urban Minor Arterial

SHA 51.3 - 8 Revised
4.83

MARYLAND STATE HIGHWAY ADMINISTRATION

ROAD INVENTORY SHEET

88-31

Party Chief BB
Recorder DW
Assistant
Map No./Dir. /
State Coordinates

Road No. CO 131
Road Name Rosaryville Rd
County P.G.
Date 3-8-89
Sheet No. 3 OF 4

SYSTEM: FED. AID. | FUNCT. CLASS. | HWY. SYS. | HPMS SAMPLE
TRAFFIC: PRKG. REST. | COM/IND. ACCESS

FAS 1384 Major Collector Minor Arterial Urban

TRAFFIC CODES
TRAFFIC CONTROLS: STOP SIGN=SS, TRAFFIC LIGHT=T.L., FLASHING RED BALL=F.R.

TRAFFIC CODES
PARKING RESTRICTIONS: A.M. PEAK, P.M. PEAK, A.M./P.M. PEAK, NO PARKING ANYTIME=N.P., COMM/IND. ACCESS=E

LINE DIAGRAM

MT LAUREL CT
2 52 Co 5479
RHODENDA AVE
2 40 CO 5576
2 48 PT
60°
2 37 PC
2 30 Hollaway Estates Pk
Hollaway Dr
2 17 CO 3347
2 12
2 07
Tyrone Dr
2 05 CO 2903
2 02

TRAFFIC: CONTROL | COM/IND. ACCESS | PRKG. REST.

E

PAVEMENT DATA

~~20'I~~
~~30' I 2 mL~~
X
36'I
J-C Rt
2 mL
X
52'I
J-CC 2mL
X
36'I J-CRt
2mL
X

SYSTEM | TRAFFIC | LINE DIAGRAM | TRAFFIC | PAVEMENT DATA

SYSTEM: FED. AID. | FUNCT. CLASS. | HWY. SYS. | HPMS SAMPLE
TRAFFIC: PRKG. REST. | COM/IND ACCESS
TRAFFIC: CONTROL | COM/IND ACCESS | PRKG. REST.

F AS J3-84(
Urban Minor Arterial

(Old Indian Head Hwy)
Indian Head Rd
MD 210
CO 135

NBL
MD 281 301
SBL @ 8.13

MD 210
MD 976A
277
276

Sudan Pl
261 CO 5369

257

PAVEMENT DATA:
20'I ~~10'F~~
~~SHD RT~~ 2ML
2-6'E SHD
36'I J-CRT
2ML

SHA 51.3 - 8 Revised
4.83

MARYLAND STATE HIGHWAY ADMINISTRATION

Washington Urban CO(01-59) 2-5-02 GD/EF (92-150) 96-166 CO A/T (01-59)

ROAD INVENTORY SHEET

Party Chief G.D.
Recorder A.H.
Assistant (OFFICE REWRITE - GD.)
Map No./Dir. H12 / N
State Coordinates 850-329

Road No. CO 132
Road Name FRANK TIPPETT RD
County PRINCE GEORGES
Date 3/30/93
Sheet No. 1 OF 4

TRAFFIC CODES
TRAFFIC CONTROLS: STOP SIGN=SS, TRAFFIC LIGHT=T.L., FLASHING RED BALL=F.R.

TRAFFIC CODES
PARKING RESTRICTIONS: A.M. PEAK, P.M. PEAK, A.M./P.M. PEAK, NO PARKING ANYTIME=N.P., COMM/IND. ACCESS=E

SYSTEM				TRAFFIC		LINE DIAGRAM	TRAFFIC			PAVEMENT DATA
FED. AID.	FUNCT CLASS.	HWY. SYS.	HPMS SAMPLE	PRKG. REST.	COM/IND. ACCESS		CONTROL	COM/IND. ACCESS	PRKG. REST.	
						TERRACO DR				
						11' D PVT DRIVE				
						0 65 CO 5373				40'I
						12' I, 5' GRASS SHLD				10'F SHLD-LT
										JCRb-RT
						0 59				2ML
						0 58				X
						30° 0 36				
						ENT TO BOWIE VILLAGE SR 141 OF MD				
						0 28				
						SURRATTS RD CO 130 0 27				24'I
										2-10'F SHDS
										2 ML
						0 11				X
										36'I
										10'I SHD RT
										3 ML
						← SB				
						US 0 00 301 NB →				

LINE DIAGRAM

SYSTEM: FED. AID. | FUNCT. CLASS. | HWY. SYS. | HPMS SAMPLE

TRAFFIC: PRKG. REST. | COM/IND ACCESS

TRAFFIC: CONTROL | COM/IND ACCESS | PRKG. REST.

PAVEMENT DATA

ANGORA DR.
CO 3525 1 32

PT 1 29
35°
PC 1 26

40' I
J CRB LT
2 ML

FARRAR AVE
CO 3528 1 20 X

24' I
2-10' F SHD
0 99 X 2 ML

Marlboro Woods Dr
0 95 Co 5753

40' J
~~24' I~~
~~10' F SHD RT~~
~~J CRB LT~~

0 90 X 2 ML
40' I

ANGORA DR
CO (01-60) X61490 88

10' F SHD RT
J CRB LT
2 ML

COMMO RD
CO 4080 0 78 X

~~40'~~

TERRACO PL
0 75 ~~OR 4T HYD~~
CO 5686

~~24' I~~ LT
~~10' F SHD~~
2 ML
J CRB RT

JCRB RT ON OLD 12.5

SHA 51.3 - 8 Revised
4.83

MARYLAND STATE HIGHWAY ADMINISTRATION

96-162, 163
BDING
3-20-97

(92-150)

97-223
3-24-98
BB/AP.

ROAD INVENTORY SHEET

Party Chief GD
Recorder AH
Assistant (OFFICE REWRITE - GD
Map No./Dir. G12 / N
State Coordinates

Road No. CO 132
Road Name FRANK TIPPETT RD
County PRINCE GEORGES
Date 3/30/93
Sheet No. 3 OF 4

TRAFFIC CODES
TRAFFIC CONTROLS: STOP SIGN=SS, TRAFFIC LIGHT=T.L., FLASHING RED BALL=F.R.

TRAFFIC CODES
PARKING RESTRICTIONS: A.M. PEAK, P.M. PEAK, A.M./P.M. PEAK, NO PARKING ANYTIME=N.P., COMM/IND. ACCESS=E

SYSTEM				TRAFFIC		LINE DIAGRAM	TRAFFIC			PAVEMENT DATA
FED. AID.	FUNCT CLASS.	HWY. SYS.	HPMS SAMPLE	PRKG. REST.	COM/IND. ACCESS		CONTROL	COM/IND. ACCESS	PRKG. REST.	
						1 85 PT				
						80°				
						(OLD FRANK TIPPETT RD)				
						~~BR CO 5877 4328~~ 1 82 PC				
						WYLD DR				
						WYLD CO 1 73 ~~CO~~ 4368				
										54'I
						GRAYSTONE DR				J C-C
						1 64				2 ML
						1 60				X
						RHODENDA AVE				
						1 44 CO 4606				
						1 43 CBC L 14' x W 16' x D 4				
										24'I
										2-10'F SHD
						1 40 PT				2 ML
						30°				
						1 34 PC				X
										40'I
										J CRB LT.
										2 ML

LINE DIAGRAM

SYSTEM: FED. AID. | FUNCT. CLASS. | HWY. SYS. | HPMS SAMPLE
TRAFFIC: PRK.G. REST. | COM/IND ACCESS
TRAFFIC: CONTROL | COM/IND ACCESS | PRK.G. REST.
PAVEMENT DATA

ROSARYVILLE RD
CO 2 80 131 TL

2 12 CBC L 9' x N 15' x D 4'

2 08

2 00

WYMAN WAY
PT 1 93 CO 2969
90°
PC 1 91

TYRONE DR
1 86 CO 2903

PAVEMENT DATA:
24'I
2-8'E SHD
2ML
X
40'I
J C-RT 8'E SHD LT
X 2ML
54'I
J C-C 2ML
~~38'I~~
~~J CRB RT~~
X
~~24'I~~
~~2-10'E SHD~~
~~2ML~~

SHA 51.3-8
11-15-72

STATE HIGHWAY ADMINISTRATION OF MARYLAND

FAR

Rural

M76
28

ROAD INVENTORY SHEET

Party Chief R. BUSH (OFFICE)
Recorder
Helper

Map No. M 40
INDEX 10

VER 6-22-77

Road No. Co 133
Road Name VAN BRADY Rd.
Sheet No. 1 of 2
Date 7-18-68 REVISED 5-7-74
County PR. GEO
State Coordinates 852- 331

	OP 273	234	
		233	60" R.C.P
30°		229	
		226	
65°		218	
	WINDSOR MANOR RD		
		212	50° 17'H 2-3'E Shld
	OP 4944		
		165 OP 272	X
		070	
		070	30°
30°		062	
		037 OP 267	
			20'H 2-3'E Shld
	VAN BRADY RD.		
		021 Co 1247	X
30°		003	17'H 2-3'E Shld
	INDIAN HEAD Rd.		
OLD CO		000	
		135	

E

SHA 51.3-8
11-15-72

ROAD INVENTORY SHEET

Road No. Co 133
Road Name
Sheet No. 2 OF 2
Date
County
State Coordinates

Molly ~~Berry~~ Berry Rd

Co 287 140

280 30°

268 30°

265

257 DR.

245 100°

242

90° 236

SAME

Form 6 HPS (Rev. 1961)

FAU

VLBA 5-046

1M 76 78

ROAD INVENTORY SHEET

Party Chief E. SCHUYLER
Recorder W. DOMAROSKI
Chainman

61-234

Gen Hwy

854-332
MAO

VER 6-22-77

Road No. CO E 134
Name CHELTANHAM RD
Sheet No. 1 OF 1
Date 7 — 18 — 68
County PRINCE GEORGES

CO OLD INDIAN	0	40	~~133~~ 135 HEADRD
H	0	37	
(DULEY SUBDIVISION RD)			
CO ~~OR~~ ~~258~~ 5142	0	14	
FARM	0	04	
FARM	0	02	
			16'I
CO			~~131~~ 3646 2-3'E SHO
DULEY STA	0	00	STA RD
	0		DULEY

SHA 51.3-8
11-15-72

Washington Urban

STATE HIGHWAY ADMINISTRATION OF MARYLAND

~~FAR~~

ROAD INVENTORY SHEET

Party Chief R. Bush
Recorder
Helper

Map No. M 40
INDEX 10
VER 6-22-77
81-249 JE CM

Road No. CO 135
Road Name OLD INDIAN HEAD Rd
Sheet No. 1 of 2
Date 7-18-68 REVISED 5-7-74
County PR. GEO
State Coordinates 85|- 330

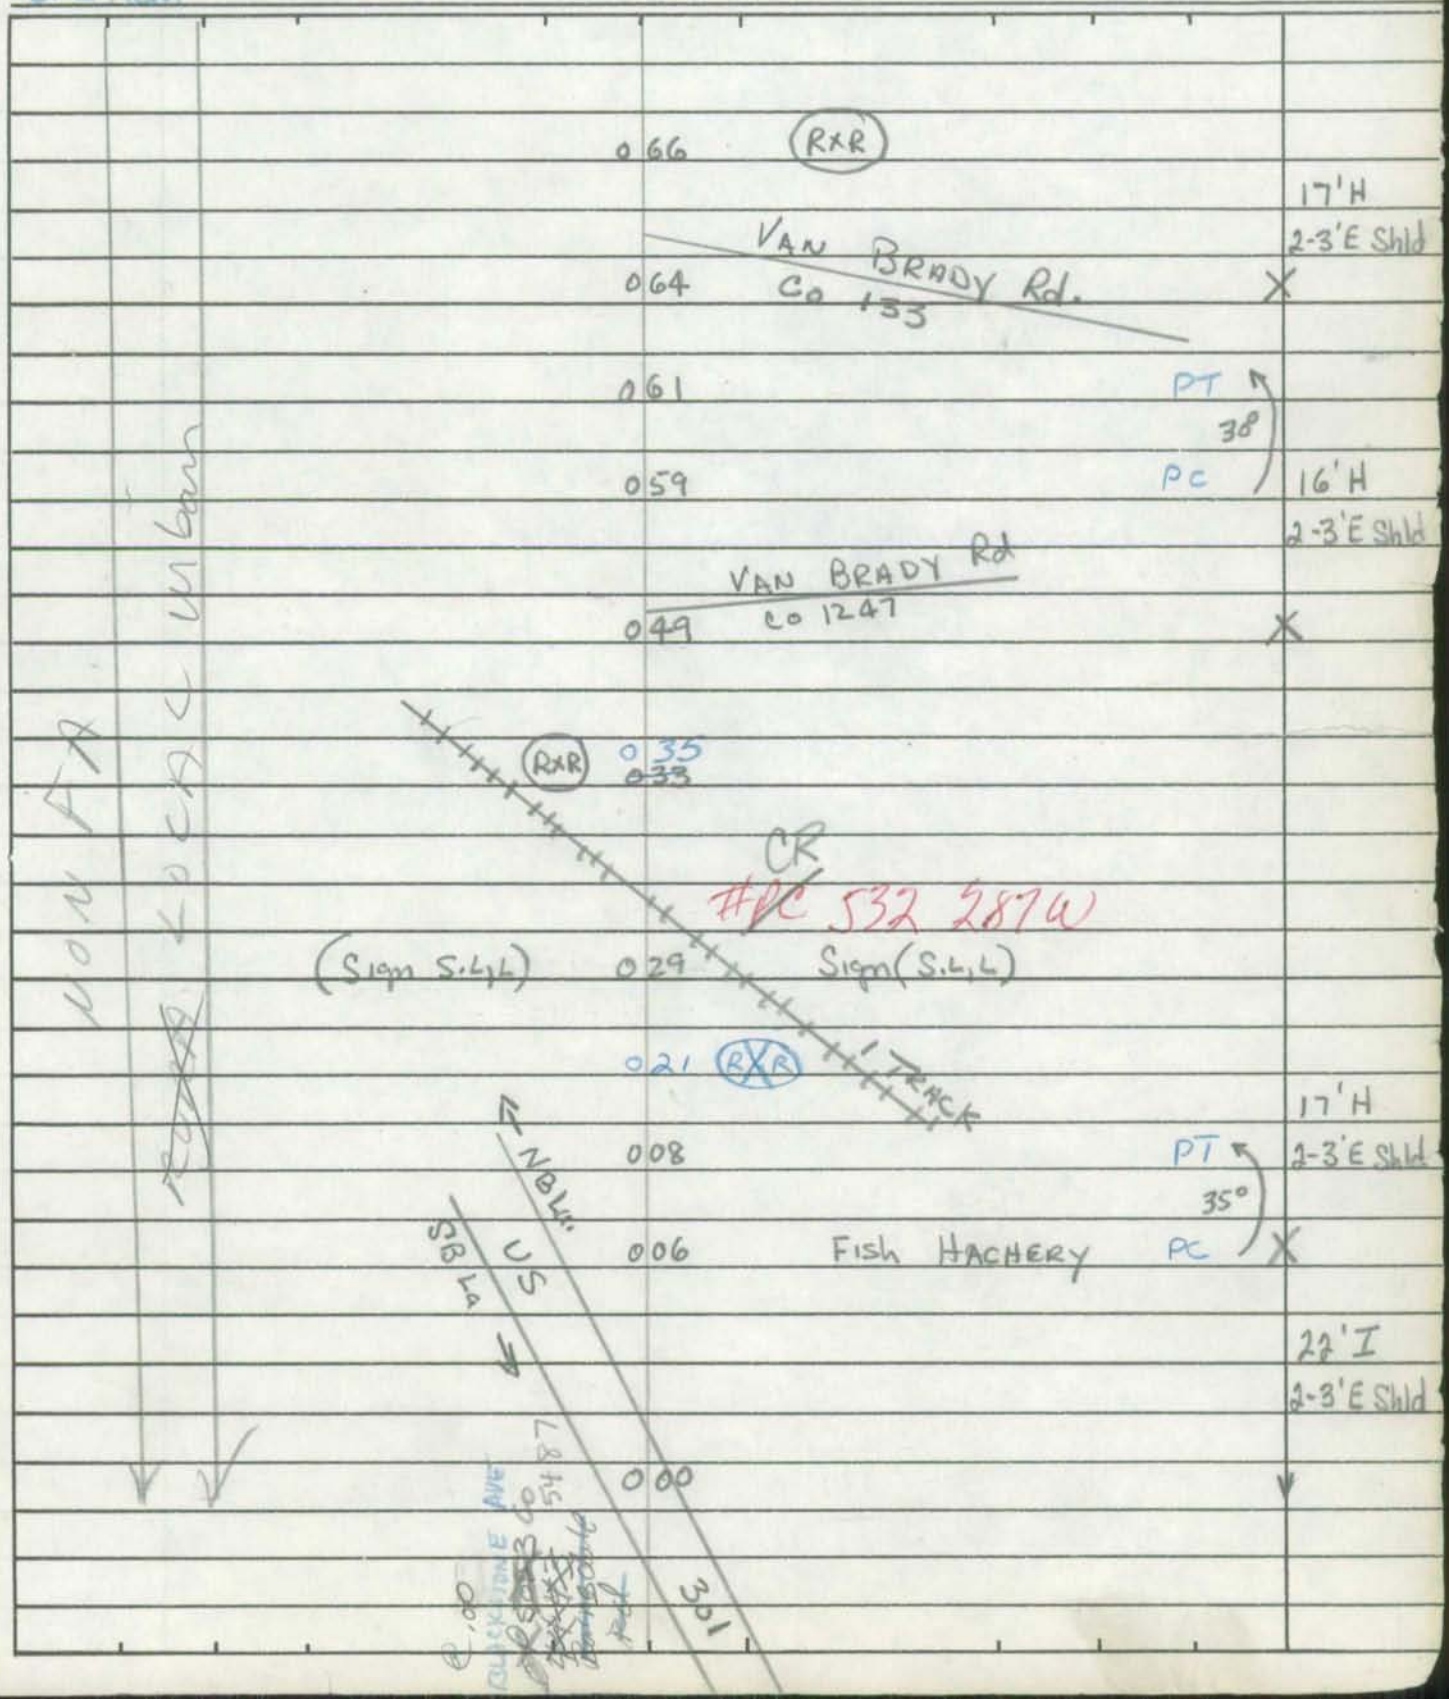

SHA 51.3-8
11-15-72

ROAD INVENTORY SHEET

Road No. Co 135
Road Name
Sheet No. 2 of 2
Date
County
State Coordinates

Rosaryville Rd (Co 131) (2.8)

	US 1	71	301
		69	90° →
45° →		49	
		46	
		42	APTS
		40	DR 30° →
	Duley Sta. Rd.		
		35	Co. 3646
90° →		24	
		11	
	CHURCH	094	H
	CHELTENHAM Rd.		
		086	Co 134 45° →
PT		077	
90° →	(R×R)	076	
PC		075	
	FARM 1000'	073	~~PVT ENT~~
			CR
	Sign (STOP-LOOK-LISTE)		P 532 286 P 1 TRACK
		071	
			Sign (STOP-LOOK-Listen)

25'I
2-6'ESHD
40'CW
22'I
2-3'ESHD
30'CW
21'H
30'C-W
24'H
30'C-W
21'H
30'CW
SAME

P & P 104

RAILROAD GRADE CROSSING SHEET

State Roads Commission of Maryland
Planning and Programming Division

1. GENERAL

Crossing No. 007

Mile Pole Number (R.R. Co.) ... 21

Coordinates ..... x 854 y 332

System Classification (Check One)

State Primary ..... ☐

State Secondary ..... ☐

State Road Only ..... ☐

County ..... ☑

Local ..... ☐
(Specify)

County and/or Municipality .. PRINCE GEORGES

U.S. Route Number .....

State Route Number .....

Road Number/Name ..... Co 135 OLD INDIANHEAD RD

Station .....

Surface Type ..... 16'F

Name of Railroad ..... PENN CENTRAL

Number of Main Tracks 1

Number of Other Tracks ..... NONE

2. TRAIN MOVEMENTS

Time Period	Pass	Freight	Train Speed at Grade Pass	Train Speed at Grade Freight	Spur	Remarks (Other than daily) Pass	Remarks (Other than daily) Freight
Day 6 A.M. to 6 P.M.							
Night 6 P.M. to 6 A.M.							
24 Hour Total							

3. TYPE OF PROTECTION

a. 4 Warning Signs - Reflectorized, (Non-reflectorized)

b. — Crossing Signs - Reflectorized, Non-reflectorized

c. — Road Marking

d. — Lights - Flashing, Stationary

e. — Traffic Control (Stop and Go) Signals

f. — Automatic Gate

g. — Watchman - Gate, Flag...hours

h. — Others

* By numerals 1 or 2 indicate whether installation is on one or both sides of track.

4. ALIGNMENT FACTOR

P. 260'

N. 260"

Average Daily Trains ...

Train Speed .....

Highway ADT.....

Highway Speed Limit ... 30 MPH

Average Vehicle Speed . 30 MPH

Max. Approach Grade .. N+0.1 P+0.1

Restricted Sight Distance . (On Highway) No

5. QUADRANT ... SIGHT DISTANCE

	@300'	@10'
A 110°	0	335"
B 70°	100"	1000"
C 90°	0	475'
D 110°	100'	1060'

6. ACCIDENT RECORD (Vehicles & Trains)

Year	No. of Accidents	No. of Fatalities
1961		
1962		
1963		
1964		
1965		
Total		

7. CROSSING RATING

A

B

C

D

Total

State Roads Commission of Maryland
Planning and Programming Division

Party _____
Date 10/27/69

DIAGRAM FOR RAILROAD GRADE CROSSING

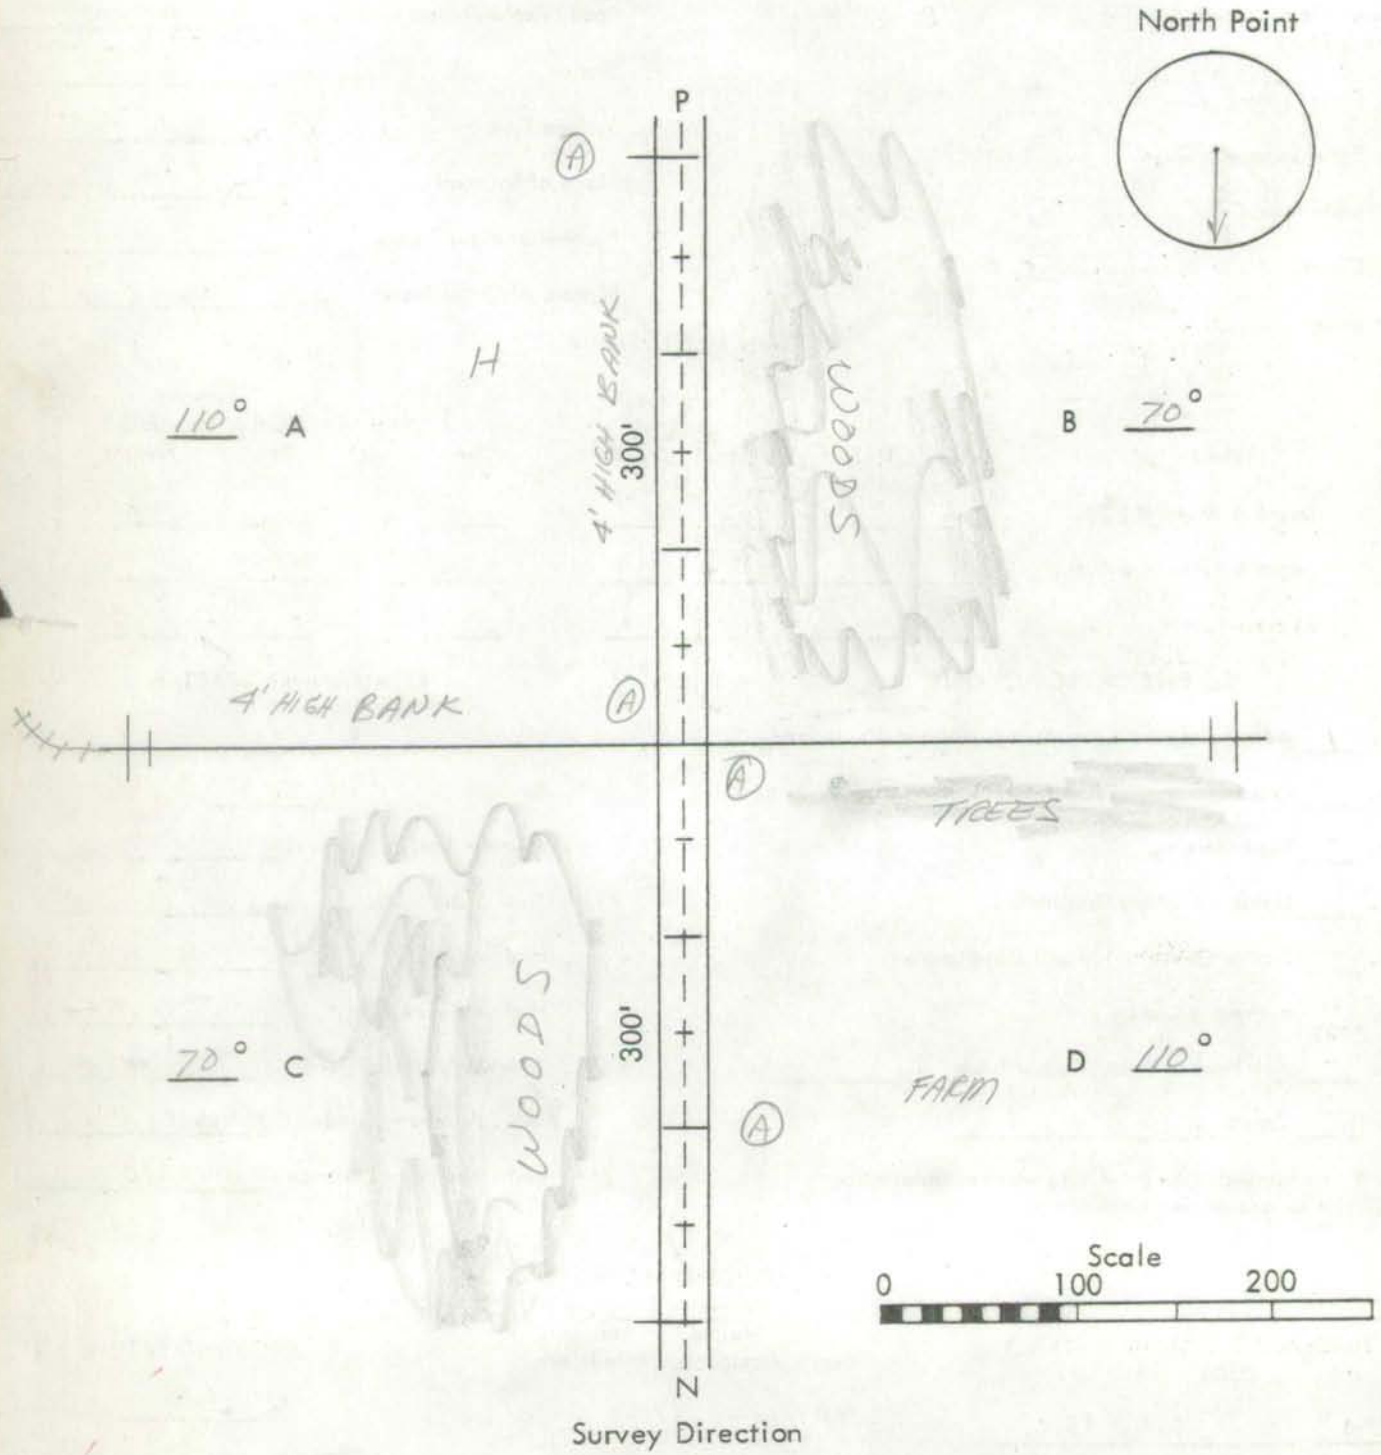

Survey Direction

Remarks: _____

CROSSING
007

COUNTY # 135
INDIAN HEAD RD.

TURN PICTURES OVER

1

2

3

4

PRINCE GEORGES Co 10/27/69

PICTURE TAKEN FACING SOUTH
ON Co 133 OLD INDIANHEAD RD.

J932332

1

PRINCE GEORGES Co 10/27/69

PICTURE TAKEN FACING NORTH
ON Co 133 OLD INDIANHEAD RD

J932332

2

PRINCE GEORGES Co 10/27/69

PICTURE TAKEN FACING WEST
ON Co 133 OLD INDIANHEAD RD

J932332

3

PRINCE GEORGES Co 10/27/69

PICTURE TAKEN FACING EAST
ON Co 133 OLD INDIANHEAD RD

J932332

4

P & P 104

RAILROAD GRADE CROSSING SHEET

State Roads Commission of Maryland
Planning and Programming Division

1. GENERAL

Crossing No. 006

Mile Pole Number (R.R. Co.) ... NONE

Coordinates ..... x 853 y 330

System Classification (Check One)

- State Primary ..... ☐
- State Secondary ..... ☐
- State Road Only ..... ☐
- County ..... ☑
- Local ..... ☐ (Specify)

County and/or Municipality .. PRINCE GEORGES

U.S. Route Number .....

State Route Number .....

Road Number/Name ..... Co 15 OLD INDIANHEAD RD

Station .....

Surface Type ..... 16'F

Name of Railroad ..... PENN CENTRAL

Number of Main Tracks 1

Number of Other Tracks ..... NONE

2. TRAIN MOVEMENTS

Time Period	Pass	Freight	Train Speed at Grade Pass	Train Speed at Grade Freight	Spur	Remarks (Other than daily) Pass	Remarks (Other than daily) Freight
Day 6 A.M. to 6 P.M.							
Night 6 P.M. to 6 A.M.							
24 Hour Total							

3. TYPE OF PROTECTION

a. 4 Warning Signs - Reflectorized, (Non-reflectorized)

b. — Crossing Signs - Reflectorized, Non-reflectorized

c. — Road Marking

d. — Lights - Flashing, Stationary

e. — Traffic Control (Stop and Go) Signals

f. — Automatic Gate

g. — Watchman - Gate, Flag...hours

h. — Others

* By numerals 1 or 2 indicate whether installation is on one or both sides of track.

4. ALIGNMENT FACTOR

P. 780'

N. 676'

Average Daily Trains ...

Train Speed .....

Highway ADT.....

Highway Speed Limit ... 30 MPH

Average Vehicle Speed . 30 MPH

Max. Approach Grade .. N.-2.3 P.-1.4

Restricted Sight Distance . (On Highway) NO

5. QUADRANT ... SIGHT DISTANCE

		@300'	@10'
A	35°	0	1000'
B	145°	0	825'
C	145°	0	1000'
D	35°	0	625'

6. ACCIDENT RECORD (Vehicles & Trains)

Year	No. of Accidents	No. of Fatalities
1961		
1962		
1963		
1964		
1965		
Total		

7. CROSSING RATING

A

B

C

D

Total

State Roads Commission of Maryland
Planning and Programming Division

Party _____
Date 10/24/69

DIAGRAM FOR RAILROAD GRADE CROSSING

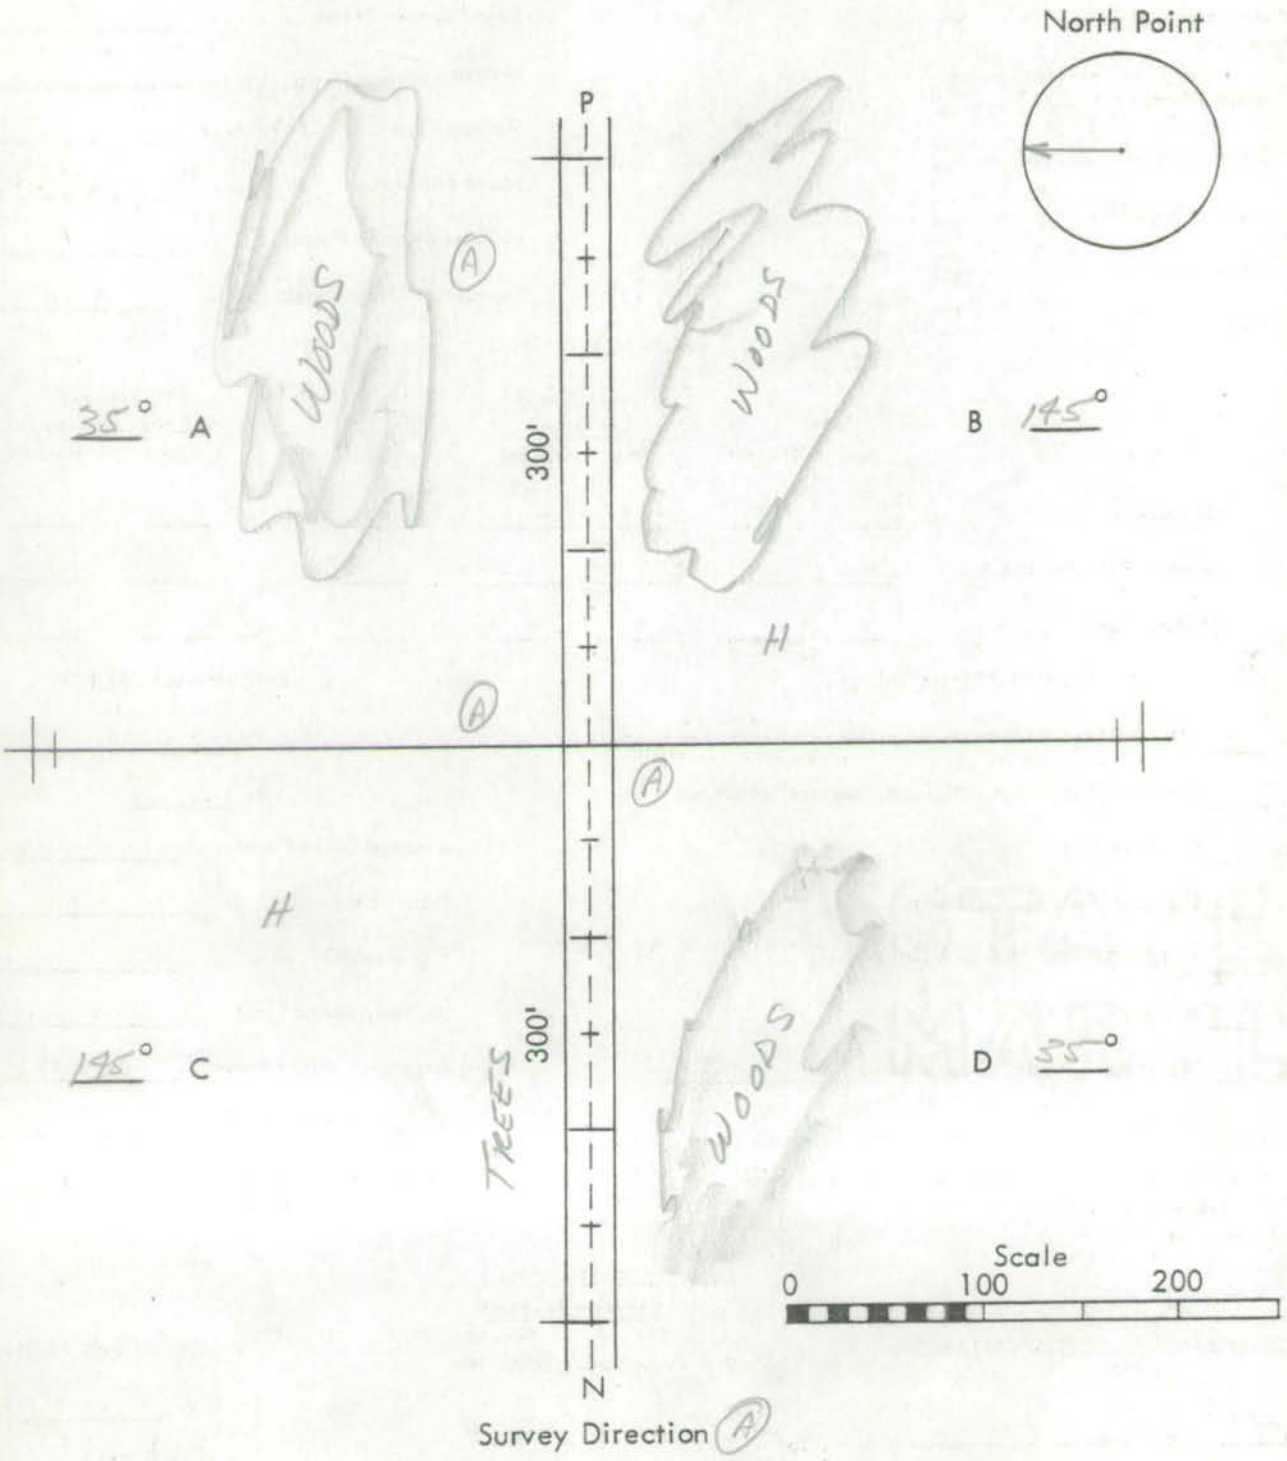

Remarks: _____

CROSSING
006

COUNTY # 135
OLD INDIAN HEAD RD.

TURN PICTURES OVER

1

2

3

4

PRINCE GEORGES Co 10/29/69

PICTURE TAKEN FACING SOUTH
ON Co 135 OLD INDIANHEAD RD

J932232

1

PRINCE GEORGES Co 10/29/69

PICTURE TAKEN FACING NORTH
ON Co 135 OLD INDIANHEAD RD

J932232

2

PRINCE GEORGES Co 10/29/69

PICTURE TAKEN FACING WEST
ON Co 135 OLD INDIANHEAD RD

J932432

3

PRINCE GEORGES Co 10/29/69

PICTURE TAKEN FACING EAST
ON Co 135 OLD INDIANHEAD RD

J932232

4

SHA 51.3-8
11-15-72

STATE HIGHWAY ADMINISTRATION OF MARYLAND

9896 MCAW
G.D. E.F. 2/12/99

ROAD INVENTORY SHEET

Party Chief F.S.
Recorder I.L
Helper

Map No. M 36

Road No. CO. 136
Road Name TRUMPS HILL RD.
Sheet No. 1 OF 3
Date 8-9-67 VER. 7-18-77
County P.G.
State Coordinates 860-346

	0 79		X
Kingfield ~~KING FIELD~~ CT. CO. 3148	0 75	H	
PT 30° PC	0 73		
	0 70	H	29'I C-LT.
	0 65		X
H	0 56		
	0 52	H	
	0 42	H	
	0 41	F	
	0 40	H	40°↑
	0 34		PT 30° PC
	0 32		
PT 30° PC	0 28		
	0 25		
	0 20	H	30°↑
		#P589	18'F
CHARLES	0 09	BRANCH SEE BR SH. 1A	2-2'E SHLD
			22'CW
CROOM MD.	0 00	RD. 382	

S ↑

SHA 51.3-8
11-15-72

96-31, 41ST
3-19-97
BB/MG

ROAD INVENTORY SHEET

Road No. CO. 136
Road Name TRUMPS HILL RD
Sheet No. 2 OF 3
Date 8-9-67
County P.G.
State Coordinates

PT 80° PC	1	50		
	1	47		
	1	33	F 30°↑	
	1	31	H	
H	1	18		16'F 18'CW
	1	16		X
	1	12	H	
F(ABAN)	1	08		
	0	99	H	26'I "J"C-LT. "I"C-RT
	0	97		X
MONMOUTH CO. 3146 DR.	0	95	H	
HEATHERMORE ~~BLVD.~~ BLVD. ~~CO.~~ CO	0	93	OP ~~3923~~ 3923	~~29'I~~ ~~C-LT.~~
	0	90		X
	0	86	H	
H	0	84	H	
N. MARLTON CO.	0	82	AVE. 3148	50'I ~~32'I~~
H	0	81	H J	C-C 3M

SHA 51.3-8
11-15-72

STATE HIGHWAY ADMINISTRATION OF MARYLAND

ROAD INVENTORY SHEET

Party Chief FS
Recorder TL
Helper

Map No.

Road No. CO. 136
Road Name TRUMPS HILL RD.
Sheet No. 3 OF 3
Date 8-9-67
County P.G.
State Coordinates

US	2	05	301	↑25'I 2-6'E SHLD
↑20° GOLF COURSE	2	02		X 50'CW
FAIRGREEN CO. LA. 3415	1	93		30'I C-L T. 36'CW
	1	91		X
H	1	54		SAME

SHA 51.3-8
11-15-72

ROAD INVENTORY SHEET

Road No. _____
Road Name _____
Sheet No. _____
Date _____
County _____
State Coordinates _____

Form 5-HPS
(Revised 1956)

MARYLAND STATE ROADS COMMISSION
TRAFFIC DIVISION

S26130

IN COOPERATION WITH
U. S. BUREAU OF PUBLIC ROADS

ROAD NO. Co 136

BRIDGE SHEET

SHEET NO. 1-A

PARTY NO.

DATE 8-8-67

COUNTY PRINCE GEORGES

RATED CAPACITY

FOR ALL STRUCTURES HAVING A TOTAL OPENING OF MORE THAN 20 FEET AS DEFINED IN NOTE 1.

ODOMETER READING 0.09 NAME OF STREAM, RAILROAD OR HIGHWAY CROSSED CHARLES BRANCH

NUMBER OF RAILROAD TRACKS

KIND OF CROSSING (NOTE 2)

UNDERPASS - SIMPLE UNDERPASS - COMBINED (NOTE 3) OVERPASS BRIDGE OVER SYSTEM

DESCRIPTION

NUMBER OF SPANS	LENGTH EACH SPAN (NOTE 4)	TYPE (NOTE 5)
2	17'	WOOD-PILE
2	14'	" "

TOTAL LENGTH - ON LINE OF ROAD OVER-ALL (NOTE 6) 62'

MATERIAL

SUBSTRUCTURE WOOD SUPERSTRUCTURE WOOD

FLOOR WOOD

CLEARANCES

ROADWAY (NOTE 7) 12' SIDEWALK WIDTHS: RIGHT LEFT

SURFACE OF ROAD TO STREAM BED 7' FOR OVERPASSES, SHOW DISTANCES TO TOP OF RAIL OR SURFACE OF LOWER ROAD. (NOTE 8)

SURFACE OF ROAD TO BOTTOM PORTAL 2' (MINIMUM OVERHEAD CLEARANCE

CLEAR DISTANCE OF OPENING ABOVE STREAM BED 5' (WATERWAYS ONLY)

POSTED LOAD LIMITS BRIDGE NO. CONSTRUCTION DATE

GENERAL CONDITION OF BRIDGE: CHECK IF GOOD, FAIR, OR POOR, DESCRIBE DEFECTS IF SERIOUS.

	GOOD	FAIR	POOR
SUPSTRUCTURE			
FLOOR	✓		
SUBSTRUCTURE	✓		
PAINT			

BADLY CORRODED OR RUSTED

TYPE OF PROTECTION FOR DRAWBRIDGES (NOTE 9)

(NOTES ON REVERSE SIDE)

S26130

Notes:

1. In agreement with Federal-aid standards, a bridge is defined as a structure including supports erected over a depression or an obstruction, as water, highway, or railway, and having a track or passageway for carrying traffic or other moving loads, and having a length measured along the center of roadway of more than 20 feet between undercoping of abutments or spring lines of arches, or extreme ends of openings for multiple boxes and pipes, where the clear distance between openings is less than half of the smaller contiguous opening.

2. Show kind of crossing by checking descriptive item applicable. For multiple-span bridges give complete information on each span including approach spans. Indicate on leg sheet the odometer reading, position, and angle of skew of structure with respect to center line of road and by arrow the direction of stream flow.

3. Give information on the span over the highway only.

4. For span length use center to center of bearings, otherwise the clear opening. Skew bridges will be measured along center line of road. See Note 1.

5. Show general type such as: Trestle, Truss, Girder, I-Beam, Rigid Frame, Arch, Slab, Suspension, or Covered Bridge. See illustrations attached. Describe draw spans by classifications listed in Article X, Section 2 of Manual.

6. The length of a bridge structure is the over-all length measured along the line of survey stationing back to back of back-walls of abutments, if present, otherwise end to end of bridge floor, but in no case less than the total clear opening of the structure.

7. Give minimum lateral clearance. Where traffic lanes are separated by bridge numbers, show clearance width of each lane separately. Special conditions should be explained by notes.

8. In case of overhead bracing or arch construction, measurement shall be made to the lowest point above the road surface.

9. Use classification listed on RR crossing sheet. Form 4 HPS.

Remarks: _____

A rearrangement of the form similar to that shown on the attachment may be used to provide space for coding.

Form 6 HPS (Rev. 1961)

FAU

5-196
90-305
2-20-91
BB/BB ~~AF~~

DT/TT
3-2-95
94-129

ROAD INVENTORY SHEET

PARTY CHIEF Frederick Settan
RECORDER Thomas Landon
CHAINMAN

Map 10

858-346
M36

VER
7-15-77

ROAD NO. Co 137
NAME S. OSBORNE RD.
SHEET NO. 1 OF 3
DATE 8-7-67
COUNTY PRINCE GEORGES

83-171 ALT

FAS 1387 MAIN TH MINOR COLLECTOR RURAL URBAN MINOR ARTERIAL

PT 45° PC		1 19		
		1 13		
		1 06	5 H	
	B-Const.	0 97		
		0 92	DR	
	H	0 89		
	H	0 83	H	
	ROLLING GLEN WAY H	0 74		2-3' ISLD
	CO 5537	0 61		22' HI
		0 50	F	2ML
		0 31		X
	~~F~~	~~0 37~~		22' HI
				2-3' ISLD
	~~H~~	~~0 32~~		2ML
		0 20		X
	~~H~~	~~0 23~~		22' HI
				2-10' ISLD
	~~H~~	~~0 20~~		2ML
		0 15 2	H	I X ~~22'~~ M
	H	0 10		~~20'~~ 8
	~~H~~	0 06	E S.C.	~~3-6' ISLD~~
		0 04		40 CW
	US	0 00 301		TL

Form 6 HPS (Rev. 1961)

ROAD INVENTORY SHEET

PARTY CHIEF Frederick Settan
RECORDER Thomas Landon
CHAINMAN

ROAD NO. Co 137
NAME
SHEET NO. 2 OF 3
DATE 8 7 67
COUNTY PRINCE GEORGES

	F	2 11			
		2 05	H		DR
		2 02			PT 35°
			Farm Rd.		
		1 97	~~OP 318~~ Co 5196		
		1 93	H		PC
	PT 35°	1 86			
	F	1 80			
	PC	1 76			
		1 70			PT 30°
		1 63			PC
	F	1 43	H		
			MARYVALE RD		
		1 39	~~OP "E"~~ Co 3396		~~OP 522~~
		1 38			PT 30°
		1 34			PC
			CARROLL WAY		
		1 32	~~OP "D"~~ Co 4108		~~OP 521~~
	F	1 29			

FAS 1383 Urban Tract Minor Collector Arterial Mi. Nw

22 XI
2 ML
2-3 I SHD
SAME

Form 6 HPS (Rev. 1961)

ROAD INVENTORY SHEET

PARTY CHIEF Frederick Settan
RECORDER Thomas Landon
CHAINMAN

98 CO ext "8
G.D.
E.F.
2/16/99

ROAD NO. Co 137
NAME
SHEET NO. 3 of 3
DATE 8-7-67
COUNTY PRINCE GEORGES

Marlboro PIKE

Co 3050 MD 4279

(William Beanes Rd)

2 34 ~~MD 3050~~ Co ~~3050~~ 4279 ~~DKE~~ 24'I 2-6"ES 50'CW

230 X

~~2 26 OP~~ 2-3'I SHD 22'XI 2ML SAME

Form 6 HPS (Rev. 1961) MAP 10,711 FAU Gr. Upper Marlboro Sm. Mbrn

5-175-A

ROAD INVENTORY SHEET

PARTY CHIEF Frederick Settan
RECORDER Thomas Landon
CHAINMAN

MAP #36
810-340
VER
7-15-77

ROAD NO. Co 138
NAME MT. CALVERT RD.
SHEET NO. 1 OF 3
DATE 8-3-67
COUNTY PRINCE GEORGES

	0 55	H	
	0 49	H	
H	0 48		
H	0 42	H	
PT 35°	0 40	GREY FOX TRAIL	
	0 39	OP 4947	
	0 33	DR.	
PC	0 30		
	0 29	H	
H	0 27		
	0 23	H	
H	0 19		
		BROOKRIDGE DR. PVT RD 0 11	
	0 18	OP ~~12"E~~ #4946	
	0 15	H	
MT CALVERT RD SPUR Co 586	0 13		18' FH ~~23' CONC~~ 34" CW
	0 06	H	
MD.	0 00	382	

Form 6 HPS (Rev. 1961)

ROAD INVENTORY SHEET

PARTY CHIEF Frederick Settan
RECORDER Thomas Landon
CHAINMAN

ROAD NO. Co 138
NAME
SHEET NO. 2 OF 3
DATE 8-3-67
COUNTY PRINCE GEORGES

	1 50	H	H 17' ~~23'~~
	1 48	PC	30'
		DUVALL RD Co 139	
H	1 40		
	1 38	H	
H	1 36	H	
		OP 519	
	~~OP "B"~~ 1 32		
	18 ± PVT RD 60 ± 10'D		
	1 29		
H	1 20		
		PVT RD ±	
	1 15 9'D	± H	
H	1 06		
	0 95	H	
	VOCATIONAL 6 ROOM SCHOOL		
	0 92		
	H ± 23 H ± 31' PVT RD 0 TO E		
	0 78	H	
H	0 70		
		PVT RD ±	
	0 69 10'E	± H	
	0 64	H	
			SAME

Form 6 HPS (Rev. 1961)

(92 Co Ex #8, 9)
GD/AH 2-24-93

78

ROAD INVENTORY SHEET

PARTY CHIEF Frederick Settan
RECORDER Thomas Landon
CHAINMAN

ROAD NO. Co 138
NAME
SHEET NO. 3 OF 3
DATE 8-3-67
COUNTY PRINCE GEORGES

PATUXENT RIVER

	~~ROAD~~ END		
~~H~~	~~291~~		
~~90°~~	~~275~~		~~12'D~~ ~~18'CW~~
	~~267~~	~~90°~~	
SIGN: PRIVATE DR END COUNTY MAINT	251	H	~~H~~ 12'~~R~~
	249	DR	18'CW
	MC CLURE RD		
	243 OP "C"	OP ~~520~~	~~X~~
	CO 5185		
	229	DR	
H	219	H	
	213	12" CMP	
TH.	209		
F	207	F	
H	183		20'I
			2 UNK
	176	DR	
H	174		
	160		X
	151	PT 40°	
			SAME

Form 6 HPS (Rev. 1961) MAP 10

FAR
876-342

5-351

ROAD INVENTORY SHEET

PARTY CHIEF Frederick Settan
RECORDER Thomas Landon
CHAINMAN

65-14

Gen Hwy
M36

ROAD NO. Co 139
NAME DUVALL RD
SHEET NO. 1 OF 1
DATE 8-7-67
COUNTY PRINCE GEORGES

Co 1208 Cream Airport

0 99 Co 1208 RD, Cream Airport Rd, Co 1208, SPUR

0 97

0 92 DR

0 91 F

P NW-01 0 84 CB L-9'xW-26"xD-4'

0 63 F

H 0 47

0 43 48"@P

0 38 PT 30°

0 33 PC

PT 35° PC 0 30

0 27 G 15'X 22'ESHD 22'CW

ENT VOCATIONAL SCHOOL 0 24

MJ Co CALVERT 0 07 H RD 138

0 00

Form 6 HPS (Rev. 1961) FAR 4-051 V8

ROAD INVENTORY SHEET

PARTY CHIEF Frederick Settan
RECORDER Thomas Landon
CHAINMAN

63-4-051-156

Gen Hwy

868-327

MAO

ROAD NO. Co 140
NAME MOLLY BERRY RD
SHEET NO. 1 OF 2 3
DATE 8-9-67
COUNTY PRINCE GEORGES

	107	F	18'F 2-3'E'SHLD 30'CW	
PT 70° PC	098			
	087			14'F
H	078			2-3'E SHLD
	071			24'CW
MATAPONI #P0493R	065	CREEK (PD) SEE BR S H. 1-B (VAN BRADY Co 133)		
	063		69-I 20	30'E
	061			36'CW
	047	F		
	023	H		
H	014			
MATAPONI	012	#P0494 CREEK SEE BR SH 1-A		18'F 2-3'E SH 30'CW
MD	000	382		

Form 6 HPS (Rev. 1961)

ROAD INVENTORY SHEET

PARTY CHIEF Frederick Settan
RECORDER Thomas Landon
CHAINMAN

ROAD NO. Co 140
NAME
SHEET NO. 2 OF 3
DATE 8-9-67
COUNTY PRINCE GEORGES

RURAL LOCAL — MILITARY COLLECTOR

H	2	54	14'G
		MARTIN RD	16'CW
	2	42 Co. 190	X
F	2	26	
	2	24 H	
CANDY HILL RD			
X Co. 3852	2	16 H	
PT	2	07	
40° F	2	05	
PC	2	03	
H	1	95	
		CP. 525	
	1	86	16'G
	1	79 DR	2-3'ESHD
			30'CW
X	1	76 NORTH HEYS RD Co 172	X
	1	69 PT 80°	
	1	56 PC	
	1	32 48"CP	
		PG RD 0	
H	1	22 18'I 23	

EDGEWOOD SENIOR HIGH SCHOOL

2 SHD

SAME

SHA 51.3-8
11-15-72

STATE HIGHWAY ADMINISTRATION OF MARYLAND

78

ROAD INVENTORY SHEET

Party Chief W.D. (F.S.)
Recorder M.Z. (T.L.)
Helper _____

Map No. _____

Road No. Co. 140
Road Name Molly Berry Rd
Sheet No. 3 of 3
Date 6-21-77 (8-9-67)
County Pr Geo.
State Coordinates _____

	Naylor Co	Baden Rd 229	
	3 83		∧ 14'F 20'cw
Rock	3 56	BR. see br sh. 1-C H P0486	X
	3 55	40°↑	
	3 49	H	12'F 16'cw
	3 42	CBC L-15' x W-14' x D-3½	X
↑ 90°	3 14		12'E 16'cw
	3 11		X
	3 03	H	
	2 80	H	
	2 75	H	
F	2 72		same

SHA 51.3-8
11-15-72

ROAD INVENTORY SHEET

Road No. _____
Road Name _____
Sheet No. _____
Date _____
County _____
State Coordinates _____

Form 5-HPS
(Revised 1956)

MARYLAND STATE ROADS COMMISSION
TRAFFIC DIVISION

S26130

IN COOPERATION WITH
U. S. BUREAU OF PUBLIC ROADS

ROAD NO. Co 140

BRIDGE SHEET

SHEET NO. 1-A

PARTY NO.

DATE 8-9-67

COUNTY PRINCE GEORGES

RATED CAPACITY

FOR ALL STRUCTURES HAVING A TOTAL OPENING OF MORE THAN 20 FEET AS DEFINED IN NOTE 1.

ODOMETER READING 0.12 NAME OF STREAM, RAILROAD OR HIGHWAY CROSSED MATAPONI CREEK

NUMBER OF RAILROAD TRACKS

KIND OF CROSSING (NOTE 2)

UNDERPASS - SIMPLE | UNDERPASS - COMBINED (NOTE 3) | OVERPASS | BRIDGE OVER SYSTEM

DESCRIPTION

NUMBER OF SPANS	LENGTH EACH SPAN (NOTE 4)	TYPE (NOTE 5)
1	33'	CONCRETE

TOTAL LENGTH - ON LINE OF ROAD OVER-ALL (NOTE 6) 33'

MATERIAL

SUBSTRUCTURE CONCRETE SUPERSTRUCTURE CONCRETE

FLOOR CONCRETE

CLEARANCES

ROADWAY (NOTE 7) 33' SIDEWALK WIDTHS: RIGHT LEFT

SURFACE OF ROAD TO STREAM BED 10' FOR OVERPASSES, SHOW DISTANCES TO TOP OF RAIL OR SURFACE OF LOWER ROAD. (NOTE 8)

SURFACE OF ROAD TO BOTTOM PORTAL 2' (MINIMUM OVERHEAD CLEARANCE

CLEAR DISTANCE OF OPENING ABOVE STREAM BED 8' (WATERWAYS ONLY)

POSTED LOAD LIMITS BRIDGE NO. CONSTRUCTION DATE

GENERAL CONDITION OF BRIDGE: CHECK IF GOOD, FAIR, OR POOR, DESCRIBE DEFECTS IF SERIOUS.

	GOOD	FAIR	POOR
SUPSTRUCTURE	✓		
FLOOR	✓		
SUBSTRUCTURE	✓		
PAINT			BADLY CORRODED OR RUSTED

TYPE OF PROTECTION FOR DRAWBRIDGES (NOTE 9)

(NOTES ON REVERSE SIDE)

S26130

Notes:

1. In agreement with Federal-aid standards, a bridge is defined as a structure including supports erected over a depression or an obstruction, as water, highway, or railway, and having a track or passageway for carrying traffic or other moving loads, and having a length measured along the center of roadway of more than 20 feet between undercoping of abutments or spring lines of arches, or extreme ends of openings for multiple boxes and pipes, where the clear distance between openings is less than half of the smaller contiguous opening.

2. Show kind of crossing by checking descriptive item applicable. For multiple-span bridges give complete information on each span including approach spans. Indicate on leg sheet the odometer reading, position, and angle of skew of structure with respect to center line of road and by arrow the direction of stream flow.

3. Give information on the span over the highway only.

4. For span length use center to center of bearings, otherwise the clear opening. Skew bridges will be measured along center line of road. See Note 1.

5. Show general type such as: Trestle, Truss, Girder, I-Beam, Rigid Frame, Arch, Slab, Suspension, or Covered Bridge. See illustrations attached. Describe draw spans by classifications listed in Article X, Section 2 of Manual.

6. The length of a bridge structure is the over-all length measured along the line of survey stationing back to back of back-walls of abutments, if present, otherwise end to end of bridge floor, but in no case less than the total clear opening of the structure.

7. Give minimum lateral clearance. Where traffic lanes are separated by bridge numbers, show clearance width of each lane separately. Special conditions should be explained by notes.

8. In case of overhead bracing or arch construction, measurement shall be made to the lowest point above the road surface.

9. Use classification listed on RR crossing sheet. Form 4 HPS.

Remarks: _____

A rearrangement of the form similar to that shown on the attachment may be used to provide space for coding.

Form 5-HPS
(Revised 1956)

MARYLAND STATE ROADS COMMISSION
TRAFFIC DIVISION

S26130

IN COOPERATION WITH
U. S. BUREAU OF PUBLIC ROADS

ROAD NO. Co 140

BRIDGE SHEET

SHEET NO. 1-B

PARTY NO. _____

DATE 8-9-67

COUNTY PRINCE GEORGES

RATED CAPACITY _____

FOR ALL STRUCTURES HAVING A TOTAL OPENING OF MORE THAN 20 FEET AS DEFINED IN NOTE 1.

ODOMETER READING 0.65 NAME OF STREAM, RAILROAD OR HIGHWAY CROSSED MATAPONI CREEK

NUMBER OF RAILROAD TRACKS _____

KIND OF CROSSING (NOTE 2) _____

UNDERPASS - SIMPLE UNDERPASS - COMBINED (NOTE 3) OVERPASS BRIDGE OVER SYSTEM

DESCRIPTION

NUMBER OF SPANS	LENGTH EACH SPAN (NOTE 4)	TYPE (NOTE 5)
2	21'	CONCRETE

TOTAL LENGTH - ON LINE OF ROAD OVER-ALL (NOTE 6) 42'

MATERIAL

SUBSTRUCTURE CONCRETE SUPERSTRUCTURE CONCRETE

FLOOR CONCRETE

CLEARANCES

ROADWAY (NOTE 7) 30'C-C SIDEWALK WIDTHS: RIGHT LEFT

SURFACE OF ROAD TO STREAM BED 7' FOR OVERPASSES, SHOW DISTANCES TO TOP OF RAIL OR SURFACE OF LOWER ROAD. (NOTE 8)

SURFACE OF ROAD TO BOTTOM PORTAL 2' (MINIMUM OVERHEAD CLEARANCE

CLEAR DISTANCE OF OPENING ABOVE STREAM BED 5' (WATERWAYS ONLY)

POSTED LOAD LIMITS _____ BRIDGE NO. _____ CONSTRUCTION DATE 1967

GENERAL CONDITION OF BRIDGE: CHECK IF GOOD, FAIR, OR POOR, DESCRIBE DEFECTS IF SERIOUS.

	GOOD	FAIR	POOR
SUPSTRUCTURE	✓		
FLOOR	✓		
SUBSTRUCTURE			
PAINT			BADLY CORRODED OR RUSTED

TYPE OF PROTECTION FOR DRAWBRIDGES (NOTE 9) _____

(NOTES ON REVERSE SIDE)

S26130

Notes:

1. In agreement with Federal-aid standards, a bridge is defined as a structure including supports erected over a depression or an obstruction, as water, highway, or railway, and having a track or passageway for carrying traffic or other moving loads, and having a length measured along the center of roadway of more than 20 feet between undercoping of abutments or spring lines of arches, or extreme ends of openings for multiple boxes and pipes, where the clear distance between openings is less than half of the smaller contiguous opening.

2. Show kind of crossing by checking descriptive item applicable. For multiple-span bridges give complete information on each span including approach spans. Indicate on leg sheet the odometer reading, position, and angle of skew of structure with respect to center line of road and by arrow the direction of stream flow.

3. Give information on the span over the highway only.

4. For span length use center to center of bearings, otherwise the clear opening. Skew bridges will be measured along center line of road. See Note 1.

5. Show general type such as: Trestle, Truss, Girder, I-Beam, Rigid Frame, Arch, Slab, Suspension, or Covered Bridge. See illustrations attached. Describe draw spans by classifications listed in Article X, Section 2 of Manual.

6. The length of a bridge structure is the over-all length measured along the line of survey stationing back to back of back-walls of abutments, if present, otherwise end to end of bridge floor, but in no case less than the total clear opening of the structure.

7. Give minimum lateral clearance. Where traffic lanes are separated by bridge numbers, show clearance width of each lane separately. Special conditions should be explained by notes.

8. In case of overhead bracing or arch construction, measurement shall be made to the lowest point above the road surface.

9. Use classification listed on RR crossing sheet. Form 4 HPS.

Remarks: _____

A rearrangement of the form similar to that shown on the attachment may be used to provide space for coding.

Form 5-HPS
(Revised 1956)

MARYLAND STATE ROADS COMMISSION
TRAFFIC DIVISION

S26130

IN COOPERATION WITH
U. S. BUREAU OF PUBLIC ROADS

Co 140
~~385~~

ROAD NO. ~~Co 172~~

BRIDGE SHEET

SHEET NO. 1-A C

PARTY NO.

DATE 8-8-67

COUNTY PRINCE GEORGES

RATED CAPACITY

FOR ALL STRUCTURES HAVING A TOTAL OPENING OF MORE THAN 20 FEET AS DEFINED IN NOTE 1.

ODOMETER READING 3.56 ~~5.40~~ ~~5.70~~ NAME OF STREAM, RAILROAD OR HIGHWAY CROSSED ROCK BRANCH

NUMBER OF RAILROAD TRACKS

KIND OF CROSSING (NOTE 2)

UNDERPASS - SIMPLE UNDERPASS - COMBINED (NOTE 3) OVERPASS BRIDGE OVER SYSTEM

DESCRIPTION

NUMBER OF SPANS	LENGTH EACH SPAN (NOTE 4)	TYPE (NOTE 5)
1	21'	CONCRETE

TOTAL LENGTH - ON LINE OF ROAD OVER-ALL (NOTE 6)

MATERIAL

SUBSTRUCTURE CONCRETE SUPERSTRUCTURE CONCRETE

FLOOR CONCRETE

CLEARANCES

ROADWAY (NOTE 7) 20 SIDEWALK WIDTHS: RIGHT LEFT

SURFACE OF ROAD TO STREAM BED 5' FOR OVERPASSES, SHOW DISTANCES TO TOP OF RAIL OR SURFACE OF LOWER ROAD. (NOTE 8)

SURFACE OF ROAD TO BOTTOM PORTAL 2' (MINIMUM OVERHEAD CLEARANCE

CLEAR DISTANCE OF OPENING ABOVE STREAM BED 3' (WATERWAYS ONLY)

POSTED LOAD LIMITS BRIDGE NO. CONSTRUCTION DATE

GENERAL CONDITION OF BRIDGE: CHECK IF GOOD, FAIR, OR POOR, DESCRIBE DEFECTS IF SERIOUS.

	GOOD	FAIR	POOR
SUPSTRUCTURE	✓		
FLOOR	✓		
SUBSTRUCTURE	✓		
PAINT			BADLY CORRODED OR RUSTED

TYPE OF PROTECTION FOR DRAWBRIDGES (NOTE 9)

(NOTES ON REVERSE SIDE)

S26130

Notes:

1. In agreement with Federal-aid standards, a bridge is defined as a structure including supports erected over a depression or an obstruction, as water, highway, or railway, and having a track or passageway for carrying traffic or other moving loads, and having a length measured along the center of roadway of more than 20 feet between undercoping of abutments or spring lines of arches, or extreme ends of openings for multiple boxes and pipes, where the clear distance between openings is less than half of the smaller contiguous opening.

2. Show kind of crossing by checking descriptive item applicable. For multiple-span bridges give complete information on each span including approach spans. Indicate on leg sheet the odometer reading, position, and angle of skew of structure with respect to center line of road and by arrow the direction of stream flow.

3. Give information on the span over the highway only.

4. For span length use center to center of bearings, otherwise the clear opening. Skew bridges will be measured along center line of road. See Note 1.

5. Show general type such as: Trestle, Truss, Girder, I-Beam, Rigid Frame, Arch, Slab, Suspension, or Covered Bridge. See illustrations attached. Describe draw spans by classifications listed in Article X, Section 2 of Manual.

6. The length of a bridge structure is the over-all length measured along the line of survey stationing back to back of back-walls of abutments, if present, otherwise end to end of bridge floor, but in no case less than the total clear opening of the structure.

7. Give minimum lateral clearance. Where traffic lanes are separated by bridge numbers, show clearance width of each lane separately. Special conditions should be explained by notes.

8. In case of overhead bracing or arch construction, measurement shall be made to the lowest point above the road surface.

9. Use classification listed on RR crossing sheet. Form 4 HPS.

Remarks: _____

A rearrangement of the form similar to that shown on the attachment may be used to provide space for coding.

Form 6 HPS (Rev. 1961)

FAR
MAPS 10+11

78

ROAD INVENTORY SHEET

~~FEMA~~ RD 4-033

PARTY CHIEF Frederick Settan
RECORDER Thomas Landon
CHAINMAN

Gen Hwy

868-333 MAO VER 6-21-77

ROAD NO. Co 141
NAME ST. THOMAS CHURCH RD
SHEET NO. 1 OF 8 24-072
DATE 8-8-67
COUNTY PRINCE GEORGES

	0 98	MATTAPONI RD Co 142	
H	0 91		
H	0 81		
H	0 72		
	0 68		DR
	0 66	H	
	0 55	H	
F 36 / 0 PVT RD H 10'E (45°) T.H. 005	0 60		
	0 35		
	0 23	H-50'-H	
	0 21	CHURCH ABAN	
	0 19	H-ABAN 300'	
END CEM	0 17	45°	
	0 15	H	
CHURCH + CEM	0 08		16'6 23'ESH
HALL	0 02		28'CW
MD	0 00	382	

Form 6 HPS (Rev. 1961)

78

ROAD INVENTORY SHEET

PARTY CHIEF Frederick Settan
RECORDER Thomas Landon
CHAINMAN

ROAD NO. Co 141
NAME
SHEET NO. 20F~~3~~2
DATE 8-8-67
COUNTY PRINCE GEORGES

FENWICK RD	MATAPONI	RD	178	CREEK SEE BR. SH 1-A	15'F
		FENWICK	~~249~~		2-3'ESH
			0'		28'CW
	PT 50° F		225		A
	PC		220		
	H		214	H	
	H		193		
			186	F	
	H		183		
	H		178		
	H		176		
	H		174		
	H		171		
	F		153		
	H		141		
	H	4TH	137		
			127		
	H		114		
			108		
	H		100		
					SAME

~~Fenwick Rd.~~ CO 6057

Form 6 HPS (Rev. 1961)

FAR
MAP 10

4-073

78

ROAD INVENTORY SHEET

Party Chief Fred Settan
Recorder Tom LANDON
Chainman

70-271 Type Change
Revised T. LANDON
60-213 W. WARFIELD
3-17-71

MAP #40
869-327
M40

Formerly named SAGER Rd

VER 6-22-77

Road No. Co 142
Name MATTAPONI ROAD
Sheet No. 1 of 1
Date 8-9-67
County PRINCE GEORGES

Md	1	13	382	
	1	10	F	12'F
				2-2'E Shld
	1	00	DR	18'CW
	0	91	F	
	0	71		
	0	48	WPC L-15'xW-13'xD-3' #P0497	~~24'F~~
				~~2-2'E Shld~~
T.H. 32 Rt Rd 0 12'E	0	42		~~18'CW~~
	0	40		
Rt 9°L 0				16'F
Club House	0	14		2-2'E Shld
				20'CW
	0	16		
				12'F
F	0	05		2-2'E Shld
St Thomas Church			Road	18'CW
Co	0	00	141	

SHA 51.3 - 8 Revised
4.83

MARYLAND STATE HIGHWAY ADMINISTRATION

(93-134, 135)

ROAD INVENTORY SHEET

Party Chief GD
Recorder AR
Assistant
Map No./Dir. 411 / W
State Coordinates 199-331

Road No. CO 143
Road Name Riverview Rd
County Prince Georges
Date 3-15-94
Sheet No. 1 OF 3

TRAFFIC CODES
TRAFFIC CONTROLS: STOP SIGN=SS, TRAFFIC LIGHT=T.L., FLASHING RED BALL=F.R.

TRAFFIC CODES
PARKING RESTRICTIONS: A.M. PEAK, P.M. PEAK, A.M./P.M. PEAK, NO PARKING ANYTIME=N.P., COMM/IND. ACCESS=E

SYSTEM				TRAFFIC		LINE DIAGRAM	TRAFFIC			PAVEMENT DATA
FED. AID.	FUNCT CLASS.	HWY. SYS.	HPMS SAMPLE	PRK.G. REST.	COM/IND. ACCESS		CONTROL	COM/IND. ACCESS	PRK.G. REST.	
						101 RT TL Ent to US GSA Bldg 0 36 101 FREE FLOW LEFT 0 33				
						Battlement LA 0 28 CO 5345 3 RT TL 18'				
						0 26				
						Freedom LA 0 11 CO 5452 4 RT TL 18'				
					E	0 08				
					E	0 02				24' I 2-8' E Shds 2ml
						Fort Washington Rd CO 0 00 416	TL		V	

SYSTEM				TRAFFIC		LINE DIAGRAM	TRAFFIC				PAVEMENT DATA
FED. AID.	FUNCT. CLASS.	HWY. SYS.	HPMS SAMPLE	PRK.G. REST.	COM/IND ACCESS		CONTROL	COM/IND ACCESS	PRK.G. REST.		
						Airport Office 1 27					
						Pvt Airport 1 22					
						West Riverview Rd CO 2571					
						1 06 905					
						Airport 1 03					
						0 93 OP 307					
						Gates DR					
						CO 3514 0 83					
						Broad (Creek) CR ~~DR~~ Rd					
						(A) 0 65 CO 2187					24'I 2-8'E Shds 2mL
						0 41 Riverview Park					

TT

SHA 51.3-8
11-15-72

STATE HIGHWAY ADMINISTRATION OF MARYLAND

FAU

ROAD INVENTORY SHEET

78

Party Chief R. Bush (OFFICE INV)
Recorder
Helper

Map No. M 39
INDEX 9

Road No. Co 143
Road Name RIVERVIEW RD
Sheet No. 1 OF 2
Date 8-22-68 (REVISED 7-11-74
County PR. GEO
State Coordinates 799 - 331

	130	FARM 1000'	
AIRPORT OFFICE	127	See new Inv.	
PVT. AIRPORT	122	WEST RIVERVIEW Rd. CO 2571	72-290 ~~18' H I~~ ~~23'6 Shld.~~
	106	90 ↑ ~~X~~ SAME	
AIRPORT	103		
	093	OP 307	
GATES DR			
CO 3514 (72-168)	083		
		BROAD CR DR	
	065	CO 2187	
ADMIN BUILDING ENTRANCE	039	ENT TO REGIONAL PARK CO (93-136)	69-I-27 24'I ~~24'CW~~
	010	FREEDOM LA CO (93-136)	
US COMM CENT.	008	R 12'I JCT RTL	2-8'E SHD 18'I.
BUS	002		1-3'E Shld 46'CW
FORT WASHINGTON RD			2ML
CO	000	416	

W

SHA 51.3-8
11-15-72

ROAD INVENTORY SHEET

Road No. CO 143
Road Name
Sheet No. 3 ~~2~~ OF ~~2~~ 3
Date
County
State Coordinates

SWAN ~~CREEK~~ HARBOUR		Rd	
Co	232	2493	
	227	to ~~756~~ 2526	
FIRTH OF LORNE CIR			
CO 3167	217		20'I
			2-3'E Shld
			30'CW
SWAN CREEK		Rd	
Co	208	600	
Serv Estates Dr OP 4603	200		
~~Collegiate Ct~~	~~188~~	FARM	
CO 4958	189		
	142	Bus	
			SAME

Form 6 HPS (Rev. 1961) FAU 4-039

ROAD INVENTORY SHEET

Party Chief E.S.
Recorder W.D.
Chainman

Gen Hwy
807-327 M39
VER 7-6-77 FT. WASH FOREST
MAP 9

Road No. CO 144
Name GALLAHAN RD
Sheet No. 1 OF 2
Date 8-28-68
County PRINCE GEO

				20'E
		~~P0490~~		~~2-3'E SNO~~ SAME
TINKERS	131	CK SEE 1A *	P0490	
H	1	No		
	1 11		PT 40°	
	1 07		PC	
	0 93		H	
	0 84		H	
FARM	0 80			
	0 75		PT 35°	
	0 72		PC	
H	0 50			
	0 44		H	
16'F				
SAND & G. PIT 1.00 MI	0 19			
S ↑				
	0 12		H	
H	0 10		H	20'I
				~~18'H~~
		118 RD		2-3'E SNO
CO. OLD FORT	0 00			BML 30' CW

Form 6 HPS (Rev. 1961)

78

ROAD INVENTORY SHEET

Party Chief E.S.
Recorder W.D.
Chainman

Road No. Co 144
Name GALLAHAN RD
Sheet No. 2 OF 2
Date 8 - 28 - 68
County PRINCE GEO

MD	190	223	
	181	H	24'I 2-10'F Flds 50' CW 2 mls
	180		
H	178		
	160	H	
H	147		
PT 35° PC	145		
	143		SAME

Form 5-HPS (Revised 1961)

MARYLAND STATE ROADS COMMISSION
PLANNING AND PROGRAMMING DIVISION

S26130

IN COOPERATION WITH
U. S. BUREAU OF PUBLIC ROADS

BRIDGE SHEET

ROAD NO. Co 144

SHEET NO. 1 A

PARTY NO.

DATE 8-28-68

COUNTY PRINCE GEO

RATED CAPACITY

FOR ALL STRUCTURES HAVING A TOTAL OPENING OF MORE THAN 20 FEET AS DEFINED IN NOTE 1.

ODOMETER READING 1.31 NAME OF STREAM, RAILROAD OR HIGHWAY CROSSED

NUMBER OF RAILROAD TRACKS

KIND OF CROSSING (NOTE 2)

UNDERPASS-SIMPLE | UNDERPASS-COMBINED (NOTE 3) | OVERPASS | BRIDGE OVER SYSTEM STREAM

DESCRIPTION

NUMBER OF SPANS	LENGTH EACH SPAN (NOTE 4)	TYPE (NOTE 5)
2	15"	WOOD BEAM

TOTAL LENGTH-ON LINE OF ROAD OVER-ALL (NOTE 6)

MATERIAL

SUBSTRUCTURE WOOD BEAM SUPERSTRUCTURE

FLOOR WOOD PLANK & BIT MIX

CLEARANCES

ROADWAY (NOTE 7) 22' SIDEWALK WIDTHS: RIGHT LEFT

SURFACE OF ROAD TO STREAM BED 8' FOR OVERPASSES, SHOW DISTANCES TO TOP OF RAIL OR SURFACE OF LOWER ROAD. (NOTE 8)

SURFACE OF ROAD TO BOTTOM PORTAL (MINIMUM OVERHEAD CLEARANCE

CLEAR DISTANCE OF OPENING ABOVE STREAM BED 6' (WATERWAYS ONLY)

POSTED LOAD LIMITS BRIDGE NO. CONSTRUCTION DATE

GENERAL CONDITION OF BRIDGE: CHECK IF GOOD, FAIR, OR POOR, DESCRIBE DEFECTS IF SERIOUS.

	GOOD	FAIR	POOR
SUPERSTRUCTURE	✓		
FLOOR		✓	
SUBSTRUCTURE		✓	
PAINT		✓	

BADLY CORRODED OR RUSTED

TYPE OF PROTECTION FOR DRAWBRIDGES (NOTE 9)

(NOTES ON REVERSE SIDE)

S26130

Notes:

1. In agreement with Federal-aid standards, a bridge is defined as a structure including supports erected over a depression or an obstruction, as water, highway, or railway, and having a track or passageway for carrying traffic or other moving loads, and having a length measured along the center of roadway of more than 20 feet between undercoping of abutments or spring lines of arches, or extreme ends of openings for multiple boxes and pipes, where the clear distance between openings is less than half of the smaller contiguous opening.

2. Show kind of crossing by checking descriptive item applicable. For multiple-span bridges give complete information on each span including approach spans. Indicate on leg sheet the odometer reading, position, and angle of skew of structure with respect to center line of road and by arrow the direction of stream flow.

3. Give information on the span over the highway only.

4. For span length use center to center of bearings, otherwise the clear opening. Skew bridges will be measured along center line of road. See Note 1.

5. Show general type such as: Trestle, Truss, Girder, I-Beam, Rigid Frame, Arch, Slab, Suspension, or Covered Bridge. See illustrations attached. Describe draw spans by classifications listed in Article X, Section 2 of Manual.

6. The length of a bridge structure is the over-all length measured along the line of survey stationing back to back of back-walls of abutments, if present, otherwise end to end of bridge floor, but in no case less than the total clear opening of the structure.

7. Give minimum lateral clearance. Where traffic lanes are separated by bridge numbers, show clearance width of each lane separately. Special conditions should be explained by notes.

8. In case of overhead bracing or arch construction, measurement shall be made to the lowest point above the road surface.

9. Use classification listed on RR crossing sheet. Form 4 HPS.

Remarks: _____

_____

A rearrangement of the form similar to that shown on the attachment may be used to provide space for coding.

SHA 51.3-8
11-15-72

STATE HIGHWAY ADMINISTRATION OF MARYLAND

2000 COUPE 98-119 BBTW 3-9-99 78

GDF 2/9/01

ROAD INVENTORY SHEET

A\T 82-144 3\23\83 J.E. & N.S.

Party Chief M.Z.
Recorder K.C.
Helper

Road No. Co. 145
Road Name THRIFT RD
Sheet No. 1 OF 3
Date 7-6-77
County PR. GEO.
State Coordinates 218-321

80-158 17 MAR 81 J.E./D.G.

Map No. 39

89-162 AT

94-160 AT

	2 16	PT 90° PC	*
	2 14		
90° TIPPETT RD Co. 146	1 98		
	1 41	35°	
30°	1 19		
	1 07	DR	
PT 50° PC	0 90		
	0 87		
	0 47	PT 50° PC	
	0 45		
E	0 34	#D489 CBC L-18'xW-19'xD-4'	
PT 90° PC	0 24		
WINDBROOK ~~RD~~ DR Co. 3764	0 23		
	0 11	#D488 BR. SH. 1A	16'H 2-3'ESHD 30'CW
FLORAL PARK Co	0 00	RD 225	V

SHA 51.3-8
11-15-72

ROAD INVENTORY SHEET

Road No. Co 145
Road Name THRIFT RD.
Sheet No. 2 OF 3
Date 7-6-77
County PR. GEO
State Coordinates

WHITE AVE		30'I
Co. 3940	385	1-CURB LT
		6'E SHD LT
	378	X 45' CW 2ML
SPELL RD		
Co.	376 2708	
PARKVIEW LA		
	369 Co. 2964	~~40'I~~
		~~1'C-C~~
	362 Bickford Ave	X 34'I
LAREN LA	357 Co 2345	X J-CRT 2ML
CO. 4201	353 Dragoo PL.	40'I J-CC
	351 Co 90-261 5140	X 2ML
(A)	3 ~~20~~ X 37	X ~~24'I J-CRT~~ ~~17'I J-CC~~
(A)	320 - - - - - - -	~~2ML~~
	318	X
	CHAIN	~~24'I J-CRT~~
	311 X ENT TO CAMPGROUND	~~2ML~~ XX
(A)	305	24'I
		2-10'E SHLD
ENT TO PICNIC AREA	GATE 288	50' CW
		2 ML
	282 ENT TO PARK POLICE	
	272 ~~EAST~~ BEECH TRAIL	X 39'I
	256 EAST BONIWOOD TURN. Co 5043	X J CURB RT
	250 ~~WEST~~ BONIWOOD TURN ~~Of 4288~~ Co 4486	X 10'E SHLD LT
	247 10' MULTI-PLATE	X
PT 35° PC	241	24'I
		2-10'E SHD
	237	50' CW
		2ML

SHA 51.3-8
11-15-72

STATE HIGHWAY ADMINISTRATION OF MARYLAND

78

ROAD INVENTORY SHEET

Party Chief M.Z.
Recorder K.C.
Helper

Map No.

Road No. Co 145
Road Name THRIFT RD
Sheet No. 3 of 3
Date 7-6-77
County PR. GEO.
State Coordinates

BRANDYWINE RD
Co. 425 599

DR
TERRENCE Co. 3990 415
WIGAN DR
Co 3984 400

WALDON WOODS 393 same
ELE. SCH.

SHA 51.3-8
11-15-72

ROAD INVENTORY SHEET

Road No. _____
Road Name _____
Sheet No. _____
Date _____
County _____
State Coordinates _____

Form 5-HPS
(Revised 1961)

MARYLAND STATE ROADS COMMISSION
PLANNING AND PROGRAMMING DIVISION

S26130

IN COOPERATION WITH
U. S. BUREAU OF PUBLIC ROADS

BRIDGE SHEET

ROAD NO. Co 145

SHEET NO. 1A

PARTY NO. _____

DATE 7-31-68

COUNTY PRINCE GEO.

RATED CAPACITY _____

FOR ALL STRUCTURES HAVING A TOTAL OPENING OF MORE THAN 20 FEET AS DEFINED IN NOTE 1.

ODOMETER READING 0.11 NAME OF STREAM, RAILROAD OR HIGHWAY CROSSED PISCATAWAY CREEK

NUMBER OF RAILROAD TRACKS _____
KIND OF CROSSING (NOTE 2) _____

UNDERPASS-SIMPLE | UNDERPASS-COMBINED (NOTE 3) | OVERPASS BRIDGE OVER SYSTEM =STREAM=

DESCRIPTION

NUMBER OF SPANS	LENGTH EACH SPAN (NOTE 4)	TYPE (NOTE 5)
1	56'	I BEAM

TOTAL LENGTH-ON LINE OF ROAD OVER-ALL (NOTE 6) 56'

MATERIAL
SUBSTRUCTURE I BEAM SUPERSTRUCTURE _____
FLOOR WOOD PLANK

CLEARANCES
ROADWAY (NOTE 7) 11' SIDEWALK WIDTHS: RIGHT NONE LEFT

SURFACE OF ROAD TO STREAM BED 6' FOR OVERPASSES, SHOW DISTANCES TO TOP OF RAIL OR SURFACE OF LOWER ROAD. (NOTE 8)
SURFACE OF ROAD TO BOTTOM PORTAL _____ (MINIMUM OVERHEAD CLEARANCE
CLEAR DISTANCE OF OPENING ABOVE STREAM BED 4' (WATERWAYS ONLY)
POSTED LOAD LIMITS _____ BRIDGE NO. _____ CONSTRUCTION DATE _____

GENERAL CONDITION OF BRIDGE: CHECK IF GOOD, FAIR, OR POOR, DESCRIBE DEFECTS IF SERIOUS.

	GOOD	FAIR	POOR
SUPERSTRUCTURE	✓		
FLOOR	✓		
SUBSTRUCTURE	✓		
PAINT	✓		

BADLY CORRODED OR RUSTED

TYPE OF PROTECTION FOR DRAWBRIDGES (NOTE 9) _____

(NOTES ON REVERSE SIDE)

S26130

Notes:

1. In agreement with Federal-aid standards, a bridge is defined as a structure including supports erected over a depression or an obstruction, as water, highway, or railway, and having a track or passageway for carrying traffic or other moving loads, and having a length measured along the center of roadway of more than 20 feet between undercoping of abutments or spring lines of arches, or extreme ends of openings for multiple boxes and pipes, where the clear distance between openings is less than half of the smaller contiguous opening.

2. Show kind of crossing by checking descriptive item applicable. For multiple-span bridges give complete information on each span including approach spans. Indicate on leg sheet the odometer reading, position, and angle of skew of structure with respect to center line of road and by arrow the direction of stream flow.

3. Give information on the span over the highway only.

4. For span length use center to center of bearings, otherwise the clear opening. Skew bridges will be measured along center line of road. See Note 1.

5. Show general type such as: Trestle, Truss, Girder, I-Beam, Rigid Frame, Arch, Slab, Suspension, or Covered Bridge. See illustrations attached. Describe draw spans by classifications listed in Article X, Section 2 of Manual.

6. The length of a bridge structure is the over-all length measured along the line of survey stationing back to back of back-walls of abutments, if present, otherwise end to end of bridge floor, but in no case less than the total clear opening of the structure.

7. Give minimum lateral clearance. Where traffic lanes are separated by bridge numbers, show clearance width of each lane separately. Special conditions should be explained by notes.

8. In case of overhead bracing or arch construction, measurement shall be made to the lowest point above the road surface.

9. Use classification listed on RR crossing sheet. Form 4 HPS.

Remarks: _____

_____

A rearrangement of the form similar to that shown on the attachment may be used to provide space for coding.

SHA 51.3-8
11-15-72

STATE HIGHWAY ADMINISTRATION OF MARYLAND

FAU

78

ROAD INVENTORY SHEET

Party Chief R. Bush (OFFICE)
Recorder
Helper

Map No. M 39
Index 9

VER 7-5-77

Road No. Co 146
Road Name TIPPETT Rd
Sheet No. 1 of 1
Date 7-31-68 Revised 5-8-74
County PR. GEO
State Coordinates 823 - 320

N

MD 139 223

113
30°
109
107
40°
16' H 20' CW
105
40°
071
16' I 20' CW
063
058 PUT ENT FARM
NEW ENGLAND DR.
053 OP 4297
043
30°
025
40°
023
WARd Rd
Co ~~DP~~ ~~DP~~ 4980
021
16' H
2-3' E Shld
THRIFT
Co
000
26' C-W
Rd
I-495

SHA 51.3-8
11-15-72

ROAD INVENTORY SHEET

Road No. _____
Road Name _____
Sheet No. _____
Date _____
County _____
State Coordinates _____

Form 6 HPS (Rev. 1961)

FAU

3-079-13

18

ROAD INVENTORY SHEET

811-367 M35

Party Chief E SCHUYLER
Recorder THANNUM
Chainman J EMERICK
DPLUMMER
6 5-141

OXON RUN

MAP 4. HILLS

Road No. Co 147
Name DAWSON ST
Sheet No. 1 OF 1
Date 12 - 13 - 67
County PRINCE GEORGES

DAWSON ST

DE
COL 015
013

SAC

2 H

2 H

25TH
Co 012

AVE
612

H 011

H

H 008

H

24TH
Co 007

AVE
1086

H 006

3 H

PT
20°
PC 004

H 002

23RD
Co 000

PKWY
1084

26' I
C-C

E

Form 6 HPS (Rev. 1961)

FAU & R Ver 8-5-77 3-045 90-107,155 2-28-91 66/66 9-99 2-28-92 DT/JS

ROAD INVENTORY SHEET

95-1 BO 3B 1 MAP 9 92-7 GO 1A 3/16/95

Party Chief	E.S.
Recorder	W.D.
Chainman	T.L.

70-264 Resurfacing PHELPS COR

Road No.	CO 148
Name	BOCK RD
Sheet No.	1 OF 5
Date	10-4-68
County	PRINCE GEO

GIIC MAP 35 804-352

		PT	043	34'I
		CO	040	165 JC-LT 10'ESHOLT
	50°	ST. BARNABAS	039	RD TL 3ML
			038	50'I
	PC		034	~~34'I~~ JC-RT
			030	H 8'ISHDLT
				42ML
		H	029	
			@.26	CO 1315
			027	BOCK TERR
			025	
		H	023	8 H 34'I
			017	JCRT
				8'ESHDLT
			@0.0	CO 1315
			015	BOCK TERR
		E	013	3 H
			011	
		TELE. BUILDING	009	
		E	005	44'I
		H	003	CH JC-C
E	90°		001	~~34'I~~ RT ~~CORR LT~~ LT ~~84'ESHDRT~~
		CO		1203
		LIVINGSTON	000	RD SS 2ML

FAU STOP MINOR ARTERIAL - URBAN

Form 6 HPS (Rev. 1961)

..78

ROAD INVENTORY SHEET

Party Chief	E.S.
Recorder	W.D.
Chainman	T.L.

PHELPS COR

Road No.	CO 148
Name	BOCK RD
Sheet No.	2 OF 5
Date	10-4-68
County	PRINCE GEO

		CO 2178			
		ROSECROFT BLVD	099		
		H	097		
		CO 658			
		WOLF ST	094		
		CO 1842			
		BROWNS LA	088		
		H	086		
		CO 1846			
		BORDER DR	082		
FAU 5107	MINOR ARTERIAL URBAN	3 H	080		
			077		
		CO 1919			
		BELFAST DR	076		
		6 H	075	2 H	
			071		
			065	H	
			062	H	
		ELEM SCHOOL	054		
			051	H	
			049		

70-264 Res-Face

3H I
VL. LT
10' ESHORT
2ML
X 34' I
CURB-LT
10' ESHORT
3ML

Form 6 HPS (Rev. 1961)

98-54
G.D. L.F
2-10-99

78

ROAD INVENTORY SHEET

Party Chief	E.S.
Recorder	W.D.
Chainman	T.L.

PHELPS COR

Road No.	CO 148
Name	BOCK RD
Sheet No.	3 OF 5
Date	10-4-68
County	PRINCE GEO.

PVT DR
?
167
166
3 H
160
CO 3020
KINGSWAY RD
157
HENSON Valley Way
CO 3499
155
154
140
126
124
1959
BOUNDARY SEE 1A
122
121
POWER STA
118
115
3 H
111
CO 2120
HAYER HILL ST
109
107
5 HH
102
CO 3020
Kingsway RD 70-229
ENT. TO PARK
ENT to Park
HENSON CK. →
#P309
FAU 5107
MINOR ARTERIAL-URBAN
24' I
2-3 E SHO
44' I
J-C-C
34' I
CURB LT
34± I
10 I SHO RT J CURB LT
2 NL
24' I
2-10 E I SHO
SAME

Form 6 HPS (Rev. 1961)

ROAD INVENTORY SHEET

Party Chief	E.S.
Recorder	W.D.
Chainman	T.L.

PHELPS COR

Road No.	CO 148
Name	BOCK RD
Sheet No.	4 OF 5
Date	10-4-68
County	PRINCE GEO

249

FAU SPOT — MINOR ARTERIAL-URBAN

		248	H	
5	H	247	H	
		245	H	
CO 2234				
HEMPSTEAD DR.		240	H	
	H	237		
	H	235	H	
MILL CROSSING RD		231	MILL CROSSING RD	
CO 5617		229	CO 95-114,115	
		228	H	
		224	H	
5	H	221	H	
PT		217		
35°				
PC		214		
				~~10 I~~
				~~2-3' ESHD~~
CO 1040				~~X~~ 44' I
HOLLY DR		211		J-CC
		208	PT	X
			80°	34' I
11	H	204	PC	1 CURB LT
				10' E SHLD
				RT
		188	H	X SAME
		CO 3324		
183 Steuben Ave				70-232

Form 6 HPS (Rev. 1961)

78

ROAD INVENTORY SHEET

Party Chief	E.S.
Recorder	W.D
Chainman	T.L.

Road No.	CO 148
Name	BOCK RD
Sheet No.	5 OF 5
Date	10-4-68
County	PRINCE GEO.

Form 5-HPS
(Revised 1961)

MARYLAND STATE ROADS COMMISSION
PLANNING AND PROGRAMMING DIVISION

S26130

IN COOPERATION WITH
U.S. BUREAU OF PUBLIC ROADS

BRIDGE SHEET

ROAD NO. Co 148
SHEET NO. 1A
PARTY NO.
DATE 10-4-68
COUNTY PRINCE GEO

RATED CAPACITY

FOR ALL STRUCTURES HAVING A TOTAL OPENING OF MORE THAN 20 FEET AS DEFINED IN NOTE 1.

ODOMETER READING 1.22 NAME OF STREAM, RAILROAD OR HIGHWAY CROSSED HENSON CK

NUMBER OF RAILROAD TRACKS
KIND OF CROSSING (NOTE 2)

UNDERPASS-SIMPLE | UNDERPASS-COMBINED (NOTE 3) | OVERPASS BRIDGE OVER SYSTEM STREAM

DESCRIPTION

NUMBER OF SPANS	LENGTH EACH SPAN (NOTE 4)	TYPE (NOTE 5)
2	28'	CONCRETE BEAM
1	60'	CONCRETE BEAM

TOTAL LENGTH-ON LINE OF ROAD OVER-ALL (NOTE 6) 116'

MATERIAL
SUBSTRUCTURE CONCRETE SUPERSTRUCTURE
FLOOR CONCRETE WITH BIT. MIX SURFACE

CLEARANCES
ROADWAY (NOTE 7) 28' SIDEWALK WIDTHS: RIGHT 4' LEFT 4'
SURFACE OF ROAD TO STREAM BED 8 FOR OVERPASSES, SHOW DISTANCES TO TOP OF RAIL OR SURFACE OF LOWER ROAD. (NOTE 8)
SURFACE OF ROAD TO BOTTOM PORTAL (MINIMUM OVERHEAD CLEARANCE
CLEAR DISTANCE OF OPENING ABOVE STREAM BED 6 (WATERWAYS ONLY)
POSTED LOAD LIMITS BRIDGE NO. CONSTRUCTION DATE 1959

GENERAL CONDITION OF BRIDGE: CHECK IF GOOD, FAIR, OR POOR, DESCRIBE DEFECTS IF SERIOUS.

	GOOD	FAIR	POOR
SUPERSTRUCTURE	✓		
FLOOR	✓		
SUBSTRUCTURE		✓	

PAINT BADLY CORRODED OR RUSTED
TYPE OF PROTECTION FOR DRAWBRIDGES (NOTE9)

(NOTES ON REVERSE SIDE)

S26130

Notes:

1. In agreement with Federal-aid standards, a bridge is defined as a structure including supports erected over a depression or an obstruction, as water, highway, or railway, and having a track or passageway for carrying traffic or other moving loads, and having a length measured along the center of roadway of more than 20 feet between undercoping of abutments or spring lines of arches, or extreme ends of openings for multiple boxes and pipes, where the clear distance between openings is less than half of the smaller contiguous opening.

2. Show kind of crossing by checking descriptive item applicable. For multiple-span bridges give complete information on each span including approach spans. Indicate on leg sheet the odometer reading, position, and angle of skew of structure with respect to center line of road and by arrow the direction of stream flow.

3. Give information on the span over the highway only.

4. For span length use center to center of bearings, otherwise the clear opening. Skew bridges will be measured along center line of road. See Note 1.

5. Show general type such as: Trestle, Truss, Girder, I-Beam, Rigid Frame, Arch, Slab, Suspension, or Covered Bridge. See illustrations attached. Describe draw spans by classifications listed in Article X, Section 2 of Manual.

6. The length of a bridge structure is the over-all length measured along the line of survey stationing back to back of back-walls of abutments, if present, otherwise end to end of bridge floor, but in no case less than the total clear opening of the structure.

7. Give minimum lateral clearance. Where traffic lanes are separated by bridge numbers, show clearance width of each lane separately. Special conditions should be explained by notes.

8. In case of overhead bracing or arch construction, measurement shall be made to the lowest point above the road surface.

9. Use classification listed on RR crossing sheets. Form 4 HPS.

Remarks:_____

A rearrangement of the form similar to that shown on the attachment may be used to provide space for coding.

Form 6 HPS (Rev. 1961)

1-588

Co 149

ROAD INVENTORY SHEET

Party Chief E. SCHUYLER
Recorder W. DOMGROSKI
Chainman

ver 5-9-78

MAP 2
844-449
M27

Road No. 67-11
Name FERNWOOD TURN
Sheet No. 1 OF 1
Date 5-16-69
County PRINCE GEORGES

Co 158 (67-12)
SILVERBIRCH 012 LA

011 PT
180°
002 PC

26 I
J G-C

Co 158 (67-12)
SILVERBIRCH 000 LA

Form 6 HPS (Rev. 1961) FAU 783-303 M39 4-057

ROAD INVENTORY SHEET

Party Chief E.S.
Recorder W.D.
Chainman

Gen Hwy
Accokeek
VER 6-28-77 MAP 12

Road No. Co 150
Name MARSHALL HALL RD
Sheet No. 1 OF 1
Date 8-7-68
County PRINCE GEO.

MD	140	227	18'I 2-3E S40
CHARLES Co.		LINE	
	061	END MAIN SIGN	A
	009	H	
	004	H	
CO		151	18'H 2-3E S40
OLD MARSHALL HALL	000	RD	

SHA 51.3-8
11-15-72

STATE HIGHWAY ADMINISTRATION OF MARYLAND

FAU

ROAD INVENTORY SHEET

1-78

Party Chief R. Bush (OFFICE INV)
Recorder
Helper

Map No. M 39 VER.
INDEX 12 6-28-77

Road No. CO 151
Road Name OLD MARSHALL HALL Rd
Sheet No. 1 OF 2
Date 8-7-68 REVISED 5-8-74
County PR. GEO.
State Coordinates 782-308

	1 95	OP 502 HIDDEN Valley Rd	
	1 86	18" cmp	
	1 76	30°	
	1 72	18" CMP	
	1 66	12" CMP	
30°	1 57		
	1 54		
	1 47	PVT FARM Rd	16'H 24'CW
~~(NEW)~~ MARSHALL HALL Rd. CO 150	1 39		X
N	0 82	DR	20'H 26'CW
ACCOKEEK CO	0 54	Rd. WEST 152	X
	0 51	12" CMP	
	0 16	DR	16'H 2-3'E Shld 26'C-W
LIVINGSTON CO	0 00	Rd 1201	

SHA 51.3-8
11-15-72

ROAD INVENTORY SHEET

Road No. Co 15-1
Road Name
Sheet No. 2 OF 2
Date
County
State Coordinates

OLD COLONIAL LA
CO. 3647

Old Colonial La
Co 3647

CACTUS HILL RD
O.P. 296

237
232
220
218
215
206
201
197

40°
30°
40°
30°
35°

SAME

Form 6 HPS (Rev. 1961) FAU 4-004 V >8

ROAD INVENTORY SHEET

Party Chief E.S.
Recorder W.D.
Chainman

63-4-004-152

790-303 M39

ACCOKEEK

LETTER 5-21-68
NAME CHANGE

MAP 12

Road No. CO 152
Name ACCOKEEK RD WEST
Sheet No. 1 OF 2
Date 8-7-68
County PRINCE GEO

	0 44	H	
	0 35	H	
H	0 30		
	0 28	H	
	0 25	H	
H	0 20		
	0 17	H	
	0 15	PT H	
		CO 665	
	0 12	ACCOLAWN RD	
		40°	
	0 11	PC	
H	0 09		
	0 07	H	
	0 04	H	
	0 01	H	
	CO EVINGTON		18' H
	0 00	170/RD	2.3 E S40

Form 6 HPS (Rev. 1961)

78

ROAD INVENTORY SHEET

Party Chief E.S.
Recorder W.D.
Chainman

Road No. C. 152
Name ACCOKEEK RD
Sheet No. 2 OF 2
Date 8-7-68
County PRINCE GEO

ROAD	H 300'	1 73	END	
		1 69	H	
		1 64	85°	
		1 61	H	
	H	1 54		
	H	1 40		
		1 30	OP 532 HICKORY HILLS LA	30°
				16" H
CO		151		2-3'ESHO
OLD MARSHALL HALL		089	ROAD	
	H	074		
		066	36" RCP	
		063		
	4 H	062	H	
		057		
	PT	050		
	30° PL	047		SAME

SHA 51.3 - 8 Revised
4.83

MARYLAND STATE HIGHWAY ADMINISTRATION

95-335T
BB/AH
3/29/96

SR-01
S-18-01
GD/EF

ROAD INVENTORY SHEET

Party Chief G. DAVIS
Recorder G. WILLIAMS
Assistant
Map No./Dir. H-11 / E
State Coordinates 795-303

Road No. Co 153 / MD 810-I
Road Name MANNING RD EAST
County PRINCE GEORGES
Date 8/12/93
Sheet No. 1 OF 2

BB/AL
8-28-97
ST R.I.

TRAFFIC CODES
TRAFFIC CONTROLS: STOP SIGN=SS, TRAFFIC LIGHT=T.L., FLASHING RED BALL=F.R.

TRAFFIC CODES
PARKING RESTRICTIONS: A.M. PEAK, P.M. PEAK, A.M./P.M. PEAK, NO PARKING ANYTIME=N.P., COMM/IND. ACCESS=E

SYSTEM				TRAFFIC		LINE DIAGRAM	TRAFFIC			PAVEMENT DATA
FED. AID.	FUNCT CLASS.	HWY. SYS.	HPMS SAMPLE	PRKG. REST.	COM/IND. ACCESS		CONTROL	COM/IND. ACCESS	PRKG. REST.	
	Rural local									18'1
		COUNTY maintained								2UML
						0|48			X	
										20'I
										2UML
						0|19			X	
						PT 30° 0|12 PC				
						0|09				18'H
										2UML
						0|05			X	
						MD 810-I				24'I
										2-8'I SHD
										2ML
						MD 210	SS		X	
	State Secondary					MANNING RD WEST 000 MD 810-I	SS		✓	

LINE DIAGRAM

SYSTEM: FED. AID. | FUNCT. CLASS. | HWY. SYS. | HPMS SAMPLE
TRAFFIC: PRKG. REST. | COM/IND ACCESS
TRAFFIC: CONTROL | COM/IND ACCESS | PRKG. REST.
PAVEMENT DATA

Rural local
County maintained

MENK RD
Co 5139
196
DUSTY LA
Co 1605
181
180
ROLLING TREE RD
169 Co 3319
163
134
127
(DENNY
MD)
MD
123
228
55
120
117
(FARMINGTON ND)
062
OP 642
90
180°
CLINTON DR
Co 4246
055

18' H
2UML
18' I
2UML
18' H
2UML
24' I
2-12' I
2ML
18' H
2UML

Form 6 HPS (Rev. 1961)

FAU 88-114/115/176 3-13-89 87-4 (STATE) EXTRA BB CG DT/TT 27-95 94-151 LX 78

ROAD INVENTORY SHEET

Party Chief E.S.
Recorder W.D.
Chainman

Gen Hwy
796-310 M39
ACCOKEEK 89-157 AT
MAP 12

Road No. CO 154
Name FARMINGTON RD
Sheet No. 1 OF 5
Date 8-8-68
County PRINCE GEO.

81-248

	H	0	61	
	H	0	54	
	CO 939			
	WHITE HALL AVE	0	52	POWER STA.
	CO 942			
	(2ND ST) APRIL ST	0	47	
		0	45	H
	~~OP 241~~			
	PVT CH. RD	0	42	
	H	0	40	
	H	0	37	
	H	0	35	(BISQUE ~~APRIL~~ ST)
		0	31	OP ~~CO~~ ~~(94-151)~~ 5086
	H	0	30	
	H	0	28	
	CAL	0	25	15'L, 32'W, 5'D
	H	0	09	
	CBC	0	06	4'L, 4'D, 26'W
	CO	0	03	1202 ~~+30~~ 40°
	LIVINGSTON	0	00	RD

FAU 5030 OTHER PRINCIPAL ART. - URBAN

30 15 40 0000 1 1994

12'I JCBRT 12'I JCBRT

0.72

18'I 34'CW
28'I
~~18'I~~ 23'E SHLD
~~28'I~~ 40'CW

Form 6 HPS (Rev. 1961)

95-34ST
BB/AH
3/07/96

DT/TT
11-17-94
94-83(ST)

78

ROAD INVENTORY SHEET

Party Chief E.S.
Recorder W.D.
Chainman

Road No. CO 154
Name FARMINGTON RD
Sheet No. 2 OF 5
Date 8-8-68
County PRINCE GEO

NON FA
LOCAL - RURAL

CO 1862
WANNAS DR 1136

145 H
142 H
138 H
133 H
131
18'E
125 0.50 Mi FARM
120 DR
107 H 400'
OR (CLOSED) 4385
087 SEWAGE PLANT ENTTO
0.03/16'I 085 H
MD 210 Service Rd. MD 210 T
082 210
0.06/16'I RI ISHD RT.
080 H 075
074
938
064
065 DR

17'I
24'CW
24'I
10'I SHL 40'
17'I CW
23'E SHD
14'CW
TL
24'I
2-10'I ISHD
2 PAL

4-217
4-218

FAU 5030
ART. - URBAN
PRIN.
OTHER
FIR
ST
CO

Form 6 HPS (Rev. 1961)

78

ROAD INVENTORY SHEET

Party Chief E.S.
Recorder W.D.
Chainman

Road No. Co 154
Name FARMINGTON RD.
Sheet No. 3 OF 5
Date 8-8-68
County PRINCE GEO.

			OP 89	
		1943	RESERVE RD	
		1933	H	
		1926	300' H	
		1916	DR	
		1892	DT 35° PC	
		1890		
NON FA	LOCAL-URBAN		CO 155 45° RT	
		1886	WHARF RD	
		1868	H	
		1860	CBC	
			12'F	
		1855	H 700'	
			CO 156	
		1854	FARMINGTON CK RD	
		1851	H	
			CO 738	
		1848	FORT TRAIL	
		1847	H	
		1846	400' H	SAME

Form 6 HPS (Rev. 1961)

78

ROAD INVENTORY SHEET

Party Chief E.S.
Recorder W.D.
Chainman

Road No. Co 154
Name FARMINGTON RD
Sheet No. 4 OF 5
Date 8-8-68
County PRINCE GEO

			H	294	
			H	292	
			CO ~~1555~~	1555	
			CEDAR (~~LA~~) ~~BLVD.~~	290 BLVD	18'I
					23'ESHD
					24'CW
				288	
				284	36'I JC-RT 2ML
				280	
				278 H	
			9 H		
				273 H	
NON FA	LOCAL-URBAN				
				271	
			H	266 H	
			CO	228	9'I
			BRYAN POINT	265 RD	24'CW 2ML
					55X
				262 H	
				260 H	
			CH & CEM	256 H	
				253 35° T	
				247 DR	
			H	245	SAME

Form 6 HPS (Rev. 1961)

18

ROAD INVENTORY SHEET

Party Chief E.S.
Recorder W.D.
Chainman

Road No. Co 154
Name FARMINGTON RD
Sheet No. 5 OF 5
Date 8-8-68
County PRINCE GEO

Form 6 HPS (Rev. 1961)

FAU

4-082

ROAD INVENTORY SHEET

796-310 M39

Gen Hwy

ACCOKEEK

VER 6-29-77 MAP 12

Party Chief E.S.
Recorder W.D.
Chainman

Road No. Co 155
Name WHARF RD
Sheet No. 1 OF 11
Date 8-19-68
County PRINCE GEO

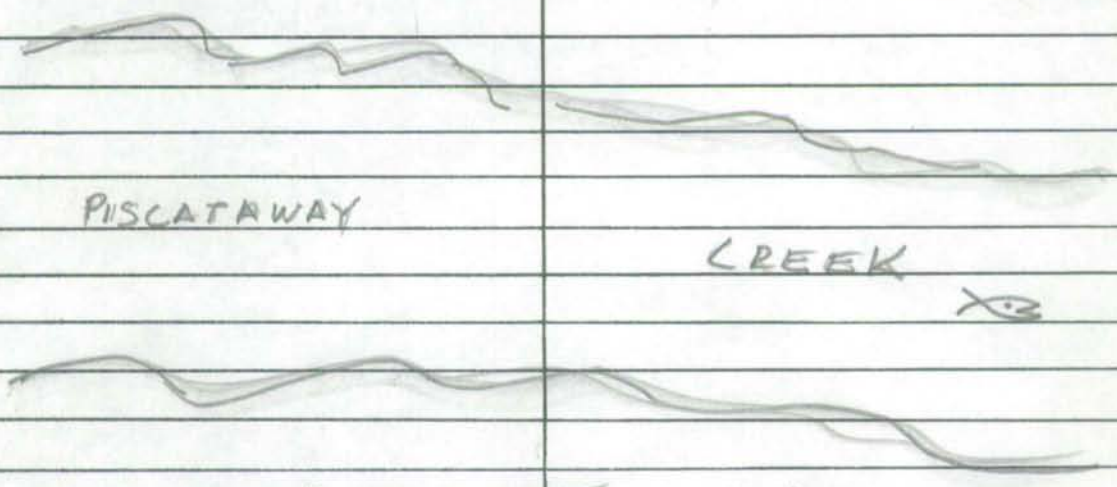

ROAD 0 65 END

H 0 57

0 55 H

PISCATAWAY NATIONAL 0 34 PARK

0 20 H

0 23 H

H 400' 0 15

18'H
2-3E SHO

154
RD

Co.
~~PORTINGTON~~
FARMINGTON 0 00

Form 6 HPS (Rev. 1961) FAU VER 76-77 4-032 78

ROAD INVENTORY SHEET

Party Chief E.S.
Recorder W.D.
Chainman

Gen Hwy
797-310 m39
ACCOKEEK
MAP 12

Road No. CO 156
Name FARMINGTON CK RD
Sheet No. 1 OF 1
Date 8-19-68
County PRINCE GEO.

Form 6 HPS (Rev. 1961)

FAU MAP 12

H-011-B

SR 93 GD GW 7-22-93

95-33 ST BRIDGE 3/4 96

78

ROAD INVENTORY SHEET

Party Chief E.S.
Recorder W.D.
Chairman

Gen Hwy SR-01 7-16-01 GD/SF

Road No. CO 157
Name BEALES HILL RD
Sheet No. 1 OF 2
Date 8-19-68
County PRINCE GEO

BB84-105 Rm 3-11-86 N ACCOKEEK 801-301 H-11 ~~H154~~ VER 6-29-77

25 I

						2-10' EWB 2 ML
		H	0	68		X
		H	0	59		
		H	0	56	H	
		H	0	51		
					CO ~~OP 293~~ 4645	
			0	45	NEWASH A LA DR	
			0	42	H	
			0	39	H	
1193	5	H	0	37	H	
			0	34	H	
FAS		H	0	23		
		H	0	21		
		H	0	19	H	
		H	0	~~18~~ 17	H Bucl Dr	
				15	Co. 4646	
		H	0	14		
		H	0	12		
		H	0	11	H	20' X I
			0	00	373	✓ 28'C-W

NOW FA MINOR COLLECTOR - RURAL

DS

Form 6 HPS (Rev. 1961)

96-3 ST
DB/MG
3-20-97

78

ROAD INVENTORY SHEET

Party Chief E.S.
Recorder W.D.
Chainman

BB/AL
8-28-97
ST R.I.

Road No. CO 157
Name BEALLEY HILL RD
Sheet No. 2 OF 2
Date 8-19-68
County PRINCE GEO

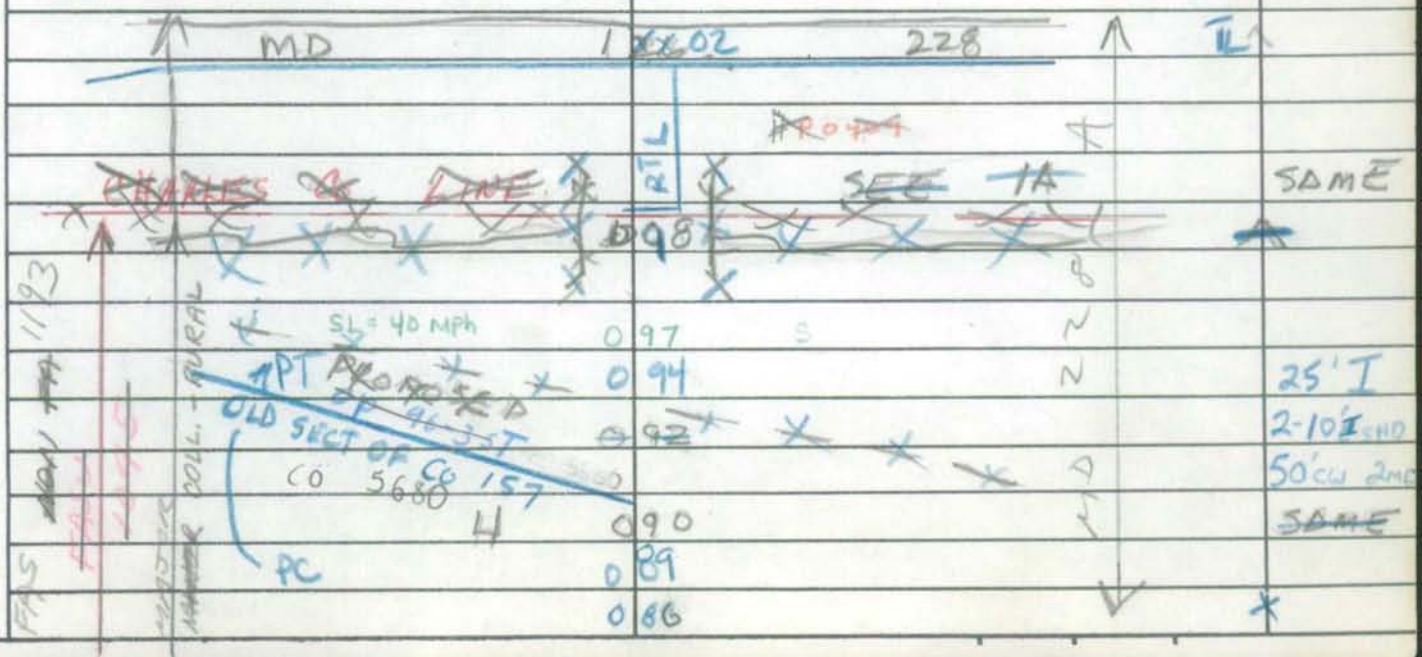

Form 5-HPS (Revised 1961) MARYLAND STATE ROADS COMMISSION PLANNING AND PROGRAMMING DIVISION S26130

IN COOPERATION WITH
U. S. BUREAU OF PUBLIC ROADS

BRIDGE SHEET

ROAD NO. Co 157

SHEET NO. 1A

PARTY NO.

DATE 8-19-68

COUNTY PRINCE GEO

RATED CAPACITY

FOR ALL STRUCTURES HAVING A TOTAL OPENING OF MORE THAN 20 FEET AS DEFINED IN NOTE 1.

ODOMETER READING 1.08 NAME OF STREAM, RAILROAD OR HIGHWAY CROSSED

NUMBER OF RAILROAD TRACKS

KIND OF CROSSING (NOTE 2)

UNDERPASS-SIMPLE UNDERPASS-COMBINED (NOTE 3) OVERPASS BRIDGE OVER SYSTEM

DESCRIPTION

NUMBER OF SPANS	LENGTH EACH SPAN (NOTE 4)	TYPE (NOTE 5)
1	36"	CONCRETE SLAB
1	17'	CONCRETE SLAB

TOTAL LENGTH-ON LINE OF ROAD OVER-ALL (NOTE 6) 53'

MATERIAL

SUBSTRUCTURE CONCRETE SLAB SUPERSTRUCTURE

FLOOR

CLEARANCES

ROADWAY (NOTE 7) 12' SIDEWALK WIDTHS: RIGHT NONE LEFT

SURFACE OF ROAD TO STREAM BED 6' FOR OVERPASSES, SHOW DISTANCES TO TOP OF RAIL OR SURFACE OF LOWER ROAD. (NOTE 8)

SURFACE OF ROAD TO BOTTOM PORTAL (MINIMUM OVERHEAD CLEARANCE

CLEAR DISTANCE OF OPENING ABOVE STREAM BED 4" (WATERWAYS ONLY)

POSTED LOAD LIMITS 6000 BRIDGE NO. CONSTRUCTION DATE

GENERAL CONDITION OF BRIDGE: CHECK IF GOOD, FAIR, OR POOR, DESCRIBE DEFECTS IF SERIOUS.

	GOOD	FAIR	POOR
SUPERSTRUCTURE			✓
FLOOR			✓
SUBSTRUCTURE			✓

PAINT BADLY CORRODED OR RUSTED

TYPE OF PROTECTION FOR DRAWBRIDGES (NOTE 9)

(NOTES ON REVERSE SIDE)

S26130

Notes:

1. In agreement with Federal-aid standards, a bridge is defined as a structure including supports erected over a depression or an obstruction, as water, highway, or railway, and having a track or passageway for carrying traffic or other moving loads, and having a length measured along the center of roadway of more than 20 feet between undercoping of abutments or spring lines of arches, or extreme ends of openings for multiple boxes and pipes, where the clear distance between openings is less than half of the smaller contiguous opening.

2. Show kind of crossing by checking descriptive item applicable. For multiple-span bridges give complete information on each span including approach spans. Indicate on leg sheet the odometer reading, position, and angle of skew of structure with respect to center line of road and by arrow the direction of stream flow.

3. Give information on the span over the highway only.

4. For span length use center to center of bearings, otherwise the clear opening. Skew bridges will be measured along center line of road. See Note 1.

5. Show general type such as: Trestle, Truss, Girder, I-Beam, Rigid Frame, Arch, Slab, Suspension, or Covered Bridge. See illustrations attached. Describe draw spans by classifications listed in Article X, Section 2 of Manual.

6. The length of a bridge structure is the over-all length measured along the line of survey stationing back to back of back-walls of abutments, if present, otherwise end to end of bridge floor, but in no case less than the total clear opening of the structure.

7. Give minimum lateral clearance. Where traffic lanes are separated by bridge numbers, show clearance width of each lane separately. Special conditions should be explained by notes.

8. In case of overhead bracing or arch construction, measurement shall be made to the lowest point above the road surface.

9. Use classification listed on RR crossing sheet. Form 4 HPS.

Remarks: _____

A rearrangement of the form similar to that shown on the attachment may be used to provide space for coding.

Form 6 HPS (Rev. 1961)

1-580 L 78

Co. 158

ROAD INVENTORY SHEET

Party Chief E. SCHUYLER
Recorder W. DOMARDSKI
Chainman

VER 5-9-78

MAP 2
PART 1

843-447 MZ7

Road No. 67-12 Co158
Name SILVERBIRCH LA
Sheet No. 1 OF 2
Date 5-16-69
County PRINCE GEORGES

		CO (67-13) 781
	056	ETHAN CT
PT 50° PC	054	
	052	
		CO (67-14) 209
	047	LAWNVIEW LA
		CO (67-16) 280
	040	TWIN HILL LA
		CO (67-17) 339
	035	EASTGATE LA
	030	CO (67-19) 753
	027	RADNOR LA
PT 50° PC	020	
	017	
(67-20) (68-60) CO2602 GOLDEN PASS	016	
	@.38	CO (67-19) 753
	012	RADNOR LA
PT 80° PC	007	
	005	
CO MT PLEASANT	751 (6018) PR 000	

26 1/2
JC-C

Form 6 HPS (Rev. 1961)

>8

ROAD INVENTORY SHEET

CO 158

Party Chief E. SCHUYLER
Recorder W. DOMBROSKI
Chainman

Road No. 67-12
Name SILVER BIRCH CA
Sheet No. 2 OF 2
Date 5-16-69
County PRINCE GEORGES

CO	70 (68-45)	
MONTPELIER	072 PR	
	069 PT	
	CO (67-11) 149	
	067 FERNWOOD TURN	
	75°	
	CO (67-11) 149	
	062 FERNWOOD TURN	
	060 PC	SAME

Form 6 HPS (Rev. 1961)

FAR

4-029

BC 181 BB 3-17-87 TR

85-180 & 193 BB/AL 3-7-86

ROAD INVENTORY SHEET

Party Chief E.S.
Recorder W.D.
Chainman

~~Gen Hwy~~

BRANDYWINE

VER 6-27-72

~~MAP 13~~

847-322 H-12 & H-11

Road No. CO 159
Name DYSON RD
Sheet No. 1 OF 3
Date 7-25-68
County PRINCE GEO

LOCAL / URBAN / FAA / NON / RURAL

			1	12	OP 280
			1	10	18" CMP
	CO 166				OP 582
	MISSOURI AVE		1	08	
	B-ELEC. CO		0	98	
	BUSINESS (~~LUNCH ROOM~~) (GARAGE)		0	90	19'I
					2-3 E SHO
	US				(SO/L) X
			6	84	301 20'I
					2-6 E SHO
X	US		0	75	301 → (NB/L) X
	CO 2717				
	EAST SHELBY LA		0	68	
		PT	0	62	
		40°			
		PC	0	58	
			0	52	35° T
		H	0	49	
		H	0	40	
		~~H~~ H	0	~~37~~ 40	
	CHELTENHAM DR				
	93-EX ~~OF 2169~~ CO 2716		0	32	
		~~H~~	0	~~24~~ 26	
		H	0	24	22'I 26'CW
		H	0	10	
			0	07	~~22'I~~ X ~~H~~ D
	CO CHERRY TREE		0	∞ 167	~~23C 340~~ 112'F SHD LT
					xing ~~ROAD~~ Rd

Form 6 HPS (Rev. 1961)

78

ROAD INVENTORY SHEET

Party Chief E.S.
Recorder W.D.
Chainman

Road No. CO 159
Name DYSON RD
Sheet No. 2 OF 3
Date 7-25-68
County PRINCE GEO

	226	18" CMP	
FARM 500'	207	400' FARM	
	204	18" CMP	
	202	GWYNN PARK J.H.S.	
	197	30°S	
PT 35° PC	192		
	190		
	177	5 H	
	164		
	160	H	
	158	H	
	156	H	
	147	PROPOSED	20' I
	145		30' CW 2 ML X 24' I 4° C-RT
		CO 2182	
	134	LUSBY'S LA	X
	128	PT 20°	
	125	PC	SAME

RTA
NON LOCAL
URBAN

Form 6 HPS (Rev. 1961)

ROAD INVENTORY SHEET

Party Chief E.S.
Recorder W.D.
Chainman

Road No. CO 159
Name DYSON RD
Sheet No. 3 OF 3
Date 7-24-68
County PRINCE GEO

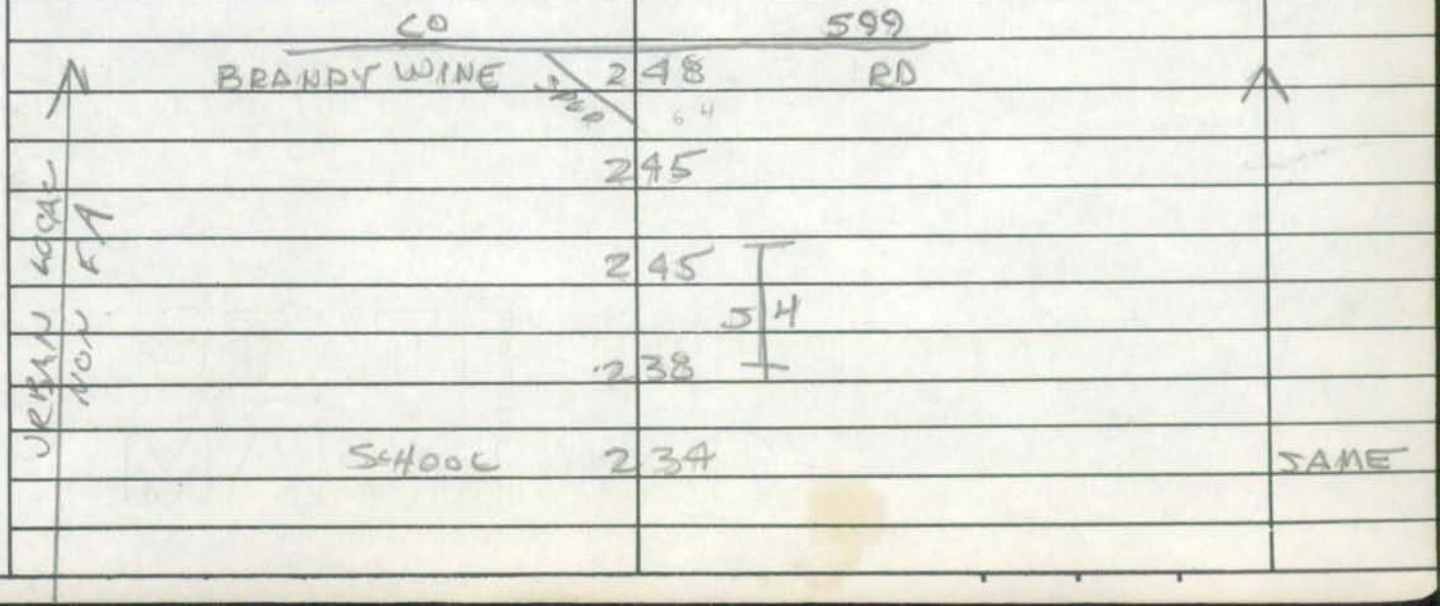

Form 6 HPS (Rev. 1961)

FAU

4-048 78

ROAD INVENTORY SHEET

SHARPERVILLE RD

Party Chief E.S.
Recorder W.D.
Chainman

Gen Hwy
807-305 M39
SHARPERVILLE

Road No. CO 160
Name ~~MIDDLETOWN RD~~
Sheet No. 1 OF 1
Date 7-31-68
County PRINCE GEO.

VER 6-28-77 MAP 12

MD

1 76 228

0 91 ~~PP406~~

CHARLES CO. LINE

MATTAWOMEN CREEK

0 90 #PP406

0 89 END MAINTANCE SIGN 16'G

0 42 X 24'CW 2ML

0 13 H

0 06 PT 50° 20'E

0 04 PC 24'CW

MD 0 00 373

Form 6 HPS (Rev. 1961) FAD 4-016 L 78

ROAD INVENTORY SHEET

Party Chief E.S.
Recorder W.P.
Chainman

803-336 M35
FRIENDLY FARMS
VER 7-14-77 MAPG

Road No. CO 161
Name BROADVIEW RD
Sheet No. 1 OF 1
Date 9-23-68
County PRUCE CO

CO 118
OLD FT 043 RD
042 H
PT 040
90° H 039
PC 036
H 033
7 4
CO 162
CENTENIAL 031
026
G H
018
014 MEDICAL CENTER
010 H
H 008
CO H 006
CENTENIAL 162
@ 00 001
MD 60 000
OLD PALMER
121 210 I
RD
16 I
23 E SH

Form 6 HPS (Rev. 1961) FAU 4-020 78

ROAD INVENTORY SHEET

Party Chief E.S. · 803-336 M35
Recorder W.D.
Chainman

FRIENDLY FARMS

VER 7-14-77 MAP 9

Road No. CO 162
Name CENTENNIAL DR
Sheet No. 1 OF 1
Date 9-23-68
County PRINCE GEO

CO BROADVIEW 0 @ 31 35 161 RD

H 034

90° 032

H 024

20° 021

H 018

009

H

H 807

H PT 75° 003

H PC 001

@ 01 161 (1)

CO BROADVIEW 000

16 I
I-3E SH

Form 6 HPS (Rev. 1961)

FAR

4-007

78

ROAD INVENTORY SHEET

Party Chief E.S.
Recorder W.D.
Chainman

Gen Hwy
MAP 40
858.305
VER 6-23-77

MAP 13

Road No. Co 163
Name ASHBOK RD
Sheet No. 1 OF 2
Date 7-24-68
County PRINCE GEO

	0	62	RXR	
	0	61	H	
	0	55	DR	
	0	52	H	
	0	48	DR	
H	0	45	H	
	0	43	DR H	
H	0	41	H	
H	0	39		
H	0	34		
H	0	31		
H	0	27	DR	
	0	20	FARM	
H	0	18		
	0	16	H	19 I
				2-3'E 540
MD	0	00	381	✓

Form 6 HPS (Rev. 1961)

78

ROAD INVENTORY SHEET

Party Chief E.S.
Recorder W.D.
Chainman

Road No. Co 163
Name ASHBOX RD
Sheet No. 2 OF 2
Date 7-24-68
County PRINCE GEO

	185 ROAD	
CO CEDARFIELD	67	A
BUSINESS (GAS STA) D	65 H	SAME

Form 6 HPS (Rev. 1961)

FAR

4-074

ROAD INVENTORY SHEET

Party Chief E.S.
Recorder W.D.
Chainman

837-313 M39
Gen Hwy

Road No. CO 164
Name SHORT CUT RD
Sheet No. 1 OF 1
Date 7-24-68
County PRINCE GEO.

VER 6-27-17

MAP 13

MD	0	44	381
BUSINESS - USED TRUCKS	0	41	
	0	39	H
CBC	0	19	6'L, 30'W, 5'D
H	0	13	
H	0	11	3 H
	0	08	
US	0	00	301

18'I
2-3'ES46

SHA 51.3-8
11-15-72

STATE HIGHWAY ADMINISTRATION OF MARYLAND

(92-97-98)
GD/AH/3-18-93

ROAD INVENTORY SHEET

Party Chief R. Bush
Recorder
Helper

Map No. M 35 Index 9

Road No. Co. 165
Road Name ST. BARNABAS RD.
Sheet No. 1 of 1
Date 4-26-74
County PRINCE GEORGES
State Coordinates 806 - 353

WB LC 3-12-80

90-156

Rewritten 11-2-84 KJP

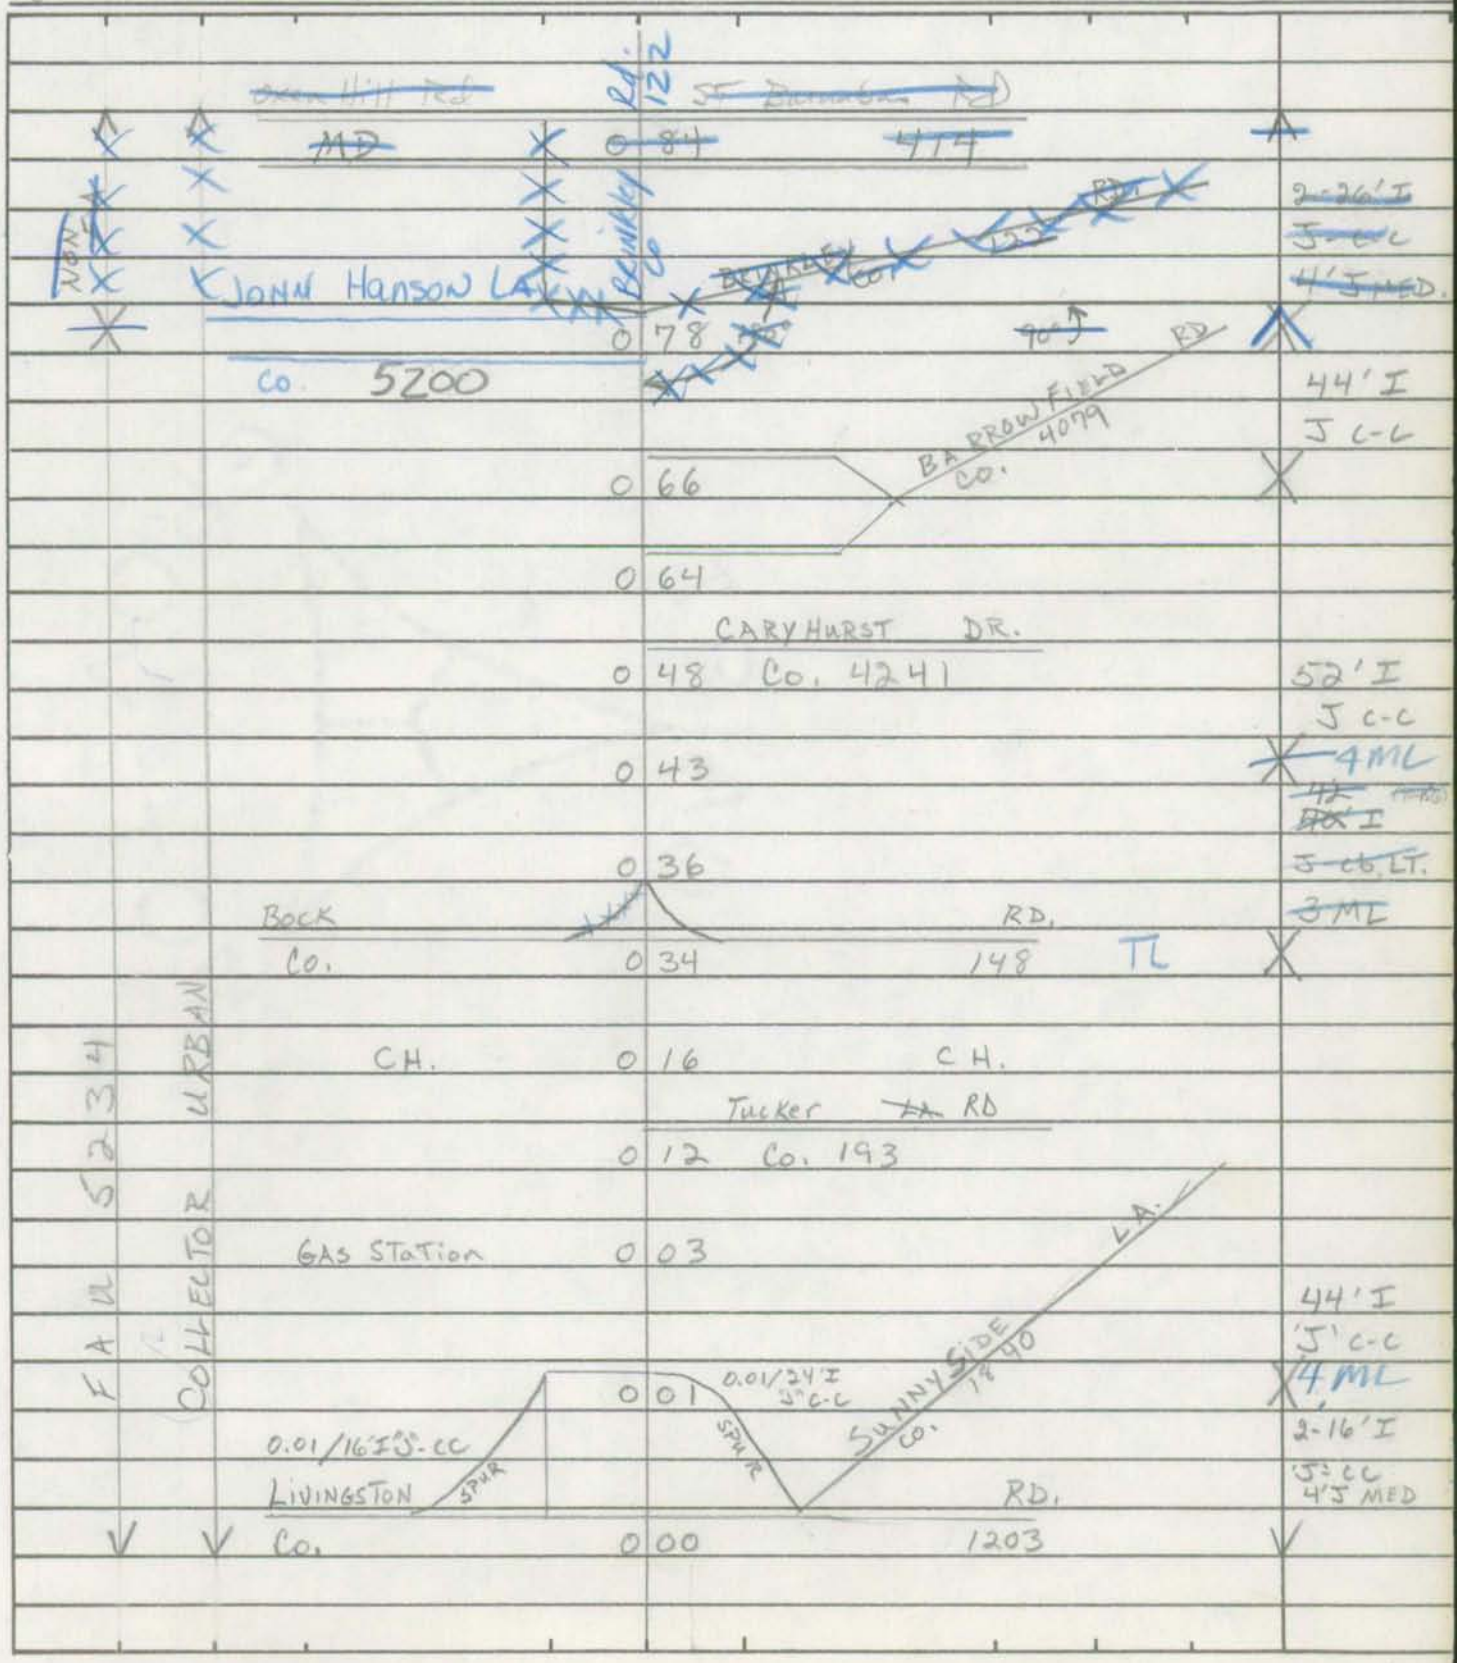

SHA 51.3-8
11-15-72

ROAD INVENTORY SHEET

Road No. _____
Road Name _____
Sheet No. _____
Date _____
County _____
State Coordinates _____

Form 6 HPS (Rev. 1961) FAR 4-050 78

ROAD INVENTORY SHEET

Party Chief E.S.
Recorder W.D.
Chainman

Gen Hwy

BRANDYWINE
842-321 M39

VER 6-23-77 MAP 13

Road No. CO 166
Name MISSOURI AVE
Sheet No. 1 of 2
Date 7-26-68
County PRINCE GEO.

				~~18'I~~
US		086	301 → NUB	~~2-3'E 540~~ 72-297
	H	076	PT	
			35°	
		073	PC	
		059	DR.	
	H	046		
		044	H	
	H 300'	033		
		031	H	
		024	H	
	H 600'	019		
		013	60" CMP	
		009	T	
	H	006	3 H	
		005	⊥	
	CH.	002	POST OFFICE	20'I
				2-3'E SHO
MD		000	381	30' CU
				2ML

FAJ 385

Form 6 HPS (Rev. 1961)

ROAD INVENTORY SHEET

Party Chief E.S.
Recorder W.D.
Chainman

Road No. CO 166
Name MISSOURI AVE
Sheet No. 2 OF 2
Date 7-26-68
County PRINCE GEO.

H ROAD	200	END H	
	192	PT (90°)	
	188	PC	9'E
			9'CW
	172		X
			18"E
CO		159	18'CW
DYSON	121	RD	X
H	119		
US		301 455	SLME
	101	DR. 18" CMP	

SHA 51.3-8
11-15-72

STATE HIGHWAY ADMINISTRATION OF MARYLAND

78

85-192 BB/AL 3-7-86

ROAD INVENTORY SHEET

Party Chief W.D. (E.S.)
Recorder M.Z. (W.D.)
Helper

Map No. H-12 / H-11 83-174 AH

Road No. Co. 167
Road Name CHERRY TREE XING RD
Sheet No. 1 OF 5
Date VER. 6-20-77 (FROM 7-25-68)
County PR. GEO.
State Coordinates 849-326

RURAL LOCAL	0 35	H	20'H
			30'CW
	0 33	H	X 2ML
30° CROSS ROAD TRAIL CO 168	0 31		
180°	0 28		
	0 27	RXR	
RXR RD. MKGS.	0 24	CR	
RXR		# PC 532 289 K	
	0 23	RXR	
	0 22	RXR RD. MKGS.	
H	0 19	RXR	
	0 18	H	
H	0 14		
RURAL MINOR COLLECTOR			18'I
	0 11	H	2-3'E SHD
			26'CW
PT 60° PC	0 10		X 2ML
			26'I
	0 08		2-6'E SHD
			40'CW
US	0 00	301	V

SHA 51.3-8
11-15-72

ROAD INVENTORY SHEET

Road No. Co. 167
Road Name CHERRY TREE XING RD
Sheet No. 2 of 5
Date 6-20-77
County P.G.
State Coordinates

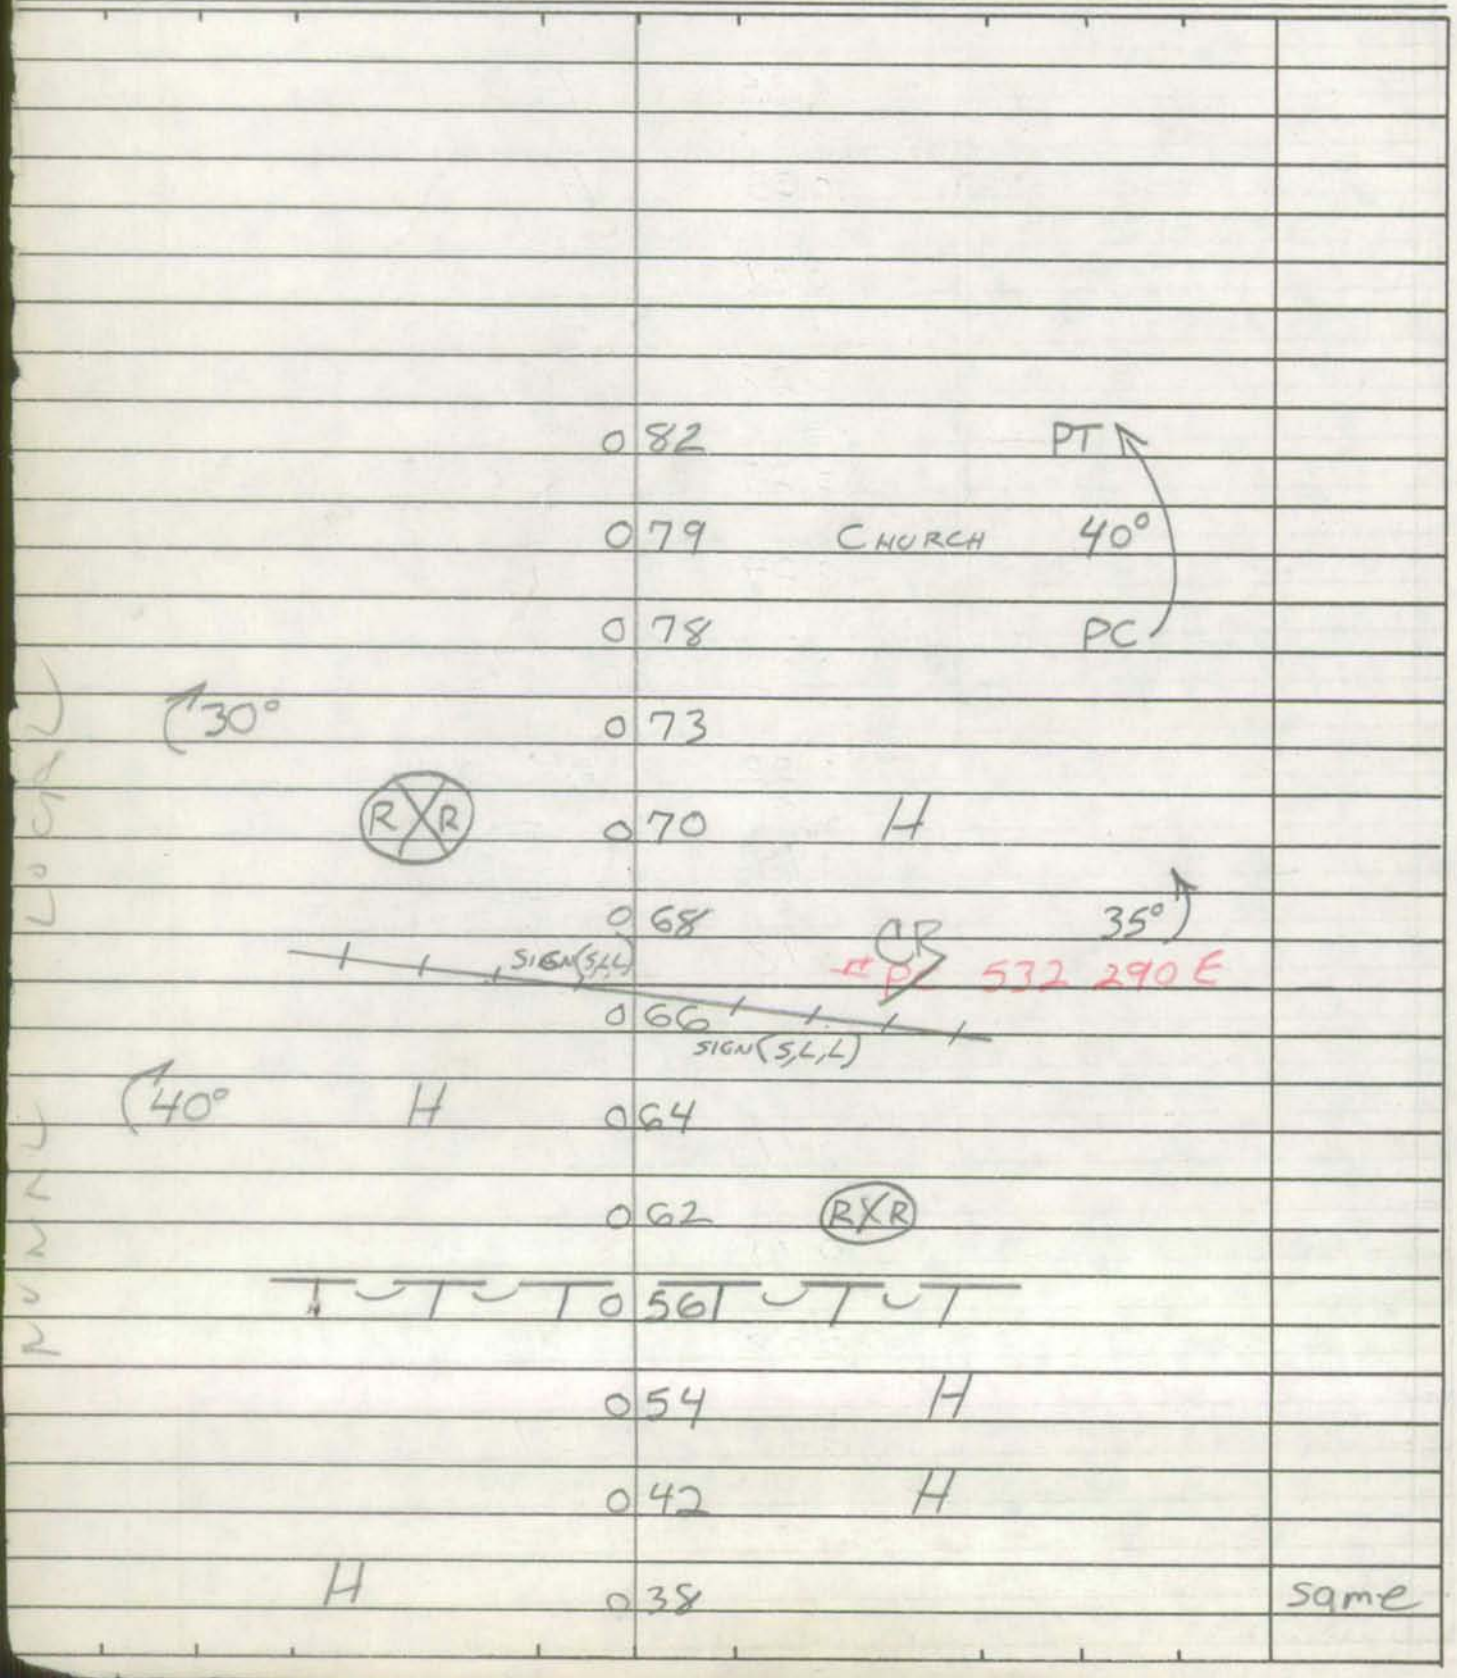

SHA 51.3-8
11-15-72

STATE HIGHWAY ADMINISTRATION OF MARYLAND

78

ROAD INVENTORY SHEET

Party Chief W.D.
Recorder M.Z.
Helper

Map No.

Road No. Co. 167
Road Name CHERRY TREE XING RD
Sheet No. 3 OF 5
Date 6-20-77
County P.G.
State Coordinates

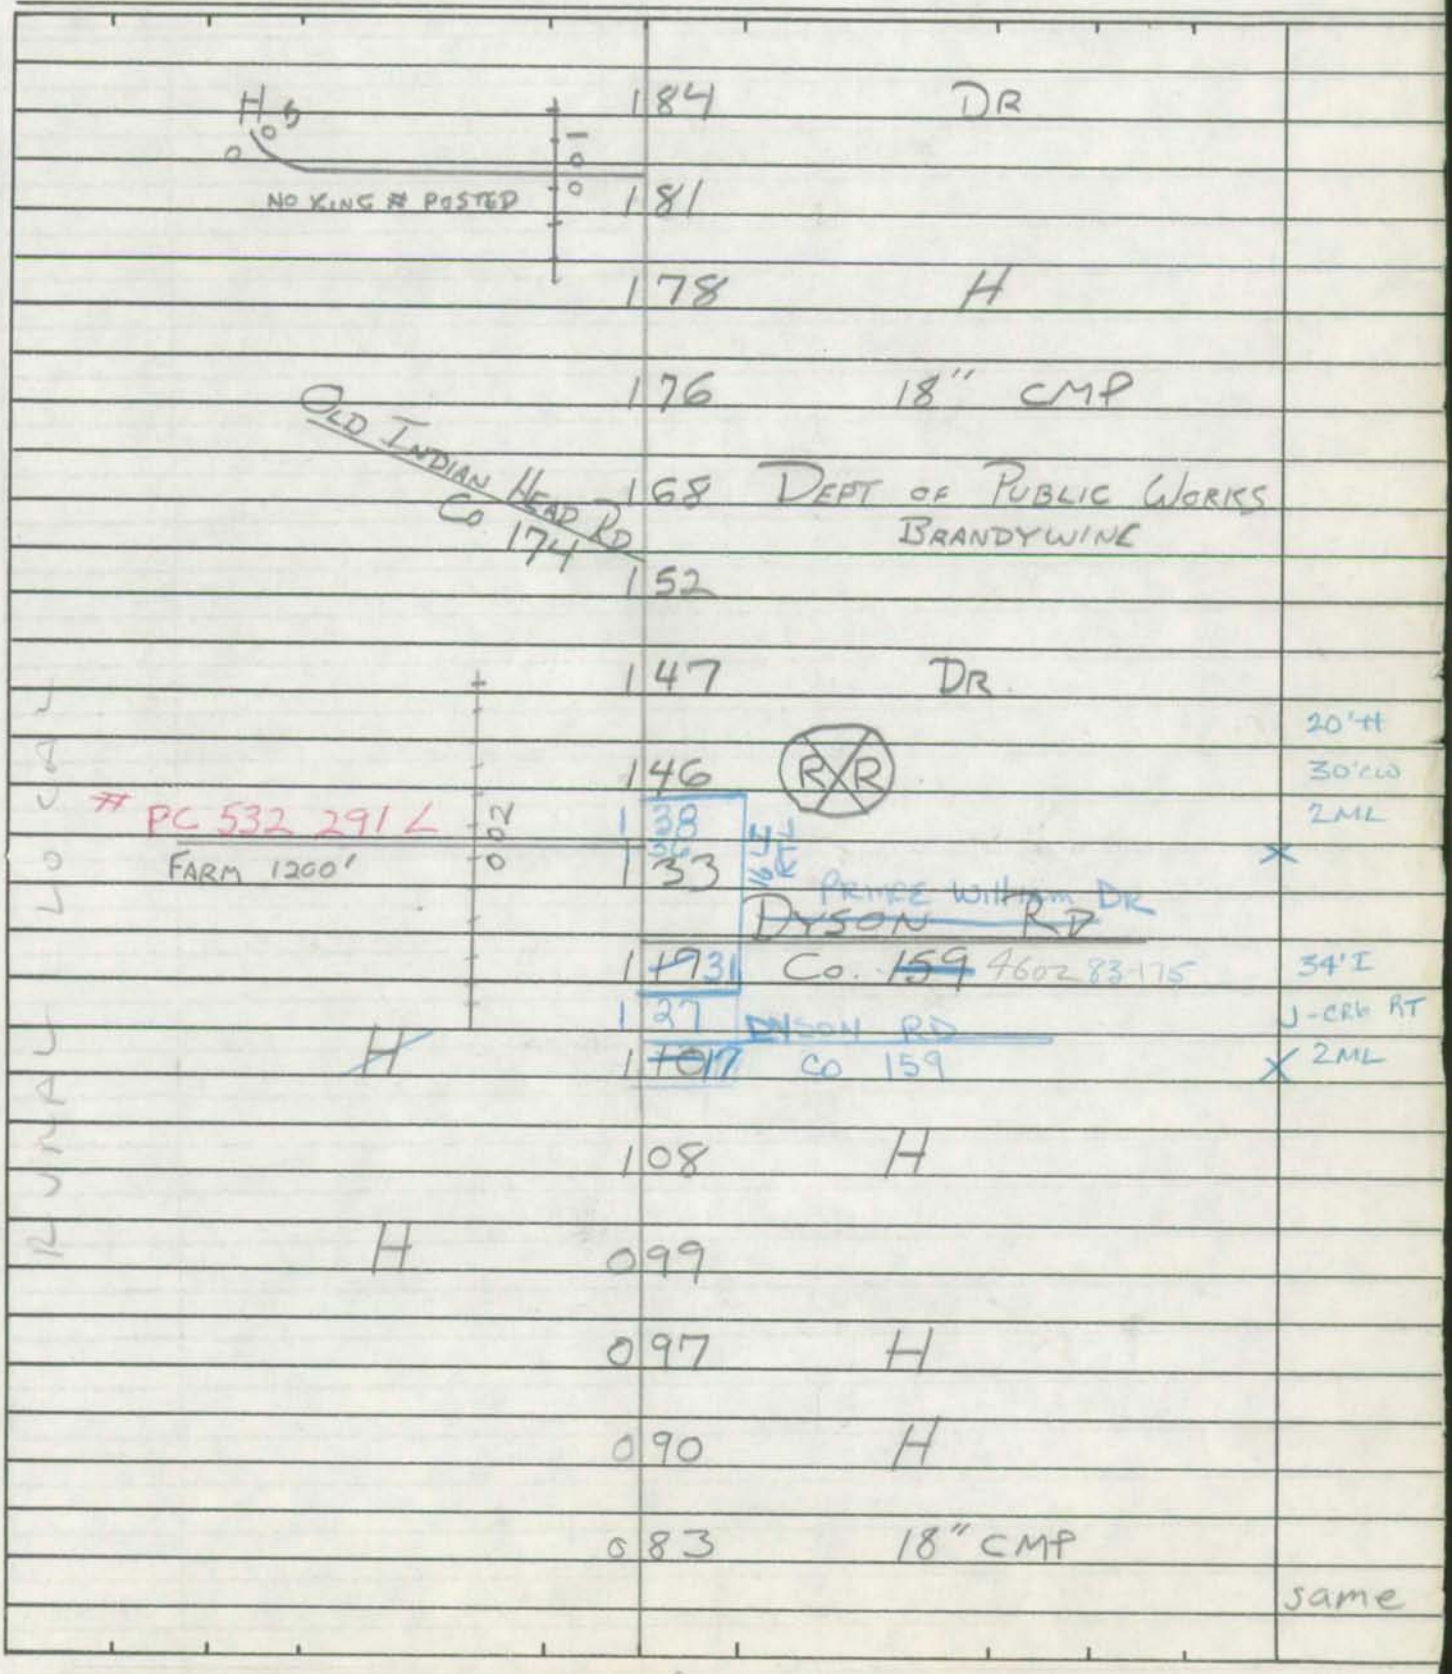

SHA 51.3-8
11-15-72

ROAD INVENTORY SHEET

Road No. Co. 167
Road Name Cherry Tree Xing Rd.
Sheet No. 4 of 5
Date 6-20-77
County P.G.
State Coordinates

	259	18" CMP
PT 35° PC	254	
	252	
	246	GAS STA. FUEL OIL TANKS
	235	H
	229	AMER. LEGION HALL
	225	18" CMP
	216	H
	212	H
	209	H
	205	18" CMP
H	200	H
H	194	
	188	H
	186	H

RURAL ROAD

SHA 51.3-8
11-15-72

STATE HIGHWAY ADMINISTRATION OF MARYLAND

78

ROAD INVENTORY SHEET

Party Chief W.D.
Recorder M.Z.
Helper

Map No.

Road No. Co. 167
Road Name CHERRY TREE XING RD.
Sheet No. 5 OF 5
Date 6-20-77
County P.G.
State Coordinates

	MD	381	
	280		
	274	H	
H	272		
	264		35°
		BANK ST	
	261	Co. 3152	same

SHA 51.3-8
11-15-72

ROAD INVENTORY SHEET

Road No. _____
Road Name _____
Sheet No. _____
Date _____
County _____
State Coordinates _____

P & P 104

RAILROAD GRADE CROSSING SHEET

State Roads Commission of Maryland
Planning and Programming Division

1. GENERAL

Crossing No. 004

Mile Pole Number (R.R. Co.) ... NONE

Coordinates ..... x 848 y 324

System Classification (Check One)

- State Primary ..... ☐
- State Secondary ..... ☐
- State Road Only ..... ☐
- County ..... ☑
- Local ..... ☐ (Specify)

County and/or Municipality .. PRINCE GEORGES

U.S. Route Number .....

State Route Number .....

Road Number/Name ..... Co 167 CHERRY TREE CROSS RD

Station .....

Surface Type ..... 16' F

Name of Railroad ..... PENN CENTRAL

Number of Main Tracks 1

Number of Other Tracks ..... NONE

2. TRAIN MOVEMENTS

Time Period	Pass	Freight	Train Speed at Grade: Pass	Train Speed at Grade: Freight	Spur	Remarks (Other than daily): Pass	Remarks (Other than daily): Freight
Day 6 A.M. to 6 P.M.							
Night 6 P.M. to 6 A.M.							
24 Hour Total							

3. TYPE OF PROTECTION

a. 4 Warning Signs - Reflectorized / (Non-reflectorized)

b. — Crossing Signs - Reflectorized, Non-reflectorized

c. — Road Marking

d. — Lights - Flashing, Stationary

e. — Traffic Control (Stop and Go) Signals

f. — Automatic Gate

g. — Watchman - Gate, Flag...hours

h. — Others

* By numerals 1 or 2 indicate whether installation is on one or both sides of track.

4. ALIGNMENT FACTOR

P. 200'

N. 600'

Average Daily Trains ...

Train Speed .....

Highway ADT.....

Highway Speed Limit ...

Average Vehicle Speed . 30 MPH

Max. Approach Grade .. N. +1.0 P. +1.6

Restricted Sight Distance . (On Highway) NO

5. QUADRANT ... SIGHT DISTANCE

		@300'	@10'
A	45°	0	50'
B	135°	0	300'
C	135°	0	300'
D	45°	0	50'

6. ACCIDENT RECORD (Vehicles & Trains)

Year	No. of Accidents	No. of Fatalities
1961		
1962		
1963		
1964		
1965		
Total		

7. CROSSING RATING

A

B

C

D

Total

State Roads Commission of Maryland
Planning and Programming Division

Party _____
Date 10/29/69

DIAGRAM FOR RAILROAD GRADE CROSSING

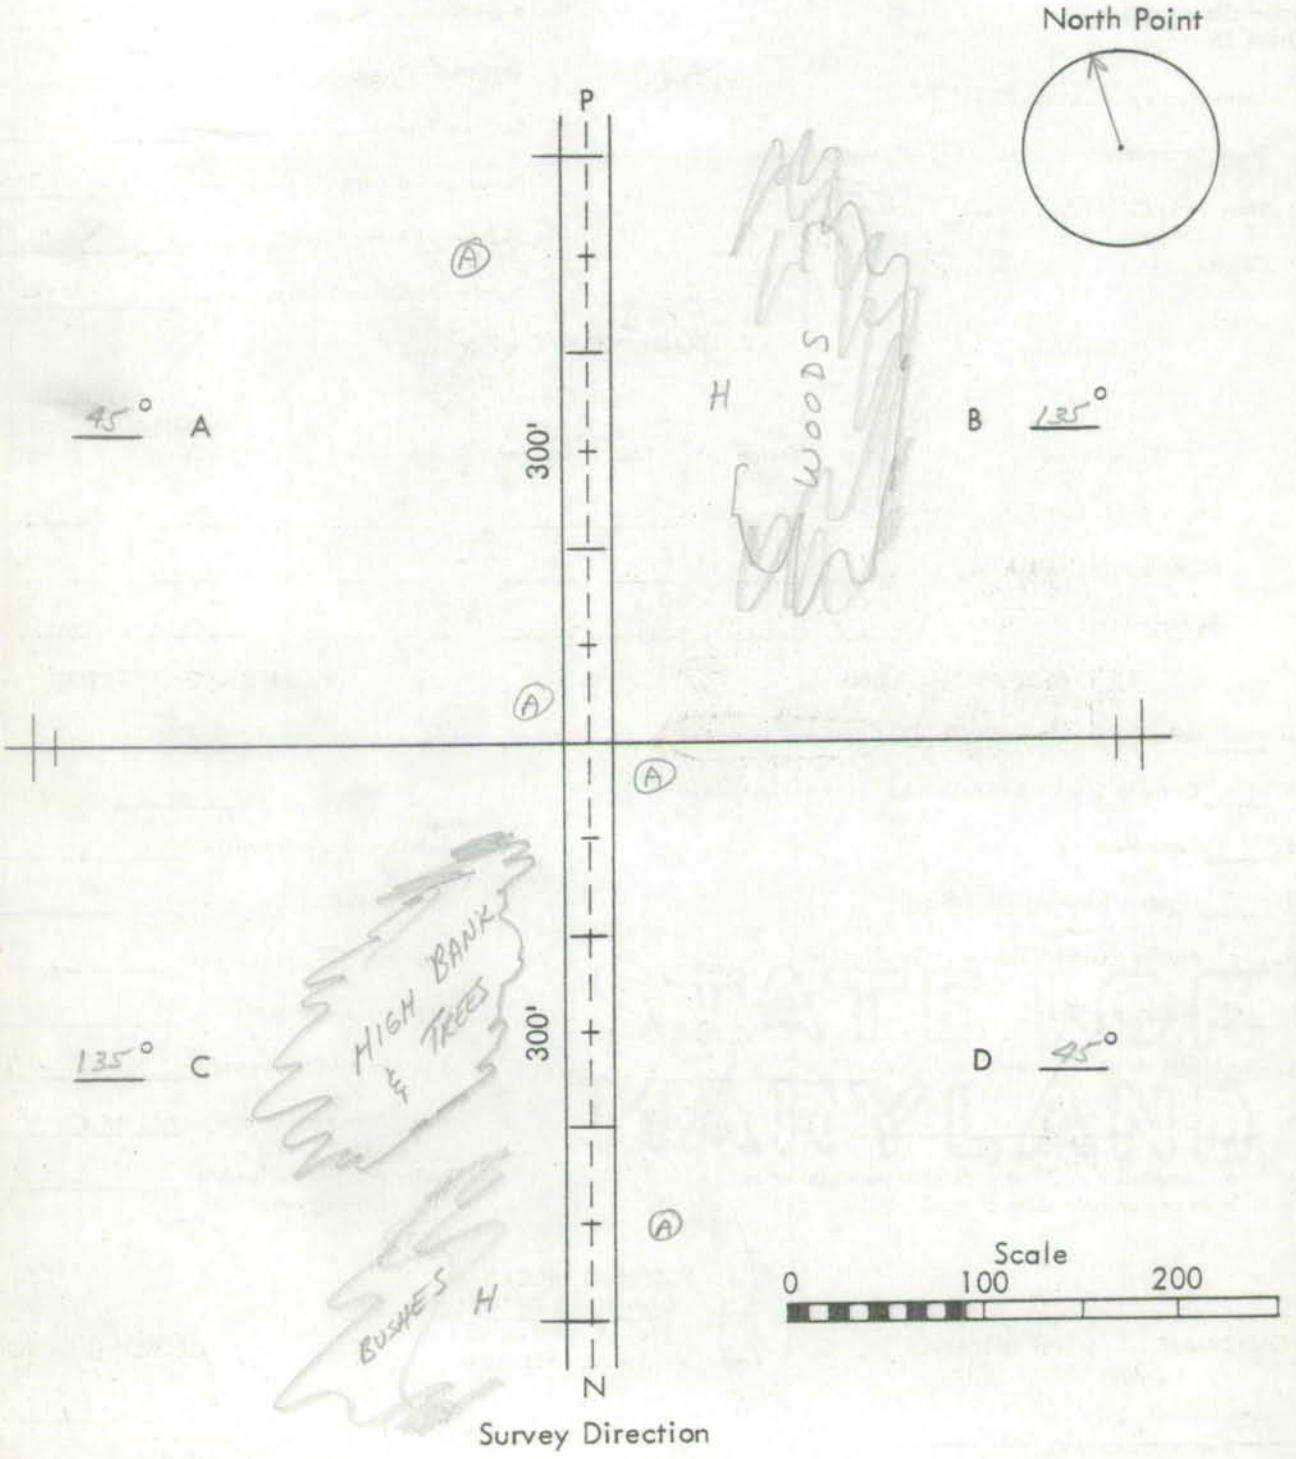

Survey Direction

Remarks: No 300' SIGHT DISTANCE ON ANGLES "A" AND "D" BECAUSE THE ROAD PARALELLS THE TRACK

CROSSING
004

COUNTY #167
CHERRY TREE CROSSING RD

TURN PICTURES OVER

1

2

3

4

STOP

PRINCE GEORGES Co 10/29/69

PICTURE TAKEN FACING SOUTH

ON Co 167 CHERRY TREE CROSS RD

J932282

1

PRINCE GEORGES Co 10/29/69

PICTURE TAKEN FACING NORTH

ON Co 167 CHERRY TREE CROSS RD.

J932282

2

PRINCE GEORGES Co 10/29/69

PICTURE TAKEN FACING WEST

ON Co 167 CHERRY TREE CROSS RD

J932282

3

PRINCE GEORGES Co 10/29/69

PICTURE TAKEN FACING EAST

ON Co 167 CHERRY TREE CROSS RD

J932282

4

P & P 104

RAILROAD GRADE CROSSING SHEET

State Roads Commission of Maryland
Planning and Programming Division

1. GENERAL

Crossing No. 005

Mile Pole Number (R.R. Co.) ... NONE

Coordinates ..... x 849 y 326

System Classification (Check One)

State Primary ..... ☐

State Secondary ..... ☐

State Road Only ..... ☐

County ..... ☑

Local ..... ☐
(Specify)

County and/or Municipality .. PRINCE GEORGES

U.S. Route Number .....

State Route Number .....

Road Number/Name ..... Co 167 ~~168~~ ~~CROSS RD~~

Station .....

Surface Type ..... 20'I

Name of Railroad ..... PENN CENTRAL

Number of Main Tracks 1

Number of Other Tracks ..... NONE

2. TRAIN MOVEMENTS

Time Period	Train Speed at Grade Pass	Train Speed at Grade Freight	Spur	Remarks (Other than daily) Pass	Remarks (Other than daily) Freight
Day 6 A.M. to 6 P.M.					
Night 6 P.M. to 6 A.M.					
24 Hour Total					

3. TYPE OF PROTECTION

a. 5 Warning Signs - Reflectorized, ~~Non-reflectorized~~

b. — Crossing Signs - Reflectorized, Non-reflectorized

c. — Road Marking

d. — Lights - Flashing, Stationary

e. — Traffic Control (Stop and Go) Signals

f. — Automatic Gate

g. — Watchman - Gate, Flag...hours

h. — Others

* By numerals 1 or 2 indicate whether installation is on one or both sides of track.

4. ALIGNMENT FACTOR

P. 728'

N. 468'

Average Daily Trains ...

Train Speed .....

Highway ADT.....

Highway Speed Limit ...

Average Vehicle Speed . 20 MPH

Max. Approach Grade .. N.+3.2 P.+4.4

Restricted Sight Distance . YES
(On Highway)

5. QUADRANT ... SIGHT DISTANCE

		@300'	@10'
A	110°	0	500'
B	70°	312'	500'
C	70°	0	600'
D	110°	0	1000'

6. ACCIDENT RECORD (Vehicles & Trains)

Year	No. of Accidents	No. of Fatalities
1961		
1962		
1963		
1964		
1965		
Total		

7. CROSSING RATING

A

B

C

D

Total

State Roads Commission of Maryland
Planning and Programming Division

Party _____
Date 10/29/69

DIAGRAM FOR RAILROAD GRADE CROSSING

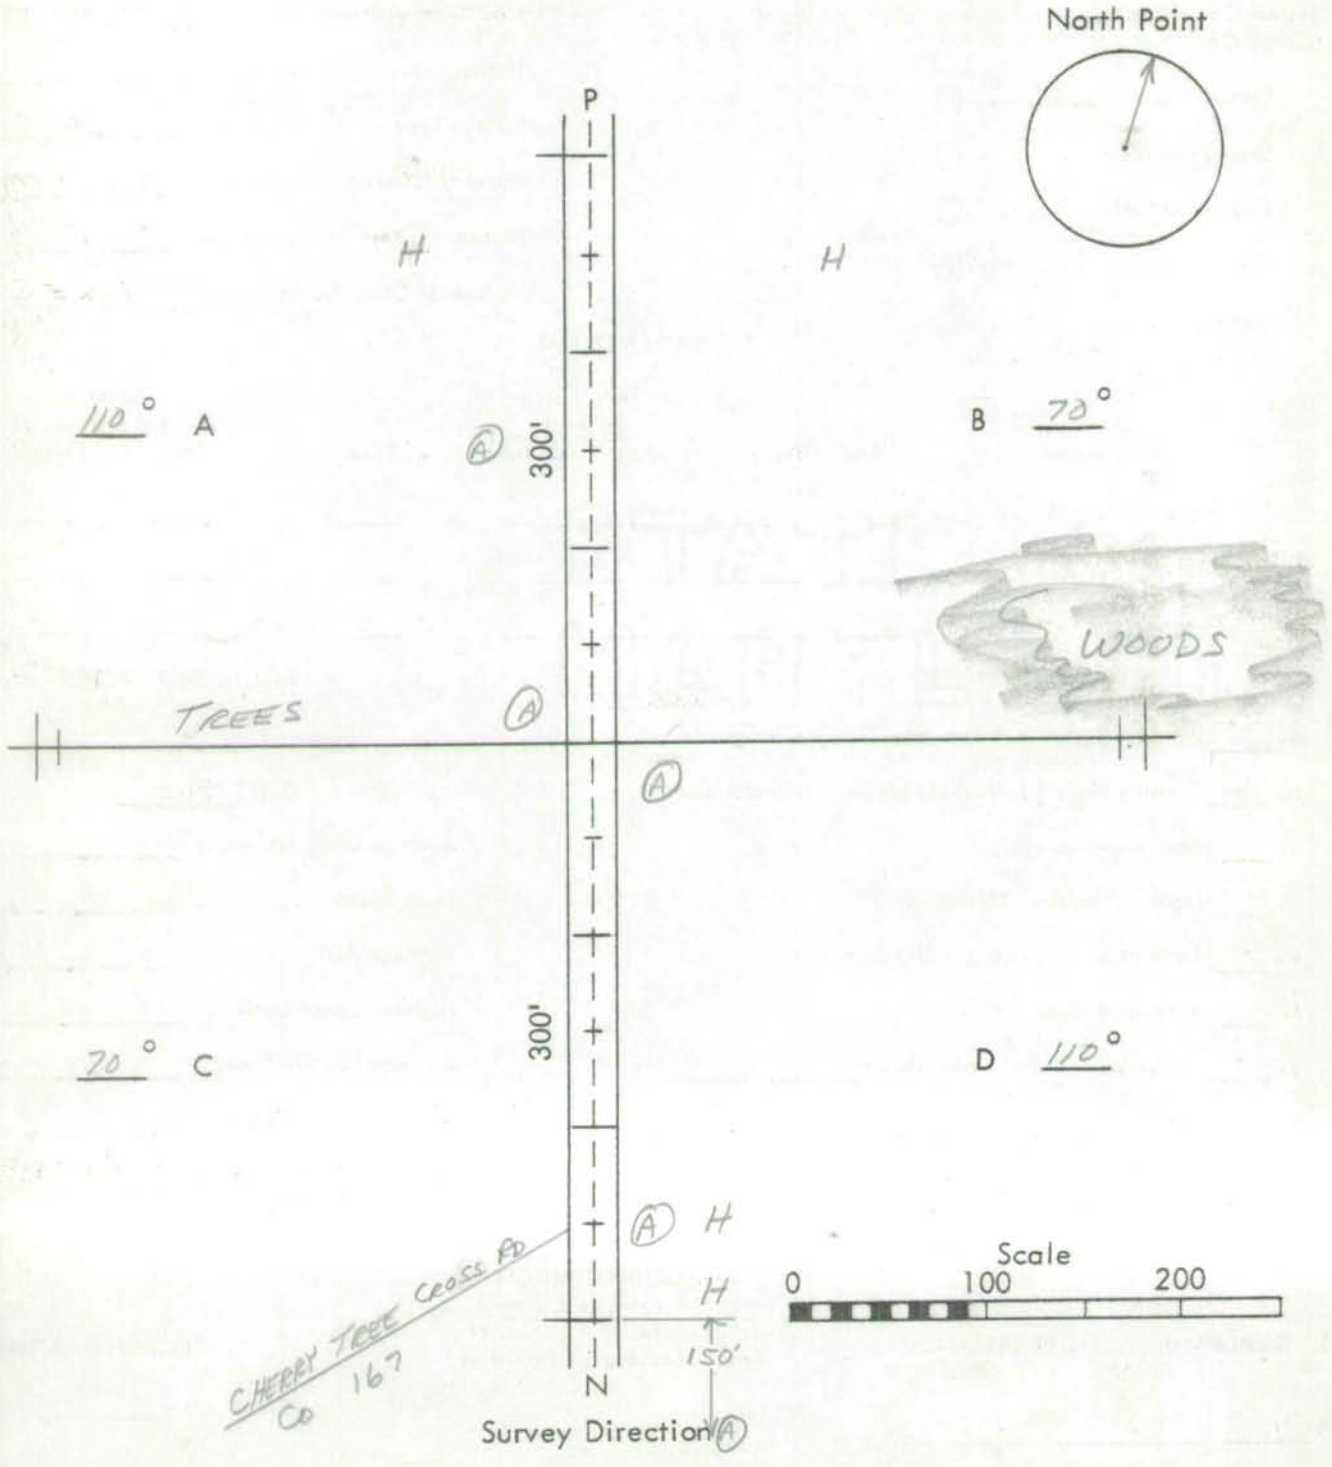

Remarks: RESTRICTION DUE TO THE HIGH BUILD UP AT THE TRACK.
CANNOT SEE ON COMING TRAFFIC BECAUSE OF THE HILL.
SEE MAX APPROACH GRADE ON FRONT.

CROSSING
#005

COUNTY #168
CROSS RD.

TURN PICTURE OVER

1

2

3

4

PRINCE GEORGES Co 10/24/69

PICTURE TAKEN FACING SOUTH
ON Co 168 CROSS RD

J932282

1

PRINCE GEORGES Co 10/24/69

PICTURE TAKEN FACING NORTH
ON Co 168 CROSS RD.

J932282

2

PRINCE GEORGES Co 10/24/69

PICTURE TAKEN FACING WEST
ON Co 168 CROSS RD

J932232

3

PRINCE GEORGES Co 10/24/69

PICTURE TAKEN FACING EAST
ON Co 168 CROSS RD

J932232

4

Form 6 HPS (Rev. 1961)

FAR MAP 10 4-023 ✓ 78

ROAD INVENTORY SHEET

~~CHERRY~~ TREE ~~CROSS~~ ~~RD~~. 4-022

Party Chief E.S.
Recorder W.D.
Chainman

Gen Hwy
TALBERT
849-328
M40

Road No. CO 168 ~~TRAIL~~
Name CROSS RD 4-023
Sheet No. 1 OF 4
Date 7-25-68
County PRINCE GEO.

		H T 95° 1 25	
		1 20 30° ↑	
		1 12 PT 30° ↑	16' E 1500' FARM
		1 10 PC	
		080 80° ↑	
NON FA MINOR COLLECTOR - RURAL	MATAPONI CK →	079	#P0491 SEE SHEET 1A
		064 OP 498	
W ↑		046 H	
	PT 30°	026	
	PC	023	
		021 DR	
		019 FARM	
	30°	007 DR	
			16' H
	CO	172	2-3E SHD
	NORTH KEYS	000 RD	26 C-W

Form 6 HPS (Rev. 1961)

78

ROAD INVENTORY SHEET

Party Chief E.S.
Recorder W.D.
Chainman

Road No. CO 168
Name CROSS RD TRAIL
Sheet No. 2 OF 4
Date 7-25-68
County PRINCE GEO

		PT 208	H	
	45°	203	H	
	P.RC	200	PRC	
		197	60° H	
		195	PC	
	H	192	H	
		190	H	
NOW FA MINOR COLLECTOR - RURAL		186	PT H	
			40°	
		184	PC H	
		174 OF 497		20' I
				30' CW
				X 2 ML
		170	PT	
			45°	
		168	PC	
	PT	161		
	35°			
	PC	158	DR	
	H	153		
		150	H	
		146	DR 30°	SAME
		TOTAL 131		

Form 6 HPS (Rev. 1961)

L 78

ROAD INVENTORY SHEET

Party Chief E.S.
Recorder W.D.
Chainman

Road No. CO 168
Name CROSS RD TRAIL
Sheet No. 3 OF 4
Date 7-25-68
County PRINCE GEO

NON FA MINOR COLLECTOR - RURAL

	H	272		
	H	268		
	H	265		
	H	260	30° ↑	
		258	H	
	PT	257		
90°		255	H	
	PC	253		
		251	30° ↓	
	H	245		
		236	PT	
			58° ↑	
		234	PC	
	PT	232		
	60°			
	PC	224		
OP 153		221		SAME

SHA 51.3-8
11-15-72

STATE HIGHWAY ADMINISTRATION OF MARYLAND

78

ROAD INVENTORY SHEET

Party Chief W.D. (E.J.)
Recorder M.Z. (W.D.)
Helper

Map No.

Road No. Co. 168
Road Name CROSS RD. TRAIL
Sheet No. 4 OF 4
Date 6-22-77 (7-25-68)
County PR. GEO
State Coordinates

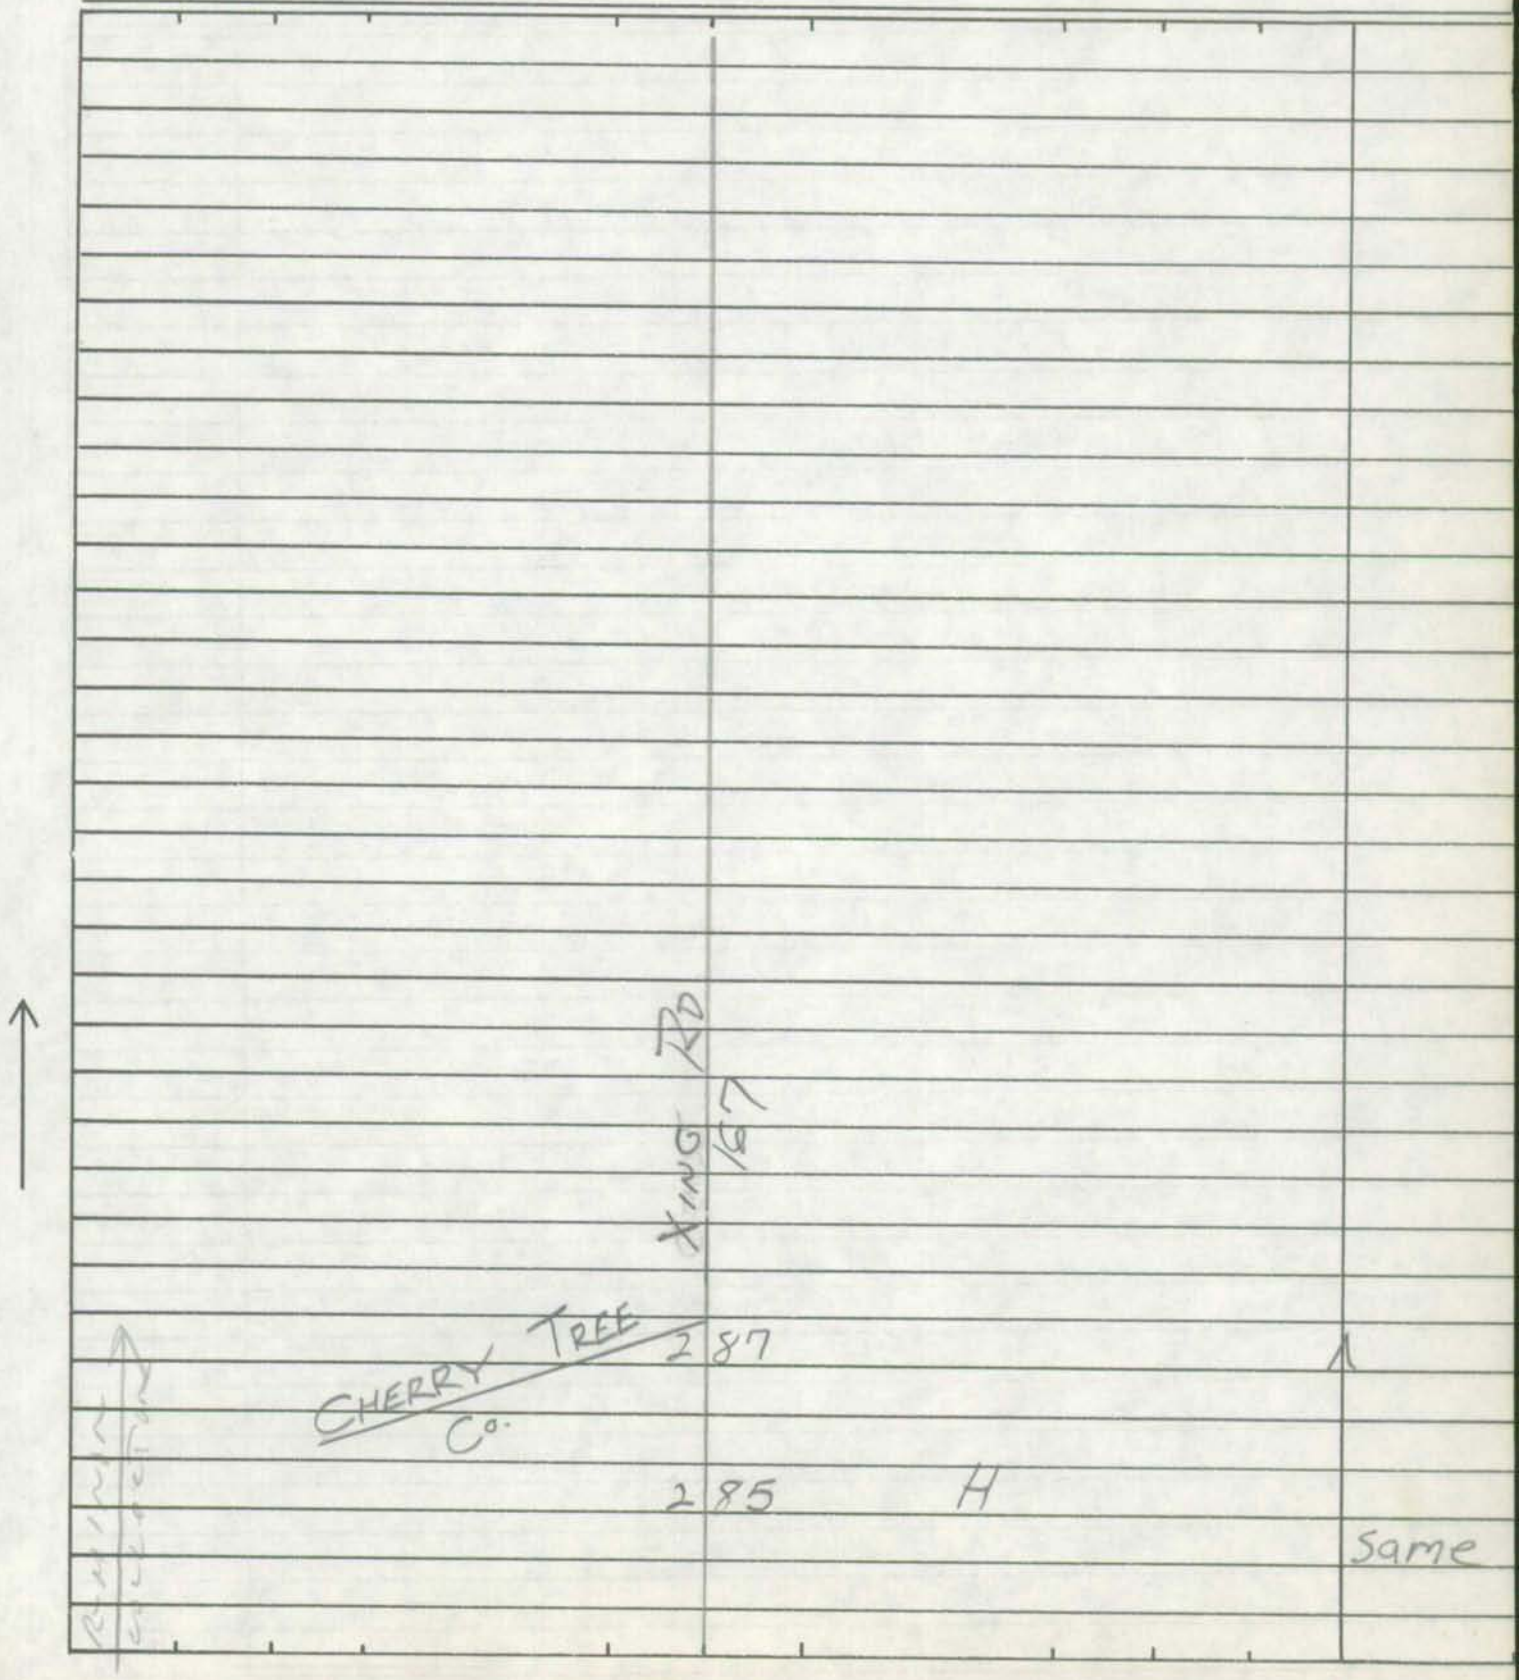

SHA 51.3-8
11-15-72

ROAD INVENTORY SHEET

Road No. _____
Road Name _____
Sheet No. _____
Date _____
County _____
State Coordinates _____

Form 5-HPS (Revised 1961) MARYLAND STATE ROADS COMMISSION PLANNING AND PROGRAMMING DIVISION S26130

IN COOPERATION WITH
U. S. BUREAU OF PUBLIC ROADS

BRIDGE SHEET

ROAD NO. C0168
SHEET NO. 1A
PARTY NO.
DATE 7-25-68
COUNTY PRINCE GEO

RATED CAPACITY

FOR ALL STRUCTURES HAVING A TOTAL OPENING OF MORE THAN 20 FEET AS DEFINED IN NOTE 1.

ODOMETER READING 079 NAME OF STREAM, RAILROAD OR HIGHWAY CROSSED

NUMBER OF RAILROAD TRACKS
KIND OF CROSSING (NOTE 2)

UNDERPASS-SIMPLE | UNDERPASS-COMBINED (NOTE 3) | OVERPASS | BRIDGE OVER SYSTEM STREAM

DESCRIPTION

NUMBER OF SPANS	LENGTH EACH SPAN (NOTE 4)	TYPE (NOTE 5)
1	27'	CONCRETE ARCH

TOTAL LENGTH-ON LINE OF ROAD OVER-ALL (NOTE 6) 27'

MATERIAL
SUBSTRUCTURE CONCRETE SUPERSTRUCTURE
FLOOR

CLEARANCES
ROADWAY (NOTE 7) 16' SIDEWALK WIDTHS: RIGHT LEFT

SURFACE OF ROAD TO STREAM BED 7' FOR OVERPASSES, SHOW DISTANCES TO TOP OF RAIL OR SURFACE OF LOWER ROAD. (NOTE 8)
SURFACE OF ROAD TO BOTTOM PORTAL (MINIMUM OVERHEAD CLEARANCE
CLEAR DISTANCE OF OPENING ABOVE STREAM BED 5 (WATERWAYS ONLY)
POSTED LOAD LIMITS BRIDGE NO. CONSTRUCTION DATE

GENERAL CONDITION OF BRIDGE: CHECK IF GOOD, FAIR, OR POOR, DESCRIBE DEFECTS IF SERIOUS.

	GOOD	FAIR	POOR
SUPERSTRUCTURE			✓
FLOOR			✓
SUBSTRUCTURE			✓

PAINT BADLY CORRODED OR RUSTED
TYPE OF PROTECTION FOR DRAWBRIDGES (NOTE 9)

(NOTES ON REVERSE SIDE)

S26130

Notes:

1. In agreement with Federal-aid standards, a bridge is defined as a structure including supports erected over a depression or an obstruction, as water, highway, or railway, and having a track or passageway for carrying traffic or other moving loads, and having a length measured along the center of roadway of more than 20 feet between undercoping of abutments or spring lines of arches, or extreme ends of openings for multiple boxes and pipes, where the clear distance between openings is less than half of the smaller contiguous opening.

2. Show kind of crossing by checking descriptive item applicable. For multiple-span bridges give complete information on each span including approach spans. Indicate on leg sheet the odometer reading, position, and angle of skew of structure with respect to center line of road and by arrow the direction of stream flow.

3. Give information on the span over the highway only.

4. For span length use center to center of bearings, otherwise the clear opening. Skew bridges will be measured along center line of road. See Note 1.

5. Show general type such as: Trestle, Truss, Girder, I-Beam, Rigid Frame, Arch, Slab, Suspension, or Covered Bridge. See illustrations attached. Describe draw spans by classifications listed in Article X, Section 2 of Manual.

6. The length of a bridge structure is the over-all length measured along the line of survey stationing back to back of back-walls of abutments, if present, otherwise end to end of bridge floor, but in no case less than the total clear opening of the structure.

7. Give minimum lateral clearance. Where traffic lanes are separated by bridge numbers, show clearance width of each lane separately. Special conditions should be explained by notes.

8. In case of overhead bracing or arch construction, measurement shall be made to the lowest point above the road surface.

9. Use classification listed on RR crossing sheet. Form 4 HPS.

Remarks: _____

_____

A rearrangement of the form similar to that shown on the attachment may be used to provide space for coding.

Form 6 HPS (Rev. 1961)

FAR

95-206 BB/AH 3/25/96

4-081

78

ROAD INVENTORY SHEET

Party Chief E. SCHUYLER
Recorder W. DOMBROSKI
Chainman

61-238

Gen Hwy
872-302 M40

MAP 13

VER 6-21-77

Road No. CO 169
Name WESTWOOD RD
Sheet No. 1 OF 1
Date 7 — 17 — 68
County PRINCE GEORGES

189 RB

CO BADEN WESTWOOD 0 81

0 77 H

C 35° 0 70

H 0 64

0 58 PT 30°

0 56 PC

H 0 39

0 37 PT 30°

0 33 PC

DR 5671 COLWELL

H PT 30° 0 25 CO H — 16'G, 2-3'E SHD, 24'CW

PRC 0 20 PRC 35° — X — 16'E, 20'CW

PRC 30° 0 15 PRC

P.C 0 11 — X

0 01 — 16'XG, 2-3'ES HD, 24'CW

CO BALD EAGLE SCH 0 00 170 ROAD

398

715

Form 6 HPS (Rev. 1961)

FAR

4-010

ROAD INVENTORY SHEET

Party Chief E. SCHUYLER
Recorder W. DOMRAOSNI
Chainman

Glen Henry
879-306 M40

Road No. CO 170
Name BALD EAGLE SCH. RD
Sheet No. 1 OF 2
Date 7 — 17 — 68
County PRNCE GEORGES

VER 6-21-77

MAP 13414

	PT	1	27
16 E			
FARM	2500'	1	24
	35°		
	PC	1	21
	H	1	08
	H	0	99
		0	96 H
H		0	86
		0	76 PT H
			65° CO 179
		0	75 NELSON PERRIE RD
		0	73 PC
	H	0	64
		0	58 H
	H	0	48 H
	H	0	40
		0	34 H
	H	0	28 H
	H	0	21
		0	08 FARM
	MD	0	00 382

20' I
23' ESHD

Form 6 HPS (Rev. 1961)

18

ROAD INVENTORY SHEET

Party Chief E. SCHUYLER
Recorder W. DOMBROSKI
Chainman

Road No. CO 170
Name BALD EAGLE SCH RD.
Sheet No. 2 OF 2
Date 7 — 17 — 68
County PRINCE GEORGES

CO	189	
BADEN WESTWOOD 2	08	ROAD
WESTWOOD P.O	2 04	
PT 70°	1 84	
P.C.	1 74	
H	1 64	
H	1 58	
	1 55	H
	1 46	PT
140		169 RD
		WESTWOOD
	1 38	50°
	1 37	PC

SAME

Form 6 HPS (Rev. 1961)

FAU

2-059-C

18

ROAD INVENTORY SHEET

ARDMORE RD

Party Chief ES.
Recorder F.S.
Chainman

842-402 M31

MAP 4

Road No. Co 171
Name ~~ARDWICK-ARDMORE RD~~
Sheet No. 1 OF 1
Date 6-17-68
County PRINCE GEO

VER 4-3-78

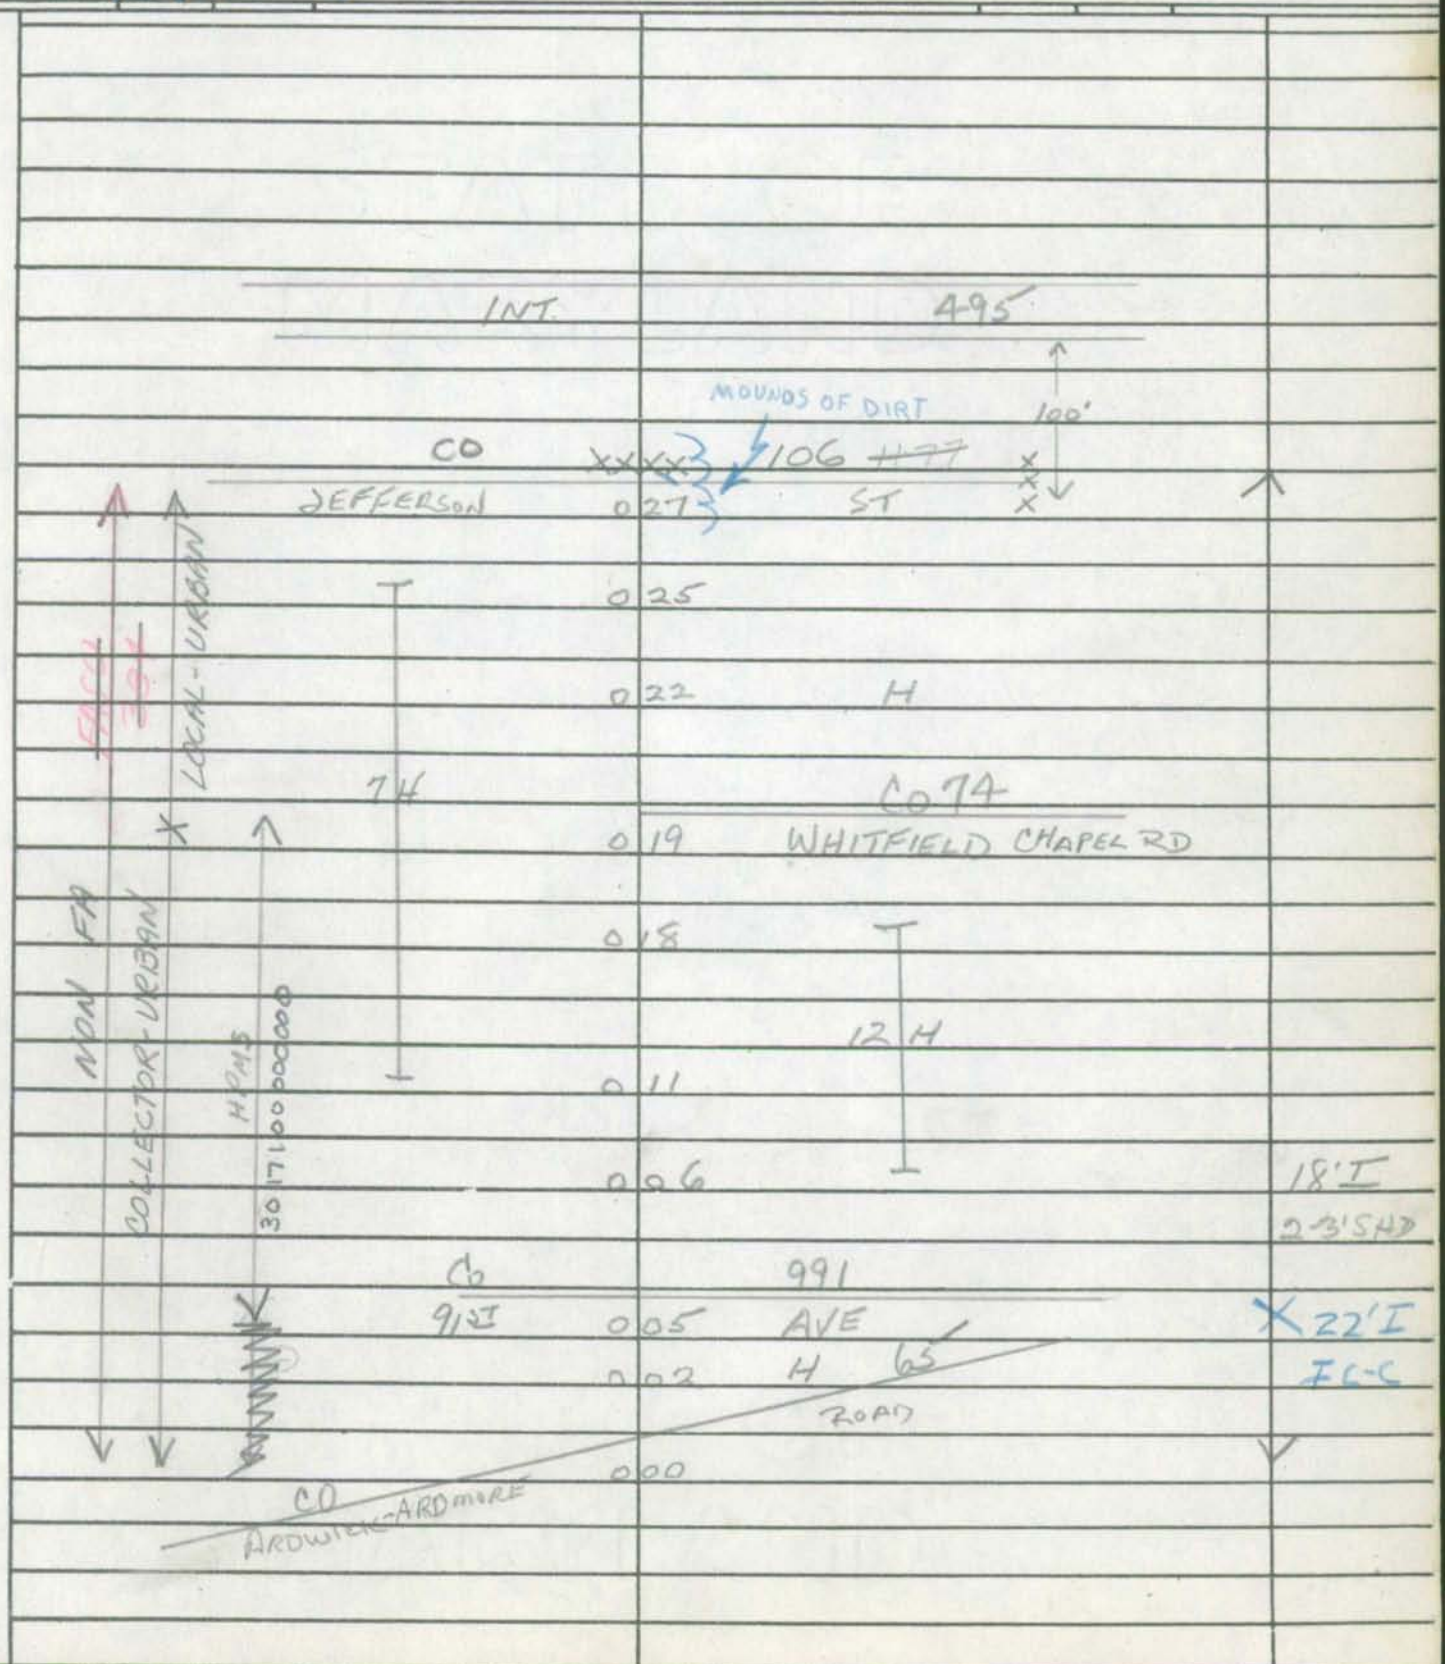

Form 6 HPS (Rev. 1961)

FAR MAPS 10+13

91-217
2-11-92
DT/JS
4-068

~~ROCK BRANCH RD~~

ROAD INVENTORY SHEET

PARTY CHIEF Frederick Settan
RECORDER Thomas Landon
CHAINMAN

Gen. Hwy

ROAD NO. Co 172
NAME NORTH HOKS RD
SHEET NO. 1 OF ~~3~~ 4 ~~4~~-014 3
DATE 8-8-67
COUNTY PRINCE GEORGES

VER 6-20-77 848314 M40

		074		DR	
	CHURCH & CEM	071			
		065	H	12" CMP	
		062	H		
		059	Waters Way 300'		
		058	Co 90-277 5144		
		054	H		
		050	H		
		045	H		
	H	040	H		
	H	038	H		
	H	034			
		031		12" CMP	
		028	H		20' H.
		019	H	12" CMP	1 ~~STG~~ 2-3' ESPLD
	H	008			50' CW
W		000	381	55	✓

NON FA LOCAL - RURAL

MD

Form 6 HPS (Rev. 1961)

98CO-CX 15 ex.
G.D.
E.F. 2/4/99

78

ROAD INVENTORY SHEET

PARTY CHIEF Frederick Settan
RECORDER Thomas Landon
CHAINMAN

ROAD NO. Co 172
NAME
SHEET NO. 2 OF ~~5~~ 3
DATE 8-8-67
COUNTY PRINCE GEORGES

		H	2	13	H		22' E
							2 mL
		H	2	09	H		~~16'G~~
							~~23'SHD~~
		H	1	92		PT	30' CW
			1	90 MARTIN RD / Co 190		80°)	
			1	89		PC	X
	NON FH	H	1	86			
	LOCAL-RURAL						
		PT 35°	1	79	H		
		PC	1	73			
		H	1	69			
		H	1	66			
			1	60	H		
			1	58	H		~~19'G~~
			1	44	H		~~24'E SHD~~ ~~40' CW~~
			1	41	H		
		EVERGREEN to SAND & GRAVEL PLT. ~~Gibbons~~			(Gibbons) CHURCH RD		
		~~OF 583~~	1	21 Co 173			X
					@1.04		
			1	08	H		
							20' H
			1	05	H		23' E SHD
							2 mL
							~~SHD~~

Form 6 HPS (Rev. 1961)

A/T(92-COEX#2)
C.D A:11
2-23-93

78

ROAD INVENTORY SHEET

PARTY CHIEF Frederick Settan
RECORDER Thomas Landon
CHAINMAN

ROAD NO. Co 172
NAME
SHEET NO. 3 OF ~~4~~ 3
DATE 8-8-67
COUNTY PRINCE GEORGES

NON FA
MINOR COLLECTOR-RURAL

393 RD Co. 140 DR
390
MOLLY BERRY Co 140
381 PT 30° PC
378 DR
368 PT 35°
364 DR
358 PC
356
316 30°
PLANTATION DR Co 5308
395
303
~~293~~
CROSS RD TRAIL Co 168
292
283 12" CMP
278
241 PT 30° PC
232
220 H 22'
216 H 2m

LOCAL-RURAL

Form 6 HPS (Rev. 1961)

4-063

78

ROAD INVENTORY SHEET

Party Chief E.S.
Recorder W.D.
Chainman

853-310 M40
VER 6-20-77

Road No. Co 173
Name GIBBONS CH RD
Sheet No. 1 OF 2
Date 7-25-68
County PRINCE GEO

93-151

CH	095		
	092	H	
H	090		
	082	H	
H	079		
	076	PT	
	074	OP 271	
		80°	
	072	P.C.	
⌈30°	057		
	050	30° ↑	
			16' G
PT	039		2-3' E shd
35°			
PC	032		
	027	PT	~~X~~ ~~X~~
			~~2~~ ~~X~~ ~~SHO~~
	024	~~HIGH~~ ~~SCH~~ FACTORY	~~X~~
		45°	
	020	P.C.	
			24 'I
			2-~~X~~ E SHO
MD	000	381	✓ 7'I

Form 6 HPS (Rev. 1961)

98CO-EX15
G.D.
E.F. 2/4/99

ROAD INVENTORY SHEET

Party Chief E.S.
Recorder W.D.
Chainman

Road No. CO 173
Name GIBBONS CH. RD
Sheet No. 2 OF 2
Date 7-25-68
County PRINCE GEO

~~ROAD~~	~~1+98~~	~~END~~	
~~45°~~	~~1+93~~		
	~~1+91~~	PT ~~30°~~	
	~~1+87~~	PC	
~~ROAD~~	~~1+ END CHAIN~~		
~~30°~~	~~1+82~~		
	~~1+74~~	~~30°~~	
	~~1+72~~	~~H~~	
	~~1+60~~		
~~PT~~	~~1+25~~		
~~40°~~			
~~PC~~	~~1+23~~		
	~~1+11~~	~~30°~~	
~~30°~~	~~1+08~~		
CO		~~173~~	
NORTH KEYS	1+04	RD	
CH	1+02		
CH HALL	1+01		
CEM	0+99		
	0+97	H	

~~AS~~
~~16'F~~
~~20'CW~~
~~20'A~~ F
~~2-3'A~~ SHD
SAME

SHA 51.3-8
11-15-72

Rural

M76
SP

STATE HIGHWAY ADMINISTRATION OF MARYLAND

ROAD INVENTORY SHEET

Party Chief R. Bush (OFFICE INV)
Recorder
Helper

Map No. M40 VER
INDEX 13 6-20-77

Road No. Co 174
Road Name OLD INDIAN HEAD Rd
Sheet No. 1 OF 2
Date 7-25-68 REVISED 5-8-74
County PR. GEO
State Coordinates 848-314

	130	(R×R)		
↑50°	125			
	099	C.B.C	L W D 14×20×7	
	095			
			40°	18' H
	092			~~16'I~~
				2-3'E Shld
				26'C-W
	075			X
			68	
	068			
H	066	H		26'I
				2-6'E Shld
↑90° Co 175 / TOWER Rd	064			X 40'C-W
N ↑				
H	059			
	054	PVT FARM ENT		
18 H				
	017			
	009	H		16'I
				2-3'E Shld
				26'C-W
MD	000 381			

SHA 51.3-8
11-15-72

ROAD INVENTORY SHEET

Road No. Co 174
Road Name
Sheet No. 2 of 2
Date
County
State Coordinates

CHERRY TREE | Xing ~~Rd~~ Rd
Co | 138 167

(R×R) Sign (S.L.L) | ~~RR~~ 592 791 LCR532 92 T
137 Sign (S.L.L)

SAME

P & P 104

RAILROAD GRADE CROSSING SHEET

State Roads Commission of Maryland
Planning and Programming Division

1. GENERAL

Crossing No. 003

Mile Pole Number (R.R. Co.) ... NONE

Coordinates ..... x 846 y 321

System Classification (Check One)

- State Primary ..... ☐
- State Secondary ..... ☐
- State Road Only ..... ☐
- County ..... ☑
- Local ..... ☐ (Specify)

County and/or Municipality .. PRINCE GEORGES

U.S. Route Number .....

State Route Number .....

Road Number/Name ..... INDIANHEAD RD CO 174

Station .....

Surface Type ..... 16' F

Name of Railroad ..... PENN CENTRAL

Number of Main Tracks 1

Number of Other Tracks ..... NONE

2. TRAIN MOVEMENTS

Time Period	Pass	Freight	Train Speed at Grade: Pass	Train Speed at Grade: Freight	Spur	Remarks (Other than daily): Pass	Remarks (Other than daily): Freight
Day 6 A.M. to 6 P.M.							
Night 6 P.M. to 6 A.M.							
24 Hour Total							

3. TYPE OF PROTECTION

a. 4 Warning Signs - Reflectorized, (Non-reflectorized)

b. — Crossing Signs - Reflectorized, Non-reflectorized

c. — Road Marking

d. — Lights - Flashing, Stationary

e. — Traffic Control (Stop and Go) Signals

f. — Automatic Gate

g. — Watchman - Gate, Flag...hours

h. — Others

* By numerals 1 or 2 indicate whether installation is on one or both sides of track.

4. ALIGNMENT FACTOR

P. 728'

N. 50'

Average Daily Trains ...

Train Speed .....

Highway ADT.....

Highway Speed Limit ...

Average Vehicle Speed . 10 MPH

Max. Approach Grade .. N+1.0 P-3.4

Restricted Sight Distance . NO (On Highway)

5. QUADRANT ... SIGHT DISTANCE

		@300'	@10'
A	130°	0	400'
B	50°	350'	100'
C	50°	0	360'
D	130°	0	500'

6. ACCIDENT RECORD (Vehicles & Trains)

Year	No. of Accidents	No. of Fatalities
1961		
1962		
1963		
1964		
1965		
Total		

7. CROSSING RATING

A

B

C

D

Total

State Roads Commission of Maryland
Planning and Programming Division

Party _____
Date 10/29/69

DIAGRAM FOR RAILROAD GRADE CROSSING

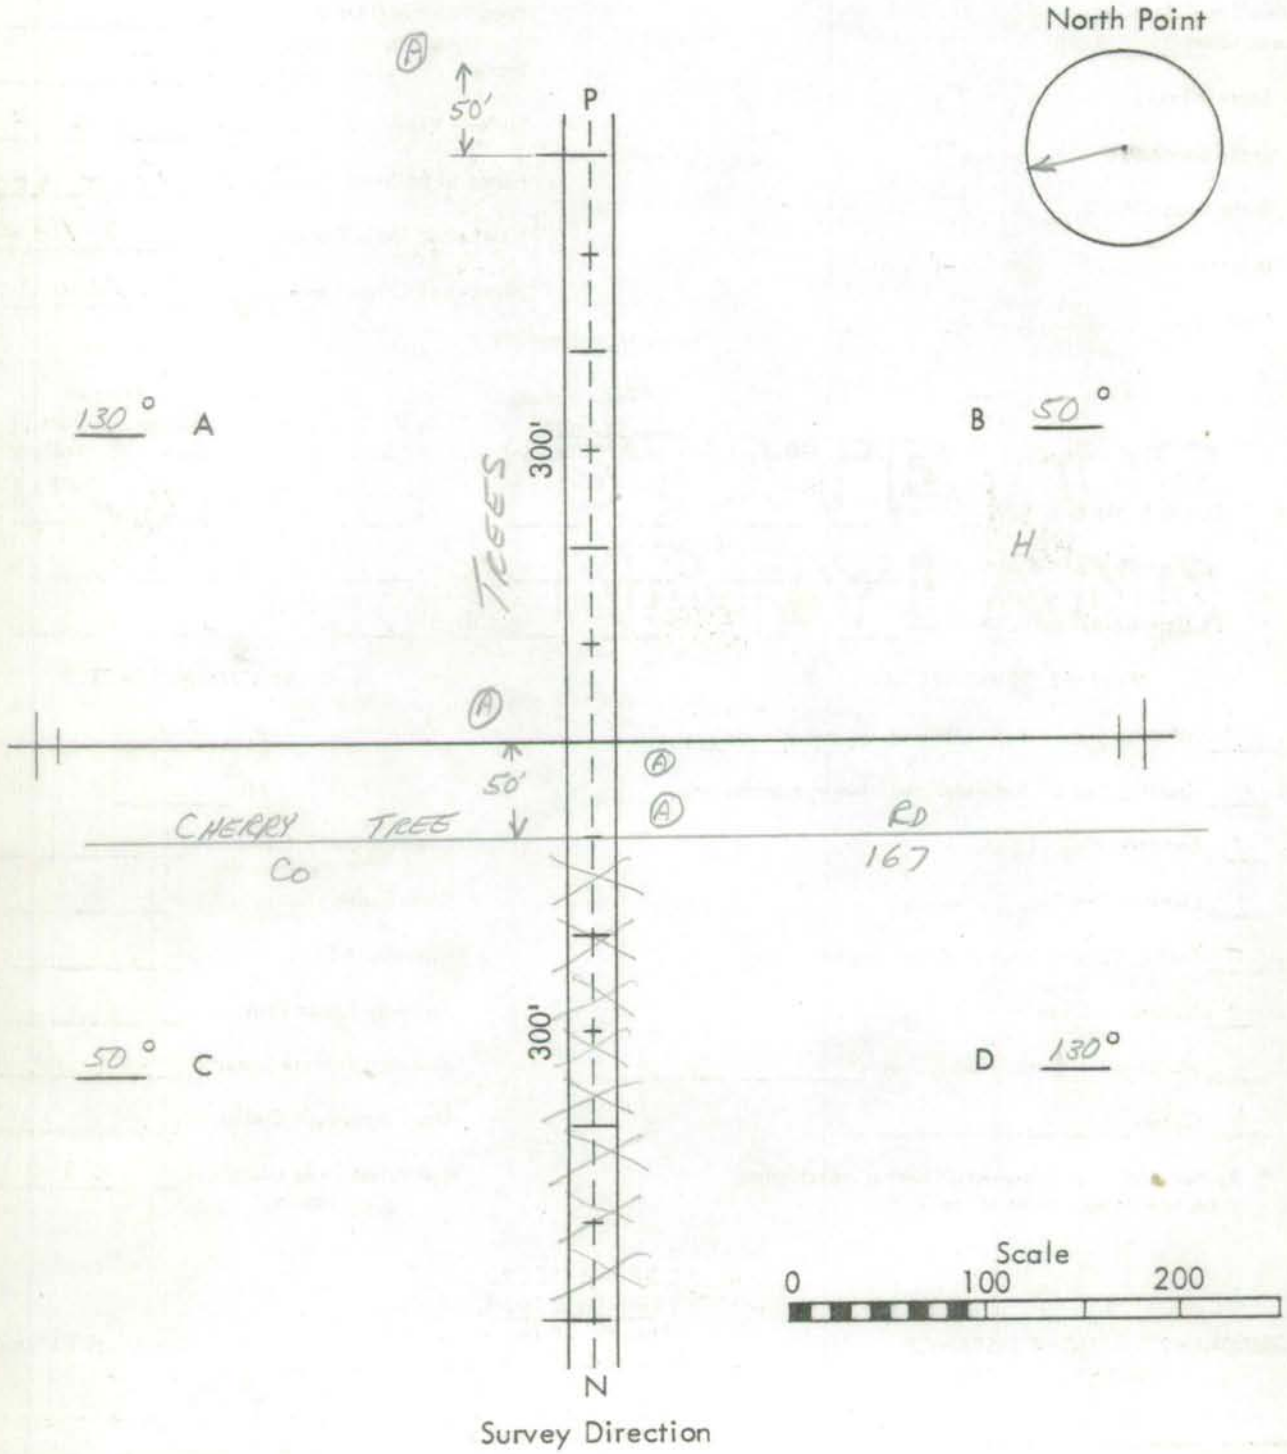

Survey Direction

Remarks: _____

CROSSING
~~#~~ 003

COUNTY #174
INDIANHEAD ROAD

TURN PICTURES OVER

1

2

3.

4

PRINCE GEORGES Co 10/29/69

PICTURE TAKEN FACING WEST
ON Co 175 INDIANHEAD RD

J932232

1

PRINCE GEORGES Co 10/29/69

PICTURE TAKEN FACING SOUTH
ON Co 175 INDIANHEAD RD

J927281

2

PRINCE GEORGES Co 10/29/69

PICTURE TAKEN FACING EAST
ON Co 175 INDIANHEAD RD

J927281

3

PRINCE GEORGES Co 10/29/69

PICTURE TAKEN FACING NORTH
ON Co 175 INDIANHEAD RD
WHERE R.R. MEETS RD NAME CHANGES
TO CHERRY TREE CROSS RD.

J932232

4

SHA 51.3-8
11-15-72

STATE HIGHWAY ADMINISTRATION OF MARYLAND

FAR

ROAD INVENTORY SHEET

Party Chief R. Bush (OFFICE)
Recorder
Helper

Road No. Co 175
Road Name TOWER Rd.
Sheet No. 1 OF 1
Date 7-25-68 REVISED 5-8-74
County PR. GEO
State Coordinates 846-321

Map No. M 40
INDEX 13

VER 6-20-77

OLD INDIAN HEAD Rd.
C.O.

0 58 174

(EDDY LA.)

0 41 Co ~~90 270~~ 5143

PROPOSED 0 17

OP 499 0 07

0 04 FIRE TOWER 26'I 2-6'E Shld

MD 0 00 381

N

SHA 51.3-8
11-15-72

ROAD INVENTORY SHEET

Road No. _____
Road Name _____
Sheet No. _____
Date _____
County _____
State Coordinates _____

Form 6 HPS (Rev. 1961)

FAU MAP 5 96MVEx 5-198 #9A BB/MG 3-7-97 VR/SW

91-Count #1 3-13-92 DT/JS

ROAD INVENTORY SHEET

Party Chief E.S.
Recorder W.D.
Chainman

Gen Hwy

881-413 M32

Ver 5-31-78

Road No. Co 176
Name OXFORD CT
Sheet No. 1 OF 1
Date 7-9-68
County PRINCE GEO

	CUL-DE			SAC	
	H	0	29 ~~32~~	H	
		0	29 ~~30~~	H	
		0	28 ~~+~~	H	
	Co 182				
	AVONDALE DR	0	24 ~~+~~ 3		
	P.T	0	24 2	H	
	45° H	0	23 ~~+~~		
	P.C. H	0	19 ~~21~~		
	Co			188	
	PARK	0	~~1~~ 3	DR	
	H	0	~~13+~~	H	
		0	~~10~~ 7	H	
	OLD H	00 ~~8~~		CRAIN DR.	20'I 2UML
	~~DP~~ Co 223	000		~~DF 5X8~~ MD 3-G	SS ✓
				©.50	
	~~Co 223~~				
	OLD ~~CRAINE~~ HWY.	00 ~~8~~			20 I 2-4'E SH
	~~MD~~	~~X X X~~ 000		~~X X X X~~ BARRICADE	✓

SHA 51.3-8
11-15-72

STATE HIGHWAY ADMINISTRATION OF MARYLAND

FAR

ROAD INVENTORY SHEET

78

Party Chief R. Bush (OFFICE INV)
Recorder
Helper

Map No. M 40
INDEX 13

VER 6-20-77

Road No. Co 177
Road Name BROOKS CHURCH Rd
Sheet No. 1 OF 1
Date 8-8-67 REVISED 5-8-74
County PR. GEO
State Coordinates 879-316

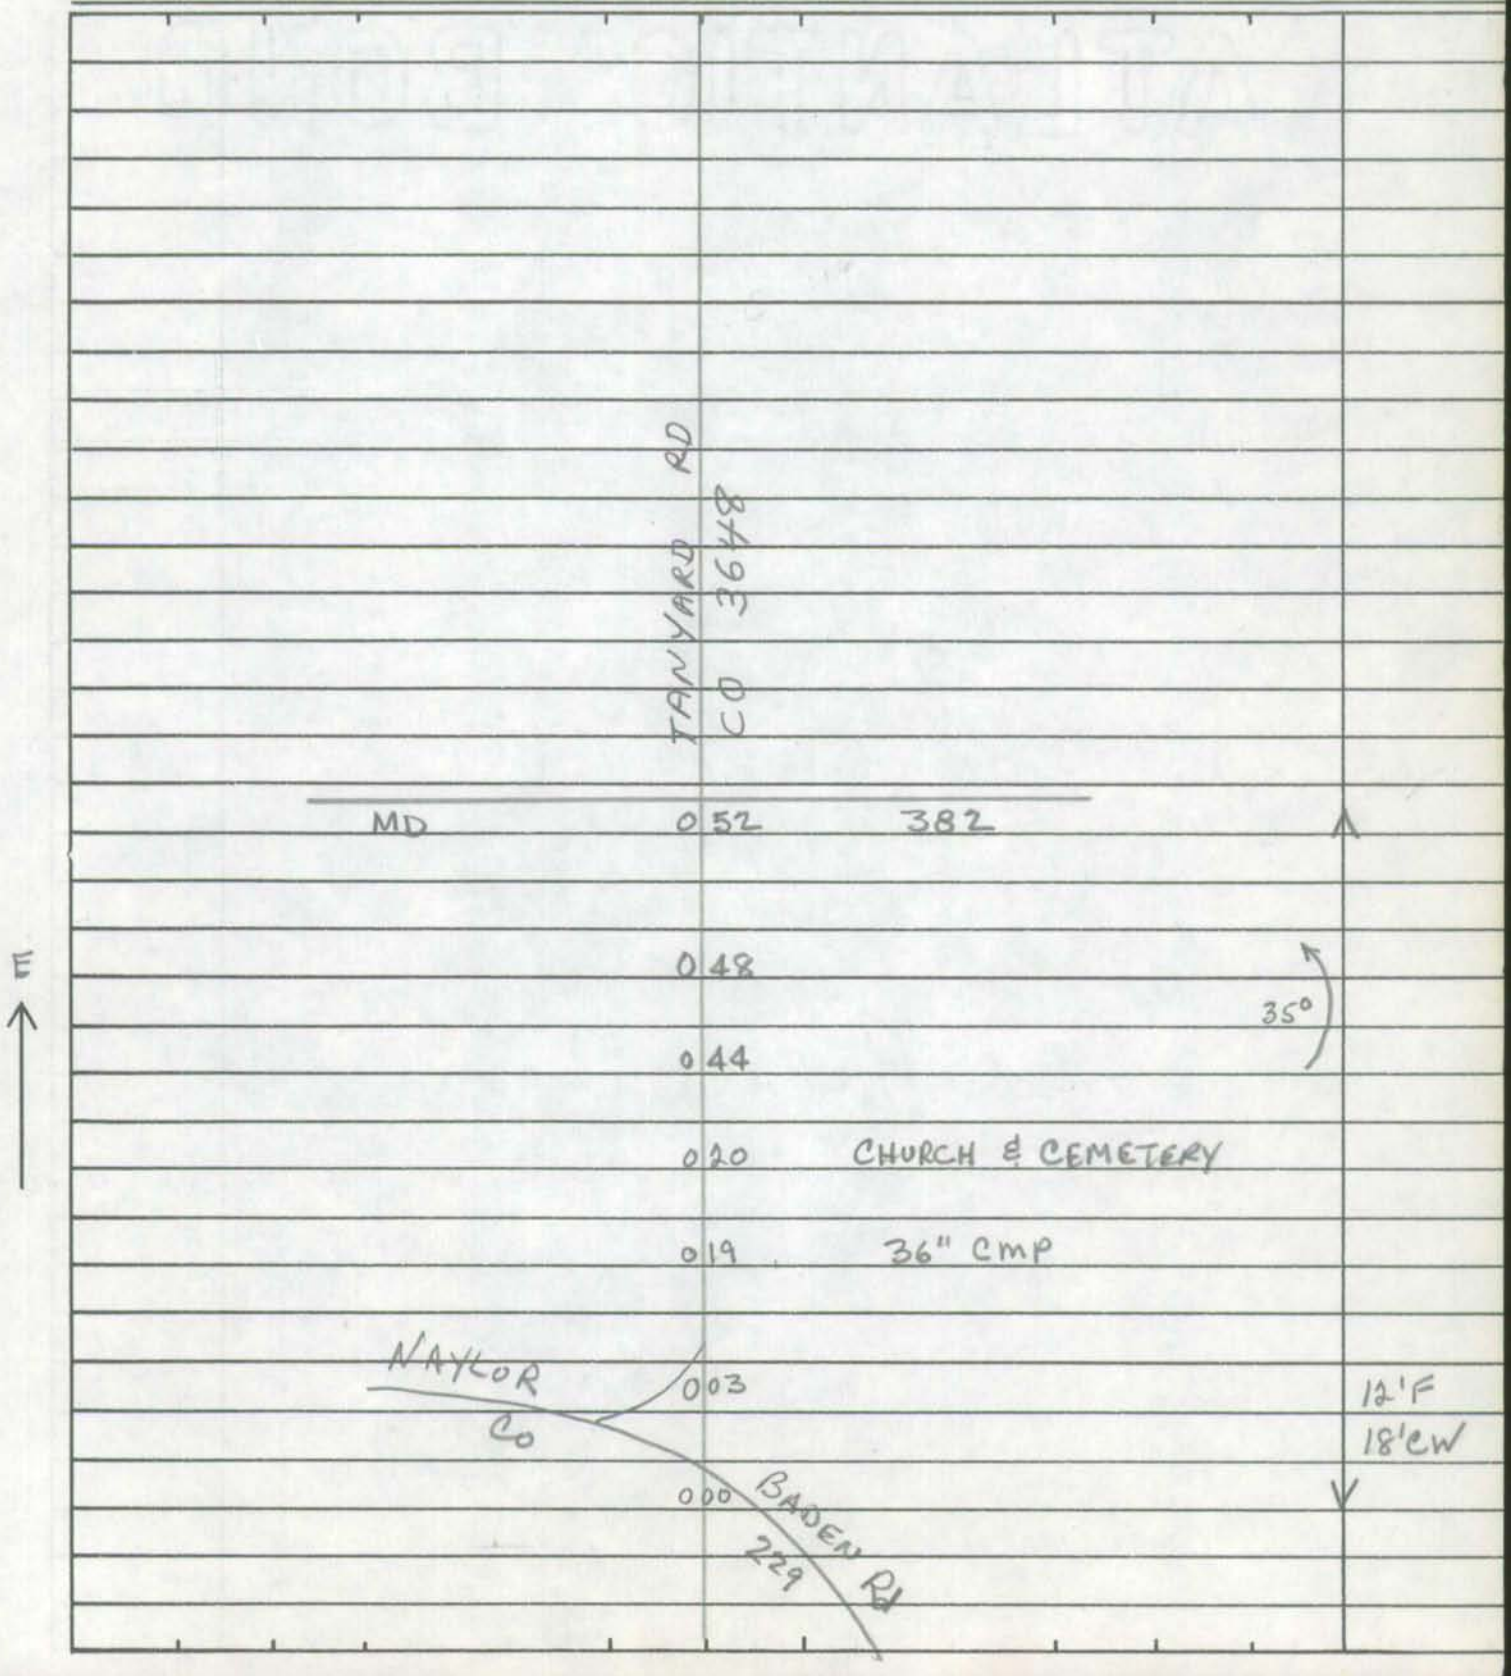

SHA 51.3-8
11-15-72

ROAD INVENTORY SHEET

Road No. _____
Road Name _____
Sheet No. _____
Date _____
County _____
State Coordinates _____

SHA 51.3-8
11-15-72 TAT

STATE HIGHWAY ADMINISTRATION OF MARYLAND

ROAD INVENTORY SHEET

Party Chief W. DOMBROSKI
Recorder M. ZALENSKI
Helper

Map No. 40

Road No. Co 178
Road Name FENNO RD
Sheet No. 1 OF 1
Date 6-21-77
County PRINCE GEORGES
State Coordinates 880-332

WAS PART OF Co 141

NOTTINGHAM Co

	1 57	RD 180	
	1 56		
H	1 53		
H	1 37		
PT 45° PC	1 34		
	1 30		
H	1 29		
	1 22		
H	1 18		
H	1 14		
	1 12	DR	
H	1 09		
		PVT RD	
OP 274	0 70	9'D 0.24	
MATAPONI	0 29	#P0498 CREEK SEE BRIDGE SH 1B	
MATAPONI	0 24	#P0487 CREEK SEE BRIDGE SH 1A	15'F 2-3'E SHLDS 28'CW
	0 00	Co 141 ST. THOMAS CHURCH RD	

S

SHA 51.3-8
11-15-72

ROAD INVENTORY SHEET

Road No. _____
Road Name _____
Sheet No. _____
Date _____
County _____
State Coordinates _____

Form 5-HPS
(Revised 1956)

MARYLAND STATE ROADS COMMISSION
TRAFFIC DIVISION

S26130

IN COOPERATION WITH
U. S. BUREAU OF PUBLIC ROADS

ROAD NO. Co 14 178

BRIDGE SHEET

SHEET NO. 1-A

PARTY NO.

DATE 8-8-67

COUNTY PRINCE GEORGES

RATED CAPACITY

FOR ALL STRUCTURES HAVING A TOTAL OPENING OF MORE THAN 20 FEET AS DEFINED IN NOTE 1.

ODOMETER READING ~~2.19~~ 0.24 NAME OF STREAM, RAILROAD OR HIGHWAY CROSSED MATAPONI CREEK

NUMBER OF RAILROAD TRACKS

KIND OF CROSSING (NOTE 2)

UNDERPASS - SIMPLE | UNDERPASS - COMBINED (NOTE 3) | OVERPASS | BRIDGE OVER SYSTEM

DESCRIPTION

NUMBER OF SPANS	LENGTH EACH SPAN (NOTE 4)	TYPE (NOTE 5)
3	15'	WOOD PILE

TOTAL LENGTH - ON LINE OF ROAD OVER-ALL (NOTE 6) 45'

MATERIAL

SUBSTRUCTURE WOOD SUPERSTRUCTURE WOOD

FLOOR WOOD

CLEARANCES

ROADWAY (NOTE 7) 12' SIDEWALK WIDTHS: RIGHT LEFT

SURFACE OF ROAD TO STREAM BED 10' FOR OVERPASSES, SHOW DISTANCES TO TOP OF RAIL OR SURFACE OF LOWER ROAD. (NOTE 8)

SURFACE OF ROAD TO BOTTOM PORTAL 2' (MINIMUM OVERHEAD CLEARANCE

CLEAR DISTANCE OF OPENING ABOVE STREAM BED 8' (WATERWAYS ONLY)

POSTED LOAD LIMITS BRIDGE NO. P0482 CONSTRUCTION DATE

GENERAL CONDITION OF BRIDGE: CHECK IF GOOD, FAIR, OR POOR, DESCRIBE DEFECTS IF SERIOUS.

	GOOD	FAIR	POOR
SUPSTRUCTURE	✓		
FLOOR	✓		
SUBSTRUCTURE	✓		
PAINT		BADLY CORRODED OR RUSTED	

TYPE OF PROTECTION FOR DRAWBRIDGES (NOTE 9)

(NOTES ON REVERSE SIDE)

S26130

Notes:

1. In agreement with Federal-aid standards, a bridge is defined as a structure including supports erected over a depression or an obstruction, as water, highway, or railway, and having a track or passageway for carrying traffic or other moving loads, and having a length measured along the center of roadway of more than 20 feet between undercoping of abutments or spring lines of arches, or extreme ends of openings for multiple boxes and pipes, where the clear distance between openings is less than half of the smaller contiguous opening.

2. Show kind of crossing by checking descriptive item applicable. For multiple-span bridges give complete information on each span including approach spans. Indicate on leg sheet the odometer reading, position, and angle of skew of structure with respect to center line of road and by arrow the direction of stream flow.

3. Give information on the span over the highway only.

4. For span length use center to center of bearings, otherwise the clear opening. Skew bridges will be measured along center line of road. See Note 1.

5. Show general type such as: Trestle, Truss, Girder, I-Beam, Rigid Frame, Arch, Slab, Suspension, or Covered Bridge. See illustrations attached. Describe draw spans by classifications listed in Article X, Section 2 of Manual.

6. The length of a bridge structure is the over-all length measured along the line of survey stationing back to back of back-walls of abutments, if present, otherwise end to end of bridge floor, but in no case less than the total clear opening of the structure.

7. Give minimum lateral clearance. Where traffic lanes are separated by bridge numbers, show clearance width of each lane separately. Special conditions should be explained by notes.

8. In case of overhead bracing or arch construction, measurement shall be made to the lowest point above the road surface.

9. Use classification listed on RR crossing sheet. Form 4 HPS.

Remarks: _____

A rearrangement of the form similar to that shown on the attachment may be used to provide space for coding.

Form 5-HPS
(Revised 1956)

MARYLAND STATE ROADS COMMISSION
TRAFFIC DIVISION

S26130

IN COOPERATION WITH
U. S. BUREAU OF PUBLIC ROADS

ROAD NO. Co 141 178

BRIDGE SHEET

SHEET NO. 1-B

PARTY NO. _____

DATE 8-8-67

COUNTY PRINCE GEORGES

RATED CAPACITY _____

FOR ALL STRUCTURES HAVING A TOTAL OPENING OF MORE THAN 20 FEET AS DEFINED IN NOTE 1.

ODOMETER READING ~~2.54~~ 0.29 NAME OF STREAM, RAILROAD OR HIGHWAY CROSSED MATAPONI CREEK

NUMBER OF RAILROAD TRACKS _____
KIND OF CROSSING (NOTE 2) _____

UNDERPASS - SIMPLE UNDERPASS - COMBINED (NOTE 3) OVERPASS BRIDGE OVER SYSTEM

DESCRIPTION

NUMBER OF SPANS	LENGTH EACH SPAN (NOTE 4)	TYPE (NOTE 5)
2	14.5'	WOOD-PILE

TOTAL LENGTH - ON LINE OF ROAD OVER-ALL (NOTE 6) 29'

MATERIAL

SUBSTRUCTURE WOOD SUPERSTRUCTURE WOOD

FLOOR WOOD

CLEARANCES

ROADWAY (NOTE 7) 12' SIDEWALK WIDTHS: RIGHT LEFT

SURFACE OF ROAD TO STREAM BED 7' FOR OVERPASSES, SHOW DISTANCES TO TOP OF RAIL OR SURFACE OF LOWER ROAD. (NOTE 8)

SURFACE OF ROAD TO BOTTOM PORTAL 2' (MINIMUM OVERHEAD CLEARANCE

CLEAR DISTANCE OF OPENING ABOVE STREAM BED 5' (WATERWAYS ONLY)

POSTED LOAD LIMITS _____ BRIDGE NO. _____ CONSTRUCTION DATE _____

GENERAL CONDITION OF BRIDGE: CHECK IF GOOD, FAIR, OR POOR, DESCRIBE DEFECTS IF SERIOUS.

	GOOD	FAIR	POOR
SUPSTRUCTURE	✓		
FLOOR	✓		
SUBSTRUCTURE	✓		
PAINT		BADLY CORRODED OR RUSTED	

TYPE OF PROTECTION FOR DRAWBRIDGES (NOTE 9) _____

(NOTES ON REVERSE SIDE)

S26130

Notes:

1. In agreement with Federal-aid standards, a bridge is defined as a structure including supports erected over a depression or an obstruction, as water, highway, or railway, and having a track or passageway for carrying traffic or other moving loads, and having a length measured along the center of roadway of more than 20 feet between undercoping of abutments or spring lines of arches, or extreme ends of openings for multiple boxes and pipes, where the clear distance between openings is less than half of the smaller contiguous opening.

2. Show kind of crossing by checking descriptive item applicable. For multiple-span bridges give complete information on each span including approach spans. Indicate on leg sheet the odometer reading, position, and angle of skew of structure with respect to center line of road and by arrow the direction of stream flow.

3. Give information on the span over the highway only.

4. For span length use center to center of bearings, otherwise the clear opening. Skew bridges will be measured along center line of road. See Note 1.

5. Show general type such as: Trestle, Truss, Girder, I-Beam, Rigid Frame, Arch, Slab, Suspension, or Covered Bridge. See illustrations attached. Describe draw spans by classifications listed in Article X, Section 2 of Manual.

6. The length of a bridge structure is the over-all length measured along the line of survey stationing back to back of back-walls of abutments, if present, otherwise end to end of bridge floor, but in no case less than the total clear opening of the structure.

7. Give minimum lateral clearance. Where traffic lanes are separated by bridge numbers, show clearance width of each lane separately. Special conditions should be explained by notes.

8. In case of overhead bracing or arch construction, measurement shall be made to the lowest point above the road surface.

9. Use classification listed on RR crossing sheet. Form 4 HPS.

Remarks: _____

A rearrangement of the form similar to that shown on the attachment may be used to provide space for coding.

Form 6 HPS (Rev. 1961) FAR 4-056 78

ROAD INVENTORY SHEET

Party Chief E. SCHUYLER
Recorder W. DOMBROSKI
Chainman

Gen Hwy
871-311 M40
MAP 13
VER 6-21-77

Road No. CO 179
Name NELSON PERRIE RD
Sheet No. 1 OF 1
Date 7 — 17 — 68
County PRINCE GEORGES

CO BALD EAGLE	1	29	170 SCH. RD
	1	21	30°
H	1	15	
30°	1	12	
#P0485P	0	89	
	0	80	PT 30°
	0	77	P.C
H	0	75	
PT 60°	0	58	
16' E FARM 1.00 MI	0	48	600' FARM
P.C	0	45	
	0	39	PT 60°
	0	31	PC
SPUR	0	02	20'I
CO NAYLOR BADEN	0	00	229 RD 2-3E SHO

Form 6 HPS (Rev. 1961) MAPS 10+11 FAR 78

4-058 ✓

ROAD INVENTORY SHEET

PARTY CHIEF Frederick Settan
RECORDER Thomas Landon
CHAINMAN

ROAD NO. Co 180
NAME NOTTINGHAM RD
SHEET NO. 10 F 2
DATE 8-8-67
COUNTY PRINCE GEORGES

872-323 M40 VER 6-20-77

	1 54	DR	
H	1 28	FWMD RD 178	
	1 17 SPUR Co		
	1 15		
H	1 14	H	
	1 12 CANDY HILL RD	H	
	1 01	F	
FAS 306	0 75		
	0 57	F	
	0 44	F	
	0 21	H	
	0 14	H	
	00 526		
	009 OP'I	90°↑	
	006	B-ABAN	16'F
			2-3'ES SHLD
	003	H	30'CW
TANYARD Co	001	RD	
	000	3648	✓

Form 6 HPS (Rev. 1961)

78

ROAD INVENTORY SHEET

PARTY CHIEF Frederick Settan
RECORDER Thomas Landon
CHAINMAN

ROAD NO. Co 180
NAME
SHEET NO. 2 OF 2
DATE 8-8-67
COUNTY PRINCE GEORGES

	MD	285	382
	H	267	
		234	DR
		PVT RD 0 W T	
	F	224 10'D A	PT 40°
		219	PC
	H	203	
		PVT RD 0	
	F	196 9'E W T	
	F	168	
		161	F

3'6

SAME

Form 6 HPS (Rev. 1961)

1-587 78

Co. 181

ROAD INVENTORY SHEET

Party Chief E SCHUYLER
Recorder W. DOMBROSKI
Chainman

MAP 2

844-448 M27

Road No. 67-13
Name ETHAN CT
Sheet No. 1 OF 1
Date 5-16-69
County PRINCE GEORGES

E ↑ VER 5-9-78

~~CUL-DE~~ 018 ~~SAC~~

D E

CUL 007 SAC

CU 158 (67-12)

SILVERBIRCH 000 LA

26 I

JC-C

Form 6 HPS (Rev. 1961)

FAU

5-011
URBAN

78

ROAD INVENTORY SHEET

Party Chief E.S.
Recorder W.D.
Chainman

Gen Hwy
882-414 M32

Ver
5-31-78

Road No. CO 182
Name AVONDALE DR.
Sheet No. 1 OF 1
Date 7-9-68
County PRINCE GEO.

		CO 1901	
CAMBRIDGE	0 32	CT	^
	0 29	H	
	0 25	H	
H	0 24		
		CO 1903	
	0 23	ZEA DR	
H	0 19		
H	0 16		
		CO 1907	
	0 15	ABBEY DR.	
H	0 13		
H	0 10		
H	0 06	H	
	0 04	PT	
		45° ↑	
	0 01	P.C.)	
			20' I
CO		176	2-4' ESHO
OXFORD	C 00	CT	✓

Form 6 HPS (Rev. 1961) FAR 4-005-A 78

ROAD INVENTORY SHEET

RIVER AIRPORT RD.

Party Chief E. SCHUYLER
Recorder W. DOMBROSKI
Chainman

Geo Hwy MAP 14

Road No. Co 183
Name ~~AIRPORT RD.~~
Sheet No. 1 OF 1
Date 7 — 17 — 68
County PRINCE GEORGES

E VER 6-21-77 879-306 M40

		9'E 600' FARM	
		9'E	
ROAD	1 26	600' FARM	END
H	1 11		
	1 06	PT 70°	
	0 99	PC H	
H	0 92		
PT 60°	0 85		
PRC	0 76	PRC 50°	
	0 70	PC FARM	
FARM 600'	0 50		
H	0 40		
H	0 38		
9'E			
FARM 1500'	0 32		
	0 26	FARM	
	0 18	FARM	
FARM	0 06		18'I 2-3'E SHD
MD	0 00	382	

Form 6 HPS (Rev. 1961) FAR 4-083 78

ROAD INVENTORY SHEET

Party Chief E. SCHUYLER
Recorder W. DOMBROSKI
Chainman

Gen. Hwy

Road No. CO 184
Name WHITES LDG. RD
Sheet No. 1 OF 1
Date 7 — 17 — 68
County PRINCE GEORGES

E ↑ VER 6-21-77 MAP 14 881-304 M40

PATUXENT RIVER

ROAD ~~087~~ END

T 75° ~~084~~

4 ~~085~~ 12'E ~~12'E~~

CHAIN

ROAD 078 END

057 PT
35°
055 PC

9'E
DSOHE FARM
040

011 DR.
001
000 382
MD

12'F
2-3'E SHLD
20'C-W

Form 6 HPS (Rev. 1961)

FAR (92-149) GD/A. HATTEN 2-23-93

89 Ex #2 2-16-90 BB | BB 4-047

MCKENDREE RD

ROAD INVENTORY SHEET

Party Chief E. SCHUYLER

Recorder W. DOMBROSKI

Chainman

Glen Hwy

66-18
64-107
66-17

6R-202 MAP 13

VER 6-21-77 862-304 #12, H11

Road No. CO 185

Name CEDARVILLE RD 4-019

Sheet No. 1 OF ~~2~~ 7

Date 7 — 19 — 68

County PRINCE GEORGES

NON FA MINOR COLLECTOR - RURAL

	H	0	75	
	PT 30° PC	0	64	H
		0	60	
	H	0	55	
	H 500'	0	48	
	H	0	46	
		0	44	H
	H	0	41	
	H	0	21	H
		0	17	DE
	H	0	14	
	H	0	10	
		008		PT 30° PC
	H	0	03	H
	H	0	01	20' I
			381	2-3' E S40
	MD	000		30 CW 2 MC

W

Form 6 HPS (Rev. 1961)

ROAD INVENTORY SHEET

Party Chief F. SCHUYLER
Recorder W. DOMBROSKI
Chainman

Road No. CO 185
Name CEDARVILLE RD
Sheet No. 2 OF 7
Date 7-19-68
County PRINCE GEORGES

NON FA MINOR COLLECTOR - RURAL

		125	H	
		122	H	
		119	H	
	C.B.C.	116	12'L 24'W, 5'D	# PO 409
		102	CH.	
		099	CEM.	
	FARM 400'	098		
		097	DR	
	(RXR)	095	H	
	H 300' H	089		
	U.S. RXR	088	~~OUT RR~~ ~~IRC~~ 532 2830 RXR CR 1 TRACK	
		086	~~CO 163~~ ASHBOX RD	
		084	GAS STA	
		082	(RXR)	
	H	079	H	
	H	077	H	SAME

Form 6 HPS (Rev. 1961)

18

ROAD INVENTORY SHEET

Party Chief E. SCHUYLER
Recorder W. DOMBROSKI
Chainman

Road No. CO 195
Name CEDARVILLE RD
Sheet No. 3 OF 9 7
Date 7 - 19 - 68
County PRINCE GEORGES

		H	1	94	H
			1	90	
		H	1	87	7 H
			1	80	
		H	1	75	H
			1	73	H
			1	71	H
			1	62	H
			1	60	300' H
		DR.	1	56	H
			1	51	H
					PINE DR
			1	50	OP 20
			1	45	H
			1	39	3 H
		FOREST RD	1	31	
		SR-114 (X-143) TX-113			
		ENT. TO CEDARVILLE ST. PARK	1	29	SAME

NON FA
MINOR COLLECTOR - RURAL
FA

Form 6 HPS (Rev. 1961)

ROAD INVENTORY SHEET

Party Chief E. SCHUYLER
Recorder W. DOMBROSKI
Chainman

Road No. Co 185
Name CEDARVILLE RD
Sheet No. 4 OF 7
Date 7 - 19 - 68
County PRINCE GEORGES

NON FH — MINOR COLLECTOR - RURAL — FAP 354

	PT 35° PC	3 22 3 16	
		3 05	PT 35° PC
Bee OAK RD		3 02	
OP 4358		2 75	
	PT 50° PC	2 61 2 54	
Co 186 DENT RD		2 37	H
		~~2 35~~	~~BRISCO RD~~ (90-294 ABANDON)
		2 33	PT 30°
		2 31	PC
		2 30	DE
OP 496		2 25	T T T T T
CEDARVILLE TRAILER PARK		2 18	
H		2 16	
		2 14	H
CBC		2 06	8'C, 24'W, 5'D
H		1 96	SAME

Form 6 HPS (Rev. 1961)

ROAD INVENTORY SHEET

Party Chief E. SCHUYLER
Recorder W. DEMBROSKI
Chainman

M13
62-202

Road No. CO 185
Name CEDARVILLE RD
Sheet No. 5 of 97
Date 7 - 19 - 68
County PRINCE GEORGES

		4 16	
		4 11	H
NON FA MINOR COLLECTOR - RURAL	MADAWOMEN	3 94	#P0407 CREEK SEE SHEET 1A
	PT 40° PC	3 85	
	~~[illegible]~~ ~~[illegible]~~ COUNTRY LA	3 80	
	~~MIDDLE~~ ~~BASE~~ Co 4759	3 77	H
		3 75	H
	H	3 72	
		3 57	1000' FARM
	PT 12.1° E FARM 1200 60° PC	3 55	
		3 53	
		3 49	
		3 39	DE
		3 32	600' FARM
		3 28	PT 30°
		3 26	PC SAME

Form 6 HPS (Rev. 1961)

(92-149)
CD - A. HATTEN
2-23-93

78

ROAD INVENTORY SHEET

Party Chief E. SCHUYLER
Recorder W. DOMBROSKI
Chairman

Road No. CD 185
Name CEDARVILLE RD
Sheet No. 6 OF 17
Date 7 - 19 - 68
County PRINCE GEORGES

				38'I
				JC-C
				2 ML
	FARM 12'F			
	700'	4	89	X
		4	85 PT (30°)	
		4	78 PC	
		4	73 H	
			CR	
	(S,L,L) SIGN		#PC 532 295 N	
	PA	4	68 SIGN (S,L,L) RR TRACK	
	10'F		OLD INDIAN HEAD RD	
	H 500'	4	67 ~~OLD INDIANHEAD RD~~	
	10'F	4	66 CO 414	
H	400'	4	64	
	H	4	61	
		4	60 RXR H	
		4	45 30°J DR	
				20'I
	OP 19	4	38	2-3'E SHD
				2 ML
	H	4	34	
			9'D	
		4	19 1200' FARM	
	H	4	17	SAME

MINOR COLLECTOR - RURAL
NON FA

SHA 51.3-8
11-15-72

STATE HIGHWAY ADMINISTRATION OF MARYLAND

78

ROAD INVENTORY SHEET

Party Chief E.S.
Recorder W.D.
Helper (M.2. OFFICE)

Map No. _____

Road No. Co, 185
Road Name CEDARVILLE RD.
Sheet No. 7 OF 7
Date 7-19-68
County PR. GEO.
State Coordinates _____

RD
McKENDREE
Co. 3863

U.S. 5 08 301 TL 22I
J FJ JC-RT
5 04 J 2MC
5 02 H E 48 I
J 4 99 JC-C
FJ 4 95 3 ML
4 94 E X
4 92 same

NON FH
MINOR COLL. - RURAL
PT
30°
PC

SHA 51.3-8
11-15-72

ROAD INVENTORY SHEET

Road No. _____
Road Name _____
Sheet No. _____
Date _____
County _____
State Coordinates _____

P & P 104

RAILROAD GRADE CROSSING SHEET

State Roads Commission of Maryland
Planning and Programming Division

1. GENERAL

Crossing No. 046

Mile Pole Number (R.R. Co.) ... NONE

Coordinates ..... x 857 y 303

System Classification
(Check One)

State Primary ..... ☐ + 0.88

State Secondary ..... ☐

State Road Only ..... ☐

County ..... ☑

Local ..... ☐
(Specify)

County and/or Municipality .. PRINCE GEORGE

U.S. Route Number .....

State Route Number .....

Road Number/Name ..... CEDARVILLE RD Co 185

Station .....

Surface Type ..... 18' I

Name of Railroad ..... U.S. GOVERNMENT

Number of Main Tracks 1

Number of Other Tracks ..... NONE

2. TRAIN MOVEMENTS

Time Period	Pass	Freight	Train Speed at Grade: Pass	Train Speed at Grade: Freight	Spur	Remarks (Other than daily): Pass	Remarks (Other than daily): Freight
Day 6 A.M. to 6 P.M.							
Night 6 P.M. to 6 A.M.							
24 Hour Total							

3. TYPE OF PROTECTION

a. 2 Warning Signs - Reflectorized, (Non-reflectorized)

b. 2 Crossing Signs - Reflectorized, (Non-reflectorized)

c. — Road Marking

d. — Lights - Flashing, Stationary

e. — Traffic Control (Stop and Go) Signals

f. — Automatic Gate

g. — Watchman - Gate, Flag...hours

h. — Others

* By numerals 1 or 2 indicate whether installation is on one or both sides of track.

4. ALIGNMENT FACTOR

P. 750'

N. 750'

Average Daily Trains ...

Train Speed .....

Highway ADT.....

Highway Speed Limit ... 30 MPH

Average Vehicle Speed . 30 MPH

Max. Approach Grade .. N+0.6, P.0

Restricted Sight Distance . (On Highway)

5. QUADRANT ... SIGHT DISTANCE

		@300'	@10'
A	120°	300'	590'
B	60°	0	50'
C	60°	0	300'
D	120°	300'	590'

6. ACCIDENT RECORD
(Vehicles & Trains)

Year	No. of Accidents	No. of Fatalities
1961		
1962		
1963		
1964		
1965		
Total		

7. CROSSING RATING

A

B

C

D

Total

State Roads Commission of Maryland
Planning and Programming Division

Party _____
Date 10/23/69

DIAGRAM FOR RAILROAD GRADE CROSSING

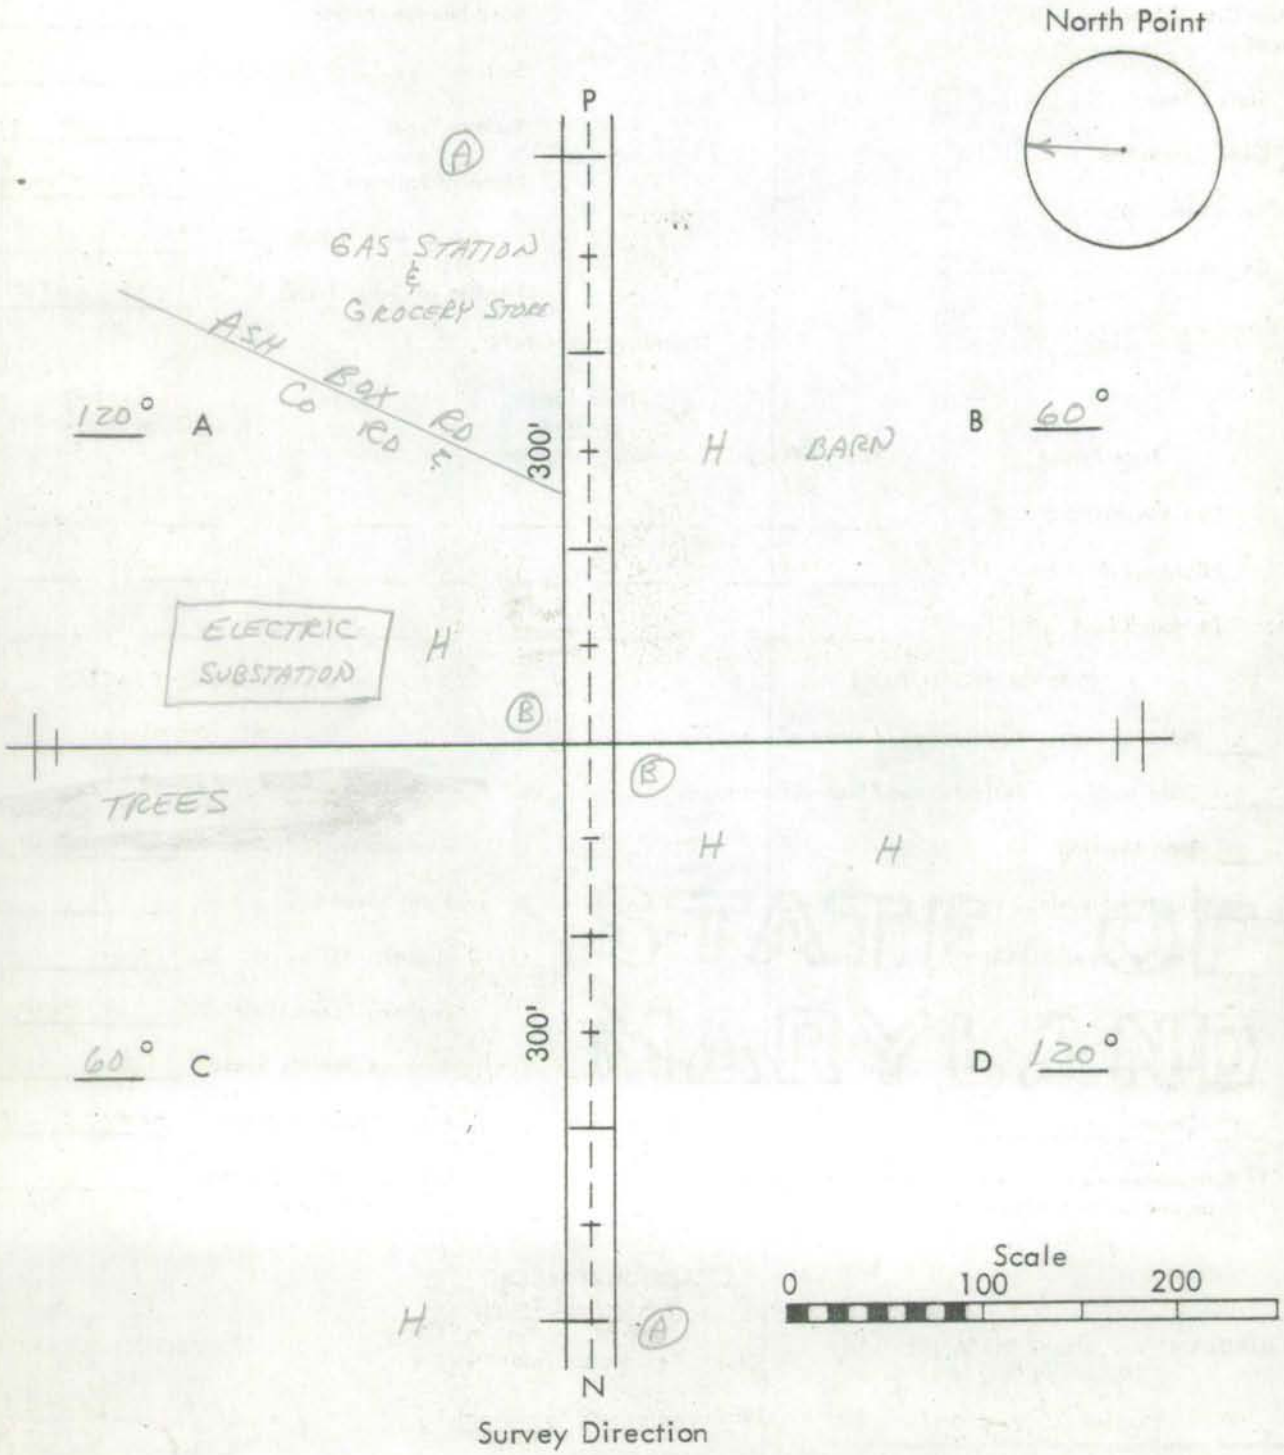

Survey Direction

Remarks: _____

CROSSING NO. 046
COUNTY # 185
CEDARVILLE RD.

TURN PICTURES OVER

1

2

3

4

RAIL ROAD
CROSSING

RAIL ROAD
CROSSING

PRINCE GEORGE Co 10/23/69

PICTURE TAKEN FACING EAST
ON Co 185 CEDARVILLE RD

E935122

1

PRINCE GEORGES Co 10/23/69

PICTURE TAKEN FACING WEST
ON Co 185 CEDARVILLE RD

E935122

2

PRINCE GEORGE Co 10/23/69

PICTURE TAKEN FACING NORTH
ON Co 185 CEDARVILLE RD

E935122

3

PRINCE GEORGE Co 10/23/69

PICTURE TAKEN FACING SOUTH
ON Co 185 CEDARVILLE RD

E935122

4

P & P 104

RAILROAD GRADE CROSSING SHEET

State Roads Commission of Maryland
Planning and Programming Division

1. GENERAL

Crossing No. 001

Mile Pole Number (R.R. Co.) ... NONE

Coordinates ..... x 838 y 303

System Classification
(Check One)

State Primary ..... ☐ +4.68

State Secondary ..... ☐

State Road Only ..... ☐

County ..... ☑

Local ..... ☐
(Specify)

County and/or Municipality .. PRINCE GEORGE

U.S. Route Number .....

State Route Number .....

Road Number/Name ..... CEDARVILLE RD Co 185

Station .....

Surface Type ..... 19'6

Name of Railroad ..... PENN CENTRAL

Number of Main Tracks 1

Number of Other Tracks ..... NONE

2. TRAIN MOVEMENTS

Time Period	Pass	Freight	Train Speed at Grade Pass	Train Speed at Grade Freight	Spur	Remarks (Other than daily) Pass	Remarks (Other than daily) Freight
Day 6 A.M. to 6 P.M.							
Night 6 P.M. to 6 A.M.							
24 Hour Total							

3. TYPE OF PROTECTION

a. 4 Warning Signs - Reflectorized, (Non-reflectorized)

b. — Crossing Signs - Reflectorized, Non-reflectorized

c. — Road Marking

d. — Lights - Flashing, Stationary

e. — Traffic Control (Stop and Go) Signals

f. — Automatic Gate

g. — Watchman - Gate, Flag...hours

h. — Others

* By numerals 1 or 2 indicate whether installation is on one or both sides of track.

4. ALIGNMENT FACTOR

P. 600'

N. 600'

Average Daily Trains ...

Train Speed .....

Highway ADT.....

Highway Speed Limit ... 40 MPH

Average Vehicle Speed . 40 MPH

Max. Approach Grade .. -0.2 (BOTH)

Restricted Sight Distance . NO
(On Highway)

5. QUADRANT ... SIGHT DISTANCE

	@300'	@10'
A 70°	0	300'
B 110°	1000'	1010'
C 110°	0	300'
D 70°	1000'	1010'

6. ACCIDENT RECORD (Vehicles & Trains)

Year	No. of Accidents	No. of Fatalities
1961		
1962		
1963		
1964		
1965		
Total		

7. CROSSING RATING

A

B

C

D

Total

State Roads Commission of Maryland
Planning and Programming Division

Party _____
Date 10/23/69

DIAGRAM FOR RAILROAD GRADE CROSSING

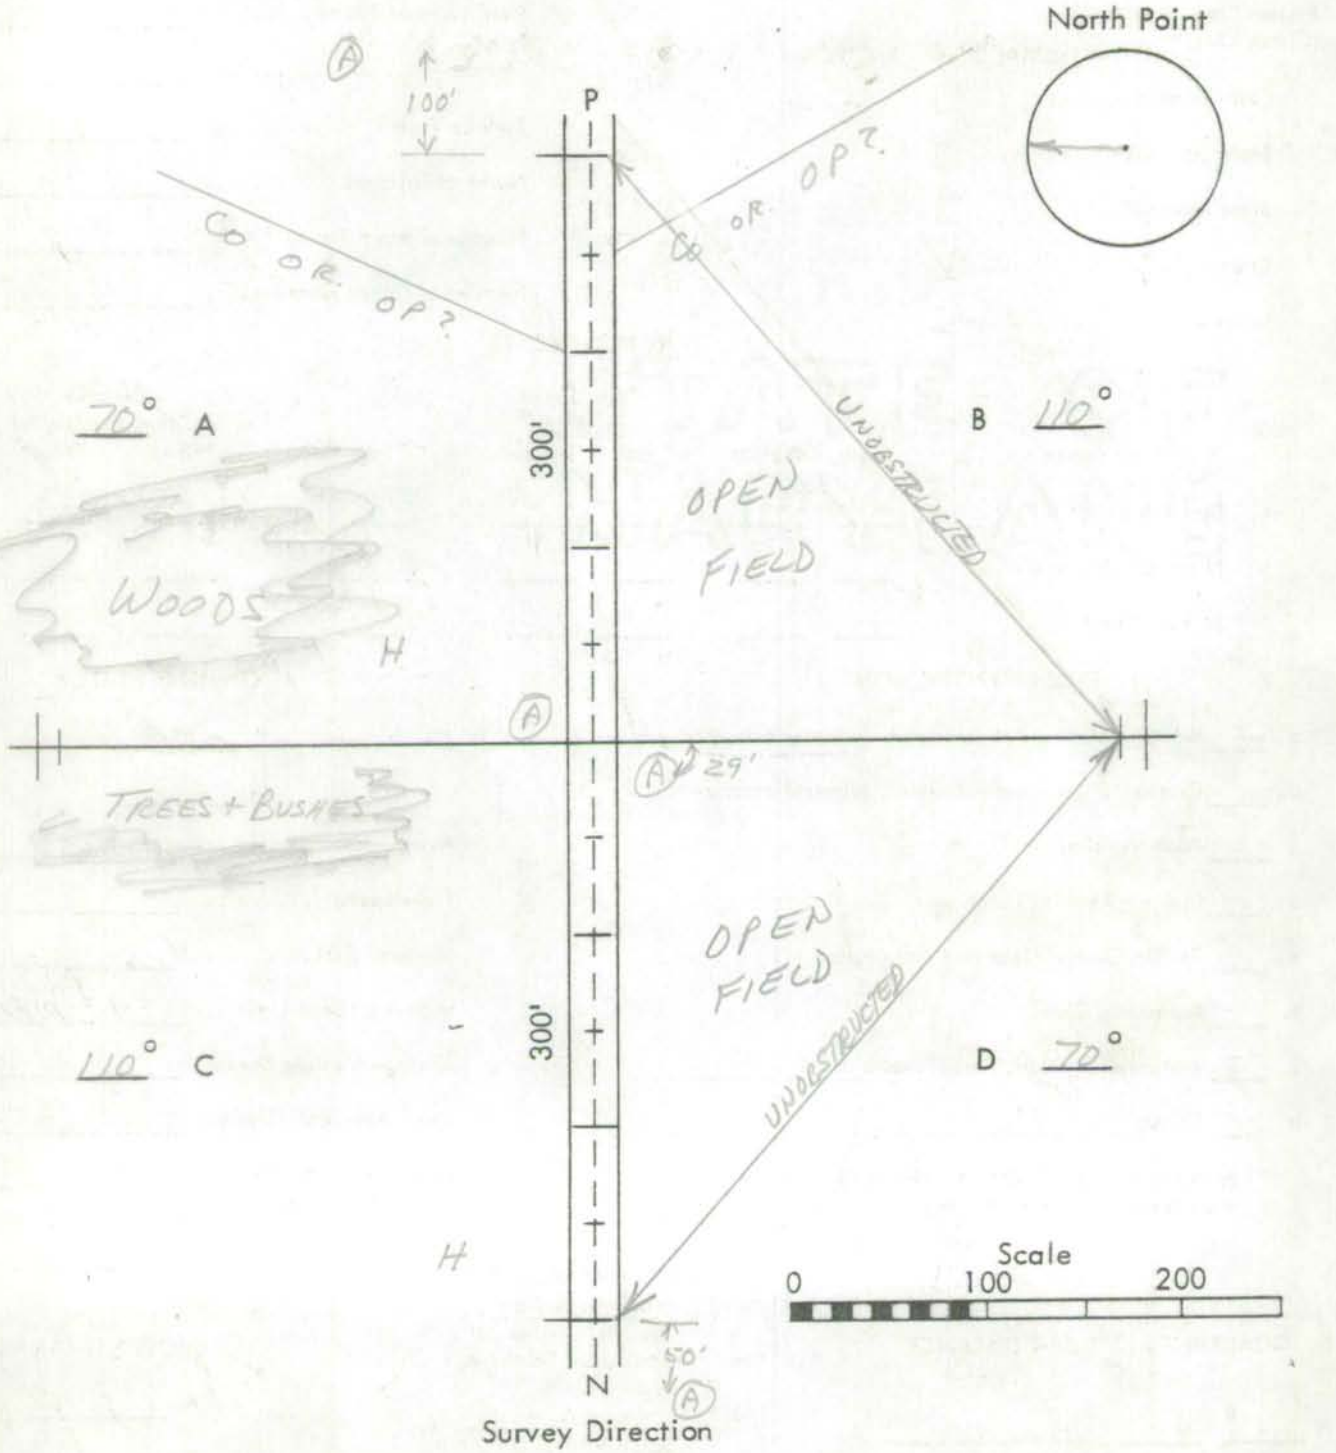

Remarks: _____

CROSSING
#001

COUNTY #185
CEDARVILLE RD.

TURN PICTURES OVER

1

2

3

4

STOP

PRINCE GEORGE Co 10/23/69

PICTURE TAKEN FACING SOUTH
ON Co 185 CEDARVILLE RD

E935122

1

PRINCE GEORGE Co 10/23/69

PICTURE TAKEN FACING NORTH
ON Co 185 CEDARVILLE RD

E935122

2

PRINCE GEORGE Co 10/23/69
PICTURE TAKEN FACING WEST
ON Co 185 CEDARVILLE RD

E935122

3

PRINCE GEORGES Co 10/23/69

PICTURE TAKEN FACING EAST ON
Co 185 CEDARVILLE RD

E935122

4

Form 5-HPS (Revised 1961) MARYLAND STATE ROADS COMMISSION PLANNING AND PROGRAMMING DIVISION S26130

IN COOPERATION WITH
U. S. BUREAU OF PUBLIC ROADS

ROAD NO. CO 185

BRIDGE SHEET

SHEET NO. 1 A

PARTY NO.

DATE 7-19-68

COUNTY PRINCE GEO

RATED CAPACITY

FOR ALL STRUCTURES HAVING A TOTAL OPENING OF MORE THAN 20 FEET AS DEFINED IN NOTE 1.

ODOMETER READING 3.94 NAME OF STREAM, RAILROAD OR HIGHWAY CROSSED MADAWOMEN CREEK

NUMBER OF RAILROAD TRACKS

KIND OF CROSSING (NOTE 2)

UNDERPASS-SIMPLE UNDERPASS-COMBINED (NOTE 3) OVERPASS BRIDGE OVER SYSTEM STREAM

DESCRIPTION

NUMBER OF SPANS	LENGTH EACH SPAN (NOTE 4)	TYPE (NOTE 5)
1	17'	I BEAM
1	19'	I BEAM

TOTAL LENGTH-ON LINE OF ROAD OVER-ALL (NOTE 6)

MATERIAL

SUBSTRUCTURE WOOD BEAM & IRON SUPERSTRUCTURE

FLOOR CORAGATED METAL WITH BIT MIX

CLEARANCES

ROADWAY (NOTE 7) 26' SIDEWALK WIDTHS: RIGHT NONE LEFT

SURFACE OF ROAD TO STREAM BED 6' FOR OVERPASSES, SHOW DISTANCES TO TOP OF RAIL OR SURFACE OF LOWER ROAD. (NOTE 8)

SURFACE OF ROAD TO BOTTOM PORTAL (MINIMUM OVERHEAD CLEARANCE

CLEAR DISTANCE OF OPENING ABOVE STREAM BED 5' (WATERWAYS ONLY)

POSTED LOAD LIMITS 14,000 LB BRIDGE NO. CONSTRUCTION DATE

GENERAL CONDITION OF BRIDGE: CHECK IF GOOD, FAIR, OR POOR, DESCRIBE DEFECTS IF SERIOUS.

	GOOD	FAIR	POOR
SUPERSTRUCTURE	✓		
FLOOR		✓	
SUBSTRUCTURE		✓	
PAINT			BADLY CORRODED OR RUSTED

TYPE OF PROTECTION FOR DRAWBRIDGES (NOTE 9)

(NOTES ON REVERSE SIDE)

S26130

Notes:

1. In agreement with Federal-aid standards, a bridge is defined as a structure including supports erected over a depression or an obstruction, as water, highway, or railway, and having a track or passageway for carrying traffic or other moving loads, and having a length measured along the center of roadway of more than 20 feet between undercoping of abutments or spring lines of arches, or extreme ends of openings for multiple boxes and pipes, where the clear distance between openings is less than half of the smaller contiguous opening.

2. Show kind of crossing by checking descriptive item applicable. For multiple-span bridges give complete information on each span including approach spans. Indicate on leg sheet the odometer reading, position, and angle of skew of structure with respect to center line of road and by arrow the direction of stream flow.

3. Give information on the span over the highway only.

4. For span length use center to center of bearings, otherwise the clear opening. Skew bridges will be measured along center line of road. See Note 1.

5. Show general type such as: Trestle, Truss, Girder, I-Beam, Rigid Frame, Arch, Slab, Suspension, or Covered Bridge. See illustrations attached. Describe draw spans by classifications listed in Article X, Section 2 of Manual.

6. The length of a bridge structure is the over-all length measured along the line of survey stationing back to back of back-walls of abutments, if present, otherwise end to end of bridge floor, but in no case less than the total clear opening of the structure.

7. Give minimum lateral clearance. Where traffic lanes are separated by bridge numbers, show clearance width of each lane separately. Special conditions should be explained by notes.

8. In case of overhead bracing or arch construction, measurement shall be made to the lowest point above the road surface.

9. Use classification listed on RR crossing sheet. Form 4 HPS.

Remarks: _____

_____

A rearrangement of the form similar to that shown on the attachment may be used to provide space for coding.

Form 6 HPS (Rev. 1961)

FAR

4-026

ROAD INVENTORY SHEET

849-301 M40
Gen Hwy

Party Chief E.S.
Recorder W.D.
Chainman

Road No. CO 185
Name DENT RD
Sheet No. 1 OF 1
Date 7-24-68
County PRINCE GEO

MAP 40
849-301

MAP 13
VER
C-23-77

MD 381 382 CHARLES CO

COUNTY LINE 101 CHARLES CO END MAINTANCE SIGN

SAME

0 97 H

0 93 H

FARM 600' 0 70

H 0 38

BEG 0 54 OAK DR

OP 0 40 4758

0 30 30°

H 0 10

185 RD

CO CEDARVILLE 000

16'6
2-3½ SHO

Form 6 HPS (Rev. 1961) FAR OP 1279 4-049 78

ROAD INVENTORY SHEET

Party Chief E.S.
Recorder W.D
Chainman

~~Gen Hwy~~ MAP 14
VER 6-21-77
E
0880-292 M40

Road No. Co 187
Name MILL TOWN LANDING RD
Sheet No. 1 OF 1
Date 7-16-68
County PRINCE GEO.

ROAD H	1	22	END	
	1	19	H	
	1	08	45°	10'E 14'CW
	0	98		
	0	94	H	
H	0	90		
	0	59	P.T. 30°	
	0	56	P.C. FARM	
85°	0	49		14'E 14'CW
9'E FARM 0.20 Mi.	0	48		
	0	44	H	
	0	38	PT 30°	
	0	36	PC	
PT 30°	0	29		
P.C	0	24		18'I 2-3'E SHO 26'CW
MD	0	00	382	

O.P. 1279

Form 6 HPS (Rev. 1961) FAU MAPS 5-202 URBAN 78

ROAD INVENTORY SHEET

Party Chief E.S.
Recorder W.D
Chainman

Gen Hwy

Road No. CO 188
Name PARK DR.
Sheet No. 1 OF 1
Date 7-9-68
County PRINCE GEO

S ↑ VER 5-31-78 881-414 M32

	ROAD	0	35 END	^
	CO		176	
	OXFORD	0	29 CT	
	H	0	23	
	H	0	20 H	
	H	0	17 H	
	H	0	15 H	
		0	12 H	
		0	07 H	
	H	0	06	
	H	0	02 H	
				20' I
	CO		1901	24'E SHO
	CAMBRIDGE	0	00 CT	v

Form 6 HPS (Rev. 1961) FAR 4-009

ROAD INVENTORY SHEET

Party Chief E. SCHUYLER
Recorder W. DOMBROSKI
Chainman

~~Gen Hwy~~

MAP 13414
881-296 m40

Road No. Co 189
Name BADEN WESTWOOD
Sheet No. 1 OF 4
Date 7 — 17 — 68
County PRINCE GEORGES

		0 54	↑ 300°	
		0 51	H	
	H	0 49		
		0 47	H	
		0 44	H	
	H 400°	0 41		
	P.T 35°	0 40		
	P.C.	0 37		
	H	0 29		
	H P.T 30°	0 24		
W ↑	P.C.	0 21		
	H	0 18		
		0 13	P.T 60°	
		0 07	P.C.	
	ATLT TOWER	0 03		20' G
				23E SHO
	MD	0 00	382	28'C-W

Form 6 HPS (Rev. 1961)

ROAD INVENTORY SHEET

Party Chief E. SCHUYLER
Recorder W. DOMBROSKI
Chainman

Road No. CO 189
Name BADEN WESTWOOD RD
Sheet No. 2 OF 9
Date 7 - 17 - 68
County PRINCE GEORGES

	223	~~WESTWOOD RD~~ CO 189
H	216	
	211	H PT
H	209	H 35°
	209	P.C.
4 M		
	194	
PT	192	300' H
50°		
PC	188	
CONTROL STA	181	
	~~179~~	
	167	H
FARM 300'	157	H
		CO 170
	149	BALD EAGLE SCHOOL RD
H	105	
H	092	
H	083	
FARM 300'	076	
H	072	SAME

Form 6 HPS (Rev. 1961)

ROAD INVENTORY SHEET

Party Chief E. SCHUYLER
Recorder W. DOMBROSKI
Chainman

MAP 13

Road No. CO 189
Name GADEN WESTWOOD RD
Sheet No. 3 OF 9
Date 7-17-68
County PRINCE GEORGES

H (PT 60° PC)	303	
	300	
	297	H
	292	PT 60° H
	280	PC H
	273	H
	271	DR.
398	267	H
FAS	260	H
	255	H
H	251	
OP 279	243	
H	238	
	236	500' FARM
30°	230	
H	229	SAME

SHA 51.3-8
11-15-72

STATE HIGHWAY ADMINISTRATION OF MARYLAND

>8

ROAD INVENTORY SHEET

Party Chief W.D. (E.S.)
Recorder M.Z. (W.D.)
Helper

Map No.

Road No. Co. 189
Road Name BADEN WESTWOOD RD.
Sheet No. 4 of 4
Date 6-22-77 (7-17-68)
County PR. GEO
State Coordinates

			381	
	MD	387		
		383		
	5 H			
		376		
1 PT	H	374	H	
45°				
PC	H	366	H	
	H	362	H	
1 PT	C&P TELEPHONE	357	CHURCH HALL	
	HORSEHEAD RD			
45°	Co. 191	353	CHURCH & CEM	
				20'I
PC	BADEN ELE SCH	347		2-3'E SHD
			NAYLOR BADEN RD	30'CW
		340	Co 229 90°	X2ML
			16'E	
		326	H	
	CHURCH	323		
	H	319		
		307	H	same

SHA 51.3-8
11-15-72

ROAD INVENTORY SHEET

Road No. _____
Road Name _____
Sheet No. _____
Date _____
County _____
State Coordinates _____

Form 6 HPS (Rev. 1961)

ROAD INVENTORY SHEET

Party Chief E. SCHUYLER
Recorder W. DOMBROSKI
Chainman

Road No. CO 189
Name BADEN WESTWOOD RD
Sheet No. 4 OF 4
Date 7-17-68
County PRINCE GEORGES

		381		
	MD	387		
	S H	383		
		376		
PT	H	374	H	
45°				
PC	H	366	H	
	H	362	H	
PT	C&P TELEPHONE	357	CH. HALL	
	HORSEHEAD RD.			
45°	CO. 191	353	CHURCH & CEM.	20' I
				2-3'C SHD
PC	BADEN ELE. SCH	347		30' C/L
			CO. 229	2 ML
		340	NAYLOR BADEN RD 90°	
			16'E	
		326	H	
	CH.	323		
	H	317		
		307	H	SAME

Form 6 HPS (Rev. 1961)

FAR

4-046

78

ROAD INVENTORY SHEET

867-317
M40
Green Hwy

PARTY CHIEF Frederick Settan
RECORDER Thomas Landon
CHAINMAN

VER 6-20-77 MAP 13

ROAD NO. Co 190
NAME MARTIN RD
SHEET NO. 1 OF 2
DATE 8-9-67
COUNTY PRINCE GEORGES

	1	41	H	
	1	34	DR	
H	1	31		
26 / 0 PVT RD 10'D	1	22		
	1	10	H	
28 / 0 PVT RD 10'D	1	07		
F	0	84	F	
	0	81	H	
	0	66	H PT 30°	
	0	61	PC	
H	0	56		
PT 30°	0	22		
PC	0	17		
H	0	08		16'F
F-200'-H	0	05		2-3'ESHs 28'cw
~~Rock Bridge~~ MOLLY BERRY RD				
Co	0	00	140 ~~172~~ ~~3851~~	

Form 6 HPS (Rev. 1961)

78

ROAD INVENTORY SHEET

PARTY CHIEF Frederick Settan
RECORDER Thomas Landon
CHAINMAN

ROAD NO. Co 190
NAME
SHEET NO. 2 of 2
DATE 8-9-67
COUNTY PRINCE GEORGES

NORTH HOLLYS RD Co 172

2 16

2 15 NORTH HOLLYS RD Co 172

2 12

PT 35° PC

2 09

1 94 H

1 91 DR

H 1 58

1 56 H

1 49 H

1 46 H

1 44 H

SAM 5

SHA 51.3-8
11-15-72

STATE HIGHWAY ADMINISTRATION OF MARYLAND

DB/CG
2/3/88
87-10
(EXTRA)

78

ROAD INVENTORY SHEET

Party Chief W.D. (E.S.)
Recorder M.Z. (W.D.)
Helper

Map No. 40 H-12

Road No. Co. 191
Road Name HORSEHEAD RD.
Sheet No. 1 OF
Date 6-22-77 (7-17-68)
County PR. GEO.
State Coordinates 865-301

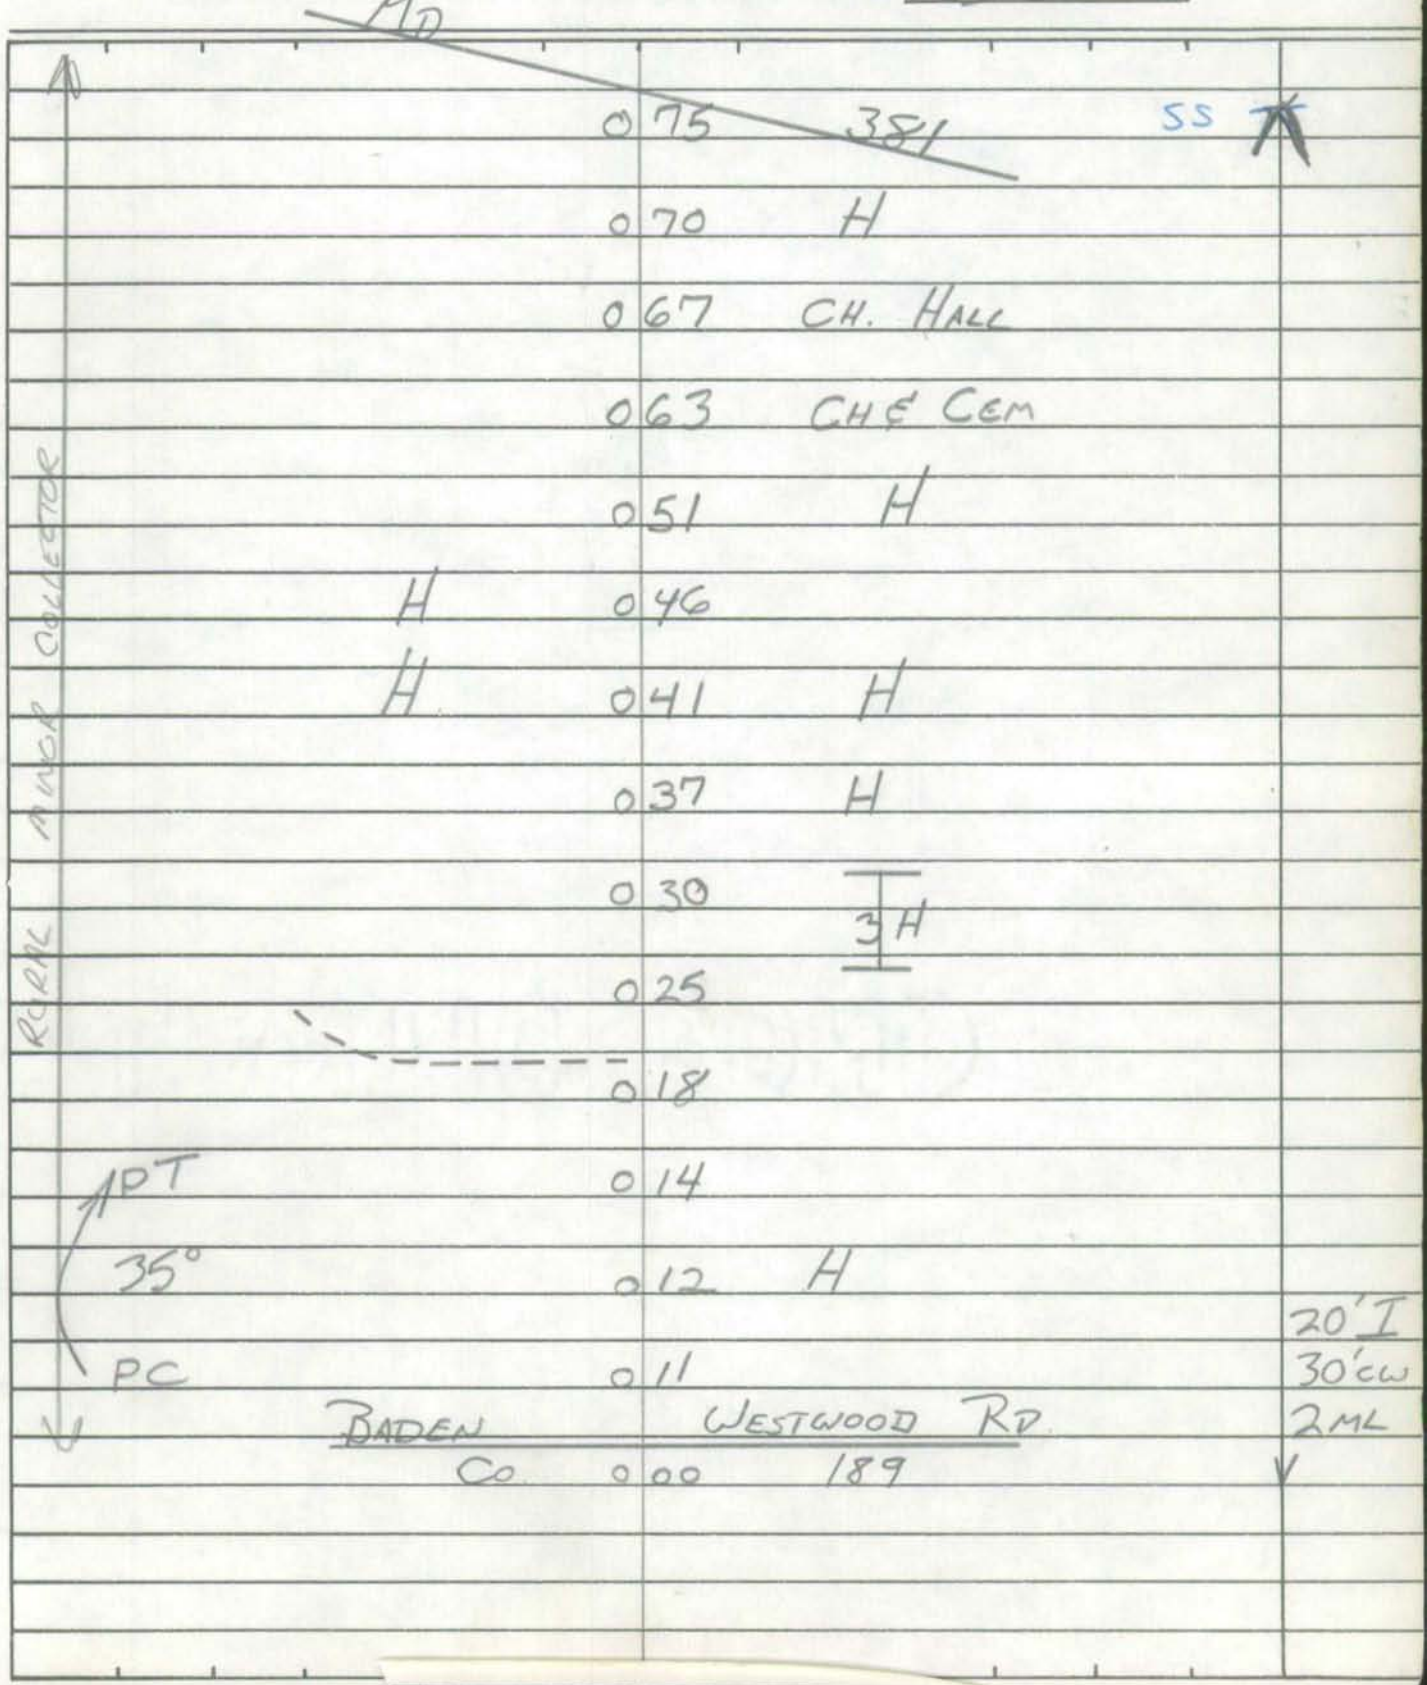

SHA 51.3-8
11-15-72

ROAD INVENTORY SHEET

Road No. Co. 191
Road Name HORSEHEAD RD
Sheet No. 2 OF 2
Date 6-22-77
County PR GEO
State Coordinates

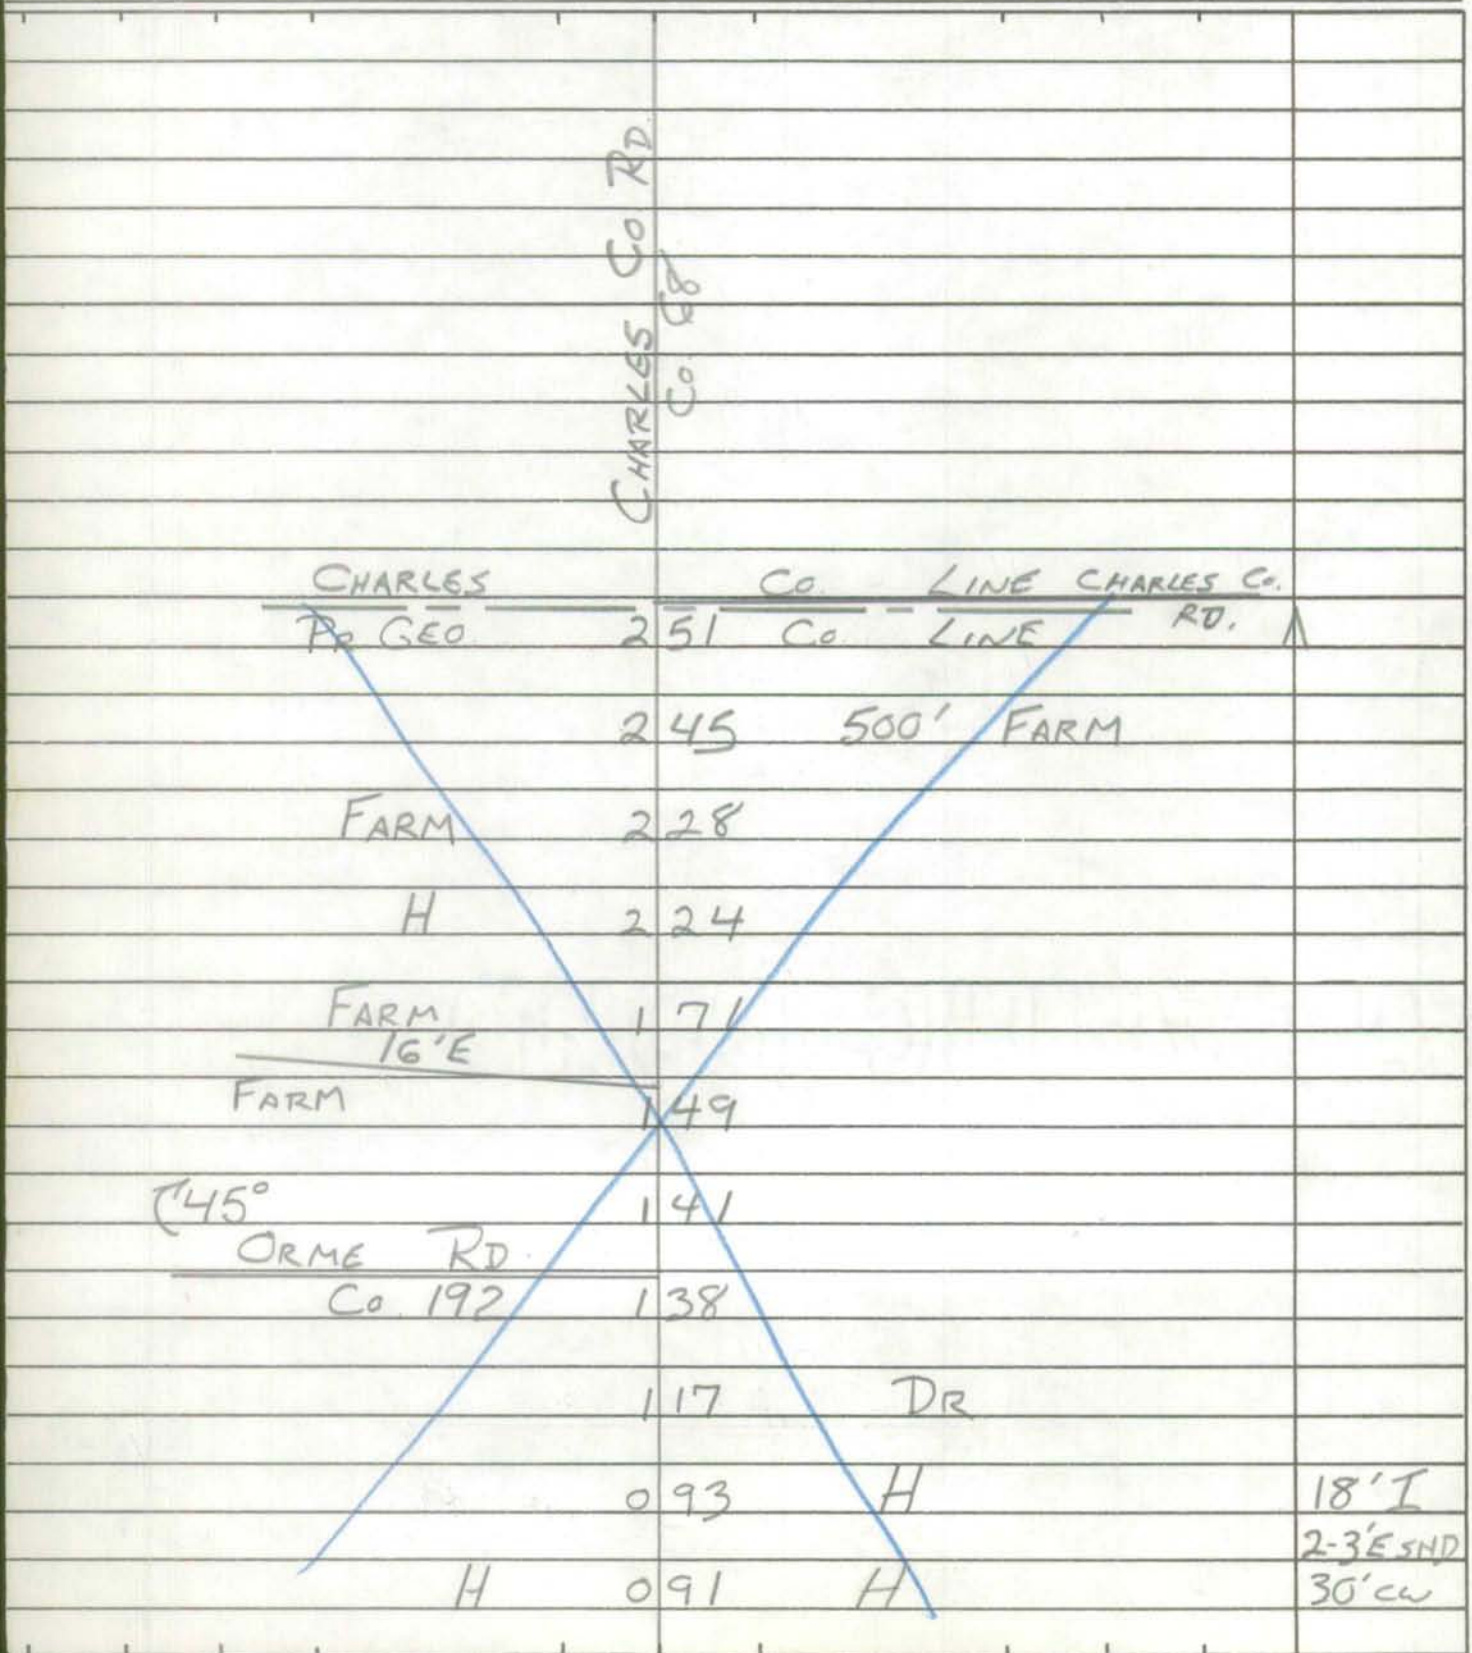

Form 6 HPS (Rev. 1961)

FAR

4-062

78

ROAD INVENTORY SHEET

867-294 M40

Party Chief E. SCHUYLER
Recorder W. DOMAROSKI
Chainman

Glen Hwy

VER C-21-77 MAP 13

Road No. CO 198
Name ORME ROAD
Sheet No. 1 OF 1
Date 7 — 17 — 68
County PRINCE GEORGES

MD	024	381	
CO		19+4855	
HORSEHEAD	000	RD	

~~16 I~~
~~2-3 I 3 HO~~
20' F
30' CW

SHA 51.3-8
11-15-72

STATE HIGHWAY ADMINISTRATION OF MARYLAND

90-157

ROAD INVENTORY SHEET

Party Chief JE
Recorder CM
Helper

Map No. 61C 35C
81-162, 163 & 164

Road No. Co 193
Road Name Tucker Rd
Sheet No. 1 of 4
Date Oct 15 1982
County Prince Georges
State Coordinates 805-350

AT-82-78

	063	EXIT SWIM CLUB	
	060	SWIMING POOL	
45°	057	ENT TO SWIM CLUB	
PC	050		
	048	ENT TO KNIGHTS OF COLUMBUS CLUB	
	045	PT ↖ 20° PC	24'I 2-8'E SHD 48'CW 2ML
	034		
	028		X
PVT ENT	026		
			34'I
		REDFORD DR	JC-RT
S ↑ 20°	025	Co 2264	10'E SHLD-LT 44'CW 2ML
	012		X
PT 25°	008		
			24'I
PC	002		2-8'F SHD 40'CW 2ML
ST Co		BARABUS Rd	
	000	165	

SHA 51.3-8
11-15-72

ROAD INVENTORY SHEET

Road No. Co 193
Road Name TUCKER Rd
Sheet No. 2 OF 4
Date Oct 15, 1982
County Prince Georges
State Coordinates 805-350

PVT	ENT	1	65	
	CHURCH	1	56	
		1	40	PT 30°
		1	22	PC; 24'I 4T 8'I SHLD 10'I SHLDRT 50'CW
		1	15	2ML
			FERGUSON LA	
15°		1	12 CO 4440	
			#P0395P	
		1	11	14' C.M. ARCH
OP	101	1	10	
	ROLLER RINK	1	03	
	ENT TO PARK	0	98	
	EXIT Community Park TUCKER Rd	0	96	PT 40° PC
	A	0	82	
		0	78	SEE BR. SHEET 1-A
	#P0396			
		0	77	CREEK
	HENSON			
		0	76	
PT		0	66	
45°				SAME

SHA 51.3-8
11-15-72

STATE HIGHWAY ADMINISTRATION OF MARYLAND

90-157
2-27-91
BB/BB

ROAD INVENTORY SHEET

Party Chief JE
Recorder CM
Helper

Map No. 35C

Road No. Co 193
Road Name Tucker Rd
Sheet No. 3 of 4
Date Oct 15, 1982
County Prince Georges
State Coordinates 805-350

		ROSE MARIE DR	
	276	Co 2403	
PT	269	Rd 148	
BOCK Co			45'I
30°	267		JC-C
			3ML
PC	263		X
	250	BOOSTER STA.	
	242	PT 35°	
5104	228	PC	
		RIDGEVALE AVE	
	223	Co 2682	
	215	PT 50°	
FAU	202	PC	24'I
			2-10'FSHD
MINOR ARTERIAL			2ML
30°	195		
	180	(proposed)	X
~~35°~~	~~182~~		~~42'I~~ 24'I SHLDR
			~~2-10'F SHLD~~
			~~50'CW~~ 2ML
		PALMER Rd	
X X	175	Co 3645 S90°	X
			~~30'I~~ 36'I
			8'I SHD LT
			~~60'CW~~
			3ML
	~~171~~		X
	168		X

FUNCTIONAL CLASSIFICATION ROAD

SHA 51.3-8
11-15-72

ROAD INVENTORY SHEET

Road No. Co 193
Road Name Tucker Rd
Sheet No. 4 of 4
Date
County
State Coordinates

ALLENTOWN Co 126 Rd

ARUNDEL ~~Rd~~ DR 3644 ALLENTOWN Rd

Co 3 00 Co 126

C & P Co. 2 94 OP 102 PT 40°

2 86 PC

SAME

FAU 5104 Minor Arterial

82-162, 163 & 164

Form 5-HPS
(Revised 1961)

MARYLAND STATE ROADS COMMISSION
PLANNING AND PROGRAMMING DIVISION

S26130

IN COOPERATION WITH
U.S. BUREAU OF PUBLIC ROADS

BRIDGE SHEET

ROAD NO. Co. 193

SHEET NO. 1 A

PARTY NO. _____

DATE 10-15-82

COUNTY PRINCE GEORGES

RATED CAPACITY _____

FOR ALL STRUCTURES HAVING A TOTAL OPENING OF MORE THAN 20 FEET AS DEFINED IN NOTE 1.

ODOMETER READING 0.77 NAME OF STREAM, RAILROAD OR HIGHWAY CROSSED HENSON CREEK

NUMBER OF RAILROAD TRACKS _____
KIND OF CROSSING (NOTE 2) _____

UNDERPASS-SIMPLE UNDERPASS-COMBINED (NOTE 3) OVERPASS BRIDGE OVER SYSTEM

DESCRIPTION

NUMBER OF SPANS	LENGTH EACH SPAN (NOTE 4)	TYPE (NOTE 5)
2	61'	CONC. & I BEAM

TOTAL LENGTH-ON LINE OF ROAD OVER-ALL (NOTE 6)

MATERIAL
SUBSTRUCTURE CONC & I BEAM SUPERSTRUCTURE CONC & STEEL RAIL
FLOOR CONC.

CLEARANCES
ROADWAY (NOTE 7) 43'J Jcb LT STEEL RAIL SIDEWALK WIDTHS: RIGHT 6'J LEFT 4'J
SURFACE OF ROAD TO STREAM BED 30' FOR OVERPASSES, SHOW DISTANCES TO TOP OF RAIL OR SURFACE OF LOWER ROAD. (NOTE 8)
SURFACE OF ROAD TO BOTTOM PORTAL _____ (MINIMUM OVERHEAD CLEARANCE
CLEAR DISTANCE OF OPENING ABOVE STREAM BED 25' (WATERWAYS ONLY)
POSTED LOAD LIMITS _____ BRIDGE NO. NOT POSTED CONSTRUCTION DATE 1979

GENERAL CONDITION OF BRIDGE: CHECK IF GOOD, FAIR, OR POOR, DESCRIBE DEFECTS IF SERIOUS.

	GOOD	FAIR	POOR
SUPERSTRUCTURE	✓		
FLOOR	✓		
SUBSTRUCTURE	✓		

PAINT BADLY CORRODED OR RUSTED

TYPE OF PROTECTION FOR DRAWBRIDGES (NOTE9) _____

(NOTES ON REVERSE SIDE)

S26130

Notes:

1. In agreement with Federal-aid standards, a bridge is defined as a structure including supports erected over a depression or an obstruction, as water, highway, or railway, and having a track or passageway for carrying traffic or other moving loads, and having a length measured along the center of roadway of more than 20 feet between undercoping of abutments or spring lines of arches, or extreme ends of openings for multiple boxes and pipes, where the clear distance between openings is less than half of the smaller contiguous opening.

2. Show kind of crossing by checking descriptive item applicable. For multiple-span bridges give complete information on each span including approach spans. Indicate on leg sheet the odometer reading, position, and angle of skew of structure with respect to center line of road and by arrow the direction of stream flow.

3. Give information on the span over the highway only.

4. For span length use center to center of bearings, otherwise the clear opening. Skew bridges will be measured along center line of road. See Note 1.

5. Show general type such as: Trestle, Truss, Girder, I-Beam, Rigid Frame, Arch, Slab, Suspension, or Covered Bridge. See illustrations attached. Describe draw spans by classifications listed in Article X, Section 2 of Manual.

6. The length of a bridge structure is the over-all length measured along the line of survey stationing back to back of back-walls of abutments, if present, otherwise end to end of bridge floor, but in no case less than the total clear opening of the structure.

7. Give minimum lateral clearance. Where traffic lanes are separated by bridge numbers, show clearance width of each lane separately. Special conditions should be explained by notes.

8. In case of overhead bracing or arch construction, measurement shall be made to the lowest point above the road surface.

9. Use classification listed on RR crossing sheets. Form 4 HPS.

Remarks: _____

A rearrangement of the form similar to that shown on the attachment may be used to provide space for coding.

SHA 51.3-8
11-15-72

STATE HIGHWAY ADMINISTRATION OF MARYLAND

ROAD INVENTORY SHEET

Party Chief WB
Recorder KC
Helper

Map No. I-12
79-140

St Mary's Co. Rt. 235

Road No. Co 194
Road Name Dr. Bowen Rd
Sheet No. 1 of 1
Date 3-10-80
County Pr. Geo.
State Coordinates 879-273

	MD	1	08	381
	H	1	06	
		0	88	Farm
	Farm	0	82	PT 30° PC
		0	77	
		0	70	H
		0	58	Farm
	H	0	45	
		0	35	W.P.C. 22'WX18'LX6'D # ~~P418B~~ P0413B
	H	0	31	
		0	29	
		0	22	
		0	11	
	Prince George / Charles HCH0010	0	00	County Line / County Line # ~~P411~~

18'H
2-3'E Shld
24'I
I-C-L+
3'E Shld R+
30'I
I-C-L+
3'E Shld R+
18'H
2-3'E Shlds

E

SHA 51.3-8
11-15-72

ROAD INVENTORY SHEET

Road No. _____
Road Name _____
Sheet No. _____
Date _____
County _____
State Coordinates _____

SHA 51.3-8
11-15-72

STATE HIGHWAY ADMINISTRATION OF MARYLAND

78

ROAD INVENTORY SHEET

Party Chief W.D (E.S.)
Recorder M.Z. (W.D.)
Helper

Map No. I-12

Road No. Co. 194
Road Name DR. BOWEN RD.
Sheet No. 1 OF 1
Date 6-23-77 (7-16-68)
County PR. GEO.
State Coordinates 879-273

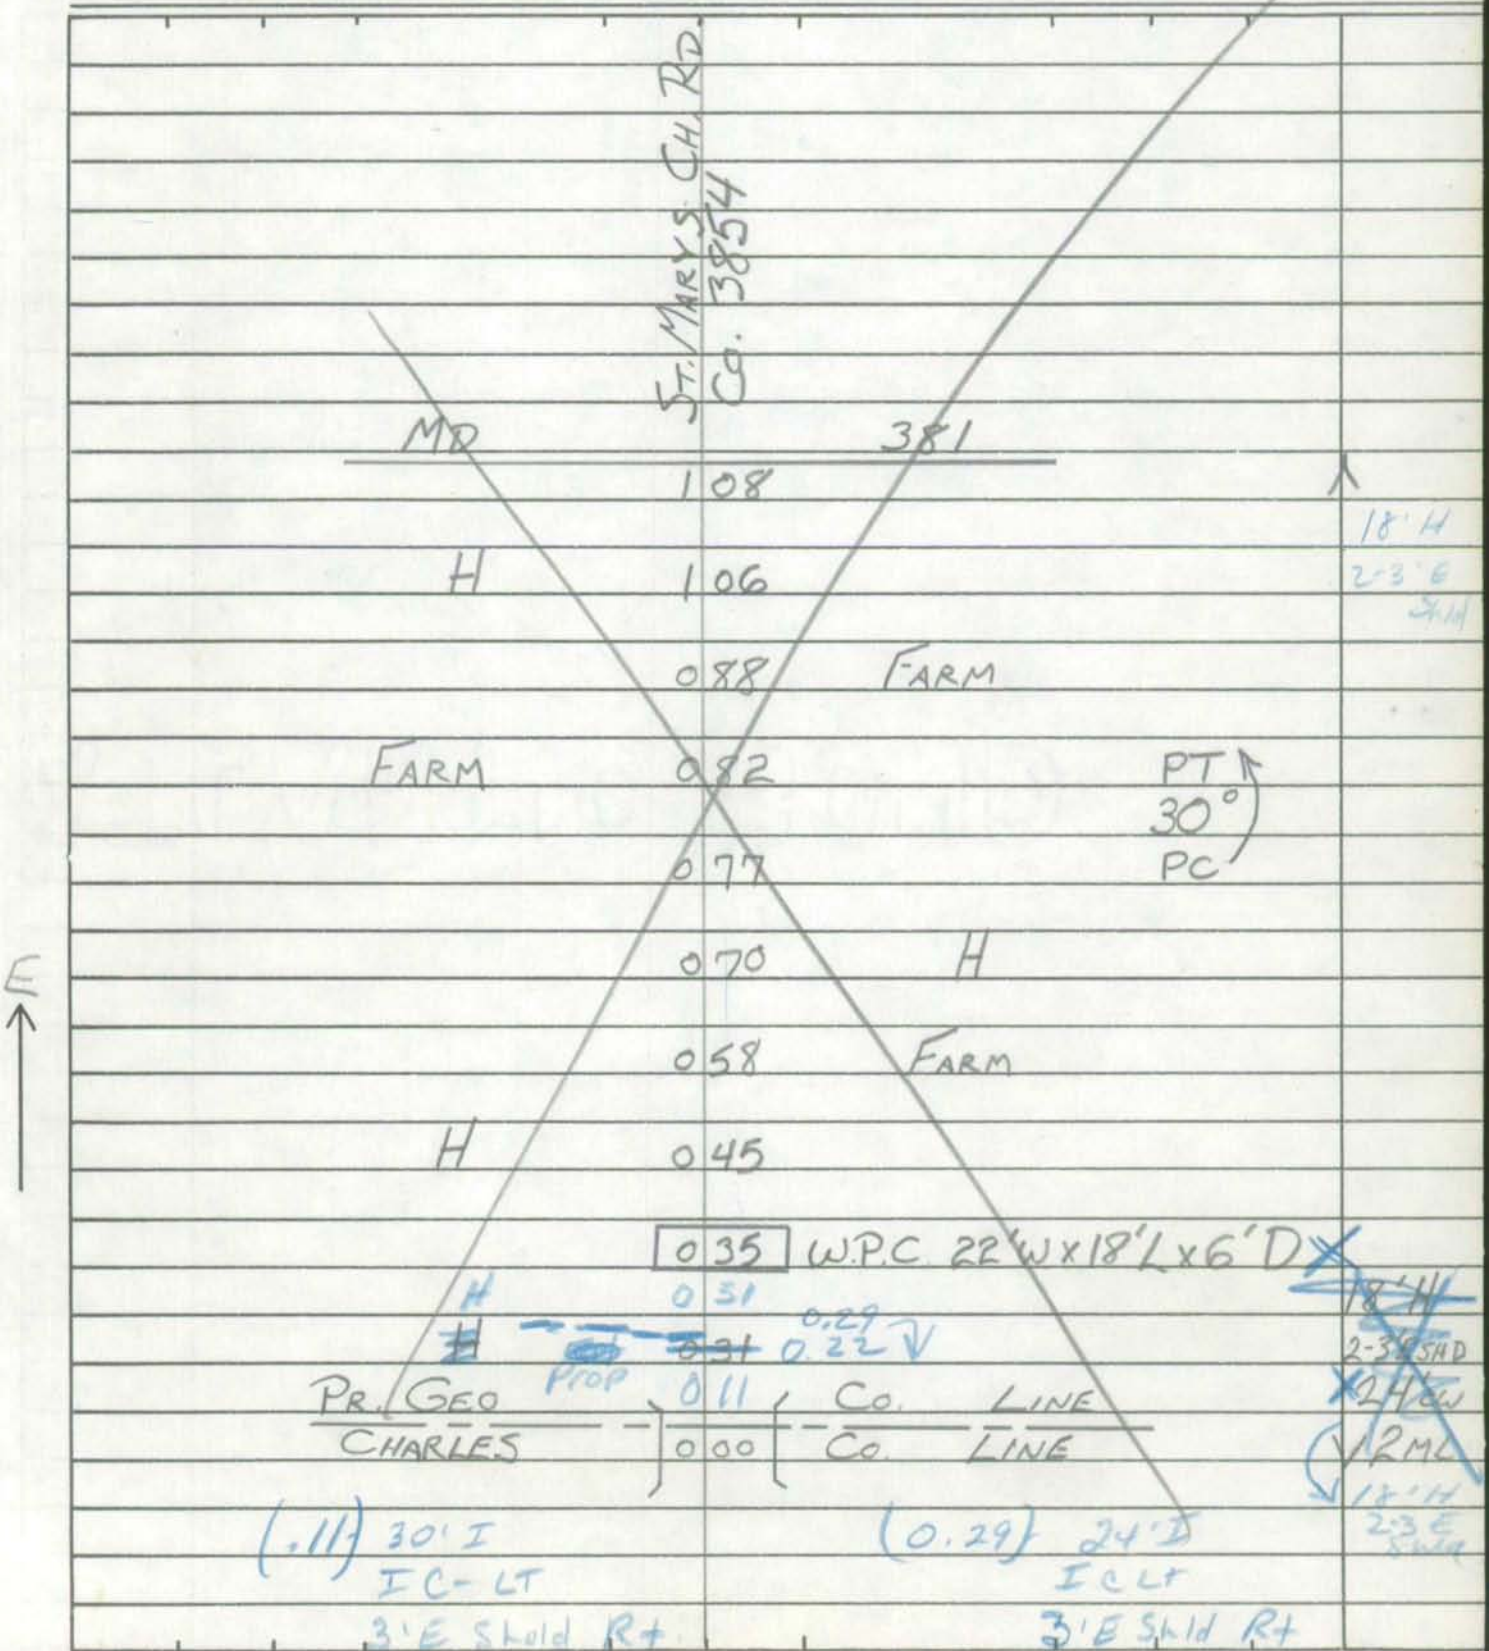

SHA 51.3-8
11-15-72

ROAD INVENTORY SHEET

Road No. _____
Road Name _____
Sheet No. _____
Date _____
County _____
State Coordinates _____

Form 5-HPS
(Revised 1961)

MARYLAND STATE ROADS COMMISSION
PLANNING AND PROGRAMMING DIVISION

S26130

IN COOPERATION WITH
U.S. BUREAU OF PUBLIC ROADS

ROAD NO. MD 194

BRIDGE SHEET

SHEET NO. 1A

PARTY NO.

DATE 7-16-68

COUNTY PRINCE GEORGES

RATED CAPACITY H 20

FOR ALL STRUCTURES HAVING A TOTAL OPENING OF MORE THAN 20 FEET AS DEFINED IN NOTE 1.

ODOMETER READING 0.00 NAME OF STREAM, RAILROAD OR HIGHWAY CROSSED SWANSON CREEK

NUMBER OF RAILROAD TRACKS

KIND OF CROSSING (NOTE 2)

UNDERPASS-SIMPLE UNDERPASS-COMBINED (NOTE 3) OVERPASS BRIDGE OVER STREAM / SYSTEM

DESCRIPTION

NUMBER OF SPANS	LENGTH EACH SPAN (NOTE 4)	TYPE (NOTE 5)
1	16'	CONCRETE SLAB
1	18'	CONCRETE SLAB

TOTAL LENGTH-ON LINE OF ROAD OVER-ALL (NOTE 6) 40'

MATERIAL
SUBSTRUCTURE CONCRETE SUPERSTRUCTURE

FLOOR

CLEARANCES
ROADWAY (NOTE 7) 27' SIDEWALK WIDTHS: RIGHT NONE LEFT

SURFACE OF ROAD TO STREAM BED 8' FOR OVERPASSES, SHOW DISTANCES TO TOP OF RAIL OR SURFACE OF LOWER ROAD. (NOTE 8)

SURFACE OF ROAD TO BOTTOM PORTAL (MINIMUM OVERHEAD CLEARANCE

CLEAR DISTANCE OF OPENING ABOVE STREAM BED 6' (WATERWAYS ONLY)

POSTED LOAD LIMITS BRIDGE NO. CONSTRUCTION DATE

GENERAL CONDITION OF BRIDGE: CHECK IF GOOD, FAIR, OR POOR, DESCRIBE DEFECTS IF SERIOUS.

	GOOD	FAIR	POOR
SUPERSTRUCTURE	✓		
FLOOR	✓		
SUBSTRUCTURE	✓		
PAINT		BADLY CORRODED OR RUSTED	

TYPE OF PROTECTION FOR DRAWBRIDGES (NOTE9)

(NOTES ON REVERSE SIDE)

S26130

Notes:

1. In agreement with Federal-aid standards, a bridge is defined as a structure including supports erected over a depression or an obstruction, as water, highway, or railway, and having a track or passageway for carrying traffic or other moving loads, and having a length measured along the center of roadway of more than 20 feet between undercoping of abutments or spring lines of arches, or extreme ends of openings for multiple boxes and pipes, where the clear distance between openings is less than half of the smaller contiguous opening.

2. Show kind of crossing by checking descriptive item applicable. For multiple-span bridges give complete information on each span including approach spans. Indicate on leg sheet the odometer reading, position, and angle of skew of structure with respect to center line of road and by arrow the direction of stream flow.

3. Give information on the span over the highway only.

4. For span length use center to center of bearings, otherwise the clear opening. Skew bridges will be measured along center line of road. See Note 1.

5. Show general type such as: Trestle, Truss, Girder, I-Beam, Rigid Frame, Arch, Slab, Suspension, or Covered Bridge. See illustrations attached. Describe draw spans by classifications listed in Article X, Section 2 of Manual.

6. The length of a bridge structure is the over-all length measured along the line of survey stationing back to back of back-walls of abutments, if present, otherwise end to end of bridge floor, but in no case less than the total clear opening of the structure.

7. Give minimum lateral clearance. Where traffic lanes are separated by bridge numbers, show clearance width of each lane separately. Special conditions should be explained by notes.

8. In case of overhead bracing or arch construction, measurement shall be made to the lowest point above the road surface.

9. Use classification listed on RR crossing sheets. Form 4 HPS.

Remarks: _____

A rearrangement of the form similar to that shown on the attachment may be used to provide space for coding.

Form 6 HPS (Rev. 1961) FAR 90-295 2-19-51 4-071 78

ROAD INVENTORY SHEET BB/BB

Party Chief E.S.
Recorder W.D.
Chainman

Gen Hwy

61-241

MAP 14

VER 6-23-77 879-272 G17

Road No. G 195
Name ST. PHILLIPS RD
Sheet No. 1 OF 1
Date 7-10-68
County PRINCE GEO

	ROAD	0	93	END	
		0	84	35°R	10'C
H	~~ROAD~~	0	70	~~END~~ H	17'E 12'CW
		0	43		
		0	42	H	
	H	0	41		
	3 GRAVES CEM	0	37		
	H	0	27		12'I ~~13'ESHD~~
	30° R	0	24	H	
	H	0	18		
		0	16	H	1 14'I 18'I
	~~CH. & CEM.~~	0	14		~~C-LT~~ 18'I IC-LT
		0	13	30° L	
		0	09		
		0	08	DR.	16'I ~~13'ESHD~~
	MD	0	00	351	

Form 6 HPS (Rev. 1961) FAU 3-057 78

ROAD INVENTORY SHEET

MAP 6

Party Chief E SCHUYLER
Recorder T LANDON
Chainman D EMERICK
D PLUMMER

NORTH BARNABY

VER 8-17-77 81A-361 m35

Road No. Co 196
Name CARLTON AVE
Sheet No. 1 OF 1
Date 12-20-67
County PRINCE GEORGES

HACAN Co	0	25	RD 129
	0	24	
	0	23	
	0	21	16 H
18 H	0	05	
	0	03	
	0	01	H
TEMPLE HILLS Co	0	00	RD 123

↑ 26'I
X C-C
78-101

17'G
2-4'ESHD
~~17'G~~
~~2-4'ESHD~~
28'CW

↓

Form 6 HPS (Rev. 1961) FAU 3-141

ROAD INVENTORY SHEET

MAP 6

Party Chief E SCHUYLER
Recorder T LANDON
Chairman J EMERICK
D PLUMMER

REVISED
4-1-70
T LANDON
W. WARFIELD
NORTH
BARNABY
814-360 m35

VEA 8-17-77

Road No. Co 197
Name LESLIE AVE
Sheet No. 1 OF 1
Date 12- 20 -67
County PRINCE GEORGES

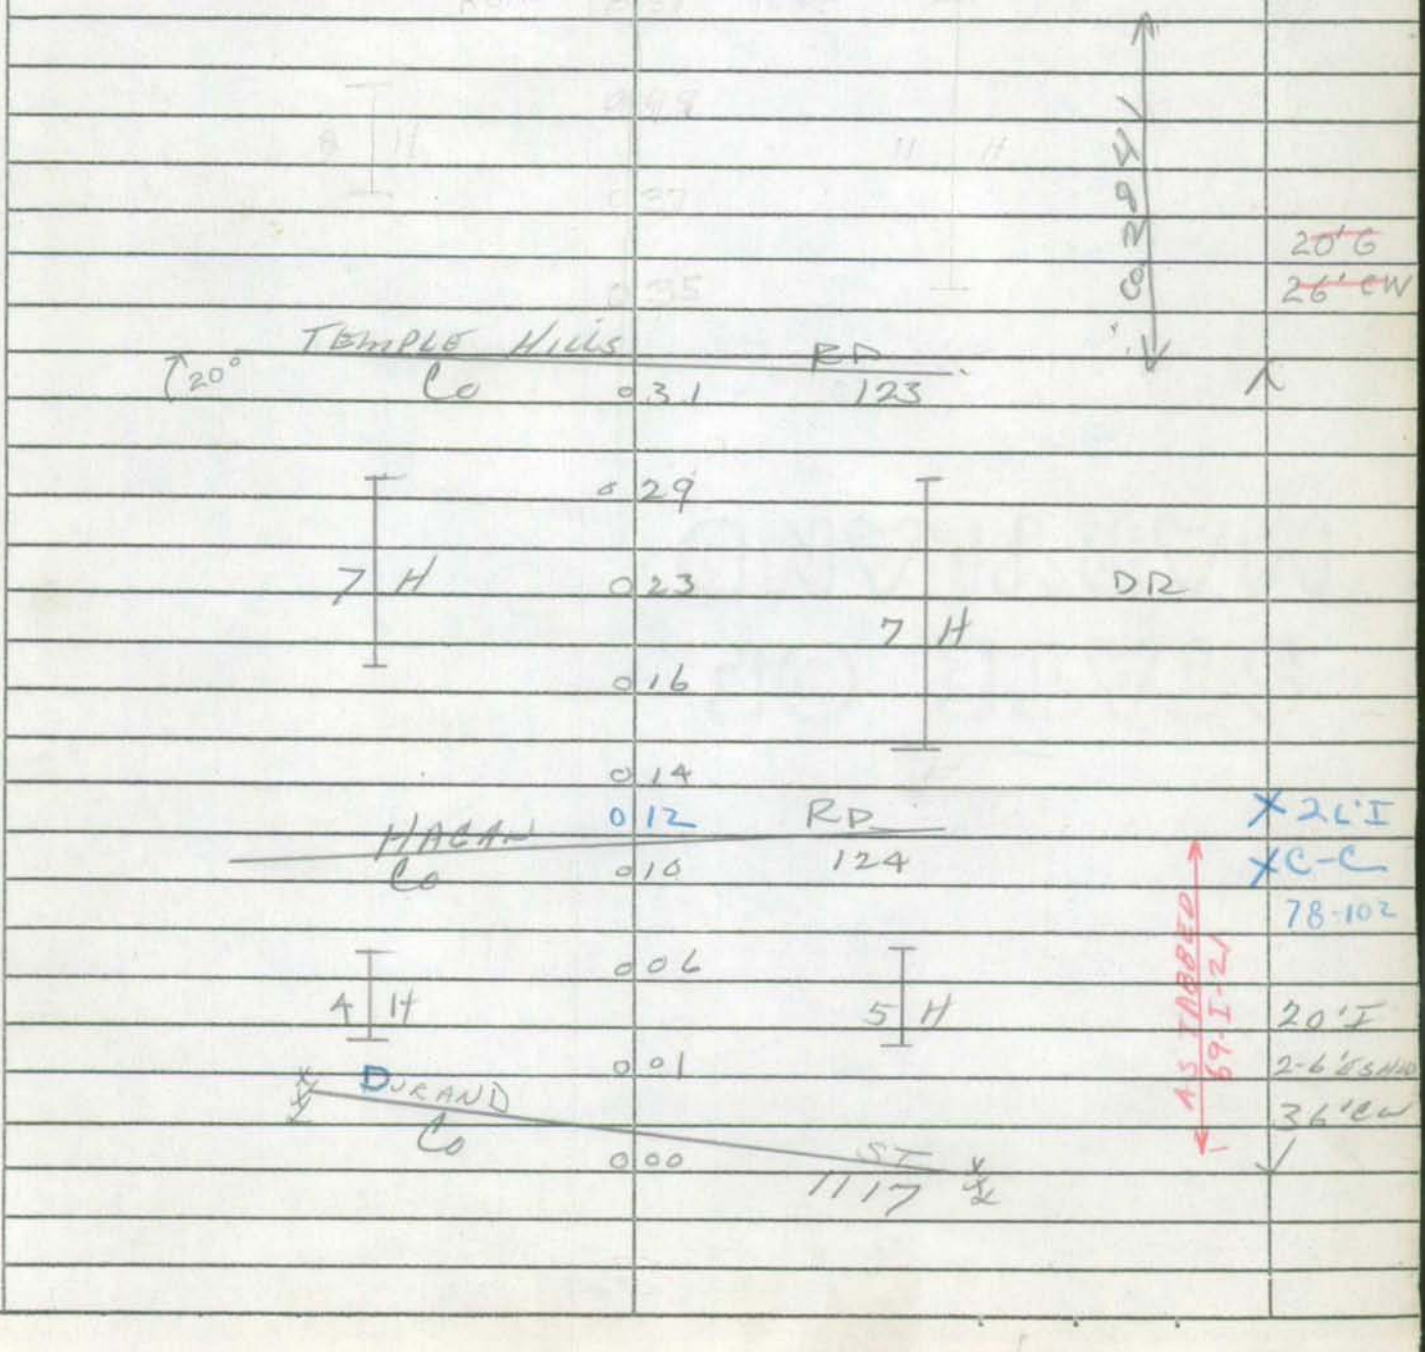

*100-03 Was MD 950-C
SHA To Co. Transfer 4/10/72

Washi. Urbana

SHA 51.3 - 8 Revised
4.83

MARYLAND STATE HIGHWAY ADMINISTRATION

Corp Lmts changes from 2002 mun. map.

ROAD INVENTORY SHEET

Party Chief T. Landon
Recorder W. Warfield
Assistant Rodriguez 7/25/2002 KJP
Map No./Dir. E11-D / N
State Coordinates 836-462

Road No. Co 198
Road Name Haynes RD
County Prince Georges
Date 3-29-71
Sheet No. 1 OF 1

96 Coex#9
86-6
81-1
67-1
Haneehg LTR. 9/26/69

TRAFFIC CODES
TRAFFIC CONTROLS: STOP SIGN-SS, TRAFFIC LIGHT=T.L., FLASHING RED BALL-F.R.

TRAFFIC CODES
PARKING RESTRICTIONS: A.M. PEAK, P.M. PEAK, A.M./P.M. PEAK, NO PARKING ANYTIME-N.P., COMM/IND. ACCESS=I

SYSTEM				TRAFFIC		LINE DIAGRAM	TRAFFIC			PAVEMENT DATA
	FUNCT CLASS	HWY SYS	HPMS SAMPLE	PKG. REST.	COMMIND ACCESS		CONTROL	COMMIND ACCESS	PKG. REST.	
						Road End				
						022				
						↑ Corp Lmts of Laurel ↑				24'I
						019				IC-C
						018 Ent. To T.H.				
						Corp Lmts of Laurel				
						017				
						Haines CT				
						Co 4419 014 Lmts of Laurel				
						013				26'I
										JCb LT
						012				
						Corp Limits				
						009				
						Laurel				
						006 24" CMP				21'I
										40'CW
										2UML
						003				
										34'I
										ICb LT
						Old Sandy Spring RD				2ML
						Co 000 3434				

COUNTY _____ ROAD NO. _____ PAGE ___ OF ___

SYSTEM				TRAFFIC		LINE DIAGRAM	TRAFFIC			PAVEMENT DATA
FUNCT CLASS	HWY SYS	NHS	STATE	PREG REST	COM/IND ACCESS		CHANGE	COM/IND ACCESS	PREG. REST.	

SHA 51.3 - 8 Revised
4.83

79-147 A/T 82-118 A/T
85-116
90-188

MARYLAND STATE HIGHWAY ADMINISTRATION

ROAD INVENTORY SHEET

Party Chief E.S.
Recorder W.D
Assistant Rewritten 5/22/91 JE
Map No./Dir. G11D / E
State Coordinates 815-342

Road No. Co 199
Road Name OAKLAWN RD
County PG
Date 12-19-68 Ver 8-8-77
Sheet No. 1 OF 3

TRAFFIC CODES
TRAFFIC CONTROLS: STOP SIGN=SS, TRAFFIC LIGHT=T.L., FLASHING RED BALL=F.R.

TRAFFIC CODES
PARKING RESTRICTIONS: A.M. PEAK, P.M. PEAK, A.M./P.M. PEAK, NO PARKING ANYTIME=N.P., COMM/IND. ACCESS=E

SYSTEM				TRAFFIC		LINE DIAGRAM	TRAFFIC			PAVEMENT DATA
FED. AID.	FUNCT CLASS.	HWY. SYS.	HPMS SAMPLE	PRKG. REST.	COM/IND. ACCESS		CONTROL	COM/IND. ACCESS	PRKG. REST.	
						0 31 PT				
						SHADY REST RD				
						0 25 Co 2165 160°				
						0 23 PC				
										23'I
						0 11			X	2ML
FA										
NON	LOCAL									
URB										27'I
										Jc-c
						0 06			X	2ML
										36'I
										Jc-c
						ALLENTOWN RD				2ML
						Co 0 00 126			Y	

SYSTEM				TRAFFIC		LINE DIAGRAM	TRAFFIC			PAVEMENT DATA
FED. AID.	FUNCT. CLASS.	HWY. SYS.	HPMS SAMPLE	PRKG. REST.	COM/IND ACCESS		CONTROL	COM/IND ACCESS	PRKG. REST.	
										26'I
						078			X	Jc-c
						PAMPER LA				
						066 OP 112				
										19'H
						Gibbons DR				2-3'E shd
						Co 1472 060			X	
										27'I
										J cb RT
						OAKDALE ST				
						056 Co 2463			X	
NON FA										20'I
	URB	LOCAL				053			X	
						WACO RD				
						048 Co 3302				
										36'I
						SLEEPY HOLLOW RD				JCC
						Co 4482 038			X	
						90° 037				
										23'I
										2ML

SHA 51.3 - 8 Revised
4.83

MARYLAND STATE HIGHWAY ADMINISTRATION

ROAD INVENTORY SHEET

Party Chief ES
Recorder WD
Assistant
Map No./Dir. G11D / E
State Coordinates 815 - 342

Road No. Co 199
Road Name OAKLAWN RD
County PG
Date 12-19-68
Sheet No. 3 OF 3

SYSTEM: FED. AID. | FUNCT CLASS. | HWY. SYS. | HPMS SAMPLE
TRAFFIC: PRKG. REST. | COM/IND. ACCESS

LINE DIAGRAM

TRAFFIC: CONTROL | COM/IND. ACCESS | PRKG. REST.

PAVEMENT DATA

JOLLY DR
CO 101 4733

KULT LA
CO 3390 095

JOLLY LA
CO 086 3389

NON FA
UR3 LOCAL

26' I
JC-C

SAME

TRAFFIC CODES

TRAFFIC CONTROLS: STOP SIGN=S.S., TRAFFIC LIGHT=T.L., FLASHING RED BALL=F.R.

TRAFFIC CODES

PARKING RESTRICTIONS: A.M. PEAK, P.M. PEAK, A.M./P.M. PEAK, NO PARKING ANYTIME=N.P., COMM/IND. ACCESS=E

SYSTEM				TRAFFIC		LINE DIAGRAM	TRAFFIC			PAVEMENT DATA
FED. AID.	FUNCT. CLASS.	HWY. SYS.	HPMS SAMPLE	PRK.G. REST.	COM/IND ACCESS		CONTROL	COM/IND ACCESS	PRK.G. REST.	

SHA 51.3-8
11-15-72

STATE HIGHWAY ADMINISTRATION OF MARYLAND

ROAD INVENTORY SHEET

Party Chief _____
Recorder _____
Helper _____

Map No. _____

Road No. CO. 200
Road Name _____
Sheet No. _____
Date _____
County _____
State Coordinates _____

NOW PART OF CO. 88

SHA 51.3-8
11-15-72

ROAD INVENTORY SHEET

324
66
258

Road No. _____
Road Name _____
Sheet No. _____
Date _____
County _____
State Coordinates _____