PRINCE GEORGES COUNTY
COUNTY ROADS
2801 to 3000

SHA 51.3-8
11-15-72

STATE HIGHWAY ADMINISTRATION OF MARYLAND

ROAD INVENTORY SHEET

Party Chief _____
Recorder _____
Helper _____

Map No. _____

Road No. _____
Road Name _____
Sheet No. _____
Date _____
County _____
State Coordinates _____

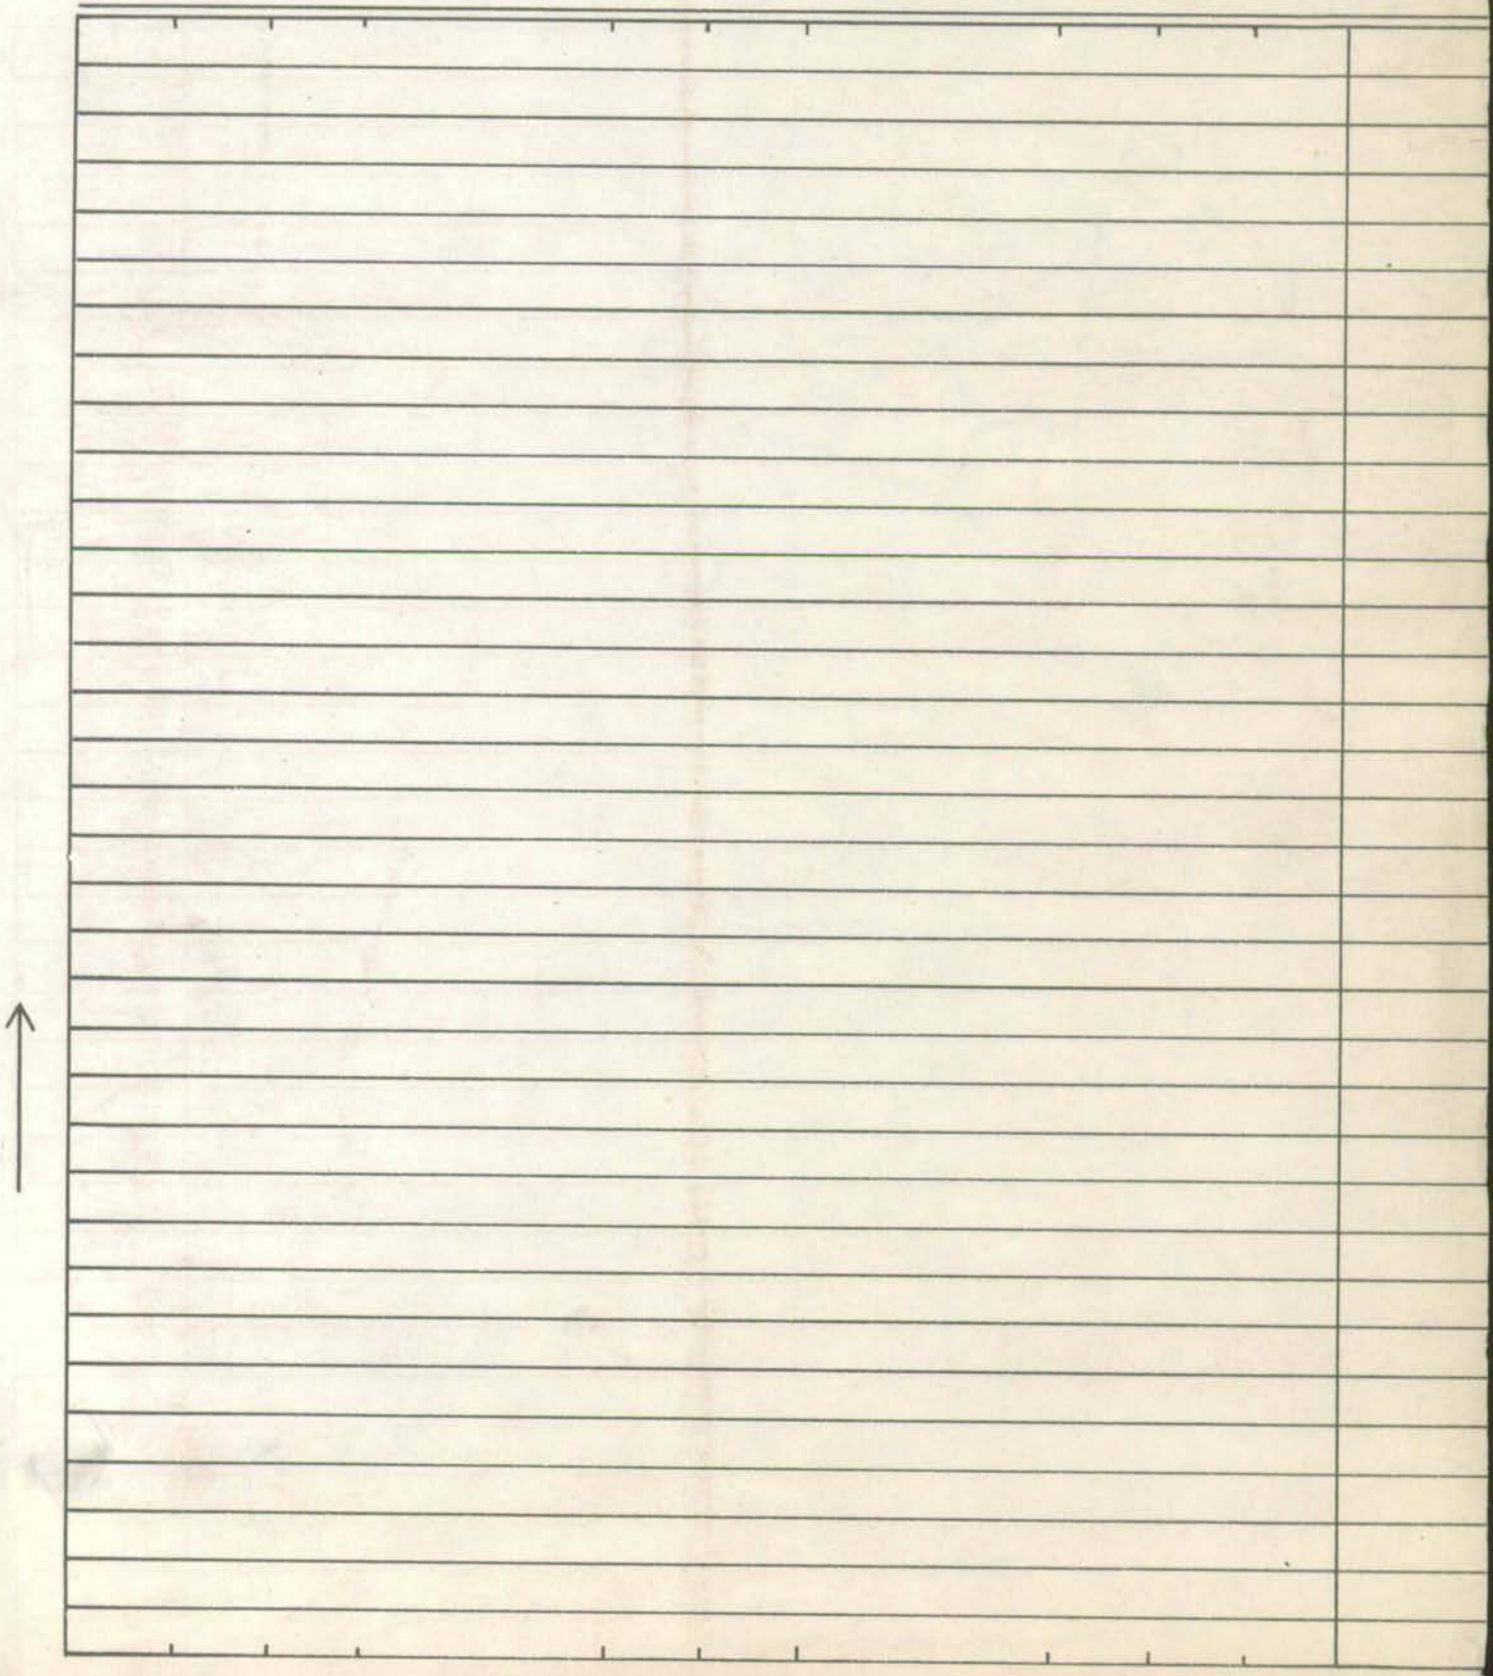

SHA 51.3-8
11-15-72

ROAD INVENTORY SHEET

Road No. _____
Road Name _____
Sheet No. _____
Date _____
County _____
State Coordinates _____

Form 6 HPS (Rev. 1961) MAP 7 3-260

ROAD INVENTORY SHEET

PARTY CHIEF Edward Schuyler
RECORDER Henry Gorman
CHAINMAN

OAKLAND
Ver
9-28-77

ROAD NO. CO. 2801
NAME TIREP DR.
SHEET NO. 1 OF 1
DATE 10/25/67
COUNTY PRINCE GEO.

827-375 M35

NASSAU CO.	020	ST. ~~RTE~~ 3664
12 H 85°	019	12 H
	005	
	002	26' I C-C
WEBER CO.	000	DR. ~~RTE~~ 1847

Form 6 HPS (Rev. 1961)

Ver WD DT 8-8-77

ROAD INVENTORY SHEET

Party Chief T. LANDON
Recorder W. WARFIELD
Helper

70-92
71-48

Road No. Co. 2802
Road Name CINDY LA.
Sheet No. 1 OF 1
Date 4-21-72
County PRINCE GEO.
Sheet 7
M35-

831-38S-

		ROAD 037 END		
		WESTON AVE.		
		Co. 2803 035		
H		034		
			11 H	
H		032		
		ARLENE DR.		
		Co. 3111 031		
		CALMOS ST.		
		Co. 3110 025		26' I "J" C-C
H		022 CANYON DR.		X
		Co. 1865		
		018	30° ↑	
↑30°		013		
	ENT. TO APTS.	010	ENT. TO APTS.	36' I "J" C-C
		004		X 36' I "I" C-C
	CENTRAL	AVE.		
	MD.	000 214		✓

Form 6 HPS (Rev. 1961)

ROAD INVENTORY SHEET

Road No. _____
Road Name _____
Sheet No. _____
Date _____
County _____

Form 6 HPS (Rev. 1961)

Map 7

Ver
WD
DT
9-8-77

2-492 78

ROAD INVENTORY SHEET

PARTY CHIEF Edward Schuyler
RECORDER Henry Gorman
CHAINMAN Joe Temerick

CARMODY
N. LLS

ROAD NO. Co. 2803
NAME WESTON AVE.
SHEET NO. 1 OF 1
DATE 10/23/67
COUNTY PR. GEO.

831-385 M35

XXX
ROAD END

021

Calmos St.

Co ~~OP~~ 019 ~~1315~~ 3110

017

13 H 9 H

002

26' I
C-C

CINDY LA.

Co 000 2802

Form 6 HPS (Rev. 1961)

MAP 7

Ver
WD
DT
9-8-77

2-113

ROAD INVENTORY SHEET

Gentry La 78

PARTY CHIEF Edward Schuyler
RECORDER Henry Gorman
CHAINMAN Joe EMERICK

CARMODY HILLS

ROAD NO. C-2804
NAME ~~75 E~~ ~~AVE~~
SHEET NO. 1 OF 1
DATE 10/23/67
COUNTY PRINCE GEORGES

833-384 M35

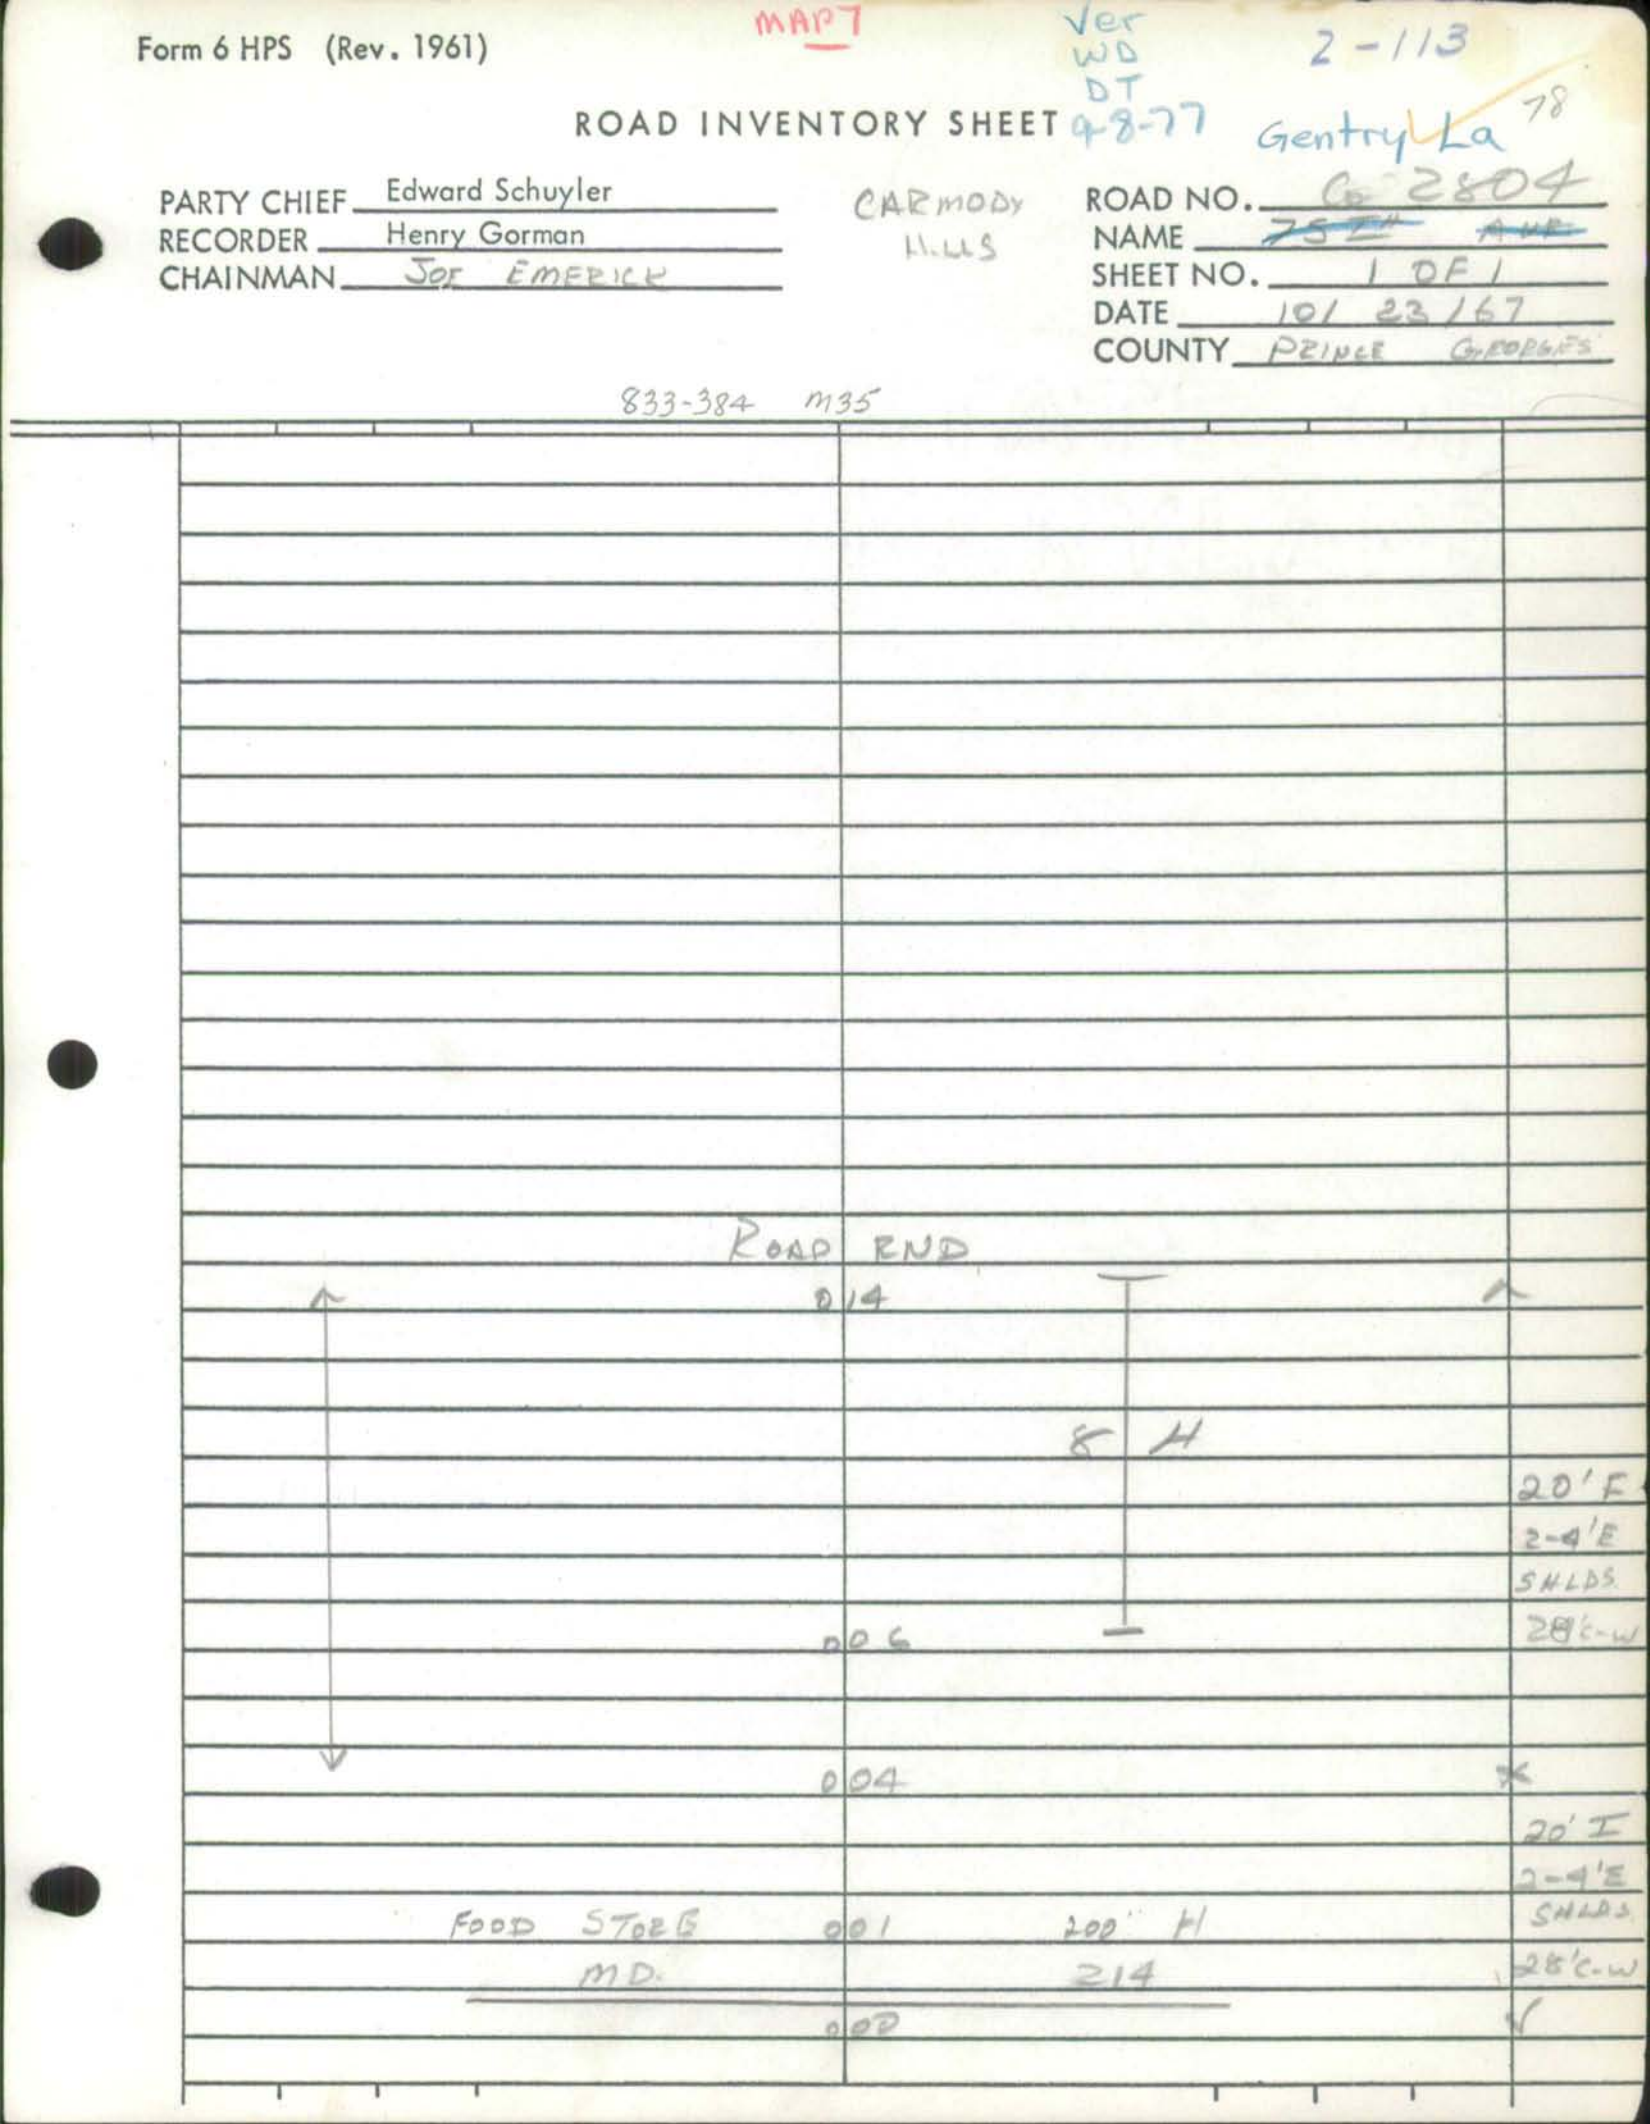

Form 6 HPS (Rev. 1961)

Map 7 Ver WD DT 9-8-77

Z-372-A

ROAD INVENTORY SHEET

PEPPER CT

PARTY CHIEF Edward Schuyler

RECORDER Henry Gorman

CHAINMAN JOE. EMERICK

CARMODY WILLS.

ROAD NO. Co. 2805

NAME ~~FRANKLIN CT.~~

SHEET NO. 1 OF 1

DATE 10/23/67

COUNTY PRINCE GEORGES

832-385 M35

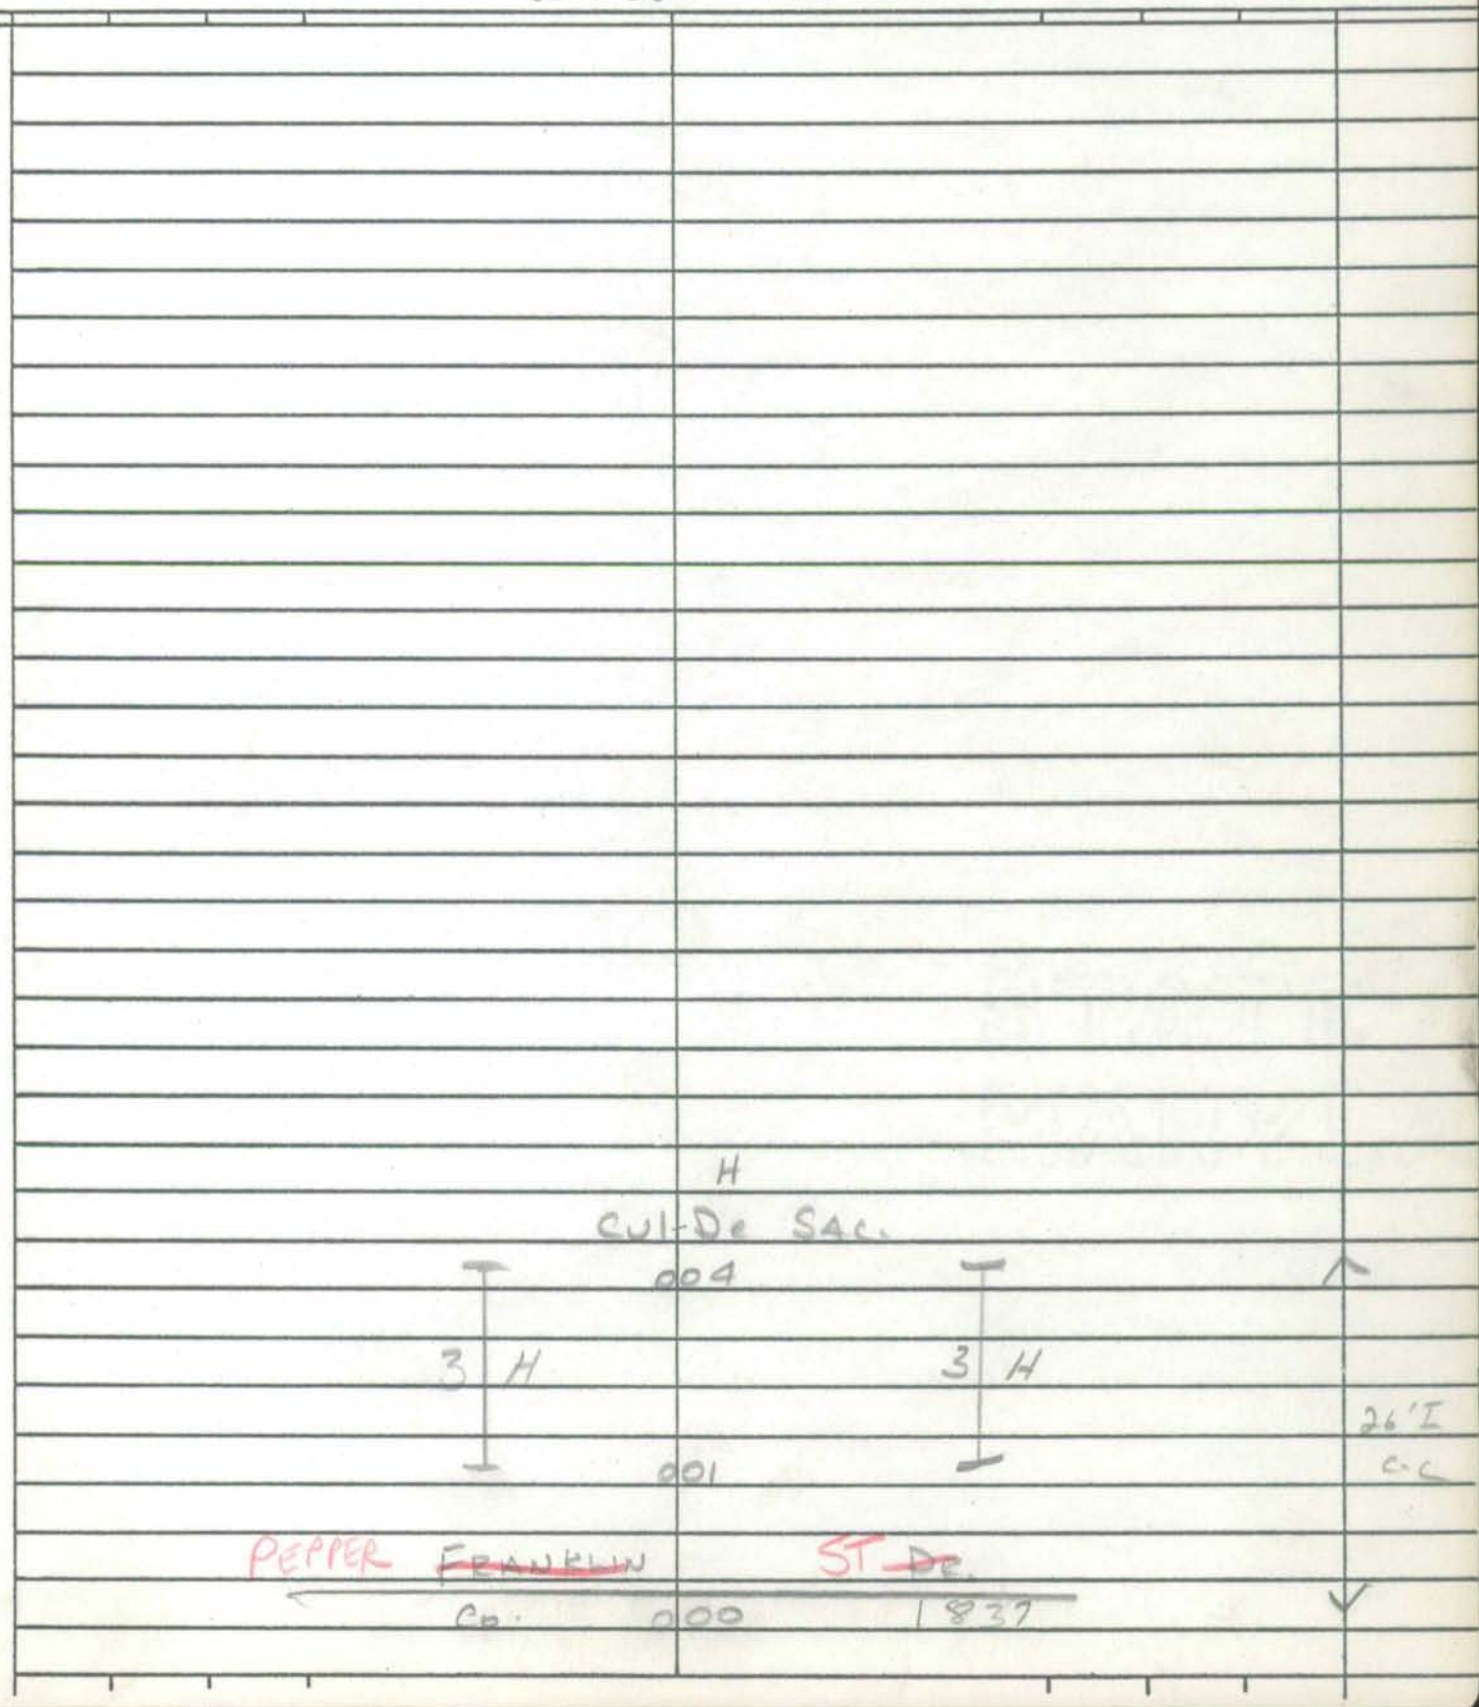

Form 6 HPS (Rev. 1961)

Map 7 OPEN No 2-078

ROAD INVENTORY SHEET

PARTY CHIEF Edward Schuyler
RECORDER Henry Gorman
CHAINMAN JOE. EMERICK

CARMODY HILLS

ROAD NO. CO. 2806
NAME 77 TH ST
SHEET NO. 1 OF 1
DATE 10/23/67
COUNTY PG - GEO

832-385 M35

NOW COMBINED WITH
CO 1866
4/6/76

78 TH PL.
CO 1866

0.24
0.22
0.17
0.15

24' 36' R/W

5 H

7 H

FRANKLIN
CO.

DR.
1833

0.13
0.10
0.01

9 H

7 H

26' T
C-C

HASTING
CO.

DR.
2085

0.00

Form 6 HPS (Rev. 1961)

MAP 7 & 6

2-221-B

78

ROAD INVENTORY SHEET

PARTY CHIEF Edward Schuyler
RECORDER Henry Gorman
CHAINMAN

CEDAR HEIGHTS

ROAD NO. Co. 2807
NAME K ST.
SHEET NO. 1 OF 2,
DATE 10/16/67
COUNTY PRINCE GEORGES

VER A-20-78 827-388 M31

029

027 5 H

BALSAMTREE ~~63 RD~~ PL ~~AVE~~

Co. 589. 024

H 022 CHURCH

021 4 H

AUTO JUNK YARD. H 020

CEDAR ~~6 TH~~ HGTS ~~AVE~~ DR

Co. 016 933

014

012 H

W 6 H 011 H CYPRESS ~~TREE~~ PL

~~6 TH~~ ~~PL~~

007 Co. 1199.

006

001 H

CYPRESS TREE ~~63 RD~~ DR ~~AVE~~

Co. 000 1042.

83-57,58
26'I
26'CW
~~20'I~~
~~20'E~~
~~23'D~~
~~SHEDS~~
~~26'C-W~~

Form 6 HPS (Rev. 1961)

2-221-B

78

ROAD INVENTORY SHEET

PARTY CHIEF Edward Schuyler
RECORDER Henry Gorman
CHAINMAN

ROAD NO. Co. 2807
NAME K ST.
SHEET NO. 2 OF 2
DATE 10/16/67
COUNTY PRINCE GEORGES

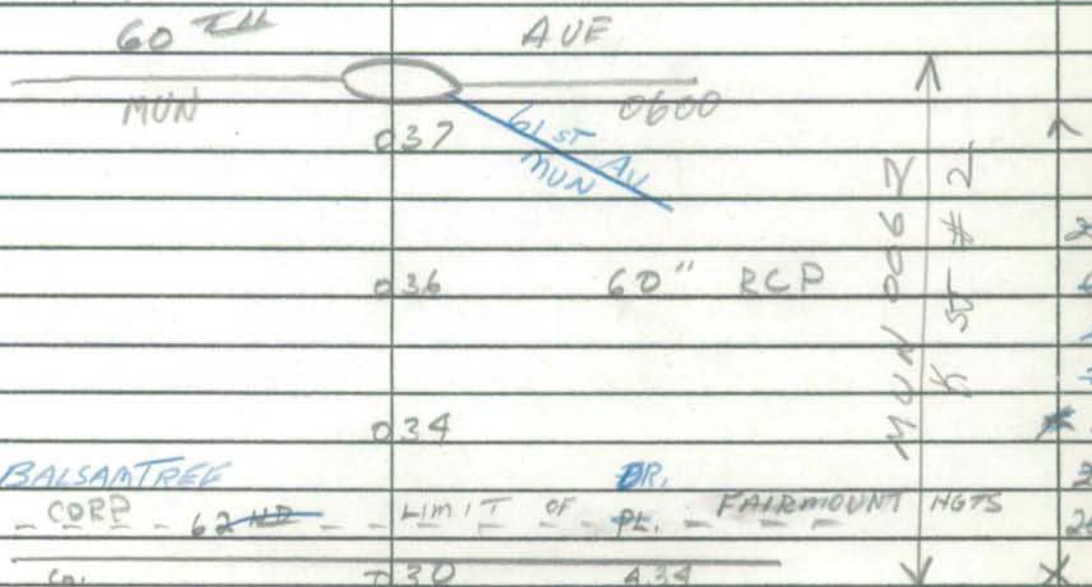

Form 6 HPS (Rev. 1961)

Map 7

2-040-B

ROAD INVENTORY SHEET

Co. JAVA PLACE ✓ 78

PARTY CHIEF Edward Schuyler
RECORDER Henry Gorman
CHAINMAN Jos. EMERICK

HIGHLAND PARK

ROAD NO. Co. 2808
NAME ~~71st PL.~~
SHEET NO. 1 OF 1
DATE 10/23/67
COUNTY PR. GEO.

VER 4-20-78

831-390 M31

	ROAD	RND.	
H	026		↑
H	025	H	
HIGHLAND ~~AV~~ PARK		DR ~~ST.~~	
Co.	003	426	
#	001		
	000	H	✓
	ROAD END.		

N ↑

~~22'E~~
~~C-E'D~~
~~SHLDS~~
~~24'-W~~
26I
JC-C

Form 6 HPS (Rev. 1961)

MAP 3

2-425-B

ROAD INVENTORY SHEET

ELSA AVE ✓ M78

PARTY CHIEF Edward Schuyler
RECORDER Henry Gorman
CHAINMAN Joe. Eberick

HIGHLAND PARK

ROAD NO. Co. 2809
NAME ~~69 [illegible] AVE~~
SHEET NO. 1 OF 1
DATE 10/23/67
COUNTY Prince Georges

VER 4-20-18

830-389 M31

ROAD ~~XXX~~ END ^

0 21

0 18 CHURCH

HIGHLAND ~~ST~~ ST ~~PARK~~ DR

0 17 Co. 426.

~~15'6~~

0 15

16 H 5 H

~~2'2D~~

~~0 14~~

0 12

~~HOLLOW~~

LOWLAND ~~ST~~ ST. 26'I

0 09. Co. 430 ~~E~~ J<-C

~~18'I~~

0 06

~~2 [illegible] E~~

~~0 [illegible]~~

ELEM

~~2'CLW~~

SCHOOL

0 00 ✓

ROAD END

SHA 51.3-8
11-15-72

STATE HIGHWAY ADMINISTRATION OF MARYLAND

ROAD INVENTORY SHEET

Party Chief MZ
Recorder JE
Helper

Map No. 31D

Road No. Co 2810
Road Name FIJI AVE
Sheet No. 1 of 1
Date 4-20-78
County PRINCE GEORGES
State Coordinates 830-389

S ↑

LOWLAND ST
CO ~~OP~~ 015 ~~620~~ 430 ↑

HIGHLAND PARK DR @.05
CO 007 426

26'I
Jc-c

~~MARTIN LUTHER~~ ~~KING JR. HWY~~
MD 000 704 ↓

SHA 51.3-8
11-15-72

ROAD INVENTORY SHEET

Road No. _____
Road Name _____
Sheet No. _____
Date _____
County _____
State Coordinates _____

Form 6 HPS (Rev. 1961)

MAP 7

Ver WD DT 9-7-77

2-362

ROAD INVENTORY SHEET

PARTY CHIEF Edward Schuyler
RECORDER Henry Gorman
CHAINMAN

MILL WOOD

835-380 M35

ROAD NO. CO. 2811
NAME MILLRACE RD.
SHEET NO. 1 OF 1
DATE 10/30/67
COUNTY PRINCE GEORGES

ROAD END

X-X-X-X

021

MILL WOOF DR.
Co. 019 2813

H 017

MILL WHEEL ST
CO. 2814 013

Z H

MILL RACE CT.
CO. 2812 008

H 006

P.T.

30

H 003 36' I

002 P.C. C-C

SHADY GLENN
CO. 2451

Form 6 HPS (Rev. 1961)

MAP7

Ver WD DT 9-7-77

2-363

ROAD INVENTORY SHEET

PARTY CHIEF Edward Schuyler
RECORDER Henry Gorman
CHAINMAN

MILLWOOD

ROAD NO. Co. 2812
NAME MILLRACE CT
SHEET NO. 1 OF 1
DATE 10/30/67
COUNTY PRINCE GEORGES

835-380 M35

H
CULDE SAC
0 07

4 H

26'I
C-C

4 H

0 01

MILL RACE RD
CO 2811

Form 6 HPS (Rev. 1961)

MAP7 Ver WD DT 9-7-77 2-365

ROAD INVENTORY SHEET

PARTY CHIEF Edward Schuyler
RECORDER Henry Gorman
CHAINMAN J. BURRICK / MILLWOOD

ROAD NO. CO. 2813
NAME MILLWOOD DR
SHEET NO. 1 OF 2.
DATE 10/30/67
COUNTY PRINCE GEORGES

835-381 M35

	035 H	
H	034 H	
H	033	
OVER	HEAD.	
D.R. T~TO	28 ~ T	POWERLINES
H	026 H	
MILL CO.	RACE RD. 2811	
T	022 T	
P.T	018	
50.	15 H	
11 H		
P.C.	007	
	003	26' I C-C
	001	
SHADY	GLEN DR 2451	

Form 6 HPS (Rev. 1961)

2-365

ROAD INVENTORY SHEET

PARTY CHIEF Edward Schuyler
RECORDER Henry Gorman
CHAINMAN J. EMERICK

ROAD NO. CO. 2&13
NAME MILLWOOD RD.
SHEET NO. 2 OF 2
DATE 10/30/67
COUNTY PRINCE GEORGES

Form 6 HPS (Rev. 1961)

MAP 7

Ver
WD
DT
9-7-77

2-364

ROAD INVENTORY SHEET

MILL WHEEL ST

PARTY CHIEF Edward Schuyler
RECORDER Henry Gorman
CHAINMAN J. EMERICK

MILLWOOD

ROAD NO. Co. 2814
NAME ~~MILLWHEEL ST~~
SHEET NO. 1 OF 1
DATE 10 Feb/67
COUNTY PRINCE GEORGES

835-381 M35

MILL | RACE RD.
Co. 0 17 2811

0 15

P.T. 11 H 0 12 9 H 26' I
C-L

30°

P.C. 0 03

SHADY | GLEN ~~RD.~~ DR
Co. 900 2451

Form 6 HPS (Rev. 1961)

MAP 7

Ver
WD
DT
9-T77

2-366

ROAD INVENTORY SHEET

PARTY CHIEF Edward Schuyler
RECORDER Henry Gorman
CHAINMAN J. EMERICK

MILLWOOD

ROAD NO. CO. 2815
NAME MILLWRIGHT ST.
SHEET NO. OF 1
DATE 10/30/67
COUNTY PRINCE GEORGES

836-380 M35

	ROAD END	
	~~XXXXXX~~ 008	
H	007	
MILLWOOF Dr		
CO. 2813	005	P.T.
	6 H	26'I C-C
		60°
H	001	P.C.
	CULDESAC 000	
H		

Form 6 HPS (Rev. 1961)

MAP 7

Ver WD DT 4-7-77

2-119

ROAD INVENTORY SHEET

PARTY CHIEF Edward Schuyler
RECORDER Henry Gorman
CHAINMAN

MILLWOOD.

ROAD NO. Co 2816
NAME SHADY GLEN CT.
SHEET NO. 1 OF 1
DATE 10/31/67
COUNTY PRINCE GEORGES

834-379 M35

Form 6 HPS (Rev. 1961)

Map 7 ✓er WD DT 9-7-77 2-324 ✓

ROAD INVENTORY SHEET

PARTY CHIEF Edward Schuyler
RECORDER Henry Gorman
CHAINMAN

WILBORN ESTATES

831-381 M35

ROAD NO. Co. 2817
NAME SISALBED DR.
SHEET NO. 1 OF 1
DATE 10/31/67
COUNTY PRINCE GEORGES

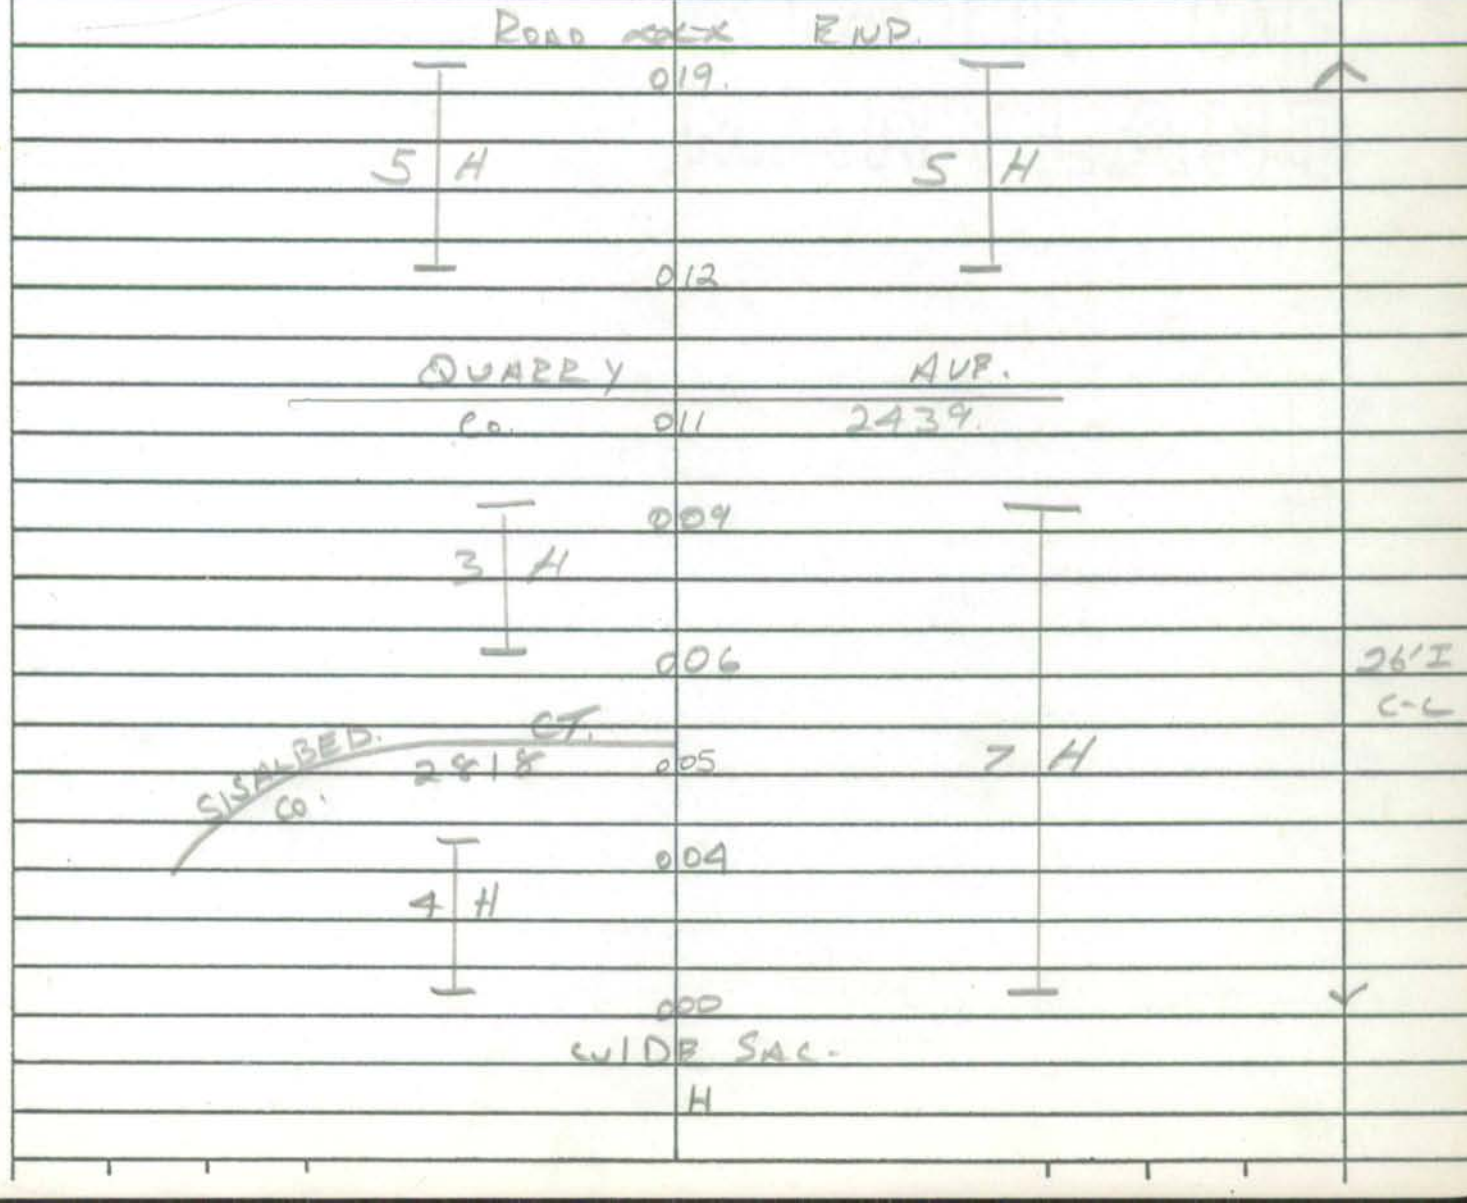

Form 6 HPS (Rev. 1961)

Map 7 Ver WD DT 9-7-77

2-325

ROAD INVENTORY SHEET

PARTY CHIEF Edward Schuyler
RECORDER Henry Gorman
CHAINMAN

WILBURN ESTATES

ROAD NO. Co. 2818
NAME SISLABED CT
SHEET NO. 1 OF 1
DATE 10/31/67
COUNTY PRINCE GEORGES

831-380 M35

Cul-De Sac.

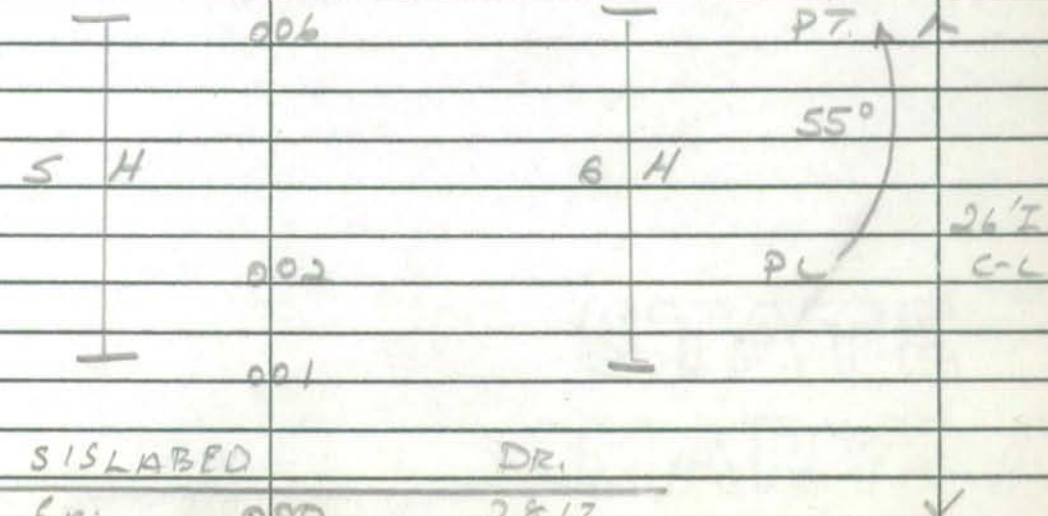

Form 6 HPS (Rev. 1961)

Map 7

Ver
WD
DT
9-7-77

2-153

ROAD INVENTORY SHEET

PARTY CHIEF Edward Schuyler
RECORDER Henry Gorman
CHAINMAN

WILBURN ESTATES

ROAD NO. Co. 2819
NAME CAPPY AVE.
SHEET NO. 1 OF 1
DATE 10/31/67
COUNTY PRINCE GEORGES

832-380 M35

ROAD ℄ ℄ END.

011

PT
80°
PC

7 H

010

7 H

006

003

26' I
C-C

WILBURN CO.

DR.

000

2437

Form 6 HPS (Rev. 1961)

MAP 6

ROAD INVENTORY SHEET

✓ 2-056

PARTY CHIEF Edward Schuyler
RECORDER Henry Gorman
CHAINMAN J. EMERICK

Ver 9-28-77

CAP., HGTS.

825-378 M35

ROAD NO. CO 2820
NAME CAMPBELL AVE
SHEET NO. 1 OF 1
DATE 11/11/67
COUNTY PR. GEO

ROAD END
C07

H

↑

26'I
C-C.

185°

005

H

003

H

BROOKE CO RD. 2153

Form 6 HPS (Rev. 1961)

ROAD INVENTORY SHEET

Party Chief
Recorder
Chainman

Road No. Co 2821
Name PARKMONT DR.
Sheet No.
Date
County

CO 2821
NOW
OP 821
NO RECORD OF COUNTY MAINTENANCE

SHA 51.3 - 8 Revised
4.83

* Corp Limits change at 0.18 From 2002 Mun. Map.

97-130
3-16-98
94-3

MARYLAND STATE HIGHWAY ADMINISTRATION

ROAD INVENTORY SHEET

OP 5052 BB/AA

Party Chief DT
Recorder TT
Assistant
Map No./Dir. G11 / S
State Coordinates 830 - ~~735~~ 375

98-131
G.D.
E.F.
2/25/99

Road No. CO. 2822
Road Name BOCHELLE AVE.
County P.G.
Date 11-23-94
Sheet No. 1 OF 2

CAPITOL HTS

TRAFFIC CODES
TRAFFIC CONTROLS: STOP SIGN=S.S., TRAFFIC LIGHT=T.L., FLASHING RED BALL=F.R.

TRAFFIC CODES
PARKING RESTRICTIONS: A.M. PEAK, P.M. PEAK, A.M./P.M. PEAK, NO PARKING ANYTIME=N.P., COMM/IND. ACCESS=E

SYSTEM				TRAFFIC		LINE DIAGRAM	TRAFFIC			PAVEMENT DATA
FED. AID.	FUNCT CLASS.	HWY. SYS.	HPMS SAMPLE	PRK.G. REST.	COM/IND. ACCESS	Capital Heights	CONTROL	COM/IND. ACCESS	PRK.G. REST.	
	URBAN LOCAL					PT 0 ~~30~~ 21				
						45^16 Corp Limits 0 18 of Capitol Heights				
						PC 0 ~~30~~ 15				
						PROSPERITY WAY CO 5912 0 ~~25~~ 10				46 I Jc-c 2UML
						HAZELWOOD Dr. ~~RD.~~ ~~(COUNTY ROAD)~~ ~~Co 000~~ 0 15.00 ~~SD 91 96-72-73~~ XX XX CO 5726				
						~~0 12~~ 30				
						~~PVT~~ ~~PVT~~ SAC. ~~DIE~~				~~46 I~~ ~~I C C~~ ~~2 UML~~

OP 5052

SYSTEM				TRAFFIC		LINE DIAGRAM	TRAFFIC				PAVEMENT DATA
FED. AID.	FUNCT. CLASS.	HWY. SYS.	HPMS SAMPLE	PRKG. REST.	COM/IND ACCESS		CONTROL	COM/IND ACCESS	PRKG. REST.		

.10-.18 was OP 773-69-156

Urban

DT/TT
11-23-94
94-33
96-72,73
3-26-97
BB/MG

SHA 51.3 - 8 Revised
4.83

MARYLAND STATE HIGHWAY ADMINISTRATION

ROAD INVENTORY SHEET

OP 3052

Party Chief E. Schuyler
Recorder H. Gorman / J. Emerick
Assistant Rewritten 11/26/93 KJP
Map No./Dir. G11 / S
State Coordinates 830-735

Road No. Co 2822
Road Name Rochelle ~~Dr~~ AVE
County Prince Georges
Date 11/1/67
Sheet No. 2 X OF 2X

91-87 A/T
69-156

TRAFFIC CODES
TRAFFIC CONTROLS: STOP SIGN=SS, TRAFFIC LIGHT=T.L., FLASHING RED BALL=F.R.

TRAFFIC CODES
PARKING RESTRICTIONS: A.M. PEAK, P.M. PEAK, A.M./P.M. PEAK, NO PARKING ANYTIME=N.P., COMM/IND. ACCESS=E

SYSTEM				TRAFFIC		LINE DIAGRAM	TRAFFIC			PAVEMENT DATA
FED. AID.	FUNCT CLASS.	HWY. SYS.	HPMS SAMPLE	PKG. REST.	COM/IND. ACCESS		CONTROL	COM/IND. ACCESS	PKG. REST.	
						ATwood ST				
						Rochelle Ave 03 00 Mu				
						0.06 mile				
						↑ Corp. Limits of / ↓ District Heights ↑				
						0 18 58 43				
						0 17 57 42 PT				
						75°				
						0 16 56 37 PC				
						↑ PT 0 10 50 35				
						85°				
				E		PC Swimming pool 0 07 47 32				
										36' I
										C-C
										2 ML
						Walker Mill Rd				
X	Co	XX	XXX	X	0	00 40 25 XX 367 ↑ XX			X	
						25 mph				46' I
										JC-C
										2 UML

Urban Local

SYSTEM				TRAFFIC		LINE DIAGRAM	TRAFFIC			PAVEMENT DATA
FED. AID.	FUNCT. CLASS.	HWY. SYS.	HPMS SAMPLE	PRKG. REST.	COM/IND ACCESS		CONTROL	COM/IND ACCESS	PRKG. REST.	

Form 6 HPS (Rev. 1961)

Map 7 Ver WD DT 9-6-77

3-084 78

ROAD INVENTORY SHEET

PARTY CHIEF Edward Schuyler
RECORDER Henry Gorman
CHAINMAN J. EMERICK

OLDE TOWNE VILLAGE

ROAD NO. Co 2823
NAME ADDISON Rd.
SHEET NO. 1 OF 1
DATE 10/30/67
COUNTY PRINCE GEORGES

832-376 M35 75-67

	ROAD 036 END		↑24'I
	032	SCHOOL - THOMAS CLAGGETT E.S.	J-CURB RT 30' CW
	ROAD END		
	029		
	028 ENTR. TO PARKING AREA		
	027		
PT.	023	28 H	
50°			
P.C.	015		
	015 PARKING ENTR. & SWIM. POOL		
	012		
		10 H	
	008		36'I J E.C.
WALKER RD.	000 MILL RD. 3107		

Form 6 HPS (Rev. 1961)

MAP 7

UNASS. NO 2-202

ROAD INVENTORY SHEET

BEECHNUT Rd

PARTY CHIEF Edward Schuyler
RECORDER Henry Gorman
CHAINMAN J. EMERICK

ROAD NO. Co 2824
NAME ~~WALKER MILL Rd~~
SHEET NO. 1 OF 1
DATE 10/30/67
COUNTY PRINCE GEORGES

836-379 M35

ROAD END
2.000

H 0.05

14' I
CURB LT
3' SHLD. RT.

BEECHNUT Rd.
CO 2441 0.04

* 17 C.W.

24' I
CURB LT
2' E SHLD. RT.
26 C.W.

WALKER MILL Rd
80
WOOD

Form 6 HPS (Rev. 1961)

Map 6

2-008-C 17

ROAD INVENTORY SHEET

HYBRID AVE

Ver 10-5-77 S.

PARTY CHIEF Edward Schuyler
RECORDER Henry Gorman
CHAINMAN Litterick

Cap. Hgts

ROAD NO. CO. 2825
NAME ~~5 3RD PL~~
SHEET NO. 1 OF
DATE 11/17/67
COUNTY ~~PRINCE GEORGES~~

821-380 M35

Marlboro Pike
Co 023 3074

Heath St.
Co 017 374

003

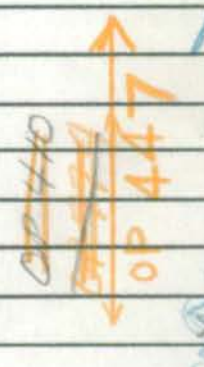

26'I
JC=C.

GUNTHER (W ST) ST. (W ST)
CO 000 372

Form 6 HPS (Rev. 1961)

ROAD INVENTORY SHEET

Party Chief
Recorder
Chairman

Road No. C02826
Name TENBURY Ct.
Sheet No.
Date
County

CO 2826
NOW
OP 820
NO RECORD OF COUNTY MAINTENANCE

Form 6 HPS (Rev. 1961)

ROAD INVENTORY SHEET

Party Chief
Recorder
Chainman

Road No. CO 2827
Name LYNFORD CT
Sheet No.
Date
County

CO 2827
NOW
OP 816

NO RECORD OF COUNTY MAINTENANCE

SHA 51.3-8
11-15-72

STATE HIGHWAY ADMINISTRATION OF MARYLAND

Ver 9-21-77

18

FAU

ROAD INVENTORY SHEET

Party Chief R. BUSH (OFFICE INV)
Recorder
Helper

Map No. M 35 T. LANDON F. RHODES
INDEX 6 2/26/75 REVISED

Road No. Co 2828
Road Name BROOKS DR
Sheet No. 1 of 3
Date 11-17-67 REVISED 6-28-74
County PR GEO
State Coordinates 822-371

	MEDORA DR.			
	Co ~~2084~~ 2096	036		* 40'I C-C
		035	ENTRANCE TO CONVENT	~~22'I~~
		032	gate ENTRANCE	X ~~3'E Shld Lt.~~
		028	NUNNERY	~~13'E Shld Rt~~ ~~37'CW~~
		027		*
		023	NUNNERY	
FAU 5220 COLLECTOR - URBAN				36'I ~~36'I~~ C-C
	Co 1676	021		
		018		X
		014	ENTRANCE TO NUNNERY	
	HOMER AVE			
	Co 527	012		
	HURON AVE			40'I C-C ~~20'I~~ ~~2-8'E Shld~~
	Co 523	006		
	Bus	002		
	MD	000	458	

N

SHA 51.3-8
11-15-72

ROAD INVENTORY SHEET

Road No. Co 2828
Road Name
Sheet No. 2 OF 3
Date
County
State Coordinates

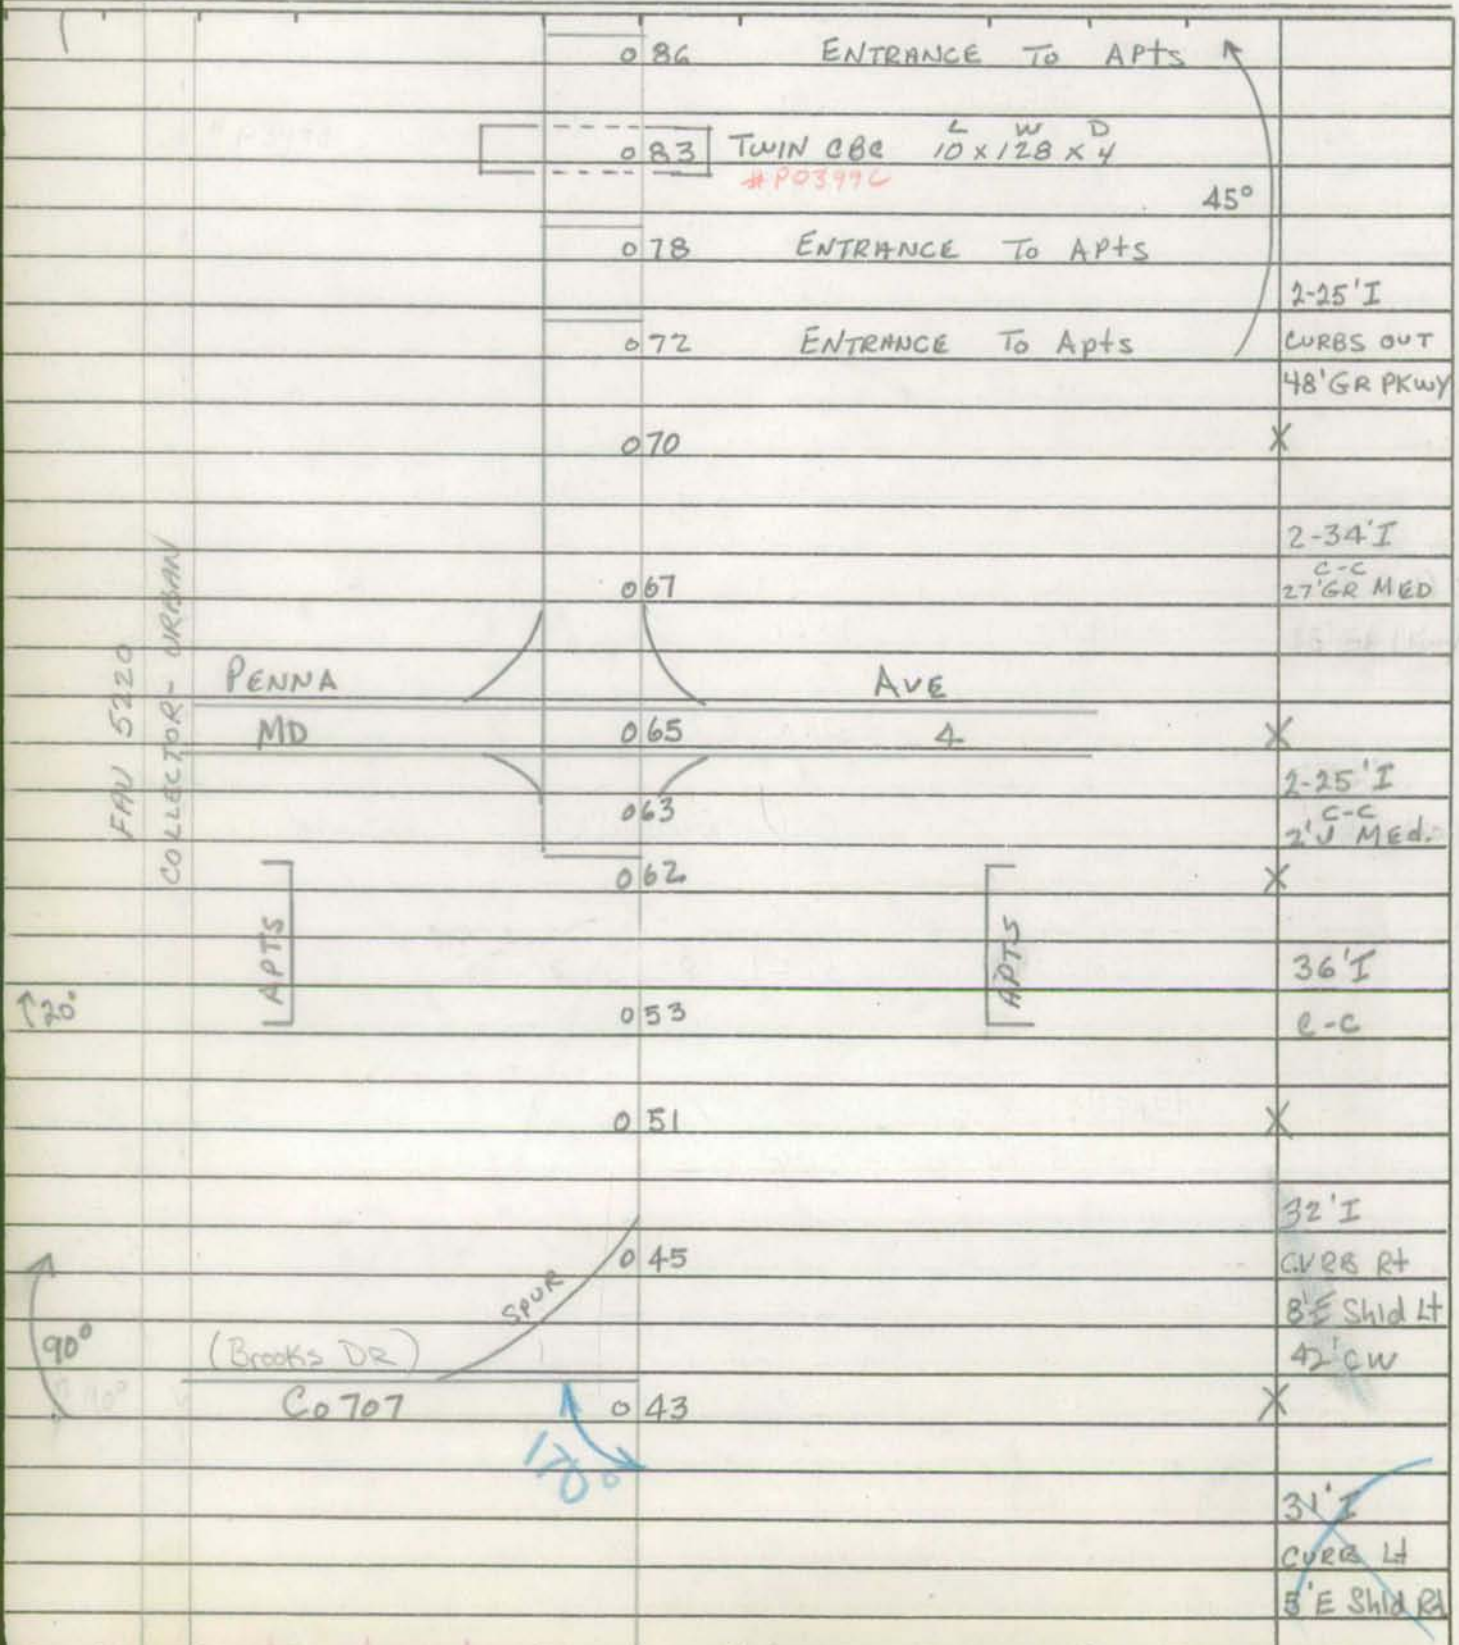

SHA 51.3-8
11-15-72

STATE HIGHWAY ADMINISTRATION OF MARYLAND

18

ROAD INVENTORY SHEET

Party Chief R.Bush
Recorder
Helper

Map No.

Road No. Co 2828
Road Name BROOKS DR
Sheet No. 3 of 3
Date
County PR GEO
State Coordinates

BARRICADE 115

~~BARRICADE~~
112

110

NON FA
LOCAL - URBAN

MARLBORO
CO

PIKE
103 3074

FAU 5220
COLLECTOR - URBAN

ADLEY
CO.
ST.
74-99

099
14'I
096
093 ENTRANCE TO APTS

2'36' I
C-C
24'GR MED

45°

SHA 51.3-8
11-15-72

ROAD INVENTORY SHEET

Road No. _____
Road Name _____
Sheet No. _____
Date _____
County _____
State Coordinates _____

Form 6 HPS (Rev. 1961)

MAP3

OR 1-597 V 78
2829

ROAD INVENTORY SHEET

Party Chief E. SCHUYLER
Recorder W. DOMOROSKI
Chainman

68-20
VER 11-15-77

72 12/20 120

810-431 M31

Road No. Co 2829
Name MISTLETOE PL
Sheet No. 1 OF 1
Date 5-6-69
County PRINCE GEORGES

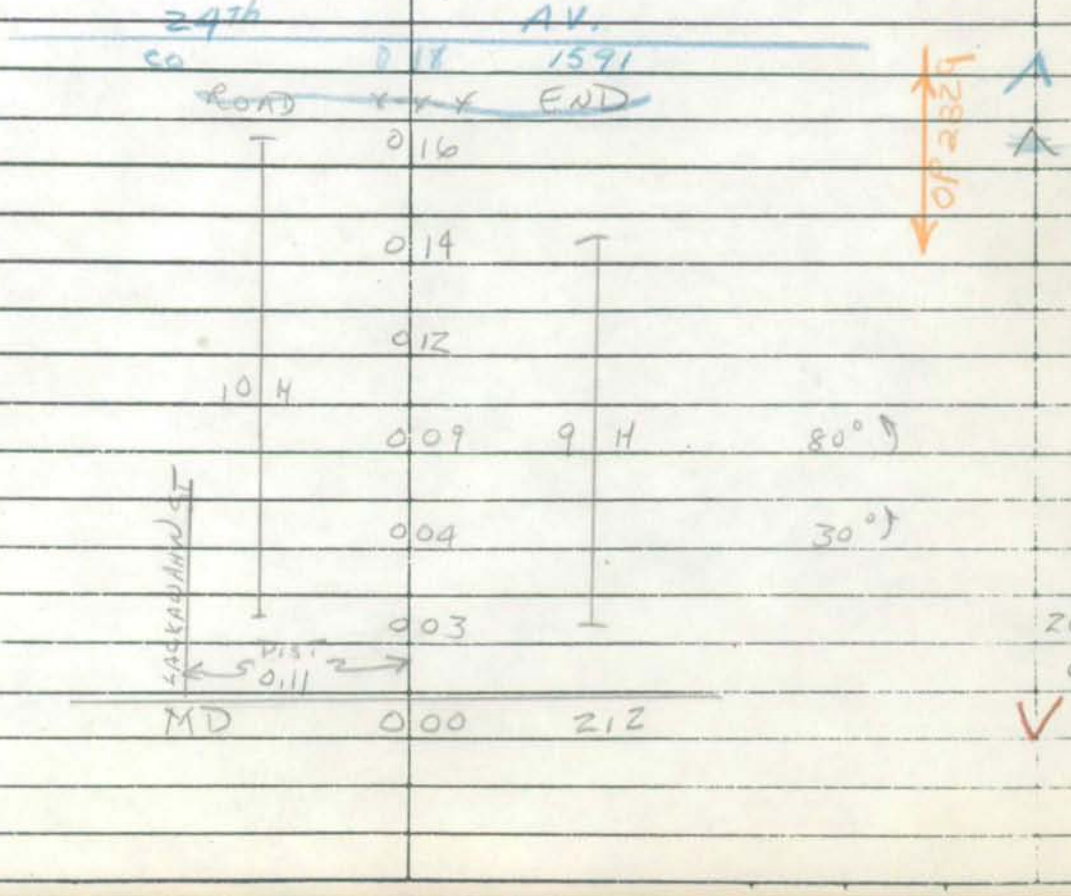

Form 6 HPS (Rev. 1961)

Map 6

97-127
3-16-98
BB/MP
R/T

2-023-D

Quo

Ave

ROAD INVENTORY SHEET

Ver
10-5-77 =
00-COEx25
2-16-01

PARTY CHIEF Edward Schuyler
RECORDER Henry Gorman
CHAINMAN J. EMERICK

S. Cap. Hgts

G-11B
823-379 ~~M35~~

ROAD NO. Co 2830
NAME ~~61ST PL~~
SHEET NO. 1 OF 1
DATE 11/17/67
COUNTY PRINCE GEORGES

GOIEF

ROAD END
X-X-X
0 15

3 H

4 H

N

GUNTHER (N ST)
CO. ~~008 ST~~

ST (N ST)

007

005 H

10 H

(Rally Ave.)
001 Co 5103 90-145

000 ROAD END H

Form 6 HPS (Rev. 1961)

Map 6 & 7

3-722

ROAD INVENTORY SHEET

Ver 9-28-77

PARTY CHIEF Edward Schuyler
RECORDER Henry Gorman
CHAINMAN J. EMERICK

PARKLAND

ROAD NO. CO. 2831
NAME NORMAN CT
SHEET NO. 1 OF 1
DATE 11/26/67
COUNTY PRINCE GEORGES

826-371 M35

CULDE SAC.
SCHOOL
005

4 H

26' I
C-C.

001

NORMAN ~~AVE~~ DR

CO 000 2144

Form 6 HPS (Rev. 1961) MAP 7 3-224

ROAD INVENTORY SHEET

Ver 9-27-77

PARTY CHIEF Edward Schuyler
RECORDER Henry Gorman
CHAINMAN J. EMERICK PARKLAND

ROAD NO. CO. 2832
NAME SURFACE SERVICE DR.
SHEET NO. 1 OF 2
DATE 11/29/67
COUNTY PRINCE GEORGES

828-369 M35

0 30

0 27 SWIMMING POOL

0 25

56

APT UNITS

38'I CURB RT
6'E SHLD LT. 41'CW

0 19 X

REGENCY PKY

30'I CURB RT
6'E SHLD LT. 362'CW

~~CREHORN LA~~

0 16 CO 2833 X

009 P.T.

30°

005 P.C.

24'I
2-6'E SHLDS
40'CW

Parkland

~~HAZELHURST~~

DR

~~DR~~

CO 000 RD

Form 6 HPS (Rev. 1961) Map 7

78

ROAD INVENTORY SHEET

PARTY CHIEF Edward Schuyler
RECORDER Henry Gorman
CHAINMAN S. EMERICK PARKLAND

ROAD NO. CO. 2832
NAME SURREY SERVICE DR
SHEET NO. 2 OF 2
DATE 11/29/67
COUNTY PRINCE GEORGES

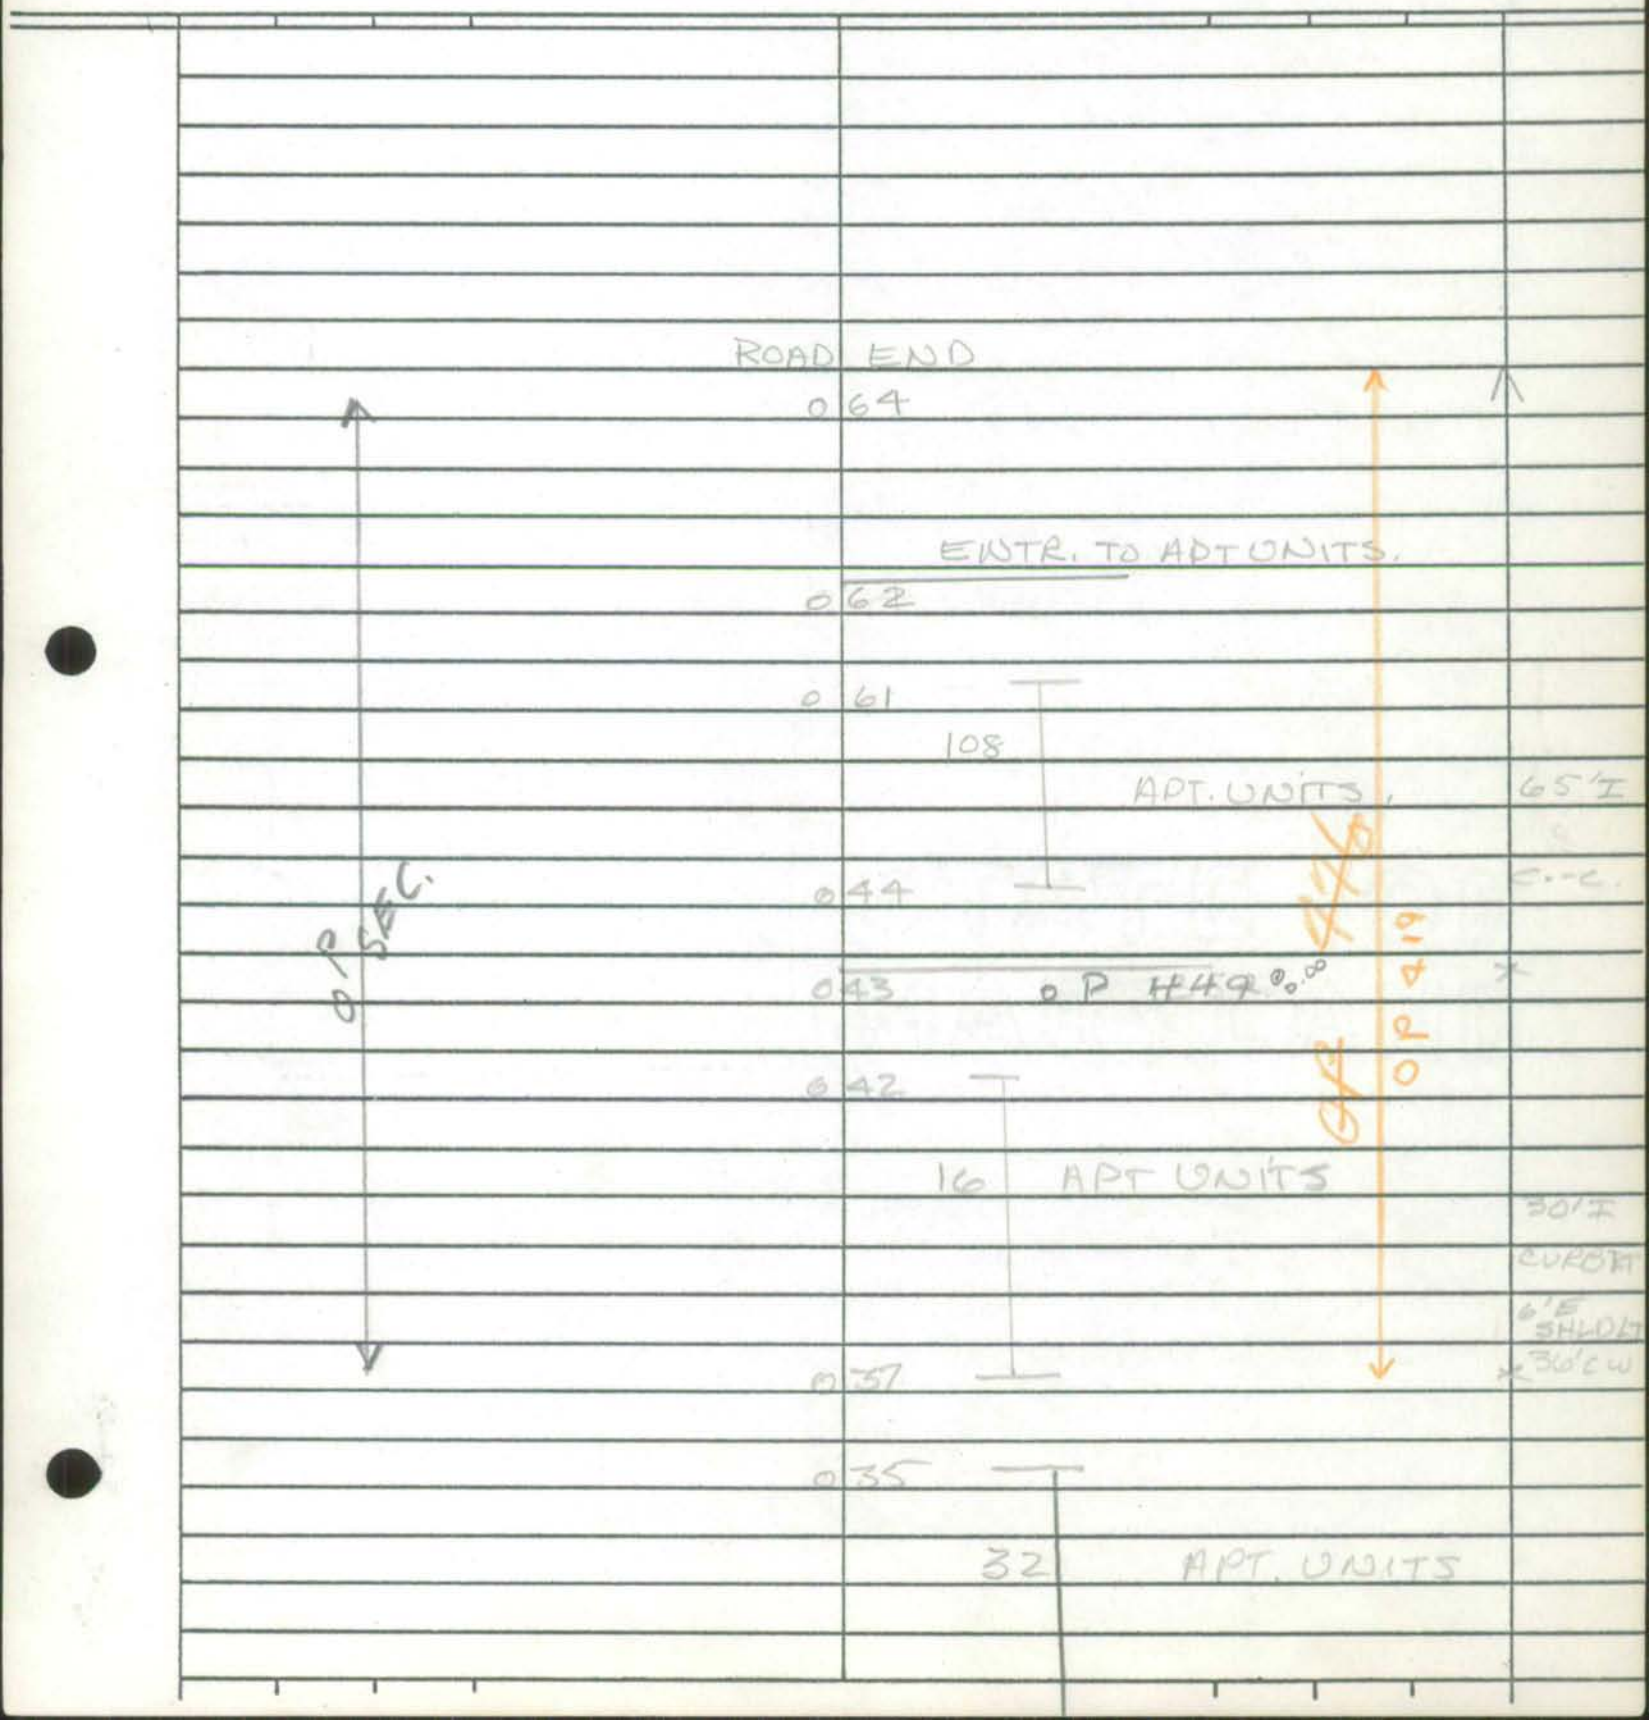

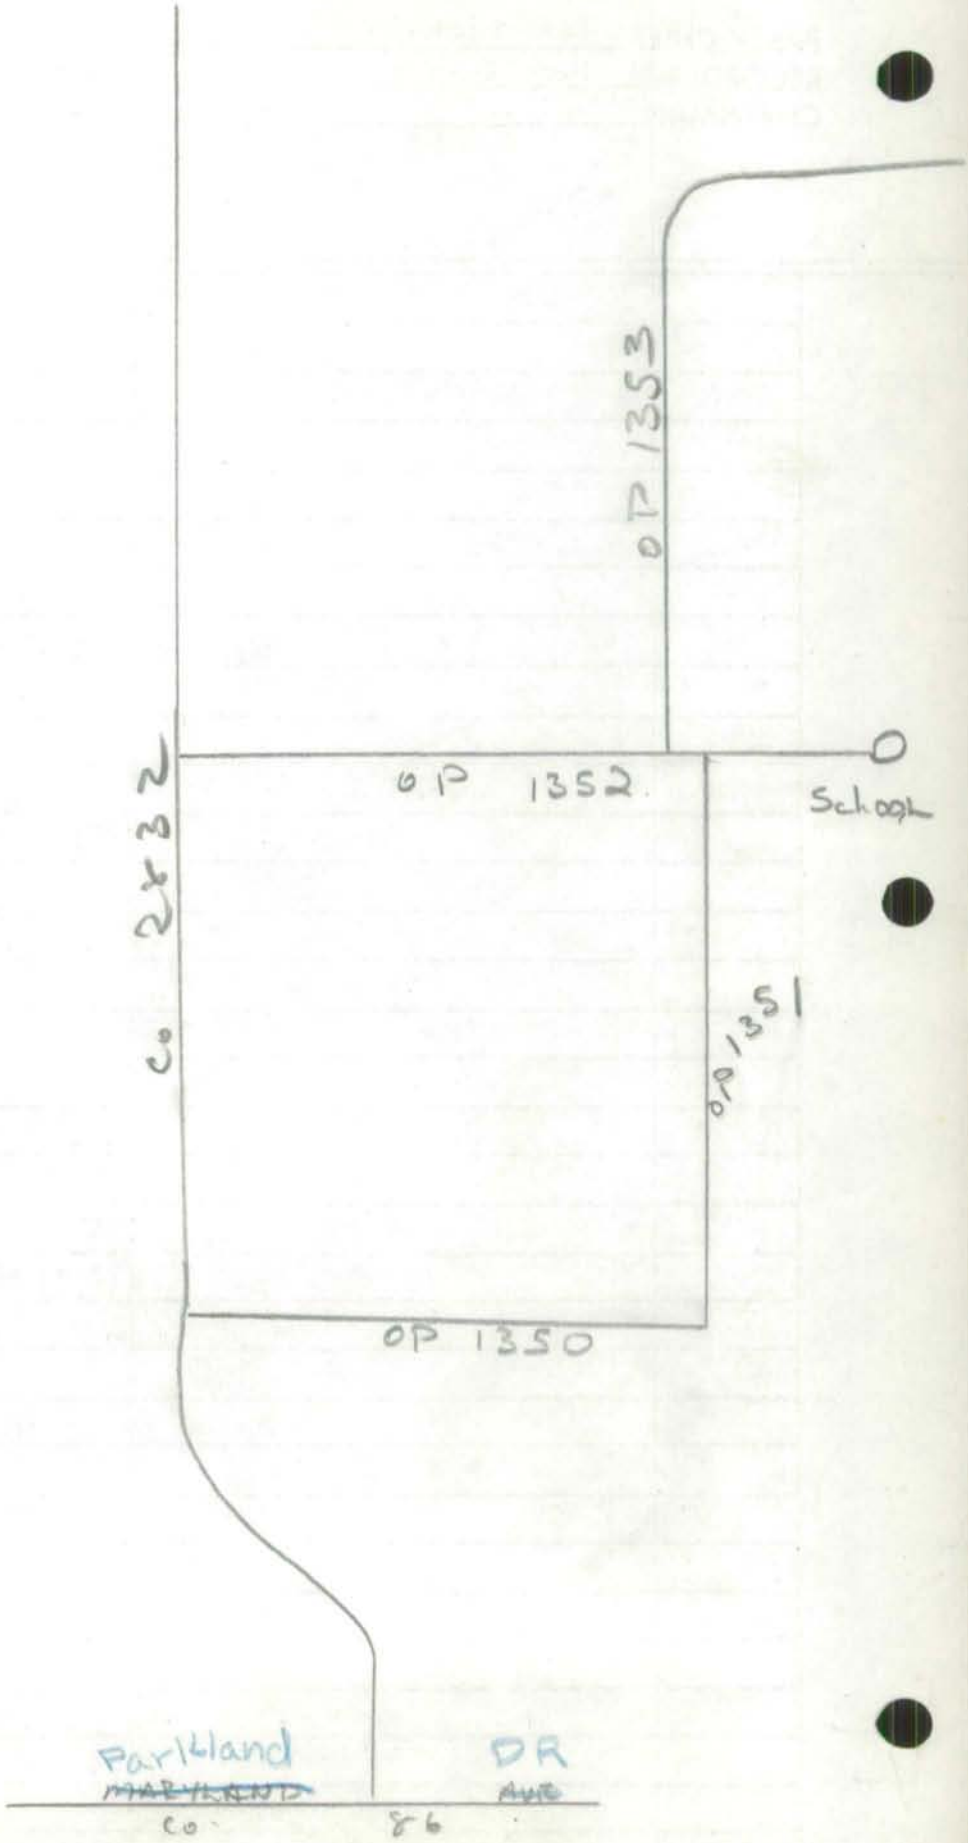
OP 1353
OP 1352
School
Co 2232
OP 1351
OP 1350
Parkland
DR
Co
86

Form 6 HPS (Rev. 1961)

~~MAP 7~~ A/T GD. AR. 93-89 3-16-94 3-312 OP ~~5094~~ 18 DT/TT 3-6-95 93-89

ROAD INVENTORY SHEET

Ver 9-27-77

PARTY CHIEF Edward Schuyler
RECORDER Henry Gorman
CHAINMAN J. EMERICK

PARKLAND

ROAD NO. REGENCY PKWY Co. 2833
NAME ~~CRESTMORE LA.~~
SHEET NO. 1 OF 1
DATE 11/26/67
COUNTY PRINCE GEORGES

G11B 828-369 M35 95-94

ROAD	END	
XXXX	039	
HIL-MAR DR	031	
CO 2668	030	30' I
~~ROAD~~	~~END~~	I CB LT
XXXX	BARRICADE	I CB RT 2 UNK
SURREY SQUARE WA		
CO. 2834	011	X
	010	
	72 APT UNITS	
		30' I
	002	CURB LT
SURREY	SERVICE DR.	3' A SHLDR
CO	2832	

Form 6 HPS (Rev. 1961) Map 7

3-315 18

ROAD INVENTORY SHEET

Ver 9-27-77 PARKLAND

PARTY CHIEF Edward Schuyler
RECORDER Henry Gorman
CHAINMAN J. ENEKICK

ROAD NO. CO. 2834
NAME SURREY SQUARE LA.
SHEET NO. 1 OF 1
DATE 11/24/67
COUNTY PRINCE GEORGES

829-368 M35

ENT. TO SCHOOL
DP 025 449

023 - SCHOOL

022

PARK

12 APT. UNITS 011
ENT. TO POOL
172 APT UNITS 007

SC'I
C-C.

REGENCY ~~PKY~~
~~CREMORNE LA~~ PKWY

CO. ~~2833~~ 2833

Form 6 HPS (Rev. 1961) Map 7 3-339

ROAD INVENTORY SHEET

Party Chief F.S.
Recorder N.D.
Chainman

Ver 10-11-77
RITCHIE
69-166

Road No. CO 2635
Name INLAND DR
Sheet No. 1 OF 1
Date 10-30-68
County PRINCE GEO

839-377 M35

CO RICHVILLE	016	2630 DR		
	015			
↱ 80° 12 H	004	10 H		
	001			26' I
CO EASTWOOD	000	2629 DR		C-C

Form 6 HPS (Rev. 1961)

3-374

ROAD INVENTORY SHEET

Party Chief E SCHAYLER
Recorder T LANGAN
Chainman D EMERICK
D PLUMMER

OXEN RUN

MAP 6

Road No. CO. 2836
Name 36TH PL
Sheet No. 1 OF 1
Date 12 - 1 - 67
County PRINCE GEORGES

		UNASSIGNED	
UNASSIGNED DUPLICATION OF CO 43	PRO P.	GREENWAY DR.	
	005	CO. 77	
	003	H	23' I CURB RT. 3' E 3 HLD LT. 26' CW.
SOUTHERN		AVE.	
APPROX. D.C.		LINE.	

36TH PL

98-4 (FDIM)
11/17/98
55/88

SHA 51.3 - 8 Revised
4.83

MARYLAND STATE HIGHWAY ADMINISTRATION

ROAD INVENTORY SHEET

94-71 CO
94-70, 74
91-92
73-66

Party Chief SNYDER
Recorder BOOTH
Assistant
Map No./Dir. G11B / N
State Coordinates 824-365

Road No. CO 2837
Road Name REGENCY PKWY
County PG
Date 11/17/98
Sheet No. 1 OF 2

TRAFFIC CODES
TRAFFIC CONTROLS: STOP SIGN-SS, TRAFFIC LIGHT=T.L., FLASHING RED BALL=F.R.

TRAFFIC CODES
PARKING RESTRICTIONS: A.M. PEAK, P.M. PEAK, A.M./P.M. PEAK, NO PARKING ANYTIME=N.P., COMM/IND. ACCESS=E

SYSTEM				TRAFFIC		LINE DIAGRAM	TRAFFIC			PAVEMENT DATA
	FUNCT CLASS	HWY. SYS.	HPMS SAMPLE	PKG. REST.	COM/IND ACCESS		CONTROL	COM/IND ACCESS	PKG. REST.	
						028				
						10FT LT				
						025 SPUR 0.02/16I/SCC				52'I
						PD 81				JC-C
										4ML
						SUITLAND CO 022	TL		X	
										30'I
										JC-LT
										2ML
						013			X	
										52'I
										JC-C
										2ML
						004 ENT TO APTS		E	X	
										52'I
										JC-C
										2UHL
						000 BARRICADE			V	

COUNTY PG ROAD NO. CO 2837 PAGE 2 OF 2

SYSTEM: FUNCT CLASS	SYSTEM: HWY SYS	SYSTEM: HPMS SAMPLE	TRAFFIC: PKG. REST.	TRAFFIC: COM/IND ACCESS	LINE DIAGRAM	TRAFFIC: CONTROL	TRAFFIC: COM/IND ACCESS	TRAFFIC: PKG. REST.	PAVEMENT DATA
					REGENCY LA				
					CO 5511 0 56				^
									52'I
									JC-LT
									2ML
					0 53				X
			E		TO TH'S + PKG 0 51 (A)				
			E		TO TH'S + PKG 0 48 ANDREW JACKSON JR. HS				
									52'I
									JC-C
									2ML
			E		TO TH'S + PKG 0 43 EXIT SCHOOL		E	X	
			E		TO TH'S + PKG 0 40				
			E		TO TH'S + PKG 0 38 TO SCHOOL		E		
					STONEY MEADOWS DR ROCK QUARRY TERR				
					0 31				
									52'I
									JC-C
									4ML

Form 6 HPS Rev. 1961

MAP 6

ROAD INVENTORY SHEET

Party Chief
Recorder
Chairman

OXON RUN HILLS

812-369 M35

Road No. S 2538
Name No Name
Sheet No.
Date
County

UNASSIGNED
No Record of Count Maintenance
NOW OP 851

Form 6 HPS (Rev. 1961)

Map 6

3-131-A

ROAD INVENTORY SHEET

Party Chief E SCHUYLER
Recorder T LANDON
Chainman J EMERICK
D PLUMMER

SILVER HILL
PARK VER
815-366 M35
8-25-77

Road No. Co 2839
Name KEATING ST
Sheet No. 1 of 1
Date 12-19-67
County PRINCE GEORGES

		ROAD END	
	027	ENT TO PARKING LOT	
← 50' →	021	SHOPPING CENTER	20'I
	017	ST. CLAIR DR	C-C
165°	016	Co 1296	
PARKING LOT	013		
SHOPPING CENTER	001	85'I	40'I
		KEATING ST	C-C
PARKING LOT	000	Co 1194	

Form 6 HPS (Rev. 1961) Map 6 3-241

ROAD INVENTORY SHEET

Party Chief G SCHUYLER
Recorder T LANDIN
Chainman D FREDERICK
D PLUMMER

SILVER HILL
PARK VER
817-363 M35
8-22-77

Road No. Co 2840
Name HOLLY TREE RD
Sheet No. 1 OF 1
Date 12- 19 -67
County PRINCE GEORGES

		XXXX	
	ROAD	047	END
		046	
7 H		043	6 H
130°		034	
	H	031	H 30°
PT 40° PC	H RANGER AVG Co 2476	025	
		021	
		019	H 30°
	B-CAR WASH	002	B-TOYS
	MD	000	414

36'I
O-C

Form 6 HPS (Rev. 1961) Map 6

98-24
11/17/98
SS/BB

3-141 M

ROAD INVENTORY SHEET

Party Chief E SCHUYLER
Recorder T LANDON
Chainman J EMERICK
D PLUMMER

NORTH BARNABY VER 8-17-72

T. LANDON 2/27/75
F. RHODES REVISED 360 M35 24-114

Road No. Q 2841
Name LESLIE AVE
Sheet No. 1 of 1
Date 12- -20 - -67
County PRINCE GEORGES

~~BARRIER~~ CADE

H CUL 0 22 SAG H

H ~~ROAD~~ 0 20 ~~END~~ H

H 0 17

0 16 11 H

9 H

0 1

TEMPLE HILL RD 123

0 00

Co

0 127

20' F
~~26' CW~~

20' CI
2-4' ADD
30' CW
20 ML

Form 6 HPS (Rev. 1961)

5-295

ROAD INVENTORY SHEET

Party Chief E.S.
Recorder W.D.
Chainman

62-

MAP 10

CLINTON VEQ

840-338 M35 7-28-77

Road No. CO 2842
Name WILDER ST
Sheet No. 1 OF 1
Date 9-25-68
County PRINCE GEO

		(FLETCHER AVE) CO 2998	
ROAD	009	END	N
	007	H	
	006	H	
CO 2355			
WENDY ST	005	H	
			RD 'I
CO		2261	2-BESHO
CHELTENHAM	000	AVE	

Form 6 HPS (Rev. 1961) FAU 1-166 L

ROAD INVENTORY SHEET

2

Party Chief E. Schuyler
Recorder H. GORMAN
Chainman

812-436 m31

Road No. Co. 2843
Name PINEWOOD CT.
Sheet No. 1 OF 1
Date 8/9/66
County PRINCE GEORGE'S

UNASSIGNED
DUPLICATION CO 813
R Bush
1-17-72

Cul - De Sac

006

S H

S H

20'C
28'C-L

002

POWDER MILL RD.

MD. 000 212

Form 6 HPS (Rev. 1961) MPS 4 1-364

ROAD INVENTORY SHEET

Party Chief E. SCHUYLER
Recorder T. LANDON
Chainman E. HOENIG

VER 6-6-78

BOWIE

863-429 M32

Road No. Co 2844
Name 5TH STREET
Sheet No. 10F1
Date 4-9-68
County PRINCE GEORGES

	ROAD	END		
H	011			↑
	007	6 H	18' CMP	18' H
	006			24' SHLD
MAPLE		AVE		
Co	000	107		↓

SHA 51.3-8
11-15-72

STATE HIGHWAY ADMINISTRATION OF MARYLAND

FAU

ROAD INVENTORY SHEET

78
98-81a
11-13-98
SS/SR

Party Chief M. Z.
Recorder J. E.
Helper

Map No. 31B
77-152+153

Road No. Co. 2845
Road Name MAGNOLIA DRIVE
Sheet No. 1 OF 1
Date 1-11-78
County PR. GEO
State Coordinates 843 - 418

SHA 51.3-8
11-15-72

ROAD INVENTORY SHEET

Road No. _____
Road Name _____
Sheet No. _____
Date _____
County _____
State Coordinates _____

Form 6 HPS (Rev. 1961)

1-387

ROAD INVENTORY SHEET

Party Chief E. SCHUYLER
Recorder F. SETTAN
Chainman

VER 12-27-77

~~MAP~~

842-420 M31 P

Road No. Co 2846
Name ORBIT LANE
Sheet No. 1 OF 1
Date 6-4-68
County PRINCE GEO

	ROAD 0 13 END		A SAME
	~~ROAD~~ 012 ~~END~~		
	011		
7 H		7 H	
	002		26'I
			Je-c
E			
Co CIPRIANO	000	28 ROAD	

Form 6 HPS (Rev. 1961) Map 4 2-412

ROAD INVENTORY SHEET

Party Chief E.S
Recorder W.D.
Chainman F.S.

Road No. CO. 2847
Name WYATT DRIVE
Sheet No. 1 OF 1
Date 6-13-68
County PRINCE GEO

VER 3-30-78 844-411 M31

		CO 2046	
	0 40	BALLA DR.	↑
	0 39		
	0 38	↑45°	
16 H			15 H
↑30°	0 28		
	0 20		
CO		2412	
BARKER	0 18	PLACE	
	0 16		
7			8
	0 07		
CO		2874	
ELLERBIE	0 06	ST	
	0 04		
3 H			3 H
ROAD	0 00	END	

Rt I
TC-C

Form 6 HPS (Rev. 1961) Map 4 2-341

ROAD INVENTORY SHEET

Party Chief E.S.
Recorder W.D.
Chainman F.S.

Road No. CO 2848
Name CLAYTON ST
Sheet No. 1 OF 1
Date 6-13-68
County PRINCE GEO

VER 3-30-78 844-410 M31

ROAD	0	07 END	
H	0	06 H	
CO		1897	
ACCONA	0	04 ST	
			R6 I
CO		2413	JC-C
RANDERA	0	00 ST	

Form 6 HPS (Rev. 1961)

2-452

ROAD INVENTORY SHEET

VER 12-29-77

Party Chief E. SCHUYLER
Recorder F. SETTAN
Chainman

MAP 4

839-413 M31

Road No. Co 2849
Name MAGNOLIA COURT
Sheet No. 1 OF 1
Date 6-3-68
County PRINCE GEO

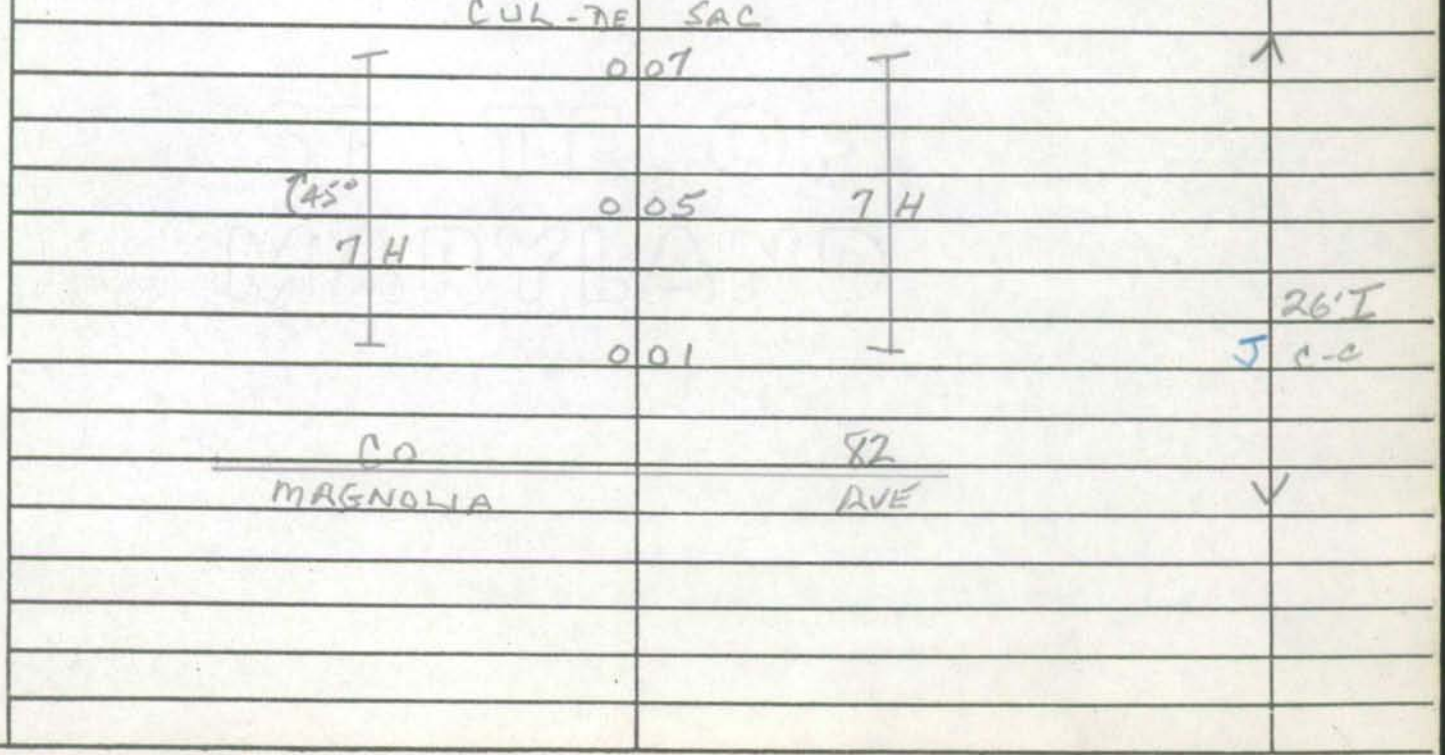

Form 6 HPS (Rev. 1961)

1-540

ROAD INVENTORY SHEET

Party Chief E.S.
Recorder P.S.
Chainman

VER 12-27-77
81-31

MAP

68-28

841-417 M31B 7718

Road No. Co 2850
Name WOODSIDE DRIVE
Sheet No. 1 OF 1
Date 6-4-68
County PRINCE GEO

Co MAGNOLIA	024	2845 DRIVE	
H	021	H	
H	020	H	
Co CHERVIL	018	2852 ROAD	
T	015	H	
	014	H	
	012	Co 2853 SAFFRON DRIVE	28'I
6 H			~~26'I~~
	011	H	JCC
	010		
I	007		26'I JCC
CO 1645 WOODSIDE COURT	005		
H	001		21'I CURB LT 26 CW
Co GOOD ~~LUCK~~	000	42 LUCK ROAD	
PARKING LOT			

Form 6 HPS (Rev. 1961)

1-472

ROAD INVENTORY SHEET

Party Chief E. SCHUYLER
Recorder F. SETTAN
Chairman

VER-12-27-77

MAP

841-417 M31

Road No. Co 2851
Name DOLPHIN ROAD
Sheet No. 1 OF 1
Date 6-4-68
County PRINCE GEO

Co GOODLUCK	0	42 22 LUCK ROAD
	0	21
		.3 H
	0	16
		Co 2853
	0	14 SAFFRON DRIVE
10 H	0	11 H
	0	09 H
		Co 2852
	0	08 CHERVIL ROAD
	0	06 H
	0	03 H
Co MAGNOLIA	0	00 2845 DRIVE

26I
TC-C

Form 6 HPS (Rev. 1961)

MAP 4

1-474

ROAD INVENTORY SHEET

Party Chief E.S.
Recorder F.S.
Chainman

840-418 m31

VER 12-27-77

68-27
69-80

Road No. C.O. 2852
Name CHERYL ROAD
Sheet No. 1 OF 1
Date 6-4-68
County PRINCE GEO

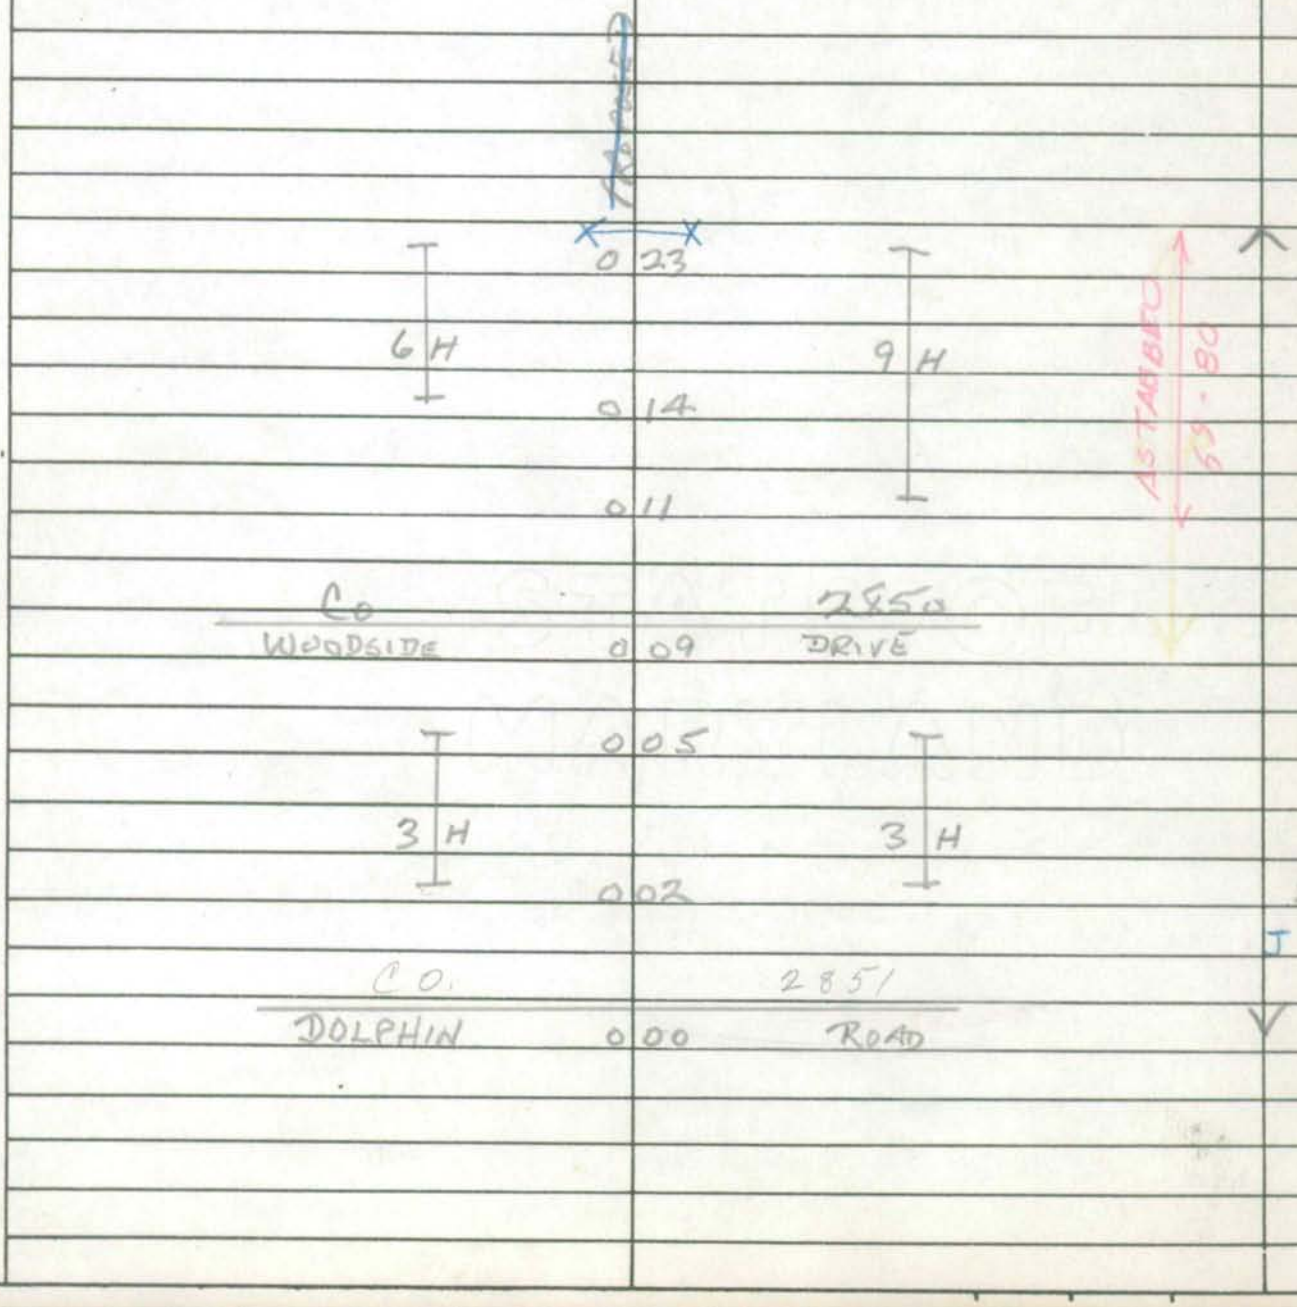

Form 6 HPS (Rev. 1961)

1-473

ROAD INVENTORY SHEET

Party Chief E.S.
Recorder E.S.
Chainman

841-417 M31

VER 12-27-77

MAP 4

Road No. Co 2853
Name SAFFRON DRIVE
Sheet No. 1 OF 1
Date 6-4-68
County PRINCE GEO.

Co DOLPHIN	010	2851 ROAD	
4 H	002	4 H	26'I JC-C
Co WOODSIDE	000	2850 DRIVE	

Form 6 HPS (Rev. 1961) Map 4

2-209

ROAD INVENTORY SHEET

Party Chief E.S.
Recorder W.D
Chainman F.S.

Road No. CO. 2854
Name ELLERBIE CT.
Sheet No. 1 OF 1
Date 6-13-68
County PRINCE GEO

VER 3-30-78

844 411 m 31

H

CUL-DE 2 H 0 05

SAC 4 H

0 01

26' I C-C

CO 2874

ELLERBIE 0 00 ST

Form 6 HPS (Rev. 1961) Map 4 1-232

ROAD INVENTORY SHEET

Party Chief E.S.
Recorder E.S.
Chainman

843-419 M31

Road No. CO 2855
Name PRESLEY PLACE
Sheet No. 1 OF 1
Date 6-4-68
County PRINCE GEO

VER 3-28-78

CO PRESLEY	012	1180 RD	
	010	3 H	
6 H	007		
	004	CO 2865 LYLE ST	
	003		
	001	H	26 I J C.C.
CO ST ANNE'S	000	2863 AVE X	

Form 6 HPS (Rev. 1961) Map 4 2-367

ROAD INVENTORY SHEET

Party Chief E.S.
Recorder W.D.
Chainman F.S.

SEABROOK
844-411 M31
Ver 3-30-78

Road No. Co 2856
Name KIMBARK AVE
Sheet No. 1 OF 1
Date 6-13-68
County PRINCE GEO

		CO 2412		
		BARKER	027	PL
			025	
	PT 45°		017	9 H
	PC		015	
			CO. 2858	
			013	CALANDA ST
17 H			009	H
			007	PT
			CO 2413	
			006	BANDERA ST
				50°
			005	
			003	PC 4 H
			001	
				26' I
		~~OF~~ CO	4168 ~~3225~~	J C-C
		ELLERBIE	000	ST

Form 6 HPS (Rev. 1961) Map 4 1-497

ROAD INVENTORY SHEET

Party Chief ES
Recorder F.S
Chainman

Road No. CO 2857
Name ELDRED PLACE
Sheet No. 1 OF 1
Date 6-4-68
County PRINCE GEO

843-419 m31

VER 3-28-78

CO / ST ANNE'S 0 12 2863 / AVE

0 09

5 H

6 H

0 03

0 01

26'I
C-C

CO / PRESLEY 000 1180 / ROAD

Form 6 HPS (Rev. 1961) Map 4 2-507

ROAD INVENTORY SHEET

Party Chief E.S
Recorder W.D.
Chainman F.J.

SEABROOK

VER 3-30-78 844-411 M31

Road No. CO 2858
Name CALANDA ST.
Sheet No. 1 OF 1
Date 6-13-68
County PRINCE GEO

CO 2412
BARKER 0 16 AL
0 13
8 H 0 06 PT 11 H
0 04 30°
0 02 PC 26' I
C-C
CO 2856
KIMBARK 0 00 AVE

Form 6 HPS (Rev. 1961) Map 4 1-568

ROAD INVENTORY SHEET

Party Chief E.S.
Recorder F.S.
Chainman

Road No. Co2859
Name NORDIC DRIVE
Sheet No. 1 OF 1
Date 6-4-68
County PRINCE GEO

844-419 m31

VER. 3-28-78

X X X Co 97TH	0 17	2861 AVE	↑
	0 13	H	
	0 11	Co 2860 96TH PLACE	
7 H	0 08	H	
	0 05	Co 1072 96TH AVE	
	0 03	H	
	0 01	H	26 I. ✓C-C
CU PRESLEY	0 00	1180 ROAD	↓

Form 6 HPS (Rev. 1961) Map 4 1-569

ROAD INVENTORY SHEET

Party Chief E.S
Recorder F.S.
Chainman

69-76

VER 3-28-78

844-419 M31

Road No. CO 2860
Name 96TH PIKE
Sheet No. 1 OF 1
Date 6-4-68
County PRINCE GEO

CO ~~OR~~ MAZZONI	016	~~533~~ 3094 AVE	
	015		
10H	003	9H	
	001		26'I Jc.c
CO NORDIC	000	2859 DRIVE	

Form 6 HPS (Rev. 1961) Map 4

1-5-92

98-85C
11-13-98
SS 15R

85-1 DB/ML 3-24-86 A/T

ROAD INVENTORY SHEET

Party Chief E.S
Recorder F.S
Chainman

T.L REV
F.R. 2/15/79

844-419 MFILD
VOR 3-28-78

Road No. Co 2861
Name 97TH AVE
Sheet No. 1 of 1
Date 6-4-68
County PRINCE GEO

		ELVIS LA.	
	029	CO. 3949	24ML 25'I
	028	H	30' CW
H	026		
CO 2859			
NORDIC DRIVE	023		
	021		
10H			
	006		
CO 3094			
~~OP 533~~			
MAZZONI AVE	004		24ML 21'I ~~CA~~ ICB RT √CB LT
H	002		
Co		42	
~~GOODLUCK TELEGRAPH~~	000	LUCK RD	

Form 6 HPS (Rev. 1961) Map 4 1-379

ROAD INVENTORY SHEET

Party Chief E S
Recorder E S
Chairman

Road No. Co 2862
Name ST ANNE'S COURT
Sheet No. 1 OF 1
Date 6-4-68
County PRINCE GEO

VER 3-28-78 844-418 M31

CUL-DE SAC

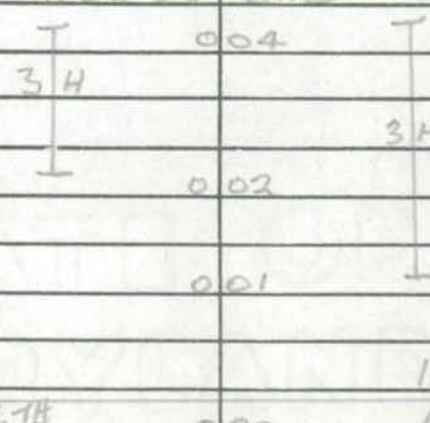

26' I
Co

Co
9618

1072
AVE

Form 6 HPS (Rev. 1961)

Map 4

1-570

98-82
11-13-98
SS/SR
98-10 CO

ROAD INVENTORY SHEET

Party Chief E.S.
Recorder F.S.
Chainman

Road No. CO 2863
Name ST ANNES AVE
Sheet No. 1 OF 1
Date 6-4-68
County PRINCE GEO

69-72

VER 3-28-78

843-419 M31

		D E		
	CUL	0 37 SAC		
		0 26	PT 35° PC	24'I J-C-C 2UML
		0 20		
	ROAD	EDIT		
		0 19		
CO 2855 PRESLEY PLACE		0 18		
	H	0 16		
	H	0 14		
CO 2857 ELDRED PLACE		0 12	11 H	
	H	0 08		
CO 2864 JONES PLACE		0 06		
	H	0 03		
	H	0 01		26'I JCC 2UML
CO ORBIT		000 2005 LANE		SS

Form 6 HPS (Rev. 1961) Map 4 1-5-71 ✓

ROAD INVENTORY SHEET

Party Chief ES.
Recorder ES.
Chainman

Road No. Co 2864
Name JONES PLACE
Sheet No. 1 OF 1
Date 6-4-68
County PRINCE GEO

VER 3-28-78 843-419 M31

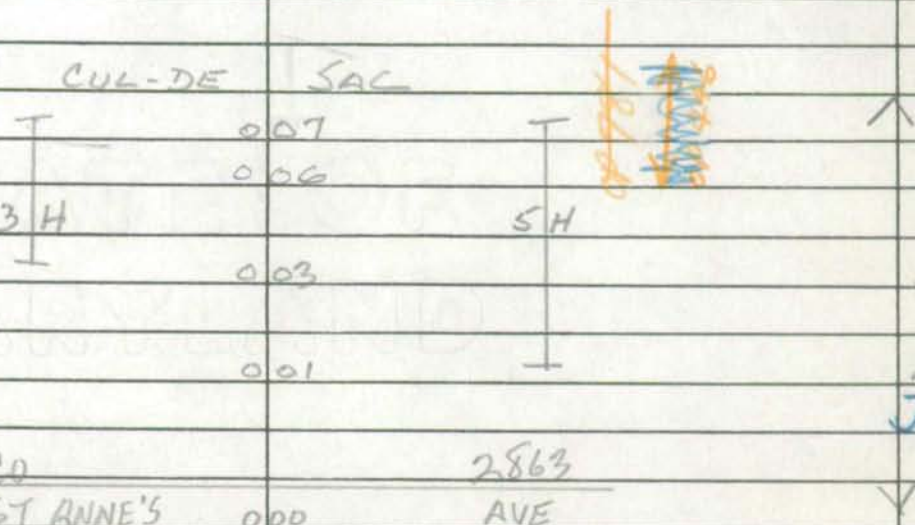

Form 6 HPS (Rev. 1961) Map 4 1-536

ROAD INVENTORY SHEET

Party Chief ES
Recorder F.S.
Chainman

REVISED 3-19-70

69-73
VER 3-28-78

843-419 M31

Road No. CO 2855
Name LYLE ST
Sheet No. 1 OF 1
Date 6-4-68
County PRINCE GEO

H
D E
0 16
0 10
0 03
0 01
0 00

CUL
9 H
CO
PRESLEY

SAC
11 H
30'
2855
PLACE

26'-7"-CU
64'-13"

26 I
C-C

Form 6 HPS (Rev. 1961)

ROAD INVENTORY SHEET

Party Chief ES.
Recorder FS.
Chainman W.D

Road No. CO 2811
Name 93RD PLACE
Sheet No. 1 OF 1
Date 6-10-68
County PRINCE GEO

Duplicate of 0043

Reassign in 1978

T CUL-DE 005 SAC T

4 H 4 H

002

CO 44
4TH STREET

26.I
C-C

Form 6 HPS (Rev. 1961) Map 4 2-166

ROAD INVENTORY SHEET

VER 12-28-77

Party Chief E.S.
Recorder F.S.
Chainman

Road No. Co 2867
Name MERNA LANE
Sheet No. 1 OF 1
Date 6-7-68
County PRINCE GEO

841-416 m31

Co 2408
BRIGHTLEA 014 DRIVE

012
8 H 9 H
001

26'I.
JCC

Co 2654
1ST 000 STREET

Form 6 HPS (Rev. 1961) Map 4 2-165 ✓

ROAD INVENTORY SHEET

VER 12-28-77

Party Chief E.S.
Recorder F.S.
Chainman

841-416 M31

Road No. Co 2868
Name CHESWOLD PLACE
Sheet No. 1 of 1
Date 6-7-68
County PRINCE GEO

CUL-DE-SAC

0 0 6

4 H 0 0 3 4 H 45°

0 0 1 26'I

J c-c

Co 2408

BRIGHTLEA 0 0 0 DRIVE

Form 6 HPS (Rev. 1961) Map 4

2-334

ROAD INVENTORY SHEET

VER 12-29-77

Party Chief ES
Recorder FS.
Chainman WD

Road No. Co 2869
Name OGDEN PLACE
Sheet No. 1 OF 1
Date 6-10-68
County PRINCE GEO

843-415 M31

Co SHERIDAN	0	15	989 ST		
T 7H	0	10	T 9H	P.T P.C. 50°	
	0	09			20'I 2-5 ESHB
	0	01			
Co 93RD	0	00	1517 AVE		

Form 6 HPS (Rev. 1961) Map 4

2-168
85-23
3-5-90
BB/DB

ROAD INVENTORY SHEET

Party Chief E.S.
Recorder W.D.
Chainman F.S.

REVISED
3-30-70
T. LANDON
W. WARFIELD

SEABROOK

846-414 M 31 69-96

VER 3-27-78

Road No. CO 2870
Name EMACK AVE
Sheet No. 1 OF 1
Date 2-11-68
County PRINCE GEO.

		XX	XX	
ROAD	0	25	END	
LINWOOD CO	0	16	~~LINWOOD~~ AVE ~~CO~~ 3114	26'I JC-LT
	0	14	H	
			OAKWOOD AVE	
	0	11	CO 3115	
	0	09		
H	0	08	H	
BEECHWOOD CO	0	07	AVE 3116	26'I C-C 69-96
H	0	05	H	
H	0	04		
~~X~~ CO ~~X~~ WOODLAND	0	02	3284 ~~70R~~ AVE	55 26'I C-C
ROAD	0	00	END	

Form 6 HPS (Rev. 1961) Map 4 2-226

ROAD INVENTORY SHEET

Party Chief F.S.
Recorder W.D.
Chainman F.S.

Road No. CO 2871
Name SHEPHERD LANE
Sheet No. 1 OF 1
Date 6-11-68
County PRINCE GEO

VER 3-27-78 847-415 M32

	H		
ROAD	0	26 END	^
	0	25	
5 H			5 H
	0	17	
CO		2880	
WALNUT	0	16 AVE	
	0	14	
7 H			
	0	05	8 H
	0	02	26' I
			JC-C
CO		947	
FRANKLIN	0	00 AVE.	v

Form 6 HPS (Rev. 1961)

MAP 7 Greater Upper Marlboro Sm. urban 5-234

ROAD INVENTORY SHEET

Party Chief E. SCHUYLER
Recorder W. DOMARSKI
Chainman

VER 7-20-77
868-374 M36

Road No. Co 2872
Name RUTHERFORD RD
Sheet No. 1 OF 1
Date 1 — 22 — 68
County PRINCE GEORGES

ROAD	0	25	END	N
			H	
H	0	18		
	0	15	H	
Co 2878				
GADSEN RD	0	12		
H	0	10	H	
			Co 2873	
	0	07	MEDWICK RD	
				24 I
CO			1955	2-3 ESHO
TOWN FARM	0	00	ROAD	Y

Form 6 HPS (Rev. 1961)

MAP 7 Greater upper Marlboro Sm. Urban 5-163

ROAD INVENTORY SHEET

Party Chief E. SCHUYLER
Recorder W. DeMAROSKI
Chainman

VER 7-20-77
868-374 m36

Road No. Co 2873
Name MEDWICK RD
Sheet No. 1 OF 1
Date 7 - 23 - 68
County PRINCE GEORGES

ROAD	0.34	END	
PT	0.33		
90°			
PC	0.28		
CO 2877			
MEDWICK CT	0.27	H	
	0.23	H	
	0.20	H	
	0.19	90°T	
H	0.14		
H	0.10		
H	0.01		
			24 I
CO		2872	2.3 E SH
RUTHERFORD	0.00	RD	

Form 6 HPS (Rev. 1961) Map 4 2-209A

ROAD INVENTORY SHEET

Party Chief E.S.
Recorder W.D.
Chairman E.S.

Road No. Co. 2874
Name ELLERBIE ST
Sheet No. 1 OF 1
Date 6-13-68
County PRINCE GEO

VER 3-30-78 845-412 m31

		CO	2412	
		BARKER	0 27 PC	
			0 25	
			0 22 9 H	
		2 H		
			0 20	
		PT	0 19	
		CO 2854		
		ELLERBIE CT	0 18	
		450		
		PC	0 15	
		CO	2847	
		WYATT	0 13 DR	
		H	0 11 H	
		CO	1983	
		FONTANA	0 08 DR	
		H	0 05 H	
		H	0 04 H	
		H	0 03 H	36' I JC-C
		MD	0 00 450	

Form 6 HPS (Rev. 1961) Map 4 2-338

ROAD INVENTORY SHEET

Party Chief E.S.
Recorder W.D
Chainman

Road No. CO 2875
Name SAUNDERS LANE
Sheet No. 1 OF 1
Date 6-14-68
County PRINCE GEO

VER 3-31-78 839-409 M31

CO		2876	
RUXTON	0 12	DR.	↑
			26'I
	0 11		VC·C
	0 10		X
H	0 08	5 H	
	0 01		20'I
			2-4'E SHD
CO		386	30'CW
LANHAM STA.	0 00	ROAD	V

Form 6 HPS (Rev. 1961) Map 4 2-339

ROAD INVENTORY SHEET

Party Chief E.S.
Recorder W.D.
Chainman

Road No. CO. 2876
Name RUXTON DRIVE
Sheet No. 1 OF 1
Date 6-14-68
County PRINCE GEO

VER 3-31-78 839-408 M31

XXX

ROAD 0 25 END

9 H 0 22 85°↑

0 11

CO 2875 18 H

SAUNDERS LA 0 09

0 03 85°↑

2 H

26' T
C-C

0 01

ROAD 0 00 END

Form 6 HPS (Rev. 1961)

MAP 7 Greater Upper Marlboro Sm. Urban 5-162

ROAD INVENTORY SHEET

Party Chief E. SCHUYLER N of UPPER MARL.
Recorder W. DOMBROSKI
Chainman

VER 7-20-77
869-374 M36

Road No. Co 2877
Name MEDWICK CT
Sheet No. 1 OF 1
Date 7 — 23 — 68
County PRINCE GEORGES

CVL-DE 008 SAC H

H 004

001 H

24'I

CO 2873 2-3 ESO

MEDWICK 000 RD

Form 6 HPS (Rev. 1961)

MAP 7 Greater Upper Marlboro
FAU Sm. Urban 5-110

ROAD INVENTORY SHEET

Party Chief E. SCHUYLER
Recorder W. DOMBROSKI
Chainman

N. OF UPPER MARL.

VER
7-20-77
867-374 M36

Road No. Co 2878
Name GADSEN RD
Sheet No. 1 OF 1
Date 7 — 23 — 68
County PRINCE GEORGES

ROAD	0	27	END
	0	24	H
H	0	22	
	0	20	H
			Co 4110
	0	18	ROSE DR
	0	15	H
~~0T~~ ~~495~~ CO 3164			
MARY ANN DR.	0	14	
H	0	11	H
PT	0	07	
Co 2879			
GADSEN CT	0	06	
45°			
PC	0	01	H
			24' I
CO		2878	2-3" ESH
RUTHERFORD	0	00	RD

Form 6 HPS (Rev. 1961)

MAP 7

FAU

Greater Upper Marlboro
Sm. Urban 5-110

ROAD INVENTORY SHEET

N. OF UPPER MARL.

Party Chief E. SCHUYLER
Recorder W. DOMBROSKI
Chainman

VER
7-20-77

867-374 M36

Road No. CO 2879
Name GADSEN CT
Sheet No. 1 OF 1
Date 7 — 23 — 68
County PRINCE GEORGES

CUL - DE	0 14 SAC	
H	0 09	
	0 06 H	
		24' I
CO	2878	2-3 ESHS
GADSEN	RD	

Form 6 HPS (Rev. 1961)

MAP 4

3-987

FAU

ROAD INVENTORY SHEET

Party Chief T. LANDON
Recorder W. WARFIELD
Helper

Road No. Co. 2880
Road Name WALNUT AVE.
Sheet No. 1 OF 1
Date 2-26-71
County PRINCE GEORGE

VER 3-27-78 70-71 847-415 M32

		X-	X-X		
		ROAD	016 END		^
		SHEPHERD	LA.		
		Co.	014 2871		
		JUSTINA	DR.		
		Co.	008 3112		
			006	H	10-7
	H		004	H	
					26'I
↑10°	H		003	H	"J"C-C
		LUNDY	DR.		
		~~70~~-70	000 70-70	3385	V

Form 6 HPS (Rev. 1961)

ROAD INVENTORY SHEET

Road No. _____
Road Name _____
Sheet No. _____
Date _____
County _____

Form 6 HPS (Rev. 1961) Map 4 2-291-B 78

ROAD INVENTORY SHEET

Party Chief E.S
Recorder F.S
Chainman

Road No. Co 2881
Name JEFFERSON STREET
Sheet No. 1 OF 1
Date 6-17-68
County PRINCE GEO

RR 4-3-78 841-404 m31

EBENEZER LA.

~~ROAD~~ 0 17 CO. ~~END~~ 3956

0 16 H

0 14

0 11 H

8 H

0 08 H

0 03 H

N

H 0 01 26 I

Jc-c

~~1990~~ 3711

CO

FAIRVIEW 0 00 AVE

Form 6 HPS (Rev. 1961)

Map 4

2-090-L

ROAD INVENTORY SHEET

98 Co Ex #6
GD/EF 2/23/99 A/T

Party Chief E. S.
Recorder W. D.
Chainman

ARDMORE

Road No. Co 2882
Name AMADOR DR
Sheet No. 1 OF 1
Date 1-16-69
County PRINCE GEO

VER 4-3-78 840-401 M31

Form 6 HPS (Rev. 1961) MAP 4 2-328 78

ROAD INVENTORY SHEET

Party Chief E.S.
Recorder W.D
Chainman

DODGE PK

Road No. Co 2883
Name REICHER ST
Sheet No. 1 OF 1
Date 1-16-69
County PRINCE GEO

VPR 4-3-78 840-398 M31

REC. X-Y	AREA -Y	
ROAD	041 END	
	Co 2885	
	038 GIRARD ST	
	037 H	
	034 H	
	Co 2884	
	033 HAMLIN ST	
	030	
PT 85° PC	023	
28 H	021	
	12 H	
	011	
PT	007	
	Co 1346	
	006 KELNER DR	
35°		
	002 H	
PC	001	26 I
Co	~~76~~	JC-C
BRIGHTSEAT	000 RD	

Form 6 HPS (Rev. 1961)

MAPH

2-327

ROAD INVENTORY SHEET

Party Chief E.S.
Recorder W.D.
Chainman

DODGE PK

VER 4-3-78

840-397 M31

Road No. CO 2884
Name HAMLIN ST
Sheet No. 1 OF 1
Date 1-16-69
County PRINCE GEO

HAMLIN ST
(MUN) 1.55
QUEEN FREDDEN

BRIGHT SEAT
CO
0 21
RD
X 76
0 18
30°
0 17
7 H
0 10
10 H
CO 1346
0 06
KELNER DR
0 01 H
26' I
K-C
CO
REICHER
0 00
2883
ST

Form 6 HPS (Rev. 1961) MAP-4

2-326

ROAD INVENTORY SHEET

Party Chief E.S.
Recorder W.D.
Chainman

DODGE PK

Road No. Co 2885
Name GIRARD ST
Sheet No. 1 OF 1
Date 1-16-69
County PRINCE GEO

VER 4-3-78 840-397 M31

Form 6 HPS (Rev. 1961) Map-7 2-072

ROAD INVENTORY SHEET Dutch Village Dr 78

Party Chief E.S.
Recorder F.S.
Chainman

Road No. Co 2886
Name ~~80th Ave~~
Sheet No. 1 of 1
Date 4-18-78
County Prince Geo

Ver 4-27-78 835-393 m31

Co
SHERIFF

0.38

75
ROAD

0.37

60 APTS UNITS

64 APT UNITS

0.09

CO
BARLOWE

0.07

1483
ROAD

0.06

30 APTS UNITS

28 APTS UNITS

0.01

36'I
JC.C

~~A 02887~~ OP 483

0.00 ~~79th Ave~~
VILLAGE GREEN DR

Form 6 HPS (Rev. 1961) Map G 3-521 ✓ 78

ROAD INVENTORY SHEET (1501) Meadowview

Party Chief E.S.
Recorder W.D.
Chainman

PARKLAND TERR
822-363 M35
UNASSIGNED

Road No. CO 2887
Name WALNUT LA
Sheet No. 1 OF 1
Date 1-23-69
County PRINCE GEO

DUPLICATION OF CO 1038

ROAD	022	END	↑
H	021		
H	019		
CO 1501			
~~STONE CLIFF~~ Walnut	018		
H	017		
H	013		
ENT TO APTS	011		10' F
			23'E SHO
	010		X
90°	002		
			24' E
			24' CW
SOUTLAND	000	PKWY	✓

Form 6 HPS (Rev. 1961) Map 4 1-498

ROAD INVENTORY SHEET

Party Chief E.S.
Recorder W.D
Chainman

Road No. Co 2888
Name AUGUSTA DRIVE
Sheet No. 1 OF 1
Date 7/1/68
County PRINCE GEO

VER 6-7-78

858.420 M32

H

COL - DE H 0 22 T SAC

0 20 90

0 18
4 H
0 19

CO 2889

GREENWOOD DR. 0 10 12 H

0 07
5 H
0 01

26' I
JC-C

CO 41

~~HILLMEADE~~ 0 00 ~~ROAD~~

~~Springfield~~ ~~Rd~~

HILLMEADE RD

Form 6 HPS (Rev. 1961) MAP 4 1-499 78

ROAD INVENTORY SHEET

Party Chief E.S.
Recorder W.D.
Chainman

VER 6-7-78

858-419 M32

Road No. CO 2889
Name GREENWOOD DR.
Sheet No. 1 OF 1
Date 7/1/68
County PRINCE GEO

CO GLENWOOD	023	2893 CT.	
	021		
	020		T T 98 P.C
11 H	016	11 H	
	008		
		CO 2890	
	005	FAIRWAY ST	
	003	H	
	001	H	26' I
CO AUGUSTA	000	2888 DRIVE	JC-C

Form 6 HPS (Rev. 1961)

MAP 4 1-339

ROAD INVENTORY SHEET

Party Chief E.S.
Recorder W.D
Chainman

Road No. CO 2890
Name FAIRWAY CT
Sheet No. 1 OF 1
Date 7/1/68
County PRINCE GEO

VER 6-7-78

858-419 M32

COL-DE		0 15	SAC	
		0 12	PT	
	5 H		95	
		0 08	P.C.	
		0 07		
			8 H	
CO 2891				
PINEVALLEY DR		0 05		
		0 04		
	3 H			
		0 01		26' I
CO			2889	JC-C
GREENWOOD		0 00	DR	

Form 6 HPS (Rev. 1961)

MAP 4

1-340

ROAD INVENTORY SHEET

Party Chief E.S.
Recorder W.D.
Chainman

VER 6-7-78

858-419 M32

Road No. CO 2891
Name PINE VALLEY DR
Sheet No. 1 OF 1
Date 7/1/68
County PRINCE GEO

ROAD	0	14	END
	0	13	H
		CO	2892
	0	10	GREEN CT
6 H			
	0	07	
		3 H	
	0	03	
			86 I
CO		2890	JC-C
FAIRWAY	0	50	CT

Form 6 HPS (Rev. 1961)

MAP 4

1-341

ROAD INVENTORY SHEET

Party Chief E.S.
Recorder W.D.
Chainman

Road No. CO 2092
Name GREEN CT
Sheet No. 1 OF 1
Date 7-1-68
County PRINCE GEO

VER 6-7-78 858-419 M 32

H

CUL-DE 0 09 SAC

4 H

4 H

0 52

26' I

CO 2891 C-C

PINE VALLEY 0 00 DR

Form 6 HPS (Rev. 1961)

MAP 4 1-496

ROAD INVENTORY SHEET

Party Chief E.S.
Recorder W.D.
Chainman

Road No. Co 2893
Name GLENWOOD CT
Sheet No. 1 OF 1
Date 7-1-68
County PRINCE GEO

VER 6-7-78

859-419 M32

CUL-DE H SAC

0 16

7 H

0 07

CO 2589

GREENWOOD DR 0 06 11 H

H 0 03

H 0 01

CO 2891

NORTHBROOK 0 00 DR

86' I

JC-C

Form 6 HPS (Rev. 1961)

MAP 4 1-495

ROAD INVENTORY SHEET

Party Chief E.S.
Recorder W.D.
Chainman

Road No. Co 2894
Name NORTHBROOK DR
Sheet No. 1 OF 1
Date 7-1-68
County PRINCE GEO

Ver 6-7-78

859-419 M32

ROAD	0	08 END	26'I JC-C
		CO 2893	
	0	06 GLENWOOD CT	X
	0	04 H	
	0	02 H	
			36'I
CO		41	JC-C
HILLMEADE	0	00 ROAD	Y

Form 6 HPS (Rev. 1961) Map 4 1-394 98-30 11-13-98 SS/SR

ROAD INVENTORY SHEET

Party Chief E.S.
Recorder W.D.
Chainman

Road No. Co 2895
Name EPLING RD
Sheet No. 1 OF 1
Date 7-2-68
County PRINCE GEO

VER 6-9-98 852-422 m32

		PRIVATE DR AHEAD	
ROAD	0	09 H END	N
H	0	08 H	
H	0	06	24 ML 26' I
	0	01 H	
CO		1869	R-3 E SHO
POTOMAC	0	00 ST	Y

Form 6 HPS (Rev. 1961)

Map 4

1-428

ROAD INVENTORY SHEET

Party Chief E.S.
Recorder W.D.
Chainman

Road No. Co 2896
Name EDGE PLACE
Sheet No. 1 OF 1
Date 7-3-68
County PRINCE GEO

VER 6-9-78

853-416 M32

NW

ROAD 003 H END

CO 1825

DUBARRY 000 ~~AVE~~ ST

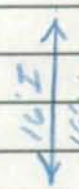

~~72-241~~
~~14'F~~
~~24'E~~ HD
21'I
24'CW

Form 6 HPS (Rev. 1961)

Map 4

1-262-B

FAIL

LBS-4(6) B3/AL 3-17-86

ROAD INVENTORY SHEET

Party Chief E.S.
Recorder W.D.
Chainman

AT 3/18/83 J.E. N.S. 82-29

REV DD DD 3-4-80 79-17

VER 6.1 -78

851-416 FIZ

Road No. Co 2897
Name HILAND AVE
Sheet No. 1 OF 1
Date 7/3/68
County PRINCE GEO

		D	15
CUL		0	19 SAC
			18
~~Road~~		~~000~~	~~END~~
Co			1830
Marguerita		0	13 Ave
Co			~~4280~~ 1829 @.34
Locust		0	09 St 79-18
ROAD		0	00 END
CO			1831
WORREL		0	04 AVE
		0	03 H
CO			1825
DUBARRY		0	00 ~~AVE~~ ST

S

ALTERNATE 64'-92'

86 I

J C-C

Form 6 HPS (Rev. 1961) Map 4 2-262-B

ROAD INVENTORY SHEET

Party Chief E.S.
Recorder W.D.
Chainman

Ver 6-9-78

Road No. Co 2598
Name HILAND AVE
Sheet No. 1 OF 1
Date 7-3-68
County PRINCE GEO

851-417 M32

CO DOLBY	0 04	1834 AVE
CO E. FRANKLIN	0 00	1833 AVE S.

SHA 51.3-8
11-15-72

STATE HIGHWAY ADMINISTRATION OF MARYLAND

URBAN

ROAD INVENTORY SHEET

85-59
BR/AL
3-13-86

Party Chief E.S.
Recorder W.D.
Helper

Map No. F12 GLENWOOD PK

Road No. Co. 2899
Road Name Cleary La.
Sheet No. 1 of 1
Date 1-20-69 Revised 3-3-75
County PR. GEO.
State Coordinates 849 - 404

Ver. 6-1-78

DE

COL 0 76 SAC

30° 0 67

BALDHILL TERR.
0 63 CO. (4713)

WOODBINE ST
CO. 4712 (3) 0 60

CLEARY CT
0 56 CO 4711

XXXX
CARIBON ~~X~~ ST
0 50 CO. 4710

0 48 H

3 H

0 42

10° H 0 36

H 0 34 H 10°

0 27 24'I
30'CW

7 H 0 19 3 H

0 12

H 0 ROMSEY DR
08 CO. 886

20'I

20° H 0 06 H 2-3'E SH
30'CW

LOTTSFORD - VISTA
CO 67 0 00 RD ~~67~~ 950

SHA 51.3-8
11-15-72

ROAD INVENTORY SHEET

Road No. _____
Road Name _____
Sheet No. _____
Date _____
County _____
State Coordinates _____

SHA 51.3-8
11-15-72

STATE HIGHWAY ADMINISTRATION OF MARYLAND

ROAD INVENTORY SHEET

Party Chief J. LANDON
Recorder M. ZALENSKI
Helper

Map No. 32

VER 6-1-76
73-45

Road No. Co. 2900
Road Name PARRISH LA.
Sheet No. 1 OF 1
Date 2-11-74
County PR. GEO.
State Coordinates 850-401

INDEX 4

73-29 LA MICHAEL CO 3560

E

SAVILLE
73-28 Co 0 15 3559 LA.

25° 0 12

LOTTSFORD VISTA
Co. 0 00 RD 67

36'I
J'c-c

24'I
30'cw

SHA 51.3-8
11-15-72

ROAD INVENTORY SHEET

Road No. _____
Road Name _____
Sheet No. _____
Date _____
County _____
State Coordinates _____

Form 6 HPS (Rev. 1961) Map 4

89-34,35
3-1-90
BB/BB

Urban
1-060

ROAD INVENTORY SHEET

Party Chief E.S.
Recorder W.D.
Chainman

VER
6-9-78

Road No. Co 2901 A
Name DUVALL ST
Sheet No. 1 OF 1
Date 7-R-88
County PRINCE GEO

851-419 M32

LANHAM MD

Severn Rd. 564

0 24

18'I
30'CW
36 I Jct
2ML
36'I
JC-C

H P.T.
65°
P C

0 18
0 17
0 16
0 13
0 12 H
0 07 H
0 06
0 05 H

26'I
JC-RT
18'I
R-3'E SW

MD

0 00 953 A

Form 6 HPS (Rev. 1961)

5-033 V 18

ROAD INVENTORY SHEET

Brook wood Ave

Party Chief	E.S.
Recorder	W.D.
Chainman	T.L.

MAP 10 VER 7-19-77

BROOKEWOOD

850-339 M36 72-180

Road No.	C.O. 2902
Name	~~BROOKE WOOD~~ AVE
Sheet No.	1 OF 1
Date	9-17-68
County	PRINCE GEO

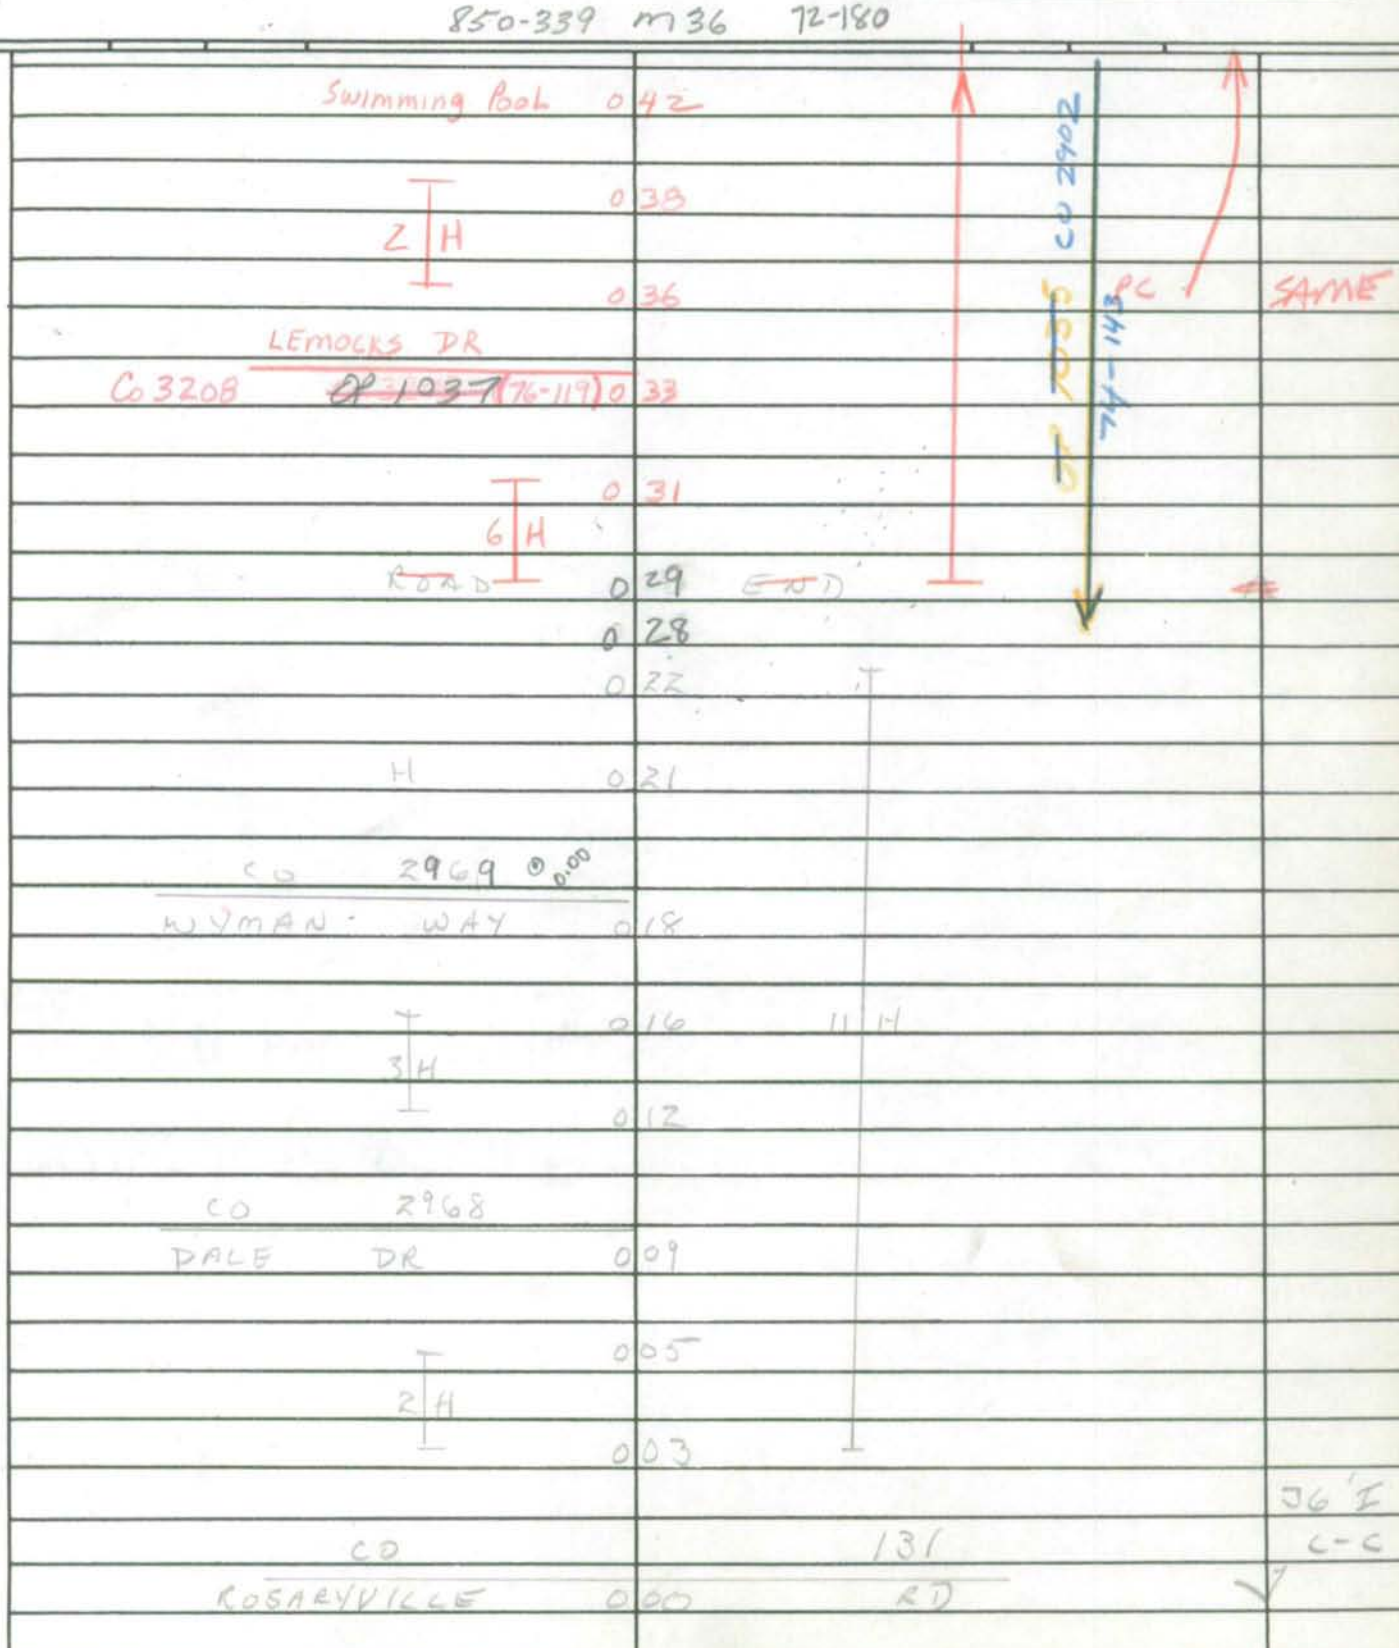

Form 6 HPS (Rev. 1961)

ROAD INVENTORY SHEET

Party Chief W. Dombroski
Recorder D. Taylor
Helper

Road No. Co. 2902
Road Name Brookwood Ave
Sheet No. 2 of 2
Date - -73
County Prince Georges

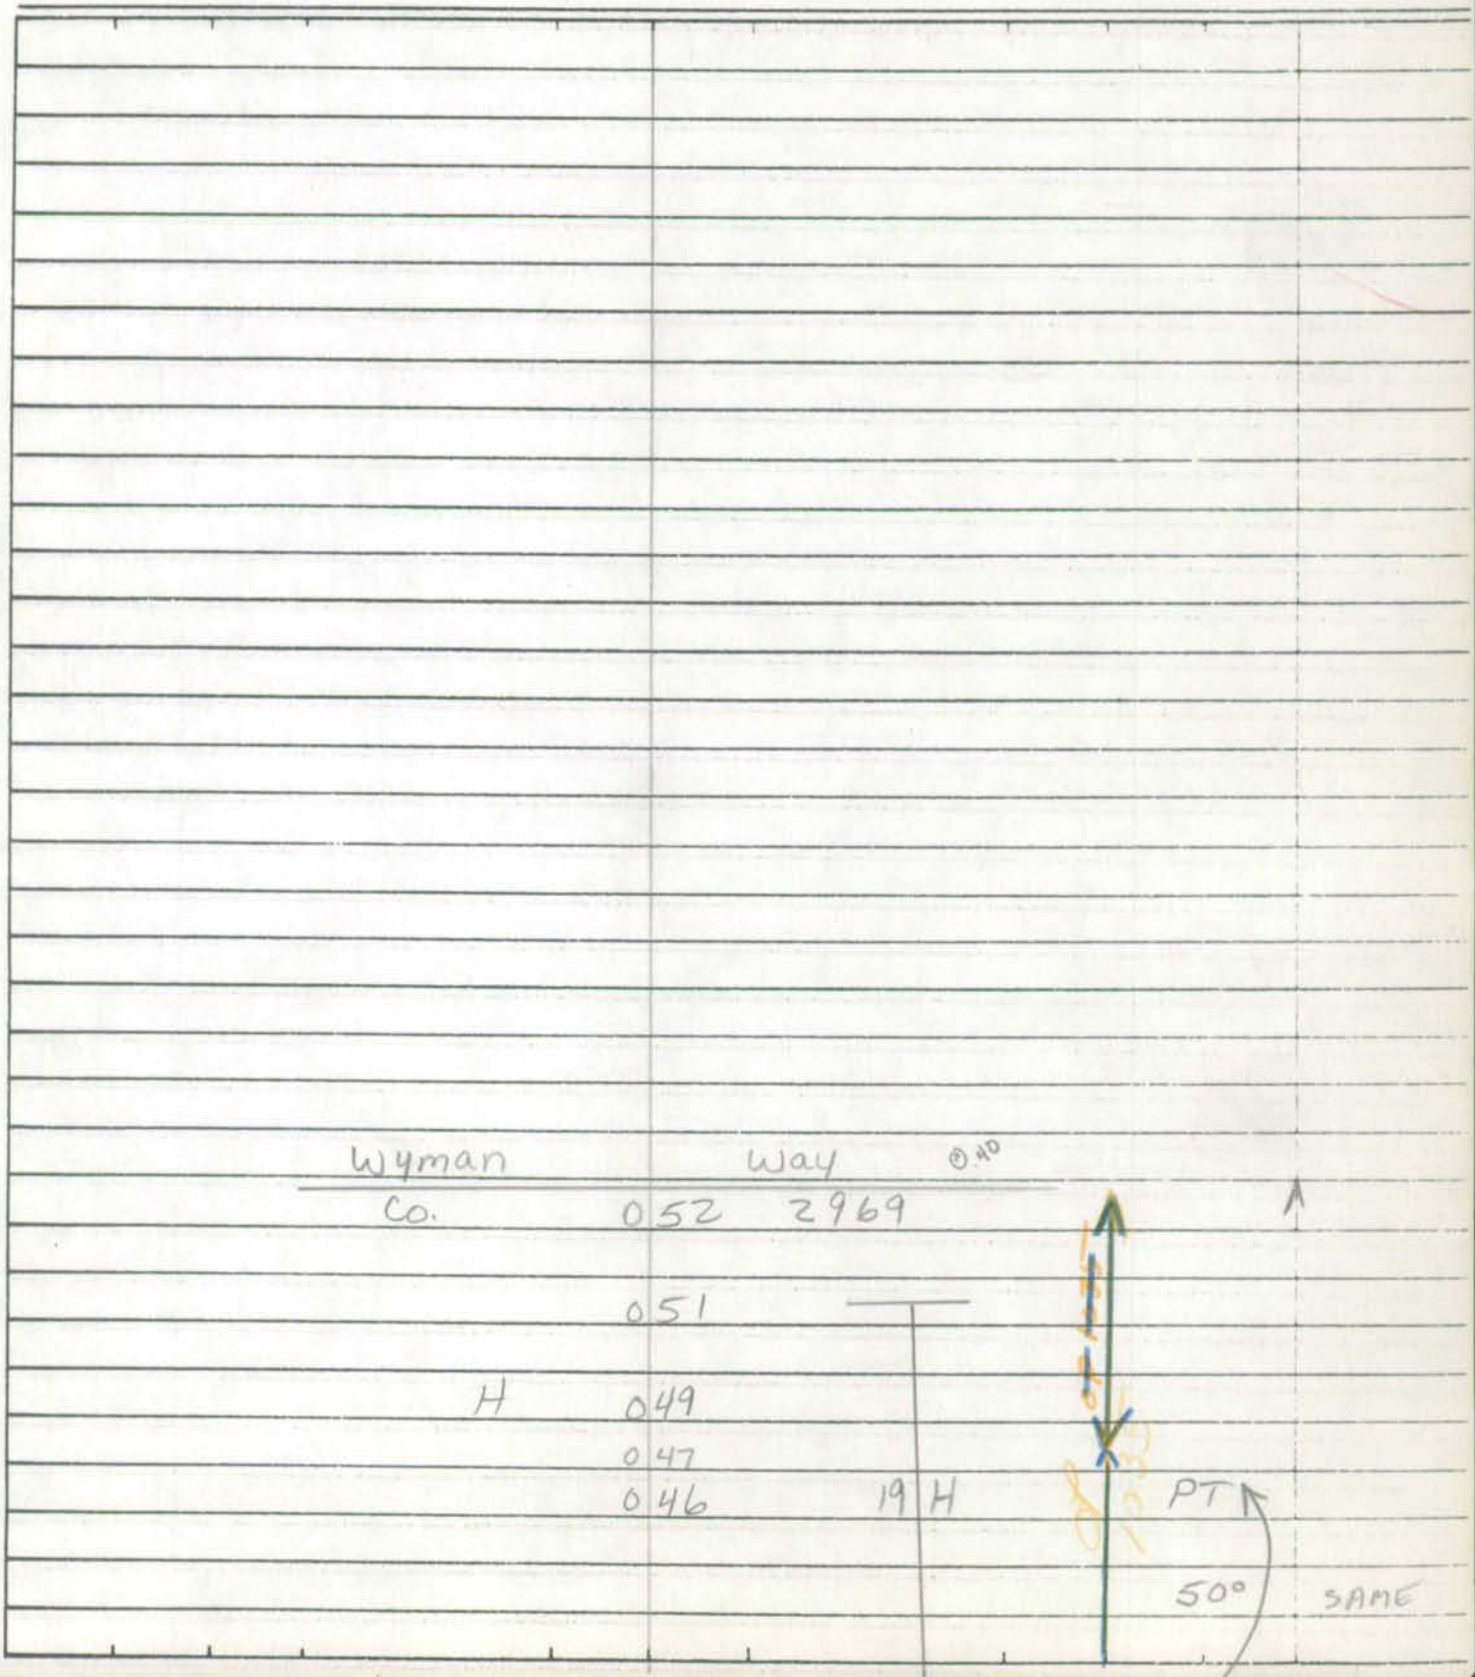

Form 6 HPS (Rev. 1961)

ROAD INVENTORY SHEET

Road No. _____
Road Name _____
Sheet No. _____
Date _____
County _____

Form 6 HPS (Rev. 1961)

RURAL 5-331 78

ROAD INVENTORY SHEET

Party Chief E.S.
Recorder W.D.
Chainman T.L.

80-85
12 MAR 81
J.E./D.G.

VER
7-19-77

~~MAP~~ 70-143
BROOKLEWOOD
851-338 M36

Road No. CO 2903
Name TYRONE DR
Sheet No. 1 OF 1
Date 9-17-68
County PRINCE GEO.

FRANK TIPPETT CO.	059	RD. 132	
GAY DR. CO. 4367	052		
~~RD~~	050	~~END~~	73-98
ROAD	040	END	
CO ~~OF~~ LEMASTERS	038	~~770~~ END DR 3208	
14 H	035	17 H	
	012		
CO DALE	009	2968 DR	
3 H	006	3 H	
	003		36 I
CO ROSARYVILLE	000	131 RD	

Form 6 HPS (Rev. 1961)

4-223-A

ROAD INVENTORY SHEET

OP ~~457~~

Party Chief E. S.
Recorder W. D.
Chainman

73-122

Potomac Landing

Road No. Co. 2904
Name Tantallon Drive E+W.
Sheet No. 2 of 2
Date 8-26-68
County Prince Georges

UNASSIGNED

NOW PART Co 2917

Road

0.87 End

71-163

0.85 H

ADD'D 71-163

I

Sewage Desposals 0.78 44' ~~X~~ C-C

44' CW

0.75 X

0.72

Co 290

0.71 Troon Circle

H

0.68

~~Co. 2698~~

0.66 Arrow Park Drive

0.64 H P.T. 40° P.C. old maint line

0.59

0.58 Golf Course SAME

Form 6 HPS (Rev. 1961) Map 9

ROAD INVENTORY SHEET

Party Chief E.S.
Recorder W.D.
Chairman

70-199
69-211

73-122

797-323 M39

Road No. Co. 2904
Name Tantallon Dr. E+W
Sheet No. 1 of 2
Date 8-26-68
County Prince Georges
Revised 3-30-71 in office by GJG

Co. Whitehaven	0 53	2905 Circle	
H	0 52		
↑30° UNASSIGNED	0 46		
Co. Surrey	0 41	2908 2917 Drive	
NOW PART	0 35		
	0 34	H	44'I C-C
Co. Ft. Washington	0 28	416 Road	X
PRESTWICK DR (72-169)			
~~Proposed~~ Co. 3515	0 25		
	0 22	PT 15° PC.	
	0 15		
	0 10	Co. 3315 LANGNER DRIVE	70-200
	0 07	H	
	0 03	Co 3316 Parkton St.	70-202
	0 02	H	52'I 3° C-C
Road	0 00	End	

Proposed

Form 6 HPS (Rev. 1961)

4-225 L 78

ROAD INVENTORY SHEET

BALESHORE CIR

Party Chief E.S.
Recorder W.D.
Chainman

797-323 M39

TANTALLON

VER 7-13-77 MAP 9

Road No. Co 2905
Name ~~WHITE HAVEN~~ CIR
Sheet No. 1 OF 1
Date 8-26-68
County PRINCE GEO

Form 6 HPS (Rev. 1961) Map 9 4-203

ROAD INVENTORY SHEET

Party Chief E.S.
Recorder W.D.
Chainman

TANTALCON + FORT WASH.

VER 7-13-77 798-324 M39

Road No. CO 2906
Name EMERALD HILL DR
Sheet No. 1 OF 1
Date 8-26-68
County PRINCE GEO

		H		
CUL-DE	016	SAC		A
H	015			
H	013			
CO 2908				
SORREY CIR DR	011	6	H	
H	008			
H	005			
		CO 2907		
	003	MIRA BAY CIR		
H	002	H		
				36 'E
CO		916		C-C
FORT WASH	000	CD		

Form 6 HPS (Rev. 1961) Map 9 4-204 V

ROAD INVENTORY SHEET

Party Chief E.S.
Recorder W.D.
Chainman

VER 7-13-77
FORT WASH
798-324 M39

Road No. CO 2907
Name MIRA BAY CIR
Sheet No. 1 OF 1
Date 8-26-68
County PRINCE GEO

Form 6 HPS (Rev. 1961)

4-202

ROAD INVENTORY SHEET

Party Chief E.S.
Recorder W.D.
Chainman

TANTALLON
FORT WASH. VED 7-13-77

798-322 M39 MAP 9

Road No. CO 2908
Name SURREY CIR. DR
Sheet No. 1 of 2
Date 8-26-68
County PRINCE GEO

		CO 2911	
	048	DELORAINE CIR	
H	047		
H	043	3 H	
	042		
		CO 2912	
	040	PEARL LIGHT CIR	
	038	H	
H	036		
80°	035	2917	36' I C-C
CO			
TANTALLON	033	DR	X
CO		2913	
0.34 INVERNESS	030	LA	
H 90°	024		
	017	90°	
0.00 CO 2913			
INVERNESS LA	011		
CO		2918	
ST. ANDREWS	005	DR	
	002		
H	001		36' I C-C
CO 832			
~~ANDREWS DR~~	000		
Surrey Circle Dr. South		CO 2908	

Form 6 HPS (Rev. 1961)

ROAD INVENTORY SHEET

Party Chief E.S.
Recorder W.D.
Chainman

TANTALLON
FORT WASH
VER
1-1

Road No. CO 2908
Name SURREY CIR DR
Sheet No. 2 OF 2
Date 8-26-68
County PRINCE GEO

CO EMERALD HILL	075	2906 DR
	074	H
H	072	H
↑ 35°	070	
CO 2909 RIVER FOREST LA	069	
H	067	
H	065	PT
		CO 2910
	064	ST ALBAN CIR
		45°
	060	PC
	058	
	055	PT
		5 H 50°
	051	PC
	050	SAME

Form 6 HPS (Rev. 1961)

4-220

ROAD INVENTORY SHEET

Party Chief E.S.
Recorder W.D.
Chainman

798-324 M39

VER FORT WASH
7-13-77

MAP 9

Road No. CO 2909
Name RIVER FOREST LA
Sheet No. 1 OF 1
Date 8-26-68
County PRINCE GEO

	H		
CUL-DE	012	SAC	A
	011	H	
H	009	H	
H	008		
H	006		
	004	H	
H	002		
			26 I
CO		2908	C-C
SURREY CIR	000	DR	

Form 6 HPS (Rev. 1961)

4-219

ROAD INVENTORY SHEET

Party Chief E.S.
Recorder W.D.
Chainman

TANTALLON VBQ
FORT WASH 7-13-77

Road No. Co 2910
Name ST ALBAN CIR
Sheet No. 1 OF 1
Date 8-26-68
County PRINCE GEO

799-324 M39 MAP 9

	H		
CUL-DE	D	08 SAC H	A
H	D	07 H	
	D	05 H	
H	D	04	
			26 I
CO		2906	C-C
SURREY CIR	D	00 DR	Y

Form 6 HPS (Rev. 1961)

4-036 ✓

ROAD INVENTORY SHEET

Party Chief E.S.
Recorder W.D.
Chainman

M39
TANTALLON
+
FORT WASH
MAP 9

Road No. CO 2911
Name DELORAINE CIR
Sheet No. 1 OF 1
Date 8-26-68
County PRINCE GEO

S
↑

VER 3-13-79
799-324

CUL-DE	004	SAC	
	003	H	
			26' I
CO		2904	C-C
SURREY CIR	000	DR	✓

Form 6 HPS (Rev. 1961)

4-021

ROAD INVENTORY SHEET

Party Chief E.S.
Recorder W.D.
Chainman

TANTALLON
+
FORT WASH

VEO 7-13-77

Road No. Co 2912
Name PEARL LIGHT CIR
Sheet No. 1 OF 1
Date 8-24-68
County PRINCE GEO

798-323 M39 MAP 9

CUL-DE	0	09	SAC	
H	0	07		
H	0	05	H	
				26 I
CO		2908		C-C
SURREY CIR	1	00	DR	

Form 6 HPS (Rev. 1961)

4-221

ROAD INVENTORY SHEET

Party Chief E.S.
Recorder W.D.
Chainman

797-322 M39
TANTALLON
VER 7-13-77 MAP 9

Road No. Co 2913
Name INVERNESS LANE
Sheet No. 1 OF 1
Date 8-26-68
County PRINCE GEO

CUL-DE	0	35	SAC
	0	32	H
H	0	31	
CO			2905 @.30
SURREY CIR	0	26	DR
	0	24	H
↑90°	0	22	
	0	20	H
	0	17	H
PT	0	15	H
90°	0	12	H
PC	0	11	
H	0	08	
	0	05	H
	0	03	H
			26' I
CO			2908 @.11 C-C
SURREY CIR	0	00	DR

Form 6 HPS (Rev. 1961)

ROAD INVENTORY SHEET

Party Chief E.S.
Recorder W.D.
Chainman

797-321 M39
TANTALLON
+
FORT WASH.
68-140 MAP9

Road No. Co 291F
Name NORTHWOOD LA
Sheet No. 1 OF 1
Date 8-26-68
County PRINCE GEO

SURREY CIR DR. S	Co 291 SURREY CIR DR	
ANDRSN DR Co. 632 023		^
H 003	H	26 I
CO	2917	L-C
TANTALLON	DR	V

Form 6 HPS (Rev. 1961)

4-239 ✓

ROAD INVENTORY SHEET

Party Chief E.S.
Recorder W.D
Chainman

797-321
TANTALLON
+
FORT WASH. VEG
7-13-77

Road No. Co 2915
Name WILLOW WIND CIR
Sheet No. 1 OF 1
Date 6-26-68
County PRINCE GEO

M39

MAP 9

CUL-DE	004	SAC	^
			26' I
CO		2917	C-C
TANTALLON	000	DR	✓

Form 6 HPS (Rev. 1961)

4-240

ROAD INVENTORY SHEET

Party Chief E.S.
Recorder W.D.
Chainman

796-322 M39
FORT WASH
VER 7-13-77 MAP 9

Road No. CO 2916
Name LOST LAKE CIR
Sheet No. 1 OF 1
Date 8-26-68
County PRINCE GEO

CUL-DE	004 SAC	A
	001 H	26 I
CO	2917	C-C
TANTALLON	000 DR	Y

SHA 51.3-8
11-15-72

STATE HIGHWAY ADMINISTRATION OF MARYLAND

FAU

ROAD INVENTORY SHEET

Party Chief J. LANDON
Recorder M. ZALENSKI
Helper

Map No. 39

Road No. Co. 2917
Road Name TANTALLON DR.
Sheet No. 1 OF 4
Date 2-7-74
County PR. GEO
State Coordinates 794-320

NB LC 2-80 79-88

73-122

INDEX #9

↑30°	H	0	47 H	
	CARNOUSTIE LA. Co. 3395	0	45	
	H	0	44	
		0	41 H	
		0	38	45°↑
	@0.00 GLENEAGLES DR. Co. 3392	0	34	
PT	@0.56 GLENEAGLES DR Co. 3392	0	27	
80°		0	23 H	
PC		0	19 60" CP	
	4 H	0	LOST LAKE CIR 14 Co. 2916	25°↑
		0	WILLOW WIND CIR. 10 Co. 2915	
		0	06 NORTHWOOD	
		0	NORWOOD LA 04 Co. 2914	44' I
	FORT WASHINGTON Co.	0	RD 00 416 @2.72	√ c-c 2ML

N ↑

SHA 51.3-8
11-15-72

ROAD INVENTORY SHEET

Road No. Co 2917
Road Name TANTALLON DR.
Sheet No. 2 OF 4
Date 2-7-74
County PR. GEO.
State Coordinates

WHITEHAVEN CIR. Co. 4098	100	BALESHORE CIR Co. 2905
PT	98	
70°	96	H
PC H	90	
ARROW PARK DR Co. 2692	88	
	86	TARTAN DR. L.A. O.P. 1085 Co. 2680
H	85	
TROON CIR Co. 290	83	
	76	SEWAGE PUMPING STA.
	73	2-72" CMP 20°↑
(90-239) Monterey Co	66	MONTEREY CIR (73-123) ~~96~~ 3613
PT	62	
80°	56	H
PC	53	H
LOCH NESS CIR Co. 3394	51	
		same

SHA 51.3-8
11-15-72

STATE HIGHWAY ADMINISTRATION OF MARYLAND

18

ROAD INVENTORY SHEET

Party Chief I. LANDON
Recorder M. ZALENSKI
Helper

Map No. 39

Road No. Co. 2917
Road Name TANTALLON DR.
Sheet No. 3 OF 4
Date 2-7-74
County PR. GEO.
State Coordinates

H	154		
PARKTON ST Co. 3316	152		
H	148		
LANGNER DR Co. 3315	145		
4 H	142	PT	
	137	30°	
SCHOOL	133	PC	
	PRESTWICK DR.		
	130 Co. 3515		52' I
FORT WASHINGTON Co.	RD.		1'c-c
	126 416		X
	123 H		
H	118		
20°	114 SURREY Co.		
	CIRCLE DR		
	112 2908		
	107	35°	
	102 H		
			same

SHA 51.3-8
11-15-72

ROAD INVENTORY SHEET

Road No. Co. 2917
Road Name TANTALLON DR
Sheet No. 4 OF 4
Date 2-7-74
County PR. GEO.
State Coordinates

~~OF~~ CO Hampton	2	13	4297 ~~4240~~ lane		
Co 4247 Gable Ln	2	01	Lane		
Co 4250 Promise Dr	1	93			
	1	85	Co 4249 Lira Dr		
	1	80	BUCKMASTER LA. CO 3411		
	1	79	~~BARRICADE~~		
	1	78			
10 H	1	71	11 H	PT 20° PC	
	1	62			
	1	61	DR	CO 2917 TANTALLON DR 1231-141	
ASBURY PROP CO ~~3406~~	1	59	3614		
	1	57			
	1	55	15 H ~~END~~ ~~to~~ ~~PAINT~~		same

Form 6 HPS (Rev. 1961)

4-201

ROAD INVENTORY SHEET

Party Chief E.S.
Recorder W.D.
Chainman

797-322 M39

MAP 9 VER TANTALLON 1-13-77

Road No. Co 2918
Name ST. ANDREWS DR
Sheet No. 1 OF 1
Date 8-26-68
County PRINCE GEO

Form 6 HPS (Rev. 1961)

4-242

ROAD INVENTORY SHEET

Party Chief E.S.
Recorder W.D.
Chainman

797-322 M39

TANTALLON

VER 2-13-77

MAP 9

Road No. Co 2919
Name MC EWAN CIR
Sheet No. 1 OF 1
Date 8-26-68
County PRINCE GEO

CUL-DE	604 SAC	
		26' I
CO	2918	C-C
ST. ANDREWS	000 DR	

Form 6 HPS (Rev. 1961)

4-245

ROAD INVENTORY SHEET

Party Chief E.S.
Recorder W.D.
Chainman

MAP 9 VER 7-12-77
FT WASH FOREST
800-319 M39

H 11

Road No. CO 2920
Name HOLLY RD
Sheet No. 1 OF 1
Date 8-26-68
County PRINCE GEO

ROAD	016	END	
		CO 2921 HOLLY CIR	
	007		
CO		XXX 2924	20'I 2.3'E SHO
PISCATAWAY	000	DR	

NW

Form 6 HPS (Rev. 1961)

4-246

91-205
DT/JS
2-11-92

ROAD INVENTORY SHEET

Party Chief E.S.
Recorder W.D.
Chainman

VER
7-12-77
FT. WASH. FOREST
800-319 M39

MAP 9

Road No. CO 2921
Name HOLLY GTGIR
Sheet No. 1 OF 1
Date 8-26-68
County PRINCE GEO

ROAD 0047 END

CO
HOLLY
000 2920
RD

20'I

Form 6 HPS (Rev. 1961)

98-109
11-19-98
SS|SR|RB 4-247 78

ROAD INVENTORY SHEET

Party Chief E.S.
Recorder W.D.
Chainman

MAP 9 VER 1-12-77
FT. WASH FOREST
801-319 M39

Road No. Co 2922
Name KELLY ~~RD~~ RD
Sheet No. 1 OF 1
Date 8-26-68
County PRINCE GEO

ROAD	0 12	END
H	0 07	20' T
Co	~~0 55~~ 2924	~~23' TH~~
PISCATAWAY	0 00	DR 2UML

Form 6 HPS (Rev. 1961)

4-218

ROAD INVENTORY SHEET

CEDAR AVE ✓ 78

Party Chief E.S.
Recorder W.D.
Chainman

MAP 9 VGR 7-12-77
FT. WASH. FOREST
800-318 M39

Road No. CO 2923
Name ~~CEDAR RD~~
Sheet No. 1 OF 1
Date 8-26-68
County PRINCE GEO.

NAME CHANGE LETTER 7-18-68

ROAD	019	END	
	OOR	H	
			20' I
CO		~~RTE~~ 2924	2-3' E SHO
PISCATAWAY	000	DR	✓

NW ↑

SHA 51.3-8
11-15-72

STATE HIGHWAY ADMINISTRATION OF MARYLAND

FAU

ROAD INVENTORY SHEET

BB 84-114 AT
Rm 3-11-85

18
82-157 EXTRA
3/23/83
J. EVANS.

Party Chief R. Bush (OFFICE INV.)
Recorder
Helper

Road No. Co 2924
Road Name PISCATAWAY DR
Sheet No. 1 OF 2
Date 8-26-68 REVISED 6-17-74
County PR GEO
State Coordinates 802 - 320

Map No. M 39
INDEX 9 & 12

VER 7-12-77

		PISCATAWAY CT.	
	0 55	Co 3318	
		CEDAR ~~DR~~ AV.	
	0 48	Co 2923	
KELLY ~~DR~~ RD.			
Co 2922	0 45		
	0 39		30° ↗
		HOLLY Rd	
	0 38	Co 2920	
	0 35	DRAIN	
			20' I
			2-3' E
			SHLDS
	0 24		30' CW
30°			
S ↑			
CASCADE DR.	0 20		X 29' I
~~AT~~ CO 4626	0 18		J-CB LT
	0 14		8'E SHLD RT
	0 03		X 40' CW
50°			
			20' I
	0 01		2-3' E Shld
			30' CW
OLD FORT		Rd.	
Co	0 00	118	↓

WARGURTON LA 1055 CO

SHA 51.3-8
11-15-72

ROAD INVENTORY SHEET

Road No. Co 2924
Road Name
Sheet No. 2 of 2
Date
County
State Coordinates

Rd.	135 End	
65°	125	
	122	
30	111	20' I I CURB - Lt 3' E Shld Rt.
	099	30
35°	089	X
	087	
40°	083	
	080	
	Coldwater Dr	
90	Co 2925	
180°	069	
	Pine Rd	
	061 Co 3700	90
		NAME

Form 6 HPS (Rev. 1961)

87-169
BB/CG
2-4-88

2-451
Coldwater Dr

ROAD INVENTORY SHEET

Party Chief E.S.
Recorder W.D.
Chainman

MAP 12
VER 7-12-77
FT. WASH. FOREST
801-317 M39

72-201
REVISED
3-13-73

Road No. CO 2925
Name ~~COLD WATER DR~~
Sheet No. 1 OF 1
Date 8-26-68
County PRINCE GEO

0.00 COLFAX DR. CO 4520 053

COLFAX DR 052 PT 25° ↑ PC

047

036 PT 30° ↑ PC

027

0.35 COLFAX DR CO 4520 025

CARIBOIA CT. CO 4860 016

~~Rt XX XX End~~ 009

PENDLETON ST. ~~OR 4488~~ CO 008 72-202 ~~X~~ 3539

PENDLETON St 0.22

~~END~~ 005 ~~END~~

COLDWATER CT (72-200) Co. 3538 002

2924 OLD AWAY DR

(87-169)
36' I C-C
~~23' I~~
~~30' CW~~
23' I
30' CW
20' I
2-3E SHO

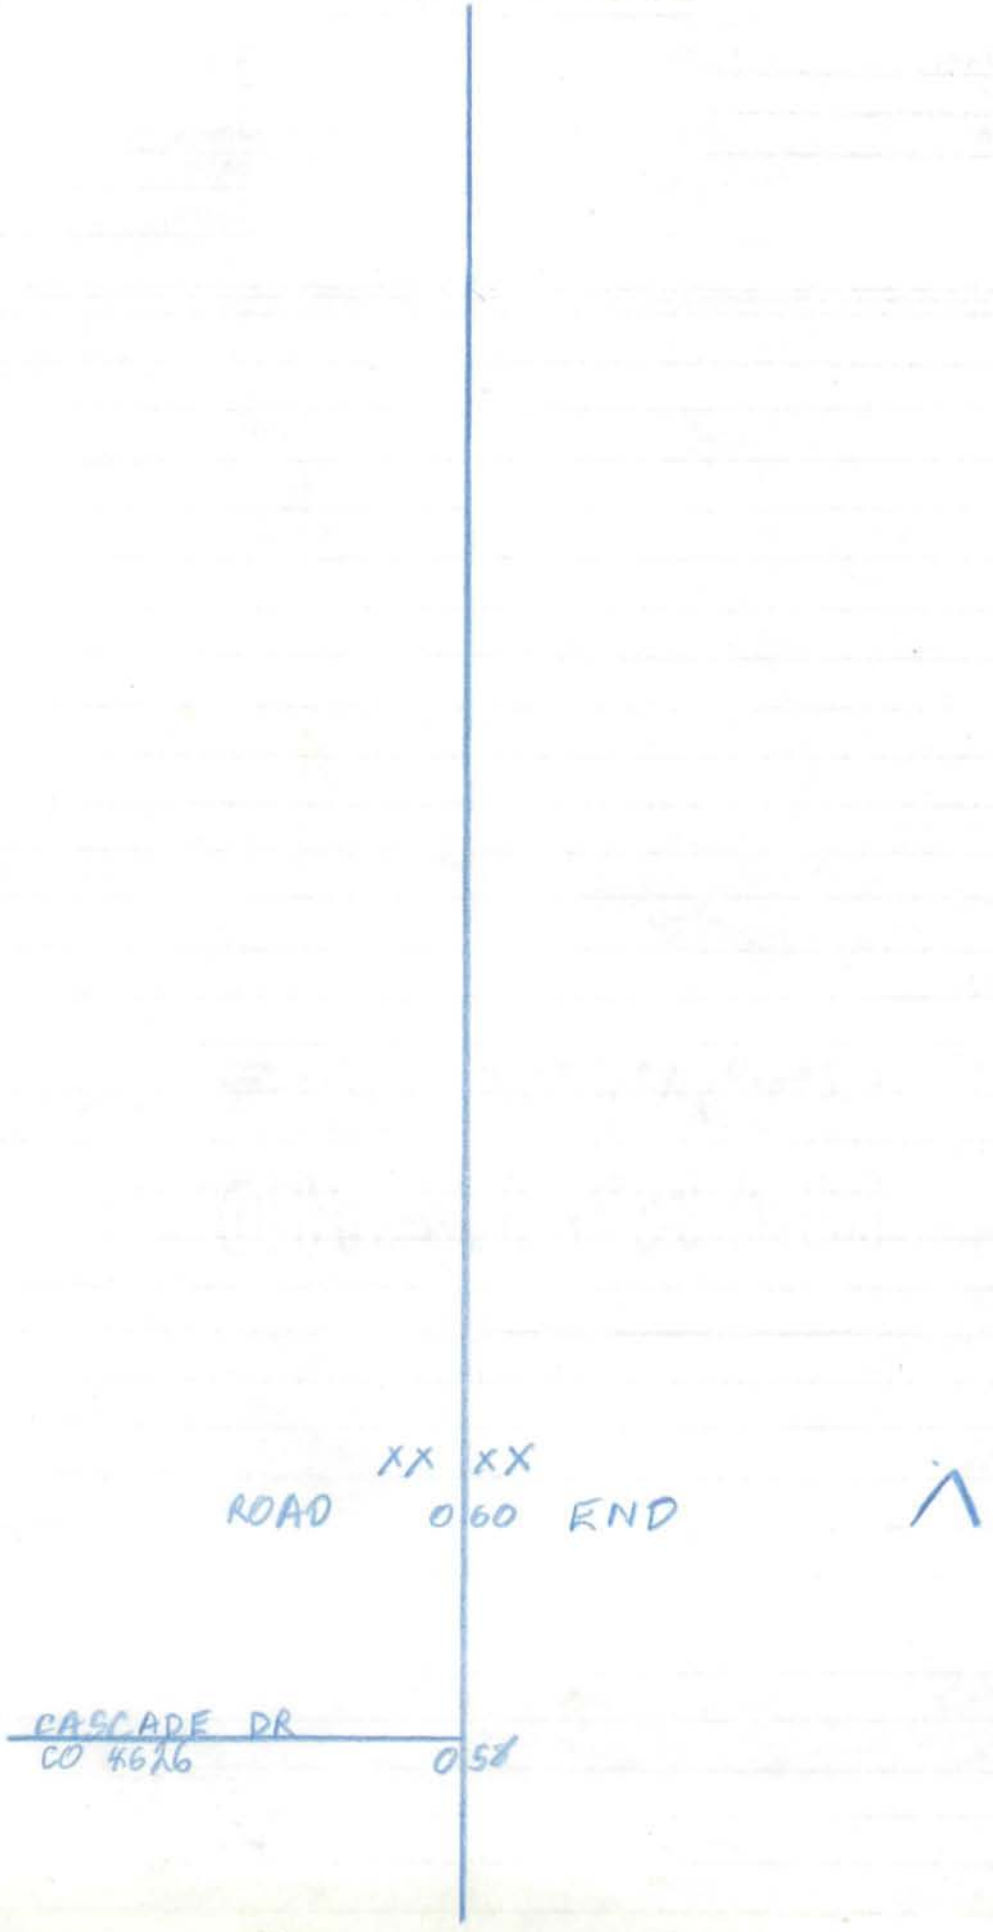
XX XX
ROAD 0 60 END
CASCADE DR
CO 4626
0 58

Form 6 HPS (Rev. 1961)

Z-450

V 78

ROAD INVENTORY SHEET

Party Chief E.S.
Recorder W.D.
Chainman

MAP 12 VER 7-12-77
FT. WASH FOREST
800-316 M39

Road No. Co 2926
Name KRIS-RAN CT
Sheet No. 1 OF 1
Date 8-26-68
County PRINCE GEO

Form 6 HPS Rev. 1961

ROAD INVENTORY SHEET

Party Chief
Recorder
Chairman

Road No. C 2927
Name Park Ridge Ct
Sheet No.
Date
County

Ft Wash Forest

69 UNASSIGNED

NO RECORD of County MAINTAINANCE

NOW OP 852

Form 6 HPS (Rev. 1961)

4-139

ROAD INVENTORY SHEET

Party Chief E.S.
Recorder W.D.
Chainman

806-317 M39
JER 7-6-77
FT. WASH FOREST
MAP 12

Road No. CO 2928
Name TAYLOR ST
Sheet No. 1 OF 1
Date 8-27-68
County PRINCE GEO

H

CUL-DE 0 05 SAC A

3 H 0 03 3 H 90°

0 01

26 T

CO 1790 C-C

TAYLOR 0 00 AVE V

Form 6 HPS (Rev. 1961)

4-210 C

ROAD INVENTORY SHEET

Party Chief E.S.
Recorder W.D.
Chainman

805-316 M39
VER 7-6-77
FT. WASH FOREST
MAP 12

Road No. CO 2929
Name TAYLOR RD
Sheet No. 1 OF 1
Date 8-27-68
County PRINCE GEO

CUL-DE

3 H

0 04

0 01

CO

TAYLOR

0 00

SAC

3 H

1790

AVE

26 I

C-C

Form 6 HPS (Rev. 1961)

A-209

ROAD INVENTORY SHEET

Party Chief E.S.
Recorder W.D.
Chainman

805-317 M39
VER 7-6-77
FT. WASH. FOREST

MAP 12

Road No. Co 2930
Name COLWYN RD
Sheet No. 1 OF 1
Date 8-27-68
County PRINCE GEO

CUL-DE

SAC

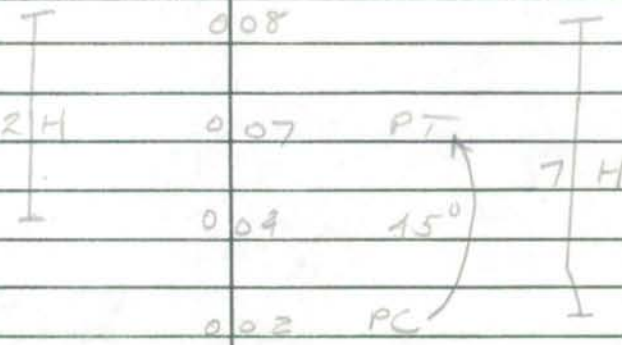

CO
TAYLOR
0 00

1790
AVE

26' I
C-C

Form 6 HPS (Rev. 1961)

4-208 L

ROAD INVENTORY SHEET

Party Chief E.S.
Recorder W.D.
Chainman

806-319 M39
MAP 9
FT. WASH FOREST
VER 7-6-77

Road No. CO 2931
Name TIOGA RD
Sheet No. 1 OF 1
Date 8-27-68
County PRINCE GEO

CUL-DE SAC

H

6 H 008 5 H

002

CO 1790

TAYLOR 000 AVE

20' I
C-C

Form 6 HPS (Rev. 1961)

4-200

ROAD INVENTORY SHEET

Party Chief E.S.
Recorder W.D.
Chainman

805-320 1139

MAP 9 VER 76-77

FT. WASH FOREST

Road No. Co 2938
Name CLARION CT
Sheet No. 1 OF 1
Date 8-27-68
County PRINCE GEO

	H		
CUL-DE	H	004	SAC
	H	002	H
	H	001	
		3	26' I
CO		2704	C-C
CLARION	000	RD	

Form 6 HPS (Rev. 1961)

4-191

ROAD INVENTORY SHEET

Party Chief E.S.
Recorder W.D.
Chainman

805-320 M39
JER 7-6-77

FT. WASH. FOREST

Road No. CO 2933
Name CLARION TERR
Sheet No. 1 OF 1
Date 5-27-68
County PRINCE GEO

H

CUL-DE 0 06 SAC N
4 H 3 H
0 01

26' I
CO 2703 C-C
CLARION 0 00 RD Y

Form 6 HPS (Rev. 1961)

4-199

ROAD INVENTORY SHEET

Party Chief E.S.
Recorder W.D.
Chainman

807-320 M39 sheet 1
VER 76-77 MAPG
FT. WASH. FOREST

Road No. CO 2934
Name CHALFONT AVE
Sheet No. 1 OF 1
Date 8-25-68
County PRINCE GEO

ROAD	033	END	
	031	H	PT 85° PC
	027		
		OP ~~CO~~ ~~2936~~ ~~822~~	
	026	VENANGO RD 3412	
	025		
T	020		
	019	T	
PT 50° PC	017		
	014	H	
	011		PT 95° PC
10 H	009		
		CO 2935	
	008	CHALFONT CT	
	007	H	
PT 50° PC	004		
	002	H	
			36 I C-C
CO		1202	
LIVINGSTON	000	RD	

Form 6 HPS (Rev. 1961)

4-199

ROAD INVENTORY SHEET

Party Chief E.S.
Recorder W.D.
Chainman

VER 7-6-77
MAP 9
FT. WASH FOREST
807-319 M39

Road No. CO 2935
Name CHALFONT CT
Sheet No. 1 OF 1
Date 8-29-68
County PRINCE GEO

H

CUL- T DE 005 T SAC
3 H 3 H
001

CO 2934
CHALFONT 000 AVE

26' E
C-C

Form 6 HPS (Rev. 1961)

ROAD INVENTORY SHEET

Party Chief
Recorder
Chainman

Road No.
Name
Sheet No.
Date
County

CO 2936

NOW

OP 822

NO RECORD OF COUNTY MAINTENANCE

Form 6 HPS (Rev. 1961)

ROAD INVENTORY SHEET

Party Chief
Recorder
Chainman

Road No.
Name
Sheet No.
Date
County

CO	2937	
NOW		
OP	767	
NO RECORD OF COUNTY	MAINTENANCE	

Form 6 HPS (Rev. 1961)

ROAD INVENTORY SHEET

Party Chief
Recorder
Chainman

Road No.
Name
Sheet No.
Date
County

CO 2938
NOW
OP 768
NO RECORD OF COUNTY MAINTENANCE

Form 6 HPS (Rev. 1961)

ROAD INVENTORY SHEET

Party Chief E.S.
Recorder W.D.
Chainman

69-205

M289

THRIFT

817-330 M39

VER 7-12-77

Road No. CO 2939
Name DELANCEY ST
Sheet No. 1 OF 1
Date 8-28-68
County PRINCE GEO

ROAD	017	END	
5 H	014	7 H	
	007		
CO		2940	
WELCH	006	ST	
H	003	H	
H	001	H	26'I
			C-C
MD	000	223	

Form 6 HPS (Rev. 1961)

98-105
11-18-98
SS1SR1BB

ROAD INVENTORY SHEET

Party Chief E.S.
Recorder W.D.
Chainman

69-206

MAP 9
THRIFT
817-330 M39
VER 7-12-77

Road No. CO 2940
Name WELCH ST
Sheet No. 1 OF 1
Date 8-28-68
County PRINCE GEO

ROAD	0	06	END
H	0	05	H
CO			2939
DELANCEY	0	03	ST
H	0	01	H
H CUL-DE	0	00	SAC H
H			

2 UNL
26' I
JC-C

Form 6 HPS (Rev. 1961)

Map 9

98-20
1-19-98
SS/SR/BB

ROAD INVENTORY SHEET

Party Chief E.S.
Recorder W.D.
Chainman

811-338 m35
G11
THRIFT
69-193
(AS TABBED)

OP 5336
Road No. CO 2941
Name TANDOM DR
Sheet No. 1 OF 1
Date 8-28-68
County PRINCE GEO

CRICKLEWOOD DR
CO 0 22 2351

PROPOSED
OP 5336

PT 0 19 PT

35° ROAD 0 14 END
PC 7 H 0 13 6 H 35° DS
0 07

ZC I
JC-C
2UML

CO 2352
TESTWAY 0 05 AVE
H 0 02 H

H CUL-DE 0 00 SAC H

H

Form 6 HPS (Rev. 1961)

4-228

ROAD INVENTORY SHEET

808-333 M39

VER 7-14-77 MAP?

FRIENDLY FARMS

Party Chief E.S.
Recorder W.D.
Chainman

Road No. CO 2942
Name ROSEDELL PL
Sheet No. 1 OF 1
Date 8-29-68
County PRINCE GEO

ROAD	014	END	
T	013	4 H	
	008		
8 H		CO 2942	
	007	MAC DOUGAL DR	
	005	3 H	
	001		
			26 I
CO		119	C-C
OLD FT	000	PL	

SHA 51.3-8
11-15-72

STATE HIGHWAY ADMINISTRATION OF MARYLAND

ROAD INVENTORY SHEET

Party Chief J.E
Recorder N.S.
Helper

Map No. 39
82-152

Road No. CO 2943
Road Name TONGA DR.
Sheet No. 1 of 1
Date 3/23/83
County P.G.
State Coordinates 808-333

	DE	
	CUL 0 23 SAC	↑
W ↑		
		26'I J-CC
↑15° OLD FORT	PL.	
60	0 10 119	X
		36'I J-CC
	RD 0 00 END	↓

A-FIELD

SHA 51.3-8
11-15-72

ROAD INVENTORY SHEET

Road No. _____
Road Name _____
Sheet No. _____
Date _____
County _____
State Coordinates _____

Form 6 HPS (Rev. 1961)

4-229

ROAD INVENTORY SHEET

Party Chief E.S.
Recorder W.D.
Chainman

808-333 M39

VER 7-14-77 MAP 9

FRIENDLY FARMS

Road No. CO 2944
Name MAC DOUGAL DR
Sheet No. 1 OF 1
Date 8-29-6F
County PRINCE GEO

ROAD	003	END	
H	002		
			26'I
CO		2942	C-C
ROSE DELL	000	PL	✓

SHA 51.3-8
11-15-72

STATE HIGHWAY ADMINISTRATION OF MARYLAND

ROAD INVENTORY SHEET

Party Chief E.S.
Recorder W.D.
Helper
FORT FOOTE
Map No. M35&39

Road No. Co 2945
Road Name KISCONKO RD
Sheet No. 1 of 1
Date 8-30-68 REVISED 3-10-75
County PR GEO.
State Coordinates 794.336
3-982

Ver 8-3-77

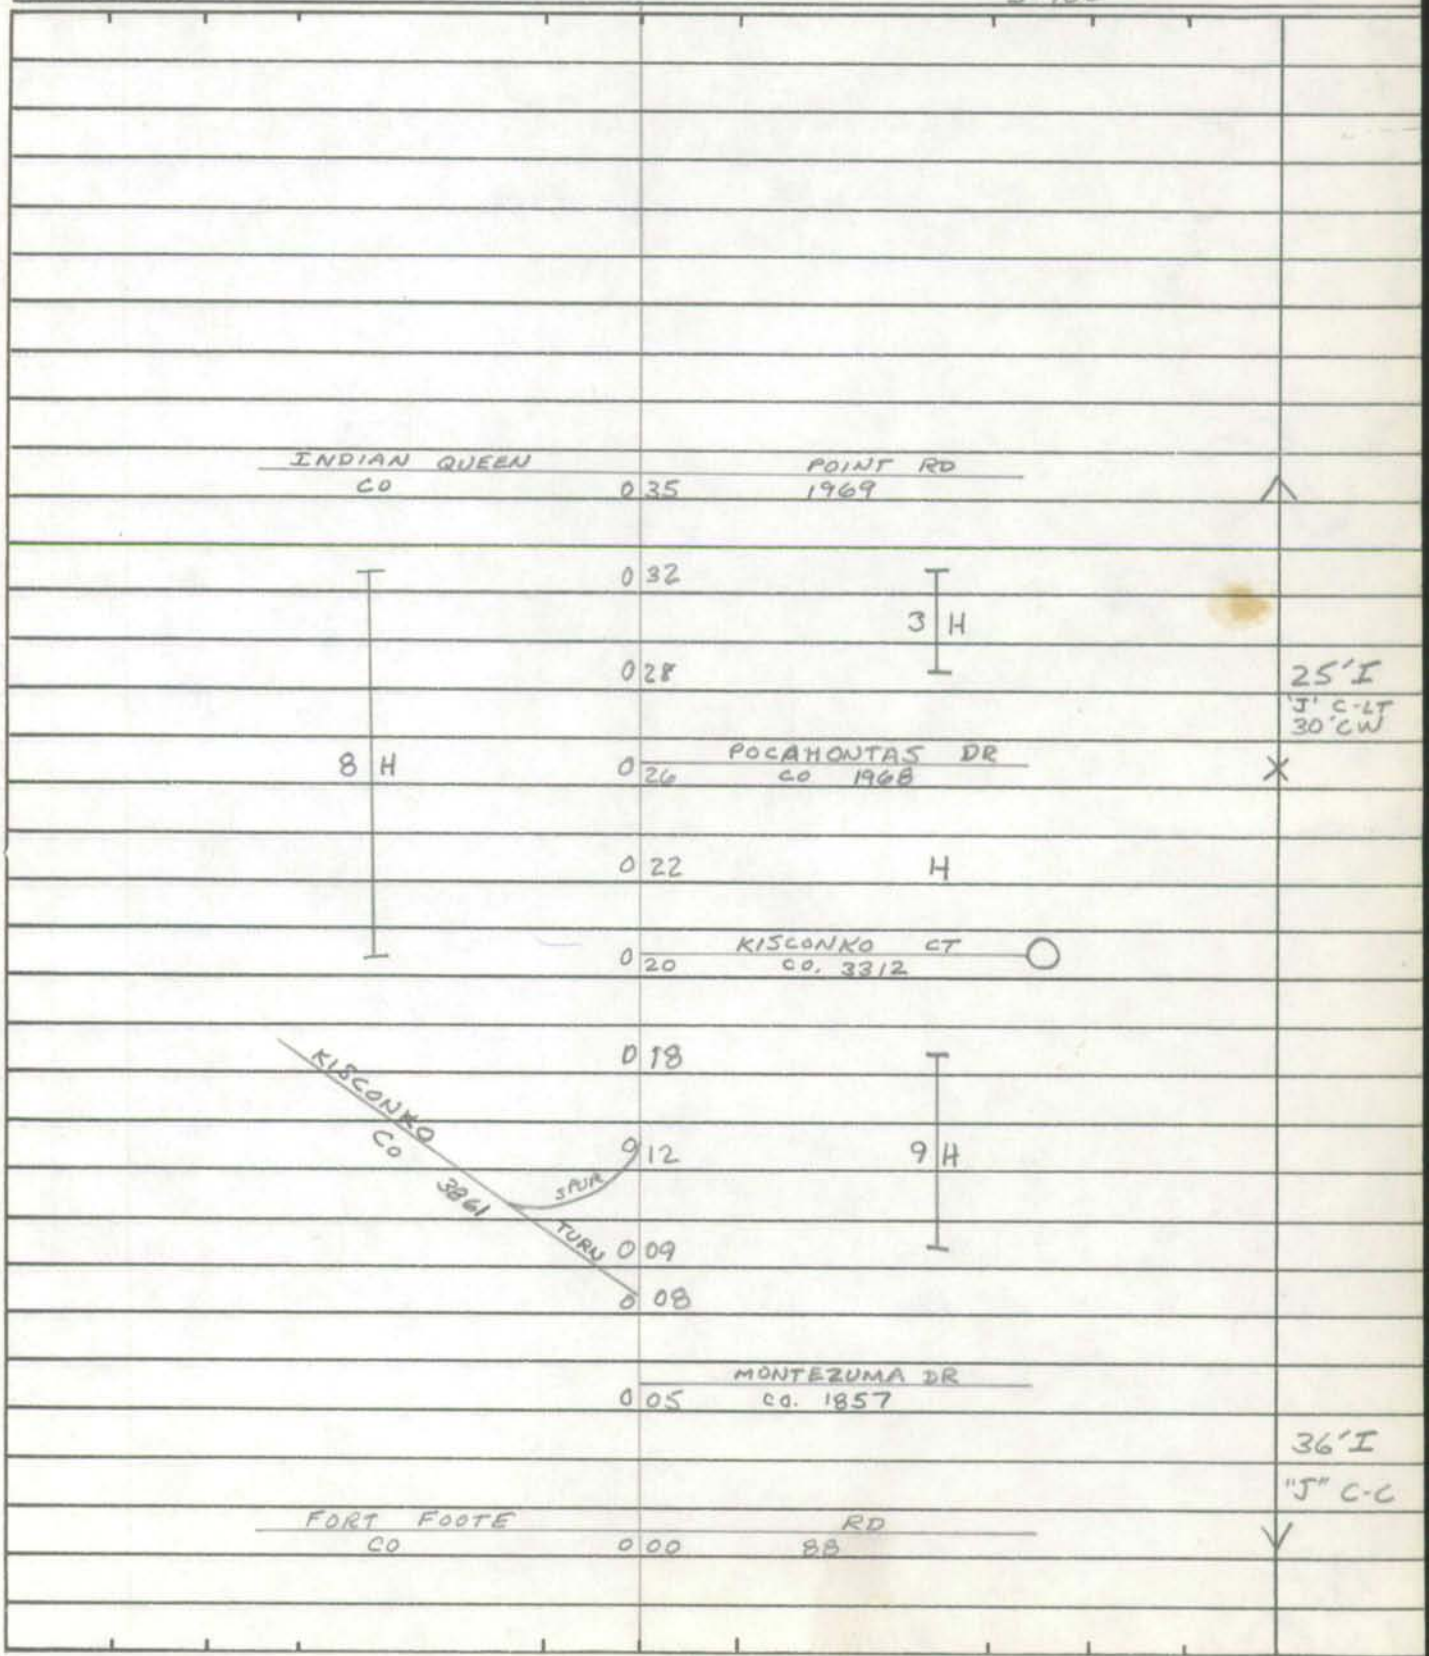

SHA 51.3-8
11-15-72

ROAD INVENTORY SHEET

Road No. _____
Road Name _____
Sheet No. _____
Date _____
County _____
State Coordinates _____

Form 6 HPS (Rev. 1961)

Ver 8-4-77 3-643

ROAD INVENTORY SHEET

Party Chief E.S.
Recorder W.D.
Chainman

MAP 9

FORTE FOOTE
794-341 M35

Road No. Co 2146
Name WEST FORT FOOTE TERRANCE
Sheet No. 1 OF 1
Date 7-3-68
County PRINCE GEO

CO 1454
E. FT FOOTE TERR 031

030

026 90°

022
10 H

009 20 H

CO 1455

007

004

H 001 H

26' I
C-C

CO 88
FORT - FOOTE 000 RD

Form 6 HPS (Rev. 1961)

Ver 8-3-77

86-124 BB
3-166 7-22-87 TM
89-76
2-19-90 BB/BB

ROAD INVENTORY SHEET

Party Chief E.S.
Recorder W.D.
Chainman

MAP 9

FT. FOOTE
793-339 M35

Road No. Co 2947
Name FORTSIDE DRIVEWAY
Sheet No. 1 OF 1
Date 8-30-68
County PRINCE GEO

Form 6 HPS (Rev. 1961)

Ver 8-3-77 3-168

ROAD INVENTORY SHEET

Party Chief E.S.
Recorder W.D.
Chainman

MAP 9

FT. FOOTE
793-338 M35

Argonne Trail
Road No. CO 2948
Name ~~ARGONNE TERRACE~~
Sheet No. 1 OF 1
Date 8-30-68
County PRINCE GEO

CO	2950	75-131
Overlook 0.04	~~ROAD~~ TR 0.05	20 I C-C
0.02		
CO	88	
FT. FOOTE 0.00	RD	

Form 6 HPS (Rev. 1961) 98-18,19 CO' 98-98 11-2-98 SS/SR 2-032-E

ROAD INVENTORY SHEET

GLEN WILLOW DR L 18

Party Chief E. SCHUYLER
Recorder W. DOMBROSKI
Chairman

MAP 7

68-89 VER 4-20-18 828-389 M31

Road No. CO-2949
Name ~~LEFTH~~ AVE
Sheet No. 1 OF 1
Date 5-13-69
County PRINCE GEORGES

SHERIFF RD
CO 038 75

PT 031 PTF

E cedar HBFT's comm. center 030
35°

PRC 028 35° PRC 34'I
027 35° PC J-C LFT
026 2ML

~~ROAD~~ 019 ~~END~~

SKILLMAN ST

015 20'I
J CURB CT
3' SHOULDER

009

002 ENT TO APTS 36'I
J C-C

~~MARTIN LUTHER~~ ~~KING JR HWY~~
MD 000 704

DIST
S 0.12

SHA 51.3-8
11-15-72

STATE HIGHWAY ADMINISTRATION OF MARYLAND

ROAD INVENTORY SHEET

Party Chief E.S.
Recorder W.D
Helper

FORT FOOTE

Map No. M 35

75-133
Ver 8-3-77

Road No. Co. 2950
Road Name Overlook Trail
Sheet No. 1 of 1
Date 8-30-68
County Pr. Geo.
State Coordinates 793-338

J-170 A

FORTSIDE CO	0	09	DR. WAY 2947
	0	06	H
	0	06	H
	0	05	ARGONNE TR. CO 2948
Belleau Co. ~~FERGUSON~~ TR. 5001	0	00	VERDUN TR. CO. 3607 (0.04

12' I
'I' C LT
'J' C RT

SHA 51.3-8
11-15-72

ROAD INVENTORY SHEET

Road No. _____
Road Name _____
Sheet No. _____
Date _____
County _____
State Coordinates _____

SHA 51.3-8
11-15-72

STATE HIGHWAY ADMINISTRATION OF MARYLAND

FAR

78

ROAD INVENTORY SHEET

Party Chief R. Bush (office INV) VER 7-5-77
Recorder
Helper

Map No. M39 T. LANDON F. RHODES 3/11/75 REVISED
INDEX 10

Road No. Co 2951
Road Name EARNSHAW DR
Sheet No. 1 of +2
Date 9-5-68 REVISED 6-20-74
County PR GEO
State Coordinates 834-325

EARNSHAW CT. Co. 3831 74-197 0 74 — 24'F 30'CW
RD — END
068
Co 2953 @ 40
REDWOOD DR E. 065
ELMWOOD DR.
054 Co 2952 90°
REDWOOD DR W. @ 200
90° Co 2953 046
041 TWIN 60" MULTI PLATES — 22'I 2-3'E Shld 30'CW
CRESTWOOD AVE N.
Co 3687 5557 038
Crestwood DR
Co (01-49,50) 6143 035
30° 019
(CRESTWOOD AVE N) Crestwood AVE SOUTH
Co 5557 016 Co 3687
013
45°
011 — 20'I 2-3'E Shld 30'CW
003
MD 000 5
Co 7564

SHA 51.3-8
11-15-72

ROAD INVENTORY SHEET

Road No. 2951
Road Name EARNSHAW DR.
Sheet No. 2 OF 2
Date 3/11/75
County P.G.
State Coordinates

LUSBY'S CO.	0 82	L.A. 2182
↑ 15°	0 77	SAME

SHA 51.3-8
11-15-72

FAR

VER 7-5-77

78

ROAD INVENTORY SHEET

Party Chief R. Bush (OFFICE INV)
Recorder
Helper

Map No. M39
INDEX 10

Road No. Co 2952
Road Name ELMWOOD DR
Sheet No. 1 OF 1
Date 9-5-68 REVISED 6-24-74
County PR. GEO
State Coordinates 836 - 326

Rd. END
0.20

S

BRIGHTWOOD DR
0.16 Co 2955

21'I
2-3'E Shld

EARNSHAW
Co

0.00

2951 DR

SHA 51 .3-8
11-15-72

ROAD INVENTORY SHEET

Road No. _____
Road Name _____
Sheet No. _____
Date _____
County _____
State Coordinates _____

SHA 51.3-8
11-15-72

FAR

VER 7.5.77

78

ROAD INVENTORY SHEET

Party Chief R. BUSH (OFFICE INV)
Recorder
Helper

Map No. M39
INDEX 10

Road No. CO 2953
Road Name REDWOOD DR. W & E
Sheet No. 1 OF 1
Date 9-5-68 REVISED 6-24-74
County PR GEO
State Coordinates 836 - 326

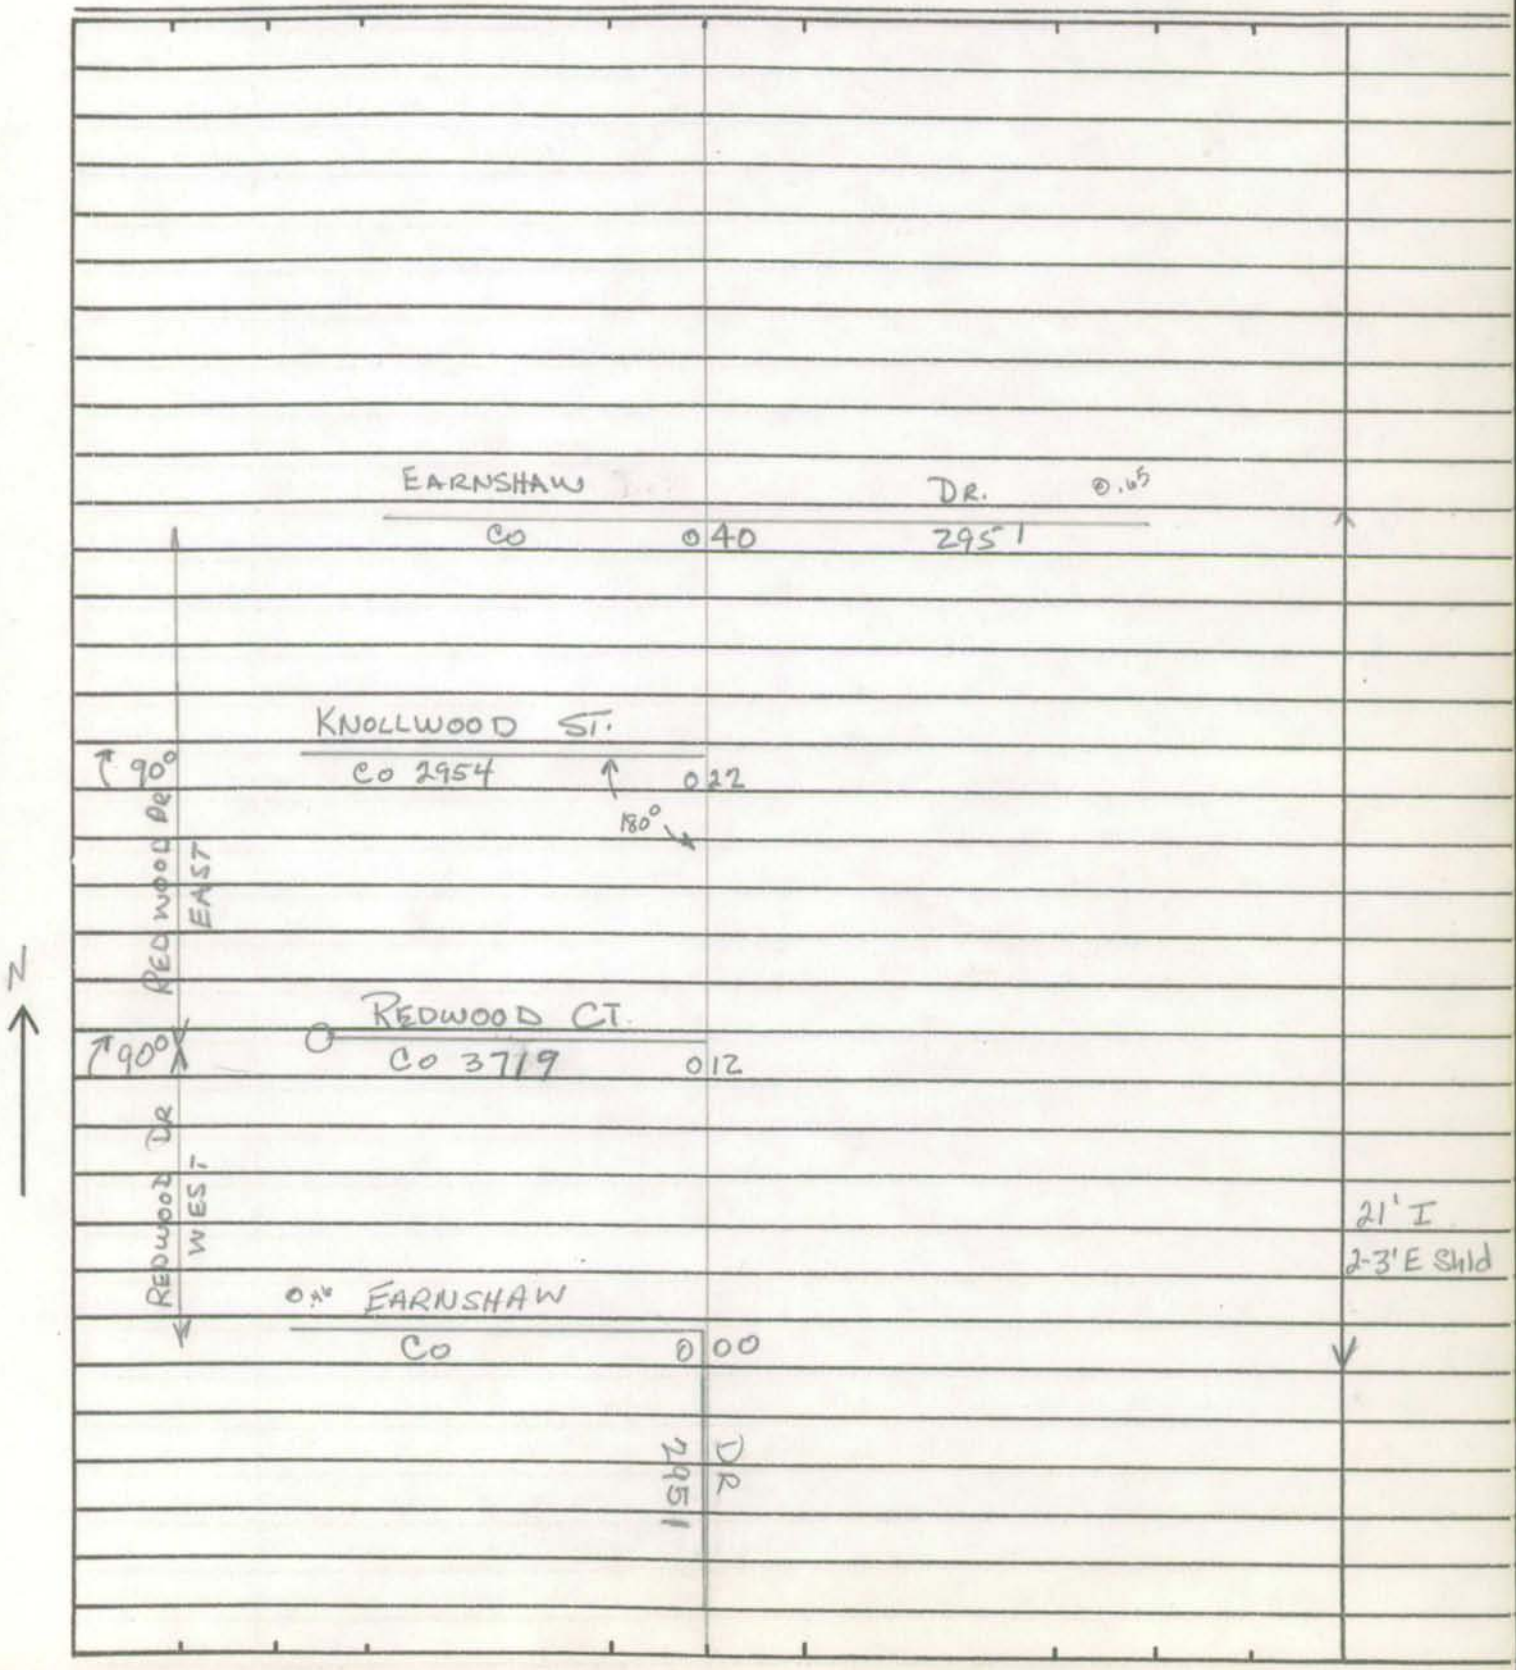

SHA 51.3-8
11-15-72

ROAD INVENTORY SHEET

Road No. _____
Road Name _____
Sheet No. _____
Date _____
County _____
State Coordinates _____

SHA 51.3-8
11-15-72

FAR VER 7-5-77

78

ROAD INVENTORY SHEET

Party Chief R. Bush
Recorder
Helper

Map No. M39
INDEX 10

T. LANDON
F. RHODES
3/11/75
REVISED

Road No. Co 2954
Road Name KNOLLWOOD ST
Sheet No. 1 OF 1
Date 9-5-68 REVISED 6-21-74
County PR GEO
State Coordinates 837 - 327

80-77 Alt

RD END

028

025 LUSBY'S LA. 2182 CO.

~~KNOLLWOOD~~ ~~OLIVE~~ EXTRA PL
CO4296

019

~~10'E~~
~~20'OW~~

E

↑20°

005

30'OW

H

~~2'I~~
~~2 3'E SHLD~~

DR. EAST

000 2953

KNOLLWOOD
REDWOOD
CO

SHA 51.3-8
11-15-72

ROAD INVENTORY SHEET

Road No. _____
Road Name _____
Sheet No. _____
Date _____
County _____
State Coordinates _____

Form 6 HPS (Rev. 1961)

VGR 7-5-77 4-241

ROAD INVENTORY SHEET

Party Chief E.S.
Recorder W.D.
Chainman

MAP 10

BLANDFORD VILL
836-326 M39

Road No. CO 2955
Name BRIGHTWOOD DR
Sheet No. 1 OF 1
Date 9-5-68
County PRINCE GEO

ROAD 003 END

21'E

CO 2952
ELMWOOD ADD DR

2-3'ESW

Form 6 HPS (Rev. 1961) Map 10 4-236

ROAD INVENTORY SHEET

Party Chief E.S.
Recorder W.D.
Chainman

Road No. SR 3956
Name MORANO DR
Sheet No. 1 OF 1
Date 9-5-68
County PRINCE GEO

BLANDFORD VILL
831-323 M39

ROAD 025 END

023 11 H

10 H

001

SR 599 26' I
BRANDYWINE 000 AD 3' C-C

Form 6 HPS (Rev. 1961)

MAP 10

ROAD INVENTORY SHEET

Party Chief: T. LANDON
Recorder: W. WARFIELD
Helper:

Road No.: Co. 2957
Road Name: LAYTON AVE.
Sheet No.: 1 of 1
Date: 3-17-71
County: PRINCE GEORGE

VEO
7-14-77
70-187 831-323 M39

	X- X-X	
ROAD	0 26 END	
	0 24	5 H
	0 17	MALTHUS ST.
15 H	0 15	70-188 Co 3328
	0 12	7 H
	0 02	26' I
BRANDYWINE Co.	0 00	RD. 599 "I" C-C

Form 6 HPS (Rev. 1961)

ROAD INVENTORY SHEET

Road No. _____
Road Name _____
Sheet No. _____
Date _____
County _____

Form 6 HPS (Rev. 1961)

J-338

ROAD INVENTORY SHEET

Party Chief E.S.
Recorder W.D.
Chainman

MAP 10
JER 7-8-71
BLANDFORD VILL
830-327 M39

Road No. Co 2958
Name GROVETON DR
Sheet No. 1 OF 1
Date 9-5-68
County PRINCE GEO.

CRESTVIEW	014	ELEM. SCH.	
H	009	H	
CO KEYSTONE	006	2959 AVE	
3 H	004	3 H	
	002		36' I
CO BRANDYWINE	000	599 RD	C-C

Form 6 HPS (Rev. 1961)

72-199 78

ROAD INVENTORY SHEET

Party Chief W. Dombroski
Recorder D. Taylor
Helper

Road No. Co. 2959
Road Name Keystone Ave
Sheet No. 1 of 2
Date 3-13-73
County Prince Georges

VER 7-8-77
830-329
M39

Danford DR
72-194 025 Co. 3535

023 H

022

Filerson St.
019 72-195 Co. 3536

018 H

016 H

9 H Fulford St
013 72-196 Co. 3537

012 H

010 H

009

N
A

Groveton DR
Co. 007 2958

004

3 H 3 H

001

26' I
2 J curbs

Cul 000 Sac
De
H H

Form 6 HPS (Rev. 1961)

ROAD INVENTORY SHEET

Road No. Co 2959
Road Name Keystone Ave
Sheet No. 2 of 2
Date 3-13-73
County Prince Georges

Road XXXX End
0 47
0 46
Briarcliff DR
5 H 0 45 Co. 2540
0 40 H
Northgate PKWY
Co. 0 39 2638
0 37
3 H
0 34
Crafton La
8 H 0 32 Co. 2543
0 29 H
0 27

same

Form 6 HPS (Rev. 1961)

5-096

MAP ID

ROAD INVENTORY SHEET

Party Chief T. LANDON
Recorder W. WARFIELD
Helper

VER 7-8-77

Road No. Co. 2960
Road Name EDWARD DR.
Sheet No. 1 of 1
Date 3-17-71
County PRINCE GEORGE

70-185 828-329 M39

Co 3327

CUSHWA DR.

70-186 0 34 70-186

0 33

0 22

20 H

10°

0 19

22 H

10°

0 02

26' I
"J" C-C

PENNY AVE.

Co. 0 00 2640

Form 6 HPS (Rev. 1961)

ROAD INVENTORY SHEET

Road No. _____
Road Name _____
Sheet No. _____
Date _____
County _____

Form 6 HPS (Rev. 1961)

5-244

ROAD INVENTORY SHEET

Party Chief E.S.
Recorder W.D.
Chainman

MAP 10
VER 7-8-72
BLAND FORD VILL
829-329 M39

Road No. CO 2961
Name SHIRLEY CT
Sheet No. 1 OF 1
Date 9-5-68
County PRINCE GEO.

H
CUL-DE

H
SAC

007

4 H

001

4 H

CO

BROOKE LANE ROAD

~~38~~ 3534

DR

26' I
C-C

Form 6 HPS (Rev. 1961)

5-135-A

ROAD INVENTORY SHEET

Party Chief E.S.
Recorder W.D.
Chainman

MAP #4

BROOKE JANE

830-329 M39

Road No. CO 2962
Name KEYSTONE AVE
Sheet No. 1 OF 1
Date 9-5-68
County PRINCE GEO

Unassigned

Now Combined with CO. 2959 72-199

Previous

ROAD	017	END	
H	016		
CO 2543			
CROFTON LA	014		
H	012	6 H	
H	010		
H	009		
CO		2638	
NORTHGATE	007	PKWY	
	006		
H	005		
CO 2540		5 H	
ARIARCLIFF DR	002		
	001		26' I
			C-C
ROAD	000	END	

Form 6 HPS (Rev. 1961)

5-315

ROAD INVENTORY SHEET

Party Chief E.S.
Recorder W.D.
Chainman

MAP 10
VER. 7-8-77
BROOKE JANE
831-329 M39

72-198
REVISED
3-13-73

Road No. Co 2963
Name HERMITT ST
Sheet No. 1 OF 1
Date 9-5-68
County PRINCE GEO

Rd XX	XX	END		
	026			
	025			
GROVETON DR				
Co. 2545	023			
		5 H		
H	021			
H	019			
FULFORD		St		
72-196	017	Co. 3537		
H	015	H		
H	013			
EILERSON		St		
72-195	011	Co. 3536		
H	009	H		
H	007	H		
DANFORD DR		(72-194)		
Co.	006	3535		
~~ROAD~~ H	002	H	~~END~~	
H	001	H		
CO		2543		
CRAFTON	000	CA		

Form 6 HPS (Rev. 1961)

5-203

ROAD INVENTORY SHEET

Party Chief E.S.
Recorder W.D.
Chainman

MAP 10
JER 78-77
N. CREST VIEW
828-332 M39

Road No. Co 2964
Name PARKVIEW LA
Sheet No. 1 OF 1
Date 9-9-68
County PRINCE GEO

	CO		145	
	THRIFT	0	23	RD
		0	19	
				S H
	6 H	0	12	
		0	10	
	CO		~~295~~ 234	
	MULLIKIN	0	08	DR
		0	06	
		0	05	H
	4 H			
		0	04	H
		0	01	H
				36' I
	CO		599	C-C
	BRANDYWINE	0	00	RD

Form 6 HPS (Rev. 1961)

5-356

ROAD INVENTORY SHEET

Party Chief E.S.
Recorder W.D.
Chainman

MAP 10
VER 7-8-77
N. CRESTVIEW
828-332 M39

Road No. CO 2965
Name MULLIKIN DR
Sheet No. 1 OF 1
Date 9 - -68
County PRINCE GEO

Part of
CO 2346
68-145
BB 10 Dw
3-9-89

RD	013	END	
ROAD	010	END	
	008	H	
H	007		
CO		2964	
PARK VIEW	006	LA	
H	003	H	
H	002	H	
H	001	H	
ROAD	000	END	

75-106

26-I
C-C

Form 6 HPS (Rev. 1961)

00-1HD CO
2-7-01
GDIEF

5-079

ROAD INVENTORY SHEET

Party Chief E.S.
Recorder W.D
Chainman

MAPID
VER 7-8-77
N. CREST VIEW
827-333 M39

Road No. CO 2966
Name DEE LANE
Sheet No. 1 OF 1
Date 9-9-68
County PRINCE GEO

75-188

D E

CUL 016 SAC

~~ROADS~~ 014 ~~END~~

013

7 H

003 7 H

002

26 I

CO 2708 C-C

SPELL 000 RD

Form 6 HPS (Rev. 1961)

5-336 L 78

ROAD INVENTORY SHEET

Party Chief E.S.
Recorder W.D.
Chainman

MAPID
VER 7-8-77
N. CRESTVIEW
REV. 3-31-76 827-333 M39

Road No. CO 2967
Name DARLENE DR
Sheet No. 1 OF 1
Date 9-9-78
County PRINCE GEO
81-239 Alt

DE
CUL 0 26 SAC

0 23 15°

SPYRI DR.
0 18 O.P +175
CO 4295

~~SKYE DR.~~
~~CO~~ CO 4916 ~~+139~~ 0 15

~~END~~ 3 07 ~~END~~

0 05
3 H
0 02
3 H

EG I
V c-c

CO
INEZ 0 00 2709 PL

Form 6 HPS (Rev. 1961)

ROAD INVENTORY SHEET

Party Chief T. LANDON
Recorder W. WARFIELD
Helper

Sheet # 10
MAP # 36
71-123

VGR
7-19-77

Road No. Co. 2968
Road Name DALE DR.
Sheet No. 1 OF 1
Date 4-19-72
County PRINCE GEO.

850-339

		BARRICADE		
H		ROAD 041 END		
		WACO DR.		
		CO. 038 3346		
H		036		
H		034	H	
		HOLLAWAY DR.		
		CO 032 3347		
H		030	H	
H		028	H	
		PHILLIPS DR		
		CO. 027 2971		
H		025	H	
H		023	H	36' I "J" C-C
		TYRONE DR.		
		CO. 021 2903		
↑15° 9 H		019	9 H	
		001		26' I "J" C-C
		BROOKWOOD AVE.		
		CO. 000 2902		

Form 6 HPS (Rev. 1961)

ROAD INVENTORY SHEET

Road No. _____
Road Name _____
Sheet No. _____
Date _____
County _____

SHA 51.3-8
11-15-72

STATE HIGHWAY ADMINISTRATION OF MARYLAND

ROAD INVENTORY SHEET

Party Chief ES
Recorder WD
Helper TL

BROOKEWOOD

Map No. M36
74-146
76-120
Ver 7-19-77

Road No. Co. 2969
Road Name Wyman Way
Sheet No. 1 of 1
Date 9-17-68
County PrGeo.
State Coordinates 850.339
5-305

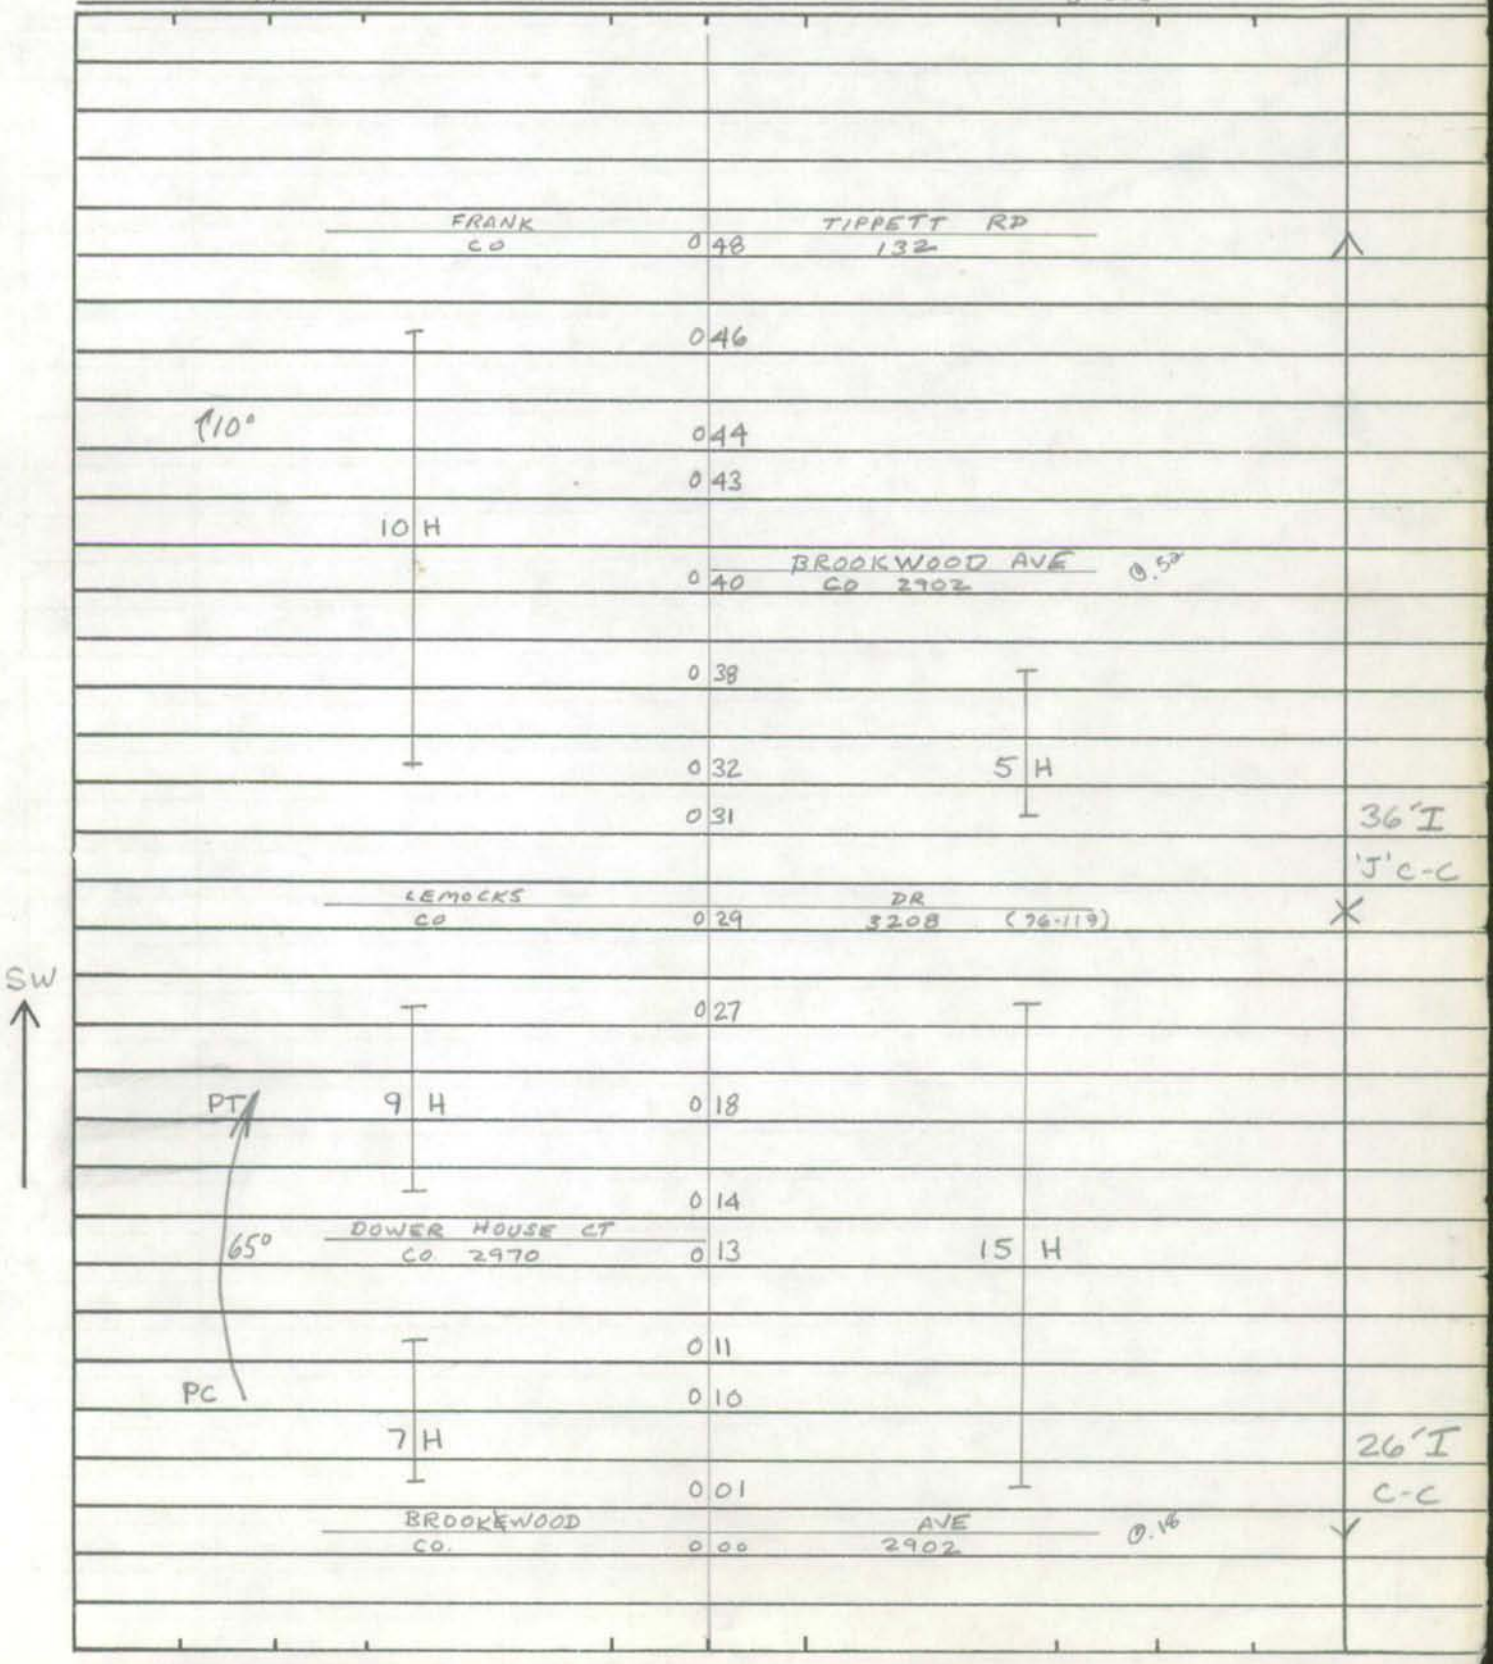

SHA 51.3-8
11-15-72

ROAD INVENTORY SHEET

Road No. _____
Road Name _____
Sheet No. _____
Date _____
County _____
State Coordinates _____

Form 6 HPS (Rev. 1961)

5-348 V

ROAD INVENTORY SHEET

Party Chief E.S.
Recorder W.D.
Chainman T.L.

MAP ID

BROOKEWOOD

VER 7-19-77 850-339 M36

Road No. CO 2970
Name DOWER HOUSE CT
Sheet No. 1 OF 1
Date 9-17-68
County PRINCE GEO

H

CUL-DE 3 H 006 SAC 3 H 002

ZG I

C-C

CO 2969

WYMAN 000 WAY

Form 6 HPS (Rev. 1961)

5-330 RURAL

ROAD INVENTORY SHEET

Party Chief E.S.
Recorder W.D.
Chainman T.L.

80-87
12 MAR 81
J.E. / D.G.

MAP 10 VER
70-145 7-19-77
BROOKEWOOD
850-339 M36

Road No. CO 2971
Name PHILLIPS DR
Sheet No. 1 OF 1
Date 9-17-68
County PRINCE GEO

H H H H H DE H
CUL 0 54 SAC

GAY DR.
CO. 0 49 4367

~~RD~~ 046 ~~END~~

73.00

~~ROAD~~ 036 ~~END~~

CO. ~~CO~~ ~~OP~~ ~~770 2113~~ 3208
LEMOCKS 034 DR

031
17 H 16 H
009

CO 2968
DALE 006 DR

003
3 H 3 H 26' I
CUL - DE 000 SAC C-C
H

Form 6 HPS (Rev. 1961)

ROAD INVENTORY SHEET

Party Chief
Recorder
Chainman

Road No. Co. 2972
Name Holloway Rd
Sheet No.
Date
County

CO 2972

NOW

OP 769

NO RECORD OF COUNTY MAINTENANCE

Form 6 HPS (Rev. 1961)

ROAD INVENTORY SHEET

Party Chief
Recorder
Chairman

Road No.
Name
Sheet No.
Date
County

CO 2973
NOW
OP 770
NO RECORD OF COUNTY MAINTENANCE

SHA 51.3-8
11-15-72

STATE HIGHWAY ADMINISTRATION OF MARYLAND

FAU

87-76
WB/CG
2-18-88

ROAD INVENTORY SHEET

Party Chief T. LANDON
Recorder M. ZALENSKI
Helper

Map No. 35

Ver 10-13-77
73-44

Road No. Co. 2974
Road Name TRUCK WAY
Sheet No. 1 OF 1
Date 3-6-74
County PR. GEO.
State Coordinates 840-384

INDEX #7

BARRICADE
0 ~~12~~ 15

MILKY WAY
0 11 73-44 Co 3567

E

RITCHIE
Co.

0 00

RD.
~~777~~ 87

46' I
J c-c

SHA 51.3-8
11-15-72

ROAD INVENTORY SHEET

Road No. _____
Road Name _____
Sheet No. _____
Date _____
County _____
State Coordinates _____

Form 6 HPS (Rev. 1961) 823-351 M35 3-201 78

ROAD INVENTORY SHEET

TALL OAK DR

Party Chief E.S.
Recorder W.D.
Chainman

70-159
BROADVIEW
MAP 9
VER 8-11-77

Road No. CO 2975
Name ~~WILE~~ ~~OAK~~ ~~DR~~
Sheet No. 1 OF 2
Date 12-11-68
County PRINCE GEO

71-79

		CO 1585	
	0 30	~~WILE~~ OAK CT	X
		TALL	
H	0 28	H	
	0 26	H	
CO		1608	
EDGEMERE	0 24	DR	
H	0 23	H	
	0 17		
CO 1610			
BAYNE PL	0 15		
		4 H	
H	0 14		
	0 12		
CO		1615	
CEDD	0 10	LA	
	0 08		
PT			
15°	0 07		
PC 3 H	0 06	3 H	
	0 04		36' I
CO		~~WILE~~ 126	C-C
ALLENTOWN	0 00	RD	V

Form 6 HPS (Rev. 1961)

ROAD INVENTORY SHEET

TALL

Party Chief T. LANDON
Recorder W. WARFIELD
Helper

Road No. Co. 2975
Road Name ~~TALL~~ OAK DR.
Sheet No. 2 OF 2
Date 4-20-72
County PRINCE GEO.

71-79

ACORN DR.
Co. 0 37 2519

0 36

HOWIE CT.
120° 71-80 Co 3387 0 35 3 H

H 0 31 15°

SAME

Form 6 HPS (Rev. 1961)

ROAD INVENTORY SHEET

Road No. _____
Road Name _____
Sheet No. _____
Date _____
County _____

Form 6 HPS (Rev. 1961)

Ver 8-3-77

3-172 78

ROAD INVENTORY SHEET

Broad Creek RD CH RD

Party Chief	E.J.
Recorder	W.D
Chainman	T.C

800-337 M35

MAP 9

Road No.	Co 2976
Name	~~OXEN HILL RD~~
Sheet No.	1 OF 1
Date	9-18-68
County	PRINCE GEO

OLD OXON HILL RD.

~~A~~ 023 CH ~~FIELD~~ ~~A~~

023 H

~~A FIELD~~ 018

CO 564

~~REBELL RD~~ 014 18'I

Old St Johns Way 2-3'E SHO

009 X 30'CW

~~OXON HILL~~ CO 20'I

@3.28 (R) 000 2-3'E SHO

RD 1/4 ✓ 30'CW

Form 6 HPS (Rev. 1961) 805-335 m39 3-491

ROAD INVENTORY SHEET

Party Chief E.S.
Recorder W.D.
Chainman

REVISED
4-3-70
T. LANDON
W. WARFIELD
FRIENDLY FARMS

Road No. CO 2977
Name CALTOR LANE
Sheet No. 1 OF 2
Date 9-23-68
County PRINCE GEO

N ↑ 69-194 70-203 70-205 AS TABBED

MAP 9

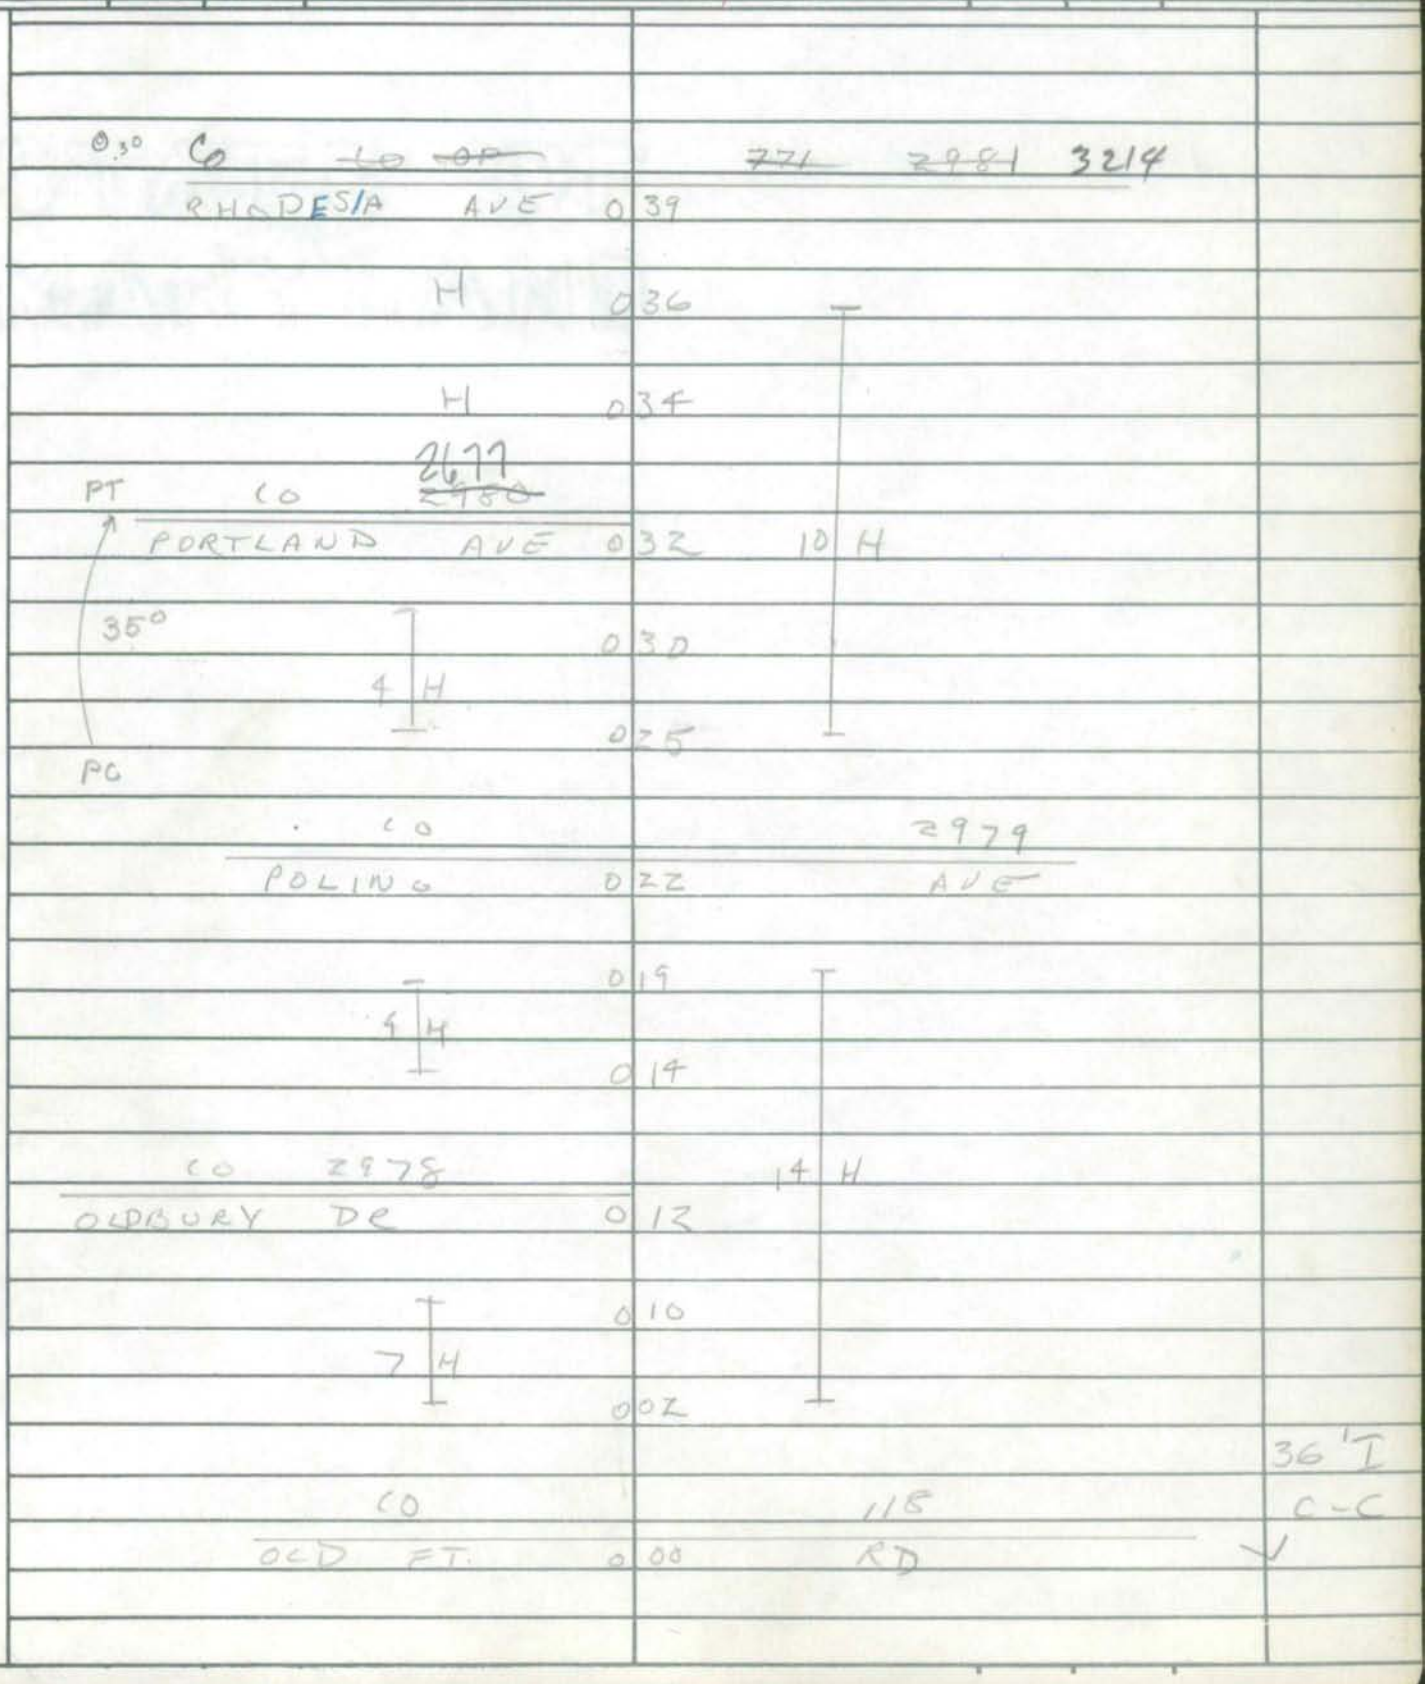

Form 6 HPS (Rev. 1961)

78

ROAD INVENTORY SHEET

Party Chief T. LANDON
Recorder W. WARFIELD
Chainman

Road No. Co. 2977
Name CALTOR LA
Sheet No. 2 OF 2
Date 4-3-70
County PRINCE GEORGES

PROPOSED

ROAD 079 END

DASHIA DR
~~OP 8~~ CO. 3216

077

075

3 H

074

072

DANIA DR

~~OP 900~~
CO. 3215

071

069

14 H

067

051

20 H

69-194

0.00 RHODISA AVE.

~~OP 711 Co. 2981~~
CO 3214

047

045

3 H

041

SAME

Form 6 HPS (Rev. 1961)

3-492

ROAD INVENTORY SHEET

Party Chief E.S.
Recorder W.D.
Chainman

MAP

FRIENDLY FARMS

VER 7-14-77

805-335 M~~35~~39

Road No. Co 2978
Name OLD BURY DR
Sheet No. 1 OF 1
Date 9-23-68
County PRINCE GEO

		H	
ROAD	013	END	
H	006	H	
	005	H	
H	004	H	17'E
			18'CW
	002		
H	001	H	26'E
CO		2977	C-C
CALTOR	000	LA	

Form 6 HPS (Rev. 1961)

96-136-138
BB/MG
3-21-97

3-493

ROAD INVENTORY SHEET

Party Chief E.S.
Recorder W.D.
Chainman

MAP9

FRIENDLY FARMS

VER
7-14-77

806-336 M35 39

Road No. CO 2979
Name POLING AVE
Sheet No. 1 OF 1
Date 9-23-68
County PRINCE GEO

ALLENTOWN Co 0 35 Rd 126

PT 0 33

Poling Terr 5752 Co 0 30

PC 0 21

ROAD 3 H

0 29

0 00

END 5 H

CO CALTOR 0 00

2977 LA 55

ROAD 0 00 XX XX

END

36'I
JC-C
2 UML

X

Z6 I
C-C
2 UML

SE

Form 6 HPS (Rev. 1961)

ROAD INVENTORY SHEET

Party Chief E.S.
Recorder W.D.
Chainman

FRIENDLY FARMS

Road No. CG 2980
Name PORTLAND AVE
Sheet No. 1 OF 1
Date 9-23-68
County PRINCE GEO

Unassigned

~~Road~~
Duplication
of Co. 2677

ROAD 010 T END ^

H 009

Co ~~2982~~ 2667
PARR CT 008 6 H

005

3 H 002

001

36 I
c-c

Co ~~2978~~ 2977
CALTOR 006 LA ✓

Form 6 HPS (Rev. 1961)

ROAD INVENTORY SHEET

Party Chief
Recorder
Chainman

Road No.
Name
Sheet No.
Date
County

CO 2781
NOW
OP 771
NO RECORD OF COUNTY MAINTENANCE

Form 6 HPS (Rev. 1961)

L

ROAD INVENTORY SHEET

Party Chief E.S.
Recorder W.D.
Chainman

FRIENDLY FARMS

Road No. CO 2982
Name PARR CT
Sheet No. 1 OF 1
Date 9-23-68
County PRINCE GEO

UNASSIGNED
DUPLICATE OF
CO 2667

H

CUL-DE

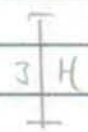

0 0 6

0 0 3

SAC

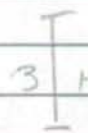

26' I
C-C

CO
PORTLAND 0 0 0

2980
AVE

Form 6 HPS (Rev. 1961) 808-334 M39 3-199

ROAD INVENTORY SHEET

Party Chief E.S.
Recorder W.D.
Chainman

FRIENDLY FARMS

Road No. CO 2983
Name ALLEN GAYLE DR
Sheet No. 1 OF 1
Date 9-23-68
County PRINCE GEO

VER 7-14-77 MAP 9

ROAD T 008 END
006
4 H 3 H
001
36 I
CO 126 C-C
ALLEN TOWN 000 RD

Form 6 HPS (Rev. 1961) 811-336 M35 4-205 18

ROAD INVENTORY SHEET

Party Chief E.S.
Recorder W.D.
Chainman

FRIENDLY FARMS

VER 8-8-77 MAP

Road No. CO 2984
Name ROSEVALE ST
Sheet No. 1 OF 1
Date 9-23-68
County PRINCE GEO

COMMUNICATIONS CENTER				
AT&T				
	GATE			
ROAD	0	18	END	
H	0	17	H	
CO			2687	
ROSE VALLEY	0	16	DR	
	0	15		
CO 2989				
ROSE VALLEY CT	0	11		
H	0	08		
CO 2988			9 H	
ROSE LA	0	05		
H	0	03		
	0	01		26' E
CO			2690	C-C
AIRPORT	0	00	DR	

Form 6 HPS (Rev. 1961)

Map 9

4-234

ROAD INVENTORY SHEET

Party Chief T. LANDON
Recorder W. WARFIELD
Helper

Road No. Co. 2985
Road Name MORELAND ST.
Sheet No. 1 of 1
Date 3-12-71
County PRINCE GEORGE

VER 8-8-77

S

70-212 812-335 M39

MELISSA DR.

Co. 70-211 0 32 70-211 3309

H 0 30

RAYMOND CT.

~~Co 291~~ 0 27

Co 3217

0 24

0 21

13 H 0 20

0 16

0 10

BLOOMING CT.

Co. 2986 0 06

H 0 04

H 0 03

ROSE VALLEY DR.

Co. 0 00 2687

24 H

PT 90° PC

26' I "J" C-C

Form 6 HPS (Rev. 1961)

ROAD INVENTORY SHEET

Road No. _____
Road Name _____
Sheet No. _____
Date _____
County _____

Form 6 HPS (Rev. 1961)

4-235

ROAD INVENTORY SHEET

Party Chief E.S.
Recorder W.D.
Chainman

MAP 9

FRIENDLY FARMS

VER 8-8-77 812-335 M39

Road No. CO. 2986
Name BLOOMING CT
Sheet No. 1 OF 1
Date 9-23-68
County PRINCE GEO

H

CUL-DE

SAC

H 004

3 H

001

26' E
C-C

CO 2985

MORELAND 000 ST

Form 6 HPS (Rev. 1961)

4-222

ROAD INVENTORY SHEET

Party Chief E.S.
Recorder W.D.
Chainman

MAP 9
FRIENDLY FARMS
VER 8-8-77
811-334 M39

Road No. Co 2987
Name SHAWN CT
Sheet No. 1 OF 1
Date 9-23-68.
County PRINCE GEO

H

CUL-DE

8 H

0 12

0 01

SAC

7 H

CO GLEN

0 00

2688 WAY

26' I
C-C

Form 6 HPS (Rev. 1961)

4-207

ROAD INVENTORY SHEET

Party Chief E.S.
Recorder W.P.
Chainman

811-336 M35

FRIENDLY FARMS

VER 8-8-77 MAP 9

Road No. CO 2988
Name ROSE LA
Sheet No. 1 OF 1
Date 9-23-68
County PRINCE GEO.

CHURCH	PIKE LOT	
ROAD 0	004 END	↑
0	003 H	
0	001 H	26' I C-C
CO	2984	
ROSEVALE 0	00 ST	↓

Form 6 HPS (Rev. 1961)

4-206

ROAD INVENTORY SHEET

Party Chief E.S.
Recorder W.D.
Chainman

811-336 M35

FRIENDLY FARMS

VER 8-8-77 MAP 9

Road No. CO 2989
Name ROSE VALLEY CT
Sheet No. 1 OF 1
Date 9-23-68
County PRINCE GEO

		H	
CUL-DE	004	SAC	
H	003	H	
			26'I
H	001	H	C-C
CO		2964	
ROSEVALE	000	ST	

Form 6 HPS (Rev. 1961)

5-342

ROAD INVENTORY SHEET

Party Chief E.S.
Recorder W.D.
Chainman T.L.

MAP 9
CLINTON
825-338 M35 VER 8-7-77

Road No. CO 2990
Name PELLA PL
Sheet No. 1 OF 1
Date 9-24-68
County PRINCE GEO

	ROAD	028	END	
CO 2995				
POLA	CT	027	H	
	H	025	H	
	H	023		
	CO		2994	
	GARDEN	021	DR	
	3 H	018		
		012		
CO 2993				
BURRELL	CT	011	10 H	
CO 2992				
REGINA	CT	006		
		002		
				26' I C-C
	MD	000	223	

Form 6 HPS (Rev. 1961)

5-362 L 18

ROAD INVENTORY SHEET

Party Chief E.S.
Recorder W.P.
Chainman T.L.

MAP 9

70-175
AS TABBED

CLINTON

VER 8-1-77

824-339 M35

Road No. CO 2991
Name ANNA DR
Sheet No. 1 OF 1
Date 9-24-68
County PRINCE GEO

N ↑

	TRENT		ST
	~~UNNER~~ Co	032	~~CONSTRUCTION~~ 3297
	H	029	
	H	027	
	CO 2714		
	SUSAN LA	025	
		024	
	7 H		10 H
	4	015	
		013	
	CO		2715
	PHYLLIS	011	DR
		009	
			5 H
	6 H	003	
		001	
			26' I
	CO		2712 C-L
	RIGA	000	ST

Form 6 HPS (Rev. 1961)

5-343

ROAD INVENTORY SHEET

Party Chief E.S.
Recorder W.D.
Chainman T.L.

MAP 9
CLINTON
825-338
M35
VER 8-1-77

Road No. Co 2992
Name REGINA CT
Sheet No. 1 OF 1
Date 9-24-68
County PRINCE GEO

H	CUL-DE	003	SAC H	
	H	001	H	
				26 4
	CO		2990	C-C
	PELLA	000	PL	

Form 6 HPS (Rev. 1961)

5-344

ROAD INVENTORY SHEET

Party Chief E.S.
Recorder W.D.
Chainman T.L.

MAP 9
CLINTON
825-338

VER 8-1-77
M35

Road No. Co 2993
Name BURRELL CT
Sheet No. 1 OF 1
Date 9-24-68
County PRINCE GEO

Form 6 HPS (Rev. 1961)

5-111-A Mo 78

ROAD INVENTORY SHEET

Party Chief E.S.
Recorder W.D.
Chainman T.L.

T. LANDON
F. RHODES
2/27/75 REVISED

MAP 9
CLINTON
825-337 M35
VER 9-1-77

Road No. CO 2994
Name GARDEN DR
Sheet No. 1 OF 1
Date 9-24-68
County PRINCE GEO

GWYNDALE			DR.	
CO.	0	44	2226	
	0	39	8 H	
	0	28		
		GARDEN	CIR	
	0	27 CO. 3820	74-161	74-159
	0	24	8 H	
	0	13		
		PAUL	DR.	
	0	11 CO. 3819	74-160	
~~ROAD~~ H	0	07	~~END~~	~~A~~
H	0	05	H	
	0	04	H	
CO			2990	
PELLA	0	02	PL	
				36 I
				C-C
ROAD	0	00	END	

Form 6 HPS (Rev. 1961)

5-345

ROAD INVENTORY SHEET

Party Chief	E.S.
Recorder	W.D.
Chainman	T.L.

MAP 9
CLINTON VER 8-1-77
825-337 M35

Road No.	CO 2995
Name	POLA CT
Sheet No.	1 OF 1
Date	9-24-68
County	PRINCE GEO

H CUL-DE	003 SAC H	
	001 H	
		26 I
CS	2980	C-C
POLA	000 PL	

Form 6 HPS (Rev. 1961)

5-077 L

ROAD INVENTORY SHEET

Party Chief E.S.
Recorder W.D.
Chainman T.C.

VER, 8-1-77
CLINTON
828-337 M35

Road No. CO 2996
Name DAVID DR
Sheet No. 1 OF 1
Date 9-24-68
County PRINCE GEO

ROAD 004 END

2 H 003 3 H

001

26' I
C-C

CO SMALL 000 2225 DR

SHA 51.3-8
11-15-72

FAU

M 16

ROAD INVENTORY SHEET

Party Chief R. Bush (OFFICE INV)
Recorder
Helper

Map No. M35
INDEX 10

VER 7.29.77

Road No. Co 2997
Road Name WADE AVE
Sheet No. 1 OF 1
Date 9-24-68 REVISED 6-14-74
County PR. GEO
State Coordinates 833 - 339

PATRICK AVE			
Co 3732	0	10	
NURSING HOME	0	04	
ENTRANCE	0	01	20'I CURB LT 3'E SHLD RT
(STUART		LA)	
Co	0	00 920 ~~920~~ 920	

W

SHA 51.3-8
11-15-72

ROAD INVENTORY SHEET

Road No. _____
Road Name _____
Sheet No. _____
Date _____
County _____
State Coordinates _____

Form 6 HPS (Rev. 1961)

CO(01-33) 5-104
2-6-02
GD/EF

ROAD INVENTORY SHEET

MAP 10

Party Chief E.S.
Recorder W.D.
Chainman

Road No. CO 2998
Name FLETCHER AVE
Sheet No. 1 OF 1
Date 9-25-68
County PRINCE GEO

CLINTON
VED
7-28-77 839-338 M35

	028 (WILDER ST)	
	036	
	BAINBridge CT @0.00	
	035 CO 6134 (01-35) PT	
	30°	
	027 PC	
ALDERBROOK CT @0.00		
CO (01-34) 6135	025	
	022 PT	
	ALLERTON TERR @0.00	
	021 CO 6136 (01-37)	
	90°	
	013 PC	
H	012	
H	010	2ML JCRB-RT
H	008	36
		~~20~~ I
CO	2261	E-3E SHO
CHELTENHAM	000 AVE	

Form 6 HPS (Rev. 1961)

5-016

ECHO LA.

78

ROAD INVENTORY SHEET

MAP 10

Party Chief E.S.
Recorder W.D.
Chainman

CLINTON

VER 7-28-77

841-339 M35

Road No. Co 2999
Name ~~BEECH~~ ~~DR~~
Sheet No. 1 OF 1
Date 9-25-68
County PRINCE GEO

	H	
ROAD	003 END	
		24 I
CO	2261	2-3 ESH
CHELTENHAM	000 AVE	

Form 6 HPS (Rev. 1961)

5-102

ROAD INVENTORY SHEET

Party Chief E.S.
Recorder W.D
Chainman

MAP 10
CLINTON
VER 7-28-77 839-341 M35

Road No. CO 3000
Name EVELYN LA
Sheet No. 1 OF 1
Date 9-27-68
County PRINCE GEO

ROAD	013	END		
H	012	H		
CO DEBORAH	010	3003 ST		
H	008			
CO 3001 CRALEY CT	004	5 H		
	002			
CO DANGERFIELD	000	557 RD		26 I C-C