PRINCE GEORGES COUNTY
COUNTY ROADS
4901 to 5100

SHA 51.3-8
11-15-72

STATE HIGHWAY ADMINISTRATION OF MARYLAND

VADA-WASH

ROAD INVENTORY SHEET CO 4901

Party Chief J.E.
Recorder D.G.
Helper

Road No. ~~OP 4355~~
Road Name CYPRESS POINT CT
Sheet No. 1 OF 1
Date 11 MAR 81
County P.G.
State Coordinates 855 - 390

Map No. 32

80 - EXTRA

88-48

	D E	
CUL	0 05 SAC	
~~CYPRESS POINT~~		26'I
	CIR.	JC-C
CO ~~OP~~	0 00 ~~4552~~ 4615	

S

SHA 51.3-8
11-15-72

ROAD INVENTORY SHEET

Road No. _____
Road Name _____
Sheet No. _____
Date _____
County _____
State Coordinates _____

SHA 51.3 - 8 Revised
4.83

MARYLAND STATE HIGHWAY ADMINISTRATION

VRBAN

ROAD INVENTORY SHEET C0 4902

Party Chief BB
Recorder AL
Assistant
Map No./Dir. F12 / E
State Coordinates 858-394

Road No. ~~OP 1534~~
Road Name CLEAVER DR (~~85-XTRA~~)
County PR. GEO.
Date 3-13-86 88-30, 185
Sheet No. 1 OF 1

TRAFFIC CODES
TRAFFIC CONTROLS: STOP SIGN=SS, TRAFFIC LIGHT=T.L., FLASHING RED BALL=F.R.

TRAFFIC CODES
PARKING RESTRICTIONS: A.M. PEAK, P.M. PEAK, A.M./P.M. PEAK, NO PARKING ANYTIME=N.P., COMM/IND. ACCESS=E

SYSTEM				TRAFFIC		LINE DIAGRAM	TRAFFIC			PAVEMENT DATA
FED. AID.	FUNCT. CLASS.	HWY. SYS.	HPMS SAMPLE	PRKG. REST.	COM/IND. ACCESS		CONTROL	COM/IND. ACCESS	PRKG. REST.	
						MD 193				
						O 30				
						Enterprise RD				
						O 26 30°				
						O 20 - - - - -				
						O 18 - - - - -				
										36'I
										"J" C-C
						ST. MICHEALS DRIVE				
						CO ~~87~~ O 11 ~~4551~~ 4719			X	
										24'I
										"J" C-C
						CUL O 00 SAL			✓	
						D E				

SYSTEM				TRAFFIC		LINE DIAGRAM	TRAFFIC				PAVEMENT DATA
FED. AID.	FUNCT. CLASS.	HWY. SYS.	HPMS SAMPLE	PRK.G. REST.	COM/IND ACCESS		CONTROL	COM/IND ACCESS	PRK.G. REST.		

SHA 51.3-8
11-15-72

STATE HIGHWAY ADMINISTRATION OF MARYLAND

CO 4903 VERSAR WALSH

ROAD INVENTORY SHEET

Party Chief J.E
Recorder N.S.
Helper

Map No. 33-C

82-82-EXTRA

Road No. ~~OP 4406~~
Road Name JOELLYN CT
Sheet No. 1 OF 1
Date 4 / 5 / 83
County P.G.
State Coordinates 798-337

88-75

D E
CUL 0 03 SAC

E

26'I
J-CC

OXON HILL RD
CO 000 114

SHA 51.3-8
11-15-72

ROAD INVENTORY SHEET

Road No. _____
Road Name _____
Sheet No. _____
Date _____
County _____
State Coordinates _____

SHA 51.3 - 8 Revised
4.83

URBAN

MARYLAND STATE HIGHWAY ADMINISTRATION

ROAD INVENTORY SHEET CO 4904

Party Chief BB
Recorder AL
Assistant
Map No./Dir. 31D /
State Coordinates 818-341

Road No. ~~OP 4542~~
Road Name SAPIENZA DR. (~~COLLECTOR~~)
County PR. GEORGES. 88-106
Date 3-10-86
Sheet No. 1 OF 1

TRAFFIC CODES
TRAFFIC CONTROLS: STOP SIGN=SS, TRAFFIC LIGHT=T.L., FLASHING RED BALL=F.R.

TRAFFIC CODES
PARKING RESTRICTIONS: A.M. PEAK, P.M. PEAK, A.M./P.M. PEAK, NO PARKING ANYTIME=N.P., COMM/IND. ACCESS=E

SYSTEM				TRAFFIC		LINE DIAGRAM	TRAFFIC			PAVEMENT DATA
FED. AID.	FUNCT. CLASS.	HWY. SYS.	HPMS SAMPLE	PRK.G. REST.	COM/IND. ACCESS		CONTROL	COM/IND. ACCESS	PRK.G. REST.	
		N				ROAD X——0 15——X END				24'T
						JOLLY DR. Co. 4733 0 00				"J" C-C

SYSTEM				TRAFFIC		LINE DIAGRAM	TRAFFIC				PAVEMENT DATA
FED. AID.	FUNCT. CLASS.	HWY. SYS.	HPMS SAMPLE	PRKG. REST.	COM/IND ACCESS		CONTROL	COM/IND ACCESS	PRKG. REST.		

SHA 51.3 - 8 Revised
4.83

URBAN

MARYLAND STATE HIGHWAY ADMINISTRATION

ROAD INVENTORY SHEET

CO 4905
~~OP 4546~~

Party Chief BB
Recorder AL
Assistant
Map No./Dir. G12 / N
State Coordinates 853-381

Road No.
Road Name HAACK PL (~~BS-XRA~~)
County P.G.
Date 3-12-86
Sheet No. 1 OF 1

88-139

SYSTEM				TRAFFIC		LINE DIAGRAM	TRAFFIC			PAVEMENT DATA
FED. AID.	FUNCT. CLASS.	HWY. SYS.	HPMS SAMPLE	PRKG. REST.	COM/IND. ACCESS		CONTROL	COM/IND. ACCESS	PRKG. REST.	
						D E CUL 0 19 SAC 0 17 PT 60° 0 03 PC MT. CO. LUBENTIA WAY 0 00 4743				24' I J' CL

TRAFFIC CODES

TRAFFIC CONTROLS: STOP SIGN=SS,
TRAFFIC LIGHT=T.L.,
FLASHING RED BALL=F.R.

TRAFFIC CODES

PARKING RESTRICTIONS: A.M. PEAK, P.M. PEAK, A.M./P.M. PEAK, NO PARKING ANYTIME=N.P., COMM/IND. ACCESS=E

SYSTEM				TRAFFIC		LINE DIAGRAM	TRAFFIC				PAVEMENT DATA
FED. AID.	FUNCT. CLASS.	HWY. SYS.	HPMS SAMPLE	PRK'G. REST.	COM/IND ACCESS		CONTROL	COM/IND ACCESS	ACCESS	PRK'G. REST.	

SHA 51.3 - 8 Revised
4.83

MARYLAND STATE HIGHWAY ADMINISTRATION

ROAD INVENTORY SHEET

CO 4906

89-121
2-28-90
BB/BB

Party Chief BB
Recorder AL
Assistant
Map No./Dir. G12 / S
State Coordinates 853-381

Road No. ~~OP 4547~~
Road Name FALCON DR. (~~EXTRA~~)
County P.G.
Date 3-12-86
Sheet No. 1 OF 1

88-140

TRAFFIC CODES
TRAFFIC CONTROLS: STOP SIGN=SS, TRAFFIC LIGHT=T.L., FLASHING RED BALL=F.R.

TRAFFIC CODES
PARKING RESTRICTIONS: A.M. PEAK, P.M. PEAK, A.M./P.M. PEAK, NO PARKING ANYTIME=N.P., COMM/IND. ACCESS=E

SYSTEM				TRAFFIC		LINE DIAGRAM	TRAFFIC			PAVEMENT DATA
FED. AID.	FUNCT. CLASS.	HWY. SYS.	HPMS SAMPLE	PRK.G. REST.	COM/IND. ACCESS		CONTROL	COM/IND. ACCESS	PRK.G. REST.	
						MT LUBENTIA WAY				
						0 32	SS			
						CO 4743				
						@ .49				
						AT 90° 0 22				
						90°				
						RC 0 17				
						UPHILL CT.				
						~~ROAD~~ 0 184 CO ~~1844~~ 502.00				
						~~90°~~ SEBAGO CT				
						~~90°~~ CO ~~4908~~ 4908 0 11				
						ADLER CT				
						CO ~~4908~~ 4909 0 05				
										24' I
										"J" C-C
						MT. LUBENTIA WAY				
						CO ~~OP~~ 0 00 4743 ~~4645~~	SS			
						@ .32				

Urban Local

SYSTEM				TRAFFIC		LINE DIAGRAM	TRAFFIC				PAVEMENT DATA
FED. AID.	FUNCT. CLASS.	HWY. SYS.	HPMS SAMPLE	PRK.G. REST.	COM/IND ACCESS		CONTROL	COM/IND ACCESS	PRK.G. REST.		

SHA 51.3 - 8 Revised
4.83

URBAN

MARYLAND STATE HIGHWAY ADMINISTRATION

ROAD INVENTORY SHEET CO 4907 OP 4548

Party Chief BB
Recorder AL
Assistant
Map No./Dir. G 12 / E
State Coordinates 853-381

Road No. OP 4548
Road Name ADLER CT. (~~BS XTRA~~)
County P.G.
Date 3-12-86 88-137
Sheet No. 1 OF 1

SYSTEM				TRAFFIC		LINE DIAGRAM	TRAFFIC			PAVEMENT DATA
FED. AID.	FUNCT CLASS.	HWY. SYS.	HPMS SAMPLE	PRKG. REST.	COM/IND. ACCESS		CONTROL	COM/IND. ACCESS	PRKG. REST.	
						D E				
						CUL 0 05 SAC				24'I
										J" C-C
						FALCON DR CD ~~ST~~ 000 ~~4548~~ 4906				

TRAFFIC CODES

TRAFFIC CONTROLS: STOP SIGN=SS, TRAFFIC LIGHT=T.L., FLASHING RED BALL=F.R.

TRAFFIC CODES

PARKING RESTRICTIONS: A.M. PEAK, P.M. PEAK, A.M./P.M. PEAK, NO PARKING ANYTIME=N.P., COMM/IND. ACCESS=E

SYSTEM				TRAFFIC		LINE DIAGRAM	TRAFFIC				PAVEMENT DATA
FED. AID.	FUNCT. CLASS.	HWY. SYS.	HPMS SAMPLE	PRK'G. REST.	COM/IND ACCESS		CONTROL	COM/IND ACCESS	PRK'G. REST.		

SHA 51.3 - 8 Revised 4.83

URBAN

MARYLAND STATE HIGHWAY ADMINISTRATION

ROAD INVENTORY SHEET CO 4908

Party Chief BB
Recorder AL
Assistant
Map No./Dir. G 12 / E
State Coordinates 853-381

Road No. ~~CO 4549~~
Road Name SEBAGO CT (~~BS XTRA~~)
County P.G
Date 3-12-86
Sheet No. 1 OF 1

88-136

TRAFFIC CODES
TRAFFIC CONTROLS: STOP SIGN=SS, TRAFFIC LIGHT=T.L., FLASHING RED BALL=F.R.

TRAFFIC CODES
PARKING RESTRICTIONS: A.M. PEAK, P.M. PEAK, A.M./P.M. PEAK, NO PARKING ANYTIME=N.P., COMM/IND. ACCESS=E

SYSTEM				TRAFFIC		LINE DIAGRAM	TRAFFIC			PAVEMENT DATA
FED. AID.	FUNCT. CLASS.	HWY. SYS.	HPMS SAMPLE	PRK'G. REST.	COM/IND. ACCESS		CONTROL	COM/IND. ACCESS	PRK'G. REST.	
						D E CUL 0 08 SAC				↑
						0 03 90°↑				24'I "J" C.C
						CO FALCON DR ~~CO 4549~~ 4906 0 00				↓

SYSTEM				TRAFFIC		LINE DIAGRAM	TRAFFIC				PAVEMENT DATA
FED. AID.	FUNCT. CLASS.	HWY. SYS.	HPMS SAMPLE	PRK.G. REST.	COM/IND ACCESS		CONTROL	COM/IND ACCESS	PRK.G. REST.		

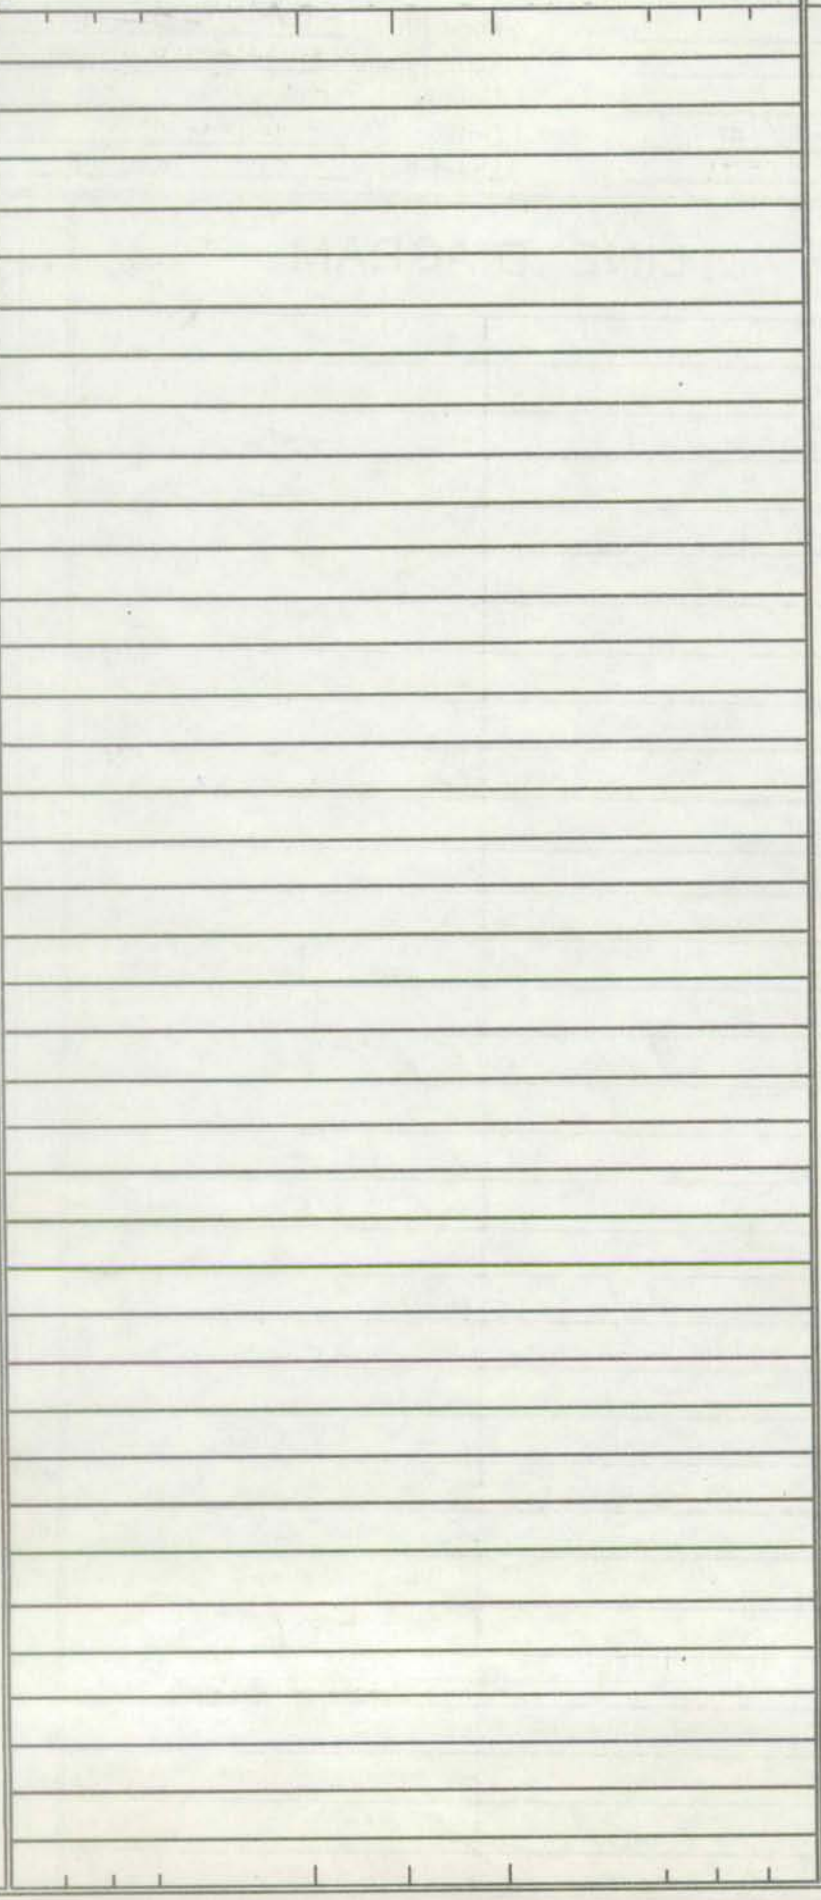

6r. Upper Marlboro Small Urban ~~Rural~~

SHA 51.3 - 8 Revised 4.83

MARYLAND STATE HIGHWAY ADMINISTRATION

ROAD INVENTORY SHEET CO 4909

~~87-EXTRA~~

88-121

89-137

Party Chief WB
Recorder CG
Assistant
Map No./Dir. G-12 / E
State Coordinates 868-358

Road No. OP 4631
Road Name COLONELS CHOICE
County P. G.
Date 2-5-88
Sheet No. 1 OF 1

TRAFFIC CODES
TRAFFIC CONTROLS: STOP SIGN=SS, TRAFFIC LIGHT=T.L., FLASHING RED BALL=F.R.

PARKING RESTRICTIONS: A.M. PEAK, P.M. PEAK, A.M./P.M. PEAK, NO PARKING ANYTIME=N.P., COMM/IND. ACCESS=E

SYSTEM				TRAFFIC		LINE DIAGRAM	TRAFFIC			PAVEMENT DATA
FED. AID.	FUNCT CLASS.	HWY. SYS.	HPMS SAMPLE	PRKG. REST.	COM/IND. ACCESS		CONTROL	COM/IND. ACCESS	PRKG. REST.	
	Rural Local				E	Col Ewell Ct. TO T.H. 0 39 — Col. DARNELL PL. CO 5125 90-212				
						0 37				
						0 35 PC				
						COL. DENTON CT. ENT. TO T.H. 0 32 — COL. CONTEE PL. CO 5033				
						COL. CLAGETT CT. ENT. TO T.H. 0 29				
						0 27				
						0 25 — COL. BEALL PL. CO 5035				
						COL. BROOKE CT. (PROPOSED) 0 22				
						0 19 — COL. ADDISON PL. CO 4949				
						COL. ASHTON PL. (PROPOSED) 0 16				
						PT 0 14				
						PC 0 27				34' I J C-C
						JOHN CO OF 0 00 — ROGERS BLVD 4864				

SYSTEM				TRAFFIC		LINE DIAGRAM	TRAFFIC			PAVEMENT DATA
FED. AID.	FUNCT. CLASS.	HWY. SYS.	HPMS SAMPLE	PRKG. REST.	COM/IND ACCESS		CONTROL	COM/IND ACCESS	PRKG. REST.	
						Gov.				
						~~Co.~~ ~~of~~ CO 0163				
						Grove ~~4632~~ 4974				
						0.33				
						Col Gardiner Ct.				
						0161				
						90-211				
						4900				
						CO				
						Col. Fenwick Pl.				34'I
						Co. 90-288 0148				JC-C
						5124				
						Rtn				
	Rural Local									

SHA 51.3 - 8 Revised
4.83

MARYLAND STATE HIGHWAY ADMINISTRATION

URBAN

ROAD INVENTORY SHEET C04910

Party Chief BB
Recorder TM
Assistant
Map No./Dir. H-11 / N
State Coordinates 840 - 321

Road No. OP 4601 ~~BE-1551~~
Road Name BREDEN CT
County PG
Date 3-19-87
Sheet No. 1 OF 1

88-149

SYSTEM				TRAFFIC		LINE DIAGRAM	TRAFFIC			PAVEMENT DATA
FED. AID.	FUNCT CLASS.	HWY. SYS.	HPMS SAMPLE	PRK.G. REST.	COM/IND. ACCESS		CONTROL	COM/IND. ACCESS	PRK.G. REST.	
						D E				
						CUL 0 08 SAC				
						APT 0 05				
						35°				
						P.C. 0 01				
										24'
										'J' C-C
						BELDING CT.				
						OP 0 00 4911 CO				

TRAFFIC CODES

TRAFFIC CONTROLS: STOP SIGN=SS, TRAFFIC LIGHT=T.L., FLASHING RED BALL=F.R.

TRAFFIC CODES

PARKING RESTRICTIONS: A.M. PEAK, P.M. PEAK, A.M./P.M. PEAK, NO PARKING ANYTIME=N.P., COMM/IND. ACCESS=E

SYSTEM				TRAFFIC		LINE DIAGRAM	TRAFFIC				PAVEMENT DATA
FED. AID.	FUNCT. CLASS.	HWY. SYS.	HPMS SAMPLE	PRK'G. REST.	COM/IND ACCESS		CONTROL	COM/IND ACCESS	PRK'G. REST.		

SHA 51.3 - 8 Revised
4.83

MARYLAND STATE HIGHWAY ADMINISTRATION

URBAN

ROAD INVENTORY SHEET CO 4911

Party Chief BB
Recorder TM.
Assistant
Map No./Dir. H 11 / NE
State Coordinates 840 - 321

Road No. ~~OP 4600~~ ~~8-180~~ 88-150
Road Name BELDING ct
County P.G.
Date 3-17-87
Sheet No. 1 OF 1

TRAFFIC CODES
TRAFFIC CONTROLS: STOP SIGN=S.S., TRAFFIC LIGHT=T.L., FLASHING RED BALL=F.R.

TRAFFIC CODES
PARKING RESTRICTIONS: A.M. PEAK, P.M. PEAK, A.M./P.M. PEAK, NO PARKING ANYTIME=N.P., COMM/IND. ACCESS=E

SYSTEM				TRAFFIC		LINE DIAGRAM	TRAFFIC			PAVEMENT DATA
FED. AID.	FUNCT CLASS.	HWY. SYS.	HPMS SAMPLE	PRKG. REST.	COM/IND. ACCESS		CONTROL	COM/IND. ACCESS	PRKG. REST.	
						D E				
						cul 0 16 SAC.				
						PT 0 13				
						50° Bredan ct.				
						~~OP 4601~~ CO 4910 0 05				
						P.C.				
										24' I
										"J" c-c
						HEATHER WICK Rd				
						~~OP CO 4577~~ 0 00 4825				

88-150

SYSTEM				TRAFFIC		LINE DIAGRAM	TRAFFIC			PAVEMENT DATA
FED. AID.	FUNCT. CLASS.	HWY. SYS.	HPMS SAMPLE	PRKG. REST.	COM/IND ACCESS		CONTROL	COM/IND ACCESS	PRKG. REST.	

SHA 51.3 - 8 Revised
4.83

MARYLAND STATE HIGHWAY ADMINISTRATION

URBAJ

ROAD INVENTORY SHEET CO 4912

Party Chief BB
Recorder TM
Assistant
Map No./Dir. H. 11 / S
State Coordinates 840-321

Road No. ~~OF 1548~~ ~~86 HO FRN~~
Road Name HEATHERWICK Ct
County PG
Date 3-17-87
Sheet No. 1 OF 1

88-151

TRAFFIC CODES
TRAFFIC CONTROLS: STOP SIGN=SS, TRAFFIC LIGHT=T.L., FLASHING RED BALL=F.R.

TRAFFIC CODES
PARKING RESTRICTIONS: A.M. PEAK, P.M. PEAK, A.M./P.M. PEAK, NO PARKING ANYTIME=N.P., COMM/IND. ACCESS=E

SYSTEM				TRAFFIC		LINE DIAGRAM	TRAFFIC			PAVEMENT DATA
FED. AID.	FUNCT. CLASS.	HWY. SYS.	HPMS SAMPLE	PRKG. REST.	COM/IND. ACCESS		CONTROL	COM/IND. ACCESS	PRKG. REST.	
						D E				
						Enl 0 19 SRC				
						0 07 P.T. 350				
						0 03 P.C.				24' I
						HEATHERWICK Rd				"J" C-C
						CO 0 00 ~~4549~~ 4825				

SYSTEM				TRAFFIC		LINE DIAGRAM	TRAFFIC				PAVEMENT DATA
FED. AID.	FUNCT. CLASS.	HWY. SYS.	HPMS SAMPLE	PRK.G. REST.	COM/IND ACCESS		CONTROL	COM/IND ACCESS	PRK.G. REST.		

SHA 51.3 - 8 Revised
4.83

MARYLAND STATE HIGHWAY ADMINISTRATION

URBAN

ROAD INVENTORY SHEET

CO 4913

Party Chief BB
Recorder TM
Assistant
Map No./Dir. H-11 / SW
State Coordinates 040-321

Road No. ~~CP~~ ~~4599~~ ~~100~~ 86 ~~=XTRA~~
Road Name RISON DR
County P.G.
Date 3-17-87
Sheet No. 1 OF

88-152

TRAFFIC CODES

TRAFFIC CONTROLS: STOP SIGN=SS, TRAFFIC LIGHT=T.L., FLASHING RED BALL=F.R.

TRAFFIC CODES

PARKING RESTRICTIONS: A.M. PEAK, P.M. PEAK, A.M./P.M. PEAK, NO PARKING ANYTIME=N.P., COMM/IND. ACCESS=E

SYSTEM				TRAFFIC		LINE DIAGRAM	TRAFFIC			PAVEMENT DATA
FED. AID.	FUNCT CLASS.	HWY. SYS.	HPMS SAMPLE	PRKG. REST.	COM/IND. ACCESS		CONTROL	COM/IND. ACCESS	PRKG. REST.	
						PROPOSED				
						ROAD 000 END				^
						HEATHERWICK Rd				24' I
										"I" L-C
						CO ~~CP~~ 0000 ~~4567~~ 4825				V

JRBAN

SYSTEM				TRAFFIC		LINE DIAGRAM	TRAFFIC				PAVEMENT DATA
FED. AID.	FUNCT. CLASS.	HWY. SYS.	HPMS SAMPLE	PRKG. REST.	COM/IND ACCESS		CONTROL	COM/IND ACCESS	PRKG. REST.		

SHA 51.3 - 8 Revised
4.83

MARYLAND STATE HIGHWAY ADMINISTRATION

URBAN

ROAD INVENTORY SHEET CO 4914

Party Chief BB
Recorder tm
Assistant
Map No./Dir. H-11 / W
State Coordinates 808-331

Road No. ~~OP 4543~~ ~~Co. 1611~~ X
Road Name PIONEER Ct.
County P.G.
Date 3-24-87
Sheet No. 1 OF 1

88-155

TRAFFIC CODES

TRAFFIC CONTROLS: STOP SIGN=SS, TRAFFIC LIGHT=T.L., FLASHING RED BALL=F.R.

PARKING RESTRICTIONS: A.M. PEAK, P.M. PEAK, A.M./P.M. PEAK, NO PARKING ANYTIME=N.P., COMM/IND. ACCESS=E

SYSTEM				TRAFFIC		LINE DIAGRAM	TRAFFIC			PAVEMENT DATA
FED. AID.	FUNCT. CLASS.	HWY. SYS.	HPMS SAMPLE	PRK.G. REST.	COM/IND. ACCESS		CONTROL	COM/IND. ACCESS	PRK.G. REST.	
						D E				
						cul 0 06 SHC				24' I
						VALLEY BROOK DR				"J" C-C
						~~OP~~ CO 0 00 ~~4587~~ 4830				

TRAFFIC CODES

SYSTEM				TRAFFIC		LINE DIAGRAM	TRAFFIC			PAVEMENT DATA
FED. AID.	FUNCT. CLASS.	HWY. SYS.	HPMS SAMPLE	PRK.G. REST.	COM/IND ACCESS		CONTROL	COM/IND ACCESS	PRK.G. REST.	

SHA 51.3 - 8 Revised
4.83

MARYLAND STATE HIGHWAY ADMINISTRATION

URBAN

ROAD INVENTORY SHEET

CO 4915

Party Chief BB
Recorder TM
Assistant
Map No./Dir. #11 / W
State Coordinates 808 - 331

Road No. ~~CO 4599~~ ~~8-164-X~~
Road Name WAGON WHEEL CT
County P.G.
Date 3-24-87
Sheet No. 1 OF 1

88-156

SYSTEM				TRAFFIC		LINE DIAGRAM	TRAFFIC			PAVEMENT DATA
FED. AID.	FUNCT CLASS.	HWY. SYS.	HPMS SAMPLE	PRKG. REST.	COM/IND. ACCESS		CONTROL	COM/IND. ACCESS	PRKG. REST.	

SYSTEM				TRAFFIC		LINE DIAGRAM	TRAFFIC				PAVEMENT DATA
FED. AID.	FUNCT. CLASS.	HWY. SYS.	HPMS SAMPLE	PRK.G. REST.	COM/IND ACCESS		CONTROL	COM/IND ACCESS	PRK.G. REST.		

SHA 51.3-8
11-15-72

STATE HIGHWAY ADMINISTRATION OF MARYLAND

96-182, 2 Co
BB/MA
2-26-97

88-9
3-28-
BB/M
DT/TT
2-2-95
94-10 EX

ROAD INVENTORY SHEET

CO 4916

Party Chief MZ
Recorder JE
Helper

Map No. ~~29~~ D
E11 D

Road No. ~~OP 693~~
Road Name KNOTT ST
Sheet No. 1 OF 1
Date 5-4-78
County PRINCE GEORGES
State Coordinates 823 - 444

		XXXX		
Rd	0	16	END	
			Heartwood DR	
ENT to PK	0	15	CO 5765	
~~ROAD~~	0	11	~~END~~	
H WANDERING OAK WAY	0	10		30'I
CO 5495	0	08		JCORT
H	0	07		2 UNL
				~~14'E~~
H	0	04	10°	~~20'EN~~
N. LINCOLN AV				24'I
CO 1881	0	00		
			ROBEY AV CO 1364	

N

SHA 51.3-8
11-15-72

ROAD INVENTORY SHEET

Road No. _____
Road Name _____
Sheet No. _____
Date _____
County _____
State Coordinates _____

SHA 51.3 - 8 Revised
4.83

MARYLAND STATE HIGHWAY ADMINISTRATION

ROAD INVENTORY SHEET

Party Chief BB
Recorder DW
Assistant
Map No./Dir. E11D / N
State Coordinates 835-455

Road No. CO 4917
Road Name (Park Center Dr)
County P.G
Date 3-28-89
Sheet No. 1 OF 1

88-6

SYSTEM				TRAFFIC		LINE DIAGRAM	TRAFFIC			PAVEMENT DATA
FED. AID.	FUNCT CLASS.	HWY. SYS.	HPMS SAMPLE	PRK.G. REST.	COM/IND. ACCESS		CONTROL	COM/IND. ACCESS	PRK.G. REST.	

D E
Cul 0 16 Sac

46'I
J-cc

Laurel Park Dr
CO 0 00 4381

TRAFFIC CODES

TRAFFIC CONTROLS: STOP SIGN=SS,
TRAFFIC LIGHT=T.L.,
FLASHING RED BALL=F.R.

TRAFFIC CODES

PARKING RESTRICTIONS: A.M. PEAK,
P.M. PEAK, A.M./P.M. PEAK, NO PARKING
ANYTIME=N.P., COMM/IND. ACCESS=E

SYSTEM				TRAFFIC		LINE DIAGRAM	TRAFFIC				PAVEMENT DATA
FED. AID.	FUNCT. CLASS.	HWY. SYS.	HPMS SAMPLE	PRKG. REST.	COM/IND ACCESS		CONTROL	COM/IND ACCESS	PRKG. REST.		

SHA 51.3 - 8 Revised
4.83

MARYLAND STATE HIGHWAY ADMINISTRATION

ROAD INVENTORY SHEET

88-12

Party Chief BB
Recorder DW
Assistant
Map No./Dir. F11A / S
State Coordinates 810-430

Road No. CO 4918
Road Name Trapper LN.
County P.G.
Date 3-28-89
Sheet No. 1 OF 1

SYSTEM: FED. AID. | FUNCT CLASS. | HWY. SYS. | HPMS SAMPLE
TRAFFIC: PRK.G. REST. | COM/IND. ACCESS

LINE DIAGRAM

TRAFFIC: CONTROL | COM/IND. ACCESS | PRK.G. REST.

PAVEMENT DATA

Buck Lodge Rd 0.35
CO 015 1331

26'I
J-CC

Buck Lodge Terr.
000 CO 3440

TRAFFIC CODES

TRAFFIC CONTROLS: STOP SIGN=SS, TRAFFIC LIGHT=T.L., FLASHING RED BALL=F.R.

TRAFFIC CODES

PARKING RESTRICTIONS: A.M. PEAK, P.M. PEAK, A.M./P.M. PEAK, NO PARKING ANYTIME=N.P., COMM/IND. ACCESS=E

SYSTEM				TRAFFIC		LINE DIAGRAM	TRAFFIC				PAVEMENT DATA
FED. AID.	FUNCT. CLASS.	HWY. SYS.	HPMS SAMPLE	PRKG. REST.	COM/IND ACCESS		CONTROL	COM/IND ACCESS	PRKG. REST.		

DT/TT
3-28-95
94-12

SHA 51.3 - 8 Revised
4.83

MARYLAND STATE HIGHWAY ADMINISTRATION

ROAD INVENTORY SHEET

Party Chief BB
Recorder DW
Assistant
Map No./Dir. F1A/S
State Coordinates 810-430

Road No. CO 4919
Road Name Trapper Ct
County P.G
Date 3-28-89
Sheet No. 1 OF 1

88-13

SYSTEM				TRAFFIC		LINE DIAGRAM	TRAFFIC			PAVEMENT DATA
FED. AID.	FUNCT. CLASS.	HWY. SYS.	HPMS SAMPLE	PRK.G. REST.	COM/IND. ACCESS		CONTROL	COM/IND. ACCESS	PRK.G. REST.	

D E
Cul 0 11 Soc

Buck Lodge Terr
CO 0 10 3440

AVE 1796
26th CO

26'I
J-cc

TRAFFIC CODES

TRAFFIC CONTROLS: STOP SIGN=SS, TRAFFIC LIGHT=T.L., FLASHING RED BALL=F.R.

TRAFFIC CODES

PARKING RESTRICTIONS: A.M. PEAK, P.M. PEAK, A.M./P.M. PEAK, NO PARKING ANYTIME=N.P., COMM/IND. ACCESS=E

SYSTEM				TRAFFIC		LINE DIAGRAM	TRAFFIC			PAVEMENT DATA
FED. AID.	FUNCT. CLASS.	HWY. SYS.	HPMS SAMPLE	PRK.G. REST.	COM/IND ACCESS		CONTROL	COM/IND ACCESS	PRK.G. REST.	

SHA 51.3 - 8 Revised
4.83

MARYLAND STATE HIGHWAY ADMINISTRATION

ROAD INVENTORY SHEET

Party Chief BB
Recorder DW
Assistant
Map No./Dir. FIID / S
State Coordinates 828-394

Road No. CO 4920
Road Name Clarkson Way
County P.G
Date 3-22-89
Sheet No. 1 OF 1

88-30

SYSTEM: FED. AID. | FUNCT. CLASS. | HWY. SYS. | HPMS SAMPLE
TRAFFIC: PRK.G. REST. | COM/IND. ACCESS

LINE DIAGRAM

TRAFFIC: CONTROL | COM/IND. ACCESS | PRK.G. REST.

PAVEMENT DATA

TRAFFIC CODES

TRAFFIC CONTROLS: STOP SIGN=SS, TRAFFIC LIGHT=T, L., FLASHING RED BALL=F.R.

TRAFFIC CODES

PARKING RESTRICTIONS: A.M. PEAK, P.M. PEAK, A.M./P.M. PEAK, NO PARKING ANYTIME=N.P., COMM/IND. ACCESS=E

E

E E

DE

Cul DE Sac

46'I

J-cc

Columbia Park Rd

CO 000 3668 SS

SYSTEM				TRAFFIC		LINE DIAGRAM	TRAFFIC				PAVEMENT DATA
FED. AID.	FUNCT. CLASS.	HWY. SYS.	HPMS SAMPLE	PRKG. REST.	COM/IND ACCESS		CONTROL	COM/IND ACCESS	PRKG. REST.		

SHA 51.3 - 8 Revised
4.83

MARYLAND STATE HIGHWAY ADMINISTRATION

ROAD INVENTORY SHEET

Party Chief BB
Recorder DS
Assistant
Map No./Dir. F12 / N
State Coordinates 860-420

Road No. CO 4921
Road Name Pam Pl
County P.G
Date 3-21-89
Sheet No. 1 OF 1

88-35

SYSTEM				TRAFFIC		LINE DIAGRAM	TRAFFIC			PAVEMENT DATA
FED. AID.	FUNCT CLASS.	HWY. SYS.	HPMS SAMPLE	PRKG. REST.	COM/IND. ACCESS		CONTROL	COM/IND. ACCESS	PRKG. REST.	

SYSTEM				TRAFFIC		LINE DIAGRAM	TRAFFIC				PAVEMENT DATA
FED. AID.	FUNCT. CLASS.	HWY. SYS.	HPMS SAMPLE	PRK.G. REST.	COM/IND ACCESS		CONTROL	COM/IND ACCESS	PRK.G. REST.		

SHA 51.3 - 8 Revised
4.83

MARYLAND STATE HIGHWAY ADMINISTRATION

95-51
BRANCH
3/11/96

ROAD INVENTORY SHEET

Party Chief JB
Recorder DW
Assistant
Map No./Dir. F12 / E
State Coordinates 865-418

Road No. C04922
Road Name Katrinka Dr
County P.G.
Date 3-21-89
Sheet No. 1 OF 1

88-38

SYSTEM				TRAFFIC		LINE DIAGRAM	TRAFFIC			PAVEMENT DATA
FED. AID.	FUNCT. CLASS.	HWY. SYS.	HPMS SAMPLE	PRKG. REST.	COM/IND. ACCESS		CONTROL	COM/IND. ACCESS	PRKG. REST.	
						DE				
						CUL 027 SAC				
						FANNON DR				
						CO 1889 017				
						PT 011				
						30°				
						PC 007				
						~~XX~~ ~~XX~~				
						~~Rd~~ 006 ~~END~~				
						Alexis Dr				26'I
						CO 000 2091				J-CC
										2UML

TRAFFIC CODES
TRAFFIC CONTROLS: STOP SIGN=SS, TRAFFIC LIGHT=T.L., FLASHING RED BALL=F.R.

TRAFFIC CODES
PARKING RESTRICTIONS: A.M. PEAK, P.M. PEAK, A.M./P.M. PEAK, NO PARKING ANYTIME=N.P., COMM/IND. ACCESS=E

SYSTEM				TRAFFIC		LINE DIAGRAM	TRAFFIC			PAVEMENT DATA
FED. AID.	FUNCT. CLASS.	HWY. SYS.	HPMS SAMPLE	PRK.G. REST.	COM/IND ACCESS		CONTROL	COM/IND ACCESS	PRK.G. REST.	

SHA 51.3 - 8 Revised
4.83

MARYLAND STATE HIGHWAY ADMINISTRATION

ROAD INVENTORY SHEET ~~OP 4652~~

Party Chief BB
Recorder DW
Assistant
Map No./Dir. F12 / W
State Coordinates 855-404

Road No. CO 4923
Road Name Sunflower Cir
County P.G
Date 3-16-89
Sheet No. 1 OF 2

88-42
89-47

TRAFFIC CODES
TRAFFIC CONTROLS: STOP SIGN=SS, TRAFFIC LIGHT=T.L., FLASHING RED BALL=F.R.

TRAFFIC CODES
PARKING RESTRICTIONS: A.M. PEAK, P.M. PEAK, A.M./P.M. PEAK, NO PARKING ANYTIME=N.P., COMM/IND. ACCESS=E

SYSTEM				TRAFFIC		LINE DIAGRAM	TRAFFIC			PAVEMENT DATA
FED. AID.	FUNCT CLASS.	HWY. SYS.	HPMS SAMPLE	PRK.G. REST.	COM/IND. ACCESS		CONTROL	COM/IND. ACCESS	PRK.G. REST.	
		~~OP 4652~~				0 63 PI				
										36'I
						Sunflower PI				J-CC
						0 46 CO 4924			X	
						0 44				
						Sunflower Ct 360°				
						~~OP 4654~~ 0 30 CO 4969				
										26'I
						Sunflower Terr				J-CC
						0 19 CO 4925			X	
		CO 4923								
						0 02 PC				36'I
						Hudee Dr				J-CC
						0 00 @ 116 CO 4613				
						Sunflower Cir. ~~OP 4652~~ CO 49 23 @ 165				

SYSTEM				TRAFFIC		LINE DIAGRAM	TRAFFIC			PAVEMENT DATA
FED. AID.	FUNCT. CLASS.	HWY. SYS.	HPMS SAMPLE	PRKG. REST.	COM/IND ACCESS		CONTROL	COM/IND ACCESS	PRKG. REST.	
						Sunflower Cir CO 4923 0.10 Hudee Dr 065 CO 4613				

SHA 51.3 - 8 Revised
4.83

MARYLAND STATE HIGHWAY ADMINISTRATION

ROAD INVENTORY SHEET ~~OP4653~~

Party Chief BB
Recorder DJ
Assistant
Map No./Dir. F12 / S
State Coordinates 851-405

Road No. C04924
Road Name Sunflower Pl
County P.G
Date 3-16-89
Sheet No. 1 OF 1

88-44
89-48

SYSTEM				TRAFFIC		LINE DIAGRAM	TRAFFIC			PAVEMENT DATA
FED. AID.	FUNCT CLASS.	HWY. SYS.	HPMS SAMPLE	PRKG. REST.	COM/IND. ACCESS		CONTROL	COM/IND. ACCESS	PRKG. REST.	
		X CO 4924								
						DE				
						Cul de Sac				
						001				26'I
						Sunflower 000 CIR	SS			J-CC
						CO 0.46 4923				

TRAFFIC CODES

TRAFFIC CONTROLS: STOP SIGN=SS, TRAFFIC LIGHT=T.L., FLASHING RED BALL=F.R.

TRAFFIC CODES

PARKING RESTRICTIONS: A.M. PEAK, P.M. PEAK, A.M./P.M. PEAK, NO PARKING ANYTIME=N.P., COMM/IND. ACCESS=E

SYSTEM				TRAFFIC		LINE DIAGRAM	TRAFFIC			PAVEMENT DATA
FED. AID.	FUNCT. CLASS.	HWY. SYS.	HPMS SAMPLE	PRKG. REST.	COM/IND ACCESS		CONTROL	COM/IND ACCESS	PRKG. REST.	

SHA 51.3 - 8 Revised
4.83

MARYLAND STATE HIGHWAY ADMINISTRATION

ROAD INVENTORY SHEET

Party Chief BB
Recorder DW
Assistant
Map No./Dir. F12 / NW
State Coordinates 851-405

Road No. C04925
Road Name Sunflower Terr
County P.G
Date 3-6-89
Sheet No. 1 OF 1

88.43

SYSTEM				TRAFFIC		LINE DIAGRAM	TRAFFIC			PAVEMENT DATA
FED. AID.	FUNCT CLASS.	HWY. SYS.	HPMS SAMPLE	PRKG. REST.	COM/IND. ACCESS		CONTROL	COM/IND. ACCESS	PRKG. REST.	

JE
Cul 005 Sac

1 Sunflower 000 Cir
CO 4923

SS

26'I
J-CC

TRAFFIC CODES

TRAFFIC CONTROLS: STOP SIGN=SS, TRAFFIC LIGHT=T.L., FLASHING RED BALL=F.R.

TRAFFIC CODES

PARKING RESTRICTIONS: A.M. PEAK, P.M. PEAK, A.M./P.M. PEAK, NO PARKING ANYTIME=N.P., COMM/IND. ACCESS=E

SYSTEM				TRAFFIC		LINE DIAGRAM	TRAFFIC			PAVEMENT DATA
FED. AID.	FUNCT. CLASS.	HWY. SYS.	HPMS SAMPLE	PRKG. REST.	COM/IND ACCESS		CONTROL	COM/IND ACCESS	PRKG. REST.	

94-10, 94-15
96-188 CO
88-53

SHA 51.3 - 8 Revised 4.83

MARYLAND STATE HIGHWAY ADMINISTRATION

ROAD INVENTORY SHEET

Party Chief: DT
Recorder: TT
Assistant:
Map No./Dir.: F12 / N
State Coordinates: 845-390

Road No.: CO 4926
Road Name: APOLLO DR
County: P.G.
Date: 12-1-94
Sheet No.: 1 OF 1

TRAFFIC CODES
TRAFFIC CONTROLS: STOP SIGN=SS, TRAFFIC LIGHT=T.L., FLASHING RED BALL=F.R.

TRAFFIC CODES
PARKING RESTRICTIONS: A.M. PEAK, P.M. PEAK, A.M./P.M. PEAK, NO PARKING ANYTIME=N.P., COMM/IND. ACCESS=E

SYSTEM				TRAFFIC		LINE DIAGRAM	TRAFFIC			PAVEMENT DATA
FED. AID.	FUNCT CLASS.	HWY. SYS.	HPMS SAMPLE	PRKG. REST.	COM/IND. ACCESS		CONTROL	COM/IND. ACCESS	PRKG. REST.	
	7			X		LOTTSFORD RD (PROP.)				
						0.39	SS		X	
						CO 64				
					E	0.34		E		
						0.29		E		
					E	0.27				
						MERCANTILE LA				
						0.22 CO 4801				
						0.20 PT				
						0.15				
						0.14 R=100'		E		
						0.06 PC				
						0.03 SPUR: 0.03/20' I, JC-C				50' I JC-C 4 ML
						ARENA DR				
						0.00	TL		X	
						CO 5342				
						LARGO CENTER DR CO 5410				

LOCAL URBAN

NO PARKING

NO PARKING

SYSTEM				TRAFFIC		LINE DIAGRAM	TRAFFIC			PAVEMENT DATA
FED. AID.	FUNCT. CLASS.	HWY. SYS.	HPMS SAMPLE	PRKG. REST.	COM/IND ACCESS		CONTROL	COM/IND ACCESS	PRKG. REST.	

SHA 51.3 - 8 Revised
4.83

MARYLAND STATE HIGHWAY ADMINISTRATION

ROAD INVENTORY SHEET

Party Chief BB
Recorder DW
Assistant
Map No./Dir. F12 KE
State Coordinates 851-391

Road No. CO 4927
Road Name River Oaks Terr.
County P.G
Date 3-16-89
Sheet No. 1 OF 1

88-51

SYSTEM: FED. AID. | FUNCT. CLASS. | HWY. SYS. | HPMS SAMPLE
TRAFFIC: PRK.G. REST. | COM/IND. ACCESS

LINE DIAGRAM

TRAFFIC: CONTROL | COM/IND. ACCESS | PRK.G. REST.

PAVEMENT DATA

D E
Cul 0 11 Sac

26 I
J.cc

1 Golf Course Dr
CO 0 00 3459

TRAFFIC CODES

TRAFFIC CONTROLS: STOP SIGN=SS, TRAFFIC LIGHT=T.L., FLASHING RED BALL=F.R.

TRAFFIC CODES

PARKING RESTRICTIONS: A.M. PEAK, P.M. PEAK, A.M./P.M. PEAK, NO PARKING ANYTIME=N.P., COMM/IND. ACCESS=E

SYSTEM				TRAFFIC		LINE DIAGRAM	TRAFFIC				PAVEMENT DATA
FED. AID.	FUNCT. CLASS.	HWY. SYS.	HPMS SAMPLE	PRK.G. REST.	COM/IND ACCESS		CONTROL	COM/IND ACCESS	PRK.G. REST.		

SHA 51.3 - 8 Revised
4.83

MARYLAND STATE HIGHWAY ADMINISTRATION

ROAD INVENTORY SHEET

Party Chief BB
Recorder DW
Assistant
Map No./Dir. G11B / SW
State Coordinates 545-350

Road No. CO 4928
Road Name Avis Dr
County P.G.
Date 3-16-89
Sheet No. 1 OF 2

88-60

SYSTEM: FED. AID. | FUNCT. CLASS. | HWY. SYS. | HPMS SAMPLE
TRAFFIC: PRKG. REST. | COM/IND. ACCESS

LINE DIAGRAM

TRAFFIC: CONTROL | COM/IND. ACCESS | PRKG. REST.

PAVEMENT DATA

PT 0 32
90°
PC 0 24

New Orchard PL 0.51
CO 0 22 4219 SS

Avis Ct
0 15 CO 4929

0 10 PT
45°
0 02 PC

Teakwood Dr
CO 0 00 4931 SS

26'I
J-CC

TRAFFIC CODES

TRAFFIC CONTROLS: STOP SIGN=SS, TRAFFIC LIGHT=T.L., FLASHING RED BALL=F.R.

TRAFFIC CODES

PARKING RESTRICTIONS: A.M. PEAK, P.M. PEAK, A.M./P.M. PEAK, NO PARKING ANYTIME=N.P., COMM/IND. ACCESS=E

SYSTEM				TRAFFIC		LINE DIAGRAM	TRAFFIC			PAVEMENT DATA
FED. AID.	FUNCT. CLASS.	HWY. SYS.	HPMS SAMPLE	PRKG. REST.	COM/IND ACCESS		CONTROL	COM/IND ACCESS	PRKG. REST.	
						New Orchard PI 0.84				
						CO 0.45 4219	55			
						30° 0.41				
										26'I J-CC

SHA 51.3 - 8 Revised
4.83

MARYLAND STATE HIGHWAY ADMINISTRATION

ROAD INVENTORY SHEET

Party Chief BB
Recorder DW
Assistant
Map No./Dir. G11B / W
State Coordinates 845-381

Road No. CO 4929
Road Name AVIS CT
County P.G.
Date 3-16-89
Sheet No. 1 OF 1

88-59

SYSTEM				TRAFFIC		LINE DIAGRAM	TRAFFIC			PAVEMENT DATA
FED. AID.	FUNCT CLASS.	HWY. SYS.	HPMS SAMPLE	PRK.G. REST.	COM/IND. ACCESS		CONTROL	COM/IND. ACCESS	PRK.G. REST.	
						DE				
						Cul 004 Sac				
						AVIS DR				26' I
						CO 000 4928	55			W-CC

TRAFFIC CODES

TRAFFIC CONTROLS: STOP SIGN=SS, TRAFFIC LIGHT=T.L., FLASHING RED BALL=F.R.

TRAFFIC CODES

PARKING RESTRICTIONS: A.M. PEAK, P.M. PEAK, A.M./P.M. PEAK, NO PARKING ANYTIME=N.P., COMM/IND. ACCESS=E

SYSTEM				TRAFFIC		LINE DIAGRAM	TRAFFIC			PAVEMENT DATA
FED. AID.	FUNCT. CLASS.	HWY. SYS.	HPMS SAMPLE	PRK.G. REST.	COM/IND ACCESS		CONTROL	COM/IND ACCESS	PRK.G. REST.	

SHA 51.3 - 8 Revised
4.83

MARYLAND STATE HIGHWAY ADMINISTRATION

ROAD INVENTORY SHEET

Party Chief BB
Recorder DA
Assistant
Map No./Dir. GIIB / N
State Coordinates 845-381

Road No. CO 4930
Road Name Castlewood PL
County P.G.
Date 3-16-89
Sheet No. 1 OF 1

88-63,68

TRAFFIC CODES
TRAFFIC CONTROLS: STOP SIGN=SS, TRAFFIC LIGHT=T.L., FLASHING RED BALL=F.R.

TRAFFIC CODES
PARKING RESTRICTIONS: A.M. PEAK, P.M. PEAK, A.M./P.M. PEAK, NO PARKING ANYTIME=N.P., COMM/IND. ACCESS=E

SYSTEM				TRAFFIC		LINE DIAGRAM	TRAFFIC			PAVEMENT DATA
FED. AID.	FUNCT CLASS.	HWY. SYS.	HPMS SAMPLE	PRKG. REST.	COM/IND. ACCESS		CONTROL	COM/IND. ACCESS	PRKG. REST.	
						D E Cul 0 32 Sac				26'I 1-CC
						Teakwood Dr 0 25 CO 4931				
						Castlewood Dr CO 4213 0 13				36'I 1-CC
						New Orchard Pl CO 0 00 4219	SS			

SYSTEM				TRAFFIC		LINE DIAGRAM	TRAFFIC			PAVEMENT DATA
FED. AID.	FUNCT. CLASS.	HWY. SYS.	HPMS SAMPLE	PRK.G. REST.	COM/IND ACCESS		CONTROL	COM/IND ACCESS	PRK.G. REST.	

SHA 51.3 - 8 Revised
4.83

MARYLAND STATE HIGHWAY ADMINISTRATION

ROAD INVENTORY SHEET

Party Chief BB
Recorder DW
Assistant
Map No./Dir. G11B / NW
State Coordinates 845-381

Road No. CO 4931
Road Name Teakwood Dr
County P.G.
Date 3-16-89
Sheet No. 1 OF 1

88-57

SYSTEM: FED. AID. | FUNCT CLASS. | HWY. SYS. | HPMS SAMPLE
TRAFFIC: PRKG. REST. | COM/IND. ACCESS

LINE DIAGRAM

TRAFFIC: CONTROL | COM/IND. ACCESS | PRKG. REST.

PAVEMENT DATA

Castlewood — PI
CO — 026 — 4930 — SS

023 — PT
35
019 — PC

Ans Dr
CO 4928 — 016

26'I
J-CC

New — Orchard PI
CO — 000 — 4219

TRAFFIC CODES

TRAFFIC CONTROLS: STOP SIGN=SS, TRAFFIC LIGHT=T.L., FLASHING RED BALL=F.R.

TRAFFIC CODES

PARKING RESTRICTIONS: A.M. PEAK, P.M. PEAK, A.M./P.M. PEAK, NO PARKING ANYTIME=N.P., COMM/IND. ACCESS=E

SYSTEM				TRAFFIC		LINE DIAGRAM	TRAFFIC			PAVEMENT DATA
FED. AID.	FUNCT. CLASS.	HWY. SYS.	HPMS SAMPLE	PRK.G. REST.	COM/IND ACCESS		CONTROL	COM/IND ACCESS	PRK.G. REST.	

SHA 51.3 - 8 Revised
4.83

MARYLAND STATE HIGHWAY ADMINISTRATION

ROAD INVENTORY SHEET

88-71

Party Chief BB
Recorder DW
Assistant
Map No./Dir. GIIC / W
State Coordinates 800-338

Road No. CO 4932
Road Name Branchview Ct
County P.G.
Date 3-13-89
Sheet No. 1 OF 1

SYSTEM: FED. AID. | FUNCT. CLASS. | HWY. SYS. | HPMS SAMPLE
TRAFFIC: PRKG. REST. | COM/IND. ACCESS

LINE DIAGRAM

TRAFFIC: CONTROL | COM/IND. ACCESS | PRKG. REST.

PAVEMENT DATA

D E
Cul 008 Sac

Branchview Dr
CO 000 4072

26' I
J-cc

TRAFFIC CODES

TRAFFIC CONTROLS: STOP SIGN=SS, TRAFFIC LIGHT=T.L., FLASHING RED BALL=F.R.

TRAFFIC CODES

PARKING RESTRICTIONS: A.M. PEAK, P.M. PEAK, A.M./P.M. PEAK, NO PARKING ANYTIME=N.P., COMM/IND. ACCESS=E

SYSTEM				TRAFFIC		LINE DIAGRAM	TRAFFIC				PAVEMENT DATA
FED. AID.	FUNCT. CLASS.	HWY. SYS.	HPMS SAMPLE	PRK.G. REST.	COM/IND ACCESS		CONTROL	COM/IND ACCESS	PRK.G. REST.		

124-47-was OP 4659

98-102, 103
G.O. E.F.
2-8-99

SHA 51.3 - 8 Revised
4.83

MARYLAND STATE HIGHWAY ADMINISTRATION

ROAD INVENTORY SHEET ~~OP 4659~~

89-73.

88-78

Party Chief DB
Recorder DW
Assistant
Map No./Dir. G11C/S
State Coordinates 797-338

Road No. CO 4933
Road Name Traverse Way
County P.G
Date 3-13-89
Sheet No. 1 OF 2

TRAFFIC CODES
TRAFFIC CONTROLS: STOP SIGN=SS, TRAFFIC LIGHT=T.L., FLASHING RED BALL=F.R.

TRAFFIC CODES
PARKING RESTRICTIONS: A.M. PEAK, P.M. PEAK, A.M./P.M. PEAK, NO PARKING ANYTIME=N.P., COMM/IND. ACCESS=E

SYSTEM				TRAFFIC		LINE DIAGRAM	TRAFFIC			PAVEMENT DATA
FED. AID.	FUNCT CLASS.	HWY. SYS.	HPMS SAMPLE	PRKG. REST.	COM/IND. ACCESS		CONTROL	COM/IND. ACCESS	PRKG. REST.	
						0 24				
						Eagle Head Dr CO 4934 0 20 @.00				
						PT 0 18 ↑ 40°				
						PC 0 14				
						0 10 30° ↑				
						Eagle Head Dr CO1 0 06 4934 @.26				
										36'I J-CC
						1 Fort Foote Rd Co 0 00 88	55			
						↑ Messina 0 44 S				

N/A
Urban Local

SYSTEM: FED. AID. | FUNCT. CLASS. | HWY. SYS. | HPMS SAMPLE

TRAFFIC: PRKG. REST. | COM/IND ACCESS

LINE DIAGRAM

TRAFFIC: CONTROL | COM/IND ACCESS | PRKG. REST.

PAVEMENT DATA

DE

CUL 067 Sac

PT 065

90°

PC 062

Highland View

CO 5958 060

26'I
JC-C
2UML

EDGEwater TERR

CO 054 (5957) @.08

26'I

Road 047 END

Pelican Garth

~~DE~~ Co 043 ~~4987~~ 4986

@.09

36'I
JC-C
2UML

NON FIA
Urban Local
SP 46 SG

SHA 51.3 - 8 Revised
4.83

MARYLAND STATE HIGHWAY ADMINISTRATION

ROAD INVENTORY SHEET

Party Chief BB
Recorder DW
Assistant
Map No./Dir. G11C/ENE
State Coordinates 797-338

Road No. CO 4934
Road Name Eagle Head Dr
County P.G.
Date 3-13-89
Sheet No. 1 OF 2

88-77

SYSTEM: FED. AID. | FUNCT CLASS. | HWY. SYS. | HPMS SAMPLE
TRAFFIC: PRK.G. REST. | COM/IND. ACCESS

LINE DIAGRAM

0|33 PT
80°
0|29 PC
Traverse @ .06 Way
CO 0|26 4933
0|20 70°
0|15 PT
120°
0|03 PC
Traverse @ .80 Way
CO 0|00 4933

TRAFFIC: CONTROL | COM/IND. ACCESS | PRK.G. REST.

55

PAVEMENT DATA

26'I
J-CC

TRAFFIC CODES
TRAFFIC CONTROLS: STOP SIGN=SS, TRAFFIC LIGHT=T.L., FLASHING RED BALL=F.R.

TRAFFIC CODES
PARKING RESTRICTIONS: A.M. PEAK, P.M. PEAK, A.M./P.M. PEAK, NO PARKING ANYTIME=N.P., COMM/IND. ACCESS=E

SYSTEM				TRAFFIC		LINE DIAGRAM	TRAFFIC			PAVEMENT DATA
FED. AID.	FUNCT. CLASS.	HWY. SYS.	HPMS SAMPLE	PRKG. REST.	COM/IND ACCESS		CONTROL	COM/IND ACCESS	PRKG. REST.	

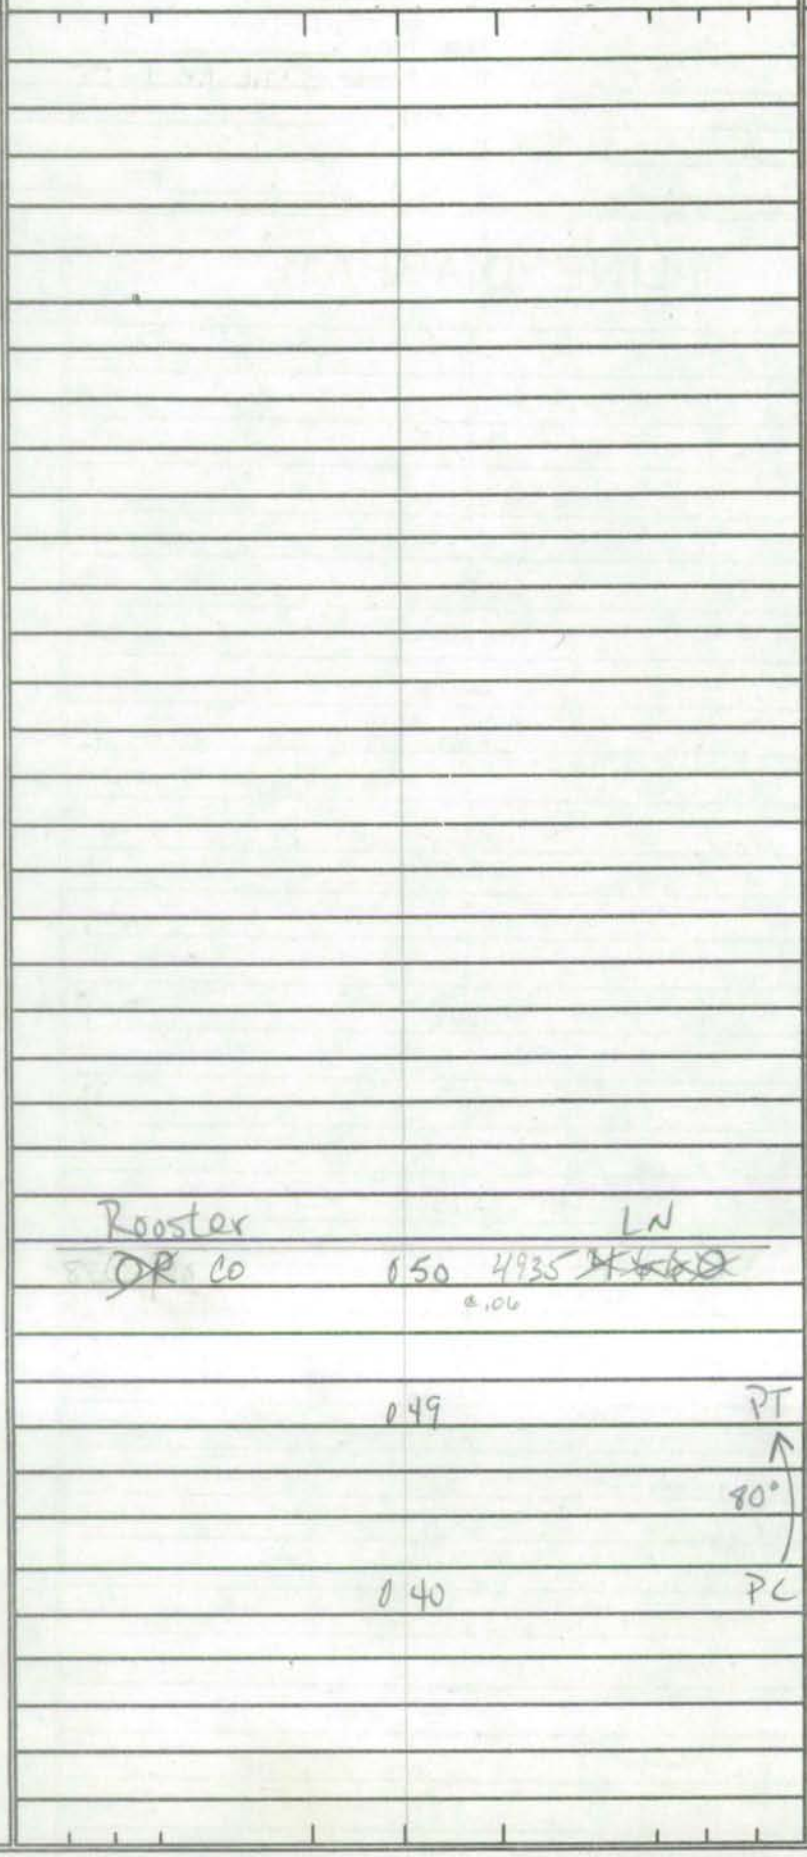

SHA 51.3 - 8 Revised
4.83

MARYLAND STATE HIGHWAY ADMINISTRATION

ROAD INVENTORY SHEET

~~CO 4760~~

Party Chief BB
Recorder DW
Assistant
Map No./Dir. G11 C/S
State Coordinates 797-338

Road No. CO 4935
Road Name Booster Ln
County P.G
Date 3-13-89
Sheet No. 1 OF 1

88-79/80

89-74

TRAFFIC CODES
TRAFFIC CONTROLS: STOP SIGN=SS, TRAFFIC LIGHT=T.L., FLASHING RED BALL=F.R.

TRAFFIC CODES
PARKING RESTRICTIONS: A.M. PEAK, P.M. PEAK, A.M./P.M. PEAK, NO PARKING ANYTIME=N.P., COMM/IND. ACCESS=E

SYSTEM				TRAFFIC		LINE DIAGRAM	TRAFFIC			PAVEMENT DATA
FED. AID.	FUNCT. CLASS.	HWY. SYS.	HPMS SAMPLE	PRK.G. REST.	COM/IND. ACCESS		CONTROL	COM/IND. ACCESS	PRK.G. REST.	
						D E				
						Cul 0 19 Sac				
						PT 0 17				
						45° 0 16				
						PC 0 15				
						0 10				
						Eagle Head Dr				
						0 06 @.50 CO 4934				
						0 03				
										26'I
										J-CC
						Cul 0 00 Sac				
						D E				

NON F/A Urban Local

CO 4935

SYSTEM				TRAFFIC		LINE DIAGRAM	TRAFFIC				PAVEMENT DATA
FED. AID.	FUNCT. CLASS.	HWY. SYS.	HPMS SAMPLE	PRK.G. REST.	COM/IND ACCESS		CONTROL	COM/IND ACCESS	PRK.G. REST.		

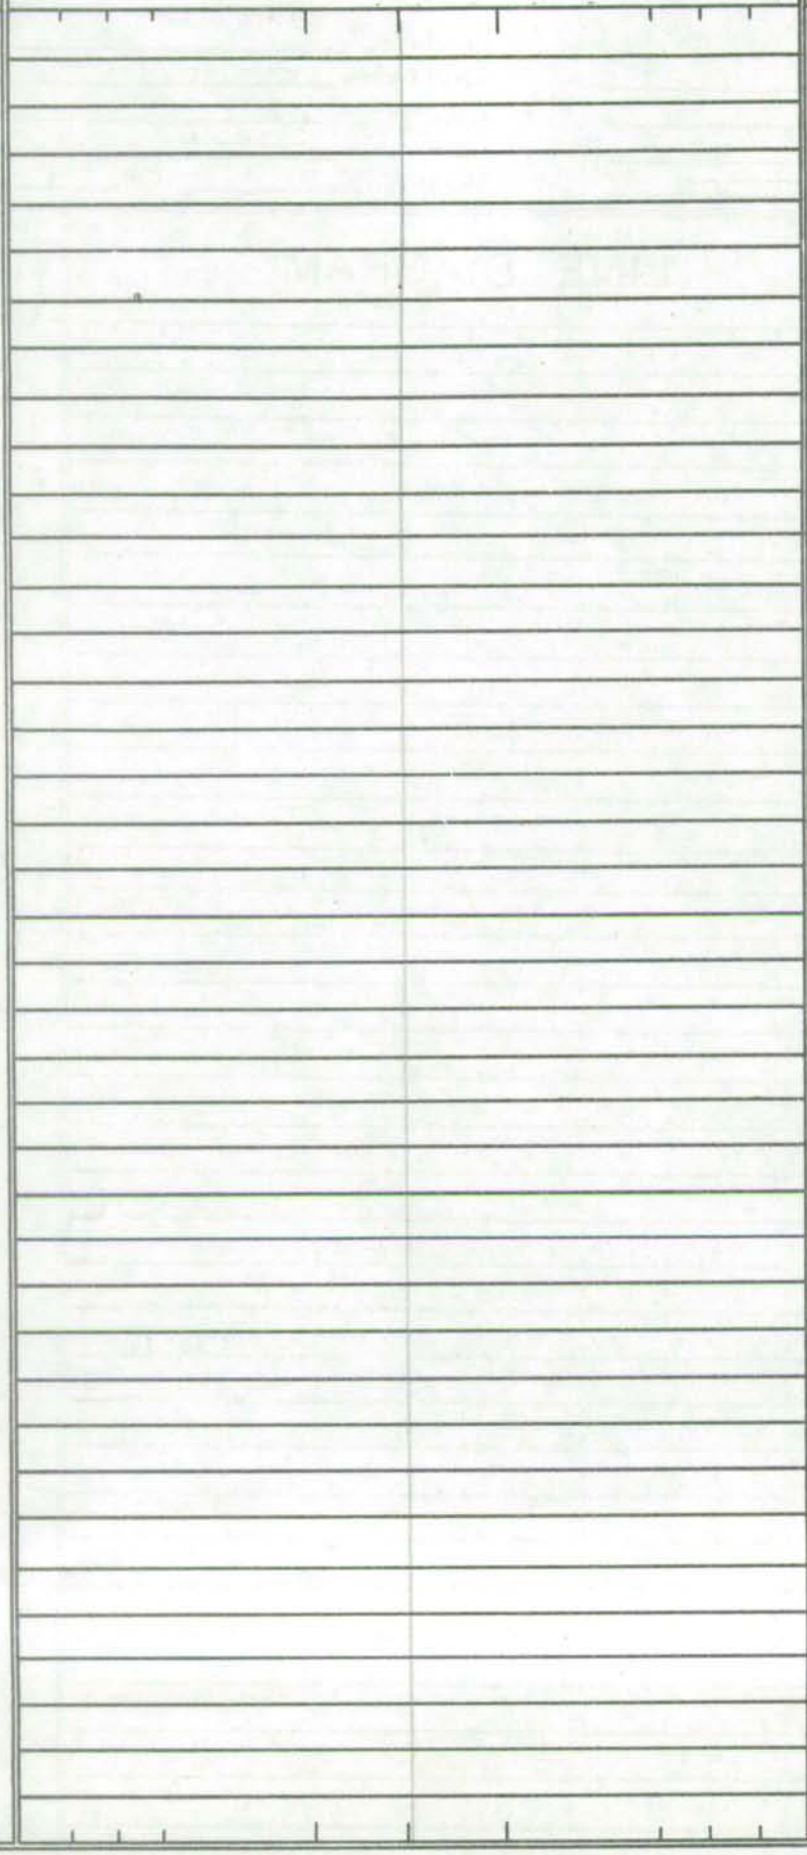

98-12
11/19/98
SS/SR/BD

SHA 51.3 - 8 Revised
4.83

MARYLAND STATE HIGHWAY ADMINISTRATION

ROAD INVENTORY SHEET

88-109

Party Chief BB
Recorder DW
Assistant
Map No./Dir. G11 D / SW
State Coordinates 820-348

Road No. CO 4936
Road Name Webster Pl
County P.G.
Date 3-14-89
Sheet No. 1 OF 1

SYSTEM				TRAFFIC		LINE DIAGRAM	TRAFFIC			PAVEMENT DATA
FED. AID.	FUNCT CLASS.	HWY. SYS.	HPMS SAMPLE	PRKG. REST.	COM/IND. ACCESS		CONTROL	COM/IND. ACCESS	PRKG. REST.	
						CO 2162 XX XX Rd 017 END				
						Webster Turn 007 CO 4937				
						Webster LN CO 000 568	SS			24ML 26'I J-CC

TRAFFIC CODES

TRAFFIC CONTROLS: STOP SIGN=SS, TRAFFIC LIGHT=T.L., FLASHING RED BALL=F.R.

TRAFFIC CODES

PARKING RESTRICTIONS: A.M. PEAK, P.M. PEAK, A.M./P.M. PEAK, NO PARKING ANYTIME=N.P., COMM/IND. ACCESS=E

SYSTEM				TRAFFIC		LINE DIAGRAM	TRAFFIC			PAVEMENT DATA
FED. AID.	FUNCT. CLASS.	HWY. SYS.	HPMS SAMPLE	PRKG. REST.	COM/IND ACCESS		CONTROL	COM/IND ACCESS	PRKG. REST.	

SHA 51.3 - 8 Revised
4.83

MARYLAND STATE HIGHWAY ADMINISTRATION

ROAD INVENTORY SHEET

88-108

Party Chief BB
Recorder DW
Assistant
Map No./Dir. G11D/NW
State Coordinates 818-348

Road No. CO 4937
Road Name Webster Turn
County PG
Date 3-14-89
Sheet No. 1 OF 1

SYSTEM: FED. AID. | FUNCT CLASS. | HWY. SYS. | HPMS SAMPLE
TRAFFIC: PRKG. REST. | COM/IND. ACCESS

LINE DIAGRAM

TRAFFIC: CONTROL | COM/IND. ACCESS | PRKG. REST.

PAVEMENT DATA

TRAFFIC CODES
TRAFFIC CONTROLS: STOP SIGN=SS, TRAFFIC LIGHT=T.L., FLASHING RED BALL=F.R.

TRAFFIC CODES
PARKING RESTRICTIONS: A.M. PEAK, P.M. PEAK, A.M./P.M. PEAK, NO PARKING ANYTIME=N.P., COMM/IND. ACCESS=E

XX XX
Rd 0 15 END

0 11 PT

90°

0 04 PC

26' I
2-CC

Webster PI
CO 0 00 4936 SS

SYSTEM				TRAFFIC		LINE DIAGRAM	TRAFFIC			PAVEMENT DATA
FED. AID.	FUNCT. CLASS.	HWY. SYS.	HPMS SAMPLE	PRKG. REST.	COM/IND ACCESS		CONTROL	COM/IND ACCESS	PRKG. REST.	

SHA 51.3 - 8 Revised
4.83

MARYLAND STATE HIGHWAY ADMINISTRATION

ROAD INVENTORY SHEET

Party Chief BB
Recorder DW
Assistant
Map No./Dir. G11D/N
State Coordinates 829-346

Road No. CO 4938
Road Name Colchester Dr
County P.G.
Date 3-14-89
Sheet No. 1 OF 1

88-95

SYSTEM: FED. AID. | FUNCT CLASS. | HWY. SYS. | HPMS SAMPLE
TRAFFIC: PRKG. REST. | COM/IND. ACCESS

LINE DIAGRAM

TRAFFIC: CONTROL | COM/IND. ACCESS | PRKG. REST.

PAVEMENT DATA

xxxx
Rd 002 END

26'I
J-CC

Arbutus LN
1 CO 000 3605

TRAFFIC CODES

TRAFFIC CONTROLS: STOP SIGN=SS, TRAFFIC LIGHT=T.L., FLASHING RED BALL=F.R.

TRAFFIC CODES

PARKING RESTRICTIONS: A.M. PEAK, P.M. PEAK, A.M./P.M. PEAK, NO PARKING ANYTIME=N.P., COMM/IND. ACCESS=E

SYSTEM				TRAFFIC		LINE DIAGRAM	TRAFFIC				PAVEMENT DATA
FED. AID.	FUNCT. CLASS.	HWY. SYS.	HPMS SAMPLE	PRKG. REST.	COM/IND ACCESS		CONTROL	COM/IND ACCESS	PRKG. REST.		

SHA 51.3-8
11-15-72

STATE HIGHWAY ADMINISTRATION OF MARYLAND

87-126
WB/GG
2-17-86

ROAD INVENTORY SHEET

CO 4939
~~4387~~

88-91
A/T
3-14-89
3B Dw

Party Chief JE
Recorder CM
Helper

Road No. ~~OP~~ 4387
Road Name MIKE SHAPIRO DR
Sheet No. 1 OF 1
Date OCT 14, 1982
County Prince Georges
State Coordinates 834-341

Map No. ~~35D~~ G11D

81-XTRA

	ROAD	END
	0.35	
↑ 15°	0.32	
	0.30 BRANCHWOOD DR. (87-126) CO 4866	
ENT TO SHOPPING CENTER	0.24	
ENT TO SHOPPING CENER	0.15	
	0.06 SHIELA LA. ENT. TO T-H	
ENT TO SHOPPING CENTER	0.03	
Md	0.00	223 TL

N

87-126

52 'I
JC-C

SIMPSON LA
AB 2-23-89
3 9 2 3

SHA 51.3-8
11-15-72

ROAD INVENTORY SHEET

Road No. _____
Road Name _____
Sheet No. _____
Date _____
County _____
State Coordinates _____

SHA 51.3 - 8 Revised
4.83

MARYLAND STATE HIGHWAY ADMINISTRATION

ROAD INVENTORY SHEET

Party Chief BB
Recorder DW
Assistant
Map No./Dir. G11D / N
State Coordinates 542-340

Road No. CO 4940
Road Name Dangerfield Ct
County P.G.
Date 3-14-89
Sheet No. 1 OF 1

88-87

SYSTEM: FED. AID. | FUNCT CLASS. | HWY. SYS. | HPMS SAMPLE
TRAFFIC: PRKG. REST. | COM/IND. ACCESS

LINE DIAGRAM

TRAFFIC: CONTROL | COM/IND. ACCESS | PRKG. REST.

PAVEMENT DATA

D E
Cul 003 Sac

Dangerfield PL
ICO 000 1181

26'I
J-CC

TRAFFIC CODES

TRAFFIC CONTROLS: STOP SIGN=SS, TRAFFIC LIGHT=T.L., FLASHING RED BALL=F.R.

TRAFFIC CODES

PARKING RESTRICTIONS: A.M. PEAK, P.M. PEAK, A.M./P.M. PEAK, NO PARKING ANYTIME=N.P., COMM/IND. ACCESS=E

SYSTEM				TRAFFIC		LINE DIAGRAM	TRAFFIC			PAVEMENT DATA
FED. AID.	FUNCT. CLASS.	HWY. SYS.	HPMS SAMPLE	PRK.G. REST.	COM/IND ACCESS		CONTROL	COM/IND ACCESS	PRK.G. REST.	

SHA 51.3 - 8 Revised
4.83

MARYLAND STATE HIGHWAY ADMINISTRATION

ROAD INVENTORY SHEET

Party Chief RR
Recorder HW
Assistant
Map No./Dir. 6117 / N
State Coordinates 842-340

Road No. CO 4941
Road Name Delphi Dr
County P.G.
Date 3-14-89
Sheet No. 1 OF 1

88-88

SYSTEM				TRAFFIC		LINE DIAGRAM	TRAFFIC			PAVEMENT DATA
FED. AID.	FUNCT. CLASS.	HWY. SYS.	HPMS SAMPLE	PRKG. REST.	COM/IND. ACCESS		CONTROL	COM/IND. ACCESS	PRKG. REST.	
						XX XX				
						Road 010 END				
						Francesca Dr				
						CO 4942 005				
										36'I
						Dangerfield PL				J-CC
						CO 000 1181				

TRAFFIC CODES

TRAFFIC CONTROLS: STOP SIGN=SS, TRAFFIC LIGHT=T.L., FLASHING RED BALL=F.R.

TRAFFIC CODES

PARKING RESTRICTIONS: A.M. PEAK, P.M. PEAK, A.M./P.M. PEAK, NO PARKING ANYTIME=N.P., COMM/IND. ACCESS=E

SYSTEM				TRAFFIC		LINE DIAGRAM	TRAFFIC			PAVEMENT DATA
FED. AID.	FUNCT. CLASS.	HWY. SYS.	HPMS SAMPLE	PRK'G. REST.	COM/IND ACCESS		CONTROL	COM/IND ACCESS	PRK'G. REST.	

SHA 51.3 - 8 Revised
4.83

MARYLAND STATE HIGHWAY ADMINISTRATION

ROAD INVENTORY SHEET

88-86

Party Chief BB
Recorder DW
Assistant
Map No./Dir. 6-11 D / W
State Coordinates 841-341

Road No. CO 4942
Road Name Francesca Dr
County P.G.
Date 3-14-89
Sheet No. 1 OF 1

TRAFFIC CODES
TRAFFIC CONTROLS: STOP SIGN=SS, TRAFFIC LIGHT=T.L., FLASHING RED BALL=F.R.

TRAFFIC CODES
PARKING RESTRICTIONS: A.M. PEAK, P.M. PEAK, A.M./P.M. PEAK, NO PARKING ANYTIME=N.P., COMM/IND. ACCESS=E

SYSTEM				TRAFFIC		LINE DIAGRAM	TRAFFIC			PAVEMENT DATA
FED. AID.	FUNCT CLASS.	HWY. SYS.	HPMS SAMPLE	PRK.G. REST.	COM/IND. ACCESS		CONTROL	COM/IND. ACCESS	PRK.G. REST.	
						XX XX				
						Road 0 09 END				
						Francesca Ct				
						0 07 CO 4943				
										26 I
						Delphi Dr				J-CC
						CO 0 00 4941				

SYSTEM				TRAFFIC		LINE DIAGRAM	TRAFFIC			PAVEMENT DATA
FED. AID.	FUNCT. CLASS.	HWY. SYS.	HPMS SAMPLE	PRK'G. REST.	COM/IND ACCESS		CONTROL	COM/IND ACCESS	PRK'G. REST.	

SHA 51.3 - 8 Revised
4.83

MARYLAND STATE HIGHWAY ADMINISTRATION

ROAD INVENTORY SHEET

Party Chief BB
Recorder DW
Assistant
Map No./Dir. GIID/N
State Coordinates 841-341

Road No. CO 4943
Road Name Francesca Ct
County P.G
Date 3-14-89
Sheet No. 1 OF 1

88-85

SYSTEM: FED. AID. | FUNCT CLASS. | HWY. SYS. | HPMS SAMPLE
TRAFFIC: PRK.G. REST. | COM/IND. ACCESS

LINE DIAGRAM

TRAFFIC: CONTROL | COM/IND. ACCESS | PRK.G. REST.

PAVEMENT DATA

D E
CW 006 Sac

Francesca Dr
CO 000 4942

26'I
J-CC

TRAFFIC CODES

TRAFFIC CONTROLS: STOP SIGN=SS, TRAFFIC LIGHT=T.L., FLASHING RED BALL=F.R.

TRAFFIC CODES

PARKING RESTRICTIONS: A.M. PEAK, P.M. PEAK, A.M./P.M. PEAK, NO PARKING ANYTIME=N.P., COMM/IND. ACCESS=E

SYSTEM				TRAFFIC		LINE DIAGRAM	TRAFFIC				PAVEMENT DATA
FED. AID.	FUNCT. CLASS.	HWY. SYS.	HPMS SAMPLE	PRK.G. REST.	COM/IND ACCESS		CONTROL	COM/IND ACCESS	PRK.G. REST.		

SHA 51.3 - 8 Revised
4.83

MARYLAND STATE HIGHWAY ADMINISTRATION

ROAD INVENTORY SHEET

Party Chief BB
Recorder ZW
Assistant
Map No./Dir. G11D / N
State Coordinates 845 - 353

Road No. CO 4944
Road Name Fallard Dr
County P.G
Date 3-14-89
Sheet No. 1 OF 1

88-83

SYSTEM				TRAFFIC		LINE DIAGRAM	TRAFFIC			PAVEMENT DATA
FED. AID.	FUNCT CLASS.	HWY. SYS.	HPMS SAMPLE	PRKG. REST.	COM/IND. ACCESS		CONTROL	COM/IND. ACCESS	PRKG. REST.	
						XX XX				
						Rd. 031 END				
						(Fallard Ct)				
						029 CO 4945				
						FALLARD TERR				
						019 CO 5527				
						006 PT				
						45°				
						002 PC				46'I
						House Rd				J-CC
						1 Dower 000 92	55			ZUML
						CO				

TRAFFIC CODES
TRAFFIC CONTROLS: STOP SIGN=SS, TRAFFIC LIGHT=T.L., FLASHING RED BALL=F.R.

TRAFFIC CODES
PARKING RESTRICTIONS: A.M. PEAK, P.M. PEAK, A.M./P.M. PEAK, NO PARKING ANYTIME=N.P., COMM/IND. ACCESS=E

SYSTEM				TRAFFIC		LINE DIAGRAM	TRAFFIC			PAVEMENT DATA
FED. AID.	FUNCT. CLASS.	HWY. SYS.	HPMS SAMPLE	PRK.G. REST.	COM/IND ACCESS		CONTROL	COM/IND ACCESS	PRK.G. REST.	

96-95 Co
BB/MG
3-19-97

SHA 51.3 - 8 Revised
4.83

MARYLAND STATE HIGHWAY ADMINISTRATION

ROAD INVENTORY SHEET

88-84

Party Chief BB
Recorder DW
Assistant
Map No./Dir. G11D / E
State Coordinates 845-354

Road No. CO 4945
Road Name Fallard Ct
County P.G.
Date 3-14-89
Sheet No. 1 OF 1

SYSTEM: FED. AID. | FUNCT. CLASS. | HWY. SYS. | HPMS SAMPLE
TRAFFIC: PRKG. REST. | COM/IND. ACCESS

LINE DIAGRAM

TRAFFIC: CONTROL | COM/IND. ACCESS | PRKG. REST.
PAVEMENT DATA

d e
cul 017 sac

E 015

013 E

010 E

E 005

~~Rd 004 END~~

E 003

Fallard Dr
CO 000 4944

46'
J-CC
2 UML

TRAFFIC CODES
TRAFFIC CONTROLS: STOP SIGN=SS, TRAFFIC LIGHT=T.L., FLASHING RED BALL=F.R.

TRAFFIC CODES
PARKING RESTRICTIONS: A.M. PEAK, P.M. PEAK, A.M./P.M. PEAK, NO PARKING ANYTIME=N.P., COMM/IND. ACCESS=E

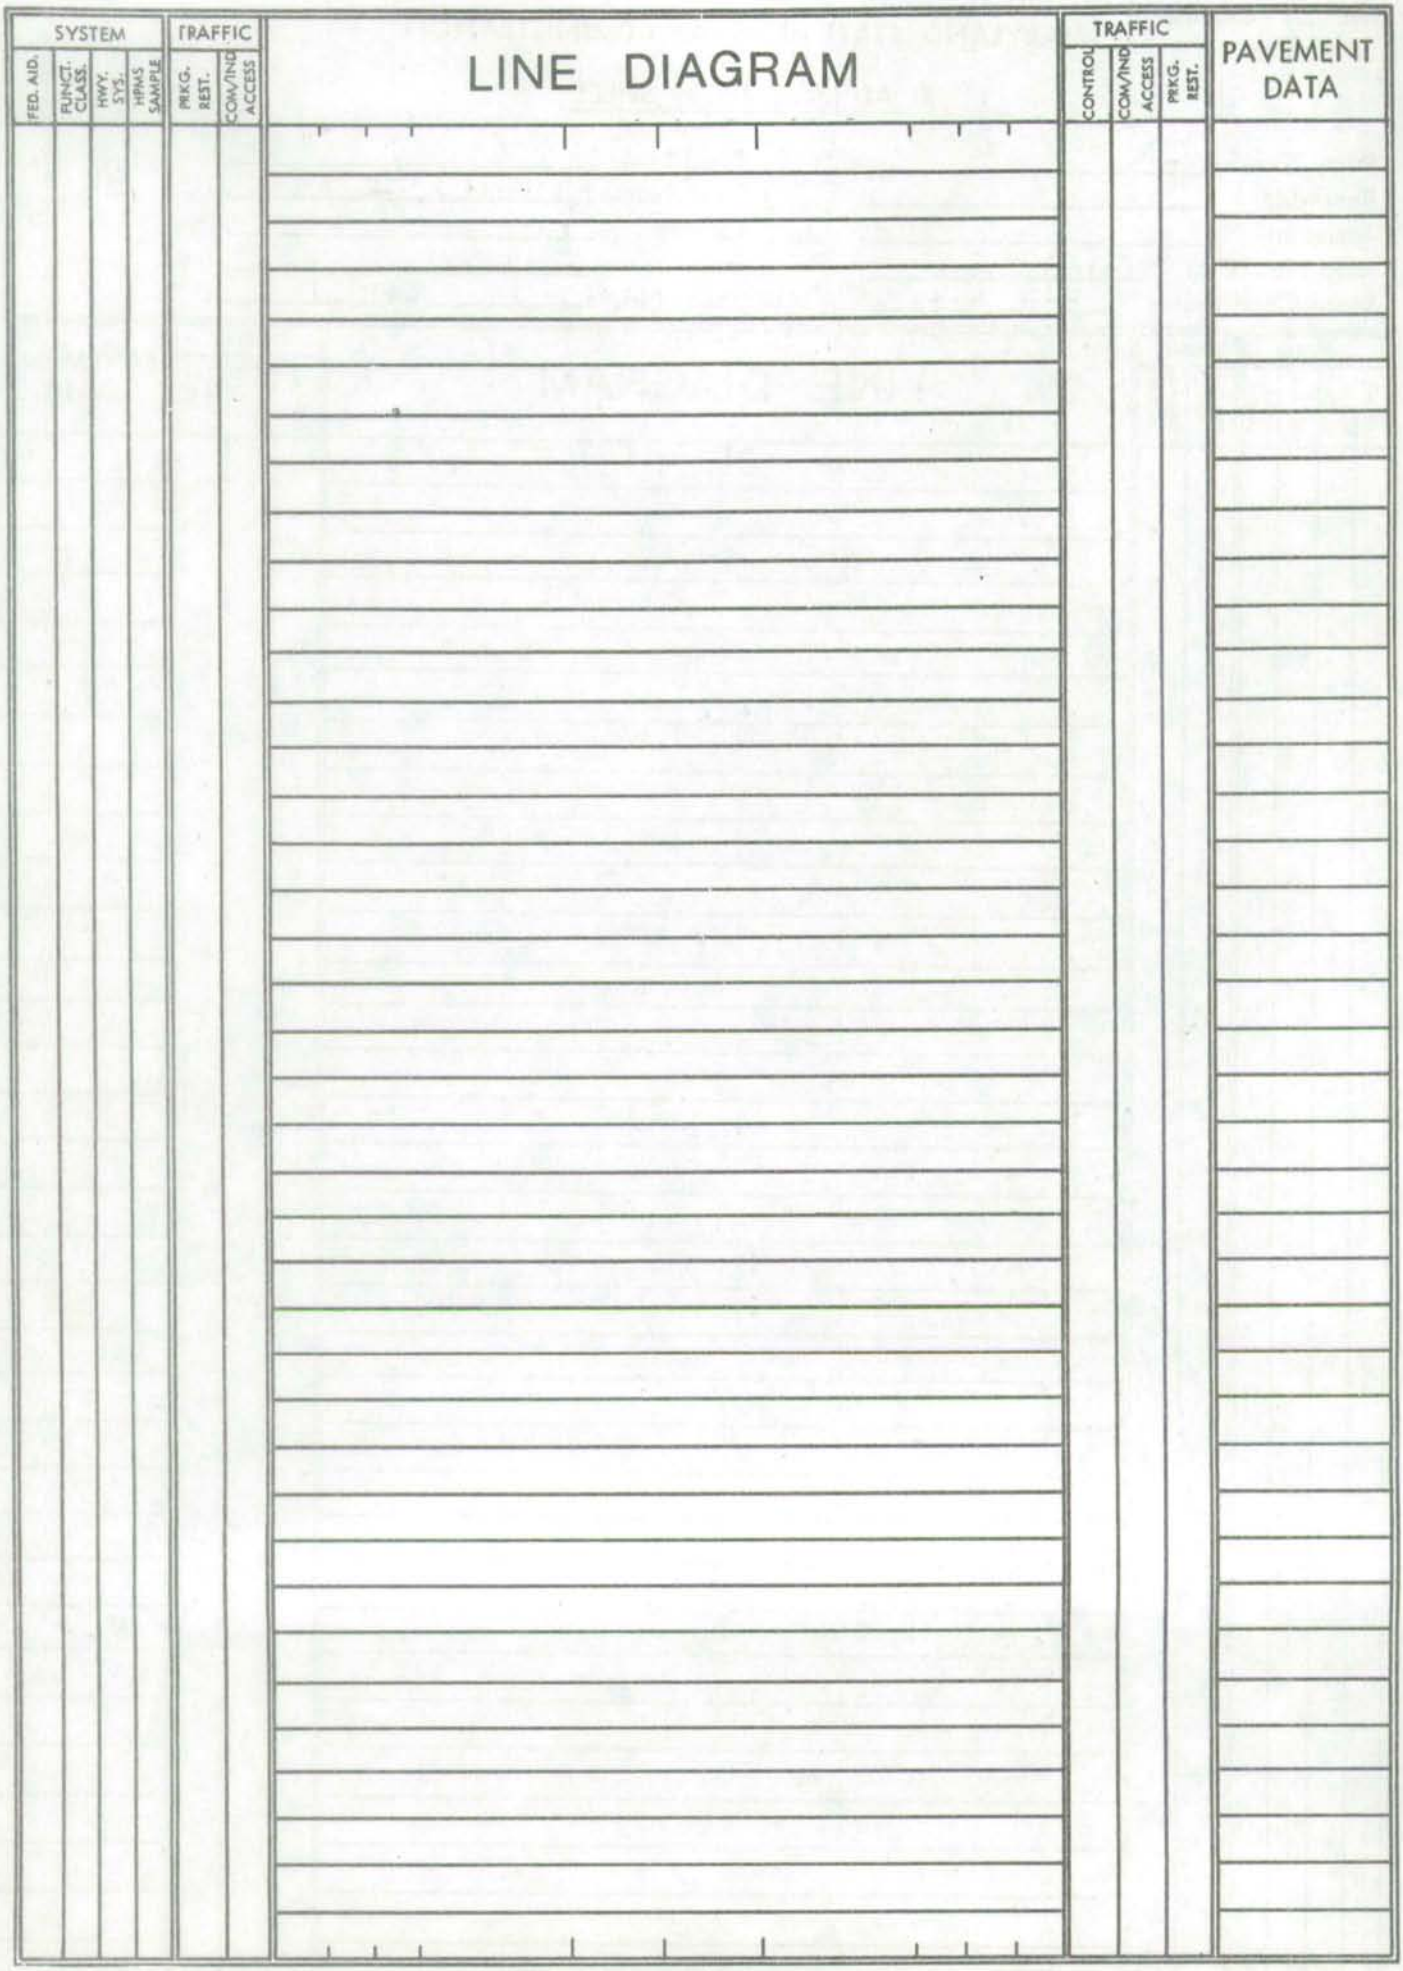
SYSTEM
FED. AID.
FUNCT. CLASS.
HWY. SYS.
HPMS SAMPLE
TRAFFIC
PRKG. REST.
COM/IND ACCESS
LINE DIAGRAM
TRAFFIC
CONTROL
COM/IND ACCESS
PRKG. REST.
PAVEMENT DATA

SHA 51.3 - 8 Revised
4.83

MARYLAND STATE HIGHWAY ADMINISTRATION

ROAD INVENTORY SHEET

88-112

Party Chief BB
Recorder DW
Assistant
Map No./Dir. GI2 / N
State Coordinates 883-384

Road No. CO 4946
Road Name Prospect Dr
County P.G.
Date 3-8-89
Sheet No. 1 OF 1

SYSTEM: FED. AID. | FUNCT CLASS. | HWY. SYS. | HPMS SAMPLE
TRAFFIC: PRKG. REST. | COM/IND. ACCESS

LINE DIAGRAM

TRAFFIC: CONTROL | COM/IND. ACCESS | PRKG. REST.

PAVEMENT DATA

D E
Cul 0 33 Soc

PT 0 26

Bonadventure Dr
CO 4947 0 24

70°

PC 0 17

18 I
24' cw

Queen Anne Rd
CO 0 00 1914

TRAFFIC CODES
TRAFFIC CONTROLS: STOP SIGN=SS, TRAFFIC LIGHT=T.L., FLASHING RED BALL=F.R.

TRAFFIC CODES
PARKING RESTRICTIONS: A.M. PEAK, P.M. PEAK, A.M./P.M. PEAK, NO PARKING ANYTIME=N.P., COMM/IND. ACCESS=E

SYSTEM				TRAFFIC		LINE DIAGRAM	TRAFFIC			PAVEMENT DATA
FED. AID.	FUNCT. CLASS.	HWY. SYS.	HPMS SAMPLE	PRK.G. REST.	COM/IND ACCESS		CONTROL	COM/IND ACCESS	PRK.G. REST.	

SHA 51.3 - 8 Revised
4.83

MARYLAND STATE HIGHWAY ADMINISTRATION

ROAD INVENTORY SHEET

Party Chief BB
Recorder DW
Assistant
Map No./Dir. G12 / NW
State Coordinates 883 - 384

Road No. CO 4947
Road Name Bowadventure Dr
County P.G.
Date 3-8-89
Sheet No. 1 OF 1

88-114

SYSTEM				TRAFFIC		LINE DIAGRAM	TRAFFIC			PAVEMENT DATA
FED. AID.	FUNCT. CLASS.	HWY. SYS.	HPMS SAMPLE	PRKG. REST.	COM/IND. ACCESS		CONTROL	COM/IND. ACCESS	PRKG. REST.	
						D E Cul 0 34 Sac 0 15 PT 40° 0 04 PC Prospect CO 0 00 Dr 4946				18'I 24'CW

TRAFFIC CODES

TRAFFIC CONTROLS: STOP SIGN=SS,
TRAFFIC LIGHT=T.L.,
FLASHING RED BALL=F.R.

TRAFFIC CODES

PARKING RESTRICTIONS: A.M. PEAK, P.M. PEAK, A.M./P.M. PEAK, NO PARKING ANYTIME=N.P., COMM/IND. ACCESS=E

SYSTEM				TRAFFIC		LINE DIAGRAM	TRAFFIC				PAVEMENT DATA
FED. AID.	FUNCT. CLASS.	HWY. SYS.	HPMS SAMPLE	PRK.G. REST.	COM/IND ACCESS		CONTROL	COM/IND ACCESS	PRK.G. REST.		

SHA 51.3 - 8 Revised
4.83

MARYLAND STATE HIGHWAY ADMINISTRATION

ROAD INVENTORY SHEET

88-116

Party Chief BB
Recorder DW
Assistant
Map No./Dir. GI2 / S
State Coordinates 883-380

Road No. CO 4948
Road Name Heritage Hills Dr
County P.G.
Date 3-8-89
Sheet No. 1 OF 1

SYSTEM				TRAFFIC		LINE DIAGRAM	TRAFFIC			PAVEMENT DATA
FED. AID.	FUNCT CLASS.	HWY. SYS.	HPMS SAMPLE	PRKG. REST.	COM/IND. ACCESS		CONTROL	COM/IND. ACCESS	PRKG. REST.	

TRAFFIC CODES

TRAFFIC CONTROLS: STOP SIGN=SS, TRAFFIC LIGHT=T.L., FLASHING RED BALL=F.R.

TRAFFIC CODES

PARKING RESTRICTIONS: A.M. PEAK, P.M. PEAK, A.M./P.M. PEAK, NO PARKING ANYTIME=N.P., COMM/IND. ACCESS=E

D E
Cul 0 17 Sac

18'I
20'cw

Clagett Landing Rd
CO 000 102

SYSTEM				TRAFFIC		LINE DIAGRAM	TRAFFIC			PAVEMENT DATA
FED. AID.	FUNCT. CLASS.	HWY. SYS.	HPMS SAMPLE	PRK'G. REST.	COM/IND ACCESS		CONTROL	COM/IND ACCESS	PRK'G. REST.	

Cercuter Upper Marlboro
Sm. urban

SHA 51.3 - 8 Revised
4.83

MARYLAND STATE HIGHWAY ADMINISTRATION

ROAD INVENTORY SHEET

Party Chief BB
Recorder DW
Assistant
Map No./Dir. G12 / S
State Coordinates 868-360

Road No. CO 4949
Road Name Col. ADDISON Pl
County P.G.
Date 3-9-89
Sheet No. 1 OF 1

88-122

SYSTEM				TRAFFIC		LINE DIAGRAM	TRAFFIC			PAVEMENT DATA
FED. AID.	FUNCT CLASS.	HWY. SYS.	HPMS SAMPLE	PRKG. REST.	COM/IND. ACCESS		CONTROL	COM/IND. ACCESS	PRKG. REST.	
						D E				
						Cul 0 09 Sac				
						0 06 PT				
						Col. ADDISON Ct				
						0 05 CO 4950 30°				
						0 03 PC				
										26'I
						Colonels Choice				J-cc
						CO 0 00 4909	55			

TRAFFIC CODES

TRAFFIC CONTROLS: STOP SIGN=SS, TRAFFIC LIGHT=T.L., FLASHING RED BALL=F.R.

TRAFFIC CODES

PARKING RESTRICTIONS: A.M. PEAK, P.M. PEAK, A.M./P.M. PEAK, NO PARKING ANYTIME=N.P., COMM/IND. ACCESS=E

SYSTEM				TRAFFIC		LINE DIAGRAM	TRAFFIC			PAVEMENT DATA
FED. AID.	FUNCT. CLASS.	HWY. SYS.	HPMS SAMPLE	PRK.G. REST.	COM/IND ACCESS		CONTROL	COM/IND ACCESS	PRK.G. REST.	

Greater Upper Marlboro
Sm. Urban

SHA 51.3 - 8 Revised
4.83

MARYLAND STATE HIGHWAY ADMINISTRATION

ROAD INVENTORY SHEET

Party Chief BB
Recorder DW
Assistant
Map No./Dir. G12 / W
State Coordinates 868-360

Road No. CO 4950
Road Name Col ADDISON Ct
County P.G.
Date 3-9-89
Sheet No. 1 OF 1

88-128

SYSTEM				TRAFFIC		LINE DIAGRAM	TRAFFIC			PAVEMENT DATA
FED. AID.	FUNCT. CLASS.	HWY. SYS.	HPMS SAMPLE	PRK.G. REST.	COM/IND. ACCESS		CONTROL	COM/IND. ACCESS	PRK.G. REST.	
						D E				
						CM 0 04 Sac				
										26'I
						1 Col. ADDISON Pl				J-CC
						CO 4949				

TRAFFIC CODES

TRAFFIC CONTROLS: STOP SIGN=SS, TRAFFIC LIGHT=T.L., FLASHING RED BALL=F.R.

TRAFFIC CODES

PARKING RESTRICTIONS: A.M. PEAK, P.M. PEAK, A.M./P.M. PEAK, NO PARKING ANYTIME=N.P., COMM/IND. ACCESS=E

SYSTEM				TRAFFIC		LINE DIAGRAM	TRAFFIC			PAVEMENT DATA
FED. AID.	FUNCT. CLASS.	HWY. SYS.	HPMS SAMPLE	PRK.G. REST.	COM/IND ACCESS		CONTROL	COM/IND ACCESS	PRK.G. REST.	

Gr. Up. Marl. urban

SHA 51.3 - 8 Revised
4.83

MARYLAND STATE HIGHWAY ADMINISTRATION

ROAD INVENTORY SHEET

88-123/124

Party Chief BB
Recorder DW
Assistant
Map No./Dir. G12 / N
State Coordinates 871-358

Road No. CO 4951
Road Name E. Court Dr
County P.G.
Date 3-9-89
Sheet No. 1 OF 1

TRAFFIC CODES
TRAFFIC CONTROLS: STOP SIGN=SS, TRAFFIC LIGHT=T.L., FLASHING RED BALL=F.R.

TRAFFIC CODES
PARKING RESTRICTIONS: A.M. PEAK, P.M. PEAK, A.M./P.M. PEAK, NO PARKING ANYTIME=N.P., COMM/IND. ACCESS=E

SYSTEM				TRAFFIC		LINE DIAGRAM (UPPER MARLBORO)	TRAFFIC			PAVEMENT DATA
FED. AID.	FUNCT CLASS.	HWY. SYS.	HPMS SAMPLE	PRKG. REST.	COM/IND. ACCESS		CONTROL	COM/IND. ACCESS	PRKG. REST.	
	NON FA Urban Rural Local					MD 725 St Main 001 004 One WAY 001 (Judge Ed. Loveless Dr) 00 CD 5381		E		18'I J-CC 29'I J-CLT

SYSTEM				TRAFFIC		LINE DIAGRAM	TRAFFIC				PAVEMENT DATA
FED. AID.	FUNCT. CLASS.	HWY. SYS.	HPMS SAMPLE	PRK.G. REST.	COM/IND ACCESS		CONTROL	COM/IND ACCESS	PRK.G. REST.		

Gr. Upper Marlboro urban
VER. 92 Mu Ex # 1
CD A/M
2-25-13

SHA 51.3 - 8 Revised 4.83

MARYLAND STATE HIGHWAY ADMINISTRATION

ROAD INVENTORY SHEET

88-127

Party Chief BB
Recorder DW
Assistant
Map No./Dir. G12 / S
State Coordinates 871-358

Road No. CO 4952
Road Name West Court Dr
County P.G.
Date 3-9-89
Sheet No. 1 OF 1

TRAFFIC CODES
TRAFFIC CONTROLS: STOP SIGN=SS, TRAFFIC LIGHT=T.L., FLASHING RED BALL=F.R.

TRAFFIC CODES
PARKING RESTRICTIONS: A.M. PEAK, P.M. PEAK, A.M./P.M. PEAK, NO PARKING ANYTIME=N.P., COMM/IND. ACCESS=E

SYSTEM				TRAFFIC		LINE DIAGRAM	TRAFFIC			PAVEMENT DATA
FED. AID.	FUNCT CLASS.	HWY. SYS.	HPMS SAMPLE	PRKG. REST.	COM/IND. ACCESS		CONTROL	COM/IND. ACCESS	PRKG. REST.	
						UPPER MARLBORO				
						ENT. TO Parking				
						Judges Dr				
						007 CO 4953	SS			
						004		E		26'I
										J-CC
						Street #1				
						003 ← mu 120				
										18'I
										J-CC
						MD 725				
						Main 000 St				

NON FA
Urban Local
ONE WAY

SYSTEM				TRAFFIC		LINE DIAGRAM	TRAFFIC			PAVEMENT DATA
FED. AID.	FUNCT. CLASS.	HWY. SYS.	HPMS SAMPLE	PRK.G. REST.	COM/IND ACCESS		CONTROL	COM/IND ACCESS	PRK.G. REST.	

Greater Upper Marlboro urban

92 M,U LOC # 1
GD, AH
2/25/93

SHA 51.3 - 8 Revised
4.83

MARYLAND STATE HIGHWAY ADMINISTRATION

ROAD INVENTORY SHEET

88-125/136

Party Chief RB
Recorder DW
Assistant
Map No./Dir. G12 / E
State Coordinates 871-358

Road No. CO 4953
Road Name (Judges Dr)
County P.G
Date 3-9-89
Sheet No. 1 OF 1

TRAFFIC CODES
TRAFFIC CONTROLS: STOP SIGN=SS, TRAFFIC LIGHT=T.L., FLASHING RED BALL=F.R.

TRAFFIC CODES
PARKING RESTRICTIONS: A.M. PEAK, P.M. PEAK, A.M./P.M. PEAK, NO PARKING ANYTIME=N.P., COMM/IND. ACCESS=E

SYSTEM				TRAFFIC		LINE DIAGRAM	TRAFFIC			PAVEMENT DATA
FED. AID.	FUNCT CLASS.	HWY. SYS.	HPMS SAMPLE	PRKG. REST.	COM/IND. ACCESS	UPPER MARLBORO	CONTROL	COM/IND ACCESS	PRKG. REST.	
					E	021	PT			
					E	017		E		
						016	X 50°			
					E	014				
						013	PE			
						East Court Dr CO 4951 ← 011				
					E	Court House 008				
						West Court Dr CO 4952 → 005		E		
NON FA	Urban Local									
K	K					MD Water 000	717 St	SS		

CO 4953

0.26 (R)

SYSTEM				TRAFFIC		LINE DIAGRAM	TRAFFIC			PAVEMENT DATA
FED. AID.	FUNCT. CLASS.	HWY. SYS.	HPMS SAMPLE	PRK'G. REST.	COM/IND ACCESS		CONTROL	COM/IND ACCESS	PRK'G. REST.	
NON FA	Rural Local Urban					Park MH 0.23 St 0.50 0.22	SS			29 1

© PHOTOLOG

Wash. urban

SHA 51.3 - 8 Revised
4.83

MARYLAND STATE HIGHWAY ADMINISTRATION

ROAD INVENTORY SHEET

Party Chief BB
Recorder DW
Assistant
Map No./Dir. G12 / S
State Coordinates 861-357

Road No. CO 4954
Road Name Kentfield LN
County P.G.
Date 3-8-89
Sheet No. 1 OF 1

88130

TRAFFIC CODES

TRAFFIC CONTROLS: STOP SIGN=SS, TRAFFIC LIGHT=T.L., FLASHING RED BALL=F.R.

PARKING RESTRICTIONS: A.M. PEAK, P.M. PEAK, A.M./P.M. PEAK, NO PARKING ANYTIME=N.P., COMM/IND. ACCESS=E

SYSTEM				TRAFFIC		LINE DIAGRAM	TRAFFIC			PAVEMENT DATA
FED. AID.	FUNCT CLASS.	HWY. SYS.	HPMS SAMPLE	PRKG. REST.	COM/IND. ACCESS		CONTROL	COM/IND. ACCESS	PRKG. REST.	
						D E Cul 0 21 Sac				
						PT 0 12 90° PC 0 04				
						William Beanes Rd CO 000 4279	SS			18'I 20'CW

SYSTEM				TRAFFIC		LINE DIAGRAM	TRAFFIC			PAVEMENT DATA
FED. AID.	FUNCT. CLASS.	HWY. SYS.	HPMS SAMPLE	PRK.G. REST.	COM/IND ACCESS		CONTROL	COM/IND ACCESS	PRK.G. REST.	

SHA 51.3 - 8 Revised
4.83

MARYLAND STATE HIGHWAY ADMINISTRATION

ROAD INVENTORY SHEET

96-95 Co
DC/MC
3-19-97

88-144

Party Chief BB
Recorder DW
Assistant
Map No./Dir. H-11 / W
State Coordinates 828-332

Road No. CO 4955
Road Name Gator Pl
County P.G
Date 3-9-89
Sheet No. 1 OF 1

SYSTEM				TRAFFIC		LINE DIAGRAM	TRAFFIC			PAVEMENT DATA
FED. AID.	FUNCT CLASS.	HWY. SYS.	HPMS SAMPLE	PRKG. REST.	COM/IND. ACCESS		CONTROL	COM/IND. ACCESS	PRKG. REST.	
						Mullikin Dr				
						CO 0 18 2346				
						Gator ct				
						0 07 CO 4956				
						PT 0 06				
						30°				
						PC 0 03				
										26'
						Bickford Ave				J-CC
						CO 0 00 2345				

TRAFFIC CODES

TRAFFIC CONTROLS: STOP SIGN=SS, TRAFFIC LIGHT=T.L., FLASHING RED BALL=F.R.

TRAFFIC CODES

PARKING RESTRICTIONS: A.M. PEAK, P.M. PEAK, A.M./P.M. PEAK, NO PARKING ANYTIME=N.P., COMM/IND. ACCESS=E

SYSTEM				TRAFFIC		LINE DIAGRAM	TRAFFIC				PAVEMENT DATA
FED. AID.	FUNCT. CLASS.	HWY. SYS.	HPMS SAMPLE	PRK.G. REST.	COM/IND ACCESS		CONTROL	COM/IND ACCESS	PRK.G. REST.		

SHA 51.3 - 8 Revised
4.83

MARYLAND STATE HIGHWAY ADMINISTRATION

ROAD INVENTORY SHEET

88-147

Party Chief BB
Recorder DW
Assistant
Map No./Dir. H-11 / S
State Coordinates 828-332

Road No. CO 4956
Road Name Gator Ct
County P.G
Date 3-9-89
Sheet No. 1 OF 1

TRAFFIC CODES
TRAFFIC CONTROLS: STOP SIGN=S.S., TRAFFIC LIGHT=T.L., FLASHING RED BALL=F.R.

TRAFFIC CODES
PARKING RESTRICTIONS: A.M. PEAK, P.M. PEAK, A.M./P.M. PEAK, NO PARKING ANYTIME=N.P., COMM/IND. ACCESS=E

SYSTEM				TRAFFIC		LINE DIAGRAM	TRAFFIC			PAVEMENT DATA
FED. AID.	FUNCT CLASS.	HWY. SYS.	HPMS SAMPLE	PRK.G. REST.	COM/IND. ACCESS		CONTROL	COM/IND. ACCESS	PRK.G. REST.	
						D E				
						Cul 007 Sec				
										26'I
						Gator P1				J-cc
						CO 000 4955				

SYSTEM				TRAFFIC		LINE DIAGRAM	TRAFFIC			PAVEMENT DATA
FED. AID.	FUNCT. CLASS.	HWY. SYS.	HPMS SAMPLE	PRK.G. REST.	COM/IND ACCESS		CONTROL	COM/IND ACCESS	PRK.G. REST.	

SHA 51.3 - 8 Revised
4.83

MARYLAND STATE HIGHWAY ADMINISTRATION

ROAD INVENTORY SHEET

Party Chief BB
Recorder DW
Assistant
Map No./Dir. H-11 / W
State Coordinates 828-332

Road No. CO 4957
Road Name Dutrow Ct
County P.G.
Date 3-9-89
Sheet No. 1 OF 1

88-146

SYSTEM: FED. AID. | FUNCT CLASS. | HWY. SYS. | HPMS SAMPLE
TRAFFIC: PRKG. REST. | COM/IND. ACCESS

LINE DIAGRAM

TRAFFIC: CONTROL | COM/IND. ACCESS | PRKG. REST.

PAVEMENT DATA

D E
Cul 0 08 Sac

24'I
J-cc

1 Brandywine Rd
CO 0 00 599 SS

TRAFFIC CODES

TRAFFIC CONTROLS: STOP SIGN=SS, TRAFFIC LIGHT=T.L., FLASHING RED BALL=F.R.

TRAFFIC CODES

PARKING RESTRICTIONS: A.M. PEAK, P.M. PEAK, A.M./P.M. PEAK, NO PARKING ANYTIME=N.P., COMM/IND. ACCESS=E

SYSTEM				TRAFFIC		LINE DIAGRAM	TRAFFIC			PAVEMENT DATA
FED. AID.	FUNCT. CLASS.	HWY. SYS.	HPMS SAMPLE	PRK.G. REST.	COM/IND ACCESS		CONTROL	COM/IND ACCESS	PRK.G. REST.	

SHA 51.3 - 8 Revised
4.83

MARYLAND STATE HIGHWAY ADMINISTRATION

ROAD INVENTORY SHEET

88-157

Party Chief BB
Recorder DW
Assistant
Map No./Dir. H11 / E
State Coordinates 192-327

Road No. CO 41958
Road Name Colleen Ct
County P.G
Date 3-13-89
Sheet No. 1 OF 1

SYSTEM				TRAFFIC		LINE DIAGRAM	TRAFFIC			PAVEMENT DATA
FED. AID.	FUNCT CLASS.	HWY. SYS.	HPMS SAMPLE	PRKG. REST.	COM/IND. ACCESS		CONTROL	COM/IND. ACCESS	PRKG. REST.	
						D E				
						Cul 0 18 Sac				
						0 14 PT				
						110°				
						0 04 PC				
										24'I
										34'CW
						River View Rd				
						CO 0 00 143				

TRAFFIC CODES

TRAFFIC CONTROLS: STOP SIGN=SS, TRAFFIC LIGHT=T.L., FLASHING RED BALL=F.R.

TRAFFIC CODES

PARKING RESTRICTIONS: A.M. PEAK, P.M. PEAK, A.M./P.M. PEAK, NO PARKING ANYTIME=N.P., COMM/IND. ACCESS=E

SYSTEM				TRAFFIC		LINE DIAGRAM	TRAFFIC				PAVEMENT DATA
FED. AID.	FUNCT. CLASS.	HWY. SYS.	HPMS SAMPLE	PRK.G. REST.	COM/IND ACCESS		CONTROL	COM/IND ACCESS	PRK.G. REST.		

SHA 51.3 - 8 Revised
4.83

MARYLAND STATE HIGHWAY ADMINISTRATION

ROAD INVENTORY SHEET

Party Chief BB
Recorder DW
Assistant
Map No./Dir. H11 / N
State Coordinates 792-326

Road No. CO 4959
Road Name Hazem ct
County P.G.
Date 3-13-89
Sheet No. 1 OF 1

88-159

SYSTEM				TRAFFIC		LINE DIAGRAM	TRAFFIC			PAVEMENT DATA
FED. AID.	FUNCT CLASS.	HWY. SYS.	HPMS SAMPLE	PRKG. REST.	COM/IND. ACCESS		CONTROL	COM/IND. ACCESS	PRKG. REST.	

DE
Cul 018 Sac

Othman DR
OP CO 000 4604-4960

26'I
J-CC

TRAFFIC CODES

TRAFFIC CONTROLS: STOP SIGN=SS, TRAFFIC LIGHT=T.L., FLASHING RED BALL=F.R.

TRAFFIC CODES

PARKING RESTRICTIONS: A.M. PEAK, P.M. PEAK, A.M./P.M. PEAK, NO PARKING ANYTIME=N.P., COMM/IND. ACCESS=E

SYSTEM				TRAFFIC		LINE DIAGRAM	TRAFFIC			PAVEMENT DATA
FED. AID.	FUNCT. CLASS.	HWY. SYS.	HPMS SAMPLE	PRKG. REST.	COM/IND ACCESS		CONTROL	COM/IND ACCESS	PRKG. REST.	

SHA 51.3 - 8 Revised
4.83

MARYLAND STATE HIGHWAY ADMINISTRATION

ROAD INVENTORY SHEET

~~OP 4661F~~

Party Chief BB
Recorder DW
Assistant
Map No./Dir. H-11 / SW
State Coordinates 792-327

Road No. CO 4960
Road Name Othman Dr
County P.G
Date 3-13-89
Sheet No. 1 OF 1

88-160

TRAFFIC CODES
TRAFFIC CONTROLS: STOP SIGN=SS, TRAFFIC LIGHT=T.L., FLASHING RED BALL=F.R.

TRAFFIC CODES
PARKING RESTRICTIONS: A.M. PEAK, P.M. PEAK, A.M./P.M. PEAK, NO PARKING ANYTIME=N.P., COMM/IND. ACCESS=E

SYSTEM				TRAFFIC		LINE DIAGRAM	TRAFFIC			PAVEMENT DATA
FED. AID.	FUNCT CLASS.	HWY. SYS.	HPMS SAMPLE	PRKG. REST.	COM/IND. ACCESS		CONTROL	COM/IND. ACCESS	PRKG. REST.	
		~~4664F~~ CO 4960				Sero Estates @.18 Dr CO ~~OP~~ 0 48 ~~4663~~ 4604				
						Hazem Ct PT 0 35 CO 4959 90°				
						PC 0 29				
						0 26				
						Othman Ct 0 19 ~~OP 4665~~ CO 5187				
						PT 0 16 90°				
						PC 0 10				
						1 Sero Estates @.55 Dr CO 0 00 4604				26'I J-CC

SYSTEM				TRAFFIC		LINE DIAGRAM	TRAFFIC				PAVEMENT DATA
FED. AID.	FUNCT. CLASS.	HWY. SYS.	HPMS SAMPLE	PRKG. REST.	COM/IND ACCESS		CONTROL	COM/IND ACCESS	PRKG. REST.		

SHA 51.3 - 8 Revised
4.83

MARYLAND STATE HIGHWAY ADMINISTRATION

ROAD INVENTORY SHEET

88-169

Party Chief BB
Recorder DW
Assistant
Map No./Dir. H-11 / E
State Coordinates 804-305

Road No. CO 4961
Road Name Trunnell LN
County P.G.
Date 3-13-89
Sheet No. 1 OF 1

SYSTEM: FED. AID. | FUNCT. CLASS. | HWY. SYS. | HPMS SAMPLE
TRAFFIC: PRKG. REST. | COM/IND. ACCESS

LINE DIAGRAM

TRAFFIC: CONTROL | COM/IND. ACCESS | PRKG. REST.

PAVEMENT DATA

Blackburn St
Co 0 16 3423 SS

0 04 35°

Realle Hill Rd
Co 0 00 626 SS

26'I
J-CC

TRAFFIC CODES

TRAFFIC CONTROLS: STOP SIGN=SS, TRAFFIC LIGHT=T.L., FLASHING RED BALL=F.R.

TRAFFIC CODES

PARKING RESTRICTIONS: A.M. PEAK, P.M. PEAK, A.M./P.M. PEAK, NO PARKING ANYTIME=N.P., COMM/IND. ACCESS=E

SYSTEM				TRAFFIC		LINE DIAGRAM	TRAFFIC			PAVEMENT DATA
FED. AID.	FUNCT. CLASS.	HWY. SYS.	HPMS SAMPLE	PRK.G. REST.	COM/IND ACCESS		CONTROL	COM/IND ACCESS	PRK.G. REST.	

SHA 51.3 - 8 Revised
4.83

MARYLAND STATE HIGHWAY ADMINISTRATION

ROAD INVENTORY SHEET

Party Chief BB
Recorder DW
Assistant
Map No./Dir. H11 / S
State Coordinates 804 - 305

Road No. CO 4962
Road Name Litton Ln
County P.G
Date 3-13-89
Sheet No. 1 OF 1

88-171

TRAFFIC CODES
TRAFFIC CONTROLS: STOP SIGN=SS, TRAFFIC LIGHT=T.L., FLASHING RED BALL=F.R.

TRAFFIC CODES
PARKING RESTRICTIONS: A.M. PEAK, P.M. PEAK, A.M./P.M. PEAK, NO PARKING ANYTIME=N.P., COMM/IND. ACCESS=E

SYSTEM				TRAFFIC		LINE DIAGRAM	TRAFFIC			PAVEMENT DATA
FED. AID.	FUNCT CLASS.	HWY. SYS.	HPMS SAMPLE	PRKG. REST.	COM/IND. ACCESS		CONTROL	COM/IND. ACCESS	PRKG. REST.	
						Elling Wood Dr				
						CO 009 4963				↑
										26'I
						1 Blackburn St				J-CC
						CO 000 3423	SS			↓

SYSTEM				TRAFFIC		LINE DIAGRAM	TRAFFIC				PAVEMENT DATA
FED. AID.	FUNCT. CLASS.	HWY. SYS.	HPMS SAMPLE	PRK.G. REST.	COM/IND ACCESS		CONTROL	COM/IND ACCESS	PRK.G. REST.		

SHA 51.3 - 8 Revised
4.83

MARYLAND STATE HIGHWAY ADMINISTRATION

ROAD INVENTORY SHEET OP 4666

Party Chief BB
Recorder DW
Assistant
Map No./Dir. H11 / E
State Coordinates 804-306

Road No. CO 4963
Road Name Ellingwood Dr
County P.G.
Date 3-13-89
Sheet No. 1 OF 1

88-172

TRAFFIC CODES
TRAFFIC CONTROLS: STOP SIGN=SS, TRAFFIC LIGHT=T.L., FLASHING RED BALL=F.R.

TRAFFIC CODES
PARKING RESTRICTIONS: A.M. PEAK, P.M. PEAK, A.M./P.M. PEAK, NO PARKING ANYTIME=N.P., COMM/IND. ACCESS=E

SYSTEM				TRAFFIC		LINE DIAGRAM	TRAFFIC			PAVEMENT DATA
FED. AID.	FUNCT CLASS.	HWY. SYS.	HPMS SAMPLE	PRKG. REST.	COM/IND. ACCESS		CONTROL	COM/IND. ACCESS	PRKG. REST.	
		CO 4963 OP 4666				XX XX Road 032 END 020 Liton LN CO 4962 016 CUL 000 Sac D E				26'I J-CC

SYSTEM				TRAFFIC		LINE DIAGRAM	TRAFFIC				PAVEMENT DATA
FED. AID.	FUNCT. CLASS.	HWY. SYS.	HPMS SAMPLE	PRK.G. REST.	COM/IND ACCESS		CONTROL	COM/IND ACCESS	PRK.G. REST.		

SHA 51.3-8
11-15-72

STATE HIGHWAY ADMINISTRATION OF MARYLAND

Wbum
97-006
3-9-98 78
BB/HP

ROAD INVENTORY SHEET

CO 4964

Party Chief MZ
Recorder JE
Helper

Road No. ~~OR 1204~~
Road Name WHEATLEY LA
Sheet No. 1 OF 1
Date 5-2-78
County PRINCE GEORGES
State Coordinates 819-447

89-2

Map No. ~~27D~~ E11D

N

ROAD	0 09 END	
		14'H
H	0 06	~~10'E~~
		14'-4"
BRIGGS CHANEY RD		
CO	0 00 12	55
	@.38	

SHA 51.3-8
11-15-72

ROAD INVENTORY SHEET

Road No. _____
Road Name _____
Sheet No. _____
Date _____
County _____
State Coordinates _____

MAR 3

Form 6 HPS (Rev. 1961)

VER 11-2-77 89-5 3-15-90 BB/BB A/T OP180 CO 4965 89-5

ROAD INVENTORY SHEET

Party Chief E. SCHUYLER
Recorder T. LANDON
Chainman

F-11A
HAMPSHIRE KNOLLS
803-416-~~A34~~

Road No. ~~OP 496~~
Name (Red Top Rd - North Court)
Sheet No. 1 OF 1
Date 7-31-67
County PRINCE GEORGES

F

H
DE
Col 005 SAC
H 004 H
6 APTS UNITS 002
RED TOP RD
Co 000 703
C.07

70'I C-C
26'I C-C

MAP 3

Form 6 HPS (Rev. 1961)

VER 11-2-77

89-6
3-15-90 ~~DP 199~~
BB/BD CO 4966
A/T

89-6

ROAD INVENTORY SHEET

Party Chief E. SCHUYLER
Recorder T. LANDON
Chainman

F 11 C
HAMPSHIRE
KNOLLS

Road No. ~~O P 445~~
Name (Red Top Rd - South CT)
Sheet No. 1 OF 1
Date 7-31-67
County PRINCE GEORGES

803-416 491

	H	H
		DE
F	CUL	004 SAC H
	H	003
	ENT. PARKING LOT	002
		001 H
	RED TOP	RD
	CO	000 703
		@.13

48' I
C-C

26' I
C-C

Form 6 HPS (Rev. 1961)

89-17 OP172

ROAD INVENTORY SHEET

CO 4967

PARTY CHIEF Edward Schuyler
RECORDER Henry Gorman
CHAINMAN

ROAD NO. ~~OP 411~~
NAME 65TH AVE.
SHEET NO. 1 OF
DATE 9/27/67
COUNTY PRINCE GEORGES'

F-11D

826-403 A431 Ver 4-11-78

	ROAD END.		
	021		
5			
	019	H	
H	018		
			OP172
	016	H	
	007		
			0 1964
MD.	000	450	
	@ 1.92		

12'E
12'C-W
22' H

Form 6 HPS (Rev. 1961)

~~OP243~~

~~MAT 4~~

ROAD INVENTORY SHEET

CO 4968 ✓ 89-30

Party Chief E.S
Recorder W.D
Chainman

F-12

VER 6-6-78

~~864~~ ~~805~~ - 420 ~~M32~~

Road No. ~~OP 604~~
Name ZIRCON DR.
Sheet No. 1 of 1
Date 6-25-68
County PRINCE GEO

GPS 98-51
11/2/98
SS/SR

SHA 51.3 - 8 Revised
4.83

MARYLAND STATE HIGHWAY ADMINISTRATION

ROAD INVENTORY SHEET CO 4969

Party Chief BB
Recorder DW
Assistant
Map No./Dir. F12 / N
State Coordinates 851-405

Road No. ~~OR~~ ~~4684~~
Road Name Sunflower Ct
County P.G.
Date 3-16-89
Sheet No. 1 OF 1

88-42 EX.
89-49

SYSTEM				TRAFFIC		LINE DIAGRAM	TRAFFIC			PAVEMENT DATA
FED. AID.	FUNCT. CLASS.	HWY. SYS.	HPMS SAMPLE	PRKG. REST.	COM/IND. ACCESS		CONTROL	COM/IND. ACCESS	PRKG. REST.	

DE
CUL 007 Sac

Sunflower CO 000 @ 130 Cir. 4923

SS

26' I
J-CC

TRAFFIC CODES

TRAFFIC CONTROLS: STOP SIGN=SS, TRAFFIC LIGHT=T.L., FLASHING RED BALL=F.R.

TRAFFIC CODES

PARKING RESTRICTIONS: A.M. PEAK, P.M. PEAK, A.M./P.M. PEAK, NO PARKING ANYTIME=N.P., COMM/IND. ACCESS=E

SYSTEM				TRAFFIC		LINE DIAGRAM	TRAFFIC			PAVEMENT DATA
FED. AID.	FUNCT. CLASS.	HWY. SYS.	HPMS SAMPLE	PRKG. REST.	COM/IND ACCESS		CONTROL	COM/IND ACCESS	PRKG. REST.	

Form 6 HPS (Rev. 1961)

MAP 7 Ver 10-6-77 OP833 ✓ CO 4970 BELGIUM 57.

ROAD INVENTORY SHEET

Party Chief E. SCHUYLER
Recorder W. DOMARSKI
Chainman

89-61

FAU
MARY/AND PK.
826-382

G11B
M35

Road No. ~~CO 726~~
Name "C" ST
Sheet No. 1 OF 1
Date 5-13-69
County PRINCE GEORGES

W

	H		
COL-DE	005	SAC	↑
			20' H
H	004	H	
			~~30' F~~
H	001	H	34' CW
			~~20' E~~
CO		722	~~20' CO~~
VENTNA (4TH)	000	AVE	↓
	0.10		

Form 6 HPS (Rev. 1961)

~~MAP 6~~

~~OP 57~~ 78

ROAD INVENTORY SHEET

N Co 497

PARTY CHIEF Edward Schuyler
RECORDER Henry Gorman
CHAINMAN

OAKLAND
Ver
9-28-77

ROAD NO. ~~OP 150~~
NAME OAKWOOD LA.
SHEET NO. 1 OF 1
DATE 10/25/67
COUNTY PRINCE GEORGES

G-11B

824-375.5 ~~M35~~ 89-65

	H		
	POOP	END.	
E		016	C
	H	013	
		10 H	15'G
	H	009	~~20'E~~
			~~PLAID~~
		006	SAW.
			20'C-W.
		004 GARAGE	
		001 GUN SMITH	X
			26'I
	MARLBORO	PIKE.	C-C
	Co ~~MD~~ ~~BVA~~	000 3074 @1.64	✓

SHA 51.3-8
11-15-72

STATE HIGHWAY ADMINISTRATION OF MARYLAND

78

ROAD INVENTORY SHEET C04972

Party Chief W.D.
Recorder M.Z.
Helper

Map No. ~~35-B~~ G-11B

Road No. ~~D.R. [illegible]~~
Road Name MATHILDA LA.
Sheet No. [illegible]
Date 8-26-77
County PR. GEO
State Coordinates 823-367

89-68

97-147

ROAD END

0 ~~PX~~13 H

0 08 H

0 06 H

0 04 H

H 0 02 H

SWANN RD

CO 0 00 @.62 1035

16' G
~~PAVE~~
20' CW

DIANNA DR

0.20 @ 0.10

SHA 51.3-8
11-15-72

ROAD INVENTORY SHEET

Road No. _____
Road Name _____
Sheet No. _____
Date _____
County _____
State Coordinates _____

Form 6 HPS (Rev. 1961)

Ver. 8-3-77

~~OP 93~~ 78
(KAYDOT RD. CO 4973) 98-19
11-19-98
SS/SR/BB

ROAD INVENTORY SHEET

Party Chief E.S.
Recorder W.D
Chainman

FRIENDLY FARMS

Road No. ~~OP 244~~
Name ~~BROAD~~ RD
Sheet No. 1 OF 1
Date 9-23-68
County PRINCE GEO

97.226

601
~~800~~ - 336

G-11 C ~~MAP 9~~ 89-71
~~495~~ +H-11

		SCENT		
	CO		118	
	OLD FORT	0	30 RD	
			@ 5.74	
		0	24 H	
		0	19 90° ↑ H	
		0	17 H	
		0	15 H	
		0	13 H	
		0	12 90° ↑ H	
		0	11 H	
S		0	09 H	
		0	07 H	
		0	05 H	
		0	02 H	I 19
	CO		118	
	OLD FORT	0	00 RD	2 unL
			@ 5.80	
		SCENT		

SHA 51.3 - 8 Revised
4.83

MARYLAND STATE HIGHWAY ADMINISTRATION

ROAD INVENTORY SHEET

AUTH VILL. ~~OR 2344~~

90-170
2-22-91
BB/BB
A/T ver
8-16-77
89-82

Party Chief E.S.
Recorder W.D
Assistant rewritten 2-1-90 J.B
Map No./Dir. 6110 / E
State Coordinates 829 - 361

Road No. CO 4974
Road Name Bridgeport Dr
County Prince Georges
Date 11-13-68
Sheet No. _____ OF _____

SYSTEM: FED. AID. | FUNCT. CLASS. | HWY. SYS. | HPMS SAMPLE
TRAFFIC: PRK.G. REST. | COM/IND. ACCESS

LINE DIAGRAM

TRAFFIC: CONTROL | COM/IND. ACCESS | PRK.G. REST.
PAVEMENT DATA

TRAFFIC CODES
TRAFFIC CONTROLS: STOP SIGN=SS, TRAFFIC LIGHT=T, L., FLASHING RED BALL=F, R.

TRAFFIC CODES
PARKING RESTRICTIONS: A.M., PEAK, P.M., PEAK, A.M./P.M., PEAK, NO PARKING ANYTIME=N, P., COMM/IND., ACCESS=E

NON FA
URBAN LOCAL
~~OP 2344~~
CO 4974

ROAD 0.22 END

0.21

3 H

0.17

75°

0.07

LAKE

60" MP 0.06

12' E

0.00

0.44 Dr 0.26

0.33

0.0 Wesson

SYSTEM				TRAFFIC		LINE DIAGRAM	TRAFFIC			PAVEMENT DATA
FED. AID.	FUNCT. CLASS.	HWY. SYS.	HPMS SAMPLE	PRKG. REST.	COM/IND ACCESS		CONTROL	COM/IND ACCESS	PRKG. REST.	

Form 6 HPS (Rev. 1961)

~~QP 542~~

~~QP 1448~~ TAYLOR MANOR AVE

ROAD INVENTORY SHEET

Party Chief E. S.
Recorder W. D.
Chainman

VEQ 8-15-77

JENKINS COR

Road No. CO 4975
Name ~~TAYLOR AVE~~
Sheet No. 1 OF 1
Date 12-13-68
County PRINCE GEO

97-171

823
~~824~~-750

GIID
~~MAP~~ 9
M35

89-87

		X-X-X	
	ROAD	016	END
	H	015	H
	H	013	H
SE			
	H	009	
	H	004	
			15' G
			~~RAILE~~
		~~126~~	~~ROAD~~
	CO ALLENTOWN	000	RD
		@ 5.14	

Form 6 HPS (Rev. 1961) See 1997 Notes + Comments

97-172 ~~OR 100~~ M 18
G.D
E.F. 2/25/99 CO 4976

ROAD INVENTORY SHEET

89-91

Party Chief E.S.
Recorder W.D.
Chainman PAGETTS COR

Road No. ~~OP 265~~
Name PUTT RD
Sheet No. 1 OF 1
Date 12-18-68
County PRINCE GEO

8/8 ~~8/7~~-347 G-11D ~~4135~~ ~~MARG~~ VER 8-8-77

97-172

	ROAD	010	END	
E				
			4 H	
	H	005		
				15' ~~C~~ I
	H	003		~~12' E~~
				~~20' E~~
	CO		568	20' CW
	WEBSTER	000	CA	
			C.25	

SHA 51.3 - 8 Revised
4.83

RURAL

MARYLAND STATE HIGHWAY ADMINISTRATION

ROAD INVENTORY SHEET

CO 4977
~~OP 4633~~

87-EXTRA

89-113

Party Chief WB
Recorder CG
Assistant
Map No./Dir. G12 / E
State Coordinates 855-385

Road No.
Road Name KETTERING TER.
County P.G.
Date 2-5-88
Sheet No. 1 OF 1

SYSTEM				TRAFFIC		LINE DIAGRAM	TRAFFIC			PAVEMENT DATA
FED. AID.	FUNCT CLASS.	HWY. SYS.	HPMS SAMPLE	PRK.G. REST.	COM/IND. ACCESS		CONTROL	COM/IND. ACCESS	PRK.G. REST.	

D E
CUL 005 SAC

23' I
J C-C

KETTERING TER DR
CO 000 2578
@.85

TRAFFIC CODES

TRAFFIC CONTROLS: STOP SIGN=SS, TRAFFIC LIGHT=T.L., FLASHING RED BALL=F.R.

TRAFFIC CODES

PARKING RESTRICTIONS: A.M. PEAK, P.M. PEAK, A.M./P.M. PEAK, NO PARKING ANYTIME=N.P., COMM/IND. ACCESS=E

SYSTEM				TRAFFIC		LINE DIAGRAM	TRAFFIC				PAVEMENT DATA
FED. AID.	FUNCT. CLASS.	HWY. SYS.	HPMS SAMPLE	PRKG. REST.	COM/IND ACCESS		CONTROL	COM/IND ACCESS	PRKG. REST.		

SHA 51.3 - 8 Revised
4.83

Gr. Upper Marlboro Sm. [illegible]

MARYLAND STATE HIGHWAY ADMINISTRATION

ROAD INVENTORY SHEET

CO 4978

Party Chief BB
Recorder TM
Assistant
Map No./Dir. 6-12 / N
State Coordinates 862.378

Road No. ~~OP 4578~~ 86-142 X
Road Name Boykin Place 89-124
County P.G.
Date 3-31-87
Sheet No. 1 OF

TRAFFIC CODES
TRAFFIC CONTROLS: STOP SIGN=S.S., TRAFFIC LIGHT=T.L., FLASHING RED BALL=F.R.

TRAFFIC CODES
PARKING RESTRICTIONS: A.M. PEAK, P.M. PEAK, A.M./P.M. PEAK, NO PARKING ANYTIME=N.P., COMM/IND. ACCESS=E

SYSTEM				TRAFFIC		LINE DIAGRAM	TRAFFIC			PAVEMENT DATA
FED. AID.	FUNCT CLASS.	HWY. SYS.	HPMS SAMPLE	PRK.G. REST.	COM/IND. ACCESS		CONTROL	COM/IND. ACCESS	PRK.G. REST.	
						D E				
						cnl 0 15 SAL				
						↑10° 0 10				
						~~Boykin Pl.~~ ~~Hancock Pl.~~				
						CO4981 ~~OPADD~~ 0 06				24' I
						↑35° ~~CO 4981~~ 0 03				1"C-C
						Cnl 0 00 SAL.				
						D E				

SYSTEM				TRAFFIC		LINE DIAGRAM	TRAFFIC			PAVEMENT DATA
FED. AID.	FUNCT. CLASS.	HWY. SYS.	HPMS SAMPLE	PRKG. REST.	COM/IND ACCESS		CONTROL	COM/IND ACCESS	PRKG. REST.	

Gr. upper Marlboro
Sm. urban

SHA 51.3 - 8 Revised
4.83

MARYLAND STATE HIGHWAY ADMINISTRATION

ROAD INVENTORY SHEET CO 4979
O.P. 4632

~~DEL~~ 90-210
2-20-91
BB/BB
87-EXTRA
89-136

Party Chief WB
Recorder CG
Assistant
Map No./Dir. G 12 / E
State Coordinates 868-358

Road No.
Road Name Governor's Grove Rd
County P. G.
Date 2-5-88
Sheet No. 1 OF 2

TRAFFIC CODES
TRAFFIC CONTROLS: STOP SIGN=SS, TRAFFIC LIGHT=T.L., FLASHING RED BALL=F.R.

PARKING RESTRICTIONS: A.M. PEAK, P.M. PEAK, A.M./P.M. PEAK, NO PARKING ANYTIME=N.P., COMM/IND. ACCESS=E

SYSTEM				TRAFFIC		LINE DIAGRAM	TRAFFIC			PAVEMENT DATA
FED. AID.	FUNCT CLASS.	HWY. SYS.	HPMS SAMPLE	PK.G. REST.	COM/IND. ACCESS		CONTROL	COM/IND. ACCESS	PK.G. REST.	
					E	TO TH ~~(PROPOSED)~~ 0 46				24' I
						0 44 PT				J C-C
						0 40 (Colmar's) Col's CHOICE				24' I
						0 38 ~~(PROPOSED)~~ ~~4909~~ CO 4909				J C-C
						XXX GOV. Pratt Ct. 0 30				
						(PROPOSED) 0 29 PC				
						GOV. OGLE PL (PROPOSED) 0 25				
						STOP 0 21				
						GOV. KENTON ENT. TO T.H. 0 18 PT				
						GOV. LEE PL. ENT. TO T.H. 0 15 50°				
						PC ENT. MARLBORO C.C. 0 11				
						John Rogers Blvd				34' I
						~~(PROPOSED)~~ ~~JOHN ROGERS BLVD~~				J C-C
						~~CO~~ ~~4864~~ CO 4864 0 00 ~~CO~~ ~~4930~~ e.32				

Rural & Local

SYSTEM				TRAFFIC		LINE DIAGRAM	TRAFFIC			PAVEMENT DATA
FED. AID.	FUNCT. CLASS.	HWY. SYS.	HPMS SAMPLE	PRK.G. REST.	COM/IND ACCESS		CONTROL	COM/IND ACCESS	PRK.G. REST.	

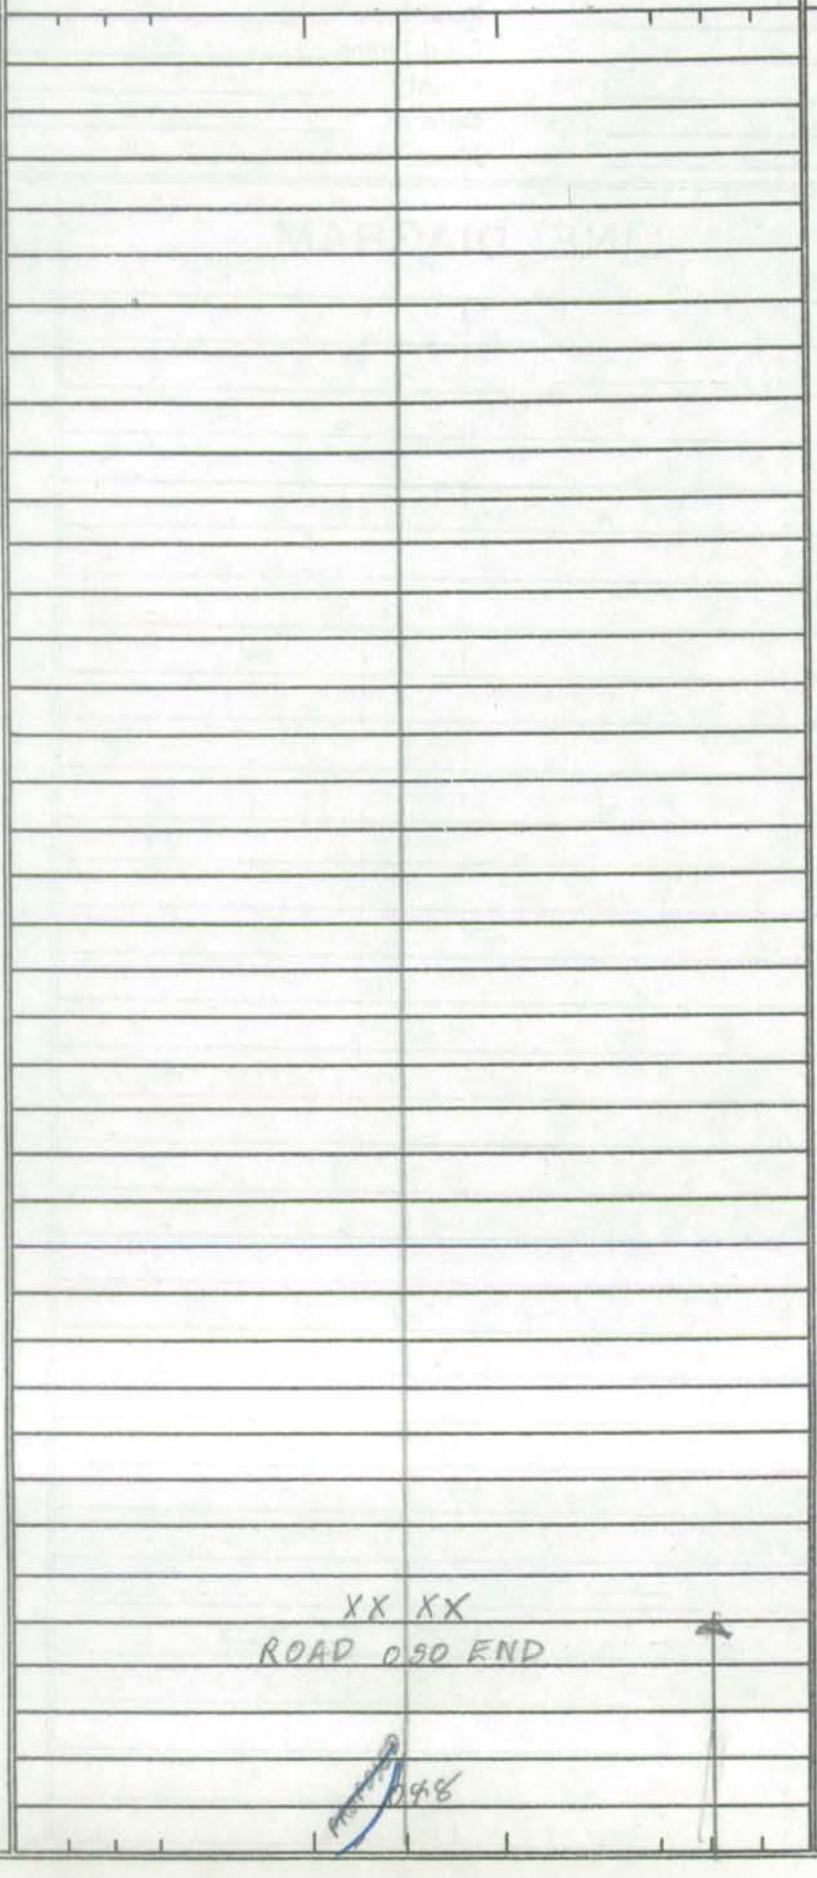

Form 6 HPS (Rev. 1961)

ROAD INVENTORY SHEET

H-11

CO 4980

97-241
3-23-98
BB/MA

822-328

Party Chief E.S.
Recorder W.D.
Chainman

THRIFT M31

VER 7-5-77

Road No. ~~CR 23~~
Name WARD Rd
Sheet No. 1 OF 1
Date 7-31-68
County PRINCE GEO

89-161

	ROAD	END	
		016	
	~~ROAD~~ H	012 ~~END~~	
		008 H	15' I
	CO	196	~~14' FI~~
	~~THRIFT~~	000 RD	~~16' CM~~
	Tippett	C.21	24ML

WO# OP 4619

Greater Upper Marlboro Sm. Urban

SHA 51.3 - 8 Revised 4.83

MARYLAND STATE HIGHWAY ADMINISTRATION

ROAD INVENTORY SHEET

Party Chief B. Burton
Recorder T. McFarland
Assistant Rewritten 4-23-90 KLP
Map No./Dir. G12 / S
State Coordinates 862-378

Road No. CO 4981
Road Name Boykin Place
County Prince Georges
Date 3-31-87
Sheet No. 1 OF 1

86-142
89-124

TRAFFIC CODES
TRAFFIC CONTROLS: STOP SIGN=SS, TRAFFIC LIGHT=T.L., FLASHING RED BALL=F.R.

TRAFFIC CODES
PARKING RESTRICTIONS: A.M. PEAK, P.M. PEAK, A.M./P.M. PEAK, NO PARKING ANYTIME=N.P., COMM/IND. ACCESS=E

SYSTEM				TRAFFIC		LINE DIAGRAM	TRAFFIC			PAVEMENT DATA
FED. AID.	FUNCT CLASS	HWY. SYS.	HPMS SAMPLE	PKG. REST.	COM/IND. ACCESS		CONTROL	COM/IND. ACCESS	PKG. REST.	
	Rural Local					Boykin Co 004 0.06 PL. 4978				24' I "J" C-C
						Hancock Co 000 0.09 DR 4748				
						PL Hancock Co 4814 0.03				

SYSTEM				TRAFFIC		LINE DIAGRAM	TRAFFIC				PAVEMENT DATA
FED. AID.	FUNCT. CLASS.	HWY. SYS.	HPMS SAMPLE	PRKG. REST.	COM/IND ACCESS		CONTROL	COM/IND ACCESS	PRKG. REST.		

Form 6 HPS (Rev. 1961)

MAP3 97-51 3-11-98 BB/AP 89-19 3-8-90 BB/BB CO 4982 ~~OP 120~~

ROAD INVENTORY SHEET

PARTY CHIEF Edward Schuyler
RECORDER Henry Gorman
CHAINMAN _____

ROAD NO. ~~OP 1299~~
NAME PARKWOOD RD
SHEET NO. 1 OF 1
DATE 9/27/67
COUNTY ~~PRINCE GEORGES~~

.13 VER 4-13-78

825-402 ~~824~~-403

F-11-D M31

ROAD	END	
0	13	20'I JC-R
~~ROAD~~	~~END~~	
005		~~25'I~~ JC-R 2 UHL
009		~~H-E~~
3 H		~~R-E~~
		~~20'C-D~~
002		
62ND AVE.		
Co. 418	000	
	e.13	

N

SHA 51.3 - 8 Revised
4.83

MARYLAND STATE HIGHWAY ADMINISTRATION

ROAD INVENTORY SHEET Bowie CO 4983

89-25

Party Chief BB
Recorder BB
Assistant
Map No./Dir. F12 / N
State Coordinates 859426

Road No. MU. 0470
Road Name CHURCH LA.
County PR. GEO.
Date 3-5-90
Sheet No. 1 OF 1

TRAFFIC CODES
TRAFFIC CONTROLS: STOP SIGN=SS, TRAFFIC LIGHT=T.L., FLASHING RED BALL=F.R.

TRAFFIC CODES
PARKING RESTRICTIONS: A.M. PEAK, P.M. PEAK, A.M./P.M. PEAK, NO PARKING ANYTIME=N.P., COMM/IND. ACCESS=E

SYSTEM				TRAFFIC		LINE DIAGRAM	TRAFFIC			PAVEMENT DATA
FED. AID.	FUNCT CLASS.	HWY. SYS.	HPMS SAMPLE	PRKG. REST.	COM/IND. ACCESS		CONTROL	COM/IND. ACCESS	PRKG. REST.	
						ROAD 024 END				
										10 E
						018				
										12'F
						Corp Limits of Bowie				16'CW
						012				
										14'F
										20'CW
						007				
										16'F
						9th ST.				20'CW
						Md. 000 564				

Unseen Local

MU 0470

CO 4983

SS

SHA 51.3 - 8 Revised
4.83

MARYLAND STATE HIGHWAY ADMINISTRATION

ROAD INVENTORY SHEET

Urban
89-57
3-1-90
BB/BB
A/T

CO 4984

Party Chief: BB
Recorder: RM
Assistant:
Map No./Dir.: F-12 / W
State Coordinates: 858-398

Road No.: ~~OR ~~
Road Name: Myer Rd
County: Prince Georges
Date: 3-26-85
Sheet No.: 1 OF 1

84-EX

TRAFFIC CODES
TRAFFIC CONTROLS: STOP SIGN=SS, TRAFFIC LIGHT=T.L., FLASHING RED BALL=F.R.

TRAFFIC CODES
PARKING RESTRICTIONS: A.M. PEAK, P.M. PEAK, A.M./P.M. PEAK, NO PARKING ANYTIME=N.P., COMM/IND. ACCESS=E

SYSTEM				TRAFFIC		LINE DIAGRAM	TRAFFIC			PAVEMENT DATA
FED. AID.	FUNCT. CLASS.	HWY. SYS.	HPMS SAMPLE	PRK.G. REST.	COM/IND. ACCESS		CONTROL	COM/IND. ACCESS	PRK.G. REST.	

SYSTEM				TRAFFIC		LINE DIAGRAM	TRAFFIC				PAVEMENT DATA
FED. AID.	FUNCT. CLASS.	HWY. SYS.	HPMS SAMPLE	PRK.G. REST.	COM/IND ACCESS		CONTROL	COM/IND ACCESS	PRK.G. REST.		

SHA 51.3-8
11-15-72

STATE HIGHWAY ADMINISTRATION OF MARYLAND

89-63 2-27-90 B/B/B A/T
97-127 3-16-98 BG/AP

ROAD INVENTORY SHEET

CO 4985

Party Chief MZ
Recorder DT.
Helper
REWRITTEN BY F.RHODES
Map No. M 35

Road No. OP 606
Road Name SUE LA.
Sheet No. 1 OF 1
Date 9/19/77
County PG.
State Coordinates 821 - 380

SE

ROAD END

H 0 11

H 0 09

50° - 62ND AVE SE. 0 03

0 01

0 00

GUNTHER ST

CO 372 #.09

.01

QUO OP 416

AVE

CO 2830

CO 4985 89-63

10'I
12'CW
26'I
C-C

SHA 51.3-8
11-15-72

ROAD INVENTORY SHEET

Road No. _____
Road Name _____
Sheet No. _____
Date _____
County _____
State Coordinates _____

89-145
2-19-90
BB/BB
A/T

SHA 51.3 - 8 Revised
4.83

MARYLAND STATE HIGHWAY ADMINISTRATION

ROAD INVENTORY SHEET

Co 4986

88 T&L.

Party Chief BB
Recorder DW
Assistant
Map No./Dir. H-11 / E
State Coordinates 797-335

Road No. ~~OR~~
Road Name Pelican Garth
County P.G
Date 3-13-89
Sheet No. 1 OF 1

TRAFFIC CODES
TRAFFIC CONTROLS: STOP SIGN=SS, TRAFFIC LIGHT=T.L., FLASHING RED BALL=F.R.

TRAFFIC CODES
PARKING RESTRICTIONS: A.M. PEAK, P.M. PEAK, A.M./P.M. PEAK, NO PARKING ANYTIME=N.P., COMM/IND. ACCESS=E

SYSTEM				TRAFFIC		LINE DIAGRAM	TRAFFIC			PAVEMENT DATA
FED. AID.	FUNCT CLASS.	HWY. SYS.	HPMS SAMPLE	PRKG. REST.	COM/IND. ACCESS		CONTROL	COM/IND. ACCESS	PRKG. REST.	
	Urban Local					D E Cul 0 15 Sac Traverse Way Co ~~OR~~ 009 4933 ~~S T~~ 0.43 Cul 0 00 Sac D E				26' I J-CC

SYSTEM				TRAFFIC		LINE DIAGRAM	TRAFFIC			PAVEMENT DATA
FED. AID.	FUNCT. CLASS.	HWY. SYS.	HPMS SAMPLE	PRK.G. REST.	COM/IND ACCESS		CONTROL	COM/IND ACCESS	PRK.G. REST.	

SHA 51.3 - 8 Revised
4.83

MARYLAND STATE HIGHWAY ADMINISTRATION

ROAD INVENTORY SHEET OP 4672

89-11

Party Chief BB
Recorder BB
Assistant
Map No./Dir. F11D / E
State Coordinates 828-410

Road No. Co 4987
Road Name BEACON LIGHT Rd.
County Pr. GEO.
Date 3-8-90
Sheet No. 1 OF 1

TRAFFIC CODES
TRAFFIC CONTROLS: STOP SIGN=SS, TRAFFIC LIGHT=T.L., FLASHING RED BALL=F.R.

TRAFFIC CODES
PARKING RESTRICTIONS: A.M. PEAK, P.M. PEAK, A.M./P.M. PEAK, NO PARKING ANYTIME=N.P., COMM/IND. ACCESS=E

SYSTEM				TRAFFIC		LINE DIAGRAM	TRAFFIC			PAVEMENT DATA
FED. AID.	FUNCT CLASS.	HWY. SYS.	HPMS SAMPLE	PRKG. REST.	COM/IND. ACCESS		CONTROL	COM/IND. ACCESS	PRKG. REST.	
	Urban Local					ROAD 0.19 END				
						↑30° 0.15 OP 4672				
						0.10				
						CO 4987				10'D
						Furman PKWY				16'CW
						0.00 OP 719 (CO 1779) 0.67				

OP 4672

SYSTEM				TRAFFIC		LINE DIAGRAM	TRAFFIC			PAVEMENT DATA
FED. AID.	FUNCT. CLASS.	HWY. SYS.	HPMS SAMPLE	PRKG. REST.	COM/IND ACCESS		CONTROL	COM/IND ACCESS	PRKG. REST.	

SHA 51.3 - 8 Revised
4.83

MARYLAND STATE HIGHWAY ADMINISTRATION

89-13

ROAD INVENTORY SHEET

Party Chief BB
Recorder BB
Assistant
Map No./Dir. FIID / E
State Coordinates 823-408

Road No. Co 4988
Road Name INGRAHAM ST.
County Pr. GEO.
Date 3-8-90
Sheet No. 1 OF 1

97-049

SYSTEM: FED. AID. | FUNCT CLASS. | HWY. SYS. | HPMS SAMPLE
TRAFFIC: PKG. REST. | COM/IND. ACCESS

LINE DIAGRAM

TRAFFIC: CONTROL | COM/IND. ACCESS | PKG. REST.

PAVEMENT DATA

PKG LOT

XX XX

Rou ROAD 0.07 END

Urban local

SPLIT TO MD 201 XXXXXXXX EDMONSTON Rd

0.00 CO 3168

0.02

EDMONSTON Rd
CO 3168

12'G
10'B
18'CW

TRAFFIC CODES

TRAFFIC CONTROLS: STOP SIGN=S.S.,
TRAFFIC LIGHT=T.L.,
FLASHING RED BALL=F.R.

TRAFFIC CODES

PARKING RESTRICTIONS: A.M. PEAK,
P.M. PEAK, A.M./P.M. PEAK, NO PARKING
ANYTIME=N.P., COMM/IND. ACCESS=E

SYSTEM				TRAFFIC		LINE DIAGRAM	TRAFFIC			PAVEMENT DATA
FED. AID.	FUNCT. CLASS.	HWY. SYS.	HPMS SAMPLE	PRK'G. REST.	COM/IND ACCESS		CONTROL	COM/IND ACCESS	PRK'G. REST.	

SHA 51.3 - 8 Revised
4.83

MARYLAND STATE HIGHWAY ADMINISTRATION

ROAD INVENTORY SHEET

89-21

Party Chief BB
Recorder BB
Assistant
Map No./Dir. FIID / S
State Coordinates 828-394

Road No. Co. 4989
Road Name STANFORD CT
County Pr. GEO.
Date 3/8/90
Sheet No. 1 OF 1

TRAFFIC CODES
TRAFFIC CONTROLS: STOP SIGN=SS, TRAFFIC LIGHT=T.L., FLASHING RED BALL=F.R.

TRAFFIC CODES
PARKING RESTRICTIONS: A.M. PEAK, P.M. PEAK, A.M./P.M. PEAK, NO PARKING ANYTIME=N.P., COMM/IND. ACCESS=E

SYSTEM				TRAFFIC		LINE DIAGRAM	TRAFFIC			PAVEMENT DATA
FED. AID.	FUNCT CLASS.	HWY. SYS.	HPMS SAMPLE	PRKG. REST.	COM/IND. ACCESS		CONTROL	COM/IND. ACCESS	PRKG. REST.	
						D E				
						CUL 0095MC				
										48 I
						COLUMBIA PARK Rd.				JC-C
						CO. 0 00 3668	55			
						C 1.07				

Urban Local

SYSTEM				TRAFFIC		LINE DIAGRAM	TRAFFIC			PAVEMENT DATA
FED. AID.	FUNCT. CLASS.	HWY. SYS.	HPMS SAMPLE	PRKG. REST.	COM/IND ACCESS		CONTROL	COM/IND ACCESS	PRKG. REST.	

CO 4990

PRINCE GEORGE'S COUNTY

UNASSIGNED

NOW MU 2735

STEEPLECHASE DR

BOWIE

02-50MU/02-28CO

CO 4991

PRINCE GEORGE'S COUNTY

UNASSIGNED

NOW MU 2736

STEEPLECHASE CT

BOWIE

02-51MU/02-29CO

CO 4992

PRINCE GEORGE'S COUNTY

UNASSIGNED

NOW MU 3005

TRIPLECROWN RD

BOWIE

02-49MU/02-31CO

SHA 51.3 - 8 Revised
4.83

* County reported .12 mi. (89-40)

MARYLAND STATE HIGHWAY ADMINISTRATION

ROAD INVENTORY SHEET

00-15 ST
GD, EF
2/20/01
89-40
97-105
3-11-98
BB/AP

Party Chief BB
Recorder BB
Assistant
Map No./Dir. F12 C / N
State Coordinates 850-409

Road No. Co. 4993
Road Name SELTZER Rd.
County Pr. GEO.
Date 3-1-90
Sheet No. 1 OF 1

TRAFFIC CODES
TRAFFIC CONTROLS: STOP SIGN=SS, TRAFFIC LIGHT=T.L., FLASHING RED BALL=F.R.

TRAFFIC CODES
PARKING RESTRICTIONS: A.M. PEAK, P.M. PEAK, A.M./P.M. PEAK, NO PARKING ANYTIME=N.P., COMM/IND. ACCESS=E

SYSTEM				TRAFFIC		LINE DIAGRAM	TRAFFIC			PAVEMENT DATA
FED. AID.	FUNCT CLASS.	HWY. SYS.	HPMS SAMPLE	PRKG. REST.	COM/IND. ACCESS		CONTROL	COM/IND. ACCESS	PRKG. REST.	

SYSTEM				TRAFFIC		LINE DIAGRAM	TRAFFIC			PAVEMENT DATA
FED. AID.	FUNCT. CLASS.	HWY. SYS.	HPMS SAMPLE	PRKG. REST.	COM/IND ACCESS		CONTROL	COM/IND ACCESS	PRKG. REST.	

SHA 51.3 - 8 Revised
4.83

MARYLAND STATE HIGHWAY ADMINISTRATION

ROAD INVENTORY SHEET

89-41

Party Chief BB
Recorder BB
Assistant
Map No./Dir. F12 / N
State Coordinates 848.405

Road No. Co. 4994
Road Name CARIBON CT
County Pr. GEO.
Date 3-1-90
Sheet No. 1 OF 1

SYSTEM				TRAFFIC		LINE DIAGRAM	TRAFFIC			PAVEMENT DATA
FED. AID.	FUNCT CLASS.	HWY. SYS.	HPMS SAMPLE	PRK.G. REST.	COM/IND. ACCESS		CONTROL	COM/IND. ACCESS	PRK.G. REST.	
						D E				
						CUL 0 04 SAC				
										24'I
						CARIBON ST.				JC-C
						Co. 0 00 4710				
						0.37				

Urban Local

TRAFFIC CODES

TRAFFIC CONTROLS: STOP SIGN=SS, TRAFFIC LIGHT=T.L., FLASHING RED BALL=F.R.

TRAFFIC CODES

PARKING RESTRICTIONS: A.M. PEAK, P.M. PEAK, A.M./P.M. PEAK, NO PARKING ANYTIME=N.P., COMM/IND. ACCESS=E

SYSTEM				TRAFFIC		LINE DIAGRAM	TRAFFIC			PAVEMENT DATA
FED. AID.	FUNCT. CLASS.	HWY. SYS.	HPMS SAMPLE	PRKG. REST.	COM/IND ACCESS		CONTROL	COM/IND ACCESS	PRKG. REST.	

SHA 51.3 - 8 Revised
4.83

MARYLAND STATE HIGHWAY ADMINISTRATION

ROAD INVENTORY SHEET

89-50

Party Chief BB
Recorder BB
Assistant
Map No./Dir. F12 / E
State Coordinates 857-405

Road No. Co. 4995
Road Name SOLOBERG LA
County Pr. GEO.
Date 3-1-90
Sheet No. 1 OF 1

SYSTEM: FED. AID. | FUNCT CLASS. | HWY. SYS. | HPMS SAMPLE
TRAFFIC: PRK.G. REST. | COM/IND. ACCESS

LINE DIAGRAM

Prvt. Dr.

ROAD 0|19 END

Urban local

0|00 MD 974
@.08

MD 974

TRAFFIC: CONTROL | COM/IND. ACCESS | PRK.G. REST.

PAVEMENT DATA

12'E
16'CW

TRAFFIC CODES
TRAFFIC CONTROLS: STOP SIGN=SS, TRAFFIC LIGHT=T.L., FLASHING RED BALL=F.R.

TRAFFIC CODES
PARKING RESTRICTIONS: A.M. PEAK, P.M. PEAK, A.M./P.M. PEAK, NO PARKING ANYTIME=N.P., COMM/IND. ACCESS=E

SYSTEM				TRAFFIC		LINE DIAGRAM	TRAFFIC			PAVEMENT DATA
FED. AID.	FUNCT. CLASS.	HWY. SYS.	HPMS SAMPLE	PRKG. REST.	COM/IND ACCESS		CONTROL	COM/IND ACCESS	PRKG. REST.	

SHA 51.3 - 8 Revised
4.83

MARYLAND STATE HIGHWAY ADMINISTRATION

ROAD INVENTORY SHEET

89-54

Party Chief BB
Recorder BB
Assistant
Map No./Dir. F12 / W
State Coordinates 869-401

Road No. Co. 4996
Road Name MT. OAK CT.
County PR. GEO.
Date 3-1-90
Sheet No. 1 OF

SYSTEM: FED. AID. | FUNCT. CLASS. | HWY. SYS. | HPMS SAMPLE
TRAFFIC: PRKG. REST. | COM/IND. ACCESS

LINE DIAGRAM

TRAFFIC: CONTROL | COM/IND. ACCESS | PRKG. REST.

PAVEMENT DATA

TRAFFIC CODES
TRAFFIC CONTROLS: STOP SIGN=SS, TRAFFIC LIGHT=T.L., FLASHING RED BALL=F.R.

TRAFFIC CODES
PARKING RESTRICTIONS: A.M. PEAK, P.M. PEAK, A.M./P.M. PEAK, NO PARKING ANYTIME=N.P., COMM/IND. ACCESS=E

Urban local

D E
CUL 0 14 SAC

18'I
26'CW.

CHURCH Rd
Co. 0 0 0 59 SS

Aug. 2000 Valid for 1999 MU SSS (Bowie)

SYSTEM				TRAFFIC		LINE DIAGRAM	TRAFFIC			PAVEMENT DATA
FED. AID.	FUNCT. CLASS.	HWY. SYS.	HPMS SAMPLE	PRKG. REST.	COM/IND ACCESS		CONTROL	COM/IND ACCESS	PRKG. REST.	

94 Co. Ex. #17 A/T
3-7-95
DT/TM

89-60

SHA 51.3 - 8 Revised
4.83

* county reported .09 mi. (89-60)

MARYLAND STATE HIGHWAY ADMINISTRATION

Capitol Heights

ROAD INVENTORY SHEET

Party Chief BB
Recorder BB
Assistant
Map No./Dir. G11B / S
State Coordinates 829-~~374~~380

Road No. Co 4997
Road Name OLD WALNUT ST
County Pr. GEO.
Date 2/27/90
Sheet No. 1 OF 1

SYSTEM				TRAFFIC		LINE DIAGRAM	TRAFFIC			PAVEMENT DATA
FED. AID.	FUNCT CLASS.	HWY. SYS.	HPMS SAMPLE	PRK.G. REST.	COM/IND. ACCESS		CONTROL	COM/IND. ACCESS	PRK.G. REST.	
						ROAD 005 END				
	Urban Local					002				12'D 16'CW 20'D 20'CW
						DISTRICT AVE ~~PR~~ Co 000 3118 (63118) @.04				

TRAFFIC CODES

TRAFFIC CONTROLS: STOP SIGN=SS, TRAFFIC LIGHT=T.L., FLASHING RED BALL=F.R.

TRAFFIC CODES

PARKING RESTRICTIONS: A.M. PEAK, P.M. PEAK, A.M./P.M. PEAK, NO PARKING ANYTIME=N.P., COMM/IND. ACCESS=E

SYSTEM				TRAFFIC		LINE DIAGRAM	TRAFFIC				PAVEMENT DATA
FED. AID.	FUNCT. CLASS.	HWY. SYS.	HPMS SAMPLE	PRKG. REST.	COM/IND ACCESS		CONTROL	COM/IND ACCESS	PRKG. REST.		

SHA 51.3 - 8 Revised
4.83

MARYLAND STATE HIGHWAY ADMINISTRATION

ROAD INVENTORY SHEET

89-67

92-83
3-23-93
GD/JS

Party Chief BB
Recorder BB
Assistant
Map No./Dir. G11B / W
State Coordinates 822-372

Road No. Co. 4998
Road Name CROSIER PL-ST
County PR. GEO.
Date 2/27/90
Sheet No. 1 OF 1

SYSTEM				TRAFFIC		LINE DIAGRAM	TRAFFIC			PAVEMENT DATA
FED. AID.	FUNCT CLASS.	HWY. SYS.	HPMS SAMPLE	PRKG. REST.	COM/IND. ACCESS		CONTROL	COM/IND. ACCESS	PRKG. REST.	
						FORT DR (Spaulding Ave)				
						Co 11016 ROAD 0.07 END				
										20'I
										IC-RT
						DUPONT AVE				
						0.02 Co 4999				
										24'I
										IC-RT
						BROOKS DR.				
						OP 643 0.00				
						(Co 707) @.07				

TRAFFIC CODES

TRAFFIC CONTROLS: STOP SIGN=SS, TRAFFIC LIGHT=T.L., FLASHING RED BALL=F.R.

TRAFFIC CODES

PARKING RESTRICTIONS: A.M. PEAK, P.M. PEAK, A.M./P.M. PEAK, NO PARKING ANYTIME=N.P., COMM/IND. ACCESS=E

FAU 5220
Urban 20 mph

SYSTEM				TRAFFIC		LINE DIAGRAM	TRAFFIC				PAVEMENT DATA
FED. AID.	FUNCT. CLASS.	HWY. SYS.	HPMS SAMPLE	PRK'G. REST.	COM/IND ACCESS		CONTROL	COM/IND ACCESS	PRK'G. REST.		

SHA 51.3 - 8 Revised
4.83

MARYLAND STATE HIGHWAY ADMINISTRATION

ROAD INVENTORY SHEET

89-66

Party Chief BB
Recorder BB
Assistant
Map No./Dir. G11B / N
State Coordinates 822-372

Road No. Co. 4999
Road Name DUPONT AVE.
County Pr. GEO.
Date 2/27/90
Sheet No. 1 OF 1

TRAFFIC CODES
TRAFFIC CONTROLS: STOP SIGN=SS, TRAFFIC LIGHT=T.L., FLASHING RED BALL=F.R.

TRAFFIC CODES
PARKING RESTRICTIONS: A.M. PEAK, P.M. PEAK, A.M./P.M. PEAK, NO PARKING ANYTIME=N.P., COMM/IND. ACCESS=E

SYSTEM				TRAFFIC		LINE DIAGRAM	TRAFFIC			PAVEMENT DATA
FED. AID.	FUNCT CLASS.	HWY. SYS.	HPMS SAMPLE	PRK.G. REST.	COM/IND. ACCESS		CONTROL	COM/IND. ACCESS	PRK.G. REST.	

SYSTEM				TRAFFIC		LINE DIAGRAM	TRAFFIC			PAVEMENT DATA
FED. AID.	FUNCT. CLASS.	HWY. SYS.	HPMS SAMPLE	PRK.G. REST.	COM/IND ACCESS		CONTROL	COM/IND ACCESS	PRK.G. REST.	

SHA 51.3 - 8 Revised
4.83

MARYLAND STATE HIGHWAY ADMINISTRATION

ROAD INVENTORY SHEET

89-70

Party Chief BB
Recorder BB
Assistant
Map No./Dir. G11C / N
State Coordinates 806-345

Road No. Co. 5000
Road Name WILSON WAY
County P.G.
Date 2-19-90
Sheet No. 1 OF 1

97-159

SYSTEM: FED. AID. | FUNCT CLASS. | HWY. SYS. | HPMS SAMPLE
TRAFFIC: PRK.G. REST. | COM/IND. ACCESS

LINE DIAGRAM

TRAFFIC: CONTROL | COM/IND. ACCESS | PRK.G. REST.

PAVEMENT DATA

PAVT RD

GATE

ROAD 0 10 END

Urban Local

16' H

FERGUSON LA.

OP 32 0.00 Co 4440

@.15 (Co 4440)

TRAFFIC CODES

TRAFFIC CONTROLS: STOP SIGN=SS, TRAFFIC LIGHT=T.L., FLASHING RED BALL=F.R.

TRAFFIC CODES

PARKING RESTRICTIONS: A.M. PEAK, P.M. PEAK, A.M./P.M. PEAK, NO PARKING ANYTIME=N.P., COMM/IND. ACCESS=E

SYSTEM				TRAFFIC		LINE DIAGRAM	TRAFFIC				PAVEMENT DATA
FED. AID.	FUNCT. CLASS.	HWY. SYS.	HPMS SAMPLE	PRKG. REST.	COM/IND ACCESS		CONTROL	COM/IND ACCESS	PRKG. REST.		

SHA 51.3 - 8 Revised
4.83

MARYLAND STATE HIGHWAY ADMINISTRATION

ROAD INVENTORY SHEET OP 4676

89-75

Party Chief BB
Recorder BD
Assistant
Map No./Dir. 61IC / W
State Coordinates 793-339

Road No. Co. 5001
Road Name Belleau Trail
County P.G.
Date 2-19-90
Sheet No. 1 OF 1

see 97 Notes + Comments
97-162

TRAFFIC CODES
TRAFFIC CONTROLS: STOP SIGN=SS, TRAFFIC LIGHT=T.L., FLASHING RED BALL=F.R.

TRAFFIC CODES
PARKING RESTRICTIONS: A.M. PEAK, P.M. PEAK, A.M./P.M. PEAK, NO PARKING ANYTIME=N.P., COMM/IND. ACCESS=E

SYSTEM				TRAFFIC		LINE DIAGRAM	TRAFFIC			PAVEMENT DATA
FED. AID.	FUNCT. CLASS.	HWY. SYS.	HPMS SAMPLE	PRKG. REST.	COM/IND. ACCESS		CONTROL	COM/IND. ACCESS	PRKG. REST.	
	Urban Local					ROAD 0 05' END				
						003				11'G 8' 15'CW
						OVERLOOK TRAIL 000 Co. 2950				

Co. 5001

Verdun Trail
Co. 5007

SYSTEM				TRAFFIC		LINE DIAGRAM	TRAFFIC			PAVEMENT DATA
FED. AID.	FUNCT. CLASS.	HWY. SYS.	HPMS SAMPLE	PRKG. REST.	COM/IND ACCESS		CONTROL	COM/IND ACCESS	PRKG. REST.	

SHA 51.3 - 8 Revised 4.83

MARYLAND STATE HIGHWAY ADMINISTRATION

ROAD INVENTORY SHEET ~~XR FORT~~

89-78

Party Chief BB
Recorder BB
Assistant
Map No./Dir. GIID / N
State Coordinates 812-361

Road No. Co. 5002
Road Name Hidden Pine La.
County Prince Georges
Date 2/20/90
Sheet No. 1 OF 1

91-106

TRAFFIC CODES
TRAFFIC CONTROLS: STOP SIGN=SS, TRAFFIC LIGHT=T.L., FLASHING RED BALL=F.R.

TRAFFIC CODES
PARKING RESTRICTIONS: A.M. PEAK, P.M. PEAK, A.M./P.M. PEAK, NO PARKING ANYTIME=N.P., COMM/IND. ACCESS=E

SYSTEM				TRAFFIC		LINE DIAGRAM	TRAFFIC			PAVEMENT DATA
FED. AID.	FUNCT CLASS.	HWY. SYS.	HPMS SAMPLE	PRKG. REST.	COM/IND. ACCESS		CONTROL	COM/IND ACCESS	PRKG. REST.	
						D E				
						CUL 0 28 SAC				
						PT 0 27				
						30°				
						PRC 0 22 PRC				
						PINE BLUFF CIR				
						0 20 Co (5269)				
						60°				
						GATEWAY DR				
						0 16 Co 5270 PC				
						0 10				
						WHITE PINE CT.				
						Co. 0 07 5003				
						0.06				
										26'I
										JC-C
						JOHN A. THOMPSON Rd.				
						Co. 0 00 4449				
						0.23				

Urban Local

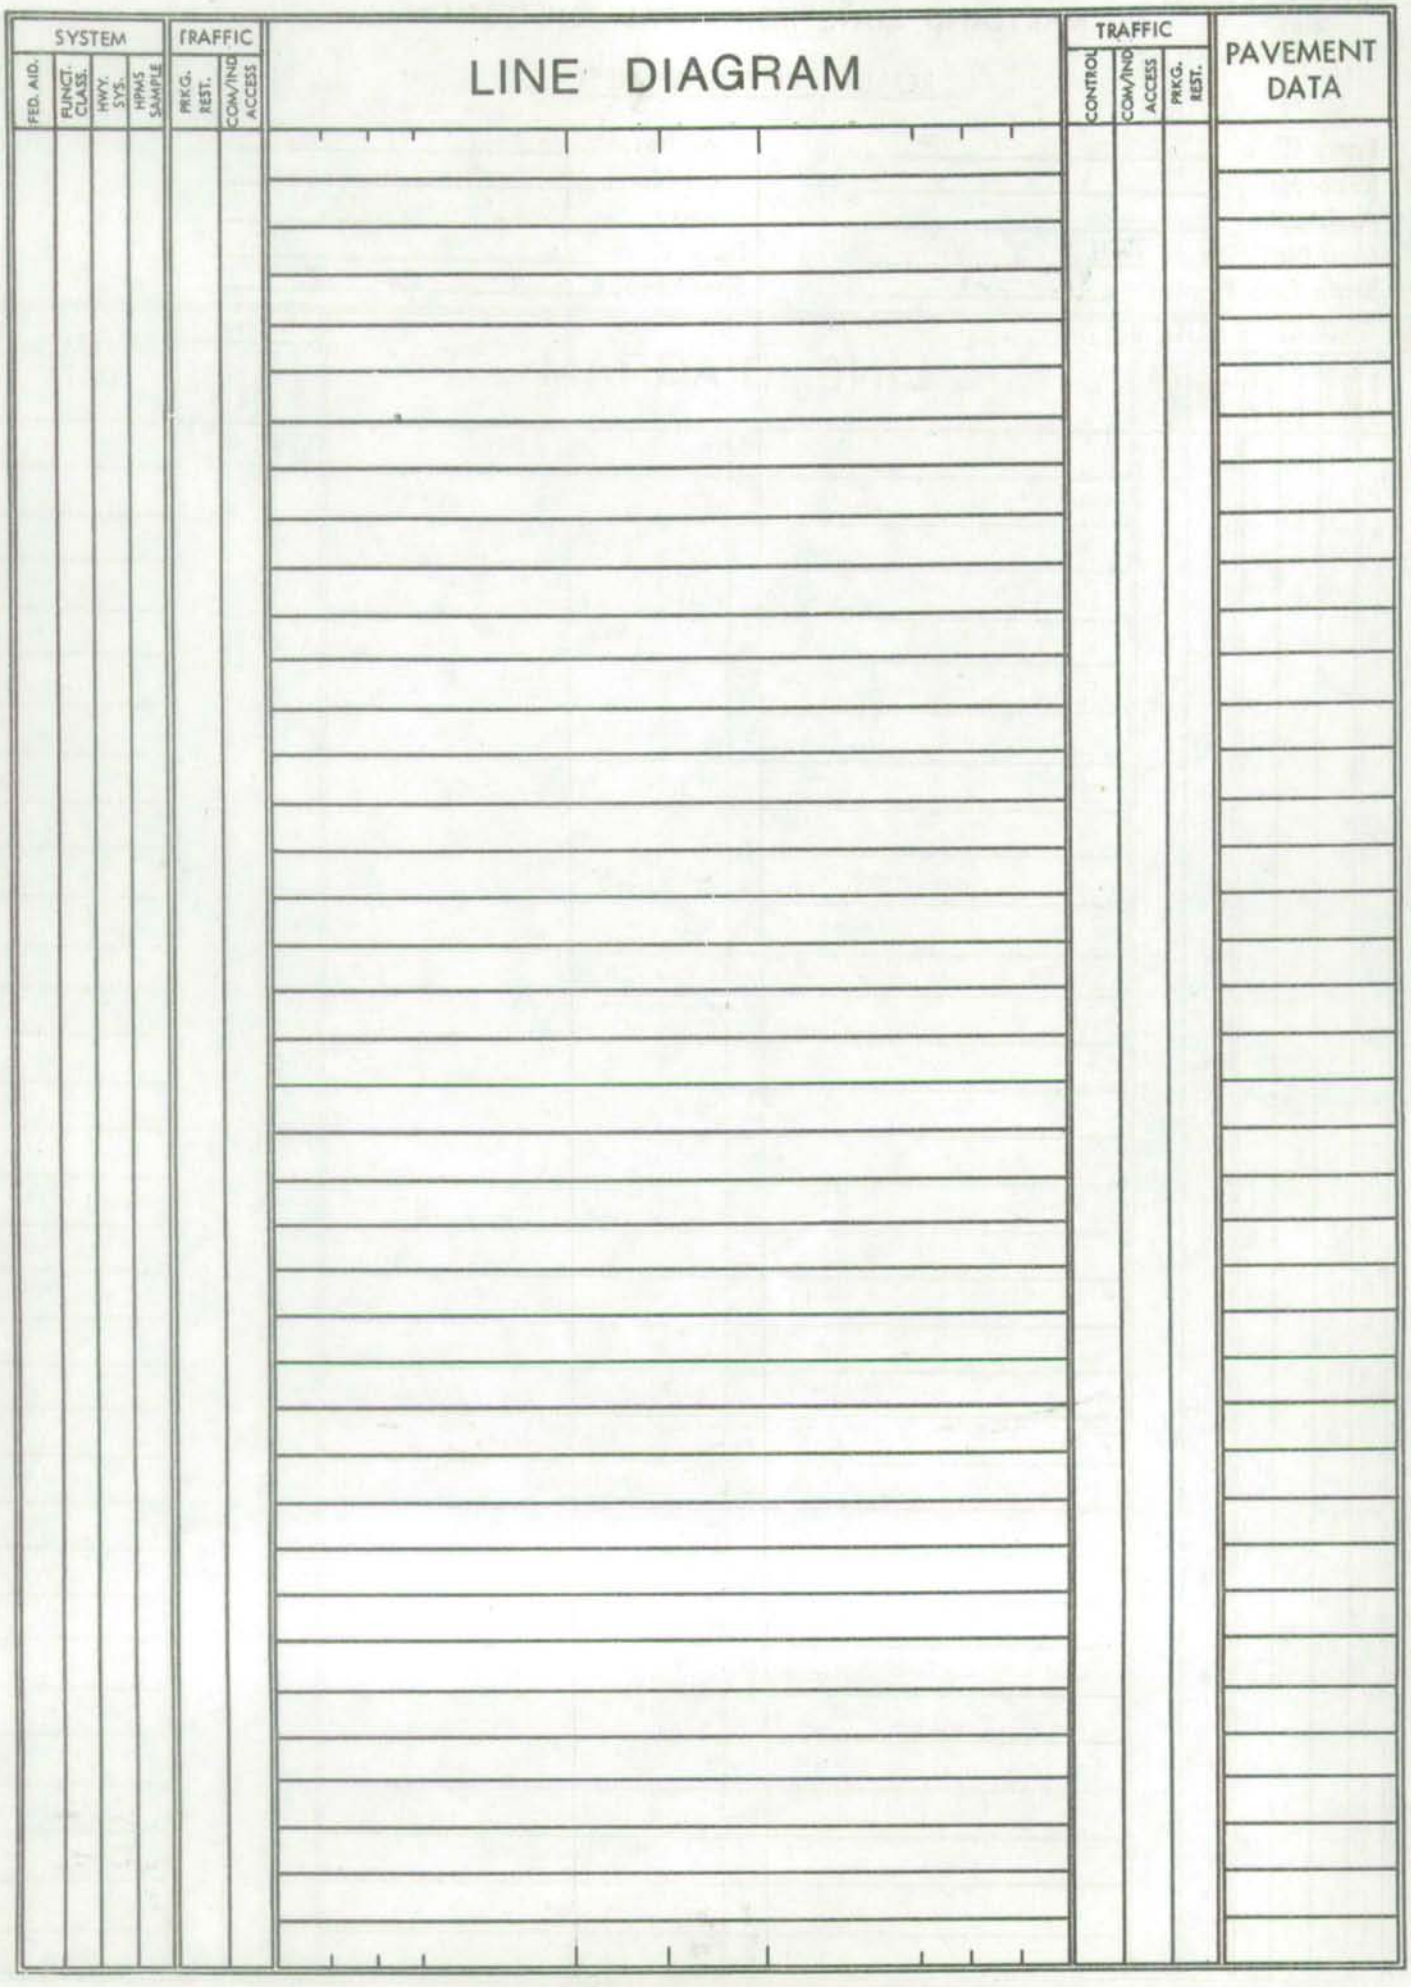
SYSTEM
FED. AID.
FUNCT. CLASS.
HWY. SYS.
HPMS SAMPLE
TRAFFIC
PRK.G. REST.
COM/IND ACCESS
LINE DIAGRAM
TRAFFIC
CONTROL
COM/IND ACCESS
PRK.G. REST.
PAVEMENT DATA

SHA 51.3 - 8 Revised
4.83

MARYLAND STATE HIGHWAY ADMINISTRATION

ROAD INVENTORY SHEET

89-77

Party Chief BB
Recorder BB
Assistant
Map No./Dir. 6110 / E
State Coordinates 812-361

Road No. Co 5003
Road Name WHITE PINE CT
County PRINCE GEORGES
Date 2/20/90
Sheet No. 1 OF 1

SYSTEM				TRAFFIC		LINE DIAGRAM	TRAFFIC			PAVEMENT DATA
FED. AID.	FUNCT CLASS.	HWY. SYS.	HPMS SAMPLE	PRKG. REST.	COM/IND. ACCESS		CONTROL	COM/IND. ACCESS	PRKG. REST.	
	Urban local					D E CUL 0 10 SAC HIDDEN PINE LA. CO. 0 0 0 0 5002 e.07 CUL 0 00 SAC D E				26' F JC-C

TRAFFIC CODES

TRAFFIC CONTROLS: STOP SIGN=SS, TRAFFIC LIGHT=T.L., FLASHING RED BALL=F.R.

TRAFFIC CODES

PARKING RESTRICTIONS: A.M. PEAK, P.M. PEAK, A.M./P.M. PEAK, NO PARKING ANYTIME=N.P., COMM/IND. ACCESS=E

SYSTEM				TRAFFIC		LINE DIAGRAM	TRAFFIC			PAVEMENT DATA
FED. AID.	FUNCT. CLASS.	HWY. SYS.	HPMS SAMPLE	PRKG. REST.	COM/IND ACCESS		CONTROL	COM/IND ACCESS	PRKG. REST.	

SHA 51.3 - 8 Revised 4.83

MARYLAND STATE HIGHWAY ADMINISTRATION

ROAD INVENTORY SHEET OP 4874

91-115
2-27-92
DT/JS
89-90
90-181

Party Chief BB
Recorder BB
Assistant
Map No./Dir. GIID / NW
State Coordinates 817-349

Road No. Co. 5004
Road Name COPPERVILLE WAY
County P.G.
Date 2-21-90
Sheet No. 1 OF 1

SYSTEM: FED. AID. | FUNCT. CLASS. | HWY. SYS. | HPMS SAMPLE
TRAFFIC: PRK.G. REST. | COM/IND. ACCESS

TRAFFIC CODES
TRAFFIC CONTROLS: STOP SIGN=SS, TRAFFIC LIGHT=T.L., FLASHING RED BALL=F.R.

TRAFFIC CODES
PARKING RESTRICTIONS: A.M. PEAK, P.M. PEAK, A.M./P.M. PEAK, NO PARKING ANYTIME=N.P., COMM/IND. ACCESS=E

LINE DIAGRAM

TRAFFIC: CONTROL | COM/IND. ACCESS | PRK.G. REST.

PAVEMENT DATA

CHERRYFIELD RD
OP 0.45 4668 @.48
0.42
C45° 0.39
HENSON VALLEY WAY 0.29
CO 5274 0.27
PT 0.18
COPPERVILLE PL
CO 5275 0.12
80° ROAD 0.10 END
PC 0.08
Greenboro LA.
0.07 Co 5005
Urban Local
CHERRYFIELD Rd.
CO. 0.00 4732 @.10

36'I
JC-C
26'I
JC-C

SYSTEM				TRAFFIC		LINE DIAGRAM	TRAFFIC			PAVEMENT DATA
FED. AID.	FUNCT. CLASS.	HWY. SYS.	HPMS SAMPLE	PRK.G. REST.	COM/IND ACCESS		CONTROL	COM/IND ACCESS	PRK.G. REST.	

SHA 51.3 - 8 Revised
4.83

MARYLAND STATE HIGHWAY ADMINISTRATION

ROAD INVENTORY SHEET

89-89
91-113
2-2792
DT/JS

Party Chief BB
Recorder BB
Assistant
Map No./Dir. 61ID / N
State Coordinates 817-349

Road No. Co. 5005
Road Name Greenboro La.
County P.G.
Date 2-21-90
Sheet No. 1 OF 1

TRAFFIC CODES
TRAFFIC CONTROLS: STOP SIGN=SS, TRAFFIC LIGHT=T.L., FLASHING RED BALL=F.R.

TRAFFIC CODES
PARKING RESTRICTIONS: A.M. PEAK, P.M. PEAK, A.M./P.M. PEAK, NO PARKING ANYTIME=N.P., COMM/IND. ACCESS=E

SYSTEM				TRAFFIC		LINE DIAGRAM	TRAFFIC			PAVEMENT DATA
FED. AID.	FUNCT CLASS.	HWY. SYS.	HPMS SAMPLE	PRKG. REST.	COM/IND. ACCESS		CONTROL	COM/IND. ACCESS	PRKG. REST.	
	Urban Local					DE CUL 0.23 SAC ROAD 0.02 END COPPERVILLE WAY Co 0.00 5004 0.07				26 I JC-C

SYSTEM				TRAFFIC		LINE DIAGRAM	TRAFFIC			PAVEMENT DATA
FED. AID.	FUNCT. CLASS.	HWY. SYS.	HPMS SAMPLE	PRKG. REST.	COM/IND ACCESS		CONTROL	COM/IND ACCESS	PRKG. REST.	

SHA 51.3 - 8 Revised
4.83

MARYLAND STATE HIGHWAY ADMINISTRATION

ROAD INVENTORY SHEET

89-175

Party Chief BB
Recorder BB
Assistant
Map No./Dir. G11D / E
State Coordinates 821-345

Road No. Co 5006
Road Name KIRBYWOOD ST.
County PR. GEO.
Date 2-21-90
Sheet No. 1 OF

TRAFFIC CODES
TRAFFIC CONTROLS: STOP SIGN=SS, TRAFFIC LIGHT=T.L., FLASHING RED BALL=F.R.

TRAFFIC CODES
PARKING RESTRICTIONS: A.M. PEAK, P.M. PEAK, A.M./P.M. PEAK, NO PARKING ANYTIME=N.P., COMM/IND. ACCESS=E

SYSTEM				TRAFFIC		LINE DIAGRAM	TRAFFIC			PAVEMENT DATA
FED. AID.	FUNCT CLASS.	HWY. SYS.	HPMS SAMPLE	PRKG. REST.	COM/IND. ACCESS		CONTROL	COM/IND. ACCESS	PRKG. REST.	
						X——X				
						ROAD 0 14 END				
						SUMMITWOOD CT.				
						Co. 5008 0 12				
						OAKWOOD DR.				
						Co. 5007 0 06				
						TEMPLE HILLS RD.				26'I
						Co. 0 00 123	SS			JC-C
						@ 1.72				

Urban Local

SYSTEM				TRAFFIC		LINE DIAGRAM	TRAFFIC			PAVEMENT DATA
FED. AID.	FUNCT. CLASS.	HWY. SYS.	HPMS SAMPLE	PRKG. REST.	COM/IND ACCESS		CONTROL	COM/IND ACCESS	PRKG. REST.	

SHA 51.3 - 8 Revised
4.83

MARYLAND STATE HIGHWAY ADMINISTRATION

ROAD INVENTORY SHEET

89-95

Party Chief BB
Recorder BB
Assistant
Map No./Dir. G11D / N
State Coordinates 821-345

Road No. Co-5007
Road Name OAKWOOD DR.
County PR. GEO.
Date 2-21-90
Sheet No. 1 OF 1

TRAFFIC CODES
TRAFFIC CONTROLS: STOP SIGN=S.S., TRAFFIC LIGHT=T.L., FLASHING RED BALL=F.R.

TRAFFIC CODES
PARKING RESTRICTIONS: A.M. PEAK, P.M. PEAK, A.M./P.M. PEAK, NO PARKING ANYTIME=N.P., COMM/IND. ACCESS=E

SYSTEM				TRAFFIC		LINE DIAGRAM	TRAFFIC			PAVEMENT DATA
FED. AID.	FUNCT CLASS.	HWY. SYS.	HPMS SAMPLE	PKG. REST.	COM/IND. ACCESS		CONTROL	COM/IND. ACCESS	PKG. REST.	
	↑								↑	
						ROAD 0 07 END				
	Urban local									
										26'I
						KIRBYWOOD ST.				JC-C
	↓					CO 0 00 5006			↓	
						2.106				

SYSTEM				TRAFFIC		LINE DIAGRAM	TRAFFIC			PAVEMENT DATA
FED. AID.	FUNCT. CLASS.	HWY. SYS.	HPMS SAMPLE	PRKG. REST.	COM/IND ACCESS		CONTROL	COM/IND ACCESS	PRKG. REST.	

SHA 51.3 - 8 Revised
4.83

MARYLAND STATE HIGHWAY ADMINISTRATION

ROAD INVENTORY SHEET

89-96

Party Chief BB
Recorder BB
Assistant
Map No./Dir. 6110 / N
State Coordinates 821-345

Road No. Co. 5008
Road Name SUMMITWOOD CT.
County PR. GEO.
Date 2-21-90
Sheet No. 1 OF 1

TRAFFIC CODES
TRAFFIC CONTROLS: STOP SIGN=SS, TRAFFIC LIGHT=T.L., FLASHING RED BALL=F.R.

TRAFFIC CODES
PARKING RESTRICTIONS: A.M. PEAK, P.M. PEAK, A.M./P.M. PEAK, NO PARKING ANYTIME=N.P., COMM/IND. ACCESS=E

SYSTEM				TRAFFIC		LINE DIAGRAM	TRAFFIC			PAVEMENT DATA
FED. AID.	FUNCT CLASS.	HWY. SYS.	HPMS SAMPLE	PRK.G. REST.	COM/IND. ACCESS		CONTROL	COM/IND. ACCESS	PRK.G. REST.	
						D E				
	1					CUL 0 04 SAC			↑	
	Urban Local									
										26 I
						KIRBYWOOD ST				JC-C
	↓					CO. 0 00 5006 0.12			↓	

SYSTEM				TRAFFIC		LINE DIAGRAM	TRAFFIC			PAVEMENT DATA
FED. AID.	FUNCT. CLASS.	HWY. SYS.	HPMS SAMPLE	PRKG. REST.	COM/IND ACCESS		CONTROL	COM/IND ACCESS	PRKG. REST.	

SHA 51.3 - 8 Revised
4.83

MARYLAND STATE HIGHWAY ADMINISTRATION

ROAD INVENTORY SHEET

89-101

Party Chief BB
Recorder BB
Assistant
Map No./Dir. GIID / N
State Coordinates 820-340

Road No. Co. 5009
Road Name Hiwassee DR.
County PR. GEO.
Date 2/27/90
Sheet No. 1 OF 1

TRAFFIC CODES
TRAFFIC CONTROLS: STOP SIGN=SS, TRAFFIC LIGHT=T.L., FLASHING RED BALL=F.R.

TRAFFIC CODES
PARKING RESTRICTIONS: A.M. PEAK, P.M. PEAK, A.M./P.M. PEAK, NO PARKING ANYTIME=N.P., COMM/IND. ACCESS=E

SYSTEM				TRAFFIC		LINE DIAGRAM	TRAFFIC			PAVEMENT DATA
FED. AID.	FUNCT CLASS.	HWY. SYS.	HPMS SAMPLE	PRKG. REST.	COM/IND. ACCESS		CONTROL	COM/IND. ACCESS	PRKG. REST.	
						DE				
						CUL 012 SAC				
	Urban local									
						PISGAH DR.				
						005 CO. 5010				
										24'E
						SANTEETLAH Rd.				JC-C
						CO. 000 4656 @.10	SS			

SYSTEM				TRAFFIC		LINE DIAGRAM	TRAFFIC			PAVEMENT DATA
FED. AID.	FUNCT. CLASS.	HWY. SYS.	HPMS SAMPLE	PRKG. REST.	COM/IND ACCESS		CONTROL	COM/IND ACCESS	PRKG. REST.	

SHA 51.3 - 8 Revised
4.83

MARYLAND STATE HIGHWAY ADMINISTRATION

ROAD INVENTORY SHEET

89-100

Party Chief BB
Recorder BB
Assistant
Map No./Dir. G11D / NE
State Coordinates 820-340

Road No. Co 5010
Road Name PISGAH Dr.
County Pr. GEO.
Date 2/27/90
Sheet No. ____ OF ____

TRAFFIC CODES
TRAFFIC CONTROLS: STOP SIGN=SS, TRAFFIC LIGHT=T.L., FLASHING RED BALL=F.R.

TRAFFIC CODES
PARKING RESTRICTIONS: A.M. PEAK, P.M. PEAK, A.M./P.M. PEAK, NO PARKING ANYTIME=N.P., COMM/IND. ACCESS=E

SYSTEM				TRAFFIC		LINE DIAGRAM	TRAFFIC			PAVEMENT DATA
FED. AID.	FUNCT CLASS.	HWY. SYS.	HPMS SAMPLE	PRK.G. REST.	COM/IND. ACCESS		CONTROL	COM/IND. ACCESS	PRK.G. REST.	
						D E				
	∧					CUL 0 10 SAC				∧
	Urban Local					PISGAH CT PR40				
						0 06 Co 5011				
						0 02 PC				24'I
						HIWASSEE Dr				JC-C
	V					Co 0 00 5009 (2.05)				V

TRAFFIC CONTROLS: STOP SIGN=SS, TRAFFIC LIGHT=T.L., FLASHING RED BALL=F.R.

PARKING RESTRICTIONS: A.M. PEAK, P.M. PEAK, A.M./P.M. PEAK, NO PARKING ANYTIME=N.P., COMM/IND. ACCESS=E

SYSTEM				TRAFFIC		LINE DIAGRAM	TRAFFIC			PAVEMENT DATA
FED. AID.	FUNCT. CLASS.	HWY. SYS.	HPMS SAMPLE	PRKG. REST.	COM/IND ACCESS		CONTROL	COM/IND ACCESS	PRKG. REST.	

SHA 51.3 - 8 Revised
4.83

MARYLAND STATE HIGHWAY ADMINISTRATION

ROAD INVENTORY SHEET

89-99

Party Chief BB
Recorder BB
Assistant
Map No./Dir. 6110 / E
State Coordinates 820-340

Road No. CO 5011
Road Name PISGAH CT.
County PR. GEO.
Date 2/27/90
Sheet No. _____ OF _____

TRAFFIC CODES

TRAFFIC CONTROLS: STOP SIGN=SS, TRAFFIC LIGHT=T.L., FLASHING RED BALL=F.R.

TRAFFIC CODES

PARKING RESTRICTIONS: A.M. PEAK, P.M. PEAK, A.M./P.M. PEAK, NO PARKING ANYTIME=N.P., COMM/IND. ACCESS=E

SYSTEM				TRAFFIC		LINE DIAGRAM	TRAFFIC			PAVEMENT DATA
FED. AID.	FUNCT CLASS.	HWY. SYS.	HPMS SAMPLE	PRKG. REST.	COM/IND. ACCESS		CONTROL	COM/IND. ACCESS	PRKG. REST.	
						D E				
	1					CUL 003 SAC			1	
	urban local									
										24'I
						PISGAH				JC-C
	V					CO. 000 DE			V	
						5010				
						0.06				

SYSTEM				TRAFFIC		LINE DIAGRAM	TRAFFIC			PAVEMENT DATA
FED. AID.	FUNCT. CLASS.	HWY. SYS.	HPMS SAMPLE	PRK.G. REST.	COM/IND ACCESS		CONTROL	COM/IND ACCESS	PRK.G. REST.	

SHA 51.3 - 8 Revised
4.83

MARYLAND STATE HIGHWAY ADMINISTRATION

ROAD INVENTORY SHEET ~~SR 3078~~

89-103,104

Party Chief BB
Recorder BB
Assistant
Map No./Dir. 611D / N
State Coordinates 820-340

Road No. Co. 5012
Road Name TROUBADOR Dr
County Pr. GEO.
Date 2/27/90
Sheet No. 1 OF 1

91-129

TRAFFIC CODES
TRAFFIC CONTROLS: STOP SIGN=SS, TRAFFIC LIGHT=T.L., FLASHING RED BALL=F.R.

TRAFFIC CODES
PARKING RESTRICTIONS: A.M. PEAK, P.M. PEAK, A.M./P.M. PEAK, NO PARKING ANYTIME=N.P., COMM/IND. ACCESS=E

SYSTEM				TRAFFIC		LINE DIAGRAM	TRAFFIC			PAVEMENT DATA
FED. AID.	FUNCT CLASS.	HWY. SYS.	HPMS SAMPLE	PRKG. REST.	COM/IND. ACCESS		CONTROL	COM/IND. ACCESS	PRKG. REST.	
						Rodgers Dr.				
	↑					OF Co 0 23 4272 ~~4077~~ @ 1.25				↑
						~~SR 4077~~ 91-129				
						GYPSY LA.				
						0 16 ~~SR 4087~~ CO 5223				
						0 11				
						PLATA ST.				
						Co 0 07 3293 @ 1.19				
						CO 5012				
						NR				
						MATADOR ~~T.L.~~				
						0 03 Co. 5013				
	Urban local									
										24'I
										JC-C
	↓					CUL 0 00 SAC				↓
						D E				

SYSTEM				TRAFFIC		LINE DIAGRAM	TRAFFIC				PAVEMENT DATA
FED. AID.	FUNCT. CLASS.	HWY. SYS.	HPMS SAMPLE	PRKG. REST.	COM/IND ACCESS		CONTROL	COM/IND ACCESS	PRKG. REST.		

SHA 51.3 - 8 Revised
4.83

MARYLAND STATE HIGHWAY ADMINISTRATION

ROAD INVENTORY SHEET

B9-105

Party Chief BB
Recorder BB
Assistant
Map No./Dir. 6110 / E
State Coordinates 820-340

Road No. Co. 5013
Road Name MATADOR DR.
County PR. GEO.
Date 2/27/90
Sheet No. 1 OF 1

TRAFFIC CODES
TRAFFIC CONTROLS: STOP SIGN=SS, TRAFFIC LIGHT=T.L., FLASHING RED BALL=F.R.

TRAFFIC CODES
PARKING RESTRICTIONS: A.M. PEAK, P.M. PEAK, A.M./P.M. PEAK, NO PARKING ANYTIME=N.P., COMM/IND. ACCESS=E

SYSTEM				TRAFFIC		LINE DIAGRAM	TRAFFIC			PAVEMENT DATA
FED. AID.	FUNCT CLASS.	HWY. SYS.	HPMS SAMPLE	PRKG. REST.	COM/IND. ACCESS		CONTROL	COM/IND. ACCESS	PRKG. REST.	
	Urban Local					D E				
						CUL 0 08 SAC				
						30°↗ 0 04				24'I
						MATADOR DR				JC-C
						Co. 0 00 5012				
						@.03				

SYSTEM				TRAFFIC		LINE DIAGRAM	TRAFFIC			PAVEMENT DATA
FED. AID.	FUNCT. CLASS.	HWY. SYS.	HPMS SAMPLE	PRK.G. REST.	COM/IND ACCESS		CONTROL	COM/IND ACCESS	PRK.G. REST.	

SHA 51.3 - 8 Revised
4.83

MARYLAND STATE HIGHWAY ADMINISTRATION

ROAD INVENTORY SHEET

89-111

Party Chief BB
Recorder BB
Assistant
Map No./Dir. G12 / S
State Coordinates 854-385

Road No. Co. 5014
Road Name PARKCREST CT.
County Pr GEO.
Date 2/28/90
Sheet No. 1 OF 1

SYSTEM: FED. AID. | FUNCT CLASS. | HWY. SYS. | HPMS SAMPLE
TRAFFIC: PRKG. REST. | COM/IND. ACCESS

LINE DIAGRAM

TRAFFIC: CONTROL | COM/IND. ACCESS | PRKG. REST.

PAVEMENT DATA

TRAFFIC CODES
TRAFFIC CONTROLS: STOP SIGN=S.S., TRAFFIC LIGHT=T.L., FLASHING RED BALL=F.R.

TRAFFIC CODES
PARKING RESTRICTIONS: A.M. PEAK, P.M. PEAK, A.M./P.M. PEAK, NO PARKING ANYTIME=N.P., COMM/IND. ACCESS=E

Urban Local

D E
CUL 0 06 SAC

24' I
JC-C

W. BRANCH DR.
CO. 0 60 4595
0.07

SYSTEM				TRAFFIC		LINE DIAGRAM	TRAFFIC			PAVEMENT DATA
FED. AID.	FUNCT. CLASS.	HWY. SYS.	HPMS SAMPLE	PRK.G. REST.	COM/IND ACCESS		CONTROL	COM/IND ACCESS	PRK.G. REST.	

SHA 51.3 - 8 Revised
4.83

MARYLAND STATE HIGHWAY ADMINISTRATION

ROAD INVENTORY SHEET

89-172

Party Chief BB
Recorder BB
Assistant
Map No./Dir. G12 / N
State Coordinates 854-385

Road No. Co 5015
Road Name TRETON CT.
County PR. GEO.
Date 2/28/90
Sheet No. 1 OF 1

SYSTEM				TRAFFIC		LINE DIAGRAM	TRAFFIC			PAVEMENT DATA
FED. AID.	FUNCT CLASS.	HWY. SYS.	HPMS SAMPLE	PRKG. REST.	COM/IND. ACCESS		CONTROL	COM/IND. ACCESS	PRKG. REST.	
	Urban Local					D E CUL 0 10 SAC 0 08 PT 90 0 02 PC HERRINGTON DL. Co 0 00 2588 @ 1.75				24'I JC-C

TRAFFIC CODES

TRAFFIC CONTROLS: STOP SIGN=SS, TRAFFIC LIGHT=T.L., FLASHING RED BALL=F.R.

TRAFFIC CODES

PARKING RESTRICTIONS: A.M. PEAK, P.M. PEAK, A.M./P.M. PEAK, NO PARKING ANYTIME=N.P., COMM/IND. ACCESS=E

SYSTEM				TRAFFIC		LINE DIAGRAM	TRAFFIC			PAVEMENT DATA
FED. AID.	FUNCT. CLASS.	HWY. SYS.	HPMS SAMPLE	PRKG. REST.	COM/IND ACCESS		CONTROL	COM/IND ACCESS	PRKG. REST.	

SHA 51.3 - 8 Revised
4.83

MARYLAND STATE HIGHWAY ADMINISTRATION

ROAD INVENTORY SHEET

89-117

Party Chief BB
Recorder BB
Assistant
Map No./Dir. G12 / N
State Coordinates 849-381

Road No. Co. 5016
Road Name Mt. LUBENTIA Ct.
County PR GEO.
Date 2/28/90
Sheet No. 1 OF 1

TRAFFIC CODES
TRAFFIC CONTROLS: STOP SIGN=SS, TRAFFIC LIGHT=T.L., FLASHING RED BALL=F.R.

TRAFFIC CODES
PARKING RESTRICTIONS: A.M. PEAK, P.M. PEAK, A.M./P.M. PEAK, NO PARKING ANYTIME=N.P., COMM/IND. ACCESS=E

SYSTEM				TRAFFIC		LINE DIAGRAM	TRAFFIC			PAVEMENT DATA
FED. AID.	FUNCT CLASS.	HWY. SYS.	HPMS SAMPLE	PRKG. REST.	COM/IND. ACCESS		CONTROL	COM/IND. ACCESS	PRKG. REST.	
	Urban local					Mt. LUBENTIA Ct WEST — Co 5018 — 004 — Mt LUBENTIA Ct EAST — Co. 5017				22-24'I JC-C 10'GRS MED
						MT — LUBENTIA WAY — Co — 000 — 4743 @.77	SS			✓
						WILDWOOD LEAF Way — Co 4753				

SYSTEM				TRAFFIC		LINE DIAGRAM	TRAFFIC			PAVEMENT DATA
FED. AID.	FUNCT. CLASS.	HWY. SYS.	HPMS SAMPLE	PRKG. REST.	COM/IND ACCESS		CONTROL	COM/IND ACCESS	PRKG. REST.	

SHA 51.3 - 8 Revised
4.83

MARYLAND STATE HIGHWAY ADMINISTRATION

ROAD INVENTORY SHEET

OP 4684

89-114

Party Chief BB
Recorder BB
Assistant
Map No./Dir. G12 / E
State Coordinates 849.381

Road No. Co 5017
Road Name MT LUBENTIA CT. EAST
County Pr. GEO.
Date 2-28-90
Sheet No. 1 OF 1

TRAFFIC CODES
TRAFFIC CONTROLS: STOP SIGN=SS, TRAFFIC LIGHT=T.L., FLASHING RED BALL=F.R.

TRAFFIC CODES
PARKING RESTRICTIONS: A.M. PEAK, P.M. PEAK, A.M./P.M. PEAK, NO PARKING ANYTIME=N.P., COMM/IND. ACCESS=E

SYSTEM				TRAFFIC		LINE DIAGRAM	TRAFFIC			PAVEMENT DATA
FED. AID.	FUNCT CLASS.	HWY. SYS.	HPMS SAMPLE	PRKG. REST.	COM/IND. ACCESS		CONTROL	COM/IND. ACCESS	PRKG. REST.	
						D E				
						CUL 0 14 SAC				
						0 11 PT				
						90°				
						0 09 TO T.H.		E		
						OP 4684				
						0 07 TO T.H. PC		E		
	Urban Local				E	TO T.H. 0 06				26'I
										JC-C
					E	T.H. 0 03				
						0 02 TO T.H.		E		
										36'I
						MT LUBENTIA CT				JC-C
						0 00 CO. 5016				
						@.04				
						MT LUBENTIA CT WEST CO 5018				

SYSTEM				TRAFFIC		LINE DIAGRAM	TRAFFIC			PAVEMENT DATA
FED. AID.	FUNCT. CLASS.	HWY. SYS.	HPMS SAMPLE	PRK.G. REST.	COM/IND ACCESS		CONTROL	COM/IND ACCESS	PRK.G. REST.	

SHA 51.3 - 8 Revised
4.83

MARYLAND STATE HIGHWAY ADMINISTRATION

89-115,116

ROAD INVENTORY SHEET OP 4711

Party Chief BB
Recorder BB
Assistant
Map No./Dir. G12 / W
State Coordinates 849-381

Road No. Co 5018
Road Name Mt. LUGENTIA CT WEST
County Pr. GEO.
Date 2/28/90
Sheet No. 1 OF 1

TRAFFIC CODES
TRAFFIC CONTROLS: STOP SIGN=SS, TRAFFIC LIGHT=T.L., FLASHING RED BALL=F.R.

TRAFFIC CODES
PARKING RESTRICTIONS: A.M. PEAK, P.M. PEAK, A.M./P.M. PEAK, NO PARKING ANYTIME=N.P., COMM/IND. ACCESS=E

SYSTEM				TRAFFIC		LINE DIAGRAM	TRAFFIC			PAVEMENT DATA
FED. AID.	FUNCT CLASS	HWY. SYS.	HPMS SAMPLE	PRKG. REST.	COM/IND. ACCESS		CONTROL	COM/IND. ACCESS	PRKG. REST.	
						D E				
						CUL 0 13 SAC				
						PT 0 11				
						90°				
					E	TO T.H. 0 09				
						PC 0 08				
						OP 4688				
						PT 0 06				
										26'I
						40°				JC-C
					E	PC TO T.H. 0 04				
										36'I
										JC-C
						MT LUGENTIA CT				
						CO. 5016 0 00				
						@ 04				
						MT LUGENTIA CT EAST				
						CO 5017				

SYSTEM				TRAFFIC		LINE DIAGRAM	TRAFFIC			PAVEMENT DATA
FED. AID.	FUNCT. CLASS.	HWY. SYS.	HPMS SAMPLE	PRKG. REST.	COM/IND ACCESS		CONTROL	COM/IND ACCESS	PRKG. REST.	

SHA 51.3 - 8 Revised
4.83

MARYLAND STATE HIGHWAY ADMINISTRATION

ROAD INVENTORY SHEET

89-119

Party Chief BB
Recorder BB
Assistant
Map No./Dir. G12 / N
State Coordinates 851-381

Road No. Co5019
Road Name DUBS CT.
County Pr. GEO
Date 2/28/90
Sheet No. 1 OF 1

TRAFFIC CODES
TRAFFIC CONTROLS: STOP SIGN=SS, TRAFFIC LIGHT=T.L., FLASHING RED BALL=F.R.

TRAFFIC CODES
PARKING RESTRICTIONS: A.M. PEAK, P.M. PEAK, A.M./P.M. PEAK, NO PARKING ANYTIME=N.P., COMM/IND. ACCESS=E

SYSTEM				TRAFFIC		LINE DIAGRAM	TRAFFIC			PAVEMENT DATA
FED. AID.	FUNCT CLASS.	HWY. SYS.	HPMS SAMPLE	PRK.G. REST.	COM/IND. ACCESS		CONTROL	COM/IND. ACCESS	PRK.G. REST.	
						D E				
						CUL O 13 SAC				
						PT O 09				
						80°				
						PC O 02				
										26 I
						Mt. LUBENTIA Way				JC-C
						D O O	SS			
						CO. @.37 4743				

Urban local

SYSTEM				TRAFFIC		LINE DIAGRAM	TRAFFIC			PAVEMENT DATA
FED. AID.	FUNCT. CLASS.	HWY. SYS.	HPMS SAMPLE	PRK.G. REST.	COM/IND ACCESS		CONTROL	COM/IND ACCESS	PRK.G. REST.	

SHA 51.3 - 8 Revised
4.83

MARYLAND STATE HIGHWAY ADMINISTRATION

ROAD INVENTORY SHEET

89-120

Party Chief BB
Recorder BB
Assistant
Map No./Dir. G12 I N
State Coordinates 851-381

Road No. CO. 5020
Road Name UPHILL CT
County Pr. GEO
Date 2/28/90
Sheet No. 1 OF 1

SYSTEM: FED. AID. | FUNCT CLASS. | HWY. SYS. | HPMS SAMPLE
TRAFFIC: PRKG. REST. | COM/IND. ACCESS

LINE DIAGRAM

TRAFFIC: CONTROL | COM/IND. ACCESS | PRKG. REST.

PAVEMENT DATA

D E
CUL 0 05 SAC

Urban Local

FALCON DR.
CO. 000 4906
@.14

24 I
JC-C

TRAFFIC CODES

TRAFFIC CONTROLS: STOP SIGN=SS, TRAFFIC LIGHT=T.L., FLASHING RED BALL=F.R.

TRAFFIC CODES

PARKING RESTRICTIONS: A.M. PEAK, P.M. PEAK, A.M./P.M. PEAK, NO PARKING ANYTIME=N.P., COMM/IND. ACCESS=E

SYSTEM				TRAFFIC		LINE DIAGRAM	TRAFFIC			PAVEMENT DATA
FED. AID.	FUNCT. CLASS.	HWY. SYS.	HPMS SAMPLE	PRKG. REST.	COM/IND ACCESS		CONTROL	COM/IND ACCESS	PRKG. REST.	

SHA 51.3 - 8 Revised
4.83

MARYLAND STATE HIGHWAY ADMINISTRATION

ROAD INVENTORY SHEET

89-122

Party Chief BB
Recorder BB
Assistant
Map No./Dir. G12 / 5
State Coordinates 851-391

Road No. Co 5021
Road Name DARIEN PL
County PR. GEO.
Date 2/28/90
Sheet No. 1 OF 1

TRAFFIC CODES
TRAFFIC CONTROLS: STOP SIGN=S.S., TRAFFIC LIGHT=T.L., FLASHING RED BALL=F.R.

TRAFFIC CODES
PARKING RESTRICTIONS: A.M. PEAK, P.M. PEAK, A.M./P.M. PEAK, NO PARKING ANYTIME=N.P., COMM/IND. ACCESS=E

SYSTEM				TRAFFIC		LINE DIAGRAM	TRAFFIC			PAVEMENT DATA
FED. AID.	FUNCT CLASS.	HWY. SYS.	HPMS SAMPLE	PKG. REST.	COM/IND. ACCESS		CONTROL	COM/IND. ACCESS	PKG. REST.	
						D E				
						CUL 011 SAC				
						PT 80° 009				
						80°				
						PC 006				
						HARAN CT.				
						002 Co 5022				
										24'I
						Mt LUBENTIA WAY				JC-C
						Co 000 4743	SS			
						@.56				

Urban Local

SYSTEM				TRAFFIC		LINE DIAGRAM	TRAFFIC			PAVEMENT DATA
FED. AID.	FUNCT. CLASS.	HWY. SYS.	HPMS SAMPLE	PRKG. REST.	COM/IND ACCESS		CONTROL	COM/IND ACCESS	PRKG. REST.	

SHA 51.3 - 8 Revised
4.83

MARYLAND STATE HIGHWAY ADMINISTRATION

ROAD INVENTORY SHEET

89-123

Party Chief BB
Recorder BB
Assistant
Map No./Dir. 612 / W
State Coordinates 851-381

Road No. Co. 5022
Road Name HARRAN CT.
County Pr GEO.
Date 2/28/90
Sheet No. ____ OF ____

TRAFFIC CODES
TRAFFIC CONTROLS: STOP SIGN=SS, TRAFFIC LIGHT=T.L., FLASHING RED BALL=F.R.

TRAFFIC CODES
PARKING RESTRICTIONS: A.M. PEAK, P.M. PEAK, A.M./P.M. PEAK, NO PARKING ANYTIME=N.P., COMM/IND. ACCESS=E

SYSTEM				TRAFFIC		LINE DIAGRAM	TRAFFIC			PAVEMENT DATA
FED. AID.	FUNCT CLASS.	HWY. SYS.	HPMS SAMPLE	PRK.G. REST.	COM/IND. ACCESS		CONTROL	COM/IND. ACCESS	PRK.G. REST.	
	Urban Local					D E COL 0 05 SAC DARIEN PL. Co. 000 5021 @.02				24'I JC-C

SYSTEM				TRAFFIC		LINE DIAGRAM	TRAFFIC			PAVEMENT DATA
FED. AID.	FUNCT. CLASS.	HWY. SYS.	HPMS SAMPLE	PRKG. REST.	COM/IND ACCESS		CONTROL	COM/IND ACCESS	PRKG. REST.	

SHA 51.3 - 8 Revised
4.83

MARYLAND STATE HIGHWAY ADMINISTRATION

ROAD INVENTORY SHEET

89-174

Party Chief BB
Recorder BB
Assistant
Map No./Dir. G12 / W
State Coordinates 851-381

Road No. CO 5023
Road Name TARA CT.
County PR. GEO.
Date 2/28/90
Sheet No. 1 OF 1

SYSTEM				TRAFFIC		LINE DIAGRAM	TRAFFIC			PAVEMENT DATA
FED. AID.	FUNCT CLASS.	HWY. SYS.	HPMS SAMPLE	PRK'G. REST.	COM/IND. ACCESS		CONTROL	COM/IND. ACCESS	PRK'G. REST.	
						D E				
						CUL 003 SAC				
										24'I
						ETNA DR				JC-C
						CO < 000 4738	55			
						@1.41				

TRAFFIC CODES

TRAFFIC CONTROLS: STOP SIGN=SS, TRAFFIC LIGHT=T.L., FLASHING RED BALL=F.R.

TRAFFIC CODES

PARKING RESTRICTIONS: A.M. PEAK, P.M. PEAK, A.M./P.M. PEAK, NO PARKING ANYTIME=N.P., COMM/IND. ACCESS=E

SYSTEM				TRAFFIC		LINE DIAGRAM	TRAFFIC			PAVEMENT DATA
FED. AID.	FUNCT. CLASS.	HWY. SYS.	HPMS SAMPLE	PRKG. REST.	COM/IND ACCESS		CONTROL	COM/IND ACCESS	PRKG. REST.	

Gr. Upper Marlboro
Sm. Urban

~~Road~~

SHA 51.3 - 8 Revised
4.83

MARYLAND STATE HIGHWAY ADMINISTRATION

ROAD INVENTORY SHEET

89-125

Party Chief BB
Recorder BB
Assistant
Map No./Dir. G12 / S
State Coordinates 860-373

Road No. Co. 5024
Road Name MAPLELEAF PL.
County Pr GEO.
Date 2/28/90
Sheet No. 1 OF 1

TRAFFIC CODES
TRAFFIC CONTROLS: STOP SIGN=SS, TRAFFIC LIGHT=T.L., FLASHING RED BALL=F.R.

TRAFFIC CODES
PARKING RESTRICTIONS: A.M. PEAK, P.M. PEAK, A.M./P.M. PEAK, NO PARKING ANYTIME=N.P., COMM/IND. ACCESS=E

SYSTEM				TRAFFIC		LINE DIAGRAM	TRAFFIC			PAVEMENT DATA
FED. AID.	FUNCT CLASS.	HWY. SYS.	HPMS SAMPLE	PRKG. REST.	COM/IND. ACCESS		CONTROL	COM/IND. ACCESS	PRKG. REST.	
	Rural Local					(MAPLELEAF Pl.) Co 0 04 5025 @.04				24'I Jc-C
						HANCOCK CO. @166 0 00 DE 4748				

SYSTEM				TRAFFIC		LINE DIAGRAM	TRAFFIC			PAVEMENT DATA
FED. AID.	FUNCT. CLASS.	HWY. SYS.	HPMS SAMPLE	PRK'G. REST.	COM/IND ACCESS		CONTROL	COM/IND ACCESS	PRK'G. REST.	

Greater Upper Marlboro
Sm. Urban

~~Rural~~

SHA 51.3 - 8 Revised
4.83

MARYLAND STATE HIGHWAY ADMINISTRATION

89-125

ROAD INVENTORY SHEET

Party Chief BB
Recorder BB
Assistant
Map No./Dir. G12 / NE
State Coordinates 860-373

Road No. Co 5025
Road Name (MAPLELEAF PL.)
County Pr. GEO.
Date 2/28/90
Sheet No. 1 OF 1

TRAFFIC CODES
TRAFFIC CONTROLS: STOP SIGN=SS, TRAFFIC LIGHT=T.L., FLASHING RED BALL=F.R.

TRAFFIC CODES
PARKING RESTRICTIONS: A.M. PEAK, P.M. PEAK, A.M./P.M. PEAK, NO PARKING ANYTIME=N.P., COMM/IND. ACCESS=E

SYSTEM				TRAFFIC		LINE DIAGRAM	TRAFFIC			PAVEMENT DATA
FED. AID.	FUNCT CLASS.	HWY. SYS.	HPMS SAMPLE	PRKG. REST.	COM/IND. ACCESS		CONTROL	COM/IND. ACCESS	PRKG. REST.	
						D E				
						CUL 0 0B SAC				
						MAPLELEAF PL				
						Co 5024 0 04 @.04				
	Rdbook Local									
										24' I
										JC-C
						CUL 0 00 SAC				
						D E				

SYSTEM				TRAFFIC		LINE DIAGRAM	TRAFFIC			PAVEMENT DATA
FED. AID.	FUNCT. CLASS.	HWY. SYS.	HPMS SAMPLE	PRKG. REST.	COM/IND ACCESS		CONTROL	COM/IND ACCESS	PRKG. REST.	

Greater Upper Marlboro Sh. Urban

Road

SHA 51.3 - 8 Revised 4.83

MARYLAND STATE HIGHWAY ADMINISTRATION

ROAD INVENTORY SHEET

89-129

Party Chief BB
Recorder BB
Assistant
Map No./Dir. GIZ / S
State Coordinates 860-373

Road No. Co. 5026
Road Name BLAZ CT.
County Pr. GEO
Date 2/28/90
Sheet No. 1 OF 1

SYSTEM				TRAFFIC		LINE DIAGRAM	TRAFFIC			PAVEMENT DATA
FED. AID.	FUNCT CLASS.	HWY. SYS.	HPMS SAMPLE	PRKG. REST.	COM/IND. ACCESS		CONTROL	COM/IND. ACCESS	PRKG. REST.	
						DE				
∧	∧					CUL 0.22 SMC				∧
						PT 45° 0.18				
						45°				
						PC 0.16				
	Road Local									24' I
						MART CT.				JC-C
						0.12 Co 5029				X
						HEIDI MARIE CT.				
						PT 30° Co 5028 0.08				
						30°				
						HILDA CT				
						PC 0.04 Co. 5027				
										36' I
										JC-C
V	V					HANCOCK CO 0.00 @.71 DR 4748	55			X

TRAFFIC CODES

TRAFFIC CONTROLS: STOP SIGN=SS, TRAFFIC LIGHT=T.L., FLASHING RED BALL=F.R.

TRAFFIC CODES

PARKING RESTRICTIONS: A.M. PEAK, P.M. PEAK, A.M./P.M. PEAK, NO PARKING ANYTIME=N.P., COMM/IND. ACCESS=E

SYSTEM				TRAFFIC		LINE DIAGRAM	TRAFFIC			PAVEMENT DATA
FED. AID.	FUNCT. CLASS.	HWY. SYS.	HPMS SAMPLE	PRK.G. REST.	COM/IND ACCESS		CONTROL	COM/IND ACCESS	PRK.G. REST.	

Greater Upper Marlboro
Sm. Urban

SHA 51.3 - 8 Revised
4.83

MARYLAND STATE HIGHWAY ADMINISTRATION

ROAD INVENTORY SHEET

89-127

Party Chief BB
Recorder BB
Assistant
Map No./Dir. G12 / W
State Coordinates 860-373

Road No. Co. 5027
Road Name HILDA CT.
County Pr. GEO.
Date 2/28/90
Sheet No. 1 OF 1

TRAFFIC CODES
TRAFFIC CONTROLS: STOP SIGN=SS, TRAFFIC LIGHT=T.L., FLASHING RED BALL=F.R.

TRAFFIC CODES
PARKING RESTRICTIONS: A.M. PEAK, P.M. PEAK, A.M./P.M. PEAK, NO PARKING ANYTIME=N.P., COMM/IND. ACCESS=E

SYSTEM				TRAFFIC		LINE DIAGRAM	TRAFFIC			PAVEMENT DATA
FED. AID.	FUNCT CLASS.	HWY. SYS.	HPMS SAMPLE	PRKG. REST.	COM/IND. ACCESS		CONTROL	COM/IND. ACCESS	PRKG. REST.	
	Rural local					D E CUL 0 04 SAC BLAZ CT. CO. 0 00 5026 @.04				26'I JC-C

SYSTEM				TRAFFIC		LINE DIAGRAM	TRAFFIC				PAVEMENT DATA
FED. AID.	FUNCT. CLASS.	HWY. SYS.	HPMS SAMPLE	PRK.G. REST.	COM/IND ACCESS		CONTROL	COM/IND ACCESS	PRK.G. REST.		

* County reported .30 mi.

SHA 51.3 - 8 Revised
4.83

MARYLAND STATE HIGHWAY ADMINISTRATION

Greater Upper Marlboro
Sm. Urban

ROAD INVENTORY SHEET

89-130

Party Chief BB
Recorder BB
Assistant
Map No./Dir. 612 / E
State Coordinates 860-373

Road No. Co. 5028
Road Name HEIDI MARIE CT.
County Pr GEO.
Date 2/28/90
Sheet No. 1 OF 1

TRAFFIC CODES
TRAFFIC CONTROLS: STOP SIGN=SS, TRAFFIC LIGHT=T.L., FLASHING RED BALL=F.R.

TRAFFIC CODES
PARKING RESTRICTIONS: A.M. PEAK, P.M. PEAK, A.M./P.M. PEAK, NO PARKING ANYTIME=N.P., COMM/IND. ACCESS=E

SYSTEM				TRAFFIC		LINE DIAGRAM	TRAFFIC			PAVEMENT DATA
FED. AID.	FUNCT CLASS.	HWY. SYS.	HPMS SAMPLE	PRKG. REST.	COM/IND. ACCESS		CONTROL	COM/IND. ACCESS	PRKG. REST.	
						D E				
						CUL 0 15 SAC				↑

SYSTEM				TRAFFIC		LINE DIAGRAM	TRAFFIC			PAVEMENT DATA
FED. AID.	FUNCT. CLASS.	HWY. SYS.	HPMS SAMPLE	PRKG. REST.	COM/IND ACCESS		CONTROL	COM/IND ACCESS	PRKG. REST.	

Greater Upper Marlboro
Sm. urban

SHA 51.3 - 8 Revised
4.83

MARYLAND STATE HIGHWAY ADMINISTRATION

ROAD INVENTORY SHEET

89-128

Party Chief BB
Recorder BB
Assistant
Map No./Dir. G12 / NW
State Coordinates 860-373

Road No. Co. 5029
Road Name MART CT.
County Pr. GEO.
Date 2/28/90
Sheet No. 1 OF 1

TRAFFIC CODES
TRAFFIC CONTROLS: STOP SIGN=SS, TRAFFIC LIGHT=T.L., FLASHING RED BALL=F.R.

TRAFFIC CODES
PARKING RESTRICTIONS: A.M. PEAK, P.M. PEAK, A.M./P.M. PEAK, NO PARKING ANYTIME=N.P., COMM/IND. ACCESS=E

SYSTEM				TRAFFIC		LINE DIAGRAM	TRAFFIC			PAVEMENT DATA
FED. AID.	FUNCT CLASS.	HWY. SYS.	HPMS SAMPLE	PRKG. REST.	COM/IND. ACCESS		CONTROL	COM/IND. ACCESS	PRKG. REST.	
	Rural Local					D E CUL 0 04 SAC				26'I JC-C
						BLAZ CT Co 0 00 5026 @ 12				

SYSTEM				TRAFFIC		LINE DIAGRAM	TRAFFIC			PAVEMENT DATA
FED. AID.	FUNCT. CLASS.	HWY. SYS.	HPMS SAMPLE	PRK.G. REST.	COM/IND ACCESS		CONTROL	COM/IND ACCESS	PRK.G. REST.	

Greater upper Marlboro
Sm. Urban

SHA 51.3 - 8 Revised
4.83

MARYLAND STATE HIGHWAY ADMINISTRATION

ROAD INVENTORY SHEET

89-131

Party Chief BB
Recorder BB
Assistant
Map No./Dir. 612 / N
State Coordinates 860-373

Road No. Co. 5030
Road Name BART CT.
County Pr. GEO.
Date 2/28/90
Sheet No. 1 OF 1

TRAFFIC CODES
TRAFFIC CONTROLS: STOP SIGN=SS, TRAFFIC LIGHT=T.L., FLASHING RED BALL=F.R.

TRAFFIC CODES
PARKING RESTRICTIONS: A.M. PEAK, P.M. PEAK, A.M./P.M. PEAK, NO PARKING ANYTIME=N.P., COMM/IND. ACCESS=E

SYSTEM				TRAFFIC		LINE DIAGRAM	TRAFFIC			PAVEMENT DATA
FED. AID.	FUNCT CLASS.	HWY. SYS.	HPMS SAMPLE	PRK.G. REST.	COM/IND. ACCESS		CONTROL	COM/IND. ACCESS	PRK.G. REST.	
						D E				
						CUL 008 SAC				
	Rural Local					PT 005				
						30°				
						PC 002				
										26 'I
						HEIDI MARIE CT.				JC-C
						Co. 000 5028				
						@.10				

SYSTEM				TRAFFIC		LINE DIAGRAM	TRAFFIC			PAVEMENT DATA
FED. AID.	FUNCT. CLASS.	HWY. SYS.	HPMS SAMPLE	PRKG. REST.	COM/IND ACCESS		CONTROL	COM/IND ACCESS	PRKG. REST.	

Wester. Urban ~~Road~~
96-106 Co
PDIMG
3-19-97
89-133

SHA 51.3 - 8 Revised
4.83

MARYLAND STATE HIGHWAY ADMINISTRATION

ROAD INVENTORY SHEET

Party Chief BB
Recorder BB
Assistant
Map No./Dir. 612 / N
State Coordinates 849-369

Road No. Co 5031
Road Name MataPeake Dr.
County Pr. GEO.
Date 2/28/90
Sheet No. 1 OF X 2

TRAFFIC CODES
TRAFFIC CONTROLS: STOP SIGN=SS, TRAFFIC LIGHT=T.L., FLASHING RED BALL=F.R.

TRAFFIC CODES
PARKING RESTRICTIONS: A.M. PEAK, P.M. PEAK, A.M./P.M. PEAK, NO PARKING ANYTIME=N.P., COMM/IND. ACCESS=E

SYSTEM				TRAFFIC		LINE DIAGRAM	TRAFFIC			PAVEMENT DATA
FED. AID.	FUNCT CLASS	HWY. SYS.	HPMS SAMPLE	PKG. REST.	COM/IND ACCESS		CONTROL	COM/IND ACCESS	PKG. REST.	
						0 34 PT				
						90°				
						STOP				
						0 26 PC				
						~~ROAD~~ 0 ~~IT~~ ~~END~~				
						HATBORO PL				
						Co 0 21 5697				
						PT 0 16				
						50°				
						PL 0 10				
						HOWELL Dr.				
						Co. 5032 0 06				
										24'I
						WESTPHALIA Rd.				30'CW
						Co 0 00 91	SS			2 UML
						C. 209				

P. G. Co 5031 2 of 2

SYSTEM				TRAFFIC		LINE DIAGRAM	TRAFFIC			PAVEMENT DATA
FED. AID.	FUNCT. CLASS.	HWY. SYS.	HPMS SAMPLE	PRKG. REST.	COM/IND ACCESS		CONTROL	COM/IND ACCESS	PRKG. REST.	
						Rd End				
						PT 0 58				
						45°				
						PC 0 44				24'I
										2 UML

Wash. Urban

SHA 51.3 - 8 Revised
4.83

MARYLAND STATE HIGHWAY ADMINISTRATION

ROAD INVENTORY SHEET ~~OF 4006~~

89-132
96-178co

Party Chief BB
Recorder BB
Assistant
Map No./Dir. G12 / W
State Coordinates 849-369

Road No. Co. 5032
Road Name Howell Dr.
County Pr GEO
Date 2/28/90
Sheet No. 1 OF 1

TRAFFIC CODES
TRAFFIC CONTROLS: STOP SIGN=SS, TRAFFIC LIGHT=T.L., FLASHING RED BALL=F.R.

TRAFFIC CODES
PARKING RESTRICTIONS: A.M. PEAK, P.M. PEAK, A.M./P.M. PEAK, NO PARKING ANYTIME=N.P., COMM/IND. ACCESS=E

SYSTEM				TRAFFIC		LINE DIAGRAM	TRAFFIC			PAVEMENT DATA
FED. AID.	FUNCT CLASS	HWY. SYS.	HPMS SAMPLE	PRKG. REST.	COM/IND. ACCESS		CONTROL	COM/IND. ACCESS	PRKG. REST.	
						DE				
	↑					CUL ○ 28 SAC			↑	
						90° ○ 20				
						○ 16				
	Local					30°				
						RPC ○ 11				
						○ 10				
										24'I
						MATAPEAKE DR.				30'CW
	↓					Co. ○ 00 5031 @.06			↓	

SYSTEM				TRAFFIC		LINE DIAGRAM	TRAFFIC			PAVEMENT DATA
FED. AID.	FUNCT. CLASS.	HWY. SYS.	HPMS SAMPLE	PRKG. REST.	COM/IND ACCESS		CONTROL	COM/IND ACCESS	PRKG. REST.	

Gr. Upper Marlboro
Sm. Urban

SHA 51.3 - 8 Revised
4.83

MARYLAND STATE HIGHWAY ADMINISTRATION

90-214

89-139

ROAD INVENTORY SHEET ~~CP 4686~~

Party Chief BB
Recorder BB
Assistant
Map No./Dir. G12 / SE
State Coordinates 869.360

Road No. Co. 5033
Road Name Colonel Contee Pl.
County Pr. Geo.
Date 2/28/90
Sheet No. 1 OF 1

TRAFFIC CODES
TRAFFIC CONTROLS: STOP SIGN=SS, TRAFFIC LIGHT=T.L., FLASHING RED BALL=F.R.

TRAFFIC CODES
PARKING RESTRICTIONS: A.M. PEAK, P.M. PEAK, A.M./P.M. PEAK, NO PARKING ANYTIME=N.P., COMM/IND. ACCESS=E

SYSTEM				TRAFFIC		LINE DIAGRAM	TRAFFIC			PAVEMENT DATA
FED. AID.	FUNCT CLASS.	HWY. SYS.	HPMS SAMPLE	PRK.G. REST.	COM/IND. ACCESS		CONTROL	COM/IND. ACCESS	PRK.G. REST.	
						D E				
						CUL 0 15 SAC				
						0 10				
	Rural Local					Col. Contee Ct.				
						Co. 5034 0 09 Pt				
						90°				
						0 03 Pc				
										24'I
						Colonels Choice				Jc-c
						OP 0 00 4631 (4709) 0.32				
						Col. Dentes Ct. ext. to Pl.				

SYSTEM				TRAFFIC		LINE DIAGRAM	TRAFFIC			PAVEMENT DATA
FED. AID.	FUNCT. CLASS.	HWY. SYS.	HPMS SAMPLE	PRKG. REST.	COM/IND ACCESS		CONTROL	COM/IND ACCESS	PRKG. REST.	

Greater Upper Marlboro
Sm. Urban

SHA 51.3 - 8 Revised
4.83

MARYLAND STATE HIGHWAY ADMINISTRATION

ROAD INVENTORY SHEET OP ~~4689~~ 90-215

89-138

Party Chief BB
Recorder BB
Assistant
Map No./Dir. 612 / N
State Coordinates 869-360

Road No. Co. 5034
Road Name Colonel Contee Ct
County Pr. Geo.
Date 2/28/90
Sheet No. 1 OF 1

SYSTEM				TRAFFIC		LINE DIAGRAM	TRAFFIC			PAVEMENT DATA
FED. AID.	FUNCT CLASS.	HWY. SYS.	HPMS SAMPLE	PRK.G. REST.	COM/IND. ACCESS		CONTROL	COM/IND. ACCESS	PRK.G. REST.	
						D E				
						CUL 006 SAC				

SYSTEM				TRAFFIC		LINE DIAGRAM	TRAFFIC			PAVEMENT DATA
FED. AID.	FUNCT. CLASS.	HWY. SYS.	HPMS SAMPLE	PRK'G. REST.	COM/IND ACCESS		CONTROL	COM/IND ACCESS	PRK'G. REST.	

Cor. Upper Marlboro
Sm. Urban

~~Road~~

SHA 51.3 - 8 Revised
4.83

MARYLAND STATE HIGHWAY ADMINISTRATION

ROAD INVENTORY SHEET

89-140

Party Chief BB
Recorder BB
Assistant
Map No./Dir. 612 / 5
State Coordinates 869-360

Road No. Co. 5035
Road Name Colonel Beall Pl.
County Pr. Geo.
Date 2/28/90
Sheet No. 1 OF 1

SYSTEM				TRAFFIC		LINE DIAGRAM	TRAFFIC			PAVEMENT DATA
FED. AID.	FUNCT CLASS.	HWY. SYS.	HPMS SAMPLE	PK.G. REST.	COM/IND. ACCESS		CONTROL	COM/IND. ACCESS	PK.G. REST.	
						D E				
	↑					CUL 0 07 SAC			↑	
										24'I
	Rural Local					Colonels CHOICE				JC-C
	↓					Co 000 4909			↓	
						@.25				

TRAFFIC CODES

TRAFFIC CONTROLS: STOP SIGN=SS, TRAFFIC LIGHT=T.L., FLASHING RED BALL=F.R.

TRAFFIC CODES

PARKING RESTRICTIONS: A.M. PEAK, P.M. PEAK, A.M./P.M. PEAK, NO PARKING ANYTIME=N.P., COMM/IND. ACCESS=E

SYSTEM				TRAFFIC		LINE DIAGRAM	TRAFFIC			PAVEMENT DATA
FED. AID.	FUNCT. CLASS.	HWY. SYS.	HPMS SAMPLE	PRK.G. REST.	COM/IND ACCESS		CONTROL	COM/IND ACCESS	PRK.G. REST.	

SHA 51.3 - 8 Revised
4.83

~~Burst~~ Greater Upper Marlboro Sm. Urban

MARYLAND STATE HIGHWAY ADMINISTRATION

ROAD INVENTORY SHEET

89.144

Party Chief JB
Recorder BB
Assistant
Map No./Dir. 612 / W
State Coordinates 872-360

Road No. Co. 5036
Road Name DEPOT LA.
County Pr. GEO.
Date 2/28/90
Sheet No. 1 OF 1

TRAFFIC CODES
TRAFFIC CONTROLS: STOP SIGN=SS, TRAFFIC LIGHT=T.L., FLASHING RED BALL=F.R.

TRAFFIC CODES
PARKING RESTRICTIONS: A.M. PEAK, P.M. PEAK, A.M./P.M. PEAK, NO PARKING ANYTIME=N.P., COMM/IND. ACCESS=E

SYSTEM				TRAFFIC		LINE DIAGRAM	TRAFFIC			PAVEMENT DATA
FED. AID.	FUNCT CLASS.	HWY. SYS.	HPMS SAMPLE	PRKG. REST.	COM/IND. ACCESS		CONTROL	COM/IND. ACCESS	PRKG. REST.	
	Rural Local					DE CUL 0 05 SAC 0 02 Blue Star @ 14.59 Mem. Hwy. U.S. 0 00 301		SS		44'I JC-C 2-12'I JC-C 1.5' JMED

SYSTEM				TRAFFIC		LINE DIAGRAM	TRAFFIC			PAVEMENT DATA
FED. AID.	FUNCT. CLASS.	HWY. SYS.	HPMS SAMPLE	PRKG. REST.	COM/IND ACCESS		CONTROL	COM/IND ACCESS	PRKG. REST.	

SHA 51.3 - 8 Revised
4.83

MARYLAND STATE HIGHWAY ADMINISTRATION

ROAD INVENTORY SHEET OP 4688

89-146

Party Chief BB
Recorder BB
Assistant
Map No./Dir. H11 / W
State Coordinates 299-326

Road No. Co. 5037
Road Name SYRIA CT
County P.G.
Date 2-19-90
Sheet No. 1 OF 1

SYSTEM: FED. AID. | FUNCT CLASS. | HWY. SYS. | HPMS SAMPLE
TRAFFIC: PRKG. REST. | COM/IND. ACCESS

LINE DIAGRAM

TRAFFIC: CONTROL | COM/IND ACCESS | PRKG. REST.

PAVEMENT DATA

TRAFFIC CODES
TRAFFIC CONTROLS: STOP SIGN=SS, TRAFFIC LIGHT=T.L., FLASHING RED BALL=F.R.

TRAFFIC CODES
PARKING RESTRICTIONS: A.M. PEAK, P.M. PEAK, A.M./P.M. PEAK, NO PARKING ANYTIME=N.P., COMM/IND. ACCESS=E

D E
CUL 016 SAC
Urban Local
OP 4688
006
24'I
JC-C
FORT Washington Rd.
Co 000 416 @1.18 SS

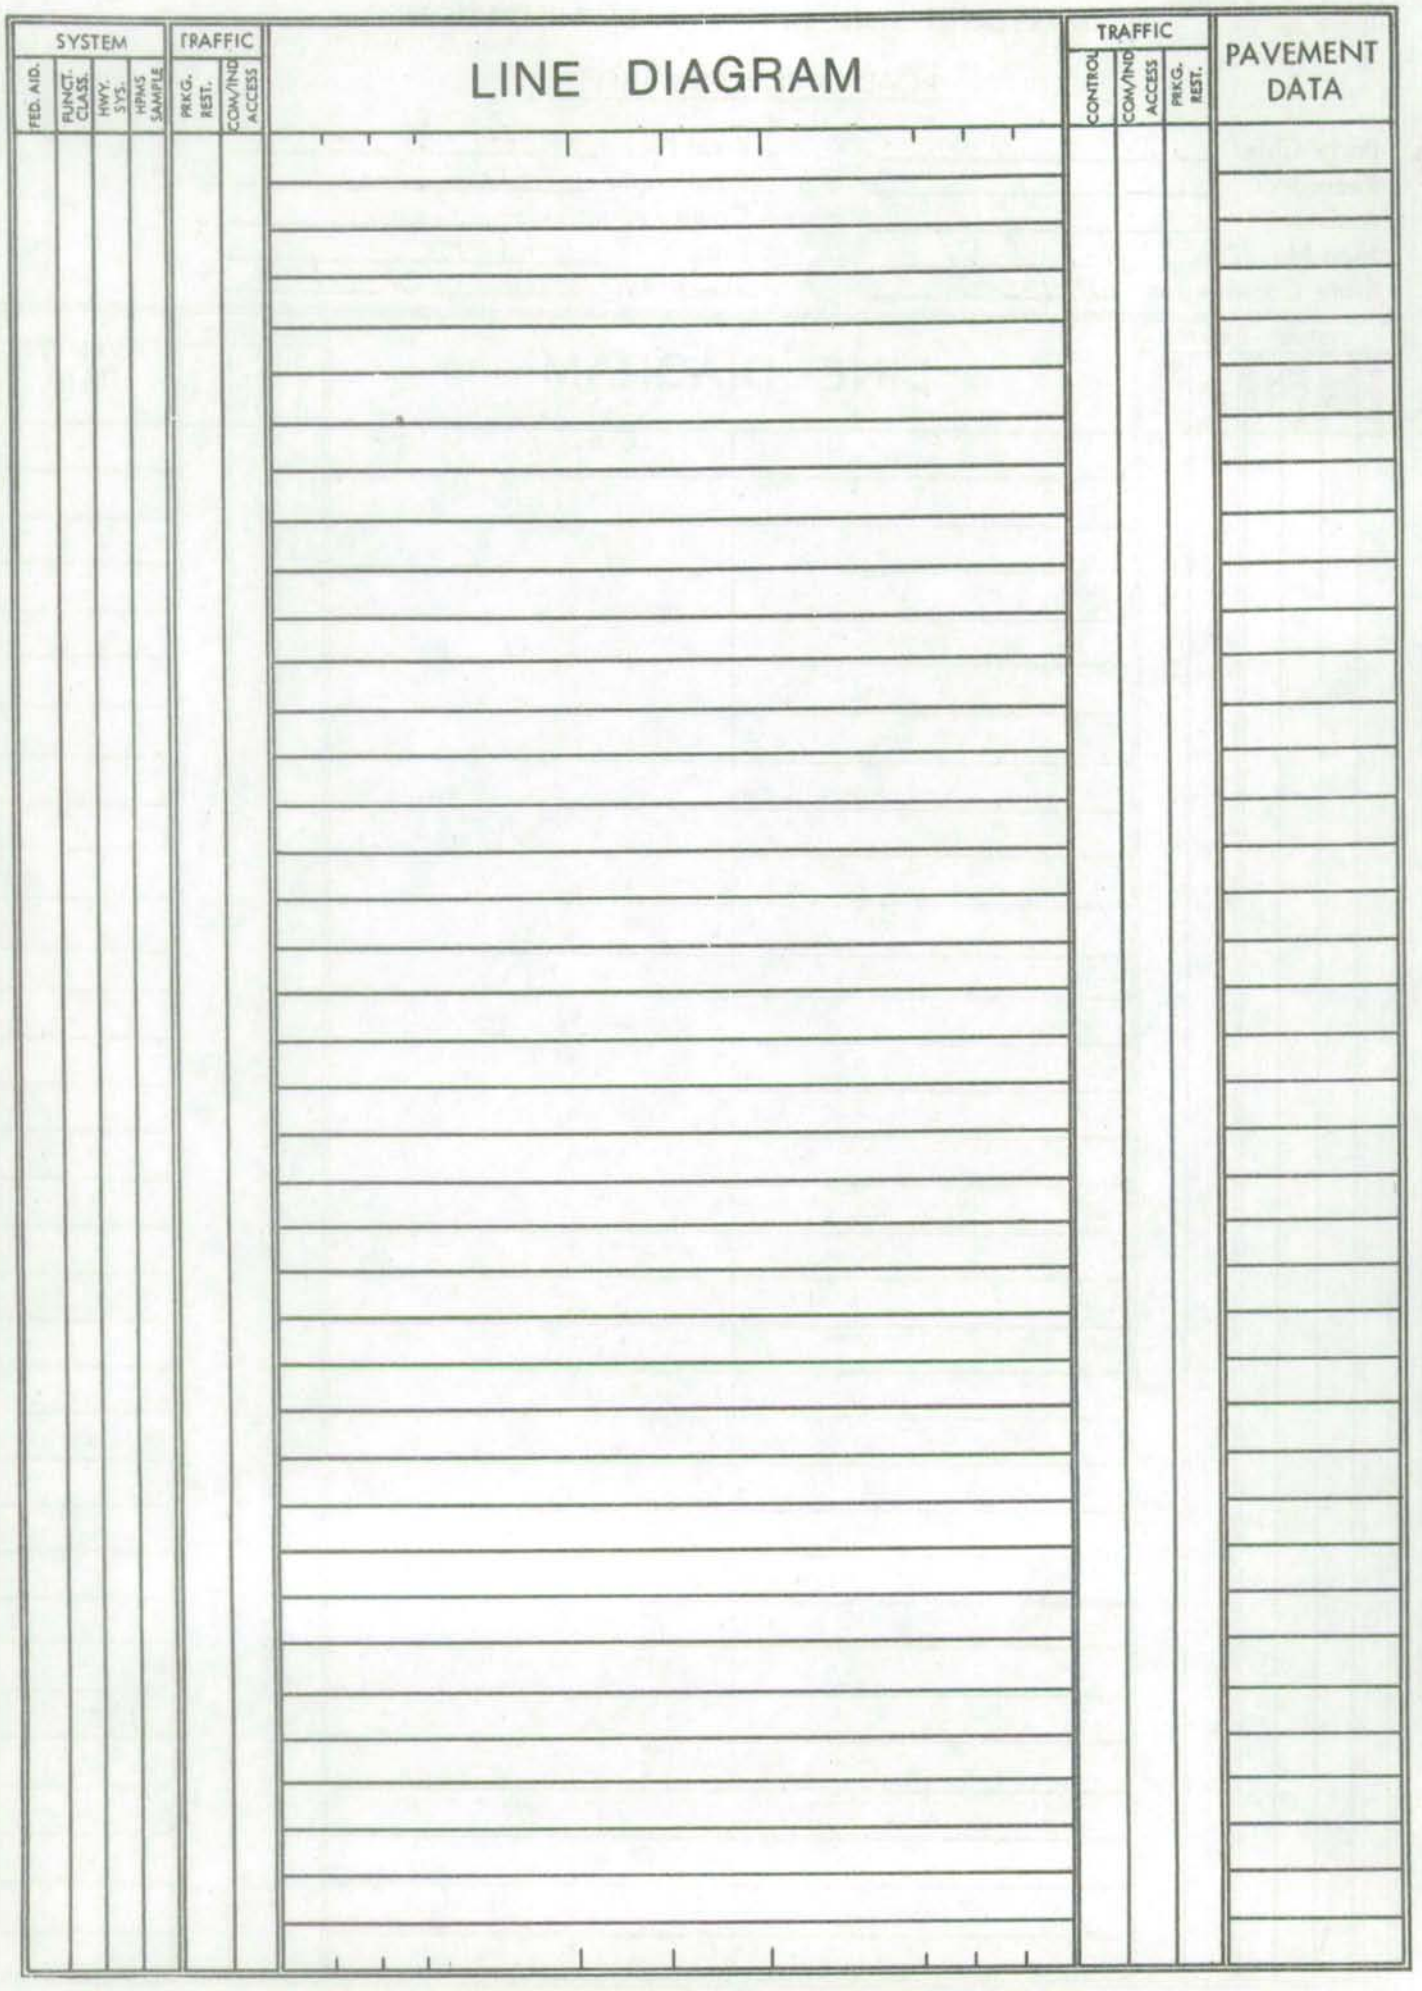
SYSTEM
FED. AID.
FUNCT. CLASS.
HWY. SYS.
HPMS SAMPLE
TRAFFIC
PRK.G. REST.
COM/IND ACCESS
LINE DIAGRAM
TRAFFIC
CONTROL
COM/IND ACCESS
PRK.G. REST.
PAVEMENT DATA

SHA 51.3 - 8 Revised
4.83

MARYLAND STATE HIGHWAY ADMINISTRATION

ROAD INVENTORY SHEET

89-149

Party Chief BB
Recorder BB
Assistant
Map No./Dir. HH / W
State Coordinates 781-327

Road No. Co 5038
Road Name CANO CT.
County P.G.
Date 2-19-90
Sheet No. 1 OF 1

SYSTEM				TRAFFIC		LINE DIAGRAM	TRAFFIC			PAVEMENT DATA
FED. AID.	FUNCT CLASS.	HWY. SYS.	HPMS SAMPLE	PRK.G. REST.	COM/IND. ACCESS		CONTROL	COM/IND ACCESS	PRK.G. REST.	
	Urban Local					D E CUL 0 11 SAC 30↑ 0 04 ASBURY CO. 0 00 DR. @ 30 3614				24 I Jc-c

TRAFFIC CODES
TRAFFIC CONTROLS: STOP SIGN=SS, TRAFFIC LIGHT=T.L., FLASHING RED BALL=F.R.

TRAFFIC CODES
PARKING RESTRICTIONS: A.M. PEAK, P.M. PEAK, A.M./P.M. PEAK, NO PARKING ANYTIME=N.P., COMM/IND. ACCESS=E

SYSTEM				TRAFFIC		LINE DIAGRAM	TRAFFIC			PAVEMENT DATA
FED. AID.	FUNCT. CLASS.	HWY. SYS.	HPMS SAMPLE	PRK'G. REST.	COM/IND ACCESS		CONTROL	COM/IND ACCESS	PRK'G. REST.	

SHA 51.3 - 8 Revised
4.83

MARYLAND STATE HIGHWAY ADMINISTRATION

ROAD INVENTORY SHEET

89172

Party Chief BB
Recorder BB
Assistant
Map No./Dir. H11 / E
State Coordinates 801-327

Road No. Co 5039
Road Name COSTE CT.
County PRINCE GEORGES
Date 2-19-90
Sheet No. 1 OF 1

SYSTEM: FED. AID. | FUNCT CLASS. | HWY. SYS. | HPMS SAMPLE
TRAFFIC: PRKG. REST. | COM/IND. ACCESS

LINE DIAGRAM

TRAFFIC: CONTROL | COM/IND. ACCESS | PRKG. REST.

PAVEMENT DATA

TRAFFIC CODES
TRAFFIC CONTROLS: STOP SIGN=SS, TRAFFIC LIGHT=T.L., FLASHING RED BALL=F.R.

TRAFFIC CODES
PARKING RESTRICTIONS: A.M. PEAK, P.M. PEAK, A.M./P.M. PEAK, NO PARKING ANYTIME=N.P., COMM/IND. ACCESS=E

Urban Local

D E
CUL 003 SAC

24'I
JC-C

ASBURY Dr
Co 000 3756
@.38 3614

SYSTEM				TRAFFIC		LINE DIAGRAM	TRAFFIC				PAVEMENT DATA
FED. AID.	FUNCT. CLASS.	HWY. SYS.	HPMS SAMPLE	PRK.G. REST.	COM/IND ACCESS		CONTROL	COM/IND ACCESS	PRK.G. REST.		

SHA 51.3 - 8 Revised
4.83

MARYLAND STATE HIGHWAY ADMINISTRATION

89-158

ROAD INVENTORY SHEET

Party Chief BB
Recorder BB
Assistant
Map No./Dir. H11 / N
State Coordinates 815-326

Road No. Co. 5040
Road Name ROULADE PL
County PRINCE GEORGES
Date 2-19-90
Sheet No. 1 OF 1

TRAFFIC CODES
TRAFFIC CONTROLS: STOP SIGN=SS, TRAFFIC LIGHT=T.L., FLASHING RED BALL=F.R.

TRAFFIC CODES
PARKING RESTRICTIONS: A.M. PEAK, P.M. PEAK, A.M./P.M. PEAK, NO PARKING ANYTIME=N.P., COMM/IND. ACCESS=E

SYSTEM				TRAFFIC		LINE DIAGRAM	TRAFFIC			PAVEMENT DATA
FED. AID.	FUNCT CLASS.	HWY. SYS.	HPMS SAMPLE	PRK.G. REST.	COM/IND. ACCESS		CONTROL	COM/IND. ACCESS	PRK.G. REST.	
	^					X — X ROAD 012 END				^
	Urban local									
						MARY CATHERINE DE				24'I
	V					CO. 000 3890 C.13				JC-C V

SYSTEM				TRAFFIC		LINE DIAGRAM	TRAFFIC				PAVEMENT DATA
FED. AID.	FUNCT. CLASS.	HWY. SYS.	HPMS SAMPLE	PRKG. REST.	COM/IND ACCESS		CONTROL	COM/IND ACCESS	PRKG. REST.		

SHA 51.3 - 8 Revised
4.83

MARYLAND STATE HIGHWAY ADMINISTRATION

ROAD INVENTORY SHEET

89-159

Party Chief BB
Recorder BB
Assistant
Map No./Dir. HL / N
State Coordinates B15-326

Road No. Co. 5041
Road Name MORDENTE DR
County PRINCE GEORGES
Date 2-19-90
Sheet No. 1 OF 1

SYSTEM				TRAFFIC		LINE DIAGRAM	TRAFFIC			PAVEMENT DATA
FED. AID.	FUNCT. CLASS.	HWY. SYS.	HPMS SAMPLE	PRK.G. REST.	COM/IND. ACCESS		CONTROL	COM/IND. ACCESS	PRK.G. REST.	
	↑					ROAD 0|19 END				↑
	urban local									
	↓					MARY CATHERINE DR. Co. 0|00 3890 @.05				24'I JC-C ↓

TRAFFIC CODES
TRAFFIC CONTROLS: STOP SIGN=SS, TRAFFIC LIGHT=T.L., FLASHING RED BALL=F.R.

TRAFFIC CODES
PARKING RESTRICTIONS: A.M. PEAK, P.M. PEAK, A.M./P.M. PEAK, NO PARKING ANYTIME=N.P., COMM/IND. ACCESS=E

SYSTEM				TRAFFIC		LINE DIAGRAM	TRAFFIC			PAVEMENT DATA
FED. AID.	FUNCT. CLASS.	HWY. SYS.	HPMS SAMPLE	PRK.G. REST.	COM/IND ACCESS		CONTROL	COM/IND ACCESS	PRK.G. REST.	

SHA 51.3 - 8 Revised
4.83

MARYLAND STATE HIGHWAY ADMINISTRATION

ROAD INVENTORY SHEET

89-169

Party Chief BB
Recorder BB
Assistant
Map No./Dir. H 11 / 5
State Coordinates 809-332

Road No. Co. 5042
Road Name Parapet Ct.
County PRINCE GEORGES
Date 2-19-90
Sheet No. 1 OF 1

SYSTEM				TRAFFIC		LINE DIAGRAM	TRAFFIC			PAVEMENT DATA
FED. AID.	FUNCT CLASS.	HWY. SYS.	HPMS SAMPLE	PRKG. REST.	COM/IND. ACCESS		CONTROL	COM/IND ACCESS	PRKG. REST.	
						D E				
						CUL 010 JAC				↑
						003 ↑ 30°				
										24'I
						OLD FORT Rd. EAST				JC-C
						Co 000 4551	SS			↓
						@.05				

SYSTEM				TRAFFIC		LINE DIAGRAM	TRAFFIC			PAVEMENT DATA
FED. AID.	FUNCT. CLASS.	HWY. SYS.	HPMS SAMPLE	PRKG. REST.	COM/IND ACCESS		CONTROL	COM/IND ACCESS	PRKG. REST.	

SHA 51.3 - 8 Revised
4.83

MARYLAND STATE HIGHWAY ADMINISTRATION

ROAD INVENTORY SHEET

98-107A
11-18-98
SS/SR/BB

EAST BONIWOOD TURN

89-163

Party Chief BB
Recorder BB
Assistant
Map No./Dir. H-11 / E
State Coordinates 823-323

Road No. Co 5043/OP5349
Road Name ~~EAST BONIWOOD TURN, EAST~~
County PRINCE GEORGES
Date 2-16-90
Sheet No. 1 OF 1

00-CO EX #52
2-7-01
GD/EF
01-48

TRAFFIC CODES
TRAFFIC CONTROLS: STOP SIGN=SS, TRAFFIC LIGHT=T.L., FLASHING RED BALL=F.R.

TRAFFIC CODES
PARKING RESTRICTIONS: A.M. PEAK, P.M. PEAK, A.M./P.M. PEAK, NO PARKING ANYTIME=N.P., COMM/IND. ACCESS=E

SYSTEM FED. AID.	SYSTEM FUNCT CLASS.	SYSTEM HWY. SYS.	SYSTEM HPMS SAMPLE	TRAFFIC PRKG. REST.	TRAFFIC COM/IND. ACCESS	LINE DIAGRAM	TRAFFIC CONTROL	TRAFFIC COM/IND. ACCESS	TRAFFIC PRKG. REST.	PAVEMENT DATA
					E	600 026		E		
						024 OP 5349				
						PC ~~ROAD~~ 021 ~~END~~				
						COSCA PARK PL. COSCA PARK DR				
						Co 5045 018 Co 5044				20' M L
										36' I
										JC-C
						015 PI			X	
						014 TO. T.H.		E		
						80°				
				E		TO T.H. 011				
						006 PC				
										44' I
										JC-C
										2 M L
						THRIFT Rd.				
						Co. 000 145				
						@ 264				

LINE DIAGRAM

SYSTEM: FED. AID. | FUNCT. CLASS. | HWY. SYS. | HPMS SAMPLE

TRAFFIC: PRKG. REST. | COM/IND ACCESS

TRAFFIC: CONTROL | COM/IND ACCESS | PRKG. REST.

PAVEMENT DATA

WEST BONIWOOD TURN 4486

CO

BIRCHVIEW DR — CO 4861 — 0161 — BIRCHVIEW CT — CO 4831

PT — 0157

SYLVIA DR — CO 5332 — 0151

500

PC — 0149

SYLVIA LA — CO 5333 — 0145

0141

E T.H 0138 T.H E

E T.H 0136 T.H E

E T.H 0131 T.H E

PT — 0129

OP 5349

CO 5043

36'I
JC-C
2 ML

SHA 51.3 - 8 Revised
4.83

MARYLAND STATE HIGHWAY ADMINISTRATION

ROAD INVENTORY SHEET

89-16A

Party Chief BB
Recorder BB
Assistant
Map No./Dir. H11 / S
State Coordinates 823-223

Road No. CO 5044
Road Name COSCA PARK DR.
County PRINCE GEORGES
Date 2-16-90
Sheet No. 1 OF 1

TRAFFIC CODES
TRAFFIC CONTROLS: STOP SIGN=SS, TRAFFIC LIGHT=T.L., FLASHING RED BALL=F.R.

TRAFFIC CODES
PARKING RESTRICTIONS: A.M. PEAK, P.M. PEAK, A.M./P.M. PEAK, NO PARKING ANYTIME=N.P., COMM/IND. ACCESS=E

SYSTEM				TRAFFIC		LINE DIAGRAM			TRAFFIC			PAVEMENT DATA
FED. AID.	FUNCT CLASS.	HWY. SYS.	HPMS SAMPLE	PRK.G. REST.	COM/IND. ACCESS				CONTROL	COM/IND. ACCESS	PRK.G. REST.	
							D	E				
				E		TO T.H. CUL	0 11	SAC TO TIH.		E		
							0 06	TO. T.H.		E		
				E		TO T.H.	0 04	TO. T.H.		E		
				E		TO T.H.	0 03					
						EAST BONIWOOD		TURN				26'I
						CO.	0 00	5043	SS			JC-C
						COSCA PARK DR.		TO 5045 @.18				

Urban Local

SYSTEM				TRAFFIC		LINE DIAGRAM	TRAFFIC				PAVEMENT DATA
FED. AID.	FUNCT. CLASS.	HWY. SYS.	HPMS SAMPLE	PRK.G. REST.	COM/IND ACCESS		CONTROL	COM/IND ACCESS	PRK.G. REST.		

SHA 51.3 - 8 Revised
4.83

MARYLAND STATE HIGHWAY ADMINISTRATION

90-259

ROAD INVENTORY SHEET ~~OP 4690~~

89-165

Party Chief BB
Recorder BB
Assistant
Map No./Dir. HII / N
State Coordinates 823-326

Road No. Co 5045
Road Name COSCA PARK PLACE
County PRINCE GEORGES
Date 2-16-90
Sheet No. 1 OF 1

TRAFFIC CODES
TRAFFIC CONTROLS: STOP SIGN=SS, TRAFFIC LIGHT=T.L., FLASHING RED BALL=F.R.

TRAFFIC CODES
PARKING RESTRICTIONS: A.M. PEAK, P.M. PEAK, A.M./P.M. PEAK, NO PARKING ANYTIME=N.P., COMM/IND. ACCESS=E

SYSTEM				TRAFFIC		LINE DIAGRAM	TRAFFIC			PAVEMENT DATA
FED. AID.	FUNCT. CLASS.	HWY. SYS.	HPMS SAMPLE	PRK.G. REST.	COM/IND. ACCESS		CONTROL	COM/IND. ACCESS	PRK.G. REST.	
						D E				
					E	TO T.H. CUL 0 09 SAC TO T.H.		E		
	Urban local									
					E	30 ft 0 07				
						0 04 TO TH		E		
					E	TO T.H. 0 02 TO. T.H.		E		26'I
						EAST BONLIWOOD TURN				JC-C
						Co. 0 0 0 5043	SS			
						@.18				
						COSCA PARK DR. CO 5044				

90-259 OP 4690

SYSTEM				TRAFFIC		LINE DIAGRAM	TRAFFIC				PAVEMENT DATA
FED. AID.	FUNCT. CLASS.	HWY. SYS.	HPMS SAMPLE	PRK'G. REST.	COM/IND ACCESS		CONTROL	COM/IND ACCESS	PRK'G. REST.		

SHA 51.3 - 8 Revised
4.83

MARYLAND STATE HIGHWAY ADMINISTRATION

ROAD INVENTORY SHEET

168-89

Party Chief BB
Recorder BB
Assistant
Map No./Dir. H-11 / N
State Coordinates 928-330

Road No. Co 5046
Road Name WILLOW CT
County PRINCE GEORGES
Date 2-16-90
Sheet No. 1 OF 1

SYSTEM: FED. AID. | FUNCT. CLASS. | HWY. SYS. | HPMS SAMPLE
TRAFFIC: PRK.G. REST. | COM/IND. ACCESS

LINE DIAGRAM

TRAFFIC: CONTROL | COM/IND. ACCESS | PRK.G. REST.

PAVEMENT DATA

TRAFFIC CODES
TRAFFIC CONTROLS: STOP SIGN=SS, TRAFFIC LIGHT=T.L., FLASHING RED BALL=F.R.

TRAFFIC CODES
PARKING RESTRICTIONS: A.M. PEAK, P.M. PEAK, A.M./P.M. PEAK, NO PARKING ANYTIME=N.P., COMM/IND. ACCESS=E

Urban Local

D E
CUL 0 04 SAC

WILLOW CO. WAY
40 54
0 00
0.31

SS

26'I
JC-C

SYSTEM				TRAFFIC		LINE DIAGRAM	TRAFFIC			PAVEMENT DATA
FED. AID.	FUNCT. CLASS.	HWY. SYS.	HPMS SAMPLE	PRK'G. REST.	COM/IND ACCESS		CONTROL	COM/IND ACCESS	PRK'G. REST.	

Form 6 HPS (Rev. 1961)

Urban

MAP 4

89-31
31-900 P 474
BB/BB

ROAD INVENTORY SHEET

CO 5047

90-81

Party Chief E.S.
Recorder W.D.
Chainman

M-32

F-12

Road No. ~~CR 1379~~
Name SHAFER LANE
Sheet No. 1 OF 1
Date 7-1-68
County PRINCE GEO

90-81 858-420

E ↑

VeR 6-7-78

ROAD	0	37	END	
H	0	35	H	
	0	34		
H	0	33		
	0	31	H	
H	0	27	H	
	0	23		
H	0	19	6 H	
H	0	16		
	0	10		
	0	03		
	0	02	H	
CO HILLMEADE	0	00	41 ROAD	

E ↑

CO 5047

44 .04

.34

13+58

.03

50 R-05

14'EI
16'C-W

~~14'EI~~
~~14'CW~~
30'I

Was OP 25

SHA 51.3 - 8 Revised
4.83

MARYLAND STATE HIGHWAY ADMINISTRATION

ROAD INVENTORY SHEET

89-79, 80
2-21-90
BB/BB

Party Chief E. Schuyler
Recorder I. Landon
Assistant Revised 6-7-90 KSP
Map No./Dir. G11 2 / W
State Coordinates 812-361

Road No. Co 5048
Road Name (John A. Thompson Rd)
County Prince Georges
Date 12-20-67
Sheet No. 1 OF 1

TRAFFIC CODES
TRAFFIC CONTROLS: STOP SIGN=SS, TRAFFIC LIGHT=T.L., FLASHING RED BALL=F.R.

TRAFFIC CODES
PARKING RESTRICTIONS: A.M. PEAK, P.M. PEAK, A.M./P.M. PEAK, NO PARKING ANYTIME=N.P., COMM/IND. ACCESS=E

SYSTEM				TRAFFIC		LINE DIAGRAM	TRAFFIC			PAVEMENT DATA
FED. AID.	FUNCT CLASS.	HWY. SYS.	HPMS SAMPLE	PRKG. REST.	COM/IND. ACCESS		CONTROL	COM/IND. ACCESS	PRKG. REST.	
	Urban Local					John A. Thompson Rd CO 4449				14' E 21' CW
						0 07				
						0 03 church		E		21' I 21' CW
						MD 0 00 414 @ 2.86				

SYSTEM				TRAFFIC		LINE DIAGRAM	TRAFFIC			PAVEMENT DATA
FED. AID.	FUNCT. CLASS.	HWY. SYS.	HPMS SAMPLE	PRK.G. REST.	COM/IND ACCESS		CONTROL	COM/IND ACCESS	PRK.G. REST.	

Form 6 HPS (Rev. 1961) MAP 2 90-1 CO 5049 ~~OP556~~ V 78

ROAD INVENTORY SHEET

WOODVIEW TERR

Party Chief E Schuyler
Recorder H Gorman
Chainman

WEST OF LAUREL
MAP 1

Ver 5-19-78

EIID

838: 464 ~~1455:27~~ 97-001

Road No. ~~OP~~ 1461
Name ~~WOODLAND~~ TERR.
Sheet No. 1 OF 1
Date 6/7/66
County PRINCE GEORGES

N			
		ROAD END	
	H	008	
		007 H	
		005 H	
	H	002 H	20' X G 30' C-W
BROOKLYN BRIDGE		RD.	
CO.		000 3	

Form 6 HPS (Rev. 1961)

~~MAP 2~~

90-2.
3-1-91
BB/TM

~~QP226~~

CO 5050
(90-2)

78

ROAD INVENTORY SHEET

97-002
3-9-98
BB/AP

Party Chief E. Schuyler
Recorder H. GOAMAN
Chainman

E11D

VER
5-8-78

833-458

Road No. ~~QP 570~~ QUILL LA
Name ~~KIMBERLEY RD.~~
Sheet No. 1 OF 1
Date 6/15/66
County PRINCE GEORGES

~~M27~~

ROAD END.
0.09

H
17'H

~~Road End.~~
0.05

E

3 H

0.03 H

20' H
~~16' E~~
24' C-C

0.01

CONTEE RD.
CO. 0.00 6

Form 6 HPS (Rev. 1961)

90-5
3-1-91
BG/TM

72-28

ROAD INVENTORY SHEET

CO 5051
OP 993

Party Chief W. Dombroski
Recorder O. Taylor
Helper

Road No.
Road Name ~~(Dunby Rd.)~~ SYCAMORE RD
Sheet No. 1 of 1
Date 2-23-73
County Prince Georges

E11D

827-440

B & O RR Tracks

Road Post 001
Road End
0 H

923

013 B- Potter Septic tank Ser.

W

(East Maple Ave)

Co. 008 26 ∧20°

004 H

B- Const. Co. 002 H

000

Road End

N

30' I
~~20' D~~
~~20'CW~~

18'E
22'CW

Form 6 HPS (Rev. 1961)

ROAD INVENTORY SHEET

Road No. _____
Road Name _____
Sheet No. _____
Date _____
County _____

Form 6 HPS (Rev. 1961)

~~MAP~~

90-8
3-1-91
BB/TM

~~OP 199~~ CO 5052

ROAD INVENTORY SHEET

Party Chief E Schuyler
Recorder H Lowndes
Chainman

FMB

E11D

829 - VER 12-12-77
~~82X~~ 440-5

Road No. ~~OP 506~~
Name CYPRESS RD
Sheet No. 10 F 1
Date 7/13/66
County PRINCE GEORGES

~~M27~~

0' DEAD END RD.
CO. 008 22 SS

S

H 006

H 003

30° E
2 u ML

~~16° E~~

~~14° E~~

H 001

EAST MAPLE AV.
CO. 000 26 SS

NON FA
URB LOCAL

SHA 51.3 - 8 Revised
4.83

MARYLAND STATE HIGHWAY ADMINISTRATION

ROAD INVENTORY SHEET

~~OR 4712~~

Party Chief BB
Recorder TM
Assistant
Map No./Dir. E11D / ~~X~~ E
State Coordinates 824-440

Road No. CO 5053
Road Name GARRETT AVE
County P.G.
Date 3-1-91
Sheet No. 1 OF 1

90-9

97-10

TRAFFIC CODES
TRAFFIC CONTROLS: STOP SIGN=SS, TRAFFIC LIGHT=T.L., FLASHING RED BALL=F.R.

TRAFFIC CODES
PARKING RESTRICTIONS: A.M. PEAK, P.M. PEAK, A.M./P.M. PEAK, NO PARKING ANYTIME=N.P., COMM/IND. ACCESS=E

SYSTEM				TRAFFIC		LINE DIAGRAM	TRAFFIC			PAVEMENT DATA
FED. AID.	FUNCT CLASS	HWY. SYS.	HPMS SAMPLE	PRK.G. REST.	COM/IND. ACCESS		CONTROL	COM/IND. ACCESS	PRK.G. REST.	
						ROAD 0 10 END				12'E
						YATES RD CO 0 05 1365 @07				24'I JC-C
						~~YATES RD~~ CUL 0 00 SAC D E				

SYSTEM				TRAFFIC		LINE DIAGRAM	TRAFFIC			PAVEMENT DATA
FED. AID.	FUNCT. CLASS.	HWY. SYS.	HPMS SAMPLE	PRKG. REST.	COM/IND ACCESS		CONTROL	COM/IND ACCESS	PRKG. REST.	

NON FA
URB LOCAL

SHA 51.3 - 8 Revised
4.83

MARYLAND STATE HIGHWAY ADMINISTRATION

ROAD INVENTORY SHEET OP 4713

90-12

Party Chief BB
Recorder TIM
Assistant
Map No./Dir. E11D / S
State Coordinates 822-441

Road No. CO 5054
Road Name EMACK RD
County P.G.
Date 3-1-91
Sheet No. 1 OF 1

97-007

TRAFFIC CODES
TRAFFIC CONTROLS: STOP SIGN=SS, TRAFFIC LIGHT=T.L., FLASHING RED BALL=F.R.

TRAFFIC CODES
PARKING RESTRICTIONS: A.M. PEAK, P.M. PEAK, A.M./P.M. PEAK, NO PARKING ANYTIME=N.P., COMM/IND. ACCESS=E

SYSTEM				TRAFFIC		LINE DIAGRAM	TRAFFIC			PAVEMENT DATA
FED. AID.	FUNCT CLASS.	HWY. SYS.	HPMS SAMPLE	PRK.G. REST.	COM/IND. ACCESS		CONTROL	COM/IND. ACCESS	PRK.G. REST.	
						ROAD 0 08 END				
						0 04				12' F
						YATES RD				12' XG
						CO 1365 0 00				

SYSTEM				TRAFFIC		LINE DIAGRAM	TRAFFIC			PAVEMENT DATA
FED. AID.	FUNCT. CLASS.	HWY. SYS.	HPMS SAMPLE	PRKG. REST.	COM/IND ACCESS		CONTROL	COM/IND ACCESS	PRKG. REST.	

SHA 51.3 - 8 Revised
4.83

MARYLAND STATE HIGHWAY ADMINISTRATION

ROAD INVENTORY SHEET

90-17

Party Chief BB
Recorder BB
Assistant
Map No./Dir. E12C / SE
State Coordinates ~~849-444~~

Road No. Co. 5055
Road Name BRISTOLWOOD TERR.
County PRINCE GEORGES
Date 3-4-91
Sheet No. 1 OF 1

TRAFFIC CODES
TRAFFIC CONTROLS: STOP SIGN=SS, TRAFFIC LIGHT=T.L., FLASHING RED BALL=F.R.

TRAFFIC CODES
PARKING RESTRICTIONS: A.M. PEAK, P.M. PEAK, A.M./P.M. PEAK, NO PARKING ANYTIME=N.P., COMM/IND. ACCESS=E

SYSTEM				TRAFFIC		LINE DIAGRAM	TRAFFIC			PAVEMENT DATA
FED. AID.	FUNCT. CLASS.	HWY. SYS.	HPMS SAMPLE	PRK.G. REST.	COM/IND. ACCESS		CONTROL	COM/IND. ACCESS	PRK.G. REST.	
	NON FA					D E				
	URBAN - LOCAL					CUL 0 14 SAC				1
						0 10 PT				
						90°				
						0 06 PC				
										24I
										L-C
										2UNL
						C.T.				
						0 00 4467				V
						BRISTOLWOOD CO				

SYSTEM				TRAFFIC		LINE DIAGRAM	TRAFFIC			PAVEMENT DATA
FED. AID.	FUNCT. CLASS.	HWY. SYS.	HPMS SAMPLE	PRKG. REST.	COM/IND ACCESS		CONTROL	COM/IND ACCESS	PRKG. REST.	

SHA 51.3 - 8 Revised
4.83

MARYLAND STATE HIGHWAY ADMINISTRATION

9020

ROAD INVENTORY SHEET

Party Chief BB
Recorder BB
Assistant
Map No./Dir. F11A / E
State Coordinates 810-430

Road No. Co. 5056
Road Name CRUZE PL.
County PRINCE GEORGES
Date 3-4-91
Sheet No. 1 OF 1

SYSTEM				TRAFFIC		LINE DIAGRAM	TRAFFIC			PAVEMENT DATA
FED. AID.	FUNCT CLASS.	HWY. SYS.	HPMS SAMPLE	PRKG. REST.	COM/IND. ACCESS		CONTROL	COM/IND. ACCESS	PRKG. REST.	
NON FA	LOCAL URBAN					ROAD 0 04 END				12'D
						RIGGS Rd. MD 0 00 212 @ 4.67				

TRAFFIC CODES

TRAFFIC CONTROLS: STOP SIGN=SS, TRAFFIC LIGHT=T.L., FLASHING RED BALL=F.R.

TRAFFIC CODES

PARKING RESTRICTIONS: A.M. PEAK, P.M. PEAK, A.M./P.M. PEAK, NO PARKING ANYTIME=N, P., COMM/IND. ACCESS=E

SYSTEM				TRAFFIC		LINE DIAGRAM	TRAFFIC			PAVEMENT DATA
FED. AID.	FUNCT. CLASS.	HWY. SYS.	HPMS SAMPLE	PRK'G. REST.	COM/IND ACCESS		CONTROL	COM/IND ACCESS	PRK'G. REST.	

SHA 51.3 - 8 Revised
4.83

MARYLAND STATE HIGHWAY ADMINISTRATION

ROAD INVENTORY SHEET

90-26

Party Chief BB
Recorder BB
Assistant
Map No./Dir. F11B / S
State Coordinates 820-439

Road No. Co. 5057
Road Name HOWARD TERR.
County PRINCE GEORGES
Date 3-4-91
Sheet No. 1 OF 1

SYSTEM				TRAFFIC		LINE DIAGRAM	TRAFFIC			PAVEMENT DATA
FED. AID.	FUNCT. CLASS.	HWY. SYS.	HPMS SAMPLE	PRK.G. REST.	COM/IND. ACCESS		CONTROL	COM/IND. ACCESS	PRK.G. REST.	
						D E				
						CUL 0 05 SAC				
										24'I
										JC-C
						HOWARD Rd.				2UML
						CO 0 00 1921				

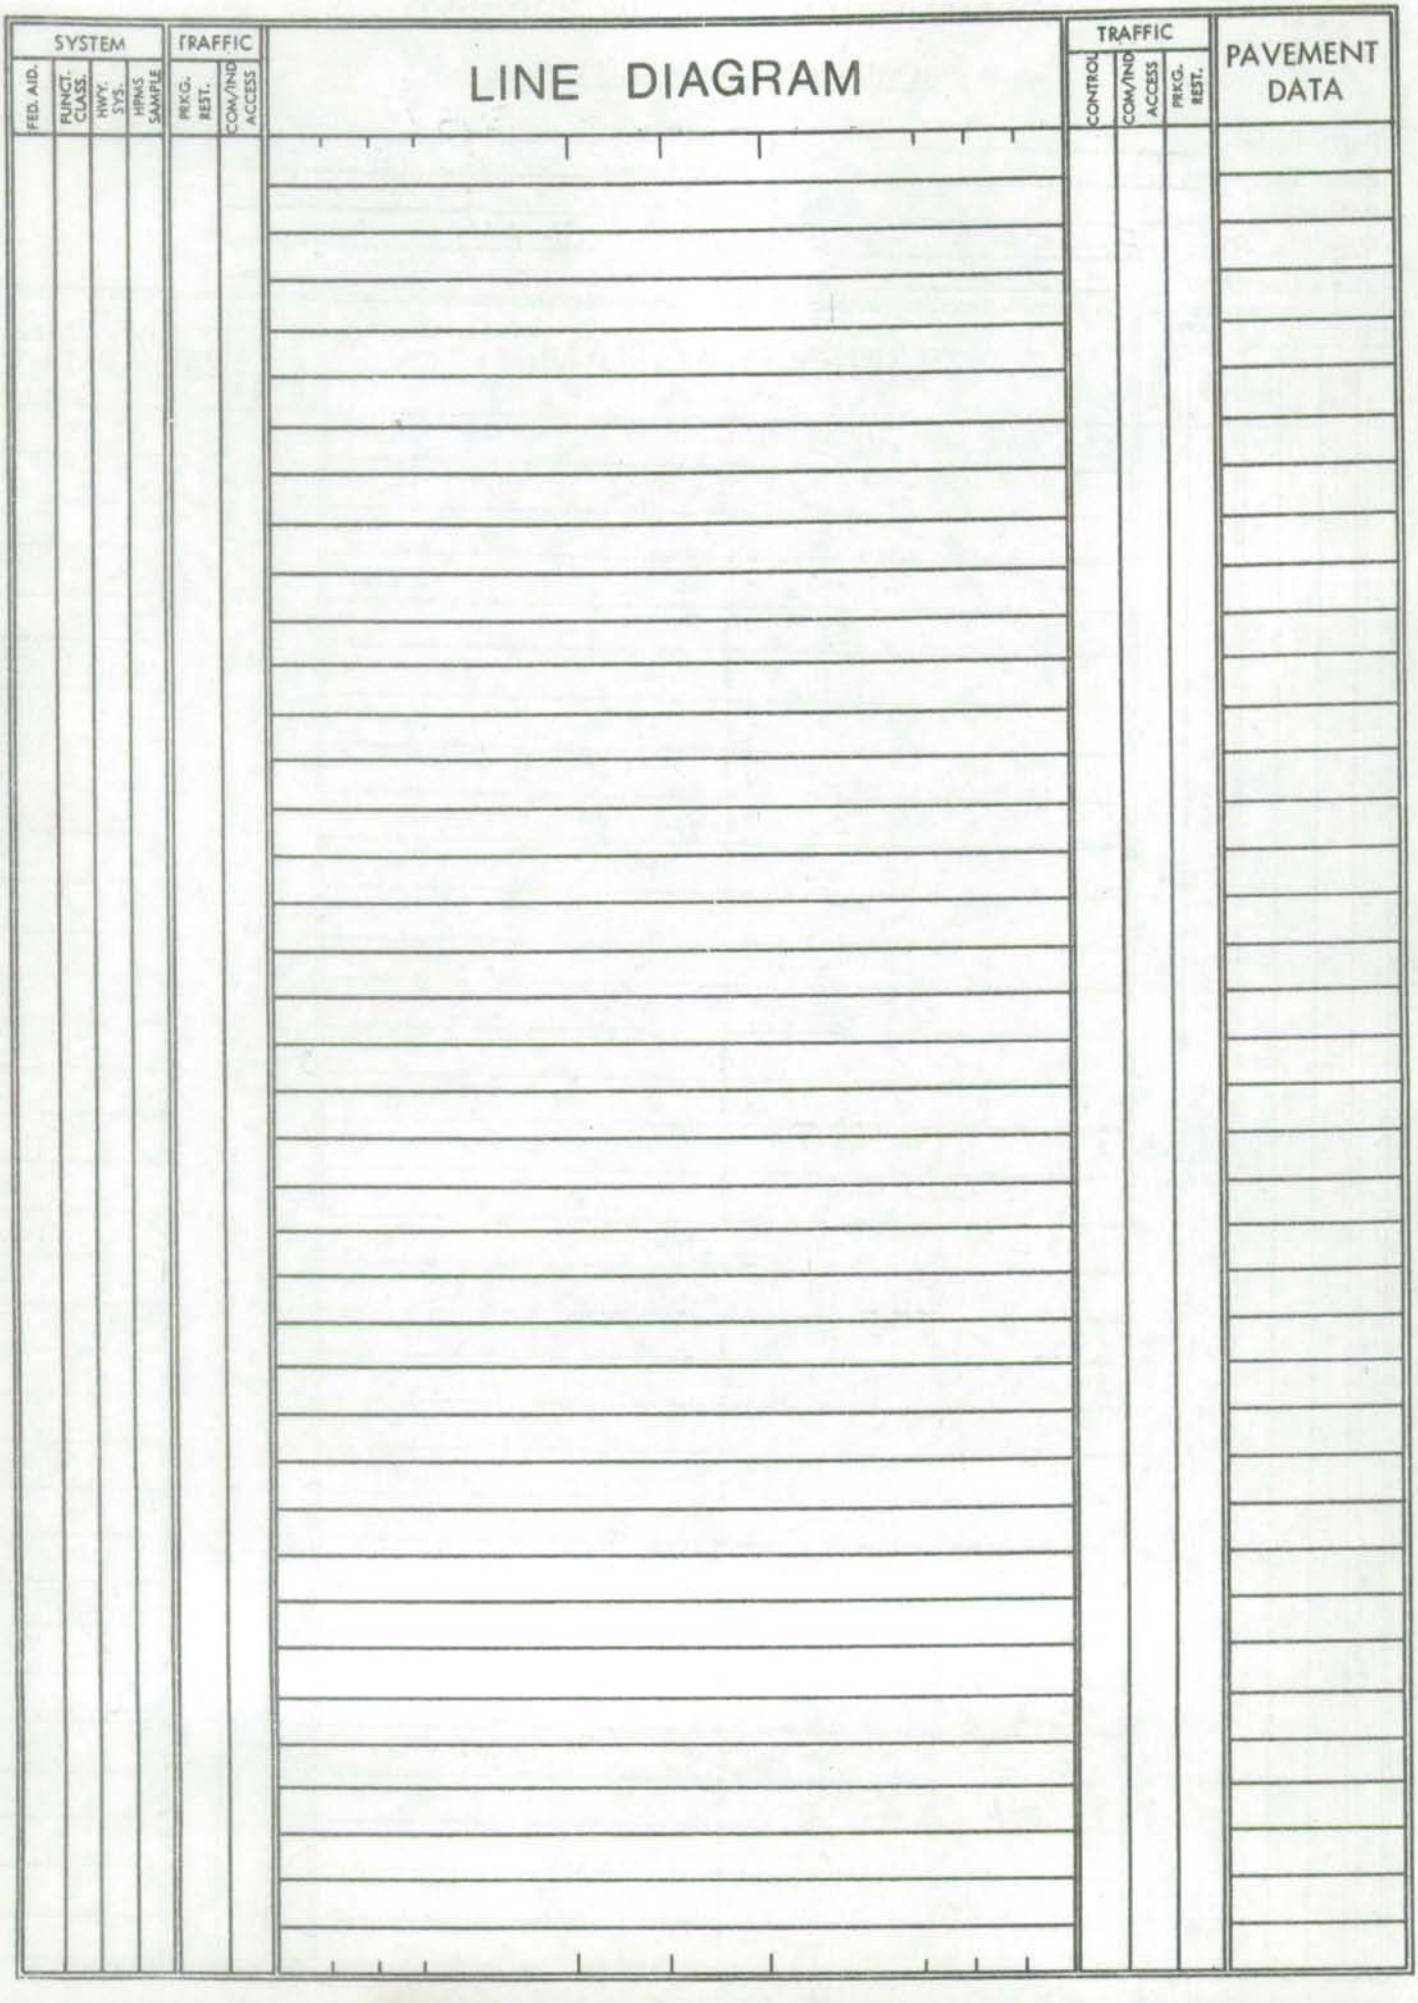
SYSTEM
FED. AID.
FUNCT. CLASS.
HWY. SYS.
HPMS SAMPLE
TRAFFIC
PRK'G. REST.
COM/IND ACCESS
LINE DIAGRAM
TRAFFIC
CONTROL
COM/IND ACCESS
PRK'G. REST.
PAVEMENT DATA

SHA 51.3 - 8 Revised
4.83

MARYLAND STATE HIGHWAY ADMINISTRATION

ROAD INVENTORY SHEET

90-27

Party Chief BD
Recorder BB
Assistant
Map No./Dir. F11B / S
State Coordinates 820-439

Road No. Co 5058
Road Name HOME ACRES TERR.
County PRINCE GEORGES
Date 3-4-91
Sheet No. 1 OF 1

SYSTEM				TRAFFIC		LINE DIAGRAM	TRAFFIC			PAVEMENT DATA
FED. AID.	FUNCT. CLASS.	HWY. SYS.	HPMS SAMPLE	PRK.G. REST.	COM/IND. ACCESS		CONTROL	COM/IND. ACCESS	PRK.G. REST.	
						D E				
						CUL 0 08 SAG				1
						130° 0 04				
										24'I
										JC-C
						Howard Rd.				20ML
						Of CO 0 00 1921				1
NON-FA										
URBAN-LOCAL										

TRAFFIC CODES

TRAFFIC CONTROLS: STOP SIGN=SS, TRAFFIC LIGHT=T.L., FLASHING RED BALL=F.R.

TRAFFIC CODES

PARKING RESTRICTIONS: A.M. PEAK, P.M. PEAK, A.M./P.M. PEAK, NO PARKING ANYTIME=N.P., COMM/IND. ACCESS=E

SYSTEM				TRAFFIC		LINE DIAGRAM	TRAFFIC			PAVEMENT DATA
FED. AID.	FUNCT. CLASS.	HWY. SYS.	HPMS SAMPLE	PRKG. REST.	COM/IND ACCESS		CONTROL	COM/IND ACCESS	PRKG. REST.	

SHA 51.3 - 8 Revised
4.83

MARYLAND STATE HIGHWAY ADMINISTRATION

ROAD INVENTORY SHEET

90-29

97-037
3-9-98
BB/AP

Party Chief BB
Recorder BB
Assistant
Map No./Dir. E11B / NW
State Coordinates 824-436

Road No. CO 5059
Road Name CLEMENTON RD.
County PRINCE GEORGES
Date 3-4-91
Sheet No. 1 OF 1

SYSTEM				TRAFFIC		LINE DIAGRAM	TRAFFIC			PAVEMENT DATA
FED. AID.	FUNCT. CLASS.	HWY. SYS.	HPMS SAMPLE	PRK.G. REST.	COM/IND. ACCESS		CONTROL	COM/IND. ACCESS	PRK.G. REST.	

TRAFFIC CODES

TRAFFIC CONTROLS: STOP SIGN=SS, TRAFFIC LIGHT=T.L., FLASHING RED BALL=F.R.

TRAFFIC CODES

PARKING RESTRICTIONS: A.M. PEAK, P.M. PEAK, A.M./P.M. PEAK, NO PARKING ANYTIME=N.P., COMM/IND. ACCESS=E

Non-FA
URB-LOCAL

ROAD END

0 00

0 01 90°

14'D
15'H

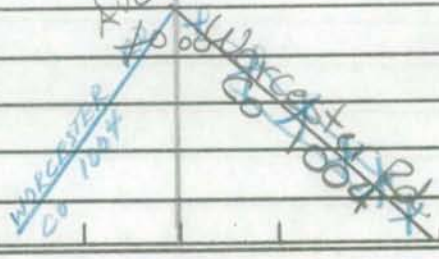

SYSTEM				TRAFFIC		LINE DIAGRAM	TRAFFIC				PAVEMENT DATA
FED. AID.	FUNCT. CLASS.	HWY. SYS.	HPMS SAMPLE	PRKG. REST.	COM/IND ACCESS		CONTROL	COM/IND ACCESS	PRKG. REST.		

SHA 51.3 - 8 Revised
4.83

MARYLAND STATE HIGHWAY ADMINISTRATION

ROAD INVENTORY SHEET

90-36

Party Chief BB
Recorder BB
Assistant
Map No./Dir. F11B / S
State Coordinates 838 - 416

Road No. Co 5060
Road Name Brays St
County Prince Georges
Date 3-4-91
Sheet No. 1 OF 1

TRAFFIC CODES
TRAFFIC CONTROLS: STOP SIGN=SS, TRAFFIC LIGHT=T.L., FLASHING RED BALL=F.R.

TRAFFIC CODES
PARKING RESTRICTIONS: A.M. PEAK, P.M. PEAK, A.M./P.M. PEAK, NO PARKING ANYTIME=N.P., COMM/IND. ACCESS=E

SYSTEM				TRAFFIC		LINE DIAGRAM	TRAFFIC			PAVEMENT DATA
FED. AID.	FUNCT CLASS.	HWY. SYS.	HPMS SAMPLE	PRKG. REST.	COM/IND. ACCESS		CONTROL	COM/IND. ACCESS	PRKG. REST.	
						D E				
						CUL 0 14 SAC				
						0 11 35°				
NON FA										24I
URB-LOCAL										JC-C
						TIFFANY LA				2UML
						G0 0 00 3104	SS			

SYSTEM				TRAFFIC		LINE DIAGRAM	TRAFFIC			PAVEMENT DATA
FED. AID.	FUNCT. CLASS.	HWY. SYS.	HPMS SAMPLE	PRK'G. REST.	COM/IND ACCESS		CONTROL	COM/IND ACCESS	PRK'G. REST.	

SHA 51.3 - 8 Revised
4.83

MARYLAND STATE HIGHWAY ADMINISTRATION

ROAD INVENTORY SHEET

90-306

Party Chief BB
Recorder BB
Assistant
Map No./Dir. F11B / S
State Coordinates 838-416

Road No. Co. 5061
Road Name Dahlgreen CT
County Prince GEDGES
Date 3-4-91
Sheet No. 1 OF

TRAFFIC CODES
TRAFFIC CONTROLS: STOP SIGN=SS, TRAFFIC LIGHT=T.L., FLASHING RED BALL=F.R.

TRAFFIC CODES
PARKING RESTRICTIONS: A.M. PEAK, P.M. PEAK, A.M./P.M. PEAK, NO PARKING ANYTIME=N.P., COMM/IND. ACCESS=E

SYSTEM				TRAFFIC		LINE DIAGRAM	TRAFFIC			PAVEMENT DATA
FED. AID.	FUNCT. CLASS.	HWY. SYS.	HPMS SAMPLE	PRK.G. REST.	COM/IND. ACCESS		CONTROL	COM/IND. ACCESS	PRK.G. REST.	
						D E				
						CUL 0 11 SAC				
						70° 0 08				
										24I
										JC-C
										2UML
						TIFFANY LA.				
						Co 000 3104	SS			

NON FA
URB - LOCAL

SYSTEM				TRAFFIC		LINE DIAGRAM	TRAFFIC			PAVEMENT DATA
FED. AID.	FUNCT. CLASS.	HWY. SYS.	HPMS SAMPLE	PRK.G. REST.	COM/IND ACCESS		CONTROL	COM/IND ACCESS	PRK.G. REST.	

98-85
11-13-98
SS/SR

SHA 51.3 - 8 Revised
4.83

MARYLAND STATE HIGHWAY ADMINISTRATION

ROAD INVENTORY SHEET

90-41

Party Chief BB
Recorder BB
Assistant
Map No./Dir. F11B / E
State Coordinates 843-419

Road No. Co 5062
Road Name ELVIS LA.
County Prince GEORGES
Date 3-491
Sheet No. 1 OF 1

TRAFFIC CODES
TRAFFIC CONTROLS: STOP SIGN=SS, TRAFFIC LIGHT=T.L., FLASHING RED BALL=F.R.

TRAFFIC CODES
PARKING RESTRICTIONS: A.M. PEAK, P.M. PEAK, A.M./P.M. PEAK, NO PARKING ANYTIME=N.P., COMM/IND. ACCESS=E

SYSTEM				TRAFFIC		LINE DIAGRAM	TRAFFIC			PAVEMENT DATA
FED. AID.	FUNCT CLASS.	HWY. SYS.	HPMS SAMPLE	PRKG. REST.	COM/IND. ACCESS		CONTROL	COM/IND. ACCESS	PRKG. REST.	
						ROAD END				
						0 08				
NON FA										10'I
URB-LOCAL										
						PRESLEY ROAD				
						Co 0 00 1180	SS			

SYSTEM				TRAFFIC		LINE DIAGRAM	TRAFFIC			PAVEMENT DATA
FED. AID.	FUNCT. CLASS.	HWY. SYS.	HPMS SAMPLE	PRKG. REST.	COM/IND ACCESS		CONTROL	COM/IND ACCESS	PRKG. REST.	

SHA 51.3 - 8 Revised
4.83

MARYLAND STATE HIGHWAY ADMINISTRATION

ROAD INVENTORY SHEET ~~OR 4717~~

90-46

Party Chief BB
Recorder BB
Assistant
Map No./Dir. FIID / N
State Coordinates 842-410

Road No. Co 5063
Road Name (Aldershot ~~St~~ DR)
County PRINCE GEORGES
Date 3-6-91
Sheet No. 1 OF 1

93-22
91-24

TRAFFIC CODES
TRAFFIC CONTROLS: STOP SIGN=SS, TRAFFIC LIGHT=T.L., FLASHING RED BALL=F.R.

TRAFFIC CODES
PARKING RESTRICTIONS: A.M. PEAK, P.M. PEAK, A.M./P.M. PEAK, NO PARKING ANYTIME=N.P., COMM/IND. ACCESS=E

SYSTEM				TRAFFIC		LINE DIAGRAM	TRAFFIC			PAVEMENT DATA
FED. AID.	FUNCT CLASS.	HWY. SYS.	HPMS SAMPLE	PRK.G. REST.	COM/IND. ACCESS		CONTROL	COM/IND. ACCESS	PRK.G. REST.	
NON FA	LOCAL URBAN									

D E
CUL 021 SAC

5063

Morley Rd. — McHENRY LA
~~OR~~ Co ~~4716~~ 2418 015 ~~OR~~ ~~4715~~
@.22 Co 1957 4715

007

24I
JC-C
2UML

McHENRY — LA.
~~OR~~ Co 000 ~~4715~~ 1957
OP 4715
@.34

5063

SYSTEM				TRAFFIC		LINE DIAGRAM	TRAFFIC			PAVEMENT DATA
FED. AID.	FUNCT. CLASS.	HWY. SYS.	HPMS SAMPLE	PRK.G. REST.	COM/IND ACCESS		CONTROL	COM/IND ACCESS	PRK.G. REST.	

SHA 51.3 - 8 Revised
4.83

MARYLAND STATE HIGHWAY ADMINISTRATION

ROAD INVENTORY SHEET

90-53

Party Chief BB
Recorder BB
Assistant
Map No./Dir. FIIB / S
State Coordinates 829-394

Road No. Co 506A
Road Name SOUTH CLUB DR.
County PRINCE GEORGES
Date 3-5-91
Sheet No. 1 OF 1

TRAFFIC CODES
TRAFFIC CONTROLS: STOP SIGN=SS, TRAFFIC LIGHT=T.L., FLASHING RED BALL=F.R.

TRAFFIC CODES
PARKING RESTRICTIONS: A.M. PEAK, P.M. PEAK, A.M./P.M. PEAK, NO PARKING ANYTIME=N.P., COMM/IND. ACCESS=E

SYSTEM				TRAFFIC		LINE DIAGRAM	TRAFFIC			PAVEMENT DATA
FED. AID.	FUNCT CLASS.	HWY. SYS.	HPMS SAMPLE	PRK.G. REST.	COM/IND. ACCESS		CONTROL	COM/IND. ACCESS	PRK.G. REST.	
						EXIT TO GIANT FOOD				
						GATE				
						X X				
						D E				
						CUL 0 17 SAC				
						0 14		E		
						0 06 300'		E		44'I
										Jc-c
										2UML
NON FA						COLUMBIA PARK Rd				
URB-LOCAL						Co 0 00 3668	TL			

SYSTEM				TRAFFIC		LINE DIAGRAM	TRAFFIC				PAVEMENT DATA
FED. AID.	FUNCT. CLASS	HWY. SYS.	HPMS SAMPLE	PRKG. REST.	COM/IND ACCESS		CONTROL	COM/IND ACCESS	PRKG. REST.		

SHA 51.3 - 8 Revised
4.83

MARYLAND STATE HIGHWAY ADMINISTRATION

ROAD INVENTORY SHEET

90-283

Party Chief BB
Recorder BB
Assistant
Map No./Dir. FIID / S
State Coordinates 824-408

Road No. Co. 5065
Road Name 55th AVE.
County PRINCE GEORGES
Date 3-6-91
Sheet No. 1 OF 1

SYSTEM: FED. AID. | FUNCT CLASS. | HWY. SYS. | HPMS SAMPLE
TRAFFIC: PKG. REST. | COM/IND. ACCESS

LINE DIAGRAM

TRAFFIC: CONTROL | COM/IND ACCESS | PKG. REST.

PAVEMENT DATA

ROAD END
0.04

NON FA
URB-LOCAL

20'F
2UML

CARTERS Rd. La
Co 0.00 322

TRAFFIC CODES
TRAFFIC CONTROLS: STOP SIGN=S.S., TRAFFIC LIGHT=T.L., FLASHING RED BALL=F.R.

TRAFFIC CODES
PARKING RESTRICTIONS: A.M. PEAK, P.M. PEAK, A.M./P.M. PEAK, NO PARKING ANYTIME=N.P., COMM/IND. ACCESS=E

SYSTEM				TRAFFIC		LINE DIAGRAM	TRAFFIC			PAVEMENT DATA
FED. AID.	FUNCT. CLASS.	HWY. SYS.	HPMS SAMPLE	PKG. REST.	COM/IND ACCESS		CONTROL	COM/IND ACCESS	PKG. REST.	

CO 5066

PRINCE GEORGE'S COUNTY

UNASSIGNED

NOW MU 3006

TRIPLE CROWN DR

BOWIE

02-53MU/02-32CO

SHA 51.3 - 8 Revised
4.83

MARYLAND STATE HIGHWAY ADMINISTRATION

ROAD INVENTORY SHEET OP 4720

Party Chief BB
Recorder BB
Assistant
Map No./Dir. F12 / E
State Coordinates 862-422

Road No. Co 5067
Road Name CHESTNUT LA.
County PRINCE GEORGES
Date 3-12-91
Sheet No. 1 OF 1

90-69
97-088
3-12-98
BB/AP

TRAFFIC CODES
TRAFFIC CONTROLS: STOP SIGN=SS, TRAFFIC LIGHT=T.L., FLASHING RED BALL=F.R.

TRAFFIC CODES
PARKING RESTRICTIONS: A.M. PEAK, P.M. PEAK, A.M./P.M. PEAK, NO PARKING ANYTIME=N.P., COMM/IND. ACCESS=E

SYSTEM				TRAFFIC		LINE DIAGRAM	TRAFFIC			PAVEMENT DATA
FED. AID.	FUNCT CLASS.	HWY. SYS.	HPMS SAMPLE	PRKG. REST.	COM/IND. ACCESS		CONTROL	COM/IND. ACCESS	PRKG. REST.	
						Private Dr.				
						ROAD 0 34 END				
						FP 4720				B'F 10'I
						0 28				
						PT 0 27				
						80°				
						PC 0 23				
NON-FA URB-LOCAL						0 18				
						5067				
						CO				10'D 12'I
						Chestnut AVE.				
						Co 0 00 51	SS			

SYSTEM				TRAFFIC		LINE DIAGRAM	TRAFFIC				PAVEMENT DATA
FED. AID.	FUNCT. CLASS.	HWY. SYS.	HPMS SAMPLE	PRKG. REST.	COM/IND ACCESS		CONTROL	COM/IND ACCESS	PRKG. REST.		

SHA-51.3 - 8 Revised 4.83

NOTE: WAS PART OF CO. 51; INV SPLIT DUE TO NAME Chg.

MARYLAND STATE HIGHWAY ADMINISTRATION

ROAD INVENTORY SHEET

90-6x#2

95-13 BA/AH 3/12/96

Party Chief BB
Recorder BB
Assistant
Map No./Dir. F12 / S
State Coordinates 865-445

Road No. Co 5068
Road Name HIGH BRIDGE Rd
County P.G.
Date 3-12-91
Sheet No. 1 OF 4

SYSTEM: FED. AID. | FUNCT CLASS. | HWY. SYS. | HPMS SAMPLE
TRAFFIC: PRKG. REST. | COM/IND. ACCESS

LINE DIAGRAM

FAU 5258 URBAN COLLECTOR

PT 0 20
30°
PC 0 17 *
0 10
#P114C 0 08 3-48" CMP
L/L 12 SHD
Accel 69 SHD
FLETCHERTOWN Rd
0 05 Co 61
Rt. Roadway MD
0 03
0 02 35°
OLD FLETCHERTOWN RD. CO 4826
0 01
OR
PC 529614B
0 00
Chestnut Ave Co 51

TRAFFIC: CONTROL | COM/IND. ACCESS | PRKG. REST.

PAVEMENT DATA
20'I 2ML
X
24'I
8'I SHD LT
2ML
X
24'I
2-8'I SHD
/2ML

TRAFFIC CODES
TRAFFIC CONTROLS: STOP SIGN=SS, TRAFFIC LIGHT=T.L., FLASHING RED BALL=F.R.

TRAFFIC CODES
PARKING RESTRICTIONS: A.M. PEAK, P.M. PEAK, A.M./P.M. PEAK, NO PARKING ANYTIME=N.P., COMM/IND. ACCESS=E

SYSTEM				TRAFFIC		LINE DIAGRAM	TRAFFIC			PAVEMENT DATA
FED. AID.	FUNCT. CLASS.	HWY. SYS.	HPMS SAMPLE	PRKG. REST.	COM/IND ACCESS		CONTROL	COM/IND ACCESS	PRKG. REST.	
7					E	0 74 HIGH BRIDGE PARK		E		
					E	0 67				
						CHESTNUT DR				
						0 66 60' (6002)				
						HIGH BRIDGE E.S. 0 52				
					E	0 50				
						ZIRCON Dr.				
						0 44 Co 4968				
						0 37 PT				
						35				
						0 33 PC				
						Mockingbird LA				
						0 30 OP 240				
						0 27 OP 239				
										20'I
										2ML

FAU 5258
URBAN COLLECTORS

SHA 51.3 - 8 Revised
4.83

MARYLAND STATE HIGHWAY ADMINISTRATION

ROAD INVENTORY SHEET

90 & #2

Party Chief BB
Recorder BB
Assistant
Map No./Dir. F12 / 5
State Coordinates 865-415

Road No. Co 5068
Road Name HIGH BRIDGE Rd.
County P.G.
Date 3-12-91
Sheet No. 3 OF 4

TRAFFIC CODES
TRAFFIC CONTROLS: STOP SIGN=SS, TRAFFIC LIGHT=T.L., FLASHING RED BALL=F.R.

TRAFFIC CODES
PARKING RESTRICTIONS: A.M. PEAK, P.M. PEAK, A.M./P.M. PEAK, NO PARKING ANYTIME=N.P., COMM/IND. ACCESS=E

SYSTEM				TRAFFIC		LINE DIAGRAM	TRAFFIC			PAVEMENT DATA
FED. AID.	FUNCT CLASS.	HWY. SYS.	HPMS SAMPLE	PRKG. REST.	COM/IND. ACCESS		CONTROL	COM/IND. ACCESS	PRKG. REST.	
										20'I
										2ML
						Woodedge Dr.				
						Co 4173 101			X	
										24'I
										8'ISHDLT
										Ic-LT Ic-RT
						089			X	2ML
										24'I
										8'ISHDRT
										Ic-RT 2ML
						085			X	
										24'I
										2ML
						OLD CHAPEL Rd				
						Co 083 52			X	
										22'I
										8'ISHDRT
										2ML
						079			X	
										20'I
										2ML

FAU 5258
URBAN Collector

SYSTEM: FED. AID. | FUNCT. CLASS. | HWY. SYS. | HPMS SAMPLE
TRAFFIC: PRKG. REST. | COM/IND ACCESS

LINE DIAGRAM

TRAFFIC: CONTROL | COM/IND ACCESS | PRKG. REST.

PAVEMENT DATA

FAU 5258
URBAN Collector

ANNAPOLIS Rd.
MD 1 55 450 FR-SS

(prop.) 1 39

Gullivers Trail GLOBAL ST
MH (prop.) 768 1 30 ~~Co~~ MH ~~4705~~ 0785

1 13 300'

PT 1 06
45°
PC 1 03

48 I
JC-C
4ML

20 I
2ML

SHA 51.3 - 8 Revised
4.83

MARYLAND STATE HIGHWAY ADMINISTRATION

ROAD INVENTORY SHEET

90-79

Party Chief BB
Recorder BB
Assistant
Map No./Dir. F12 / E
State Coordinates 856 - 424

Road No. Co 5069
Road Name BURROUGHS DR.
County PRINCE GEORGES
Date 3-6-91
Sheet No. 1 OF 1

TRAFFIC CODES
TRAFFIC CONTROLS: STOP SIGN=SS, TRAFFIC LIGHT=T.L., FLASHING RED BALL=F.R.

TRAFFIC CODES
PARKING RESTRICTIONS: A.M. PEAK, P.M. PEAK, A.M./P.M. PEAK, NO PARKING ANYTIME=N.P., COMM/IND. ACCESS=E

SYSTEM				TRAFFIC		LINE DIAGRAM	TRAFFIC			PAVEMENT DATA
FED. AID.	FUNCT CLASS.	HWY. SYS.	HPMS SAMPLE	PRK.G. REST.	COM/IND. ACCESS		CONTROL	COM/IND. ACCESS	PRK.G. REST.	
						DRISCOLL DR.				
						Co 010 5071	SS			
						TOLKIN CT				
						005 Co 5070				24'I
										Jc-c
						SPRINGFIELD Rd				2UML
						Co 000 3641	SS			

Non FA
URBAN - LOCAL

SYSTEM				TRAFFIC		LINE DIAGRAM	TRAFFIC			PAVEMENT DATA
FED. AID.	FUNCT. CLASS.	HWY. SYS.	HPMS SAMPLE	PRK.G. REST.	COM/IND ACCESS		CONTROL	COM/IND ACCESS	PRK.G. REST.	

SHA 51.3 - 8 Revised
4.83

MARYLAND STATE HIGHWAY ADMINISTRATION

ROAD INVENTORY SHEET

90-77

Party Chief BB
Recorder BB
Assistant
Map No./Dir. F12 / S
State Coordinates 855-424

Road No. Co. 5070
Road Name JOCKIN CT.
County PRINCE GEORGES
Date 3-6-91
Sheet No. 1 OF 1

TRAFFIC CODES
TRAFFIC CONTROLS: STOP SIGN=SS, TRAFFIC LIGHT=T.L., FLASHING RED BALL=F.R.

TRAFFIC CODES
PARKING RESTRICTIONS: A.M. PEAK, P.M. PEAK, A.M./P.M. PEAK, NO PARKING ANYTIME=N.P., COMM/IND. ACCESS=E

SYSTEM				TRAFFIC		LINE DIAGRAM	TRAFFIC			PAVEMENT DATA
FED. AID.	FUNCT CLASS.	HWY. SYS.	HPMS SAMPLE	PRK.G. REST.	COM/IND. ACCESS		CONTROL	COM/IND. ACCESS	PRK.G. REST.	
						D E				
						CUL 0 09 SAC				
										24'I
										JC-C
										2UML
						BURROUGHS Dr.				
NON FA	URB LOCAL					Co 000 5069	SS			

SYSTEM				TRAFFIC		LINE DIAGRAM	TRAFFIC			PAVEMENT DATA
FED. AID.	FUNCT. CLASS.	HWY. SYS.	HPMS SAMPLE	PRK'G. REST.	COM/IND ACCESS		CONTROL	COM/IND ACCESS	PRK'G. REST.	

SHA 51.3 - 8 Revised
4.83

MARYLAND STATE HIGHWAY ADMINISTRATION

ROAD INVENTORY SHEET ~~OF 2~~

90-75,284

Party Chief BB
Recorder BB
Assistant
Map No./Dir. F12 / N
State Coordinates 856-423

Road No. Co. 5071
Road Name DRISCOLL DR
County PRINCE GEORGES
Date 3-6-91
Sheet No. 1 OF 2

93-40

TRAFFIC CODES
TRAFFIC CONTROLS: STOP SIGN=SS, TRAFFIC LIGHT=T.L., FLASHING RED BALL=F.R.

TRAFFIC CODES
PARKING RESTRICTIONS: A.M. PEAK, P.M. PEAK, A.M./P.M. PEAK, NO PARKING ANYTIME=N.P., COMM/IND. ACCESS=E

SYSTEM				TRAFFIC		LINE DIAGRAM	TRAFFIC			PAVEMENT DATA
FED. AID.	FUNCT CLASS.	HWY. SYS.	HPMS SAMPLE	PRKG. REST.	COM/IND. ACCESS		CONTROL	COM/IND. ACCESS	PRKG. REST.	
NON FA	URB - LOCAL					Webb CT				
						0 27 Co 5075				
						FROST DR. @ 0.0				
						Co 5073 0 21				
						PT 0 18				
						50°				
						Burroughs Dr				
						Co 5069 0 12				34'I
						PC 0 11				Jc-c
										2UML
						Proctor CT.				
						0 06 Co 5072				X
										2-24'I
										Jc-c
										6'GrsPkwy
										2UML
						Lanham Severn Rd				
						0 00	SS			V
						MD 564 @ 4.25				

SYSTEM: FED. AID. | FUNCT. CLASS. | HWY. SYS. | HPMS SAMPLE

TRAFFIC: PRKG. REST. | COM/IND ACCESS

LINE DIAGRAM

TRAFFIC: CONTROL | COM/IND ACCESS | PRKG. REST.

PAVEMENT DATA

Ducketts town Rd

Co 0 79 47 @1.41 (L) SS

CROFT ~~CIR~~ CT Hill Terr

~~OR~~ Co 5421 0 75 Co ~~4725~~ 5422 @1.05

CROFT ~~CIR~~ CT Hill Terr

~~OR~~ Co 5421 0 74 Co ~~4725~~ 5422

Millay Ct

0 69 ~~OR~~ Co ~~4724~~ 5391 @1.06

Millay Ct

0 68 ~~OR~~ Co ~~4724~~ 5391 @1.00

30°

Backus Dr

~~OR~~ Co 0 63 5392 ~~4725~~ @.19

~~PI~~ PRC 0 57 PRC

30°

Backus Dr

~~OR 4725~~ Co 5392 @.00 0 ~~55~~ 52

PC 0 51

Blanding Ct

0 47 ~~OR~~ Co ~~4722~~ 5393

0 42 2-48" RCP

Frost Ct @.16 Dr.

Co 0 33 5073

NON FA
URB - LOCAL

34'I
JC-C
2UML

SHA 51.3 - 8 Revised
4.83

MARYLAND STATE HIGHWAY ADMINISTRATION

ROAD INVENTORY SHEET

90-76

Party Chief BB
Recorder BB
Assistant
Map No./Dir. F-12 / E
State Coordinates 856-424

Road No. Co 5072
Road Name Proctor Ct.
County PRINCE GEORGES
Date 3-6-91
Sheet No. 1 OF 1

TRAFFIC CODES

TRAFFIC CONTROLS: STOP SIGN=SS, TRAFFIC LIGHT=T.L., FLASHING RED BALL=F.R.

TRAFFIC CODES

PARKING RESTRICTIONS: A.M. PEAK, P.M. PEAK, A.M./P.M. PEAK, NO PARKING ANYTIME=N.P., COMM/IND. ACCESS=E

SYSTEM				TRAFFIC		LINE DIAGRAM	TRAFFIC			PAVEMENT DATA
FED. AID.	FUNCT. CLASS.	HWY. SYS.	HPMS SAMPLE	PRK.G. REST.	COM/IND. ACCESS		CONTROL	COM/IND. ACCESS	PRK.G. REST.	
NON FA	URB-Local					D E CUL 0 11 SAC				24'I Jc-c 2UNL
						DRISCOLL DR. Co 0 00 5071 90-75,284	SS			

SYSTEM				TRAFFIC		LINE DIAGRAM	TRAFFIC				PAVEMENT DATA
FED. AID.	FUNCT. CLASS.	HWY. SYS.	HPMS SAMPLE	PRKG. REST.	COM/IND ACCESS		CONTROL	COM/IND ACCESS	PRKG. REST.		

SHA 51.3 - 8 Revised
4.83

MARYLAND STATE HIGHWAY ADMINISTRATION

ROAD INVENTORY SHEET

90-80

Party Chief BB
Recorder BB
Assistant
Map No./Dir. F12 / NE
State Coordinates 806-425

Road No. Co. 5073
Road Name FROST DR.
County PRINCE GEORGES
Date 3-6-91
Sheet No. 1 OF 2

TRAFFIC CODES
TRAFFIC CONTROLS: STOP SIGN=SS, TRAFFIC LIGHT=T.L., FLASHING RED BALL=F.R.

TRAFFIC CODES
PARKING RESTRICTIONS: A.M. PEAK, P.M. PEAK, A.M./P.M. PEAK, NO PARKING ANYTIME=N.P., COMM/IND. ACCESS=E

SYSTEM				TRAFFIC		LINE DIAGRAM	TRAFFIC			PAVEMENT DATA
FED. AID.	FUNCT CLASS.	HWY. SYS.	HPMS SAMPLE	PRKG. REST.	COM/IND. ACCESS		CONTROL	COM/IND. ACCESS	PRKG. REST.	
						PT 0 27				
						80°				
						PC 0 21				
						DRISCOLL @ DR				
						Co 0 16 5071 284	SS			
						PT 0 14				
						DRUMMOND CT				
NON FA						Co 5074 0 12				
URB - LOC						180°				
						PC 0 02				
										24 I
										JC-C
										2UML
						DRISCOLL @ DR				
						Co 0 00 5071 284	SS			✓

SYSTEM				TRAFFIC		LINE DIAGRAM	TRAFFIC			PAVEMENT DATA
FED. AID.	FUNCT. CLASS.	HWY. SYS.	HPMS SAMPLE	PRK'G. REST.	COM/IND ACCESS		CONTROL	COM/IND ACCESS	PRK'G. REST.	
						D E				
						CUL 0 36 SAC				
						0 33 PT				
						BLAKE CT				
						0 32 CO 5076				
						30°				24'I
										Jc-c
										2UML
						0 31 PC				

SHA 51.3 - 8 Revised
4.83

MARYLAND STATE HIGHWAY ADMINISTRATION

ROAD INVENTORY SHEET

90-72

Party Chief BB
Recorder BB
Assistant
Map No./Dir. F12 / NW
State Coordinates 856-425

Road No. CO 5074
Road Name DRUMMOND CT
County PRINCE GEORGES
Date 3-6-91
Sheet No. 1 OF 1

TRAFFIC CODES
TRAFFIC CONTROLS: STOP SIGN=SS, TRAFFIC LIGHT=T.L., FLASHING RED BALL=F.R.

TRAFFIC CODES
PARKING RESTRICTIONS: A.M. PEAK, P.M. PEAK, A.M./P.M. PEAK, NO PARKING ANYTIME=N.P., COMM/IND. ACCESS=E

SYSTEM				TRAFFIC		LINE DIAGRAM	TRAFFIC			PAVEMENT DATA
FED. AID.	FUNCT CLASS.	HWY. SYS.	HPMS SAMPLE	PRK.G. REST.	COM/IND. ACCESS		CONTROL	COM/IND. ACCESS	PRK.G. REST.	
						D E				
						CUL 003 SAC			↑	
										24'I
										JC-C
										2 UML
									✓	

NON FA
URB-LOCAL

SYSTEM				TRAFFIC		LINE DIAGRAM	TRAFFIC				PAVEMENT DATA
FED. AID.	FUNCT. CLASS.	HWY. SYS.	HPMS SAMPLE	PRK'G. REST.	COM/IND ACCESS		CONTROL	COM/IND ACCESS	PRK'G. REST.		

SHA 51.3 - 8 Revised
4.83

MARYLAND STATE HIGHWAY ADMINISTRATION

ROAD INVENTORY SHEET

90-73

Party Chief BB
Recorder BB
Assistant
Map No./Dir. F12 / E
State Coordinates 856-425

Road No. Co 5075
Road Name WEBB CT
County PRINCE GEORGES
Date 3-6-91
Sheet No. 1 OF 1

TRAFFIC CODES
TRAFFIC CONTROLS: STOP SIGN=SS, TRAFFIC LIGHT=T.L., FLASHING RED BALL=F.R.

TRAFFIC CODES
PARKING RESTRICTIONS: A.M. PEAK, P.M. PEAK, A.M./P.M. PEAK, NO PARKING ANYTIME=N.P., COMM/IND. ACCESS=E

SYSTEM				TRAFFIC		LINE DIAGRAM	TRAFFIC			PAVEMENT DATA
FED. AID.	FUNCT CLASS.	HWY. SYS.	HPMS SAMPLE	PRK.G. REST.	COM/IND. ACCESS		CONTROL	COM/IND. ACCESS	PRK.G. REST.	
NON FA						D E				
URB-LOCAL						CUL 005 SAC				24'I
										JL-C
						DRISCOLL DR				2 Unit
						CO 000 5071	55			

SYSTEM				TRAFFIC		LINE DIAGRAM	TRAFFIC			PAVEMENT DATA
FED. AID.	FUNCT. CLASS.	HWY. SYS.	HPMS SAMPLE	PRKG. REST.	COM/IND ACCESS		CONTROL	COM/IND ACCESS	PRKG. REST.	

SHA 51.3 - 8 Revised
4.83

MARYLAND STATE HIGHWAY ADMINISTRATION

ROAD INVENTORY SHEET

90-74

Party Chief BB.
Recorder BB
Assistant
Map No./Dir. F12 / SW
State Coordinates 857-425

Road No. Co 5076
Road Name BLAKE CT
County PRINCE GEORGES
Date 3-6-91
Sheet No. 1 OF 1

TRAFFIC CODES
TRAFFIC CONTROLS: STOP SIGN=SS, TRAFFIC LIGHT=T.L., FLASHING RED BALL=F.R.

TRAFFIC CODES
PARKING RESTRICTIONS: A.M. PEAK, P.M. PEAK, A.M./P.M. PEAK, NO PARKING ANYTIME=N.P., COMM/IND. ACCESS=E

SYSTEM				TRAFFIC		LINE DIAGRAM	TRAFFIC			PAVEMENT DATA
FED. AID.	FUNCT CLASS.	HWY. SYS.	HPMS SAMPLE	PRK.G. REST.	COM/IND. ACCESS		CONTROL	COM/IND. ACCESS	PRK.G. REST.	
NON FA	URB-LOCAL					D E CUL 0 06 SAC FROST CO DR 5073				24I JC-C 2UML

SYSTEM				TRAFFIC		LINE DIAGRAM	TRAFFIC				PAVEMENT DATA
FED. AID.	FUNCT. CLASS.	HWY. SYS.	HPMS SAMPLE	PRKG. REST.	COM/IND ACCESS		CONTROL	COM/IND ACCESS	PRKG. REST.		

SHA 51.3 - 8 Revised
4.83

MARYLAND STATE HIGHWAY ADMINISTRATION

ROAD INVENTORY SHEET

90-92

Party Chief BB
Recorder BB
Assistant
Map No./Dir. F12 / W
State Coordinates 861-420

Road No. Co. 5077
Road Name PINE CT.
County PRINCE GEORGES
Date 3-12-91
Sheet No. 1 OF 1

TRAFFIC CODES
TRAFFIC CONTROLS: STOP SIGN=SSy
TRAFFIC LIGHT=T.L.,
FLASHING RED BALL=F.R.

TRAFFIC CODES
PARKING RESTRICTIONS: A.M. PEAK, P.M. PEAK, A.M./P.M. PEAK, NO PARKING ANYTIME=N.P., COMM/IND. ACCESS=E

SYSTEM				TRAFFIC		LINE DIAGRAM	TRAFFIC			PAVEMENT DATA
FED. AID.	FUNCT CLASS.	HWY. SYS.	HPMS SAMPLE	PRKG. REST.	COM/IND. ACCESS		CONTROL	COM/IND. ACCESS	PRKG. REST.	
						DE				
						CUL 005 SAC				

SYSTEM				TRAFFIC		LINE DIAGRAM	TRAFFIC				PAVEMENT DATA
FED. AID.	FUNCT. CLASS.	HWY. SYS.	HPMS SAMPLE	PRKG. REST.	COM/IND ACCESS		CONTROL	COM/IND ACCESS	PRKG. REST.		

SHA 51.3 - 8 Revised
4.83

Was PART of OP 242

MARYLAND STATE HIGHWAY ADMINISTRATION

ROAD INVENTORY SHEET

OP 4726

90-94

Party Chief BB
Recorder BB
Assistant
Map No./Dir. F12 / N
State Coordinates 862-420

Road No. Co 5078
Road Name CEDAR Rd.
County PRINCE GEORGES
Date 3-12-91
Sheet No. 1 OF 1

TRAFFIC CODES
TRAFFIC CONTROLS: STOP SIGN=SS, TRAFFIC LIGHT=T.L., FLASHING RED BALL=F.R.

TRAFFIC CODES
PARKING RESTRICTIONS: A.M. PEAK, P.M. PEAK, A.M./P.M. PEAK, NO PARKING ANYTIME=N.P., COMM/IND. ACCESS=E

SYSTEM				TRAFFIC		LINE DIAGRAM	TRAFFIC			PAVEMENT DATA
FED. AID.	FUNCT CLASS.	HWY. SYS.	HPMS SAMPLE	PRKG. REST.	COM/IND. ACCESS		CONTROL	COM/IND. ACCESS	PRKG. REST.	
						ROAD END				
						0 21				8'D
						0 17				
						OP 4726				12'D
						Mockingbird LA				
						OP 0 10 240				
						NO NAME				
						0 09 OP 241				14'E
						PINE Rd.				
						OP 242 0 00				

SYSTEM				TRAFFIC		LINE DIAGRAM	TRAFFIC				PAVEMENT DATA
FED. AID.	FUNCT. CLASS.	HWY. SYS.	HPMS SAMPLE	PRKG. REST.	COM/IND ACCESS		CONTROL	COM/IND ACCESS	PRKG. REST.		

SHA 51.3 - 8 Revised
4.83

MARYLAND STATE HIGHWAY ADMINISTRATION

ROAD INVENTORY SHEET

90-285

Party Chief BB
Recorder BB
Assistant
Map No./Dir. F12 / N
State Coordinates 859-421

Road No. Co 5079
Road Name EXECUTIVE PL.
County PRINCE GEORGES
Date 3-6-91
Sheet No. 1 OF 1

TRAFFIC CODES
TRAFFIC CONTROLS: STOP SIGN=SS, TRAFFIC LIGHT=T.L., FLASHING RED BALL=F.R.

TRAFFIC CODES
PARKING RESTRICTIONS: A.M. PEAK, P.M. PEAK, A.M./P.M. PEAK, NO PARKING ANYTIME=N.P., COMM/IND. ACCESS=E

SYSTEM				TRAFFIC		LINE DIAGRAM	TRAFFIC			PAVEMENT DATA
FED. AID.	FUNCT CLASS.	HWY. SYS.	HPMS SAMPLE	PRKG. REST.	COM/IND. ACCESS		CONTROL	COM/IND. ACCESS	PRKG. REST.	
						EXECUTIVE				
						D E				
					E	CUL 009 SAC		E		
						004		E		44'I
						GREENBELT Rd				JC-C
							SS			ZUML
						MD 193 @M.P. 9.96				

NON FA
URB-LOCAL

SYSTEM				TRAFFIC		LINE DIAGRAM	TRAFFIC				PAVEMENT DATA
FED. AID.	FUNCT. CLASS.	HWY. SYS.	HPMS SAMPLE	PRK.G. REST.	COM/IND ACCESS		CONTROL	COM/IND ACCESS	PRK.G. REST.		

(WAS PART OF CO 4204)

90-88 97-104 3-11-98 BB/AP

SHA 51.3 - 8 Revised 4.83

MARYLAND STATE HIGHWAY ADMINISTRATION

ROAD INVENTORY SHEET

Party Chief MZ
Recorder JE
Assistant
Map No./Dir. F12 / W
State Coordinates 851-411

Road No. CO 5080
Road Name (MARYLAND ST)
County P. G.
Date 6-9-78 (REWRITTEN 4-15-91 JE)
Sheet No. 1 OF 1

97-102

TRAFFIC CODES

TRAFFIC CONTROLS: STOP SIGN=SS, TRAFFIC LIGHT=T.L., FLASHING RED BALL=F.R.

PARKING RESTRICTIONS: A.M. PEAK, P.M. PEAK, A.M./P.M. PEAK, NO PARKING ANYTIME=N.P., COMM/IND. ACCESS=E

SYSTEM				TRAFFIC		LINE DIAGRAM	TRAFFIC			PAVEMENT DATA
FED. AID.	FUNCT. CLASS.	HWY. SYS.	HPMS SAMPLE	PRK.G. REST.	COM/IND. ACCESS		CONTROL	COM/IND. ACCESS	PRK.G. REST.	
NON FA	URB-LOCAL					ROAD END				A
						0 10				
										20' G
										B/E
						(CENTER ~~ST~~ AVE) 0.00				
						CO 4204				

Y

SYSTEM				TRAFFIC		LINE DIAGRAM	TRAFFIC			PAVEMENT DATA
FED. AID.	FUNCT. CLASS.	HWY. SYS.	HPMS SAMPLE	PRK'G. REST.	COM/IND ACCESS		CONTROL	COM/IND ACCESS	PRK'G. REST.	

SHA 51.3 - 8 Revised
4.83

MARYLAND STATE HIGHWAY ADMINISTRATION

ROAD INVENTORY SHEET

90-97

Party Chief BB
Recorder BB
Assistant
Map No./Dir. F12 / S
State Coordinates 868-414

Road No. Co. 5081
Road Name WOODCLIFF RD
County PRINCE GEORGES
Date 3-12-91
Sheet No. 1 OF 1

TRAFFIC CODES
TRAFFIC CONTROLS: STOP SIGN=SS, TRAFFIC LIGHT=T.L., FLASHING RED BALL=F.R.

TRAFFIC CODES
PARKING RESTRICTIONS: A.M. PEAK, P.M. PEAK, A.M./P.M. PEAK, NO PARKING ANYTIME=N.P., COMM/IND. ACCESS=E

SYSTEM				TRAFFIC		LINE DIAGRAM	TRAFFIC			PAVEMENT DATA
FED. AID.	FUNCT CLASS	HWY. SYS.	HPMS SAMPLE	PRKG. REST.	COM/IND. ACCESS		CONTROL	COM/IND. ACCESS	PRKG. REST.	
						ROAD XXXX END				
						0 12				
						0 06				
NON FA					E					30 I
U/B - LOCAL										JC-LT
						ANNAPOLIS Rd.				2UML
						MD 0 00 450 @ M.P. 11.29	SS			

SYSTEM				TRAFFIC		LINE DIAGRAM	TRAFFIC			PAVEMENT DATA
FED. AID.	FUNCT. CLASS.	HWY. SYS.	HPMS SAMPLE	PRKG. REST.	COM/IND ACCESS		CONTROL	COM/IND ACCESS	PRKG. REST.	

SHA 51.3-8
11-15-72

STATE HIGHWAY ADMINISTRATION OF MARYLAND

90-98
3-12-91
BB|BB
A/T

78

ROAD INVENTORY SHEET CO 5082

Party Chief MZ
Recorder JE
Helper

Map No. ~~32~~ F12

Road No. ~~OP122A~~
Road Name TONGUE AV.
Sheet No. 1 OF 1
Date 6-6-78
County PRINCE GEORGES
State Coordinates 871·410

97-107

W

ROAD END

0 14 H

0 11 H

0 09 H

15' G

0 06 H

~~A&E~~

20 C-W

MD 197

Callington 0 00 FD) SS

@ 1.95 ~~CHIEF~~

SHA 51.3-8
11-15-72

ROAD INVENTORY SHEET

Road No. _____
Road Name _____
Sheet No. _____
Date _____
County _____
State Coordinates _____

SHA 51.3 - 8 Revised
4.83

MARYLAND STATE HIGHWAY ADMINISTRATION

ROAD INVENTORY SHEET

90-99

Party Chief BB
Recorder BB
Assistant
Map No./Dir. F12 / E
State Coordinates 865-407

Road No. Co. 5083
Road Name CAT RD.
County PRINCE GEORGES
Date 3-8-91
Sheet No. 1 OF 1

00-62

TRAFFIC CODES
TRAFFIC CONTROLS: STOP SIGN=SS, TRAFFIC LIGHT=T.L., FLASHING RED BALL=F.R.

TRAFFIC CODES
PARKING RESTRICTIONS: A.M. PEAK, P.M. PEAK, A.M./P.M. PEAK, NO PARKING ANYTIME=N.P., COMM/IND. ACCESS=E

SYSTEM				TRAFFIC		LINE DIAGRAM	TRAFFIC			PAVEMENT DATA
FED. AID.	FUNCT CLASS.	HWY. SYS.	HPMS SAMPLE	PRKG. REST.	COM/IND. ACCESS		CONTROL	COM/IND. ACCESS	PRKG. REST.	
						Private Rd.				
						ROAD END 0 06				
										15'H
										~~12'D~~
NON FA URB LOCAL						CHURCH Rd Co 0 00 59				

SYSTEM				TRAFFIC		LINE DIAGRAM	TRAFFIC			PAVEMENT DATA
FED. AID.	FUNCT. CLASS.	HWY. SYS.	HPMS SAMPLE	PRK'G. REST.	COM/IND ACCESS		CONTROL	COM/IND ACCESS	PRK'G. REST.	

SHA 51.3 - 8 Revised
4.83

MARYLAND STATE HIGHWAY ADMINISTRATION

ROAD INVENTORY SHEET

90-101

Party Chief BB
Recorder BB
Assistant
Map No./Dir. F12 / N
State Coordinates 884-389

Road No. Co 5084
Road Name STURBRIDGE LA
County PG
Date 3-8-91
Sheet No. 1 OF 1

SYSTEM: FED. AID. | FUNCT CLASS. | HWY. SYS. | HPMS SAMPLE
TRAFFIC: PRKG. REST. | COM/IND. ACCESS

LINE DIAGRAM

TRAFFIC: CONTROL | COM/IND. ACCESS | PRKG. REST.

PAVEMENT DATA

XX XX
ROAD 0 08 END

PT Private Drive 0 05
30°
PC 0 02

NON FA
RURAL - LOCAL

18'I
2UML

CENTRAL AVE.
MD 0 00 214 SS
@ M.P. 11.82

TRAFFIC CODES

TRAFFIC CONTROLS: STOP SIGN=SS, TRAFFIC LIGHT=T.L., FLASHING RED BALL=F.R.

TRAFFIC CODES

PARKING RESTRICTIONS: A.M. PEAK, P.M. PEAK, A.M./P.M. PEAK, NO PARKING ANYTIME=N.P., COMM/IND. ACCESS=E

SYSTEM				TRAFFIC		LINE DIAGRAM	TRAFFIC				PAVEMENT DATA
FED. AID.	FUNCT. CLASS.	HWY. SYS.	HPMS SAMPLE	PRK.G. REST.	COM/IND ACCESS		CONTROL	COM/IND ACCESS	PRK.G. REST.		

SHA 51.3 - 8 Revised
4.83

MARYLAND STATE HIGHWAY ADMINISTRATION

ROAD INVENTORY SHEET

Party Chief _____
Recorder _____
Assistant _____
Map No./Dir. 1
State Coordinates _____

Road No. Co 5085
Road Name Delcastle Dr
County P.G.
Date _____
Sheet No. _____ OF _____

SYSTEM				TRAFFIC		LINE DIAGRAM	TRAFFIC			PAVEMENT DATA
FUNCT CLASS	HWY. SYS	HPMS SAMPLE		PREG. REST.	COM/IND ACCESS		CONTROL	COM/IND ACCESS	PREG. REST.	

UNASSIGNED

NOW

PART OF

MU 0617
(Bowie)
97-9mm

TRAFFIC CODES

TRAFFIC CONTROLS: STOP SIGN-SS, TRAFFIC LIGHT=T.L., FLASHING RED BALI=F.R.

TRAFFIC CODES

PARKING RESTRICTIONS: A.M. PEAK, P.M. PEAK, A.M./P.M. PEAK, NO PARKING ANYTIME=N.P., COMM/IND. ACCESS=E

COUNTY _____ ROAD NO. _____ PAGE ___ OF _____

SYSTEM				TRAFFIC		LINE DIAGRAM	TRAFFIC				PAVEMENT DATA
FUNCT CLASS	HWY SYS	HPMS SAMPLE		PREG. REST	COM/IND ACCESS		CRITICAL	COM/IND ACCESS	PREG. REST.		

SHA 51.3 - 8 Revised 4.83

MARYLAND STATE HIGHWAY ADMINISTRATION

90-109 3-891 urban BB/BB

ROAD INVENTORY SHEET CO 5086

Party Chief BB
Recorder Rm
Assistant
Map No./Dir. F-12 / W
State Coordinates 959-395

Road No. ~~OT 4506~~
Road Name (Waesche Dr.)
County Prince Georges
Date 3-26-85
Sheet No. 1 OF 2

95-80
94-Et.

TRAFFIC CODES
TRAFFIC CONTROLS: STOP SIGN=S.S., TRAFFIC LIGHT=T.L., FLASHING RED BALL=F.R.

TRAFFIC CODES
PARKING RESTRICTIONS: A.M. PEAK, P.M. PEAK, A.M./P.M. PEAK, NO PARKING ANYTIME=N.P., COMM/IND. ACCESS=E

SYSTEM				TRAFFIC		LINE DIAGRAM	TRAFFIC			PAVEMENT DATA
FED. AID.	FUNCT. CLASS.	HWY. SYS.	HPMS SAMPLE	PRK.G. REST.	COM/IND. ACCESS		CONTROL	COM/IND. ACCESS	PRK.G. REST.	
						PT 0.43				32'I
						0.40				JC-C
						Waesche Ct				2UML
						CO CO 90-108 5090 0.34				
						100°				
						PC 0.24				
						Waesche Co PL				
						0.23 5089 90-106				
						5086				
						0.19 PT				
						30°				
						~~Road~~ ~~End~~				
						0.17 PC				
						Waterleaf Way				
						0.14 CO 90-105 5087				
						CO				
										36'I
										J-CC
						Enterprise Rd 0.00 193				2UML
						@ M.P. 15.95				

SYSTEM: FED. AID. | FUNCT. CLASS. | HWY. SYS. | HPMS SAMPLE
TRAFFIC: PRK.G. REST. | COM/IND ACCESS

LINE DIAGRAM

TRAFFIC: CONTROL | COM/IND ACCESS | PRK.G. REST.

PAVEMENT DATA

Enterprise Rd

IND 0 86 193 S

@ M.P. 15.4

36' I
JC-C
2 UML

CREPE CT

0 80 OP 4730.1 X

PT 0 79

40°

PC 0 75

Waterleaf Way

0 72 OP 4731

(APRICOT CT)

0 67 ~~OR 4841~~
CO 5571

PT 0 60

80°

PC 0 51

32' I
JC-C
2 UML

SHA 51.3 - 8 Revised
4.83

MARYLAND STATE HIGHWAY ADMINISTRATION

ROAD INVENTORY SHEET

OP 4731

90-105

95-80

Party Chief BB
Recorder BB
Assistant
Map No./Dir. F12 / N
State Coordinates 956-395

Road No. Co. 5087
Road Name Waterleaf Way
County PRINCE GEORGES
Date 3-8-91
Sheet No. 1 OF 1

SYSTEM				TRAFFIC		LINE DIAGRAM	TRAFFIC			PAVEMENT DATA
FED. AID.	FUNCT CLASS	HWY. SYS.	HPMS SAMPLE	PRKG. REST.	COM/IND ACCESS		CONTROL	COM/IND. ACCESS	PRKG. REST.	
						Waesche DR				
						DP 022 4506 5086				
						CO				
						008				
						Coral Root Ct				
						Co 5088 006				
										24'I
										JC-C
						Waesche DR.				2UML
						DF CO 000 5086				
						CUL-DE-SAC				

OP 4731 / 5087 / CO

NON FA
UEB - LOCAL

TRAFFIC CODES

TRAFFIC CONTROLS: STOP SIGN=SS, TRAFFIC LIGHT=T.L., FLASHING RED BALL=F.R.

TRAFFIC CODES

PARKING RESTRICTIONS: A.M. PEAK, P.M. PEAK, A.M./P.M. PEAK, NO PARKING ANYTIME=N, P., COMM/IND. ACCESS=E

SYSTEM				TRAFFIC		LINE DIAGRAM	TRAFFIC			PAVEMENT DATA
FED. AID.	FUNCT. CLASS.	HWY. SYS.	HPMS SAMPLE	PRK.G. REST.	COM/IND ACCESS		CONTROL	COM/IND ACCESS	PRK.G. REST.	

SHA 51.3 - 8 Revised
4.83

MARYLAND STATE HIGHWAY ADMINISTRATION

ROAD INVENTORY SHEET

90-104

Party Chief BB
Recorder BB
Assistant
Map No./Dir. F12 / W
State Coordinates 956-395

Road No. Co 5088
Road Name CORAL ROOT CT.
County PRINCE GEORGES
Date 3-8-91
Sheet No. 1 OF 1

TRAFFIC CODES
TRAFFIC CONTROLS: STOP SIGN=S.S., TRAFFIC LIGHT=T.L., FLASHING RED BALL=F.R.

TRAFFIC CODES
PARKING RESTRICTIONS: A.M. PEAK, P.M. PEAK, A.M./P.M. PEAK, NO PARKING ANYTIME=N.P., COMM/IND. ACCESS=E

SYSTEM				TRAFFIC		LINE DIAGRAM	TRAFFIC			PAVEMENT DATA
FED. AID.	FUNCT CLASS.	HWY. SYS.	HPMS SAMPLE	PKG. REST.	COM/IND. ACCESS		CONTROL	COM/IND. ACCESS	PKG. REST.	

SYSTEM				TRAFFIC		LINE DIAGRAM	TRAFFIC			PAVEMENT DATA
FED. AID.	FUNCT. CLASS.	HWY. SYS.	HPMS SAMPLE	PRK'G. REST.	COM/IND ACCESS		CONTROL	COM/IND ACCESS	PRK'G. REST.	

SHA 51.3 - 8 Revised
4.83

MARYLAND STATE HIGHWAY ADMINISTRATION

ROAD INVENTORY SHEET

90-106

Party Chief BB
Recorder BB
Assistant
Map No./Dir. F12 / S
State Coordinates 955-395

Road No. Co 5089
Road Name Waesche Rd.
County PRINCE GEORGES
Date 3-8-91
Sheet No. 1 OF 1

TRAFFIC CODES
TRAFFIC CONTROLS: STOP SIGN=SS, TRAFFIC LIGHT=T.L., FLASHING RED BALL=F.R.

TRAFFIC CODES
PARKING RESTRICTIONS: A.M. PEAK, P.M. PEAK, A.M./P.M. PEAK, NO PARKING ANYTIME=N.P., COMM/IND. ACCESS=E

SYSTEM				TRAFFIC		LINE DIAGRAM	TRAFFIC			PAVEMENT DATA
FED. AID.	FUNCT CLASS.	HWY. SYS.	HPMS SAMPLE	PRK.G. REST.	COM/IND. ACCESS		CONTROL	COM/IND. ACCESS	PRK.G. REST.	
						D E				
						CUL 0 13 SAC				
						Waesche DR				
NON FA						CO 0 08 5086				24'I
URB-LOCAL										JC-C
										2UML
						CUL 0 00 SAC				
						D E				

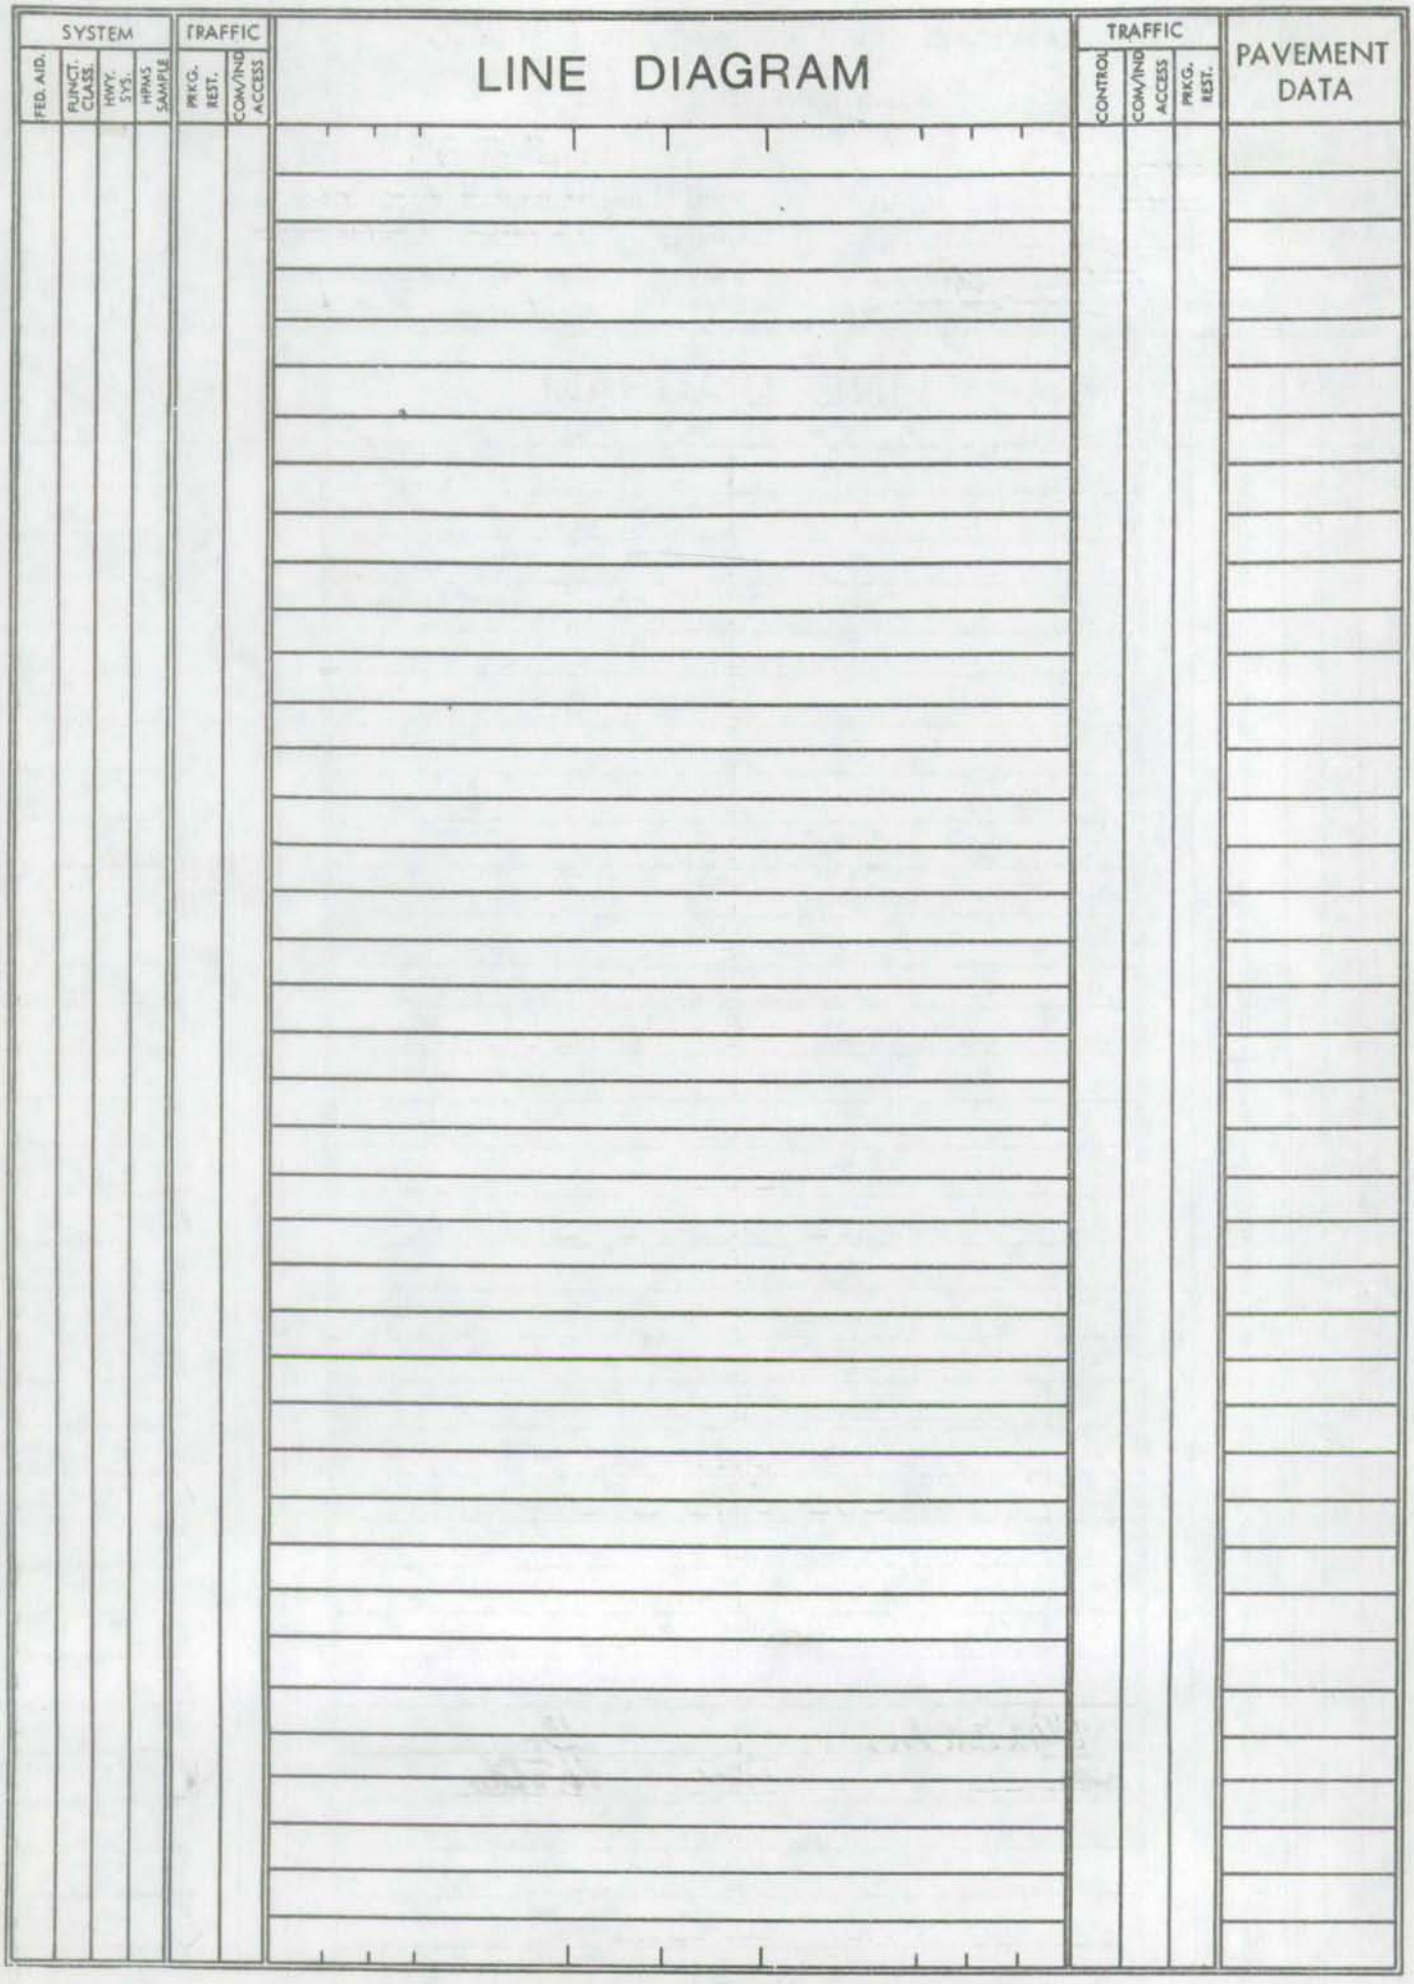
SYSTEM
FED. AID.
FUNCT. CLASS.
HWY. SYS.
HPMS SAMPLE
TRAFFIC
PRKG. REST.
COM/IND ACCESS
LINE DIAGRAM
TRAFFIC
CONTROL
COM/IND ACCESS
PRKG. REST.
PAVEMENT DATA

SHA 51.3 - 8 Revised
4.83

MARYLAND STATE HIGHWAY ADMINISTRATION

ROAD INVENTORY SHEET

90-108

Party Chief BB
Recorder BB
Assistant
Map No./Dir. F12 / S
State Coordinates 954-325

Road No. Co 5090
Road Name Waeshe Ct.
County PRINCE GEORGES
Date 3-8-91
Sheet No. 1 OF 1

TRAFFIC CODES
TRAFFIC CONTROLS: STOP SIGN=SS, TRAFFIC LIGHT=T.L., FLASHING RED BALL=F.R.

TRAFFIC CODES
PARKING RESTRICTIONS: A.M. PEAK, P.M. PEAK, A.M./P.M. PEAK, NO PARKING ANYTIME=N.P., COMM/IND. ACCESS=E

SYSTEM				TRAFFIC		LINE DIAGRAM	TRAFFIC			PAVEMENT DATA
FED. AID.	FUNCT CLASS.	HWY. SYS.	HPMS SAMPLE	PRKG. REST.	COM/IND. ACCESS		CONTROL	COM/IND. ACCESS	PRKG. REST.	
						D E				
						CUL 0 07 SAC				
NON-FA										24'I
U2B - LOCAL										JC-C
						Waeshe DR				2UML
						CO 0 00 5086				

SYSTEM				TRAFFIC		LINE DIAGRAM	TRAFFIC			PAVEMENT DATA
FED. AID.	FUNCT. CLASS.	HWY. SYS.	HPMS SAMPLE	PRK.G. REST.	COM/IND ACCESS		CONTROL	COM/IND ACCESS	PRK.G. REST.	

SHA 51.3 - 8 Revised
4.83

MARYLAND STATE HIGHWAY ADMINISTRATION

90-112

ROAD INVENTORY SHEET

Party Chief BB
Recorder BB
Assistant
Map No./Dir. F12 / N
State Coordinates 852-390

Road No. Co 5091
Road Name Winged Foot Dr.
County PRINCE GEORGES
Date 3-7-91
Sheet No. 1 OF 1

TRAFFIC CODES
TRAFFIC CONTROLS: STOP SIGN=SS, TRAFFIC LIGHT=T.L., FLASHING RED BALL=F.R.

TRAFFIC CODES
PARKING RESTRICTIONS: A.M. PEAK, P.M. PEAK, A.M./P.M. PEAK, NO PARKING ANYTIME=N.P., COMM/IND. ACCESS=E

SYSTEM				TRAFFIC		LINE DIAGRAM	TRAFFIC			PAVEMENT DATA
FED. AID.	FUNCT CLASS.	HWY. SYS.	HPMS SAMPLE	PRKG. REST.	COM/IND. ACCESS		CONTROL	COM/IND. ACCESS	PRKG. REST.	
NON FA	URB - LOCAL					Spyglass Co. 0 10 Hill 5092	SS			24 I JC-C 2UML
						130° 0 06 LAKE ARBOR 0 00 ~~DR.~~ Way Co 3460	SS			

SYSTEM				TRAFFIC		LINE DIAGRAM	TRAFFIC			PAVEMENT DATA
FED. AID.	FUNCT. CLASS.	HWY. SYS.	HPMS SAMPLE	PRKG. REST.	COM/IND ACCESS		CONTROL	COM/IND ACCESS	PRKG. REST.	

SHA 51.3 - 8 Revised
4.83

MARYLAND STATE HIGHWAY ADMINISTRATION

90-115

ROAD INVENTORY SHEET

Party Chief BB
Recorder BB
Assistant
Map No./Dir. F12C / SW
State Coordinates 852-390

Road No. Co 5092
Road Name SPYGLASS HILL
County PRINCE GEORGES
Date 3-7-91
Sheet No. 1 OF 2

SYSTEM: FED. AID. | FUNCT CLASS. | HWY. SYS. | HPMS SAMPLE
TRAFFIC: PKG. REST. | COM/IND. ACCESS

LINE DIAGRAM

CUL

Mission Hills

0 30 Co 5093'

PT 0 29

40°

PC 0 26

Winged Foot Dr.

Co 5091 0 23

PT 0 20

100°

PC 0 08

Mission Hills

Co 0 06 5093'

Spyglass Hill Ct

Co 0 00 5094

TRAFFIC: CONTROL | COM/IND. ACCESS | PKG. REST.

PAVEMENT DATA

24'I
JC-C
ZUML

NON FA
U2B - LOCAL

TRAFFIC CODES
TRAFFIC CONTROLS: STOP SIGN=S.S., TRAFFIC LIGHT=T.L., FLASHING RED BALL=F.R.

TRAFFIC CODES
PARKING RESTRICTIONS: A.M. PEAK, P.M. PEAK, A.M./P.M. PEAK, NO PARKING ANYTIME=N.P., COMM/IND. ACCESS=E

SYSTEM				TRAFFIC		LINE DIAGRAM	TRAFFIC				PAVEMENT DATA
FED. AID.	FUNCT. CLASS.	HWY. SYS.	HPMS SAMPLE	PRKG. REST.	COM/IND ACCESS		CONTROL	COM/IND ACCESS		PRKG. REST.	

D E
CUL 036SAC

24'I
JC-C
2 VML

SHA 51.3 - 8 Revised
4.83

MARYLAND STATE HIGHWAY ADMINISTRATION

ROAD INVENTORY SHEET

90-111

Party Chief BB
Recorder BB
Assistant
Map No./Dir. F12C / E
State Coordinates 852-340

Road No. Co 5093
Road Name MISSION Hills
County PRINCE GEORGES
Date 3-7-91
Sheet No. 1 OF 1

TRAFFIC CODES
TRAFFIC CONTROLS: STOP SIGN=SS, TRAFFIC LIGHT=T.L., FLASHING RED BALL=F.R.

TRAFFIC CODES
PARKING RESTRICTIONS: A.M. PEAK, P.M. PEAK, A.M./P.M. PEAK, NO PARKING ANYTIME=N.P., COMM/IND. ACCESS=E

SYSTEM				TRAFFIC		LINE DIAGRAM	TRAFFIC			PAVEMENT DATA
FED. AID.	FUNCT CLASS.	HWY. SYS.	HPMS SAMPLE	PRKG. REST.	COM/IND. ACCESS		CONTROL	COM/IND. ACCESS	PRKG. REST.	
						D E				
						CUL 0 24 SAC				↑
						0 21 30°				
						Spyglass Hill				
						Co 0 16 5092				
						0 14 PT				
						40°				
						0 10 PC				
NON FA						PT 0 07				
URB-LOCAL						40°				
						PC 0 03				
										24' I
										JC-C
						Spyglass Hill				2UML
						Co 0 00 5092	SS			↓

SYSTEM				TRAFFIC		LINE DIAGRAM	TRAFFIC			PAVEMENT DATA
FED. AID.	FUNCT. CLASS.	HWY. SYS.	HPMS SAMPLE	PRK'G. REST.	COM/IND ACCESS		CONTROL	COM/IND ACCESS	PRK'G. REST.	

SHA 51.3 - 8 Revised
4.83

MARYLAND STATE HIGHWAY ADMINISTRATION

ROAD INVENTORY SHEET

90-110

Party Chief BB
Recorder BB
Assistant
Map No./Dir. F12 / NE
State Coordinates 853-341

Road No. Co 5094
Road Name Spyglass Hill Ct
County PRINCE GEORGES
Date 3-7-91
Sheet No. 1 OF 1

TRAFFIC CODES
TRAFFIC CONTROLS: STOP SIGN=SS, TRAFFIC LIGHT=T.L., FLASHING RED BALL=F.R.

TRAFFIC CODES
PARKING RESTRICTIONS: A.M. PEAK, P.M. PEAK, A.M./P.M. PEAK, NO PARKING ANYTIME=N.P., COMM/IND. ACCESS=E

SYSTEM				TRAFFIC		LINE DIAGRAM	TRAFFIC			PAVEMENT DATA
FED. AID.	FUNCT CLASS	HWY. SYS.	HPMS SAMPLE	PRKG. REST.	COM/IND. ACCESS		CONTROL	COM/IND. ACCESS	PRKG. REST.	
						D E				
						CUL 0 07 SAC				
						Spyglass Hill				
						0 03 Co 5092 90-115				
										24'I
										SC-C
										2UML
						CUL 0 00 SAC				
						D E				

NON FA
URB - LOCAL

SYSTEM				TRAFFIC		LINE DIAGRAM	TRAFFIC			PAVEMENT DATA
FED. AID.	FUNCT. CLASS.	HWY. SYS.	HPMS SAMPLE	PRKG. REST.	COM/IND ACCESS		CONTROL	COM/IND ACCESS	PRKG. REST.	

SHA 51.3 - 8 Revised
4.83

MARYLAND STATE HIGHWAY ADMINISTRATION

ROAD INVENTORY SHEET

Urban

95-134
BOAH
3/13/96

92-60
91-66
89-53
90-114

Party Chief DT
Recorder JS
Assistant
Map No./Dir. F12 / N
State Coordinates 850 - 389

Road No. CO 5095
Road Name CAMPUS WAY NORTH
County PRINCE GEORGES
Date 3-13-92
Sheet No. 1 OF 2

TRAFFIC CODES
TRAFFIC CONTROLS: STOP SIGN=S.S., TRAFFIC LIGHT=T.L., FLASHING RED BALL=F.R.

TRAFFIC CODES
PARKING RESTRICTIONS: A.M. PEAK, P.M. PEAK, A.M./P.M. PEAK, NO PARKING ANYTIME=N.P., COMM/IND. ACCESS=E

SYSTEM				TRAFFIC		LINE DIAGRAM	TRAFFIC			PAVEMENT DATA
FED. AID.	FUNCT CLASS.	HWY. SYS.	HPMS SAMPLE	PKG. REST.	COM/IND. ACCESS		CONTROL	COM/IND. ACCESS	PKG. REST.	
						12'I 5095 0 36 PT CO				
						12'I 0 34				
						0 33				
						0 27 45°				
						12'H 0 24				
						0 16 PC				
						5095 87-53 92-60				
						0 13				
						12'H LAZY DAY LA				
						0 10 CO 5607				2-36'I
										24'GRSMED
										Jc-c
										6mL
						5095 87-53 CO 0 03				
						12'H .04/16'I, Jcc .04/16'I, Jcc				2-24'I
										24'GRSMED
										Jc-c
						MD 0 00 214 V @5.07 (L) CAMPUS WAY SOUTH CO 4638 (+.00)	TL			4mL

LINE DIAGRAM

SYSTEM				TRAFFIC		TRAFFIC			PAVEMENT DATA
FED. AID.	FUNCT. CLASS.	HWY. SYS.	HPMS SAMPLE	PRK'G. REST.	COM/IND ACCESS	CONTROL	COM/IND ACCESS	PRK'G. REST.	
					E				

ROAD XXXX 0 70 END

0 68

12' H

0 65

12' H

0 63

.03/16'I Jc-c

WAY

LAKE ARBOR

CO 0 61 3460 SS

@ 1.43

12' H

↱30° 0 57

0 54

12' H

ARBOR PARK PL

CO 5254 0 51

12' H

0 48

5095

0 39

12' H

2-36'I

10'GRSMED

Jc-c

2umL

2-36'I

24'GRSMED

Jc-c

6mL

SHA 51.3 - 8 Revised
4.83

MARYLAND STATE HIGHWAY ADMINISTRATION

ROAD INVENTORY SHEET

90-116

Party Chief BB
Recorder BB
Assistant
Map No./Dir. F12 / N
State Coordinates 850-343

Road No. Co 5096
Road Name Terrapin Hills DR
County PRINCE GEORGES
Date 3-7-91
Sheet No. 1 OF 1

91-61

SYSTEM: FED. AID. | FUNCT CLASS. | HWY. SYS. | HPMS SAMPLE
TRAFFIC: PRK.G. REST. | COM/IND. ACCESS

TRAFFIC CODES
TRAFFIC CONTROLS: STOP SIGN=SS, TRAFFIC LIGHT=T.L., FLASHING RED BALL=F.R.

TRAFFIC CODES
PARKING RESTRICTIONS: A.M. PEAK, P.M. PEAK, A.M./P.M. PEAK, NO PARKING ANYTIME=N.P., COMM/IND. ACCESS=E

NON FA
URB LOCAL

LINE DIAGRAM

Willow Oaks Dr

OR Co 0 34 ~~4755~~ 5212 0.16 SX=1

0 30 PI

0 29 54" RCP 80°

0 26

PRC 0 19 PRC

90°

PC 0 10

Terrapin Hills Ct

0 09 Co 5097

0 07 30°

Golf Course Dr.

Co 0 04 3459 5096

CO

CUL 0 ∞ SAC

D E

TRAFFIC: CONTROL | COM/IND. ACCESS | PRK.G. REST.

PAVEMENT DATA

24'I
Je-c
2UNL

SYSTEM				TRAFFIC		LINE DIAGRAM	TRAFFIC			PAVEMENT DATA
FED. AID.	FUNCT. CLASS.	HWY. SYS.	HPMS SAMPLE	PRK.G. REST.	COM/IND ACCESS		CONTROL	COM/IND ACCESS	PRK.G. REST.	

SHA 51.3 - 8 Revised
4.83

MARYLAND STATE HIGHWAY ADMINISTRATION

ROAD INVENTORY SHEET

90-118

Party Chief BB
Recorder BB
Assistant
Map No./Dir. F12 / E
State Coordinates 850-394

Road No. Co 5097
Road Name Terrapin Hills Ct
County PRINCE GEORGES
Date 3-7-91
Sheet No. 1 OF 1

TRAFFIC CODES
TRAFFIC CONTROLS: STOP SIGN=SS, TRAFFIC LIGHT=T.L., FLASHING RED BALL=F.R.

TRAFFIC CODES
PARKING RESTRICTIONS: A.M. PEAK, P.M. PEAK, A.M./P.M. PEAK, NO PARKING ANYTIME=N.P., COMM/IND. ACCESS=E

SYSTEM				TRAFFIC		LINE DIAGRAM	TRAFFIC			PAVEMENT DATA
FED. AID.	FUNCT CLASS.	HWY. SYS.	HPMS SAMPLE	PRKG. REST.	COM/IND. ACCESS		CONTROL	COM/IND. ACCESS	PRKG. REST.	
						D E CUL 0 07 SAC				
NON FA UOB LOCAL										24'I Jc-c 2UML
						Terrapin Hills DR. Co 0 00 5096				

SYSTEM				TRAFFIC		LINE DIAGRAM	TRAFFIC			PAVEMENT DATA
FED. AID.	FUNCT. CLASS.	HWY. SYS.	HPMS SAMPLE	PRK'G. REST.	COM/IND ACCESS		CONTROL	COM/IND ACCESS	PRK'G. REST.	

SHA 51.3 - 8 Revised
4.83

MARYLAND STATE HIGHWAY ADMINISTRATION

ROAD INVENTORY SHEET

90-119

Party Chief BB
Recorder BB
Assistant
Map No./Dir. F12 / S
State Coordinates 853-405

Road No. Co. 5098
Road Name BISCOE CT.
County PRINCE GEORGES
Date 3-8-91
Sheet No. 1 OF 1

TRAFFIC CODES
TRAFFIC CONTROLS: STOP SIGN=SS, TRAFFIC LIGHT=T.L., FLASHING RED BALL=F.R.

TRAFFIC CODES
PARKING RESTRICTIONS: A.M. PEAK, P.M. PEAK, A.M./P.M. PEAK, NO PARKING ANYTIME=N.P., COMM/IND. ACCESS=E

SYSTEM				TRAFFIC		LINE DIAGRAM	TRAFFIC			PAVEMENT DATA
FED. AID.	FUNCT CLASS.	HWY. SYS.	HPMS SAMPLE	PRK.G. REST.	COM/IND. ACCESS		CONTROL	COM/IND. ACCESS	PRK.G. REST.	
						DE				
						CUL 0 045 AC				
										24'I
										Jc-c
										ZUML
NON FA						Dr.				
URB-LOCAL						0 00 4579	SS			
						Concrete				
						60				

SYSTEM				TRAFFIC		LINE DIAGRAM	TRAFFIC			PAVEMENT DATA
FED. AID.	FUNCT. CLASS.	HWY. SYS.	HPMS SAMPLE	PRKG. REST.	COM/IND ACCESS		CONTROL	COM/IND ACCESS	PRKG. REST.	

CO 5099

Prince Georges County

UNASSIGNED

NOW ABANDONED

New York Ave

00-15 ST

SHA 51.3 - 8 Revised
4.83

MARYLAND STATE HIGHWAY ADMINISTRATION

OP 4761

ROAD INVENTORY SHEET

90-126

Party Chief BB
Recorder BB
Assistant
Map No./Dir. F12 / SE
State Coordinates 850-405

Road No. Co 5100
Road Name Pennsylvania LA.
County PRINCE GEORGES
Date 3-8-91
Sheet No. 1 OF 1

TRAFFIC CODES
TRAFFIC CONTROLS: STOP SIGN=SS, TRAFFIC LIGHT=T.L., FLASHING RED BALL=F.R.

TRAFFIC CODES
PARKING RESTRICTIONS: A.M. PEAK, P.M. PEAK, A.M./P.M. PEAK, NO PARKING ANYTIME=N.P., COMM/IND. ACCESS=E

SYSTEM				TRAFFIC		LINE DIAGRAM	TRAFFIC			PAVEMENT DATA
FED. AID.	FUNCT CLASS.	HWY. SYS.	HPMS SAMPLE	PRK.G. REST.	COM/IND. ACCESS		CONTROL	COM/IND. ACCESS	PRK.G. REST.	
						ROAD 0 00 BEG END				
						0 07 PT				
						909				
						0 05 PC OP 4761				10'E
						0 01				
						Co 5100				10'F
						LOTTSFORD-VISTA Rd.				
						Co 0 00 929				

SYSTEM				TRAFFIC		LINE DIAGRAM	TRAFFIC			PAVEMENT DATA
FED. AID.	FUNCT. CLASS.	HWY. SYS.	HPMS SAMPLE	PRK.G. REST.	COM/IND ACCESS		CONTROL	COM/IND ACCESS	PRK.G. REST.	