PRINCE GEORGES COUNTY
OTHER PUBLIC ROADS
566 to 800

SHA 51.3 - 8 Revised
4.83

MARYLAND STATE HIGHWAY ADMINISTRATION

ROAD INVENTORY SHEET

Party Chief _____
Recorder _____
Assistant _____
Map No./Dir. _____/_____
State Coordinates _____

Road No. _____
Road Name _____
County _____
Date _____
Sheet No. _____ OF _____

SYSTEM				TRAFFIC		LINE DIAGRAM	TRAFFIC			PAVEMENT DATA
	FUNCT CLASS	HWY SYS	HPMS SAMPLE	PKG. REST.	COM/IND ACCESS		CONTROL	COM/IND ACCESS	PKG. REST.	

TRAFFIC CODES

TRAFFIC CONTROLS: STOP SIGN-SS, TRAFFIC LIGHT=T.L., FLASHING RED BALL=F.R.

TRAFFIC CODES

PARKING RESTRICTIONS: A.M. PEAK, P.M. PEAK, A.M./P.M. PEAK, NO PARKING ANYTIME=N.P., COMM/IND. ACCESS=E

COUNTY _____ ROAD NO. _____ PAGE ___ OF ___

SYSTEM				TRAFFIC		LINE DIAGRAM	TRAFFIC				PAVEMENT DATA
	FUNCT. CLASS	HWY SYS	HPMS SAMPLE	PRES.	COM/IND ACCESS		CONTROL	COM/IND ACCESS	PRES.		

PRINCE GEORGE'S COUNTY

OP 566

MUIRKIRK ROAD

UNASSIGNED

NOW PART OF CO 21

91-182

Form 6 HPS (Rev. 1961)

ROAD INVENTORY SHEET

Party Chief E. S.
Recorder H. S.
Chainman

Road No. Co. 21
Name MUIRKIRK RD.
Sheet No. 8 OF 6
Date 6/16/56
County P G.

GRAVEL

PIT.

END

393 +

386 ⊥ 9' D 19' C-W

369 ⊥

366 18" RCP

END

SHA 51.3-8
11-15-72

STATE HIGHWAY ADMINISTRATION OF MARYLAND

ROAD INVENTORY SHEET

Party Chief _____
Recorder _____
Helper _____

Map No. _____

Road No. _____
Road Name _____
Sheet No. _____
Date _____
County _____
State Coordinates _____

SHA 51.3-8
1-15-72

ROAD INVENTORY SHEET

Road No. _____
Road Name _____
Sheet No. _____
Date _____
County _____
State Coordinates _____

Form 6 HPS (Rev. 1961) FAU O.P. 57 I-368 A

ROAD INVENTORY SHEET

Party Chief E. Schmidt
Recorder H Goerner
Chainman

MAP 1 @ Myattswood 823-444 N27

AS Tabbed 3-17-70 VER 54-78

Road No. CO. 25
Name PINE ST
Sheet No. 1 OF 1
Date 7/11/66
County PRINCE GEORGES

AMMENDALE RD / CO. 023 TO

015 H 10' D 20' C-L

MAPLE PL / Co. 29 010

020 5 H

H 006

H 005 20' F 30' C-W

004

POWDER MILL RD / MD 000 212

Form 6 HPS (Rev. 1961)

FAU

OP 568

ROAD INVENTORY SHEET

Party Chief E Schaub

Recorder H Conrad

Chainman

MAP

822-439 M39

Road No. Co. 21

Name CEDAR LA.

Sheet No. 2 OF 2

Date 7/27/66

County PRINCE GEORGES

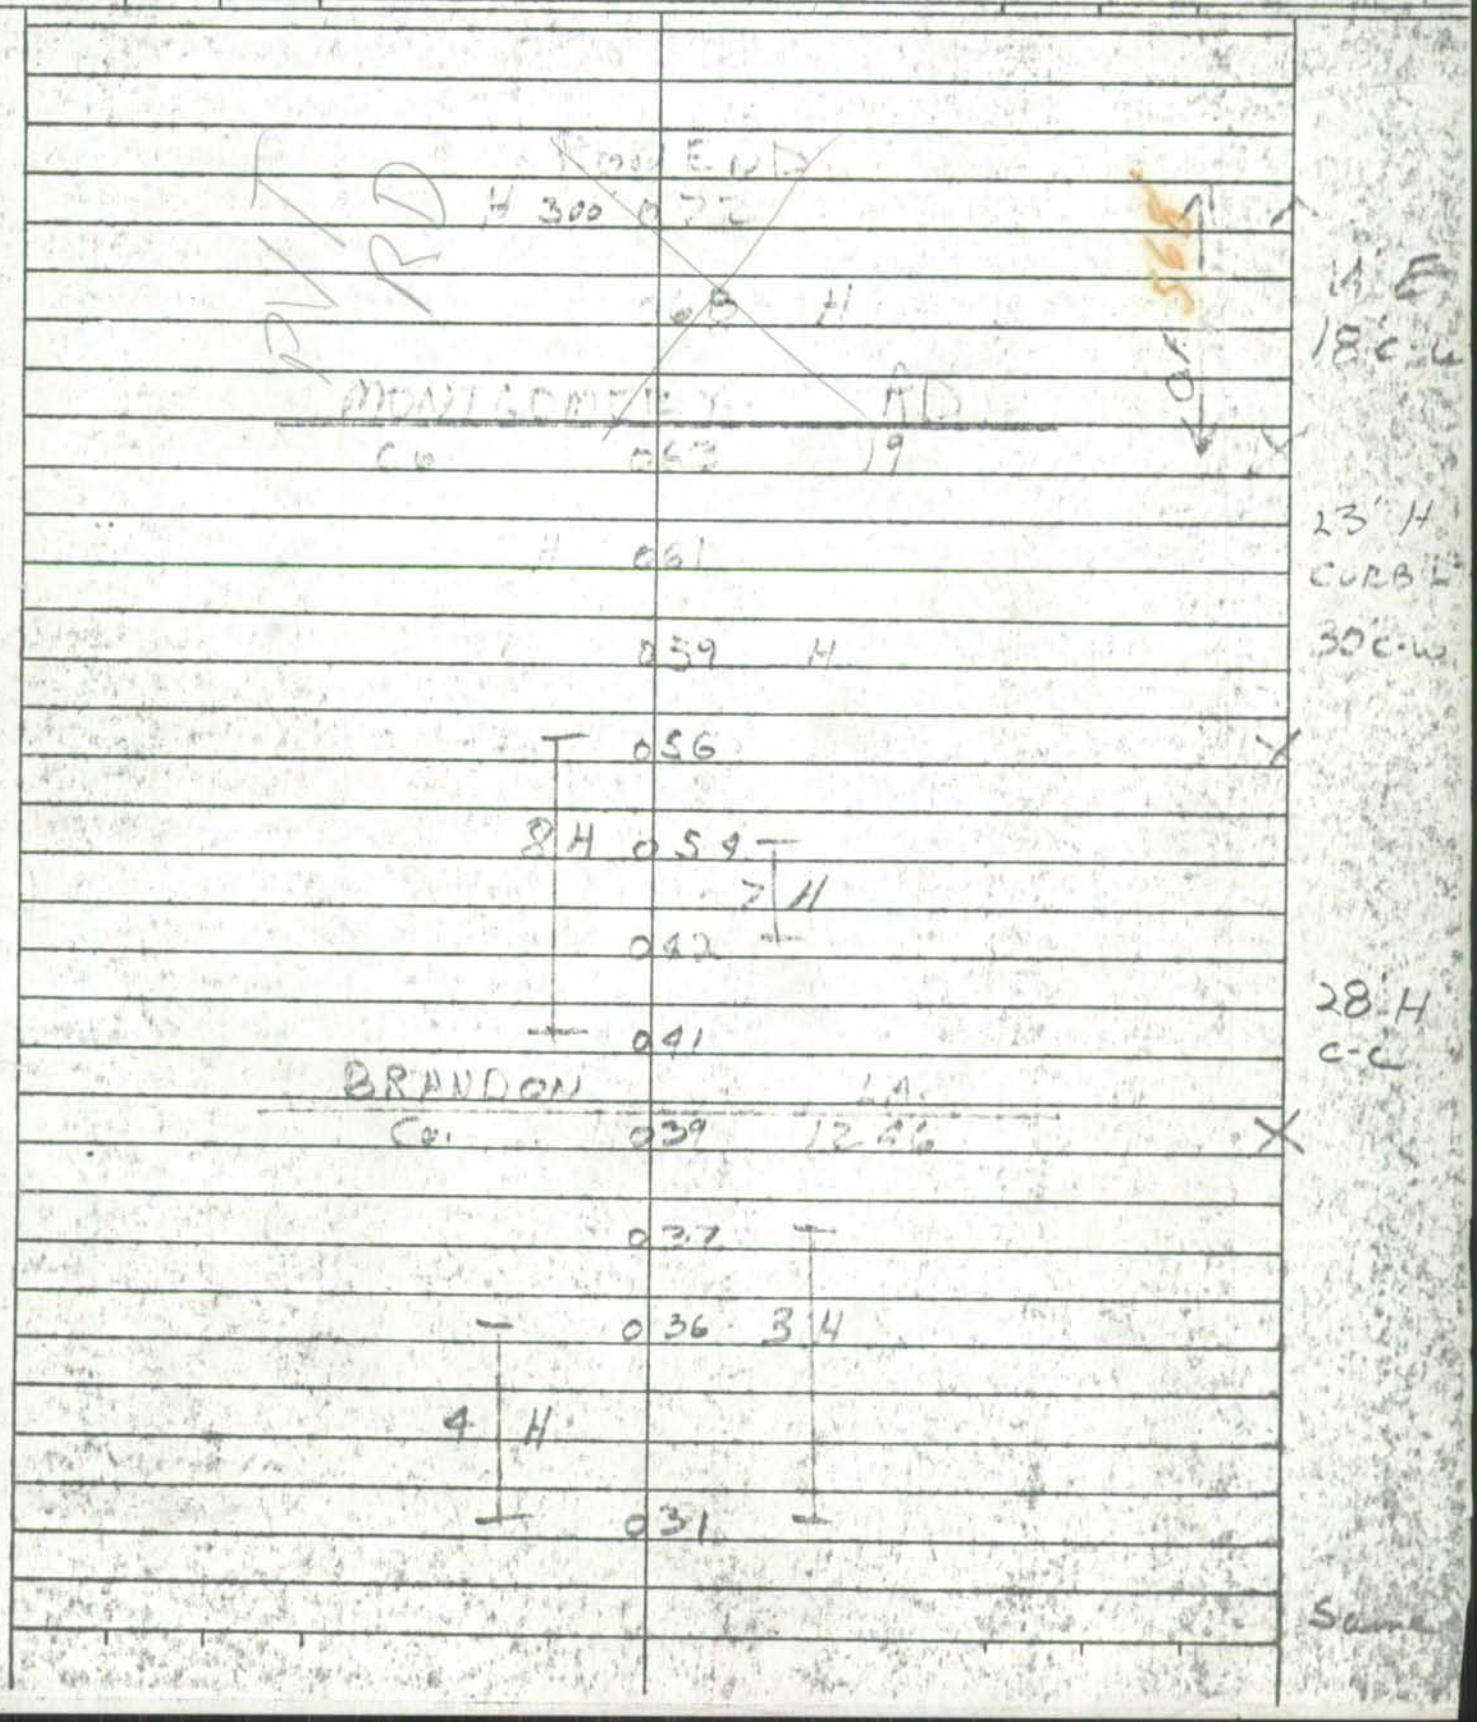

Form 6 HPS (Rev. 1961) ~~MAP~~

OP. 569

95-62

ROAD INVENTORY SHEET

Party Chief E.S.
Recorder W.D
Chairman

F12

870 - 409
~~868 - 448~~

VER 6-6-78

~~M42~~

Road No. Co. 60
Name OLD STAGE Rd.
Sheet No. 2 of 2
Date 7-9-68
County Pr. Geo.

SEF

CO 60

ROAD 113 END

10'E

102 90°

091

CLOVER HILL TERR
OP 4834 088

S

BRIERCREST RD
OP 4833 074

~~Road~~ ~~185~~ End

10'E
14'CW

13

90°

~~98°~~ Farm 301' 066

SAME

Form 6 HPS (Rev. 1961) MAP4 ~~OP 570~~

ROAD INVENTORY SHEET

CO 4459

Party Chief E.S.
Recorder W.D.
Chainman

VeR 5-31-78

A31
867-430 M32

Road No. CO 62
Name NORMAL SCHOOL RD.
Sheet No. 2 OF 2
Date 6-24-68
County PRINCE GEO

UNASSIGNED

NOW CO 4459

SAND & GRAVEL PIT

LAND

SLEXTRA

CEMENT PLANT

LEGEND: PAVED ROAD

END

SIGN ROAD NARROWS

 

Form 6 HPS (Rev. 1961) Reassigned 2-17-71 GJG (Previous OP571 Now Co. 80 69-158)

ROAD INVENTORY SHEET

Party Chief E. Schuyler
Recorder H. GORMAN
Chainman

GREEN BELT

VER 5-9-78

F11B

Road No. OP571
Name COURT. TO-Research Rd.
Sheet No. 1 OF 1
Date 5/19/67
County PRINCE GEORGES

825.428 A-91

HILLSIDE		RD	
MUN	003	220	@.03
	001		
			60' F C-C
RESEARCH		RD.	
MUN	000	1430	@.37

Form 6 HPS (Rev. 1961)

map 7

OP 572

ROAD INVENTORY SHEET

Parkland DR

Ver 9-27-77

PARTY CHIEF Edward Schuyler
RECORDER Henry Gorman
CHAINMAN J. FIERICK

ROAD NO. CO. 86
NAME ~~PARKLAND~~ DRIVE
SHEET NO. 3 OF 3
DATE 11/29/67
COUNTY PRINCE GEORGES

GHB
826-369

PARKLAND
~~M35~~

ROAD END

PT

70°

H HILLSIDE AVE

0.58

0.57

0.55

0.52

P.C.

W

12'E
2-3'
SHLD
18'CL

5 H

14'G
2-3'E
SHLD
20'CL

SHA 51.3 - 8 Revised
4.83

Rewritten 10-22-91 KJP

MARYLAND STATE HIGHWAY ADMINISTRATION

95-128
BB/AH
3/31/95

ROAD INVENTORY SHEET COLUMBINE LA

Party Chief E. Schuyler
Recorder W. Dombroski
Assistant T. Landon
Map No./Dir. 61D1 N
State Coordinates 841-353

Road No. OP 573
Road Name ~~(Dower House Rd)~~
County Prince Georges
Date 9-30-68
Sheet No. 1 OF 1

TRAFFIC CODES
TRAFFIC CONTROLS: STOP SIGN=S.S., TRAFFIC LIGHT=T.L., FLASHING RED BALL=F.R.

TRAFFIC CODES
PARKING RESTRICTIONS: A.M. PEAK, P.M. PEAK, A.M./P.M. PEAK, NO PARKING ANYTIME=N.P., COMM/IND. ACCESS=E

SYSTEM				TRAFFIC		LINE DIAGRAM	TRAFFIC			PAVEMENT DATA
FED. AID.	FUNCT CLASS.	HWY. SYS.	HPMS SAMPLE	PKG. REST.	COM/IND. ACCESS		CONTROL	COM/IND. ACCESS	PKG. REST.	
						Dower House Rd West RD Co 3698 0 ~~38~~ 38 92 0.18 @1.11	SS			
						0 32 50° (50 0 31 COLUMBINE CT 0 24 30° PROPOSED 0 18 ~~0~~ 07 GOLDENROD LA 30° 0 15				
						Cu Leapley Co. RD 1049 0.00 @.35 (R)				24'I JCC 2VNL
						CUL 0 00 D E SAG				

SYSTEM				TRAFFIC		LINE DIAGRAM	TRAFFIC			PAVEMENT DATA
FED. AID.	FUNCT. CLASS.	HWY. SYS.	HPMS SAMPLE	PRK.G. REST.	COM/IND ACCESS		CONTROL	COM/IND ACCESS	PRK.G. REST.	

SHA 51.3 - 8 Revised
4.83

MARYLAND STATE HIGHWAY ADMINISTRATION

ROAD INVENTORY SHEET

Party Chief _____
Recorder _____
Assistant _____
Map No./Dir. 1
State Coordinates _____

Road No. OP 574
Road Name Bellefont La
County P. G.
Date _____
Sheet No. _____ OF _____

SYSTEM				TRAFFIC		LINE DIAGRAM	TRAFFIC			PAVEMENT DATA
FED. AID.	FUNCT. CLASS.	HWY. SYS.	HPMS SAMPLE	PRK.G. REST.	COM/IND. ACCESS		CONTROL	COM/IND. ACCESS	PRK.G. REST.	
						SEE INVENTORY OF Co 94				

TRAFFIC CODES

TRAFFIC CONTROLS: STOP SIGN=SS, TRAFFIC LIGHT=T.L., FLASHING RED BALL=F.R.

TRAFFIC CODES

PARKING RESTRICTIONS: A.M. PEAK, P.M. PEAK, A.M./P.M. PEAK, NO PARKING ANYTIME=N.P., COMM/IND. ACCESS=E

SYSTEM				TRAFFIC		LINE DIAGRAM	TRAFFIC				PAVEMENT DATA
FED. AID.	FUNCT. CLASS.	HWY. SYS.	HPMS SAMPLE	PRK'G. REST.	COM/IND ACCESS		CONTROL	COM/IND ACCESS	PRK'G. REST.		

Form 6 HPS (Rev. 1961)

MAP 6

O.P. 575

STATE SER.

ROAD INVENTORY SHEET

Party Chief E. SCHUYLER
Recorder T. LANDON
Chairman J. EMERICK
D PLUMMER

SILVER HILL

VER 8-23-67

Road No. MD 414-A
Name OLD SILVER HILL Rd
Sheet No. 1 OF 1
Date 12 - 7 - 67
County PRINCE GEORGES

GIIB 815-368 M-35

ABERDEEN ST.

C 13 CO 1145

010

009

ANDOVER PL

007 CO 1196

N

005

004

← 50' →

3 H

001

BOWIA CT

MD 414 000 C. 1197

MD 414

MD 414

208.5725

A

H

H

A

20'G

3'E

23'

32'G

3'E SH

LT

MD

Form 6 HPS (Rev. 1961)

MAP 8

OP. 576

ROAD INVENTORY SHEET

Party Chief E.S
Recorder W.D.
Chairman

889-380 N36

VER 7-19-77

Road No. Co 102
Name CLAGETT LANDING RD
Sheet No. KOF
Date 7-10-68
County PRINCE GEO

ROAD 7.55 END

	1	ST	H	
	2		DR.	
H	2	19		
	2	40	H	15'E 18'CW
	3		25° IND COUNTY SIGN MAIN	
H 85°	2	27		
	2	17	PT	
	2	14	P.C	
	1	96	FARM	
PT	1	82		
(35° P.C	1	88		
	1	81	FARM	
30°	1	72		
	1	56	90°	
FARM	1	36		
			9'E	
	1	19	0.60 FARM	SAME
	1			

Form 6 HPS (Rev. 1961) + HU

ROAD INVENTORY SHEET

O.P. 5-77

PARTY CHIEF Frederick Setton
RECORDER Thomas Landon
CHAINMAN

Gen Hwy MAP 10 VER 7-15-77

ROAD NO. Co 107
NAME C Hwy P.D
SHEET NO. 1 OF 2
DATE 8-3-67
COUNTY PRINCE GEORGES

872 - 349 M-36

			9'D
	RVRSIDE		14'CW
	144	RVRSIDE	X
	140	RVRSIDE	
H	136	H	
H	133		
		Pvt Rds	
	14	9'CP 0 123 TH.	
X	094	C.B. L-14'X W-2.4'X D-6'	
	060		
	059	B-TRUCKING	
US	045	301	
	037	H	
H	033		
	018	H	
F	014		H 16' X
H	011		24'CW
		PD 109	
	000	Prince George Co	

Form 6 HPS (Rev. 1961)

OP 577

ROAD INVENTORY SHEET

PARTY CHIEF Frederick Settan
RECORDER Thomas Landon
CHAINMAN

ROAD NO. Co 109
NAME
SHEET NO. 2 OF 2
DATE 8-3-62
COUNTY PRINCE GEORGES

	H
ROAD	END
H	164 H
	153 OP 164
	151 H

OP 577

SA 1915

Form 6 HPS (Rev. 1961) 7-14-70 G.G.

OP 578

ROAD INVENTORY SHEET

Party Chief E.S.
Recorder W.D.
Chainman

FRIENDLY FARMS

Road No. Co 121
Name OLD PALMER RD
Sheet No. 2 OF 2
Date 9-25-65
County PRINCE GEO

Unassigned

R/R	1	32	MD		
H	1	24			
9'2					
FARM	1	09		OP 578	
	1	06	DR		
CO			15		
OLD FORT	1	03	MD		24' I
					C-C
	0	96		X	
CO BROADVIEW 161					
	0	91			
					24' I
					2-3 E SHL
4	0	86		X	
900'					
	0	82		STATE MAIN	
H	0	81			16' I
					7-3 E SHL
OP 99	0	74	DS	X	
FARM	0	73			
	0	68	CO.C 15 L, 8 D, 100+ W		24' I
					2-3 E SHL
	0	64	65°9	X	
	0	60			

Form 6 HPS (Rev. 1961)

FAU MAP 7

OP 579

ROAD INVENTORY SHEET

Party Chief E.S.
Recorder W.D.
Chainman T.L.

VER 9-2-77
N. WESTPHILIA
843-363
3~~64~~

Road No. CO 129
Name ARMSTRONG LA
Sheet No. 1 OF 1
Date 7-30-64
County PRINCE GEO

M35B

ROAD	059	END	
	057	H	9'E
			9'CW
	048		
	046	H	
			OP
	041	H	
H	037		
	032	PINING H.	16'E
			16'CW
OP 75			
RYON RD	034		
H	027		
H	019		
		10 H	
H	017		
	005		
AUTO & EXAIN 10'E			
SERVICE 500'	001		
			16'H
CO		2064	2.3E540
SERVICE	000	CO	

Form 6 HPS (Rev. 1961) MAP 11 OP 1580

ROAD INVENTORY SHEET

PARTY CHIEF Frederick Settan
RECORDER Thomas Landon
CHAINMAN

ROAD NO. Co 138
NAME MT CALVERT RD
SHEET NO. 3 OF 3
DATE 8-3-67
COUNTY PRINCE GEORGES

VCR 7-15-77 880-346 M36

PAVEMENT

UNASSIGNED - NOW PRIVATE Rd

NC

90°

90°

	291		12'D
	267	92 Co. Off #8,9	18'CM
	251	H	12'
	249	DR	18'CM
	243	MCCLURE RD OP520 OP "C" ~~OP1926~~	
	239	DR	
H	219	H	
	213	12" CMP	
T.H.	209		
F	207	F	
H	183		
	176	DR	
H	174		
	151	PT 40°	

SAME

Form 6 HPS (Rev. 1961)

MAP 3

ROAD INVENTORY SHEET

FAU

OP ~~[illegible]~~ BILLINGS AVE 581

PARTY CHIEF: Edward Schuyler
RECORDER: Henry Gorman
CHAINMAN: J. EMERICK

ROAD NO. CO 260
NAME ~~51ST AVE~~ / BLVD. HILLS
SHEET NO. 1 OF 2
DATE 11/14/67
COUNTY PRINCE GEORGES

NAME CHANGE Effective 2-9-70

Ver 10-4-77

918-377 M35

W ST		W ST	
CO	0	20 266	
H	0	18	26'I C.C.
ALTAU		AVE	
CO.	0	16 32	*
H	0	14 VOL. F.D.	
BYERS		ST	
CO	0	11 ~~268~~	21 G
	0	09	*
	0	07	"
CIRUS ~~CLARKE~~		~~ST~~ PL	
CO	0	06 269	
H	0	05	
	0	04	LT 28 C.L.
DENT		ST. 0.18	21'F
CO	0	02 270	2-2'A SHLDS 25'C.L.
H	0	01 "	E. W
		Road 0 00 END	

0.0 SF.C.

Form 6 HPS (Rev. 1961)

MAPS ✱ +10

OP582

ROAD INVENTORY SHEET

Party Chief E.S.
Recorder W.D.
Chainman

VER 6-23-77

FAR

841.5 - 321 322 M39

Road No. CO 166
Name [illegible]
Sheet No. 2 OF 2
Date 7-26-68
County PRINCE GEO

H	ROAD	200	END H		
		192	PT 90°		
		188	PC		9 E
					9 CW
		172			
					18 E
		159			18 CW
DYSON		121	RD		
H		119			
		106			
US			301 4-SP		SAME
		91	DI. 18" CMP		

OP582

Form 6 HPS (Rev. 1961) MAP 10+13 OP 583

ROAD INVENTORY SHEET FAR

Party Chief E.S.
Recorder W.D.
Chairman

VER
6-20-77
314
855 - 314 M40

Road No. CO 173
Name GIBBONS CHAPEL RD.
Sheet No. 1 OF 2
Date 7-15-68
County PRINCE GEO.

	TRAD	1 [illegible]	END	
Abandoned 98CO-EX 15 G.D-E.F. 2/4/99				
			PT 30° PC	
	ROAD		END CHAIN	
		1 [illegible]	30°	
		172	H	16'F 20'CW
		150		
	PT 40° PC	125		
		123		
		111		
	30°	108		
	CO	172		20'F 2-3A SHO
N	NORTH KEYS	1 [illegible]	ED	
	CH	102		
	CH HALL	101		
	CEM.	099		
		097	H	SAME

CP 583

ROAD INVENTORY SHEET CO. 3854

Road No. OP 584
Road Name ST. MARYS CO RD
Sheet No. 2 OF 2
Date 7-16-68
County PR. GEO.
State Coordinates 279-275 G 17

Chief
Recorder
Engineer

Map No.

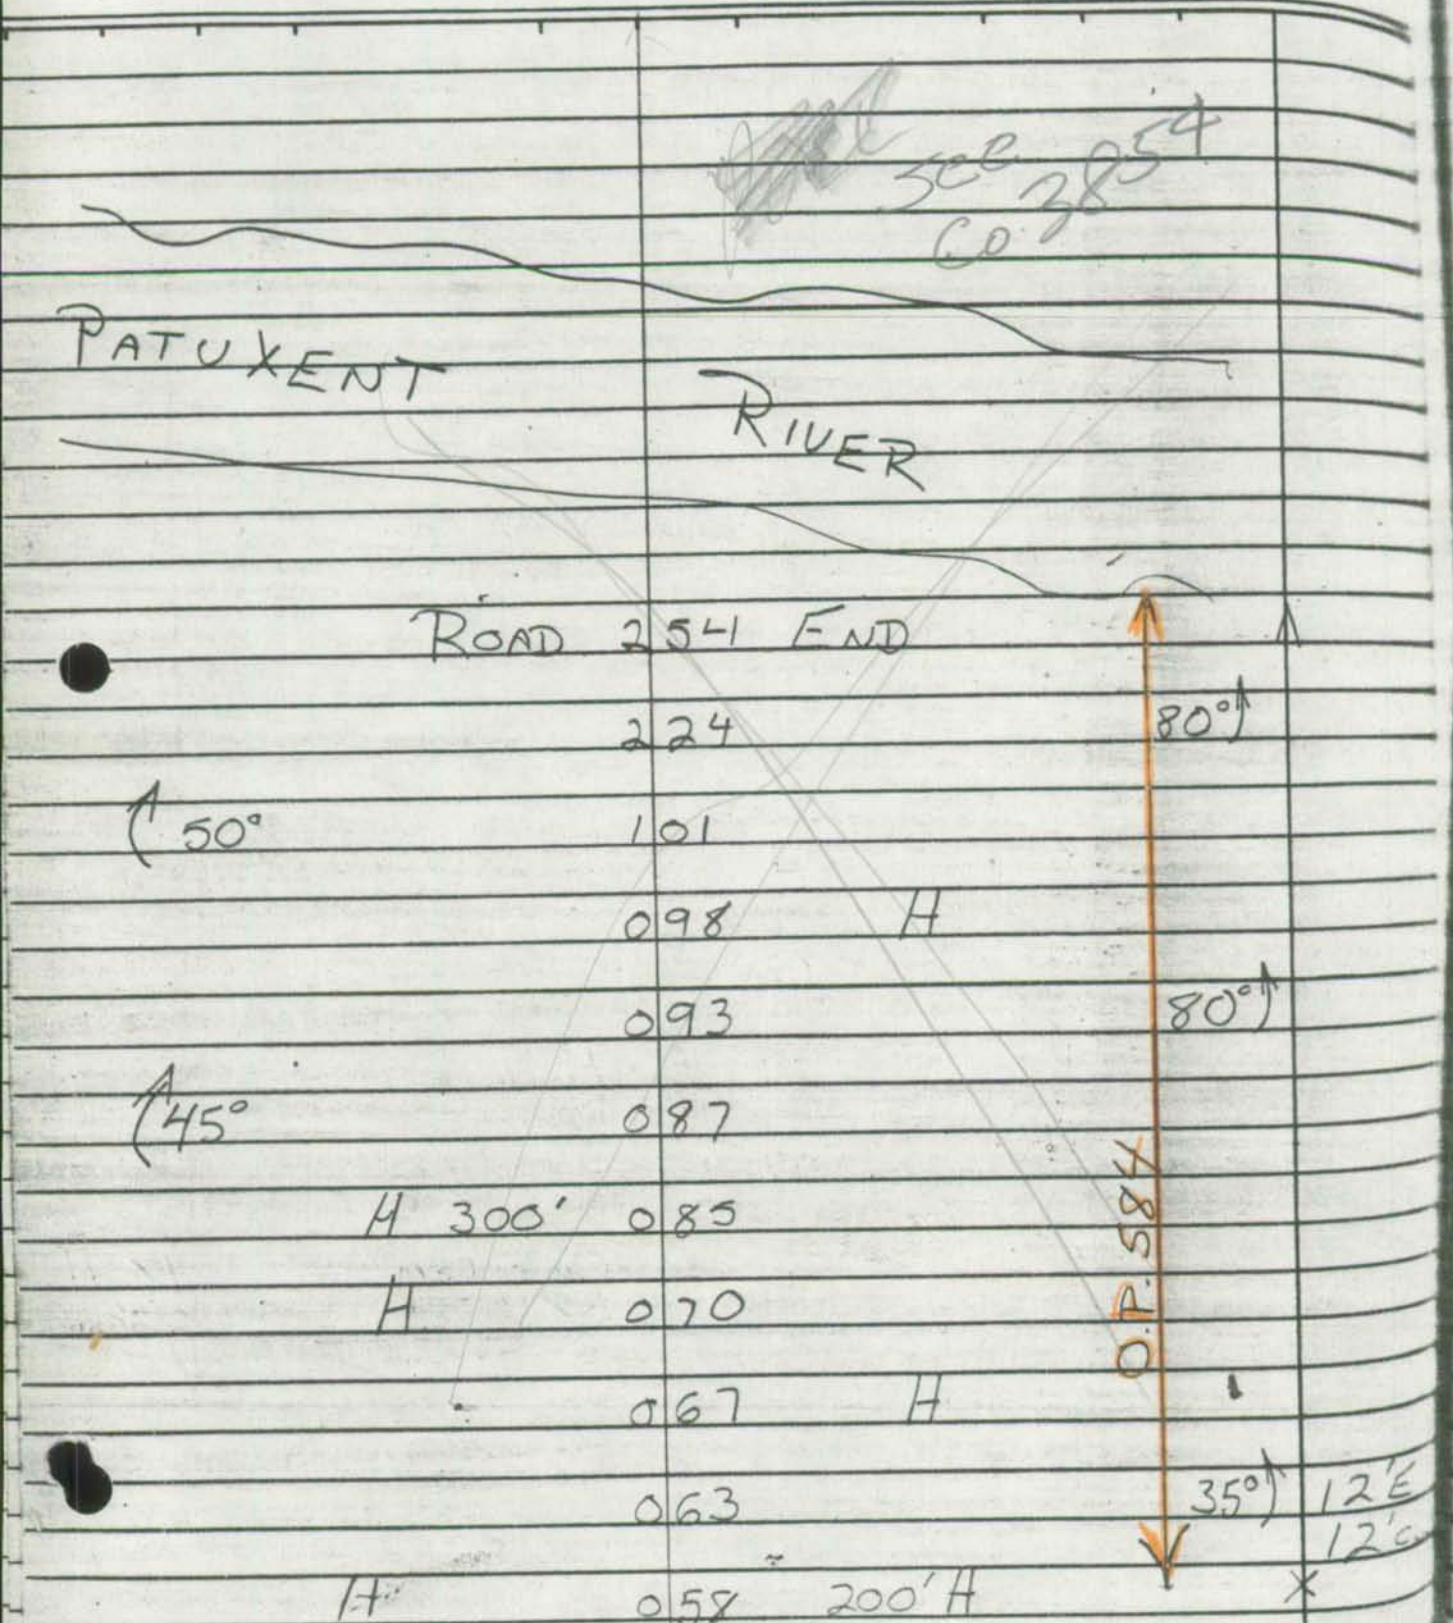

Form 6 HPS (Rev. 1961) FAR

0,8,585

ROAD INVENTORY SHEET

Party Chief E.S.
Recorder W.D.
Chainman

Gen Hwy

61-241

~~AAPH~~ FAR

I 12 VER 6-23-77 878-270 617

Road No. Co 195
Name ST PHILLIPS RD
Sheet No. 1 of 1
Date 7-18-65
County PRINCE GEO

UNASSIGNED

NOW CO 195

H ROAD 0 70 END H

90-2-195

0 73

0 75 H

H 0 71

3 CL. ES JEM. 0 37

0 37

Ca. 1 24 4

H 15'

0 16 H

CH. & CEM. 0 19

0 13 ↑30°

0 08 DR.

RD 0 00 381

16'E
12'CW

12'L
2-2'SHO

16'T
2-2'SHO

Form 6 HPS (Rev. 1961)

OP 586

ROAD INVENTORY SHEET

Party Chief E.S.
Recorder W.D.
Chainman

PAGETTS COR

Road No. Co 199
Name OAKDAWN RD
Sheet No. 2 OF 2
Date 12-19-68
County RANGE GEO

815-341 M35 MAPPG

71-87

ROAD 100 END

UNASSIGNED

CROP 086 PROP

Now Co 199

H 080

1 076 5 H

H 072

069

066 OP 112

Co 197
GIBBONS DR 060

Co 3058

H 056 OAKDALE ST

055 H

053 H

051 H SAME

Form 6 HPS (Rev. 1961) 70-241 FAU 3-101 - A&B ✓

Map 9

ROAD INVENTORY SHEET

OP 587 UNASS

Party Chief T. LANDON
Recorder W. WARFIELD
Helper
70-241

Road No. Co. 200
Road Name FT. FOOTE RD.
Sheet No. 1 OF 2
Date 3-10-71
County PRINCE GEORGES

75-139

196
497-331 M-35

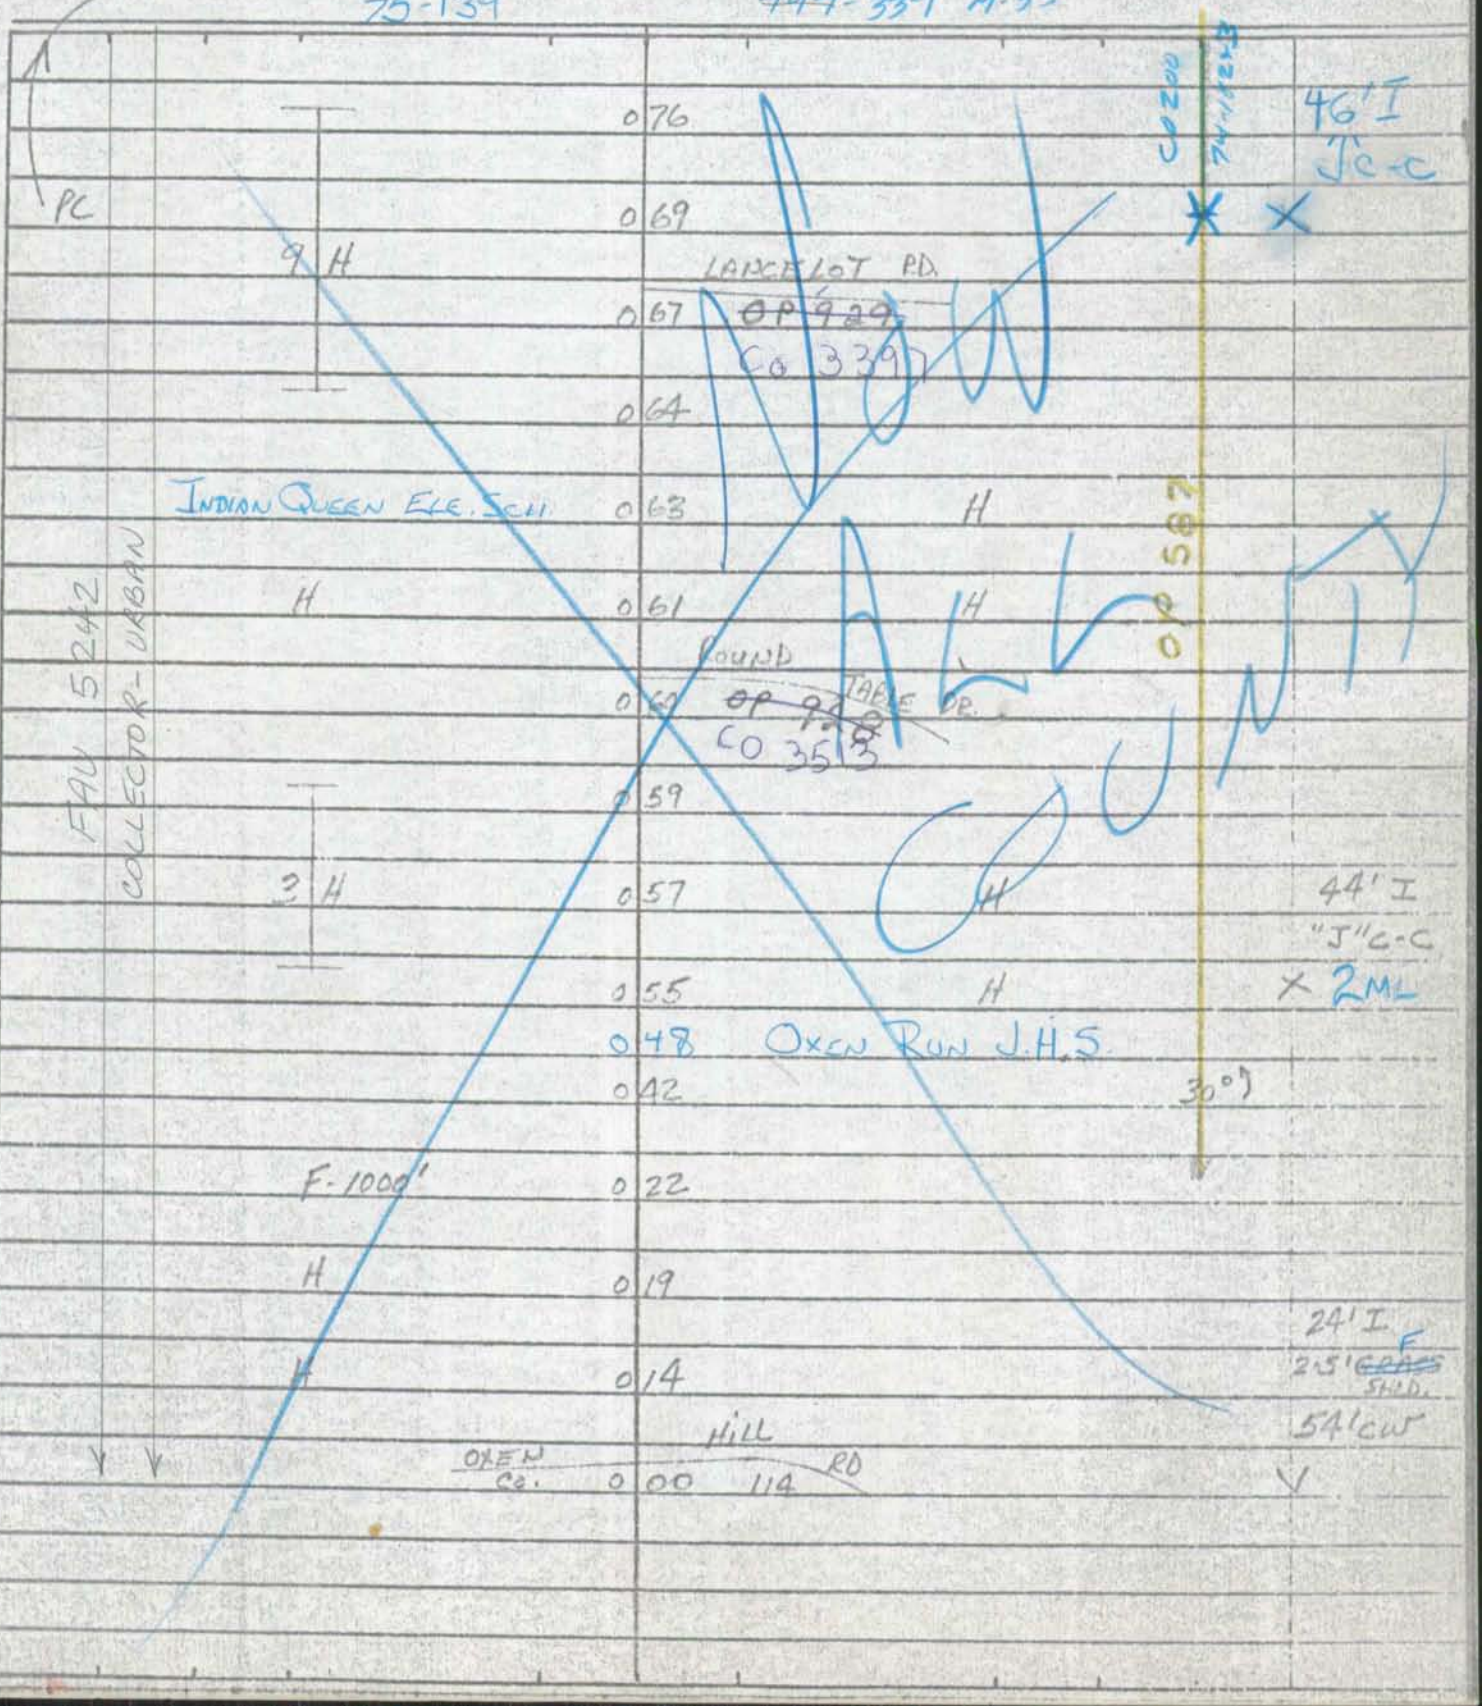

Form 6 HPS (Rev. 1961)

ROAD INVENTORY SHEET

Road No. Co. 200
Road Name FT. FOOTE RD.
Sheet No. 2 OF 2
Date 3-10-71
County PRINCE GEORGE

			FT. FOOTE RD.	
		1	10 Co. 88	↑
NON FA X LOCAL X URBAN	CARROLL BAR DR. Co. 2503	1	07	18'G 22'E SHLD 28'C-C
		1	05	*
			IVANHOE RD.	
		1	03 70-241 Co. 3511	
			LOCKSLEY RD.	
FAU 5242 COLLECTOR - URBAN	10 H	0	96 ~~OP 931~~ Co. 3511	
			FRIAR RD.	
		0	90 ~~OP 930~~ Co. 3609	
				40'I "J"C-C
		0	89	
	Kisconko RD. Co. 2945	0	87	* ~~24'E~~ ~~25'E SHLD~~
			LOUGHRAN RD	
		0	83 O.P 939	~~44'C-C~~
	H	0	80	*
				~~34'I~~
1 PT	WEDGEWOOD DR ~~Proposed~~ Co. 3827	0	78	~~J"C-C~~ ~~5'E SHLDS~~
40°				~~44'C-C~~

same

Form 6 HPS (Rev. 1961) MAP 3 ~~OP 588~~

ROAD INVENTORY SHEET

PARTY CHIEF Edward Schuyler
RECORDER Henry Gorman
CHAINMAN

ROAD NO. Co. 230
NAME METZEROTT RD.
SHEET NO. 9 OF 9
DATE 8/12/66
COUNTY PRINCE GEORGES

425
816-~~424~~ M31 XXXX

		STH 2	24
		2	20
		2	19
		2	16 H
UNIVERSITY		BLVD.	
MD		2	11 193
		2	10
PT			
30°	H	2	08
PC		2	07
		2	02 Bus. TV & RADIO REPAIR
		2	01 F
ENT. To MOOSE Lodge		1	92 H
	H	1	90
ADKINS RD.			
OP 480		1	88
		1	87 OP 1164
		1	86 H
			36th AV.
		1	82 to 1371
9	11		

Form 6 HPS (Rev. 1961)

Map 36

OP. 589

ROAD INVENTORY SHEET

FAU

PARTY CHIEF Edward Schuyler
RECORDER Henry Gorman
CHAINMAN J. Emerick

70-123

CORAL HILLS

ROAD NO. Co. 247
NAME "R" ST.
SHEET NO. 1 OF 1
DATE 11/10/67
COUNTY PRINCE GEORGES

Unassigned
Now Co 247

SOUTH AVE
CO 179

H
61ST AVE
CO 246

H
61ST PL
CO 207

H
62ND AVE.
OP 1341

H
62ND AVE
OP 1341

H
62ND AVE
CO 1473

20'G
2-7'D
SHLDS
24'C to C

LITE
E-S-D
SHLDS

5-8-69
10-12-73

Form 6 HPS (Rev. 1961)

MAP 7

OP591

Map 1

ROAD INVENTORY SHEET

FAU

Party Chief E.S.
Recorder W.D
Chairman

FORESTVILLE

Road No. Co 262
Name CROSS ST
Sheet No. 1 OF 1
Date 10-17-68
County PRINCE GEO

VER

634-368
835-~~207~~ M&S 69-164 9-14-77

ROAD	0	38	END
CO 264			
SPRING ST	0	34	
CO 263			
PUMPKIN	0	27	DIP
CO 742			
PINE ST	0	20	
	0	15	
	0	15 13	
	0	04	57 TOWN HOUSES
	0	01	
ROAD	0	00	END

Form 6 HPS (Rev. 1961)

~~MAP 3~~ MAP 6

ROAD INVENTORY SHEET

FAU

~~OP 592~~ WILL ST

PARTY CHIEF Edward Schuyler

RECORDER Henry Gorman

CHAINMAN J. EMERICK

Ver 10-4-77

Conrad Hills

ROAD NO. CO. 266

NAME ~~W. ST~~

SHEET NO. 1 OF 2

DATE 11/13/67

COUNTY PRINCE GEORGES

Name/ch Eff 1-24-71

M-136

~~MD 377~~

OP 592 UNASSIGNED NOW CO 4629

Nova ~~RD~~ AVE

~~CO~~ C 24 372 84-58

Billings ~~RD~~ ~~AVE~~ Ave

~~CO~~ C 18 260

Arcadia ~~RD~~ AVE

~~CO~~ C 24 379

OP 635

C 01 SERVICE RD. ~~CONN~~

Md. SOUTHERN AVE. LINE

D.C. LINE

Reassigned 2/17/71 GJG
Previous OP 593 Now Co 270 (69-160)

Wash. Urban

SHA 51.3 - 8 Revised
4.83

MARYLAND STATE HIGHWAY ADMINISTRATION

ROAD INVENTORY SHEET

Party Chief E. Schuyler
Recorder A. Gorman
Assistant Rewritten 6/20/94 KJP
Map No./Dir. F11B / W
State Coordinates 835-428

Road No. OP 593
Road Name Court 22 (Research Rd)
County Prince George's
Date 5/19/67
Sheet No. 1 OF 1

TRAFFIC CODES
TRAFFIC CONTROLS: STOP SIGN=SS, TRAFFIC LIGHT=T.L., FLASHING RED BALL=F.R.

TRAFFIC CODES
PARKING RESTRICTIONS: A.M. PEAK, P.M. PEAK, A.M./P.M. PEAK, NO PARKING ANYTIME=N.P., COMM/IND. ACCESS=E

SYSTEM				TRAFFIC		GREENBELT LINE DIAGRAM	TRAFFIC			PAVEMENT DATA
FED. AID.	FUNCT. CLASS.	HWY. SYS.	HPMS SAMPLE	PRKG. REST.	COM/IND. ACCESS		CONTROL	COM/IND. ACCESS	PRKG. REST.	
						Road end 003				
										58' F
										Curb. RT.
										58' CW
						Research RD				
						Mile 000 0430 @.37				
						Court 571 20				
						Court 22				

SYSTEM				TRAFFIC		LINE DIAGRAM	TRAFFIC				PAVEMENT DATA
FED. AID.	FUNCT. CLASS.	HWY. SYS.	HPMS SAMPLE	PRK.G. REST.	COM/IND ACCESS		CONTROL	COM/IND ACCESS	PRK.G. REST.		

Form 6 HPS (Rev. 1961)

MAP 6 Ver 10-3-77 NOVA AVE OP 597

ROAD INVENTORY SHEET

PARTY CHIEF Edward Schuyler
RECORDER Henry Gorman
CHAINMAN J. E Meplet

Blvd
HG 75

817-376 M35

ROAD NO. C0272
NAME ~~52ND AVE~~ BLVD
SHEET NO. 5 5
DATE 11 5 '76
COUNTY PRINCE GEORGES

ROAD END. ~~X-X-X~~ BARRICADE

1 24

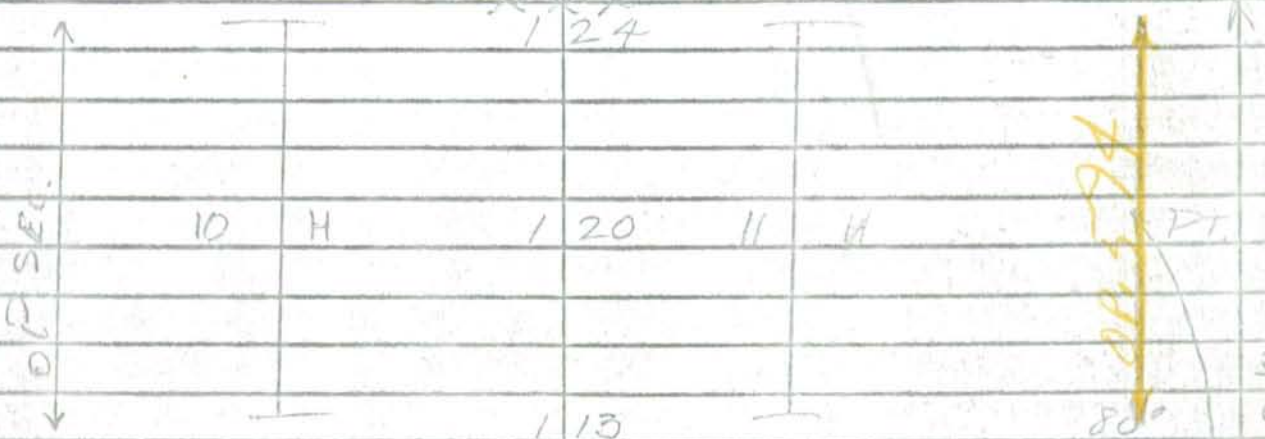

ELLIS ST

CO 271

SAME

Form 6 HPS (Rev. 1961)

~~MAP 3~~ MAP 6 OP595

ROAD INVENTORY SHEET

FAU

PARTY CHIEF Edward Schuyler
RECORDER Henry Gorman
CHAINMAN S. E. MERRICK

ROAD NO. CO275
NAME BALTIMORE AVE
SHEET NO. 1
DATE 11/14/67
COUNTY PRINCE GEORGES

Ver 10-4-71

BLDG HGTS.

818 - 376 M-35

V ST		V ST	
CO	0	ST	12 ST
3 I H	C	20	2 I H
	C	17	
'W' ST		'W' ST	
CO	0	16	266
3 I H	0	15	H
	0	13	H
ALTON		ST.	
CO.	0	12	32
H	0	11	H
H	0	10	
	0	08	H
BYERS		ST	
CO	0	01	263
3 I H	0	06	
	0	04	1
	0	03	CITUS PL.
H	0	01	
CLOCK		ST.	
CO	0	00	777

PT C.C. 45° PC

Map 3

ROAD INVENTORY SHEET

FAU

OP596

SHELL ST.

PARTY CHIEF Edward Schuyler
RECORDER Henry Gorman
CHAINMAN J. Emerick

ROAD NO. CO. 277
NAME ~~2 STREET~~
SHEET NO. 1 OF 1
DATE 11/13/67
COUNTY PRINCE GEORGES

Name/Ch (Eff 1-24-71) Ver 10-4-71

CARROLL HILLS. G11B

819-377 ~~A-36~~

John Eager Howard ROAD
~~SCHOOL WELL MISTA~~
Elem. School

END ~~CAR STREET~~
CO 278

36
35
30
29
SAND AVE.
CO. 028 BK
27
19
51ST AVE
CO. 018
16
10
49TH AVE.
CO 009 377
008
007
MD SOUTHERN AVE LINE
ARLEX 1/1 LIMITS OF D.C.

12 H
10 H
8 H
S H
S H
7 H

Form 6 HPS (Rev. 1961)

MAP 3"

ROAD INVENTORY SHEET

FAU

08597

RAIL ST

PARTY CHIEF Edward Schuyler
RECORDER Henry Gorman
CHAINMAN J. Sutrich

ROAD NO. CO. 278
NAME ~~B.S.~~ OF
SHEET NO. 1 OF 4
DATE 11/13/67
COUNTY PRINCE GEORGES

Name/Ch Ver. CARROLL HILLS.
Ext 1-24-71 10-4-77
8/9-377 M-35

PULL

	ROAD	END
	C	32
	C	31
	52ND	AVE
	CO	C 29 278
H	C	28 H
	C	24
H	C	22 1 H
	D	20
	51ST	AVE
	CO.	C 18 307
7 H	C	17 5 H
	C	11
	49TH	AVE.
	CO.	C 10. 379
	C	09
8 H		5 H
	C	01
MD.	SOUTH RD	RUC. LINE
		0+00

Form 6 HPS (Rev. 1961)

MAP 3

ROAD INVENTORY SHEET

FAU

0P598

Edgewick Ave

PARTY CHIEF Edward Schuyler

RECORDER Henry Gorman

CHAINMAN Frederick

ROAD NO. CO 282

NAME ~~Sand Mine~~

SHEET NO. 1 OF 1

DATE 11/3/67

COUNTY PRINCE GEORGES

Ver 10-4-77

~~MABS~~ CARROLL HILLS. G11B

820-378 ~~A-35~~

DRIVE WAY

23

22 H

0P598

2 0 RST

SAND MINE

CO 282

19

SST

16 CO 282

12 H

S

13 H

PHPD RD.

11 CO 283

09 H

07

PST

PST

CO 531

HARRISONBURG STORE.

01

MANCHESTER

PIKE

01

PRINCE GEORGES COUNTY

OP 599

SEE INVENTORY OF

CO 283

OMAHA ST

99-87 CO

Form 6 HPS (Rev. 1961)

~~MAPS~~ 6

ROAD INVENTORY SHEET

FAU

OP600

Lorton Ave

PARTY CHIEF Edward Schuyler
RECORDER Henry Gorman
CHAINMAN J. ENERGY

ROAD NO. C0.288
NAME [illegible]
SHEET NO. 1 OF 1
DATE 7/67
COUNTY PRINCE GEORGES
821 - 377 ~~A-95~~

Ver 10-4-77

Name Change

FORM HLS G11B

POND END

C09

C08

C07

C06

C05

R ST

C03

270

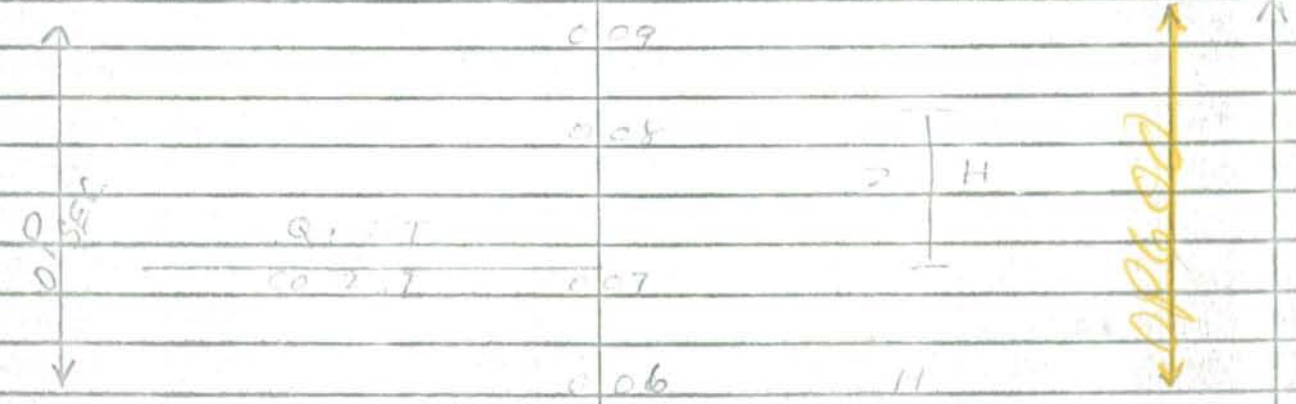

POND END.

Form 6 HPS (Rev. 1961)

MAP 4

08601

ROAD INVENTORY SHEET

Party Chief F. SCHUYLER

Recorder H. GORMAN

Chainman

FID

Road No. Co 299

Name AUTUMN AVE.

Sheet No. 2 OF 2

Date 8/10/67

County PRINCE GEORGES

830-412 M31

ROAD END.

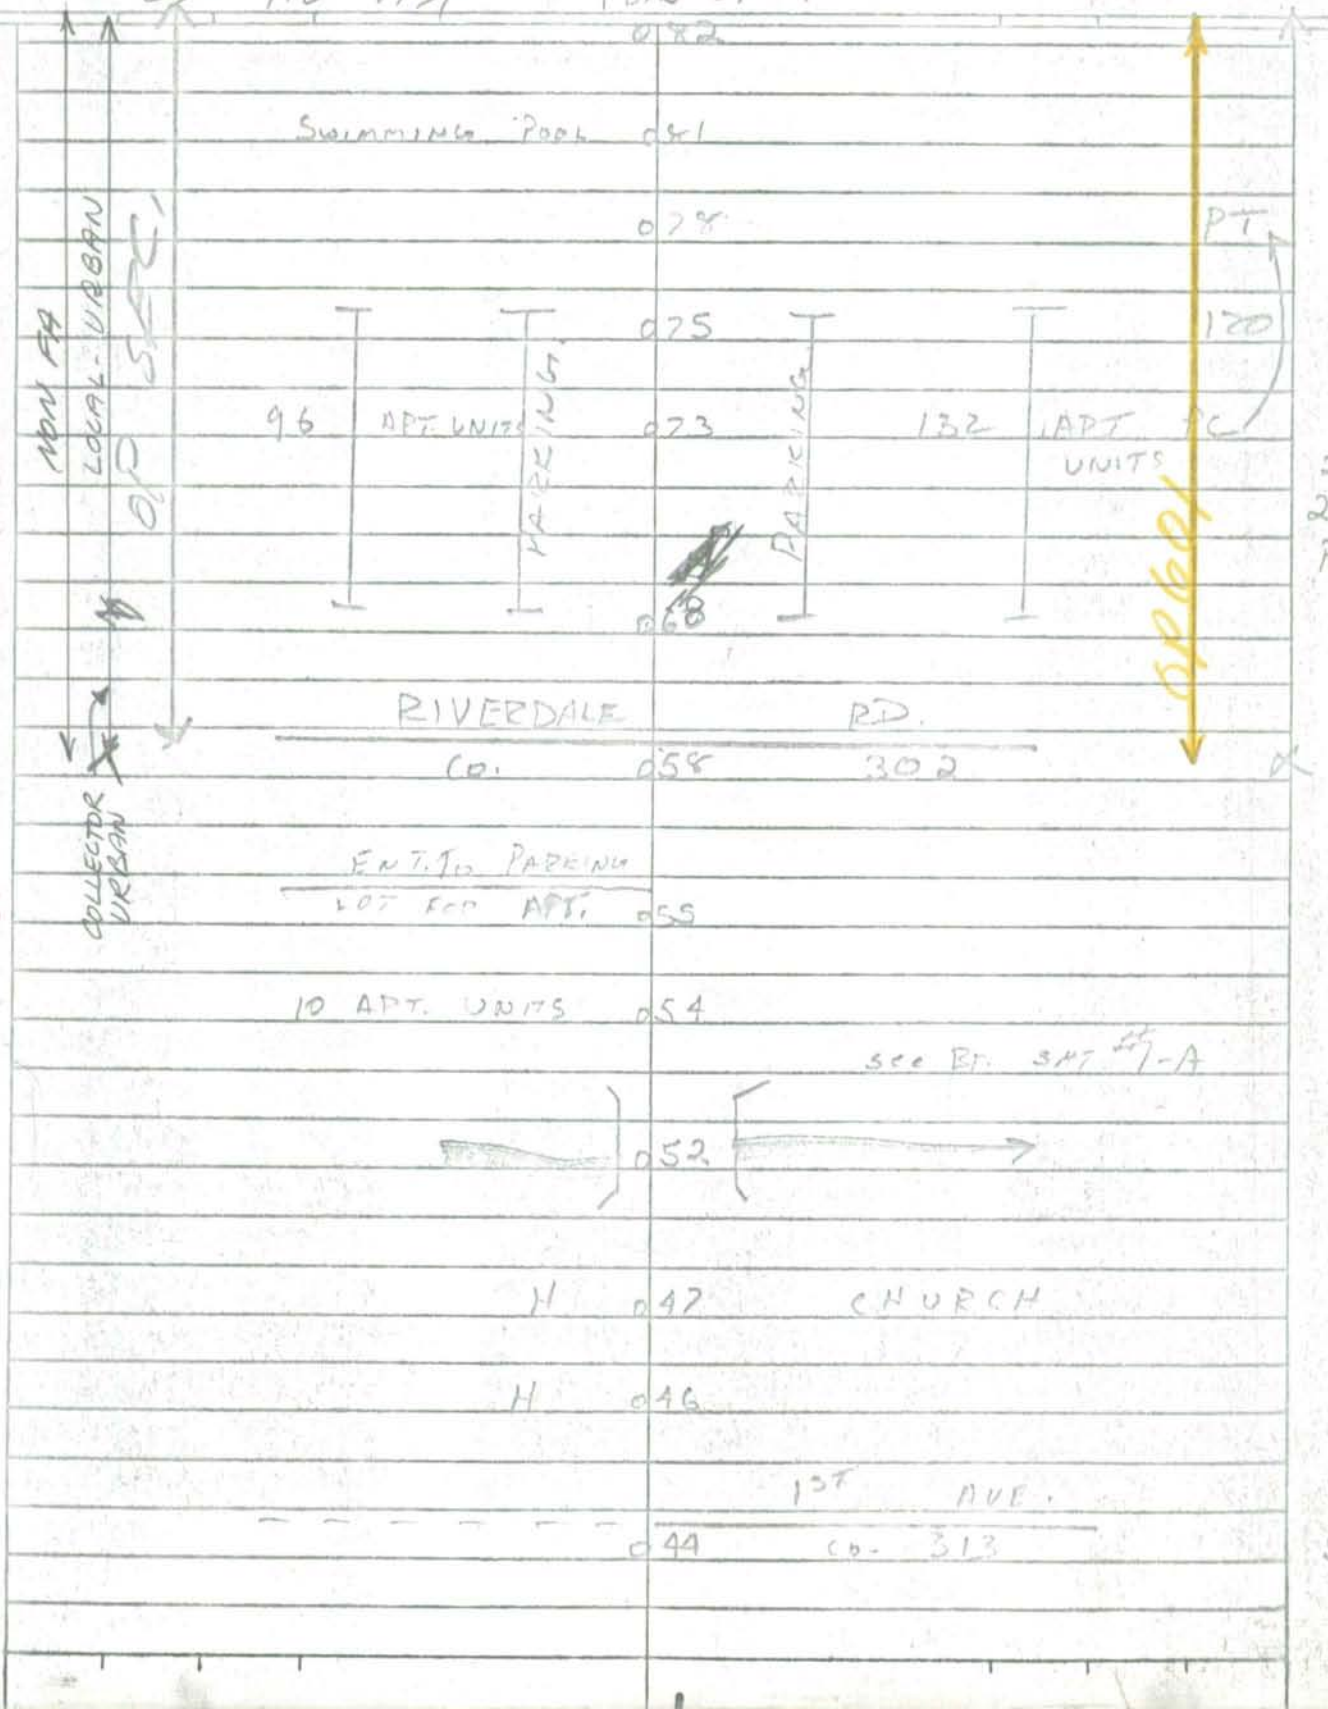

Reassigned 2-17-71 6/6

Form 6 HPS (Rev. 1961) (Previous OP602 Now to 306 68-73)

Urban

ROAD INVENTORY SHEET

Party Chief E. Schuyler
Recorder H. GORMAN
Chainman

GREENBELT

VER 5-17-78

F113

Road No. OP 602
Name COURT 3-Ridge Rd.
Sheet No. 1 OF 1
Date 5/24/67
County PRINCE GEORGES'

833-426

Not PULL 4-8-80

ROAD END

60'

N

56' F
56' C-W

RIDGE RD.

MUN 000 0440

@ 2.57 (?)

Court to 295

Form 6 HPS (Rev. 1961)

MAP 2" MAP 4

~~of 603~~

ROAD INVENTORY SHEET

FAU

Party Chief E. Schoyer

Recorder H. Cochran

Chainman

Road No. ~~Co.~~ 313

Name 1ST AVE.

Sheet No. 1 of 1

Date 8-4-10/67

County PRINCE GEORGES'

829-413 M-31

PULL

OK

ROAD END.

027

ABAN

ROAD 012 ENDH

010 H

H 002

AUBURN AVE.

CO. 000 299

Co 324 1

70-39

12' E

18' C-W

26' I

C-C

SHA 51.3-8
11-15-72

STATE HIGHWAY ADMINISTRATION OF MARYLAND

FAU

ROAD INVENTORY SHEET

O.P. 604

Party Chief R. Bush (OFFICE IND)
Recorder
Helper

Road No. Co 322
Road Name CARTERS Rd
Sheet No. 1 OF 2
Date 8-21-67 REVISED 5-13-74
County PR. GEO
State Coordinates 822 - 407

Map No. M31
INDEX 3 VER 4-7-78

UNASSIGNED

57th AVE
Co 674

0 51 — 36'I Curb Jct

NOW

0 44 — X

58th AVE
Co ~~67I~~ 3680

0 42 — 30'I 2'D Sh Rt CURB Lt

85-20

0 40 — X

59th AVE
Co 1259

0 35 — 36'I Curb Jct

0 33 — BEG Co. Maint — X — 24I JOB LT 30'C-G 18'E 24'Curb

ENT TO TENTON FLE. SCHOOL

0 28

0 17 — END Co Maint — X

62ND AVE
Co 1579

0 15

22'I 6'F Shld Lt CURB Rt

GREENVALE PKWY
65RD ~~AVE~~
Co 3661

Form 6 HPS (Rev. 1961)

MAP 3

ROAD INVENTORY SHEET

FAU

OP605

MAP 6

PARTY CHIEF Edward Schuyler
RECORDER Henry Gorman
CHAINMAN T. LANDON

ROAD NO. Co. 347
NAME ADDISON RD
SHEET NO. 1 OF 1
DATE 8-31-67
COUNTY PRINCE GEORGES

VER-4-18-78

FHD

819.5-393 M31

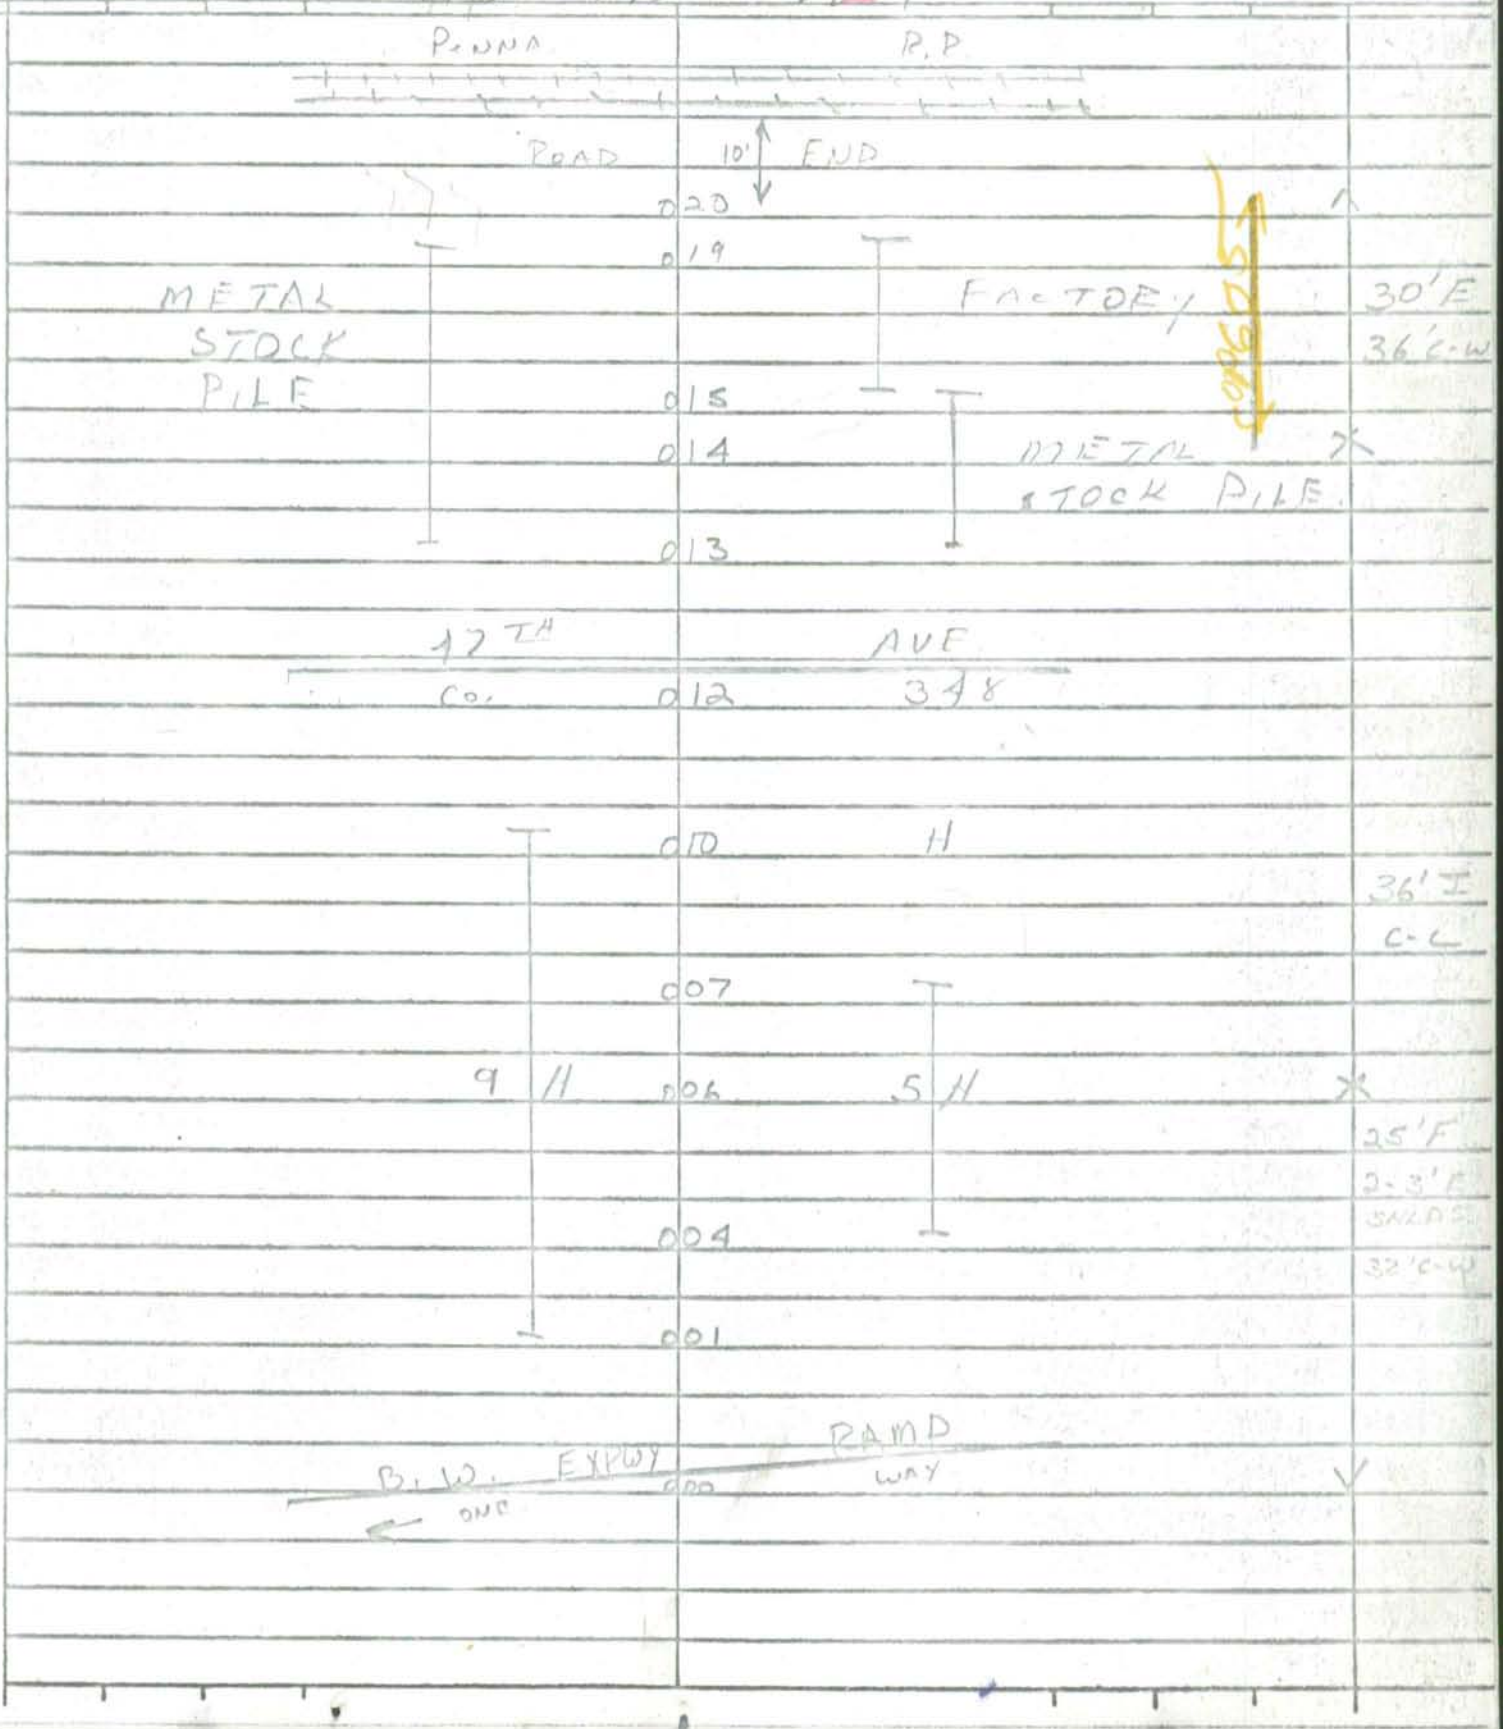

SHA 51.3 - 8 Revised
4.83

MARYLAND STATE HIGHWAY ADMINISTRATION

ROAD INVENTORY SHEET

Party Chief _____
Recorder _____
Assistant _____
Map No./Dir. G11B / SE
State Coordinates 821-380

Road No. OP 606
Road Name Sue La.
County Pr. Georges
Date _____
Sheet No. _____ OF _____

SYSTEM				TRAFFIC		LINE DIAGRAM	TRAFFIC			PAVEMENT DATA
FED. AID.	FUNCT CLASS.	HWY. SYS.	HPMS SAMPLE	PRK.G. REST.	COM/IND. ACCESS		CONTROL	COM/IND. ACCESS	PRK.G. REST.	

SEE INVENTORY OF

Co 4985

89-63

TRAFFIC CODES

TRAFFIC CONTROLS: STOP SIGN=SS, TRAFFIC LIGHT=T.L., FLASHING RED BALL=F.R.

TRAFFIC CODES

PARKING RESTRICTIONS: A.M. PEAK, P.M. PEAK, A.M./P.M. PEAK, NO PARKING ANYTIME=N.P., COMM/IND. ACCESS=E

SYSTEM				TRAFFIC		LINE DIAGRAM	TRAFFIC			PAVEMENT DATA
FED. AID.	FUNCT. CLASS.	HWY. SYS.	HPMS SAMPLE	PRK.G. REST.	COM/IND ACCESS		CONTROL	COM/IND ACCESS	PRK.G. REST.	

Form 6 HPS (Rev. 1961)

Ver MZ DT 9-19-77

OP607

ROAD INVENTORY SHEET

Glacier Ave

PARTY CHIEF Edward Schuyler FAU

RECORDER Henry Gorman

CHAINMAN J. EMERICK

Cap. Hgts.

ROAD NO. Co. 375

NAME ~~Edmonston Ave~~

SHEET NO. 3 OF 3

DATE 11/16/67

COUNTY PRINCE GEORGES

822-381 M35 MAP 3

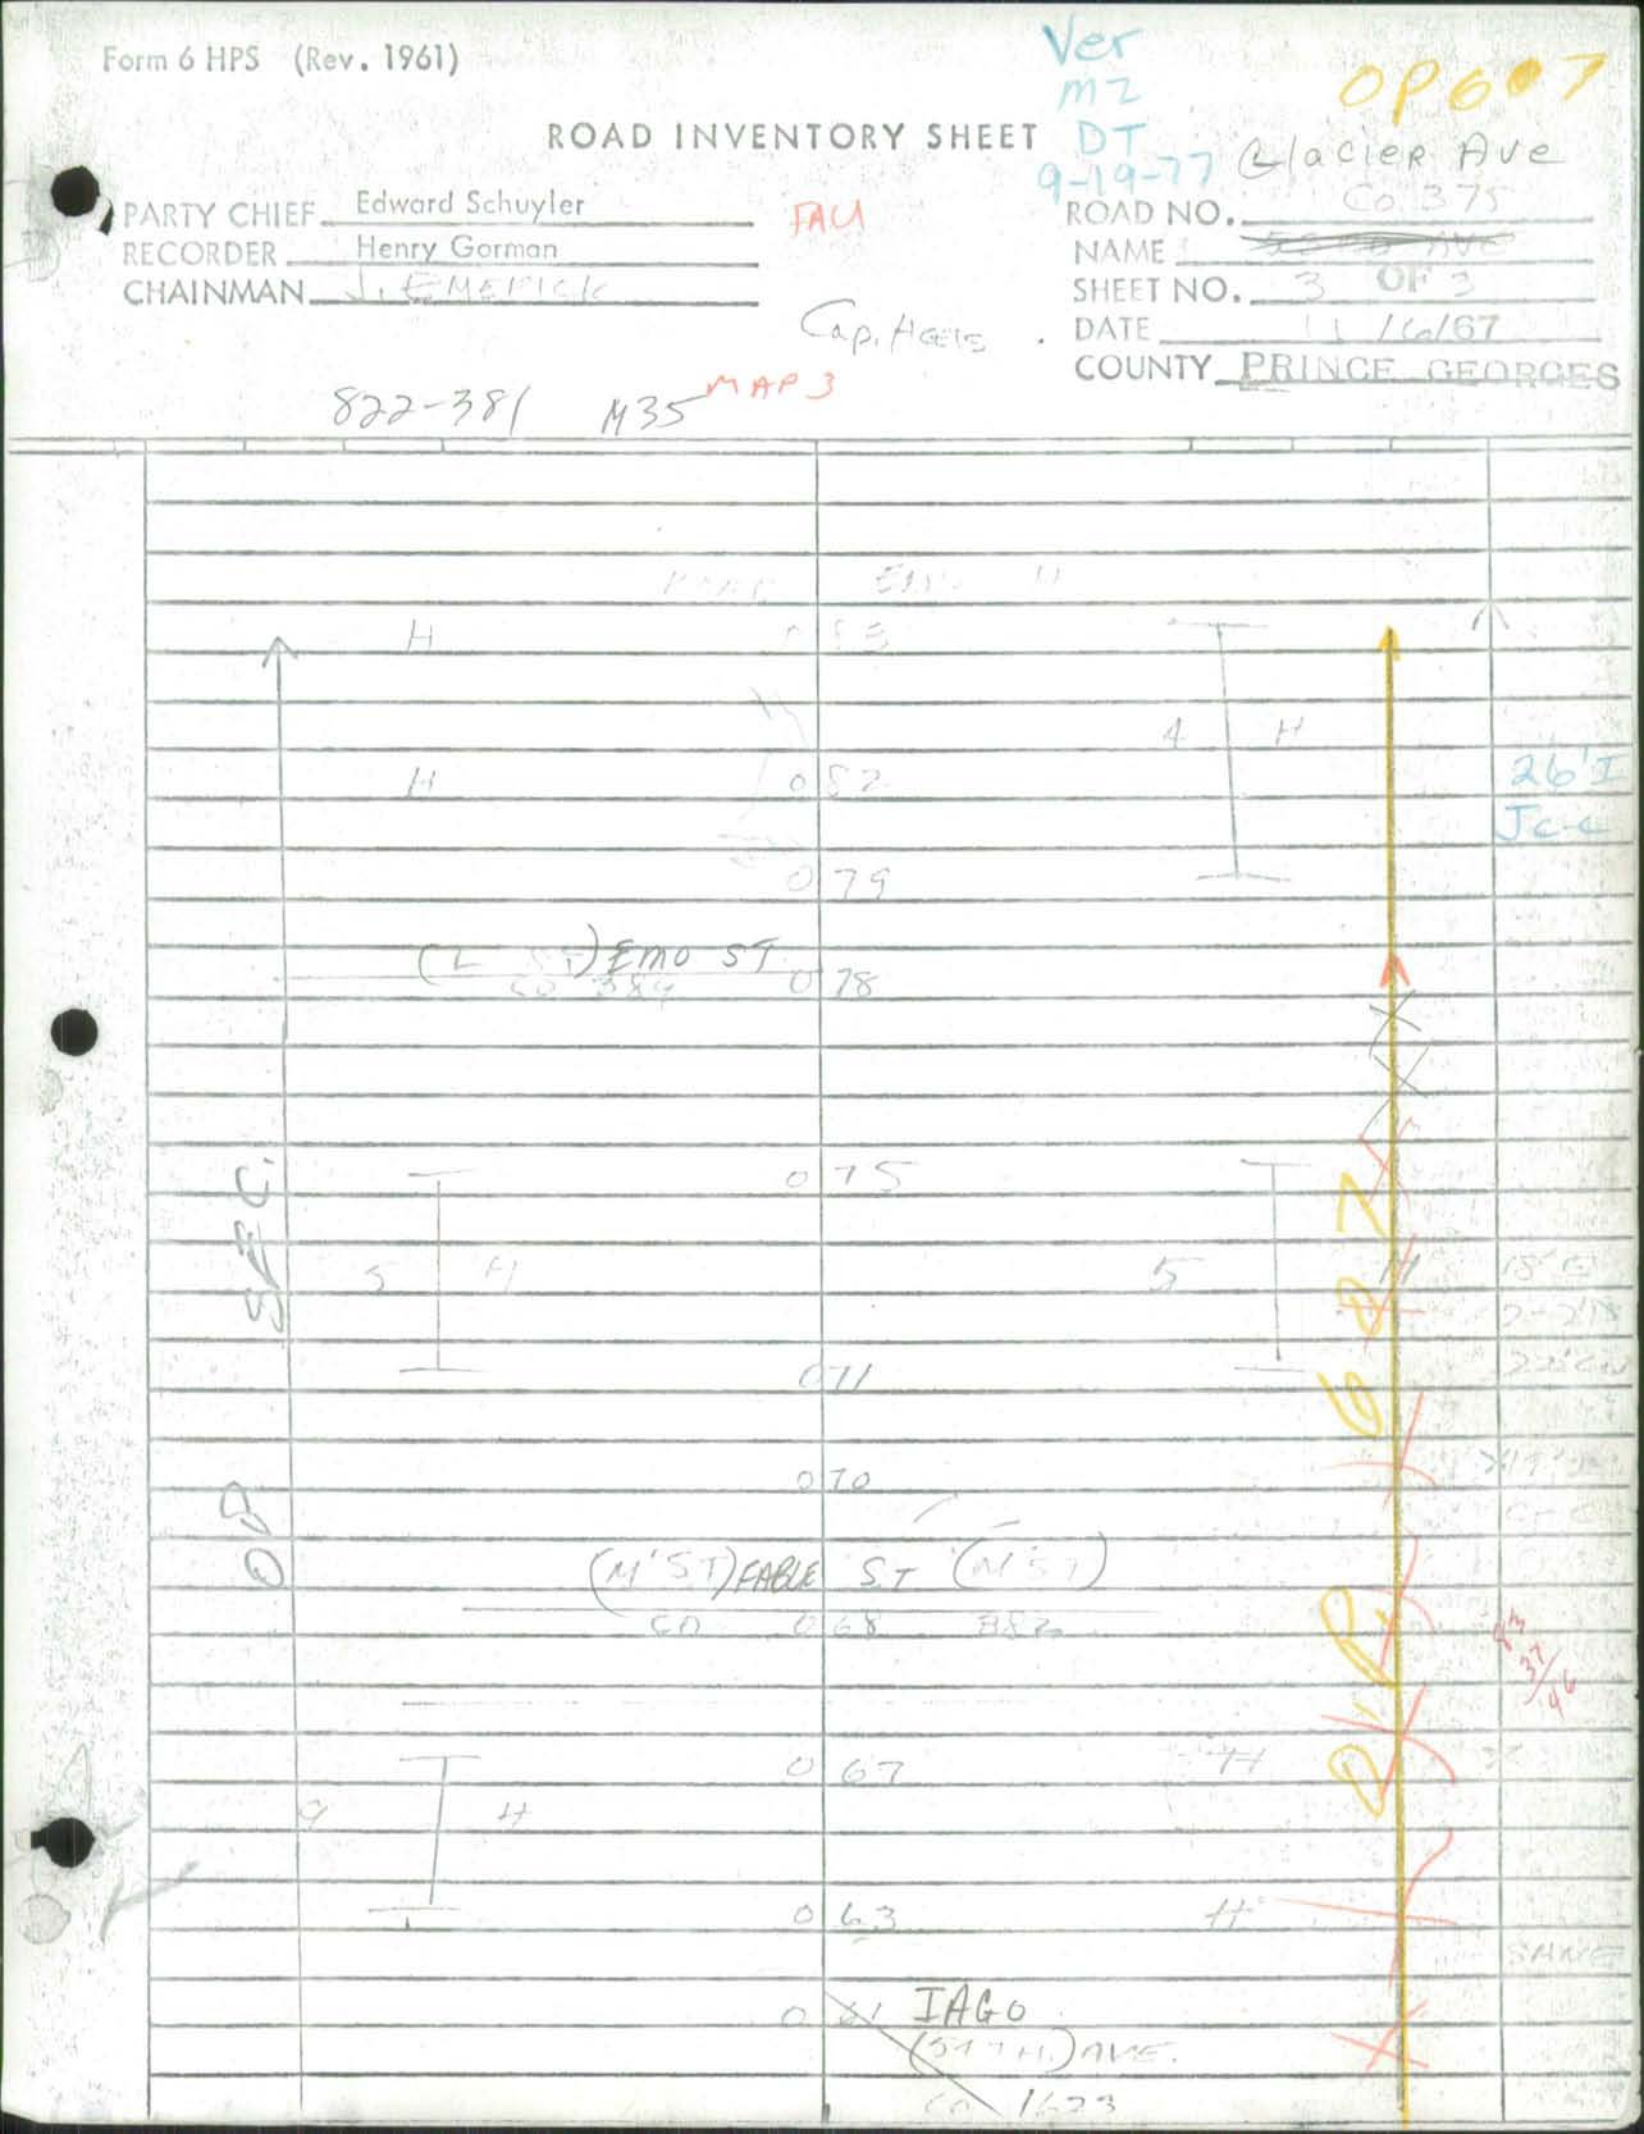

Form 6 HPS (Rev. 1961)

map 3

ROAD INVENTORY SHEET

FAU

Ver MZ DT 9-19-77

OP 608

ABEL AVE

PARTY CHIEF Edward Schuyler
RECORDER Henry Gorman
CHAINMAN J. EMERICK

Cap. Hgts.

ROAD NO. Co. 376
NAME ~~14TH AVE S.E~~
SHEET NO. 1 OF 1
DATE 11/16/67
COUNTY PRINCE GEORGES

62-92
63-2-004-77

820-380 M 35

Rd. Rdwy H

D 16

24 APPROACHES

9 FC

D

C 12

C 11

(0' S-T) HEATH ST (0' S-T) HEATH ST

0' D 39 ST

C 07

H D 06

H 6 04

H C 02 H

BENNING Rd

OP 608

1926-T
JC-C

Form 6 HPS (Rev. 1961)

MAP 6

O.P. 609

ROAD INVENTORY SHEET

Ver 10-3-77

ARCADIA AVE

PARTY CHIEF Edward Schuyler
RECORDER Henry Gorman
CHAINMAN [illegible]

ROAD NO. CO 379
NAME ~~[illegible]~~
SHEET NO. 2 OF 3
DATE 11/14/67
COUNTY PRINCE GEORGES

Blvd Hgts

NAME CHANGE Effective 2-9-70

818 - 717 A-35

SEE CO 379

V ST			
CO			
	0	52	
W. ST		W. ST	
CO.	0	50 266	
	0	48	
H	0	46	H
DETON		ST	
CO.	0	45 32	
	0	44	H
BYER		ST	
CO	0	40 266	
H	0	39	
H	0	37	
LIDKE		ST	
CO	0	36 266	
H	0	35	

0.P. 609

26' E
C-C.

SAME

Form 6 HPS (Rev. 1961)

Reassigned 2-17-71 GJG
(Previous OP 610 Now Co. 1619 69-148)

ROAD INVENTORY SHEET

Urban

Party Chief E. Schuyler
Recorder M. GORMAN
Chairman

VER 5-10-78

GREENBELT.

F11B

Road No. OP 610.
Name COURT 5 - Ridge Rd.
Sheet No. 1 OF 1
Date 5/21/67
County PRINCE GEORGES'

9337 - 425

Do Not PULL

W/ 4-8-80

ROAD END.

NE

001

52' I
CURB ET.
52'C-W

RIDGE RD.

MUN 000 0440 @ 2.51

Form 6 HPS (Rev. 1961)

Reassigned 2-17-71 GJG
(Previous OP611 Now Co. 381 70-121)

ROAD INVENTORY SHEET

Urban ✓

Party Chief E. Schuyler
Recorder H. GORMAN
Chainman

Vell 5-10-78

GREENBELT.

F11B

Road No. OP611
Name COURT 42-Ridge Rd.
Sheet No. 1 OF 1
Date 5/23/67
County PRINCE GEORGES'

837-A27 M-31

RD No 1 ALL

W 4-8-80

ROAD END
002

E

58'F
58'C-W

001

14'F
C-C

RIDGE RD.

MUN 000 044D @1.61

Form 6 HPS (Rev. 1961)

Map 3

ROAD INVENTORY SHEET

FAU Ver MT DT 9-19-77

O.P. 612

FABLE AVE

PARTY CHIEF Edward Schuyler
RECORDER Henry Gorman
CHAINMAN D. ENDICOTT

Cap. Hgts

ROAD NO. ~~C257~~
NAME ~~MAST~~
SHEET NO. 1 OF
DATE 11-1-67
COUNTY PRINCE GEORGES

823-080 M-35

MASS HWY

87-105

LARCHMONT (57TH) AVE

CO 0 18 828

0 17

0 15

mentor (58TH) AVE

CO 0 14 370

NOVA (59TH) AVE

CO 0 09 371

0 06

0 05 36" R.C.P.

0 02

CAPITOL HGTS (61ST) AVE

0 00 (CO 6) 393

23'I
C-C.
16'G
CURB
2'3.1d
19'I
6'E SHD
18'H
26cw

Form 6 HPS (Rev. 1961)

Map 3

ROAD INVENTORY SHEET

FAU

O.P. 613

IAGO ACE

PARTY CHIEF Edward Schuyler

RECORDER Henry Gorman

CHAINMAN S. Emrick

70-120

Cap. Hgts.

ROAD NO. CO 385

NAME ~~5TH AVE~~

SHEET NO. 1 OF 1

DATE 1/16/67

COUNTY PRINCE GEORGES

67-112

Unassigned

Now Co. 385

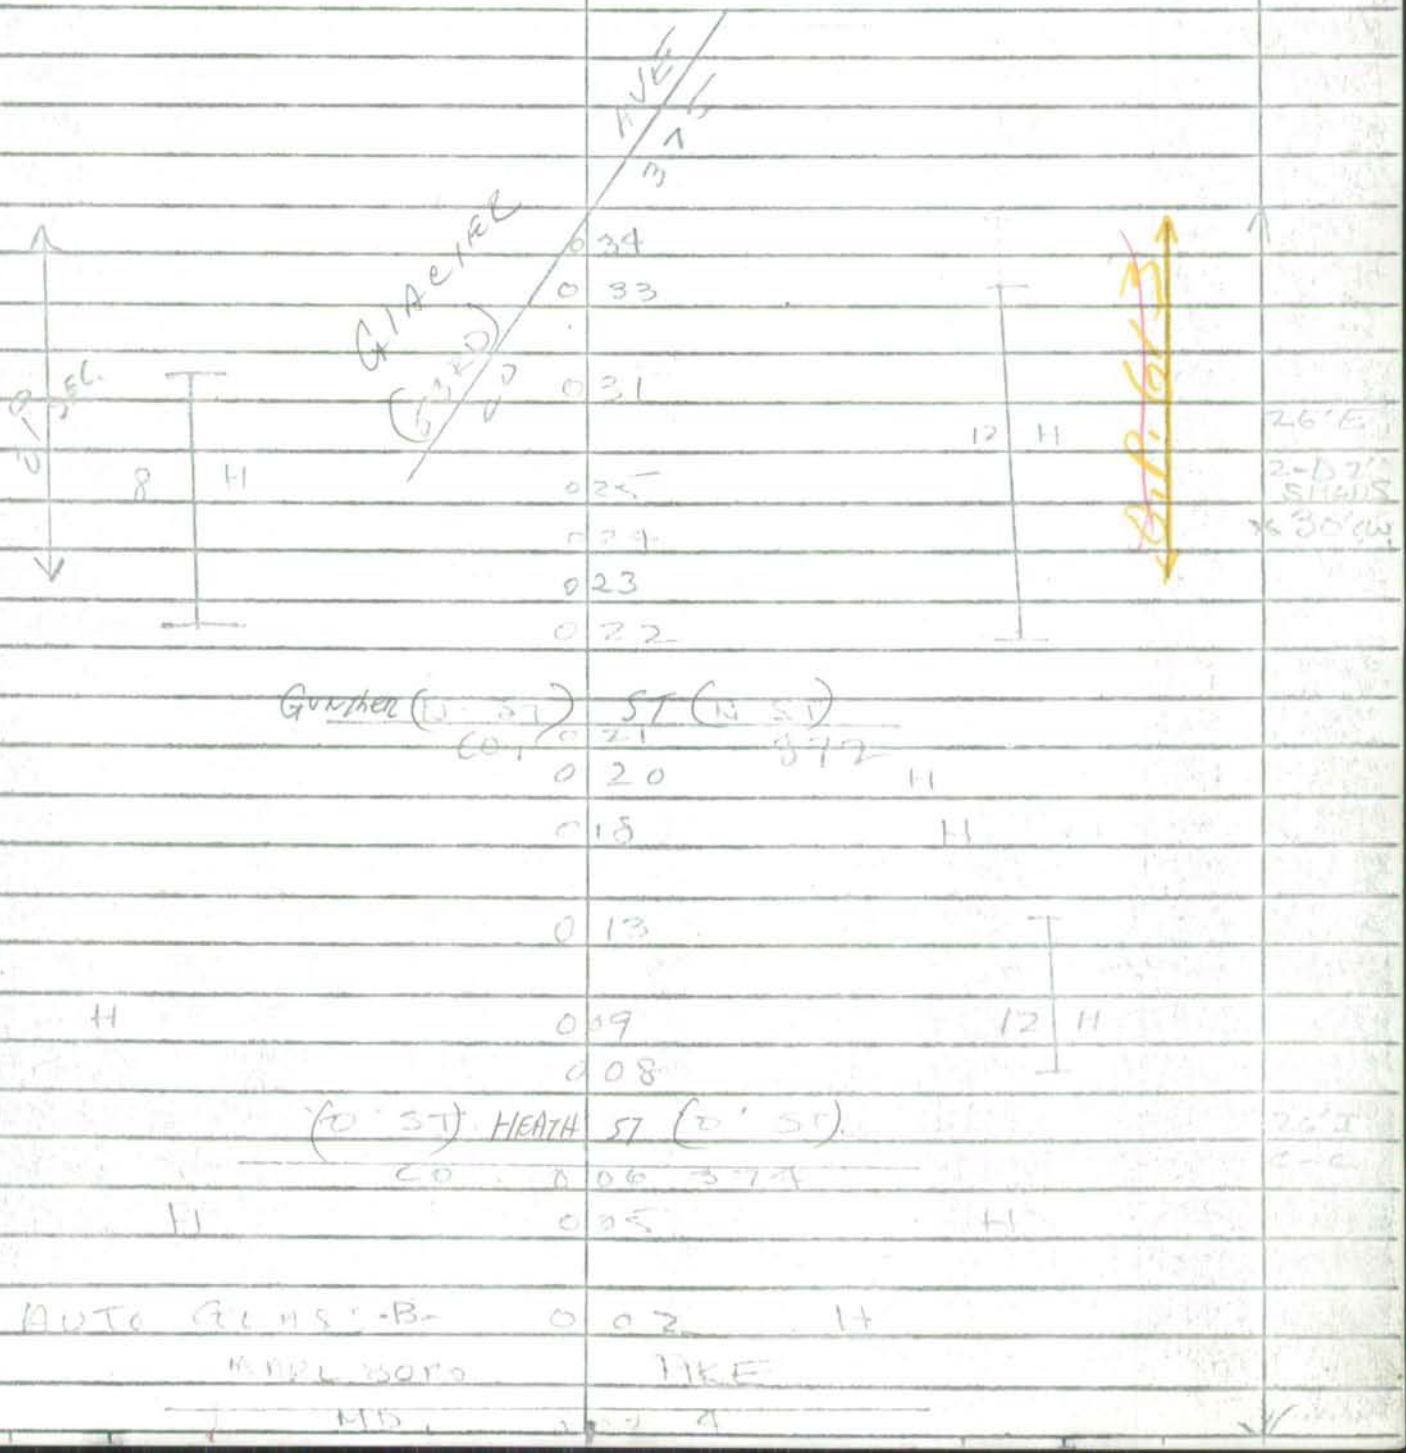

Form 6 HPS (Rev. 1961)

MAP 4

OP 614

ROAD INVENTORY SHEET

Party Chief T. LANDON
Recorder W. WARFIELD
Chainman

Road No. Co. ~~386~~ 3665
Name CRANDALL RD
Sheet No. 3 OF 3
Date 3-30-70
County PRINCE GEORGES

Ver 3-31-78 ~~439~~ 444 – ~~410~~ 408 M 31

		0.78		
	ROAD	~~130~~ END		
		~~126~~	H	
H		~~119~~		
				10'E
		~~116~~	H	12'CMP
		~~113~~ 0.61		*
		~~111~~	H	
H		~~105~~	H	
		~~103~~	H	
H-300'		~~101~~		
				12'F
H		~~100~~		14'CMP
		~~099~~	H	*
		~~096~~	H	
		~~090~~	2-24"CMP	
				SAME

614

OP

Form 6 HPS (Rev. 1961)

Map 3

ROAD INVENTORY SHEET

FAU

O.P. 615

PARTY CHIEF Edward Schuyler
RECORDER Henry Gorman
CHAINMAN J. E. MERICK

Ver 9-27-77

PYLEKLAND

ROAD NO. Co 394
NAME MORAN DR.
SHEET NO. 1 OF 1
DATE 11/29/67
COUNTY PRINCE GEORGES

61-99 827 - 372
827.5 - 372.5 M35

PARKING

OPSPC-

PRINCE GEORGES
SOUTHERN BORDER TRAIL.

B. GAS

MURPHY

AND AVE

18'G
2-4'A shlds
26'CW

18'I
2-4'A shlds
26'CW

MD.

972-19

Form 6 HPS (Rev. 1961)

T. LANDON

ROAD INVENTORY SHEET

VERIFIED 12/14/77

Party Chief E.S.
Recorder W.D
Chainman

MORNINGSIDE

Road No. OP 616 229 0120
Name MARIANNE DR
Sheet No. 1 OF 1
Date 11-6-68
County PRINCE GEO

(G11D) 832-362 ~~M35D~~ 75-8 76-11

DOUGLASS E. PATTERSON REC. A CENTER

PARKING LOT

ROAD 031 END

030 PLAYGROUND

T 30° 027

~~APPX CORP LINE~~ 025 ~~OF MORNINGSIDE~~

E

BEAU-FORD 019 RD

PT 011

MORGAN RD 009

35°

PC (MARIANNE CT) 006

NE

APPROX CORP LINE OF MORNINGSIDE

CO 81

SUITLAND 000 RD

P

19'I
19'CW
~~16'I~~
~~E-3'E SHO~~
24'CW

75-8
20'E C-G

74-8
20'E C-G

3CI
JCC
20'I
C-G

SHA 51.3-8
11-15-72

STATE HIGHWAY ADMINISTRATION OF MARYLAND

ROAD INVENTORY SHEET

Party Chief J EINOLF
Recorder (OFFICE)
Helper

Map No. 31

Road No. ~~OP 617~~
Road Name PRESLEY LA
Sheet No. 1 of 1
Date 9-11-67 (9-18-78)
County PRINCE GEORGES
State Coordinates 827-410

UNASSIGNED
part
NOW of CO 407

89- 10

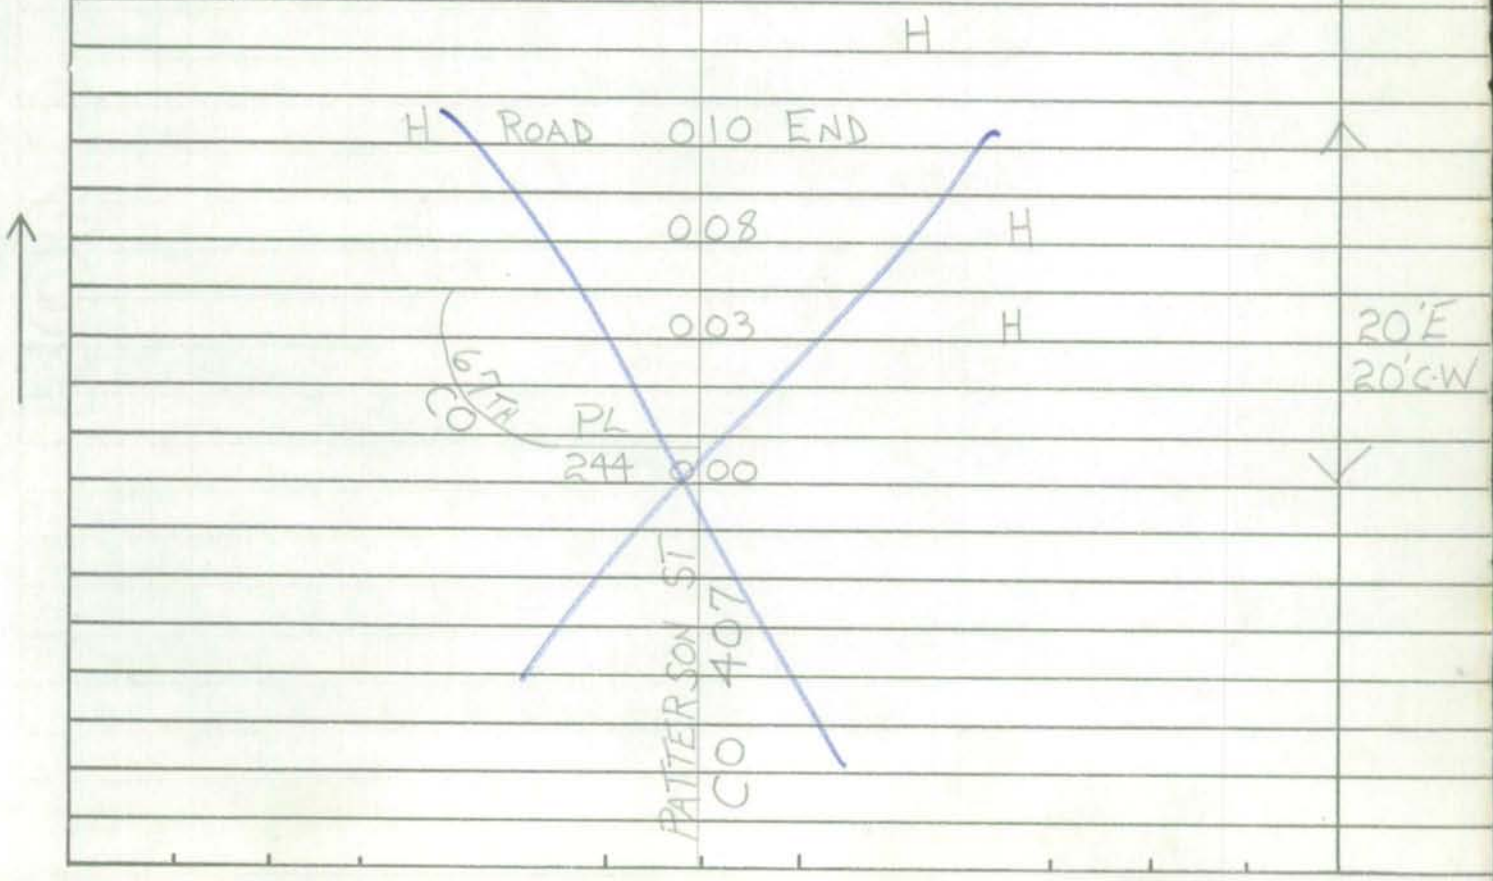

SHA 51.3-8
11-15-72

ROAD INVENTORY SHEET

Road No. _____
Road Name _____
Sheet No. _____
Date _____
County _____
State Coordinates _____

Form 6 HPS (Rev. 1961)

~~RCT 2~~

O.P. 618

ROAD INVENTORY SHEET

FIID

FAU

PARTY CHIEF Edward Schuyler
RECORDER Henry Gorman
CHAINMAN

ROAD NO. Co. 408
NAME 67TH AVE.
SHEET NO. 2 OF 3
DATE 9/11/67
COUNTY PRINCE GEORGES

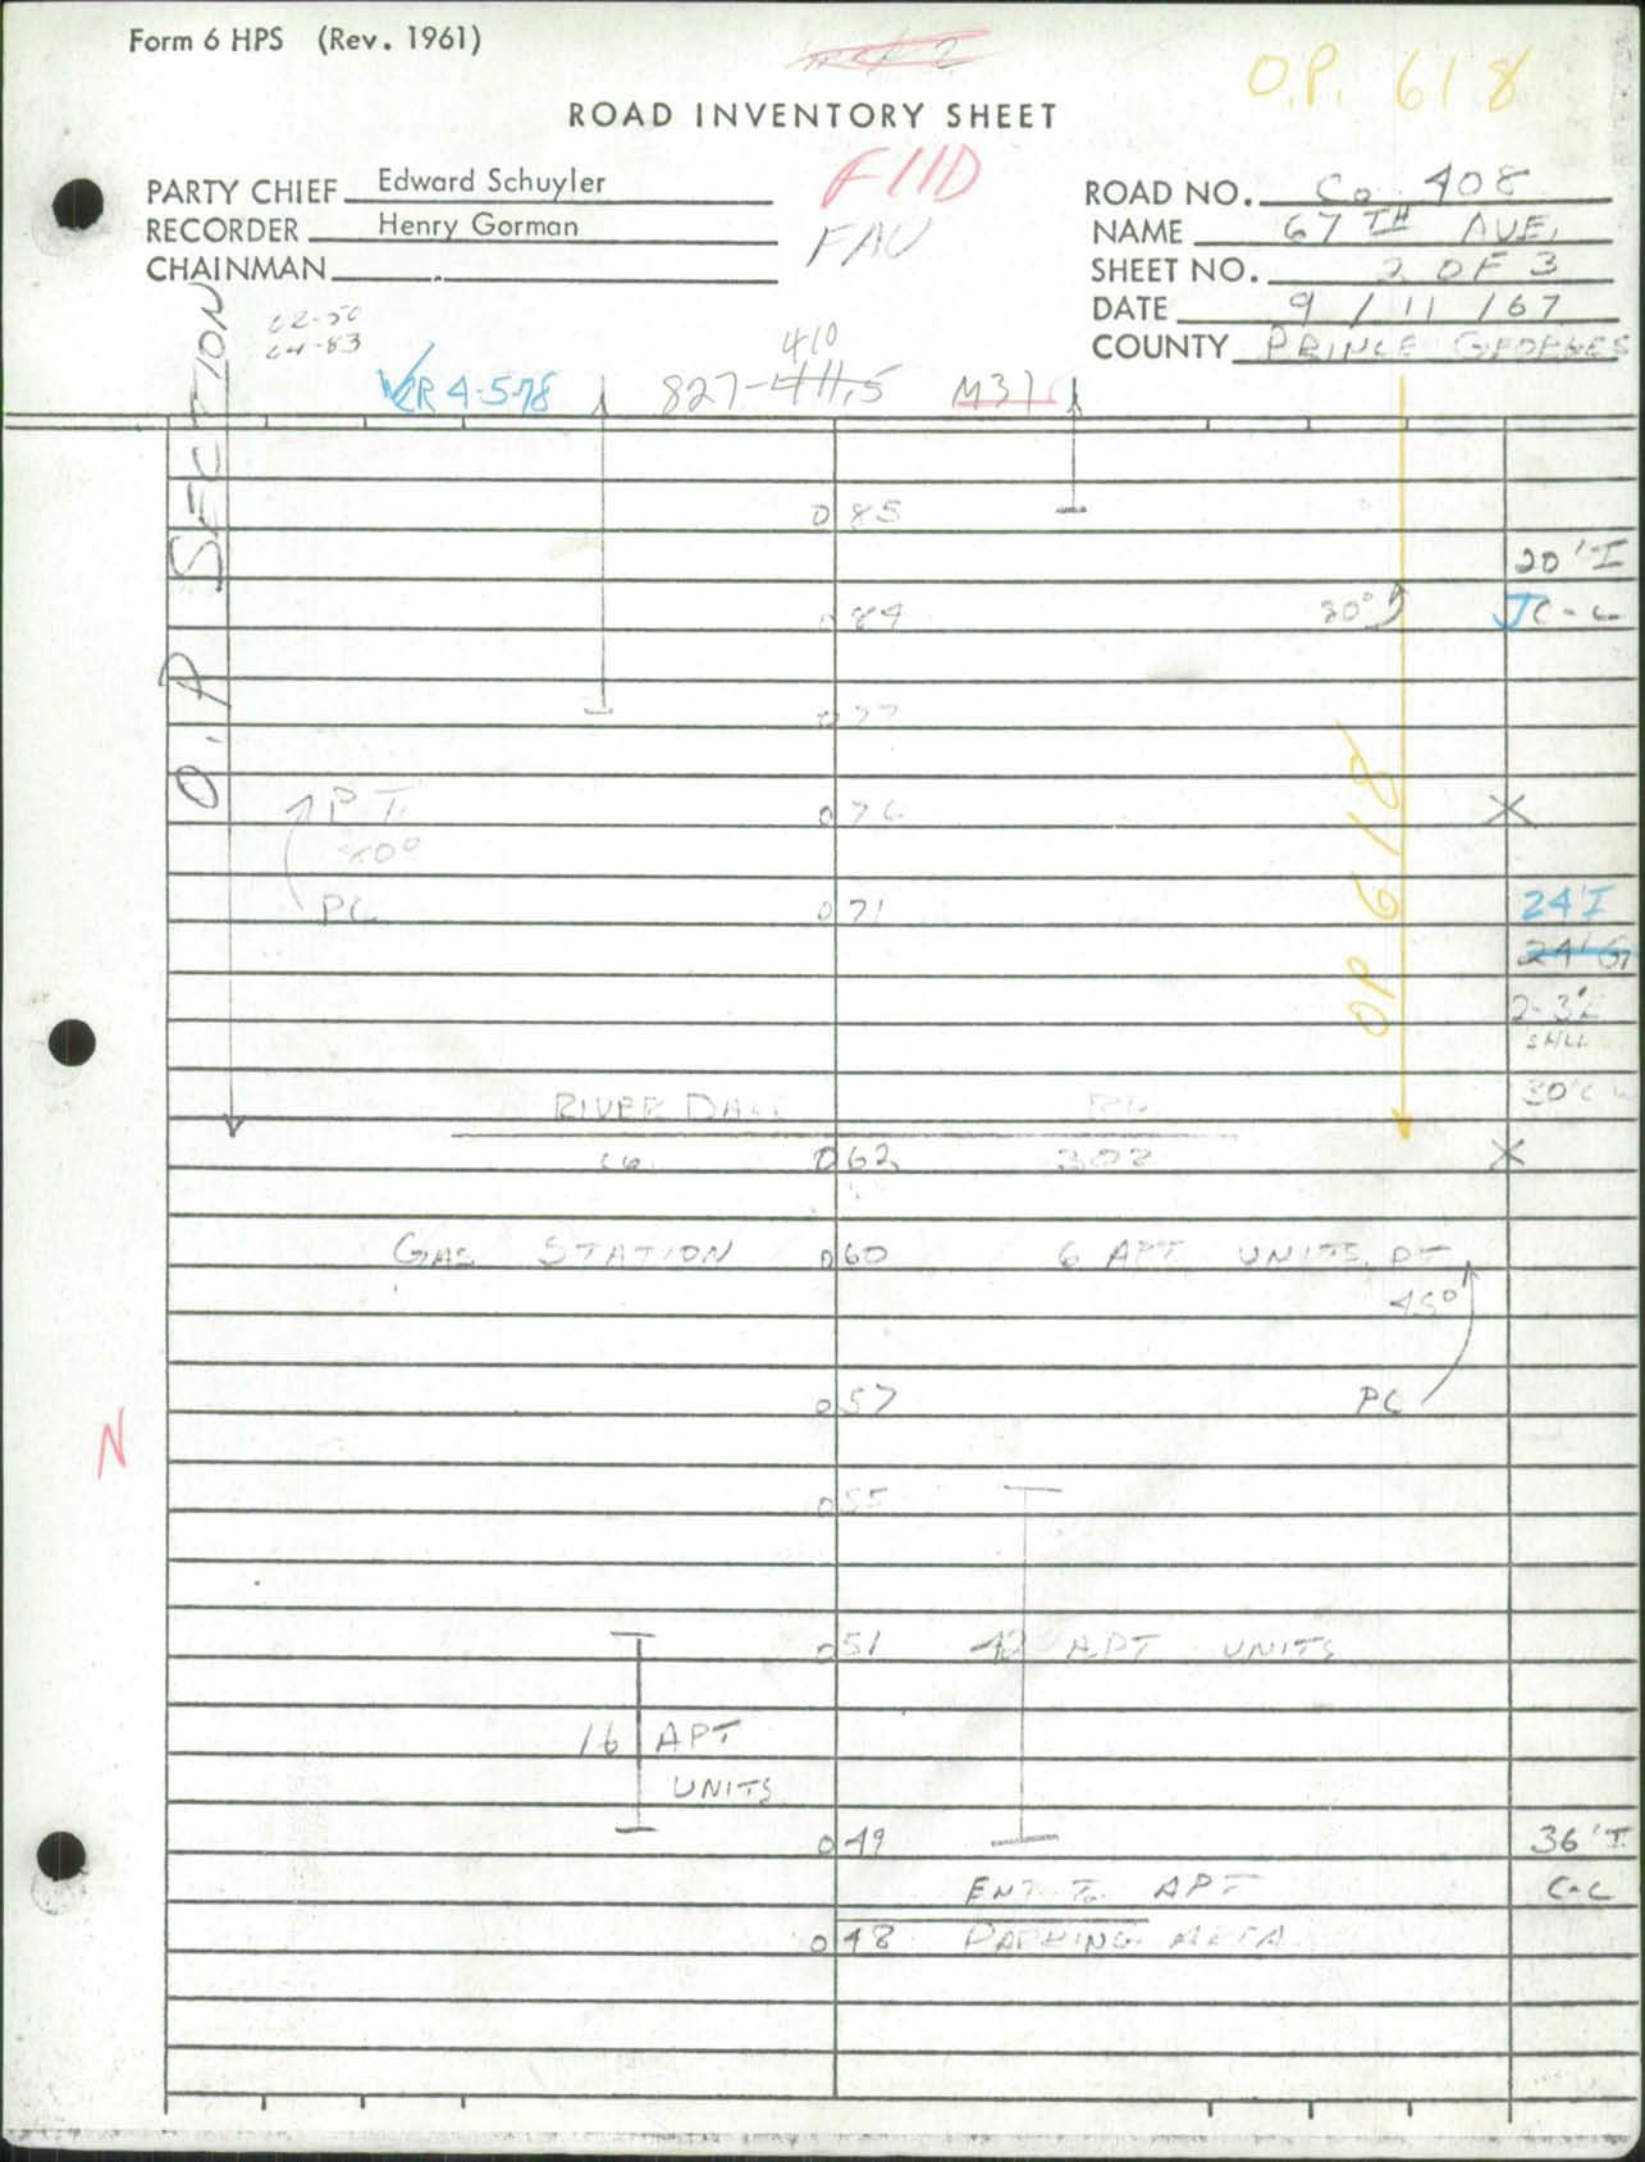

Form 6 HPS (Rev. 1961)

MAP 4

O.P. 618

ROAD INVENTORY SHEET

PARTY CHIEF Edward Schuyler
RECORDER Henry Gorman
CHAINMAN

NAME 67TH AVE.
SHEET NO. 2 OF 3
DATE 9/11/67

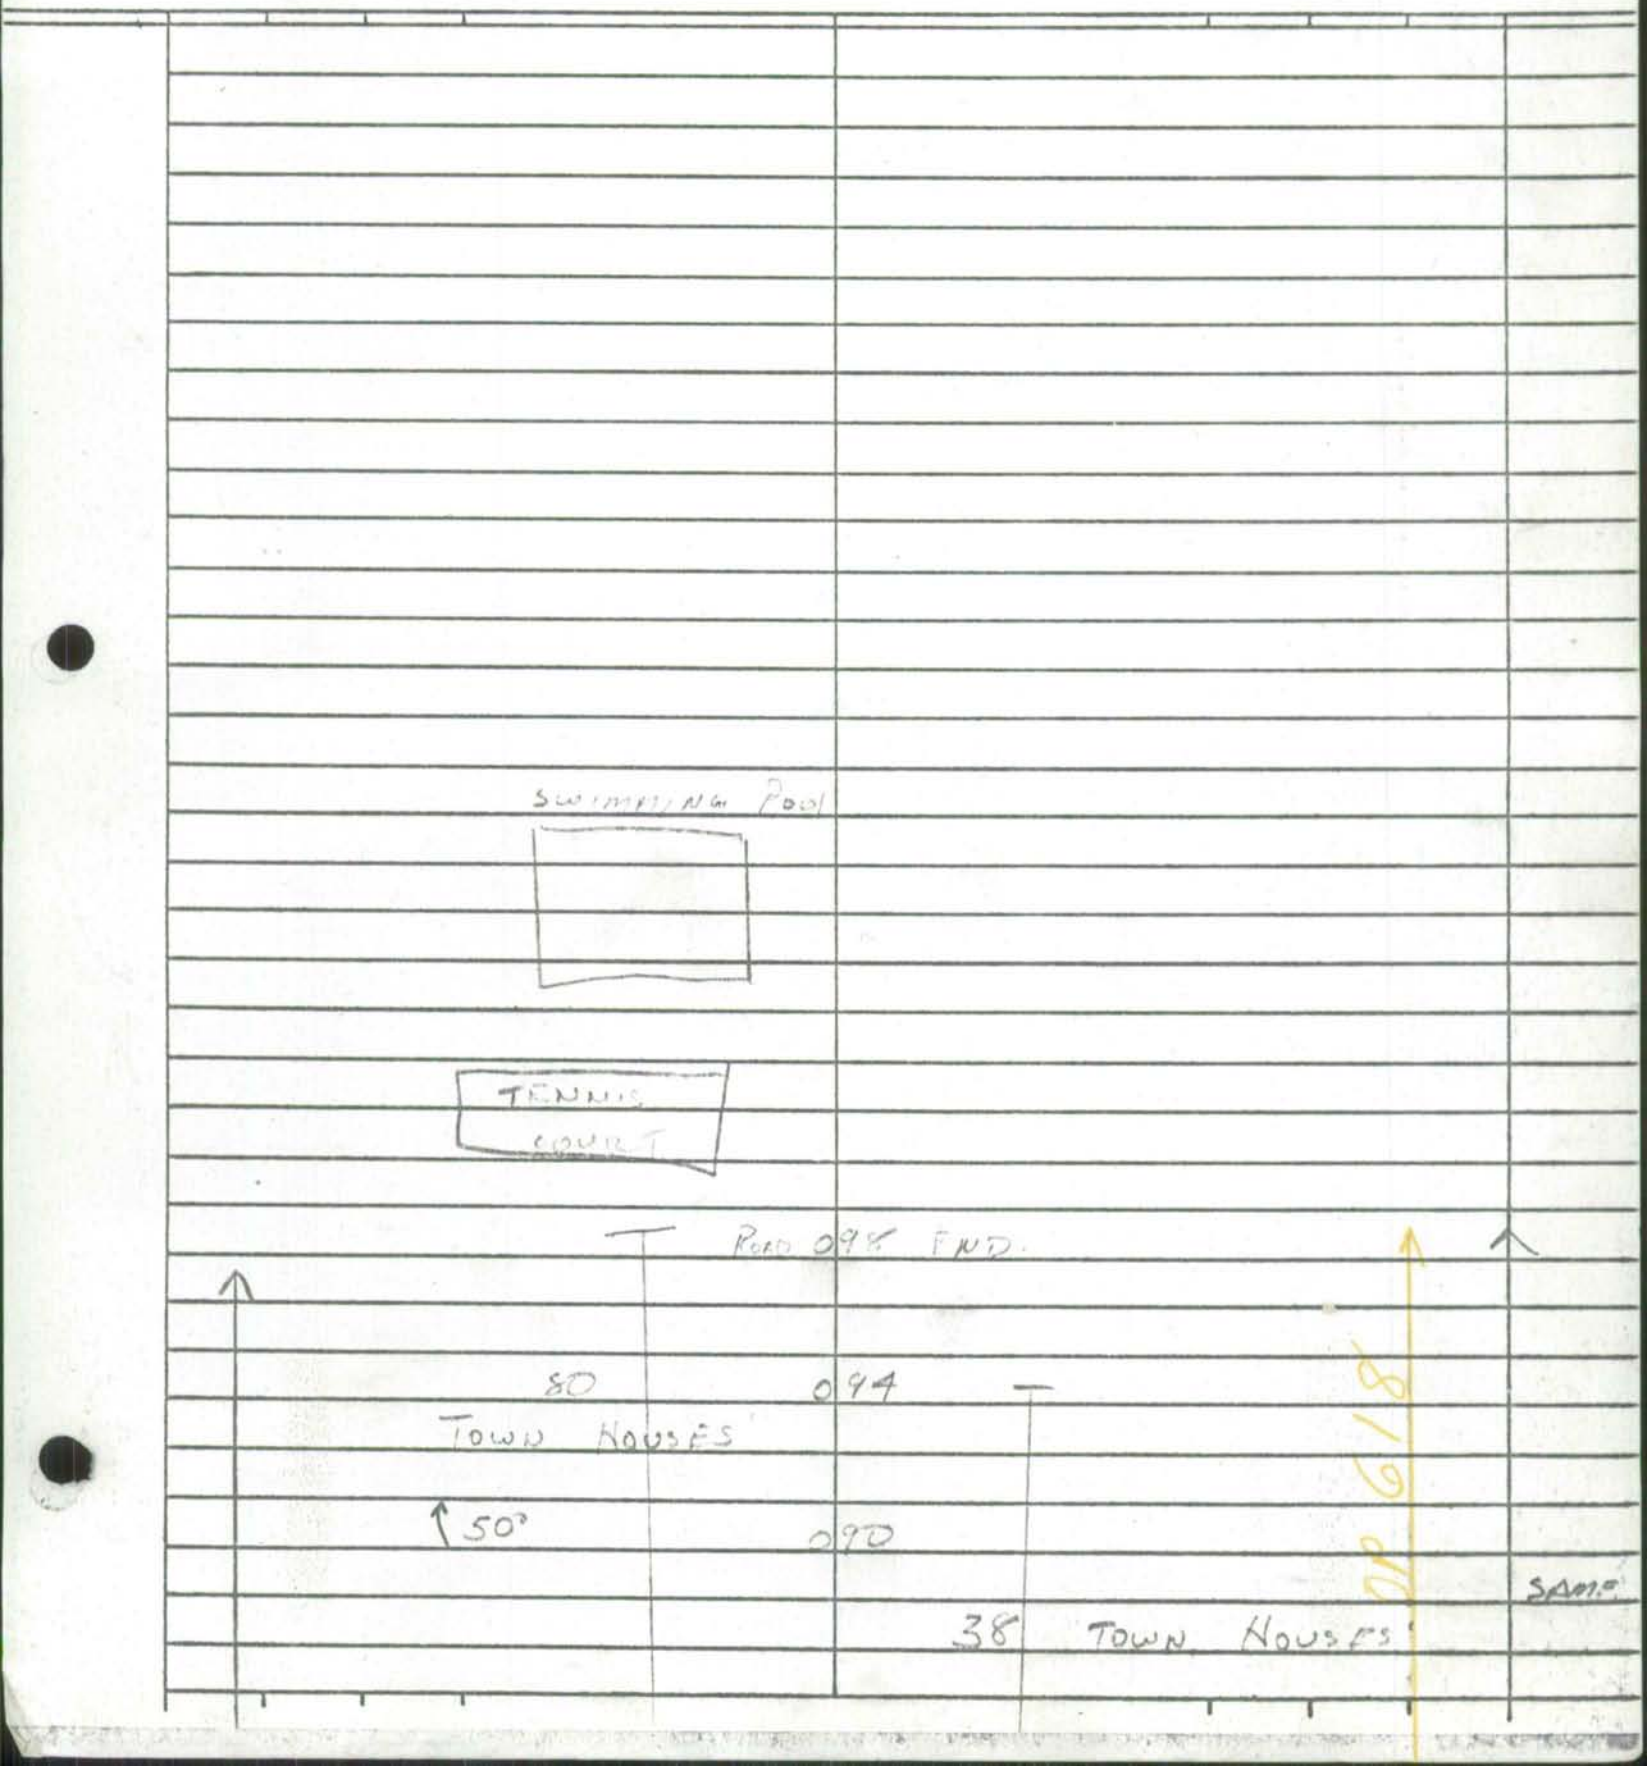

SHA 51.3-8
11-15-72

STATE HIGHWAY ADMINISTRATION OF MARYLAND CO OP 619 ST.
~~OP~~ 4498 TOURNAMENT
~~OP 619 MCKELDIN DR.~~

ROAD INVENTORY SHEET

Party Chief T. LANDON
Recorder E. RHODES
Helper

Map No. M35 MORNING SIDE
80-14
26 MAR 81 J.C./D.G.

Road No. MUN. 0030
Road Name BEAUFORD RD.
Sheet No. 1 OF 1
Date 12/14/77
County P.G.
State Coordinates 852-361
77-14

82-14
4/7/83
J.C.,V.S.
GIB/
81-14 A/T

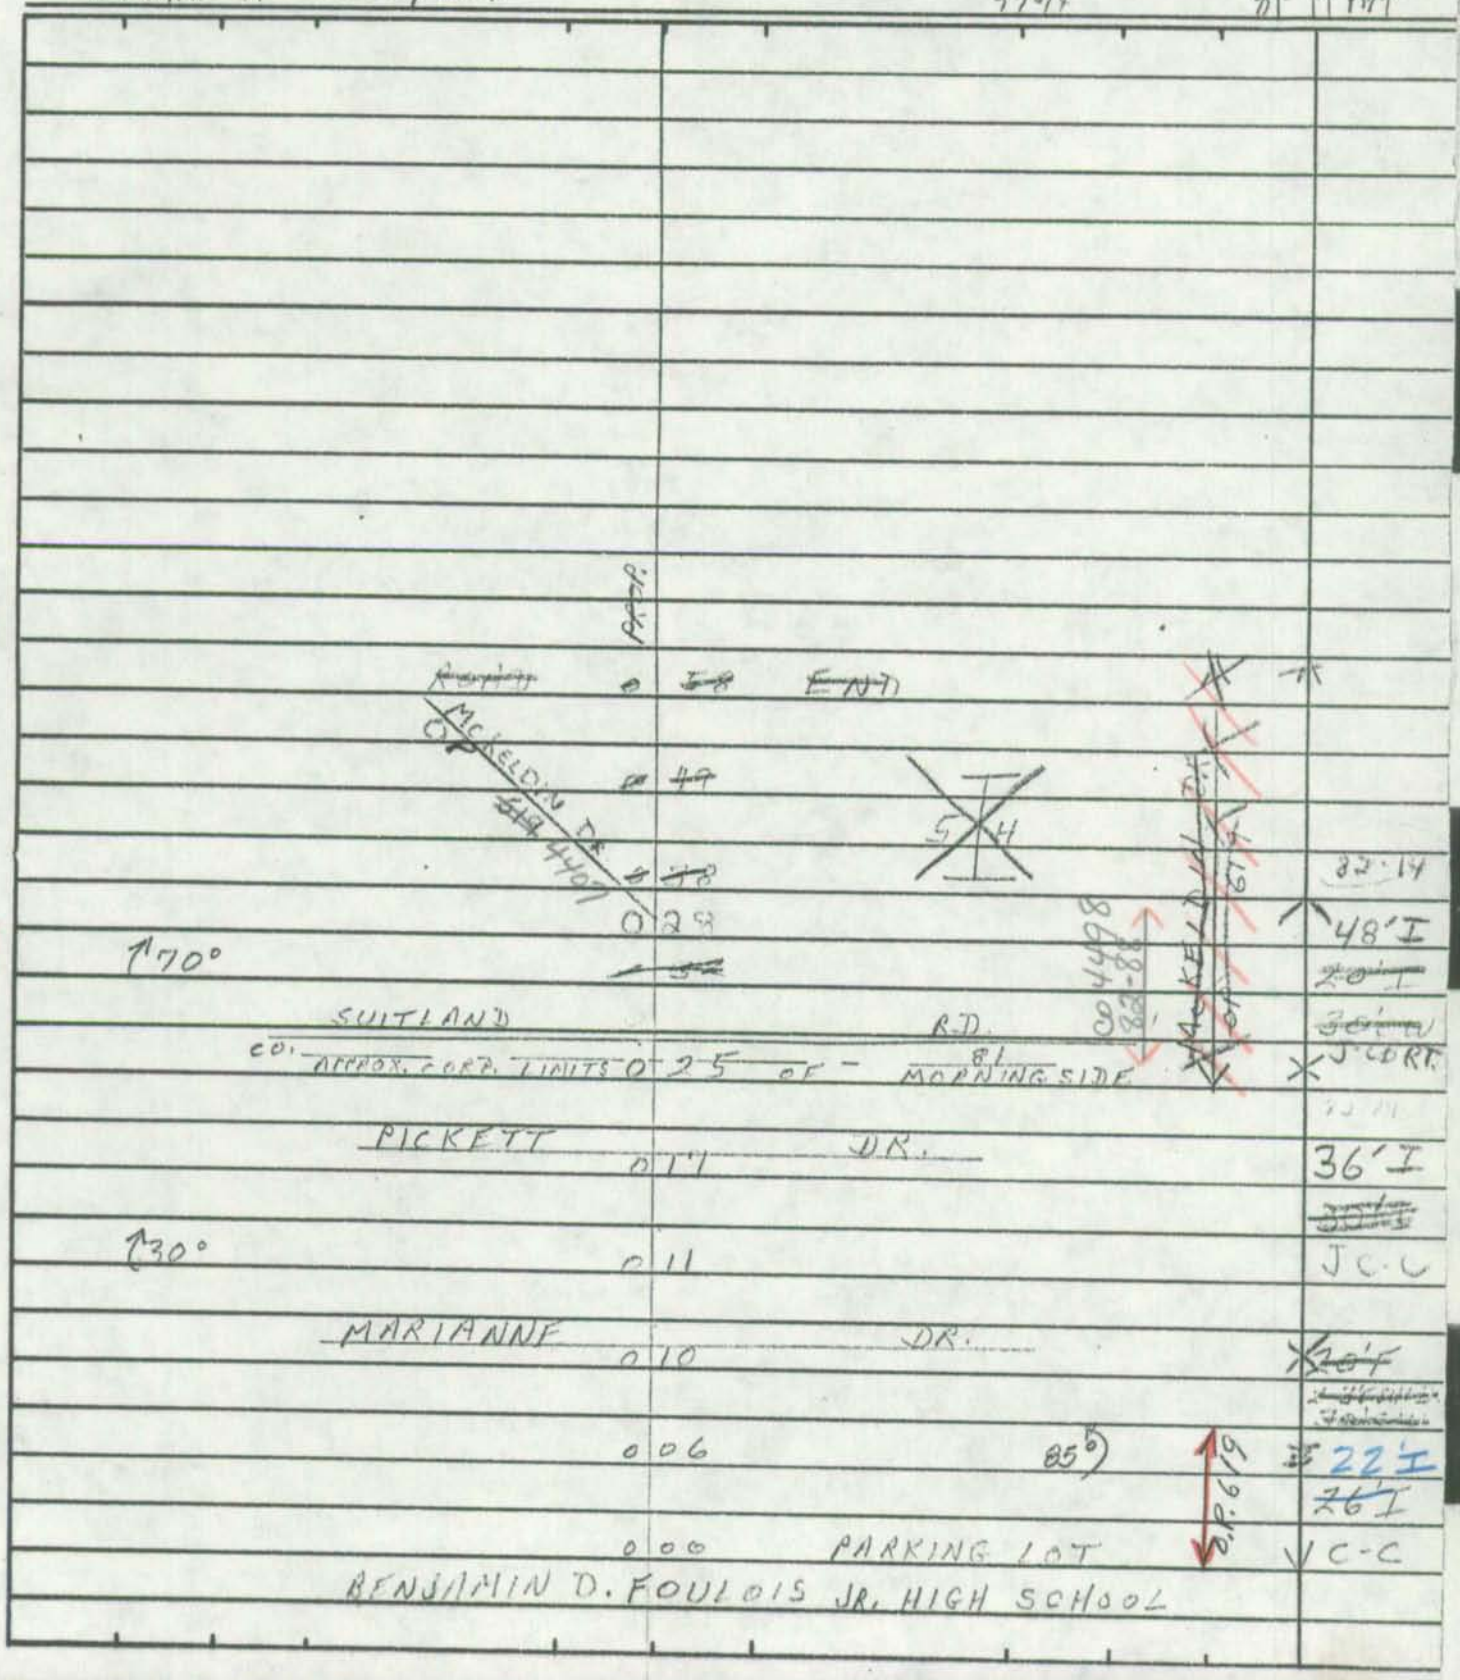

Form 6 HPS (Rev. 1961)

map 3

ROAD INVENTORY SHEET

O.P. 620

LOWLAND ST

PARTY CHIEF Edward Schuyler
RECORDER Henry Gorman
CHAINMAN Joe Blake

FAU

ROAD NO. Co. 430
NAME ~~Lowland St~~
SHEET NO. 1 OF 1
DATE 11/23/07

7-1-87

830-389 390 M31

All Now All Co.

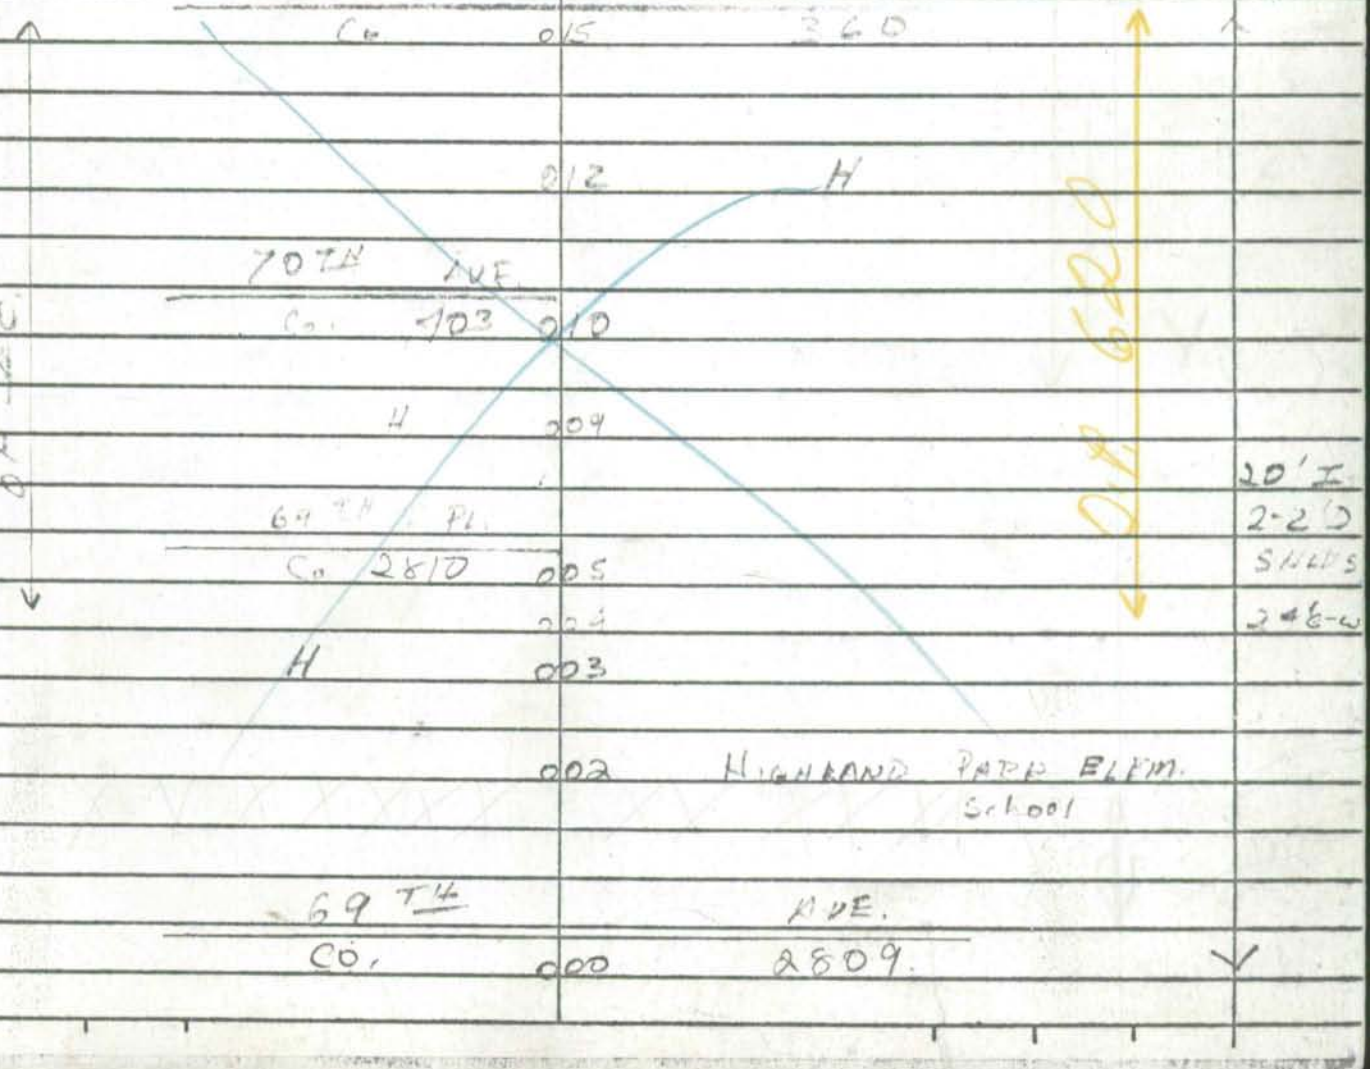

Form 6 HPS (Rev. 1961)

map 3 VER 10-27-77 O.P. 621

ROAD INVENTORY SHEET

FAU

Party Chief E. SCHUYLER
Recorder T. LANDON
Chainman

HAMPSHIRE

804 414 HOLLS
803 413 M38

Road No. Co 439
Name RATDALE RD
Sheet No. 1 OF 1
Date 8-1-67
County PRINCE GEORGES

RAY
Co

0 30 RD 965

0 28

0 27 H

0 26 H

LINWOOD STREET

10 H 0 23 Co 1686

0 19 H

LUBAY PLACE

0 17 Co 1635

0 16

0 15

RATDALE COURT

Co 2767 0 13 5 H

H 0 10

RED TOP RD
Co 0 06 438

0 04 H

26'I
C-C

0 03 * 10'D
14'CW

TRUMAN RD

Co 441 0 00

Form 6 HPS (Rev. 1961) MAP3 map 2 OP627

ROAD INVENTORY SHEET

PARTY CHIEF Edward Schuyler FAU
RECORDER ~~Henry Gorman~~ T. LANDON
CHAINMAN

ROAD NO. Co 486
NAME 54TH AVE
SHEET NO. 1 OF 1
DATE 8-22-67

822-407 M37 DECATUR HEIGHTS

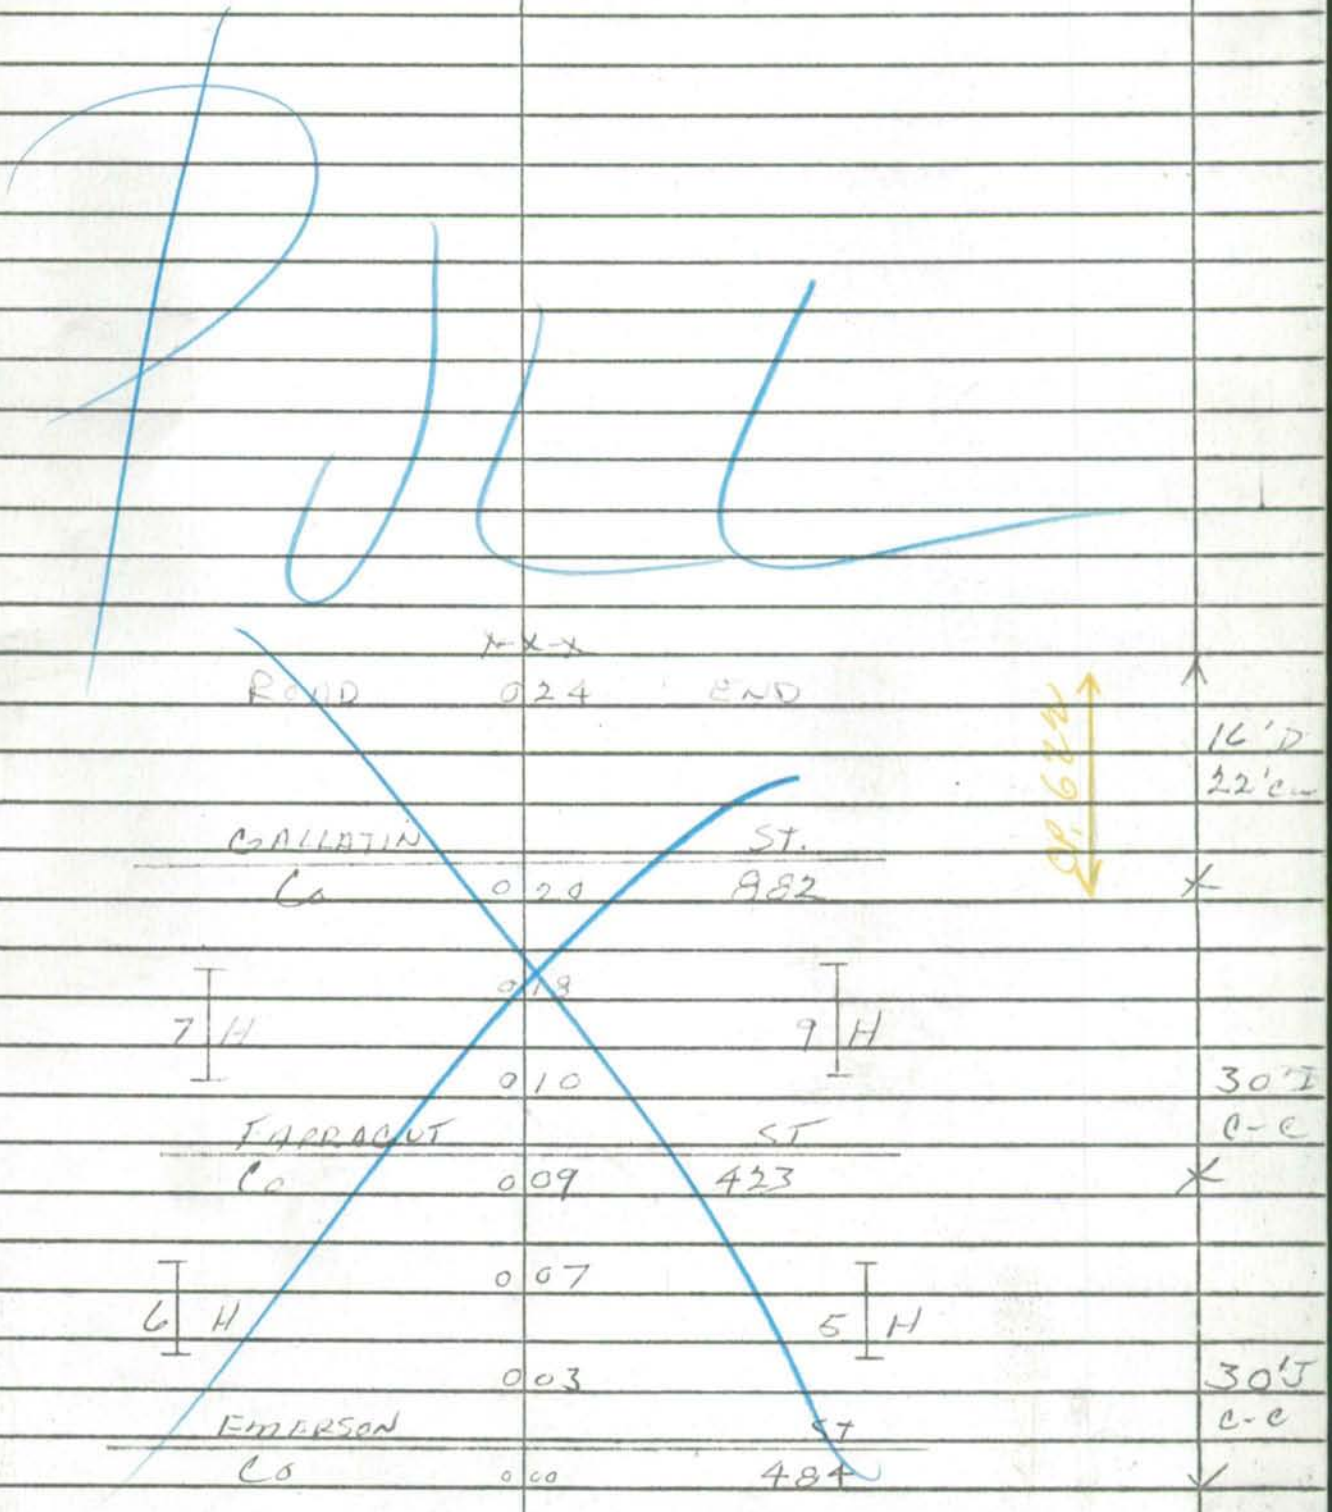

Form 6 HPS (Rev. 1961)

MAP 7 OP 623

ROAD INVENTORY SHEET

PARTY CHIEF Edward Schuyler
RECORDER Henry Gorman
CHAINMAN

FAU

ROAD NO. Co 508
NAME 72 NE ST.
SHEET NO. 1 OF 1
DATE 10 / 12 / 67
COUNTY PF GFD.

830-886 M35

UNASSIGNED NOW

ROAD END
099

Co 508

9'D
9'C-W

C STREET
~~Co 518~~ 095
OP 627

H 045

H 032

H 035

18'E
2-2'D
SHLDS.

D ST
Co. 516 034

22'C-W

19'C-W
2-2'
E SHLDS.
24'C-W

CURVE DATA

10 | H
033
021
12 | 11

F Co. 361 ST
Co 519
LIMITS OF BEAT PLAT SHEET

HYLTON ST
008

30'E
C-C

JOPLIN ST.
002

ROAD 000 END
(MUN. PARK)

Form 6 HPS (Rev. 1961)

MAP7

OP624

ROAD INVENTORY SHEET

PARTY CHIEF Edward Schuyler

RECORDER Henry Gorman

CHAINMAN

ROAD NO. Co 510

NAME

SHEET NO.

DATE

COUNTY

84-386 M35

UNASSIGNED

7/22/76

PUL

0.52

H 0.50

0.66 90°

0.84 H

0.92 H

0.97

B 57

OP ~~730~~/29 0.34

OP624

9'2

9'6-W

X

Form 6 HPS (Rev. 1961)

MAP 37

OP625

ROAD INVENTORY SHEET

PARTY CHIEF Edward Schuyler
RECORDER Henry Gorman
CHAINMAN

CARMODY HILLS FAV

ROAD NO. 515
NAME 7672 ST.
SHEET NO. 1 OF 1
DATE 10/17/63

832-387 M35

NOW CO 515 78-81

FND

012

VALLEY PARK RD

CO 2052 OOP

OOC

L

ST.

CO 2064 SW

24' E
C-C

OOB

OOA

3 H

12' E
2-2' D
SHLDS
16' C-W

OOI

FADS

ST.

OP

000

34

Form 6 HPS (Rev. 1961)

OP626

ROAD INVENTORY SHEET

FAU 7
CARMODY HILLS

PARTY CHIEF Edward Schuyler
RECORDER Henry Gorman
CHAINMAN

ROAD NO. Co. 516
NAME D ST
SHEET NO. 1 OF 2
DATE 10/19/67
COUNTY PRINCE GEORGE

832-387-M35

UNASSIGNED 72-75 + 82

039
74TH
Co.
028
035
H
75TH ST
OP 436
10 H
031
4 H
027
18'E
2-2 D
SK
22'-W
76TH
ST
Co
025
515
023
16 H
13 H
004
78TH
ST.
10.
002
1593
26'I
C.C
H
001
H
ROAD
000
END.
ATHLETIC
FIELD

Form 6 HPS (Rev. 1961)

~~MAP 3~~ 7

OP 626

ROAD INVENTORY SHEET

PARTY CHIEF Edward Schuyler
RECORDER Henry Gorman
CHAINMAN _____

CAVMONDY
N. ILS

ROAD NO. Co 516
NAME D ST.
SHEET NO. 2 OF 2
DATE 10/19/67

EXTENDED 72-88

POND END
072

72 ND ST.
CO 066 508

72 ND PL.
CO. 061 504

72 ND ST
Co 056 510

CARMODY N. ILS DR.
CO. 052 511

050

3 11

049

72 ND PL.
047 Co 512

246

8 H 79 TH ST.
042 Co 625

10'D
10'C-W
X NO SHLD
18'E
2-2'D
SH-D.S
22-C-W
*
10'E
10'E
6 WLD LT
4'E SHLD RT
24'C-W
*
SAME

OP 626 72-88

RAMP

Form 6 HPS (Rev. 1961)

72-77

ROAD INVENTORY SHEET

C Street
OP627
~~Co 518~~

Party Chief W. Dombroski
Recorder O. Taylor
Helper

Road No.
Road Name Franklin DR
Sheet No. 1 of 1
Date 2-28-73
County Prince Georges

M-35

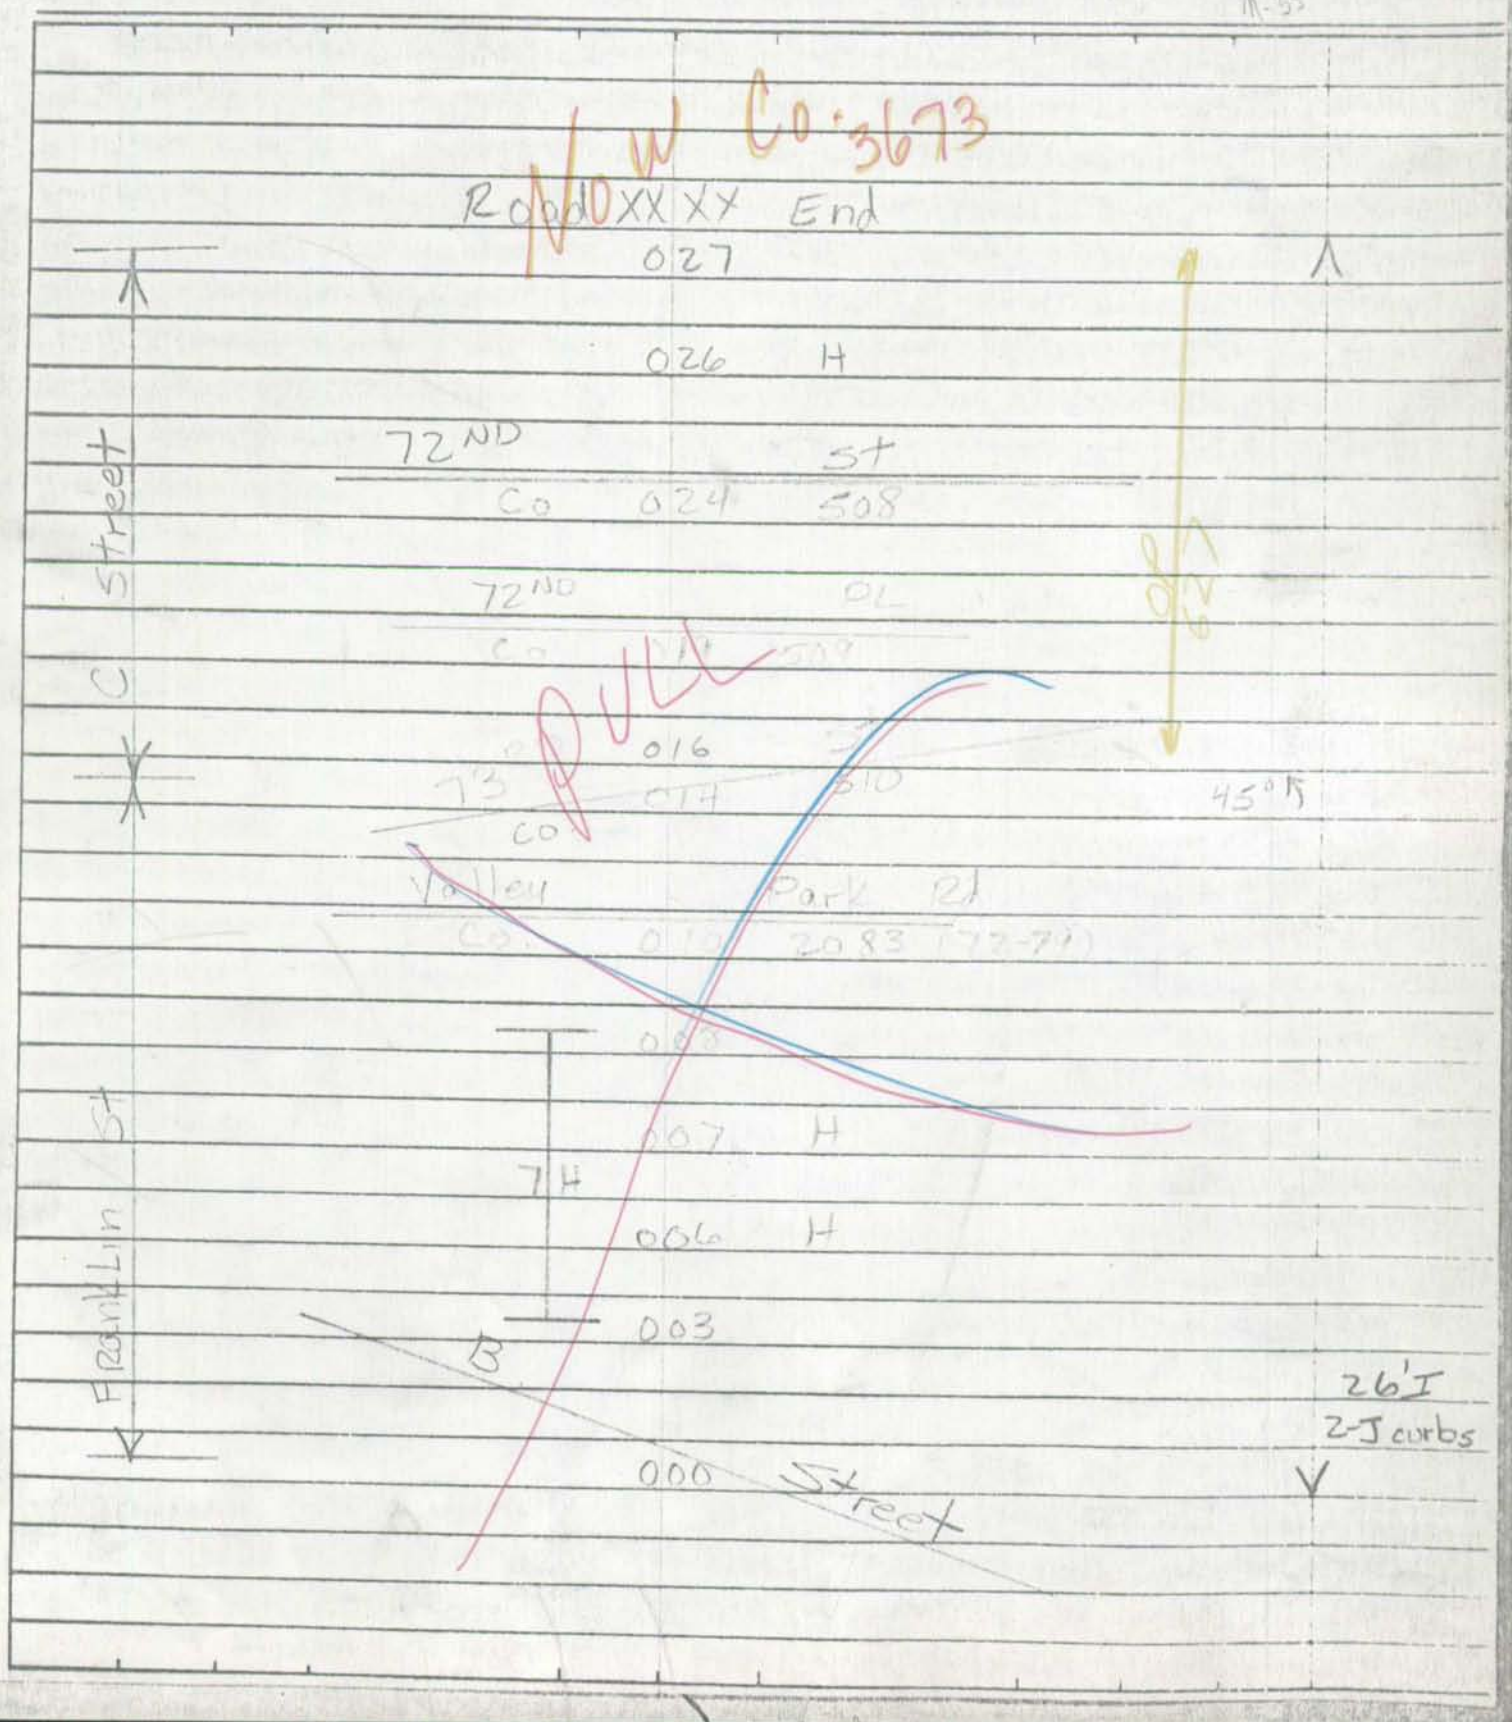

Form 6 HPS (Rev. 1961)

map 3

OP628

ROAD INVENTORY SHEET

FAU
CHAPEL
OAKS

PARTY CHIEF Edward Schuyler
RECORDER Henry Gorman
CHAINMAN

ROAD NO. Co. 541
NAME ENGLEWOOD AVE.
SHEET NO. 1 OF 1
DATE 10/7/62

VER
4-19-78

MAP 4
823-393 M31

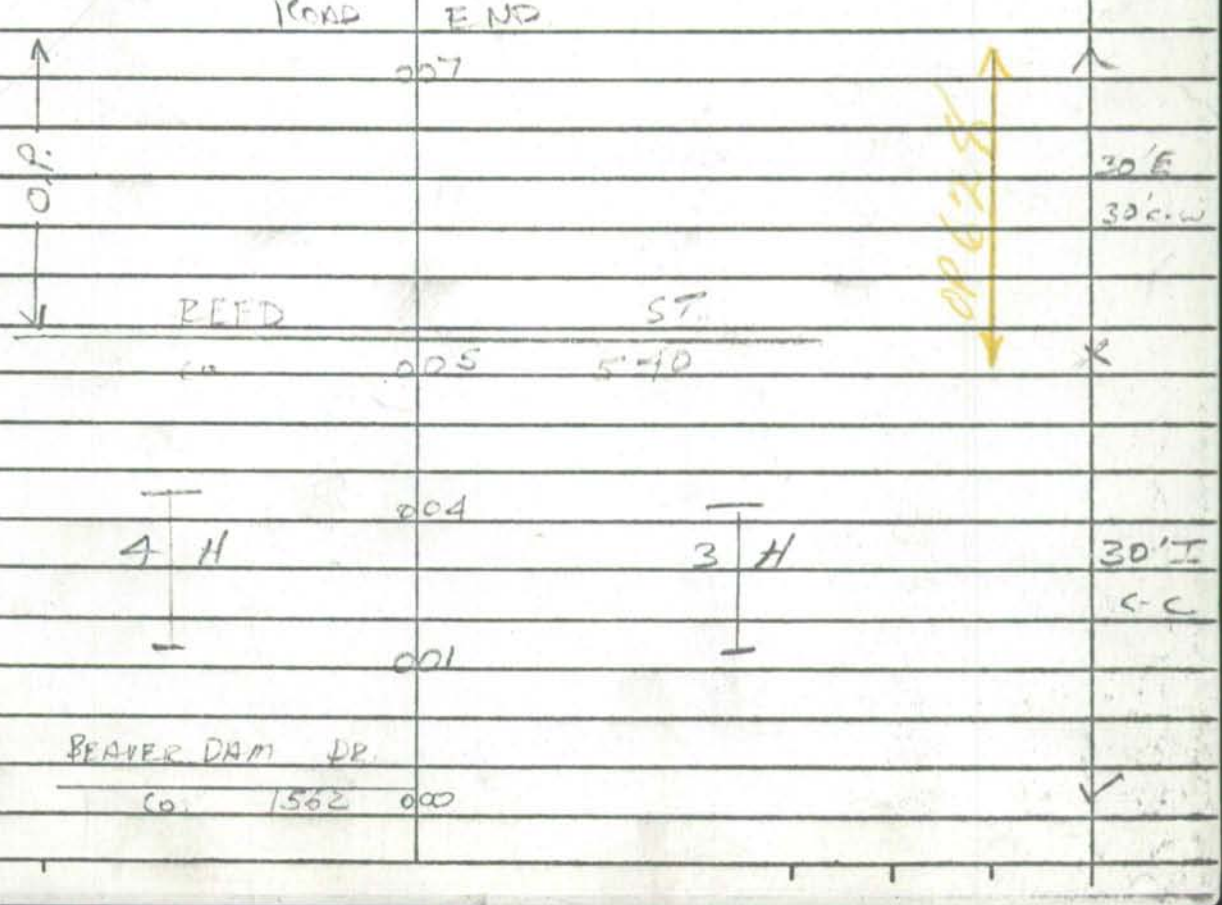

Form 6 HPS (Rev. 1961)

map 9

O.P. 629

ROAD INVENTORY SHEET

FAU

Party Chief	E.S.
Recorder	W.D
Chainman	

PROJECTS CO.

61-108

815-349 M35

Road No.	CO. 5W
Name	WEBSTER LA.
Sheet No.	2 of 2
Date	12-18-68
County	PRINCE GEO.

	Unassigned		
	Now barricaded		
	72-138		
	0+00	END	
			9 D
			9 CW
	0+29		
	0+74		
	0+74	E'CMP	
H	0+71		
	0+69	H	
H	0+65	H	
	0+63	DR	
PROPOSED	0+62		
H	0+58	H	
			12'F
			2-3'ESHD
		CO 2360	
	0+56	NORTH DR	
	0+55	H	
H	0+52		SAME

Form 6 HPS (Rev. 1961)

map 4

OP 630

ROAD INVENTORY SHEET

CARDIFF LANE

Party Chief E.S.
Recorder N.D
Chainman

FHU

N. BARNABY

Road No. CO 572
Name ~~SCHENLEY LA~~
Sheet No. 1 OF 1
Date 8-20-71
County PRINCE GEORGES

G11D

813-354 ~~353~~ ~~M35~~ ~~9~~ VER 8-17-71

W

H ROAD 005 ~~014~~ END

H 001 ~~010~~

SCHENLEY LA

CO 572 ~~009~~ ~~000~~

OP 630

16'I

2-3½ESHD

CO 575

~~005~~ HENRY AVE

H ~~004~~

CO 574

MULBERRY LA ~~002~~

~~16'I~~

CO 570

~~000~~ MYRTLE AVE

~~2-3~~ 5.40

Form 6 HPS (Rev. 1961)

OP 631

ROAD INVENTORY SHEET

PARTY CHIEF Edward Schuyler
RECORDER Henry Gorman
CHAINMAN

CEDAR HEIGHTS

FHU

VER A-20-18

BALSAM TREE PL

ROAD NO. G 529
NAME ~~63 RD~~ AVE
SHEET NO. 1 OF 1
DATE 10 / 16 / 67
COUNTY PRINCE GEORGES

855 ~ 389 ~ M31

UNASSIGNED NOW G589 8-20-71

"K" CO. 016 ST. 2807

H 015

9 H

H 008

005

24 I
~~18 I~~
2-3'
E SHLDR
21'c-w

H 004

003

OP SEC.

JEFFERSON "H" HGTS CO. 000 ST. DR 352

~~18'~~ 21'

Form 6 HPS (Rev. 1961)

FAU

ROAD INVENTORY SHEET

OP632

Party Chief E SCHUSLER
Recorder T LANDECK
Chainman T EDERICK
D PLUMMER
65-192

MAP 6

OXON RUN
HILLS
366
8/2-367

Road No. CO 611
Name FAIRLAWN ST.
Sheet No. 1 OF 2
Date 12-13-67
County PRINCE GEORGES

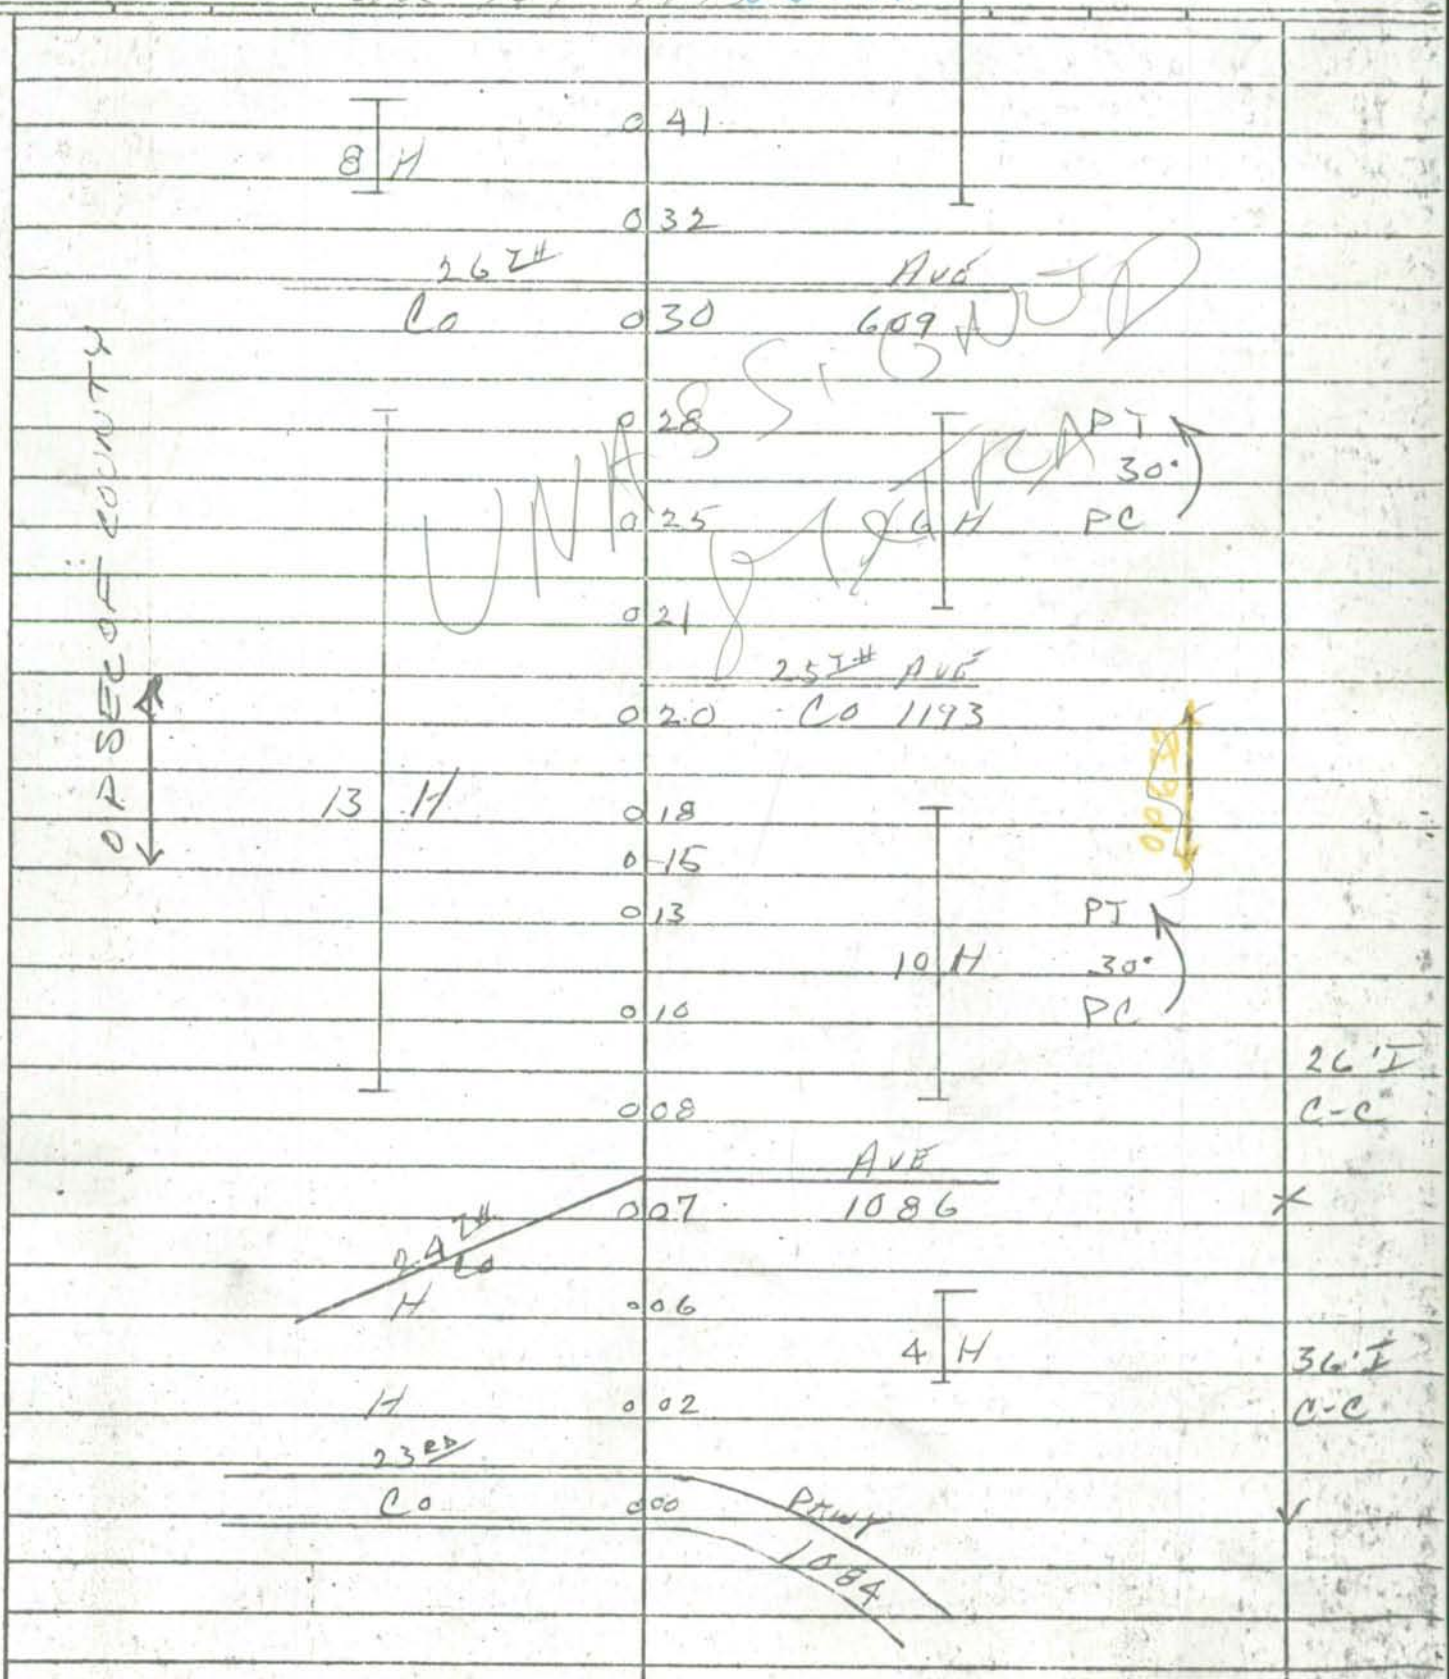

Form 6 HPS (Rev. 1961)

+HV

MAP 3

OP 633

ROAD INVENTORY SHEET

PARTY CHIEF Edward Schuyler
RECORDER Henry Gorman
CHAINMAN

CHAPEL OAKS

ROAD NO. Co 630
NAME WOOD HILL DR.
SHEET NO. 1 OF 1
DATE 10/9/67
COUNTY PRINCE GEORGES

VER 4-19-78

823-393

M31

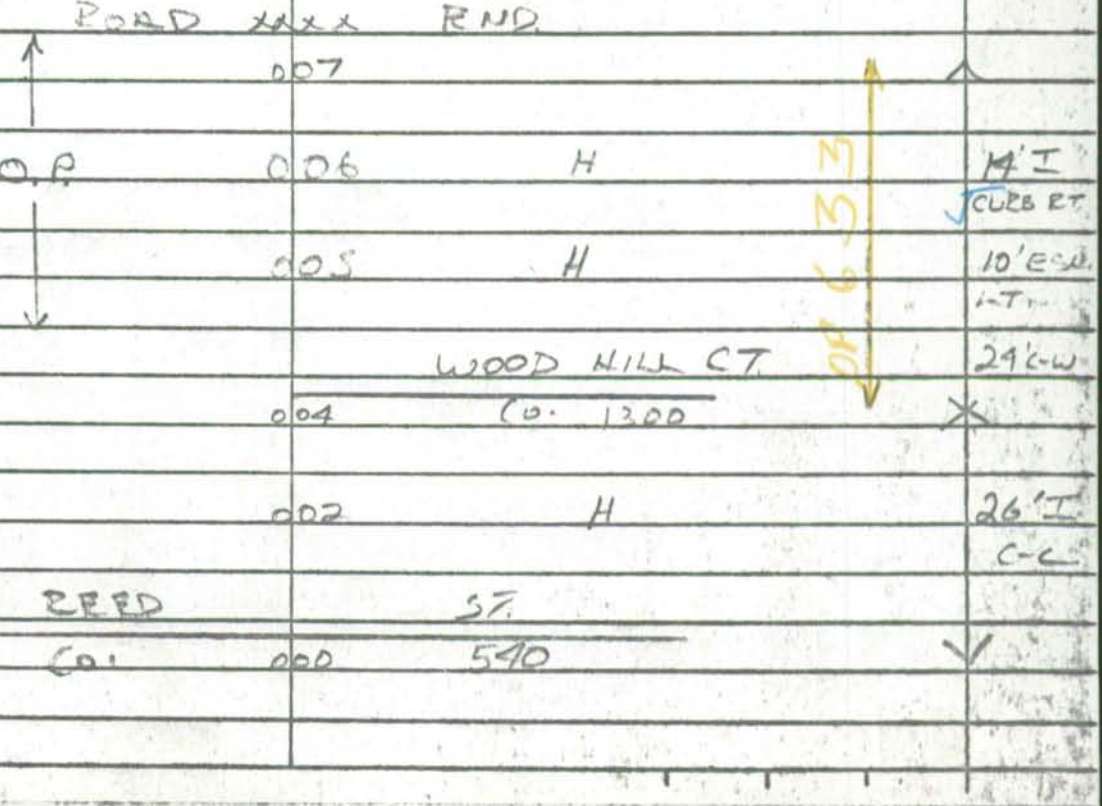

Form 6 HPS (Rev. 1961)

FAU

OP 634

ROAD INVENTORY SHEET

See New Inv.

PARTY CHIEF Edward Schuyler
RECORDER Henry Gorman
CHAINMAN

ROAD NO. Co. 645
NAME WEBSTER ST
SHEET NO. 1 OF 1
DATE 9/18/67
COUNTY PRINCE GEORGE

Unassigned

Now Co. 645

1968

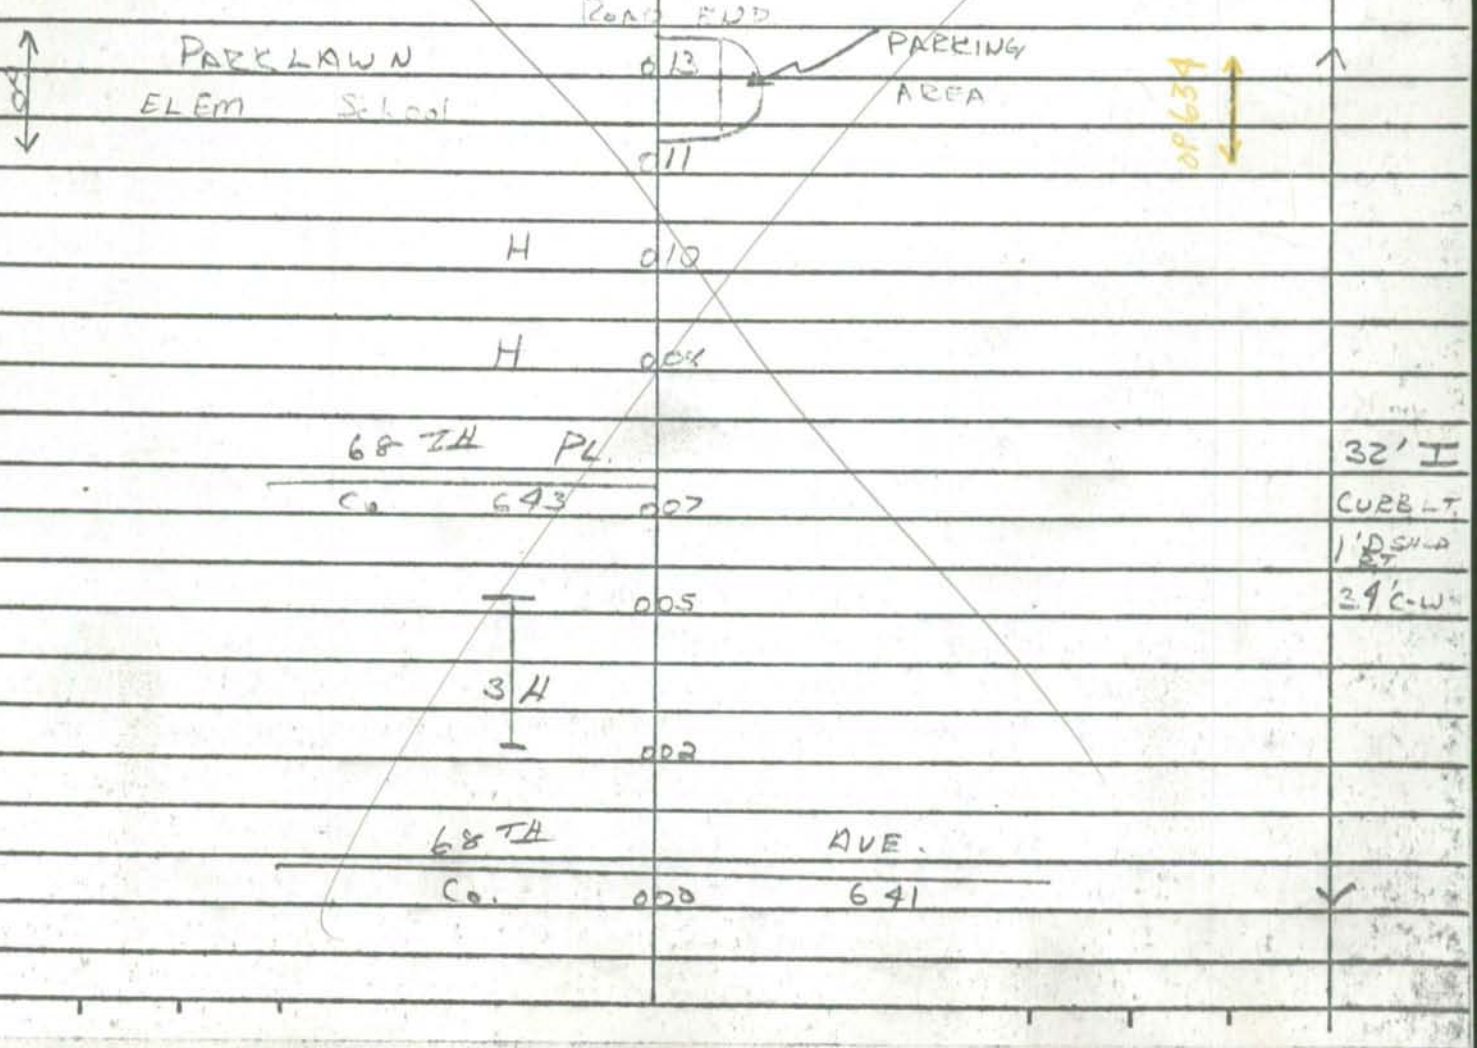

Form 6 HPS (Rev. 1961)

FAU Ver 10-4-77 OP 635

ROAD INVENTORY SHEET

MAP 6

PARTY CHIEF Edward Schuyler
RECORDER Henry Gorman
CHAINMAN

ROAD NO. CO. 659
NAME SOUTHERN AVE
SHEET NO.
DATE
COUNTY PRINCE GEORGES

817
~~815~~ - 378 M35

BYERS ST
268
10

ALTON ST
CO 32
04

WILLARD ST
CO
08

592

OP

Form 6 HPS (Rev. 1961) T 110

OP 636

Ver MTZ DT 9-20-37

ROAD INVENTORY SHEET

MAP 6

Party Chief E. Schuyler
Recorder L. Emmitt
Chainman T. HANDON
D. PLUMMER

PARKLAND TERR.

Road No. Co 666
Name COVINGTON ST
Sheet No. 1 OF 1
Date 12/6/37
County PA. Co.

G11B

822-~~348~~
820-361

~~M35~~

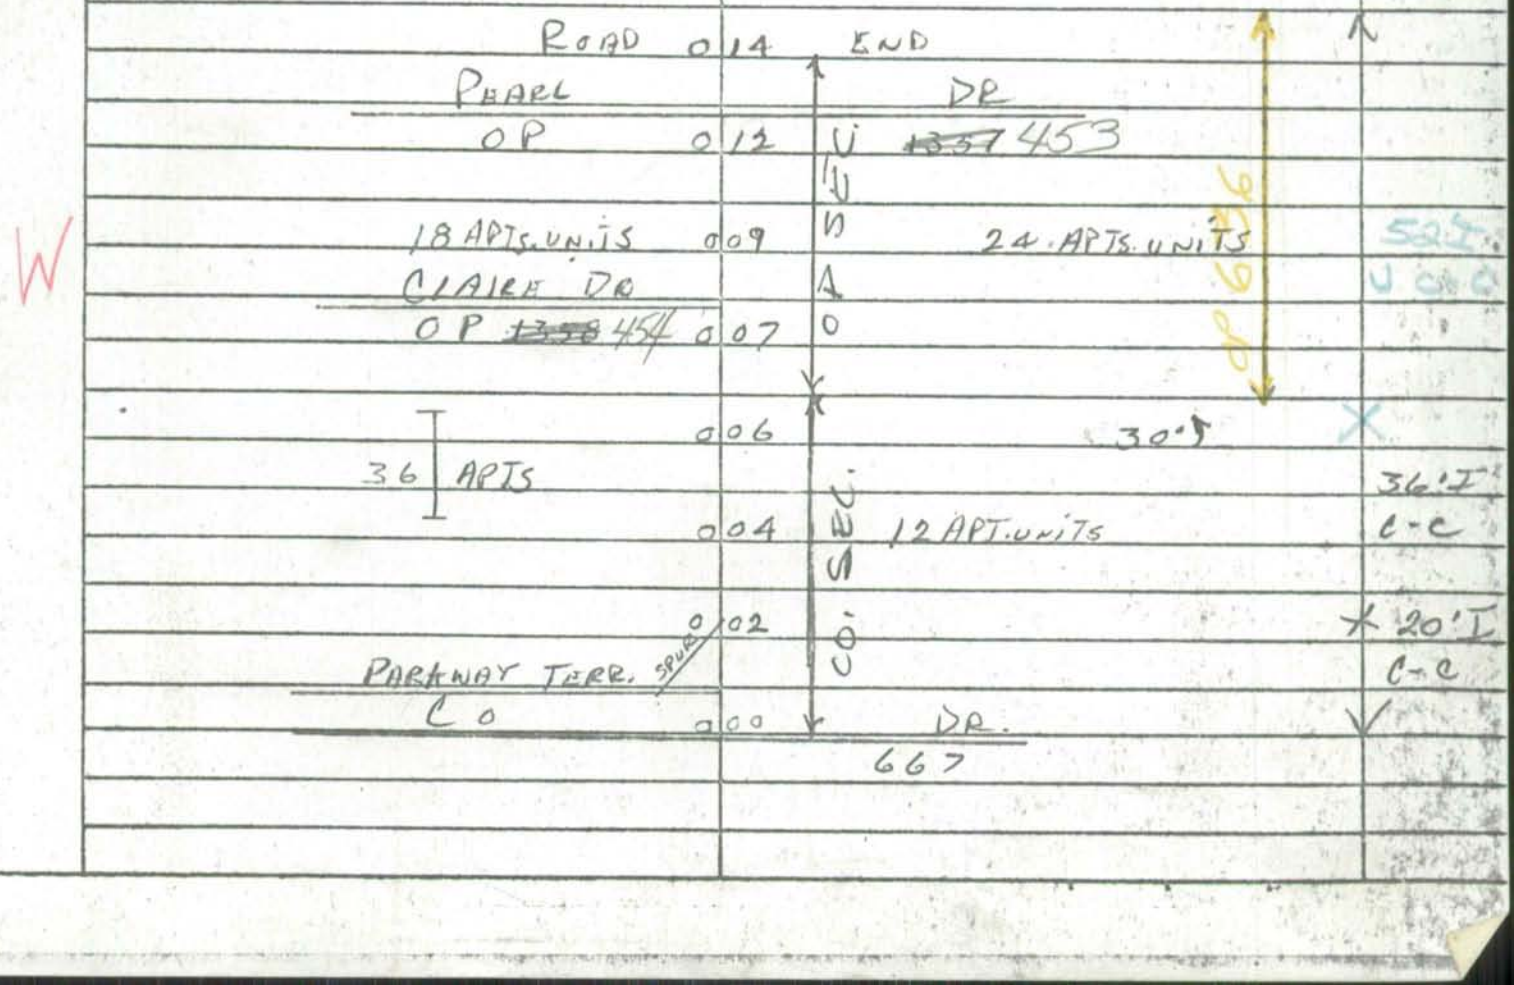

Reassigned 2-17-71 GJG
Previous OP 637 Now Co. 676

Form 6 HPS (Rev. 1961)

ROAD INVENTORY SHEET

Party Chief E. Schuyler GREENBELT
Recorder M. GORMAN
Chainman

Vell 6-10-70

F11B

Road No. OP 637
Name COURT S1-Ridge Rd.
Sheet No. 1 OF 1
Date 5 / 23 / 67
County PRINCE GEORGES'

836-429

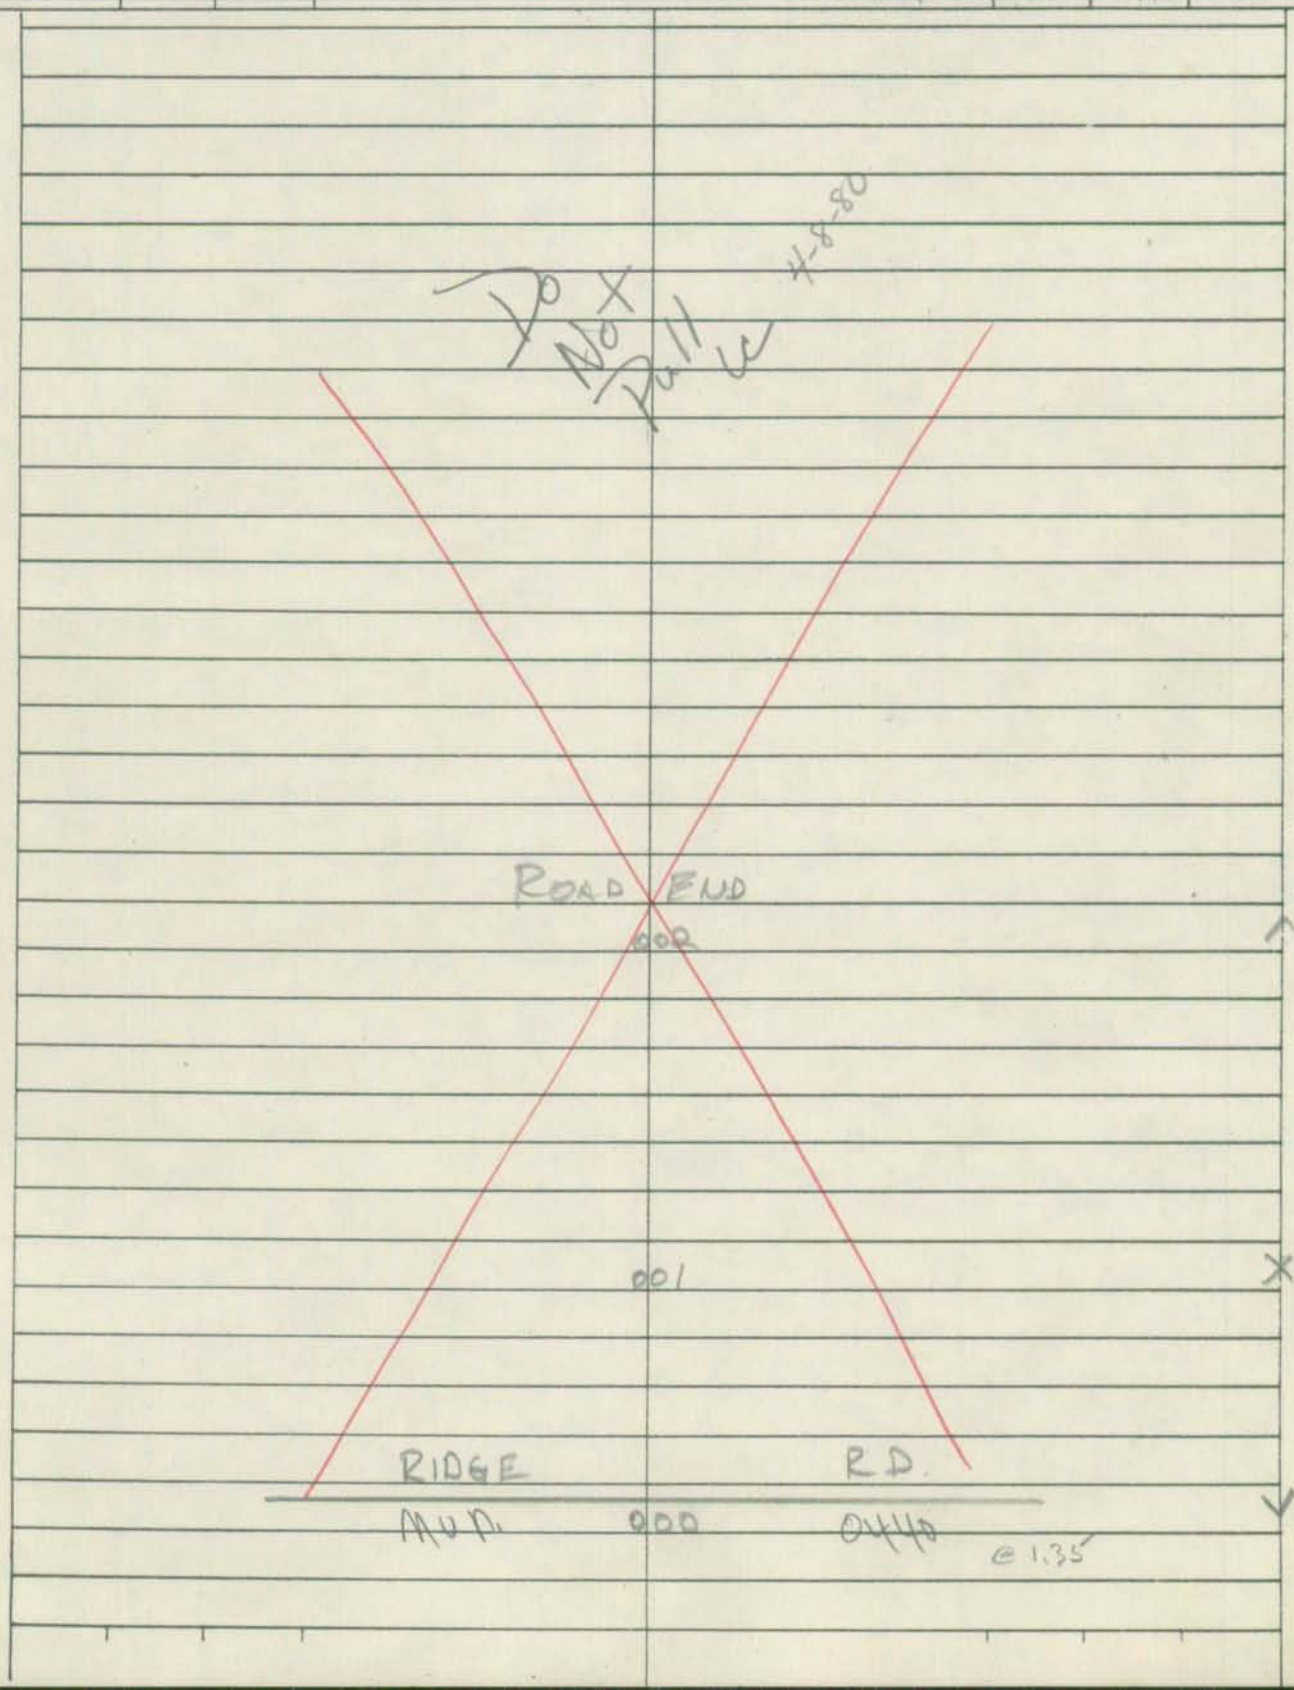

Reassigned 2-17-71 GJG

Form 6 HPS (Rev. 1961) (Previous OP 638 Now Co 688 49-134)

Urban

ROAD INVENTORY SHEET

Party Chief E. Schuyler GREENBELT

Recorder H. GOEMAN

Chainman

VER 6-12-78

F11B

Road No. OP 638

Name Court 53 - Ridge Rd.

Sheet No. 1 OF 1

Date 5/23/67

County PRINCE GEORGES

Do Not Publish 1-8-80

ROAD END.

003

001

W

58' G
58' C-W

16' G
C-C

RIDGE RD

MUN 0.00 0440

@ 1.29

Reassigned 2-17-71 GJG

Form 6 HPS (Rev. 1961) (Previous OP639 Now Dr. 689. 69-137)

ROAD INVENTORY SHEET

Urban OP639

Party Chief E. Schuyler
Recorder H. GORMAN
Chainman

GREENBELT
071

VER
6-12-78

Road No. OP639
Name COURT 59-Ridge Rd.
Sheet No. 1 OF 1
Date 5/23/67
County PRINCE GEORGES'
83⅛-428

M-31

Do Not Pull 1-8-80

ROAD END
002

53' F
53' C-W

001

21' F
C-C

RIDGE RD. 0,32
AVA 000 440

Form 6 HPS (Rev. 1961)

MAP 4 FAU GPS 98-99 11-2-98 SS/SR OP640K GPS 11-2-98 SS/SR

ROAD INVENTORY SHEET

PARTY CHIEF Edward Schuyler
RECORDER Henry Gorman
CHAINMAN

KENT VILLAGE

ROAD NO. Co. 690
NAME FOREST RD
SHEET NO. 1 OF 1
DATE 10/9/67
COUNTY PRINCE GEORGES'

VER 4-24-78

830-398 M31

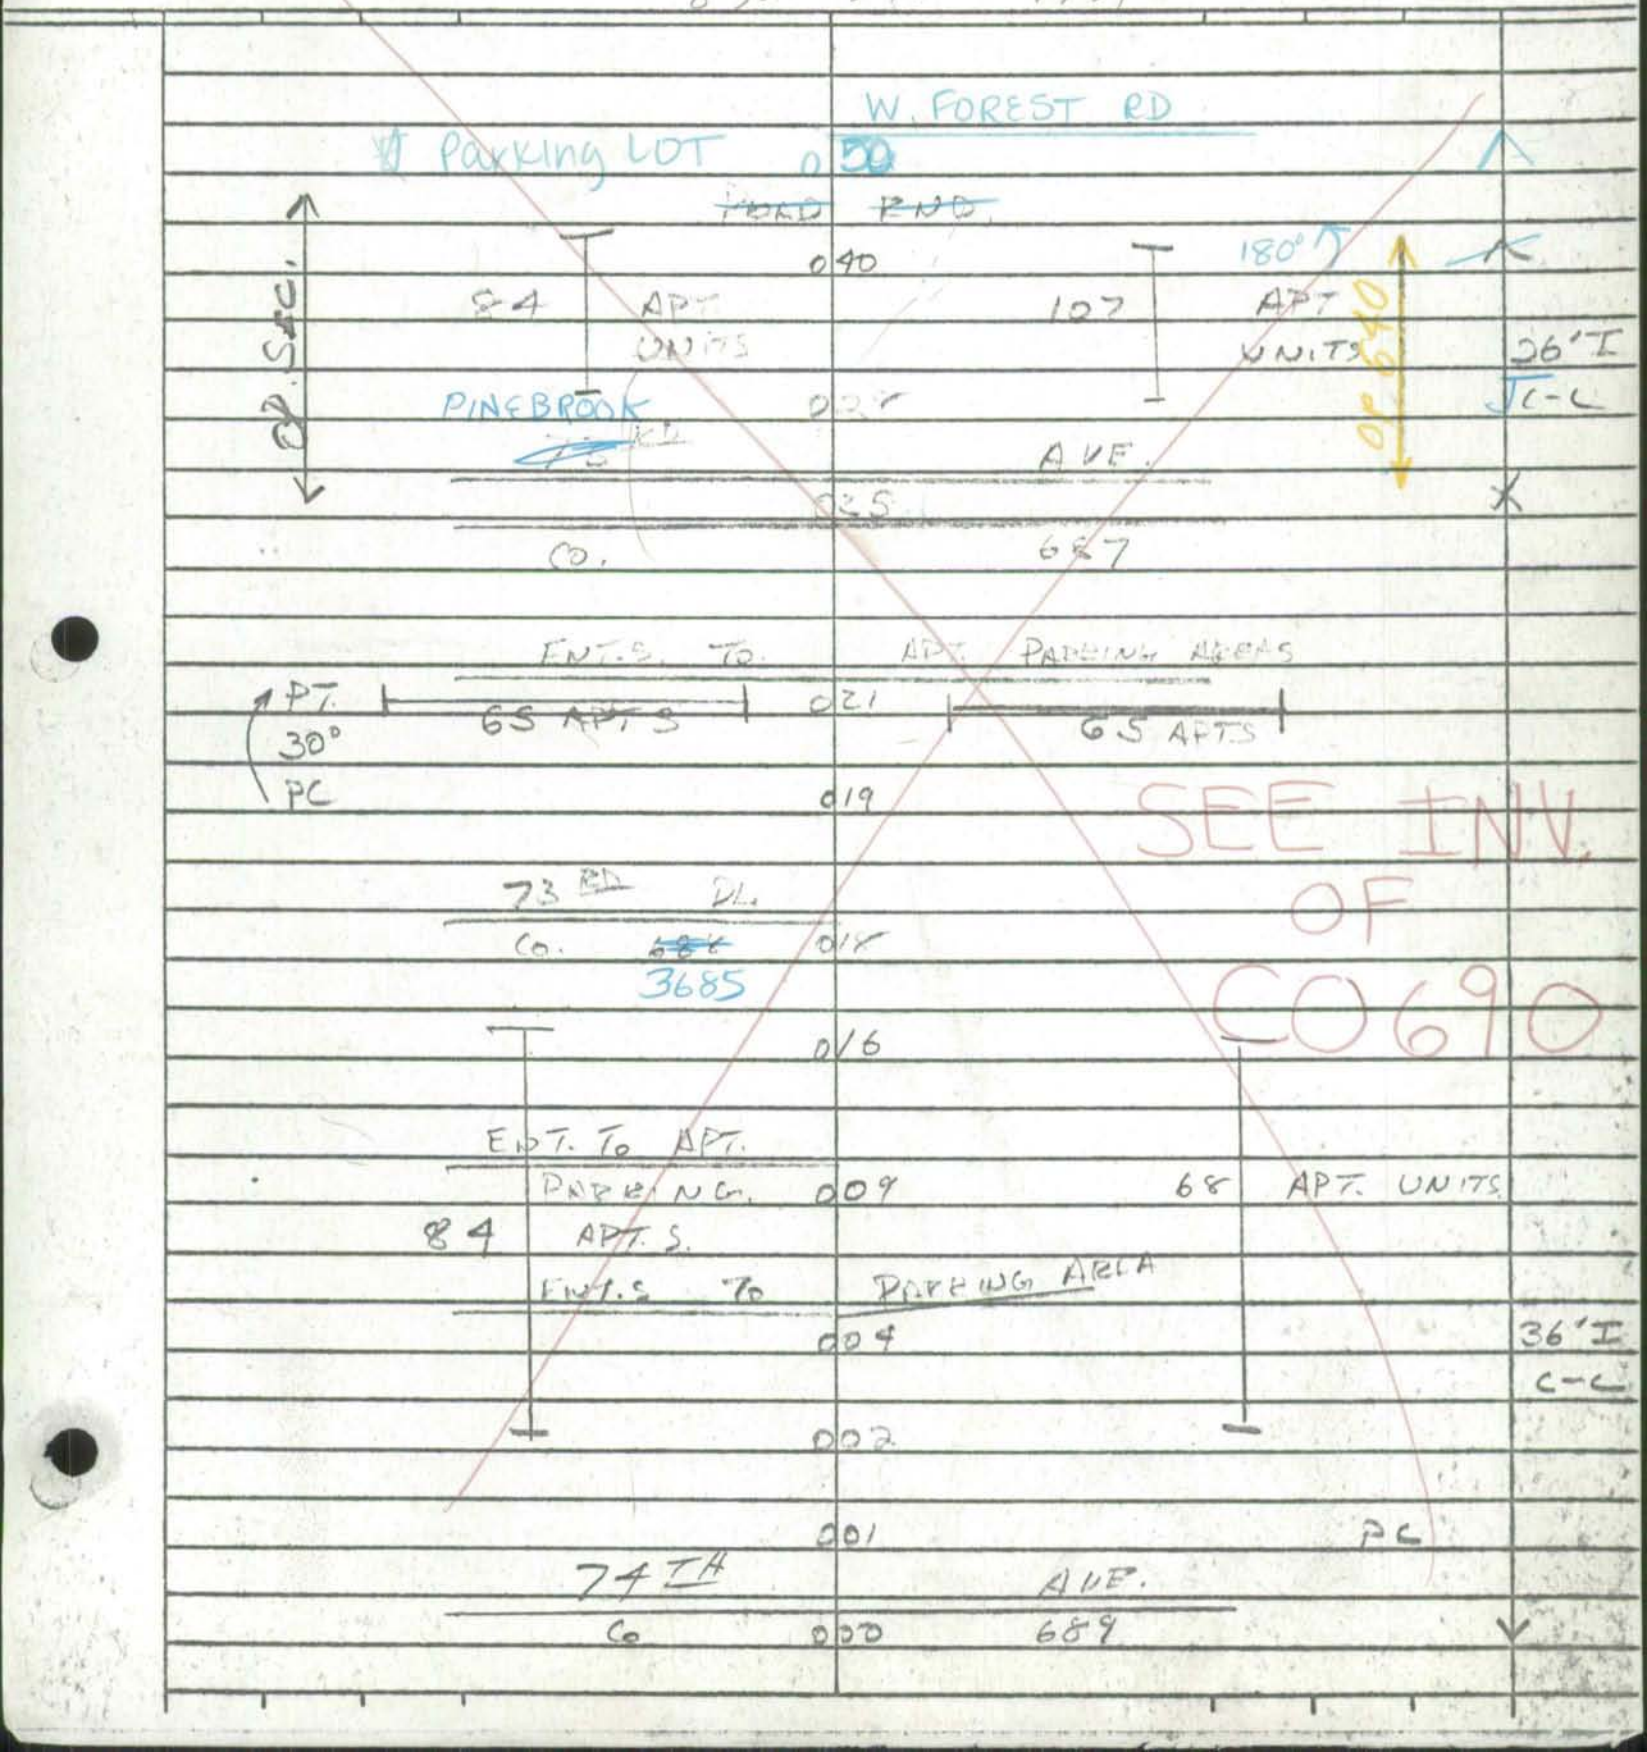

SEE INV.
OF
C0620

Form 6 HPS (Rev. 1961)

MAP 4

ROAD INVENTORY SHEET

OP 641

PARTY CHIEF Edward Schuyler
RECORDER Henry Gorman
CHAINMAN

ROAD NO. CO 691
NAME HAWTHORNE ST
SHEET NO. 3 OF 3
DATE 10 / 2 / 69
COUNTY PR. GEO.

VER 4-24-78

834-398 M31

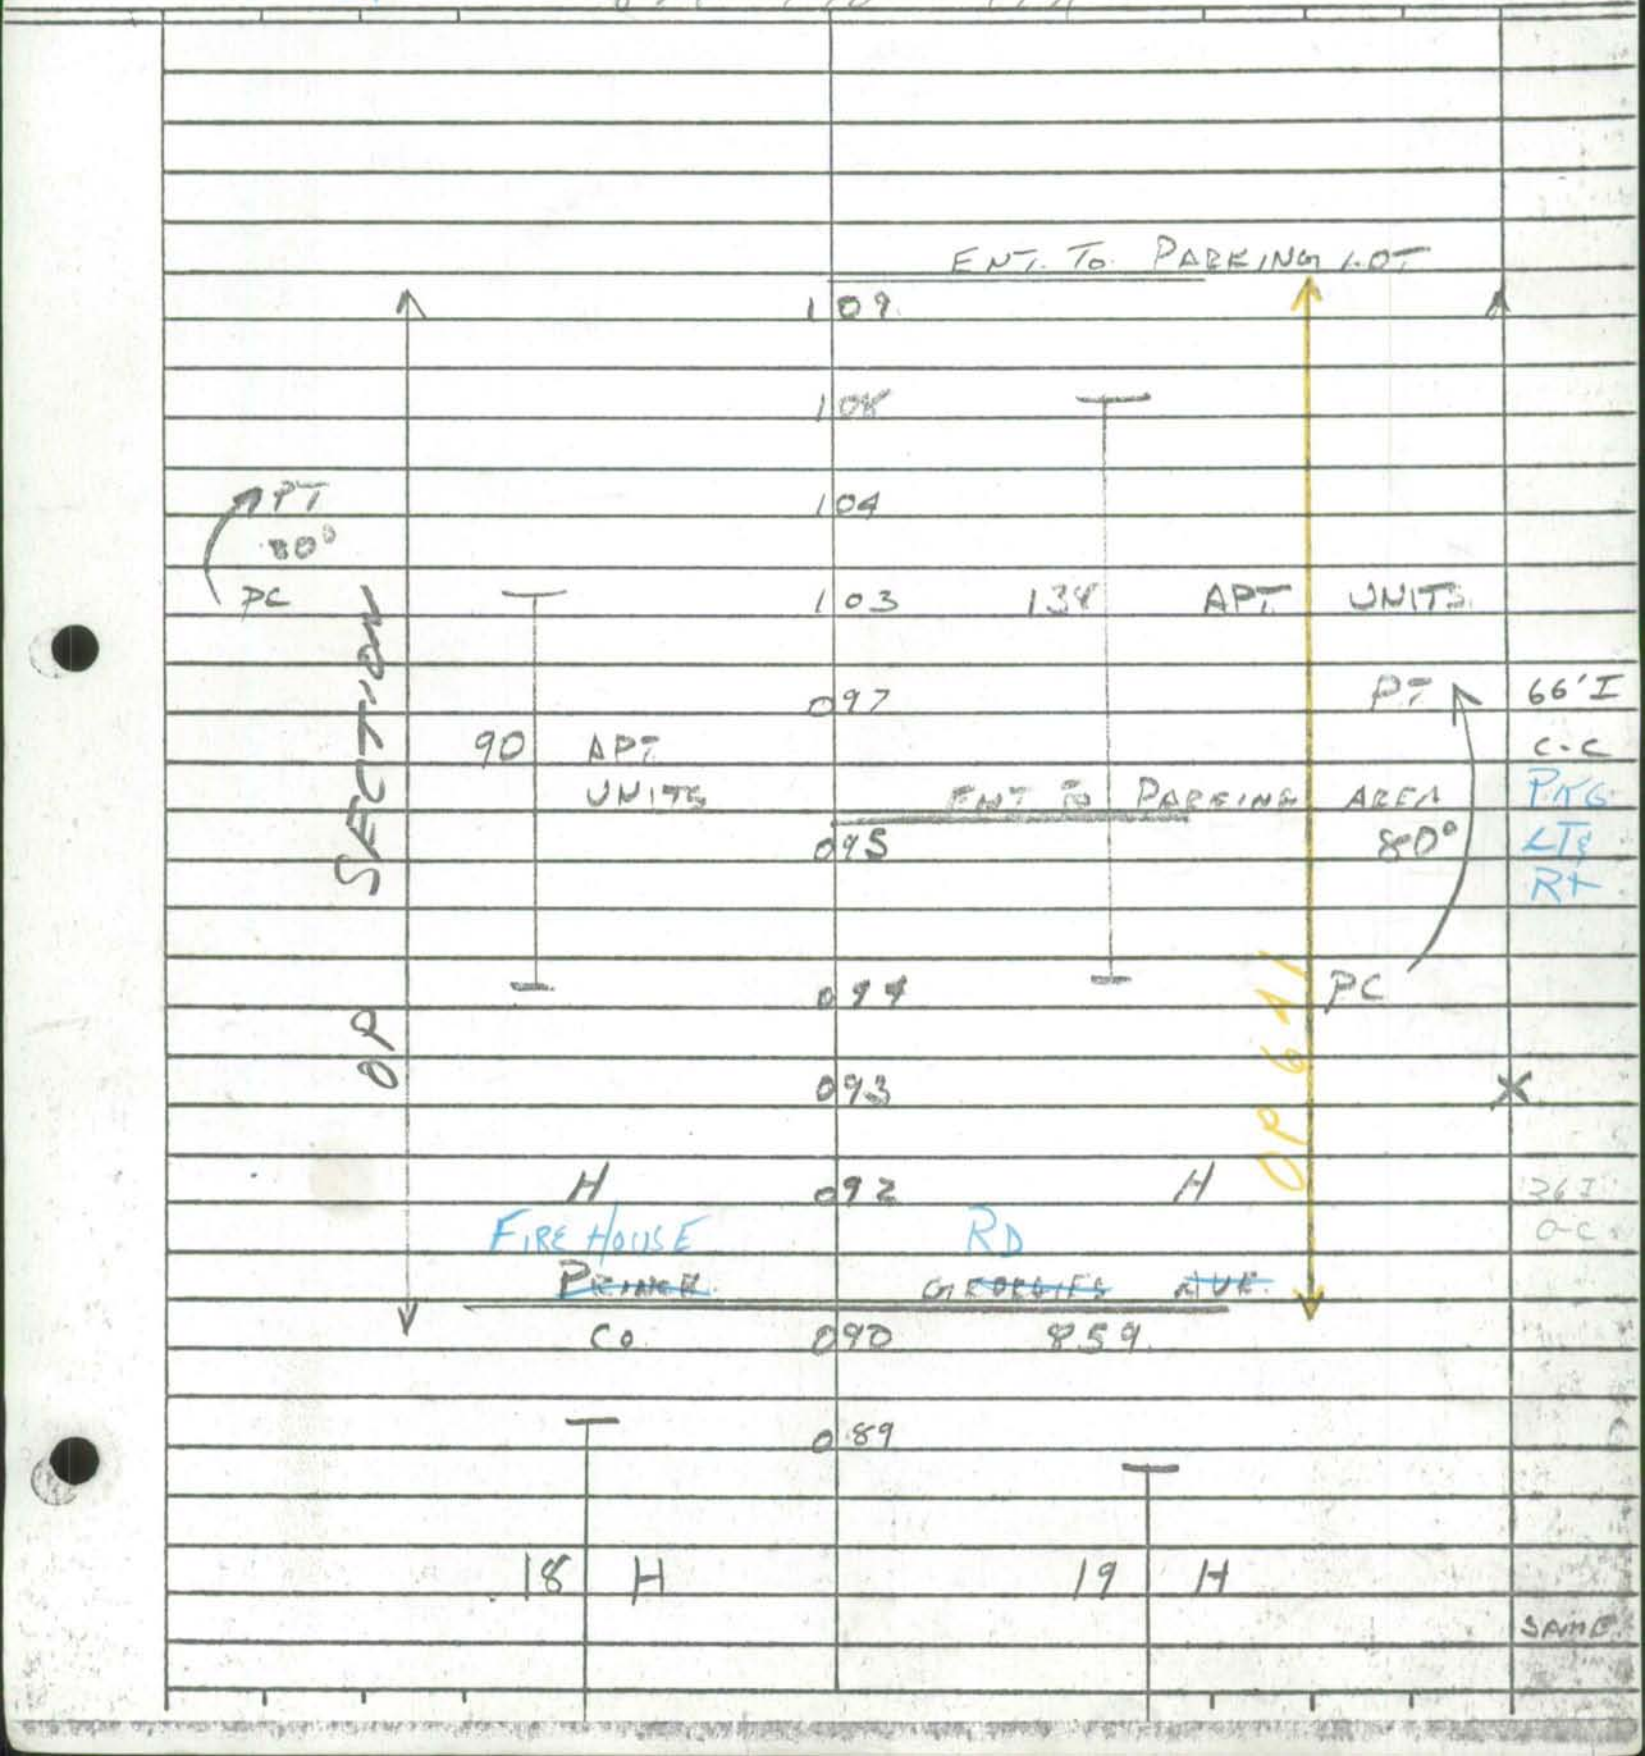

Rural

SHA 51.3-8
11-15-72

STATE HIGHWAY ADMINISTRATION OF MARYLAND

ROAD INVENTORY SHEET

Party Chief W. DOMBROSKI
Recorder M. ZALENSKI
Helper

Map No. ~~39~~ H11

Road No. OP 642
Road Name
Sheet No. 1 OF 1
Date 6-29-77
County PRINCE GEORGES
State Coordinates 794-299

	H	AUTO JUNK YARD	
S ↑	ROAD	0 17 END	^
		0 14 H	
		0 12 H	
	H	0 05 H	18'E 18'CW
	CO MANNING	000	V
		EAST	

SHA 51.3-8
11-15-72

ROAD INVENTORY SHEET

Road No. _____
Road Name _____
Sheet No. _____
Date _____
County _____
State Coordinates _____

SHA 51.3-8
11-15-72

STATE HIGHWAY ADMINISTRATION OF MARYLAND

FAU

O.P. 643

ROAD INVENTORY SHEET

Party Chief R.Bush (OFFICE INV)
Recorder
Helper

Map No. M35
INDEX 6

Ver 9-2777

Road No. Co 707
Road Name BROOKS DR N
Sheet No. 1 OF 1
Date 11-17-67 REVISED 7-1-74
County PR GEO
State Coordinates 822-373

CROSIER PL.
~~DAVIS ST~~
Co ~~PVT~~ ~~P~~ 89-67 .007
4998

O.P. 643

.005

.003

.000

Crossover

DR

2828

BROOKS CO

N

20'I
20'CW
~~8'E~~
~~2-3'E Shld~~
~~24'CW~~

19'I
CURB Lt
~~3'E Shld Rt~~
22'CW

Form 6 HPS (Rev. 1961)

MAP 7

~~OP644~~

~~OF 154~~

NEW KIRK AVE.

ROAD INVENTORY SHEET

Party Chief E S.
Recorder W.D
Chainman

FORESTVILLE

Road No. CO 736
Name [illegible] AVE
Sheet No. 1 OF 1
Date 10-17-68
County PRINCE GEO

836-367 M35

UNASSIGNED
NOW CO
7A-105

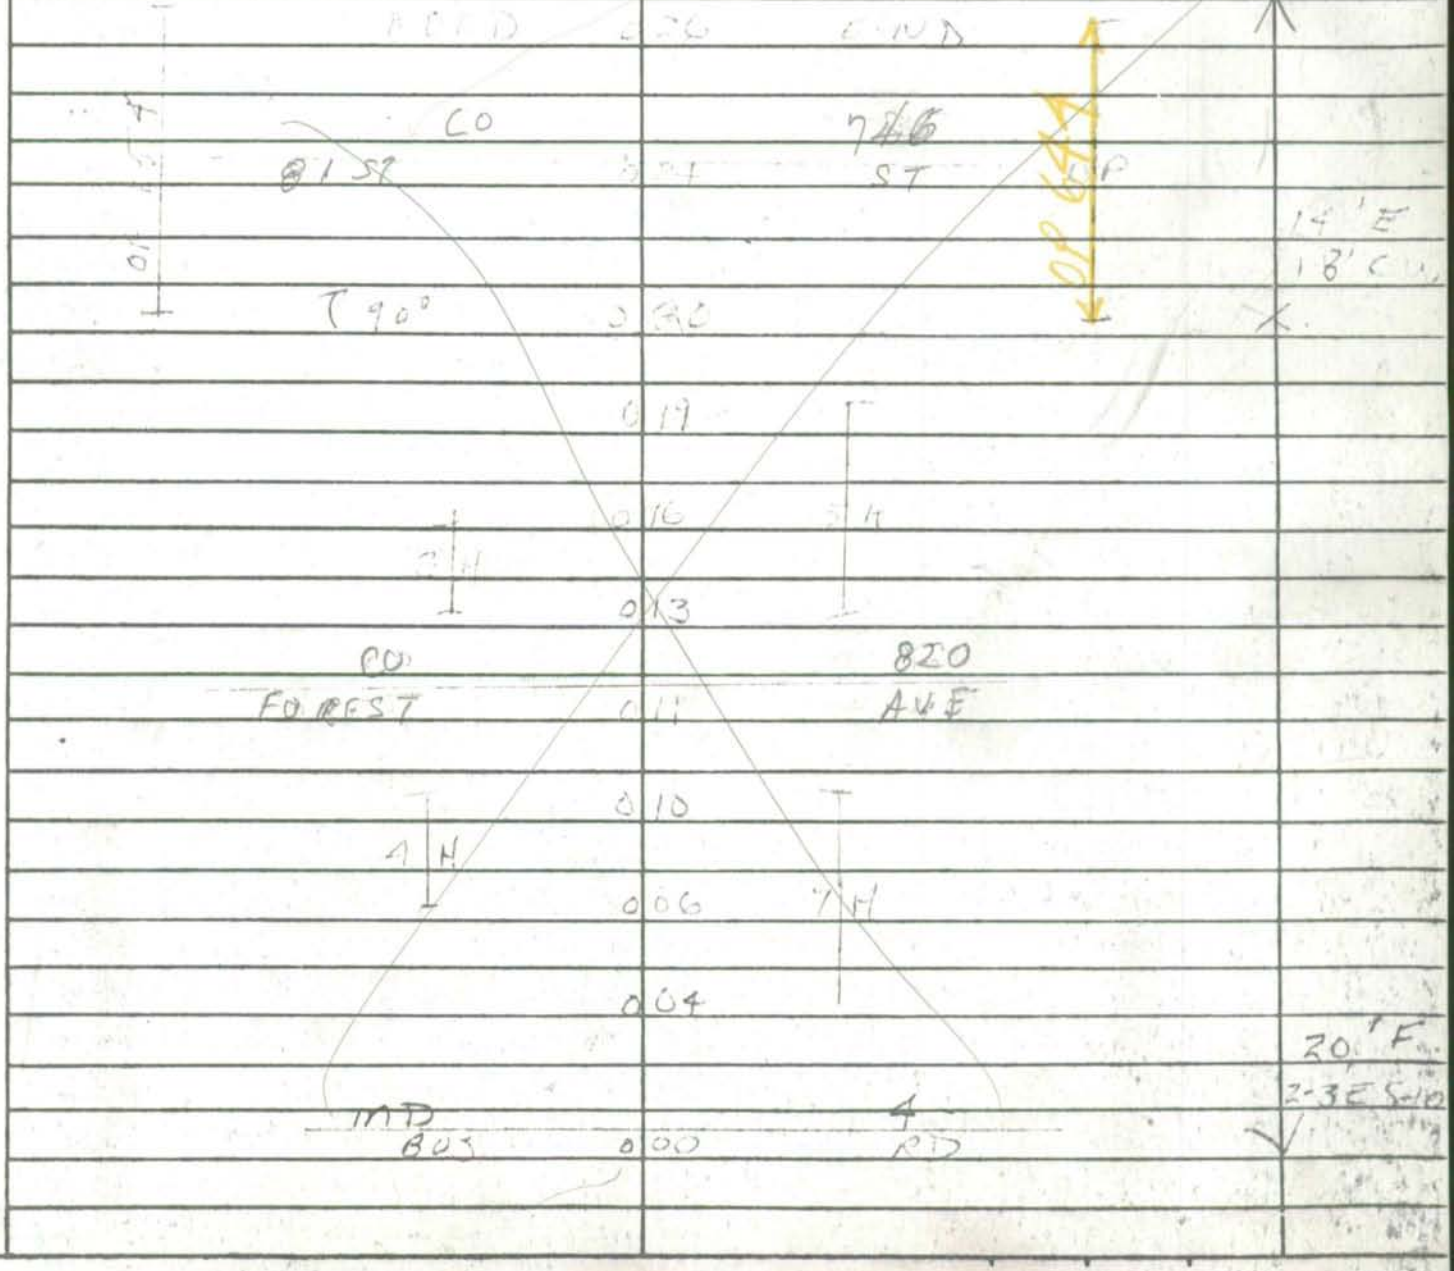

Form 6 HPS (Rev. 1961)

FAU MAP 7

O.P. 645

ROAD INVENTORY SHEET

ORLEANS AVE

Party Chief E.S.
Recorder W.D.
Chainman

VER 9-15-77
FORESTVILLE
435 - 368
~~336 - 367~~ M35

Road No. CO 737
Name ~~CO RD~~ [illegible]
Sheet No. 1 of 1
Date 10-17-68
County PRINCE GEO

ROAD	016	END	
	015	4 H	
5 H	013		
	012		
	011		
		CO F.20	
	010	FOREST AVE	
	009		
3 H			
	007	4 H	
	005		
I.O.O.F.	001		
			18' H
MD		4	2-3 SHO
BUS	000	RD	✓

Form 6 HPS (Rev. 1961)

Reassigned 2-17-71 GJG
Previous OP 646 NW Co. 748
69-171)

ROAD INVENTORY SHEET

Urban

Party Chief E. Schuyler
Recorder N. GORMAN
Chainman

GREENBELT.

VER 6-12-78

F11B

Road No. OP 646
Name COURT 55-Ridge Rd.
Sheet No. 1 OF 1
Date 5/23/67
County PRINCE GEORGES

836-428 A-31

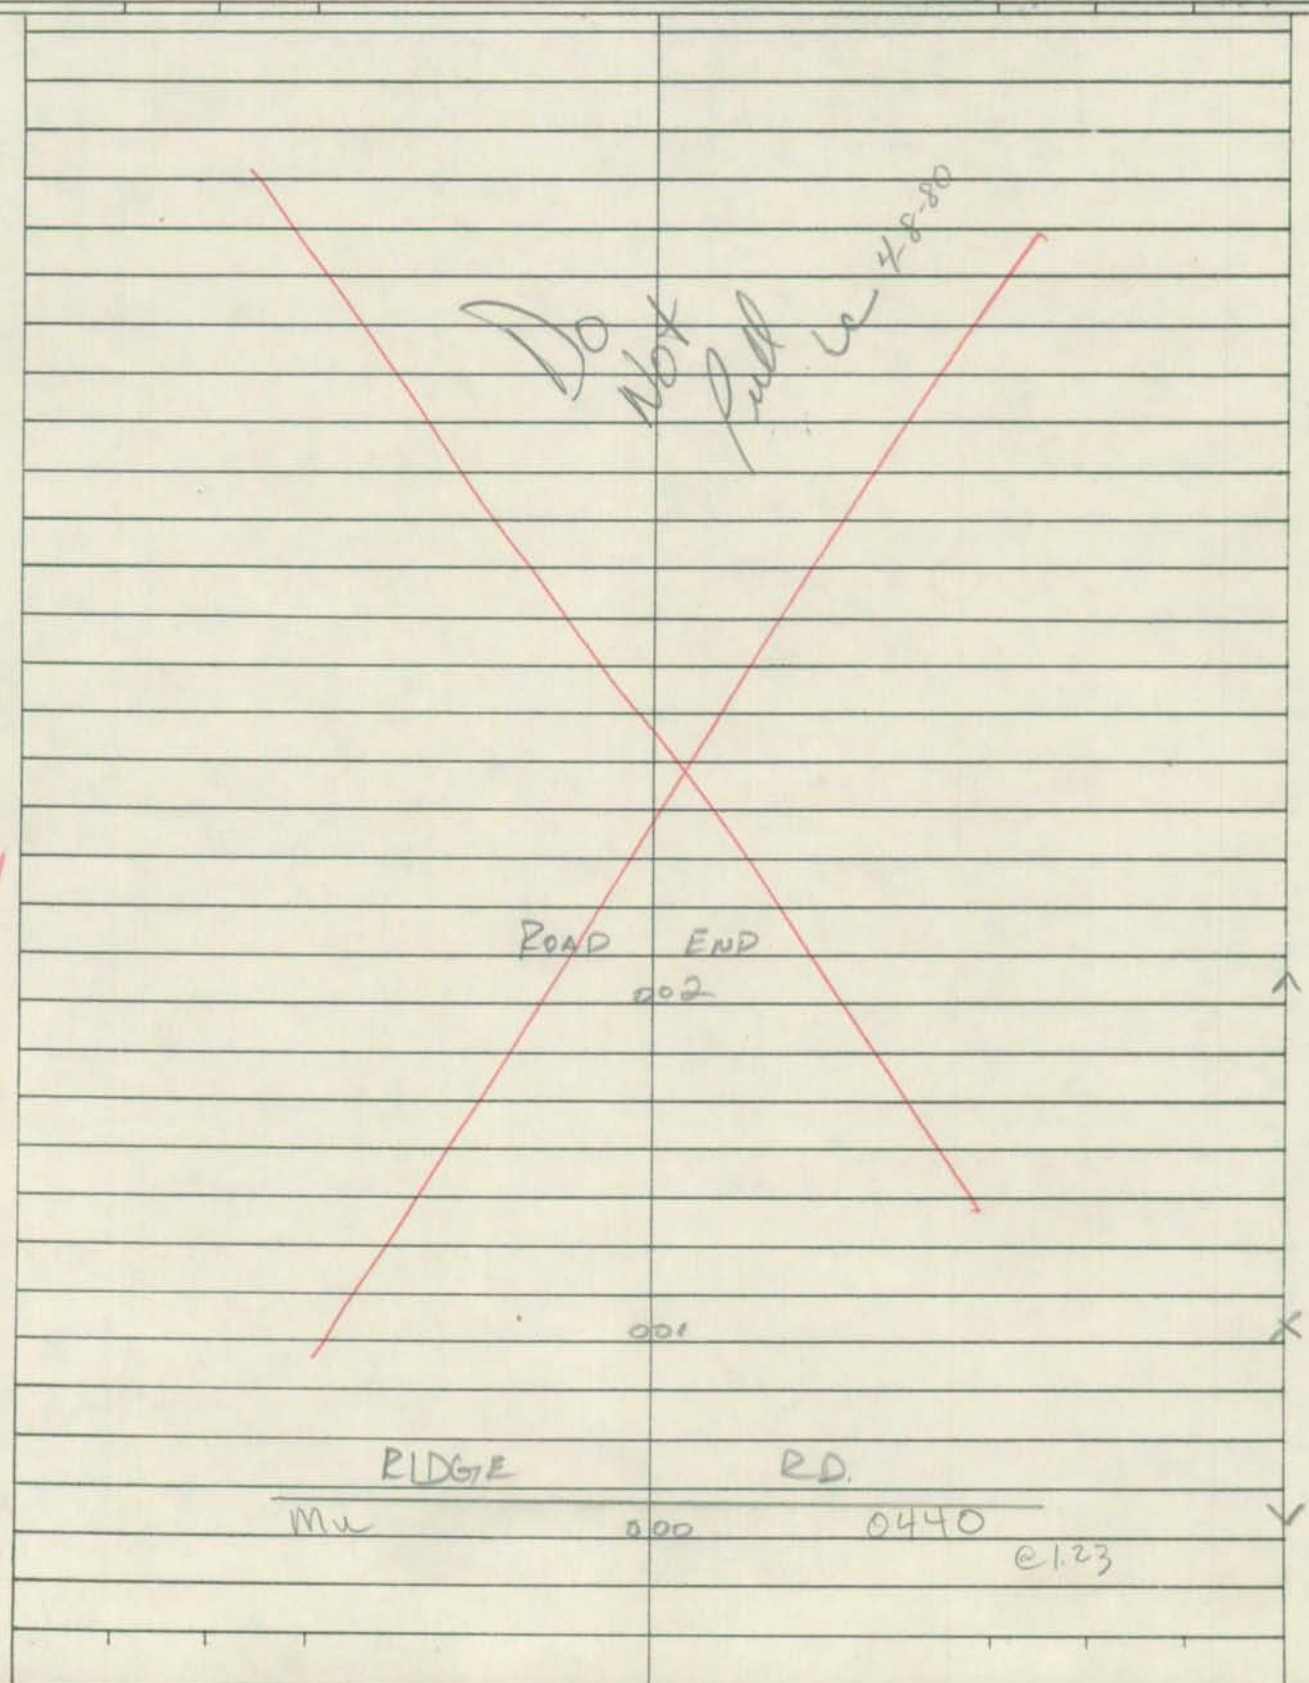

Reassigned 2-17-71 GJG
(Previous OP 646 Now Co. 748 69-171)

Form 6 HPS (Rev. 1961)

ROAD INVENTORY SHEET

Urban

Party Chief E. Schuyler
Recorder N. Gorman
Chainman

GREENBELT

Road No. OP 646
Name COURT SS-Ridge Rd.
Sheet No. 1 OF 1
Date 5/23/67
County PRINCE GEORGES

VER 6-12-74

F11B

836-428 A-31

Do not fill in 4-8-80

W

ROAD END

002

001

58'G
58'CW

18'G
C-C

RIDGE RD.

MH 000 0440

@1.23

Form 6 HPS (Rev. 1961) MAP 7 FAU

ROAD INVENTORY SHEET

OCALA OP 647

Party Chief E.S
Recorder V.D.
Chainman

Ver 10-10-77

N. FOREST VILLAGE

837-~~370~~ 371 M35

Road No. CO 749
Name [illegible] ST
Sheet No. 1 OF 1
Date 12-22-65
County PRINCE GEO.

PULL

		20		
		17		16'E
	CO		748	16'CW
T 45°	(~~[illegible]~~)	016	DR	
	VINEYARD		DR	
	11 H	014	8 H	
		003		26'I
	CO		592	C-C
	PARK	000	BLVD	

PPS (Rev. 1961)

Ver
10-13-77

72-102 extra

OP 648 M

ROAD INVENTORY SHEET

W. Dombroski
O. Taylor

Road No. G.752
Road Name Berry La
Sheet No. 1 of 1
Date 2-28-73
County Prince Georges

LANDON
M-35
PHILLIPS
2/9/75
REVISED

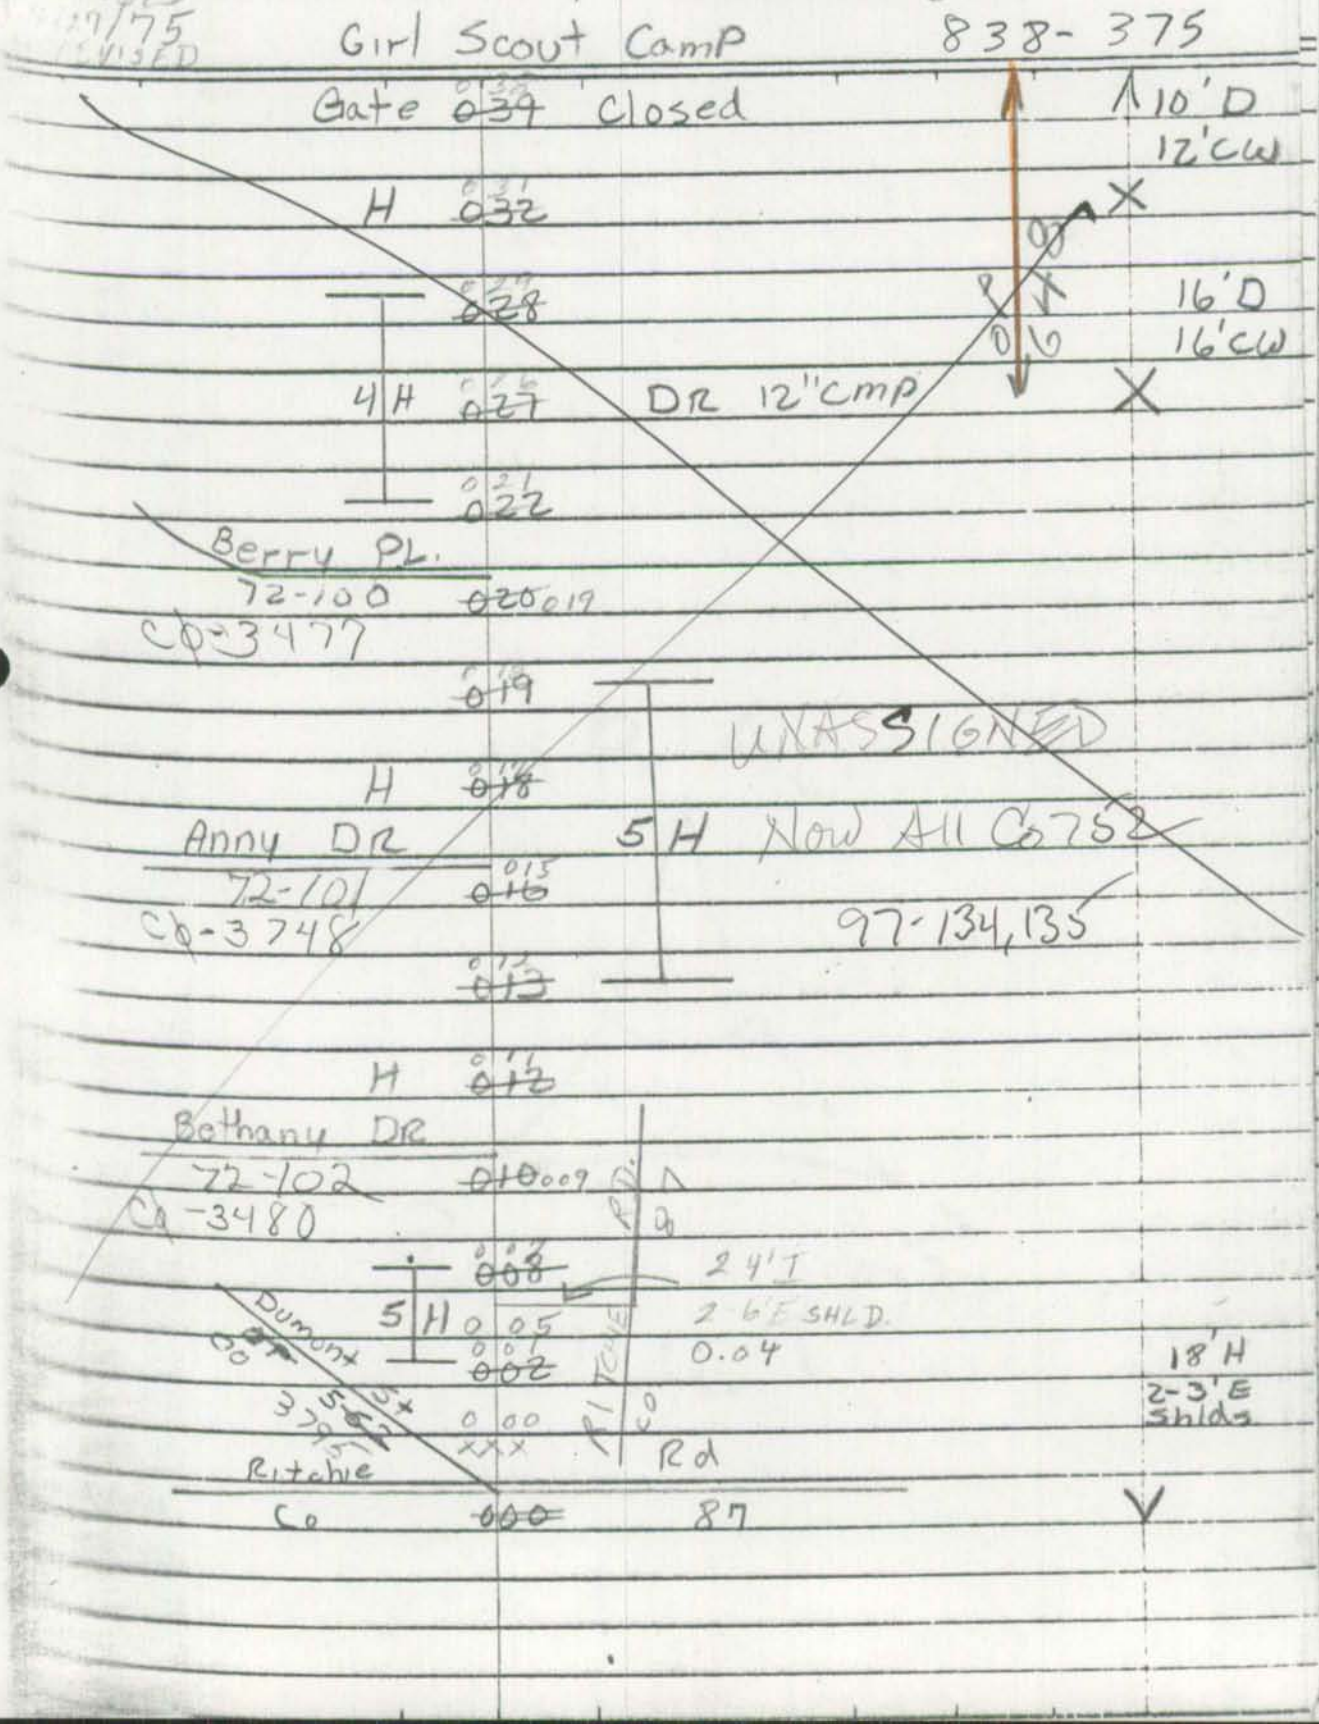

Form 6 HPS (Rev. 1961) FAU MAP 7 OP 649

ROAD INVENTORY SHEET

Party Chief E.S.
Recorder W.D.
Chainman

64-I-71 WESTPHILIA 940-369 ~~839-368~~ M35

VEQ 7-21-71

Road No. CO 761
Name WILLOW AVE
Sheet No. 1 OF 1
Date 10-31-68
County PRINCE GEO

ROAD	011	END	
			14' E
CO 760			14' CW
POPLAR DR	009		
H	004	6 H	
	002		
			18' H
CO		757	2-3' ESHO
OAK	000	ST.	

Form 6 HPS (Rev. 1961)

MAP 3

ROAD INVENTORY SHEET

OP 650

14TH PLACE

Party Chief E. SCHUYLER
Recorder N GORMAN
Chainman

CHILLUM HEIGHTS

-410

804-411 M31

Road No. Co 782
Name MADISON ST
Sheet No. 1 OF 1
Date 7/26/67
County PRINCE GEORGES

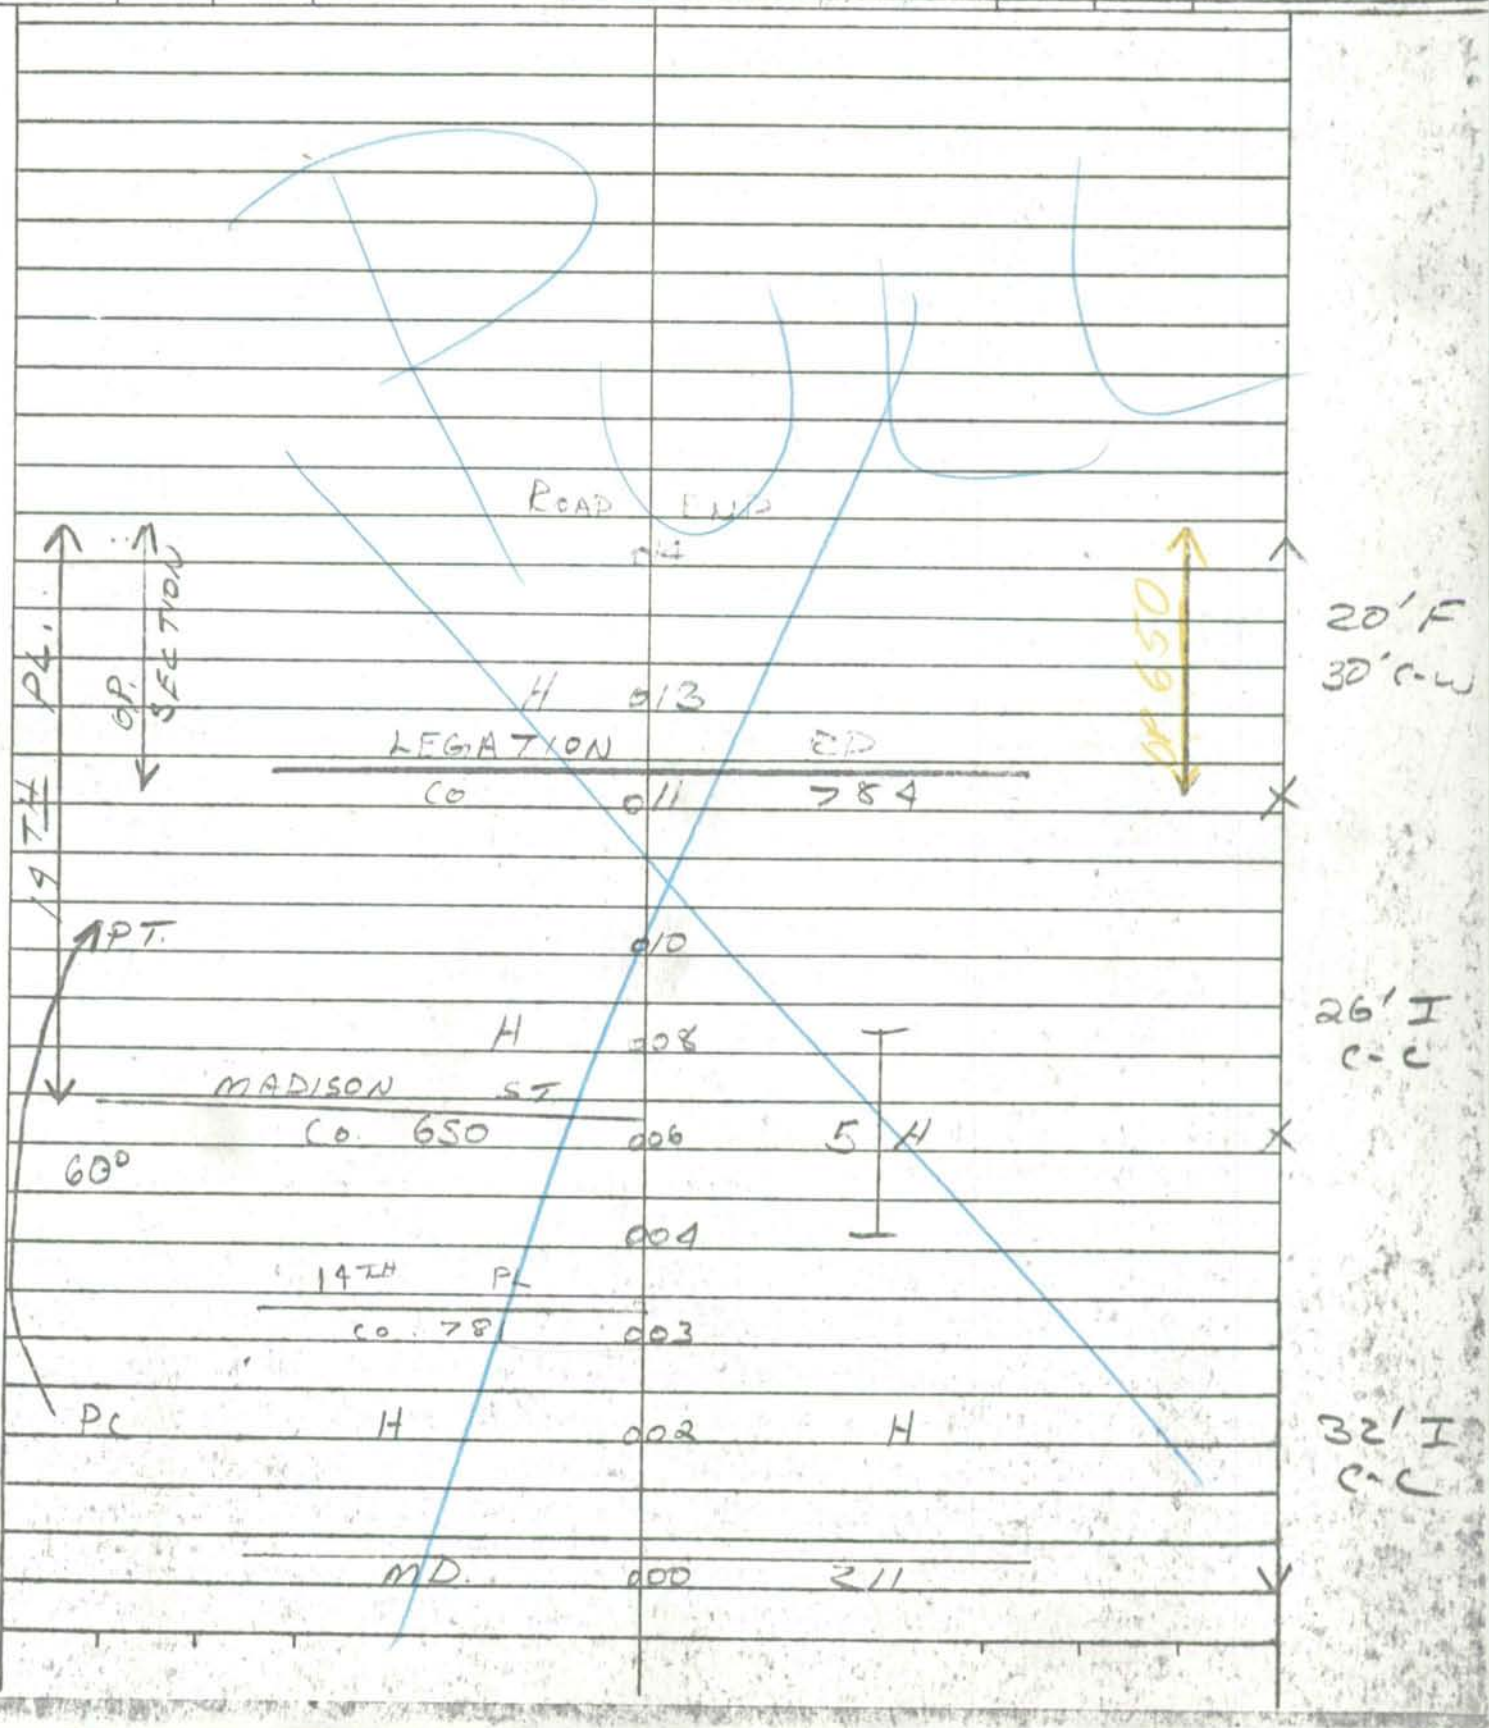

FORM C.H.S. (REV. 1961)

ROAD INVENTORY SHEET

MAP 7

OP651

Party Chief E. SCHUYLER
Recorder H. GOERMER
Chainman

BERKSHIRE

VER
9-14-77
830-870 M35

Road No. CO. 901
Name GUILFORD ST.
Sheet No. 1 OF 1
Date 11/29/67
County PRINCE GEORGES

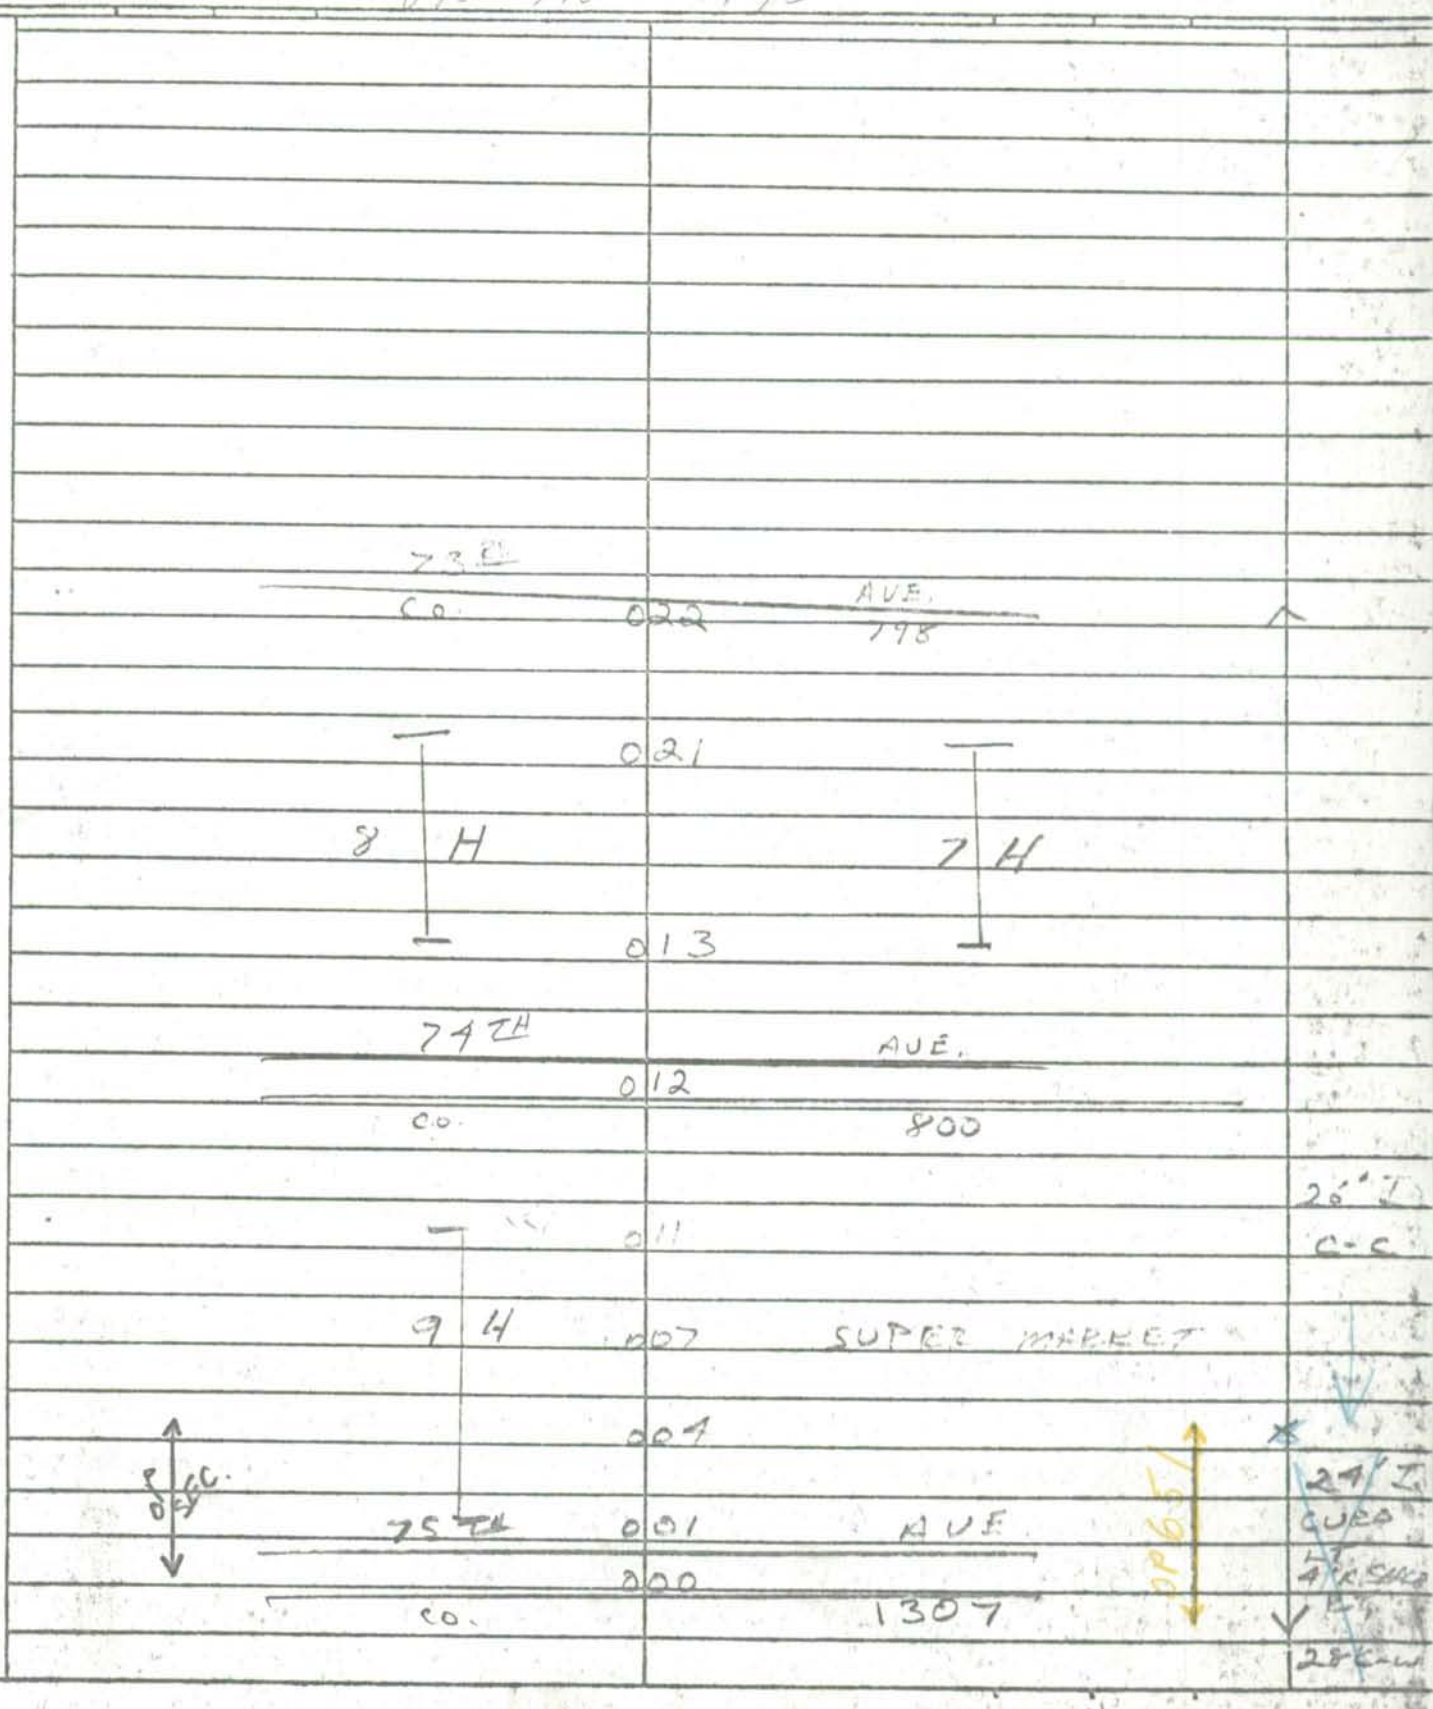

Form 6 HPS (Rev. 1961)

+ 11 K

ROAD INVENTORY SHEET

08652 OPEN NO

Party Chief E. SNYDER
Recorder W. [illegible]
Chainman
61-228

Gen Hwy MAP 13

629
830 - 307 M39

Road No. Co 819
Name MISTER R D.
Sheet No. 1 of 1
Date 7 - 19 - 68
County PRINCE GEORGES

PULL 7-7 6-23

ROAD 11 633 ANGLY END 14' C

ROAD END

11 11

D 19 PT 30°

D 17 PC

14' T

CO 1.5' V

CEDARVILLE D 00 RD

MAP 7 + 11

ROAD INVENTORY SHEET

OP 653
XAVIER La.

Party Chief E. SCHUYLER
Recorder H. GOLDMAN
Chainman

BERKSHIRE

Road No. CO. 922
Name ~~MINION DR.~~
Sheet No. 1 OF 1
Date 11/29/67
County PRINCE GEORGES

Name Change
Effective 1-20-70

71-53
UNASSIGNED
NOW CO 822

WALTERS

CO

27

26

23

32

17

006

004 REAL ESTATE

002 SNACK BAR

~~ATD.~~ ~~BUS~~ ~~4~~

CO 000 3074

90°

18' H

45' H

16'D
2-4'A
SHLDS.
24'C-C

18'G
2-3'E
SHLD.S.
24'C-C

23' I
C-C

Form 6 HPS (Rev. 1961)

OP 654
CO 823

ROAD INVENTORY SHEET

MAP 10 FAIR

Party Chief
Recorder
Chainman

Road No.
Name MOORE
Sheet No. 1 OF 2
Date
County

BLANDFORD
DIRIDGE
835-
823-321 M39

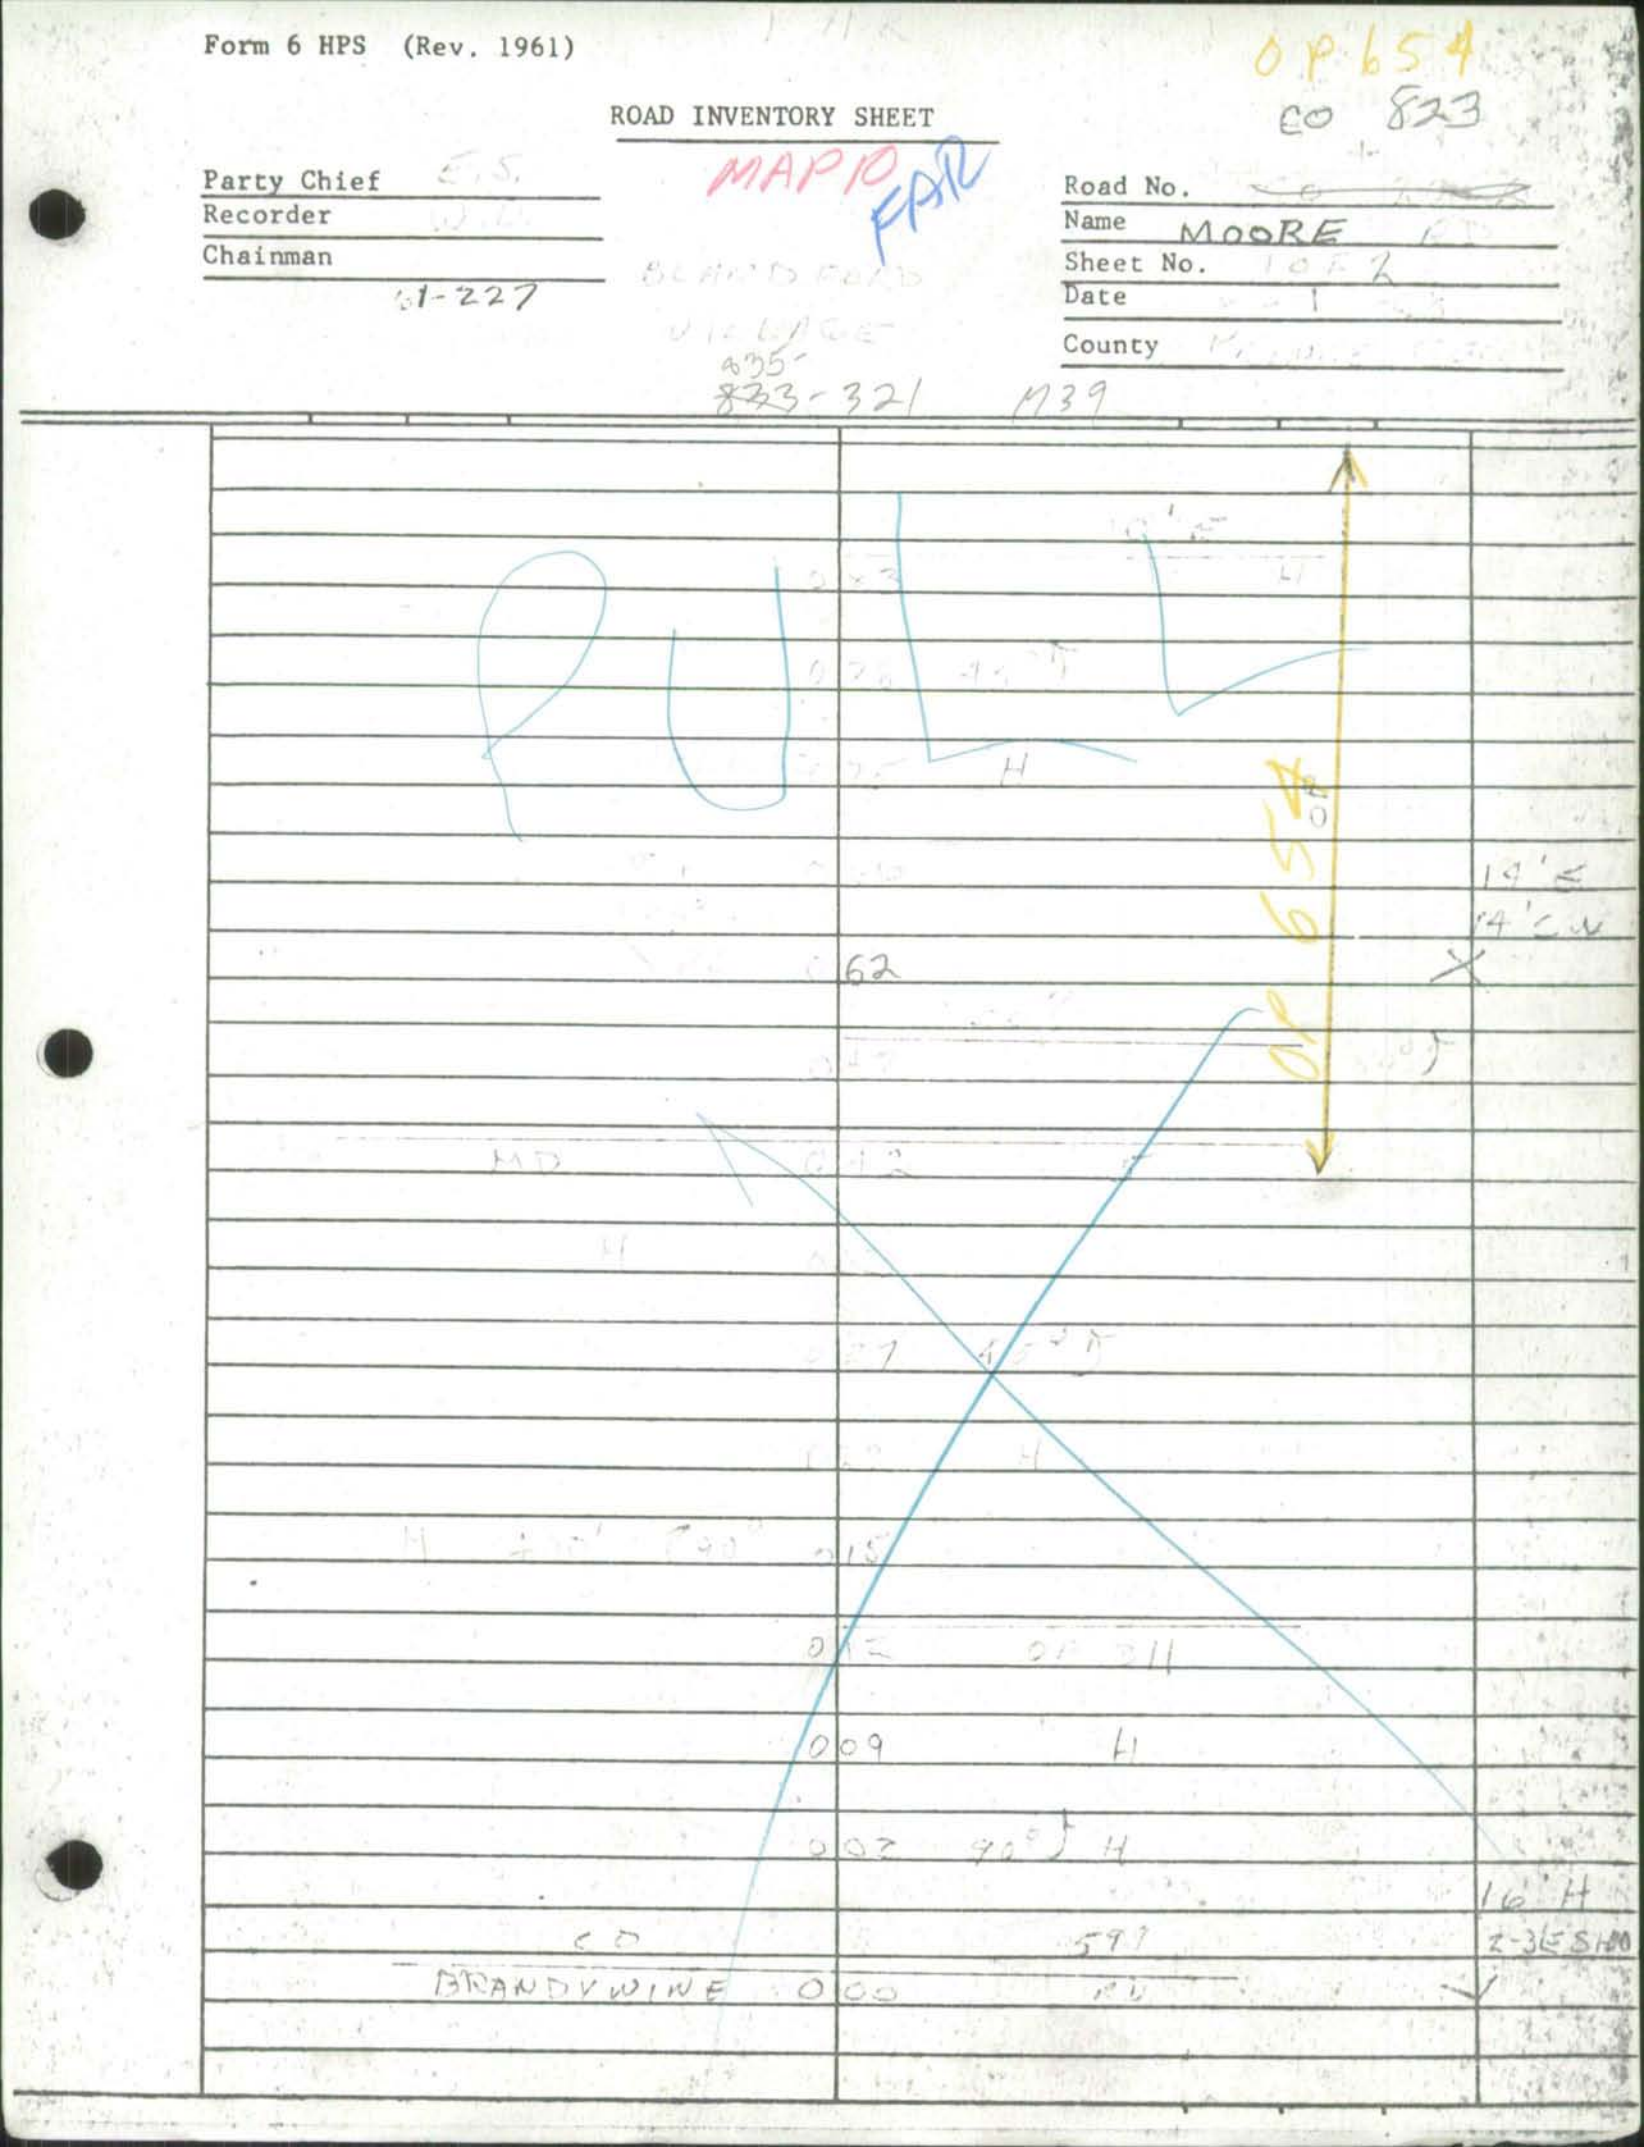

Form 6 HPS (Rev. 1961)

OP654

ROAD INVENTORY SHEET

CO 823

Party Chief
Recorder
Chainman

IAR

Road No.
Name
Sheet No.
Date
County

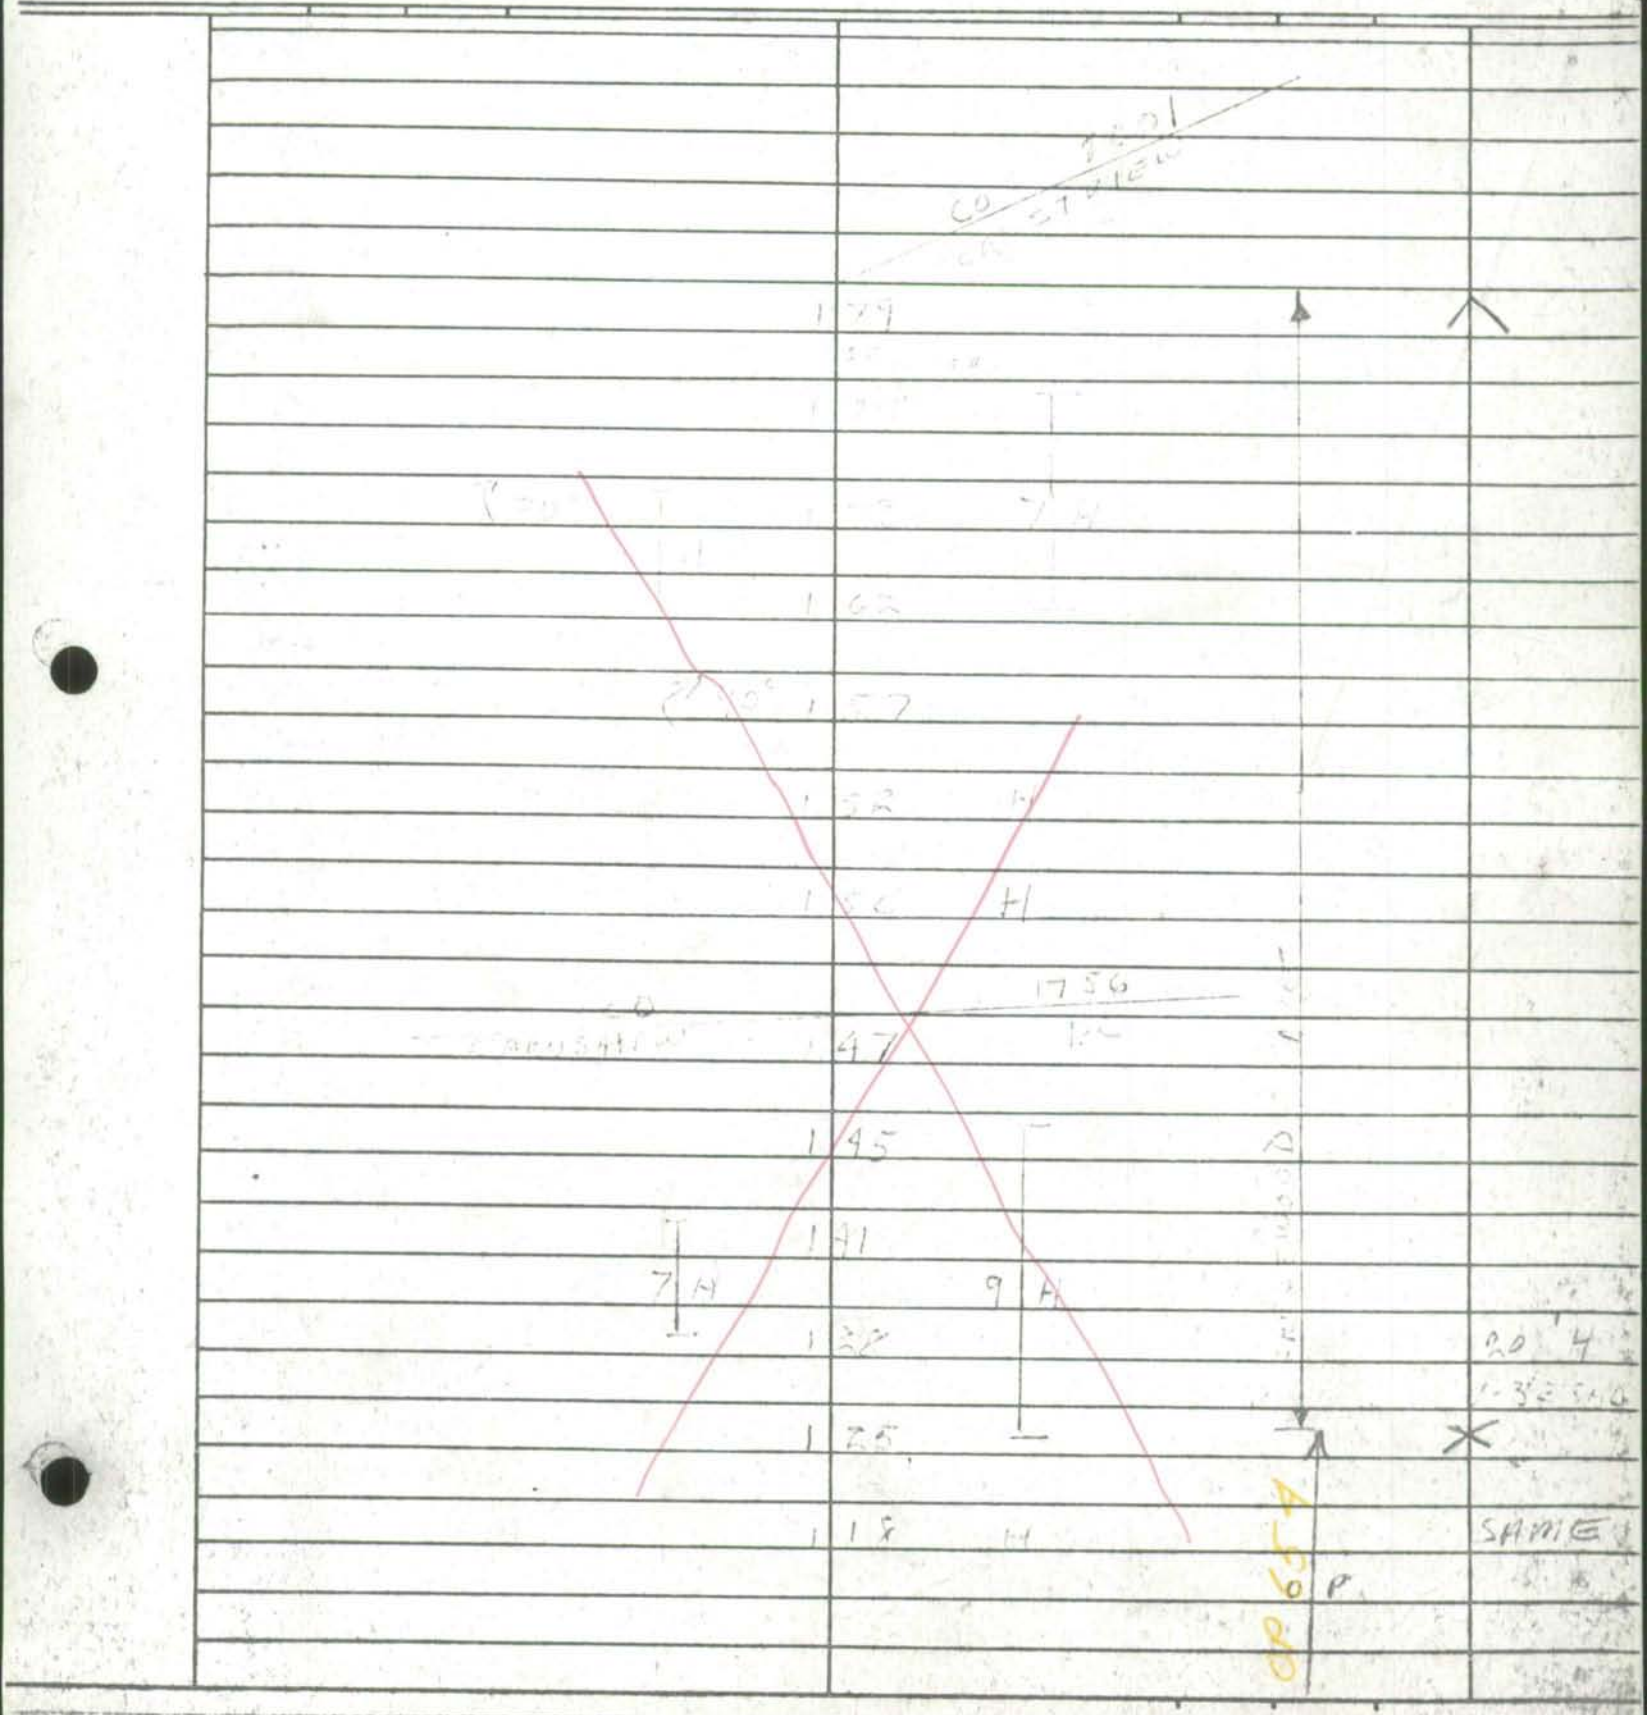

Form 6 HPS (Rev. 1961) MAP 3 FAU OP655 UNASS.

ROAD INVENTORY SHEET

PARTY CHIEF Edward Schuyler
RECORDER Henry Gorman
CHAINMAN

ROAD NO. Co. 849
NAME TECUMSEH ST.
SHEET NO. 1 OF 1
DATE 8/1962
COUNTY PRINCE GEORGE'S

809-425 M31 Road END

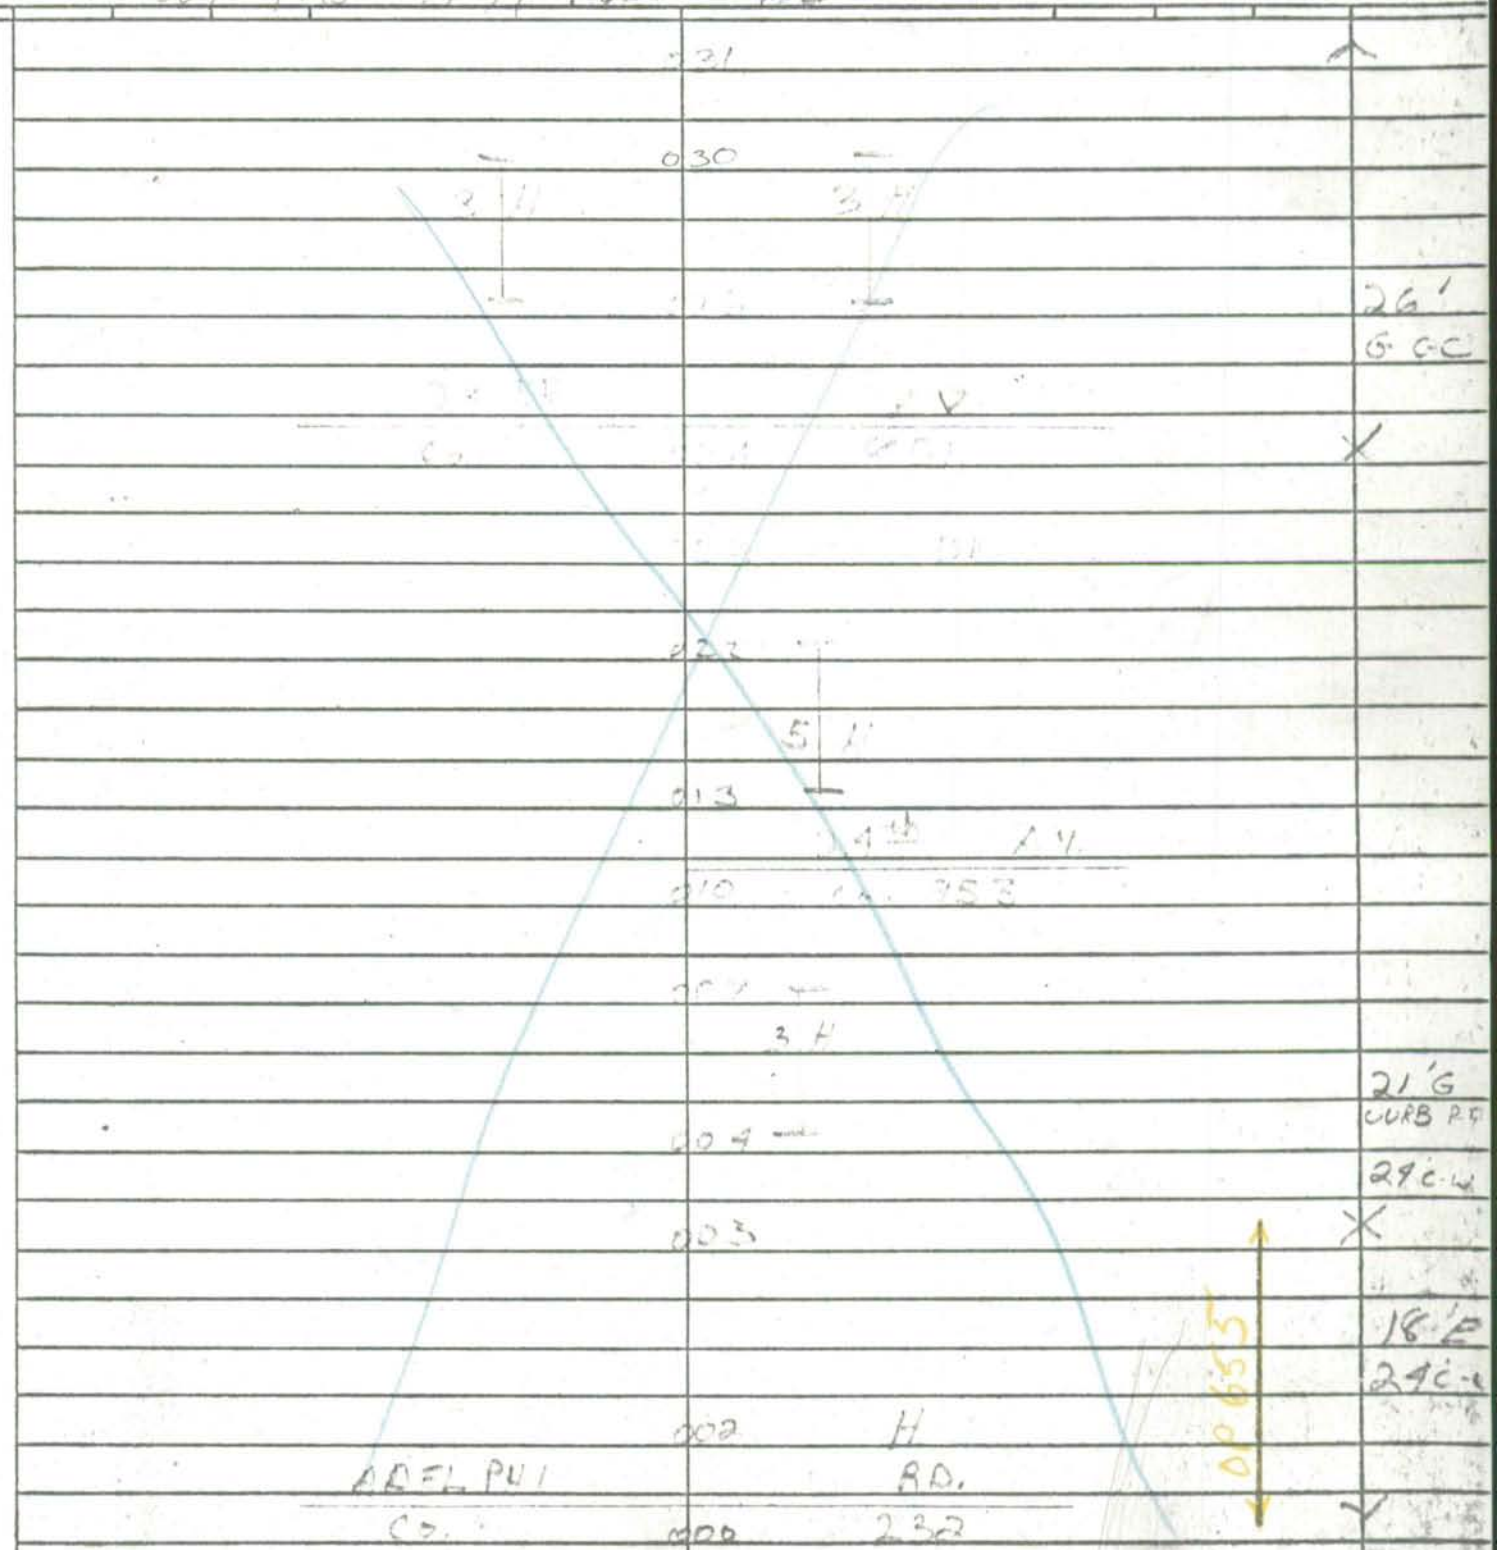

Form 6 HPS (Rev. 1961) MAP 7 OP65G

ROAD INVENTORY SHEET

Party Chief E.S.
Recorder N.D.
Chainman

FAU Ver 10-10-77

DIST. HGTS.

835-371 M35

Road No. CO 893
Name MASON ~~DR~~ ST
Sheet No. 1 OF 2
Date 10-10-77
County PRINCE GEO

ROAD	075	END	
		1363	
	072	~~LINE~~	
Over-dale		PL	
	078		
		730	
[illegible]	077	AVE	
81ST	082	AVE	
CO		721	
80TH	076	AVE	
			26' I
CO		733	C-C
79TH	071	AVE	X
CO		728	
BOWES	062	AVE	
CO		1309	
WINTERGREEN	052	AVE	
CO		1302	
ROSLYN	052	AVE	
CORP. Limits	049	of District HGTS.	SAME

Form 6 HPS (Rev. 1961)

FAU

OP657

ROAD INVENTORY SHEET

MAP 3

PARTY CHIEF Edward Schuyler
RECORDER Henry Gorman
CHAINMAN T. LANDON

ROAD NO. Co. 699
NAME NEWTON ST.
SHEET NO. 1 OF 3
DATE 8/31/67
COUNTY PRINCE GEORGES

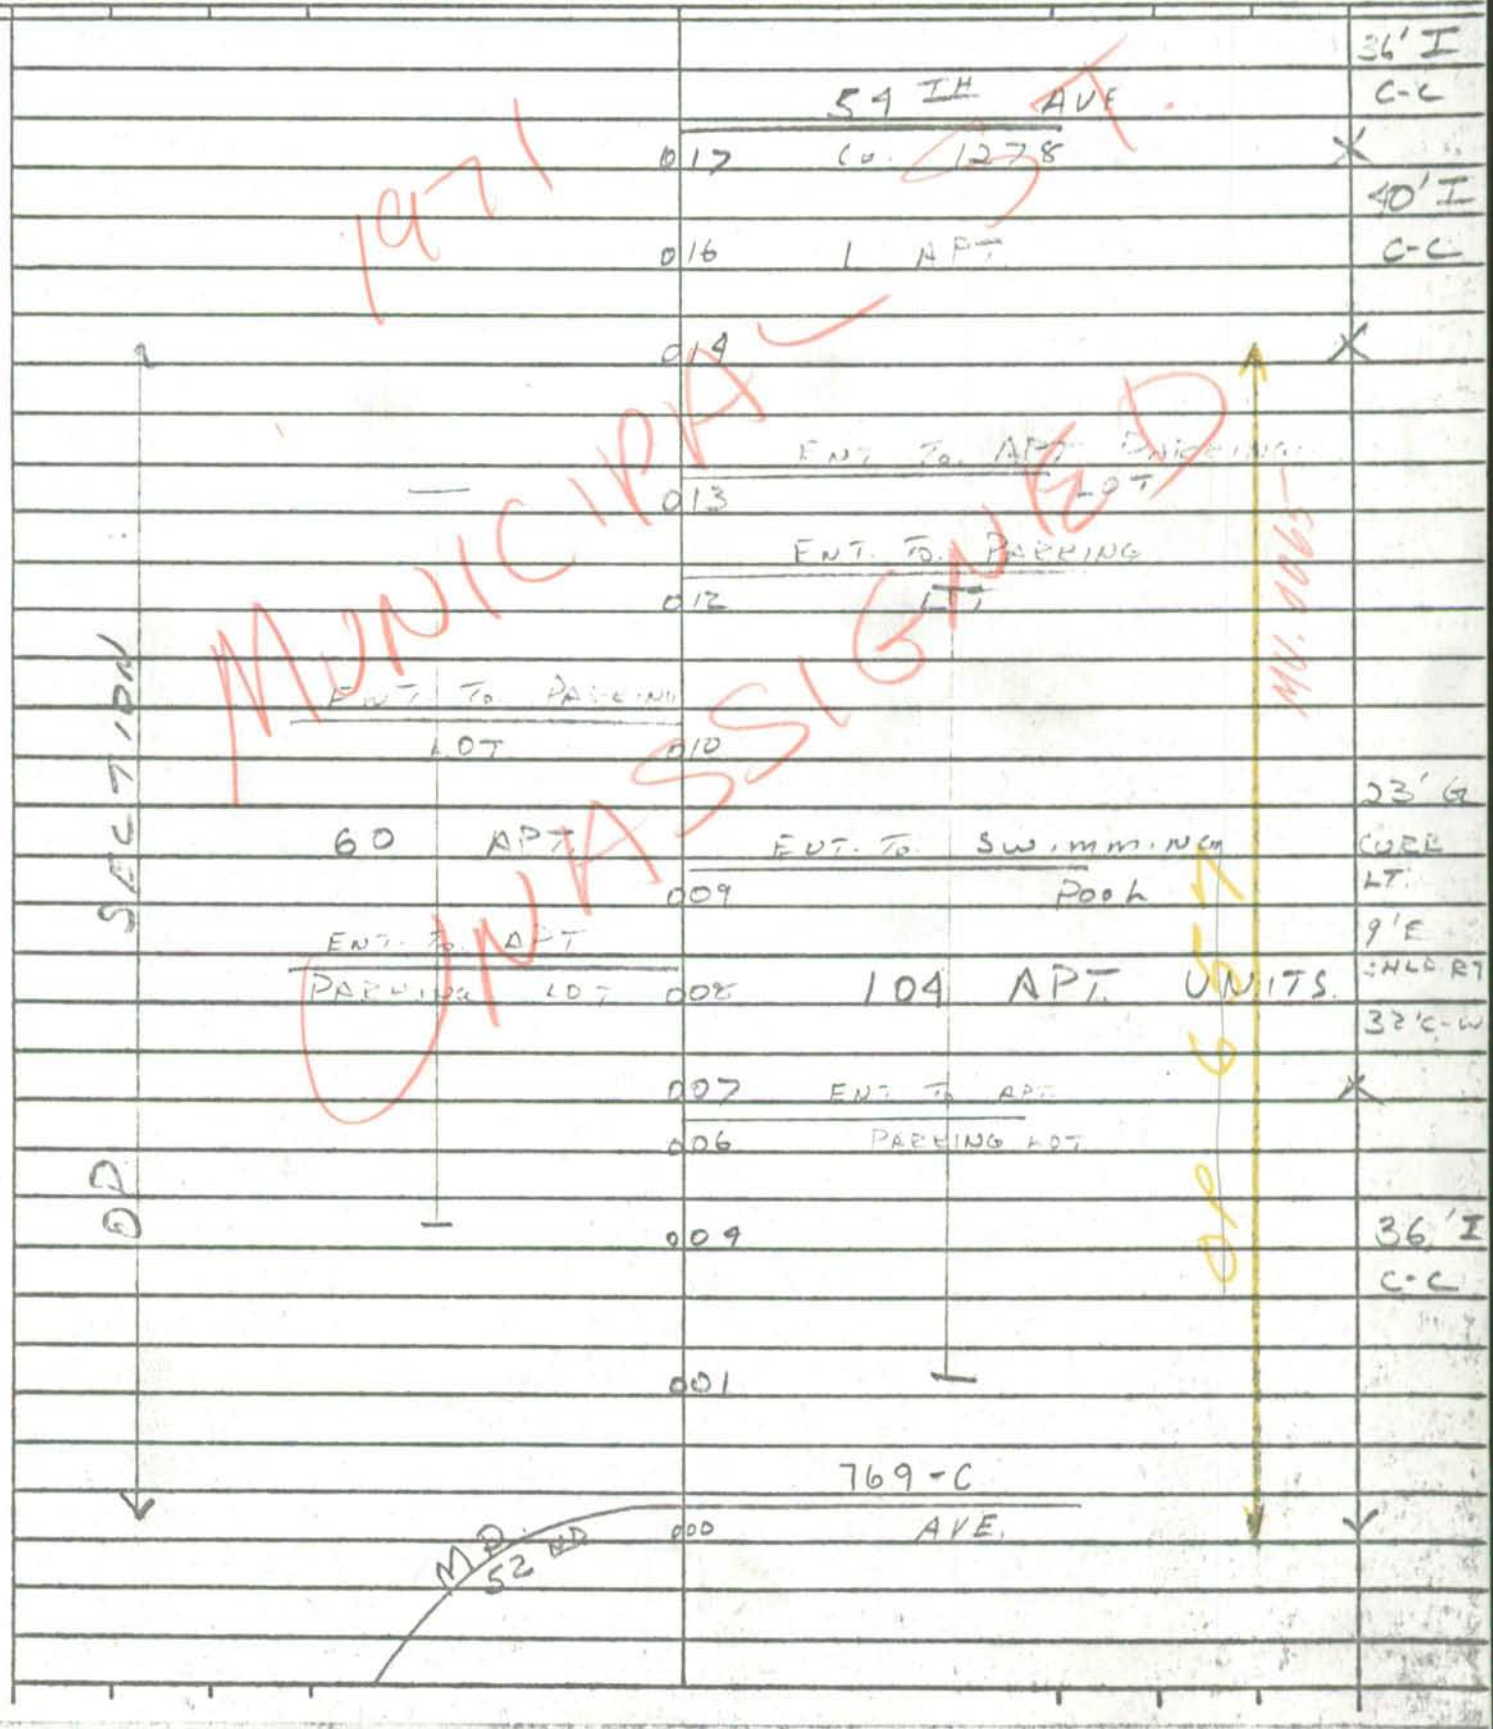

Form 6 HPS (Rev. 1961) FAU MAP 9 OP 658

ROAD INVENTORY SHEET

4

Party Chief E. S.
Recorder W. D.
Chainman

N. BARNABY
357
& 814-356 M35

Road No. Co 912
Name TEMPLE BLVD
Sheet No. 1 OF
Date 11-20-68
County PRINCE GEO

UNASSIGNED (NBT)
NOW
Co 912
1976

ROAD	026	END	
~~OP~~ Co		~~517~~ 3970 ~~1423~~ (X-53)	
~~PINE~~ JOEL	021	LA ~~ST~~	26'I c-c
Co		809	
JOAN	015	LA	X
Co		810	
JANICE	007	LA	
AMERICAN LEGION	005		20'I 2-3"E SH
Co		571	
FISHER	000	RD	✓

Form 6 HPS (Rev. 1961)

MAP 7

OP659

ROAD INVENTORY SHEET

Party Chief E.S.
Recorder W.D.
Chainman

61-153

MORNING SIDE

829-M62 M35

Road No. CO 415
Name [illegible]
Sheet No. 1 OF 1
Date 11-5-68
County PRINCE GEO

POLL

038

OP659

20' I

X

10

9 M

20' I

X

013

1 M

001

26' I
C-C

10

81

SUITLAND

000

RD

V

SHA 51.3 - 8 Revised
4.83

MARYLAND STATE HIGHWAY ADMINISTRATION

ROAD INVENTORY SHEET

Party Chief _____
Recorder _____
Assistant _____
Map No./Dir. 1
State Coordinates _____

Road No. OP 660
Road Name STUART LA
County PG
Date _____
Sheet No. _____ OF _____

SYSTEM				TRAFFIC		LINE DIAGRAM	TRAFFIC			PAVEMENT DATA
FED. AID.	FUNCT. CLASS.	HWY. SYS.	HPMS SAMPLE	PRK.G. REST.	COM/IND. ACCESS		CONTROL	COM/IND. ACCESS	PRK.G. REST.	

see INV
of C 5750
Co 920
94-107 Co

TRAFFIC CODES

TRAFFIC CONTROLS: STOP SIGN=SS, TRAFFIC LIGHT=T.L., FLASHING RED BALL=F.R.

TRAFFIC CODES

PARKING RESTRICTIONS: A.M. PEAK, P.M. PEAK, A.M./P.M. PEAK, NO PARKING ANYTIME=N.P., COMM/IND. ACCESS=E

SYSTEM				TRAFFIC		LINE DIAGRAM	TRAFFIC			PAVEMENT DATA
FED. AID.	FUNCT. CLASS.	HWY. SYS.	HPMS SAMPLE	PRKG. REST.	COM/IND ACCESS		CONTROL	COM/IND ACCESS	PRKG. REST.	

Form 6 HPS (Rev. 1961) FAU OP661

ROAD INVENTORY SHEET

Party Chief E.S.
Recorder W.D.
Chainman T.L.

MAP 10

Road No. Co 937
Name [illegible]
Sheet No. 1 OF 5
Date 9-26-67
County PRINCE GEO.

VER 7-28-71

COLES CORNER

839 - 345
~~344~~ - 344 A35

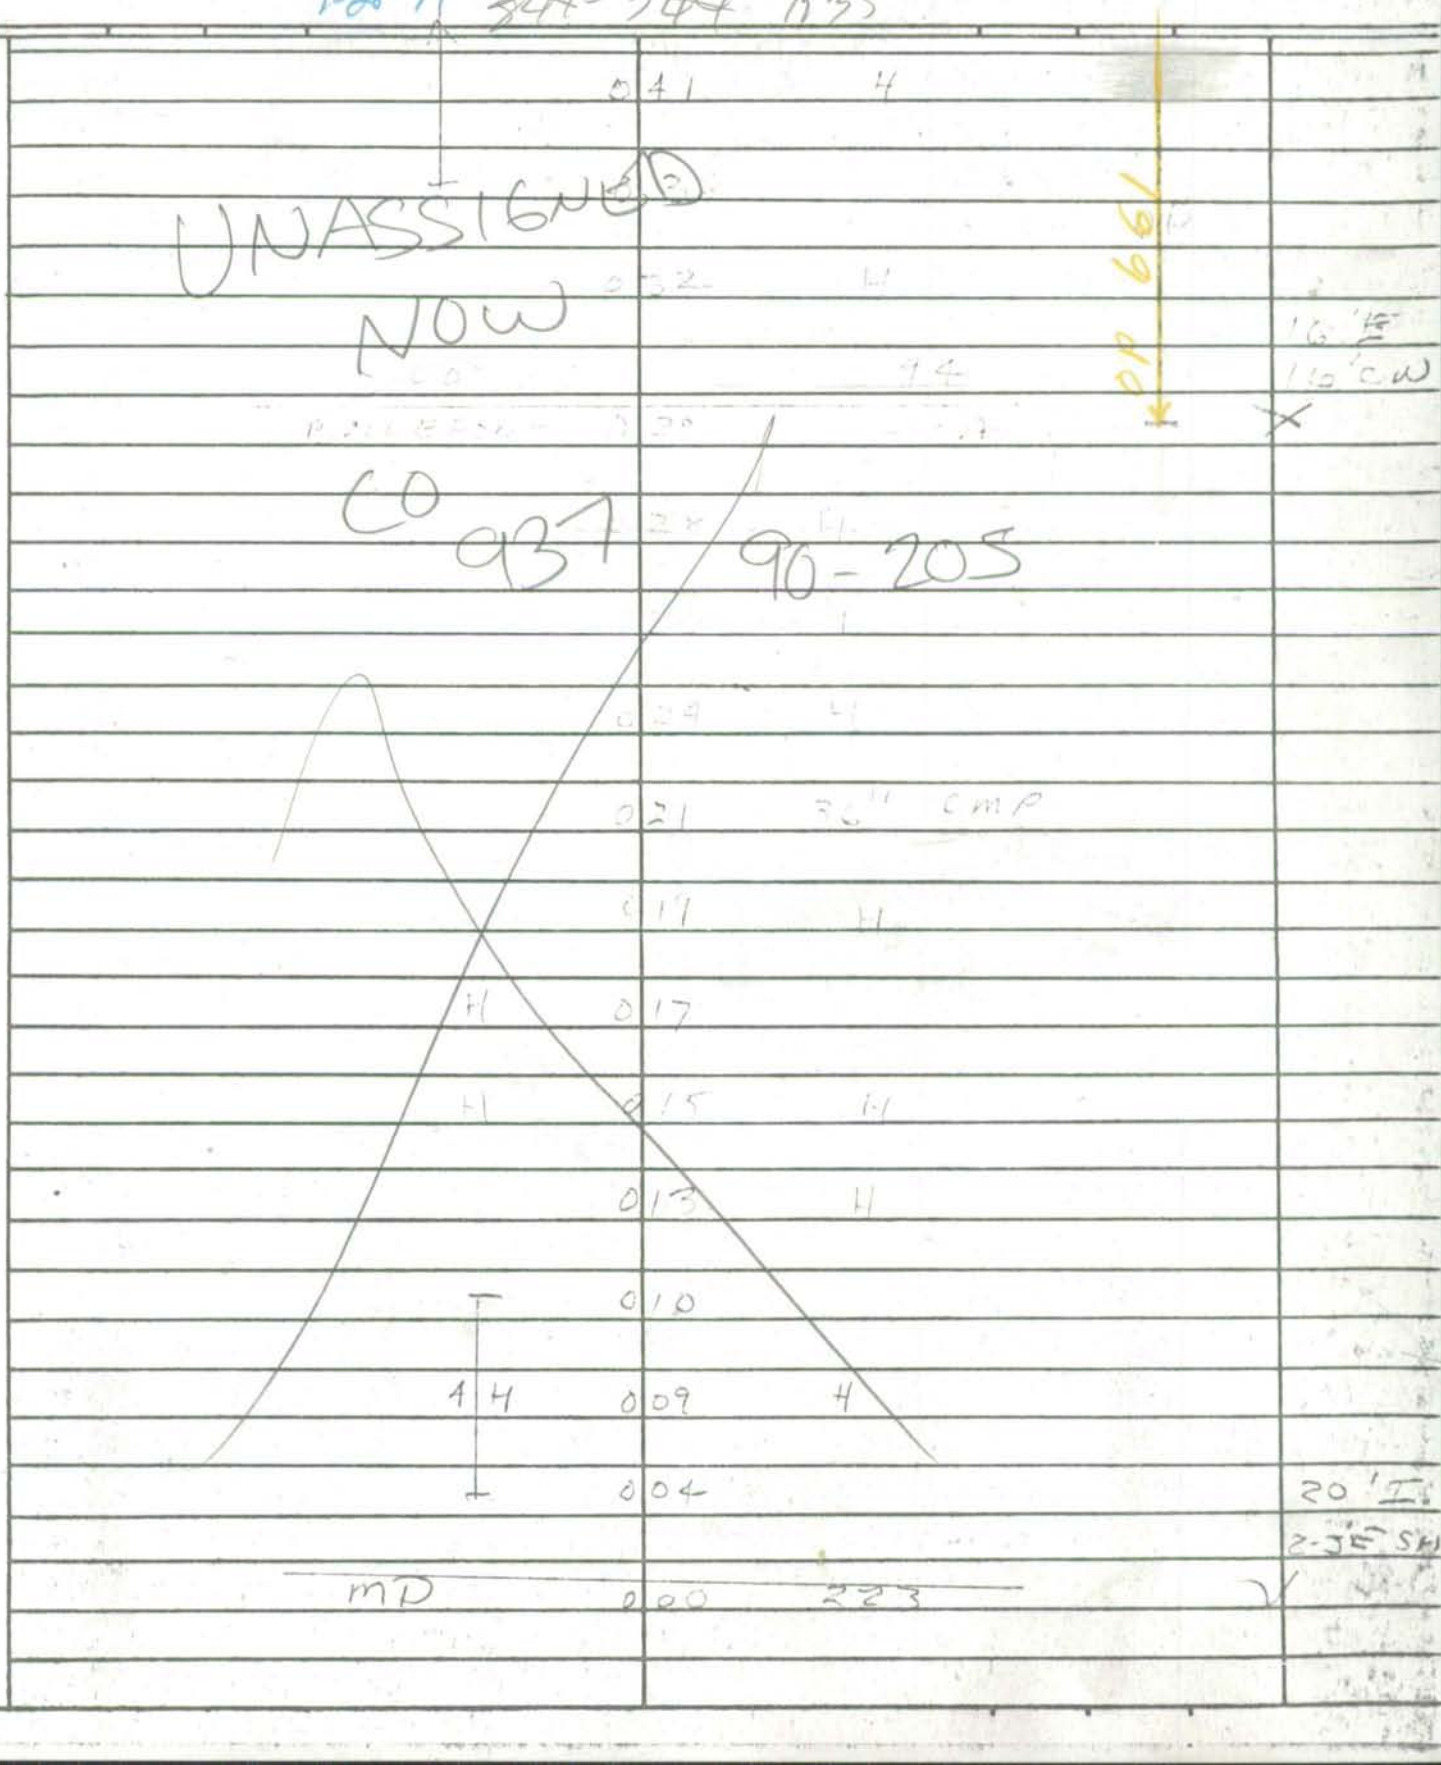

Form 6 HPS (Rev. 1961)

OP661

ROAD INVENTORY SHEET

Party Chief E.S.
Recorder W.D.
Chainman T.L

COLES CORNER

Road No. CO 937
Name SUCCANNA LN
Sheet No. 2 OF 2
Date 7-26-61
County PRINCE GEO.

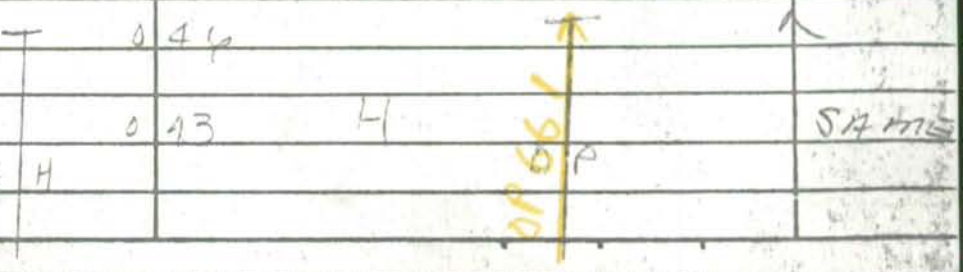

SHA 51.3-8
11-15-72

STATE HIGHWAY ADMINISTRATION OF MARYLAND

ROAD INVENTORY SHEET

Party Chief _____
Recorder _____
Helper _____

Map No. _____

Road No. OP 662
Road Name _____
Sheet No. _____
Date _____
County P.G.
State Coordinates _____

~~See Inventory~~

~~OC Co. 4382~~

81-38

UNASSIGNED

Now CO

4382

90-45

SHA 51.3-8
11-15-72

ROAD INVENTORY SHEET

Road No. _____
Road Name _____
Sheet No. _____
Date _____
County _____
State Coordinates _____

Form 6 HPS (Rev. 1961)

FAH

OP663

ROAD INVENTORY SHEET

MAP 10

SPRINGBROOK LA

Party Chief	E.S.
Recorder	W.D.
Chainman	
Road No.	Co. 997
Name	LINDEN ST
Sheet No.	1 OF 3
Date	10-1-62
County	RAINCE GRN

60-44
63-3-193-190 JENKINS FORK

VER

SEE COPY OF CO 997

040

DR

20' G

22' SH

H

GD 200

GD 200

NOW

59 M/M

H

DR.

20' E

26' CW

6 11

59 M/M

017

012

005

30°

004

20' H

2-4' E SHO

CO

CIRCLE

003

30°

22' H

2-4' E SHO

179

CO

OLD BRANCH 000

AVE

Form 6 HPS (Rev. 1961) MAP 10 OP 663

ROAD INVENTORY SHEET

SPRINGBROOK LA

Party Chief E.S.
Recorder W.P.
Chainman T.

Road No. Co 997
Name ~~KINDER ST~~
Sheet No. 1 OF 2
Date 11-1-66
County PAYNE GEO

JENKINS CORNER
931-344 M35

ROAD	059	END	
	057	C.B.C. - 9'L, 32'W, 4'D	
B - OFFICES	055	200'H	24'E
CO SCHULTZ	051	931 RD	30'CW
T	050		OP
C H	044	H	SAME

DO NOT COPY

Greater Upper Marlboro

SHA 51.3 - 8 Revised 4.83

Mun. Imp. 54-1 62-2

MARYLAND STATE HIGHWAY ADMINISTRATION

ROAD INVENTORY SHEET

Upper Marlboro OP 664 Co. 1010

Party Chief E. Schuyler
Recorder W. Dombroski
Assistant Rewritten 10-19-89 KJP
Map No./Dir. / S
State Coordinates 869-355

Road No. MUN. 0130
Road Name Valley Lane
County Prince Georges
Date 7-11-68
Sheet No. 1 OF 1

TRAFFIC CODES
TRAFFIC CONTROLS: STOP SIGN=SS, TRAFFIC LIGHT=T.L., FLASHING RED BALL=F.R.

TRAFFIC CODES
PARKING RESTRICTIONS: A.M. PEAK, P.M. PEAK, A.M./P.M. PEAK, NO PARKING ANYTIME=N.P., COMM/IND. ACCESS=E

SYSTEM FED. AID.	SYSTEM FUNCT CLASS.	SYSTEM HWY. SYS.	SYSTEM HPMS SAMPLE	TRAFFIC PRKG. REST.	TRAFFIC COM/IND. ACCESS	LINE DIAGRAM	TRAFFIC CONTROL	TRAFFIC COM/IND. ACCESS	TRAFFIC PRKG. REST.	PAVEMENT DATA
						Road 0 23 END				
								OP 664		
						0 17				
										10' E
										10' CW
						PT 0 14				
						80°				
								0 1010		
						PC 0 09		CO		10' F
										14' CW
						Corp. Limits of Upper Marlboro				
						0 07 W.P.C.				
								0130		
E						Church + Cemetery 0 01		MUN.		10' I
										2-2' E shd.
						Church ST.				16' CW
						MUN. 0 00 0020				

Form 6 HPS (Rev. 1961)

FHA

OP 665

ROAD INVENTORY SHEET

Party Chief E Schuyler
Recorder N GORMAN
Chainman

MAP 2

Road No. Co. 1016
Name WILLIAMSON AVE.
Sheet No. 1 OF 1
Date 9/12/66
County PRINCE GEORGES

VER 5-8-77

841 - 455 M27D

PULL

NOW Co 1016

82-1

HOLLY RD
OP 0 20 667

Road End

019

H 018

H 016

H 014

LINDEN ST
OP. Sec. Co 013 1017

011 H

LOCUST ST
OP. Sec. Co. 006 1013

H 005 H

CHESTNUT RIDGE DR
(76-11) OP ~~239~~ Co 3948 000

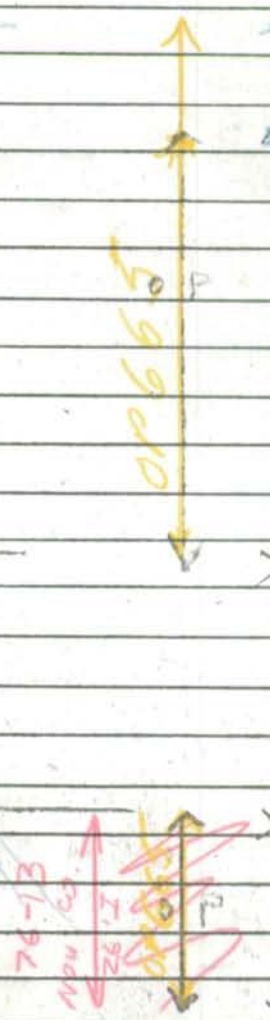

22'I
ICB.LT
30'C-W
18'D
24'C-W

18'GI
24 C-W

24'C-W
10'D
12'C-W

Form 6 HPS (Rev. 1961)

FAU

OP666

ROAD INVENTORY SHEET

LINDENDALE DR

Party Chief E. Schuyler
Recorder H. GORMAN
Chainman

MAP 2

Road No. CO. 1017
Name ~~LINDEN~~ ST
Sheet No. 1 OF 1
Date 6/13/66
County PRINCE GEORGES.

840-455 MGJ

	Road END		
	035		
	033 H		
	032 H		18' D
WILLIAMSON	D.E.		24' C-C
CO.	031 1016		
NOW	CO 1017		
	030 76-14		
S H			
	025 H		
	024		
	023 H		
WAGGMAN	D.E.		
CO	021 1015		
H	020		
	019 H		
H	013		
CLARK	D.E.		
CO.	011 1014		
H	009		
H	005 H		
	004 H		
H	002 BUS. MOTEL UNITS.		18' G
			24' C-C
U.S.	1.		
	000		

Form 6 HPS (Rev. 1961) FAU OP667

ROAD INVENTORY SHEET

Party Chief E. S.
Recorder H.G.
Chainman

MAP 2

Road No. Co. 1018
Name HOLLY ST
Sheet No. 1 OF 1
Date 6/13/66
County D G

VER 5.8-K M27
840-455 H ROAD 33 END
Road End

WILLIAMAN AV.
OP665

0 31
0 30 "
0 29 "
0 27 "
0 26 "
H 022
WILLIAMAN AVE
021
018 H
H 015
CLARK AVE
CD 011 10.4
009 H
008 H
007 H
H 005
004
H 001 Bus USED CARS
U.S 1
000

26 I
30' C-W
X
26 I
I C-C
18' E
24' C-W
X
18' G
24' C-W
Y

PULL NOW Co. 1018

82-2

Form 6 HPS (Rev. 1961) FAU

OP668

ROAD INVENTORY SHEET

Party Chief E. S.
Recorder H. G.
Chainman

MAP 2

Road No. CO 1020
Name CYPRESS ST.
Sheet No. 1 OF 1
Date 6/13/66
County P. G.

840-454 M27

UNASSIGNED		
NOW CO	1020	
76-	7	
Road	END	
"	026	
		10' D
WAGGAMAN AV.		15' C.W.
CO. 1015	021	
	018 H	
H	016	
	014 H	
H	012	
CLARK		
CO. 1014	011	
	008 H	
H	007	
H	005 H	18' C
		24' C-W
U.S.	1.	
	000	

OP 669

Prince Georges County

UNASSIGNED

NOW

MD 5-P

Deer Pond La

See contract # P-391-502-370

9/28/01

Form 6 HPS (Rev. 1961)

FAU MAP 6

OP 670

ROAD INVENTORY SHEET

PARTY CHIEF Edward Schuyler
RECORDER Henry Gorman
CHAINMAN [illegible]

Ver 9-23-77

ROAD NO. [illegible]
NAME [illegible]
SHEET NO. 1 OF 2
DATE 11/21/67
COUNTY PRINCE GEORGES

819 375
820-376 M35

		021	H		40'E
C P					2-3'A SHLDS
					16'C.U
	SHADY SIDE		AVE		
	CO	020	323691		X
		010	2.71		
		008	H		
					26'I
		006	H		2-3'A SHLDS
					2'C.U
	HUBBARD	ST			
	CO.	004	2.75		X
H		003	H		
H		001	H		25'I
	LAKEWOOD	AVE			C-C
	CO	000	1123		

Form 6 HPS (Rev. 1961)

OP 670

ROAD INVENTORY SHEET

PARTY CHIEF Edward Schuyler
RECORDER Henry Gorman
CHAINMAN J. EMBRICK

ROAD NO. CO. 1073
NAME KENILWORTH AVE.
SHEET NO. 2 OF 2
DATE 11/21/67
COUNTY PRINCE GEORGES

DUPONT HEIGHTS

	ROAD END	
	031	
H	028	
	024 H	
Rd. Spec.		
		SAME.
H	025 H	

N 10° E

Form 6 HPS (Rev. 1961)

1 AU

08 671

ROAD INVENTORY SHEET

PARTY CHIEF Edward Schuyler
RECORDER Henry Gorman
CHAINMAN [illegible]
64-138

Ver 9-22-77
DUPONT HEIGHTS

ROAD NO. CO 1103
NAME LAKE WOOD DR.
SHEET NO. 1 OF
DATE 11/21/67
COUNTY PRINCE GEORGES

G11B 820-375 M35

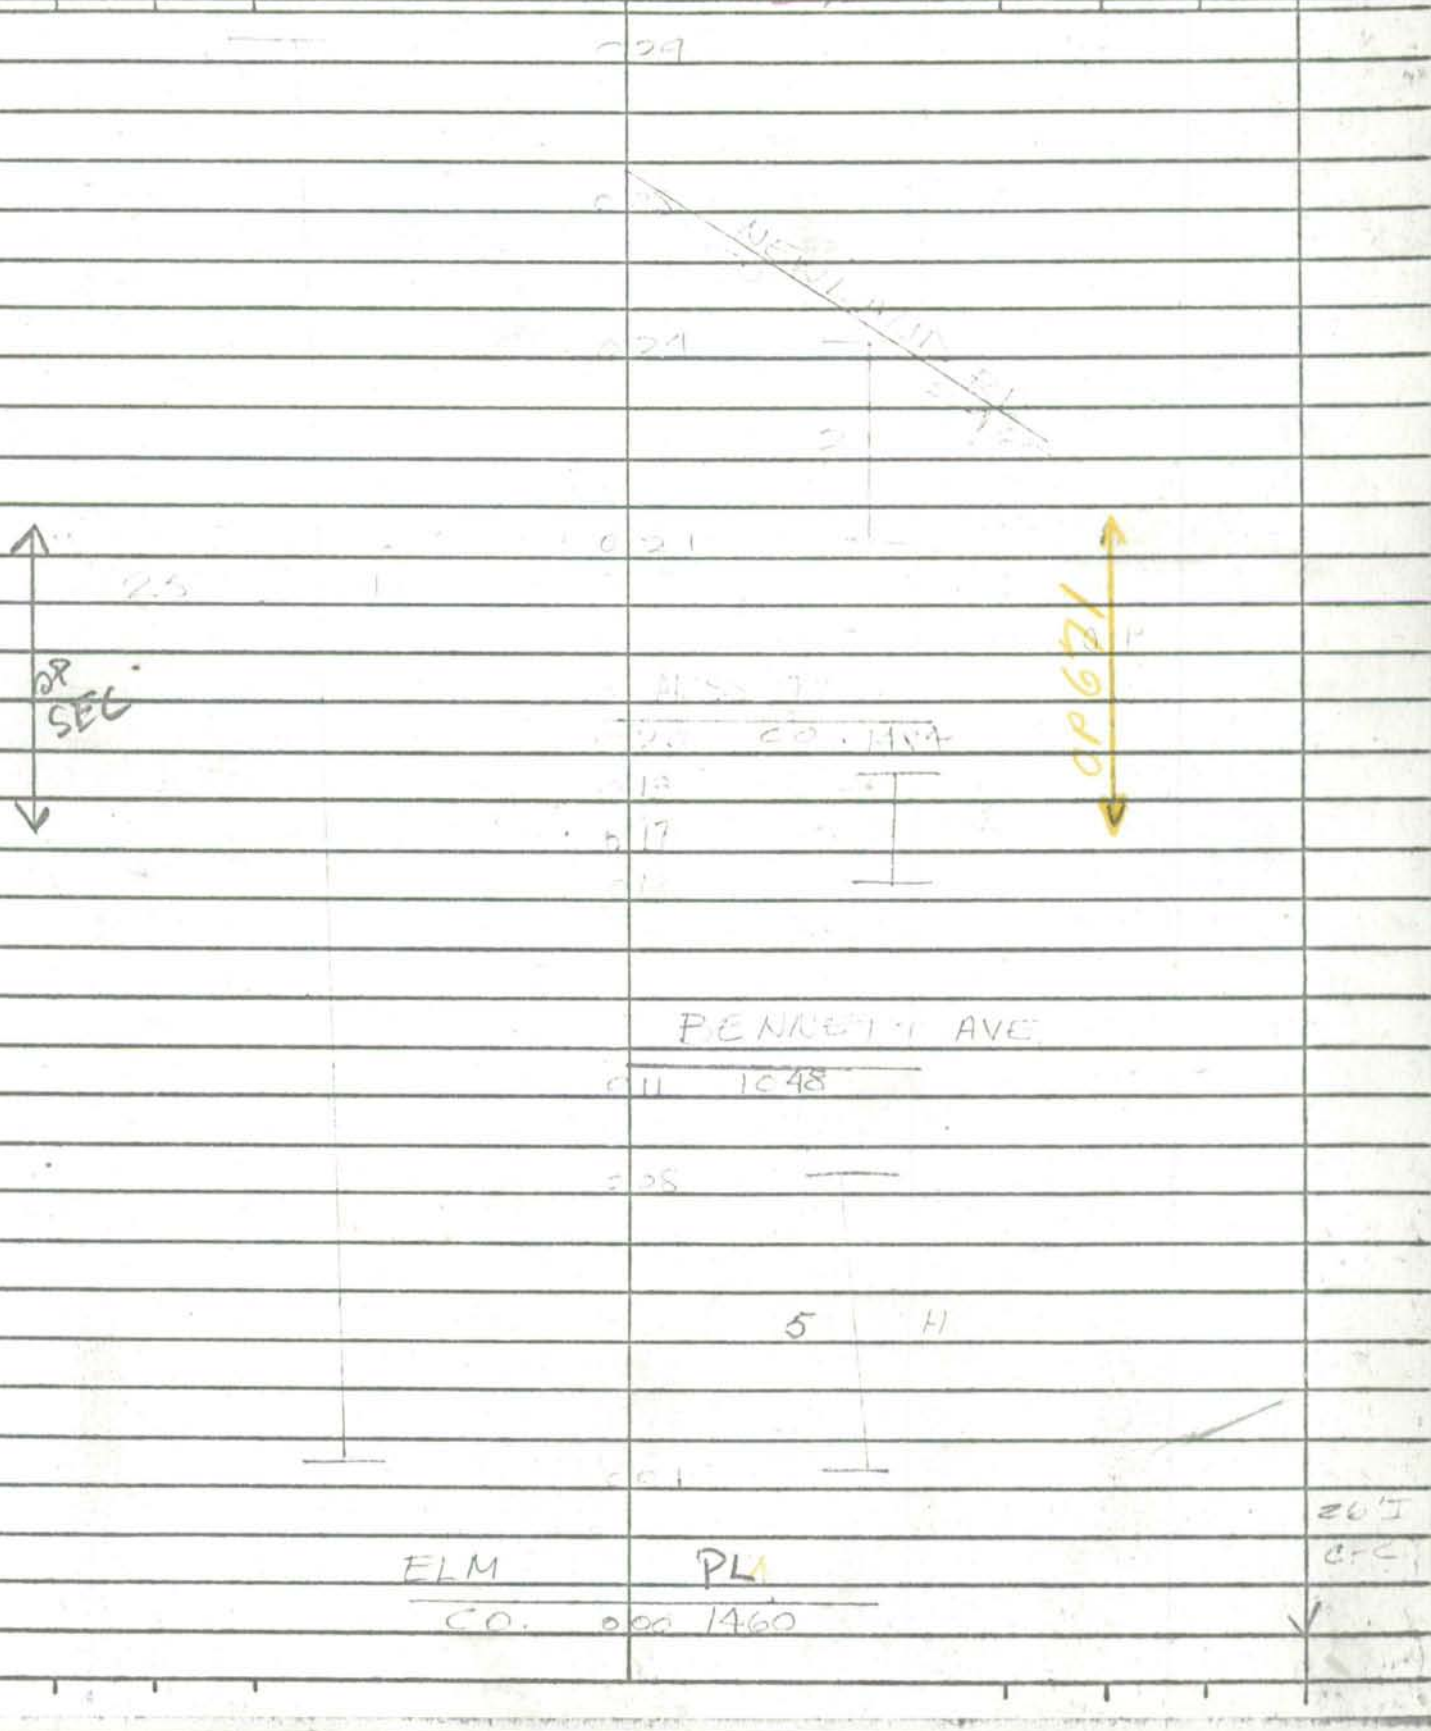

Form 6 HPS (Rev. 1961) MAP 7 OP 672

ROAD INVENTORY SHEET

Party Chief E. S.
Recorder W D
Chainman

VER
AUTH VILL 8-16-77
429 - 358
~~829 - 354~~ M35

Road No. RD 1109
Name MORRIS AVE
Sheet No. 2 OF 2
Date 11 - 13 - 78
County PRINCE GEO

F

495

DIST 0.00

OP ~~to~~ 2197 ~~2197~~

CARSWELL ~~DR~~ AVE 0.51

0.50

200 UNITS

150 UNITS

0.43 RENTAL OFFICE

36' T C-C

0.39

PT

21 APTS 0.32 [A] 40°

PC

0.29

SAME

Form 6 HPS (Rev. 1961)

FAU #

OP 673

ROAD INVENTORY SHEET

Party Chief [illegible]
Recorder W. T.
Chainman

MAPS 7+10
AUTH VICINITY
8-16-71
828-358 M35

Road No. CO 1111
Name MEDFORD AVE
Sheet No. 1 of 1
Date 11-13-67
County [illegible]

		FAU M	
ROAD	038	RD	
H	031		
[illegible]	27		
	024	TELE SOUTH	10'E
CO 1113			15'CW
GRIFFITH DR	014		X
H			
CO 1112			
DAVIS BLVD	007		
H	005		T
			20'E
CO		127	2-3'E SHO
AUTH	000	RD	V

Form 6 NPS (Rev. 1961)

ROAD INVENTORY SHEET

OP674

VNAS5

Party Chief E. SCHAEFER
Recorder T. LANDON
Chainman D. LIMBACK

MAP 6
NORTH
BARNABY
813 = 359
M 35

Road No. Co 1117
Name DURAND ST.
Sheet No. 1 of 1
Date 12-20-61
County PRINCE GEORGES

NOW ALL COUNTY

		ROAD	009	END
			008	H
			006	
			005	LESLIE AVE CO 197
4 H			003	H
			001	H
		ROAD	000	END
H				H

20'E
2-6'AS WID
36'CN

Form 6 HPS (Rev. 1961)

FAU OP675

ROAD INVENTORY SHEET

Party Chief E.S.
Recorder W.D.
Chainman E.S.

MAP10

Road No. Co 1170
Name BIRCH
Sheet No.
Date
County

VER 8-15-77 827-352 1135

Now Co. 1170

ROAD T 15 T.D 13 11 H 52 H 00 01 CO 1169 ALEY RD 00

DE CUL 29 SAC

20 TO 2-ZERO

Form 6 HPS (Rev. 1961)

FHU

OF676

ROAD INVENTORY SHEET

Party Chief E S.
Recorder W.P
Chainman T.L

MAP 40

HEDRICKS CORNER

GIID VER 8-15-77

827-352 M35

Road No. C 117
Name BEECHWOOD DR
Sheet No. 1 of 1
Date

ROAD 023 END

1 H 18'6

2-3 E S-L

E

CO 1169

ALLEY 17 RD 24'E

2-1 E S-L

TNT 11 X

85° 10 26'I

C-C

PC 09 X

35 H 08 16 4 71'I

C-C

ROAD 00 END

9 H

Form 6 HPS (Rev. 1961) +AU

OP677

ROAD INVENTORY SHEET

Party Chief E.S.
Recorder W.D
Chainman

MAP10

CLINTON

VER 7-28-77

839 - 339
~~840~~ 440 435

Road No. CR 1173
Name ORILEY ~~DR~~ DR
Sheet No. 1 of 1
Date 7-25-77
County PRINCE GEO

H

ROAD C IR END

0 15

H C 12

H 0 04

C6 1181

DANDERFIELD 0 00 PL

10' E
10' CW

20' I
18' C

2-3' ESHO

Form 6 HPS (Rev. 1961)

OP678

ROAD INVENTORY SHEET

Party Chief E.S.
Recorder E.S.
Chainman

Road No. CO 1180
Name PRESLEY ROAD
Sheet No. 2 OF 2
Date 6-4-78

VER 3-28-78 843-420/317 M89B1

UNASSIGNED

NOW CO 1180

90-40

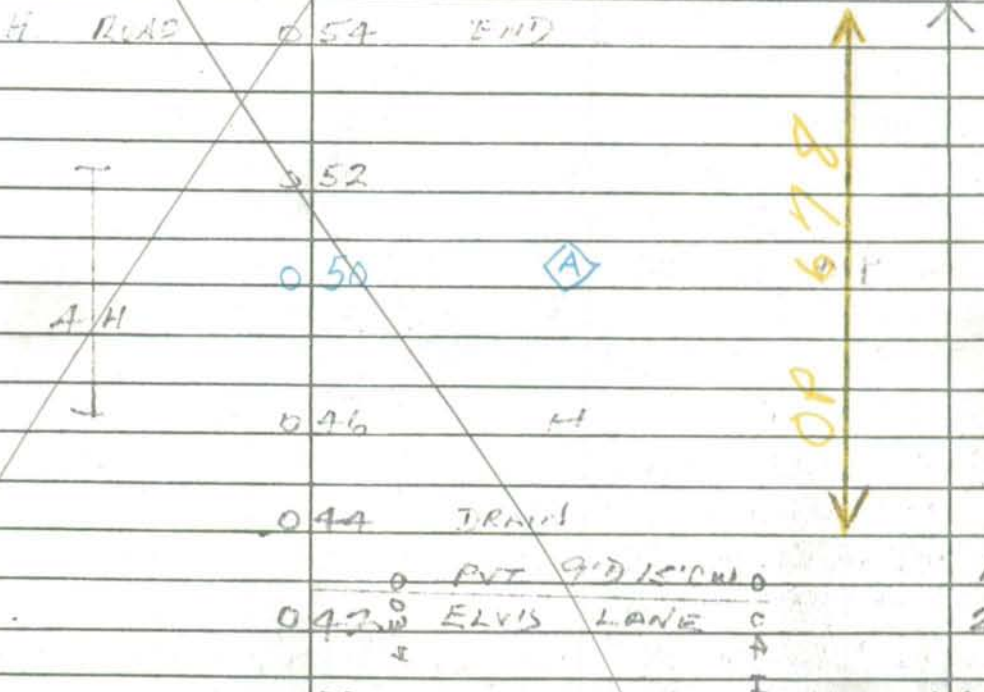

Form 6 HPS (Rev. 1961)

OP679

ROAD INVENTORY SHEET

Party Chief E.S.
Recorder W.D
Chainman

MAPID

VER 7-28-77

841
839-340 M35

Road No. CO 1181
Name [illegible]
Sheet No. 2 of 2
Date 1-[illegible]-[illegible]
County [illegible]

UNNASSIGNED
See CO 1181 88-89
BB, DW

		[illegible]		
		071		
H		072		
		073	H	14'E
		074		14'C-W
		075	END MAIN SIGN	
H		076		
		044	H	SAME

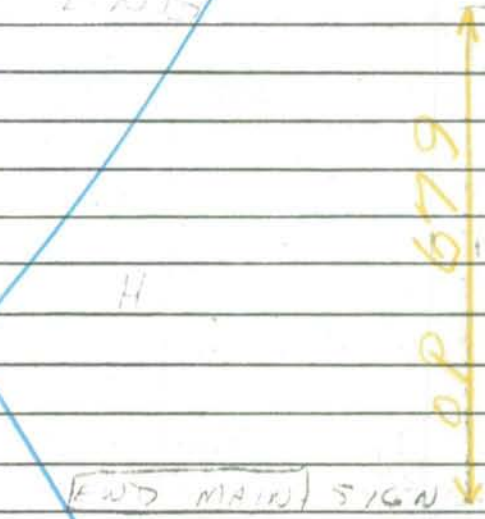

Form 6 HPS (Rev. 1961)

FAU

OP680

ROAD INVENTORY SHEET

PARTY CHIEF Edward Schuyler
RECORDER Henry Gorman
CHAINMAN

RADIANT VALLEY

ROAD NO. Co. 1276
NAME THOKIWOOD RD
SHEET NO. 1 OF 1
DATE 9/21/67
COUNTY PRINCE GEORGES

62-73

VERA 11-78

0030 - 402

~~829 401~~ M31

ROAD ~~X-X-X-X~~

032

FNT To Swimming Pool 031

030

029

RAKEWOOD Co. 027 RD 212

025

024 1½ H

021 15' H

011 26'-T

010 TC-C

009

FAKEWOOD Co. 006 RD 212

006

005 5' H

002 5' H

001

GOODWIN Co. 000 ST 207

Form 6 HPS (Rev. 1961)

MAP 4

ROAD INVENTORY SHEET

6P681

PARTY CHIEF Edward Schuyler
RECORDER Henry Gorman
CHAINMAN

ROAD NO. Co. 1277
NAME WAPITI AVE
SHEET NO. 3 OF 3
DATE 9 / 26 / 67
COUNTY PRINCE GEORGES

827-403 M31

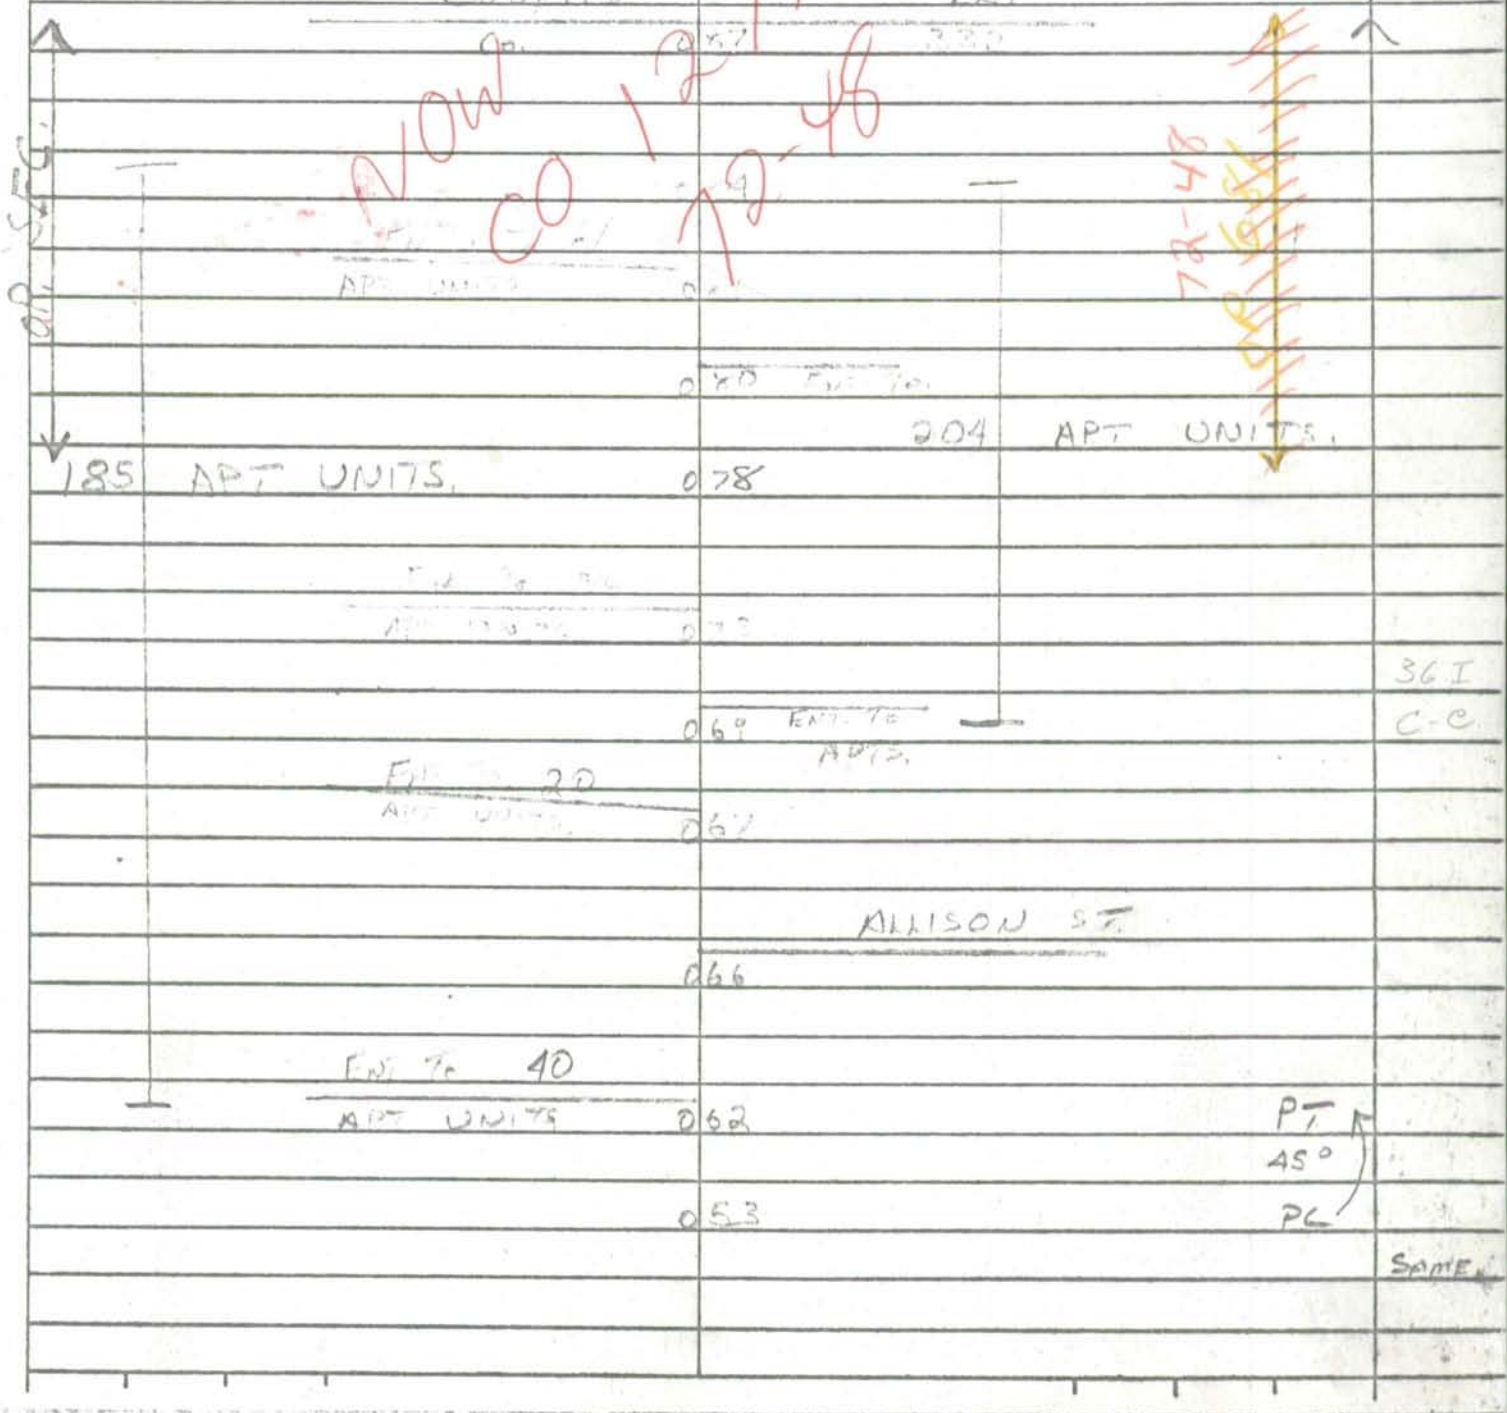

Form 6 HPS (Rev)

Reassigned 2-17-71 GJG
(Previous OP 682 Now Co. 1283 69-130)

ROAD INVENTORY SHEET

Urban

GREENBELT

Party Chief E. Schuyler
Recorder H. Goeman
Chainman

Road No. OP 682
Name Court St-Ridge Rd
Sheet No. 1 OF 1
Date 5/23/67
County Prince Georges

F11B

836-429 M-31

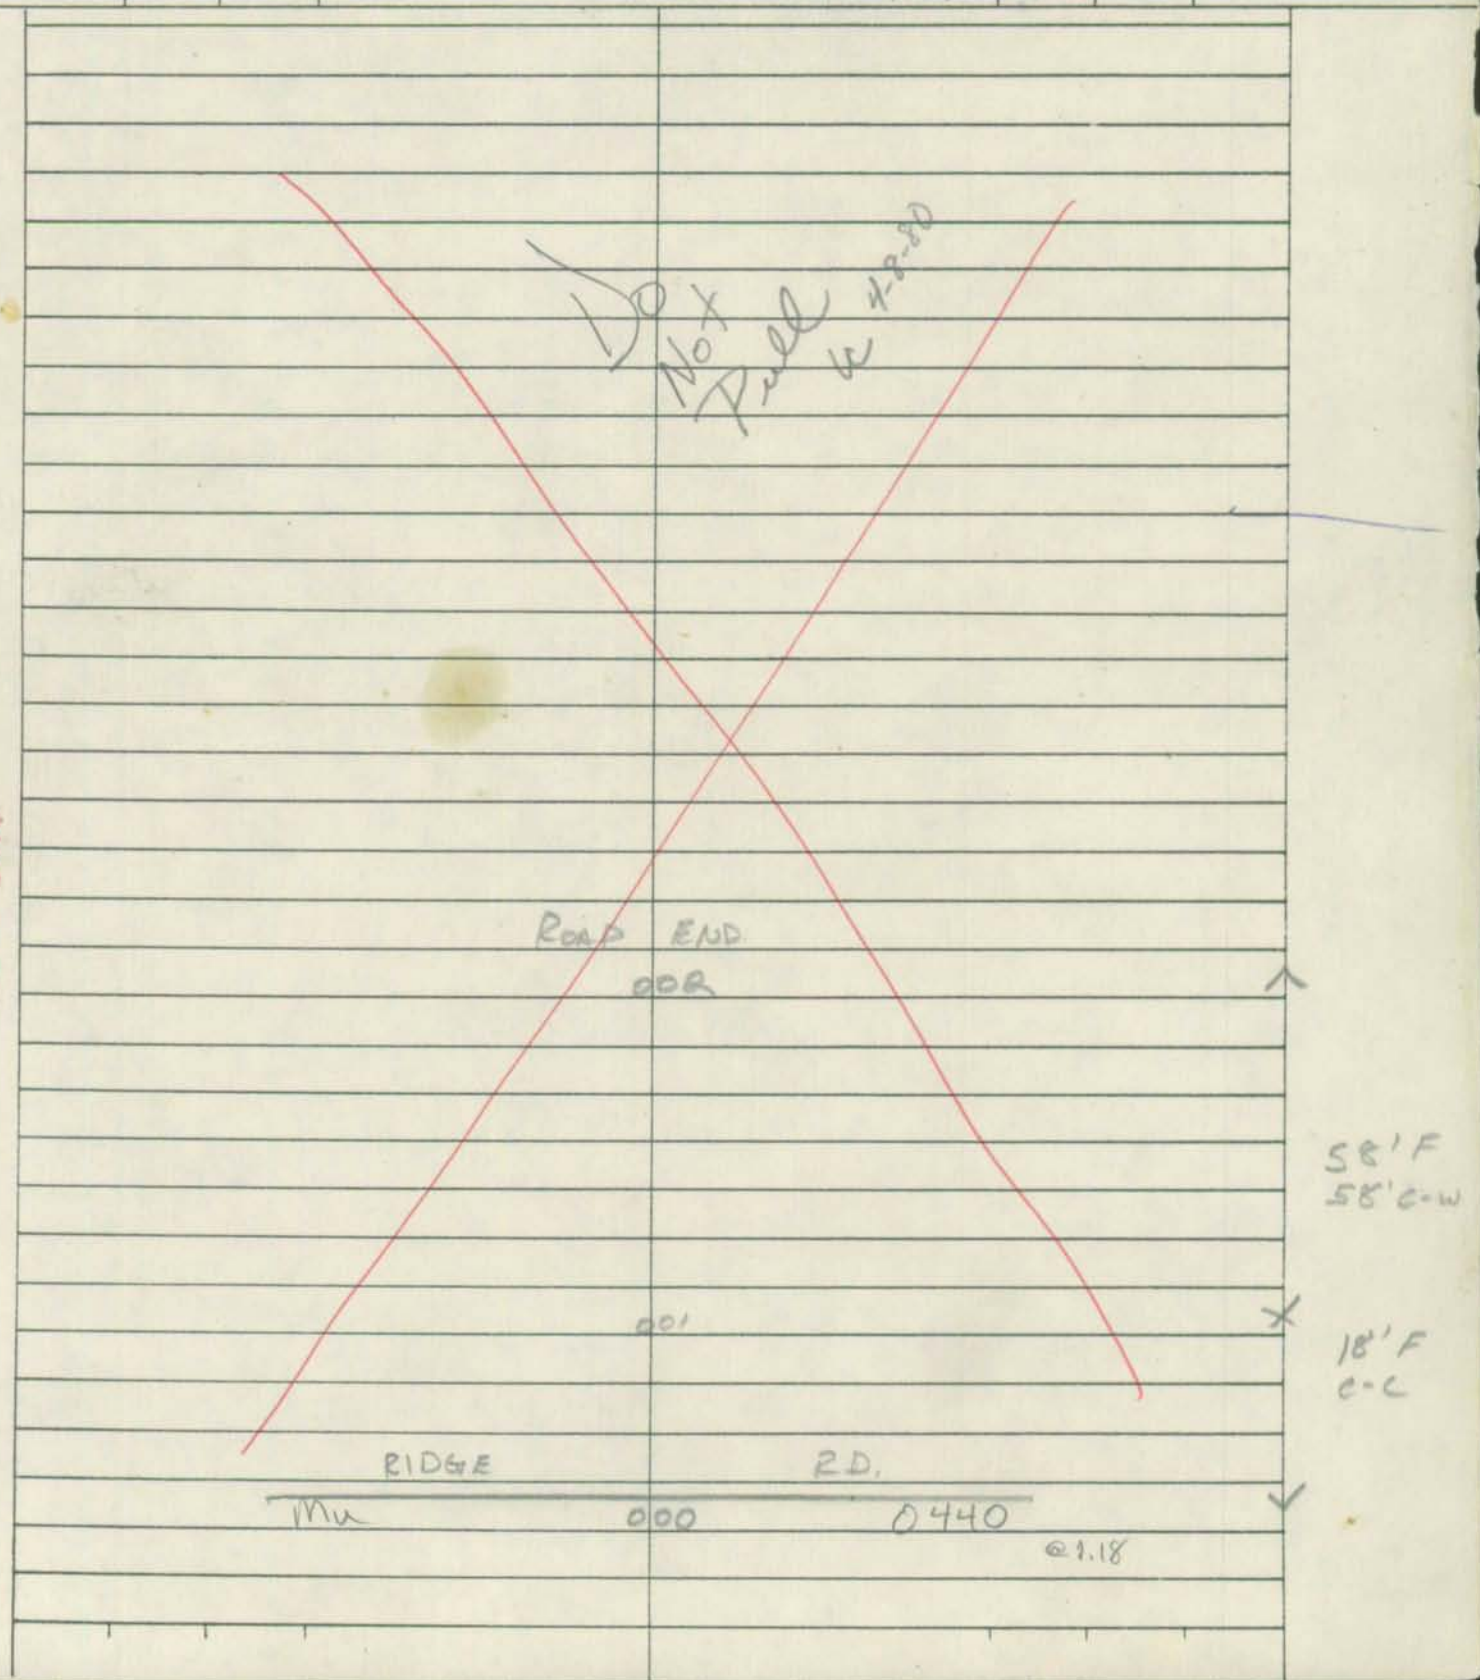

Reassigned 2-17-71 GJG

Form 6 HPS (Rev. 1961) (Previous OP 682 Now Co. 1282 69-130)

ROAD INVENTORY SHEET

Urban

Party Chief E. Schuyler

Recorder H. Goeman

Chainman

GREENBELT

Road No. OP 682

Name Court St-Ridge Rd

Sheet No. 1 OF 1

Date 5/23/67

County Prince Georges

F11B

836-429 M-31

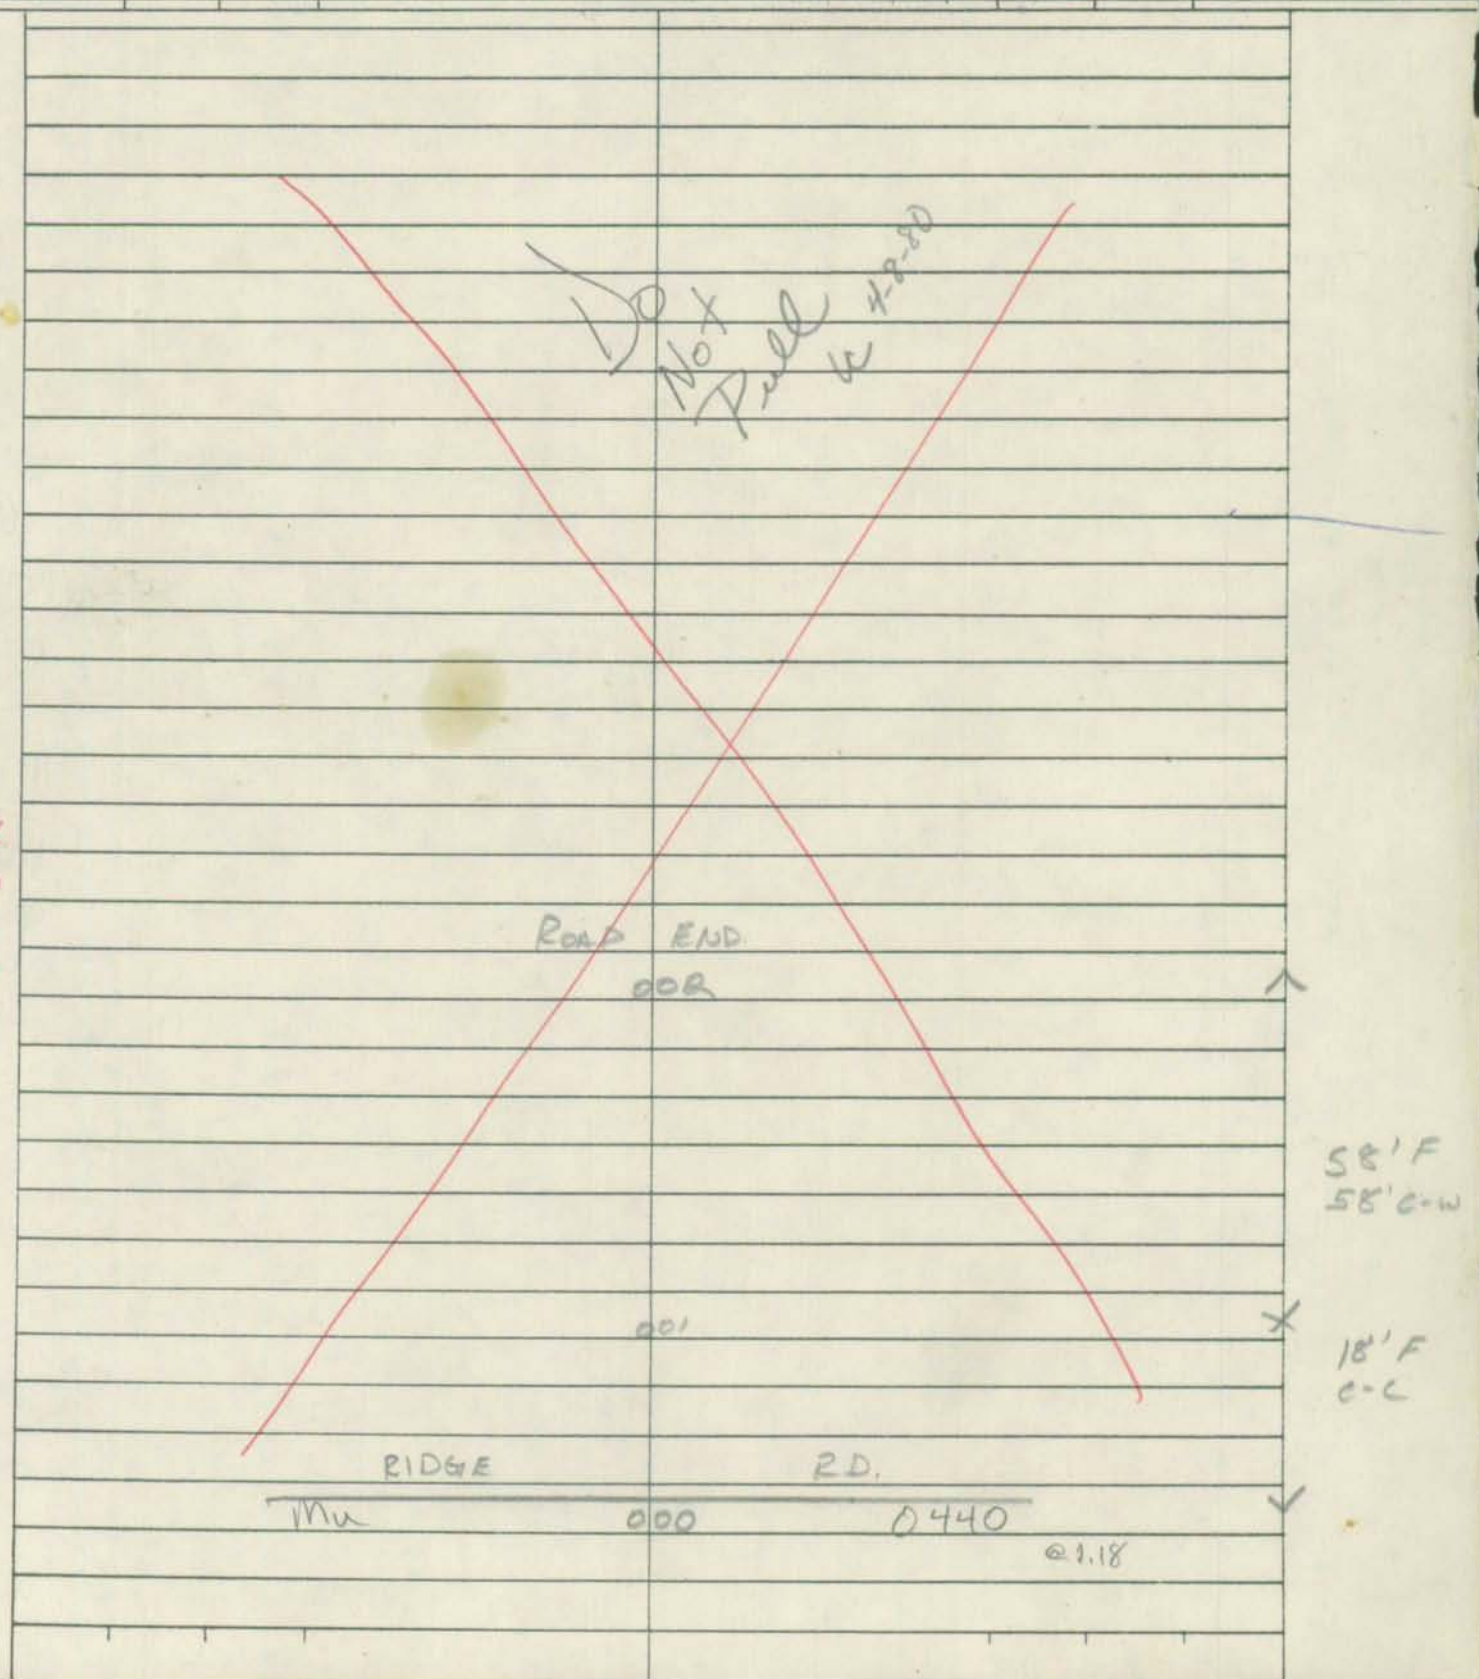

Form 6 HPS (Rev. 1961) MAP 3 FAU OP 683

ROAD INVENTORY SHEET

Party Chief E.S.
Recorder W.D.
Chainman

65-122

Ver 10-10-77

DIST HQTR

833-371

Road No. 1303
Name
Sheet No. 2
Date 10-11-77
County PRINCE GEO

M35

OP 683

024

CO 1371

WILTSEY AVE

030

014

CO 1301

LIMITS

FIRST CHAPEL AVE

LANSDALE 005

ONE WAY

KIPLING 003

MAIN

36' I
C-C

Form 6 HPS (Rev. 1961)

OP683

ROAD INVENTORY SHEET

Party Chief
Recorder
Chainman

Road No. # CO 1303
Name LORRING DR
Sheet No. 2 OF 2
Date 10-21-68
County PRINCE GEO

Form 6 HPS (Rev. 1961) MAPS FAU VER 11-7-77 OP684

ROAD INVENTORY SHEET

PARTY CHIEF Edward Schuyler
RECORDER Henry Gorman
CHAINMAN

ROAD NO. Co. 131a
NAME
SHEET NO.
DATE
COUNTY

809 ~~808~~ 424 M31 T	033	
	030 Co. 131a	30'
	030	
	025	
	020	
	015	
	010	
	005	
	003	
	002	26' I
		C-C
20'	AV.	
Co.	000 152 B	

Form 6 HPS (Rev. 1961) MAP 3

ROAD INVENTORY SHEET VNA55 ~~OP 685~~

Party Chief E Schaub
Recorder
Chairman

VER 11-9-77

812 - 429
~~809 - 428~~

M31

Road No. CO 1331
Name Buckhorn Rd
Sheet No. 2
Date
County

	090	
	079	
	072	
	050	14' D
		18' C W
	030	
		24' E
		4 C W
	025	
		20' I
		CURB P
		30' C-W

R/W ~~X X X~~ END

Form 6 HPS (Rev. 1961)

FAU

OP686

ROAD INVENTORY SHEET

Party Chief E SCHUYLER
Recorder N GORMAN
Chainman
13-1-285-35

HER
12-1-77

Road No. Co. 1334
Name CALVERTON DR.
Sheet No. 1 OF 1
Date 6/27/67
County PRINCE GEORGES'

814-417 M-31

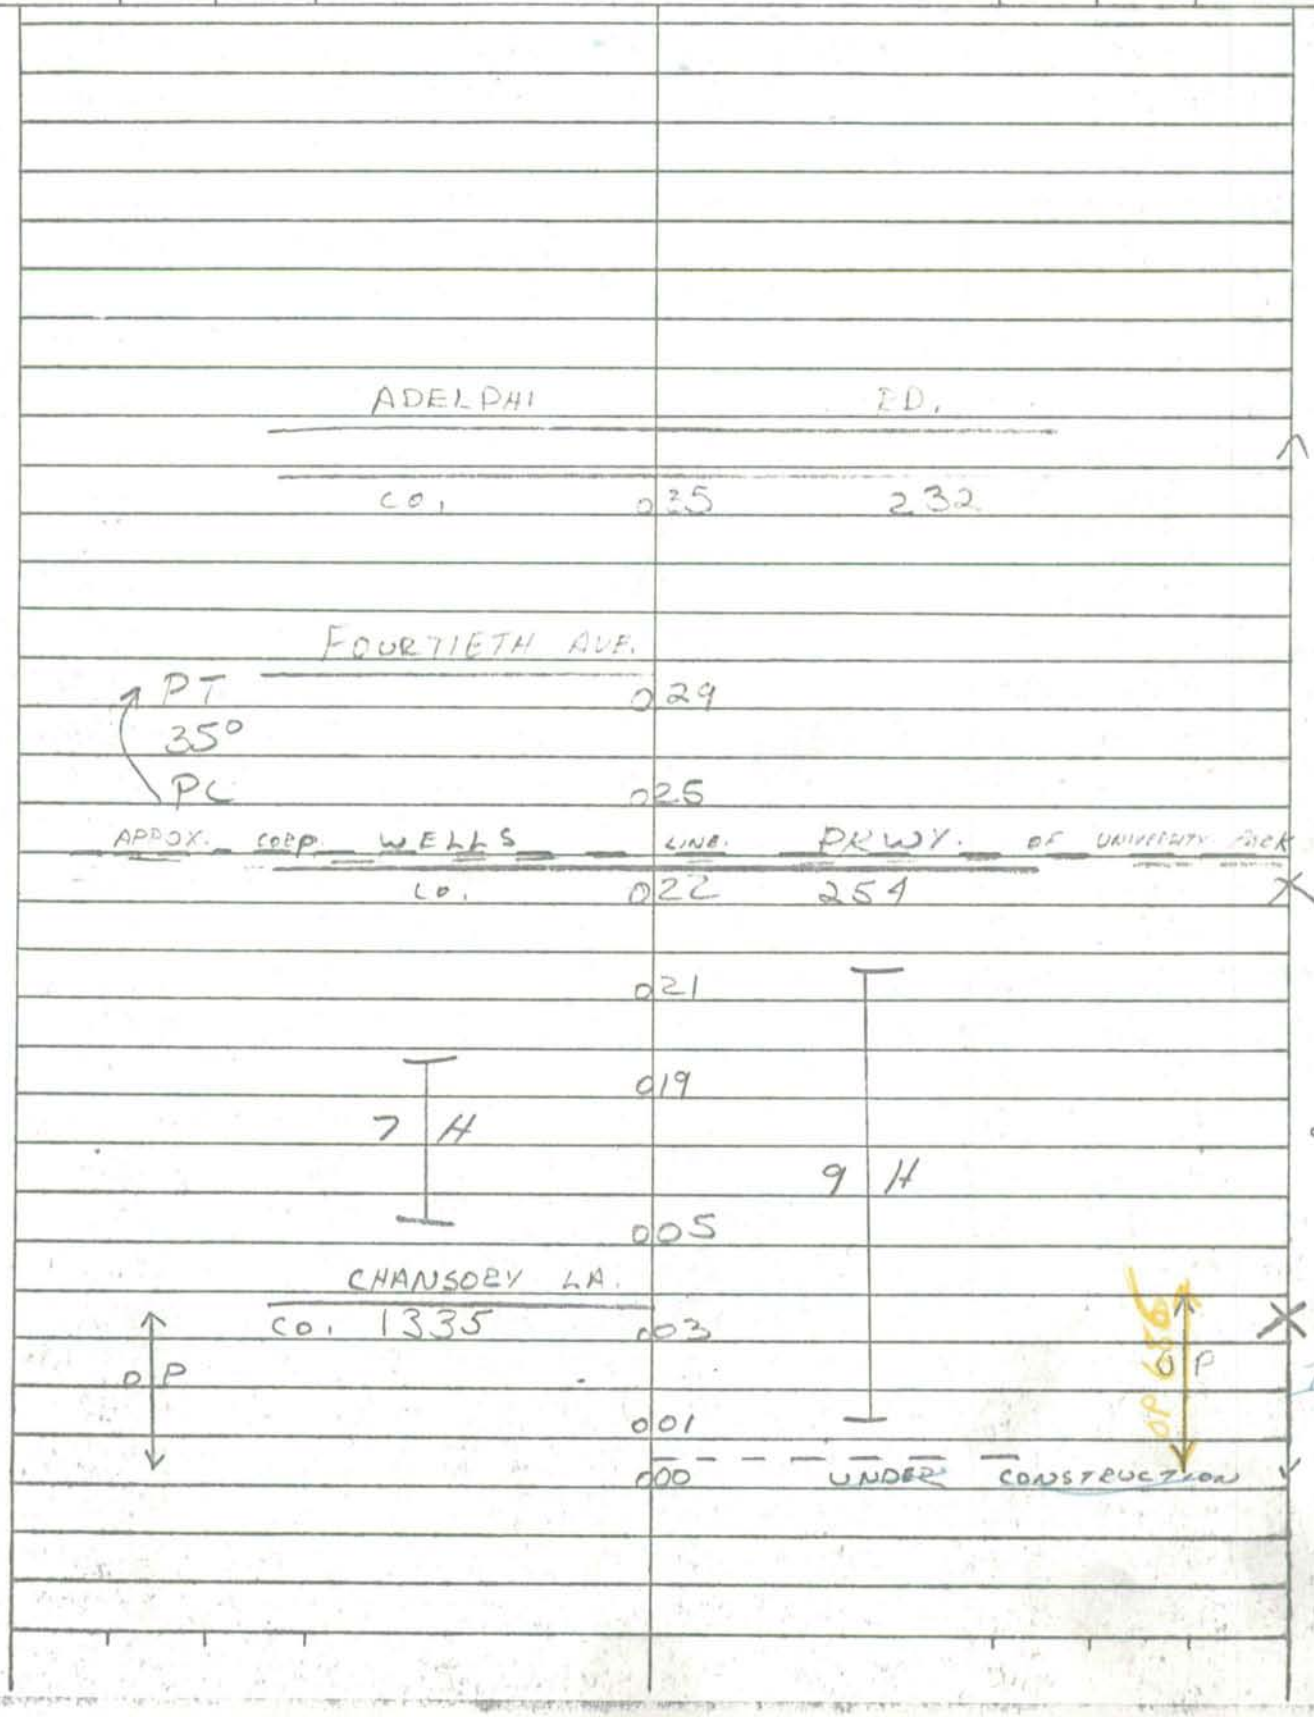

Form 6 HPS (Rev. 1961)

FHU

OP687

ROAD INVENTORY SHEET

Party Chief E.S.
Recorder W.D
Chainman T.L.

MAP 10
VER 7-5-77

SUNRATT SU[illegible]

~~835-332~~ 836-331 M39

Road No. CO 1350
Name RIDGE RD
Sheet No. 1 of 1
Date 7-17-[illegible]
County [illegible]

		H		
ROAD	000	END		
	010	GATE		19' E
				14' CW
	012			
H	009	H		
	006	H		
H	005	H		
				16 G
CO		1353		7-32 SHO
MOORES	000	EP		

Form 6 HPS (Rev. 1961)

FAH

OP688

ROAD INVENTORY SHEET

MAP 10
VER 7-5-77

Party Chief E. S.
Recorder W. P.
Chainman T. C.

Road No. CO 1353
Name MOORES LA.
Sheet No. 1 OF 1
Date 9-17-CR
County PRINCE GEO

SURRATTSVILLE
835
836-332-7439

ROAD	H	031	LWD	
	H	029		
	H	027		
	H	025		
		023		
		021		
		019		
	H	017		
		015	H	
CO	1350			
RIDGE	RD	014		
		013		
		011	H	
	H	009	H	
	H	007	H	
CO		130	RTS	
UNITS	0	000		

OP 689

PRINCE GEORGE'S COUNTY

UNASSIGNED

ABANDONED-NOW PVT DRIVEWAY

AARON LA

01-24CO

Form 6 HPS (Rev. 1961) FAU OP 690

ROAD INVENTORY SHEET

Party Chief F Schuyler
Recorder H. Gorman
Chairman

MAP 1

Road No. CO. 1361
Name WORCESTER AV.
Sheet No.
Date
County PRINCE GEORGES

VEG
R-6-77

437
824-438

M31

UNASSIGNED - Prince Georges County maintains the entire road - from phone conversation with Mark Fowler, 4/18/94, KSF

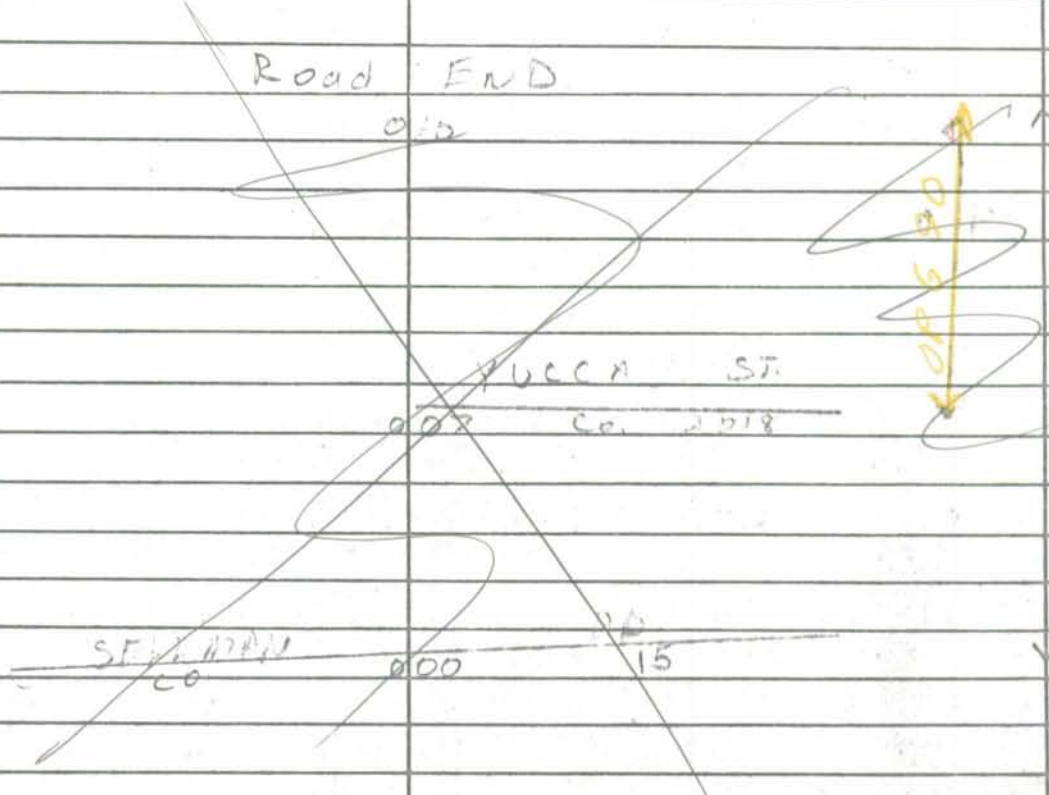

Form 6 HPS (Rev. 1961)

FALL

OP 691

OVERHILL PL

ROAD INVENTORY SHEET

Party Chief E.S.
Recorder W.D.
Chainman

VER 9-15-77

64-I-8'S N. FORESTVILLE

G11B

830-371

~~435~~

Road No. CR 1363
Name
Sheet No. 1 of 1
Date 10-21-64.

N

COL-DE 7 H

6 H

MC

CR

593

MASON

ST

20

14 H

10

19 4

01

OP

26' I

C-C

CO

732

MARION

00

ST

Form 6 HPS (Rev. 1961)

FAU

OP 692

ROAD INVENTORY SHEET

Party Chief J. Schmidt
Recorder N. Lorenz
Chainman

MAP 1

VER 12-7-77
833-441

Road No. Co. 1365
Name 127th St.
Sheet No. 1 OF 1
Date 7/27/66

M27

UNASSIGNED

NOW

CO 1365

90-11

450'

034

028

022

021

CEDAR

CO.

016

31

009

008

004

HOWARD TP.

CO. 1921

000

24'T
30'C-W

18'T
24'C-W

18'E
30'C-W

SHA 51.3 - 8 Revised
4.83

MARYLAND STATE HIGHWAY ADMINISTRATION

ROAD INVENTORY SHEET

Party Chief _____ Road No. OP 693
Recorder _____ Road Name _____
Assistant _____ County _____
Map No./Dir. 1 Date _____
State Coordinates _____ Sheet No. _____ OF _____

SYSTEM				TRAFFIC		LINE DIAGRAM	TRAFFIC			PAVEMENT DATA
FED. AID.	FUNCT CLASS.	HWY. SYS.	HPMS SAMPLE	PRKG. REST.	COM/IND. ACCESS		CONTROL	COM/IND. ACCESS	PRKG. REST.	

UNASSIGNED
NOW
CO. 4916
88-9

TRAFFIC CODES
TRAFFIC CONTROLS: STOP SIGN=SS, TRAFFIC LIGHT=T.L., FLASHING RED BALL=F.R.

TRAFFIC CODES
PARKING RESTRICTIONS: A.M. PEAK, P.M. PEAK, A.M./P.M. PEAK, NO PARKING ANYTIME=N.P., COMM/IND. ACCESS=E

Form 6 HPS (Rev. 1961) FAU 08694

ROAD INVENTORY SHEET

Party Chief ES
Recorder ES
Chairman

65-79 70-50

Road No. 01403
Name MAIN ST
Sheet No. 1 OF 2
Date 6-7-68
County PRINCE GEO

		0 32		
	& H	0 27	~~Co 948 7TH ST~~ UNASSIGNED	
		0 26	H	
		0 22	H Now All Co 1403	24' I
	Co 6TH	0 21	1198 STREET	2-5'C SHS
	H	0 16	H	
	Co 5TH	0 13	1025 STREET	
	H	0 11	H	26' I C-C
		0 10		
	Co 4TH	0 06	44 STREET	
		0 05	H	
	H	0 01		24' I 2-5'E SHS
	Co 3RD	0 00	499 ST	

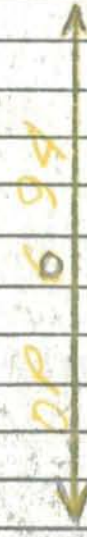

Form 6 HPS (Rev. 1961)

FAU MAP 6

08695

ROAD INVENTORY SHEET

PARTY CHIEF Edward Schuyler
RECORDER Henry Gorman
CHAINMAN

6-6-15

ROAD NO. CO 142
NAME LOCUST
SHEET NO. 1 OF 1
DATE 1967
COUNTY PRINCE GEORGES

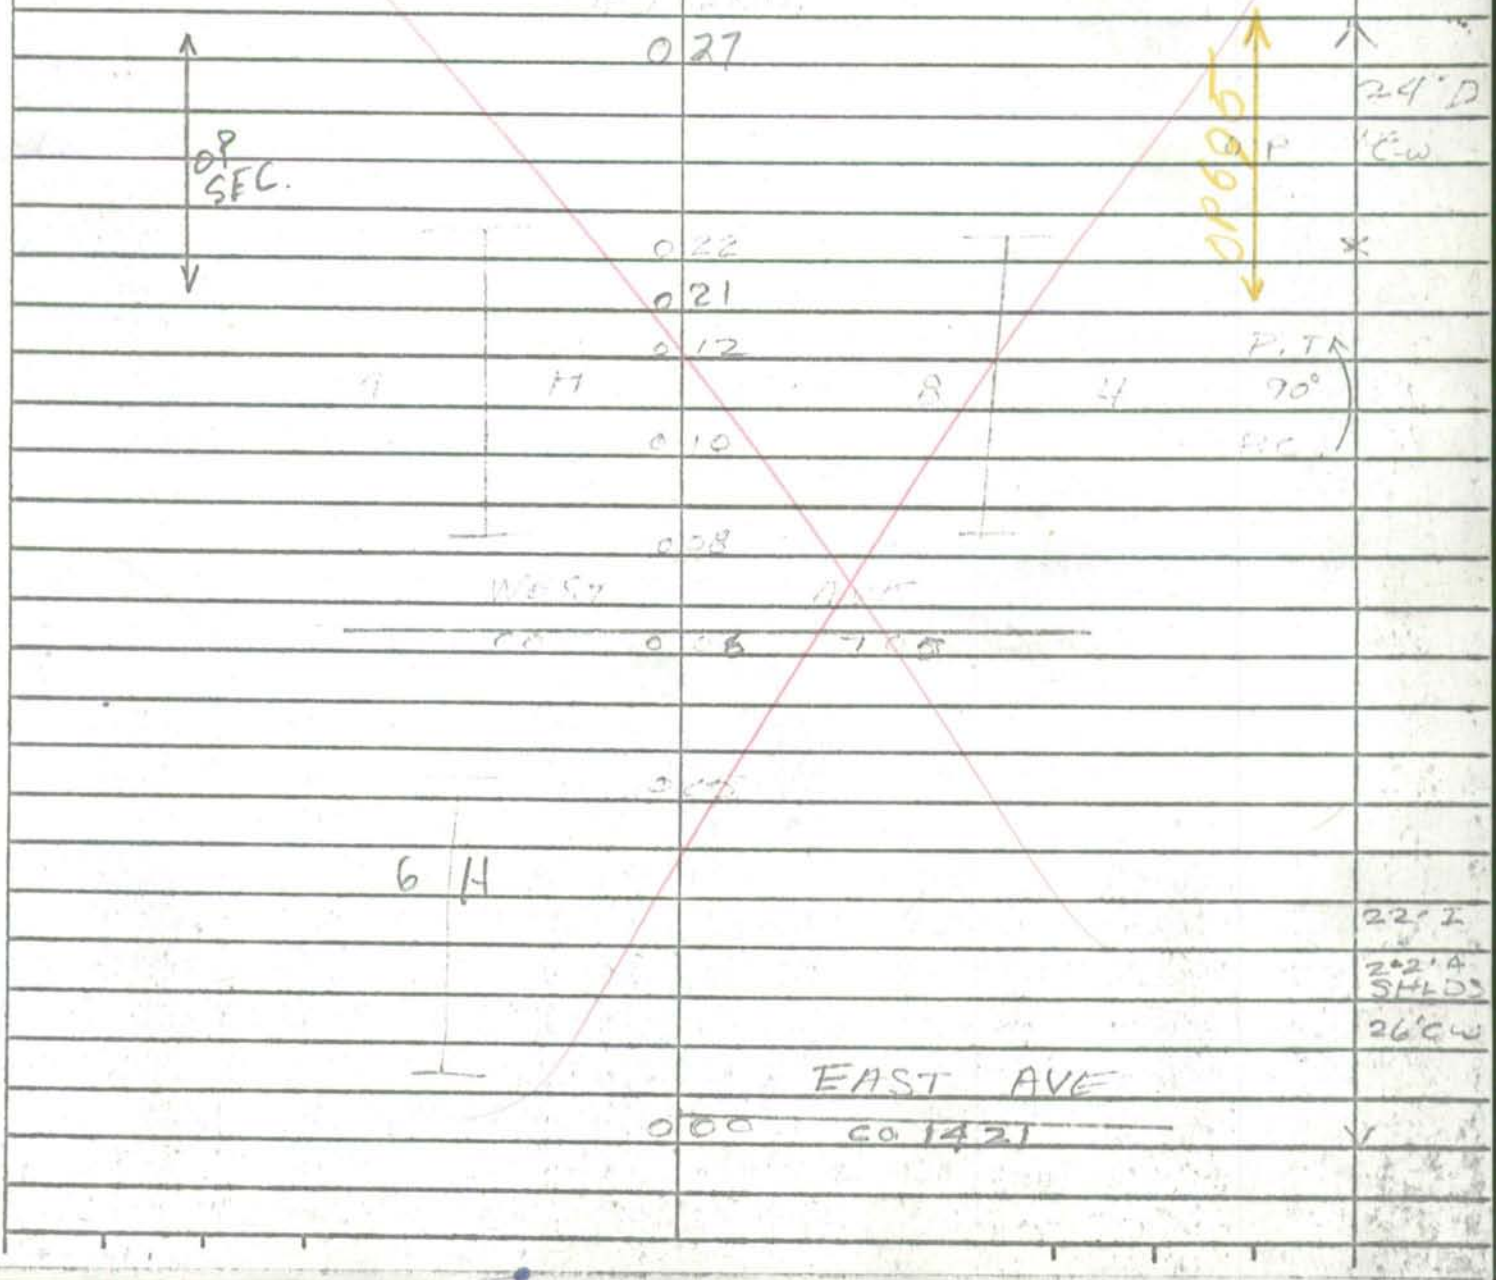

Form 6 HPS (Rev. 1961)

F A U MAP 6

OP 696

ROAD INVENTORY SHEET

G11A

Party Chief E SCHUELER
Recorder T LANDON
Chainman C ENDICK
D Prosser
63-3-076-115 B

802-349
810-344

HILLCROST HEIGHTS

Ver 8-25-77

Road No. Co 1446
Name COLEBROOK DR
Sheet No. 1 of 1
Date 12-14-67
County PRINCE GEORGES

Form 6 HPS (Rev. 1961) FAU. OP697

ROAD INVENTORY SHEET

Party Chief E.S.
Recorder V.D.
Chainman

FA.

MIDDLETON FARMS.

GLD 827 ~~828~~ - 355 ~~M35~~ MARD 8-15-77

Road No. CO 1456
Name ROBIN LANE
Sheet No. 1 OF 1
Date 11-14-96
County PRINCE GEO

UNASSIGNED
NOW CO 1446
96-173

W

ROAD 0 32 END

0 30

0 29

0 25

0 21

OF 36
ROBIN DR 0 19

0 18

0 01

IRD
ALLENTOWN 0 0 RD

90°

14' E
14' CW

20' I.
2-3' E SHC

Form 6 HPS (Rev. 1961)

FAU

OP698

ROAD INVENTORY SHEET

PARTY CHIEF Edward Schuyler
RECORDER Henry Gorman
CHAINMAN J. E. MERKLE

60-82
61-254

DUPONT HEIGHTS

820
829-376 M35

ROAD NO. CO. 146
NAME
SHEET NO. 1 OF 1
DATE 11/21/67
COUNTY PRINCE GEORGES

E

PORTER AVE
0 10 CO 56

50'

R. WARSH. U.F.

HOUSTON
CO. 0 CO. 275

24' I
C-C.

Form 6 HPS (Rev. 1961)

FAU MAP 6 OP697

ROAD INVENTORY SHEET

Party Chief E. SCHUYLER
Recorder T. L. [illegible]
Chainman D. EMERICK
D. GARNER
59-277

NORTH BARNABY

Road No. C.R. 1461
Name SOUTH BARNABY ST
Sheet No. 1 OF 1
Date 12-20-67
County PRINCE GEORGES

361
812 - 360 MS

VER 8-22-77

Ⓐ PARKING LOT

ROAD 0 24 END

PLAY GROUND 0 22

0 21 H
0 19

0 16 PROPOSED RD

0 17

0 15 4 H

0 12

8 H

0 07 H

0 05 H

MD 0 00 414

176
28'cl

20'I

28'cw

Form 6 HPS (Rev. 1961) FAI OP 700

ROAD INVENTORY SHEET

Party Chief E.S.
Recorder W.D.
Chainman T.L.

MAP 10

Road No. CO 1465
Name KEEBLER DR
Sheet No. 1 OF 1
Date 10-1-68
County PRINCE GEO.

JENKINS CORNER

830 343
~~831~~ - ~~342~~ M35

ROAD	031	PROPOSED END	20'E
	029		26'CW
H	026		
H	024		~~20'E~~
CO		971	~~20'CW~~
SCHULTZ	022	RD	
	020	H	24'I 30'CW
30°	011		~~20'F~~
	006		18'H
CO WOODLEY	000	1029 RD	~~14'G~~ ~~20'F~~ 24'CW

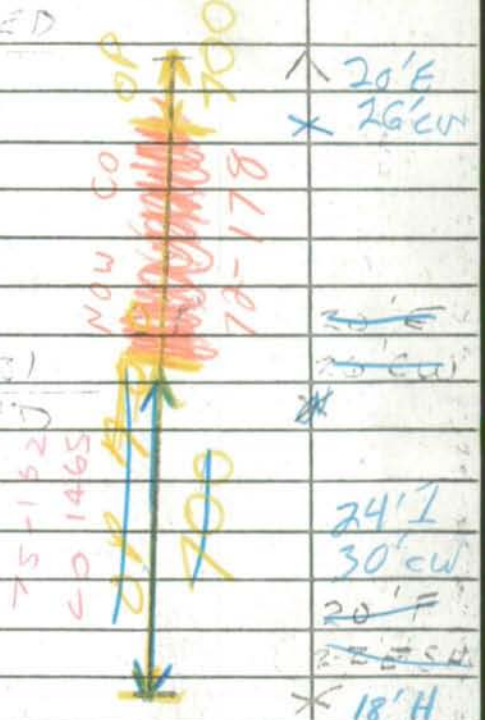

 

SHA 51.3-8
11-15-72

OP 701

ROAD INVENTORY SHEET

Road No. CO 1516
Road Name WELLINGTON ST
Sheet No. 2 OF 2
Date
County PRINCE GEORGES
State Coordinates

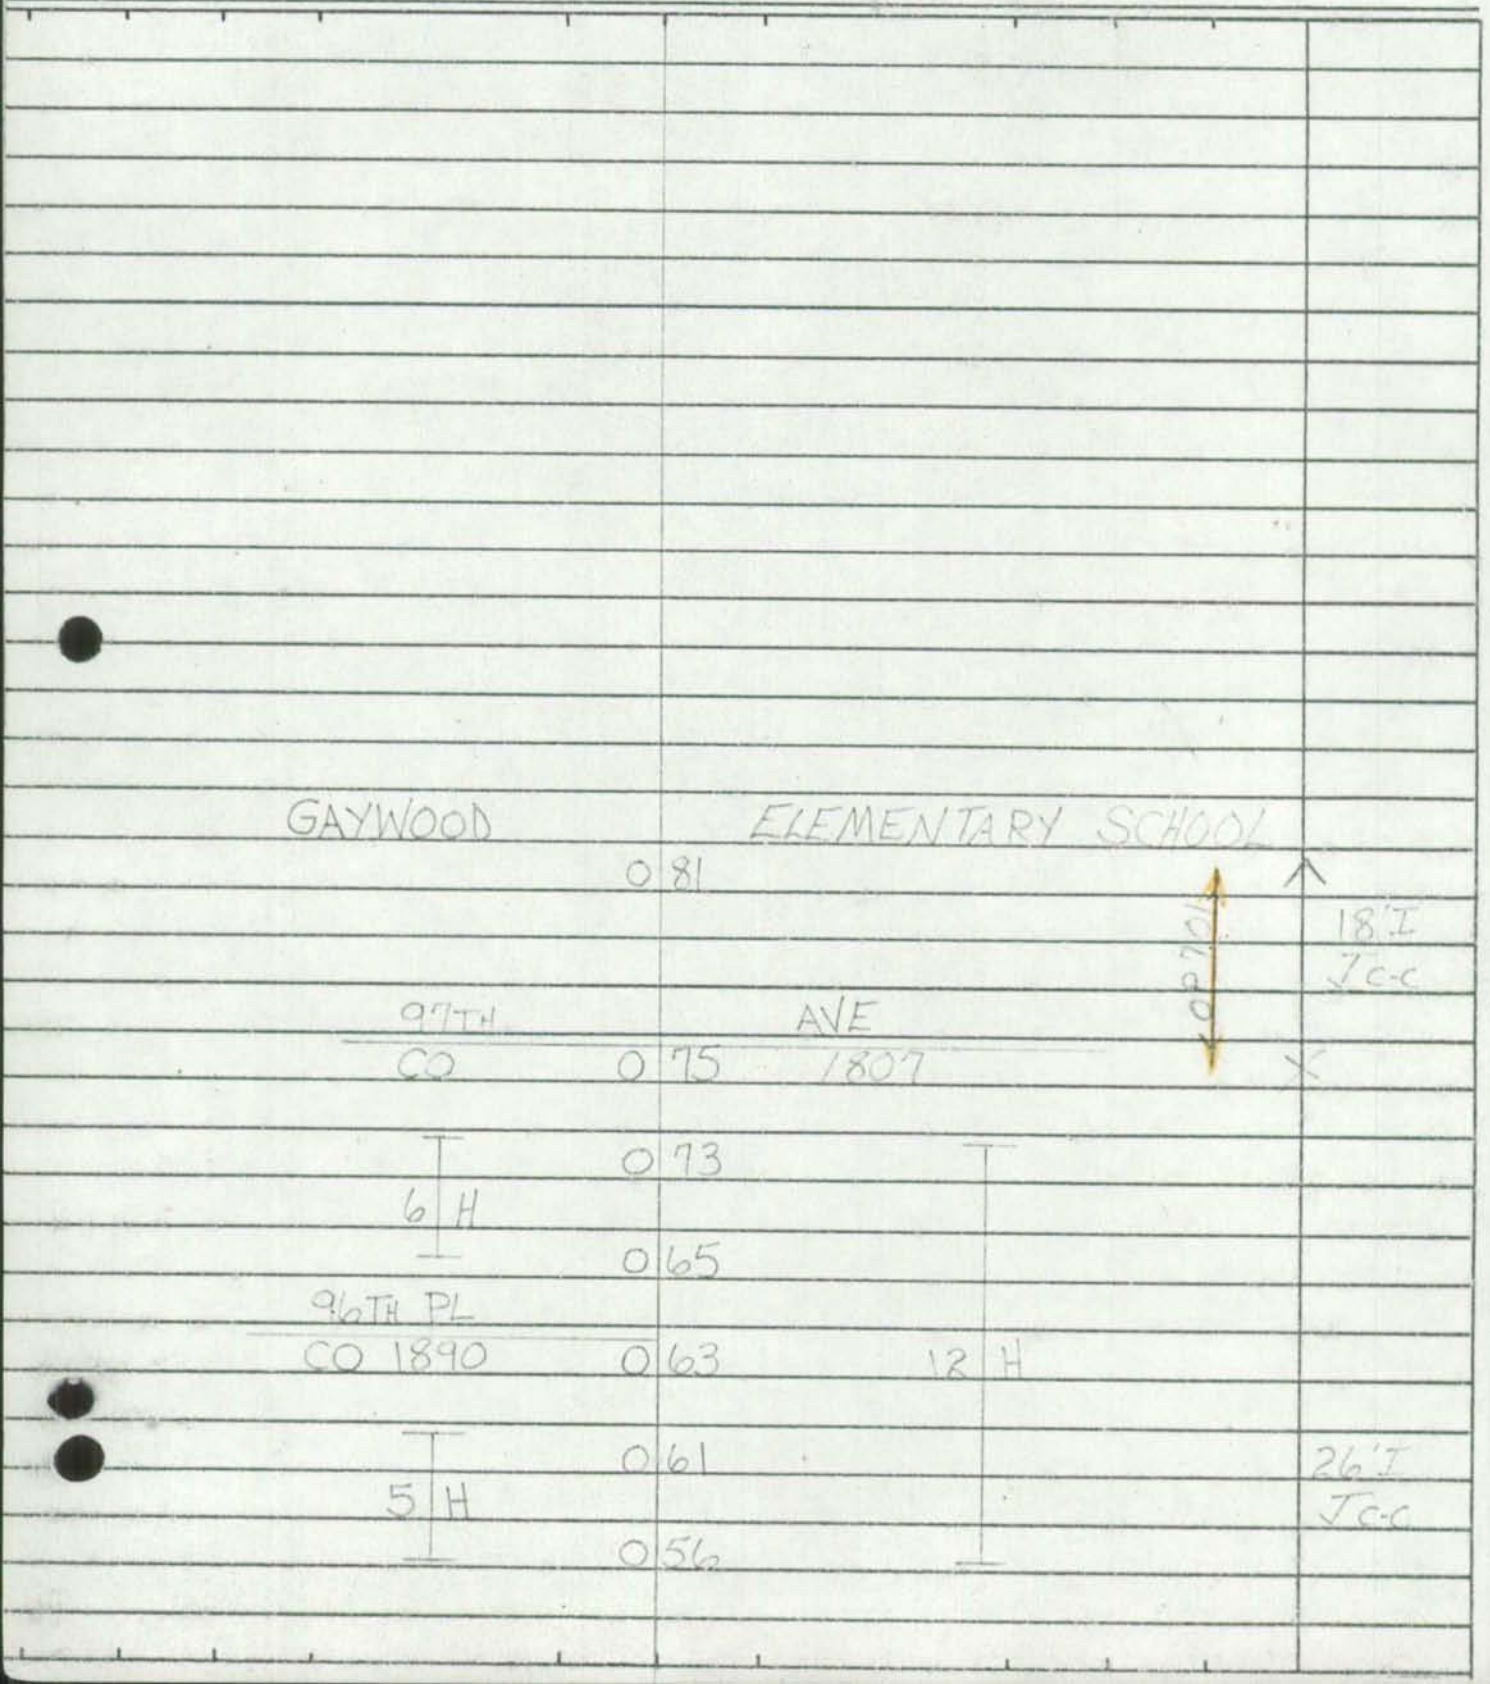

Form 6 HPS (Rev. 1961)

FAU

OP702

ROAD INVENTORY SHEET

Party Chief E. Schuyler
Recorder H Lorman
Chairman

~~MAP~~

Road No. Co. 1524
Name TOWN HALL PL.
Sheet No. 1021
Date 8/4/66
County PRINCE GEORGES

FIIB

822-437
823-436

~~1431~~

45th
Co.

PL.
1523

UNASSIGNED

025

4 H

NOW CO 1524

3 H

20' H
2-5' FSH
36'C-W

019

45th
Co.

AV.
1521

017

90-28

015

4 H

007

7 H

44th AV.
Co. 1520

005

004 H

003

20' I
2-5' ESH
30'C-W

001 H

43RD
Co.

AV.
1519

000

Form 6 HPS (Rev. 1961)

FAU MAP 1 OP 703

ROAD INVENTORY SHEET

Party Chief F Schmitt
Recorder M Coleman
Chainman

BELTSVILLE HEIGHTS

Road No. Co 1526
Name LEXINGTON RD
Sheet No. 1 OF 1
Date 7/20/66
County PRINCE GEORGES

826-441 M27

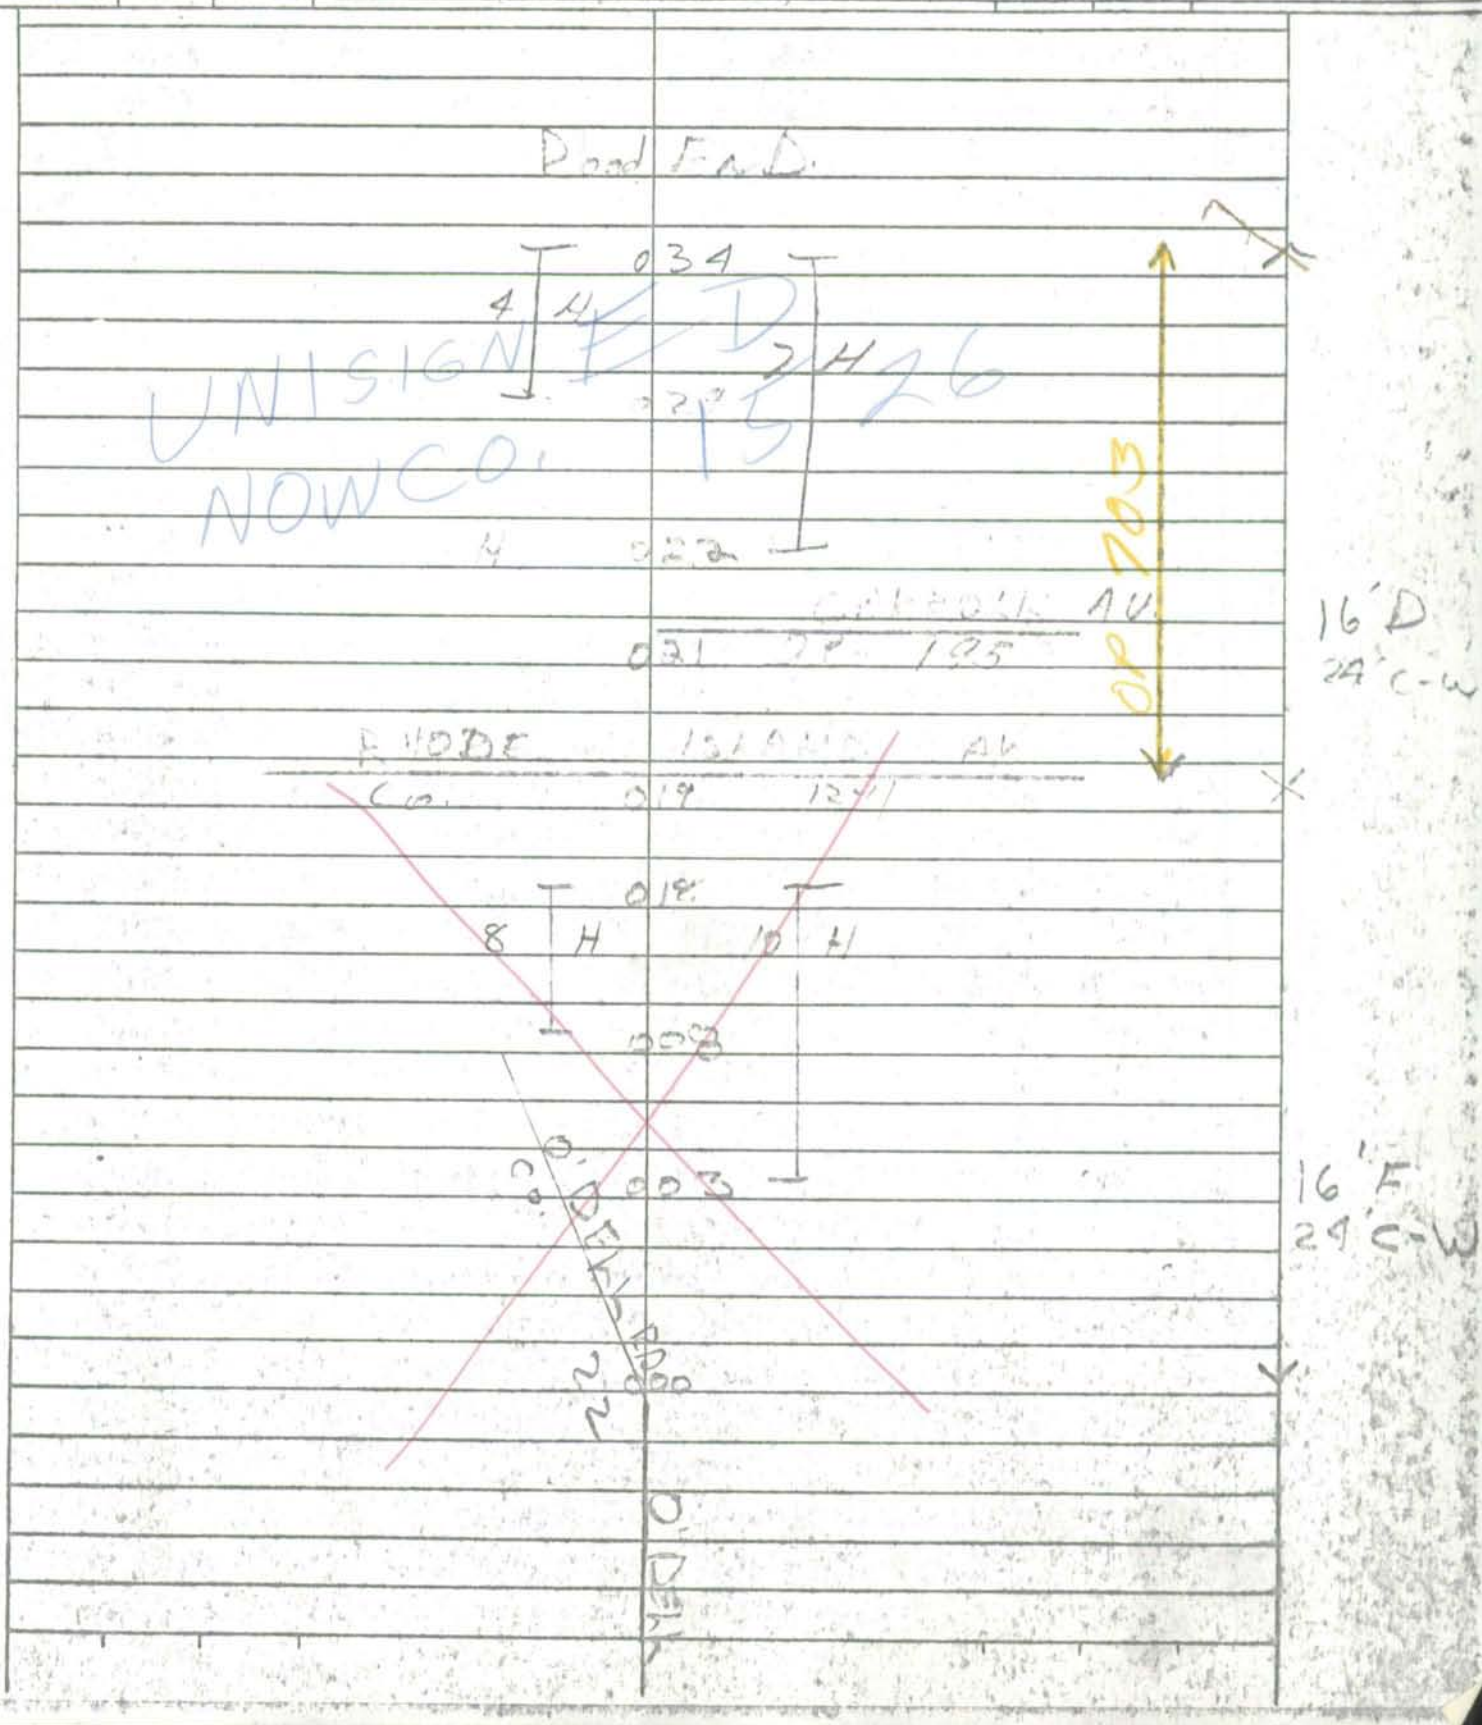

Form 6 HPS (Rev. 1961) FAU MAP 1 OF 704

ROAD INVENTORY SHEET

Party Chief E. Shuler
Recorder H. [illegible]
Chainman

Road No. Co. 1533
Name CAVERLY AV.
Sheet No. 1 OF 1
Date 7/22/66
County PRINCE GEORGES

823-442. M27

Unassigned
Now Co 1533
72-205

Road END
H 308' 13
011 2-24" Square CMP
GREENWOOD RD
Co 1534 007
003 H
H 003
POWDER MILL RD.
MD. 212

18' E
24' C-W
18' F
24' C-W

Form 6 HPS (Rev. 1961)

FAU

GPS 98-77B
11-4-98
SS/SR

08705

ROAD INVENTORY SHEET

Party Chief E. Schuyler
Recorder H GORMAN
Chainman

MAP 2

Road No. Co. IS 42
Name MARYLAND AV.
Sheet No. 1 OF 2
Date 7/12/66
County PRINCE GEORGES

827 ~~439~~ 439 M31 VER 12-12-77 BD

ODELL
Co.

0 35 22

0 22 — SWIMMING POOLS
"I" | Bus. DEPT.

0 21

OP 271

0 20 — RESEARCH LAB VS Corp.
"I" | 2 Bus. IRON WORKS

0 15

16'G
30'C W

185°

0 13

0 11
"I" WAREHOUSE

0 06 — OP
FREDERICK AVE.
0 05 OP 370

0 04
"I" CONTAINER
Bus | CORP.

0 01

24'G
30'C W

OLD BALTIMORE PIKE.
Co.
0 00 23

Form 6 HPS (Rev. 1961)

08705

ROAD INVENTORY SHEET

Party Chief E. Schuyler
Recorder H. Gorman
Chainman

Road No. Co. 1542
Name MARYLAND AV.
Sheet No. 2 OF 2
Date 7/13/66
County PRINCE GEORGES

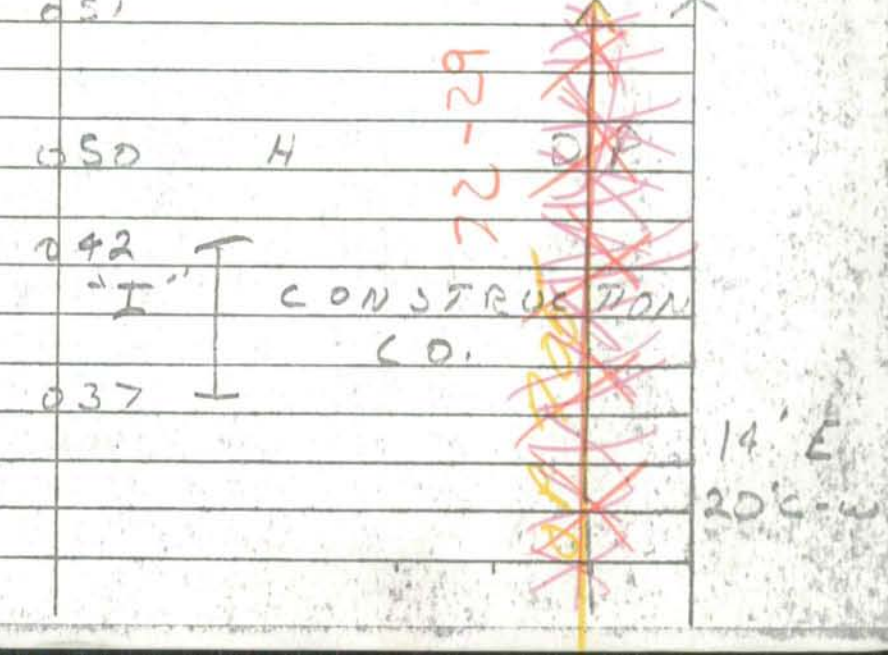

Form 6 HPS (Rev. 1961)

FAU MAP 3

O.P. 706

1-026-F

ROAD INVENTORY SHEET

HOLLY HILL MANOR

Party Chief F Schuster

Recorder

Chainman

(2 FIIA

809-430 ~~M31~~

Road No. (Co.) 591

Name 24th AV.

Sheet No. 1 OF 1

Date 5/16/66

County PRINCE GEORGE'S

N

[illegible] S 12 [illegible]

~~JUNK~~ ~~RxC~~

009

1 H

005 H - 300'

004 [illegible]

003

206

30' F

26' F

18' F

LACKAWANNA ST

Form 6 HPS (Rev. 1961)

FAU ~~MAP~~ 10 OP707

ROAD INVENTORY SHEET

Party Chief E.S.
Recorder W.D.
Chainman

GID VER 7-28-77

838-337 ~~M35~~

Road No. 1595
Name ATOM RD
Sheet No. 1 of 1
Date 9-[illegible]-6[illegible]
County PRINCE GEO.

UNASSIGNED

NOW ALL

CO 1595

MASSIE 89-110

100' PC

CO DANGERFIELD

1595 RD

557

18' E

20' E

20 CMP

Form 6 HPS (Rev. 1961)

FAU

OP 708

ROAD INVENTORY SHEET

(2)

Party Chief
Recorder
Chairman

65-15
66-24

MAP 4
FILE

Road No. CO 1598
Name SMITH AVE
Sheet No. 1
Date 1-6-
County

VER 3-27-78 845-415 ~~831~~

E	0 25	
	- 0 23	
	0 15	
H		
		22 I
		2-3 ASH
SAMPSON	10	

SHA 51.3-8
11-15-72

STATE HIGHWAY ADMINISTRATION OF MARYLAND

OP 709

ROAD INVENTORY SHEET

Party Chief M.Z
Recorder D.T
Helper

Map No. ~~35~~ B G11B

Road No. Co 1621
Road Name Elfin Ave
Sheet No. 1 of
Date 10-5-77
County P.G.
State Coordinates 822-381

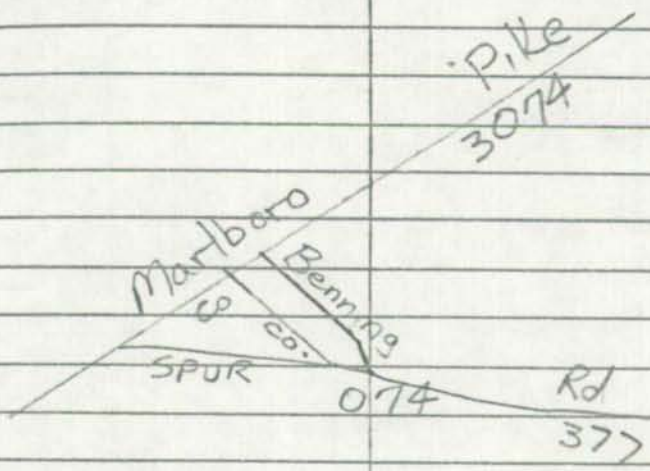

Heath		St
Co.	061	374
Gunther		St.
Co.	047	372
	045	
Fable		St
Co	028	382
Emo	027	St
Co	018	389
Approx Corp. Limits	015	of Dist. Hghts.
	011	
Doppler		St
(MUN)	000	(MUN)

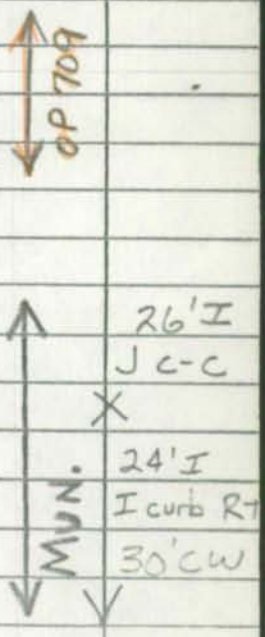

Form 6 HPS (Rev. 1961)

TAH

OP710

ROAD INVENTORY SHEET

PARTY CHIEF Edward Schuyler
RECORDER Henry Gorman
CHAINMAN

(3)

ROAD NO. Co 1646
NAME 60TH AVE.
SHEET NO. 1 OF 1
DATE 10/16/67
COUNTY PRINCE GEORGE

VER
A-19-78

397
824-393 M31

UNASSIGNED

ROAD END H

025 CHURCH

NOW CO 1646

018

96-54

017

S H

7 H

006

60" RCP

H

REED ST

005 Co 1562 340

26' I
C-C

004 H

REED ST
Co 1649
CORP LIMITS OF

003

CHEVERLY

STATE ST
LMUN ST

000

10' E
10' C-W

26 I
ICBRT
JCBLT
~~20' I~~
CURB
2' E SHL
RT 22' C-L

Form 6 HPS (Rev. 1961) FAU MAP 6 08711

ROAD INVENTORY SHEET

4

YORKFIELD DR

Party Chief E.S.
Recorder W.D
Chainman

Road No. CO 1659
Name ~~YORKSHIRE~~ DR
Sheet No. 1 OF 1
Date 11-15-66
County PRINCE GEO

59-278 BROADVIEW VED 8-10-77

827 358
~~823~~ ~~359~~ 435

Form 6 HPS (Rev. 1961)

FAU 6 Ver 10-6-77 OPT 1/2

MAP

ROAD INVENTORY SHEET

TOPEKA AVE

PARTY CHIEF Edward Schuyler
RECORDER ~~Henry Gorman~~ V. [illegible]
CHAINMAN H. GORMAN
6-3-2-026-75

Md.
PARK.

ROAD NO. CO1678
NAME ~~65 AVE~~
SHEET NO. 1 of 1
DATE [illegible]
COUNTY [illegible]

825
~~825~~ 05 - ~~383~~ 382 435

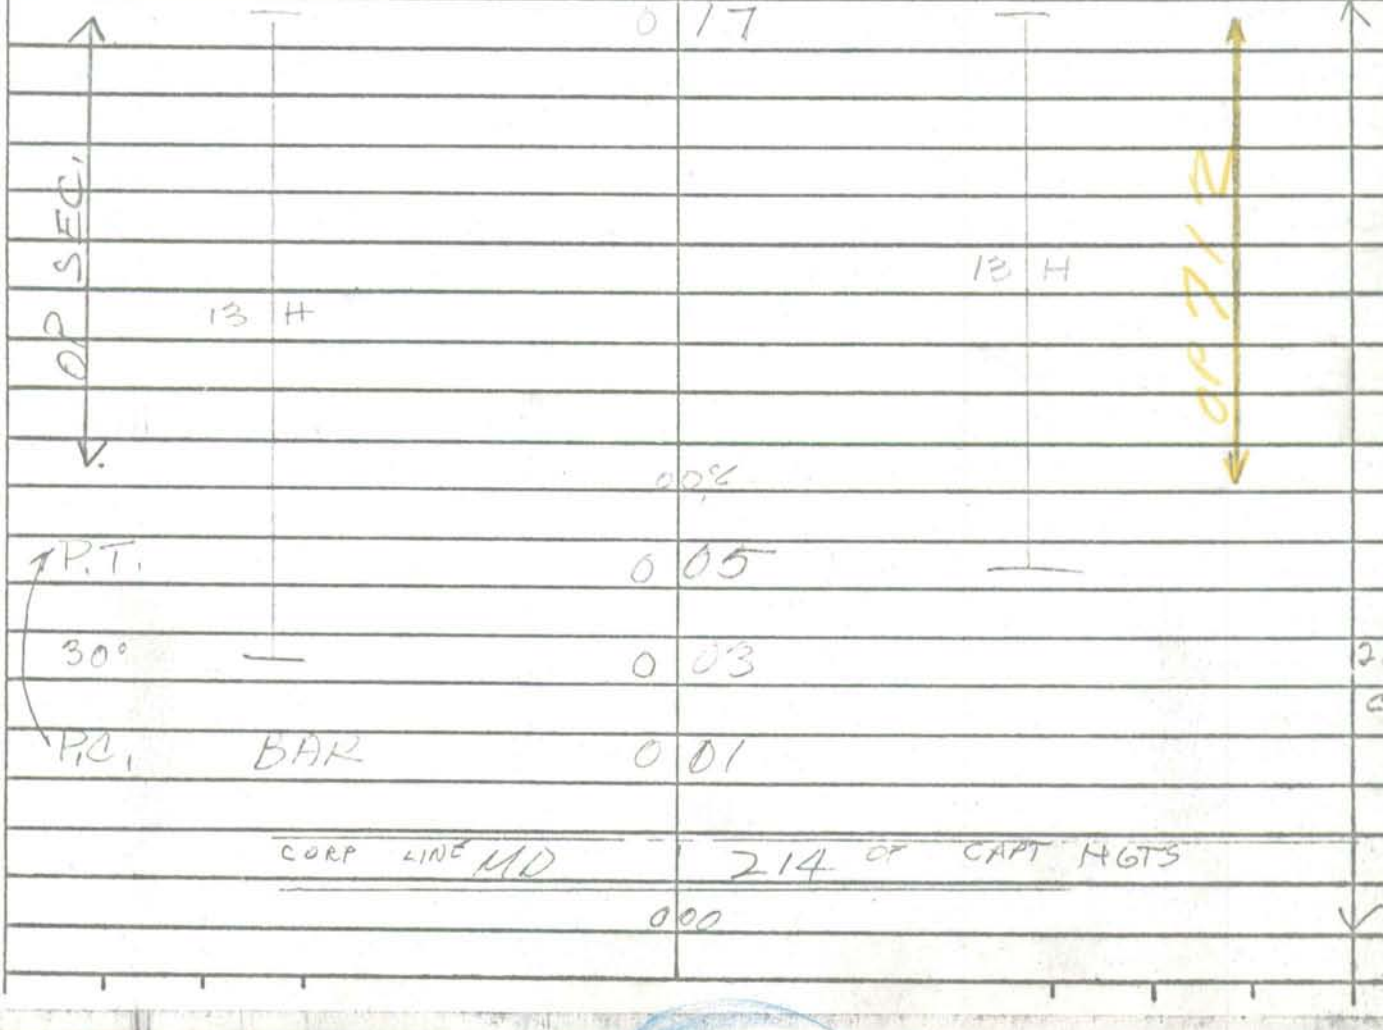

Form 6 HPS (Rev. 1961)

FAU

OP713

ROAD INVENTORY SHEET

Party Chief F.S.
Recorder W.D.
Chainman

MAP 10

Road No. Co 1694
Name VISTA LA
Sheet No. 1 OF 1
Date 9-25-64
County PRINCE GEO

VER 7-29-71

CLINTON 635 834-340 M35

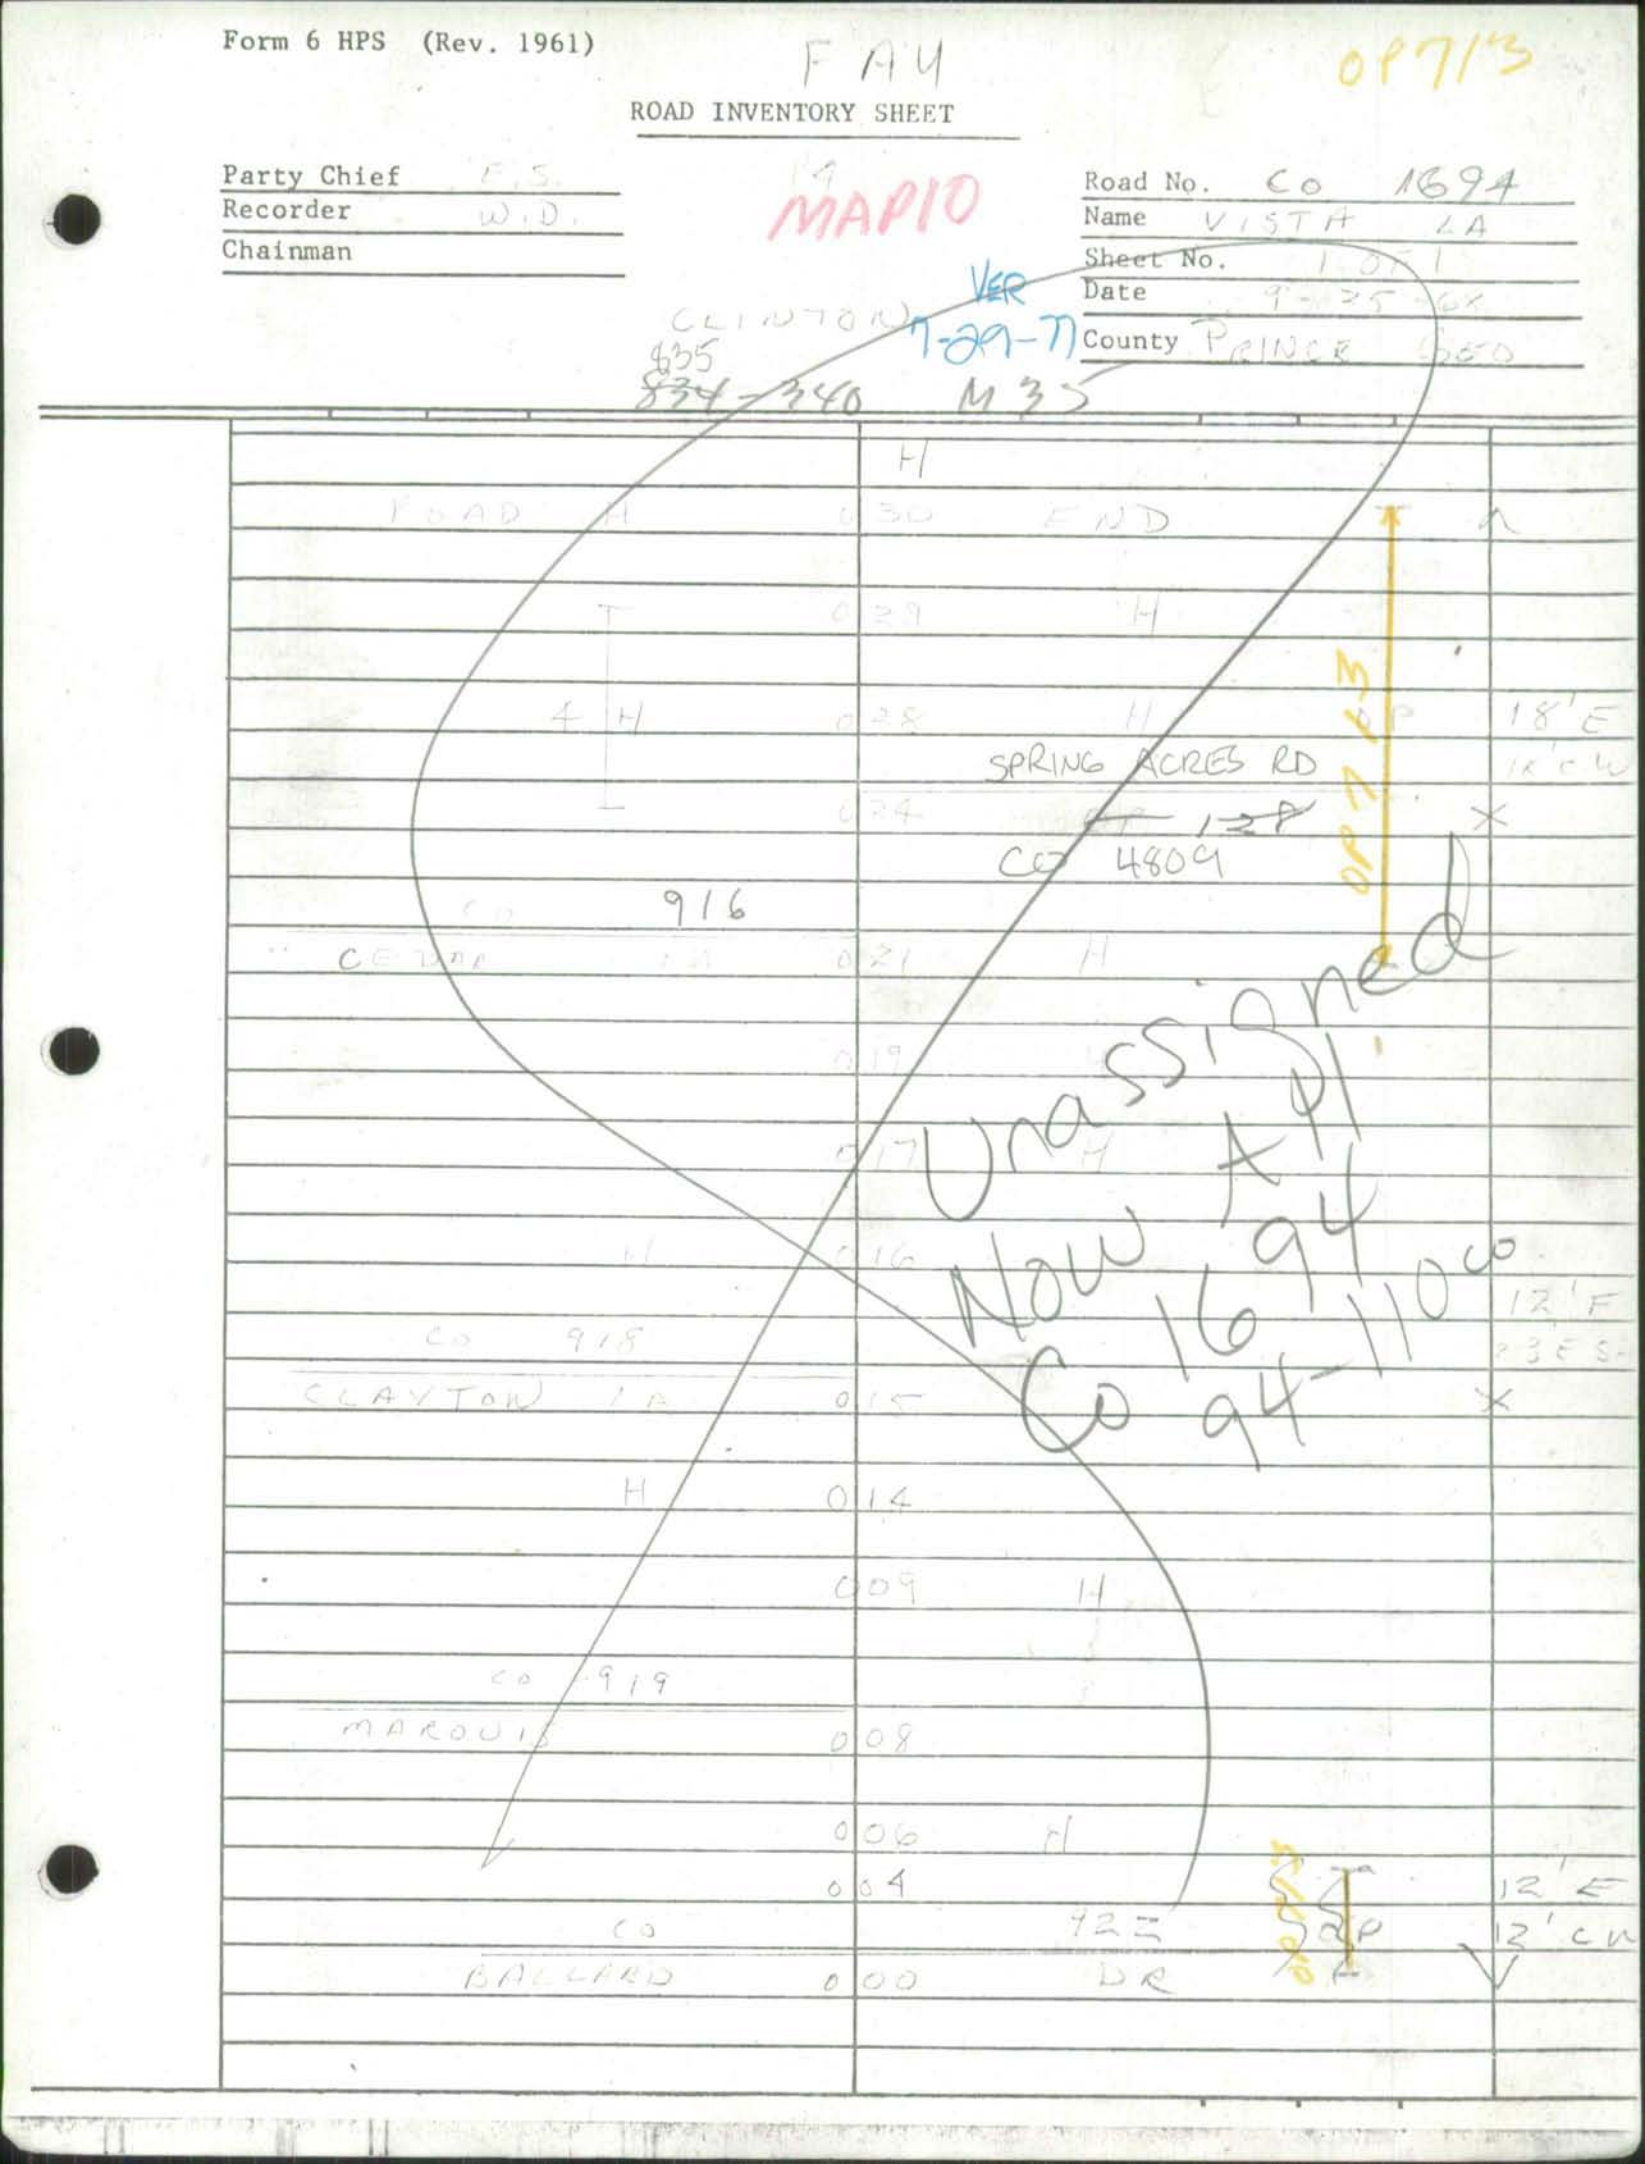

Form 6 HPS (Rev. 1961) FAU OP 714

ROAD INVENTORY SHEET

Party Chief E. S.
Recorder W. D
Chainman MIDDLETON FARMS

-3-546-126-A
170-154

Road No. CO 1700
Name SHOPTON DR
Sheet No. 1 OF 1
Date 11-14-68
County PAUL E SCO.

Unassigned
New Co. 1700

FENCE
ROAD 0+25 END

0+24 11

0+22 G WASH DR

0+21

CO 2339
TYBURN ST

0+16 A H

0+14

OP 1419
0+13 SHOPTON CT

0+10 H

0+08 OP 39

0+05 H

0+04

CO
MIDDLETON 0+00 ZA

26' I
C-C

Form 6 HPS (Rev. 1961)

FAH

OP715

1972 UNASSIGNED RT

ROAD INVENTORY SHEET

Party Chief E.S.

Recorder W.D.

Chainman

59-270

4

FT. FOOTE

MAP 9

Road No. [illegible] 1722

Name DAF CR

Sheet No. 1 OF 1

Date 7-3-68

County PRINCE GEO

	ROAD		END		
	H	043	H		
		GATE			
		040			
		031			
	H	030			
	H	028			
				549	
			CHAPEL DR.		
		024			
		020			
		016			
		010	H		
		003			16'C
			114		3-3-SH
	OVEN HILL	000	RD		

Form 6 HPS (Rev. 1961) FAU OP 716

ROAD INVENTORY SHEET

Party Chief E. S.
Recorder W. D
Chainman

GLENWOOD PR

Road No. CO 1733
Name RAILROAD AVE
Sheet No. 1 OF 1
Date 1-20-61
County PRINCE GEO

UNASSIGNED DUPLICATE OF O.P. 829

BEG END

0+00

9'D
12'CU

0+23

0+21

4 | 4

0+17 H

0+14 CH

H 0+10 H

OP CENTER LOG AVE

T 15° 0+05

0+03 45°

16' H
2-3'E SH

CO 412
PACTO 0+00 AVE

Form 6 HPS (Rev. 1961) FAU MAP 6 OP 717

ROAD INVENTORY SHEET

Party Chief E.S.
Recorder W.D.
Chainman

GLASSMANOR

Road No. Co 1749
Name ABBOTT DR
Sheet No. 1 of 1
Date 1-10-69
County PRINCE GEO

811-389 N35

UNASSIGNED
NOW Co 1749
ABBOTT DR
76-62

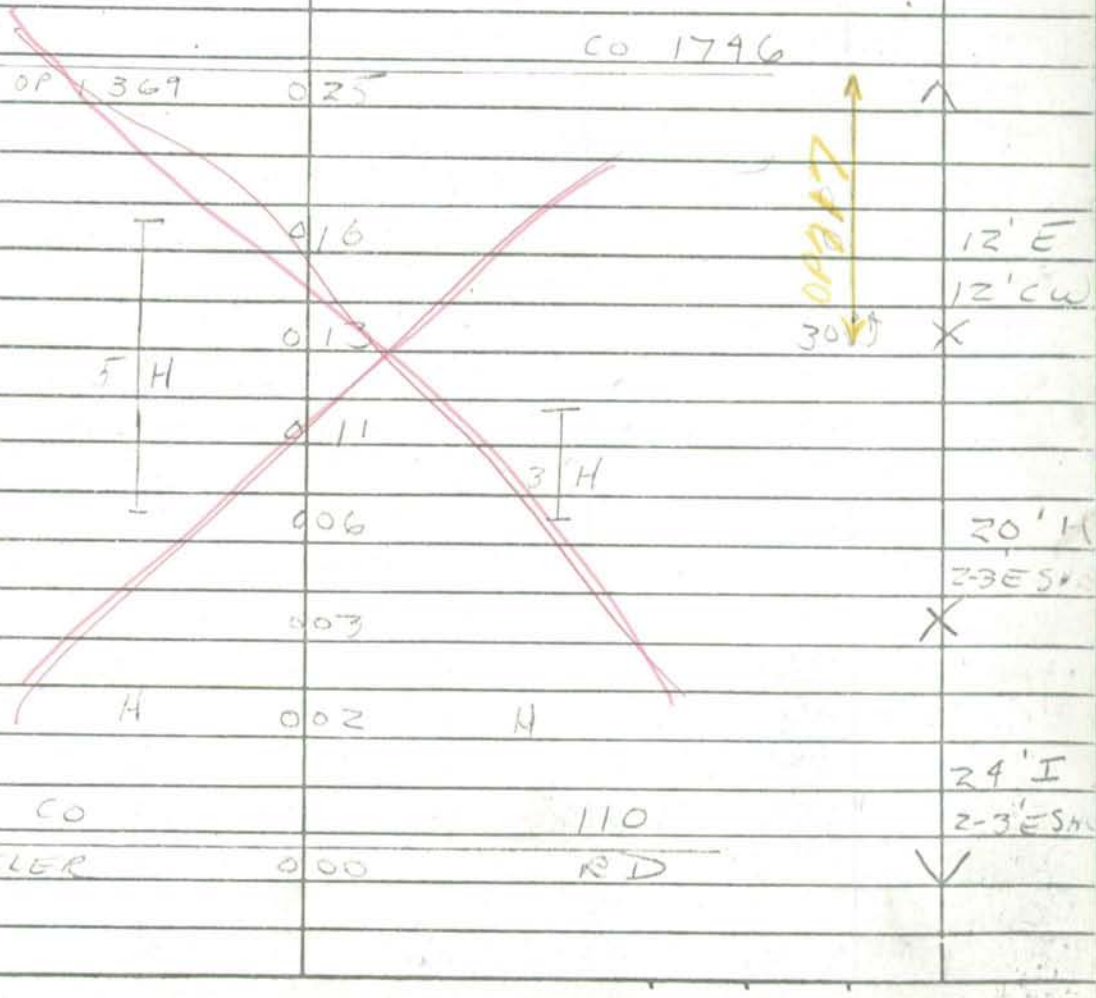

Reassigned 2-17-71 GJG

Form 6 HPS (Rev. 1961) Previous OP 718 Now Co 1762

ROAD INVENTORY SHEET

Urban

Party Chief E. S. Chuyler

Recorder H. Gorman

Chainman

GREENBELT

Road No. OP-718

Name COURT. 71-Ridge Rd.

Sheet No. 1 OF 1

Date 5/23/67

County PRINCE GEORGES'

F11B

634-429 MD

Do Not Plot 4-8-80

S

ROAD END

003

001

57' I

57' C-W

18' I

C-C

RIDGE RD.

Mi 0000 0440

e.87

Form 6 HPS (Rev. 1961)

FAV

ROAD INVENTORY SHEET

MAP 08719

PARTY CHIEF Edward Schuyler
RECORDER Henry Gorman
CHAINMAN

ROAD NO. Co. 1777
NAME FURMAN LEWY
SHEET NO. 2 OF 2
DATE 9/12/67
COUNTY PRINCE GEORGES

VER 4-5-18 828 827.4 - 407.4 M31

600' H 1000' H
Beacon Light Rd
(ABAN)
C4987
NON FA
LOCAL
H 200'
C63 ELEMENTARY School
H
C61
INGRAHAM ST
Co 1777
C54
H H
C57
C47
VALLERY ST
C46 Co. 1977
C43
6 H
C36
22 H
GREENLAND ST.
C35 Co. 2205
SAME

Form 6 HPS (Rev. 1961) FAU OP 720

ROAD INVENTORY SHEET

Party Chief E. Schuyler
Recorder K Gorman
Chainman
67-25

Road No. Co. 1785
Name GREENWOOD RD.
Sheet No. 1 of 1
Date 7/27/66
County PRINCE GEORGES

UNASSIGNED

90-13

NOW see Co 1785

BER + JMB

Road E. of D.

H -12 T

-10

ASH SL 9 H

Co. 1093 006

H -04

001

CEDAR LA.

Co. 000 21

18' F
24' C-C

18' E
24' C-C

Form 6 HPS (Rev. 1961)

OP 721

ROAD INVENTORY SHEET

Party Chief E. SCHWARZER
Recorder T. LANDON
Chainman J. EMERICK
D. PLUMMER

4 GIID
BARNABY OAKS MANOR VER 8-19-72

Road No. Co 1837
Name BROADWATER ST
Sheet No. 1 of 1
Date 12-21-67
County DP GED.

~~812~~ - 358 ~~1175~~
811 - 359

E

PROPOSED 810 RD

0.1

0.09
0.07
0.06
0.01
0.00

6 1/4

5 1/4

CO. LIMIT

30' E
36' O.

26' E
C-C

WINSTON CO

ST 1838

Form 6 HPS (Rev. 1961) 1 AU OP722

97.100 WB/CG 2-12-88

ROAD INVENTORY SHEET

Party Chief E.S.
Recorder W.D.
Chainman T.L.

4

VER 8-18-77

PHELPS COR

Road No. CO 1290
Name SUNNYSIDE LA.
Sheet No. 1 OF ~~2~~
Date 10-4-68
County PRINCE GEO

G11C 804-350 ~~M35~~

				19'I
	C	37	H	16'H
				~~22'E~~ SW
	C	28	H	X 20'C-W
	C	25	H	
H	C	23		
				16'I
	C	22	H	~~16'E~~
				~~22'C SW~~
H	C	20		X 20'C-W
H	C	19		
CO 2264				
REDFORD DR	H	17		
	C	15		
8 H	C	12	H	
	C	08		
7-11 STORE	C	02		
			1203 ROAD	
GAS STA	C	01		
165 CO BARNABAS	C	00		
				24'H
				CURB-C
				3 SHO-A

N

Form 6 HPS (Rev. 1961)

OP 722

ROAD INVENTORY SHEET

Party Chief S.S.
Recorder W.D.
Chainman T.L.

PHELPS COR

Road No. Co 1840
Name SUNNYSIDE LA
Sheet No. 2 of 2
Date 10-7-64
County PRINCE GEO

GOLF COURSE

ROAD	CLUB HOUSE	049	END	
	PT 60°	046		
	PC	043		SAME

Form 6 HPS (Rev. 1961)

OP 723

CAPT BRENDT DR

ROAD INVENTORY SHEET

Party Chief E.S.

Recorder W.D.

Chainman

Road No. CR 1963

Name CAPT ~~BRENDT~~ DR

Sheet No. 1 OF 1

Date 5-17-83

County PRINCE GEO

ACCURATE MAP 12 798 ~~798~~ - 309.5 M 39

ABAN 7-6-77

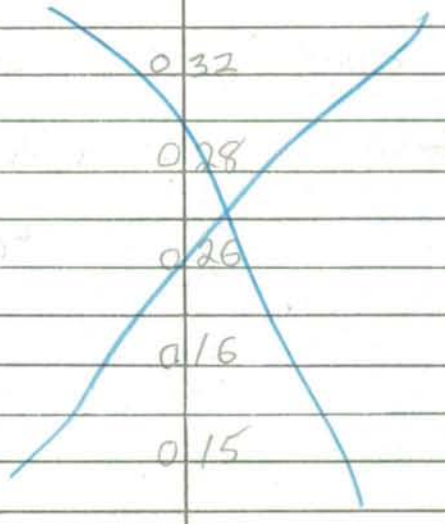

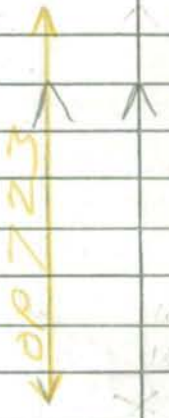

16' H

2-3' ESH

Reassigned 2-17-71 SJG

Fo[illegible]S (Rev. 1961) (Previous OP 724/Nov Co 1870 69-226)

ROAD INVENTORY SHEET

Urban

Pa[illegible]ief E. Schoyler GREENBELT

Recorder N. GORMAN

Chairman

F11B

Road No. OP 724

Name COURT 73 - Ridge Rd.

Sheet No. 1 OF 1

Date 5/23/67

County PRINCE GEORGES'

834 ~~A29 438~~ ~~A31~~

S

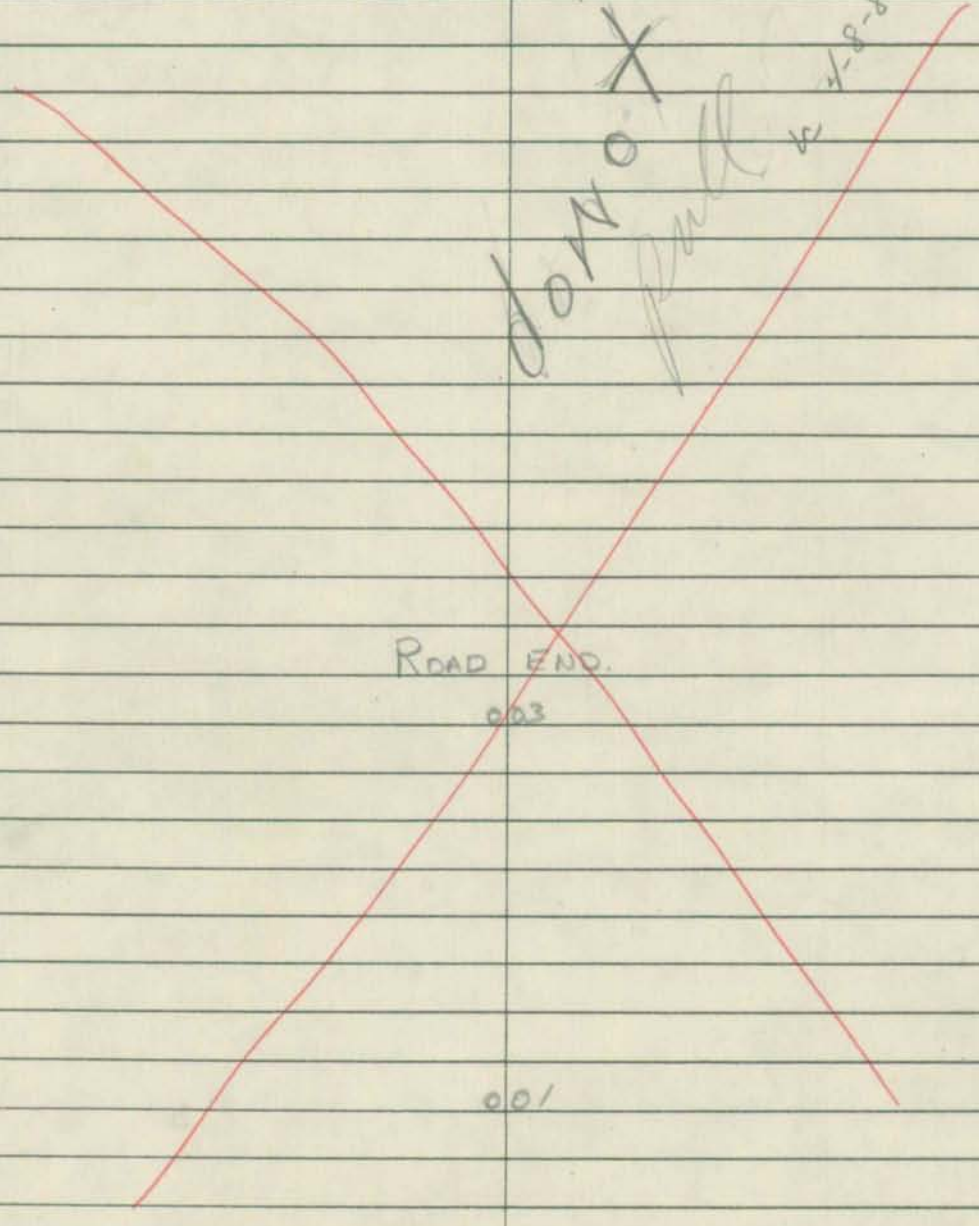

Reassigned 2-17-71 SJG
(Previous OP 724 Now Co 1890 69-226)

Form 6 HPS (Rev. 1961)

ROAD INVENTORY SHEET

Urban

Party Chief E. Schuyler GREENBELT
Recorder N. GORMAN
Chainman

F11B

834 ~~A29 438~~ ~~A31~~

Road No. OP 724
Name COURT 73 - Ridge Rd.
Sheet No. 1 OF 1
Date 5/23/67
County PRINCE GEORGES'

S

ROAD END.

023

001

56' F
56' C-W

18' F
C-C

RIDGE RD.

MUN. 000 0440

@.82

Form 6 HPS (Rev. 1961) FAU 08725

ROAD INVENTORY SHEET

Party Chief E.S.
Recorder W.D.
Chainman T.L.

MAP 10
COLES CORNER
7-135

Road No. Co 1871
Name WAYNE DR
Sheet No. 1 OF 1
Date 9-26-68
County PRINCE GEO

ALL TO Co. 1871

UNASSIGNED

MD 022 223 A

017

015

12 H

90°

011 6 H

007

006

002

20' H
2-3 ESH

Co 1870

GREEN 000 ST

Form 6 HPS (Rev. 1961)

FAU

OP 726

See New Inv.

ROAD INVENTORY SHEET

Party Chief E Schuyler

Recorder K Gorman

Chainman

Road No. Co. 1875

Name TOWHEE AV

Sheet No. 1 OF 1

Date 8/11/66

County PRINCE GEORGE'S

UNASSIGNED

NL CO

025

12 H.

30'D

30'C-C

15 H 017

PT

63°

26'I

C-C

027

KILLDEER AV.

026 Co. 1876

001 H

PC

36'I

C-C

RIGGS

MD

RD.

000 212

Form 6 HPS (Rev. 1961) FHA OP 727

ROAD INVENTORY SHEET

Party Chief E. Schuyler
Recorder A. Brown
Chairman

~~MAP~~ FIIB

Road No. Co. 1884
Name WICOMICO AV.
Sheet No. 1 OF 1
Date 8/3/66
County PRINCE GEORGES

VER 12-6-77 823-439 ~~M3~~

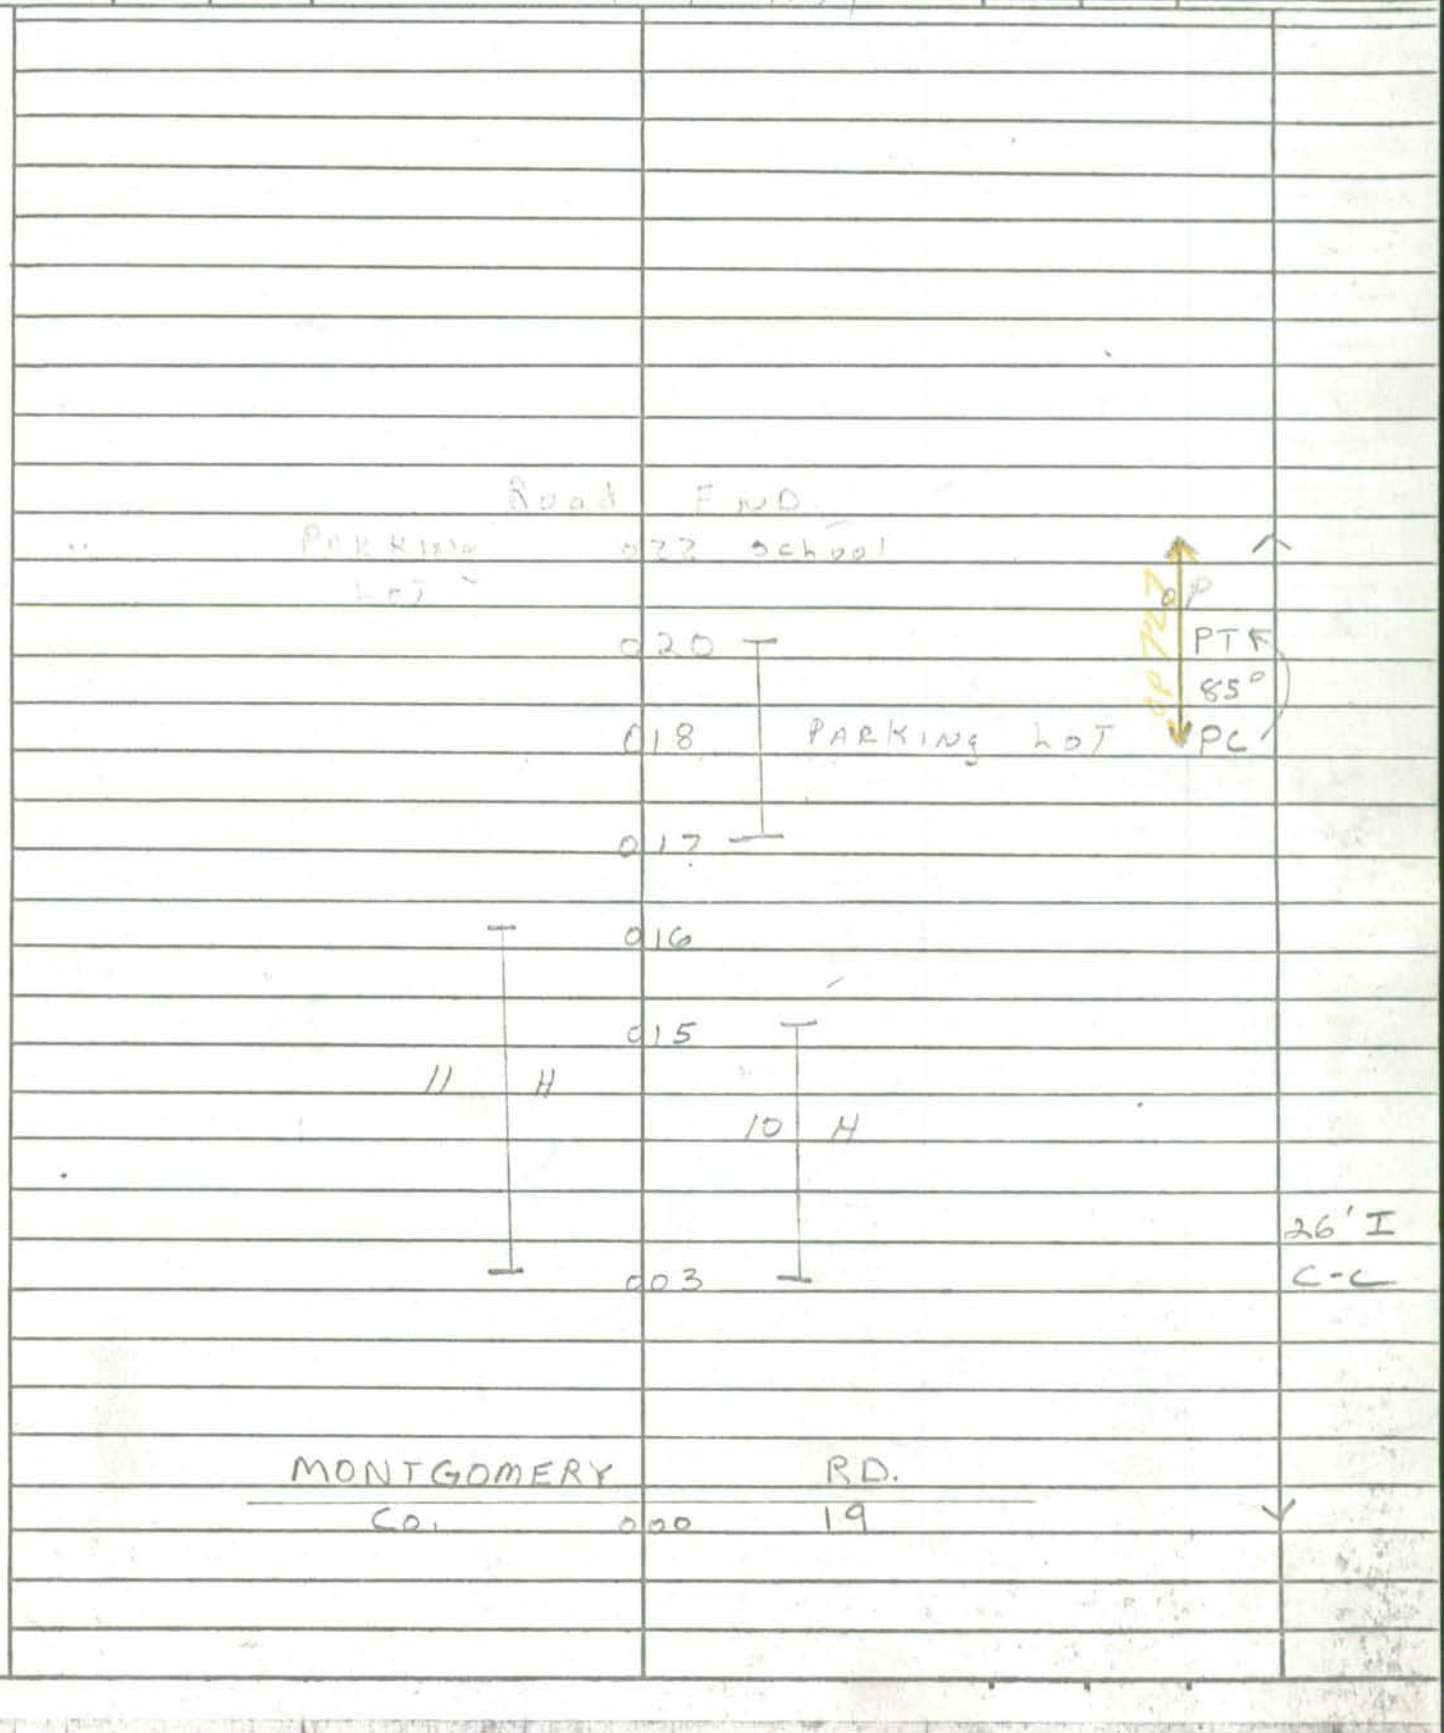

Form 6 HPS (Rev. 1961)

FHU MAP7

OP728

ROAD INVENTORY SHEET

Party Chief E.S.
Recorder W.D.
Chainman

59-223

VGR 8-16-77

AUTH VILL

GIID

828-340 ~~M95~~

Road No. CO 1907
Name CABLE AVE
Sheet No. 1 OF 1
Date 11-13-68
County PRINCE GEO

ROAD	032	FDD
9 H	031	9 H
	020	
CO		1905
DUBLIN	018	DR
	016	
W		
5 H	015	7 H
	009	
CO		1906
PRAYNER	006	AVE
H	004	H
	003	
H	002	H
CO		2146
BARTO	000	AVE

26' I
2-3' ESHO
X

26' I
G-G

Form 6 HPS (Rev. 1961)

FAU

OP 729

ROAD INVENTORY SHEET

Party Chief E. SCHUYLER
Recorder H. GORMAN
Chainman

4.0-38

VER 11-30-77

F11B

812-417

Road No. Co. 1935
Name ROSEMARY LA.
Sheet No. 1 OF 1
Date 6/27/67
County PRINCE GEORGES'

~~M~~ 31

See Inventory of

Co 1935

97.38

STANDARD ~~ST~~ DRIVEWAY

~~STANDARD~~ Co. 1935

24

10'E
12'C-W

019 (ASH HILL HISTORICAL HOUSE)

016

W

BRIDLE PATH LA

~~OP 400~~

MUN 0045

14 H

015

OP SEPT'ON

PONY TRAIL LA.

~~OP 399~~

MUN 0356

010

H

004

24'E
30'C-W

002

001

26'I
C-L

CLAY MORE CO.

AVE.

000 1936

Form 6 HPS (Rev. 1961)

FAU
~~MAR 7~~

OP 730

ROAD INVENTORY SHEET

Party Chief E. SCHUYLER
Recorder T. LANDON
Chainman

C0-56
62-48
65-56

VER 3-24-78

FHD

WILDER
CROFT

Road No. Co 1939
Name MARTIN'S LANE
Sheet No. 1 OF 1
Date 8-16-67
County PRINCE GEORGES

831 = ~~411~~
832 - ~~412~~ ~~431~~

	ROAD	0 48	END
6 H		0 40	H
		0 37	H
	RIVERDALE		RD
	Co	0 32	302
H		0 29	H
H		0 26	H
	KEMPTON		RD
	Co	0 24	1938
		0 23	
3 H			
		0 16	
	MARTINS COURT		
	Co 2269	0 14	9 H
H		0 11	
		0 09	
	LOIS		LANE
	Co	0 07	2031
H		0 03	H
		0 01	H
	MARTINA TERR		
	Co 2626	0 00	

10'E
13'CW

36'I
C-C

S

Form 6 HPS (Rev. 1961)

OP 731

ROAD INVENTORY SHEET

See New Inv.

Party Chief E. Schuyler
Recorder H Greene
Chairman

Road No. Co. 1979
Name KERR RD
Sheet No. 1 OF 1
Date 6/9/66
County Prince Georges

Unassigned

1969

016

RED MILL RD.
CO. 2736
OPERATION

014

012

7 H

4 H 011

002

19'G
30'cw

OREM
Co.

DR.
1973

1000

26'I
C-C

Form 6 HPS (Rev. 1961) FAU

ROAD INVENTORY SHEET

OP732 BAYWOLF ST.

Party Chief E.S.
Recorder W.D
Chainman

Road No. CO 1993
Name ~~WOLF ST~~
Sheet No. 1 OF 1
Date 12-13-66
County PRINCE GEO

60-177 G11P

VENKINS COR VSR 8-15-T

~~MAP 9~~

822-349 ~~495~~

W

CO WALDRAN	009	2163 AVET		
		OF	DRAIN	24 H 2-3'E SH.
	007			X
PT 30° PC	006			
	004			
~~CO LOCH~~ RAVEN	003	1995 RD		
				26 'I CVC
CO 2522 BUCHANAN RD	000			V

Form 6 HPS (Rev. 1961) FAU OP 733

ROAD INVENTORY SHEET

Party Chief E. S.
Recorder W. D
Chainman

JENKINS COR

60-178

822-348 M35

MAP 9

Road No. CO 1994
Name MCKINLEY ST
Sheet No. 1 OF 1
Date 12-13-68
County FAUCET GEO

75-111

UNASSIGNED

NOW

CO 1994

X-X-X

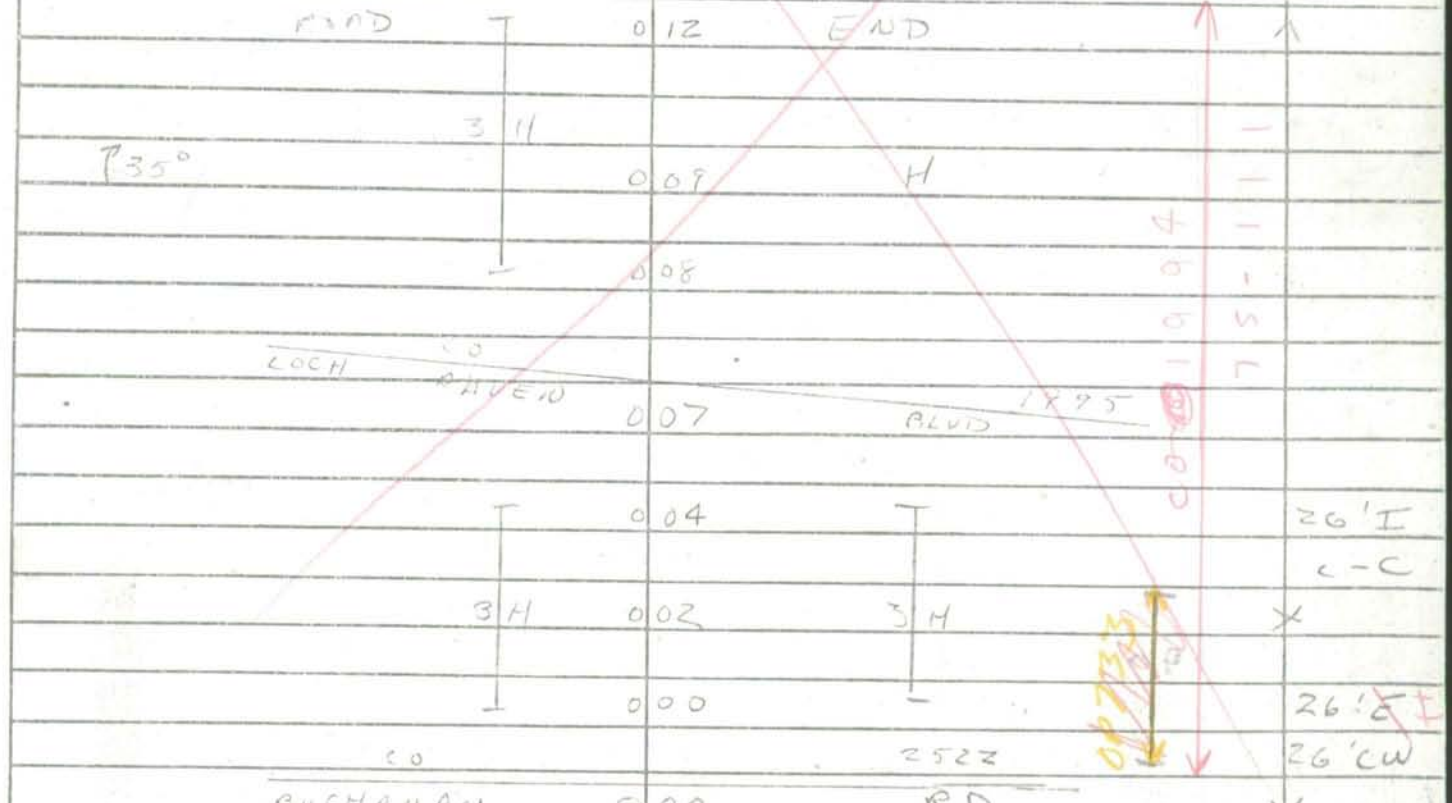

Form 6 HPS (Rev. 1961) FAU OP 734

ROAD INVENTORY SHEET

MAP 1

Party Chief F. Schmidt
Recorder W. Coleman
Chainman

67-24
61-10

Road No. Co. 2008
Name KENNY ST.
Sheet No. 1 OF 1
Date 7/26/66
County PRINCE GEORGES

821-443 M27

X-X-X-X-X-X

ROAD BEGIN END

PULL

NOW ALL

CO. 2008

MONTGOMERY CO. RD 19

26' I C.C.

Form 6 HPS (Rev. 1961) FHU OP 735

ROAD INVENTORY SHEET

Party Chief E Schuyler
Recorder N Gorman
Chainman

Road No. Co. 2016
Name TALBOT AV.
Sheet No. 1 OF 1
Date 7/25/66
County PRINCE GEORGES

FHB 8-1-19

VER 12-8-77 826.5 - 439.5 439 M31

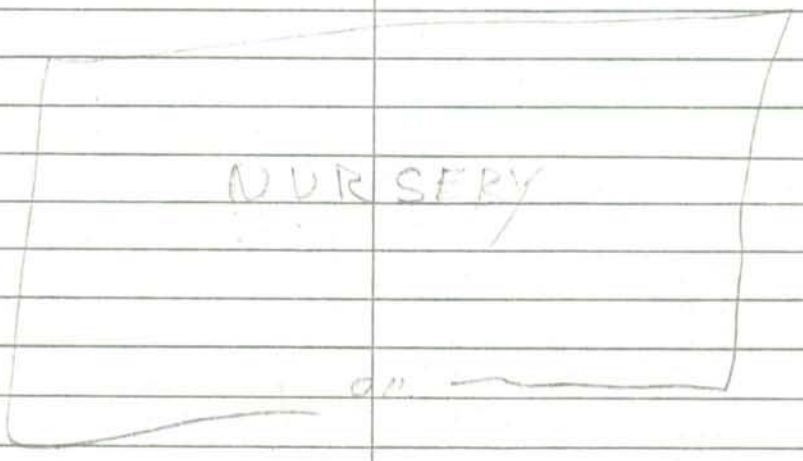

E

008

007

005

14' I

DR. 12" CMP 002

AV.

GEORGE 1602

000

PRINCE CO.

Form 6 HFS (Rev. 1961)

ROAD INVENTORY SHEET

OP 736

MAP 6

Party Chief E. Schuyler
Recorder L. Emrich
Chainman
6-1-74

S. OF SCOTLAND
822
~~821~~ 369

Road No. UNASS CO. 2041
Name SUCHANOR LA.
Sheet No. 1 OF 1
Date 12/7/67
County M. Co.
M 35

NOW ALL COUNTY !

COUNT. AHEAD O.K. SET

ROAD END

0.04

102 APTS. UNITS

0.01

SUCHANO RD.

CO 000 1.35

26' I
C.O.

Reassigned 2-17-71 G/G

Form 6 HPS (Rev. 1961) (Previous OP737 Now Co. 2050 61-147 69-172)

ROAD INVENTORY SHEET

URBAN

Party Chief E. Schuyler
Recorder H. Gorman
Chainman

GREENBELT. UNIVERSITY SQUARE

Road No. OP737
Name Service Rd. "C"
Sheet No. 1 OF 1 Ch. 1
Date 5/16/67
County PRINCE GEORGES

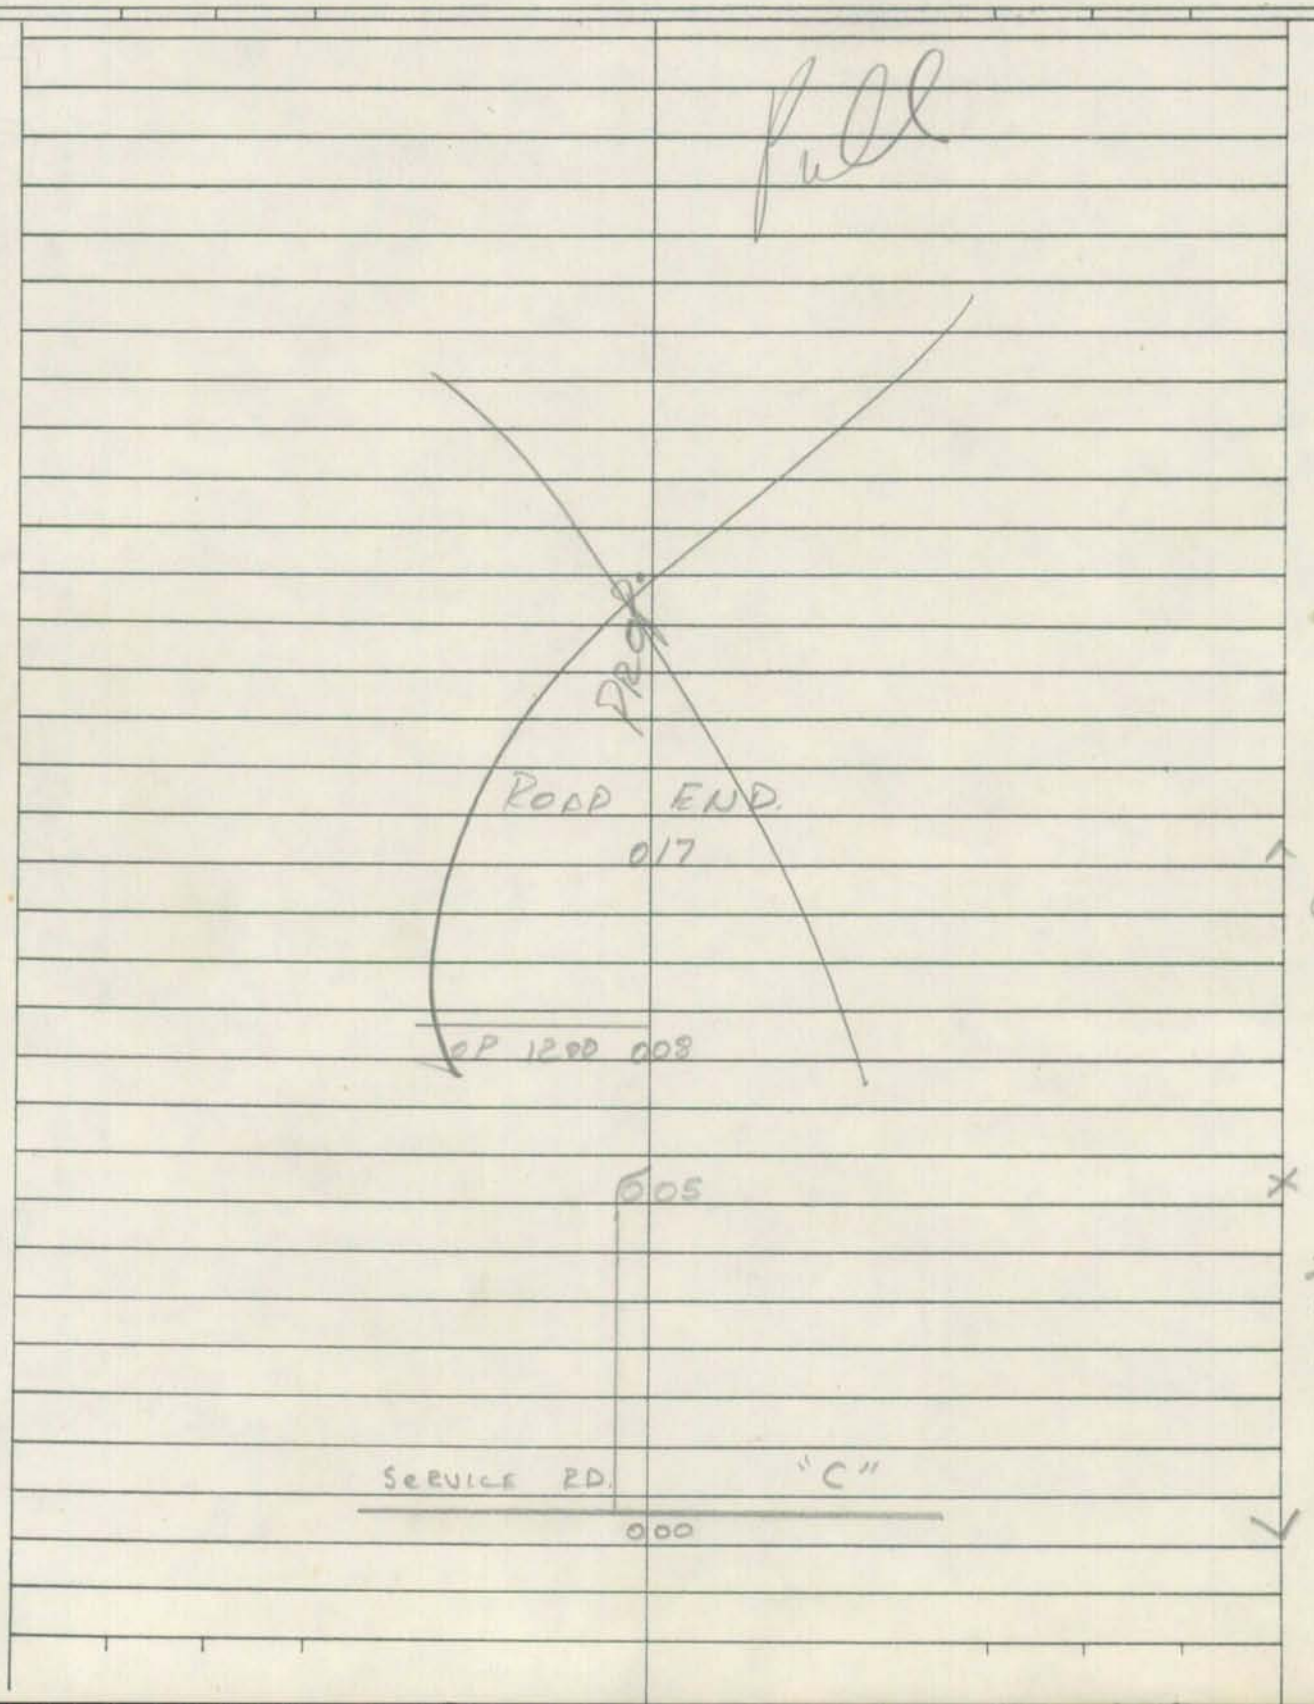

Form 6 HPS (Rev. 1961) FAU OP738

ROAD INVENTORY SHEET

BIDDLE RD

Party Chief E.S.
Recorder W.D.
Chainman

Glen Huey VER 6-29-77 MAP 12

Road No. Co 2058
Name ~~BIDDLE~~ ~~RD.~~
Sheet No. 1 OF 1
Date 8-8-68
County PRINCE GEO.

61-229
M39
796-304
CO LIVINGSTON 053 1201

	H	0 50	MD 810 J	
	H	0 46		
		0 42	95° ↑	
	H	0 39	80° ↑	
		0 35		
		0 31	H	
		0 26	H	
		0 25	H	
	H	0 24		
		0 20	PR	
	H	0 15		
	H	0 12	H	
	H	0 10	H	
	H	0 08		
		0 07	H	
		0 03	H	
CO FARMINGTON		0 00	699 RD	

20'E
30 CWL
~~15~~ 6
~~22'E SHO~~

Form 6 HPS (Rev. 1961) 1-AD

OP 739

ROAD INVENTORY SHEET

Mulberry Street

Party Chief E. Schuyler
Recorder H GORMAN
Chainman
61-108

Road No. CO. 2089
Name CATALPA ST.
Sheet No. 1 OF 1
Date 6/12/66
County PRINCE GEORGES

Unassigned
1970 Improvement
Picked up in field

Roads Field

035
030
010 OP 739
009
30 APT UNITS. 3 H
007
004
BUS TAVERN 001
U.S. 1.
000

20' D
24' C-W
24' H
20' C-W

Form 6 HPS (Rev. 1961) FHU OP 740

ROAD INVENTORY SHEET

Party Chief E.S.
Recorder W.D
Chainman

MAP 6+9

TEMPLE HILLS

68-116

818-358/359 8-10-773 VER

Road No. Co Z103
Name CANTERBERRY WAY
Sheet No. 1 OF 2
Date 12-16-68
County PRINCE GEO

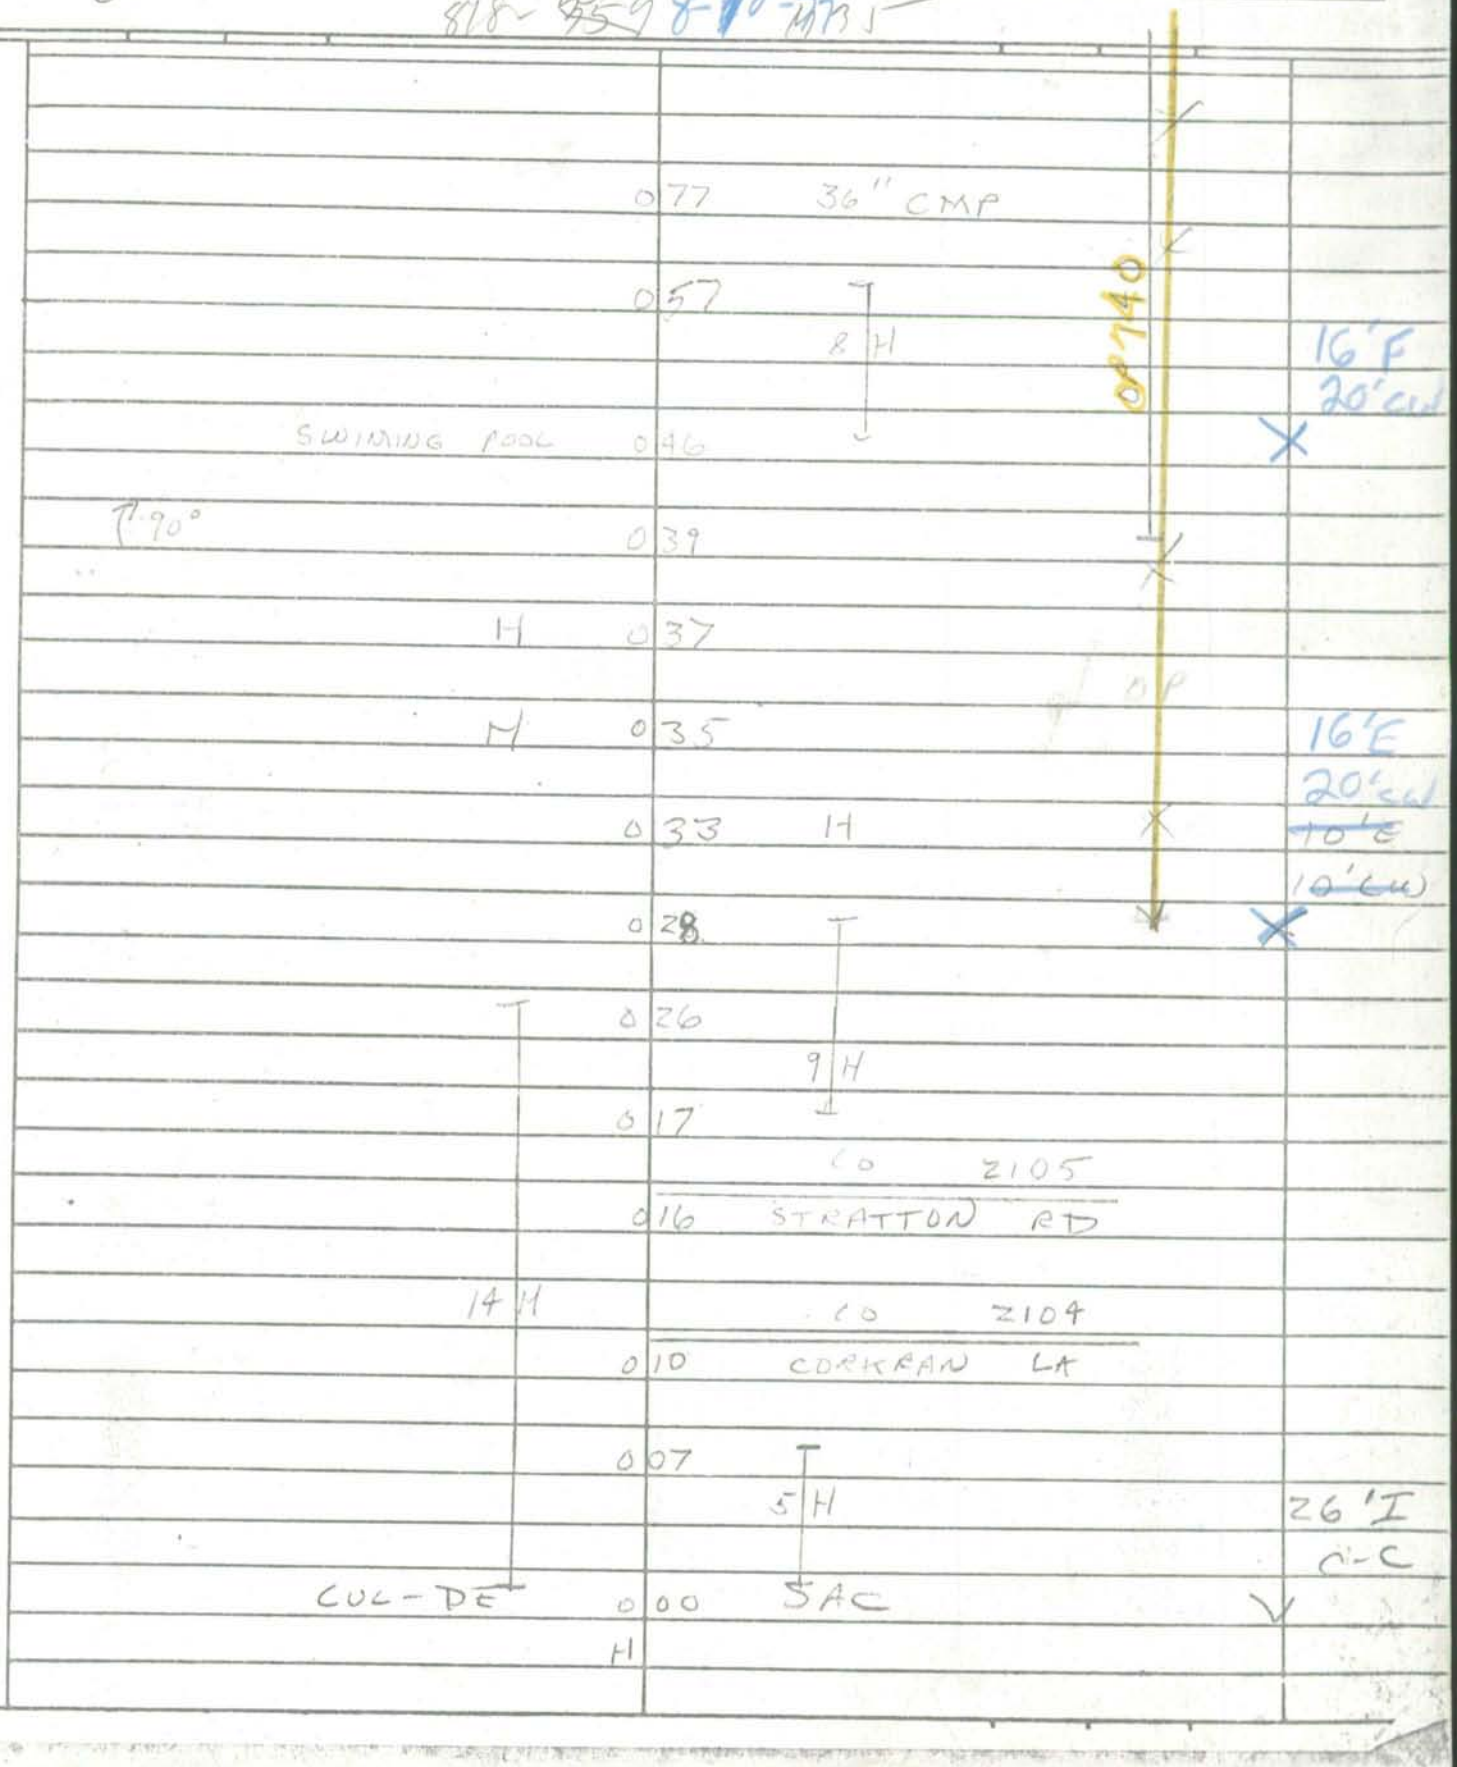

Form 6 HPS (Rev. 1961)

ROAD INVENTORY SHEET

OP 740

Party Chief E.S.
Recorder W.D.
Chainman

TEMPLE HILLS

Road No. CO 2103
Name CANTERBERRY WAY
Sheet No. 2 OF 2
Date 12-16-68
County PRINCE GEO

Reassigned 2-17-71 GJG

Form 6 HPS (Rev. 1961)

(Previous OP 741 Now Co 2124 69-196)

ROAD INVENTORY SHEET

Urban

Party Chief E. Schuyler

Recorder H. Gorman

Chainman

GREENBELT

UNIVERSITY

SQUARE

Road No. OP 741

Name Service Rd. "C" CT. #2

Sheet No. 1 OF 1

Date 5/16/67

County PRINCE GEORGES

UNDER ALL CONSTRUCTION

60' I

C-C

OP 000 1199

Form 6 HPS (Rev. 1961)

OP 742

ROAD INVENTORY SHEET

Party Chief E.S.
Recorder W.D.
Chainman

Road No. CO 2137
Name RIVER BEND RD
Sheet No. 2 OF 2
Date 9-3-68
County PRINCE GEO

MAP 9

70-237 UNASSIGNED

	0	73	
	0	58	H
H	0	56	
	0	53	H
H	0	49	
	0	46	

Form 6 HPS (Rev. 1961) FAU OP 743

ROAD INVENTORY SHEET

Party Chief E.S.
Recorder W.D
Chainman

BROADVIEW

52 - 198
64 - 74

Road No. Co 2150
Name TOLSON RD
Sheet No. 1 OF 1
Date 11-15-66
County PRINCE GEO

822-359 M35

UNASSIGNED
71-47
NOW Co 2150

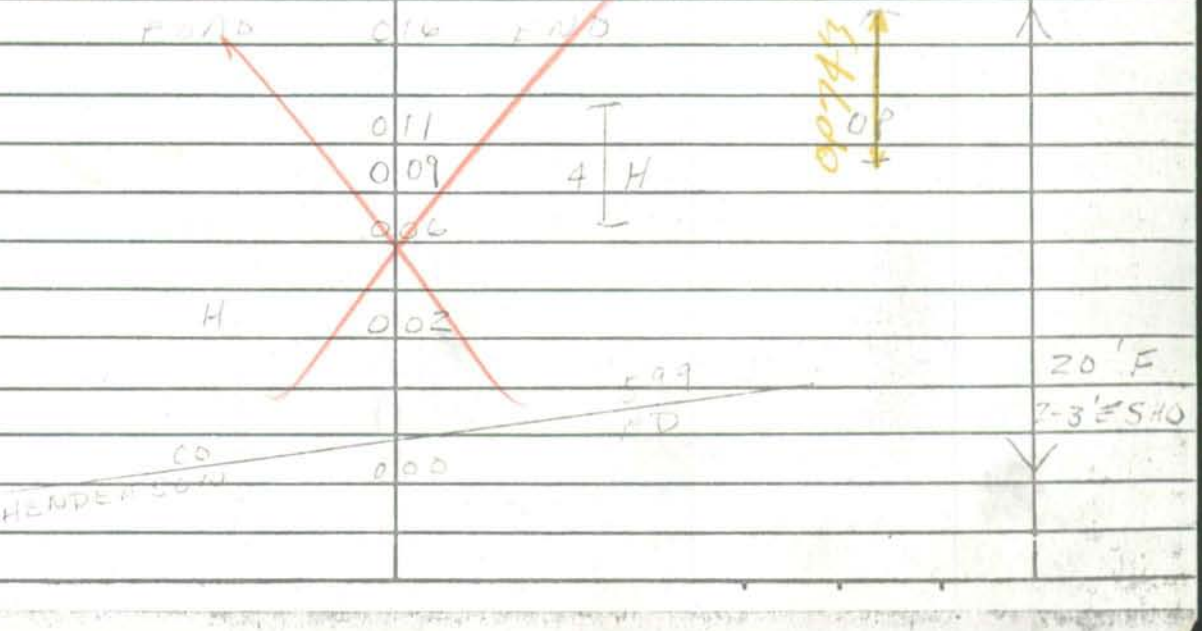

Form 6 HPS (Rev. 1961) FAO

OP 744

ROAD INVENTORY SHEET

VMASS

Party Chief E.S.
Recorder W.D.
Chainman

62-197
65-172

BROADVIEW

Road No. TO 2152
Name HOLTLANDS RD
Sheet No. 1 OF
Date 11-19-68
County PRINCE GEO

819-355.5 M35

SHA 51.3-8
11-15-72

STATE HIGHWAY ADMINISTRATION OF MARYLAND

ROAD INVENTORY SHEET

Party Chief _____
Recorder _____
Helper _____

Map No. _____ 1-11

Road No. O.P. 745
Road Name _____
Sheet No. _____
Date _____
County _____
State Coordinates _____

SEE

CO. 2182

SHA 51.3-8
11-15-72

ROAD INVENTORY SHEET

Road No. _____
Road Name _____
Sheet No. _____
Date _____
County _____
State Coordinates _____

Form 6 HPS (Rev. 1961)

OP 746

ROAD INVENTORY SHEET

Party Chief E.S.
Recorder W.D.
Chainman

Road No. CO 2112
Name WHEATON DR
Sheet No. 1 OF 2
Date 8-22-66
County PRINCE GEO

MAP 12
VER 7-13-77
M39
704-318 ~~320~~

PISCATAWAY

CREEK

MARINEA - RESTAURANT

ROAD 100 END

087 - 34° ↓

↑ 75° 083

090

↑ 90° 052

2 46

18'6
2-3 ESL

Form 6 HPS (Rev. 1961)

Map 1

ROAD INVENTORY SHEET

Now ALL Co 2382 78-3

Party Chief T. Landon
Recorder W. Warfield
Chainman

64-13
65-30

FAU

VER 5-2-78

Road No. ~~OP 747~~
Name Calverton Blvd.
Sheet No. 1 of 1
Date 3-31-71
County Prince George's

717-44 M-27

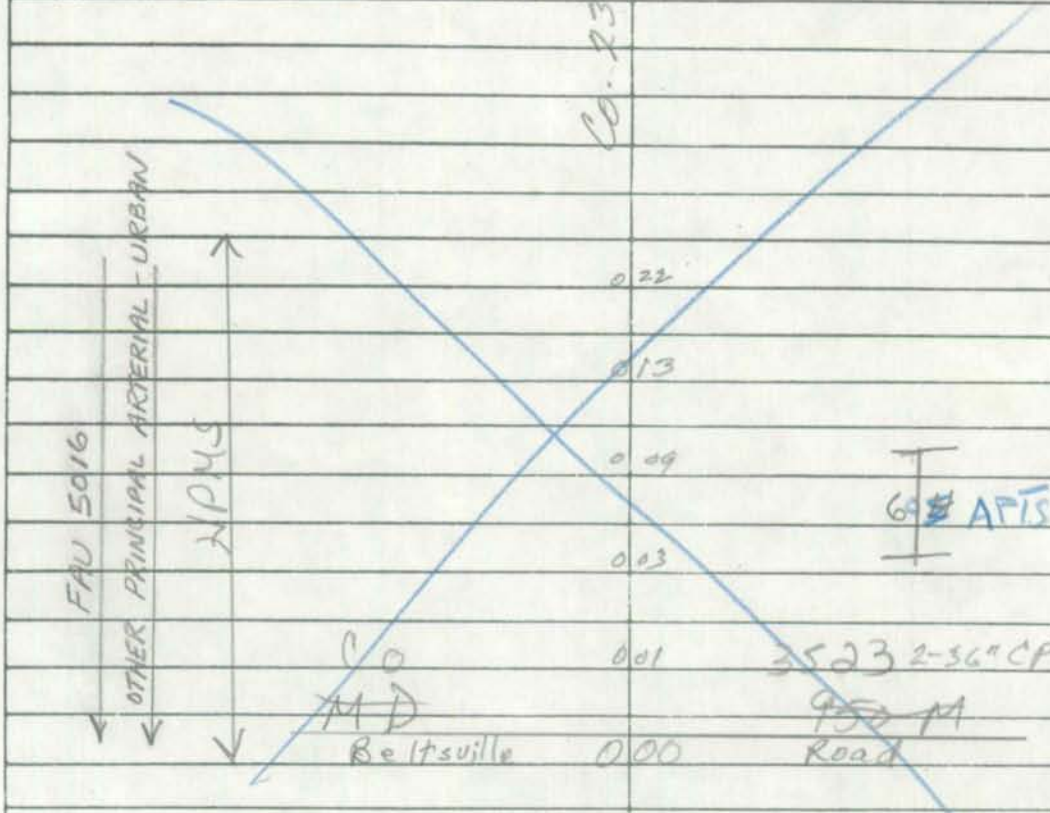

Form 6 HPS (Rev. 1961)

F/U MAP 1 OP 748

ROAD INVENTORY SHEET

Party Chief E Schuyler
Recorder
Chainman

64-17
64-22

817 - 440
~~816 - 442~~ M27

Road No. Co. 2386
Name EVANS TRAIL
Sheet No. 1 OF 2
Date x/11/66
County PRINCE GEORGES

	0.69	
27 APT. UNITS		
	0.62	
CONTINENTAL DR.		
OP 377	0.58	
	0.55	36' I
18 APT. UNITS		C-C
		21' I
		CURB HT.
		40' C-W
22 UNITS NOT TO PARKING LOT		
	0.42 W. PC	3' X 1' X 10'
	0.30 H	OP
	0.26	
	0.25 H	
	0.05 CPC	2' X 3' X 14'
	0.04 H	OP
		10' E
		12' C-W
SELMAN	RD.	
CO.	0.00 15	

Form 6 HPS (Rev. 1961)

1 AG

1 OP 749

ROAD INVENTORY SHEET

MAP 4

PARTY CHIEF Edward Schuyler
RECORDER Henry Gorman
CHAINMAN

64-94 73-35

830-399 M31

ROAD NO. Co. 2428
NAME PENNSY DR.
SHEET NO. 1 OF 2
DATE 10/2/67
COUNTY PRINCE GEORGES

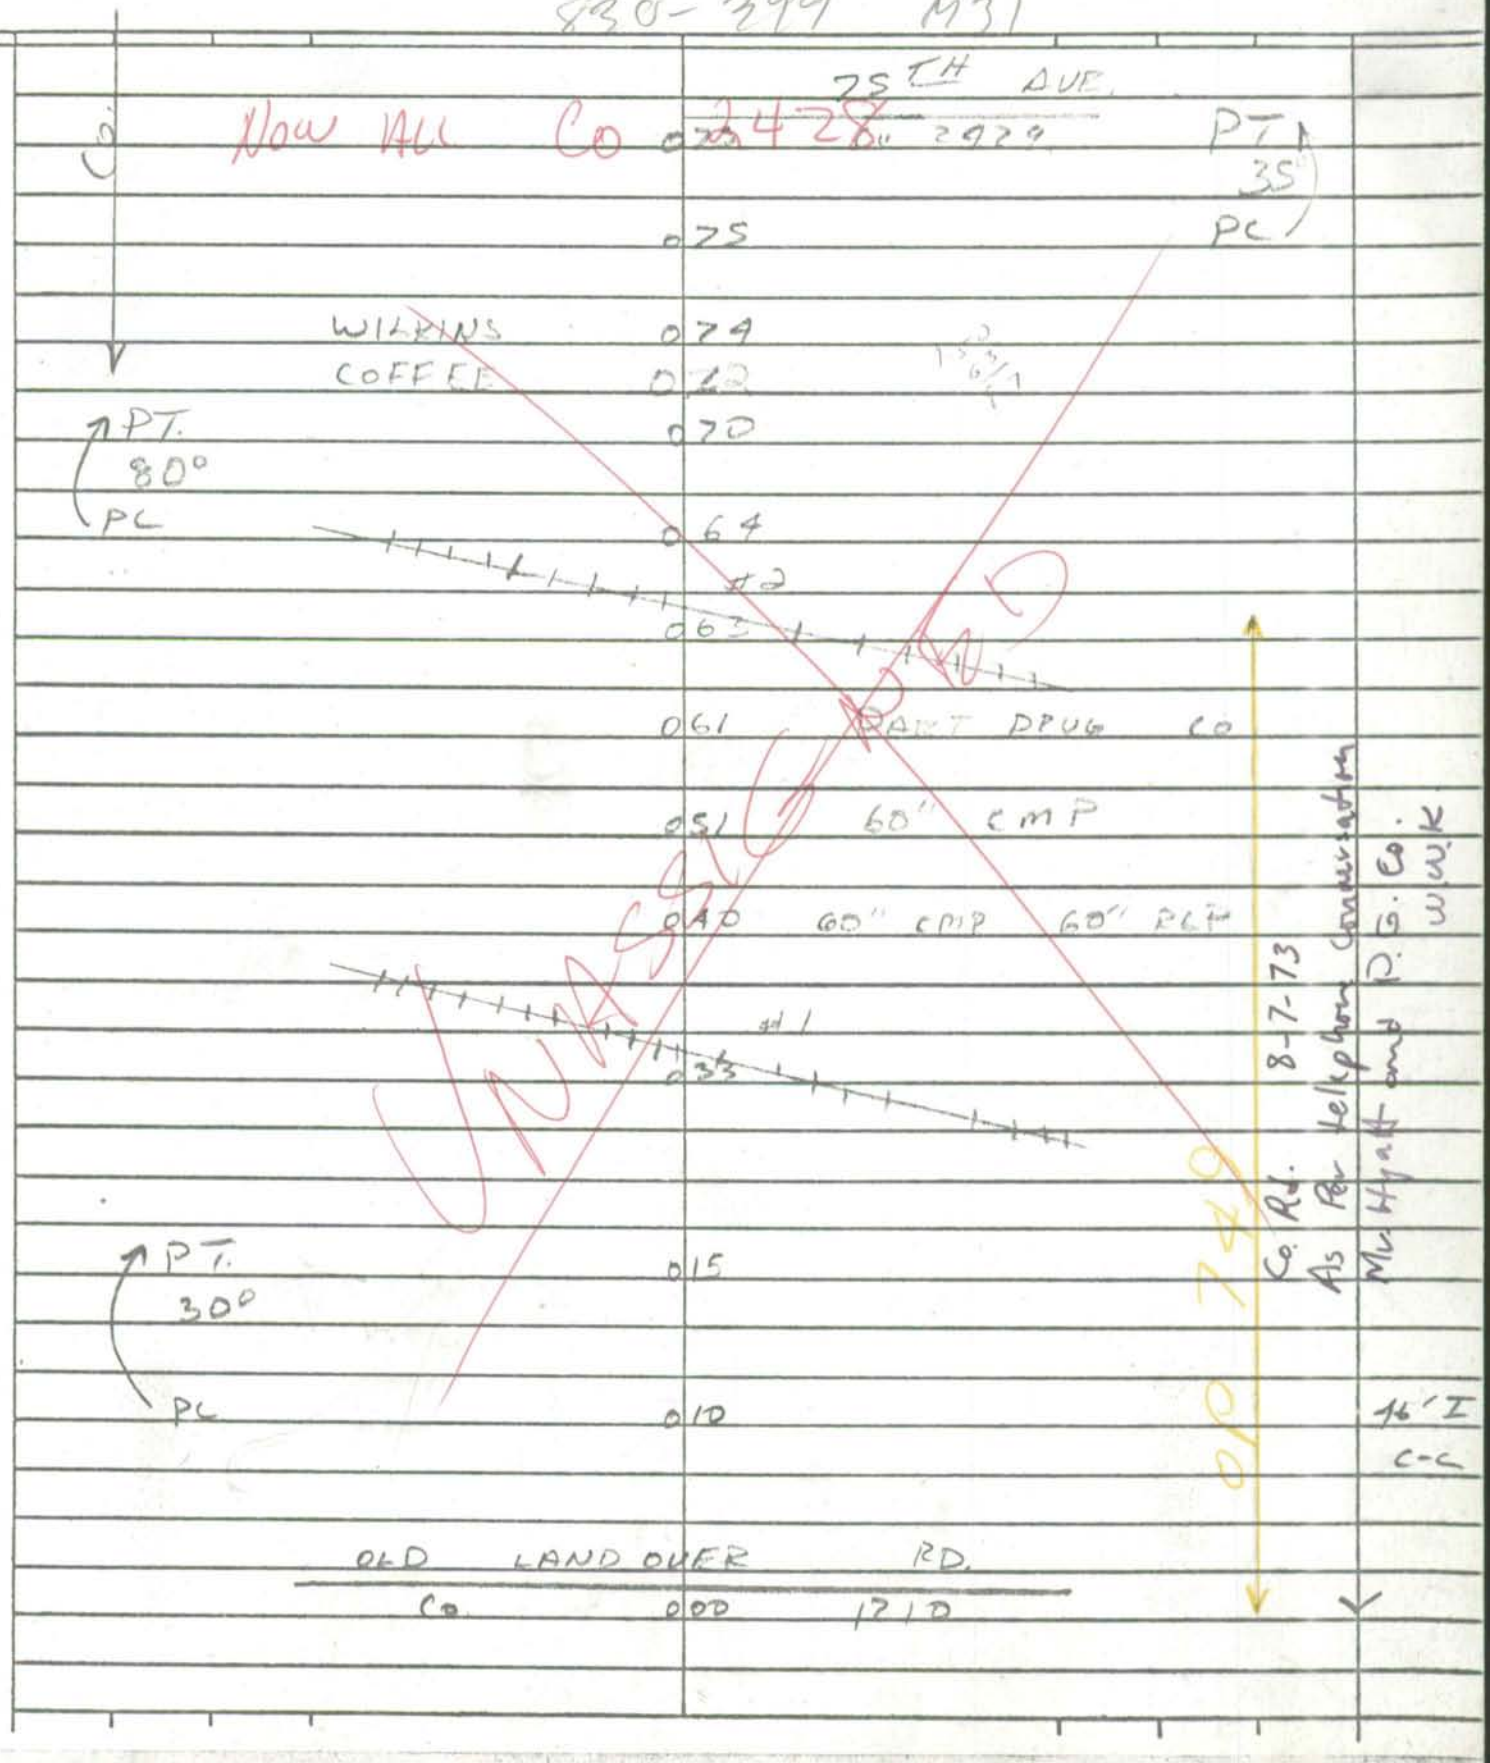

Form 6 HPS (Rev. 1961)

FAH

OP750

ROAD INVENTORY SHEET

PARTY CHIEF Edward Schuyler
RECORDER Henry Gorman
CHAINMAN

ROAD NO. Co 2430
NAME SULLIVAN DR.
SHEET NO. 1 OF 1
DATE 9 / 26 / 67
COUNTY PRINCE GEORGE

9-76
VER
4-17-78

427
~~826~~-400

M 31

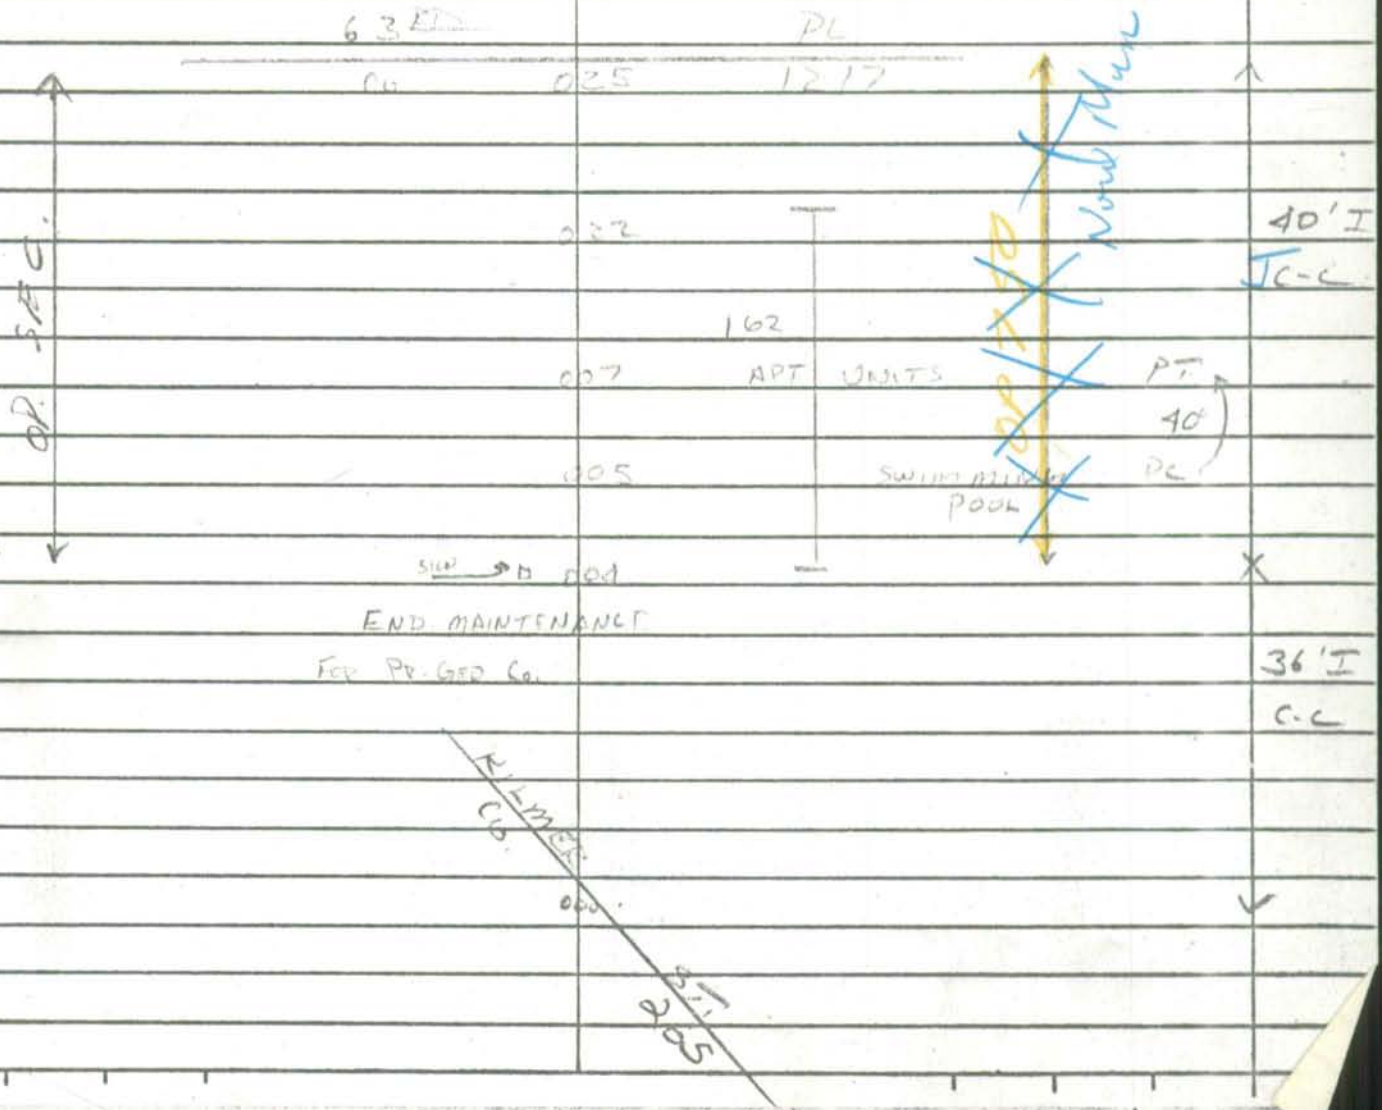

Form 6 HPS (Rev. 1961)

1-A4

OP751

ROAD INVENTORY SHEET

PARTY CHIEF Edward Schuyler
RECORDER Henry Gorman
CHAINMAN

3 Columbia Park

64-97
66-94

ROAD NO. Co. 2431
NAME Columbia Pl.
SHEET NO. 1 OF 1
DATE 10 / 4 / 67
COUNTY Prince Georges'

431 395
~~820-396~~ 431

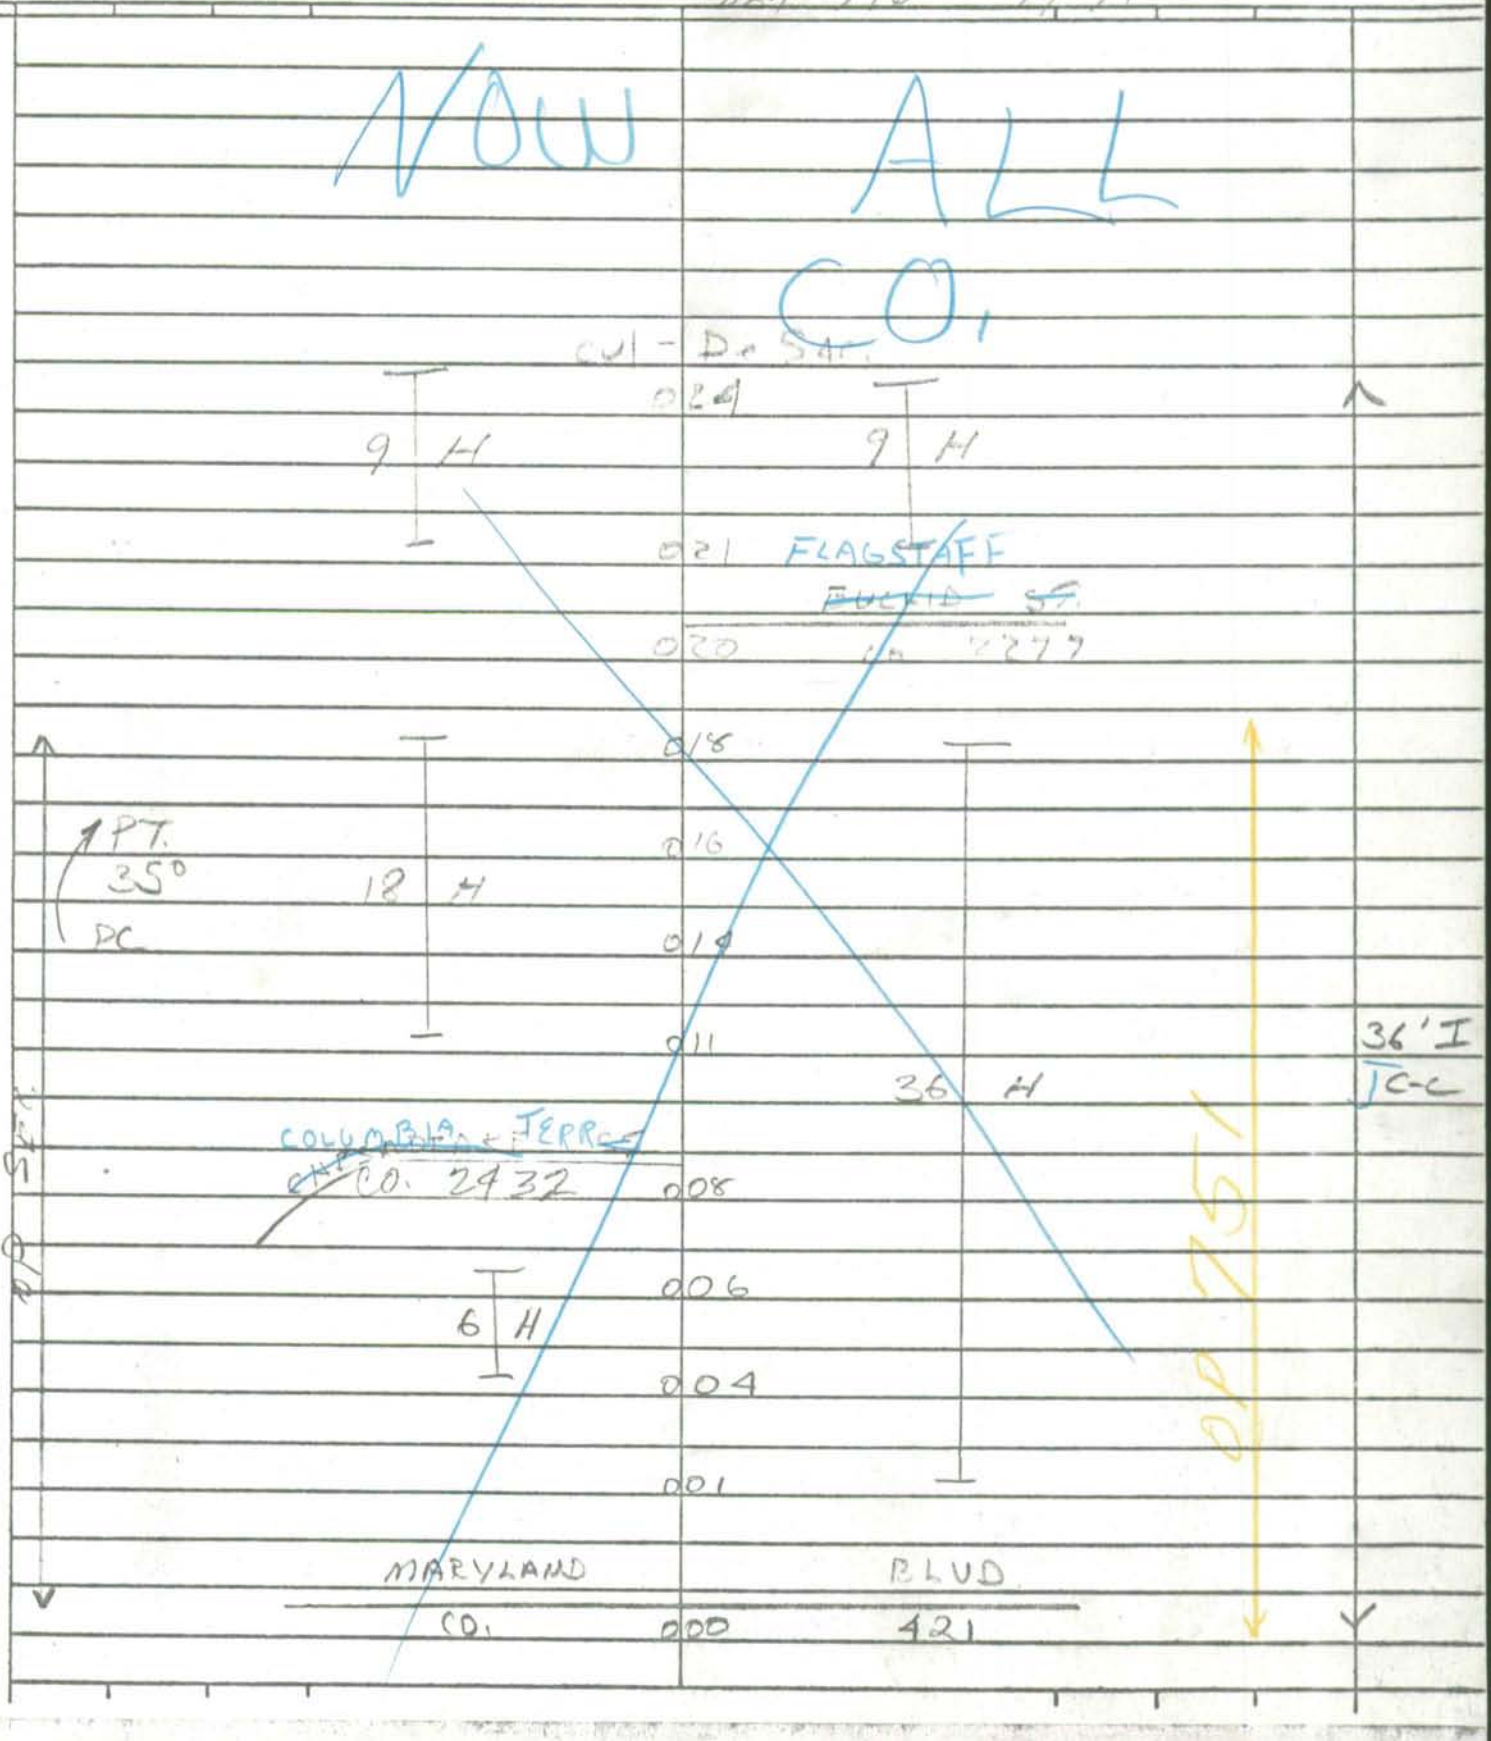

Form 6 HPS (Rev. 1961)

Reassigned 2-17-71 GJG
(Previous OP 752 Now Co. 2434 69-143)

SR. 93
GO, GW
8/11/93

Urban

ROAD INVENTORY SHEET

Party Chief E. Schuyler
Recorder H. GOREMAN
Chainman

GREEN BELT.

F11B

Road No. OP 752
Name ~~Court~~ ~~&~~ ~~Southern~~ & CT SOUTHERN RD
Sheet No. 1 OF 1
Date 5 / 18 / 67
County PRINCE GEORGES

4M-424

STILL ASSIGNED

W

ROAD END

003

16' F
2-18' F
PARKING AREAS
52'C-W

Md 193-A
SOUTH
000 @.23

~~19TH~~ WAY
MU 0470
000 @.24

Form 6 HPS (Rev. 1961)

MAP 7

OP753

ROAD INVENTORY SHEET

PARTY CHIEF Edward Schuyler
RECORDER Henry Gorman
CHAINMAN

ROAD NO. CO.2437
NAME WILFORD DR.
SHEET NO. 2 OF 2
DATE 10/13/67
COUNTY PRINCE GEORGES

830-380 M35

71-49 Extra
Also see 67-100

UNASSIGNED
CO 2437
ALL

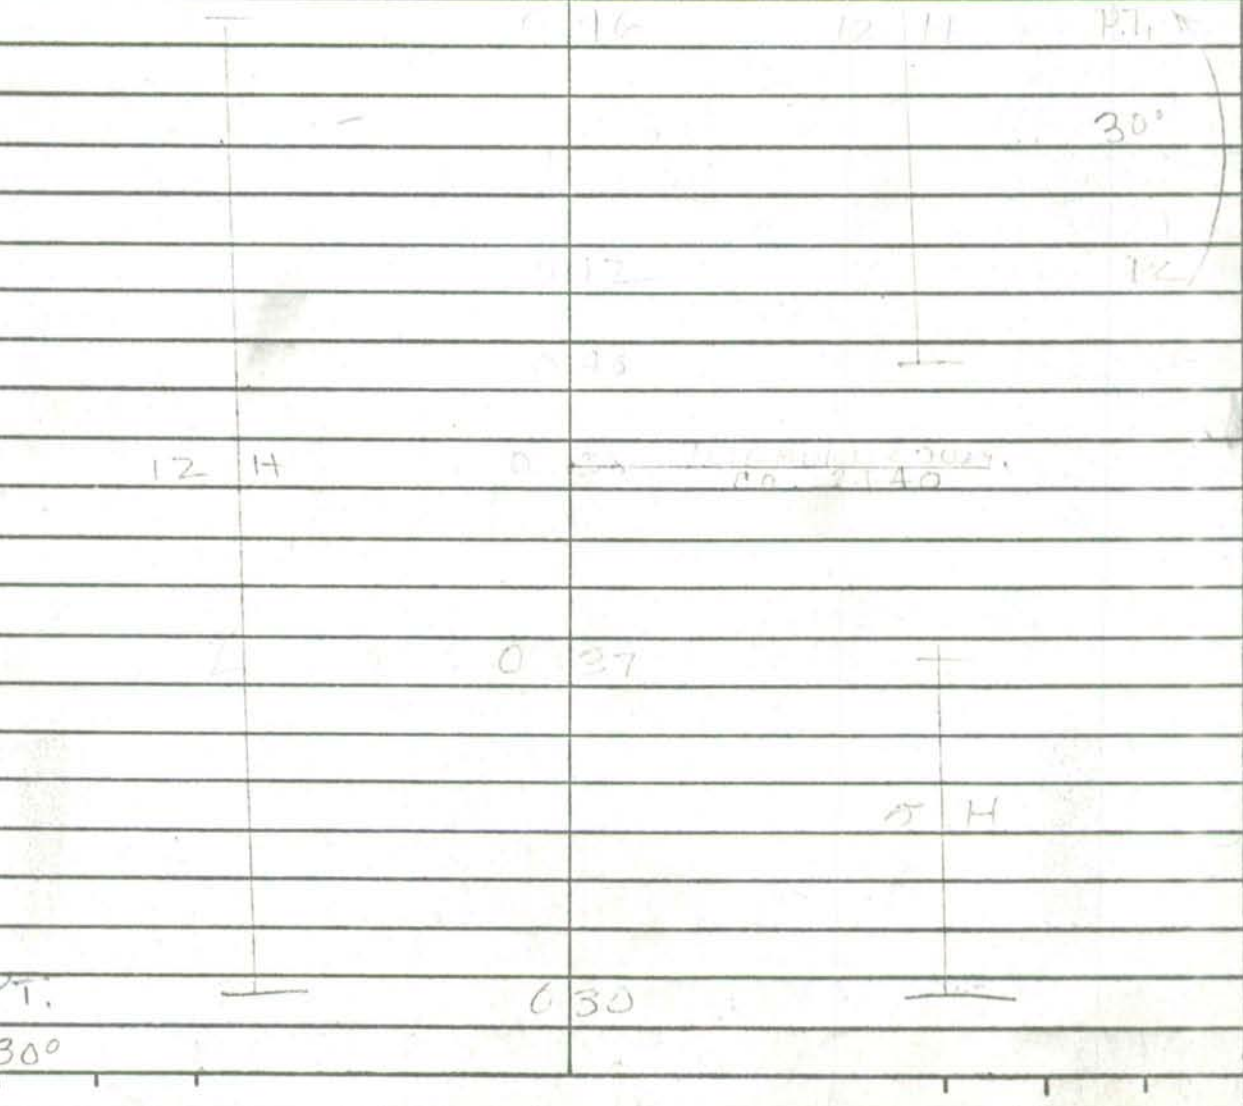

Form 6 HPS (Rev. 1961)

FAI

OP754

UNASS

ROAD INVENTORY SHEET

MAP 7

WILBURN ESTATES

PARTY CHIEF Edward Schuyler
RECORDER Henry Gorman
CHAINMAN

66-135
67-238

ROAD NO. Co. 2437
NAME QUARRY RD.
SHEET NO. 1 OF 2
DATE 10/31/67
COUNTY PRINCE GEORGES

837 387
837-980 MBS

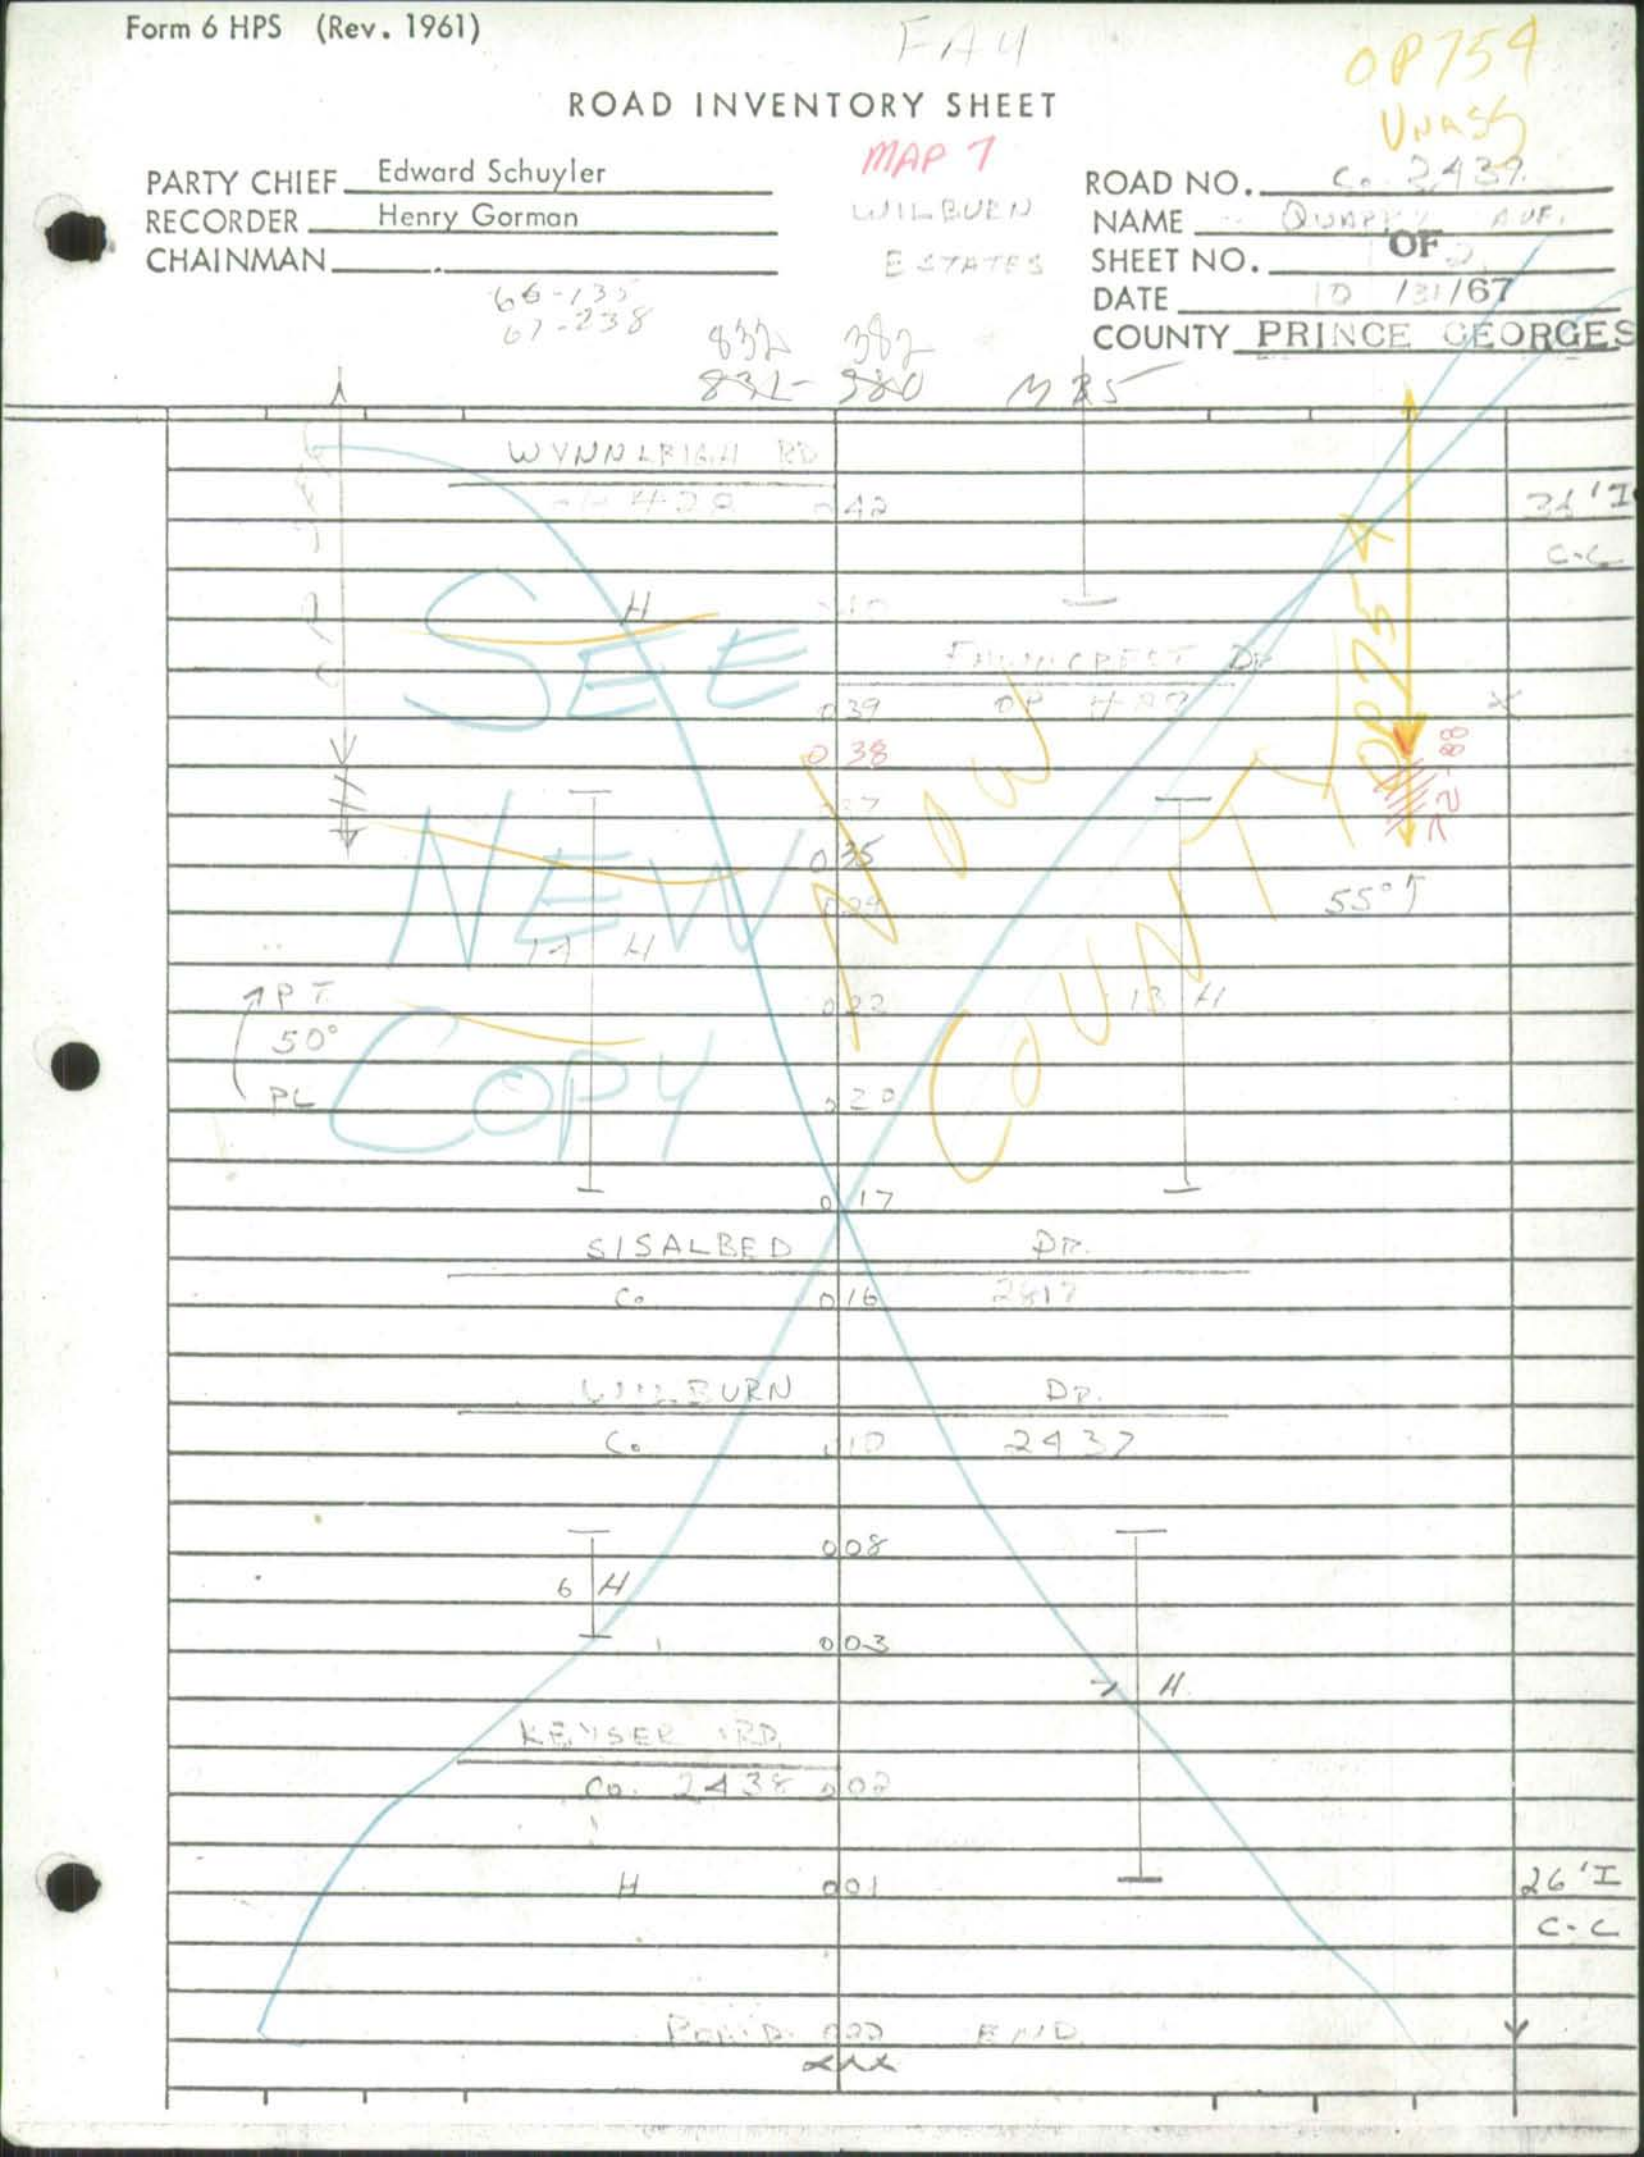

Form 6 HPS (Rev. 1961)

OP754

ROAD INVENTORY SHEET

PARTY CHIEF Edward Schuyler
RECORDER Henry Gorman
CHAINMAN

DATE 10/31/67
COUNTY PRINCE GEORGES

See New Copy

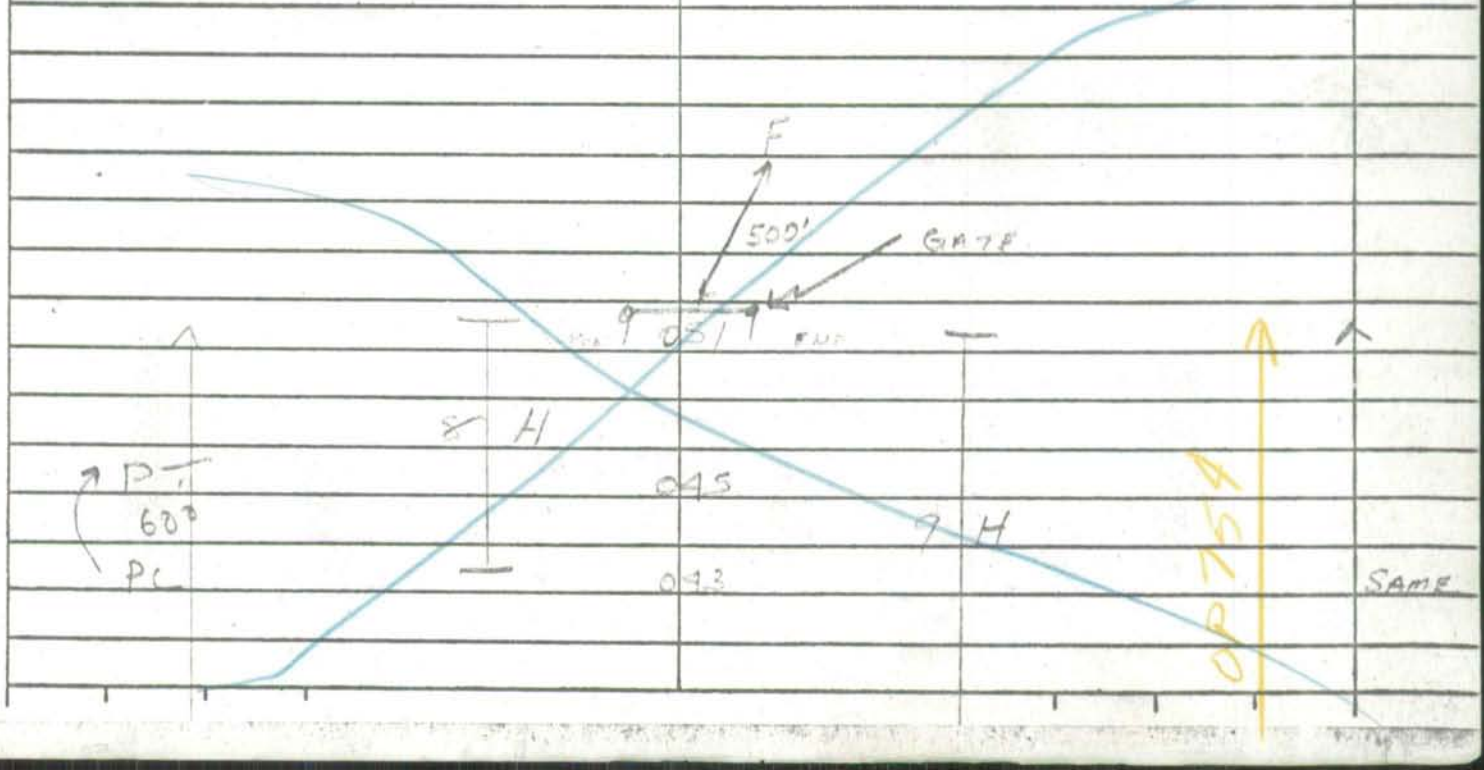

Form 6 HPS (Rev. 1961)

MAP 7 Ver WD DT 9-6-77

OP 755 Unassigned No.

ROAD INVENTORY SHEET

PARTY CHIEF Edward Schuyler
RECORDER Henry Gorman
CHAINMAN J. HENDRICK

ROAD NO. CO 2451
NAME SHADYGLEN DR
SHEET NO. 3 OF 3
DATE 10/20/77
COUNTY PRINCE GEORGES

335 - 384
334 - 376
M35

NOW ALL CO 2451

MD		214
	1	63
	1	60
	1	58
WALKER MILL RD		
CO	1	57 364
DRUMLEA RD	1	54
(72-84) Co. 3466	1	53
	1	51
CALDER DR	1	49
(72-85) Co 3467	1	48
	1	44
ABAN. H 300'	1	39
H	1	36
		78
MILL WOOF DR		
Co 2813	1	32

FAU 5215 COLLECTOR - URBAN

72-86 NOW B 2451

OF SEC.

SAME

Form 6 HPS (Rev. 1961)

Reassigned 2-17-71 GJG

(Previous OP756 Now Co. 2460 69-180)

ROAD INVENTORY SHEET

Urban

Party Chief E. Schuyler

Recorder K. GORMAN

Chainman

GREENBELT

F11B

Road No. OP 756

Name COURT 9-South way

Sheet No. 1 OF 1

Date 5/18/67

County PRINCE GEORGES'

875-424 M-31

E

ROAD END

003

18' PARKING AREA

18' PARKING AREA

001

18' F

C-C

SOUTH WAY.

Mu 000 0470

@.22

Reassigned 2-17-71 GJG

Form 6 HPS (Rev. 1961) (Previous OF 757 Now Co. 3171 70-17)

ROAD INVENTORY SHEET

Urban ~~0680~~ OF 757

Party Chief E. Schuyler

Recorder H. GORMAN

Chainman

GREENBELT

F11B

Road No.

Name COURT 39-Ridge Rd.

Sheet No. 1 OF 1

Date 5/23/67

County PRINCE GEORGES'

8½ - 426 M-31

Not Pulled

W

ROAD END

002

24' F

WALL TO WALL

RIDGE RD.

Mu 000 0440

@1.64

Reassigned 2-17-71 GG
(Previous OP 758 Nov Co 3172 69-183)

Form 6 HPS (Rev. 1961)

ROAD INVENTORY SHEET

Urban ✓ OP 758 ~~0670~~

Party Chief E. Schuyler
Recorder H. GORMAN
Chainman

GREENBELT
F11B

Road No.
Name COURT 28-Ridge Rd.
Sheet No. 1 OF 1
Date 5 / 23 / 67
County PRINCE GEORGES'
836-425 M-31

E

ROAD END.

002 ^ 58'F 58'C-W

001 X 21'F C-C

RIDGE RD.

Mu 000 0440 ✓

@1.72

@.04

Reassigned 2-17-71 GG

Form 6 HPS (Rev. 1961) Previous OP 759 Now Co. 3170

ROAD INVENTORY SHEET

Urban ~~0660~~ OP 759

Party Chief E. Schuyler
Recorder H. GORMAN
Chainman

GREEN BELT.

F11B

Road No. OP 759
Name COURT 37 - Ridge Rd.
Sheet No. 1 OF 1
Date 5/23/67
County PRINCE GEORGES'
836-425 ~~M~~ 31

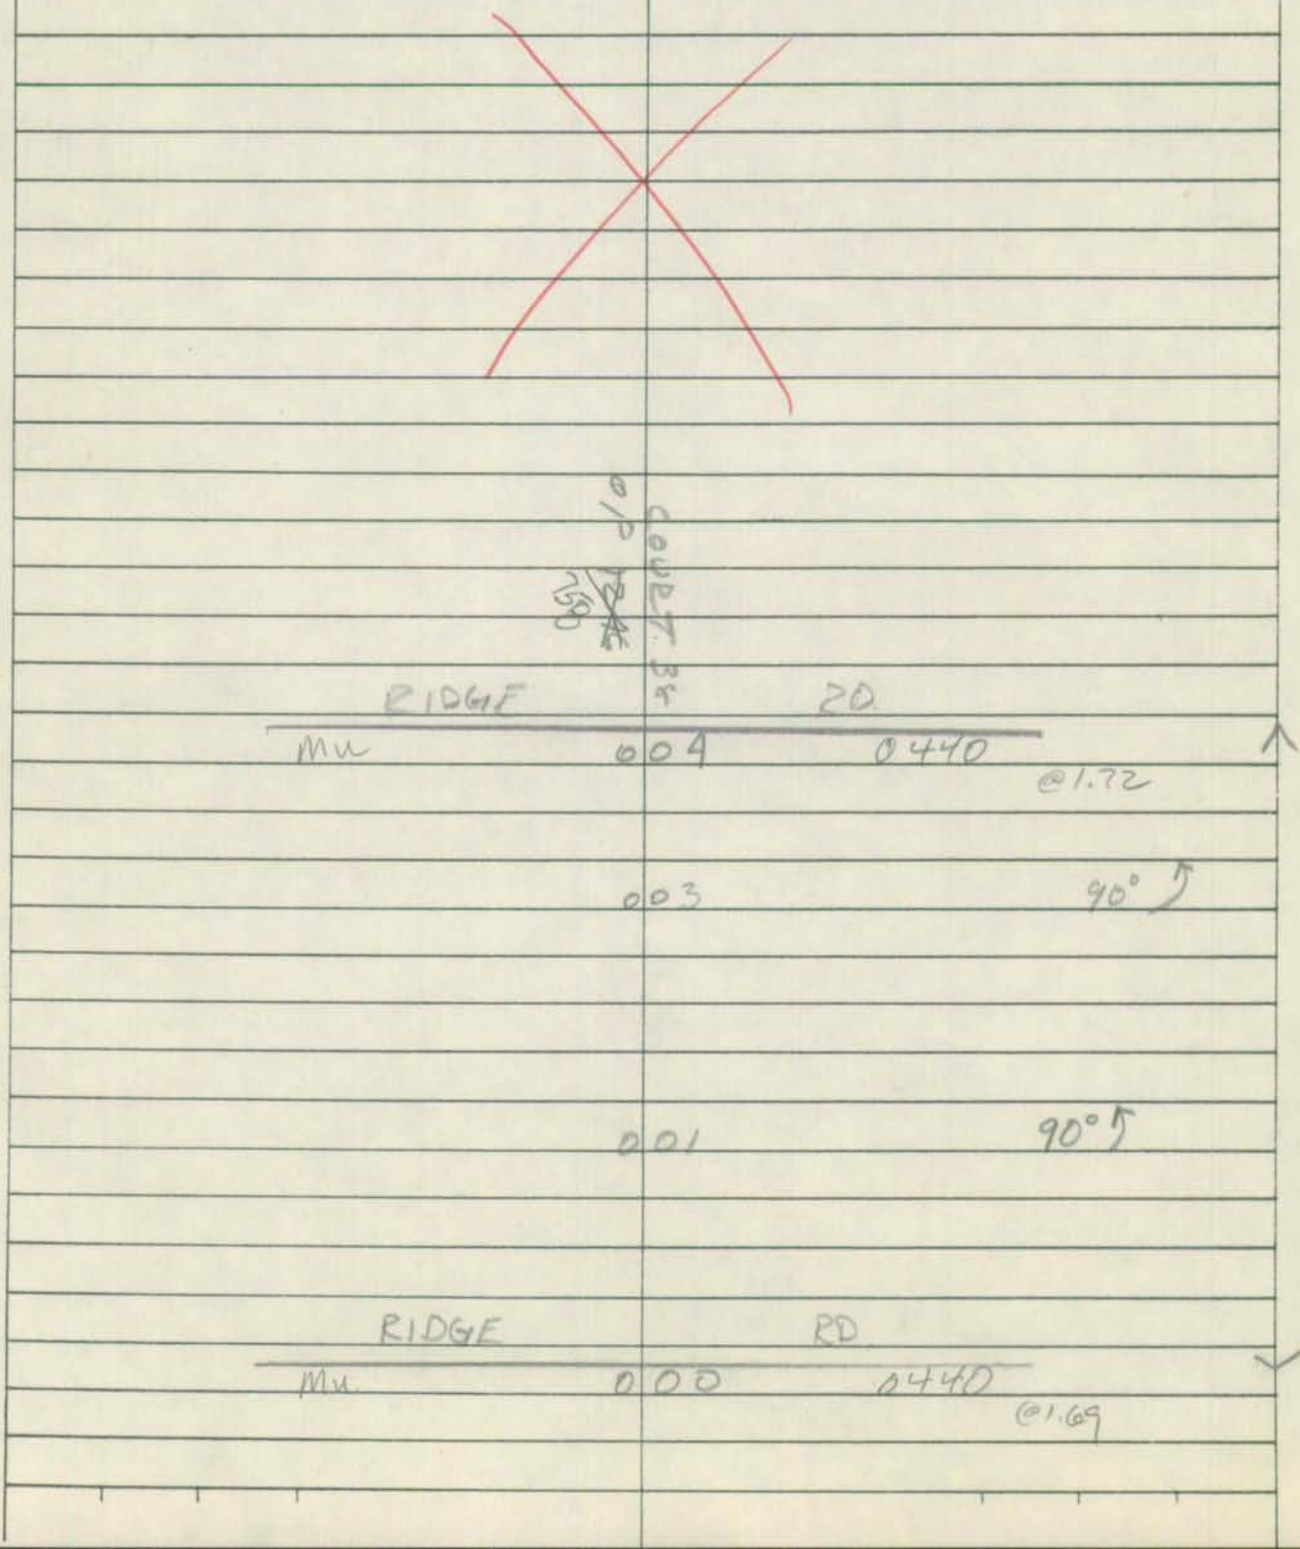

Reassigned 2-17-71 G/G

Previous OP 760 Now Co. 3169

Form 6 HPS (Rev. 1961)

ROAD INVENTORY SHEET

Urban ✓ 0650

Party Chief E. Schuyler GREENBELT

Recorder H. GORMAN

Chainman

F11B

Road No. OP 760

Name COURT 33-Ridge Rd.

Sheet No. 1 OF 1

Date 5 / 23 / 67

County PRINCE GEORGES'

836-426 M-31

W

RIDGE RD.

M.H. 005 0440 @1.80 ↑

004 90° ↱

002 90° ↱

18' I
20' C-W

RIDGE RD.

M.H. 000 0440 @1.77 ↓

SHA 51.3 - 8 Revised
4.83

MARYLAND STATE HIGHWAY ADMINISTRATION

ROAD INVENTORY SHEET

Party Chief _____
Recorder _____
Assistant _____
Map No./Dir. 1
State Coordinates _____

Road No. OP762
Road Name MILL BRANCH PL
County PG
Date _____
Sheet No. _____ OF _____

SYSTEM				TRAFFIC		LINE DIAGRAM	TRAFFIC			PAVEMENT DATA
FED. AID.	FUNCT. CLASS.	HWY. SYS.	HPMS SAMPLE	PRKG. REST.	COM/IND. ACCESS		CONTROL	COM/IND. ACCESS	PRKG. REST.	
						SEE INV OF CO 5166 90-100				

TRAFFIC CODES

TRAFFIC CONTROLS: STOP SIGN=SS, TRAFFIC LIGHT=T.L., FLASHING RED BALL=F.R.

TRAFFIC CODES

PARKING RESTRICTIONS: A.M. PEAK, P.M. PEAK, A.M./P.M. PEAK, NO PARKING ANYTIME=N.P., COMM/IND. ACCESS=E

SYSTEM				TRAFFIC		LINE DIAGRAM	TRAFFIC			PAVEMENT DATA
FED. AID.	FUNCT. CLASS.	HWY. SYS.	HPMS SAMPLE	PRK.G. REST.	COM/IND ACCESS		CONTROL	COM/IND ACCESS	PRK.G. REST.	

Form 6 HPS (Rev. 1961)

ROAD INVENTORY SHEET

Party Chief
Recorder
Chainman

Road No.
Name
Sheet No.
Date
County

Form 6 HPS (Rev. 1961) FAU

1-406-A

OP 764

ROAD INVENTORY SHEET

Party Chief E. Schuyler
Recorder N. Lowndes
Chainman

63-1-960-4
62-13

9
-45

REVISED
3-11-70
T. LAYDON
W. WARFIELD

Road No. ~~C-2177~~
Name JOSEPHINE AV.
Sheet No. 1 OF 1
Date 7/28/66
County PRINCE GEORGE'S

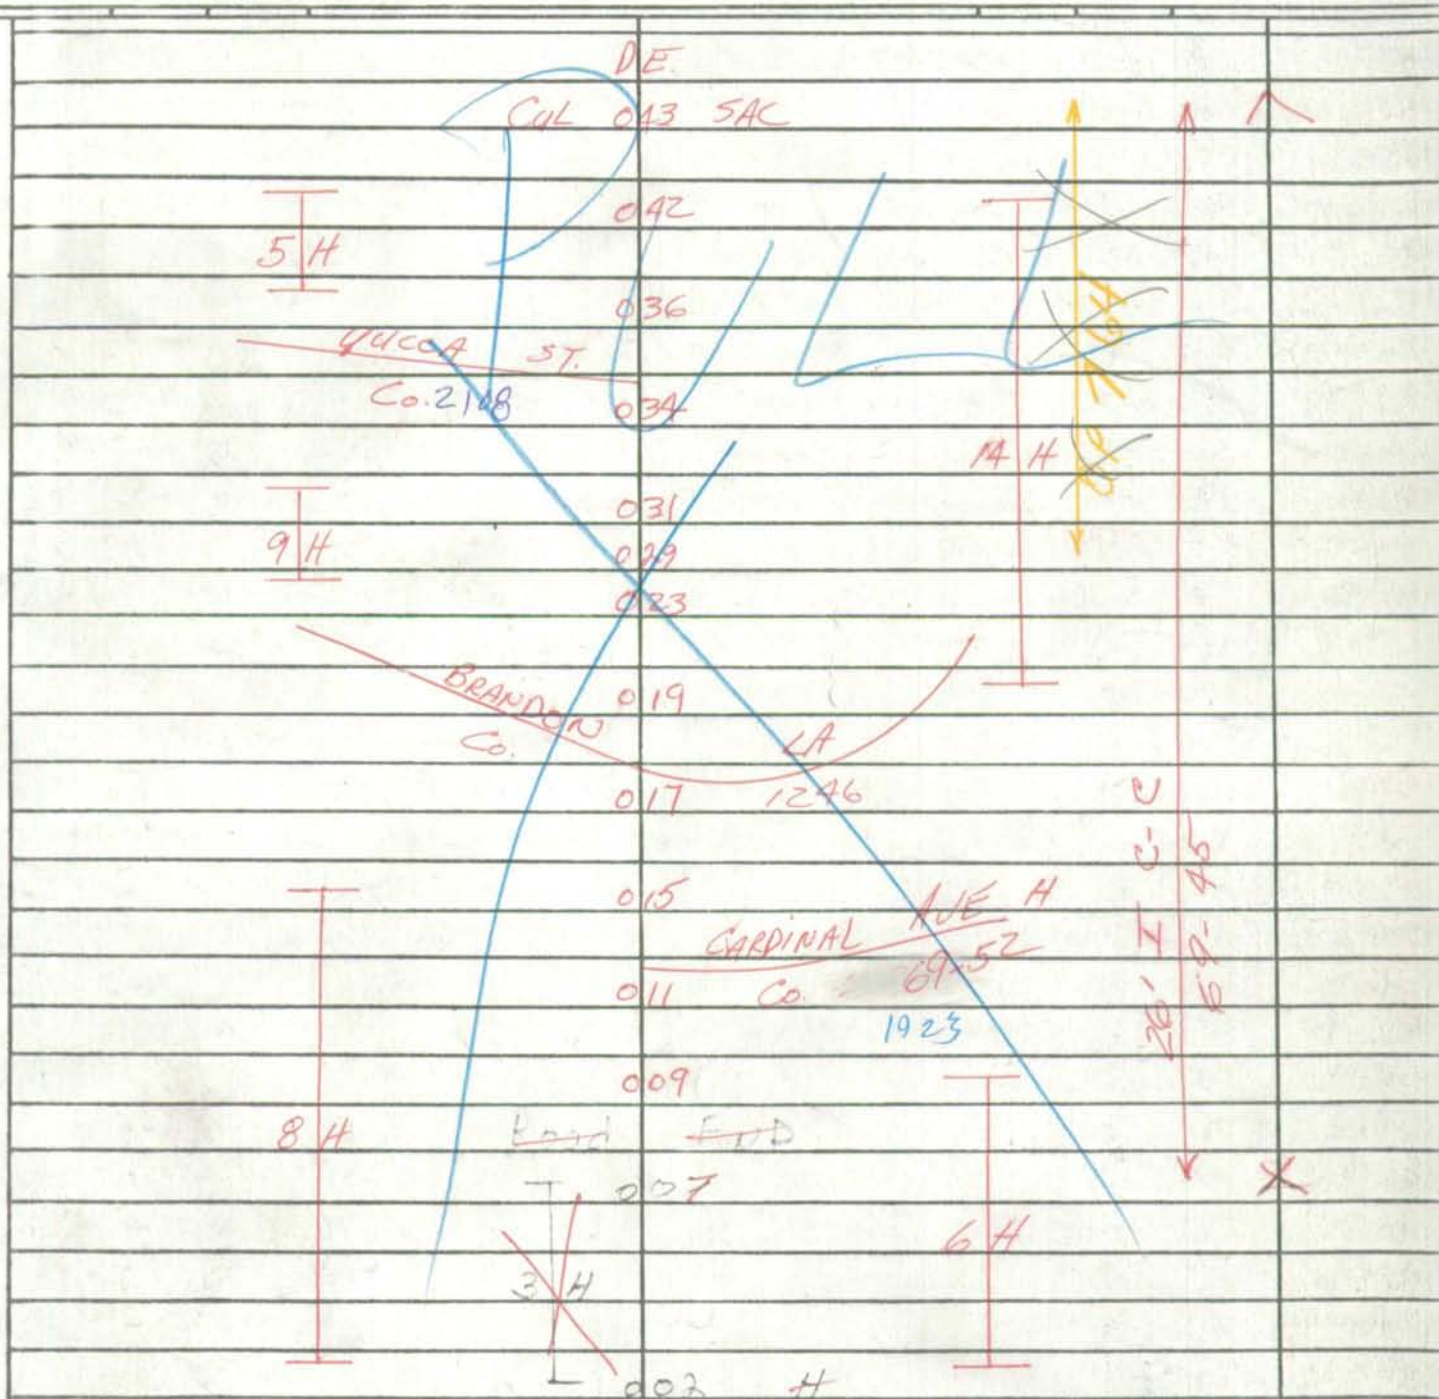

 

Form 6 HPS (Rev. 1961)

Reassigned 2-17-71 G/C
(Previous OP765 Now Co. 3092 70-36)

S.R. 93 GD/GW 8/11/93

Urban

ROAD INVENTORY SHEET

Party Chief F. Schuyler
Recorder H. GORMAN
Chainman

GREEN BELT

F11B
834 - 424
835 - 428

M31

Road No. OP 765
Name ~~COURT~~ 11 COURT SOUTHWAY
Sheet No. 1 OF 1
Date 5/18/67
County PRINCE GEORGES

W1

E

ROAD END
OOA

16' I
24' C-W

~~DIE~~ ~~DIE~~
SOUTH OOO WAY
MD 193-A

@.19

Reassigned 2-17-71 GJG

Form 6 HPS (Rev. 1961)

ROAD INVENTORY SHEET

Urban 0880
OP766

PARTY CHIEF Edward Schuyler
RECORDER Henry Gorman
CHAINMAN

GREEN BELT

ROAD NO.
NAME SPRING HILL CT.
SHEET NO. 1 OF 1
DATE 1/5/67
COUNTY PRINCE GEORGES

VER 12-20-77 FIIB

828-426 ~~91~~

EDMONSTON RD.
MUN 029 0090 @.41

PT. 35° PRC 028

025

PRC 55° PRC

PRC 35° PRC 018

012

PRC 95°

S

EDMONSTON TERR.
008 OP.389 @.00

004 PC 25'I
J-C

SPRING HILL DR.
MUN 000 0480 @.37

Form 6 HPS Rev. 1961

ROAD INVENTORY SHEET

Party Chief
Recorder
Chainman

Road No. OP 767
Name BRIER HILL Rd
Sheet No.
Date
County P-G.

71-110

UNASSIGNED

NOW Co 767

Form 6 HPS Rev. 1961

ROAD INVENTORY SHEET

Party Chief
Recorder
Chainman

Road No. OP 768
Name ARONA Rd
Sheet No.
Date
County P.G.

71-112

UNASSIGNED

NOW CO 3414

Form 6 HPS Rev. 1961

ROAD INVENTORY SHEET

Party Chief
Recorder
Chairman

Road No. OP769
Name Holloway Dr.
Sheet No.
Date
County R.G. Co.

71-121

UNASSIGNED

Now Co 3347

Form 6 HPS (Rev. 1961)

ROAD INVENTORY SHEET

C.3208

Party Chief
Recorder
Chainman

Road No.
Name
Sheet No.
Date
County

Unassigned Now

C.3208

Form 6 HPS (Rev. 1961)

Co 3214 RHODESIA ??

ROAD INVENTORY SHEET

Party Chief E.S.
Recorder W.D
Chainman

~~MARCH~~ MAP FRIENDLY FARMS

70-204

Road No. CO 3214
Name RHODESIA AVE
Sheet No. 1 OF 1
Date 4-23-68
County PRINCE GEO.

Unassigned Now

Co. 3214

ROAD TO 34 CND

4 0 32 1

CO 2678 2977

CENTER 0 30 CA

0 29

0 25 20 H PT 150° PC

16 4

0 06

0 01

36' E C-C

CO Co2678 2977

CENTER CL

Form 6 HPS (Rev. 1961)

ROAD INVENTORY SHEET

OP 772

Party Chief E.S.
Recorder W.D.
Chainman T.L.

~~MAP 3~~
CAMP SPRINGS
—
JENKINS CORNER
MAP 9

Road No. ~~CO~~ 3019
Name MARK DR
Sheet No. 1 OF 1
Date 10-2-68
County PRINCE GEO

824-353 M35

Unassigned
Now 6.3496
(72-133)

ROAD ADD END

3 H

004 4 H

CH. 001

26' I
C-C

CO 12 Z

BRINKLEY 300 RD

Form 6 HPS (Rev. 1961)

FAU

ROAD INVENTORY SHEET

Party Chief E.S.
Recorder W.D.
Chainman

MAPP

N. FORESTVILLE

Road No. ~~CO~~ OP 774 ~~3029~~
Name
Sheet No. 1 OF 1
Date 10-22-68
County PRINCE GEO

839-373.5 M35

Unassigned
Now Co. 3481

ROAD	D	002	END	1
H	D	001	H	
				26' I
				C-C
CO RTE.	D	000	3026 DR	V

Form 6 HPS (Rev. 1961)

MAP 7

FAU

C

ROAD INVENTORY SHEET

OP 775

Party Chief	E.S.
Recorder	W.D.
Chainman	

IER 10-15-77

WESTPHALIA

G11B

844-370

Road No.	~~CO 3030~~
Name	TOWN Rd
Sheet No.	1 OF 1
Date	10-31-68
County	PRINCE GEO

MAS

W

AUTO JUNK YARD

ROAD 017 END

PVT RD 013

H 011

005 H

12'F

CO 89

D'ARCY 000 RD

2-3'E SHO

Form 6 HPS (Rev. 1961)

~~MAR7~~

ROAD INVENTORY SHEET

OP 77C

Party Chief E.S.
Recorder W.D.
Chainman

VER 10-15-71

WEST PHALIA

G11B

844-370.5

Road No. ~~60~~ ~~3031~~
Name
Sheet No. 1 OF 1
Date 10-31-68
County PRINCE GEO

~~MAR5~~

W

	H		
ROAD	007	H END	^
	006	H	
	003	H	
			12' F
DARCY	RD		2-3' E SHO
CO.	000	89	v

Reassigned 2-17-71 EJG

Form 6 HPS (Rev. 1961) (Previous OP777 Now Co. 3177 70-41)

Urban ✓

ROAD INVENTORY SHEET

Party Chief E. Schuyler
Recorder H. GIORMAN
Chainman

GREENBELT

F11B

Road No. ~~0640~~ OP 777
Name COURT 32 - Ridge Rd.
Sheet No. 1 OF 1
Date 5 / 23 / 67
County PRINCE GEORGES'
836-425 M-31

E

ROAD END

003

60' I
60' C-W

od

16' I
C-C

RIDGE RD.

Mu 000 0440

@ 1.85

Form 6 HPS (Rev. 1961)

Reassigned 2-17-71 GJG
(Previous OP 778 New Co. 3181 70-45)

ROAD INVENTORY SHEET

urban V ~~630~~

Party Chief E. Schuyler
Recorder H. GORMAN
Chairman

GREENBELT.

F11B

Road No. OP 778
Name COURT 24-Ridge Rd.
Sheet No. 1 OF 1
Date 5/23/67
County PRINCE GEORGES'

9¾ or 425 M-31

ROAD END
025

14' F
19' C-W

5

RIDGE RD.
Mu 000 0440 @1.96

COURT 03
Mu 0442

signed 2-17-71 GJG

Form 6 HPS (Rev. 1961) (Previous OP 779 Now Co. 3180 70-44)

ROAD INVENTORY SHEET

Urban ✓ ~~0620~~

Party Chief E. Schuyler
Recorder H. GORMAN
Chainman

GREENBELT
F11B

Road No. OP 779
Name COURT 20 - Ridge Rd.
Sheet No. 1 OF 1
Date 5/23/67
County PRINCE GEORGES'
425' 425 A-31

S

ROAD END.

004

60'F
60'C-W

45°

002

14'F
16'C-W

RIDGE
Mu

000

RA.
0440

@2.10

Form 6 HPS (Rev. 1961)

assigned 2-17-71 GJG
Previous OP780 Now Co. 3179
70-43

ROAD INVENTORY SHEET

Urban ✓ ~~0610~~

Party Chief E. Schuyler
Recorder N. GORMAN
Chainman

GREENBELT.
F11B

Road No. OP 780
Name COURT 19-Ridge Rd.
Sheet No. 1 OF 1
Date 5/23/67
County PRINCE GEORGES
835.425 ~~M-71~~

N

ROAD END
004

12'I
12'C-W

RIDGE RD.
M 000 0440
@2.09

Reassigned 2-17-71 GJG

Form 6 HPS (Rev. 1961) (Previous OP781 Now Co. 3178 11-42)

ROAD INVENTORY SHEET Urban ✓ ~~0600~~

Party Chief E. Schuyler GREENBELT

Recorder H. GORMAN

Chainman

F1B

Road No. OP781

Name COURT 18-Ridge Rd.

Sheet No. 1 OF 1

Date 5/21/67

County PRINCE GEORGES

835-425 ~~M~~

S

RIDGE RD

Mu 005 0440 @2.16

001 90°

ONE WAY

002 90°

30'I
36'C-W

RIDGE RD

Mu 000 0440 @2.13

Reassigned 2-17-71 GG

Form 6 HPS (Rev. 1961) (Previous OP 782 Nov 68. 3110 70-94)

ROAD INVENTORY SHEET

Urban

Party Chief E. Schuyler
Recorder H. Gorman
Chainman

GREENBELT

F11B

Road No. OP 782
Name Loop T 17 - Ridge Rd.
Sheet No. 1 OF 1
Date 5/24/67
County PRINCE GEORGES'

835-425

RIDGE RD.

Mu 005 0440 @2.17

N

004 90° ↑

16' F
24' C-W

002 90° ↑

RIDGE RD.

Mu 000 0440 @.215

Form 6 HPS (Rev. 1961)

Realigned 2-17-71 GJG
(Previous OP 783 Now Co. 3104 70-46)

ROAD INVENTORY SHEET 71-33

Urban

Party Chief E. Schuyler
Recorder H. GOERMAN
Chainman

GREENBELT

F11B

Road No. OP 783 0580
Name C.T. 16-Ridge Rd.
Sheet No. 1 OF 1
Date 5/18/67
County PRINCE GEORGES.
834-424 ~~M-3~~

	ROAD END.	
	004	^
		58' I
		C-C
	002	X
		22' I
		C-C
RIDGE	RD	
Mu 0	000 0440	Y
		@2.24

Form 6 HPS (Rev. 1961)

Reassigned 2-17-71 SJG
(Previous OP784 Now Co 3111 70-93)

ROAD INVENTORY SHEET

Urban

Party Chief E. Schuyler
Recorder H. GOEMAN
Chairman

GREENBELT

F11B

Road No. OP 784
Name CT. 14-Ridge Rd.
Sheet No. 1 OF 1
Date 5/18/67
County PRINCE GEORGES'

834-425 M-31

S

ROAD END

005

56' I

002

14' I
C-C

RIDGE RD.

TMU 000 0440

232

OP 784

COURT II

Form 6 HPS (Rev. 1961)

Reassigned 2-17-71 GJG
(Previous OP 785 Now Co. 3112 70-74)
71-34

ROAD INVENTORY SHEET

Urban

Party Chief E. Schuyler
Recorder H. GOERMAN
Chainman

GREENBELT.

F11B

Road No. OP 785
Name COURT 13 - Ridge Rd.
Sheet No. 1 OF 1
Date 5/18/67
County PRINCE GEORGES'

834-424 M-31

N

ROAD	END.	
	005	
		28' I
RIDGE	RD.	
MM	000 0440	
	@2.24	

Court 13
Ridge Rd

Form 6 HPS (Rev. 1961)

Reassigned 2-17-71 GJG
(Previous OP786 Now Co. 3113 70-73)

Urban

ROAD INVENTORY SHEET

Party Chief E. Schuyler
Recorder H. Gorman
Chainman

GREENBELT

F11B

Road No. OP 786
Name COURT 12-Ridge Rd.
Sheet No. 1 OF 1
Date 5 / 24 / 67
County PRINCE GEORGES'

834-425 M-31

S

ROAD END
0 0 3

56'F
56'C-W

0 0 1

14'F
C-C

RIDGE RD.

mu 0 0 0 0 4 4 0

@ 2.38

OP 793 County

Form 6 HPS (Rev. 1961)

Reassigned 2-17-71 GJG
(Previous OP787 Now Co. 3186 70-64)

URBAN

ROAD INVENTORY SHEET

Party Chief E. Schuyler
Recorder H. Goerman
Chairman

GREEN BELT

F11B

Road No. OP787
Name COURT 11-Ridge Rd.
Sheet No. 1 OF 1
Date 5/18/67
County PRINCE GEORGES'

834-425 M-31

N

ROAD END.
004

24'I

RIDGE RD.

MU 000 0440 @2.32

COURT 14

Form 6 HPS (Rev. 1961)

MAP 6

3-598A OP 788

ROAD INVENTORY SHEET

Party Chief T. LANDON
Recorder W. WARFIELD
Chainman

Road No. CO 3735
Name OAKWOOD ST
Sheet No. 1 OF 1
Date 4-1-70
County PRINCE GEORGES

69-183

808-~~36~~ 363 M-35

NOW ALL COUNTY

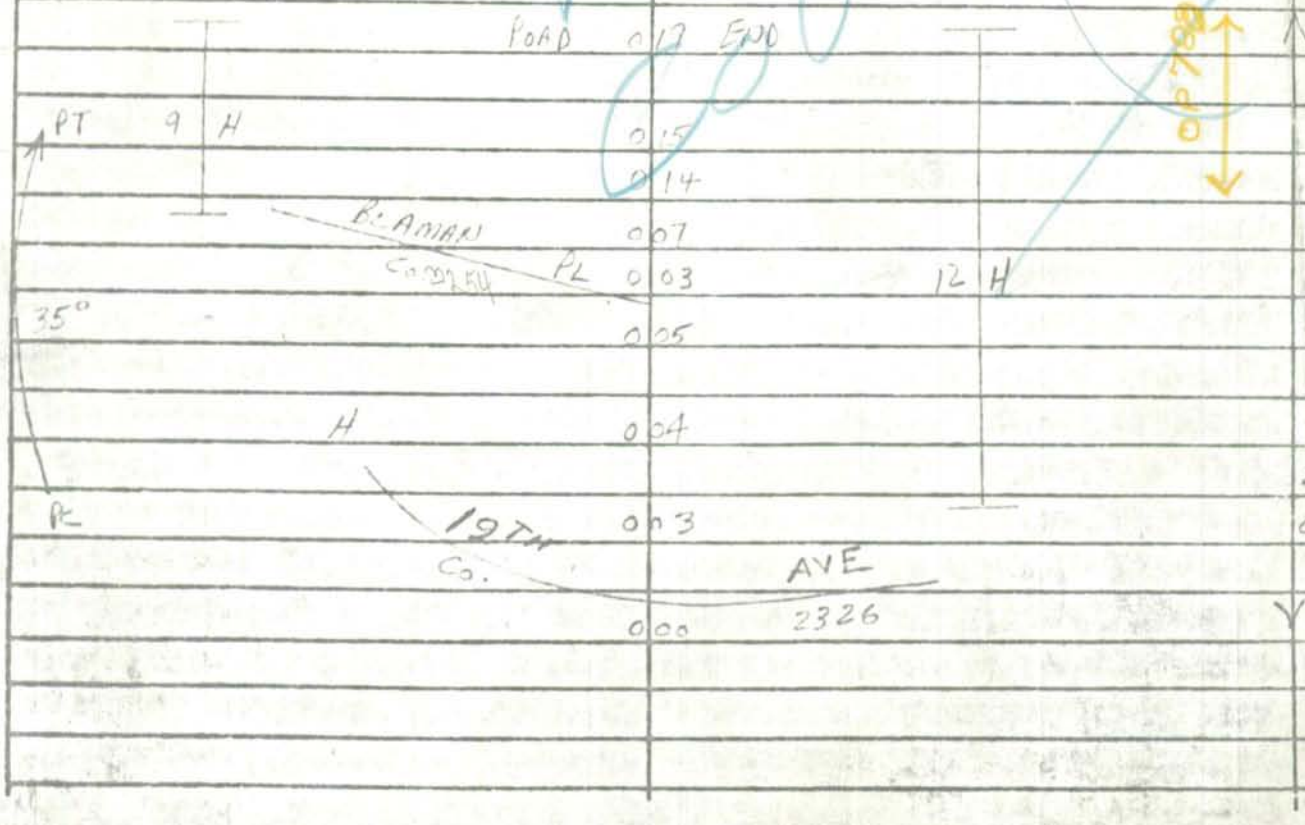

Form 6 HPS (Rev. 1961)

ROAD INVENTORY SHEET

T. LANDES
T. RHODES
VERIFIED
12/14/77

OP 789

Party Chief E.S.
Recorder W.D.
Chainman

Road No. ~~OP~~ ~~030~~ 0020
Name AMES ST
Sheet No. 1 OF 1
Date 11-6-GR
County PRINCE GEO

M35 832-362 N-7 75-16 AS TABED

MORNINGSIDE
ELEM
SCHOOL

CUL-DE 015 SAC

~~010~~ ~~SCHOOL~~

007

005 PR-36" RCP 40'

~~APROX. CRE LINE~~ 004 ~~MORNINGSIDE~~

MORGAN 000 0130 RD

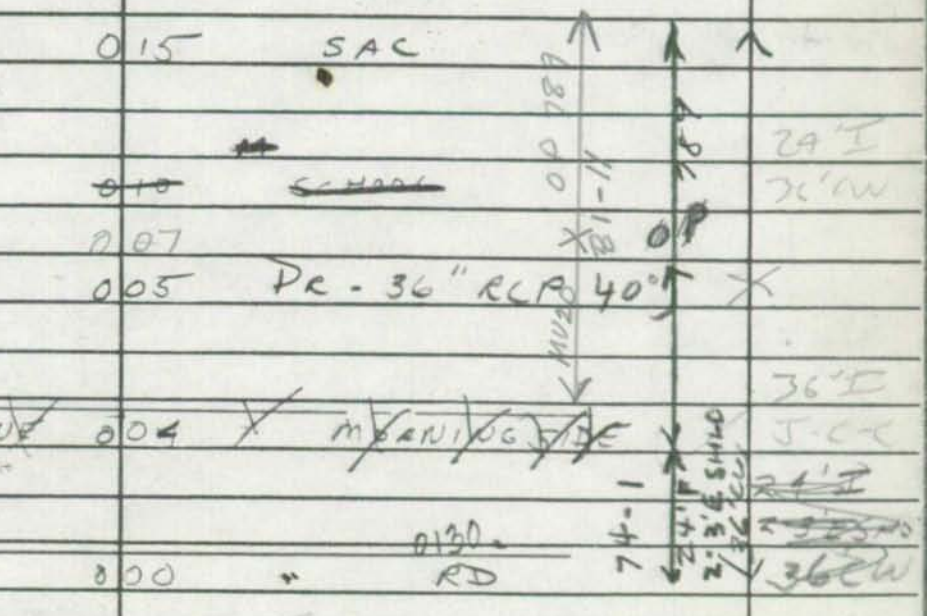

ROAD INVENTORY SHEET

Party Chief T. LANDON
Recorder D. WARFIELD
Chairman

Road No. OP 790
Name FARNESS DR.
Sheet No. 1 OF 1
Date 4-1-70
County PRINCE GEORGES

69-187 "A"

815-355 M35

(Unassigned
Now 0.349¢
(72-130)

Abandoned

ROAD 006 END

H 005

H 003 3 H 26' I C-C

001

HOLTONS Co. 000 LA. 1696.

Form C HRS (Rev. 1961) MAP 9

ROAD INVENTORY SHEET

FA 4

Party Chief T. LANDON
Recorder
Chainman

Road No. AP 791
Name FARNESS CT.
Sheet No. 1 OF 1
Date 4-1-70
County PRINCE GEORGES

815-355 M35 69-187 "B"

Unassigned
Now CO. 3493
(72-129)

H H
D E
CUL 006 SAC
H 005
3 H
002 55°
H 001 26' I
C-C
HOLTON LA.
CO. 000 1696

Form 6 HPS (Rev. 1961) MAP 10 F A U

ROAD INVENTORY SHEET

Co 3200

Party Chief T. LANDON
Recorder W. WARFIELD
Chainman

70-135

Map 7

EXTRA

69-216 "A"

Road No. OP 792
Name OLD COLONY DR.
Sheet No. 1 OF 2
Date 4-6-70
County PRINCE GEORGES

73-91

PT
45°
PC
H
10 A
WEXFORD
OP
4 H
MARKATE RD
OP 794
5 4
N. MARLTON
CO.
10°
ROAD

0050
0048
0047
0044
0042
0028
0025
0022
0018
0015
0012
0009
0006
0003
0000

H
BERWICK RD
OP 796
NOW ALSO Co 3200
11 H
RD
795
7 H
HARTLAND RD
OP 793
H
AVE.
3141
END

Co 3200

36' I
C-C

Reassigned 2-17-71 GJG

Form 6 HPS (Rev. 1961) (Previous OP 793 Now Co. 793 70-136)

ROAD INVENTORY SHEET

Urban

Party Chief E. Schuyler

Recorder H. Goerman

Chainman

GREENBELT

F11B

Road No. OP 793

Name COURT 9-Ridge Rd.

Sheet No. 1 OF 1

Date 5/24/67

County PRINCE GEORGES'

434-425 M-3

N

ROAD END.

002

24' F

WALL TO WALL

RIDGE RD.

MH 000 0440

@ 2.38

90 CONT'D 786

Reassigned 2-17-71 GJG

Form 6 HPS (Rev. 1961) Previous OP 794 Now Co. 3202 70-137

ROAD INVENTORY SHEET

urban

Party Chief E. Schuyler

Recorder H. Gotcman

Chainman

GREENBELT.

F11B

Road No. OP 794

Name COURT 6 A - Ridge Rd.

Sheet No. 1 OF 1

Date 5/24/67

County PRINCE GEORGES'

933-426 M-31

ROAD END.

004

38' I

WALL LEFT

CURB RT.

38' C-W

W

002

13' I

C-C

COURT 6

OP

000

264

795

357

@.02

Reassigned 2-17-71 GJG

Form 6 HPS (Rev. 1961) Previous OP 795 Now Co. 3204

ROAD INVENTORY SHEET

Urban

Party Chief E. Schuyler

Recorder H. Gorman

Chairman

GREENBELT.

F11B

Road No. OP 795

Name COURT 6 - Ridge Rd.

Sheet No. 1 OF 1

Date 5/24/67

County PRINCE GEORGES'

933-426 M-34

COURT RD

RIDGE RD.

W — Mu — 004 — 0440 — @2.57

↑ 90° — 003

14' F
16' C-W

COURT RD.

OP ~~1267~~ 794 — 002

↑ 90° — 001

RIDGE RD.

Mu — 000 — 0+40 — @2.54 ↓

Form 6 HPS (Rev. 1961)

Reassigned 2-17-71 GJG
(Previous OP796 Now Co 3205 70-140)

ROAD INVENTORY SHEET

Urban

PARTY CHIEF Edward Schuyler
RECORDER Henry Gorman
CHAINMAN

LAUREL

~~HT RD~~

Ver 5-10-78

~~NOT Loved~~

ROAD NO. OP 796
NAME MARSHALL AVE.
SHEET NO. 1 OF 1
DATE 12/19/66
COUNTY PRINCE GEORGES

~~835 462~~ M-27
~~833~~ 460

THIS IS A PRIVATE STREET OWNED BY LAUREL SHOPPING CENTER.

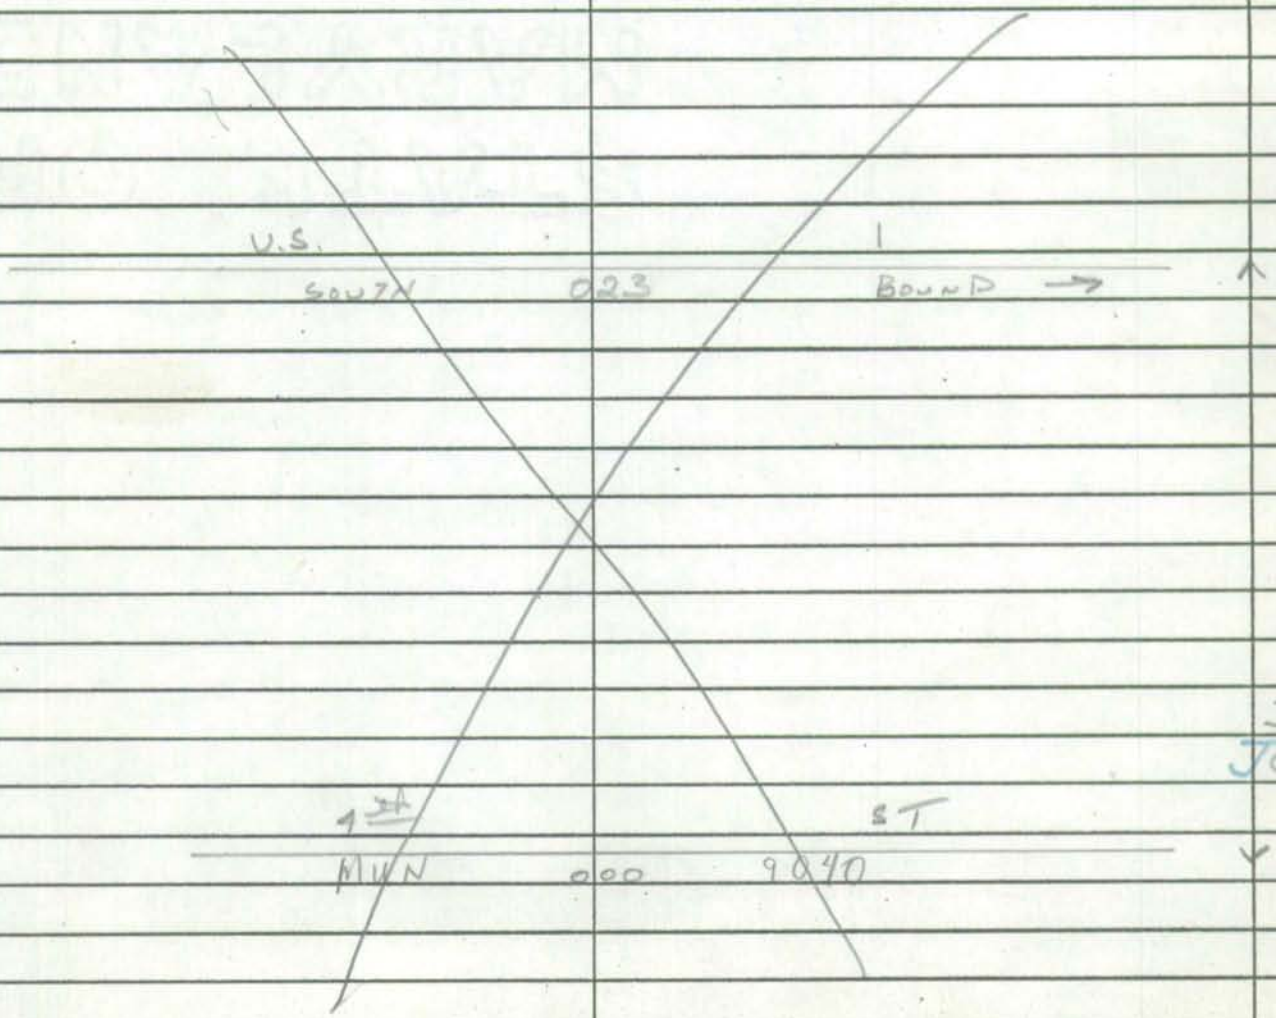

Form 6 HPS (Rev. 1961) MAP 10 FA4 OP797 Co 3599

ROAD INVENTORY SHEET

Party Chief T. LANDON
Recorder W. WARFIELD
Chairman

map 7

EXTRA

Road No. ~~OP 797~~
Name GRANDHAVEN AVE.
Sheet No. 1 OF 1
Date 4-7-70
County PRINCE GEORGES

862-343 M36 GP-216 "I"

INDEX #10

73-92

XX XX

ROAD 037 END

Unassigned

036 H

6 H 034 H Co 3599

THORNBERRY

032 ~~OP 803~~ DR. EAST Co 3600

029 H

T T T

026

T T T

PT 023 (END CoH MAINT)

020 H

THORNBERRY

50° 018 ~~OP 803~~ DR. WEST Co 3600

12 H

015

PC 013 8 H

003

OLD COLONY OP Co

001 ~~797~~ 3200

ROAD 000 END

XX XX

Co 3599

46' I C-C

Reassigned 2-17-71 G/G.

Form 6 HPS (Rev. 1961)

(Previous OP 798 Now Co 3203 70-138)

ROAD INVENTORY SHEET

PARTY CHIEF Edward Schuyler

RECORDER Henry Gorman

CHAINMAN

LAUREL

Urban ~~H87~~ ✓

ROAD NO. OP 798

NAME RIVER VIEW CT

SHEET NO. 1 OF 1

DATE 12/23/66

COUNTY PRINCE GEORGES

~~835-468~~ M-27

835-469

Duplicate of OP1281

Pulled 11-24-71

PARKING LOT

ROAD END

005

26' I

C-C

MAIN ST.

MUN 000 230 ✓

Form 6 HPS (Rev. 1961)

Reassigned 2-17-71 GJG
(Previous OP 799 Now Co 3206 70-141)

URBAN-LAUREL

ROAD INVENTORY SHEET

PARTY CHIEF Edward Schuyler
RECORDER Henry Gorman
CHAINMAN

LAUREL

E II D

Urban 1187 OP 799
ROAD NO.
NAME ALLEY # 13
SHEET NO. 1 OF 1
DATE 12/22/66
COUNTY PRINCE GEORGES
~~955-468~~ M-~~31~~
642-469

	LAUREL		AVE.	
	MUN	003	0210	
			@.47 (R)	
N				12' H
				CURB RT.
		002		15' C-W
				19' F
				19' C-W
		001	MOTOR POOL for	
			LAUREL NATIONAL GUARD	
	ALLEY		# 1	
		000		
	MUN		8010	
			@.02 (R)	

Form 6 HPS (Rev. 1961)

Reassigned 2-17-71 EJG
Previous OP 800 Now Co. 3215

ROAD INVENTORY SHEET

Urban 7186

PARTY CHIEF Edward Schuyler
RECORDER Henry Gorman
CHAINMAN

LAUREL URBAN

E11D

ROAD NO. OP800
NAME ALLEY
SHEET NO. 1 OF 1
DATE 12/22/66
COUNTY PRINCE GEORGES
844-462 M-27

LAUREL

N

PRINCE		GEORGE ST.	
MUN	006	0350	
			9'E
			12'C-W
MONTGOMERY		ST	
MUN	000	0260	